

- ① VT 14 STA 382+75.0 RT - VT 14 STA 386+25.0 RT
CONSTRUCT NEW GRASS-LINED DITCH
- ② VT 14 STA 383+91.3 RT - VT 14 STA 385+83.2 RT
CONSTRUCT NEW DITCH LINED WITH STONE FILL, TYPE I

CONSTRUCT 5' WIDE PAVED APRON
VT 14 STA 384+28.7 LT - VT 14 STA 384+67.8 LT

CONSTRUCT GRAVEL DRIVE (10' WIDE)
VT 14 STA 384+50.0 LT

CONSTRUCT SLOPE W/ STONE FILL, TYPE II
VT 14 STA 382+80.9 RT - VT 14 STA 386+15.0 RT



SPECIAL PROVISION (REINFORCED SOIL SLOPE) W/ STONE FILL, TYPE II
VT 14 STA 386+25.0 RT - VT 14 STA 388+00.0 RT

BOX BEAM GUARDRAIL

VT 14 STA 384+87.1 LT - VT 14 STA 387+88.8 LT
VT 14 STA 386+11.7 RT - VT 14 STA 388+00.0 RT

MANUFACTURED TERMINAL SECTION, TANGENT


VT 14 STA 384+73.3 LT - VT 14 STA 384+87.1 LT
VT 14 STA 385+97.5 RT - VT 14 STA 386+11.7 RT
VT 14 STA 387+88.8 LT - VT 14 STA 388+00.0 LT

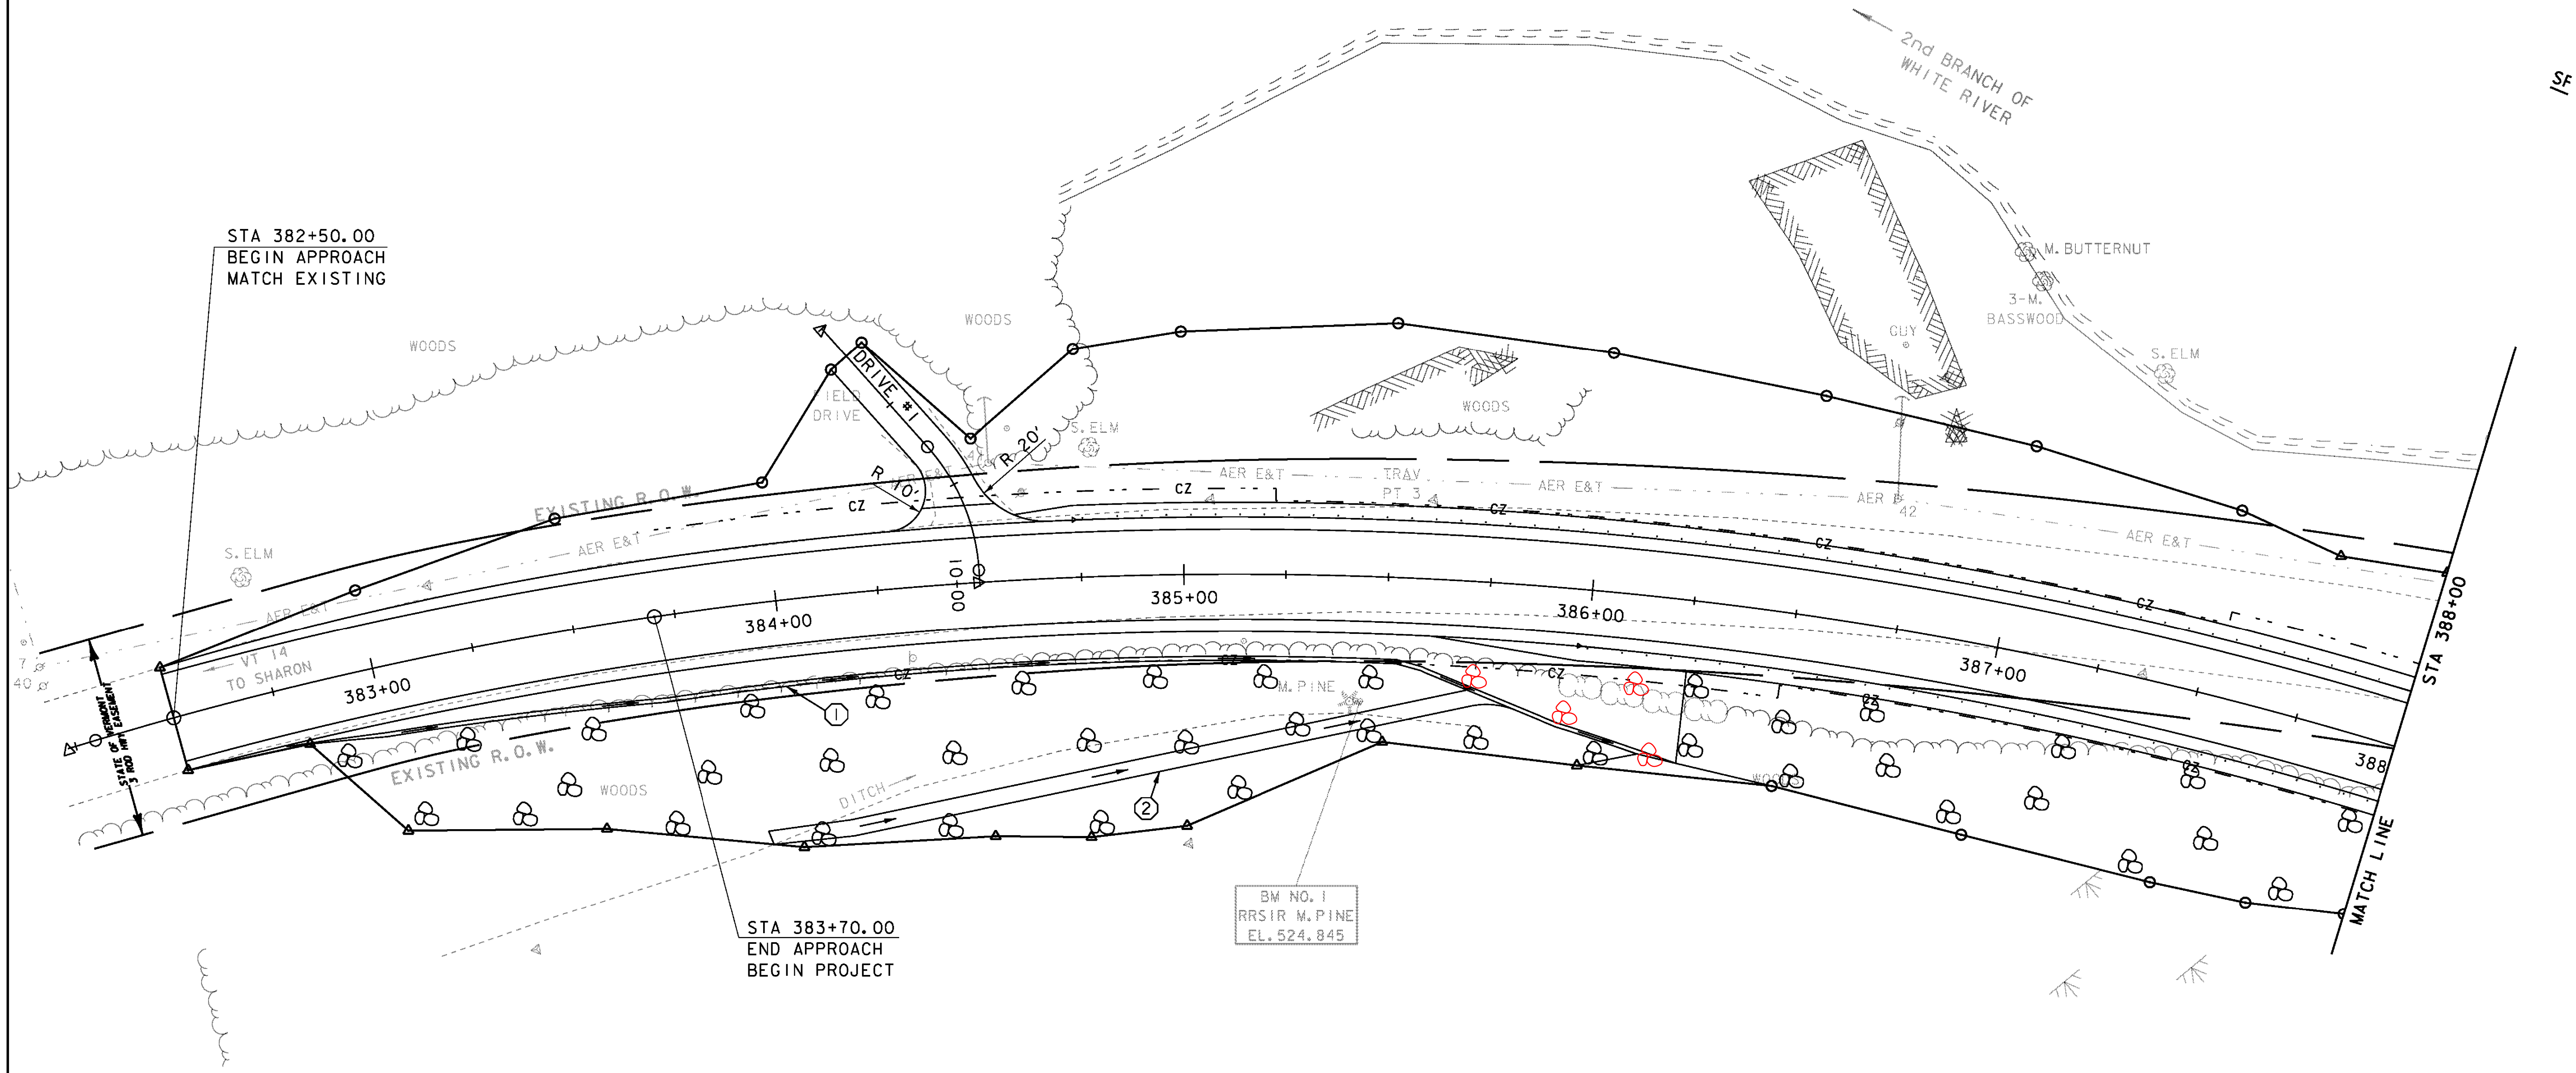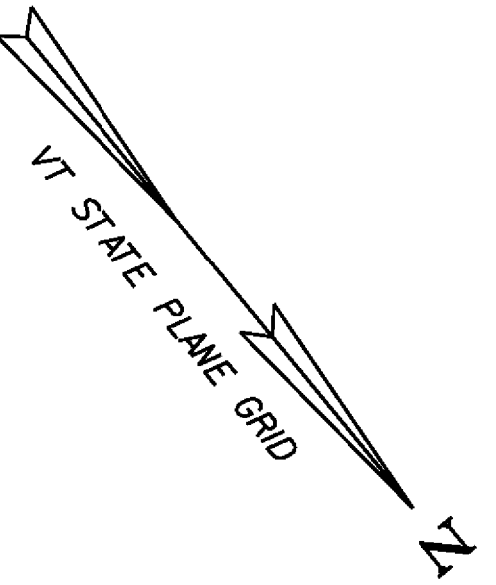

STA 382+50.00
BEGIN APPROACH
MATCH EXISTING

STA 383+70.00
END APPROACH
BEGIN PROJECT

BM NO. 1
RRSIR M. PINE
EL. 524.845

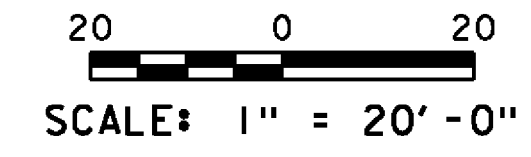

PROJECT NAME: ROYALTON	PLOT DATE: 08-OCT-2013
PROJECT NUMBER: BRS 0147(13)	DRAWN BY: L. BULLOCK
FILE NAME: \BR 27\s86e055bdr_27.dgn	CHECKED BY: C. CARLSON
PROJECT LEADER: C. CARLSON	SHEET 21 OF 186
DESIGNED BY: D. PETERSON	
BRIDGE 27 LAYOUT (1)	