

**DURABLE 4 INCH WHITE LINE**




VT 14 STA 393+50.0 RT - VT 14 ~~STA 396+25.0 RT~~  
VT 14 STA 393+50.0 LT - VT 14 ~~STA 396+25.0 LT~~

**DURABLE 4 INCH YELLOW LINE**

VT 14 STA 393+50.0 C - VT 14 STA 396+25.0 C (DOUBLE)

**REMOVING SIGNS**

VT 14 STA 397+00.0 LT

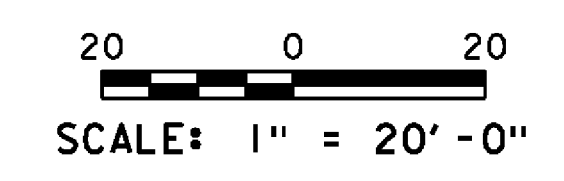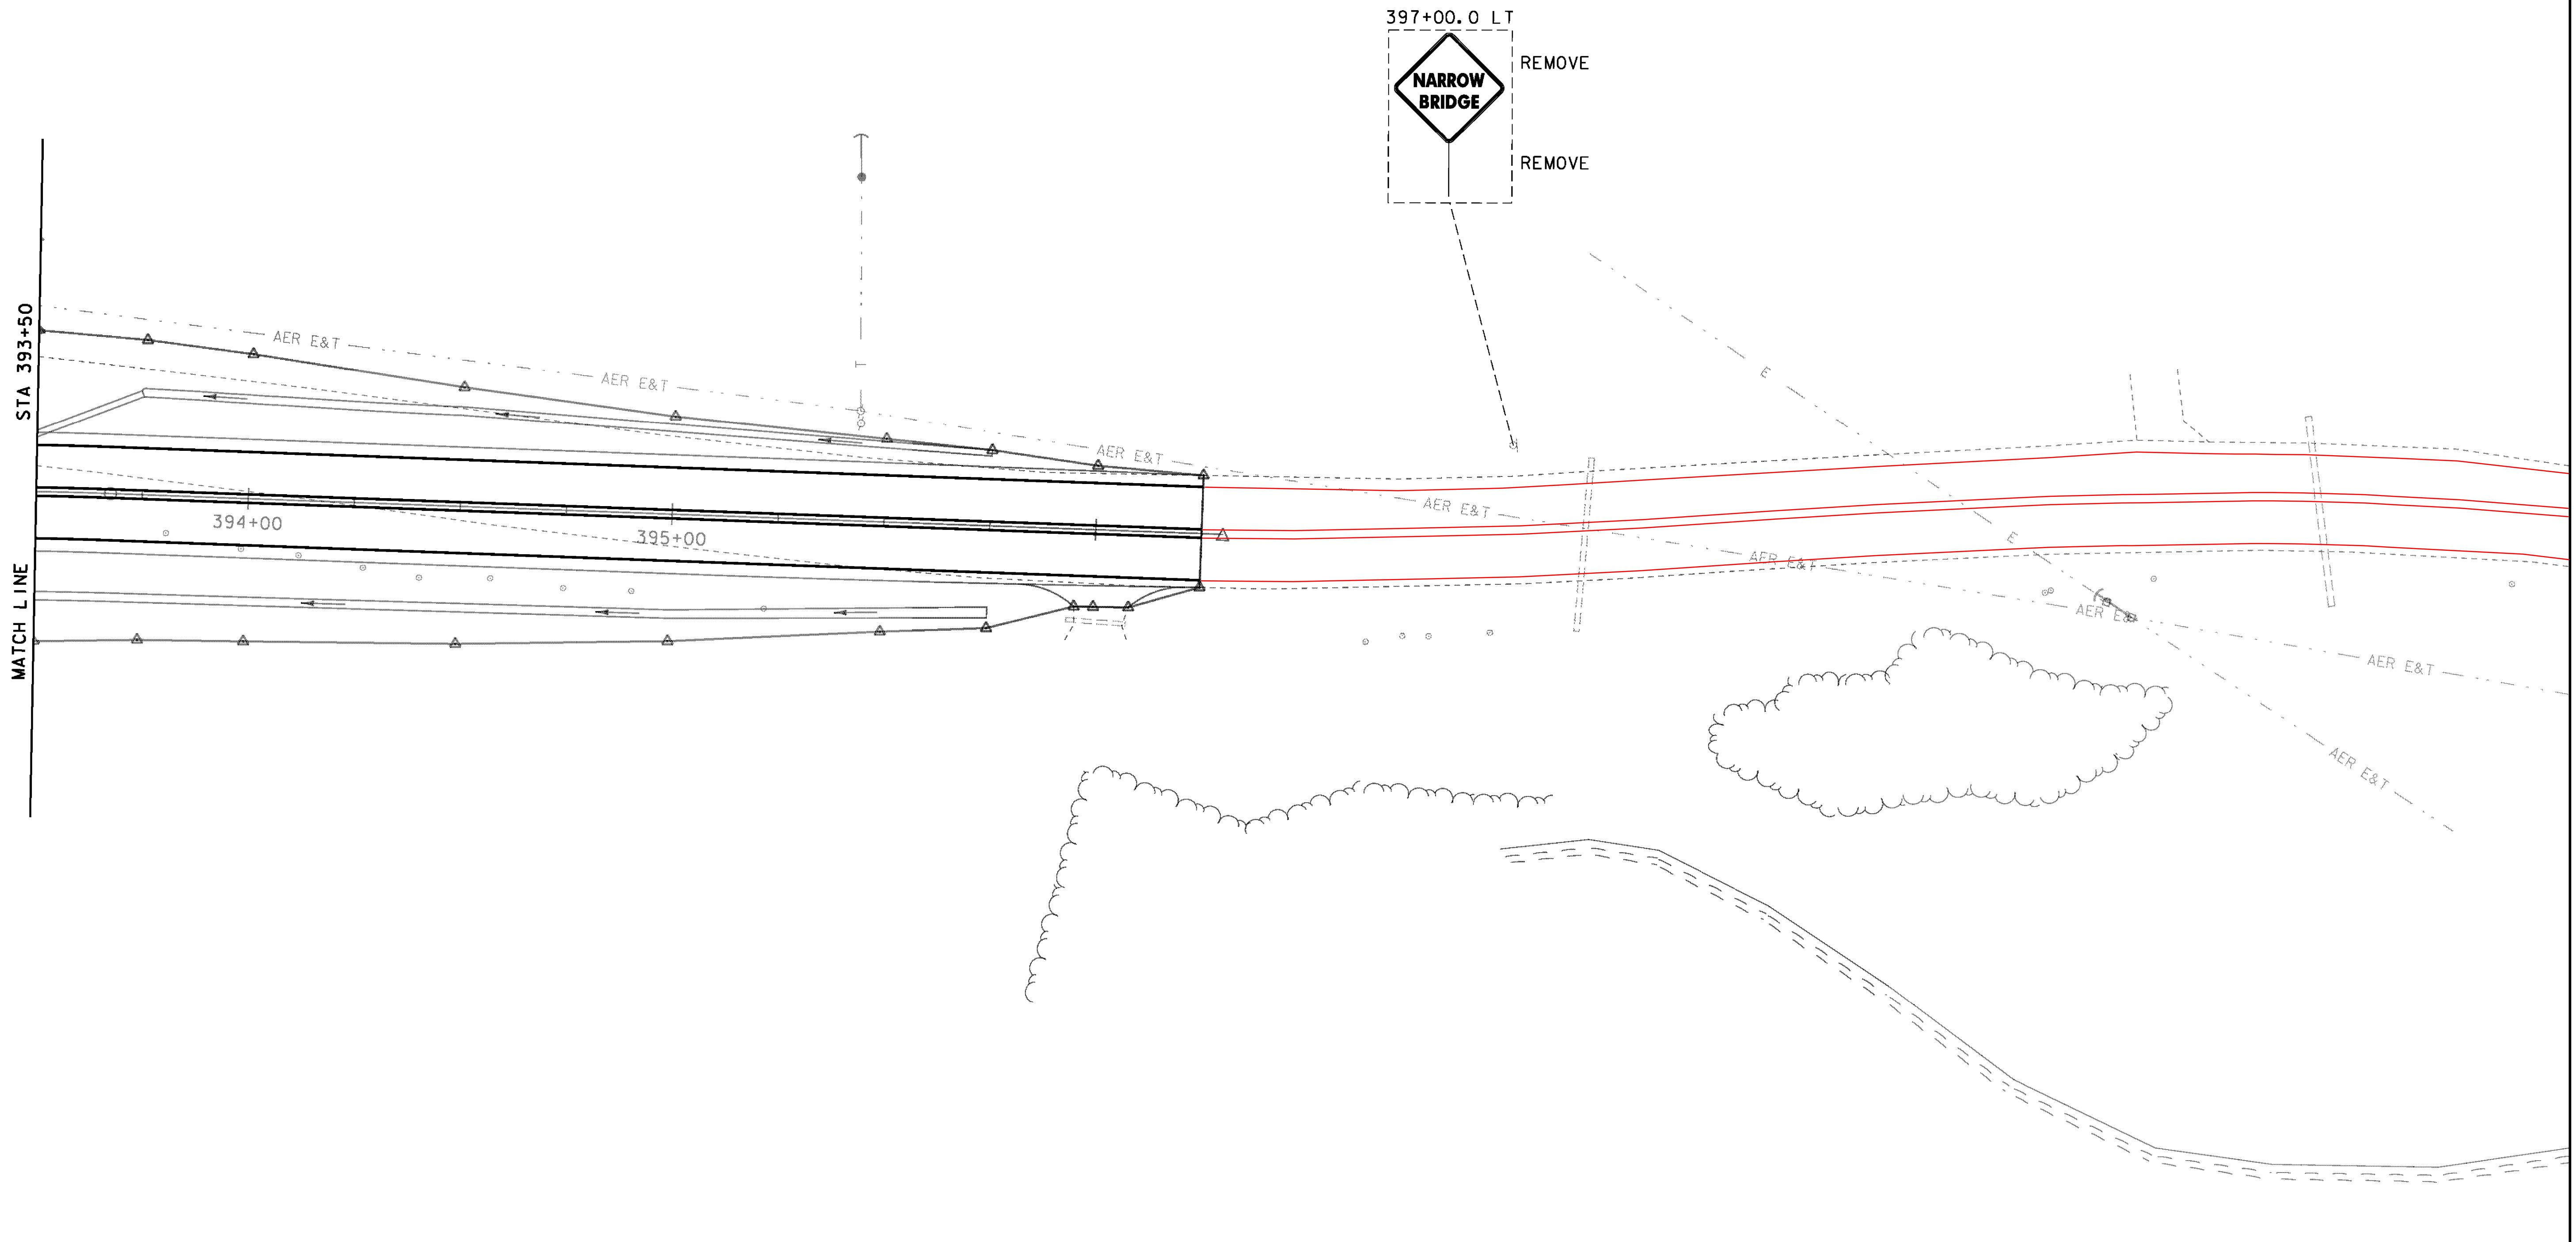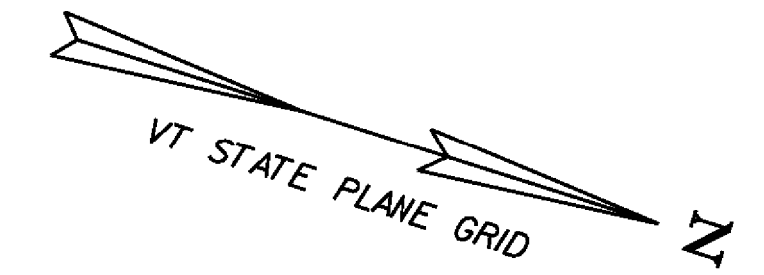

PROJECT NAME:	ROYALTON
PROJECT NUMBER:	BRS 0147 (13)
FILE NAME:	\\BR 27\s86e055\trfbdr_27.dgn
PROJECT LEADER:	C. CARLSON
DESIGNED BY:	D. PETERSON
BRIDGE 27 SIGNS & PAVEMENT MARKINGS (3)	
PLOT DATE:	08-OCT-2013
DRAWN BY:	D. PETERSON
CHECKED BY:	C. CARLSON
SHEET	31 OF 186