


PLAN

SCALE 1" = 10'-0"
 10 0 10

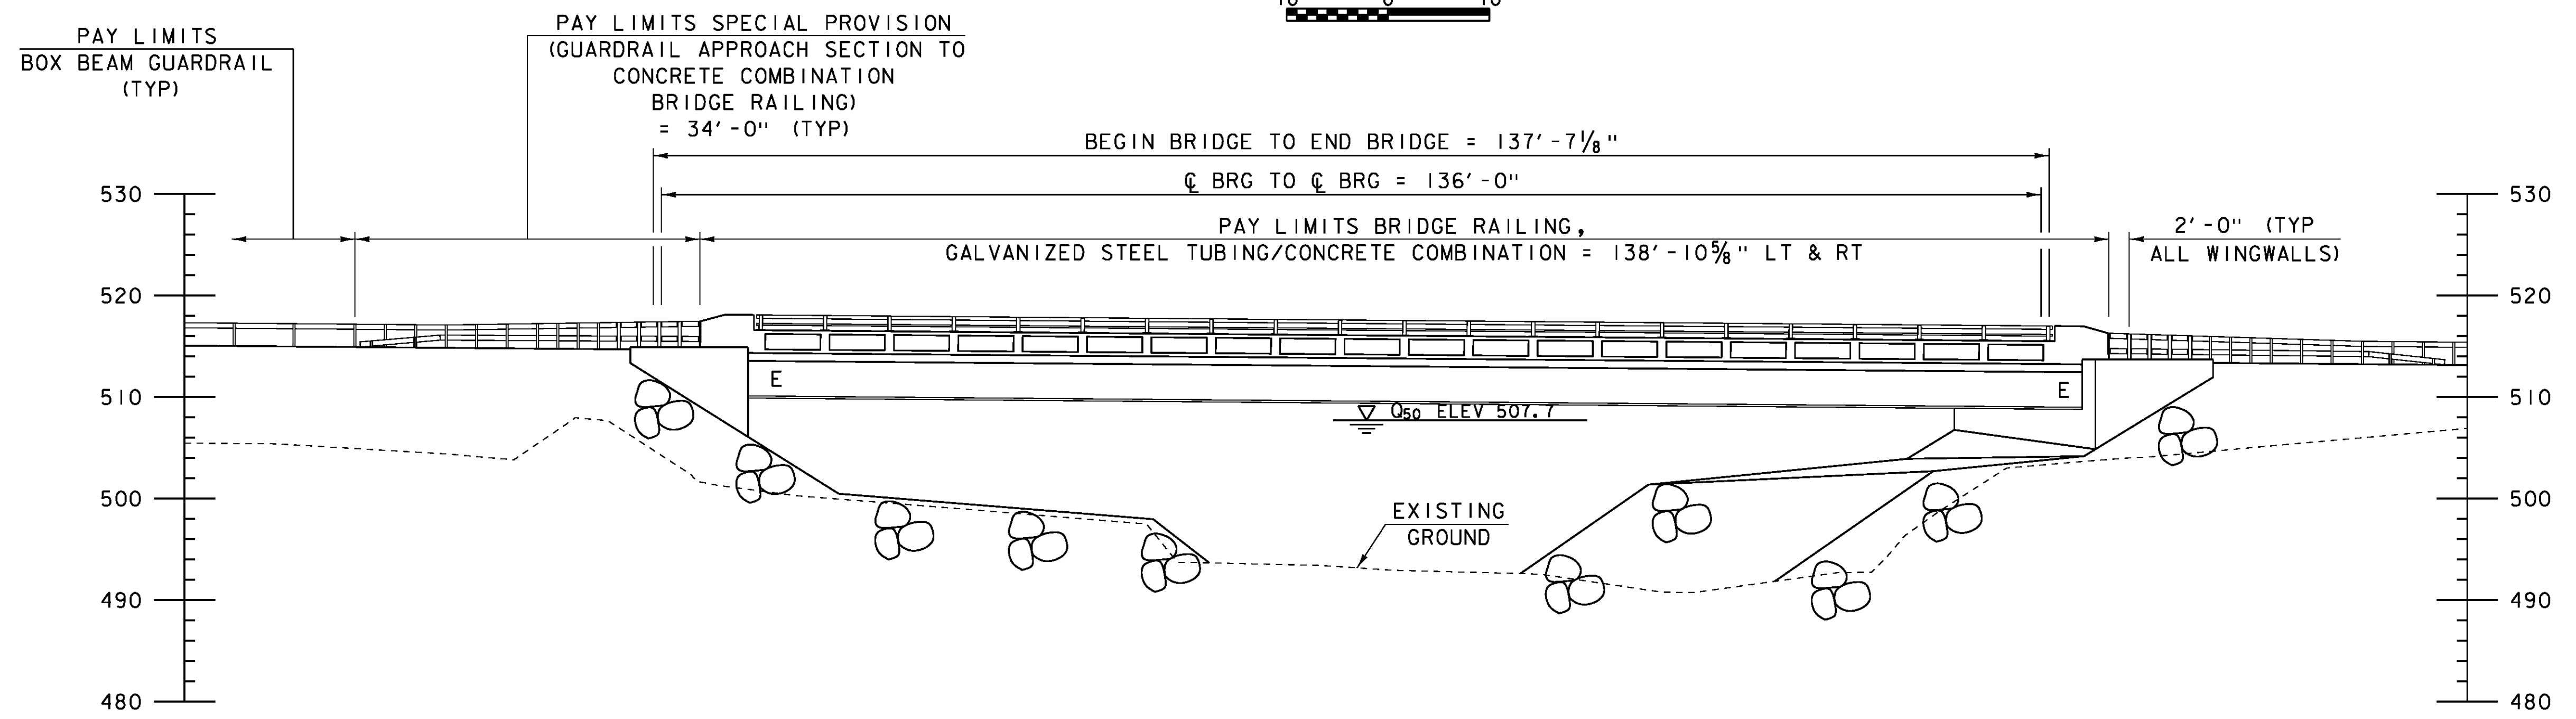

ELEVATION

SCALE 1" = 10'-0"
 10 0 10

PROJECT NAME:	ROYALTON	PLOT DATE:	08-OCT-2013
PROJECT NUMBER:	BRS 0147 (13)	DRAWN BY:	D. PETERSON
FILE NAME:	\BR 27\s86e055pe.27.dgn	CHECKED BY:	C. CARLSON
PROJECT LEADER:	C. CARLSON	BRIDGE 27 PLAN AND ELEVATION	SHEET 35 OF 186