



FRAMING PLAN

SCALE 1/8" = 1'-0"

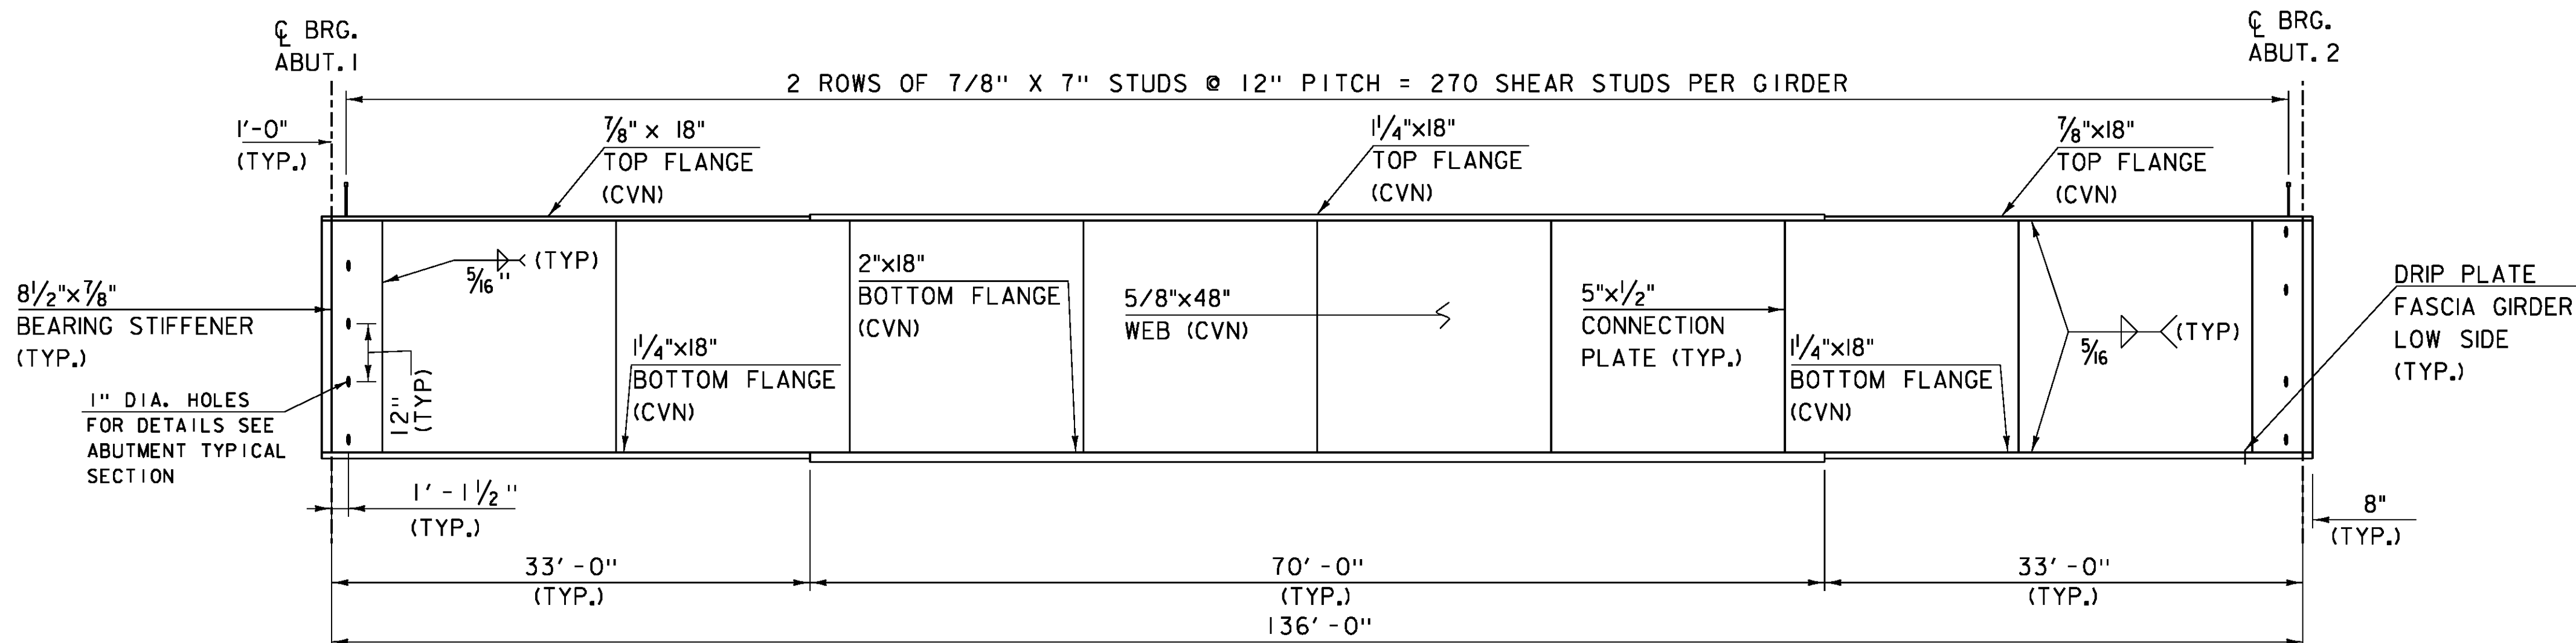

GIRDER ELEVATION

HORIZONTAL SCALE 1/8" = 1'-0"
 VERTICAL SCALE 1/2" = 1'-0"

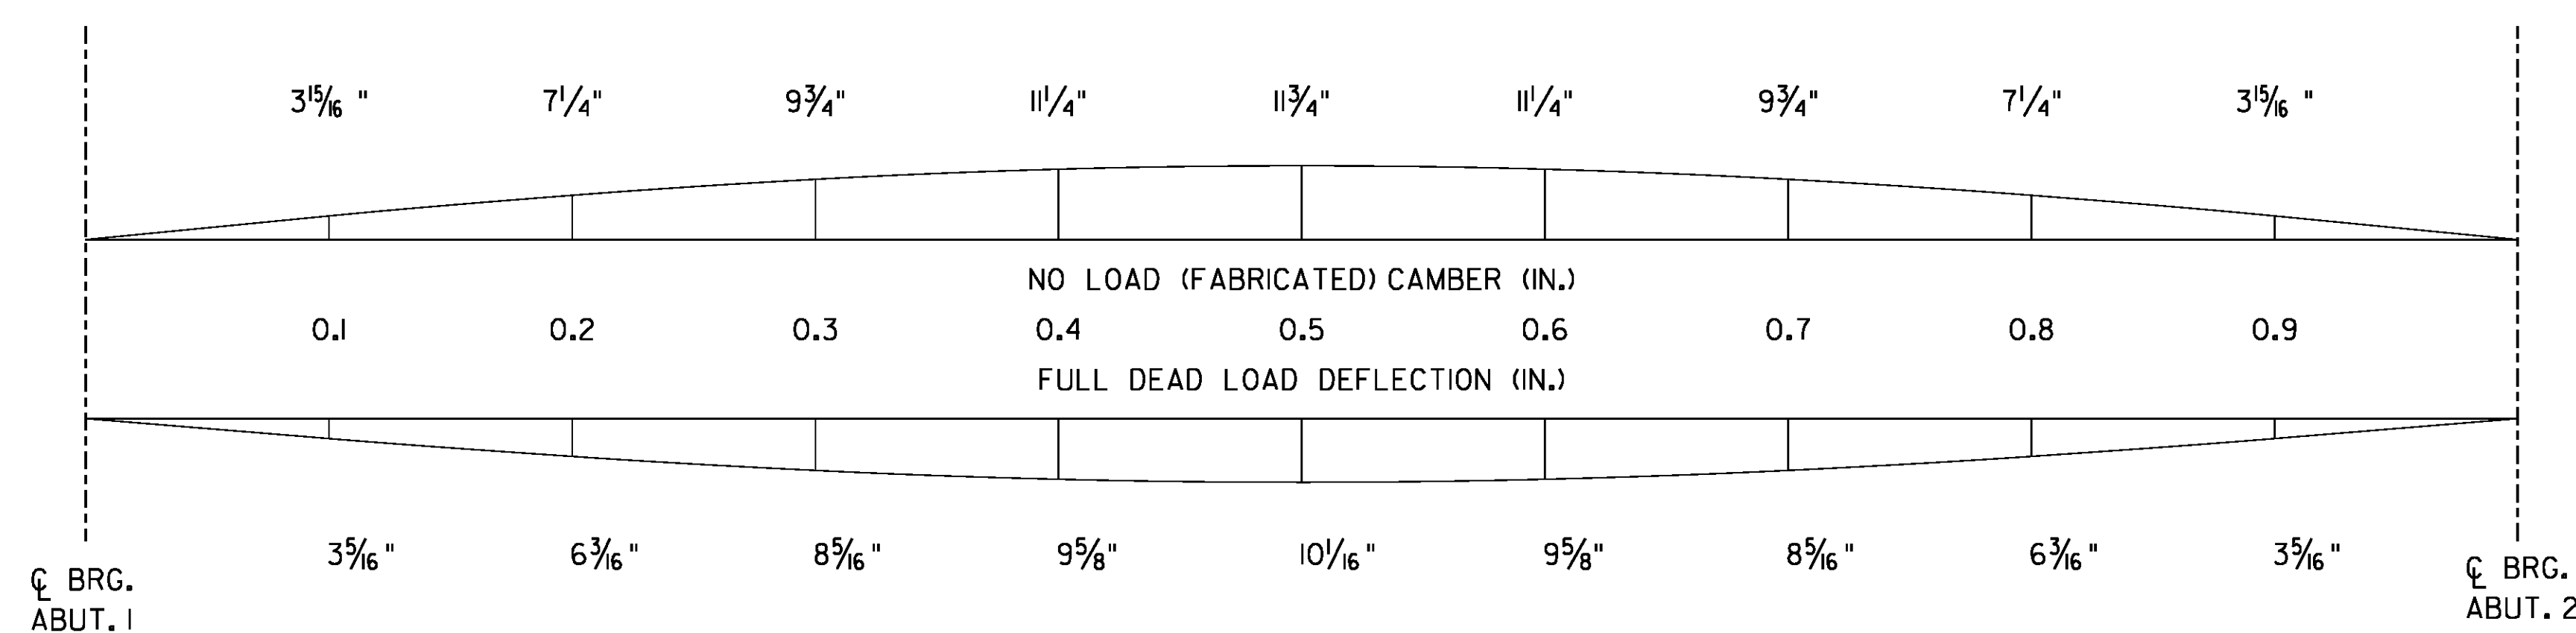

CAMBER AND DEAD LOAD DEFLECTION

HORIZONTAL SCALE 1/8" = 1'-0"
 VERTICAL SCALE 1/2" = 1'-0"

NOTE:

- NF = NEAR FACE
- FF = FAR FACE
- EF = EACH FACE
- ▲ = CUT TO FIT IN FIELD
- 3" CLEAR, UNLESS OTHERWISE SPECIFIED ON THE PLANS.
- 2'-2" BAR LAP UNLESS OTHERWISE SPECIFIED ON THE PLANS.

PROJECT NAME: ROYALTON
 PROJECT NUMBER: BRS 0147(13)

FILE NAME: s86e055sup.dgn
 PROJECT LEADER: C. CARLSON
 DESIGNED BY: D. PETERSON
 BRIDGE 27 FRAMING PLAN

PLOT DATE: 08-OCT-2013
 DRAWN BY: N. COVEY
 CHECKED BY: D. PETERSON
 SHEET 37 OF 186