


INTEGRAL ABUTMENT NO. 2 PLAN
SCALE 1/2"=1'-0"

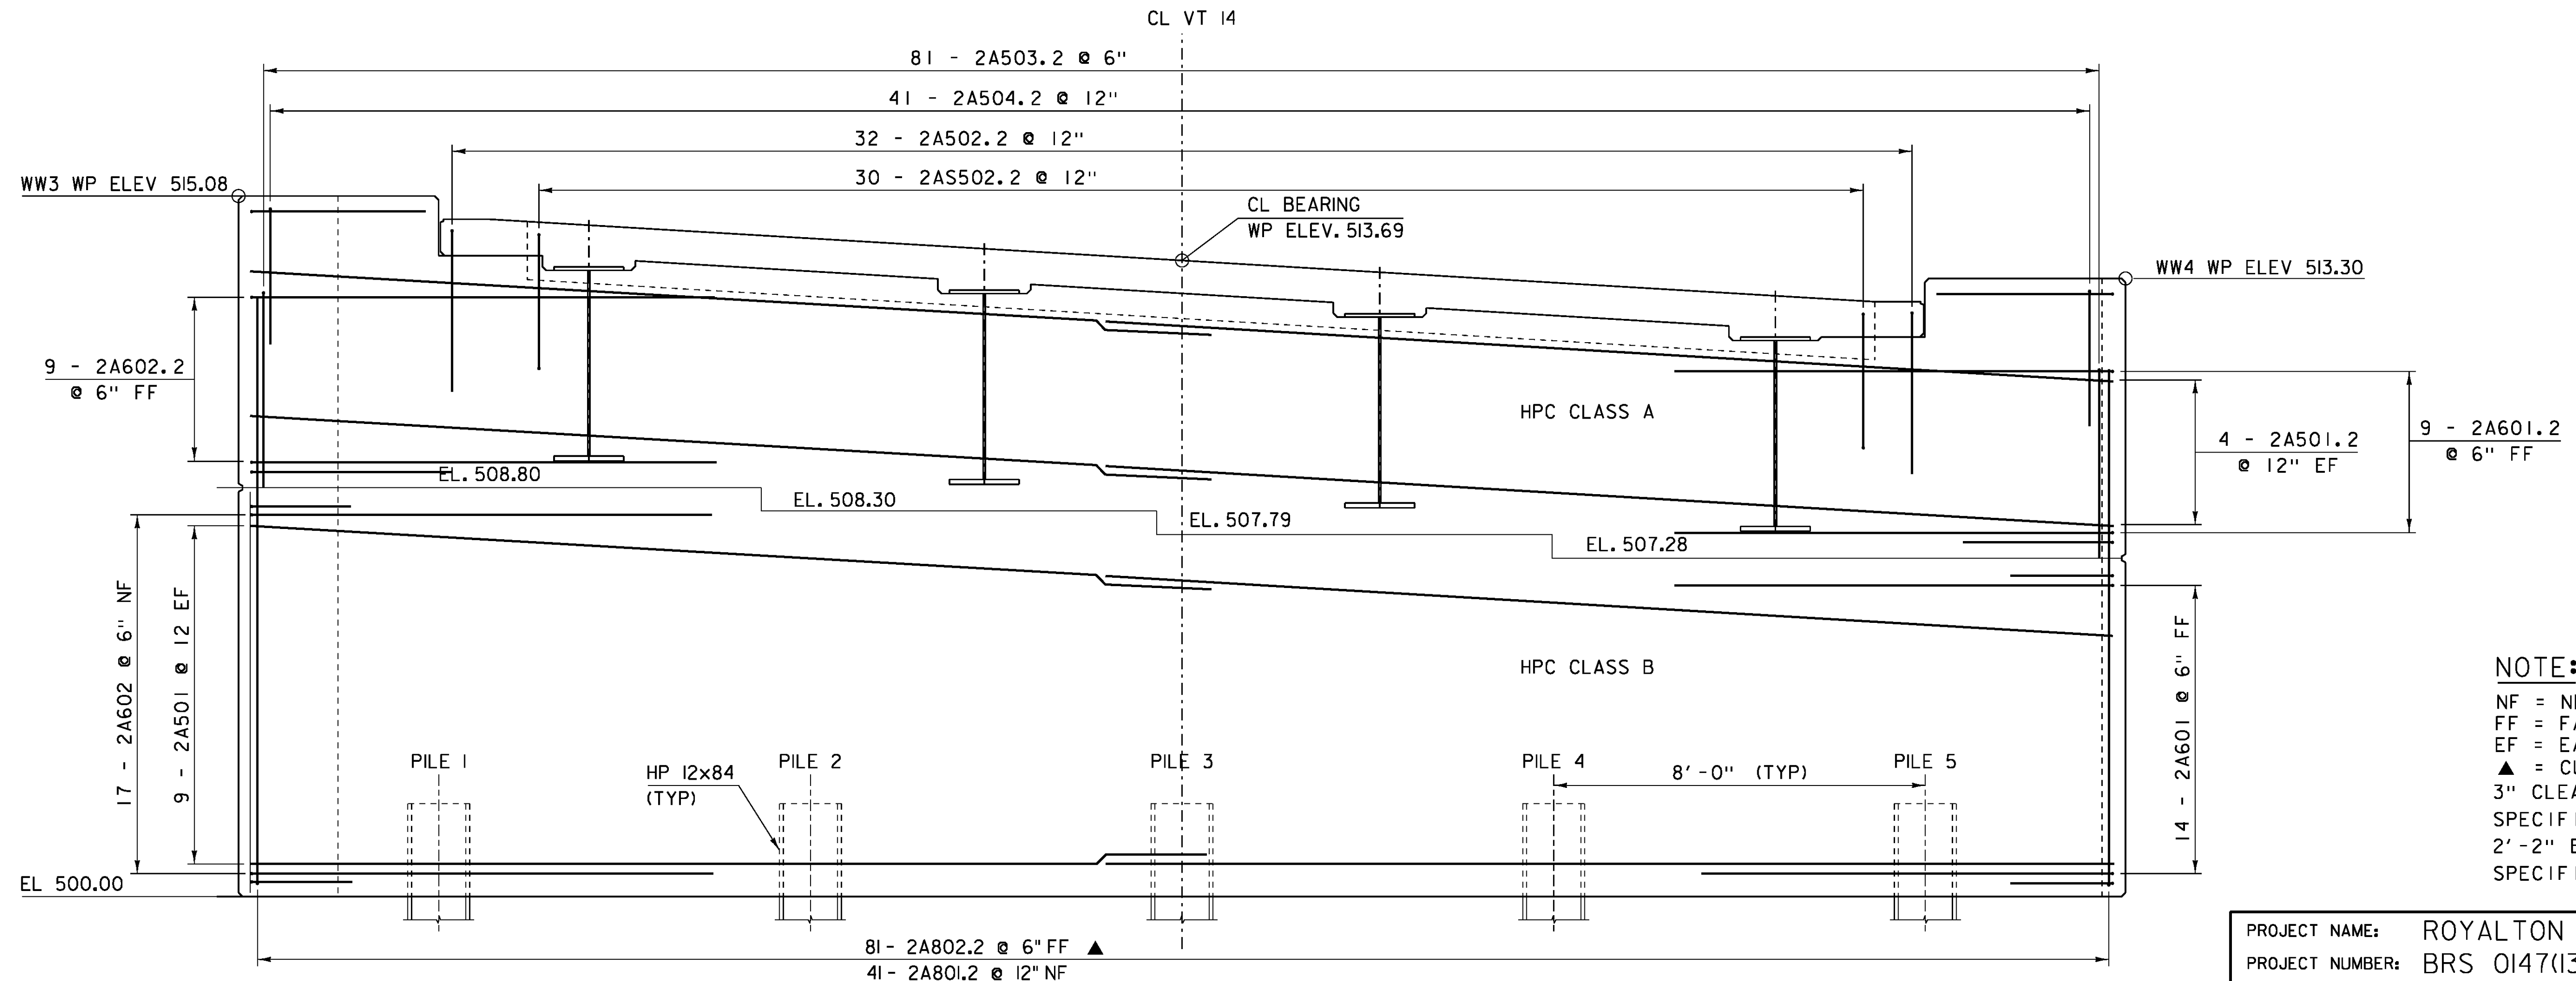

INTEGRAL ABUTMENT NO. 2 ELEVATION
SCALE 1/2"=1'-0"

NOTE:
 NF = NEAR FACE
 FF = FAR FACE
 EF = EACH FACE
 ▲ = CUT TO FIT IN FIELD
 3" CLEAR, UNLESS OTHERWISE SPECIFIED ON THE PLANS.
 2'-2" BAR LAP UNLESS OTHERWISE SPECIFIED ON THE PLANS.

PROJECT NAME:	ROYALTON
PROJECT NUMBER:	BRS 0147(I3)
FILE NAME:	s86e005sub.dgn
PROJECT LEADER:	C. CARLSON
DESIGNED BY:	D. PETERSON
BRIDGE 27 ABUTMENT 2 PLAN AND ELEVATION	SHEET 42 OF 186
PLOT DATE:	08-OCT-2013
DRAWN BY:	C. MOONEY
CHECKED BY:	J. LACROIX