


WINGWALL 2 ELEVATION
SCALE 1"=1'-0"

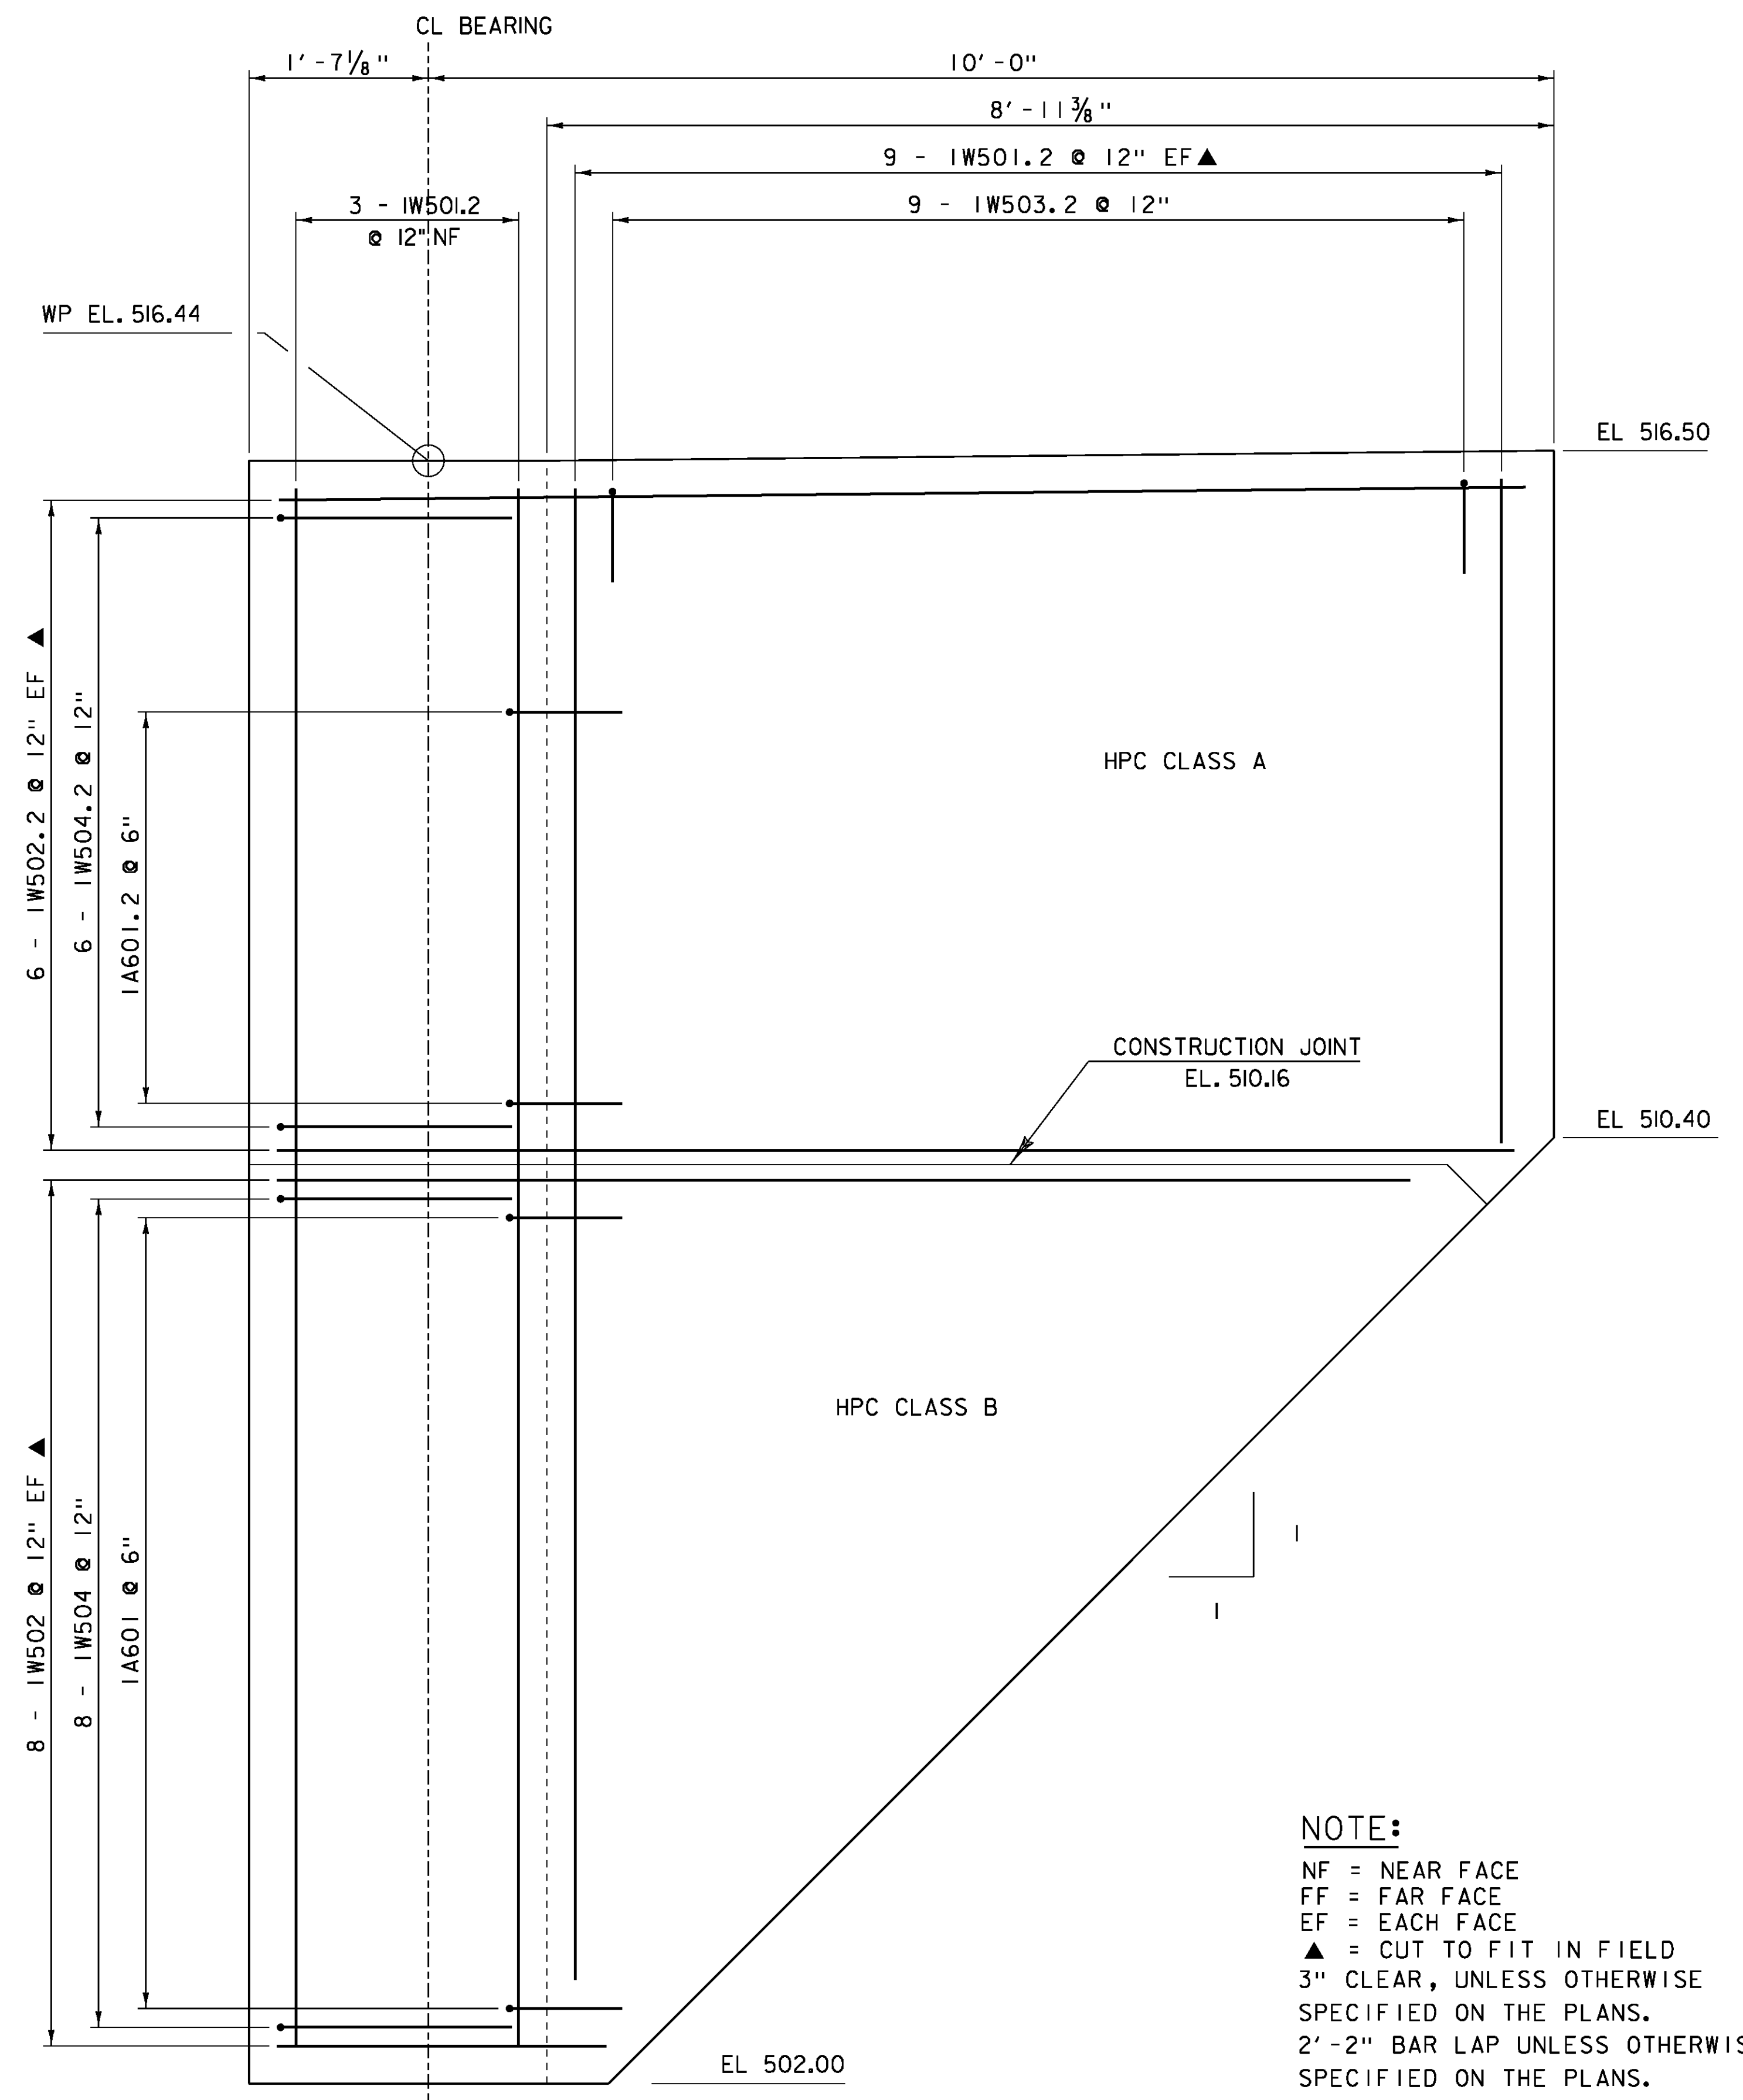

WINGWALL 1 ELEVATION
SCALE 1"=1'-0"

NOTE:
 NF = NEAR FACE
 FF = FAR FACE
 EF = EACH FACE
 ▲ = CUT TO FIT IN FIELD
 3" CLEAR, UNLESS OTHERWISE SPECIFIED ON THE PLANS.
 2'-2" BAR LAP UNLESS OTHERWISE SPECIFIED ON THE PLANS.

| | |
|--|----------------|
| PROJECT NAME: | ROYALTON |
| PROJECT NUMBER: | BRS 0147(13) |
| FILE NAME: | s86e005sub.dgn |
| PROJECT LEADER: | C. CARLSON |
| DESIGNED BY: | D. PETERSON |
| BRIDGE 27 WINGWALLS 1 AND 2 ELEVATIONS | |
| PLOT DATE: | 08-OCT-2013 |
| DRAWN BY: | C. MOONEY |
| CHECKED BY: | J. LACROIX |
| SHEET | 44 OF 186 |