



386+00


STA 383+70.00
END APPROACH
BEGIN PROJECT

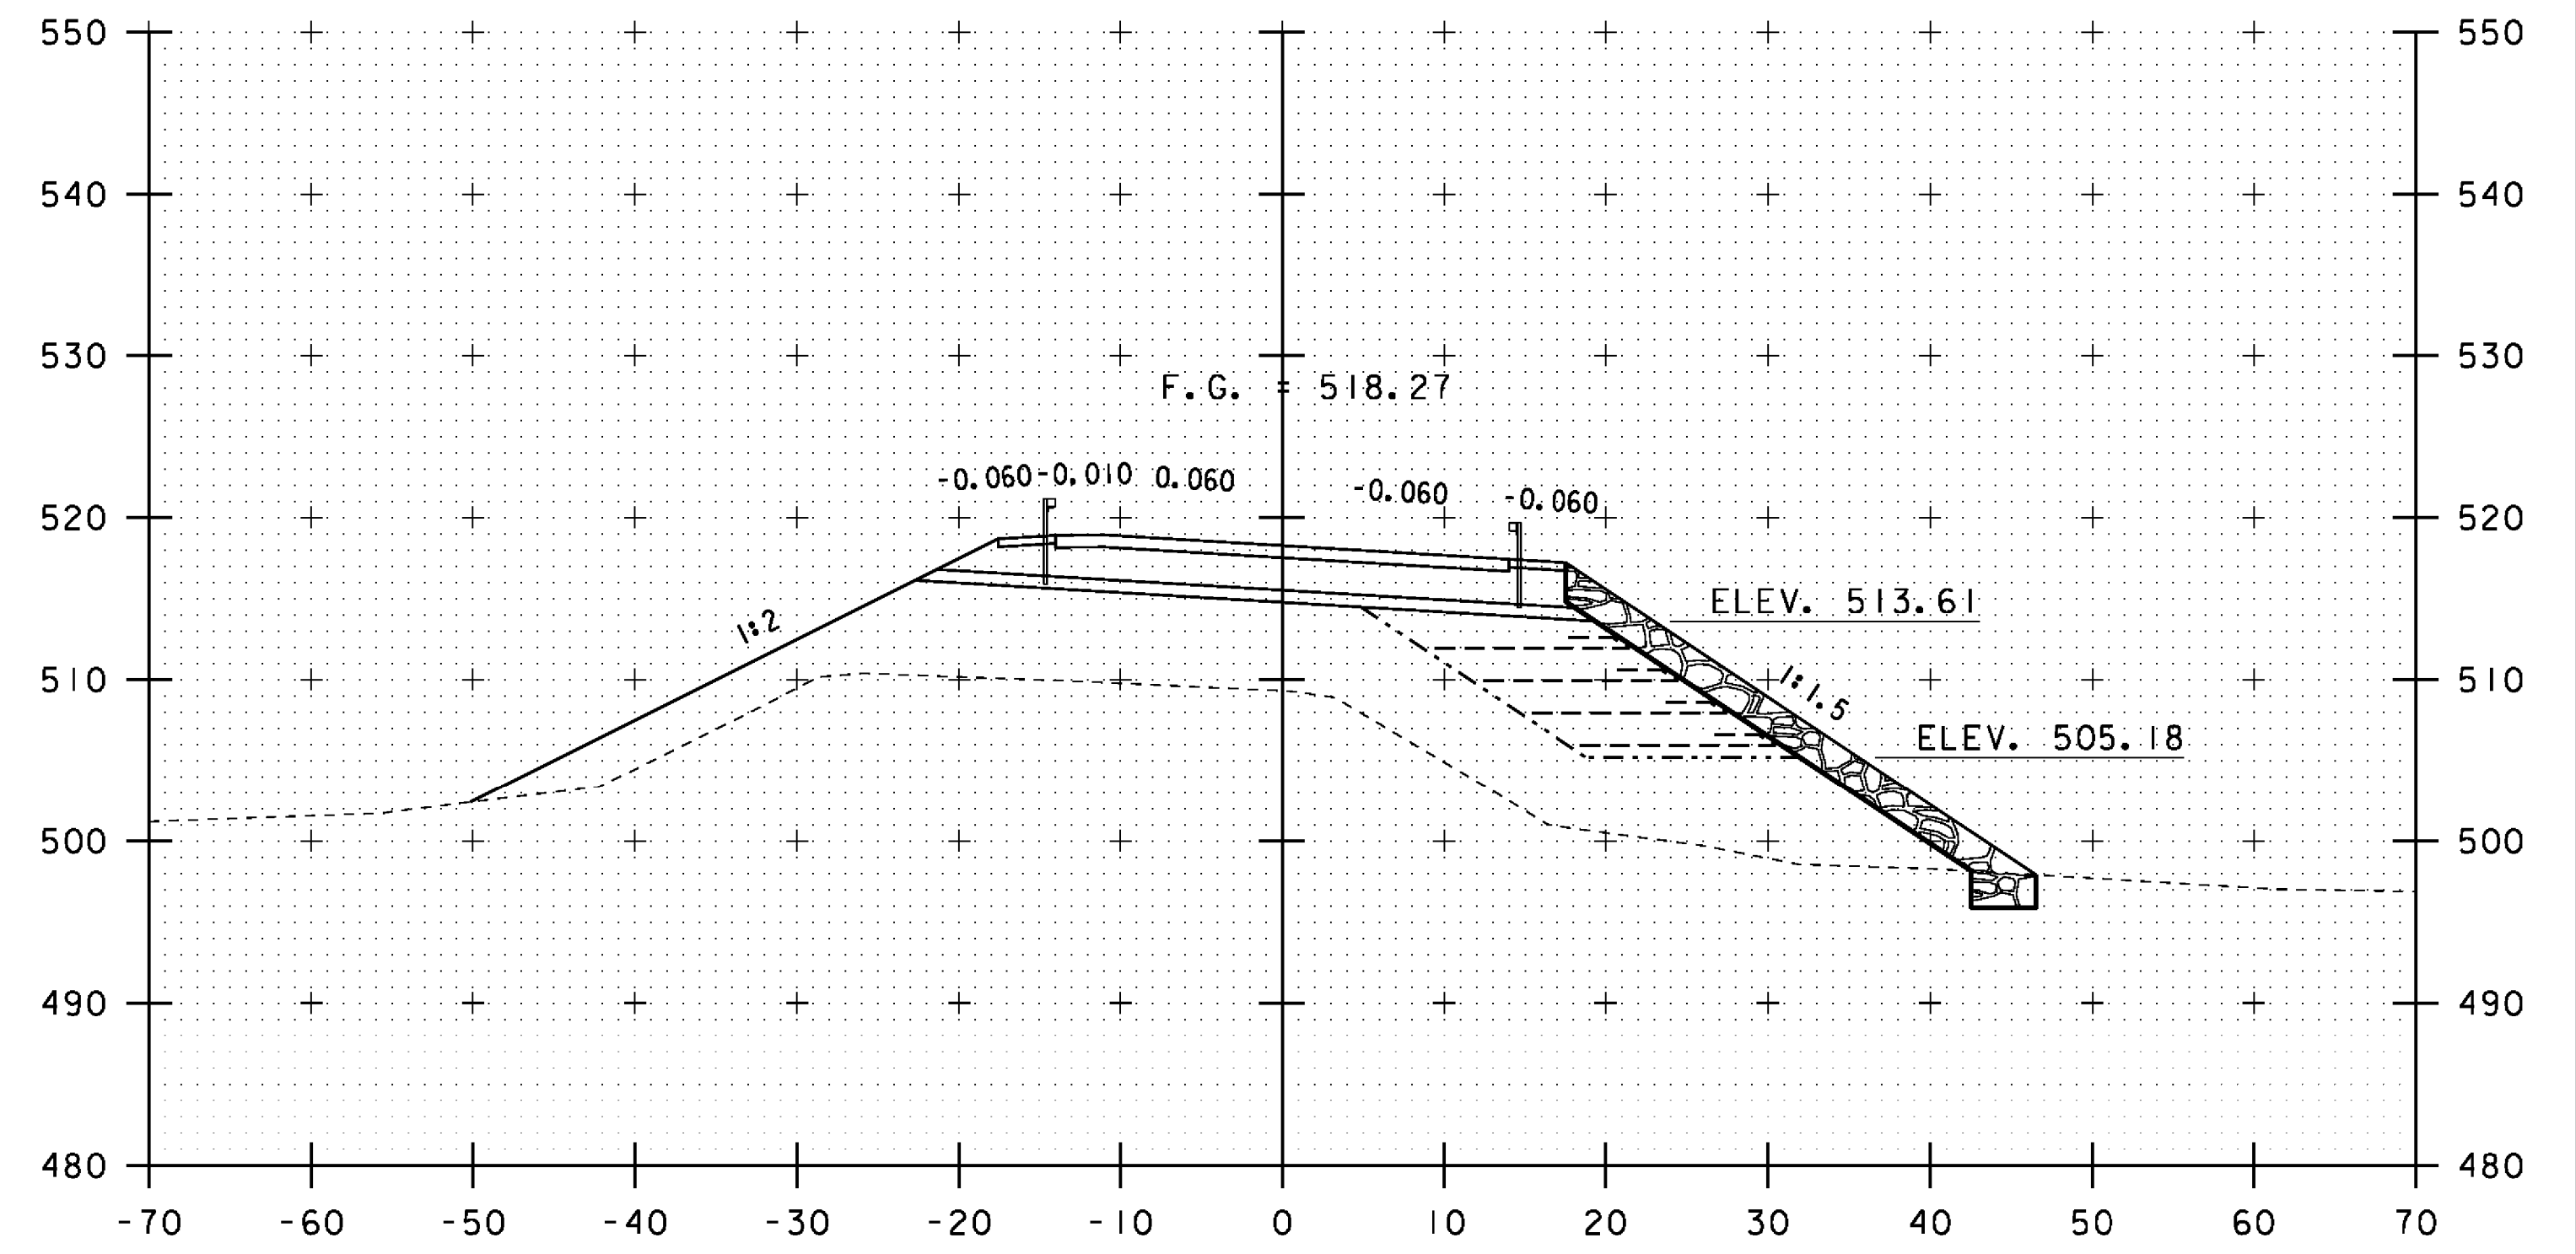

387+00

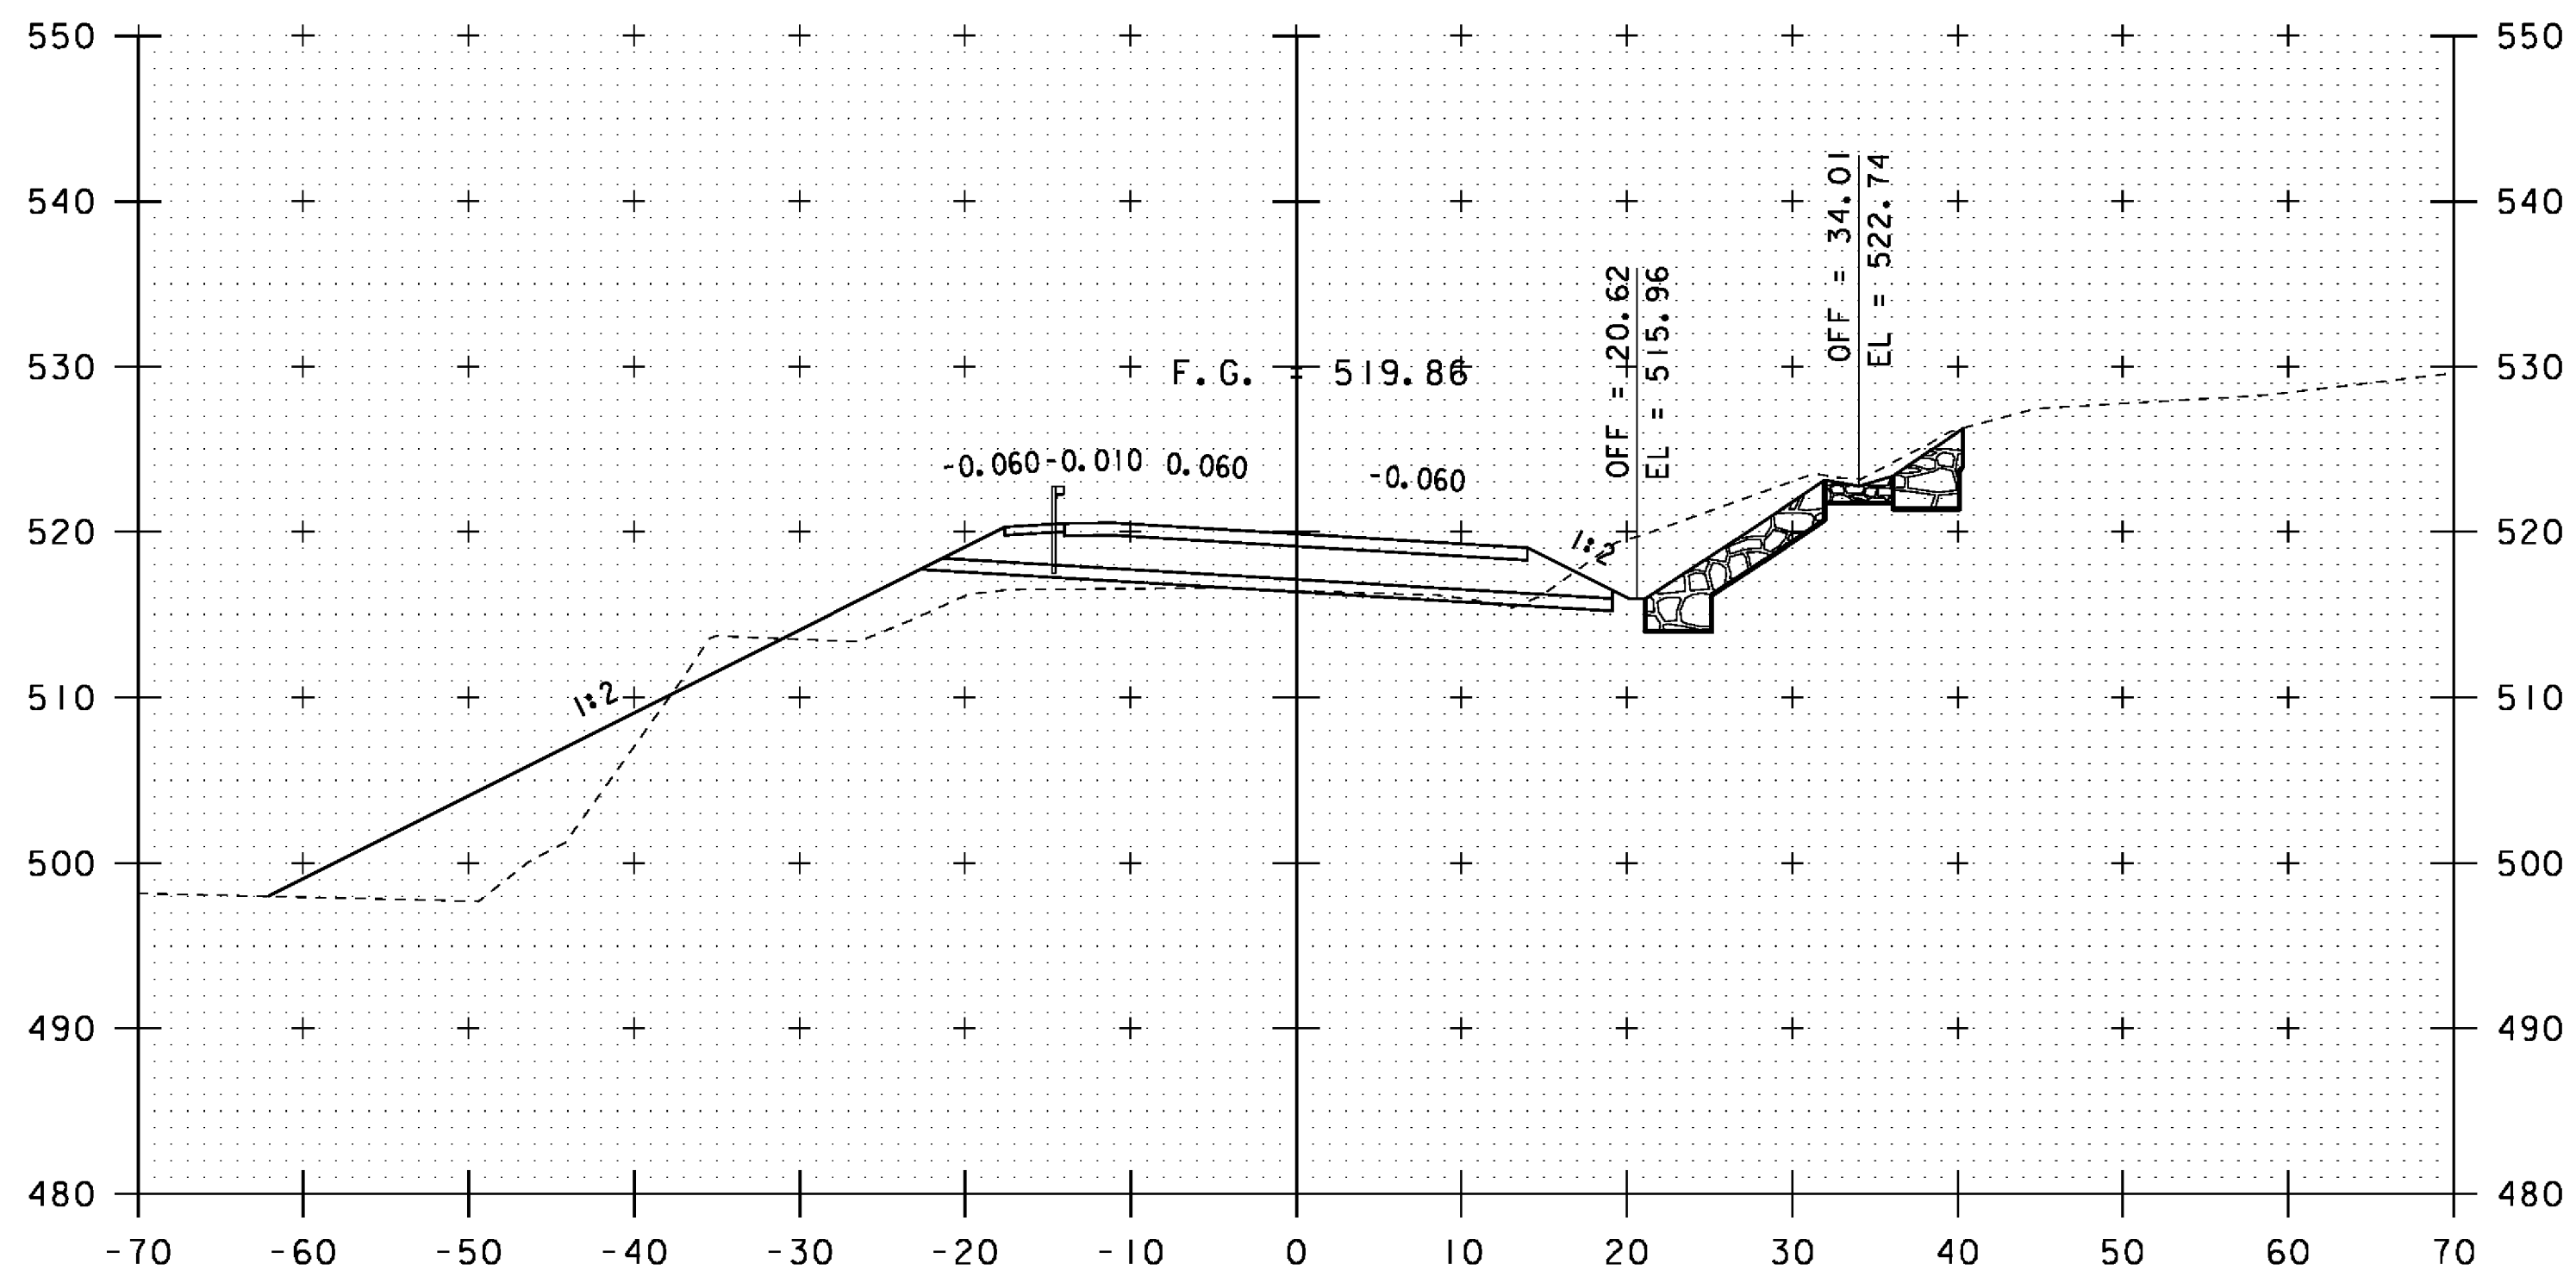

385+50

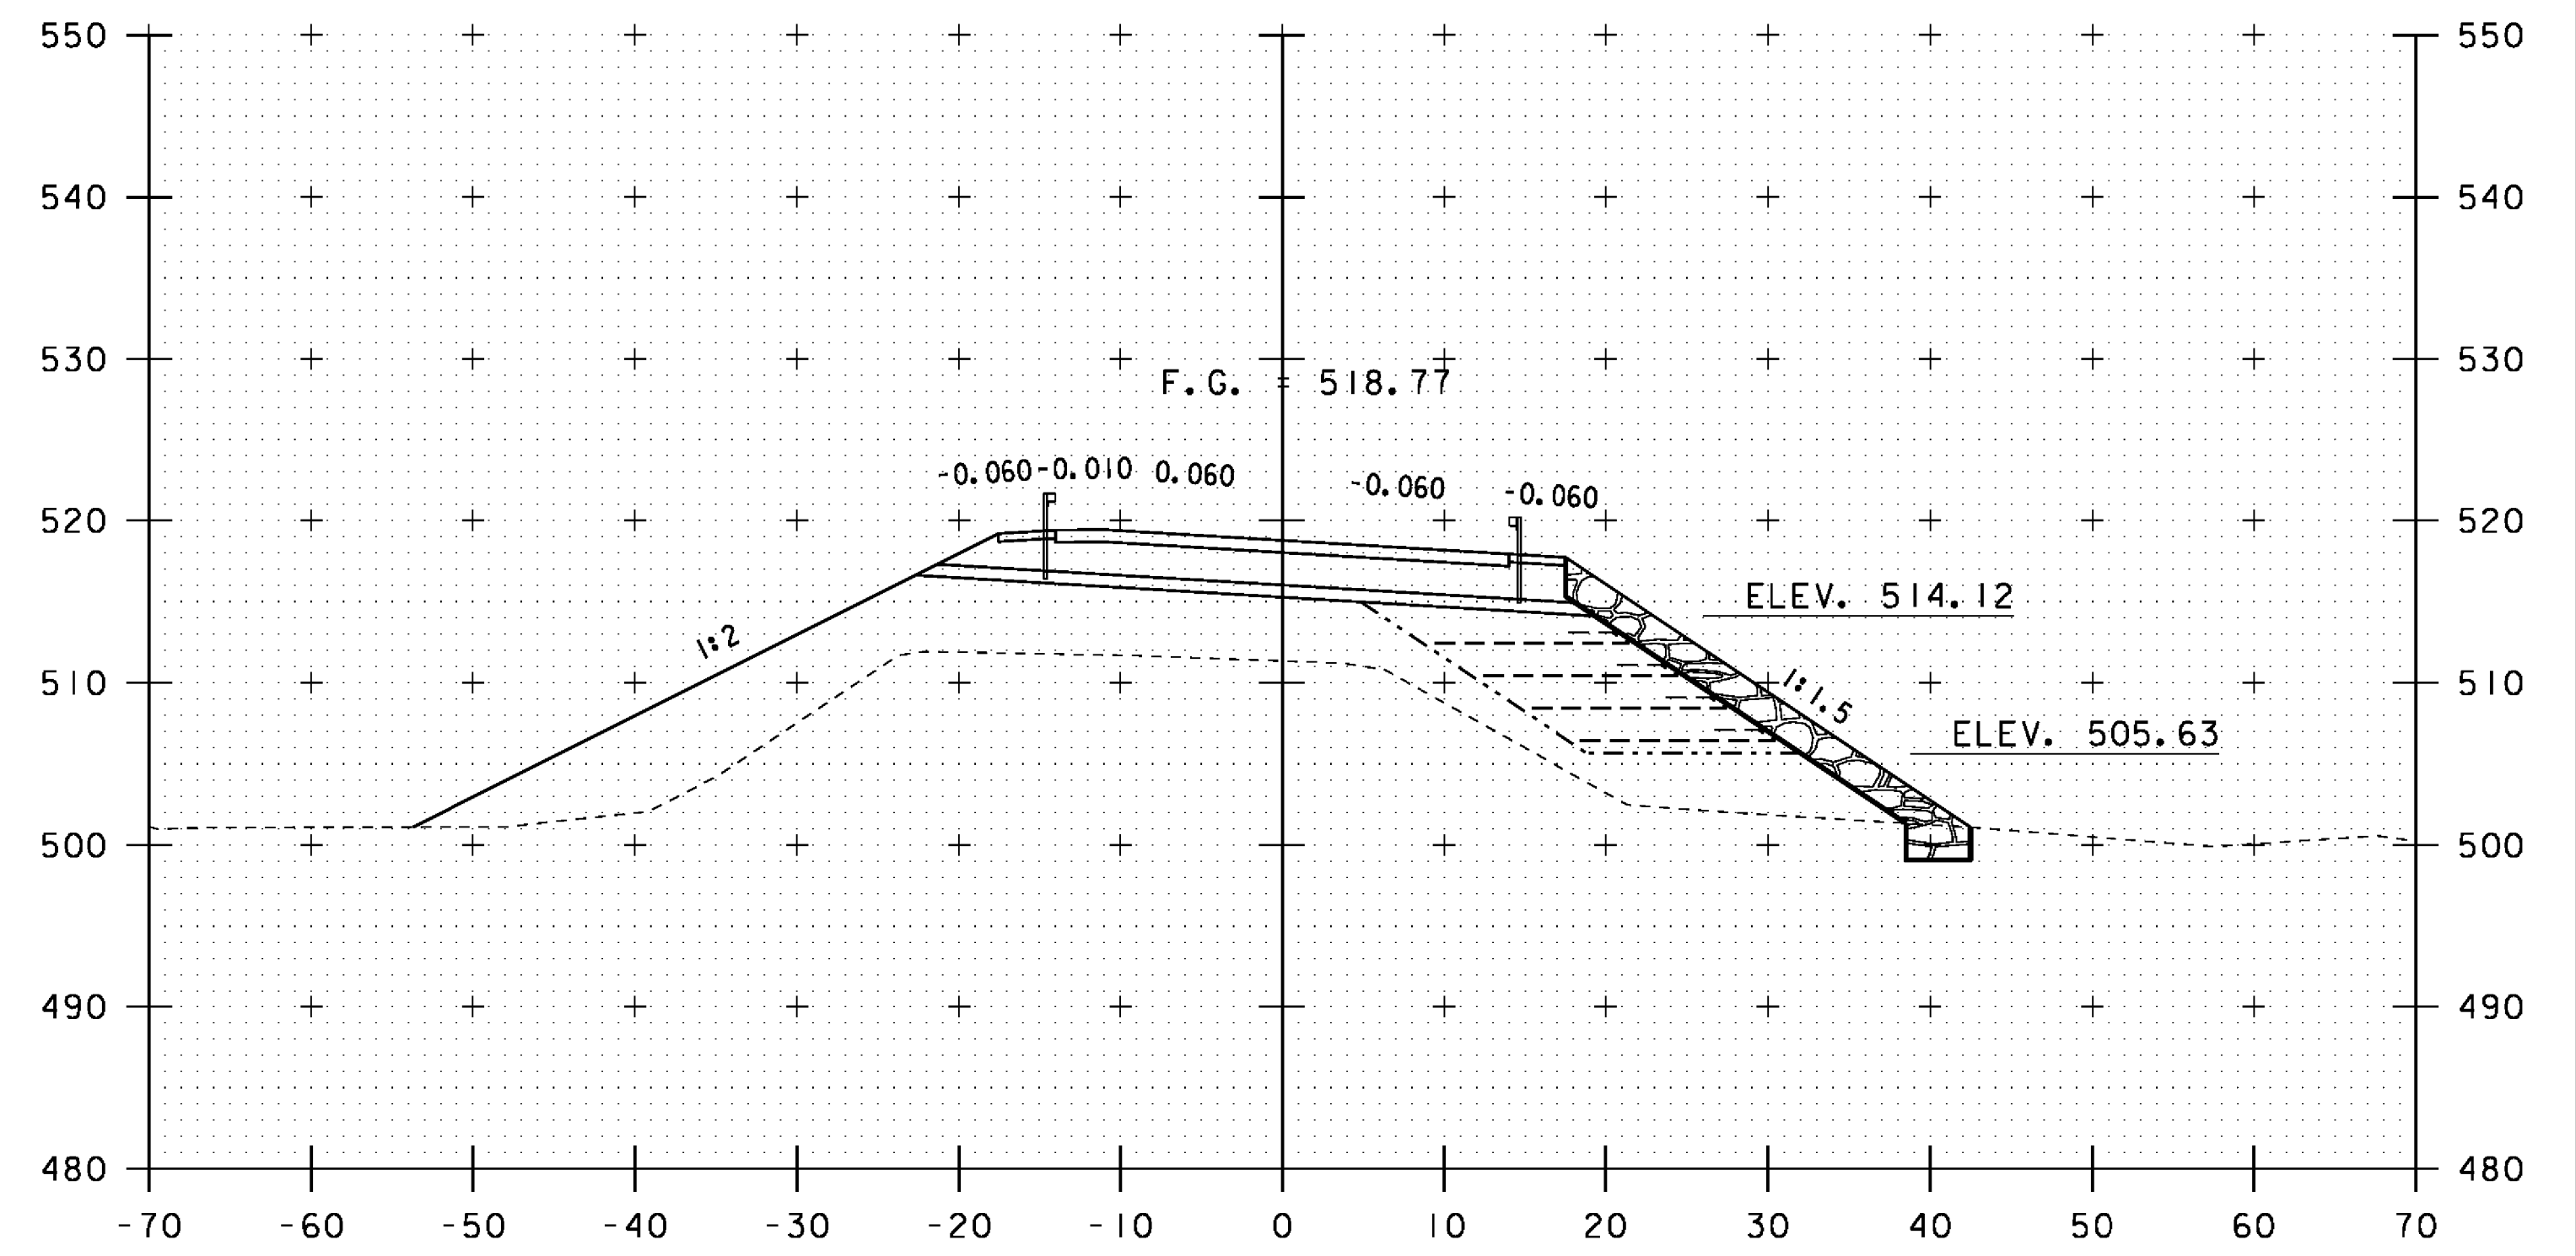

386+50

STA 386+25.0 RT - STA 388+50.0 RT
CONSTRUCT REINFORCED SLOPE W/ STONE
FILL, TYPE 11

10 0 10
SCALE: 1" = 10' - 0"

STA. 385+50 TO STA. 387+00

PROJECT NAME: ROYALTON
PROJECT NUMBER: BRS 0147 (13)

FILE NAME: \BR 27\86e055\sl.27.dgn
PROJECT LEADER: C. CARLSON
DESIGNED BY: G. ROY
BRIDGE 27 VT 14 CROSS SECTIONS (3)

PLOT DATE: 08-OCT-2013
DRAWN BY: G. ROY
CHECKED BY: D. PETERSON
SHEET 53 OF 186