




393+50

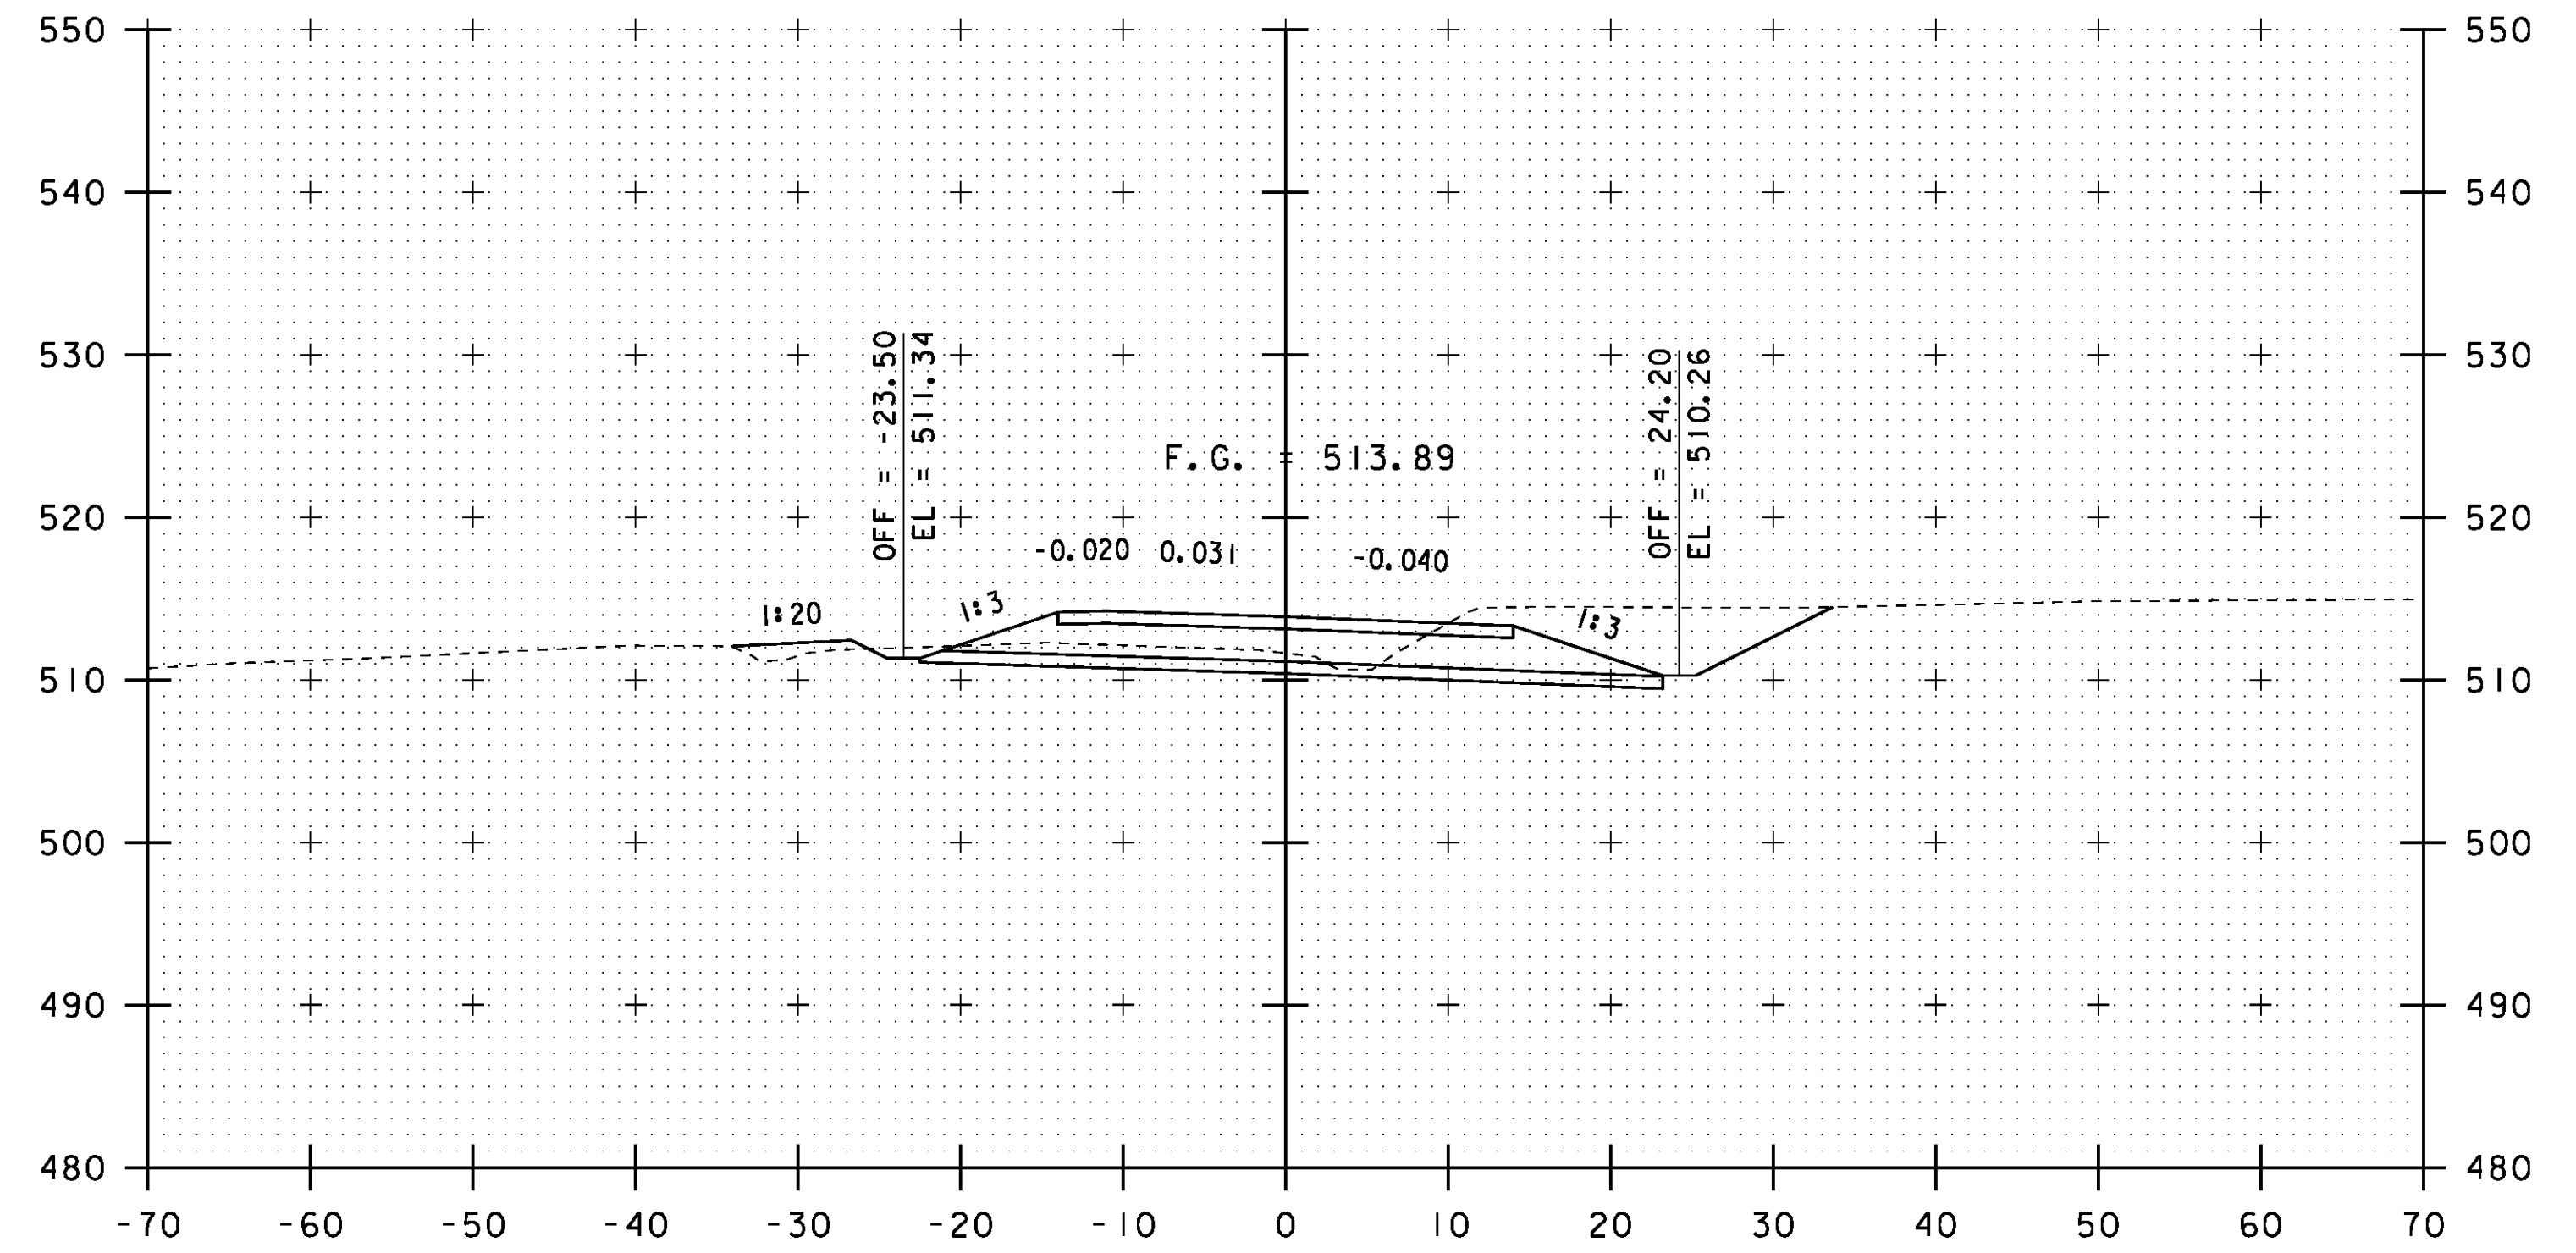

394+00

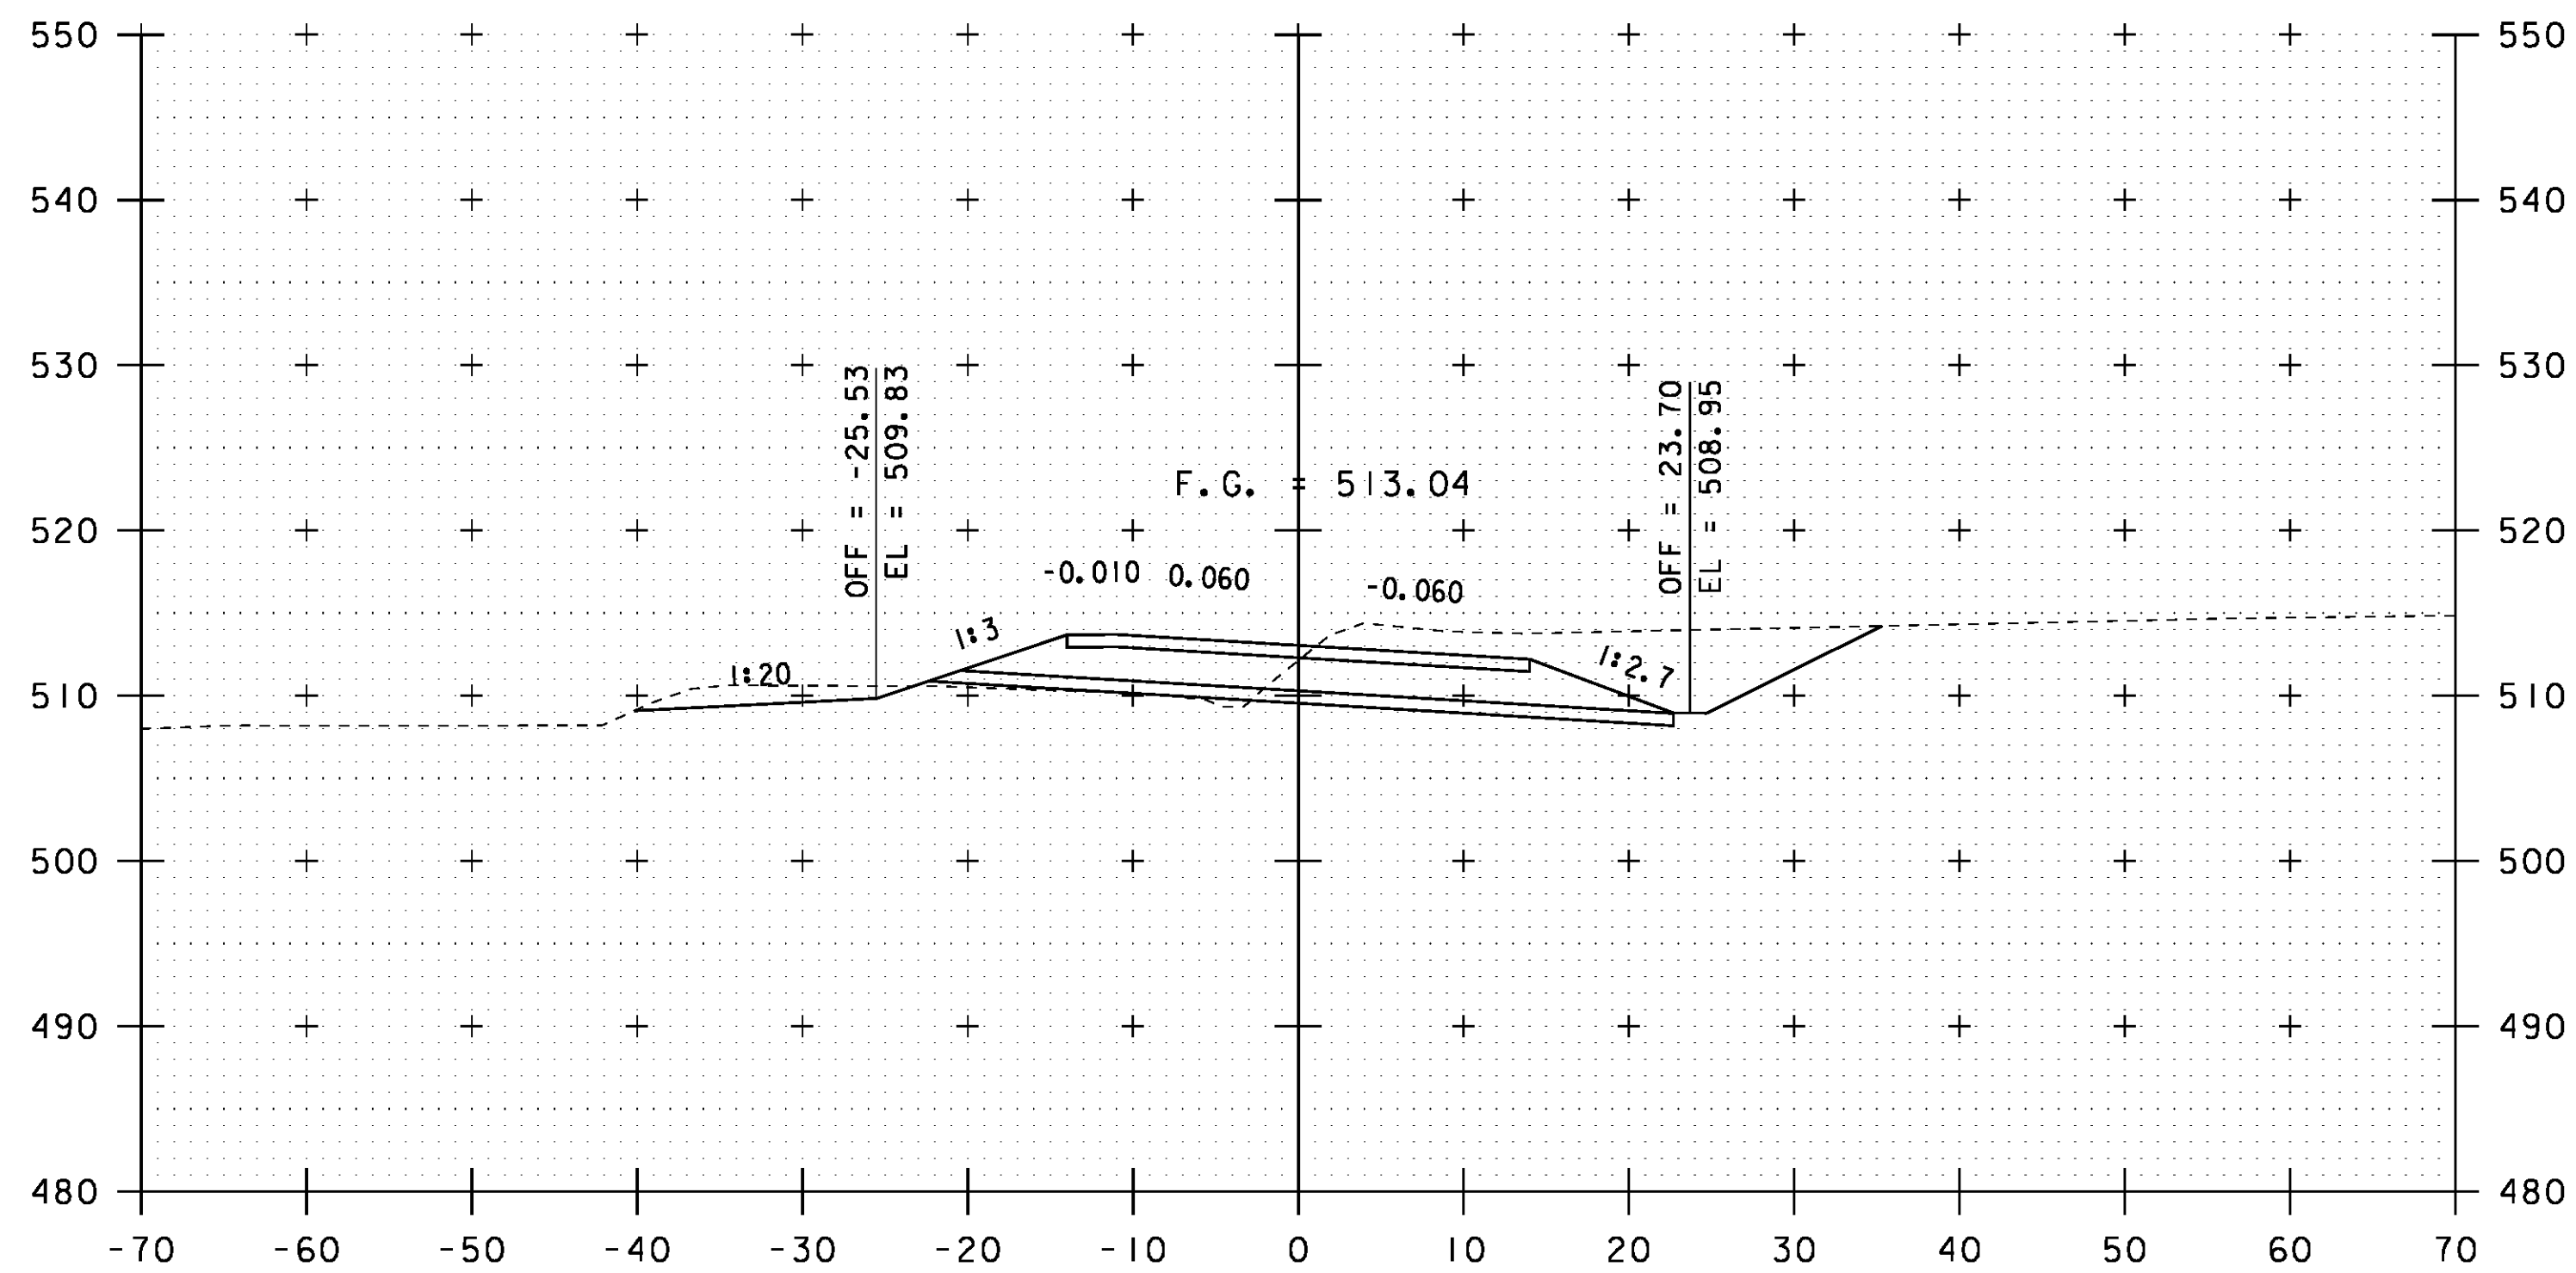

393+25

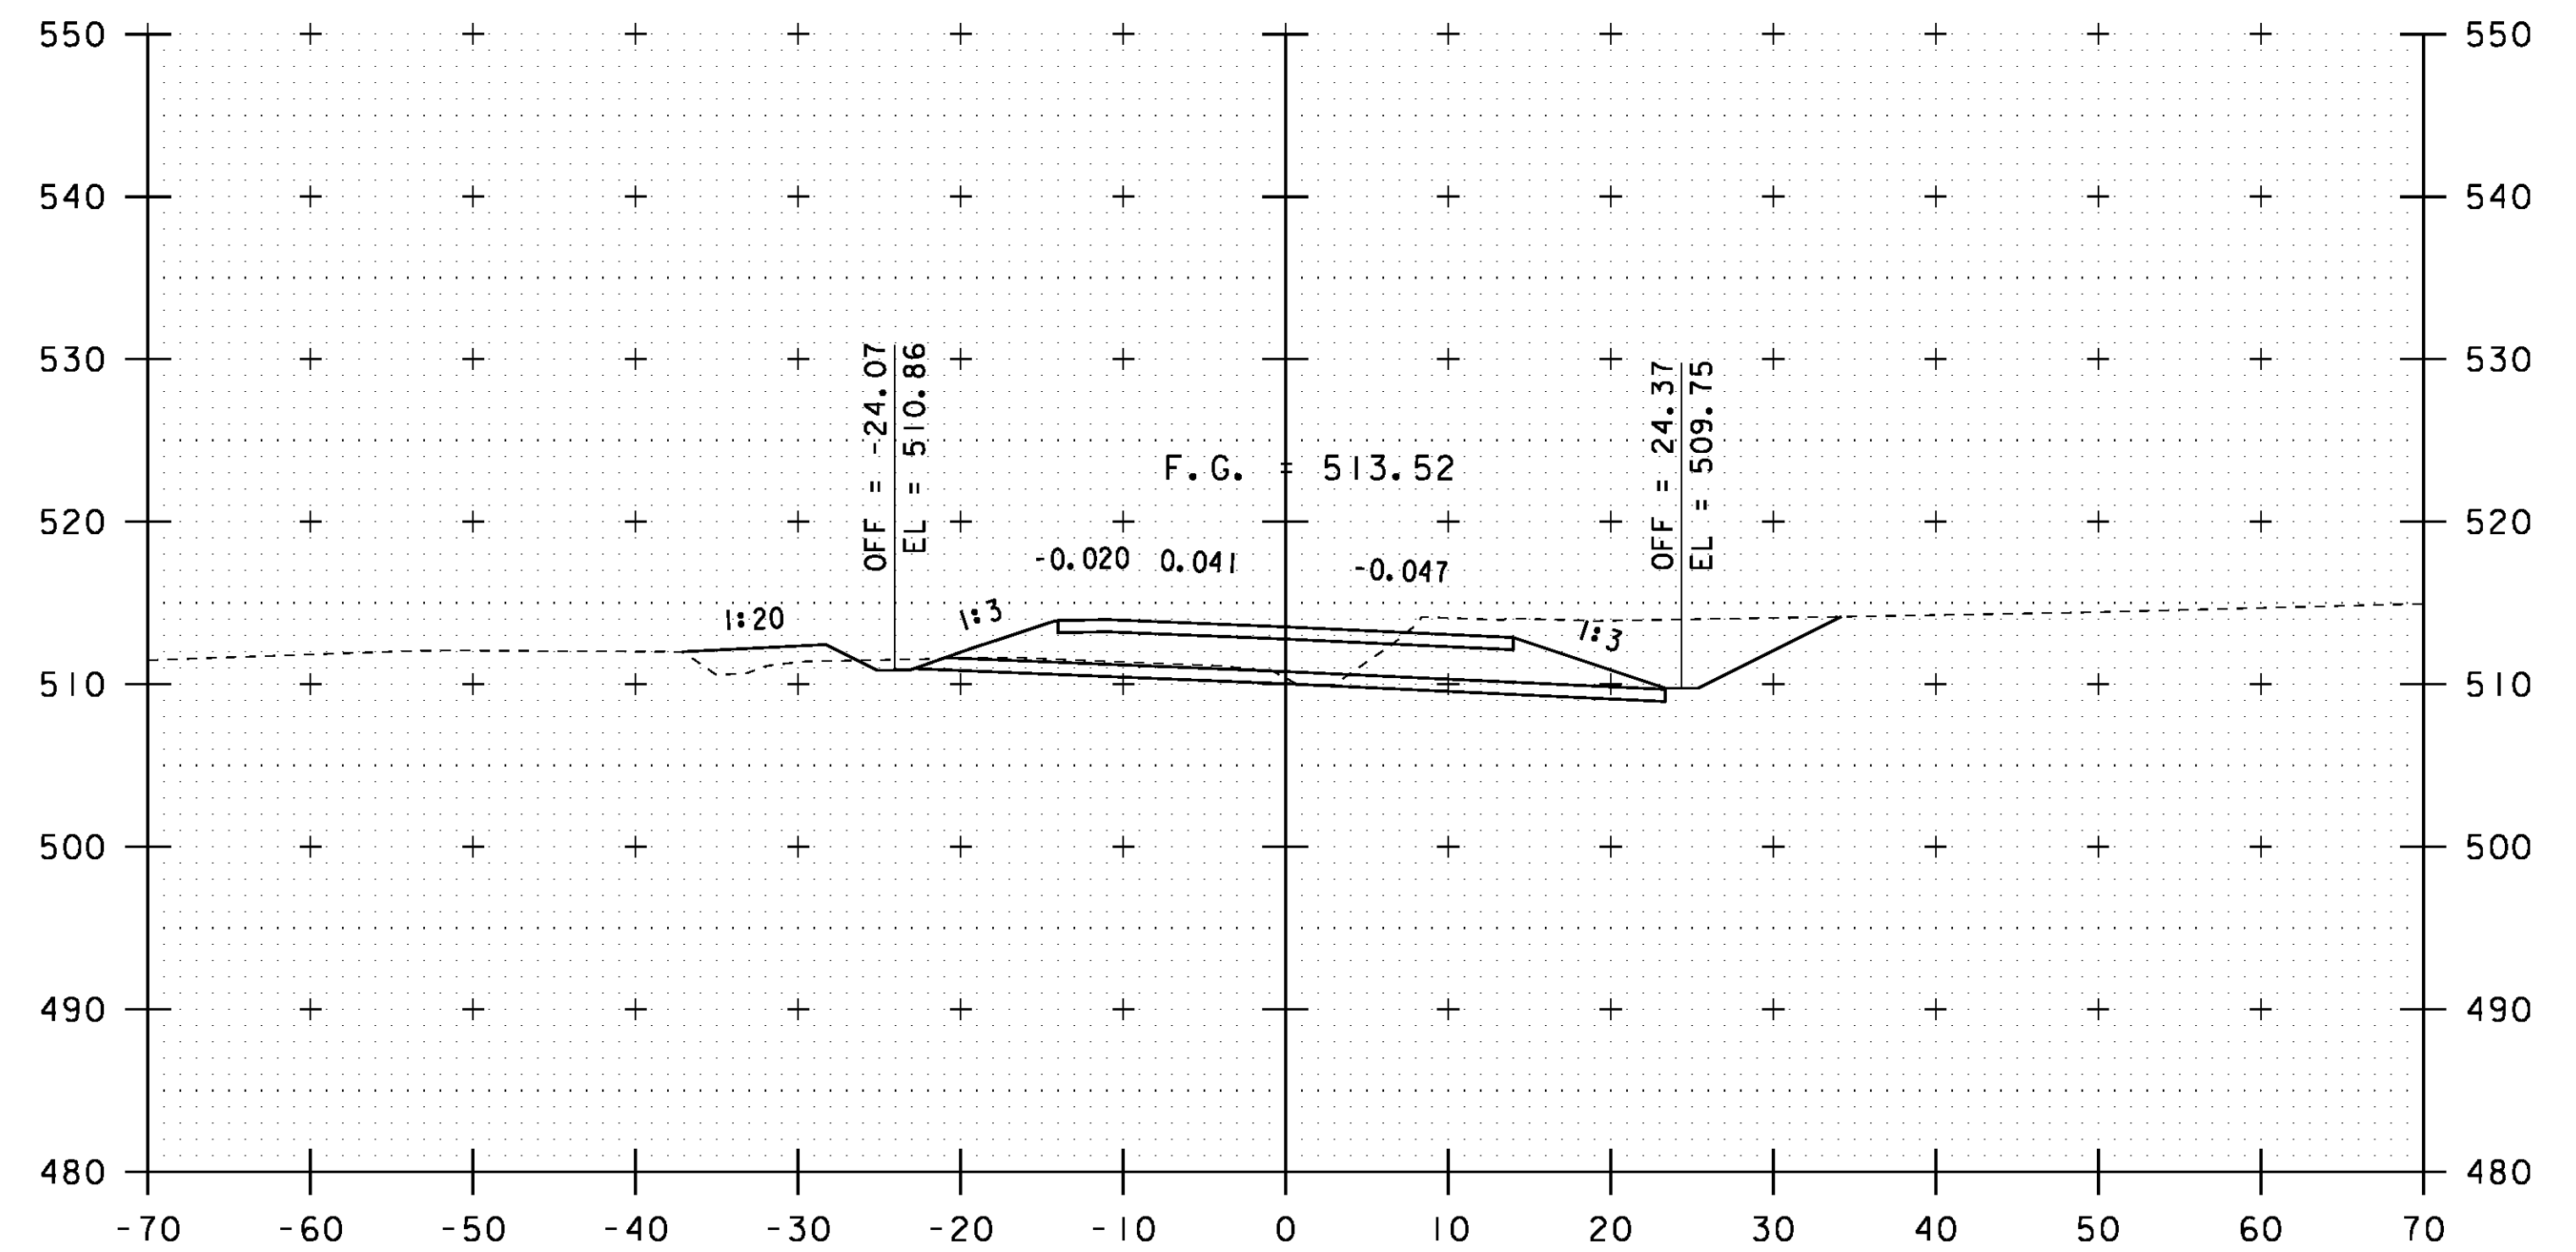

393+75

STA 393+75.0 LT - STA 395+75.0 LT
CONSTRUCT NEW GRASS-LINED DITCH



SCALE: 1" = 10' - 0"

STA. 393+25 TO STA. 394+00

| | |
|------------------------------------|------------------------------------|
| PROJECT NAME: ROYALTON | PLOT DATE: 08-OCT-2013 |
| PROJECT NUMBER: BRS 0147 (13) | DRAWN BY: G. ROY |
| FILE NAME: \BR 27\86e055xsl.27.dgn | CHECKED BY: D. PETERSON |
| PROJECT LEADER: C. CARLSON | SHEET 59 OF 186 |
| DESIGNED BY: G. ROY | BRIDGE 27 VT 14 CROSS SECTIONS (9) |