


396+25

STA 396+25.00
END APPROACH
MATCH EXISTING



396+00

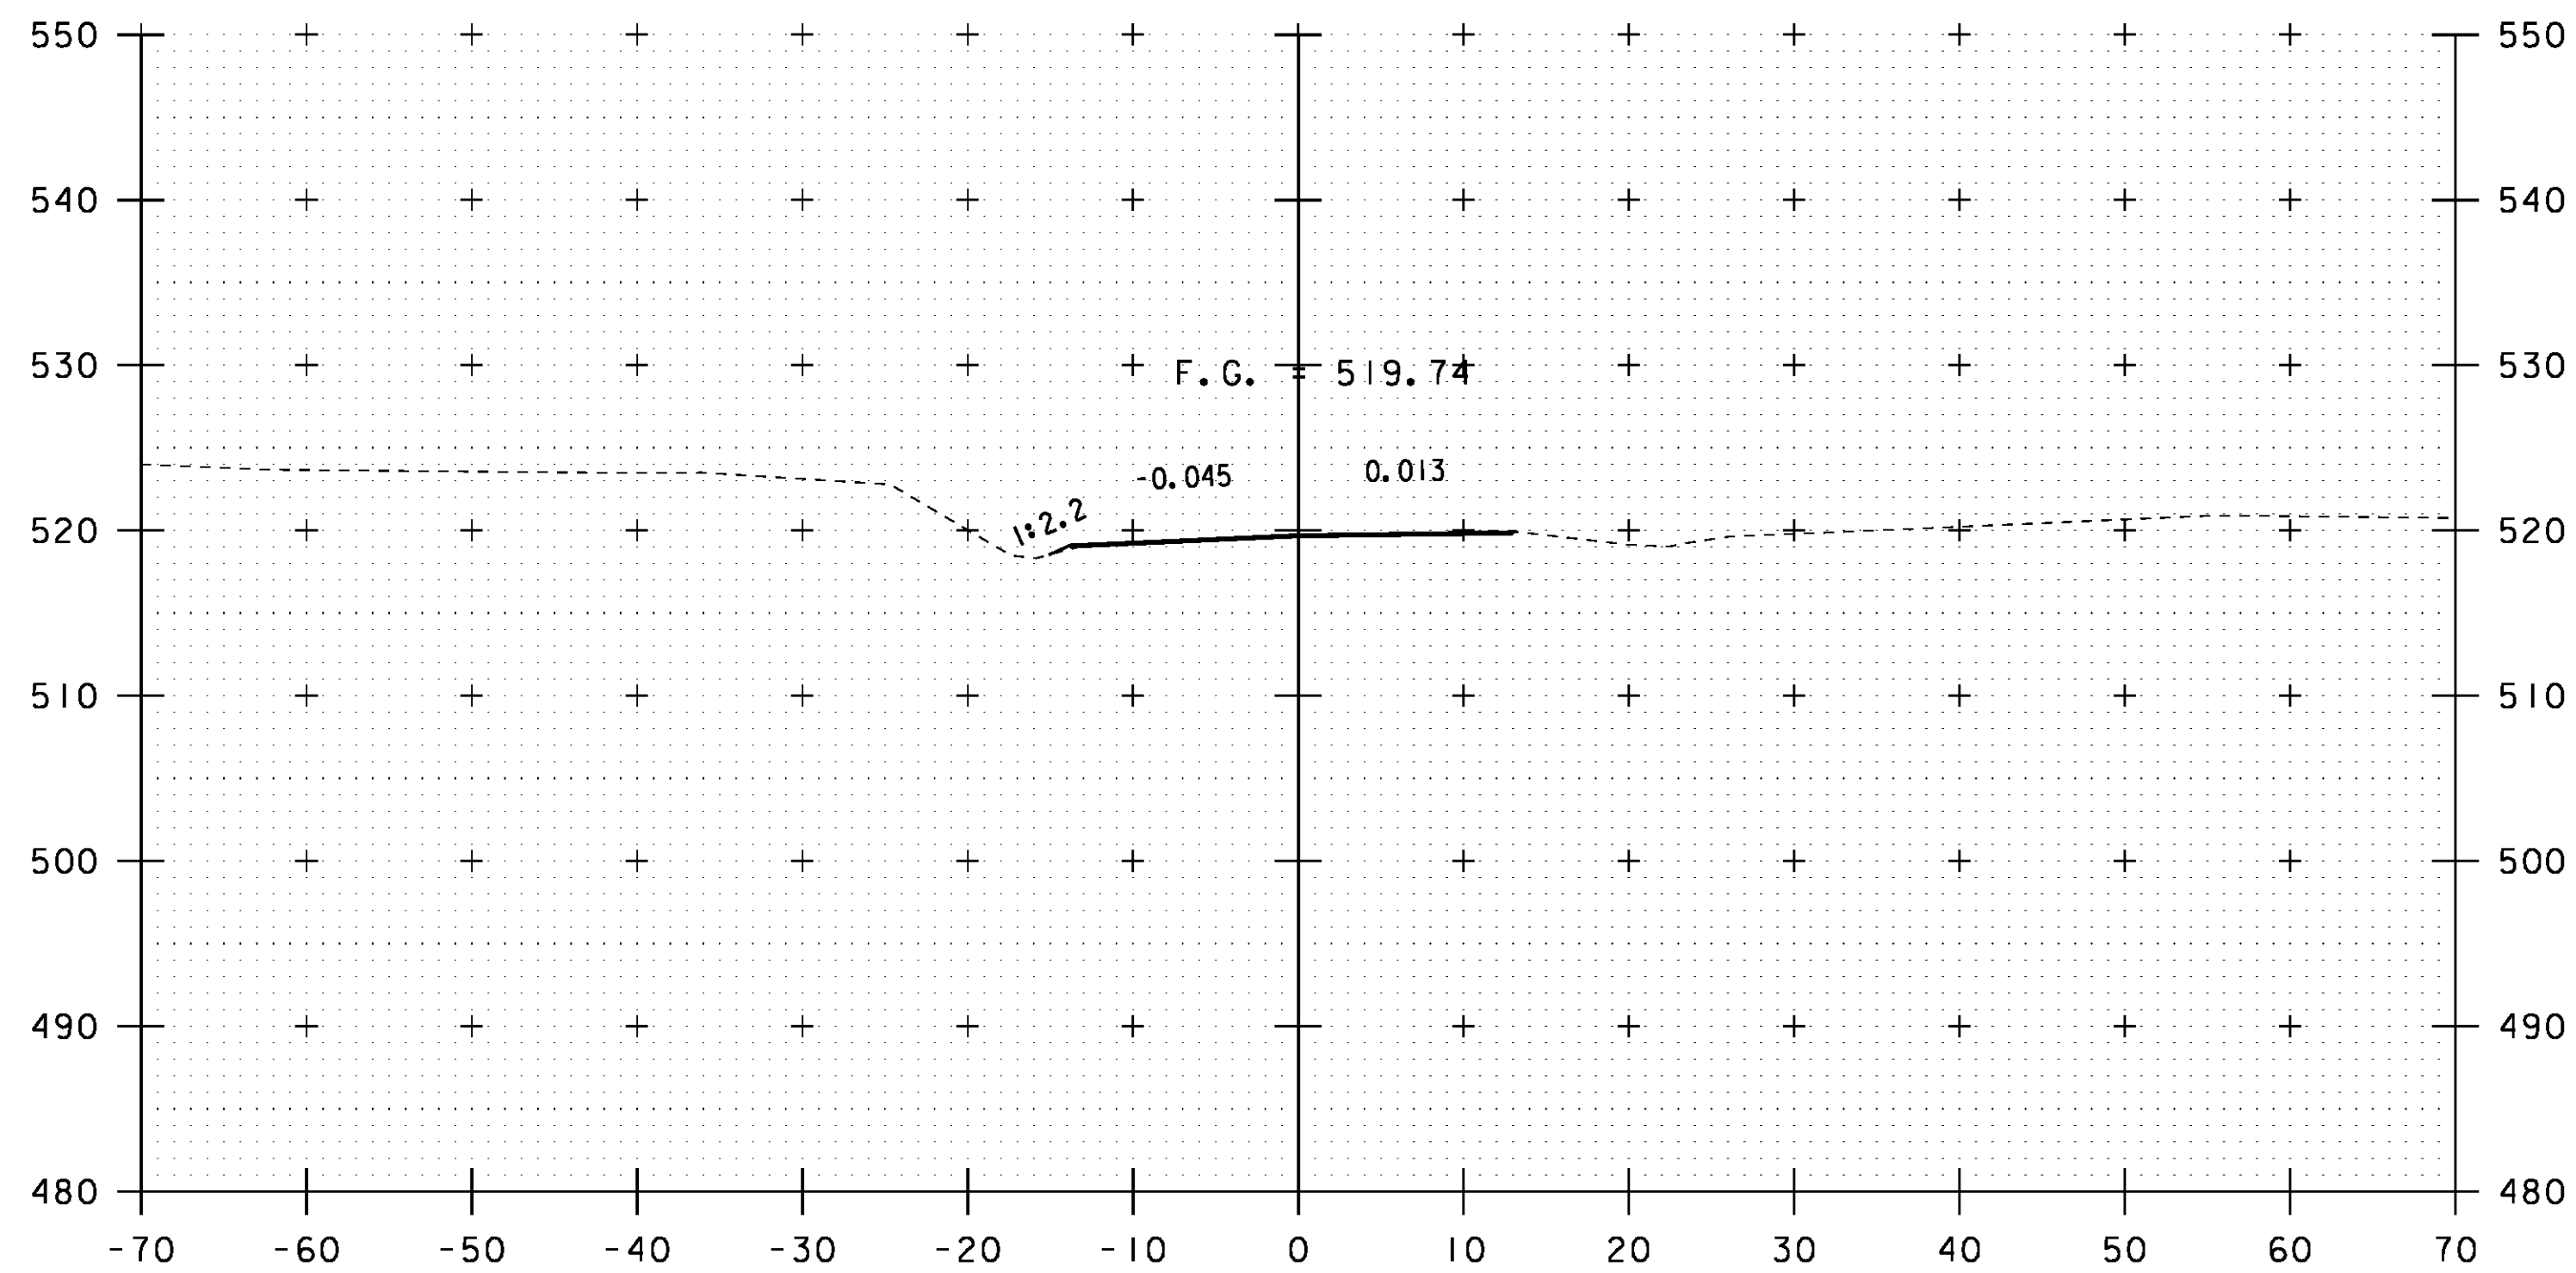

STA. 396+00 TO STA. 396+25

PROJECT NAME: ROYALTON	PLLOT DATE: 08-OCT-2013
PROJECT NUMBER: BRS 0147 (13)	DRAWN BY: G. ROY
FILE NAME: \BR 27\s86e055xsl.27.dgn	CHECKED BY: D. PETERSON
PROJECT LEADER: C. CARLSON	SHEET 61 OF 186
DESIGNED BY: G. ROY	
BRIDGE 27 VT 14 CROSS SECTIONS (11)	