



49+30

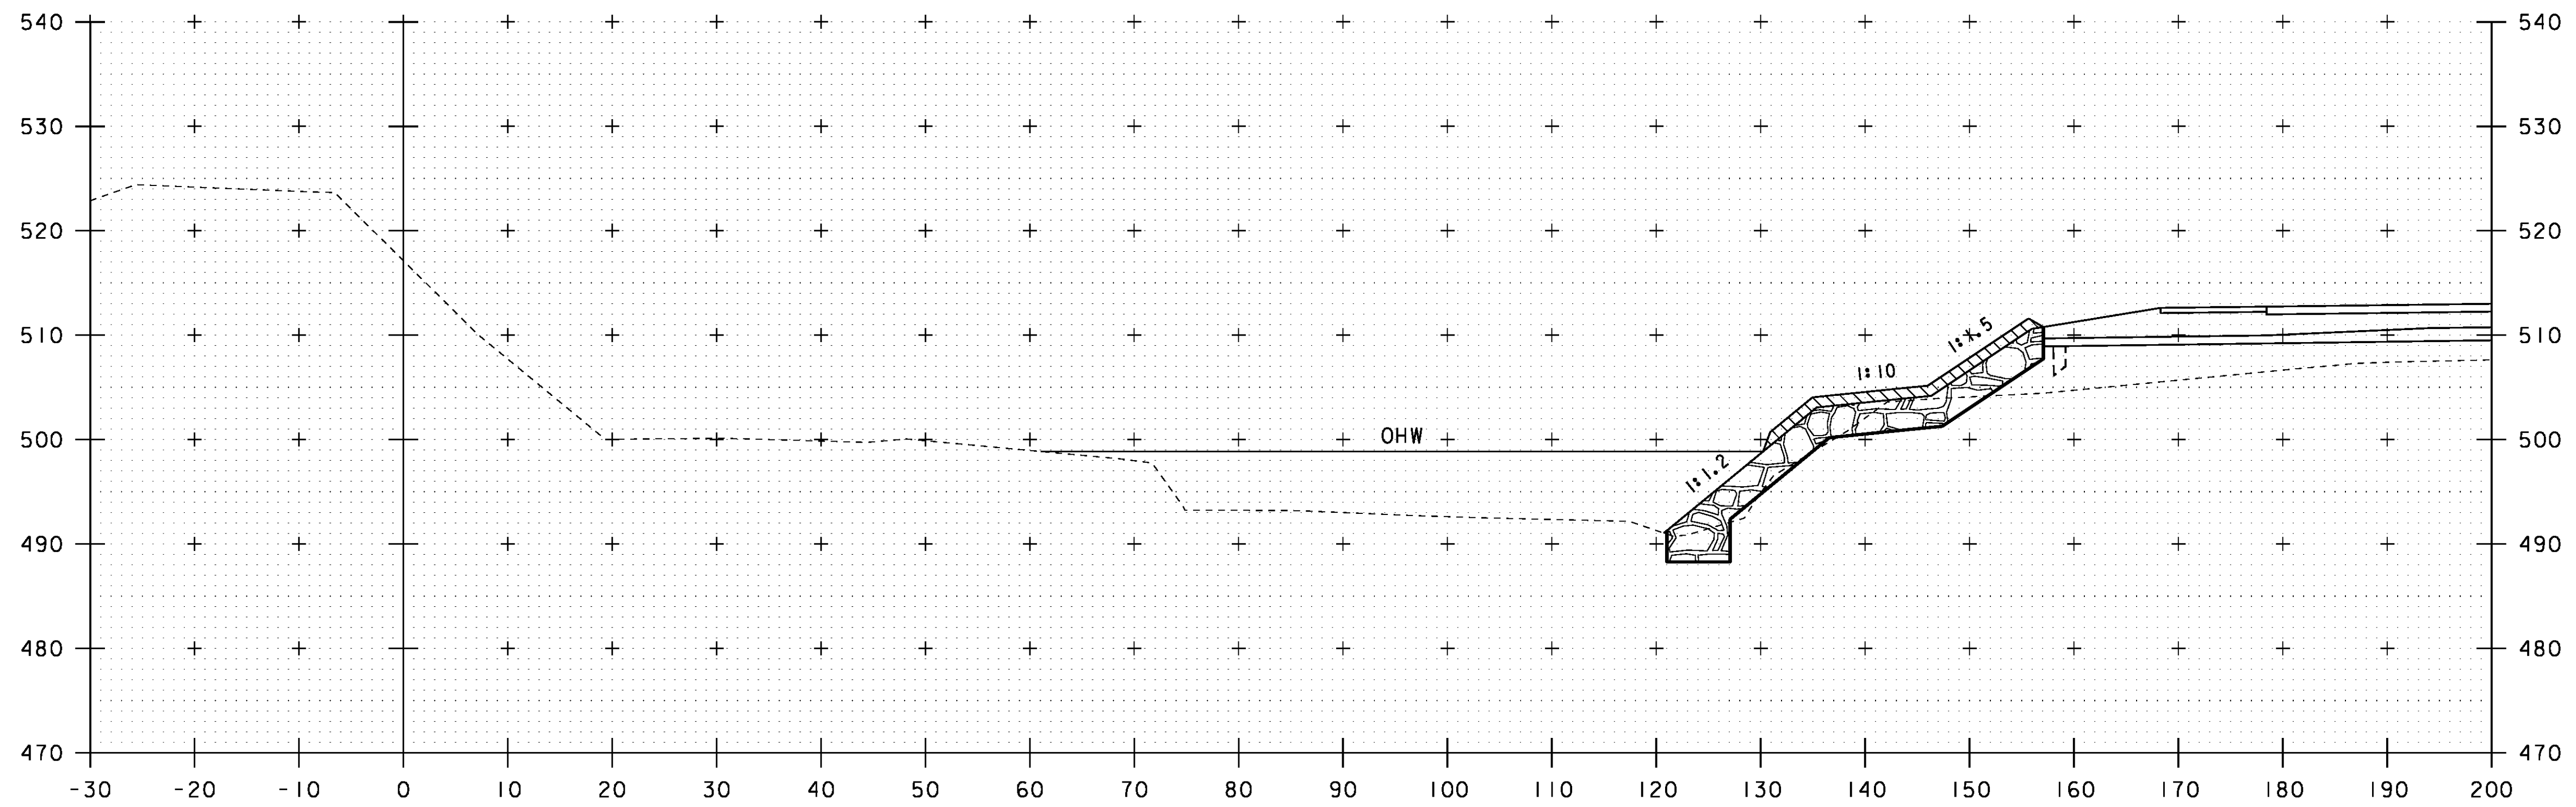

49+20

CHANNEL STA 49+19.6 FAR RT
 BEGIN STRUCTURE EXCAVATION
 GRANULAR BACKFILL FOR STRUCTURES

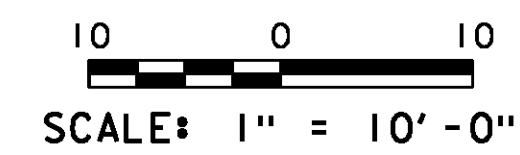

STA. 49+20 TO STA. 49+30

PROJECT NAME:	ROYALTON	FILE NAME:	\BR 27\s86e055xsl.27.dgn	PROJECT LEADER:	C. CARLSON	DESIGNED BY:	G. ROY	BRIDGE 27 CHANNEL LINE CROSS SECTIONS (2) SHEET	65 OF 186
PROJECT NUMBER:	BRS 0147 (13)	PLLOT DATE:	08-OCT-2013	DRAWN BY:	G. ROY	CHECKED BY:	D. PETERSON		