



49+90

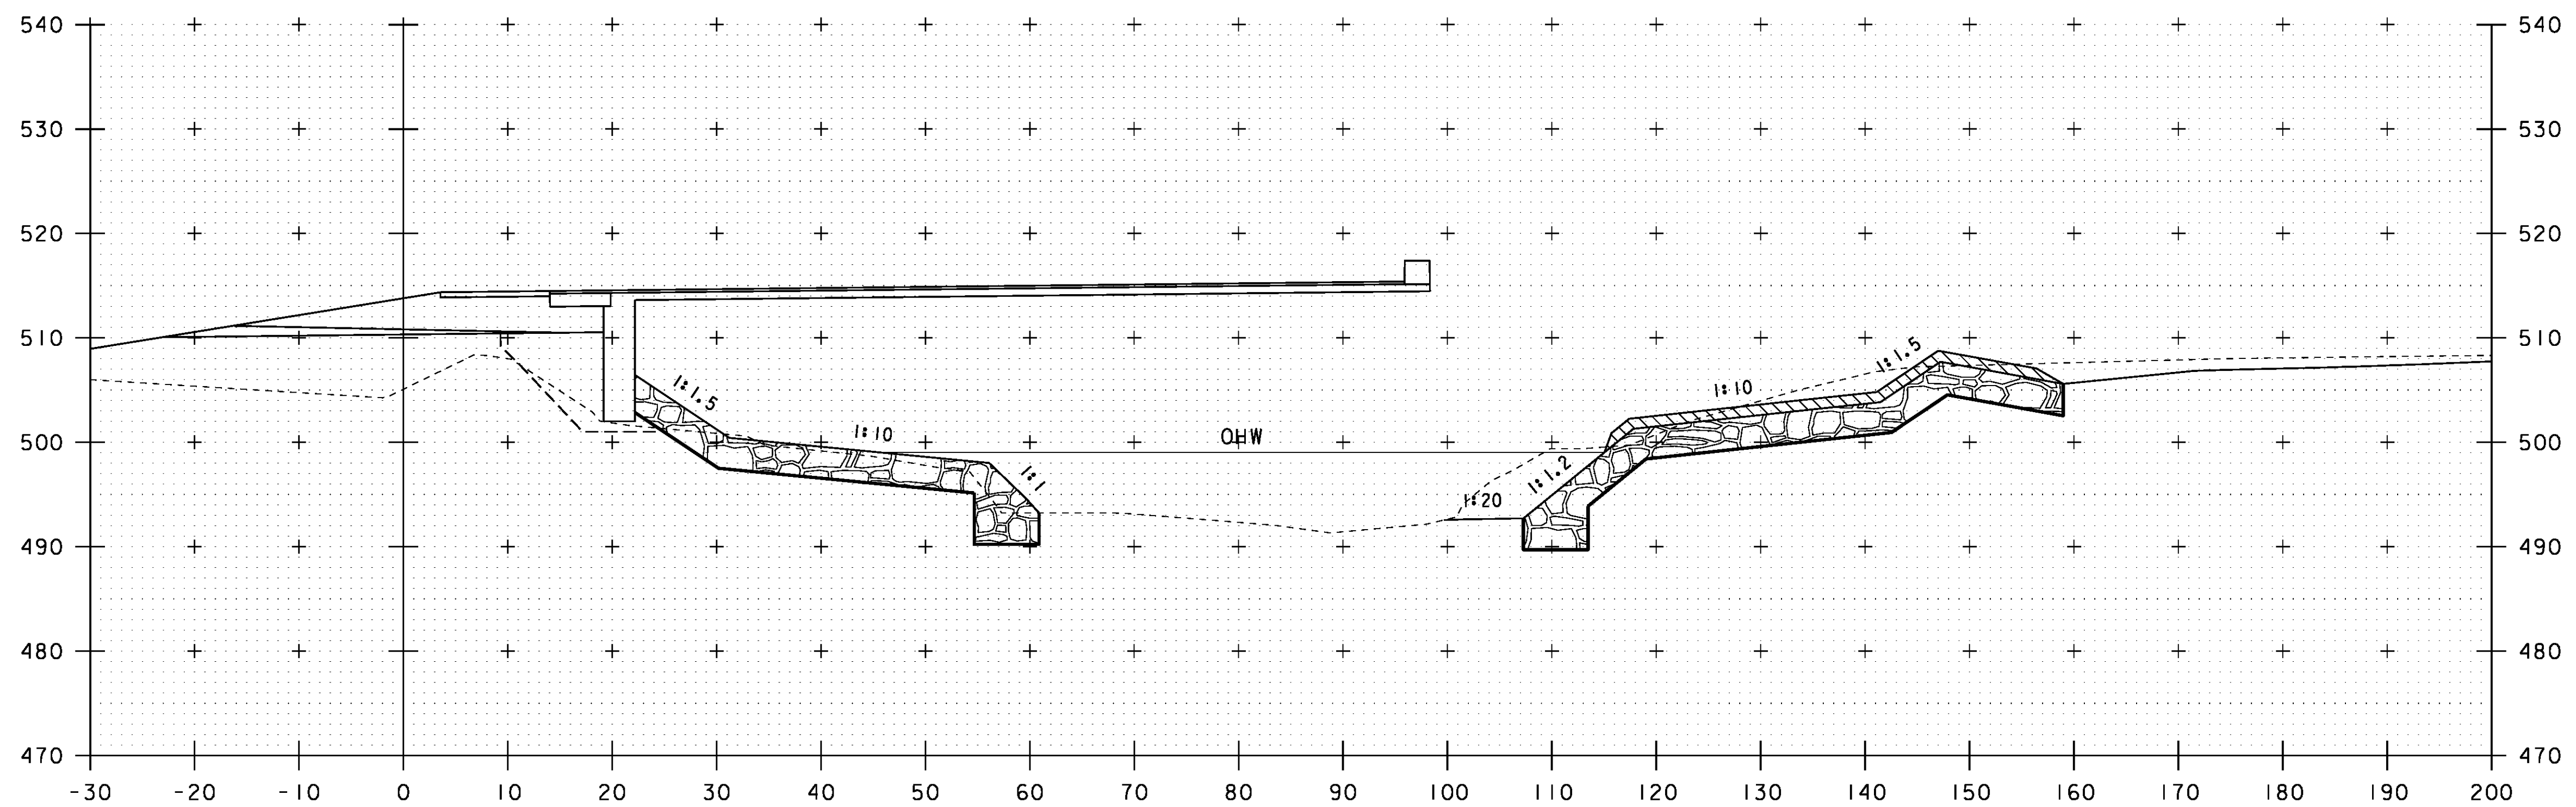

49+80

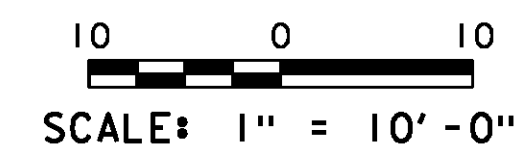

STA. 49+80 TO STA. 49+90

PROJECT NAME:	ROYALTON
PROJECT NUMBER:	BRS 0147 (13)
FILE NAME:	\BR 27\s86e055xsl.27.dgn
PROJECT LEADER:	C. CARLSON
DESIGNED BY:	G. ROY
BRIDGE 27 CHANNEL LINE CROSS SECTIONS (5) SHEET	68 OF 186
PLOT DATE:	08-OCT-2013
DRAWN BY:	G. ROY
CHECKED BY:	D. PETERSON