



50+10

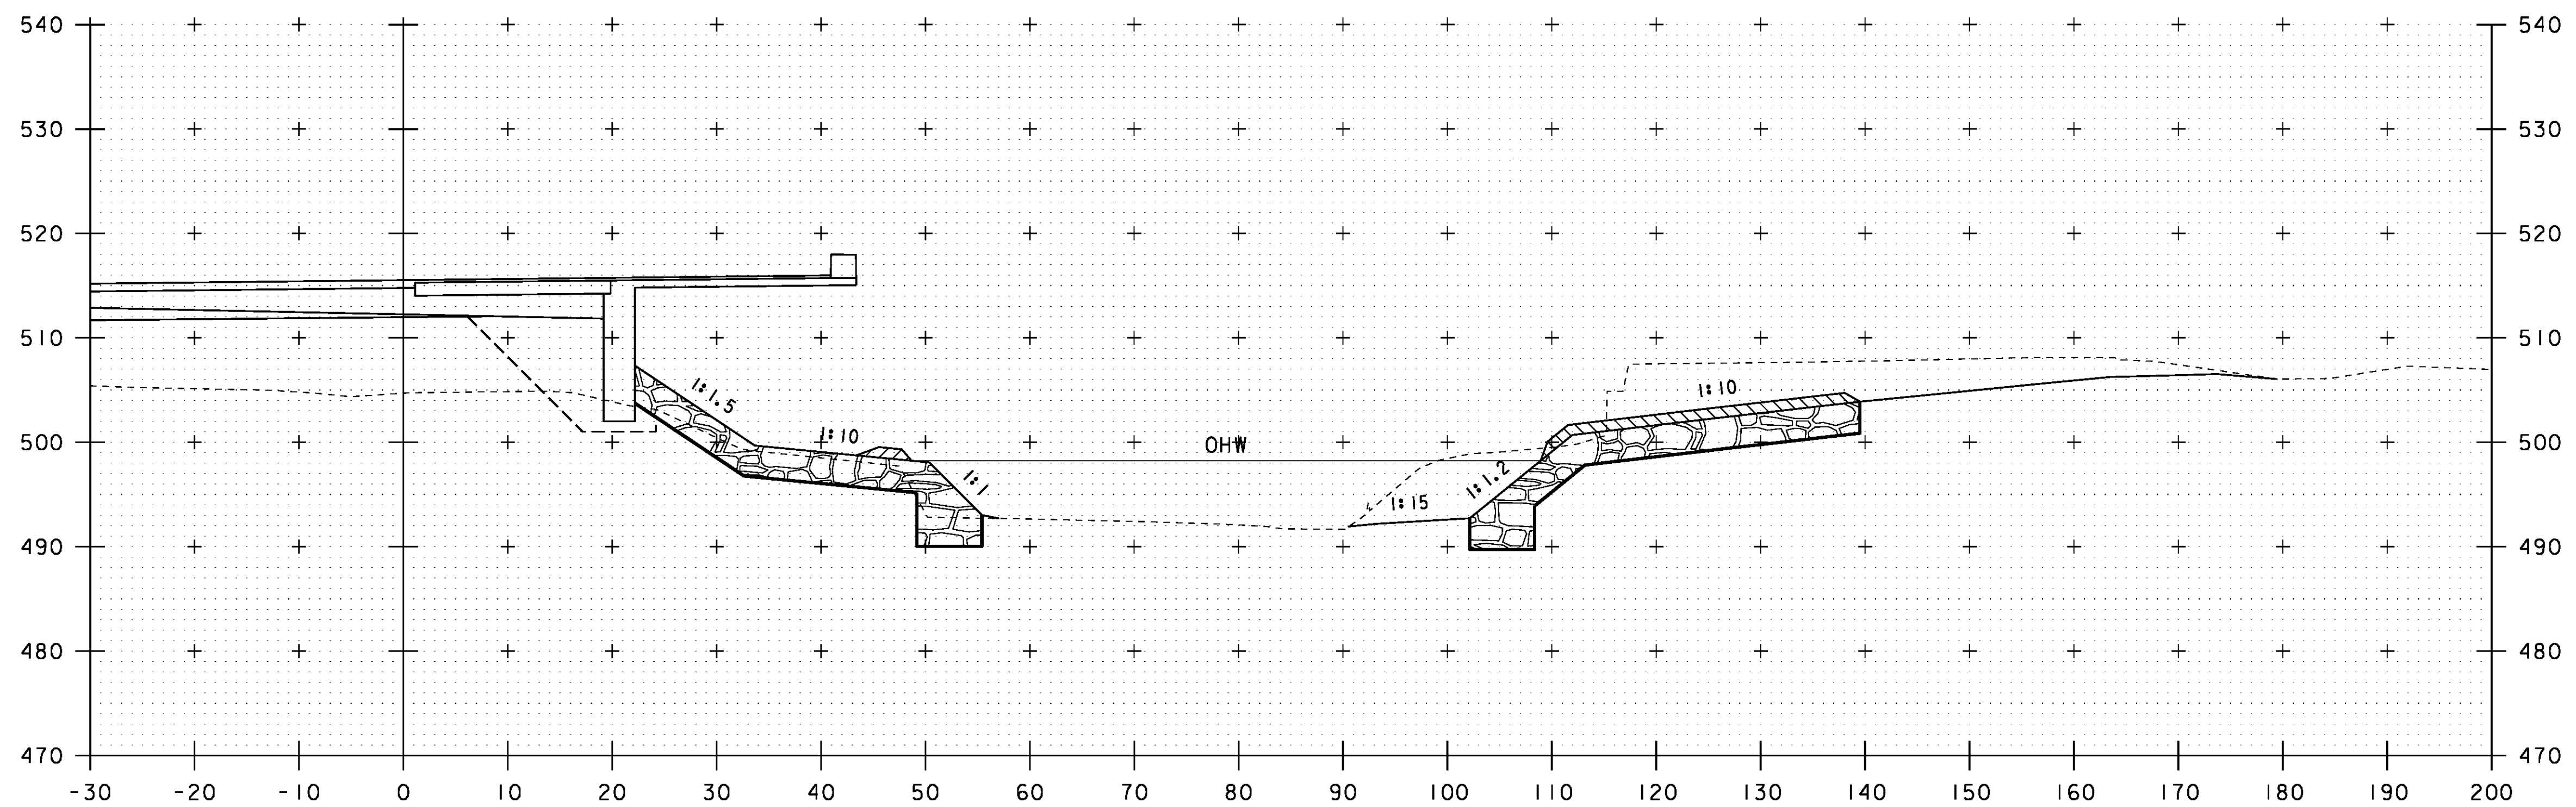

50+00

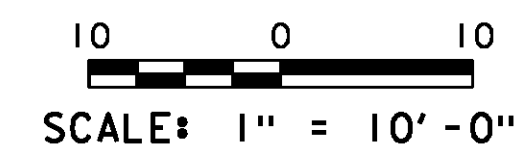

STA. 50+00 TO STA. 50+10

PROJECT NAME:	ROYALTON
PROJECT NUMBER:	BRS 0147 (13)
FILE NAME:	\BR 27\s86e055xsl.27.dgn
PROJECT LEADER:	C. CARLSON
DESIGNED BY:	G. ROY
BRIDGE 27 CHANNEL LINE CROSS SECTIONS (6) SHEET	69 OF 186
PLOT DATE:	08-OCT-2013
DRAWN BY:	G. ROY
CHECKED BY:	D. PETERSON