


CHANNEL STA 50+64.1 RT
 END UNCLASSIFIED CHANNEL EXCAVATION
 GEOTEXTILE UNDER STONE FILL
 STONE FILL, TYPE III
 GRUBBING MATERIAL

50+75

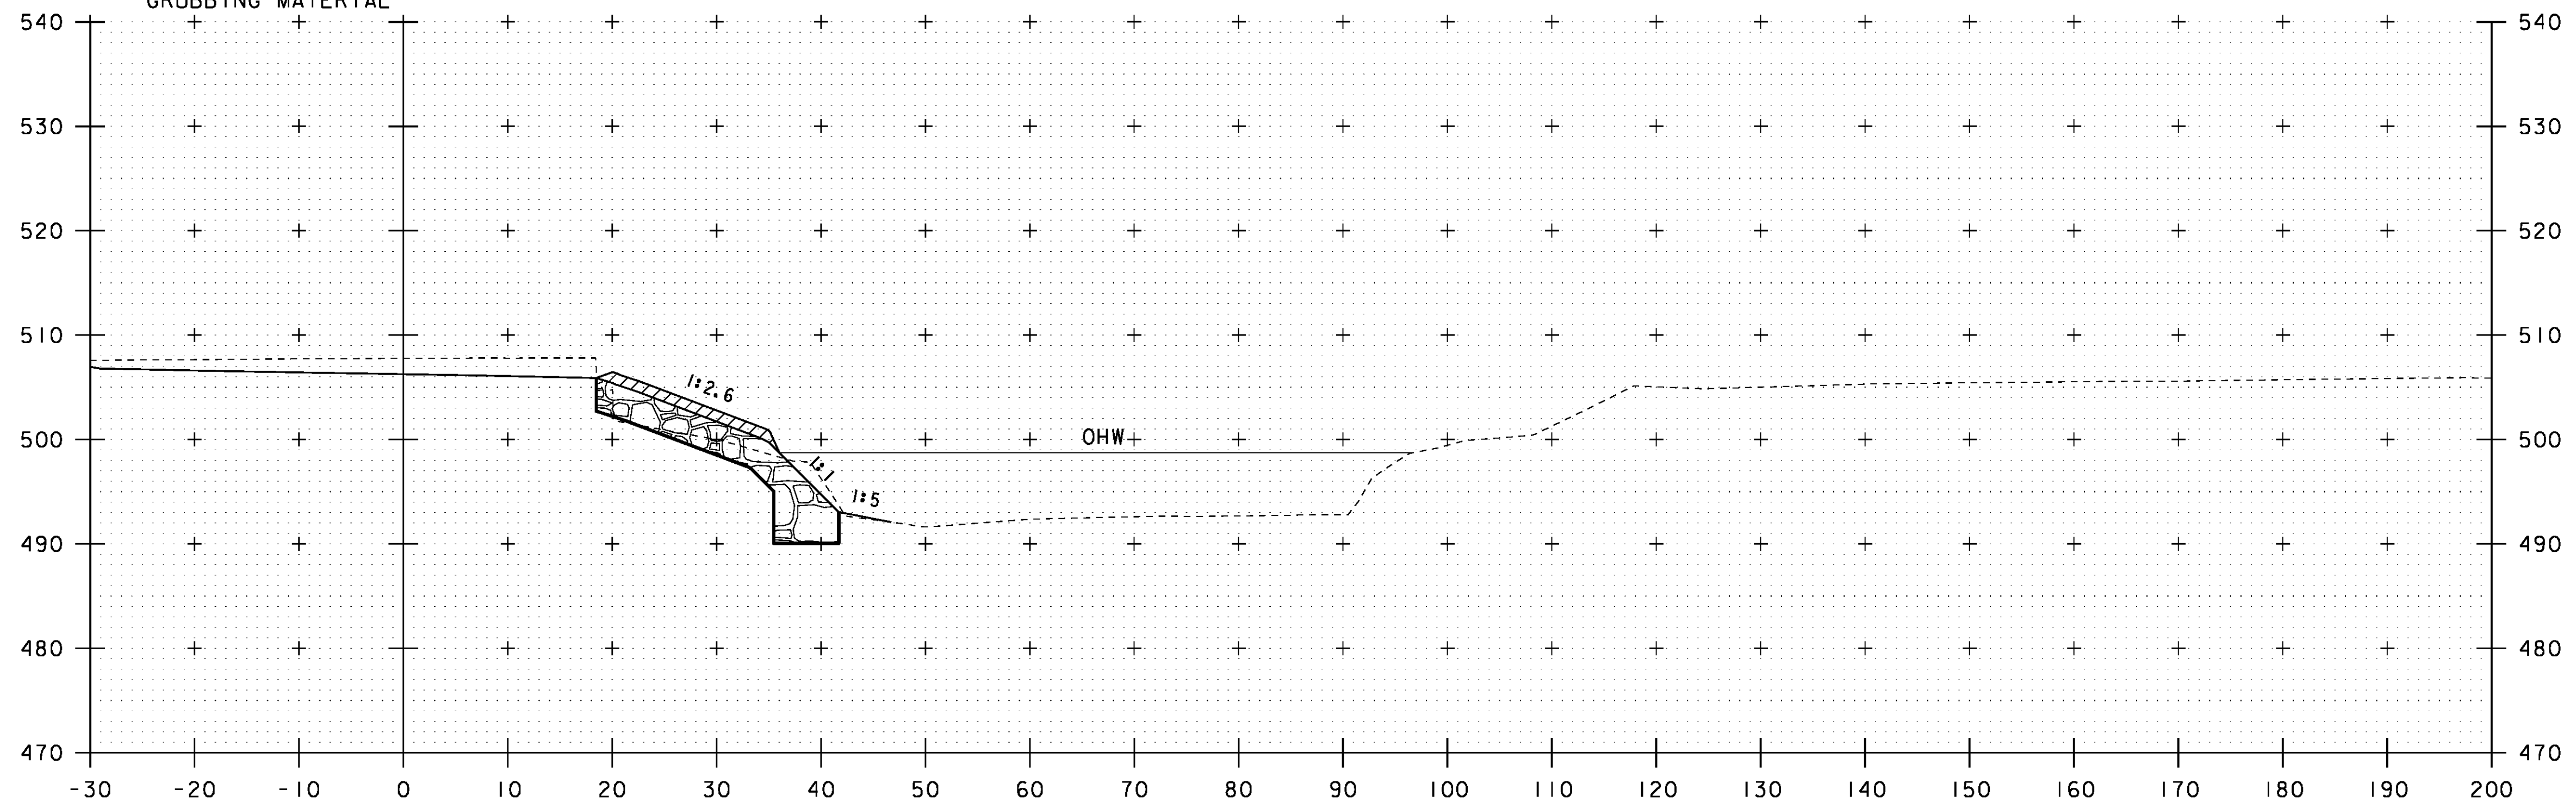

CHANNEL STA 50+40.6 FAR RT
 END UNCLASSIFIED CHANNEL EXCAVATION
 GEOTEXTILE UNDER STONE FILL
 STONE FILL, TYPE III
 GRUBBING MATERIAL

50+50



STA. 50+50 TO STA. 50+75

| | |
|---|--------------------------|
| PROJECT NAME: | ROYALTON |
| PROJECT NUMBER: | BRS 0147 (13) |
| FILE NAME: | \BR 27\s86e055xsl.27.dgn |
| PROJECT LEADER: | C. CARLSON |
| DESIGNED BY: | G. ROY |
| PLOT DATE: | 08-OCT-2013 |
| DRAWN BY: | G. ROY |
| CHECKED BY: | D. PETERSON |
| BRIDGE 27 CHANNEL LINE CROSS SECTIONS (8) SHEET 71 OF 186 | |