



399+25


STA 399+25.00
BEGIN APPROACH
MATCH EXISTING

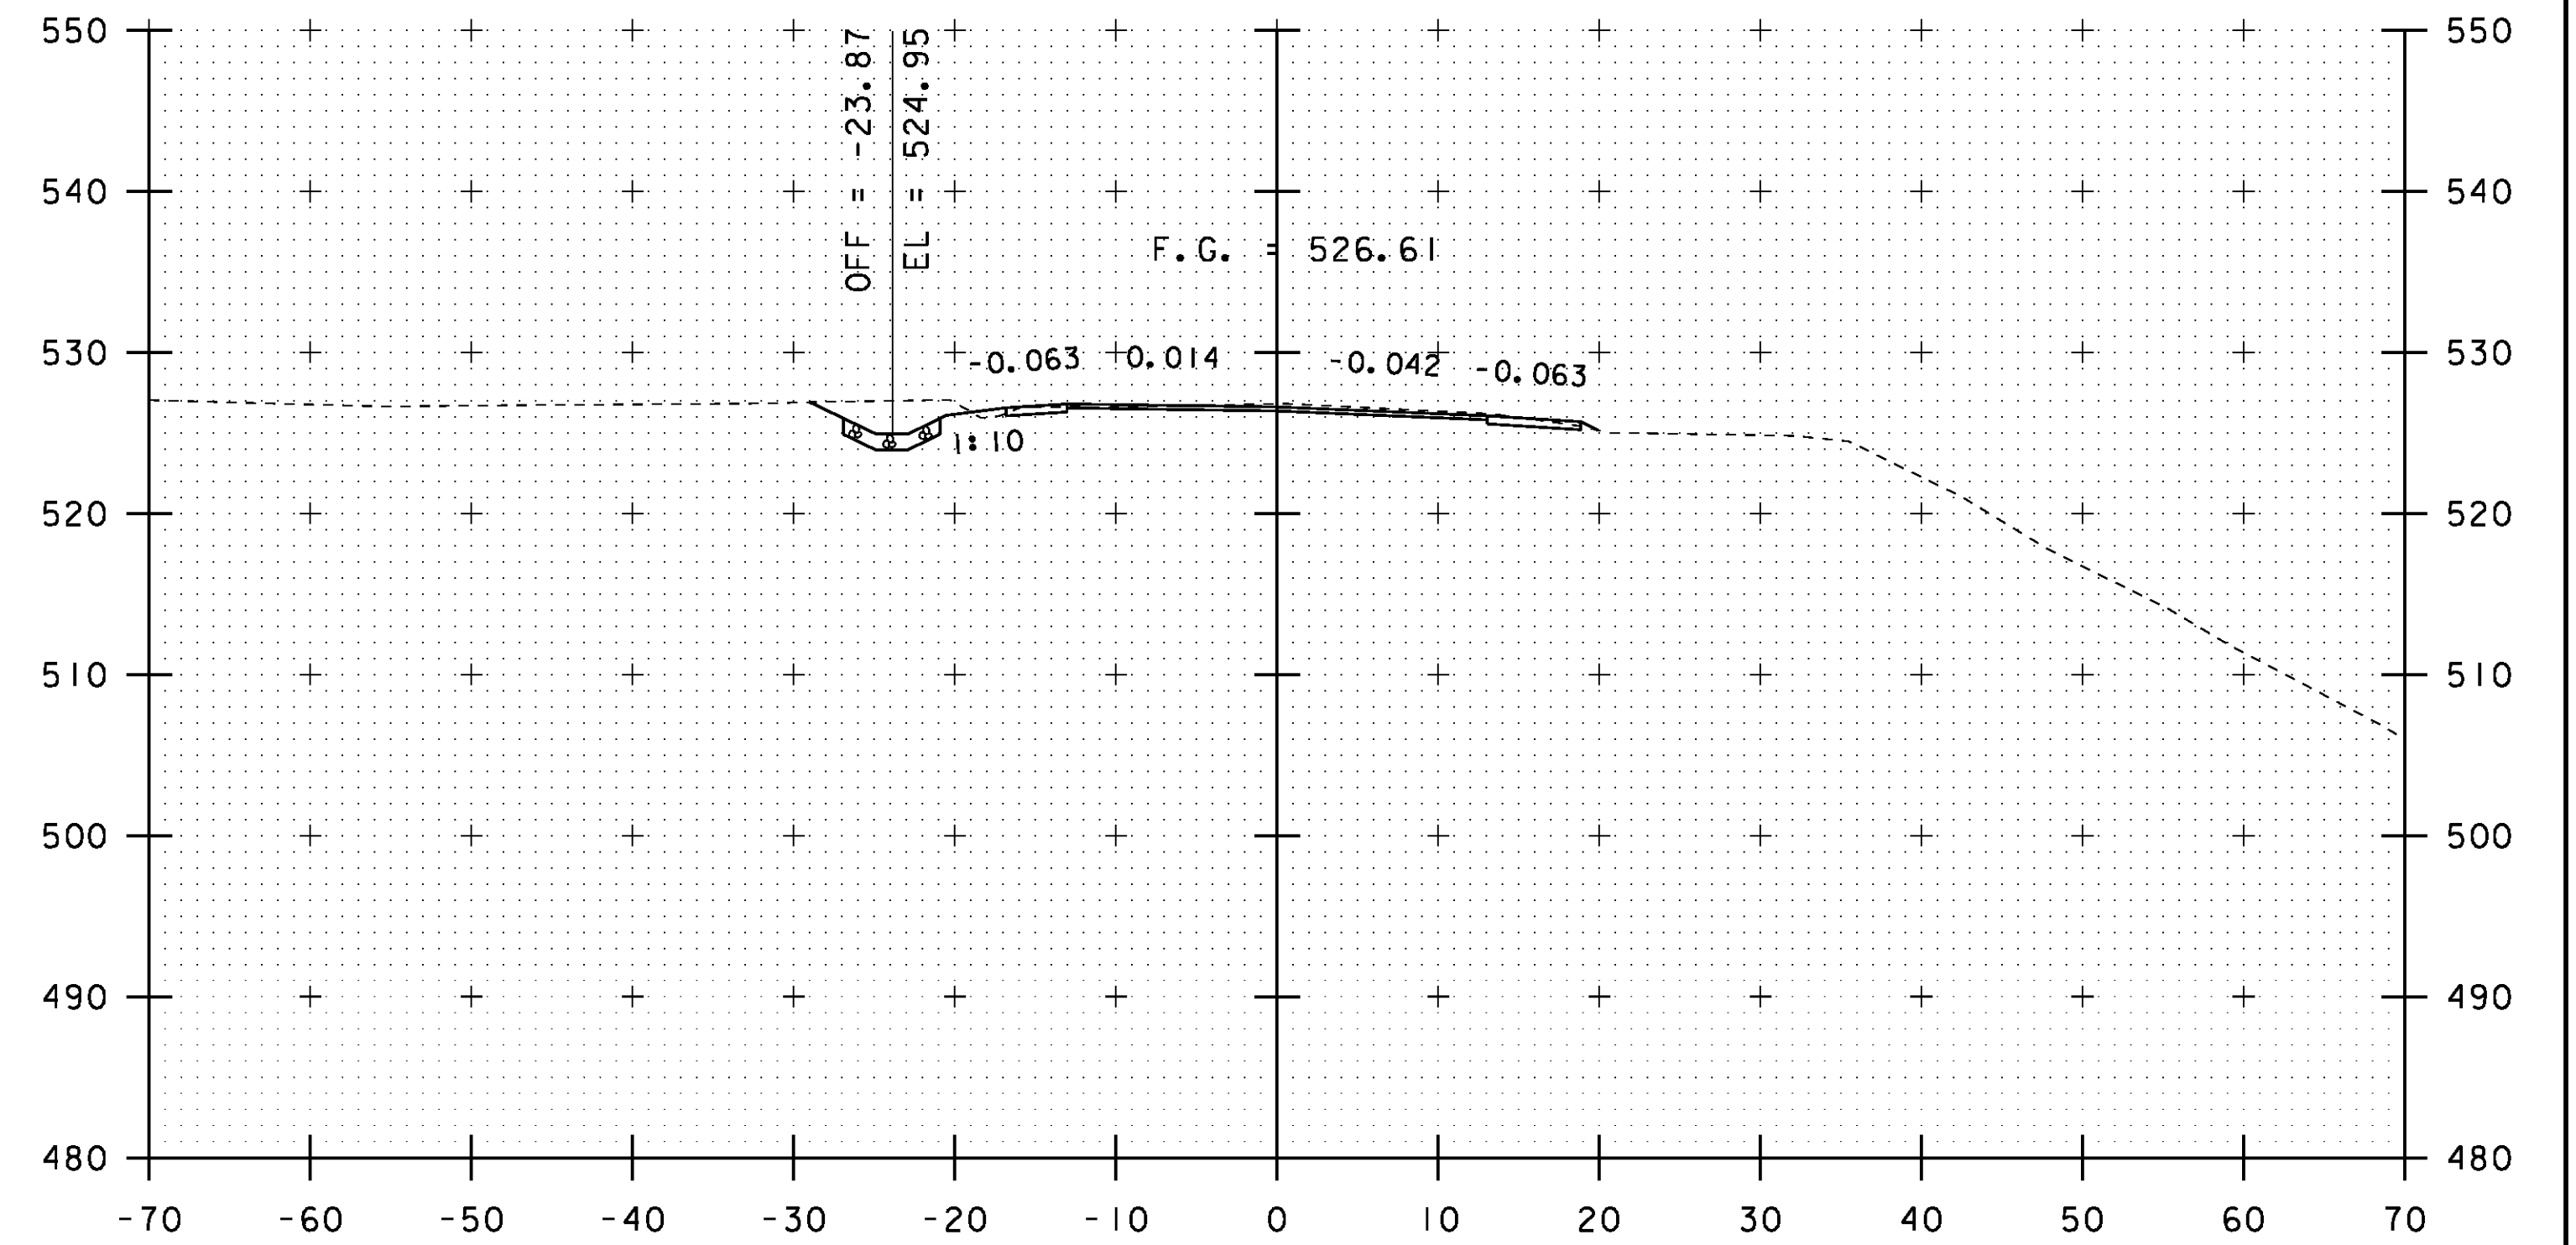


399+75

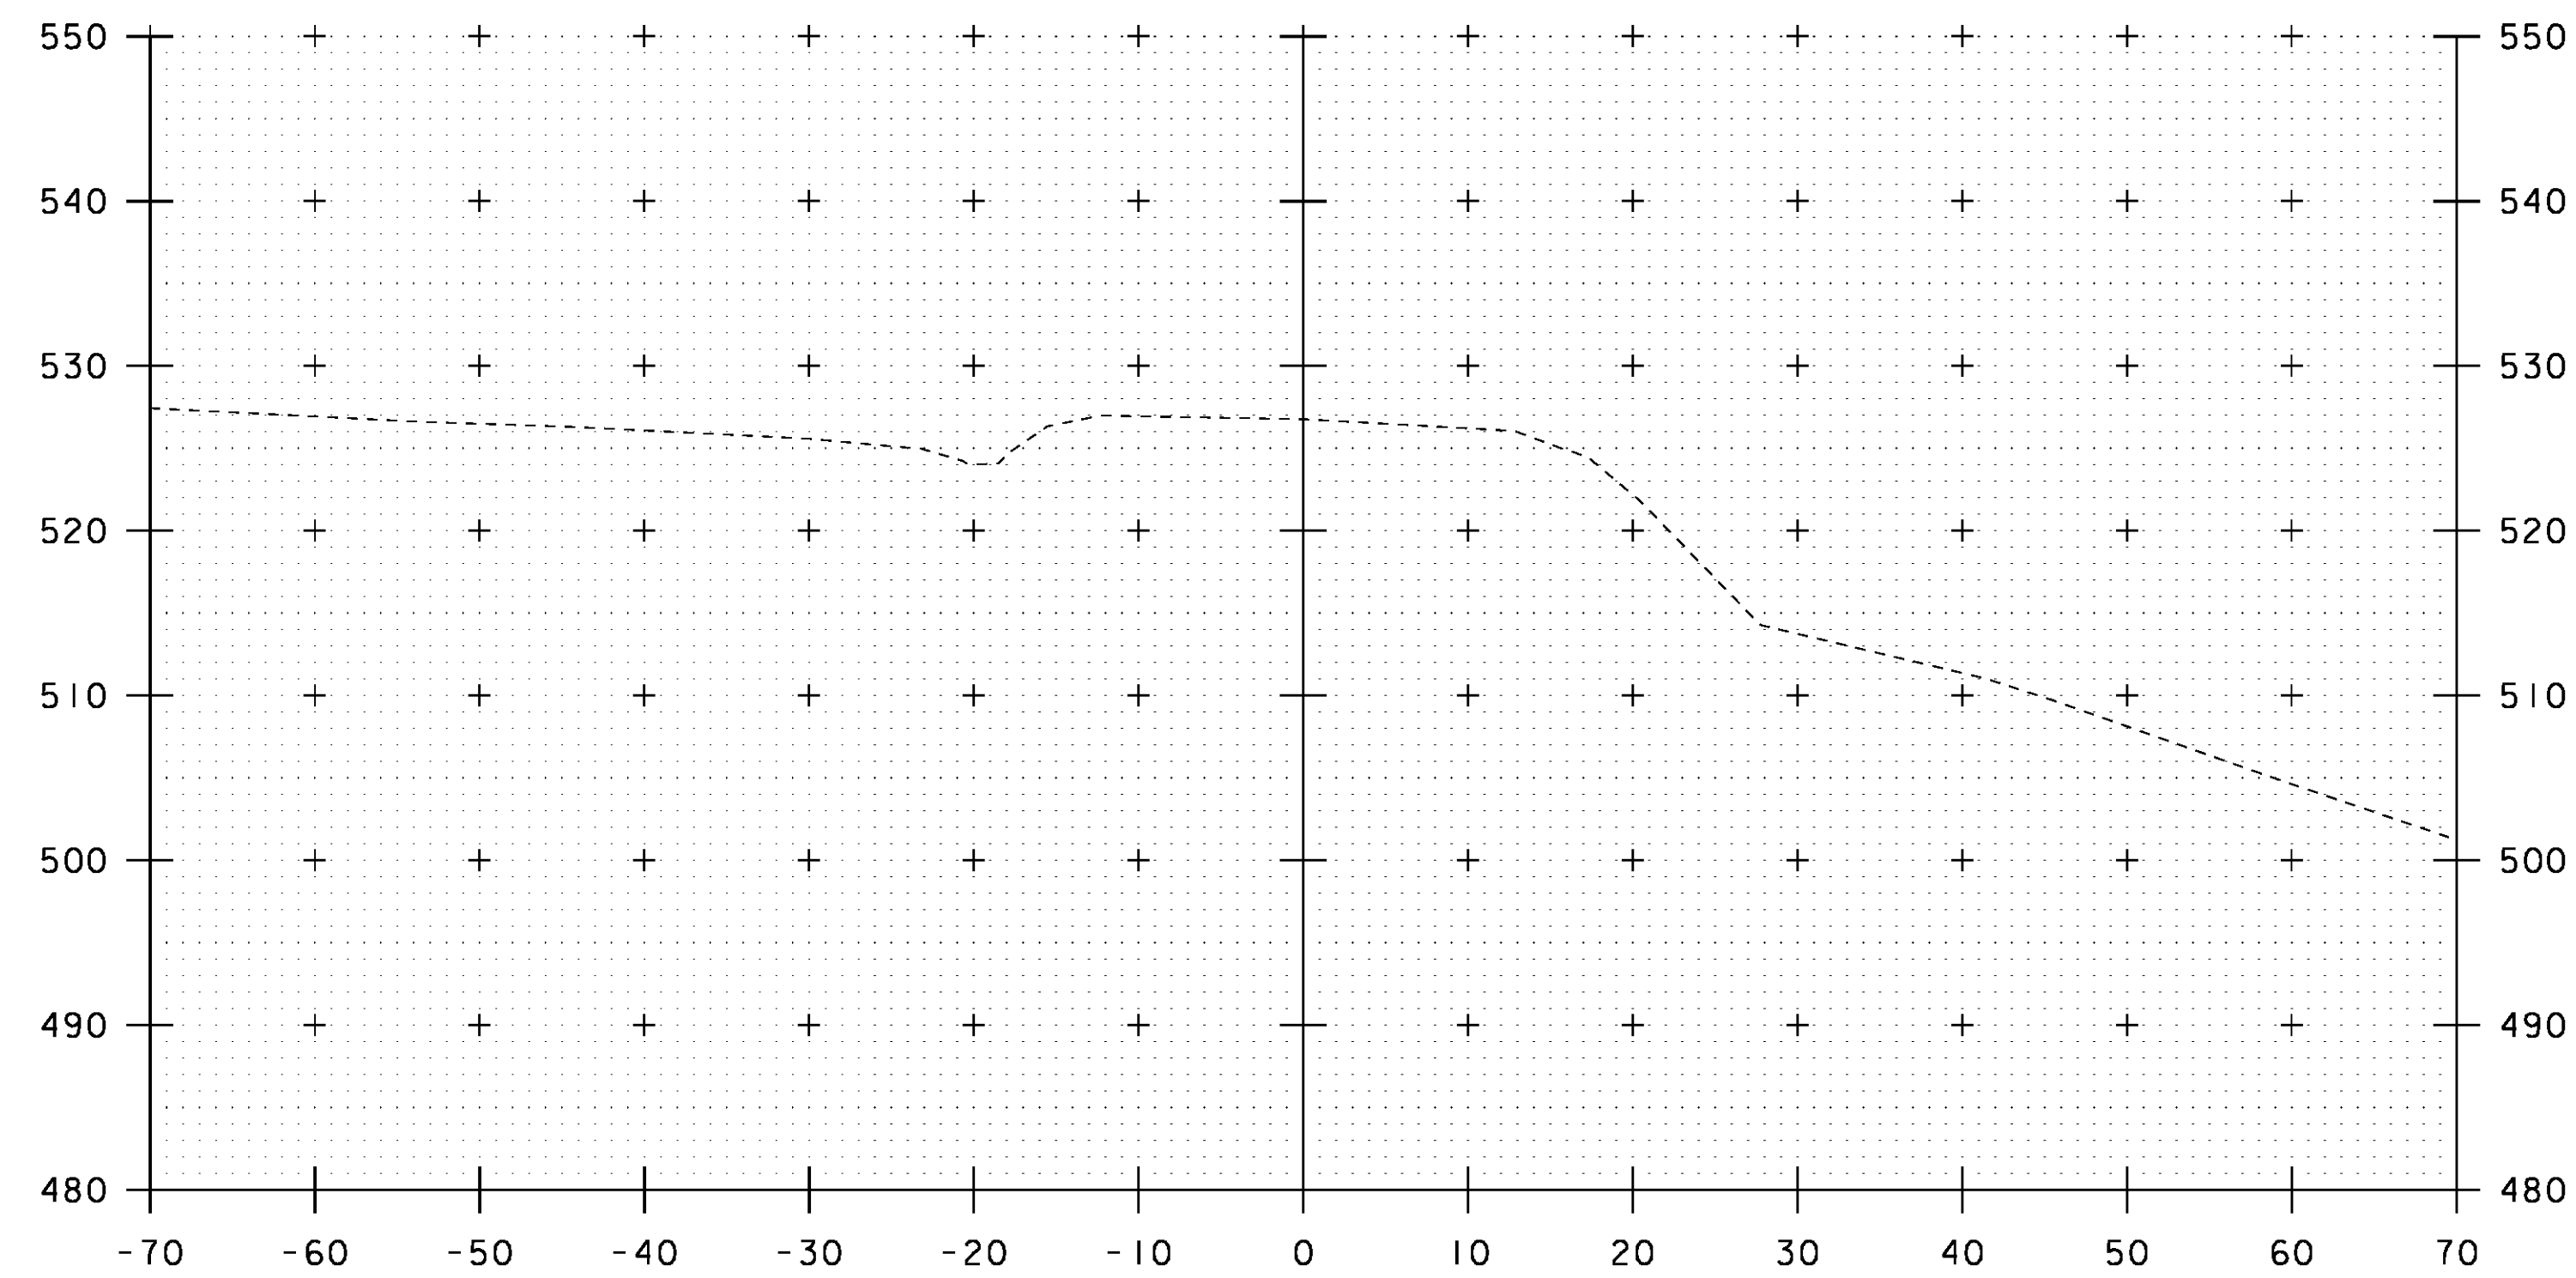

399+00

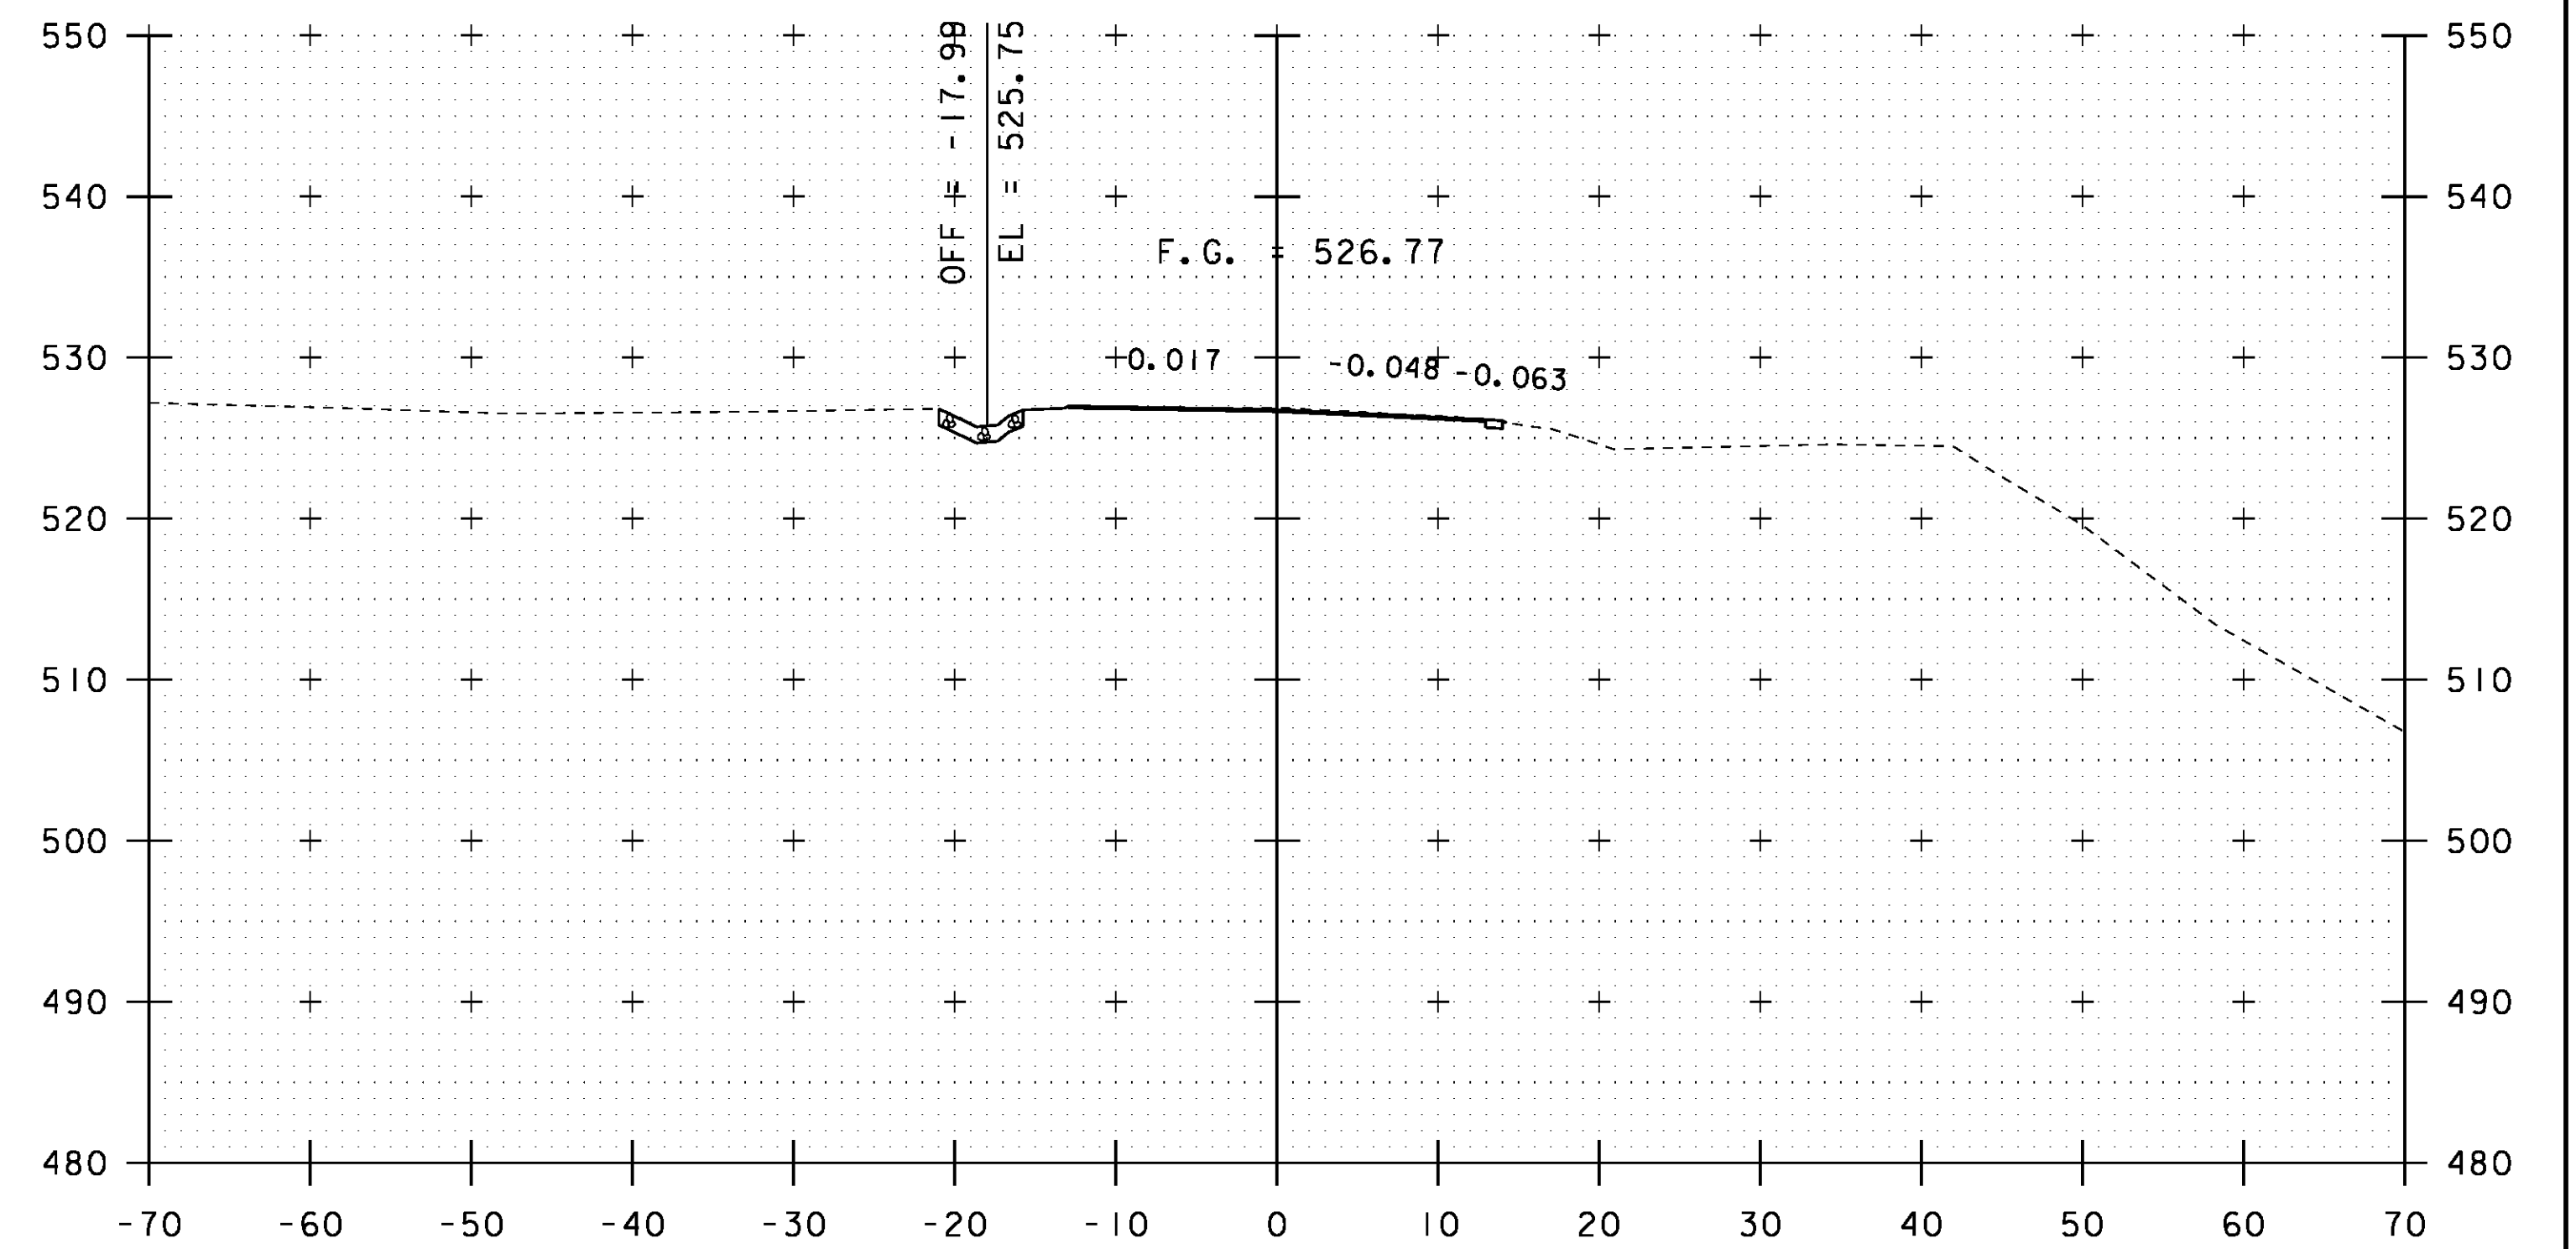

399+50

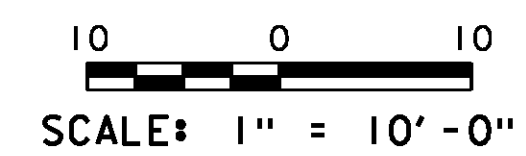

STA. 399+00 TO STA. 399+75

PROJECT NAME:	ROYALTON	PLOT DATE:	08-OCT-2013
PROJECT NUMBER:	BRS 0147(13)	DRAWN BY:	G. ROY
FILE NAME:	s86e05xsl_cattlepass3.dgn	CHECKED BY:	D. PETERSON
PROJECT LEADER:	C. CARLSON		
DESIGNED BY:	G. ROY		
VT 14 CROSS SECTIONS AT CATTLE PASS (1) SHEET 79 OF 186			