



400+25

STA 400+25.00
BEGIN FULL DEPTH CONSTRUCTION

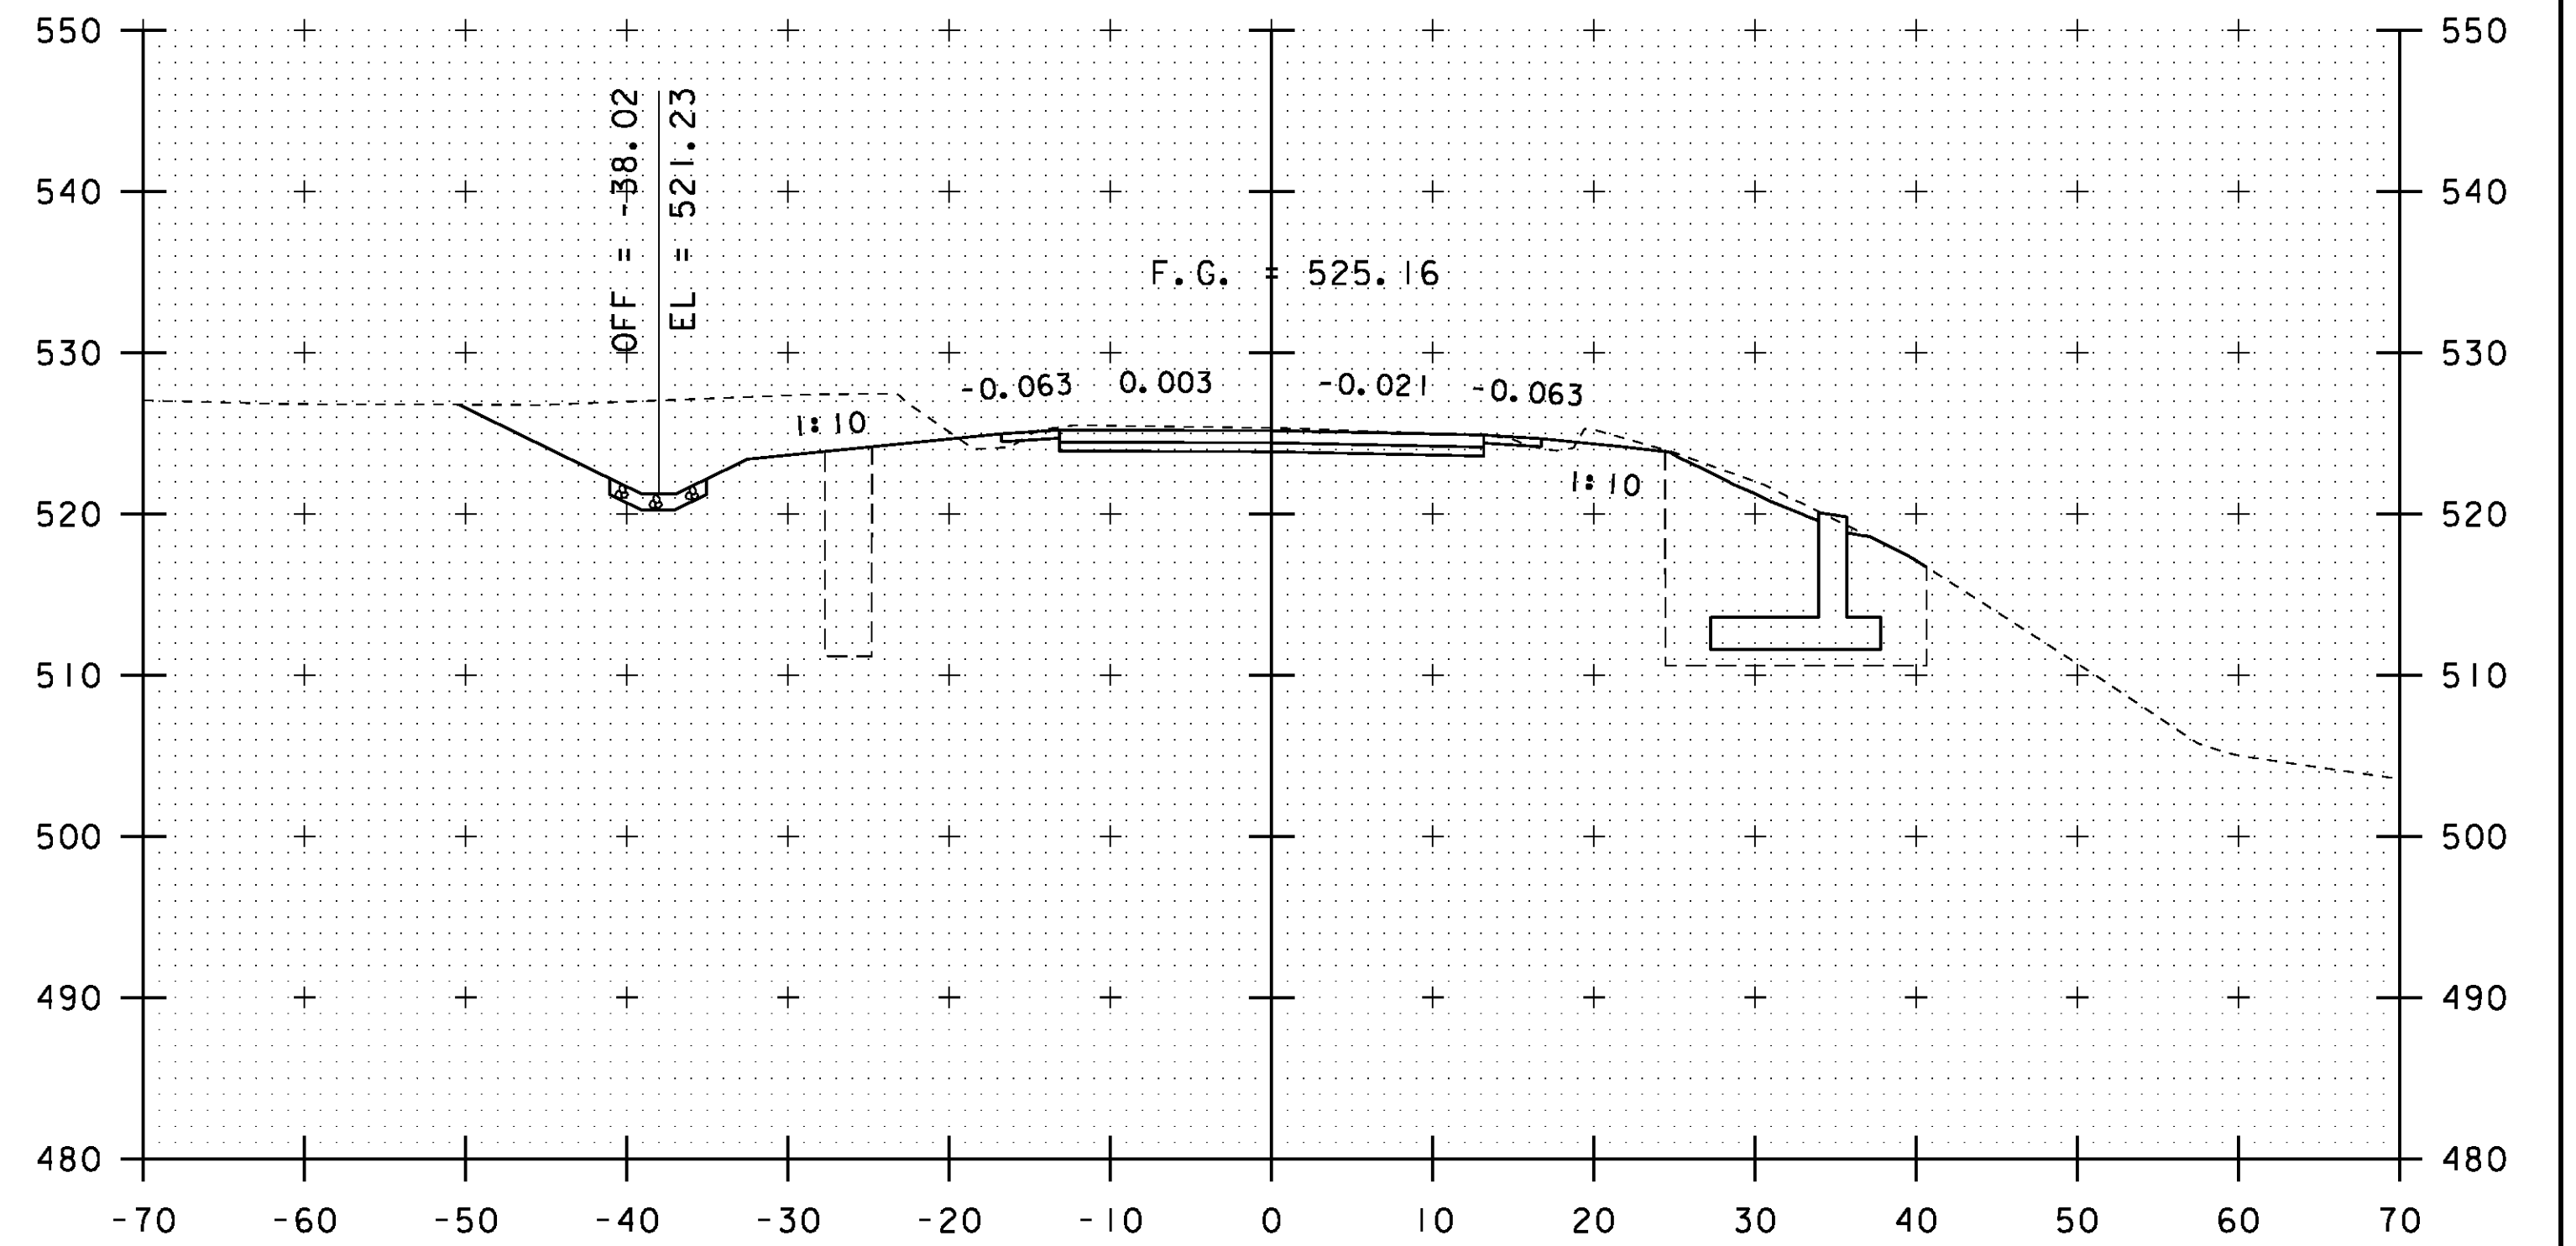


400+75

STA 400+75.00
END FULL DEPTH CONSTRUCTION

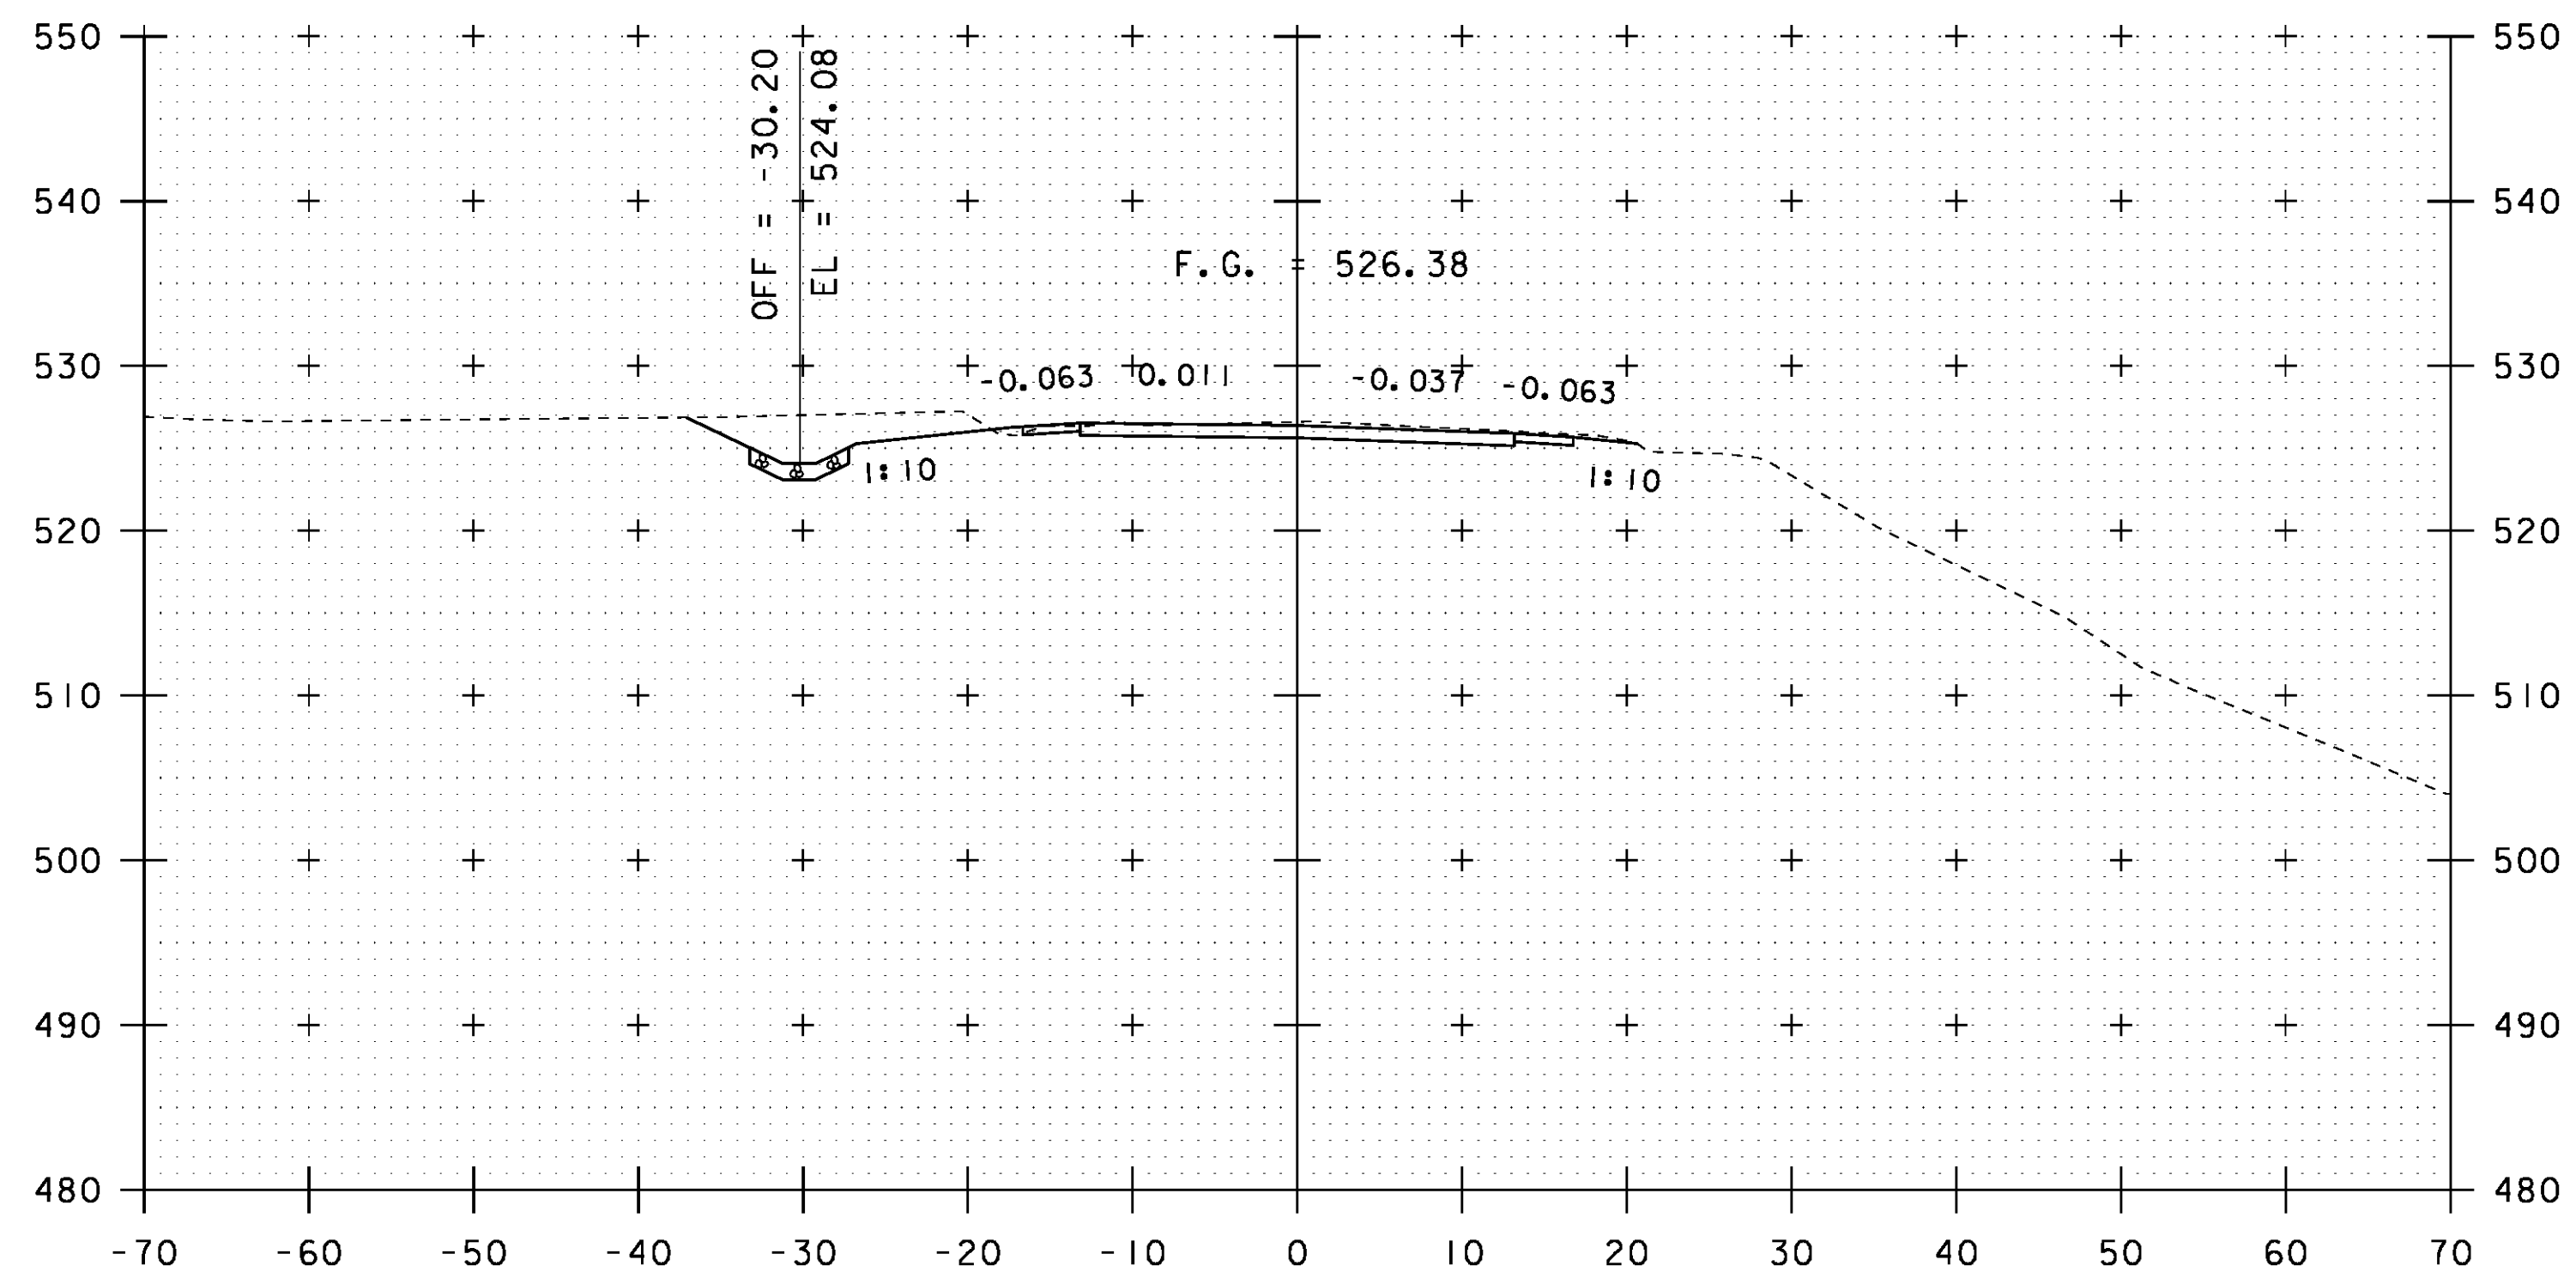


400+00

STA 400+00.00
END APPROACH

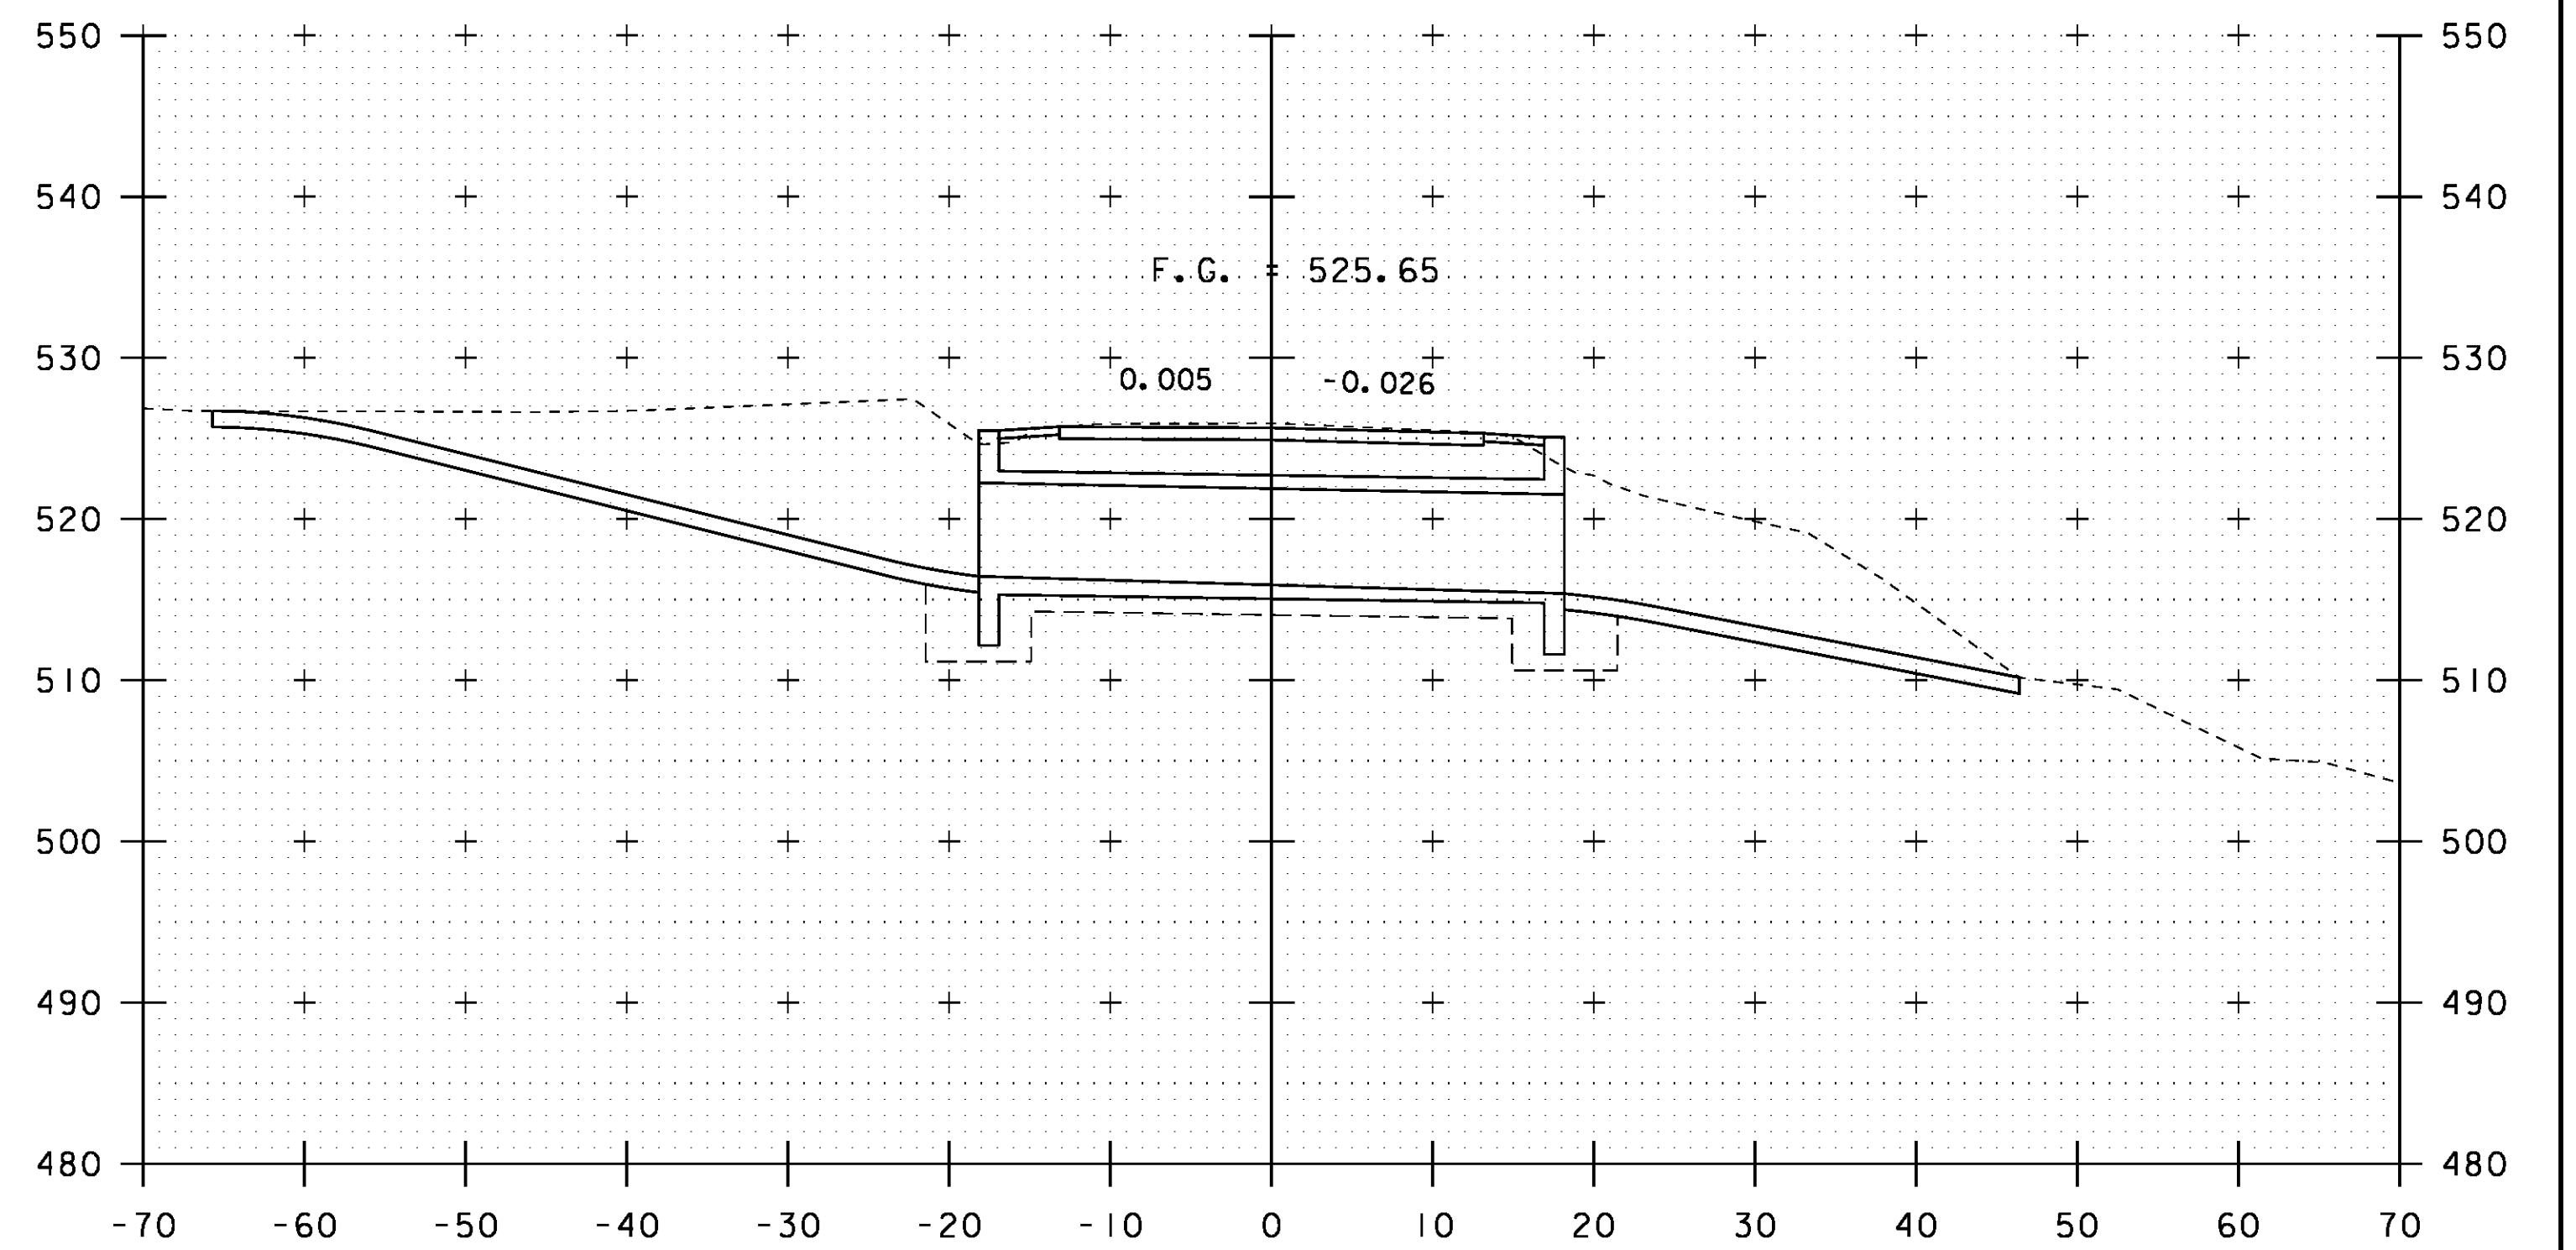

400+50

STA 400+50.00
CONSTRUCT 8' W X 6' H X 36-4" BOX

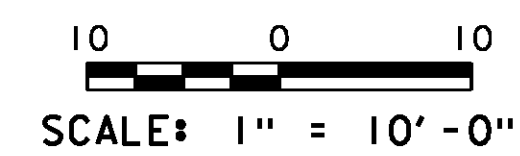

STA. 400+00 TO STA. 400+75

PROJECT NAME:	ROYALTON	PLOT DATE:	08-OCT-2013
PROJECT NUMBER:	BRS 0147(13)	DRAWN BY:	G. ROY
FILE NAME:	s86e05xsl_cattlepass3.dgn	CHECKED BY:	D. PETERSON
PROJECT LEADER:	C. CARLSON		
DESIGNED BY:	G. ROY		
VT 14 CROSS SECTIONS AT CATTLE PASS (2) SHEET 80 OF 186			