


### VT 14 BANKING DIAGRAM

HORIZONTAL SCALE: 1" = 10'-0"  
 VERTICAL SCALE: 1" = 0.01'/'

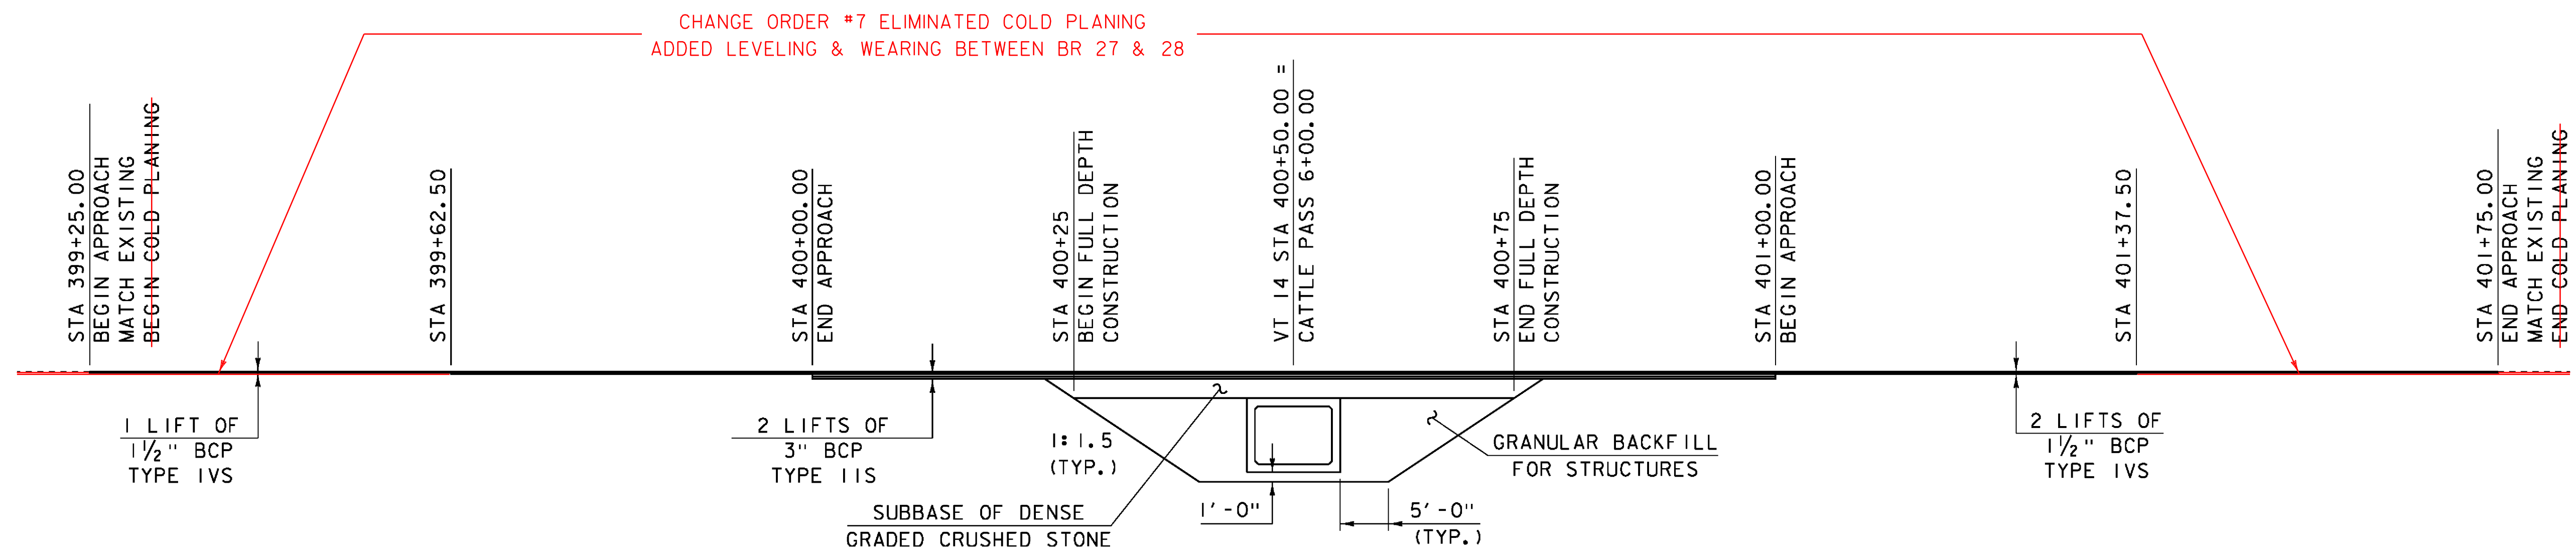

### VT 14 MATERIAL TRANSITION DETAIL

HORIZONTAL SCALE: 1" = 10'-0"  
 VERTICAL SCALE: 1" = 10'-0"

PROJECT NAME:	ROYALTON
PROJECT NUMBER:	BRS 0147(13)
FILE NAME:	s86e055pro_cattlepass3.dgn
PLOT DATE:	08-OCT-2013
PROJECT LEADER:	C. CARLSON
DRAWN BY:	G. ROY
DESIGNED BY:	G. ROY
CHECKED BY:	D. PETERSON
BANKING DIAGRAM AND MATERIAL TRANSITION SHEET 82 OF 186	