




6+30

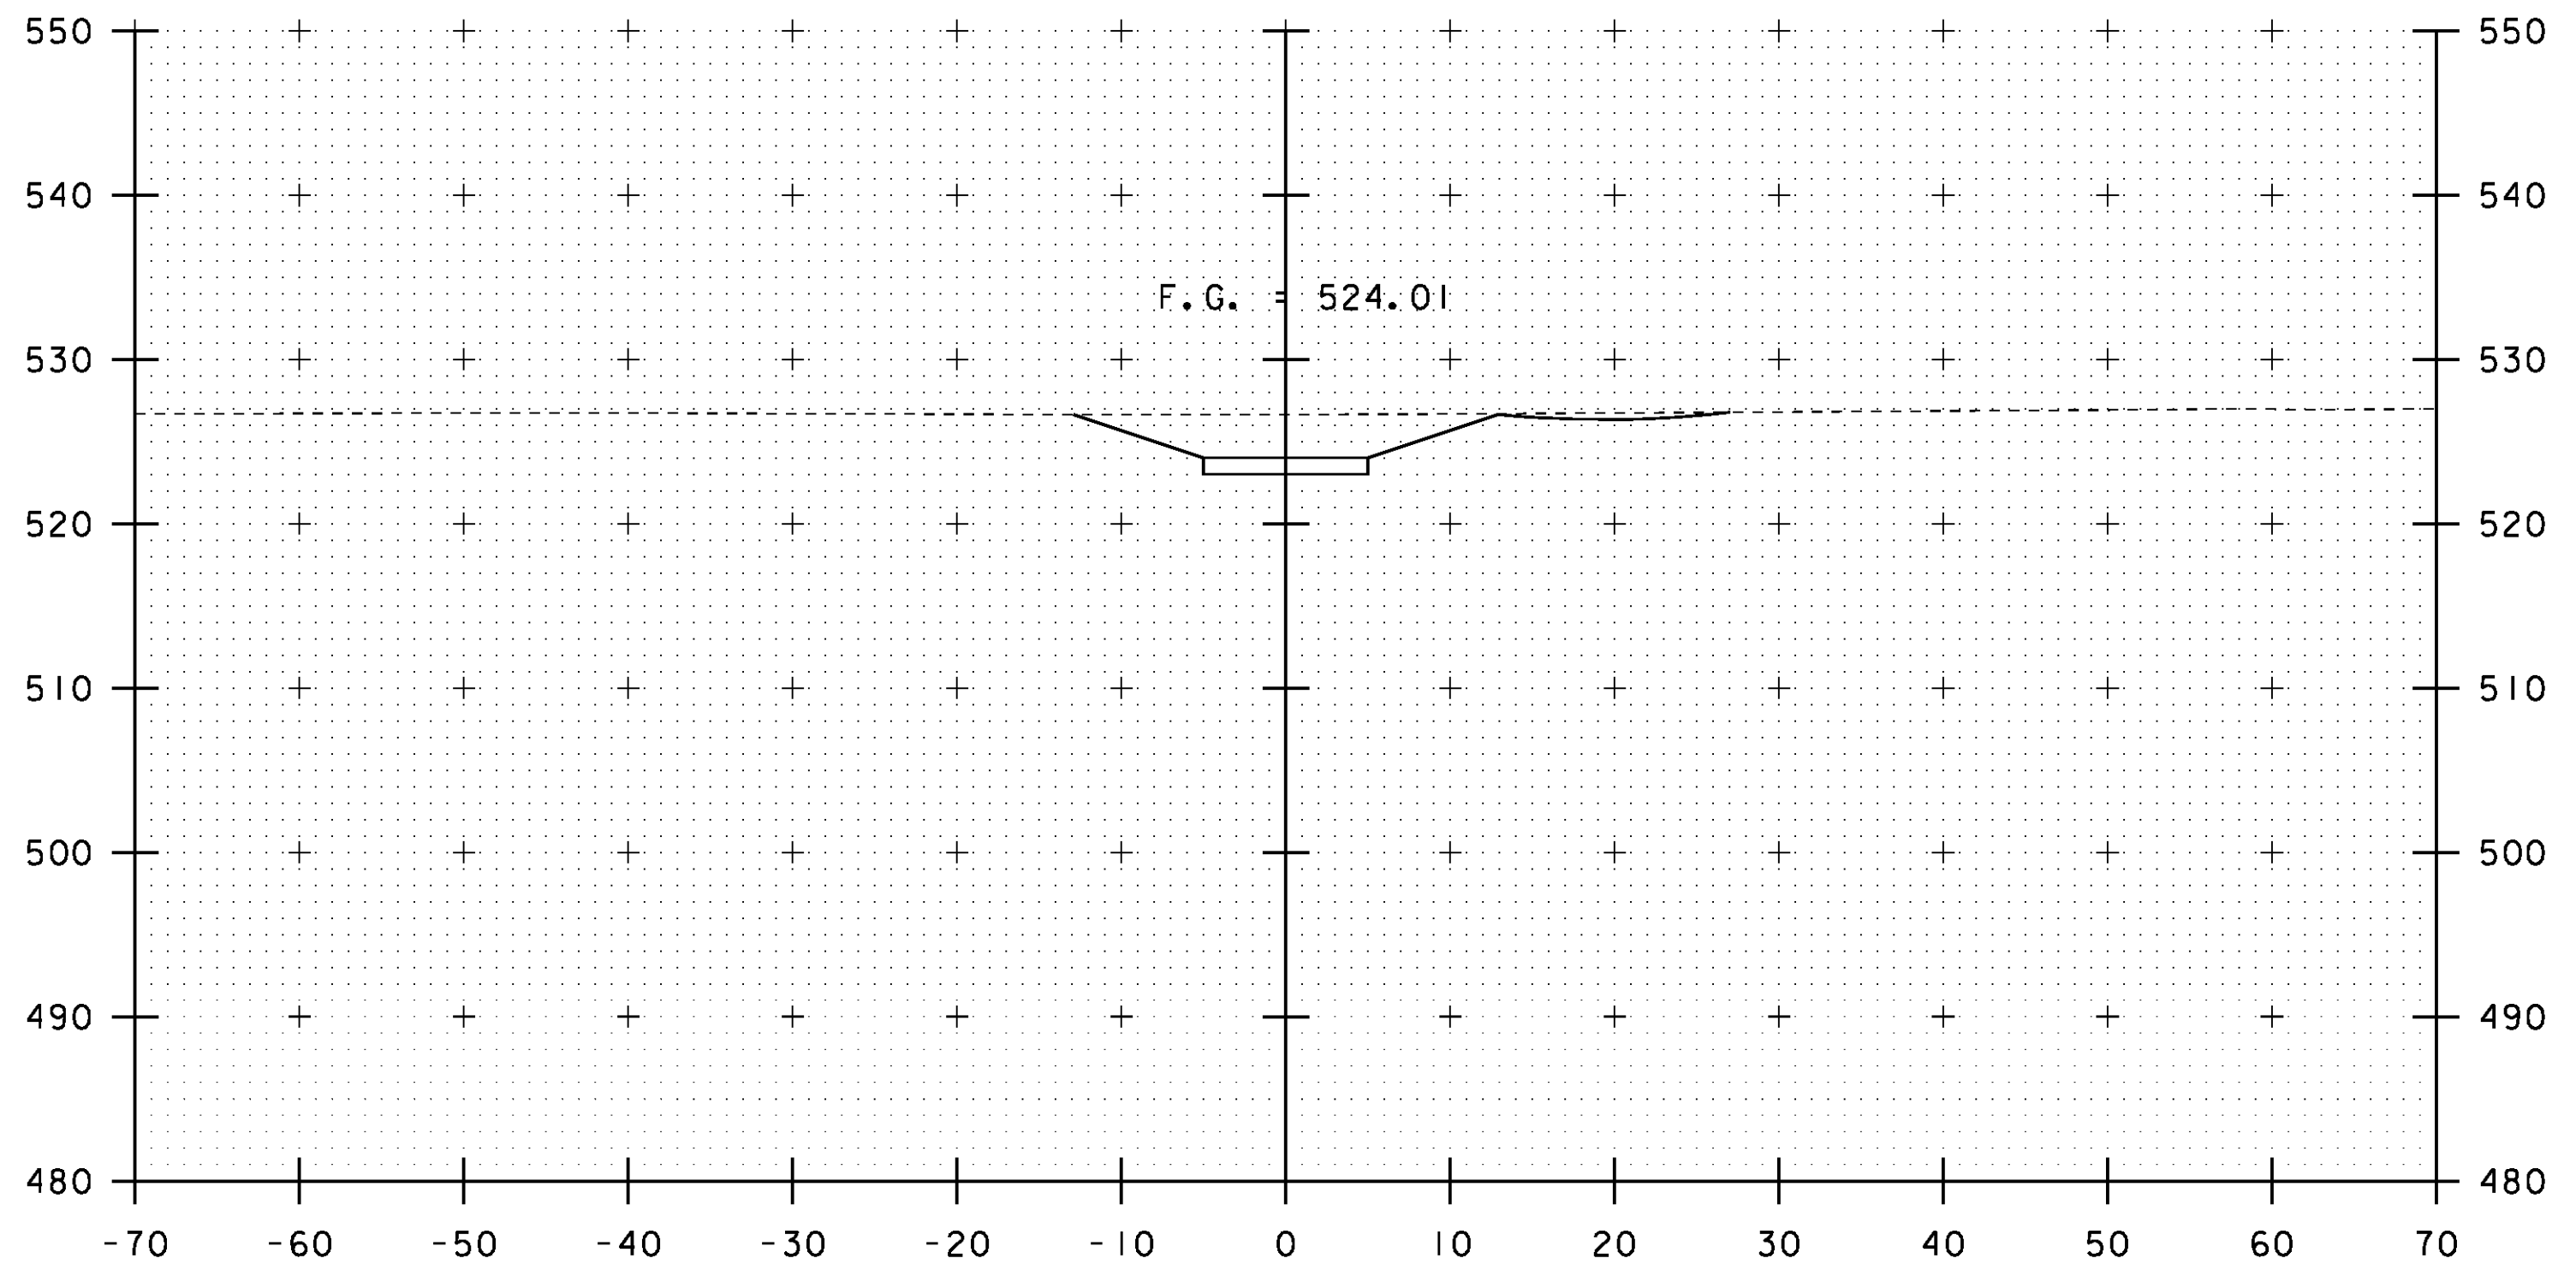


6+50

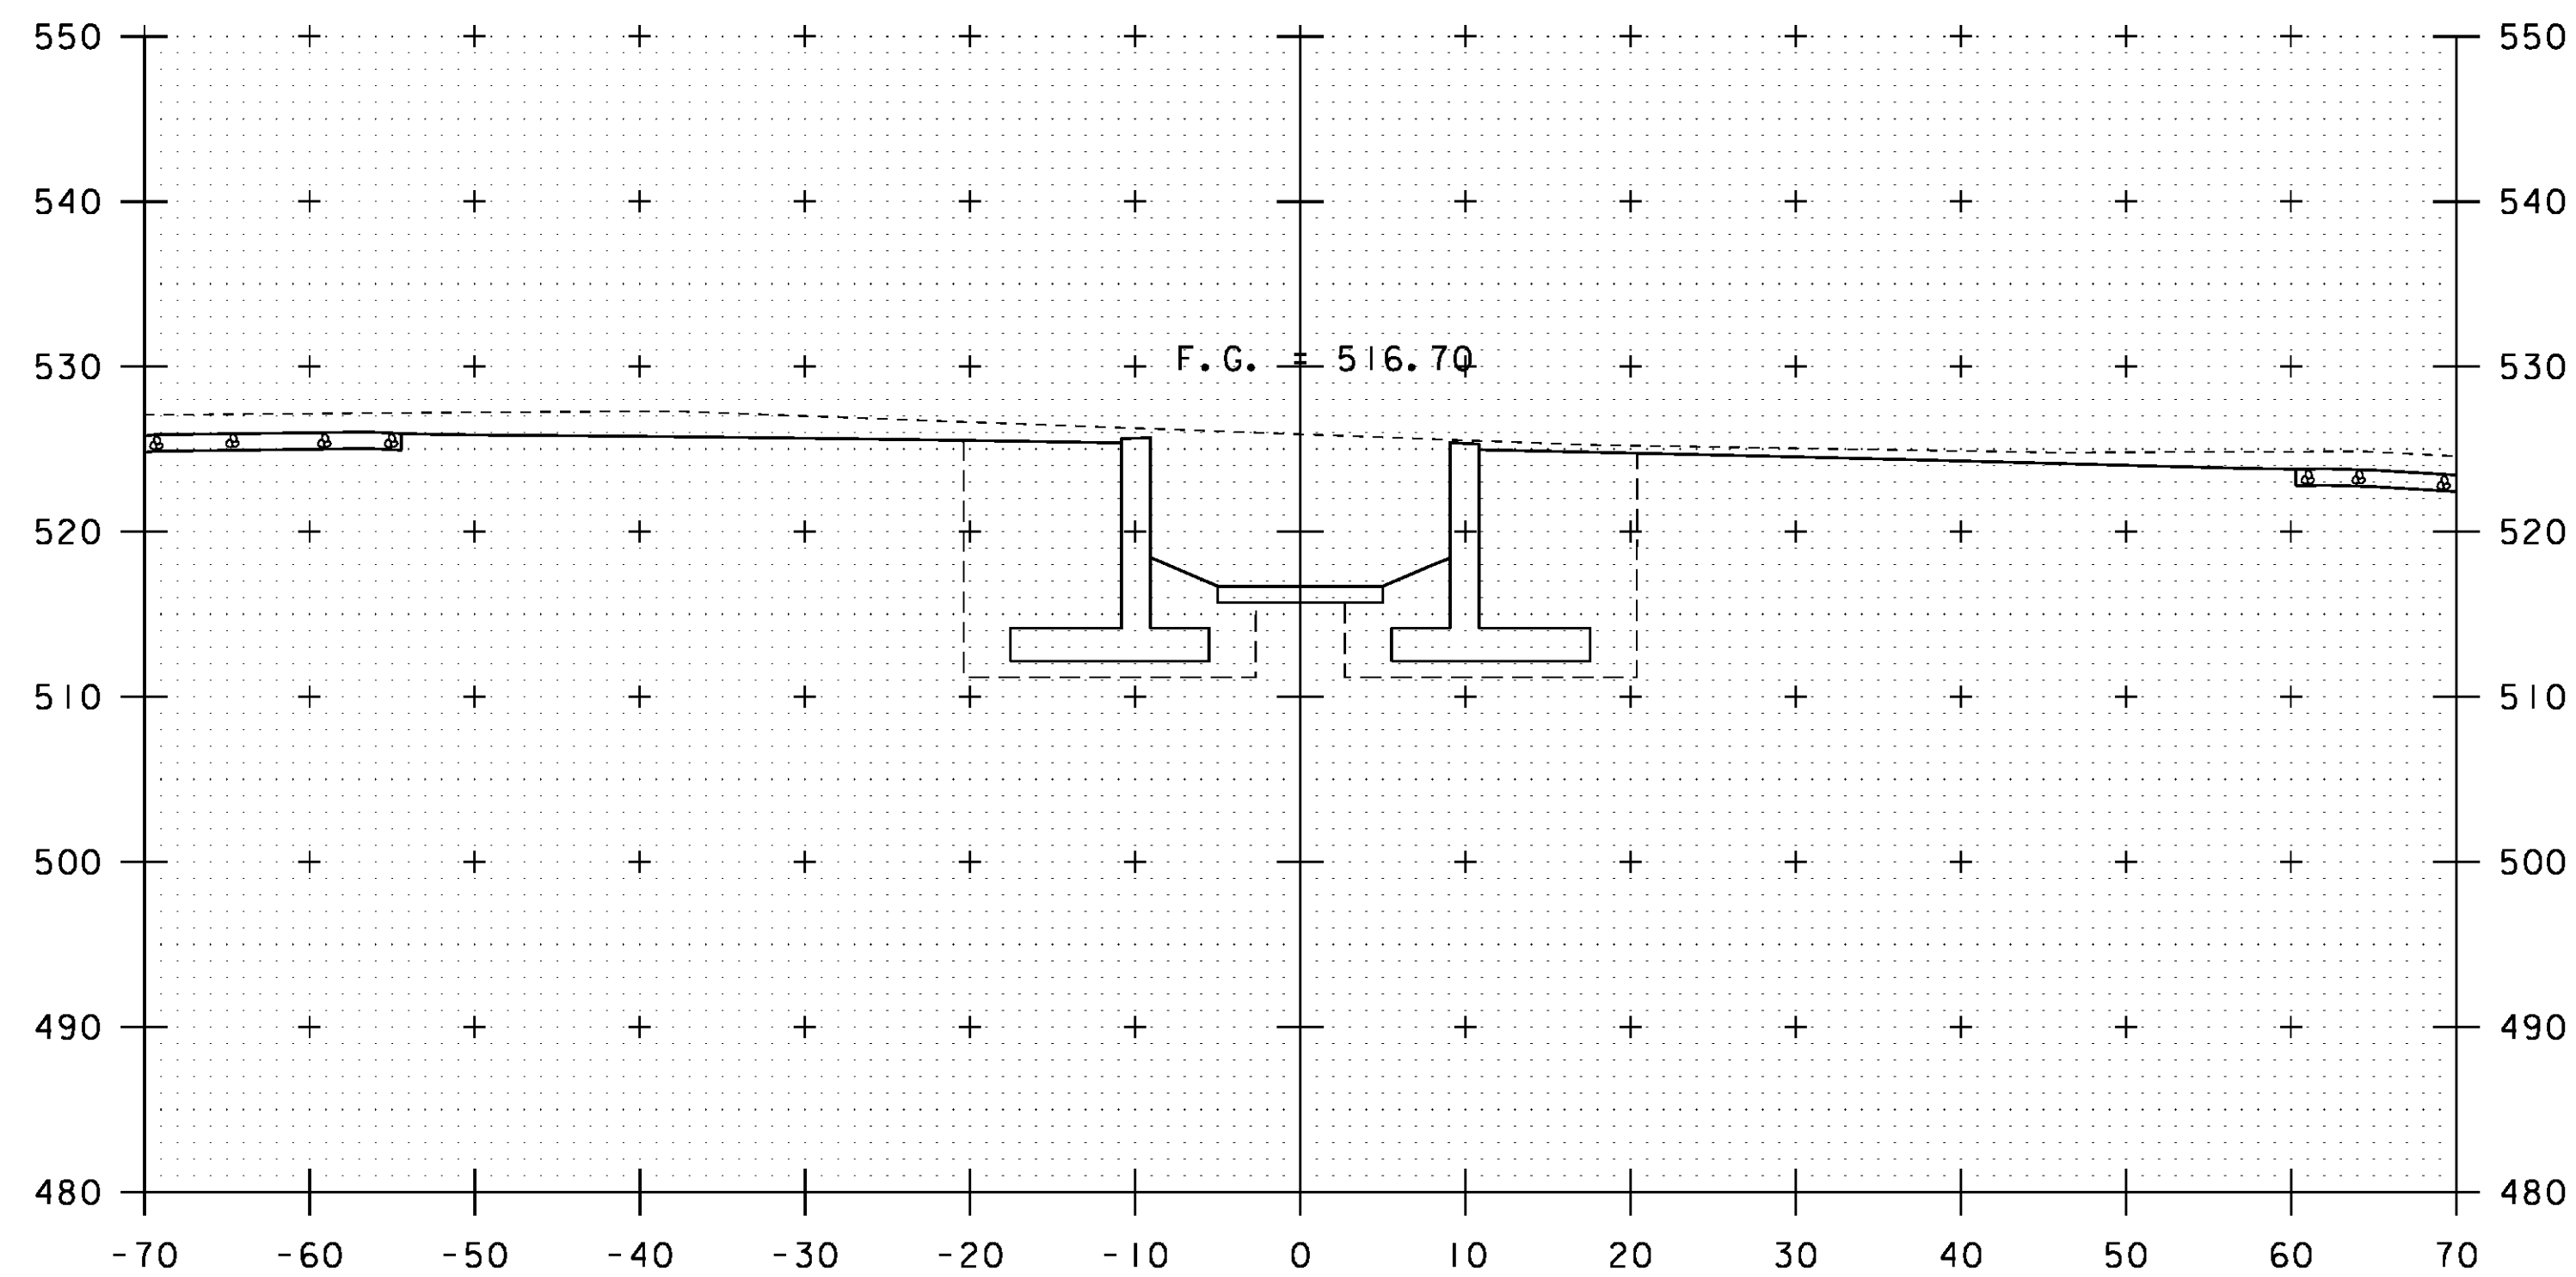

6+20

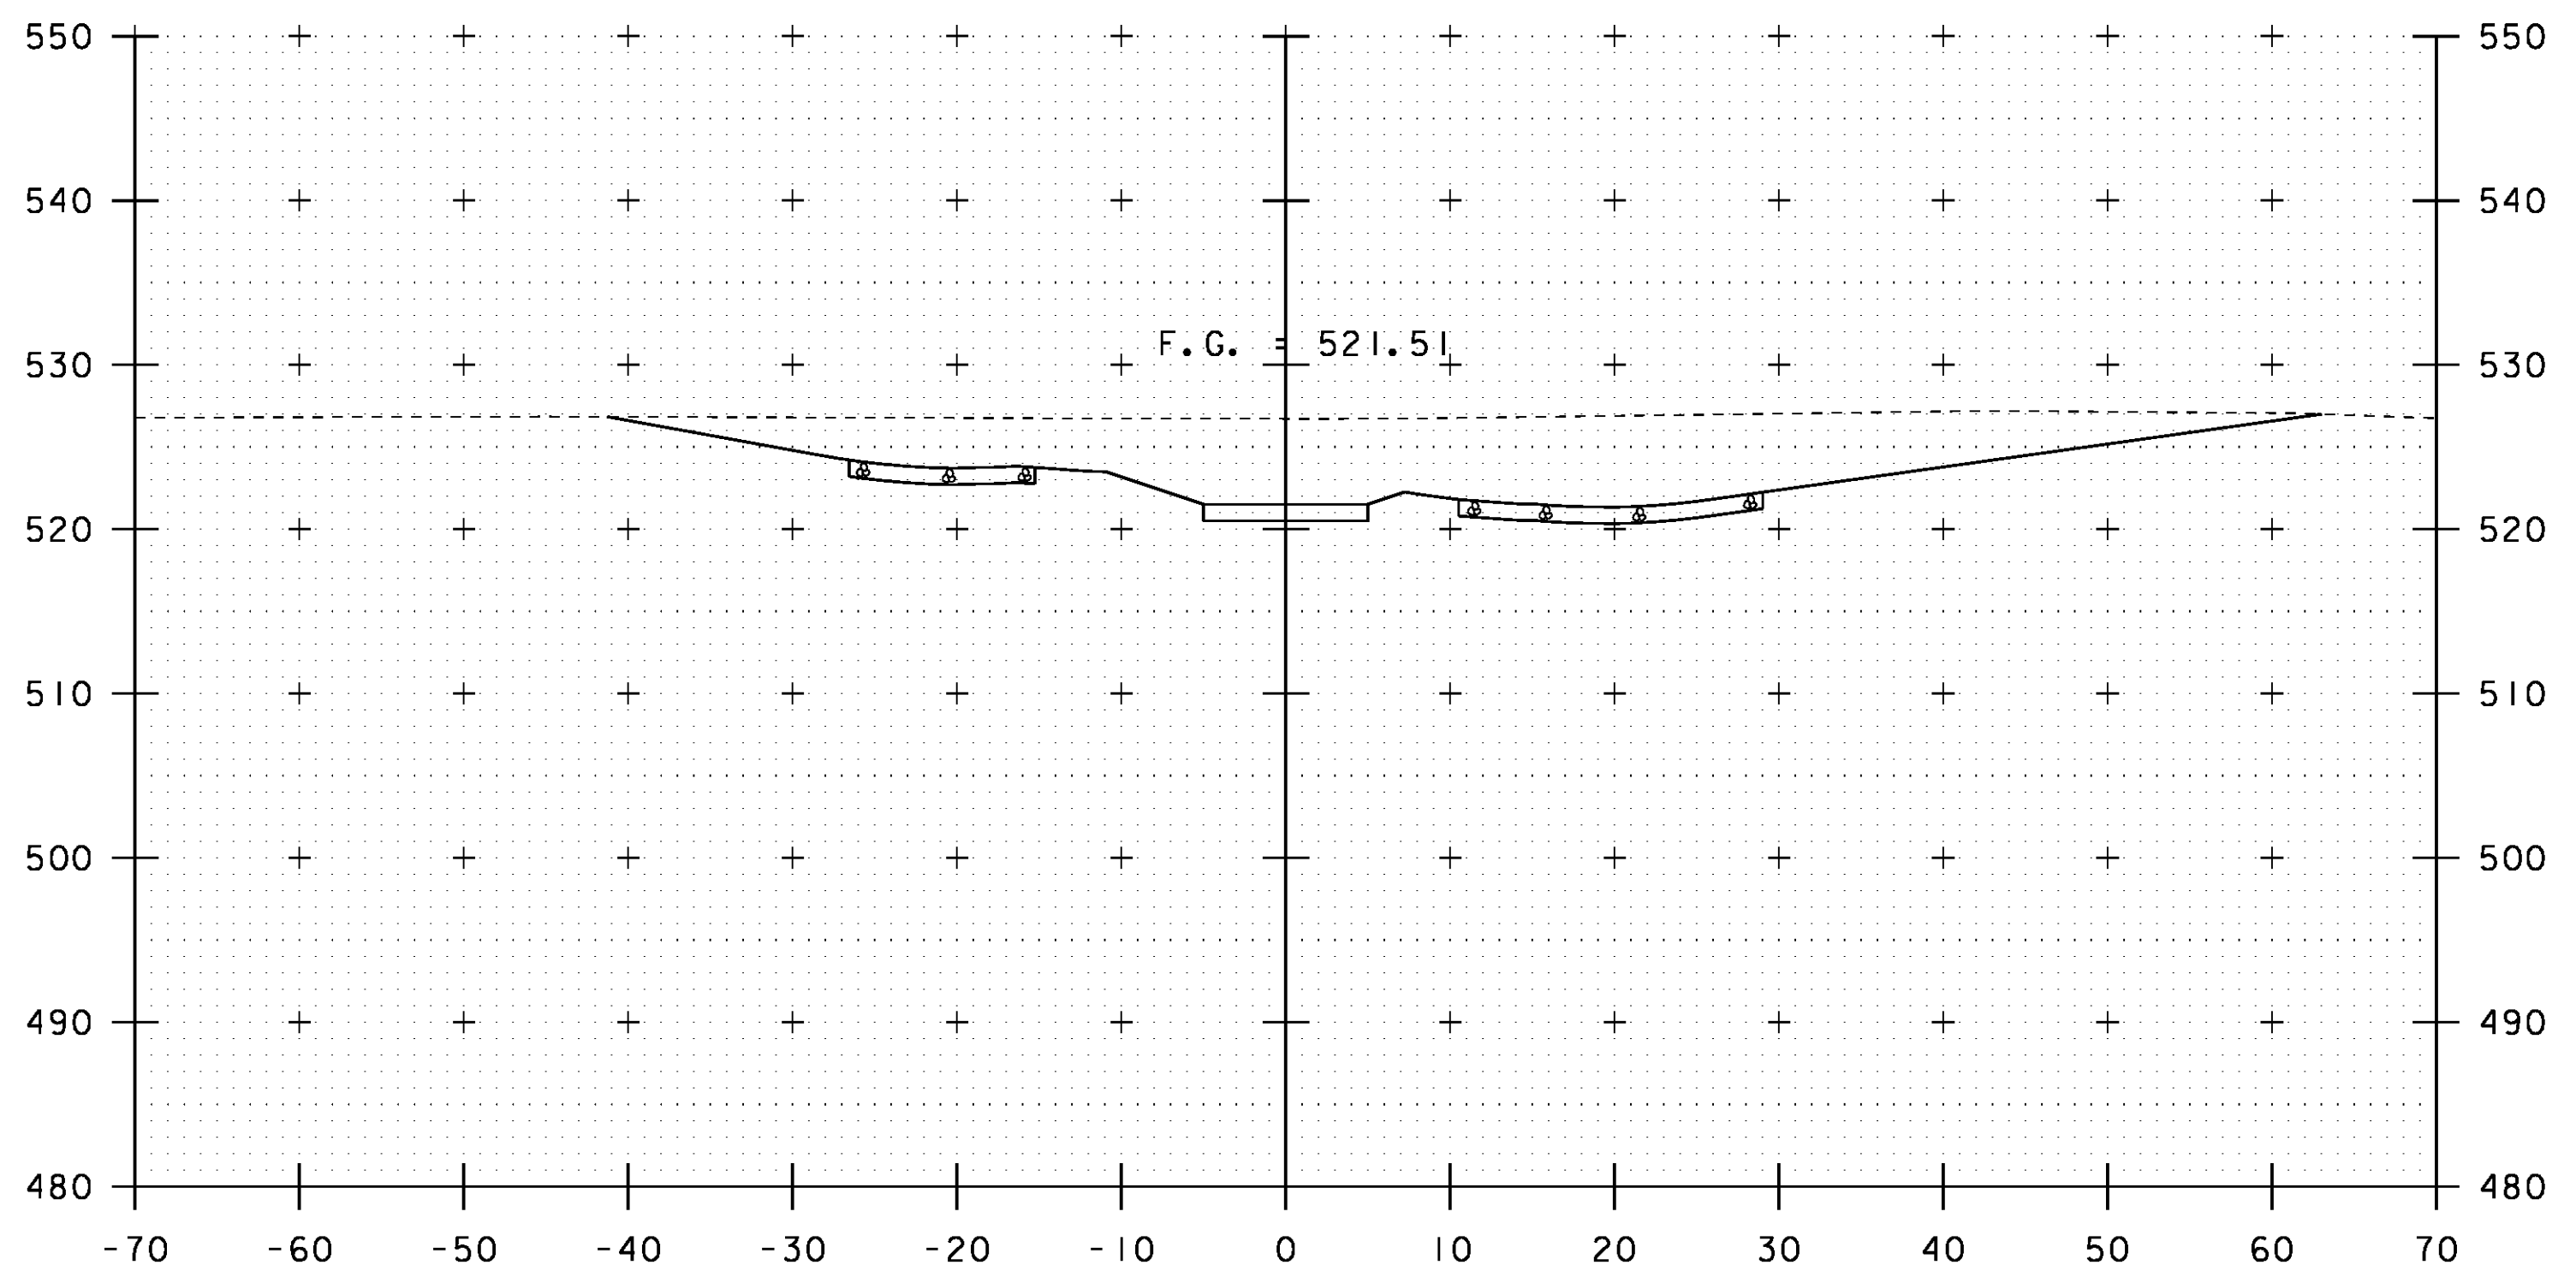

6+40

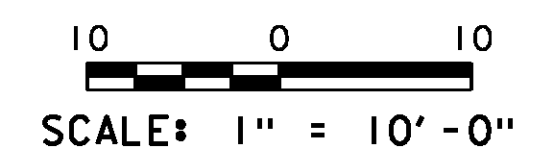

STA. 6+20 TO STA. 6+50

PROJECT NAME: ROYALTON	PLOT DATE: 08-OCT-2013
PROJECT NUMBER: BRS 0147(13)	DRAWN BY: G. ROY
FILE NAME: s86e05xsl_cattlepass3.dgn	CHECKED BY: D. PETERSON
PROJECT LEADER: C. CARLSON	SHEET 85 OF 186
DESIGNED BY: G. ROY	
CATTLE PASS CROSS SECTIONS (3)	