


6+70

STA 6+65.70
END CATTLE PASS
MATCH EXISTING

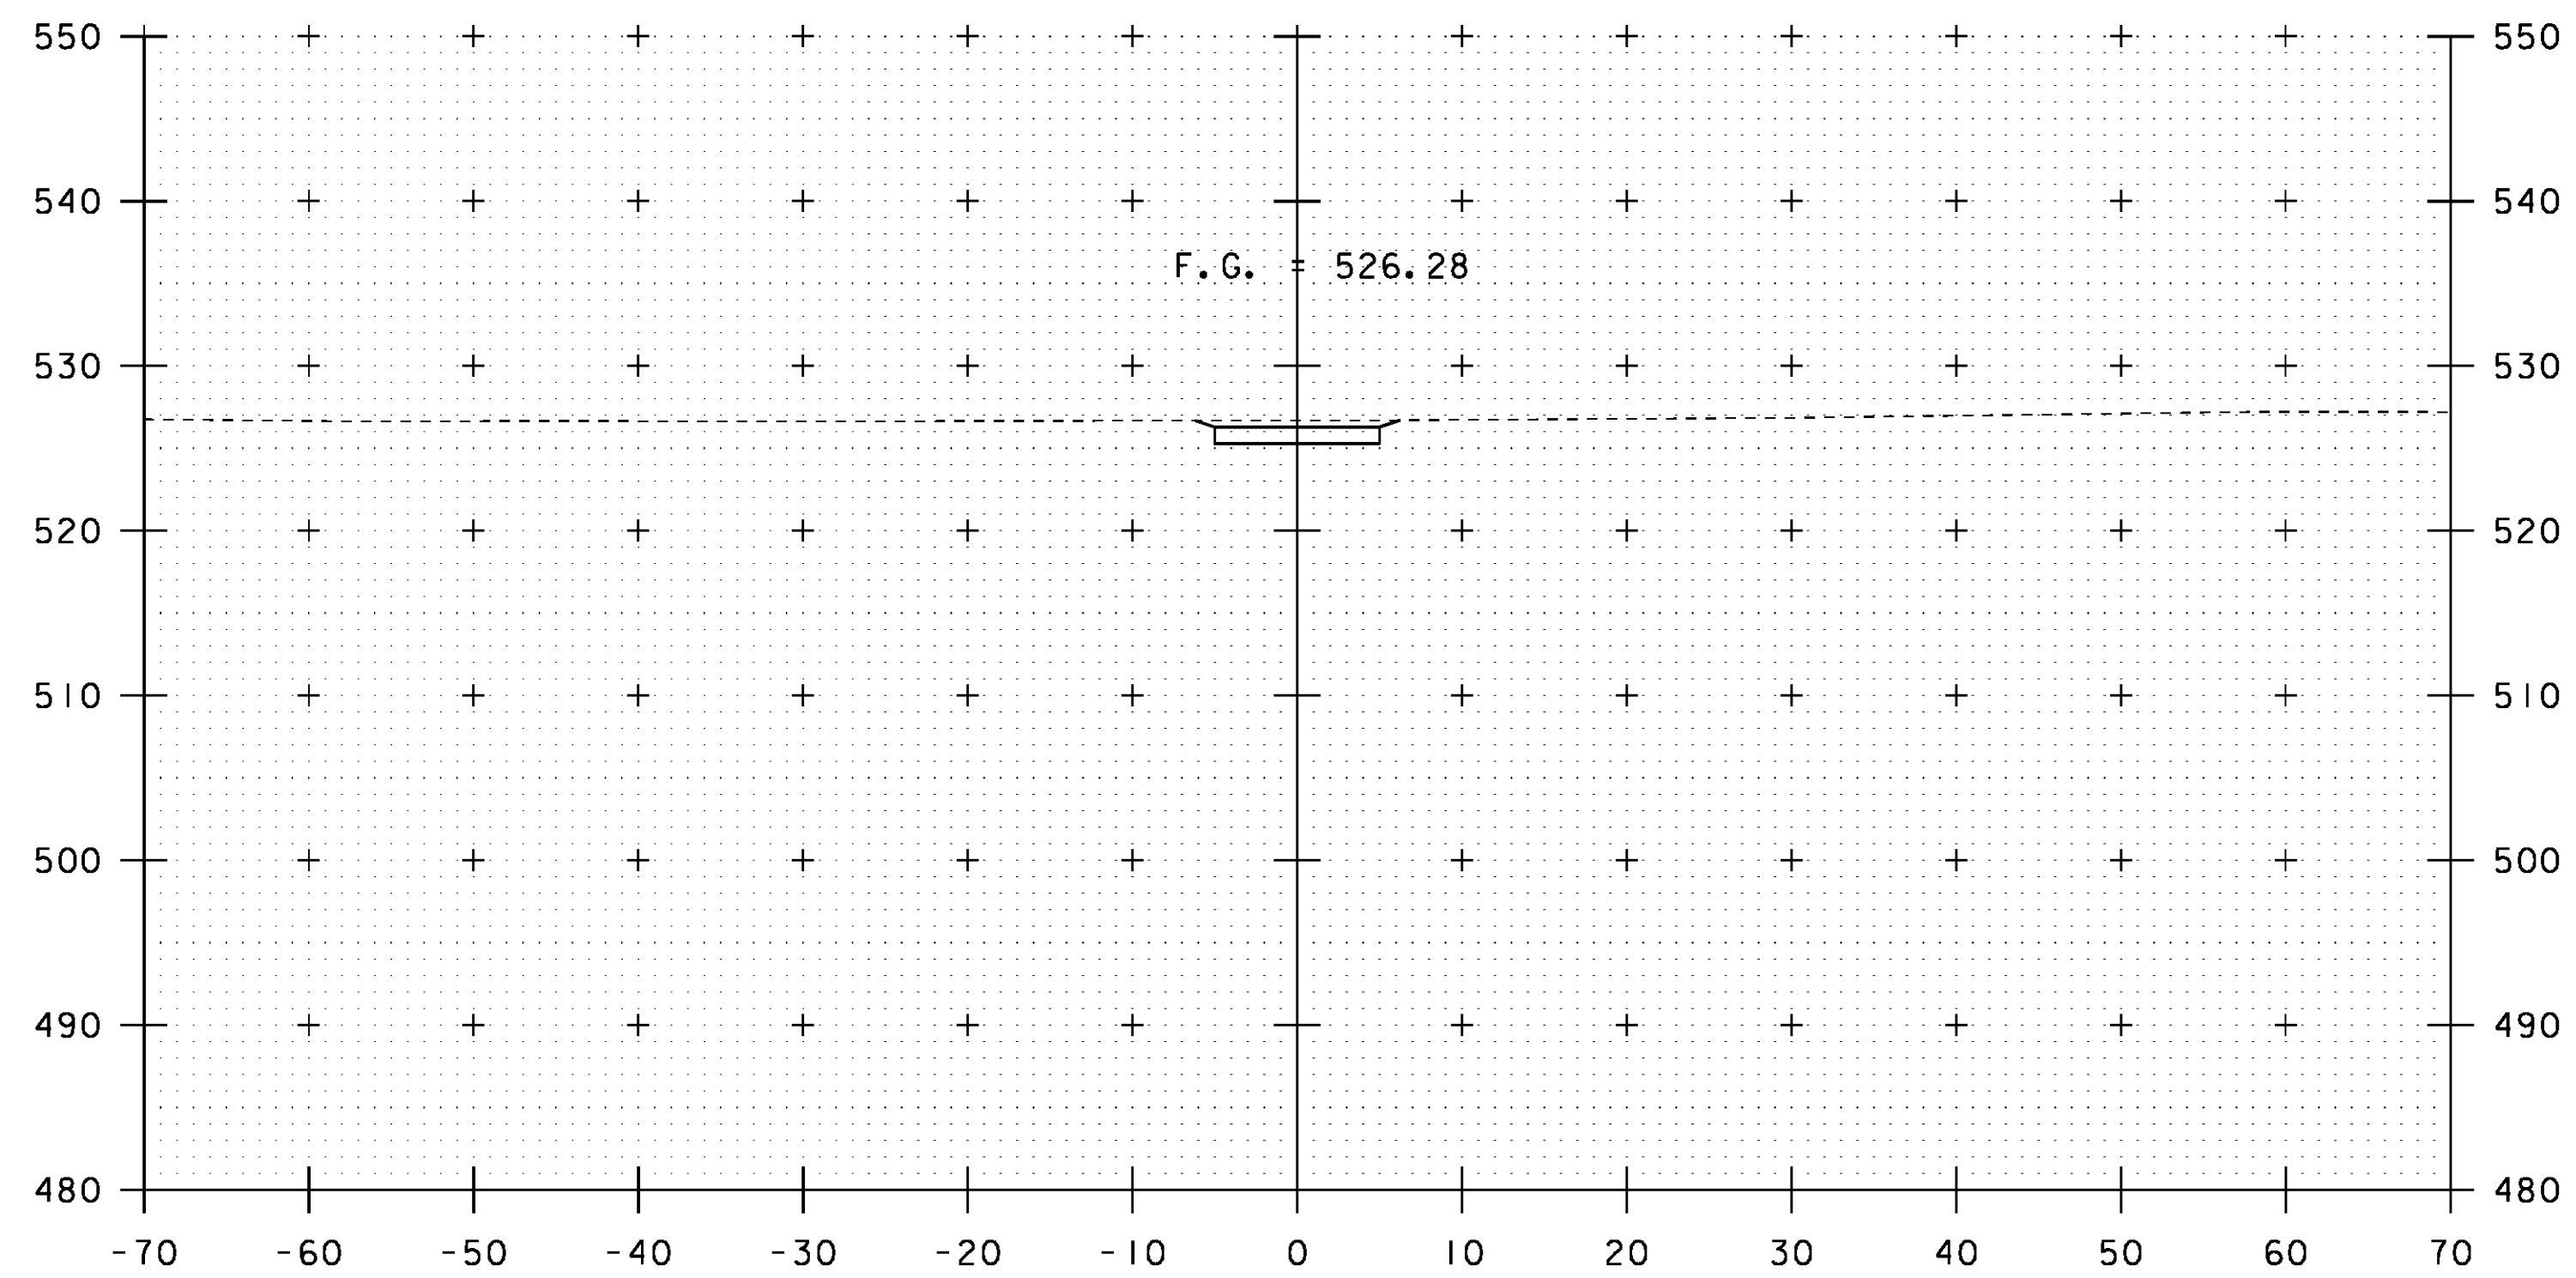

6+60

STA. 6+60 TO STA. 6+70

PROJECT NAME: ROYALTON	PLOT DATE: 08-OCT-2013
PROJECT NUMBER: BRS 0147(13)	DRAWN BY: G. ROY
FILE NAME: s86e05xsl_cattlepass3.dgn	CHECKED BY: D. PETERSON
PROJECT LEADER: C. CARLSON	SHEET 86 OF 186
DESIGNED BY: G. ROY	
CATTLE PASS CROSS SECTIONS (4)	