


DECK REINFORCING PLAN
SCALE: 3/8" = 1'-0"

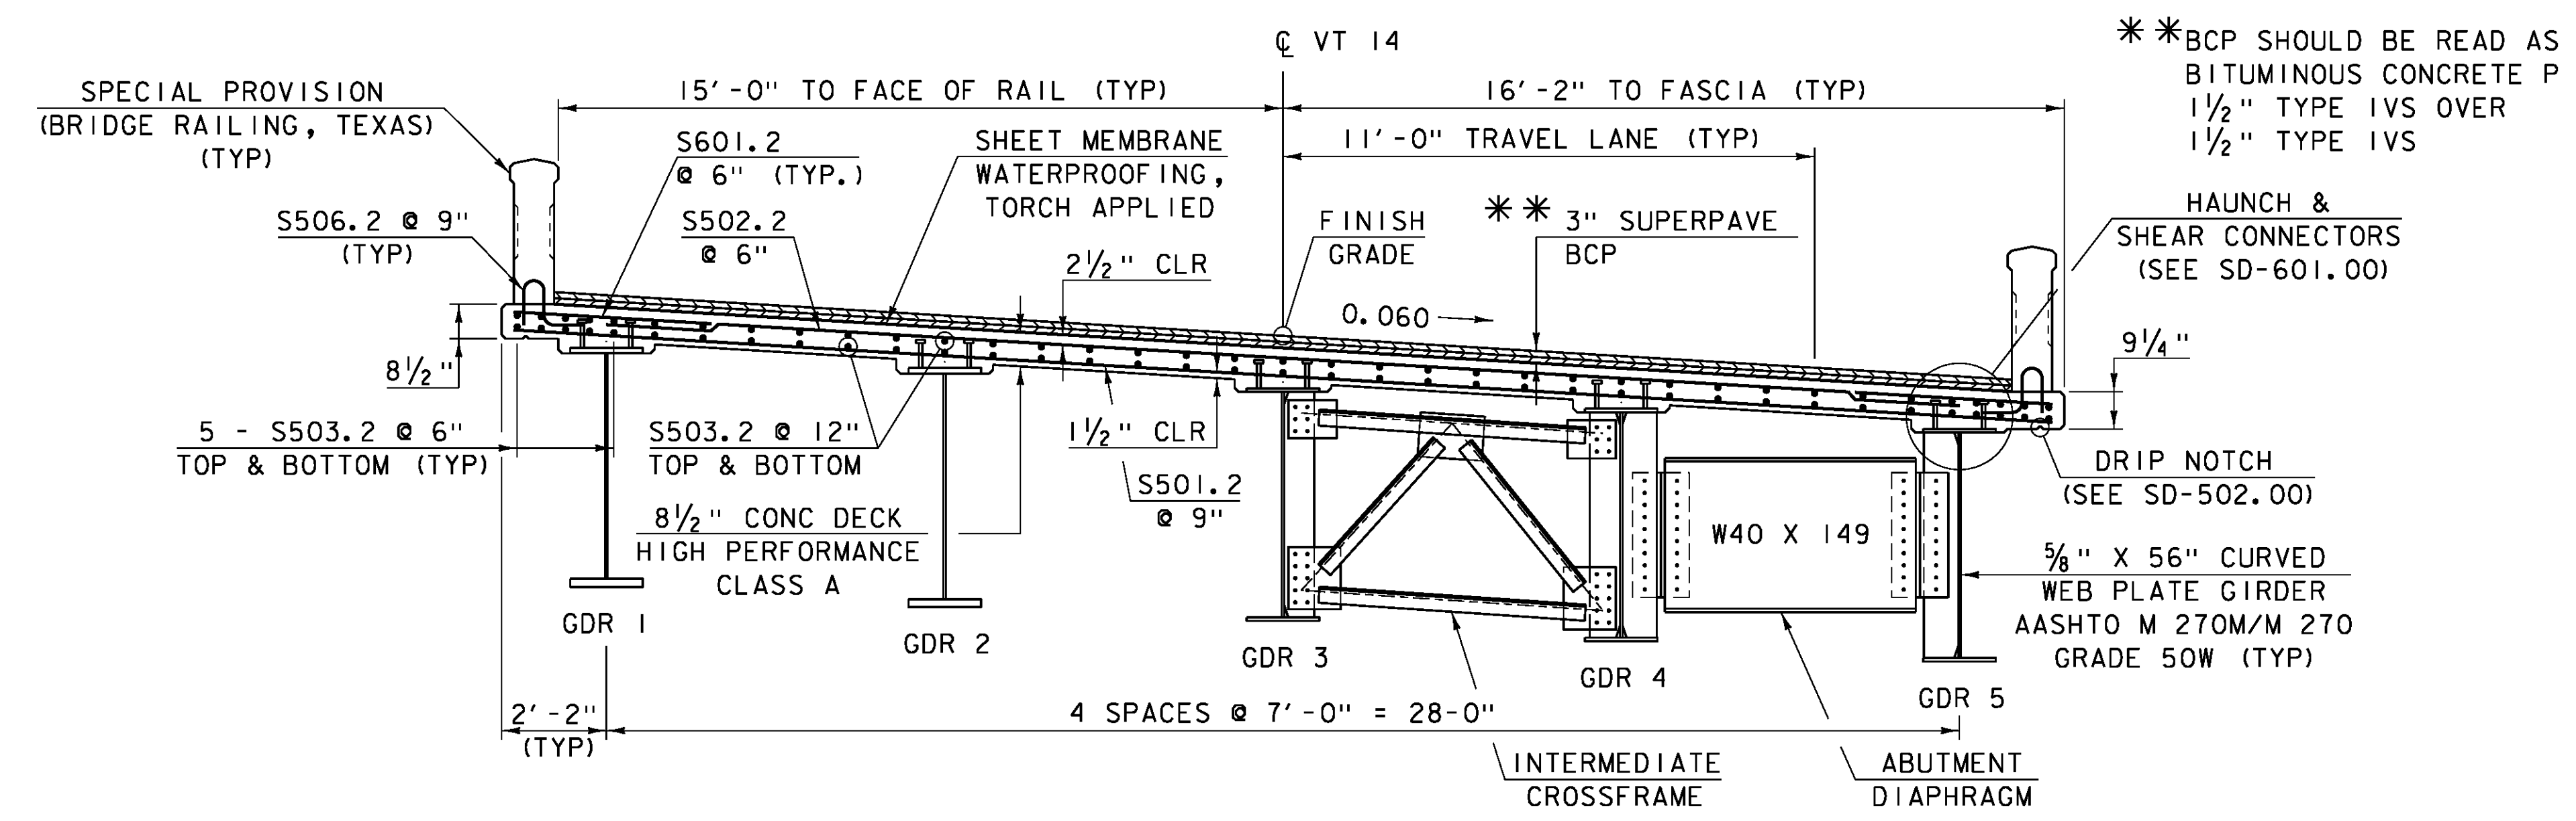

BRIDGE 28 TYPICAL SECTION
SCALE: 3/8" = 1'-0"

- NOTES:**
- ▲ = CUT TO FIT IN FIELD
 - 3" CLEAR, UNLESS OTHERWISE SPECIFIED ON THE PLANS.
 - 2'-2" BAR LAP UNLESS OTHERWISE SPECIFIED ON THE PLANS.

PROJECT NAME: ROYALTON	PLOT DATE: 08-OCT-2013
PROJECT NUMBER: BRS 0147 (13)	DRAWN BY: G. ROY
FILE NAME: \BR 28\86e055sup_28.dgn	CHECKED BY: D. PETERSON
PROJECT LEADER: C. CARLSON	SHEET 109 OF 186
DESIGNED BY: D. PETERSON	
BRIDGE 28 DECK REINFORCING DETAILS	