



APPROACH SLAB PLAN NO. 1 TYPICAL

SCALE 1/4" = 1'-0"

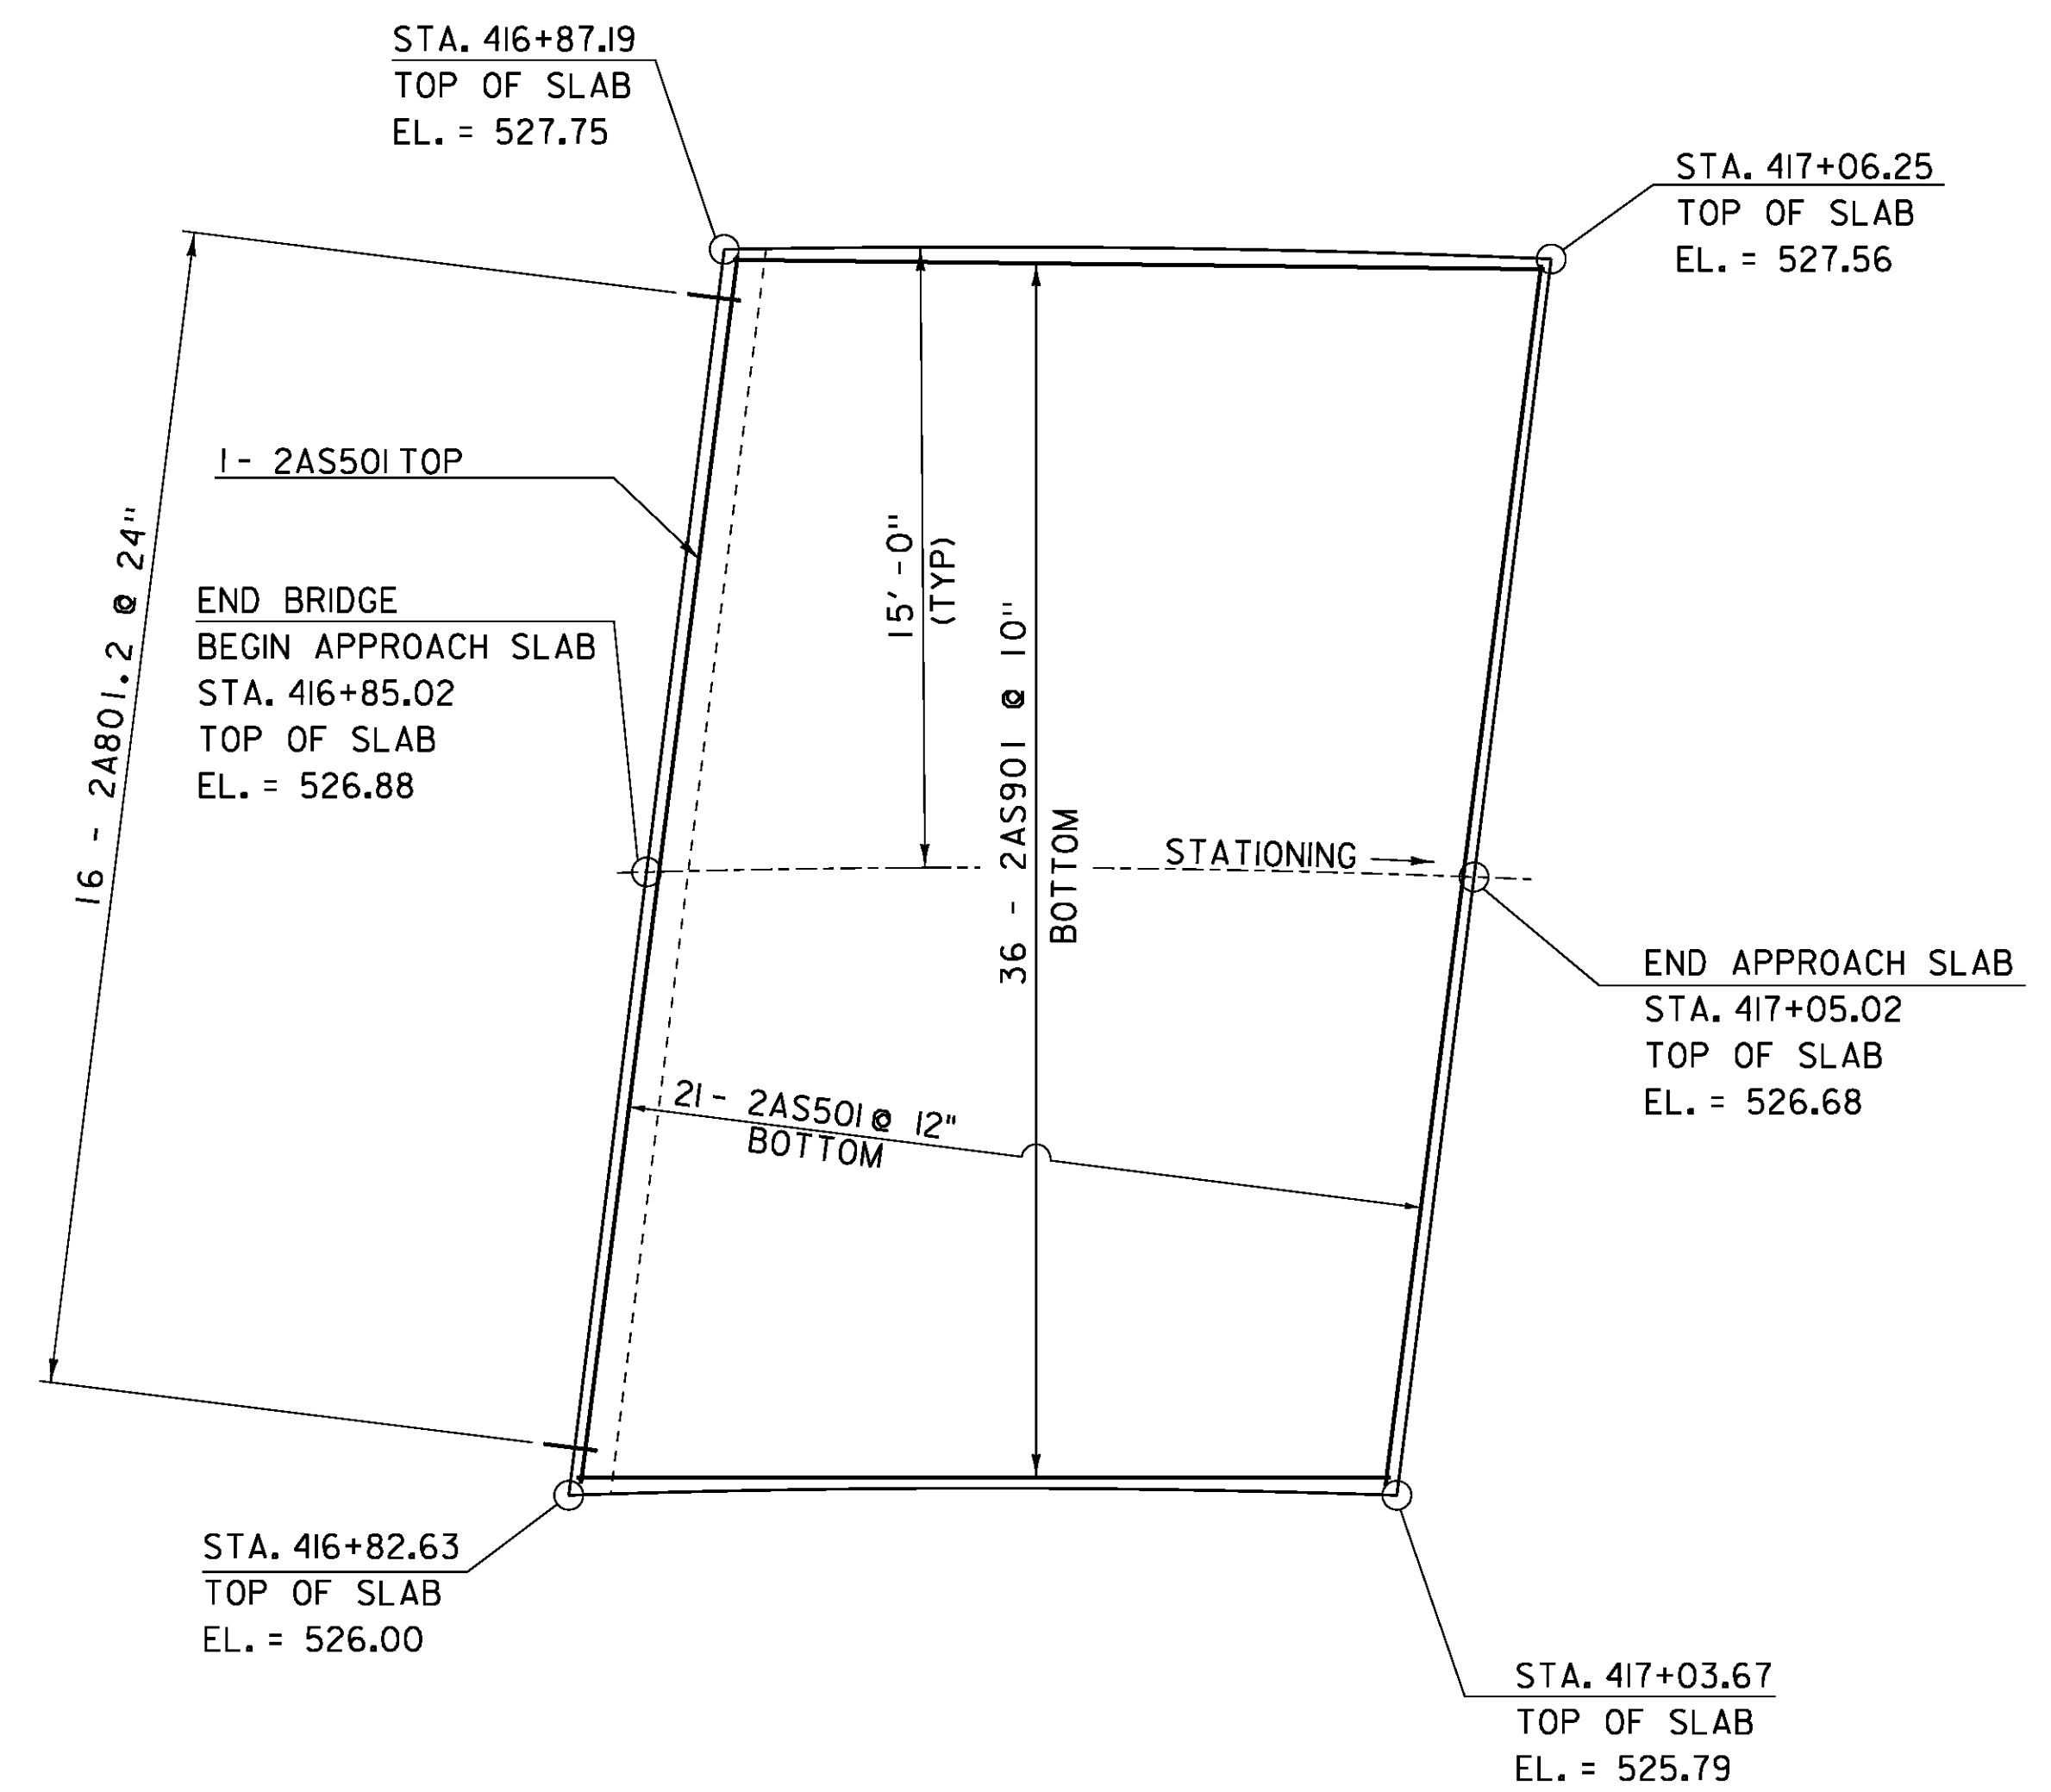


APPROACH SLAB PLAN NO. 2 TYPICAL

SCALE 1/4" = 1'-0"

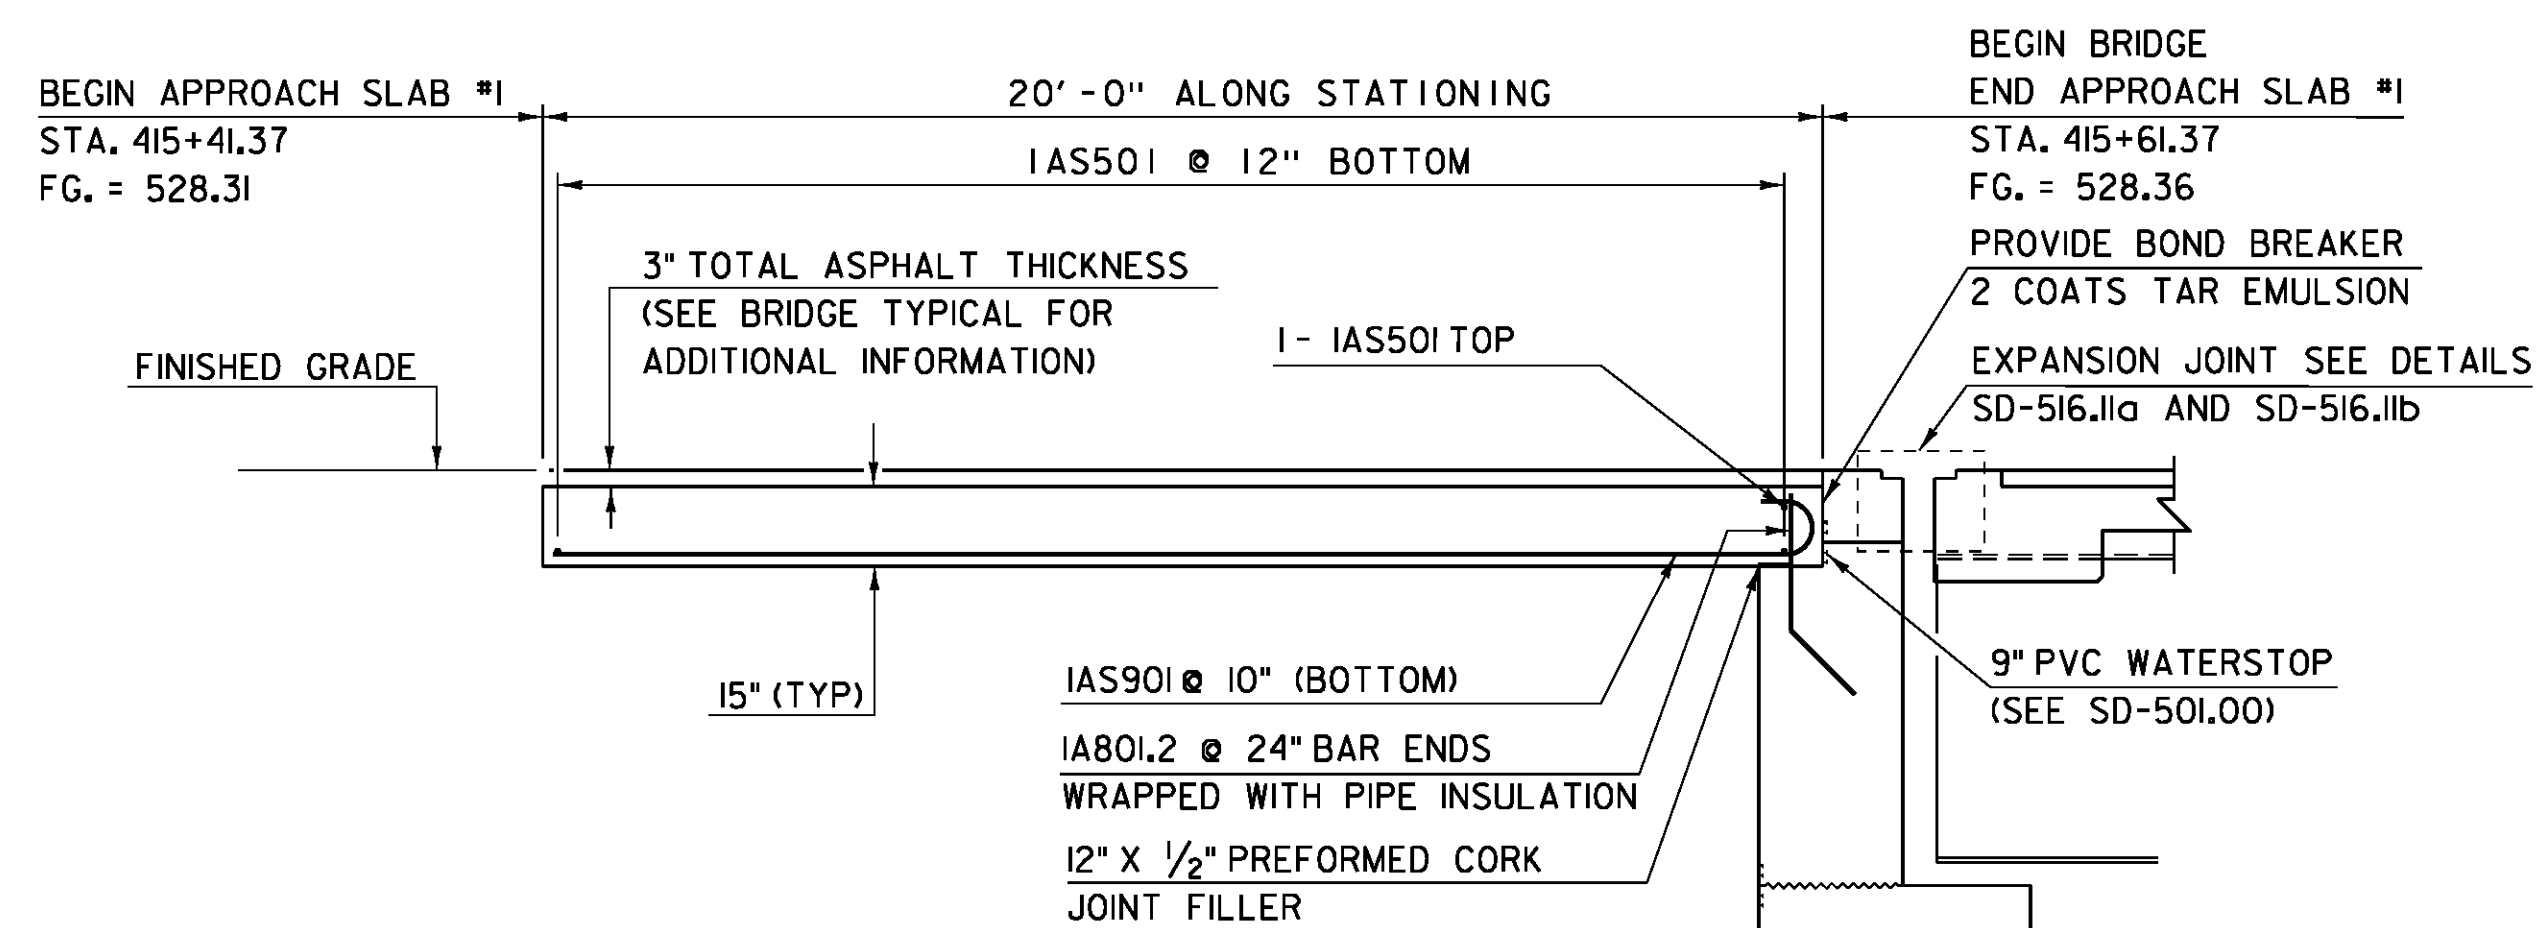

APPROACH SLAB NO. 1 TYPICAL

SCALE 1/4" = 1'-0"

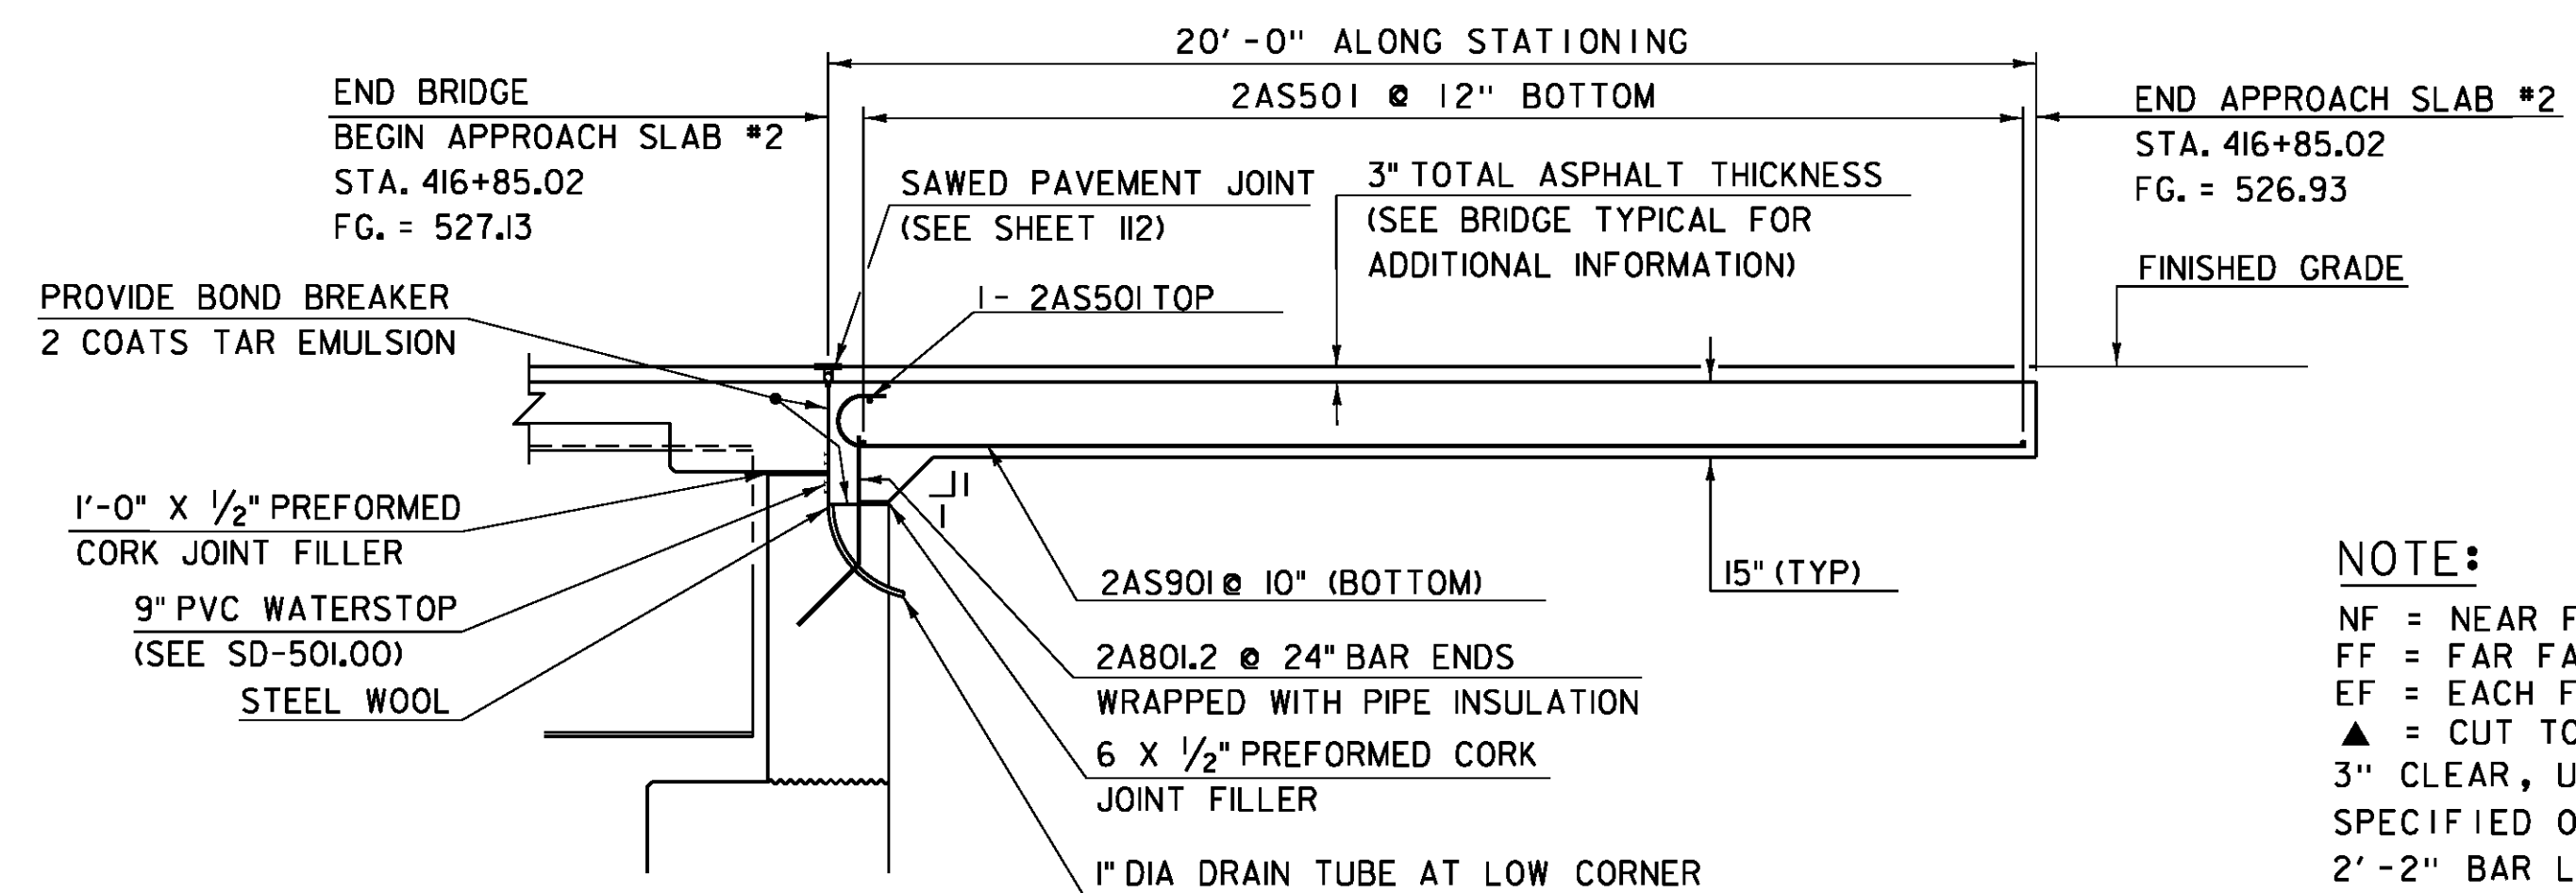

APPROACH SLAB NO. 2 TYPICAL

SCALE 1/4" = 1'-0"

NOTE:
 NF = NEAR FACE
 FF = FAR FACE
 EF = EACH FACE
 ▲ = CUT TO FIT IN FIELD
 3" CLEAR, UNLESS OTHERWISE SPECIFIED ON THE PLANS.
 2' - 2" BAR LAP UNLESS OTHERWISE SPECIFIED ON THE PLANS.

PROJECT NAME:	ROYALTON
PROJECT NUMBER:	BRS 0147 (13)
FILE NAME:	86e055/STR/86e055sub.dgn
PROJECT LEADER:	C.CARLSON
DESIGNED BY:	D.PETERSON
PLOT DATE:	08-OCT-2013
DRAWN BY:	G.ROKES
CHECKED BY:	D.PETERSON
BRIDGE 28 APPROACH SLAB 1 AND 2 TYPICALS SHEET 115 OF 186	