


ABUTMENT #2 BACK WALL ELEVATION

SCALE 3/8" = 1'-0"

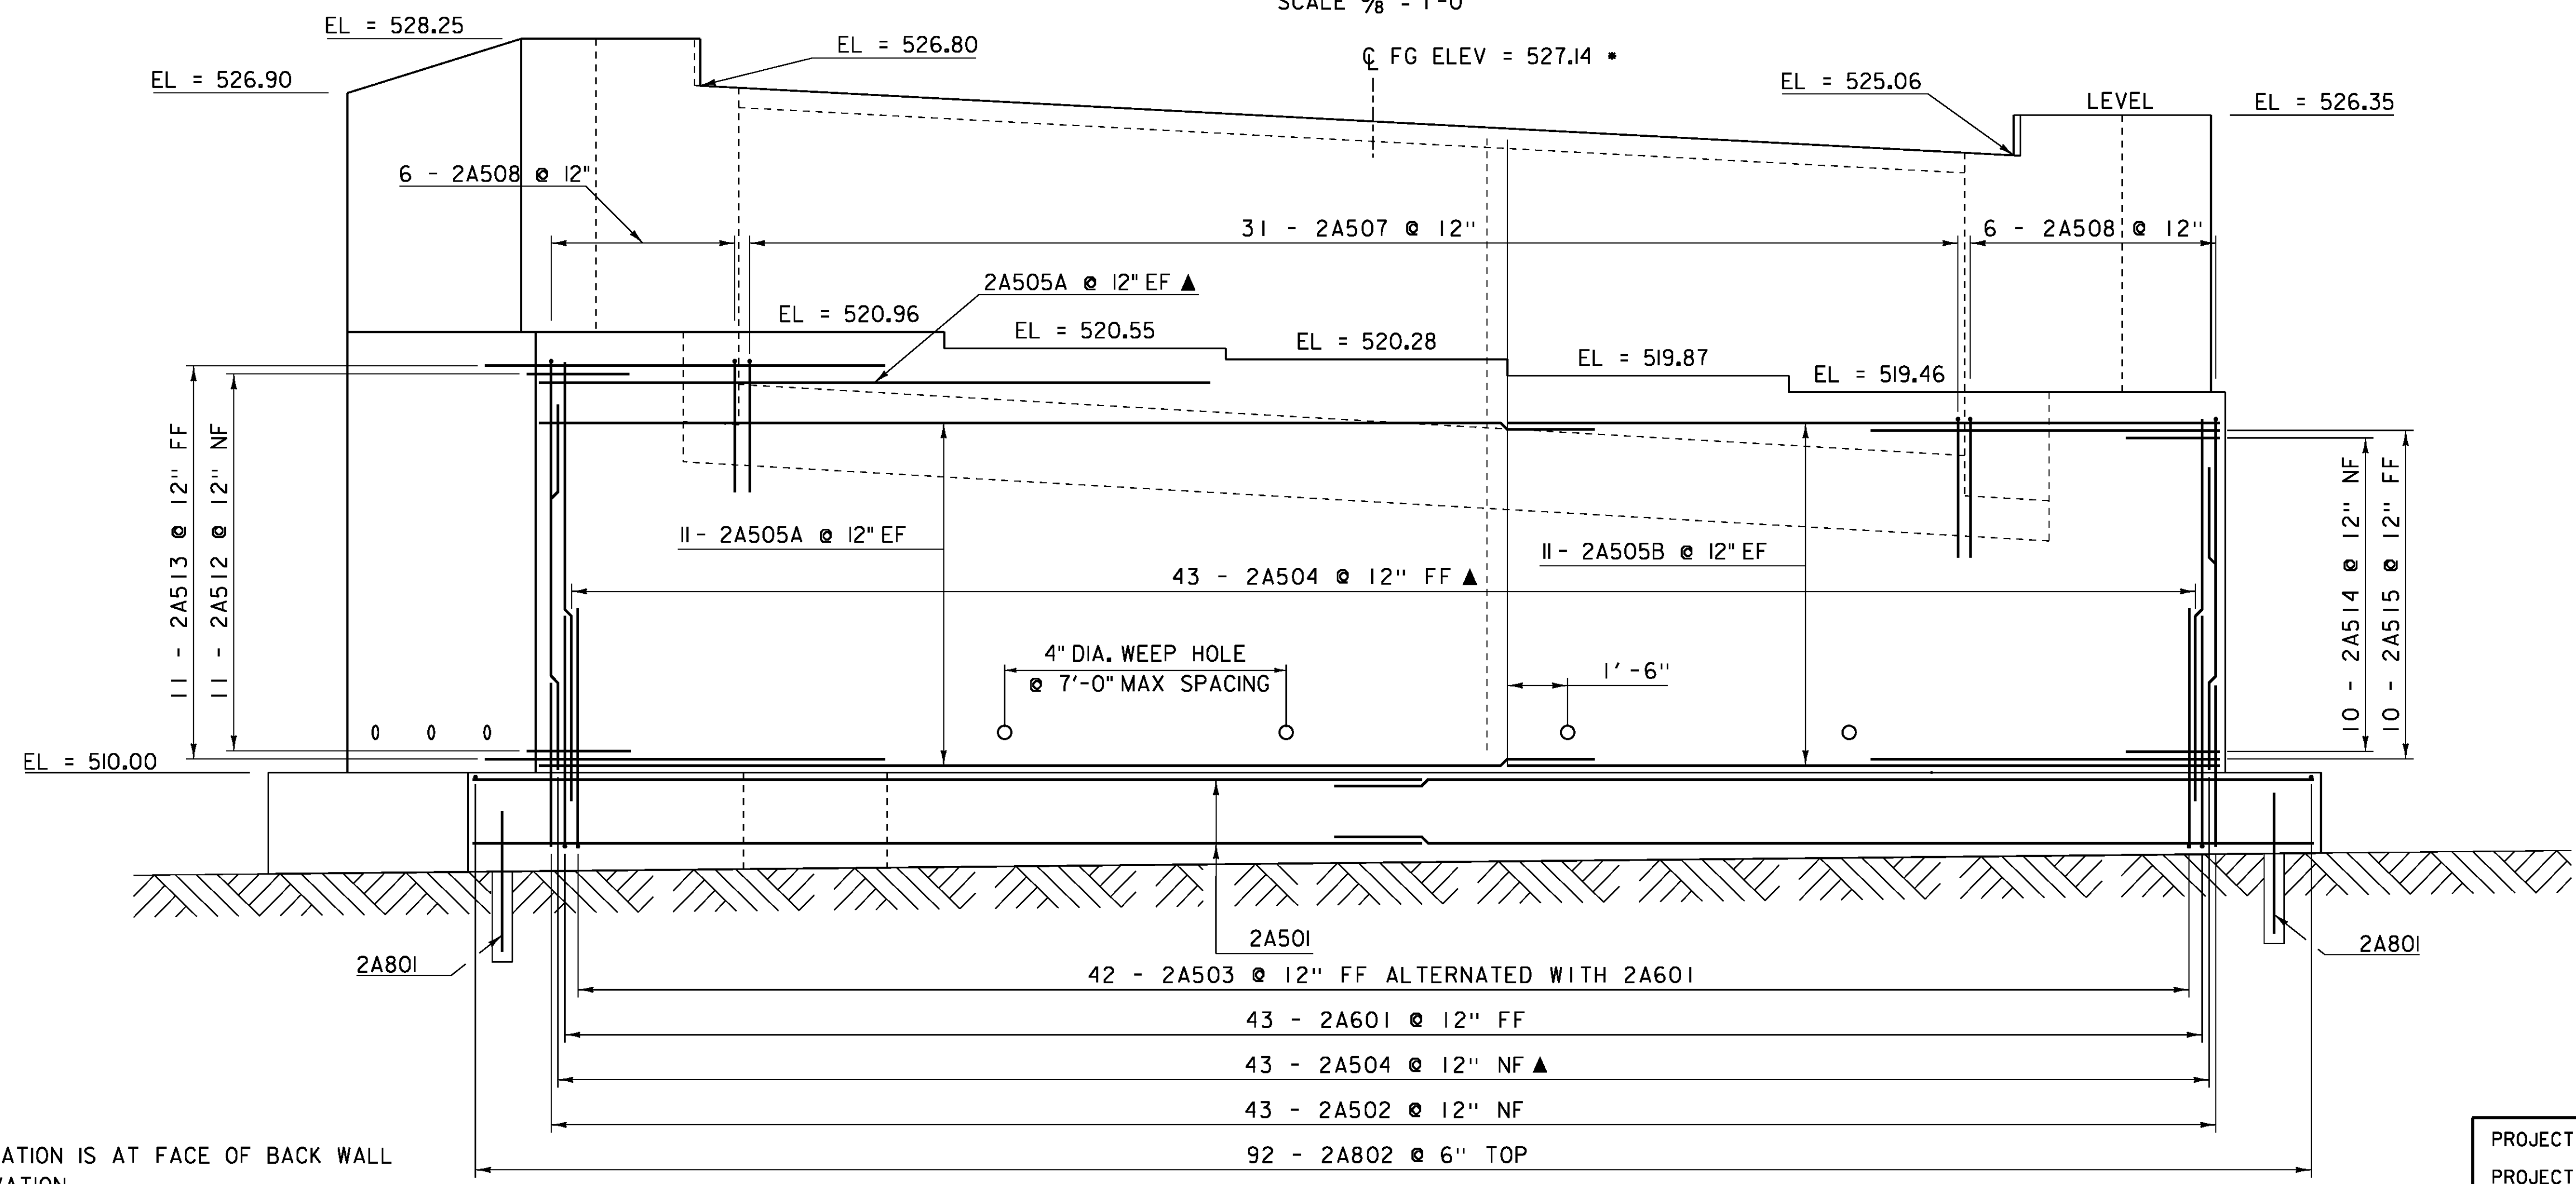

ABUTMENT #2 ELEVATION

SCALE 3/8" = 1'-0"

• STATION IS AT FACE OF BACK WALL ELEVATION

NOTE:
 NF = NEAR FACE
 FF = FAR FACE
 EF = EACH FACE
 ▲ = CUT TO FIT IN FIELD
 3" CLEAR, UNLESS OTHERWISE SPECIFIED ON THE PLANS.
 2'-2" BAR LAP UNLESS OTHERWISE SPECIFIED ON THE PLANS.

PROJECT NAME:	ROYALTON	PLOT DATE:	08-OCT-2013
PROJECT NUMBER:	BRS 0147 (13)	DRAWN BY:	G.ROKES
FILE NAME:	86e055/STR/86e055sub.dgn	CHECKED BY:	D.PETERSON
DESIGNED BY:	D.PETERSON	SHEET	126 OF 186
BRIDGE 28 ABUTMENT 2 ELEVATION			