



412+25

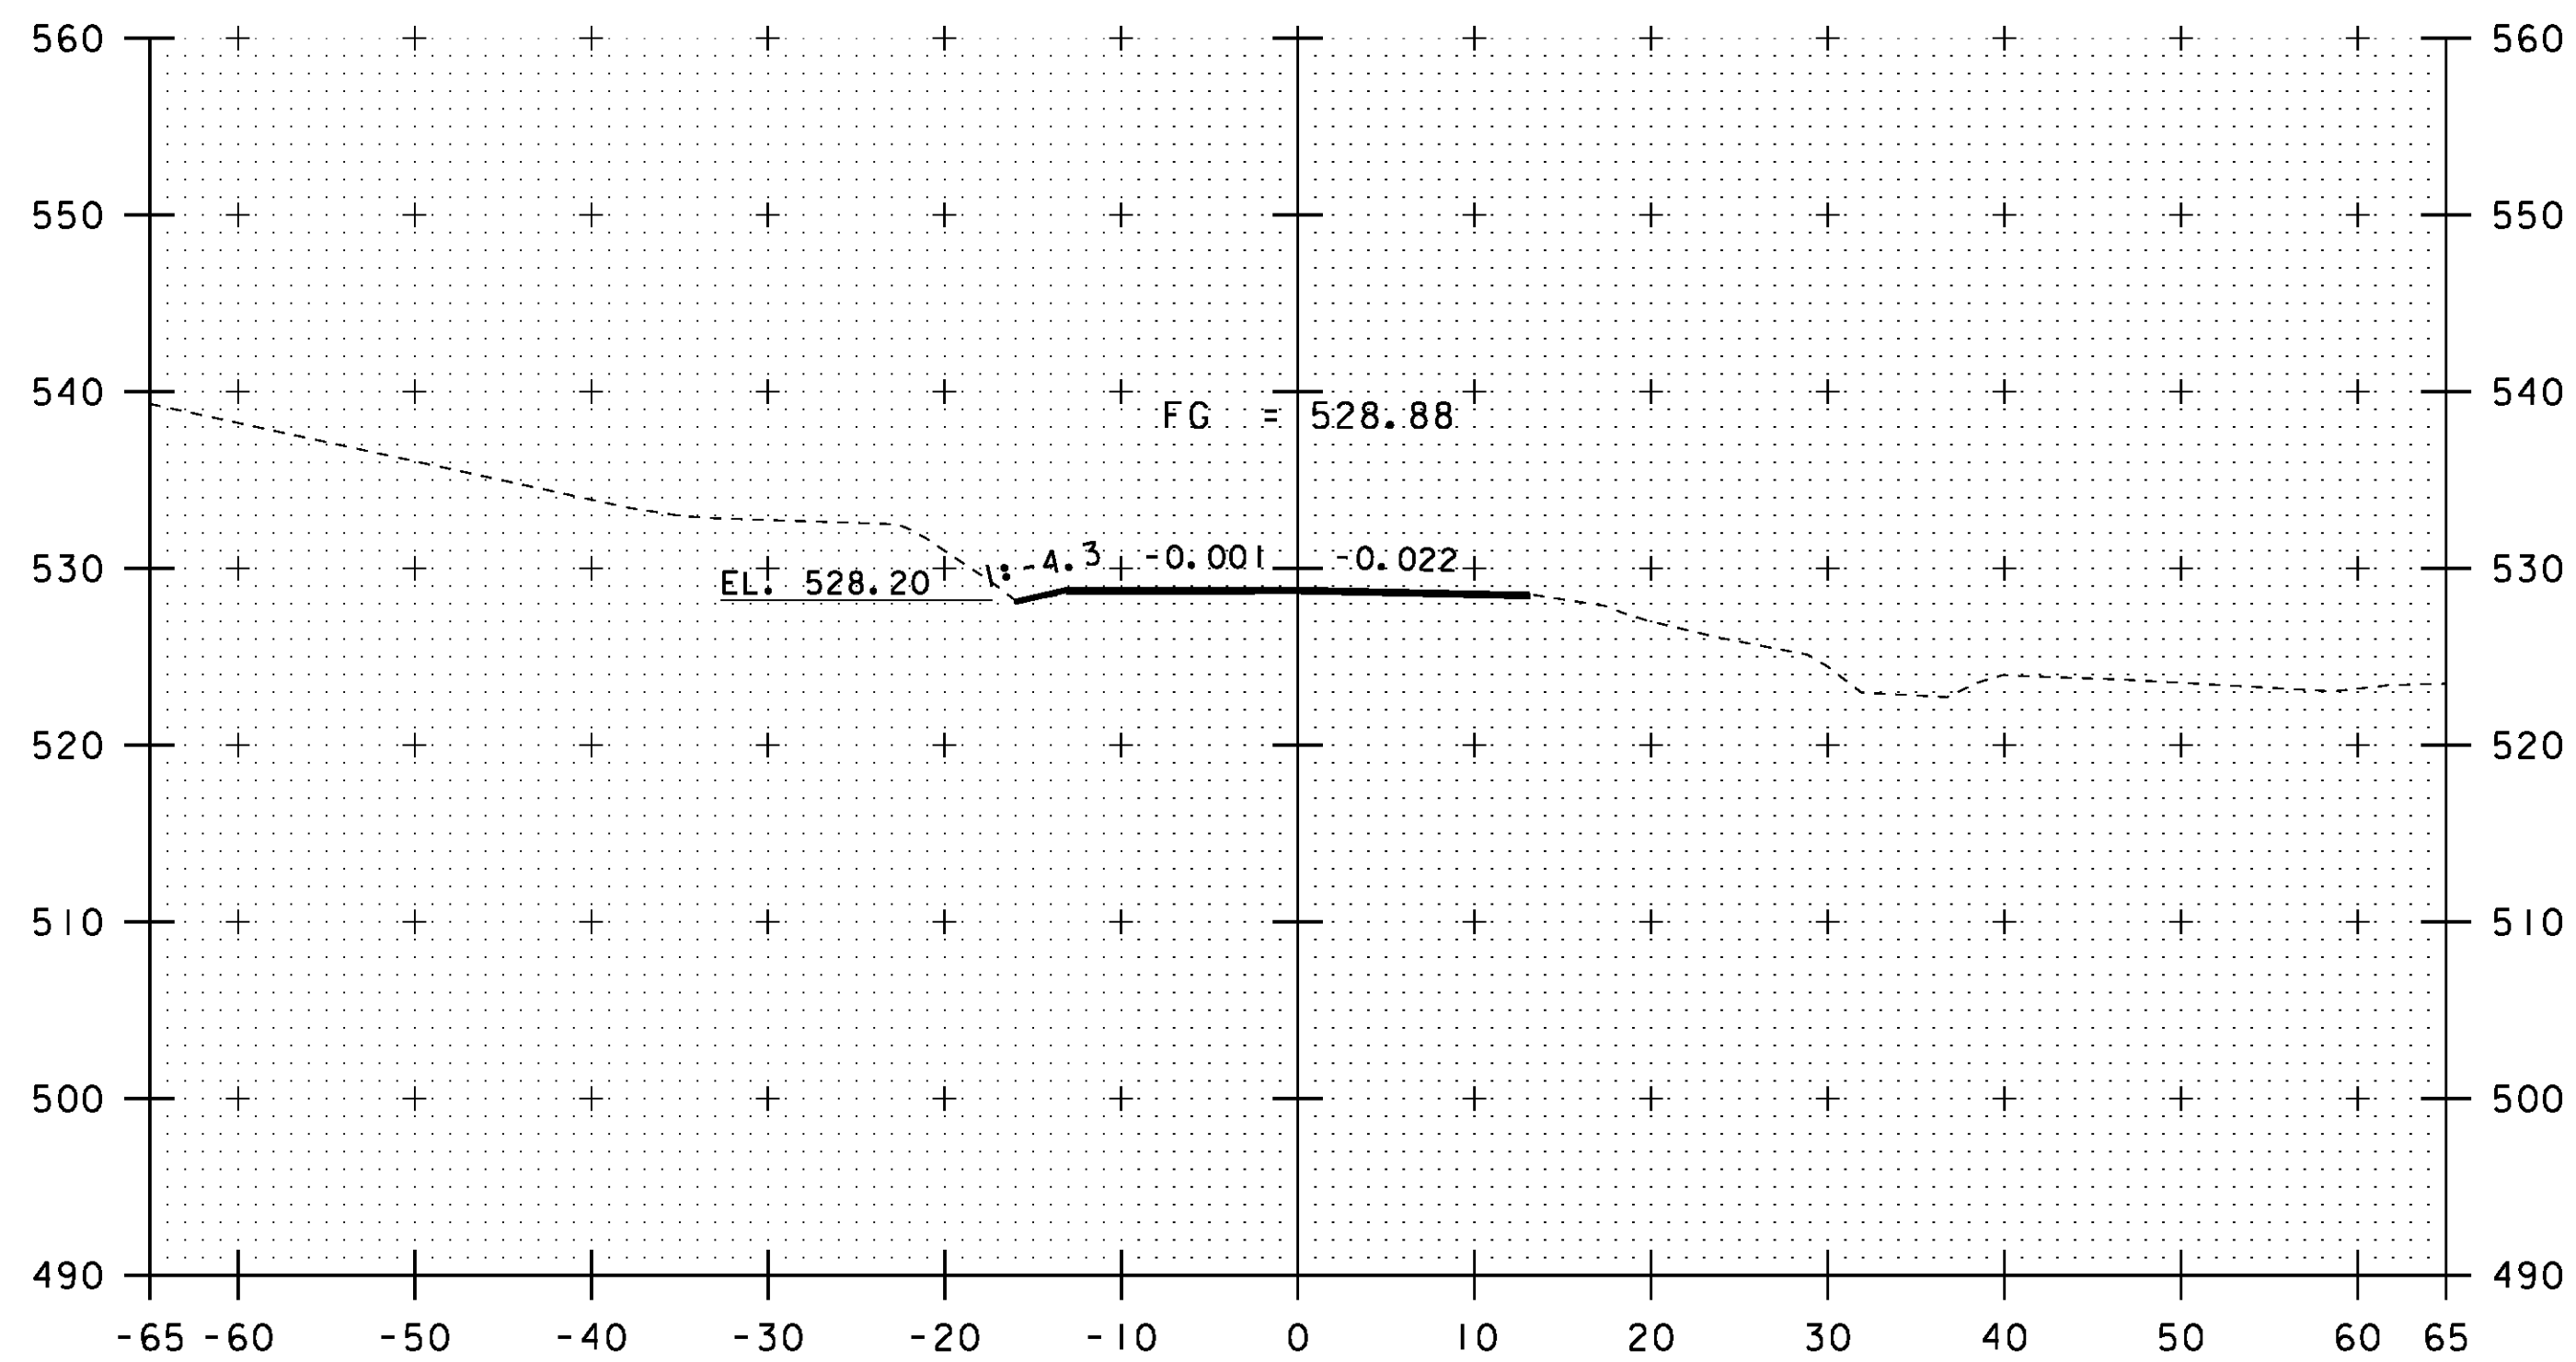


STA 412+75.00 LT. - TH #22 STA 31+40 LT  
CONSTRUCT GRASS-LINED DITCH

412+75

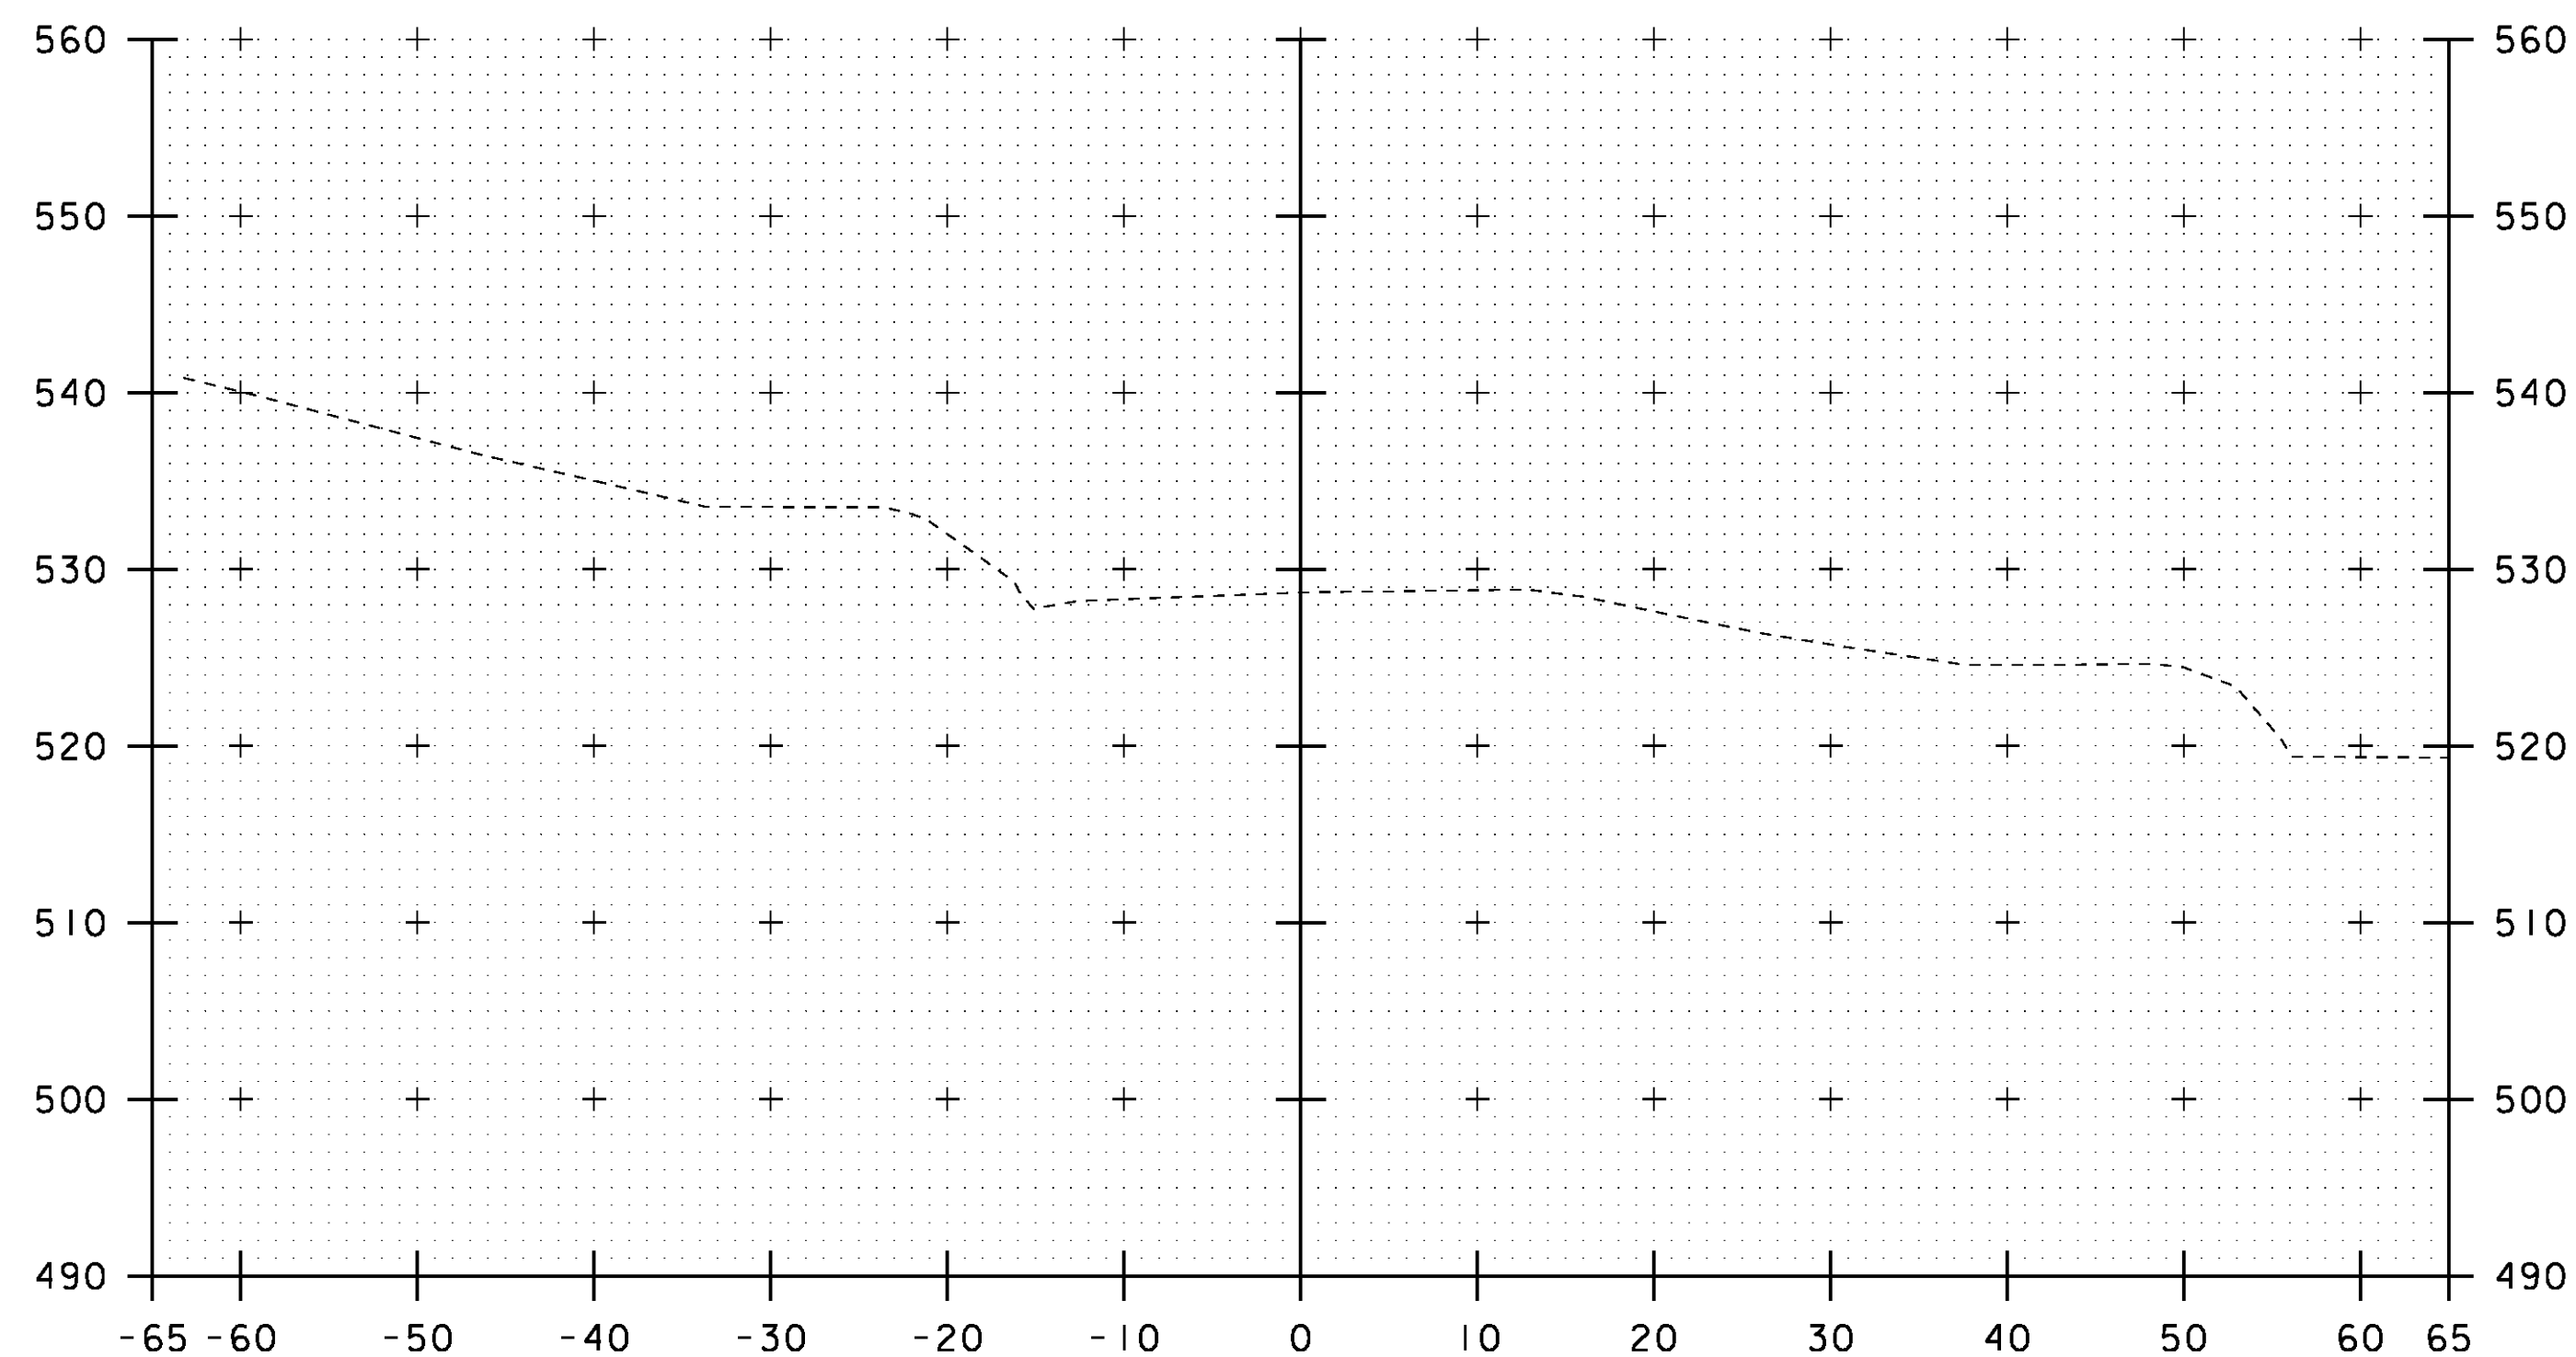


412+00

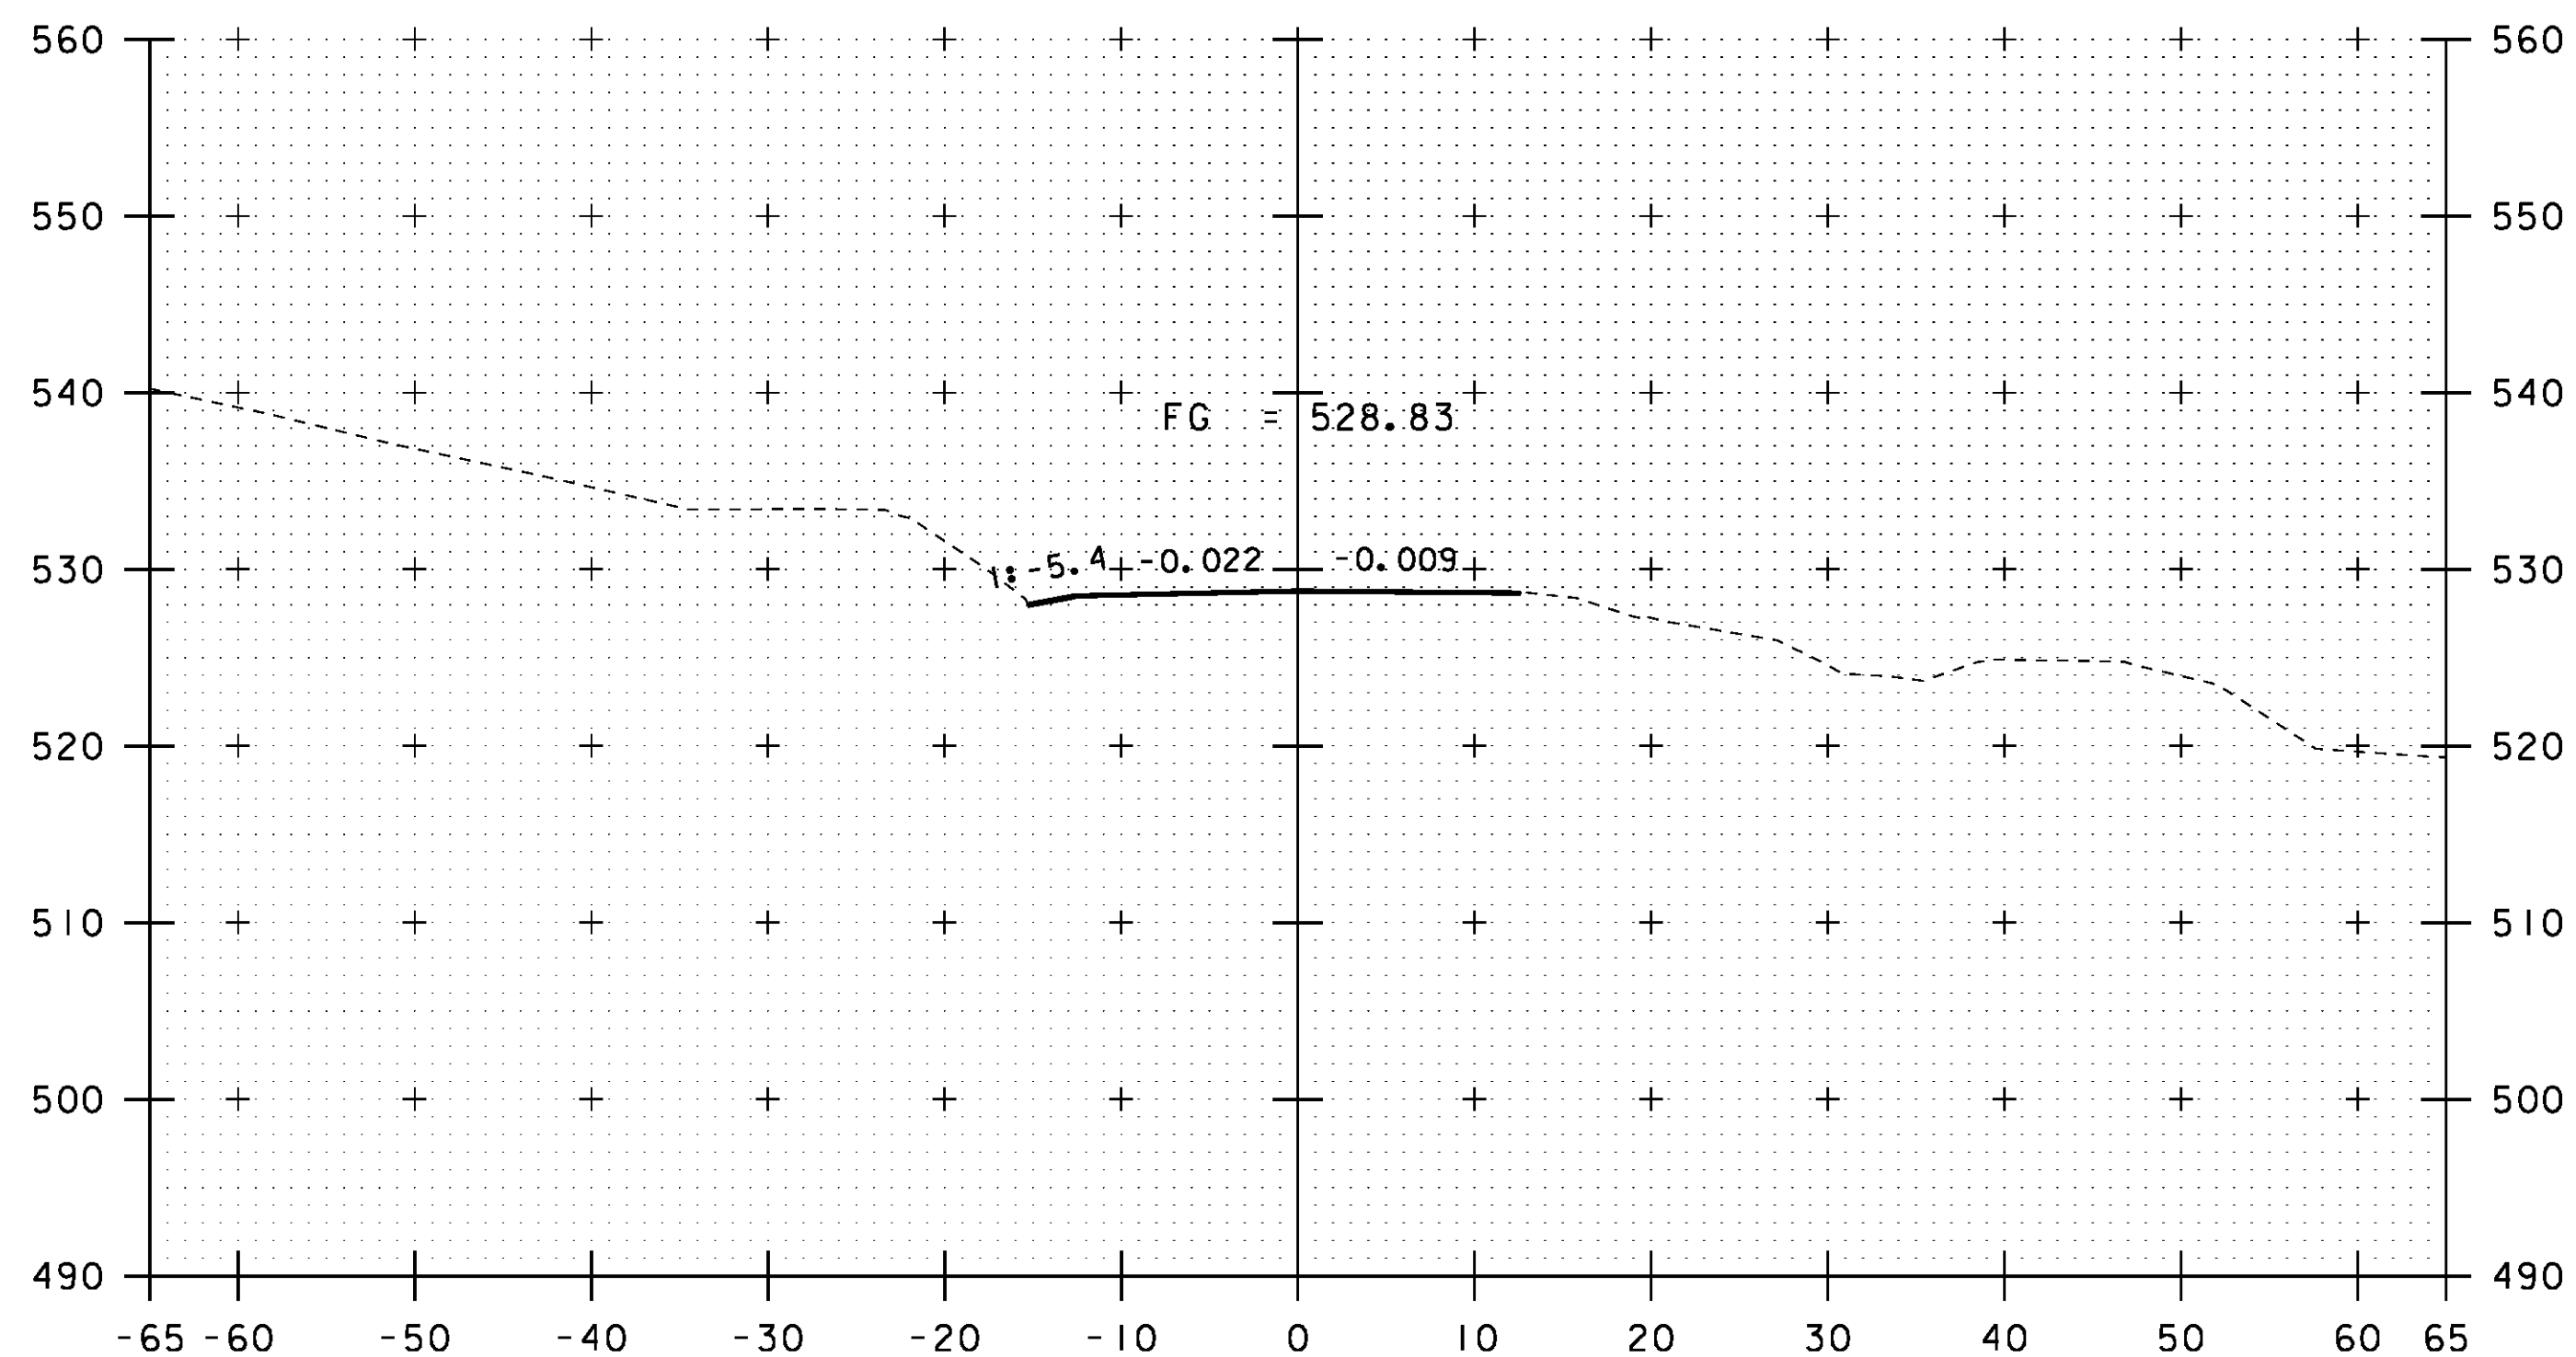

412+50

BEGIN APPROACH  
MATCH EXISTING

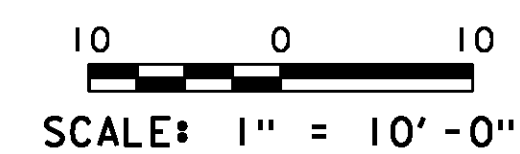

STA. 412+00 TO STA. 412+75

PROJECT NAME: ROYALTON  
PROJECT NUMBER: BRS 0147 (13)

FILE NAME: \BR\_28\s86e055xsl\_28.dgn  
PROJECT LEADER: C. CARLSON  
DESIGNED BY: D. PETERSON  
BRIDGE 28 VT 14 CROSS SECTIONS (1)

PLOT DATE: 08-OCT-2013  
DRAWN BY: STR3  
CHECKED BY: C. CARLSON  
SHEET 137 OF 186