


413+25

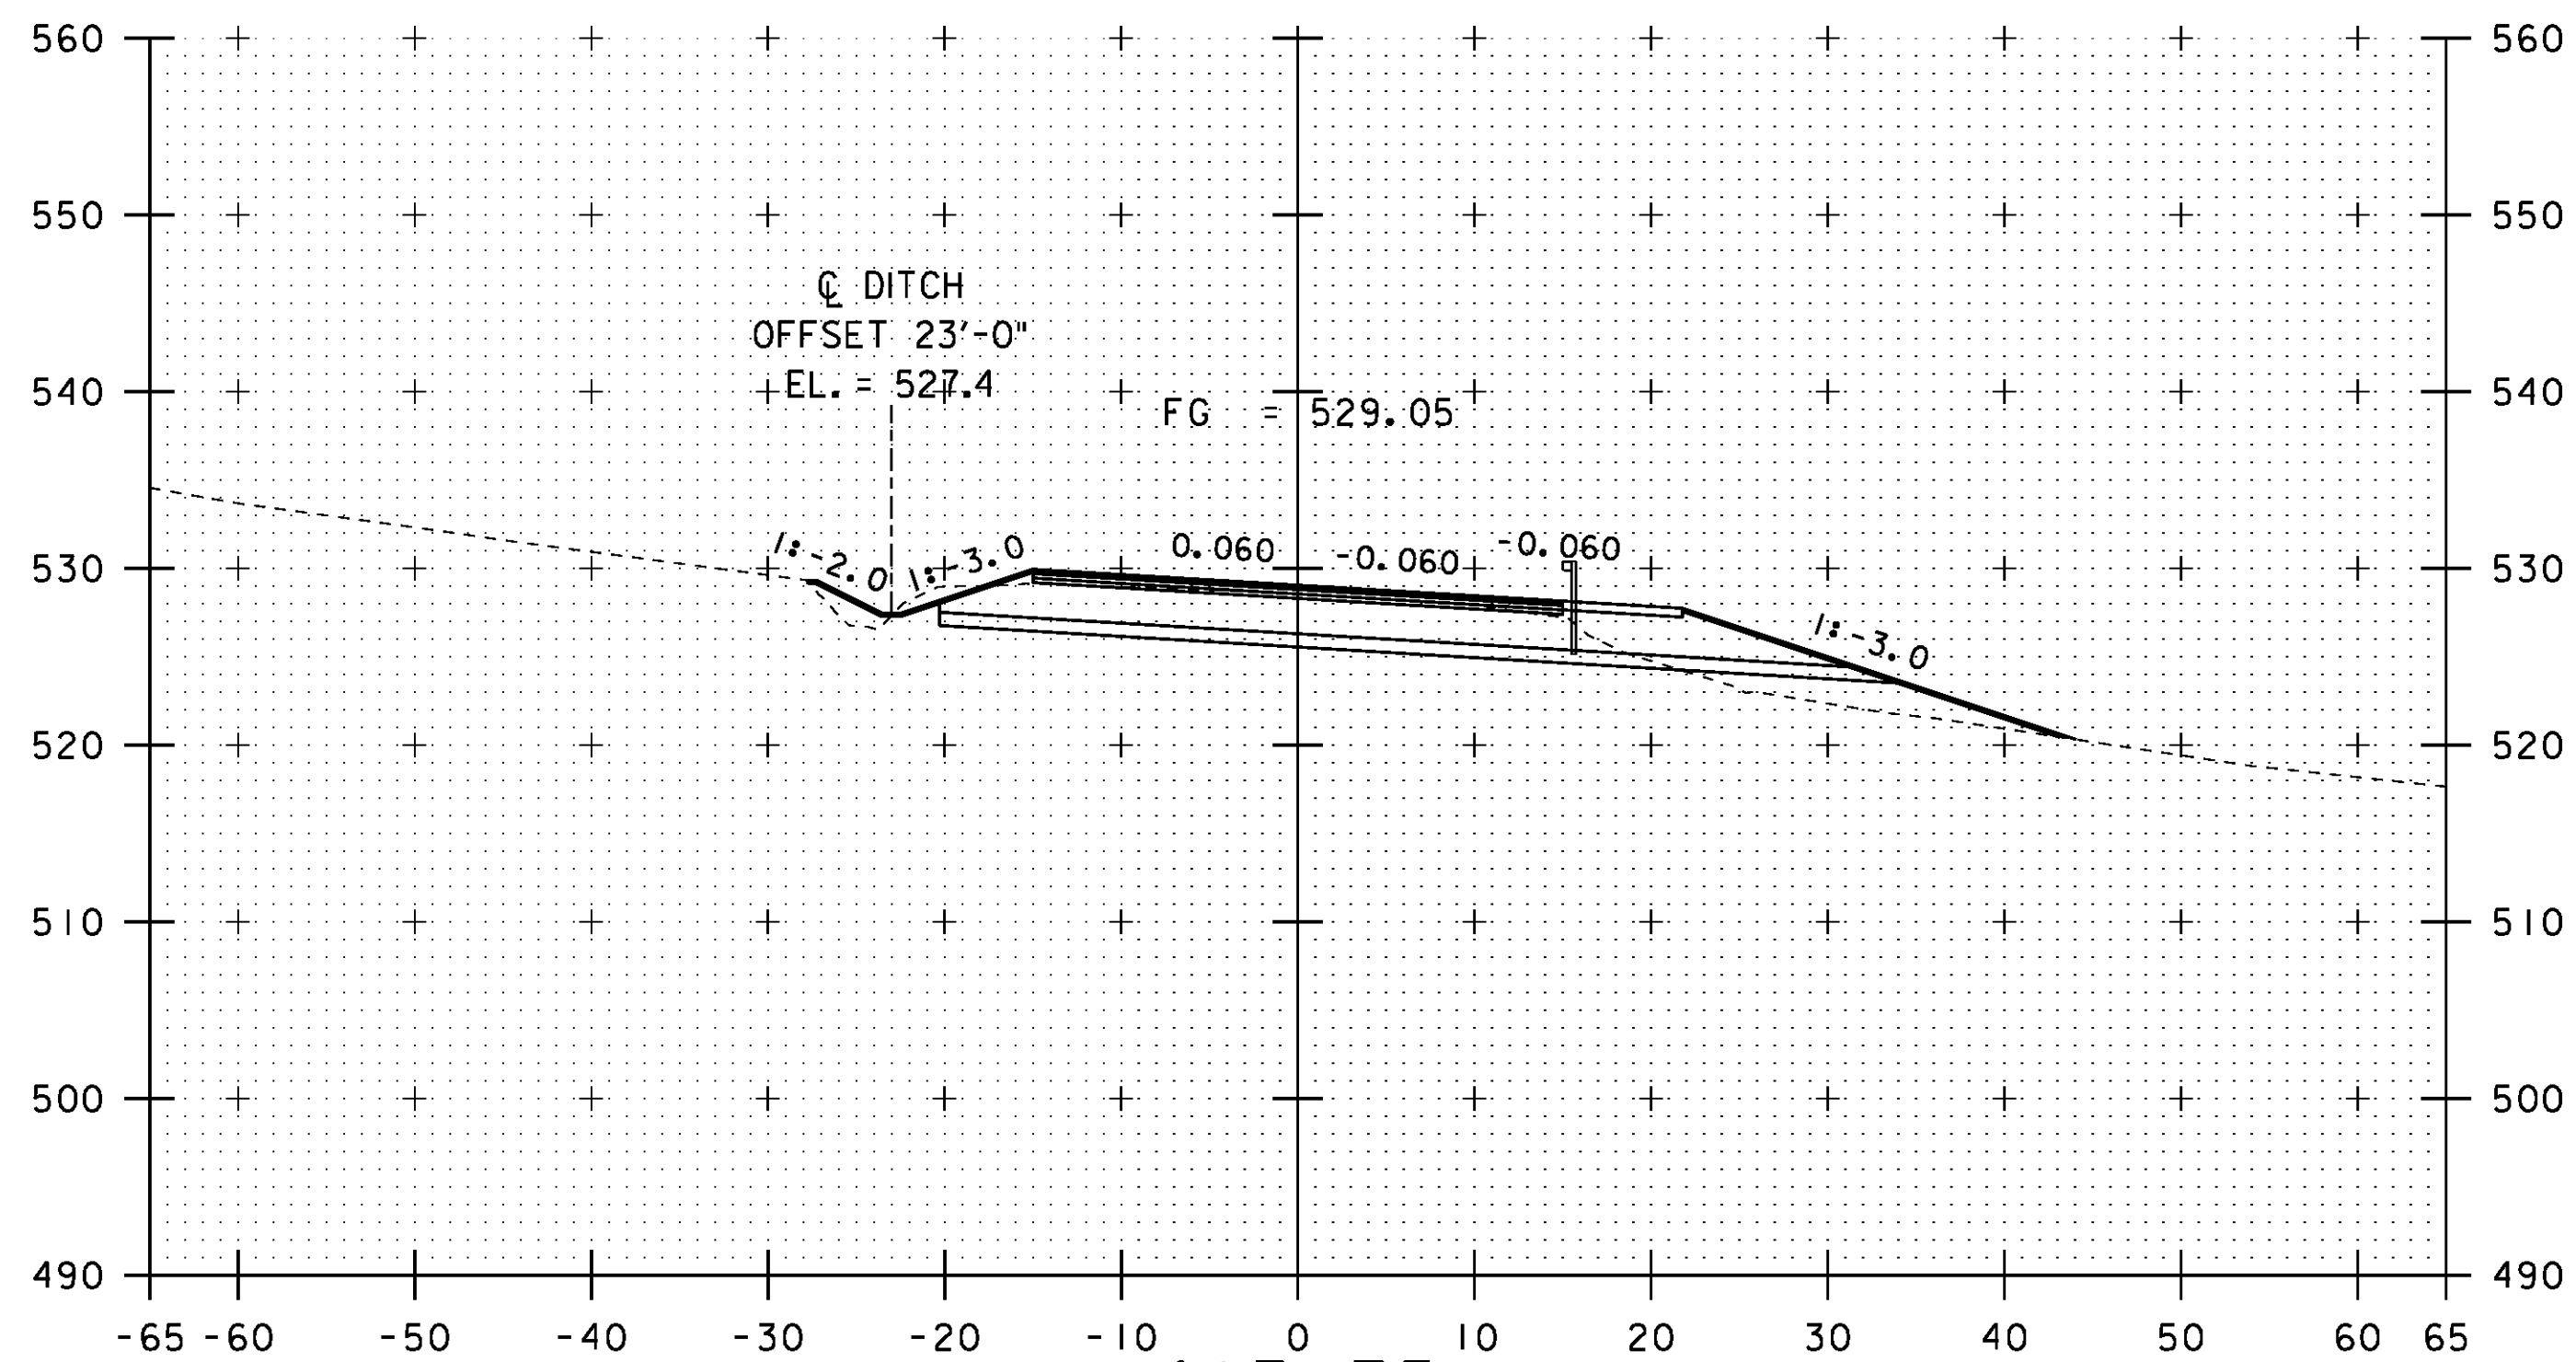


413+75


413+70.00

END APPROACH  
RESUME FULL DEPTH ROADWAY

STA 413+65.00 C/L  
REMOVE EXISTING 18" CGMP

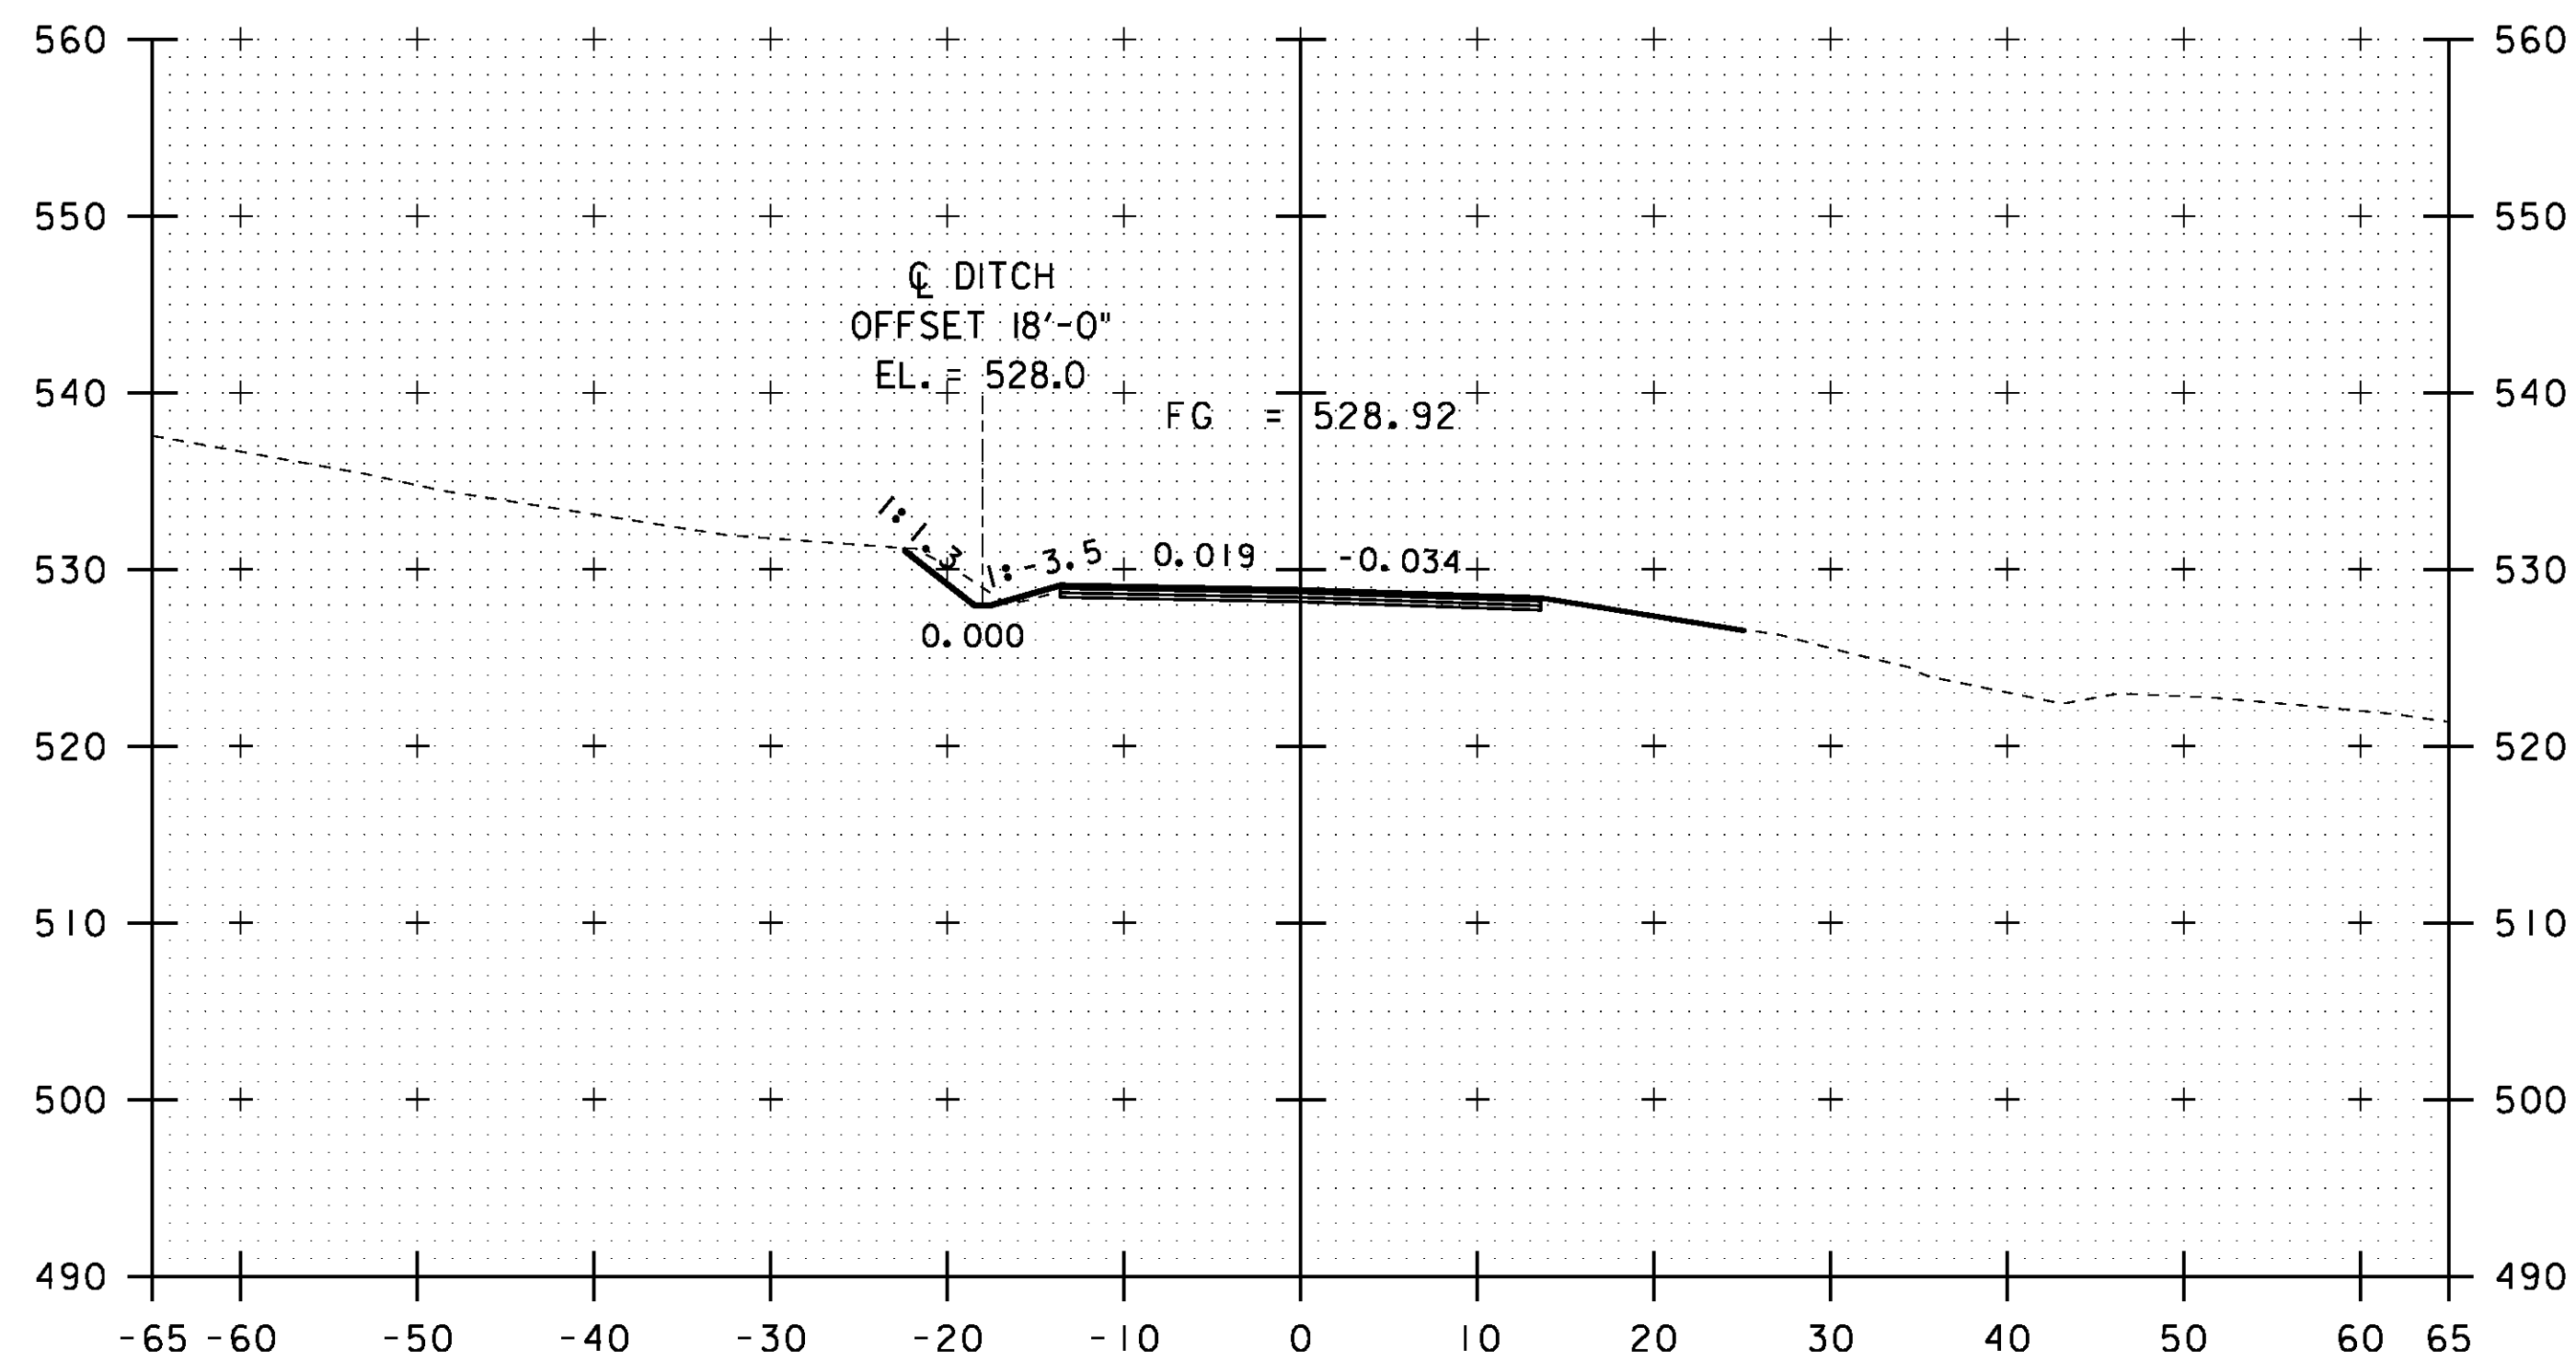

413+00

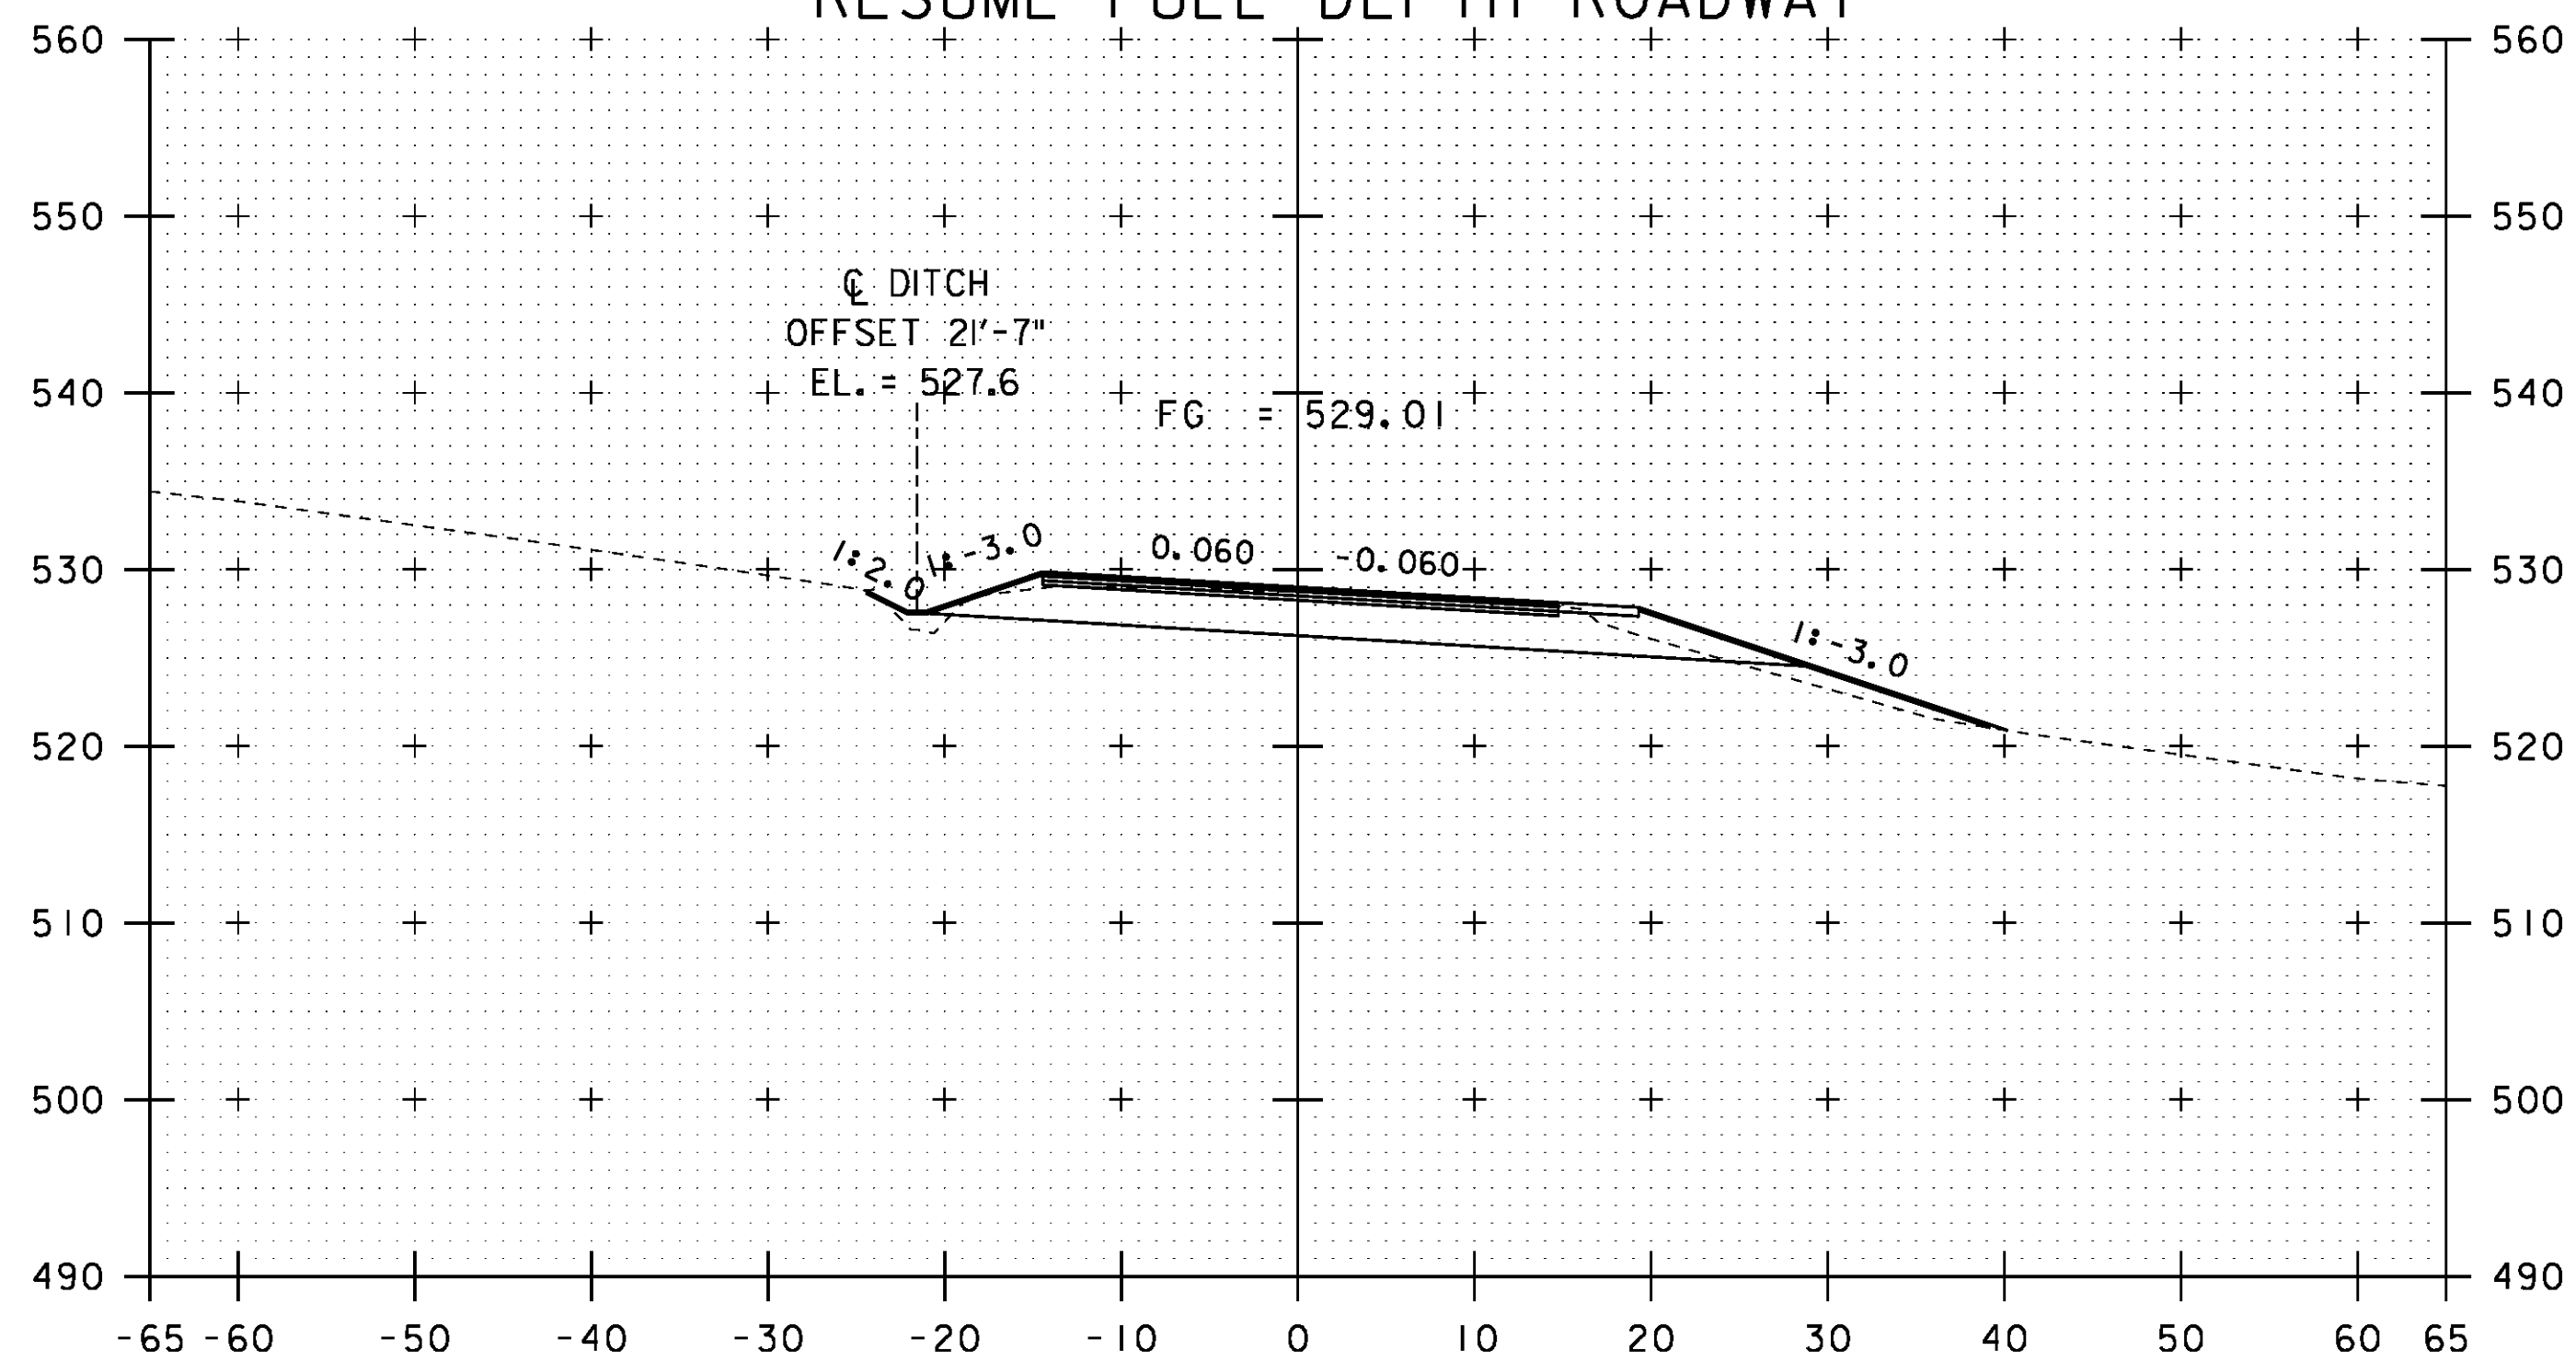

413+50

10 0 10  
SCALE: 1" = 10'-0"

STA. 413+00 TO STA. 413+75

PROJECT NAME: ROYALTON  
PROJECT NUMBER: BRS 0147 (13)

FILE NAME: \BR\_28\86e055xsl\_28.dgn  
PROJECT LEADER: C. CARLSON  
DESIGNED BY: D. PETERSON  
BRIDGE 28 VT 14 CROSS SECTIONS (2)

PLOT DATE: 08-OCT-2013  
DRAWN BY: STR3  
CHECKED BY: C. CARLSON  
SHEET 138 OF 186