




417+25

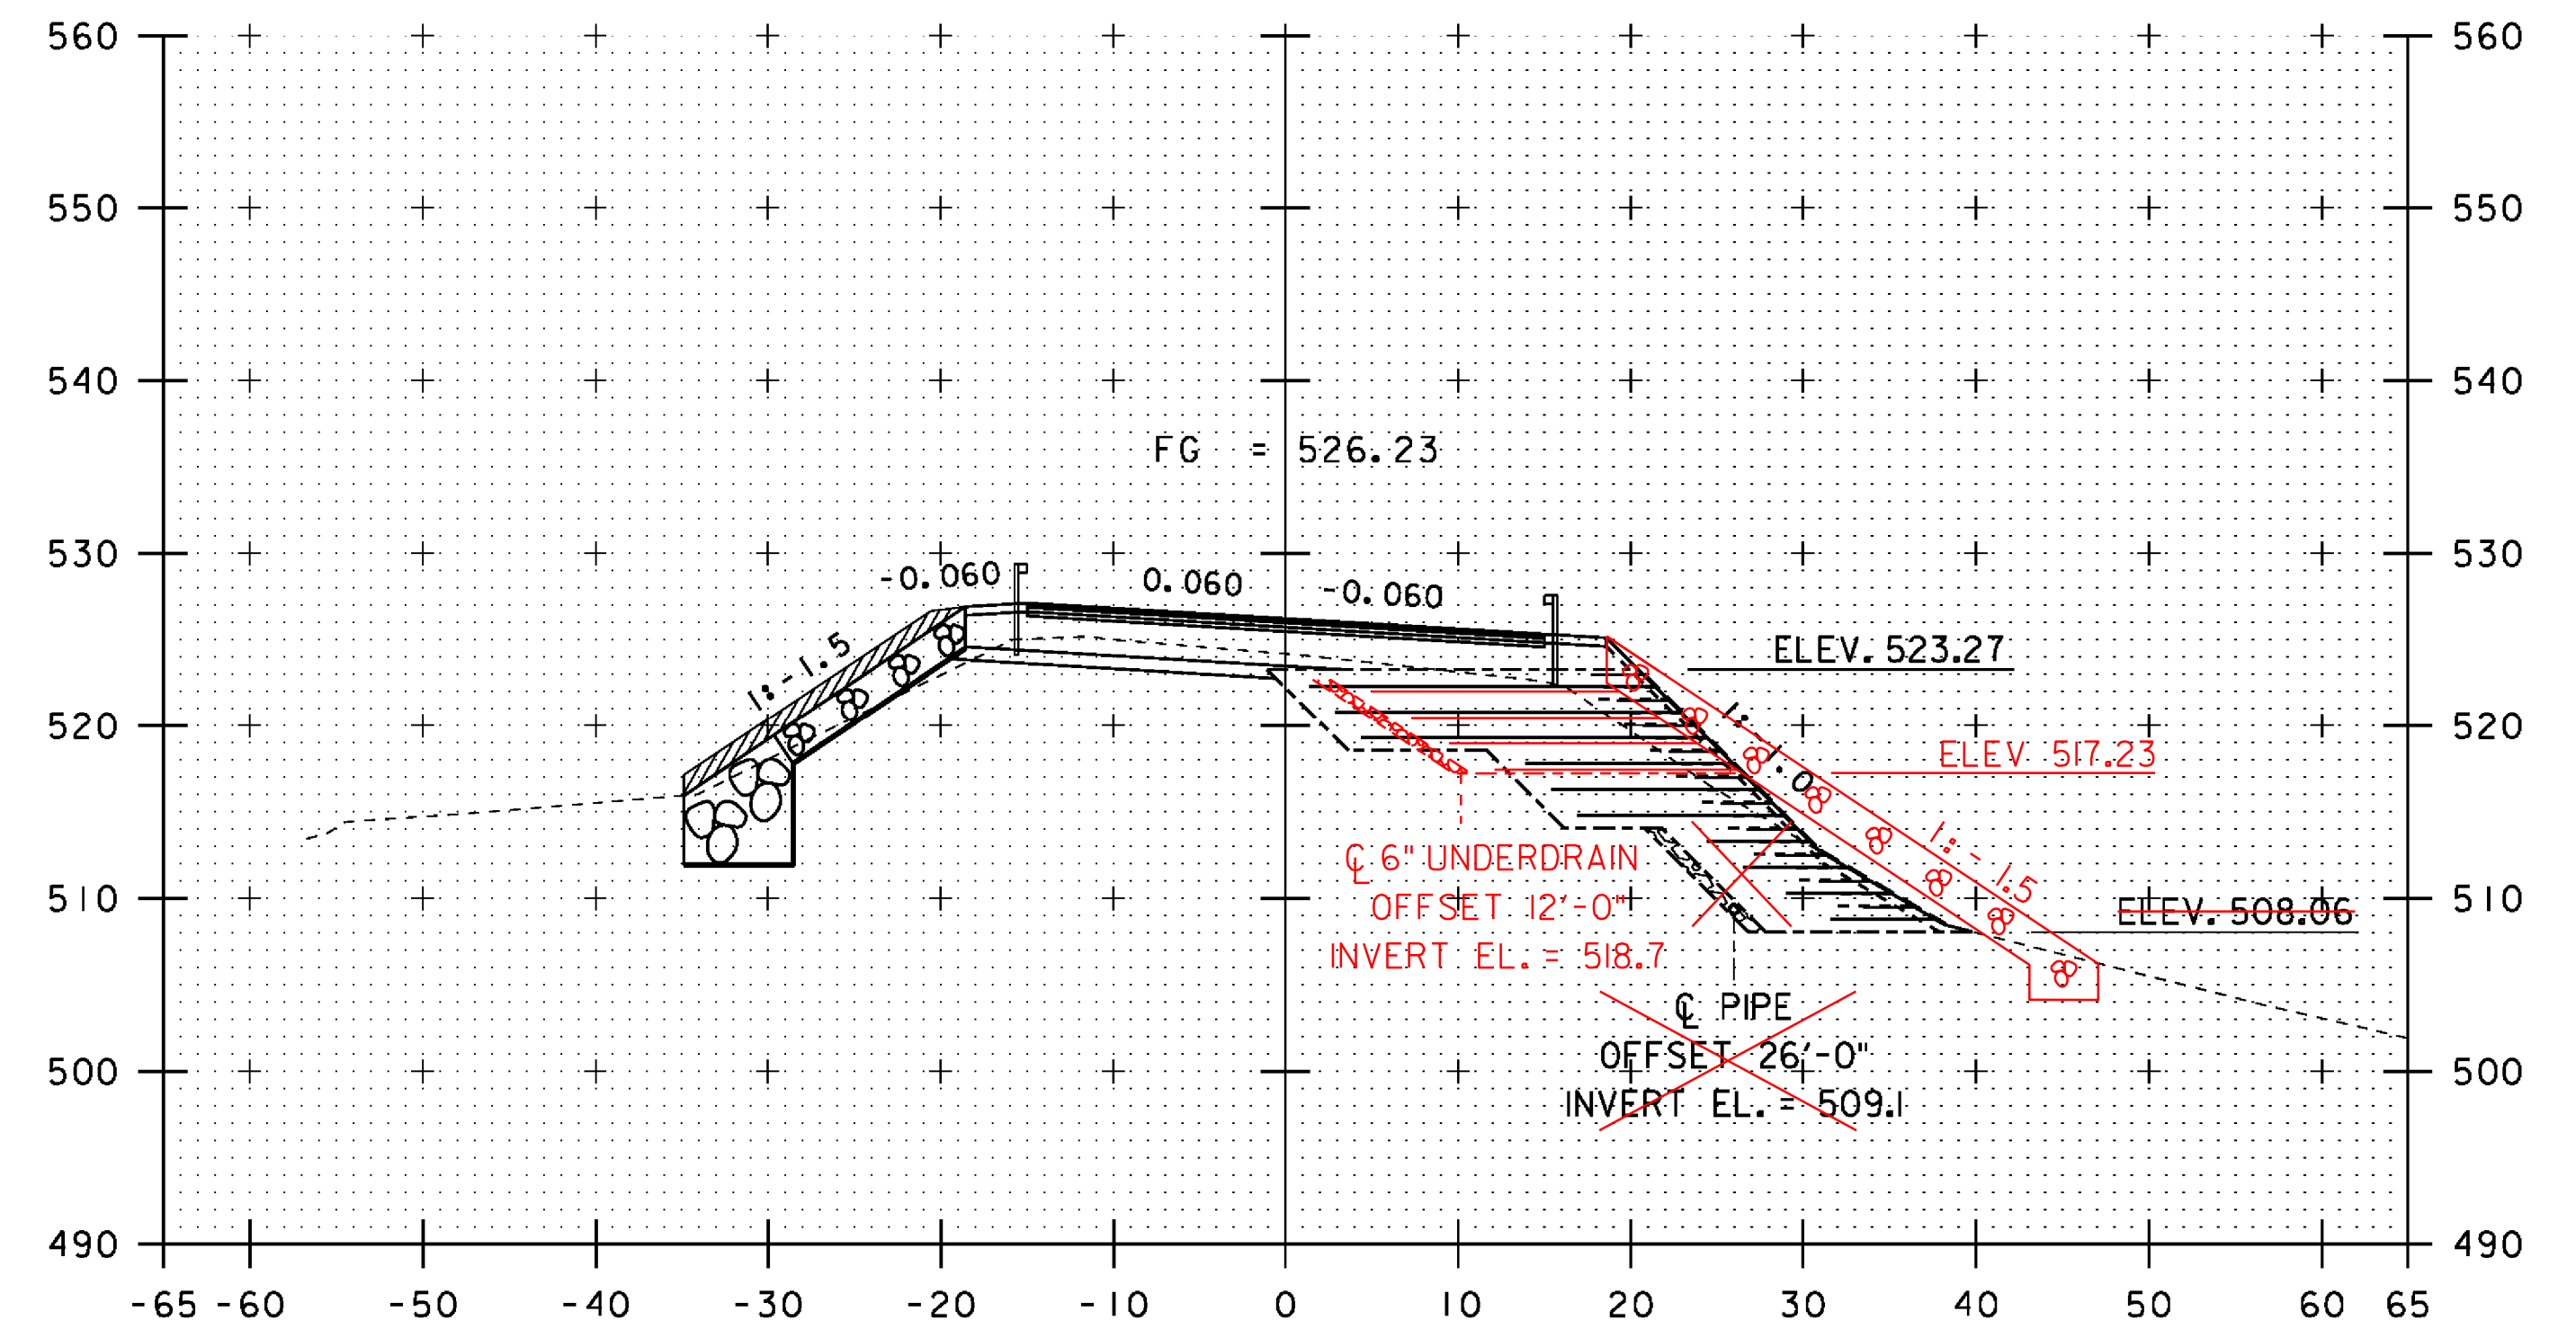

417+75

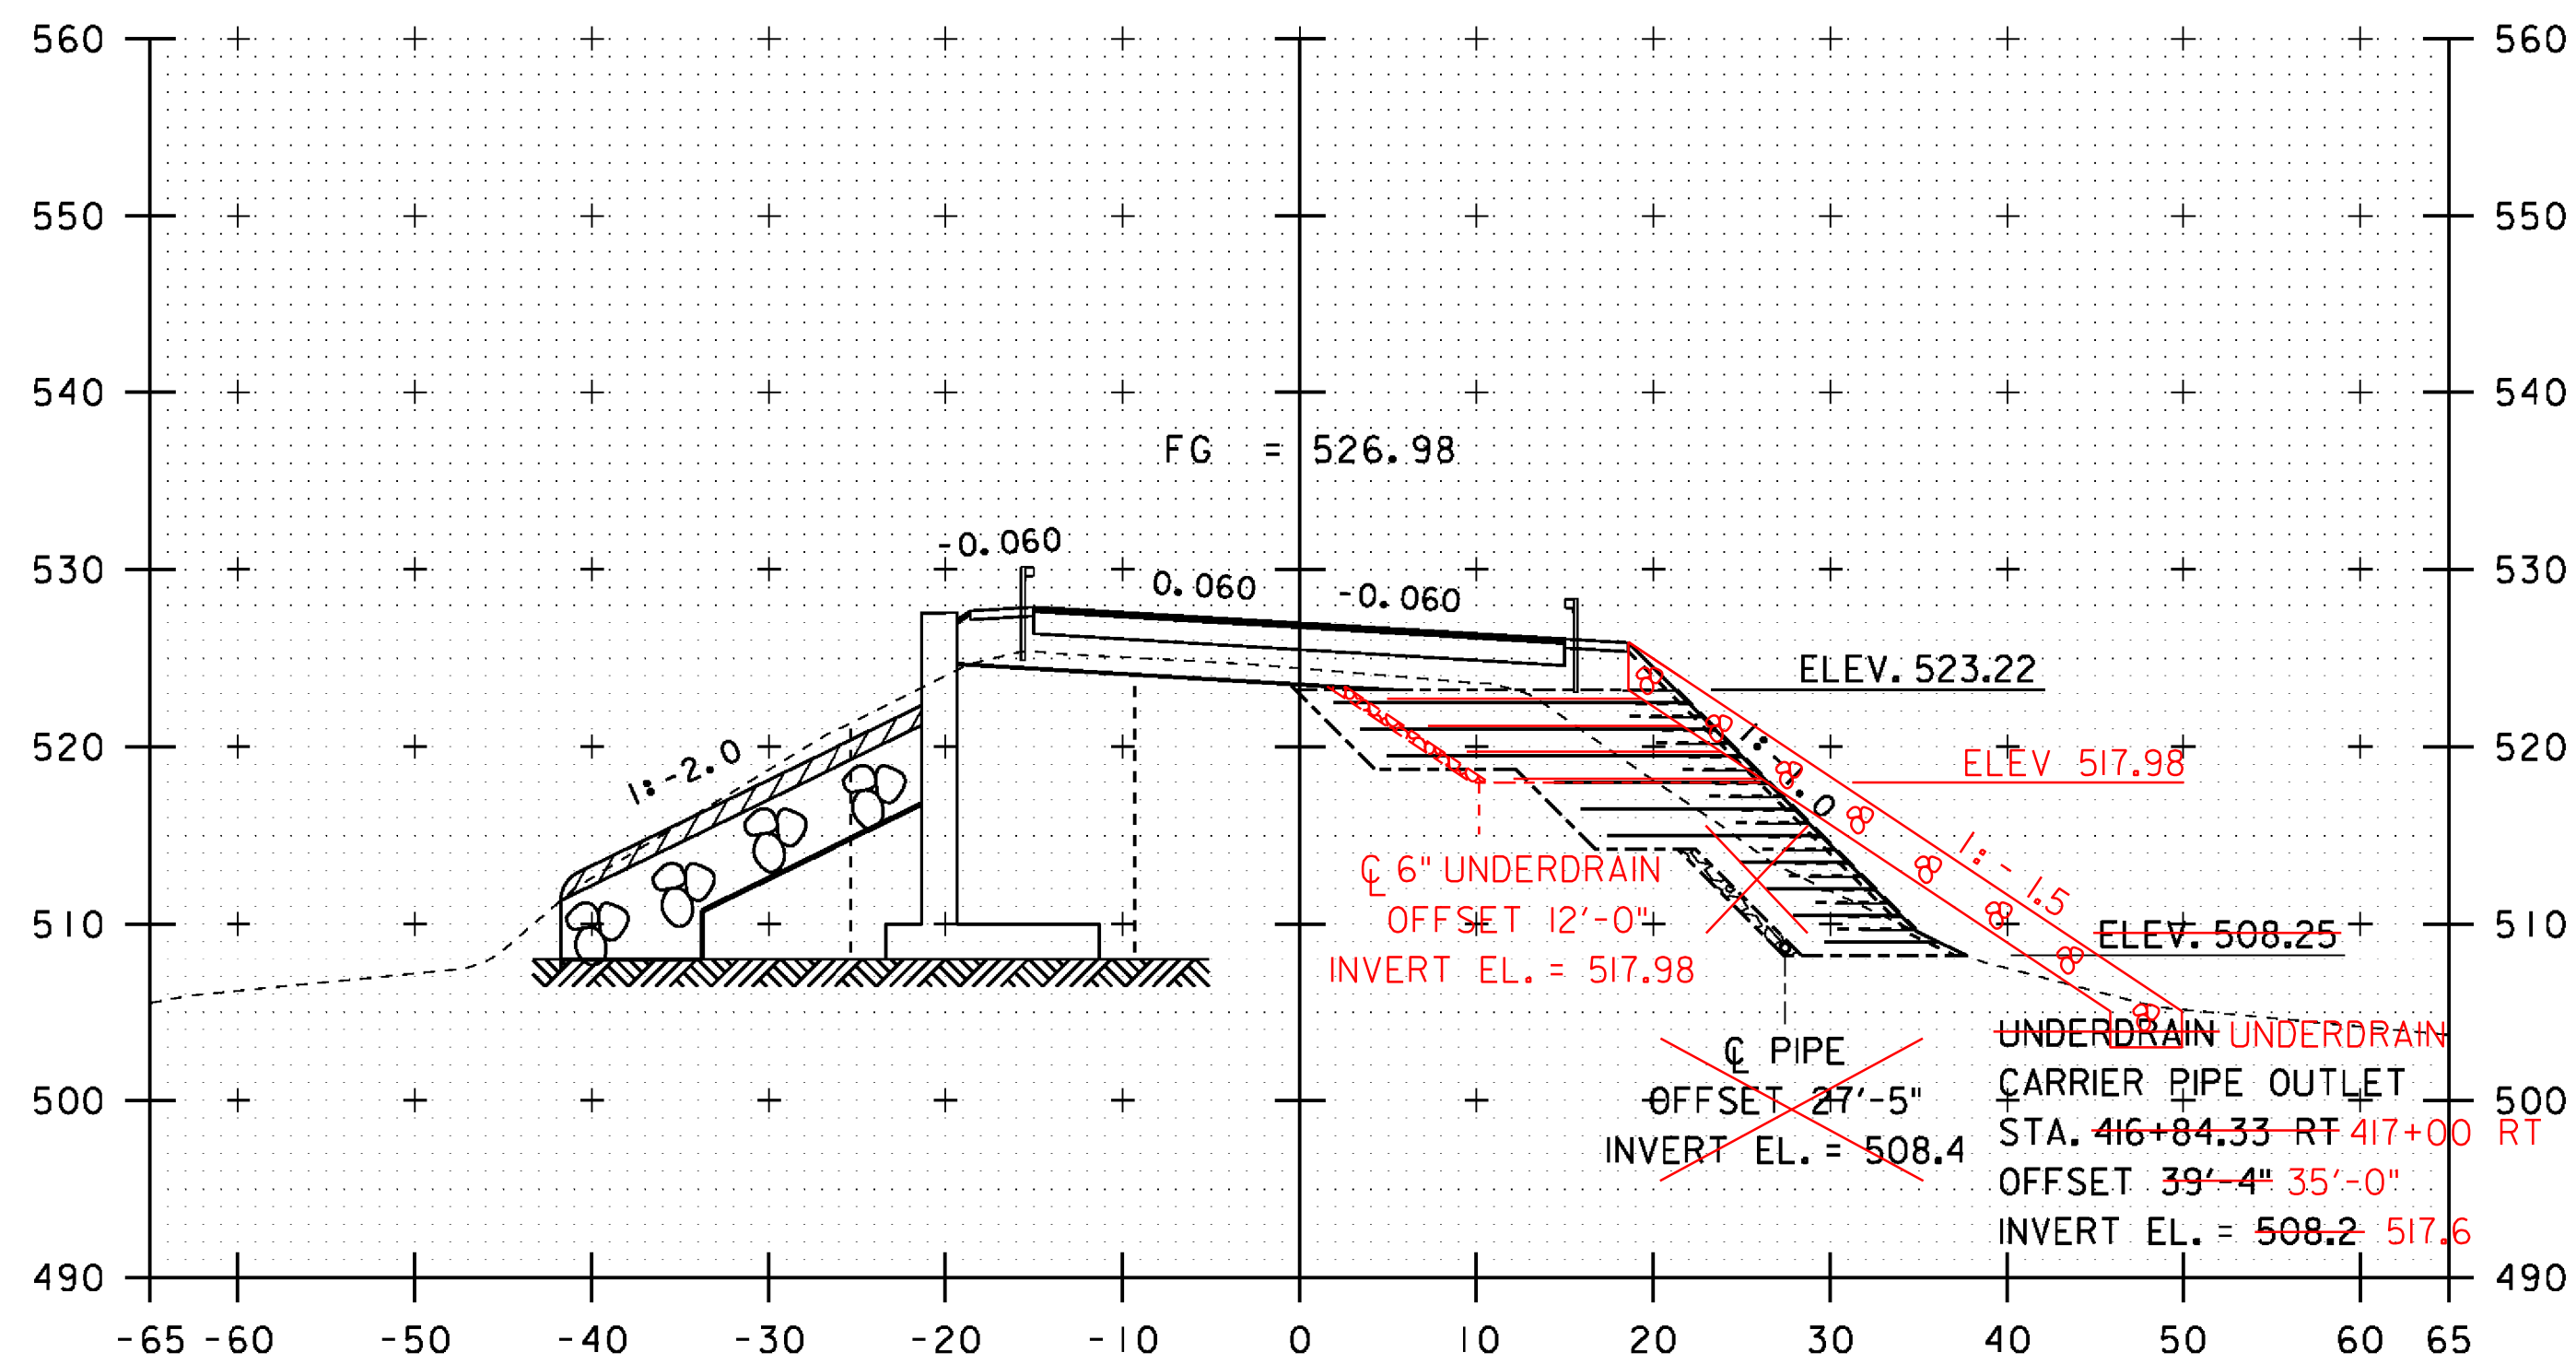

417+00

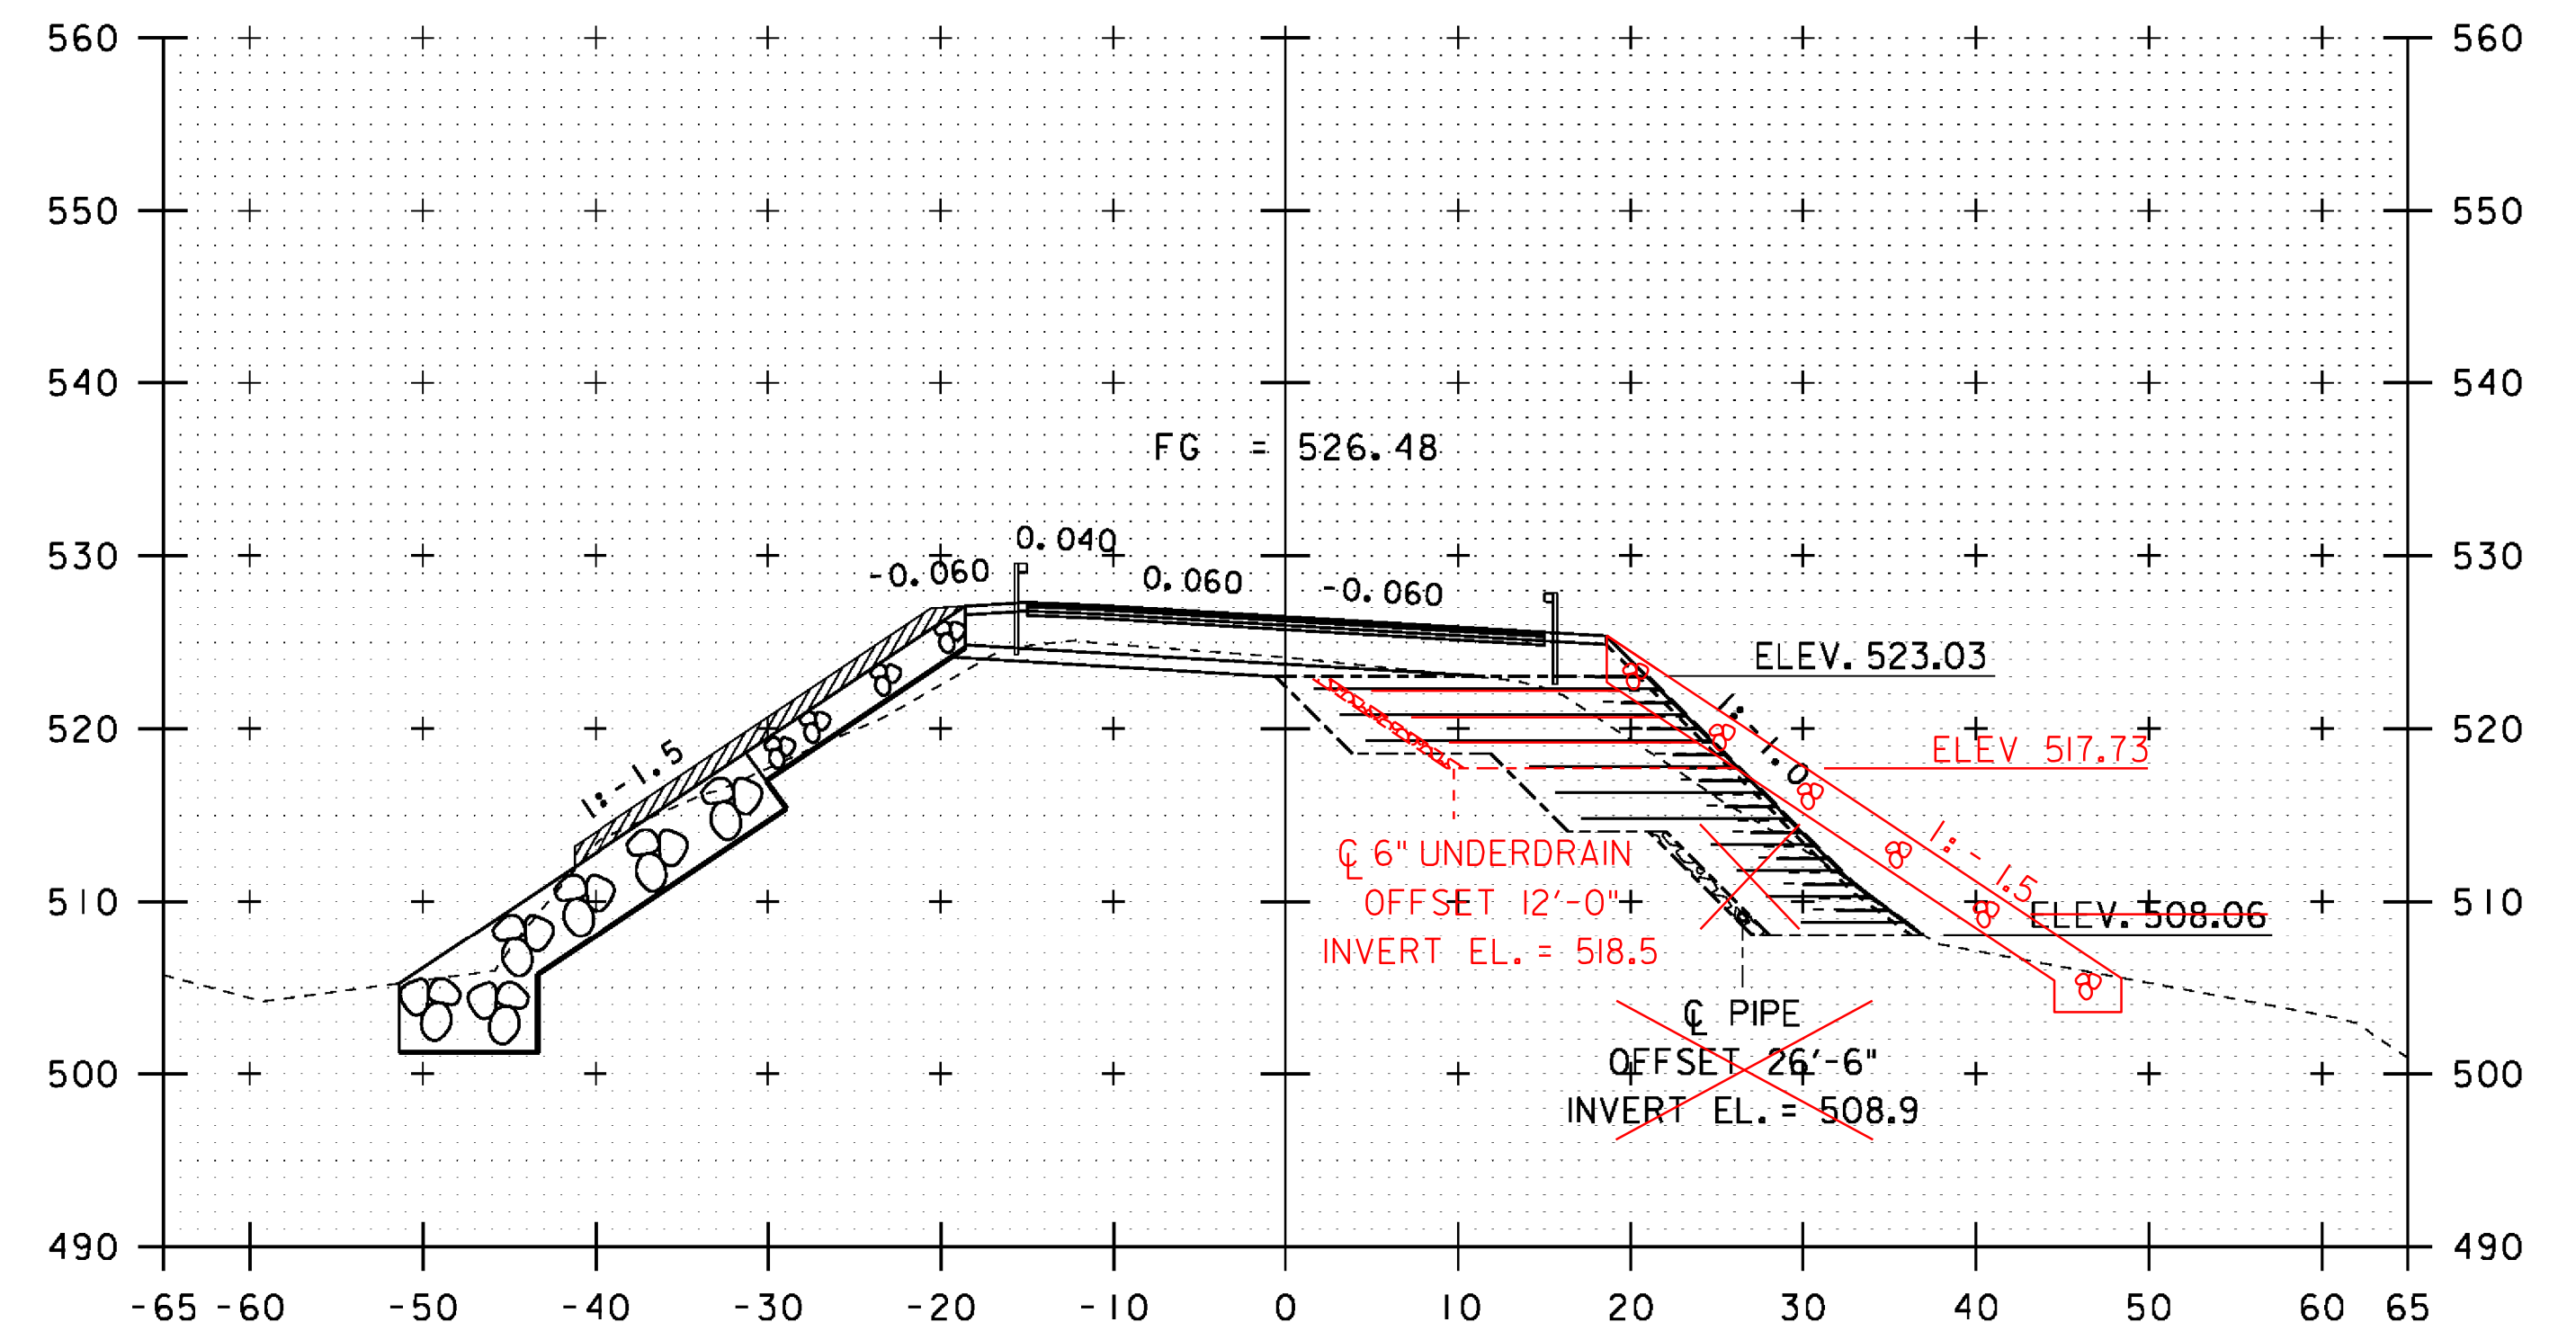

417+50

STA 417+06.90 LT.
 BEGIN STONE FILL, TYPE II
 GEOTEXTILE UNDER STONE FILL
 GRUBBING MATERIAL

STA 417+00.00 RT.
 BEGIN REINFORCED SOIL SLOPE
 BEGIN STONE FILL, TYPE II
 GEOTEXTILE UNDER STONE FILL
 GRUBBING MATERIAL

10 0 10
 SCALE: 1" = 10'-0"

STA. 417+00 TO STA. 417+75

PROJECT NAME: ROYALTON
 PROJECT NUMBER: BRS 0147 (13)

FILE NAME: \BR_28\86e055\sl_28.dgn
 PROJECT LEADER: C. CARLSON
 DESIGNED BY: D. PETERSON
 BRIDGE 28 VT 14 CROSS SECTIONS (6)

PLOT DATE: 08-OCT-2013
 DRAWN BY: STR3
 CHECKED BY: C. CARLSON
 SHEET 142 OF 186