



418+25

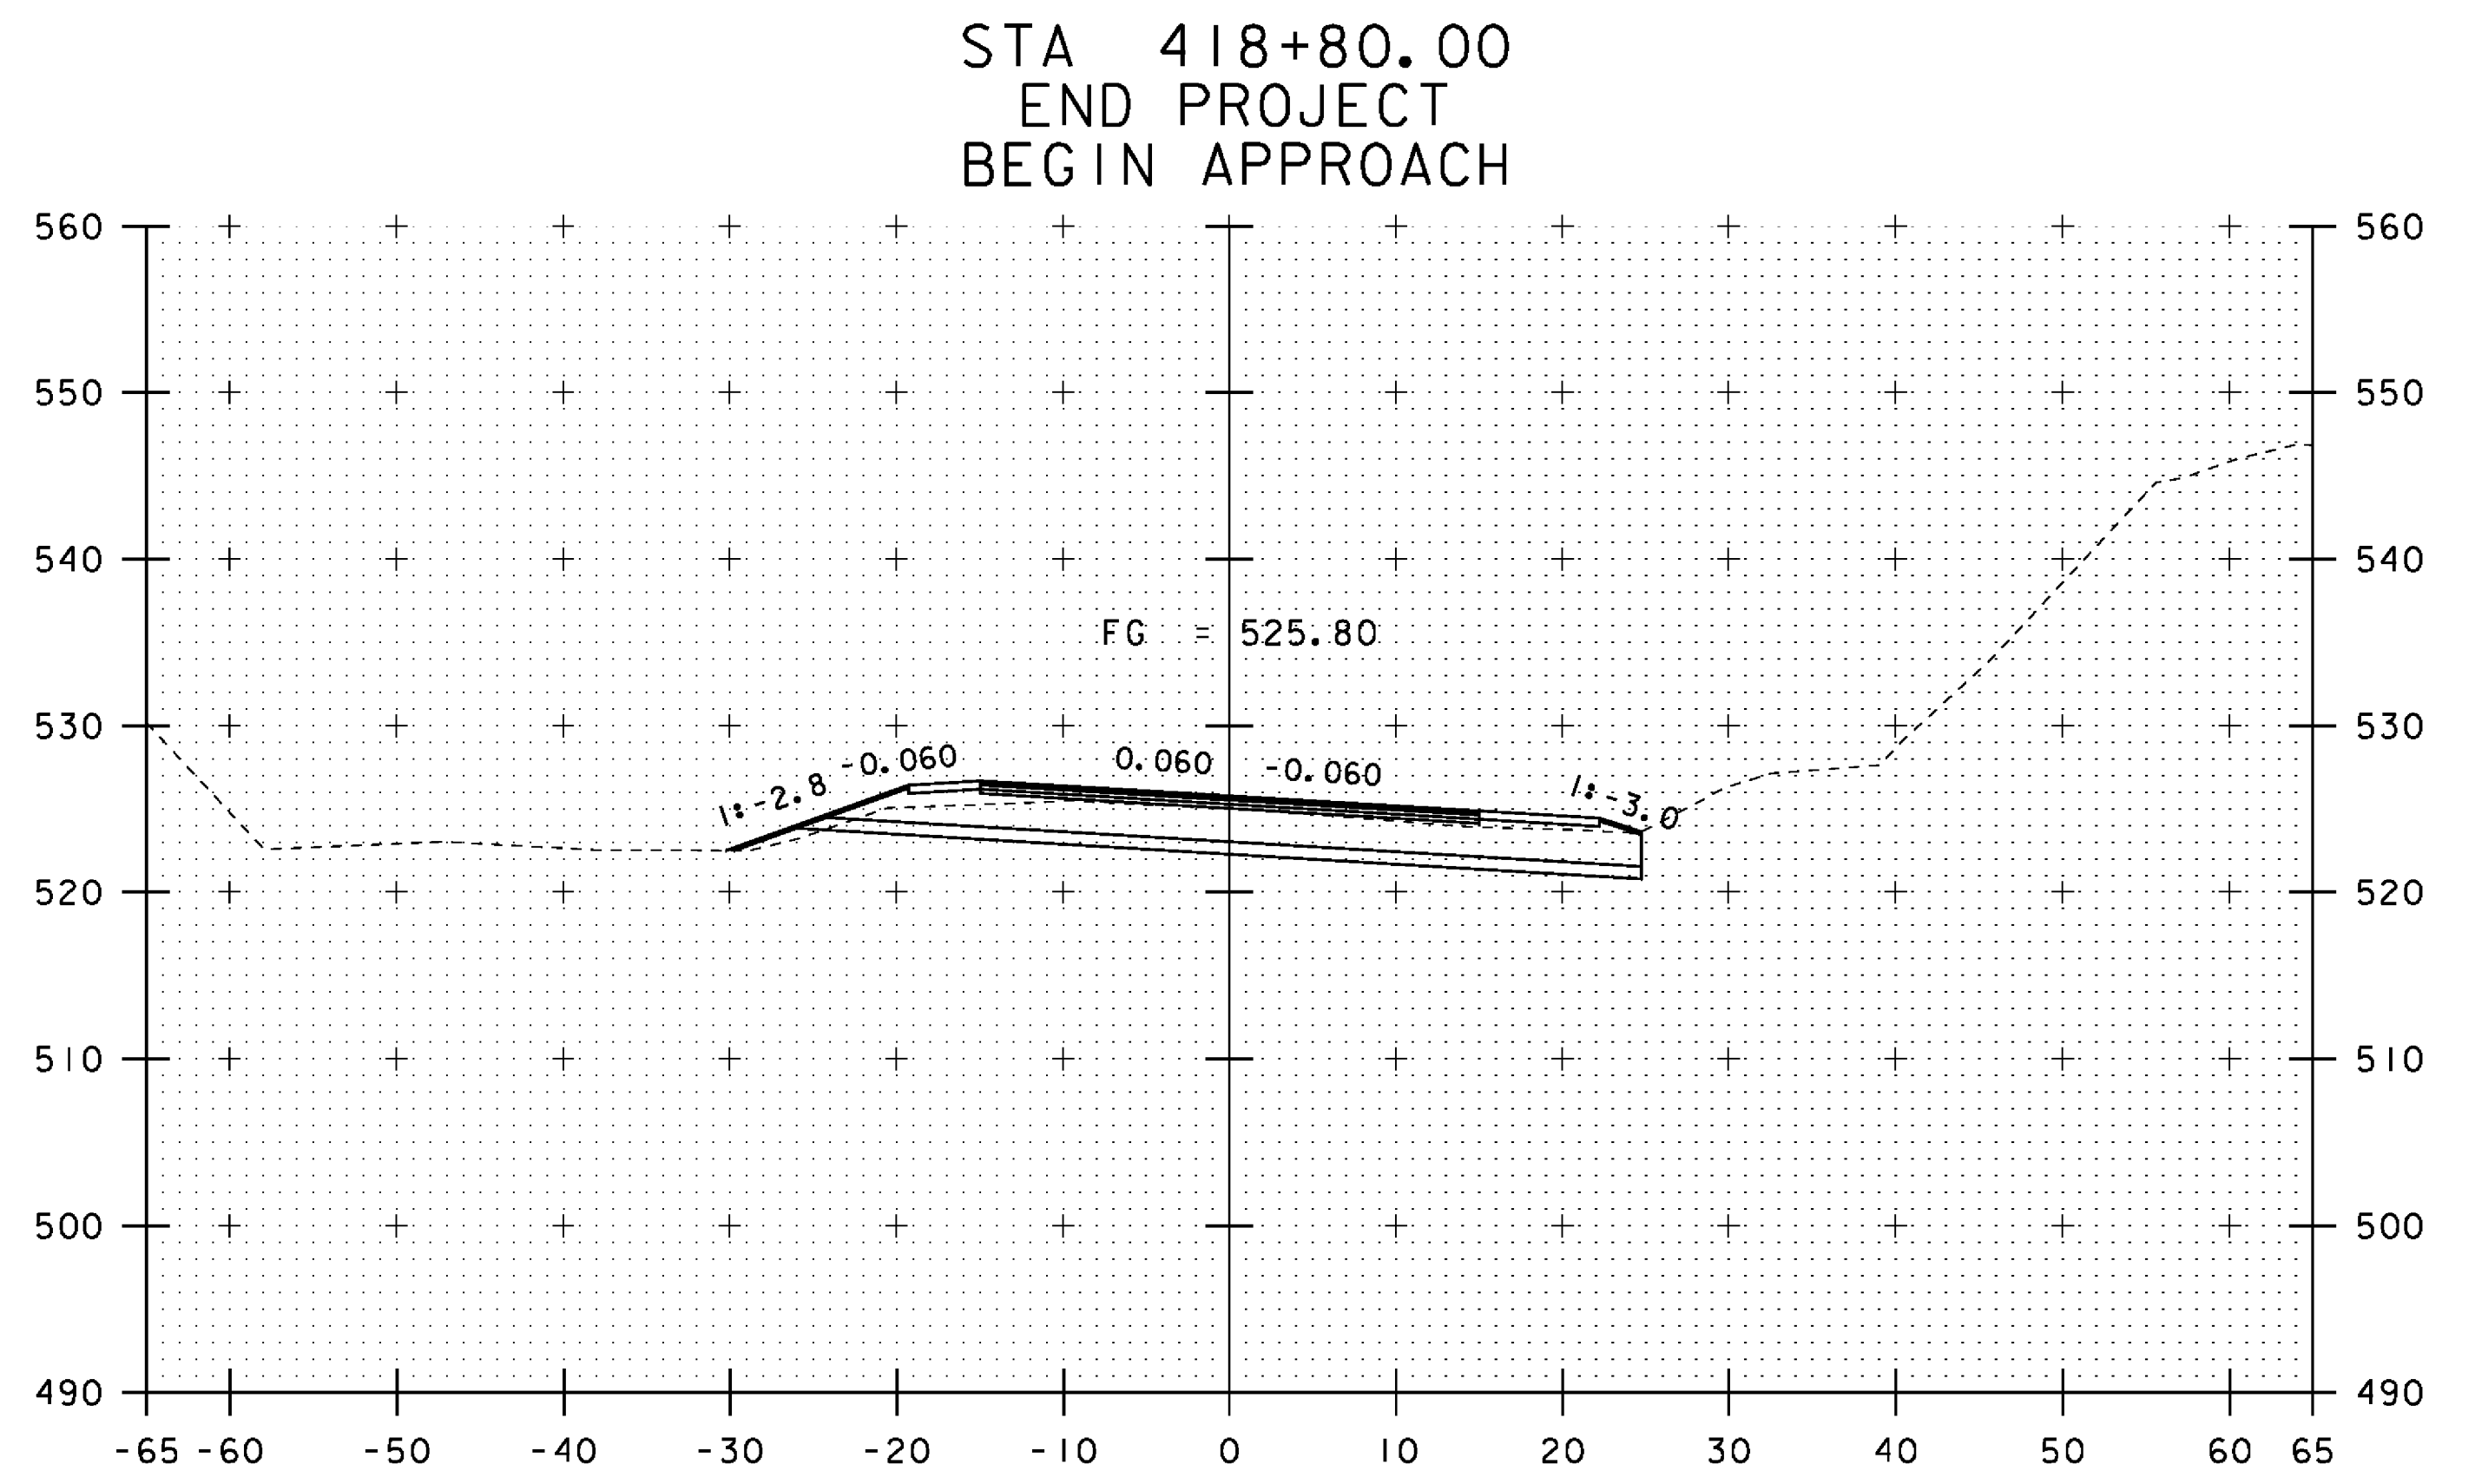


418+75

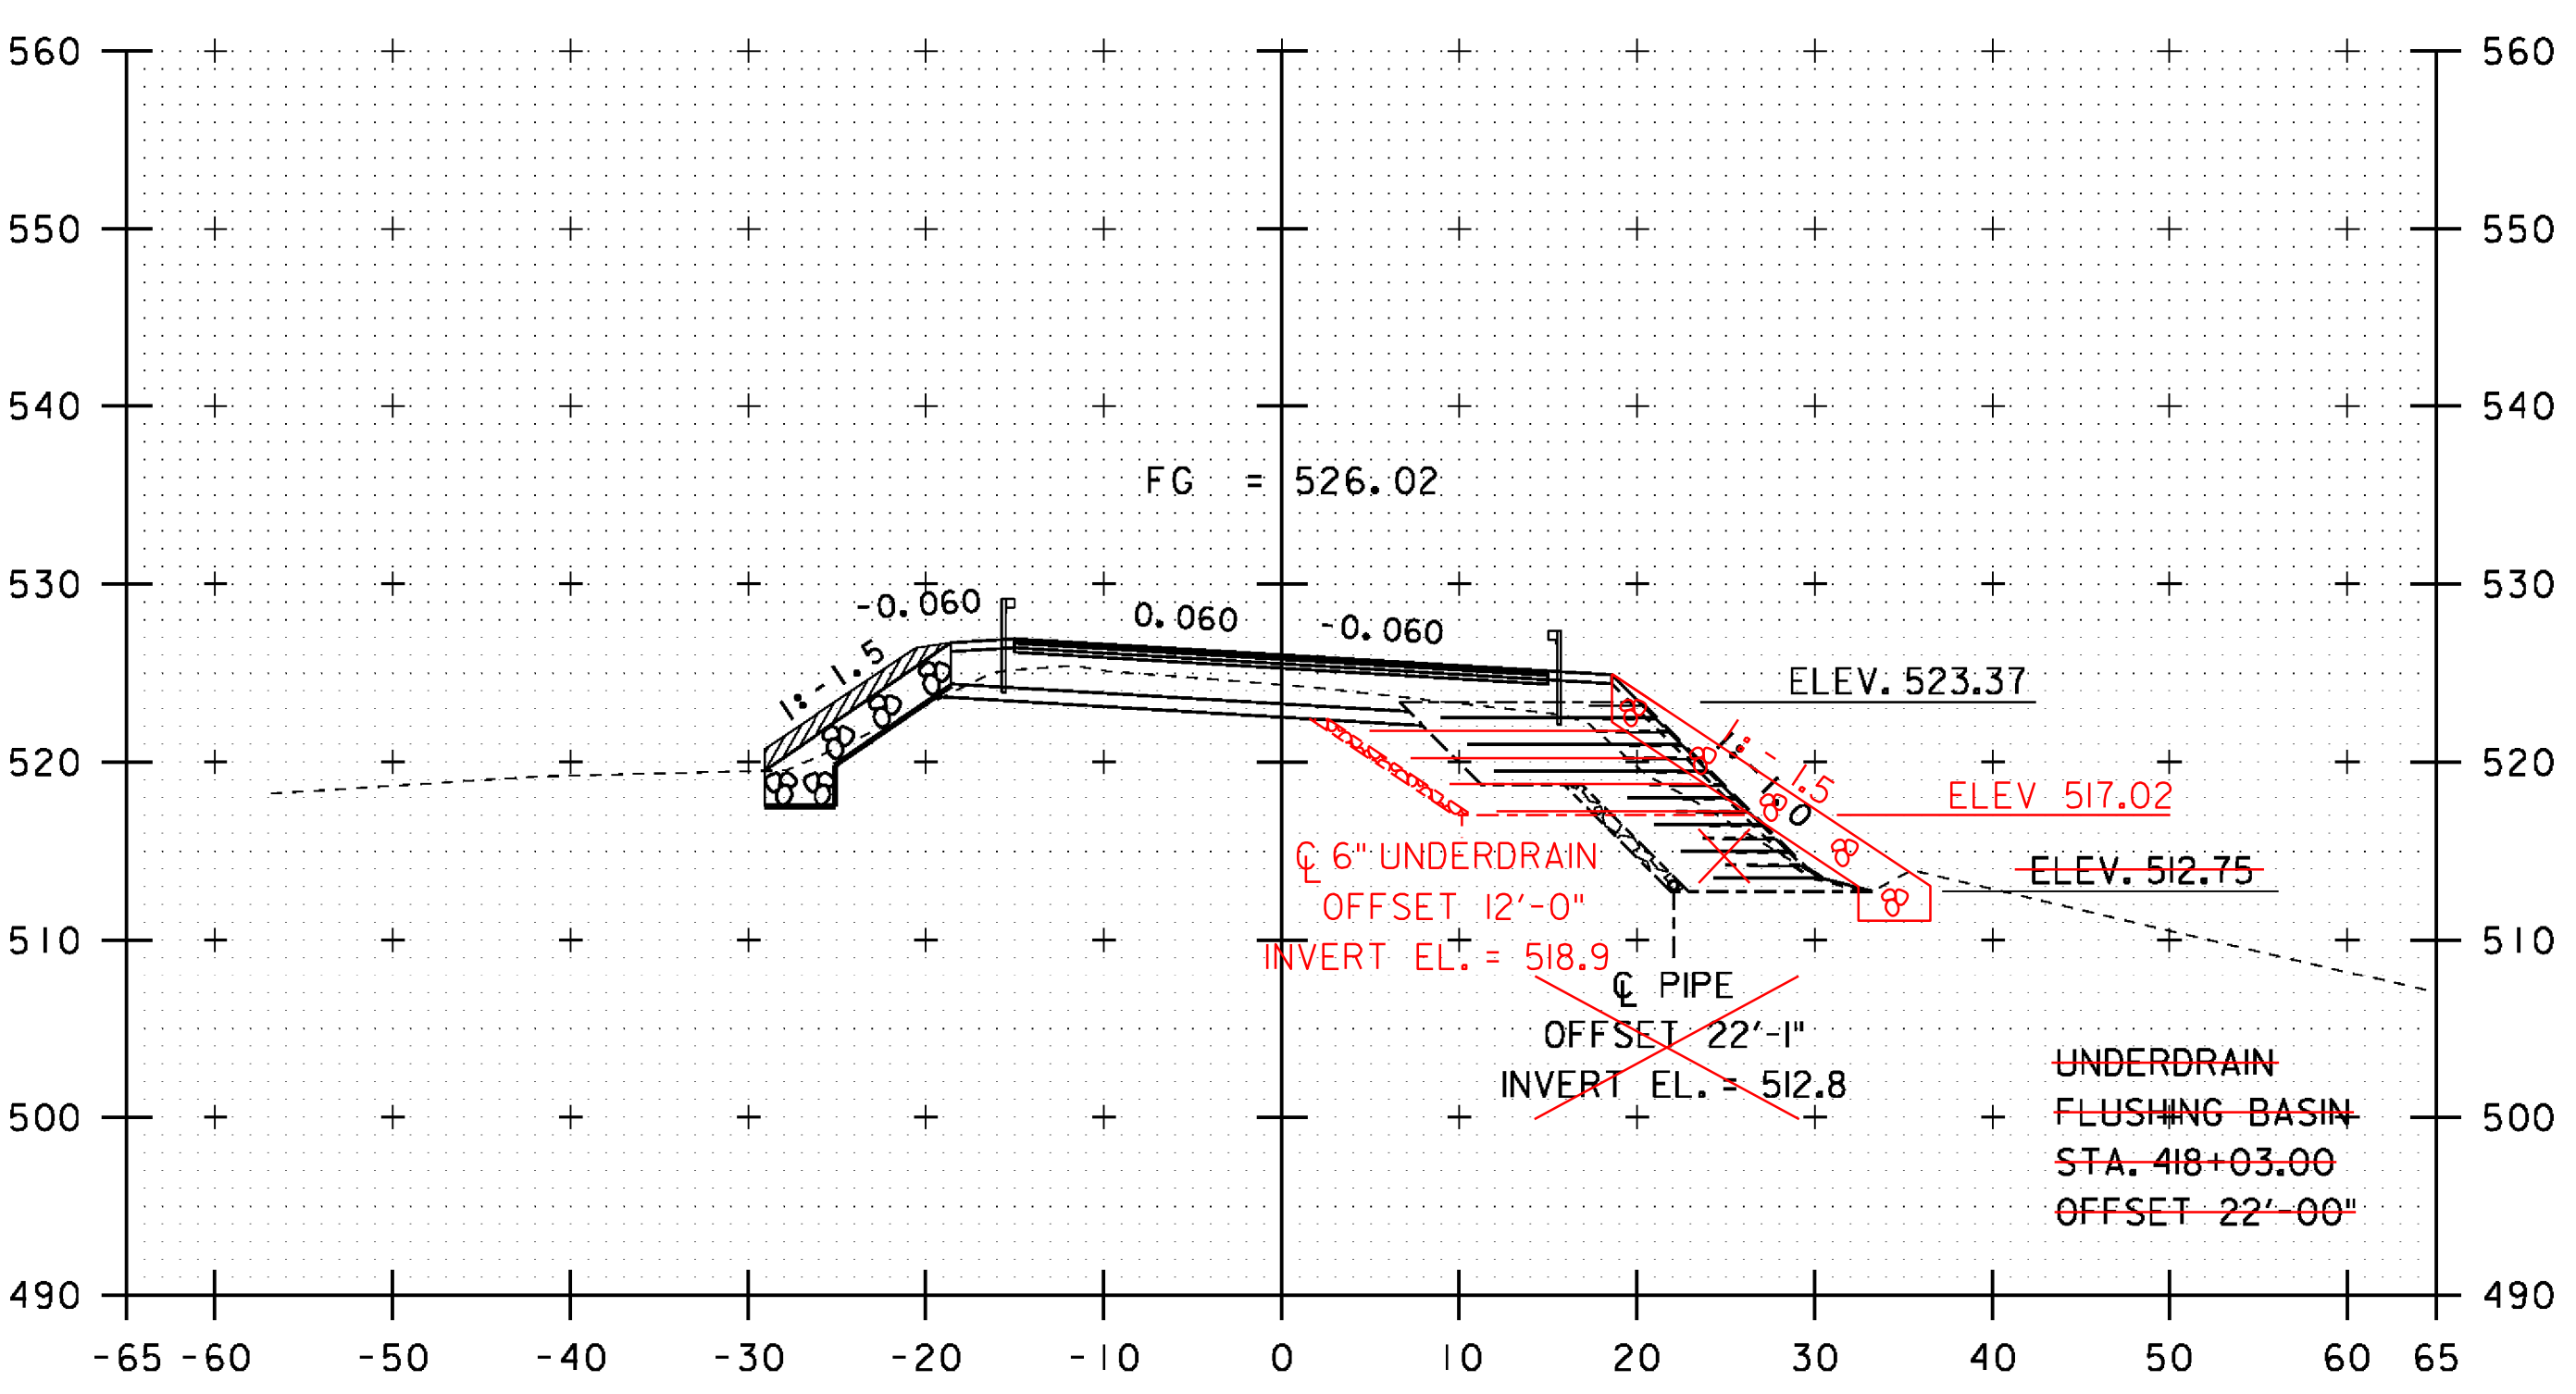


418+00

STA 418+00.00 RT.  
 END REINFORCED SOIL SLOPE  
 STONE FILL, TYPE II  
 GEOTEXTILE UNDER STONE FILL  
 GRUBBING MATERIAL

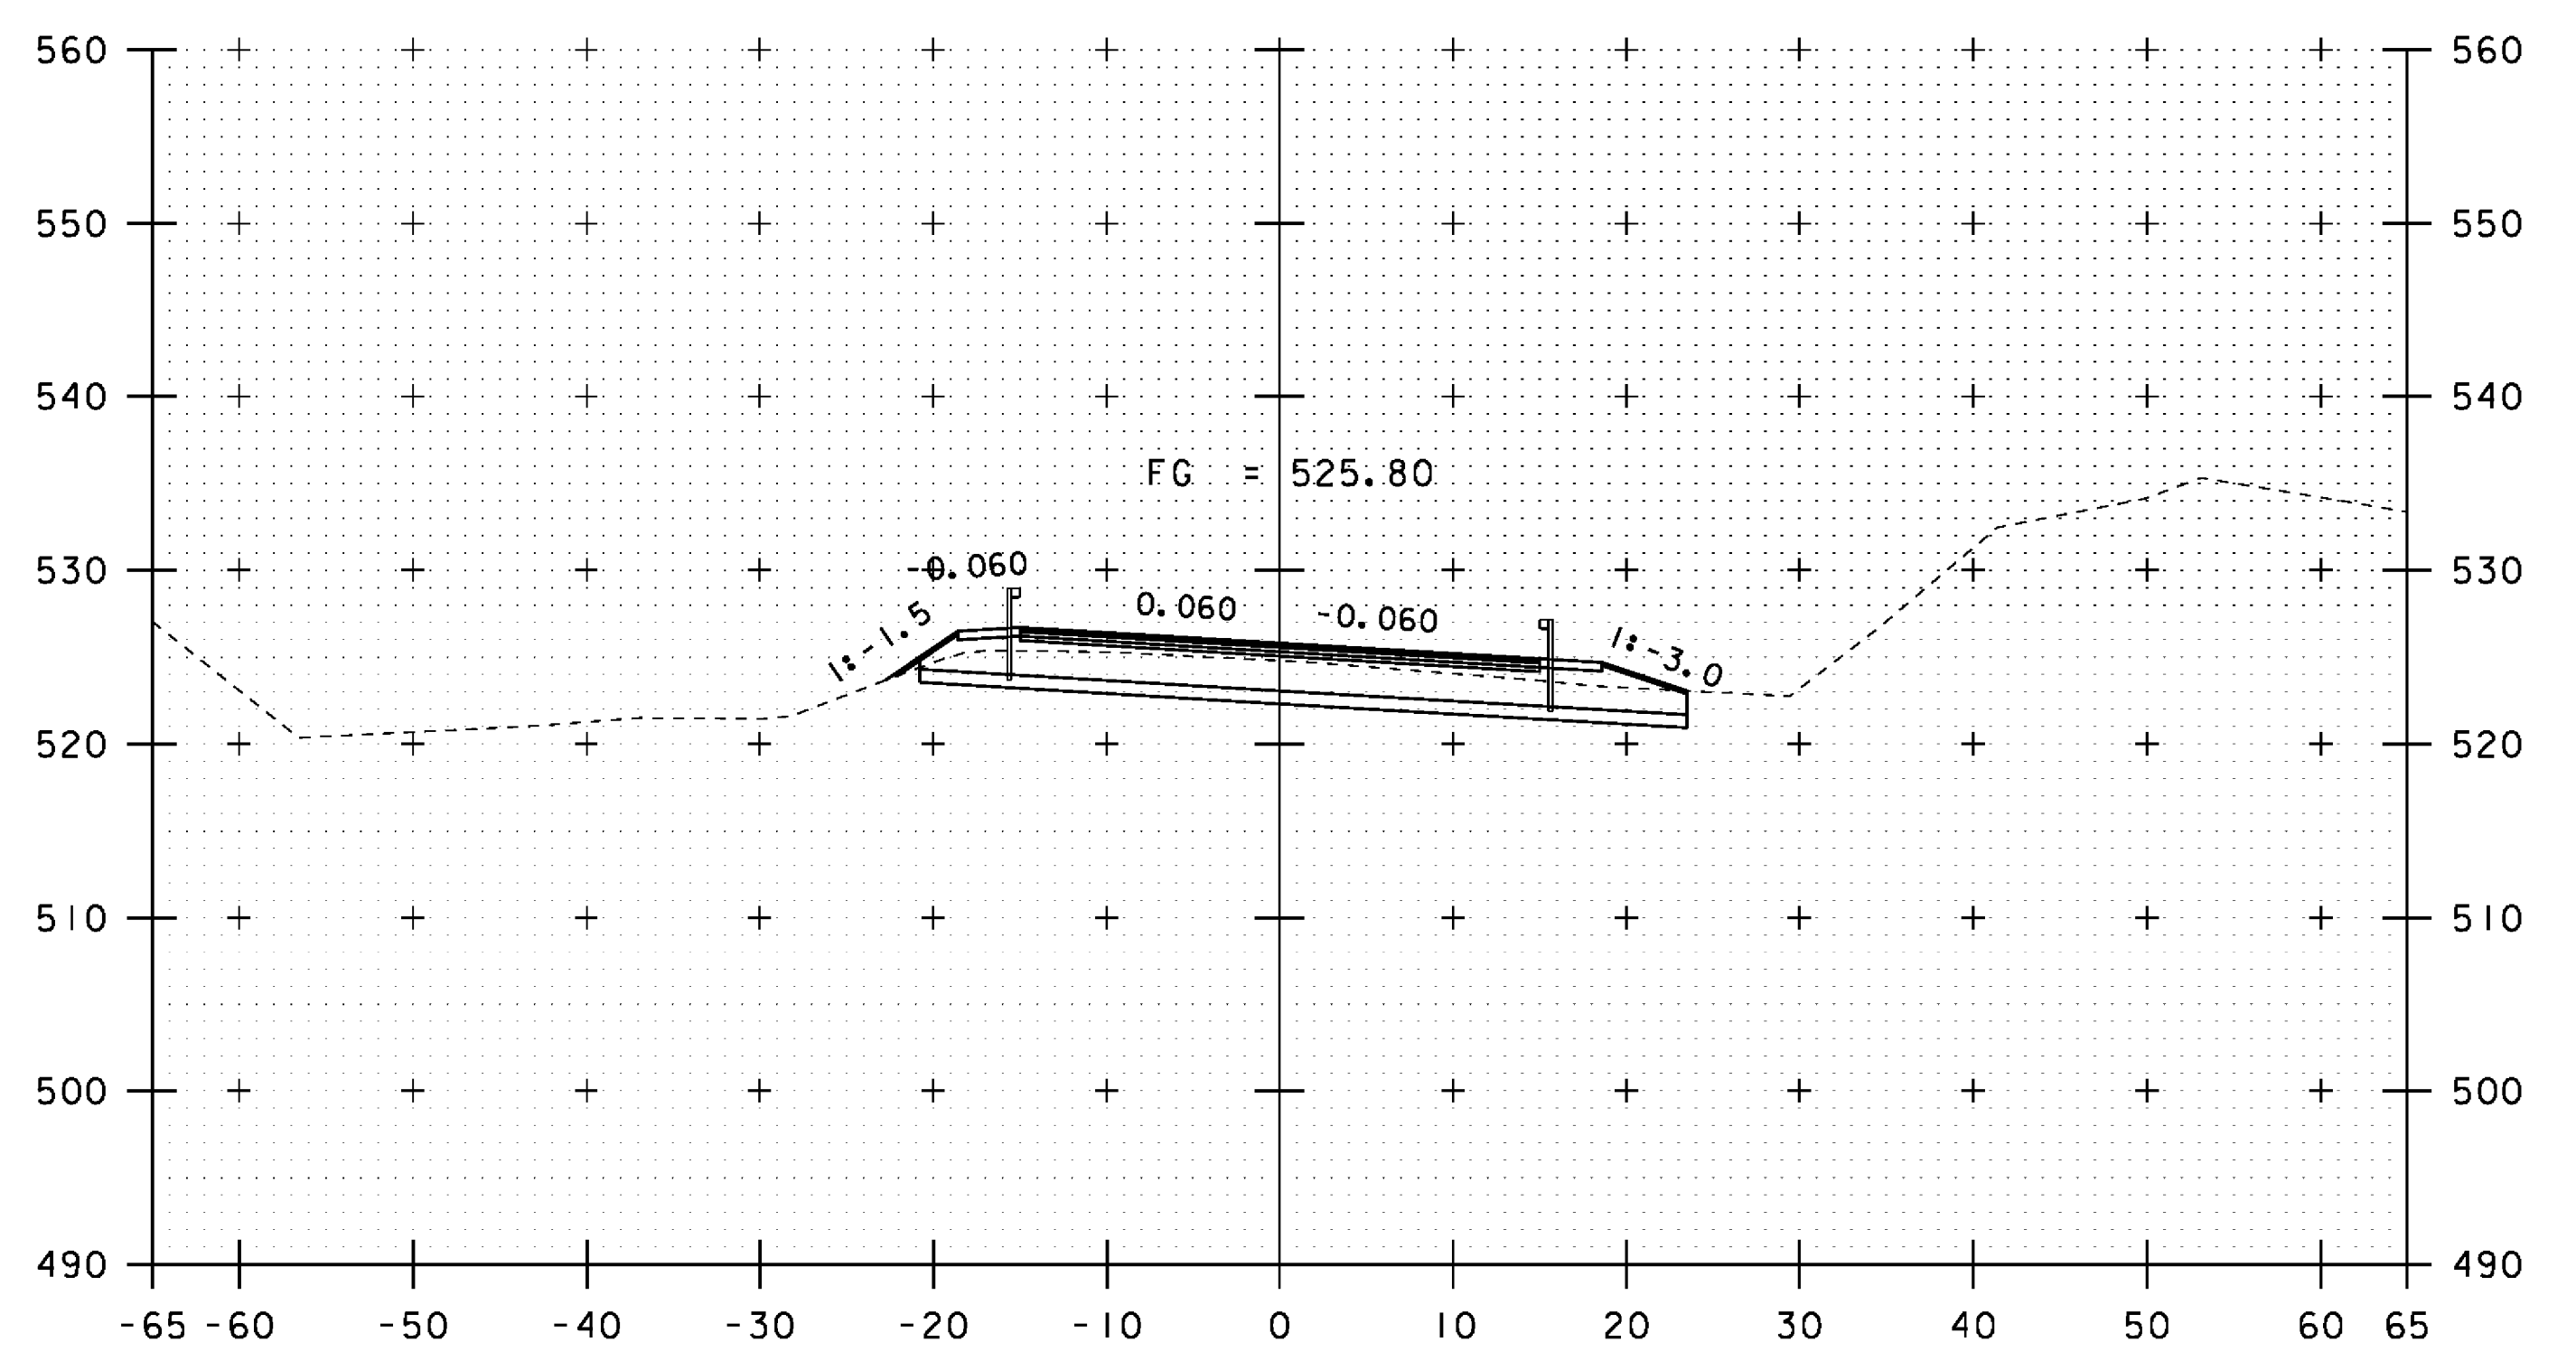

418+50

STA 418+50.00 LT.  
 END STONE FILL, TYPE II  
 GEOTEXTILE UNDER STONE FILL  
 GRUBBING MATERIAL

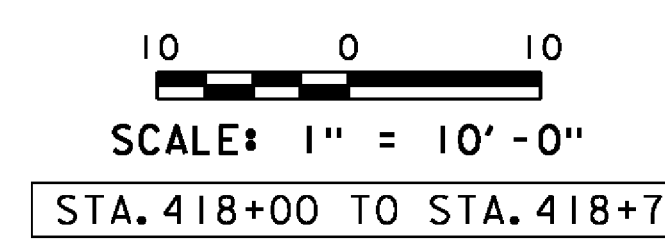

PROJECT NAME:	ROYALTON	PLOT DATE:	08-OCT-2013
PROJECT NUMBER:	BRS 0147 (13)	DRAWN BY:	STR3
FILE NAME:	\\BR.28\86e055\sl.28.dgn	CHECKED BY:	C. CARLSON
PROJECT LEADER:	C. CARLSON	SHEET	143 OF 186
DESIGNED BY:	D. PETERSON		
BRIDGE 28 VT 14 CROSS SECTIONS (7)			