




420+25

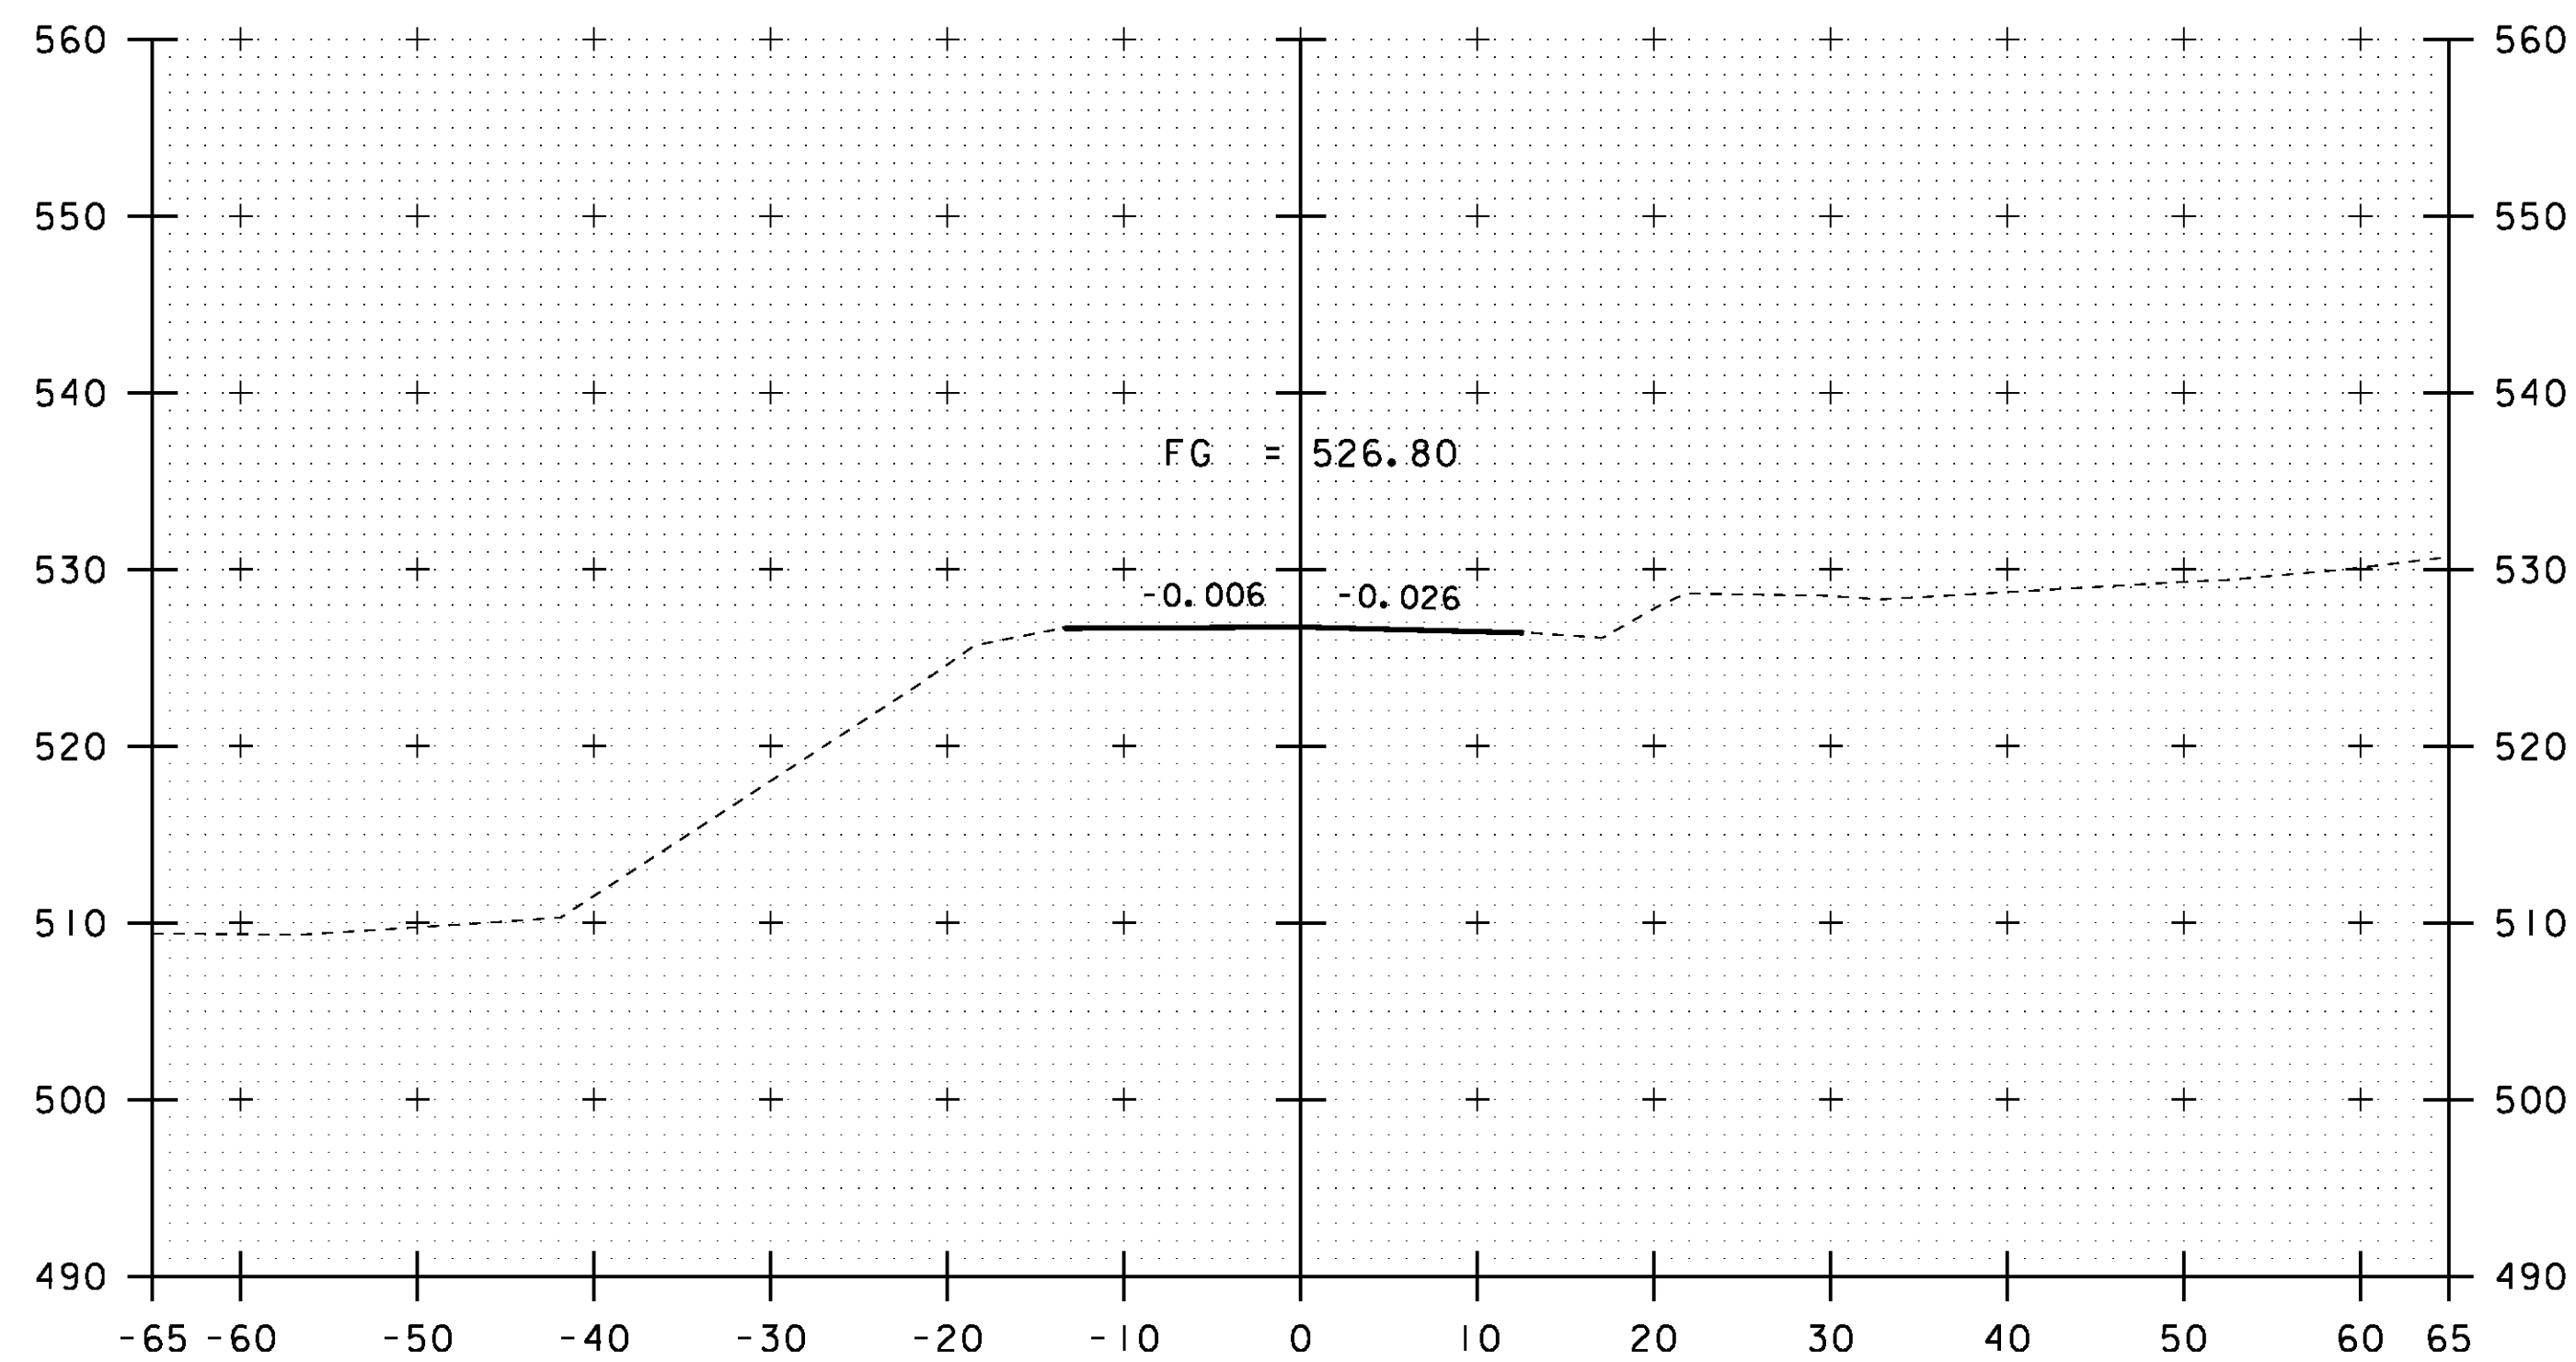

420+00
END APPROACH
MATCH EXISTING

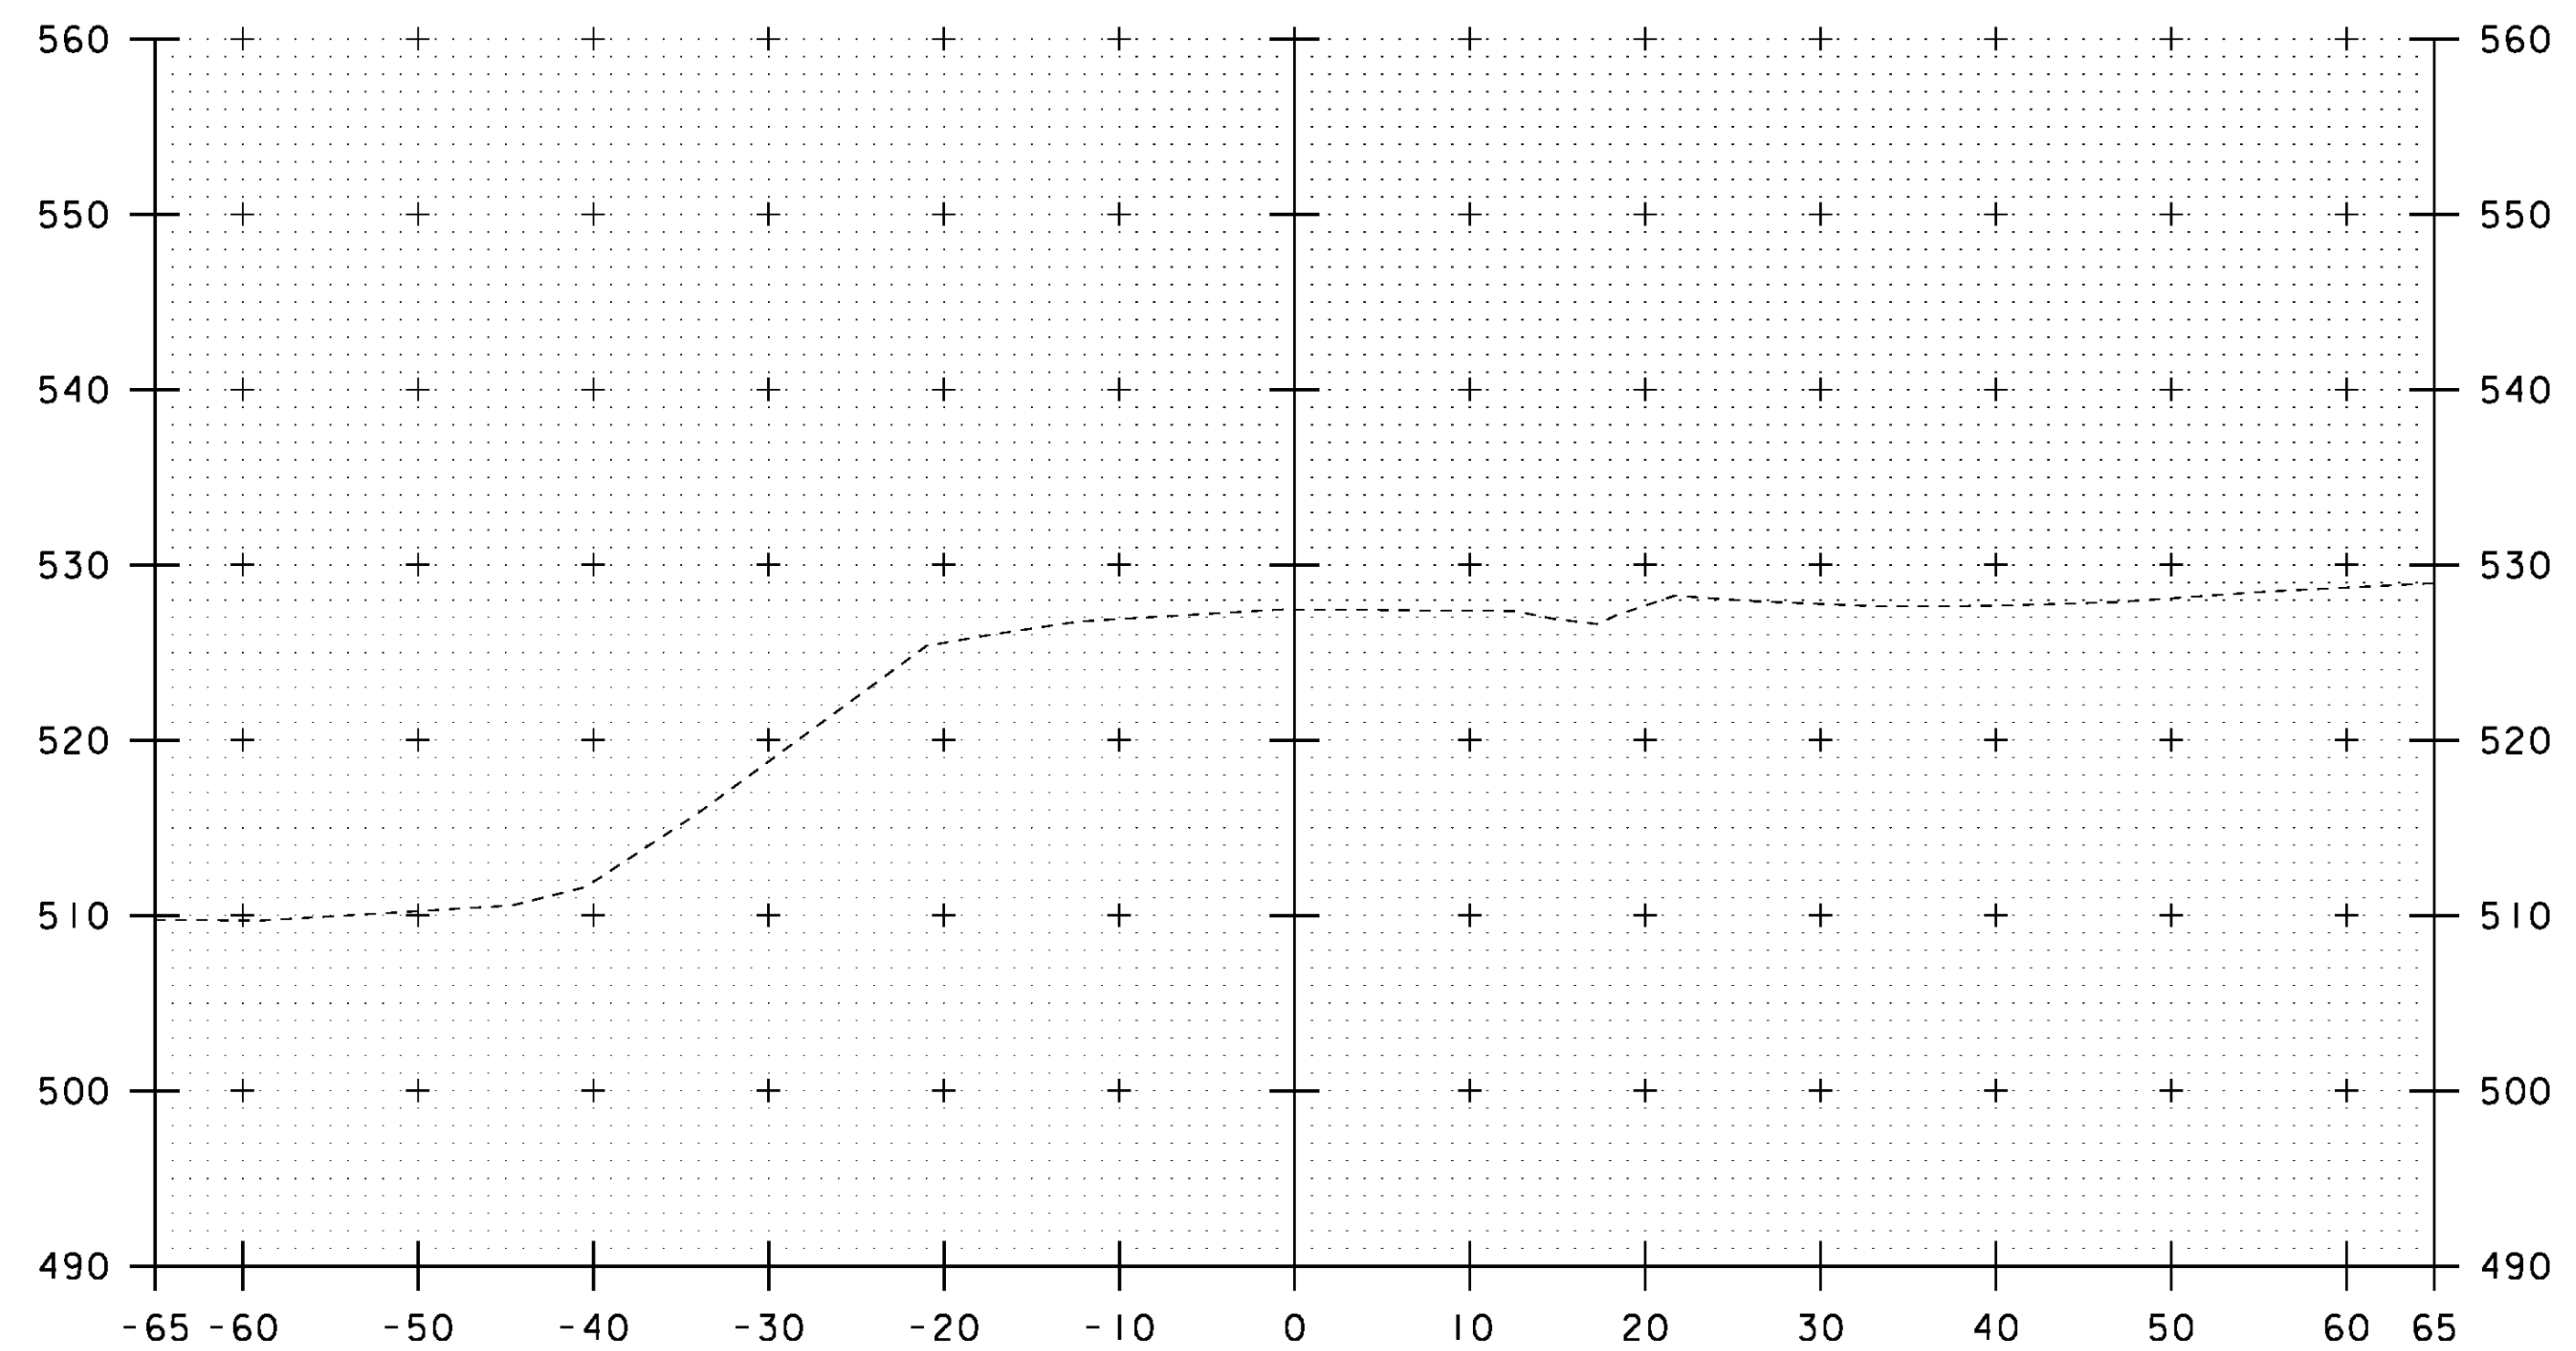

420+50

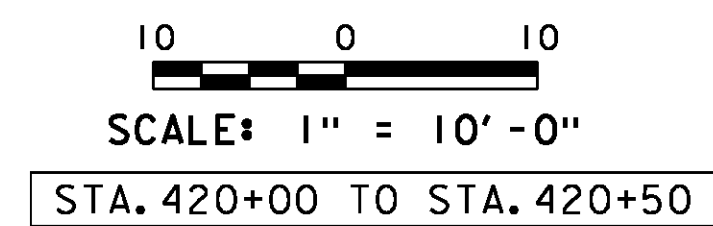

PROJECT NAME: ROYALTON	PLLOT DATE: 08-OCT-2013
PROJECT NUMBER: BRS 0147 (13)	DRAWN BY: STR3
FILE NAME: \BR_28\86e055xsl_28.dgn	CHECKED BY: C. CARLSON
PROJECT LEADER: C. CARLSON	SHEET 145 OF 186
DESIGNED BY: D. PETERSON	
BRIDGE 28 VT 14 CROSS SECTIONS (9)	