



STA 61+15.00 LT  
RESUME STONE FILL, TYPE IV  
GEOTEXTILE UNDER STONE FILL

61+20

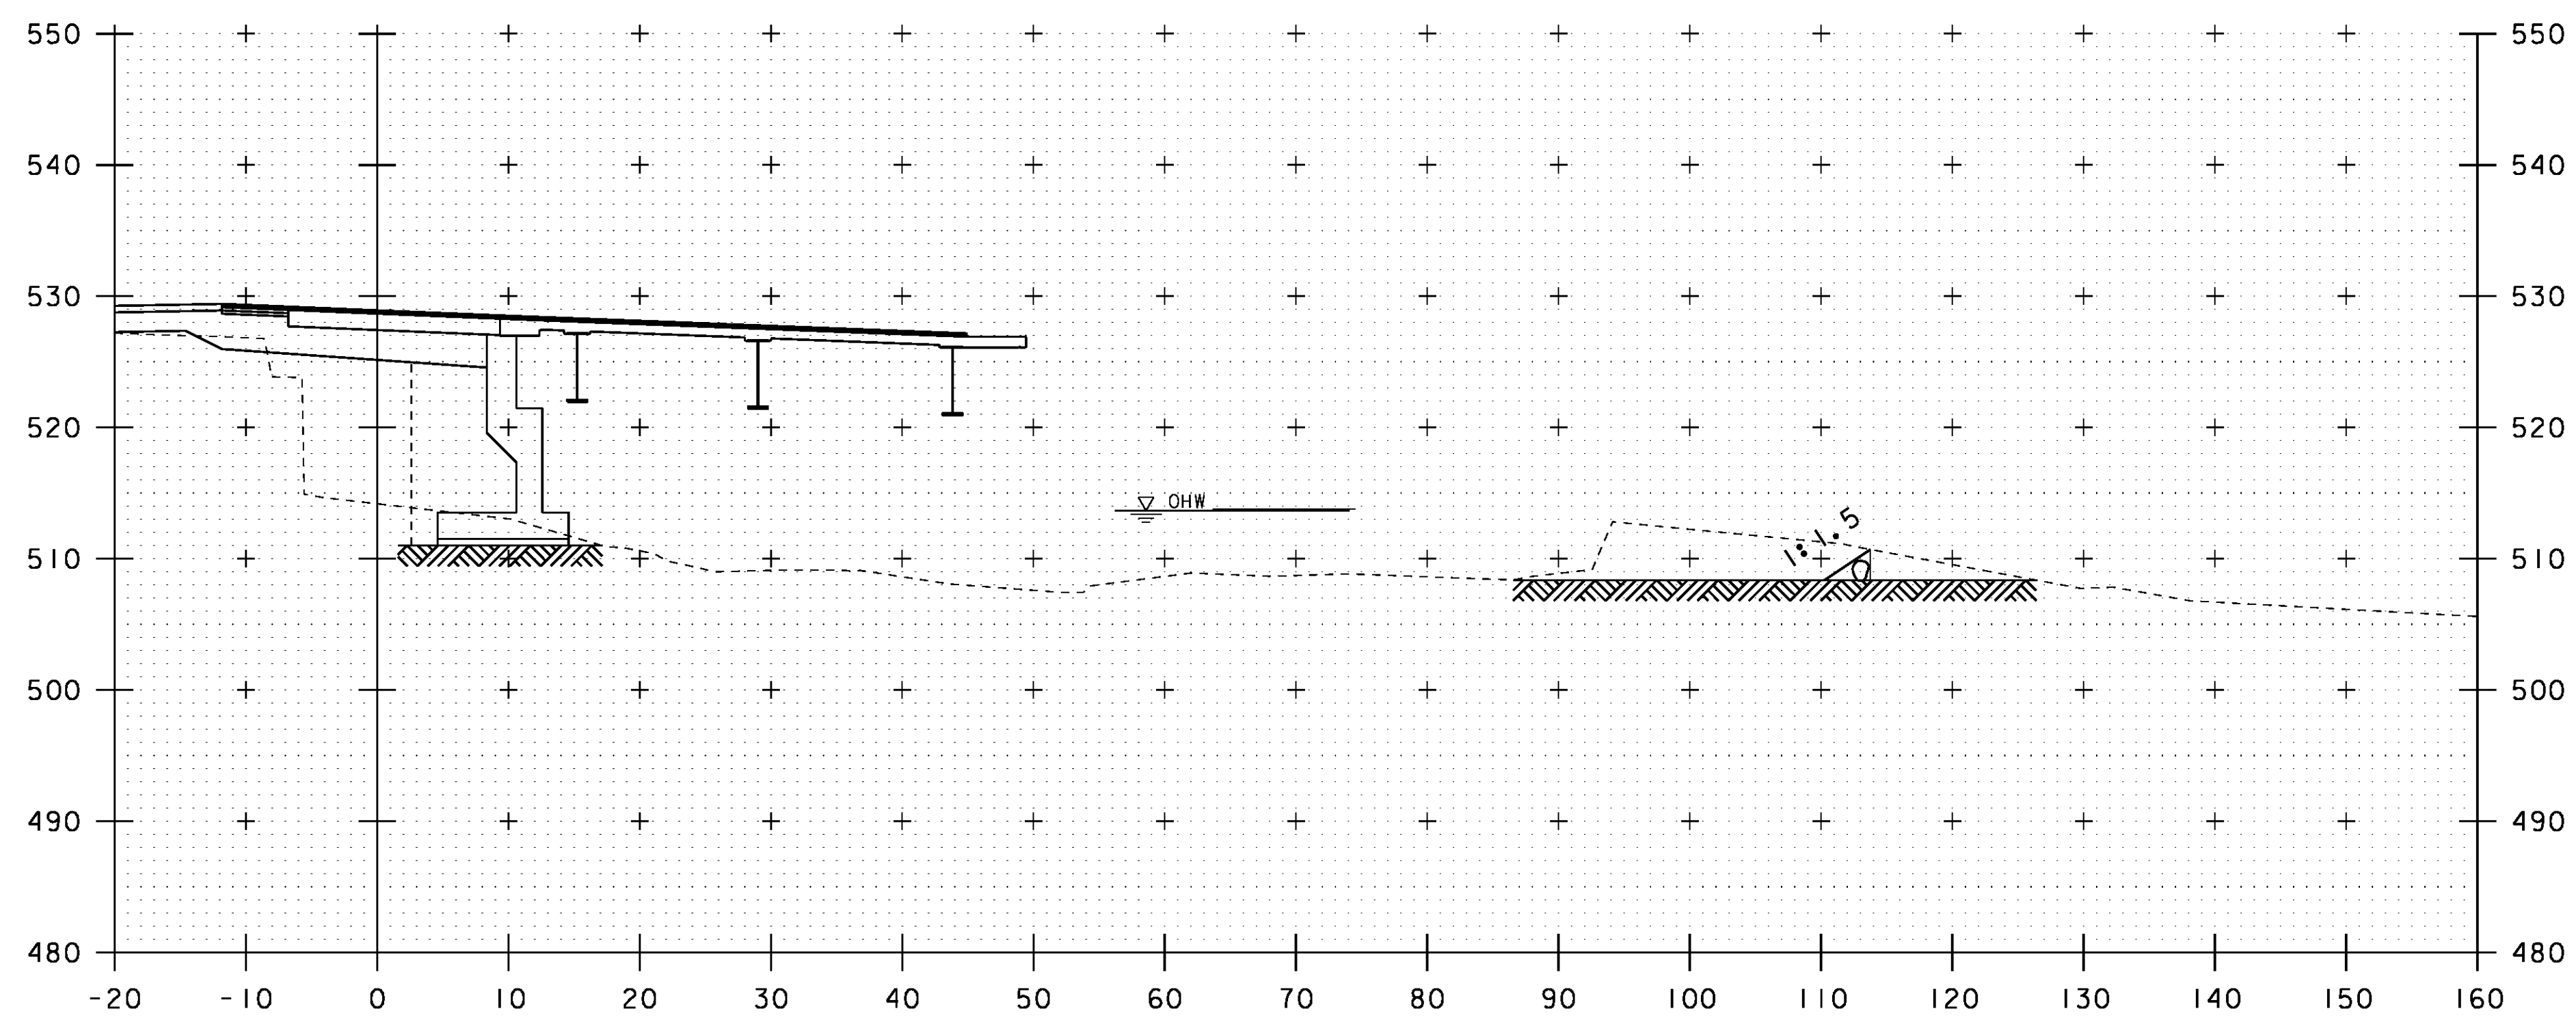

STA 61+00.03 RT  
BEGIN UNCLASSIFIED CHANNEL EXCAVATION  
GEOTEXTILE UNDER STONE FILL  
STONE FILL, TYPE IV  
GRUBBING MATERIAL

61+10

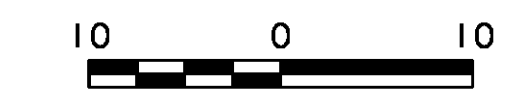

SCALE: 1" = 10'-0"

STA. 61+10 TO STA. 61+20

PROJECT NAME:	ROYALTON
PROJECT NUMBER:	BRS 0147 (13)
FILE NAME:	\BR_28\86e055xsl-28.dgn
PROJECT LEADER:	C. CARLSON
DESIGNED BY:	D. PETERSON
BRIDGE 28 CHANNEL LINE CROSS SECTIONS (5) SHEET	150 OF 186
PLOT DATE:	08-OCT-2013
DRAWN BY:	STR3
CHECKED BY:	C. CARLSON