



61+80

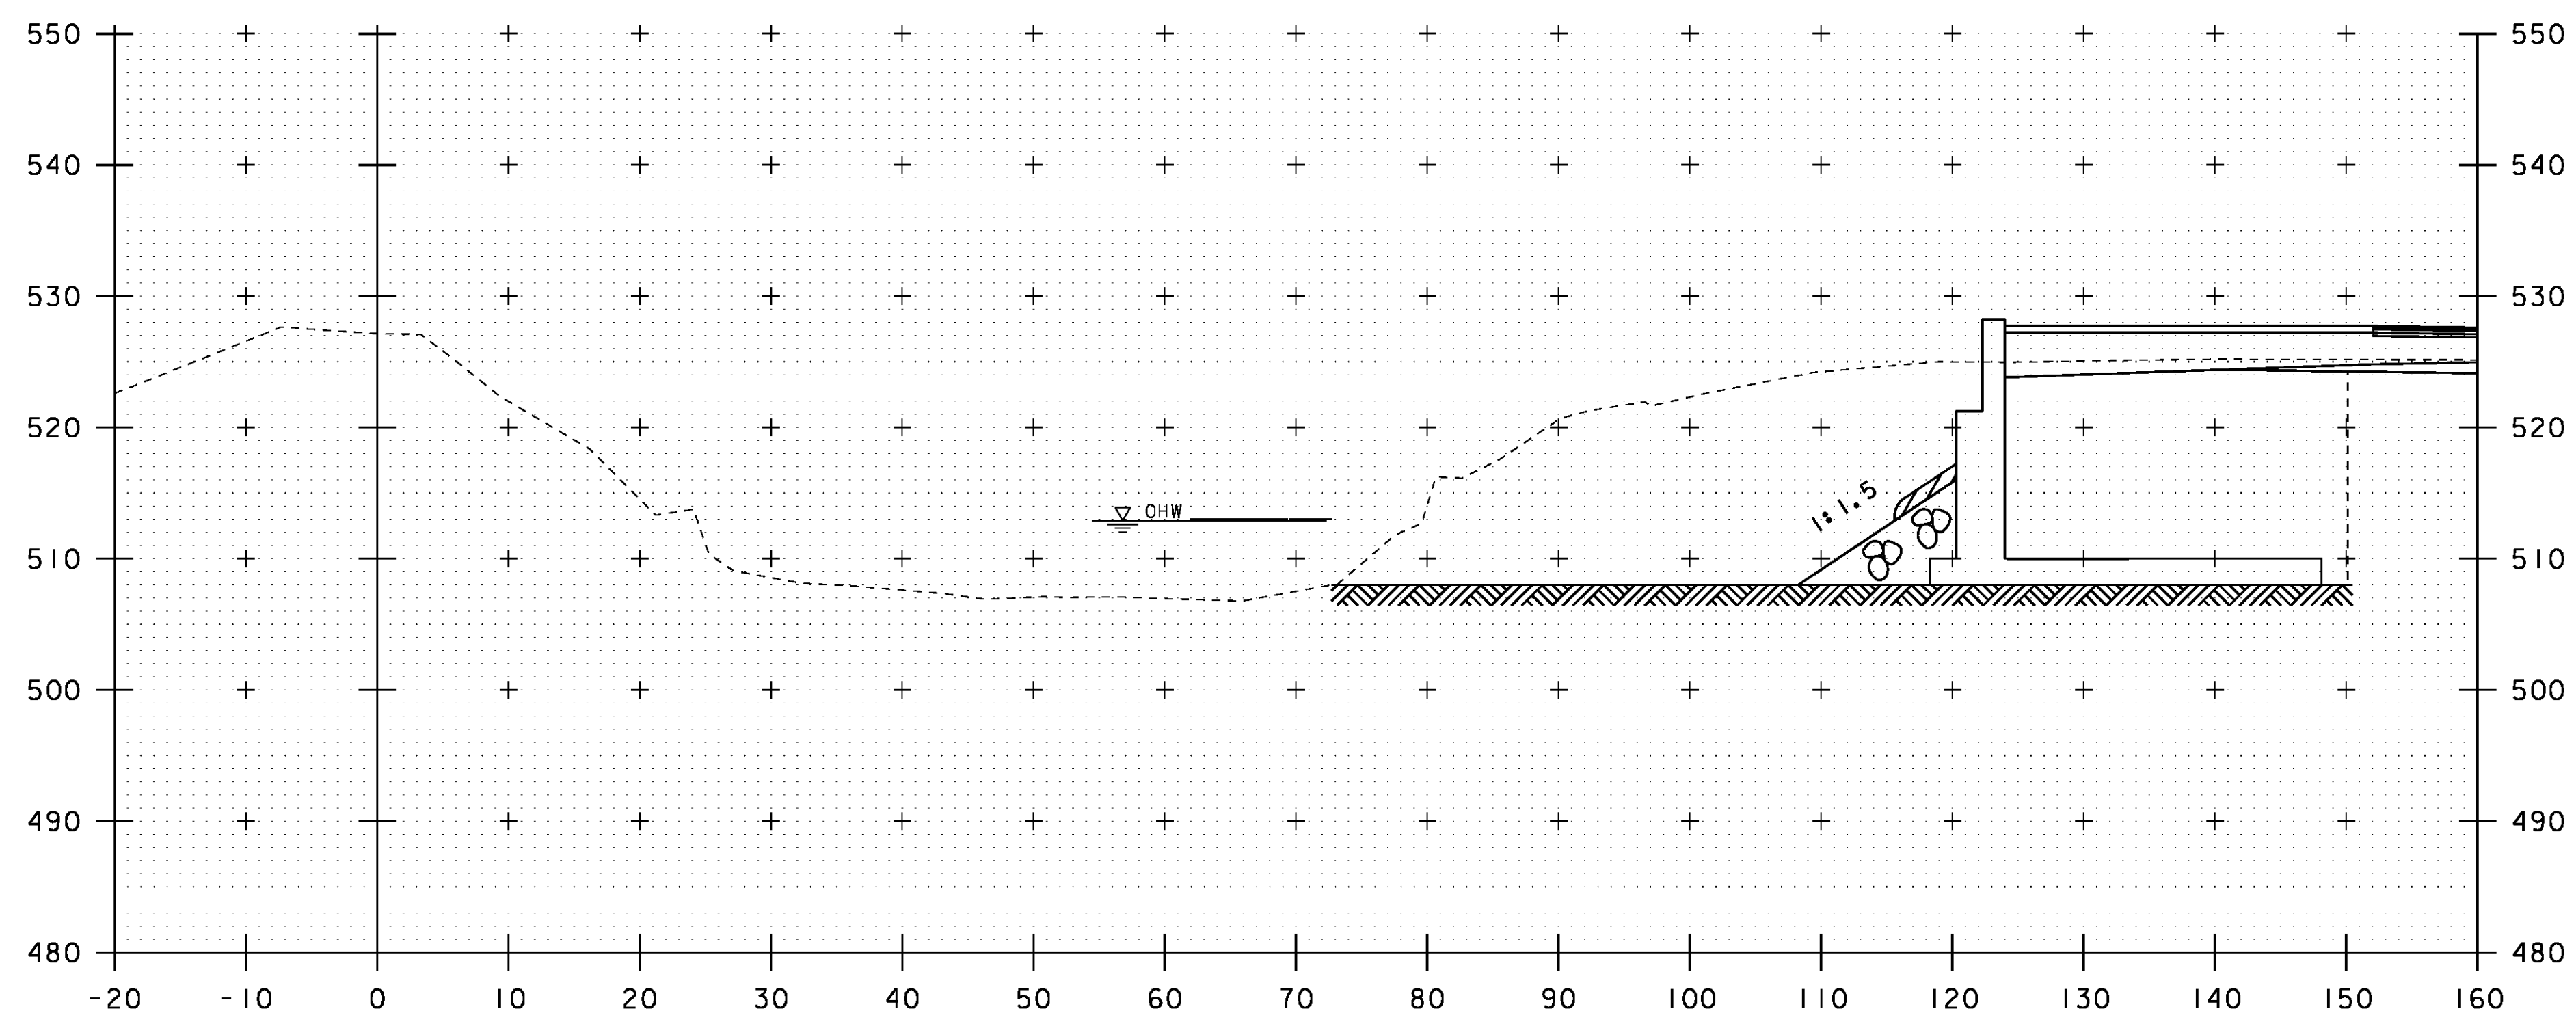

61+70

STA. 61+65.00 RT
BEGIN GRUBBING MATERIAL

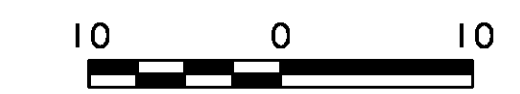

SCALE: 1" = 10'-0"

STA. 61+70 TO STA. 61+80

PROJECT NAME:	ROYALTON
PROJECT NUMBER:	BRS 0147 (13)
FILE NAME:	\BR_28\s86e055xsl_28.dgn
PROJECT LEADER:	C. CARLSON
DESIGNED BY:	D. PETERSON
BRIDGE 28 CHANNEL LINE CROSS SECTIONS (8) SHEET	153 OF 186
PLLOT DATE:	08-OCT-2013
DRAWN BY:	STR3
CHECKED BY:	C. CARLSON