



62+00

STA 62+00
 END UNCLASSIFIED CHANNEL EXCAVATION
 GEOTEXTILE UNDER STONE FILL
 STONE FILL, TYPE IV
 GRUBBING MATERIAL

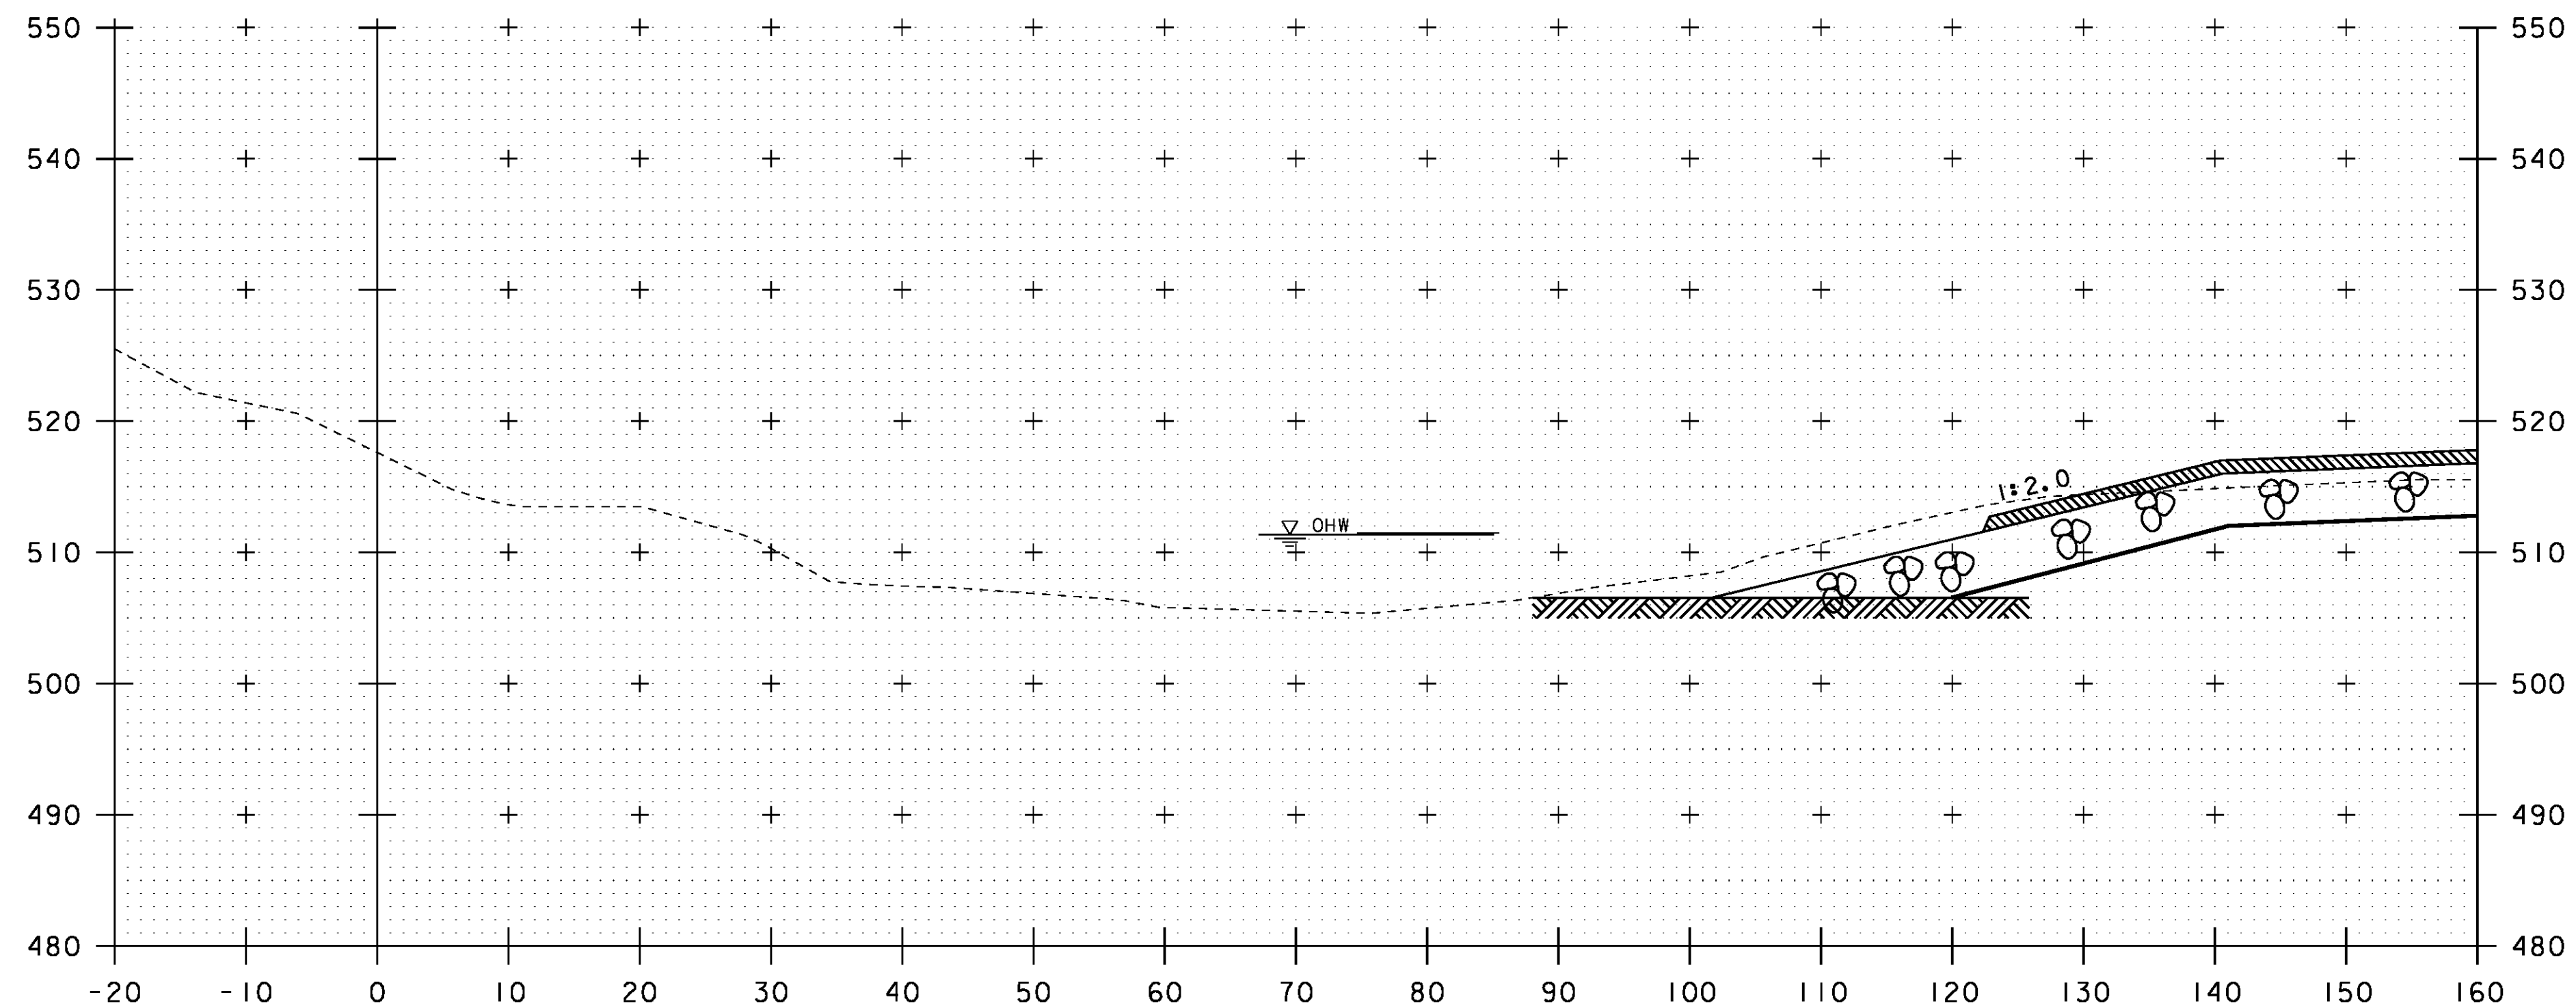

61+90

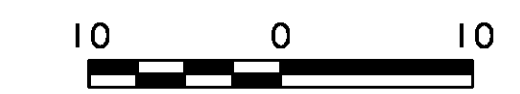

SCALE: 1" = 10'-0"

STA. 61+90 TO STA. 62+00

PROJECT NAME:	ROYALTON
PROJECT NUMBER:	BRS 0147 (13)
FILE NAME:	\BR_28\86e055xsl_28.dgn
PROJECT LEADER:	C. CARLSON
DESIGNED BY:	D. PETERSON
BRIDGE 28 CHANNEL LINE CROSS SECTIONS (9) SHEET	154 OF 186
PLOT DATE:	08-OCT-2013
DRAWN BY:	STR3
CHECKED BY:	C. CARLSON