




30+75

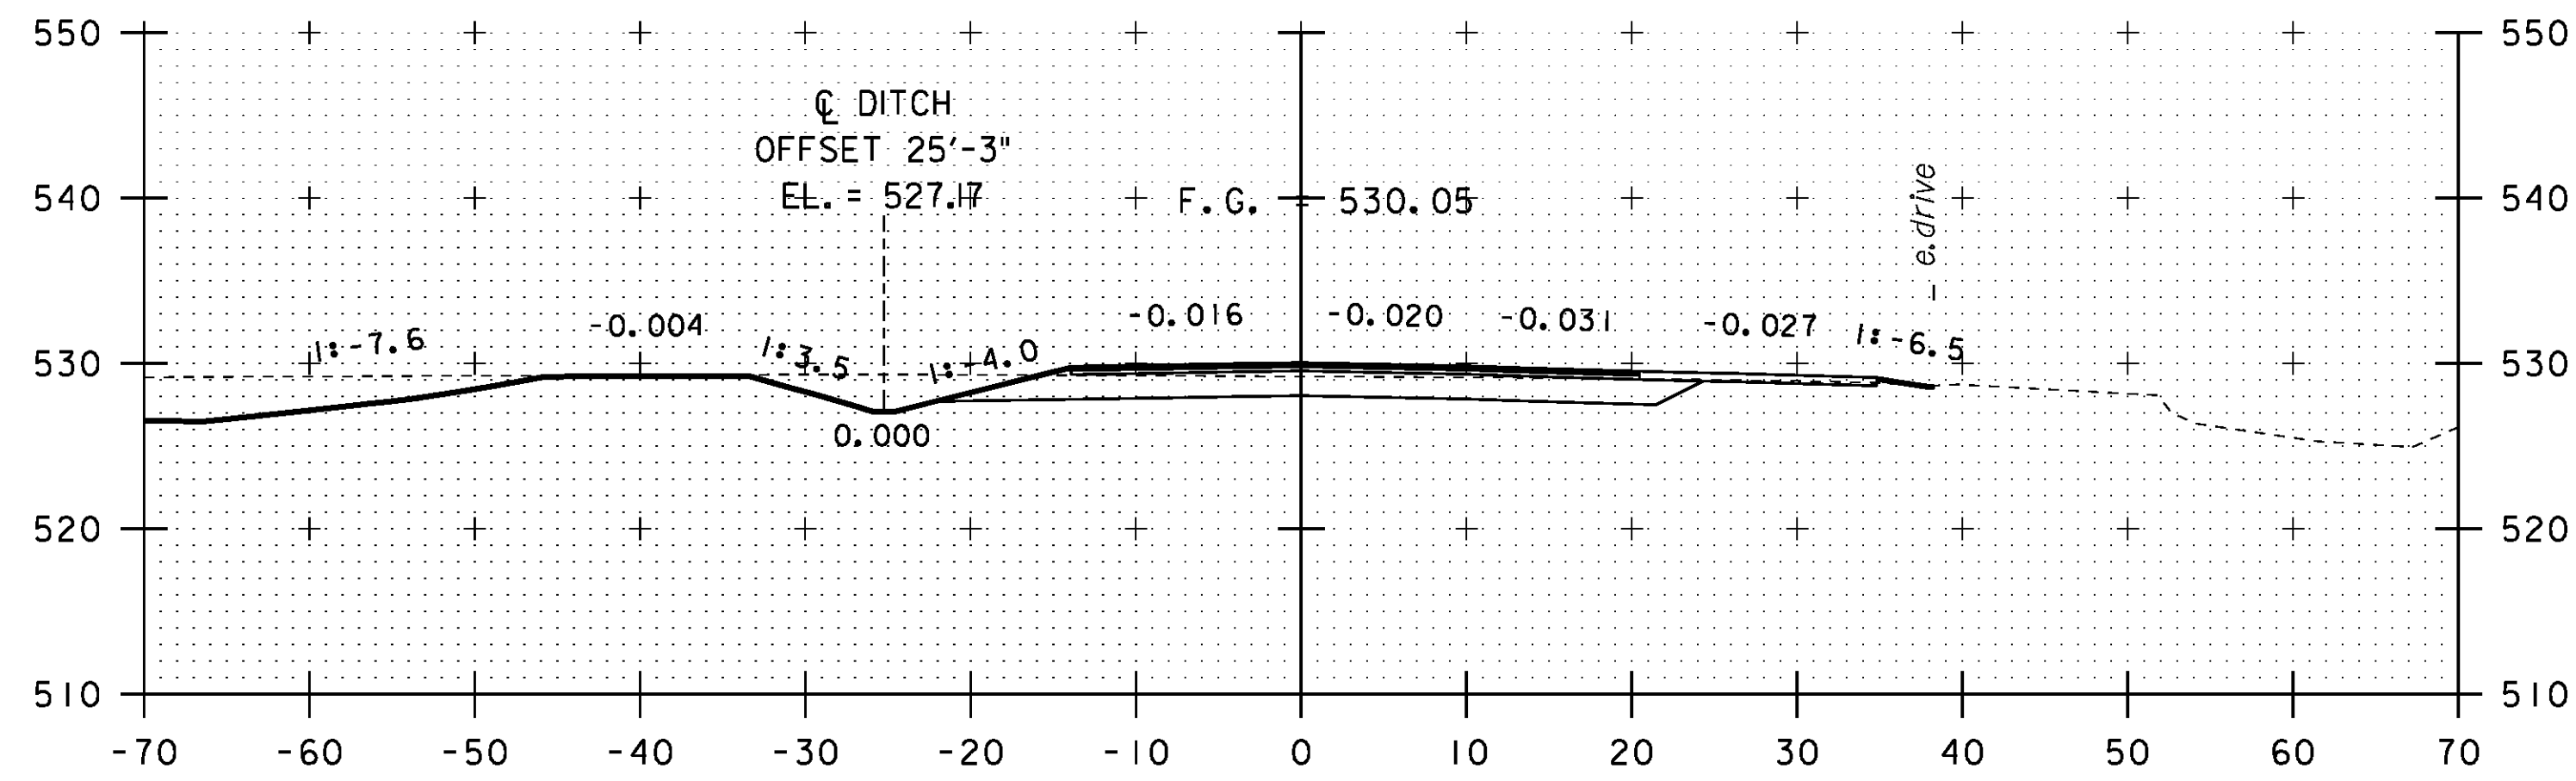


30+50

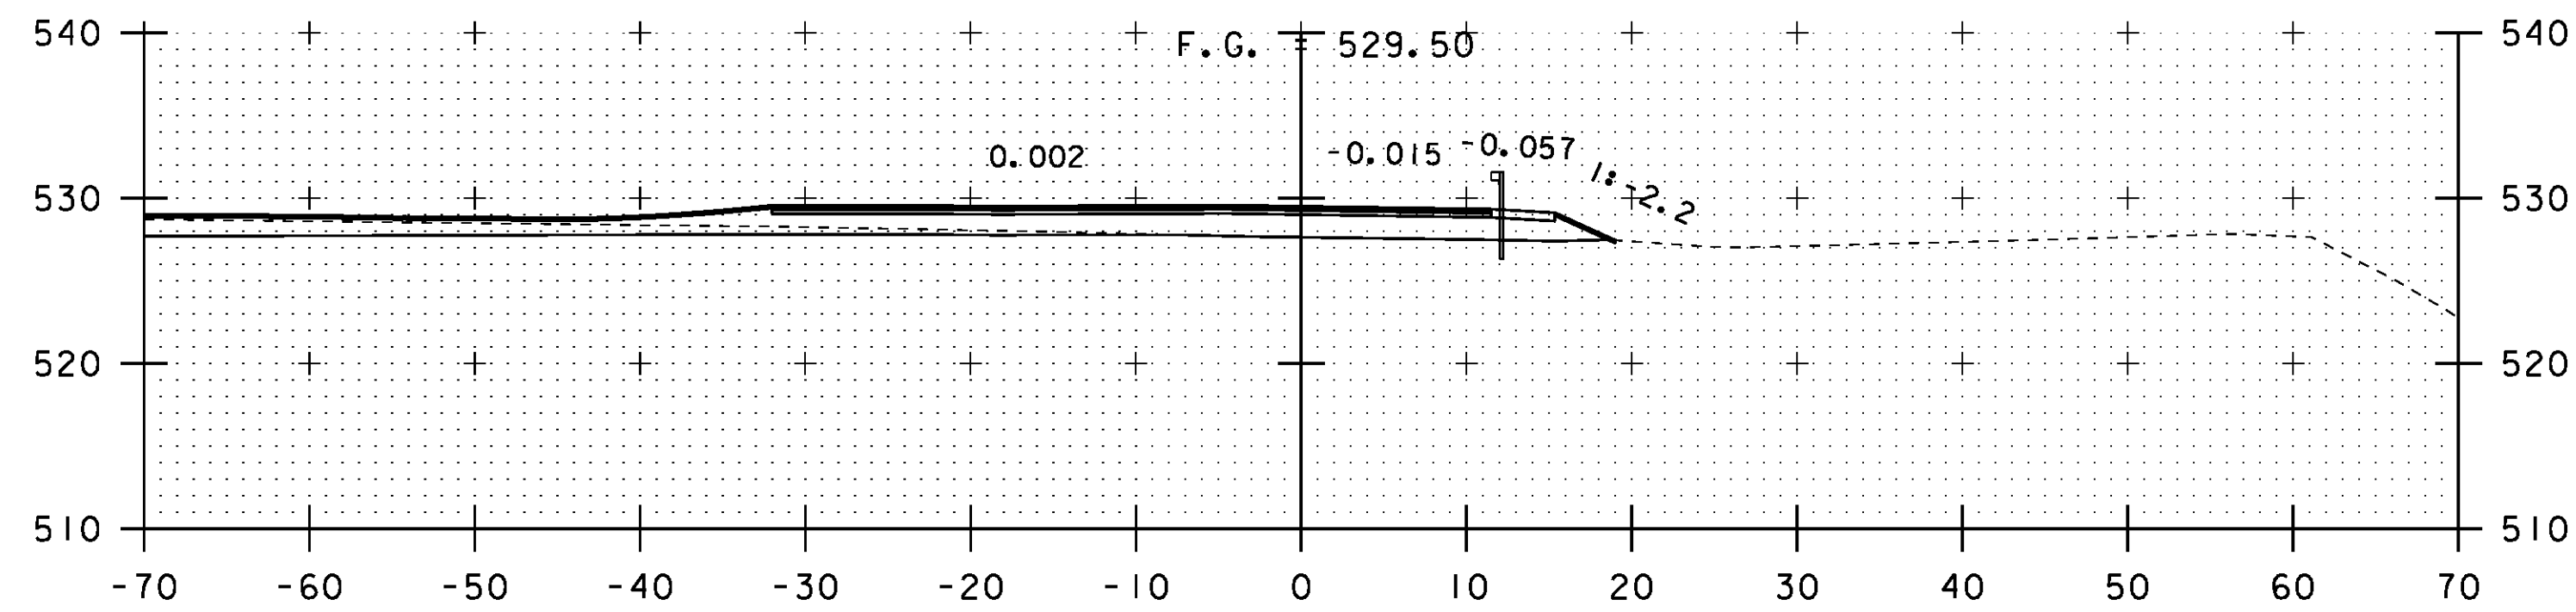

30+25

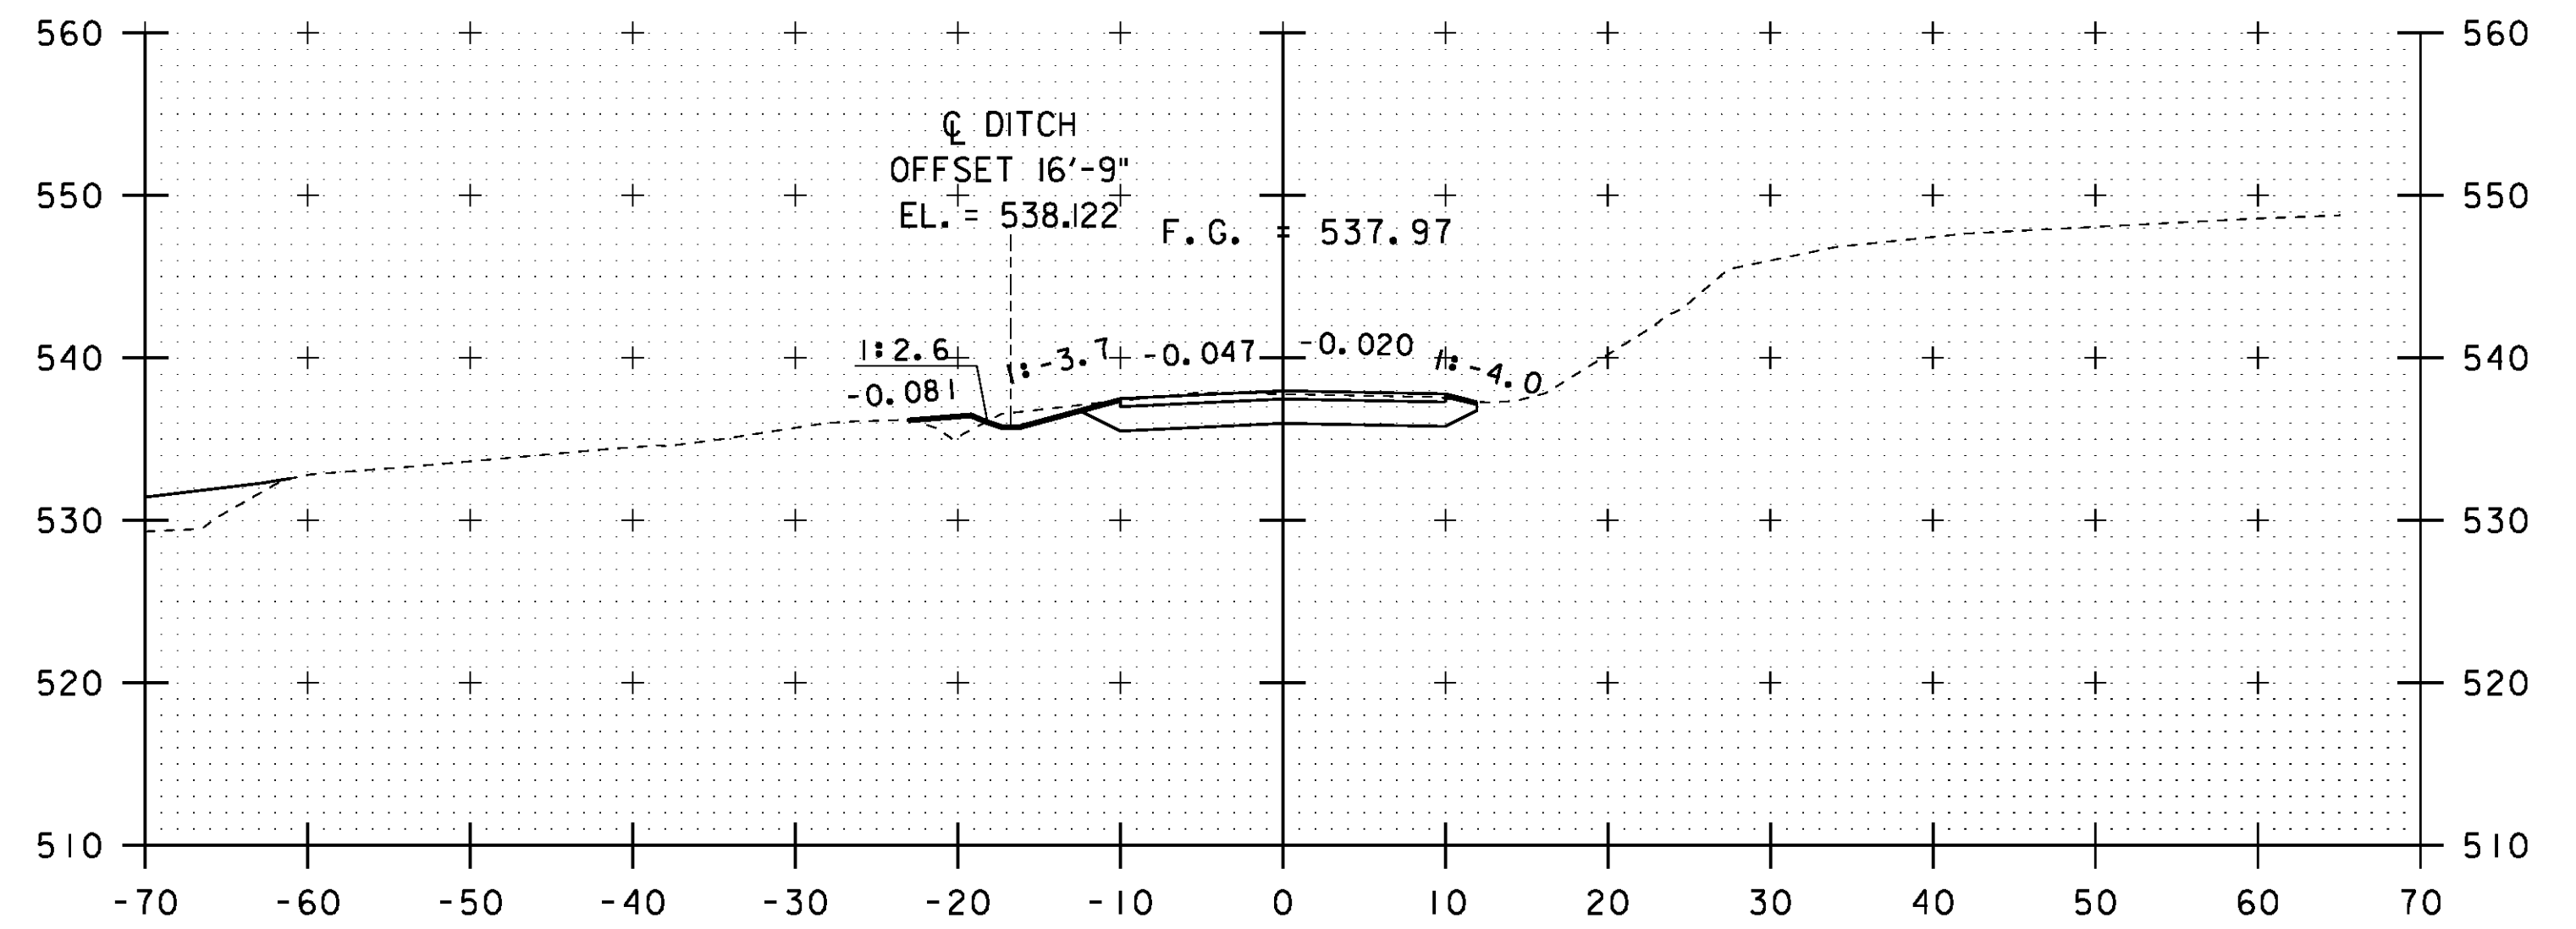

31+25

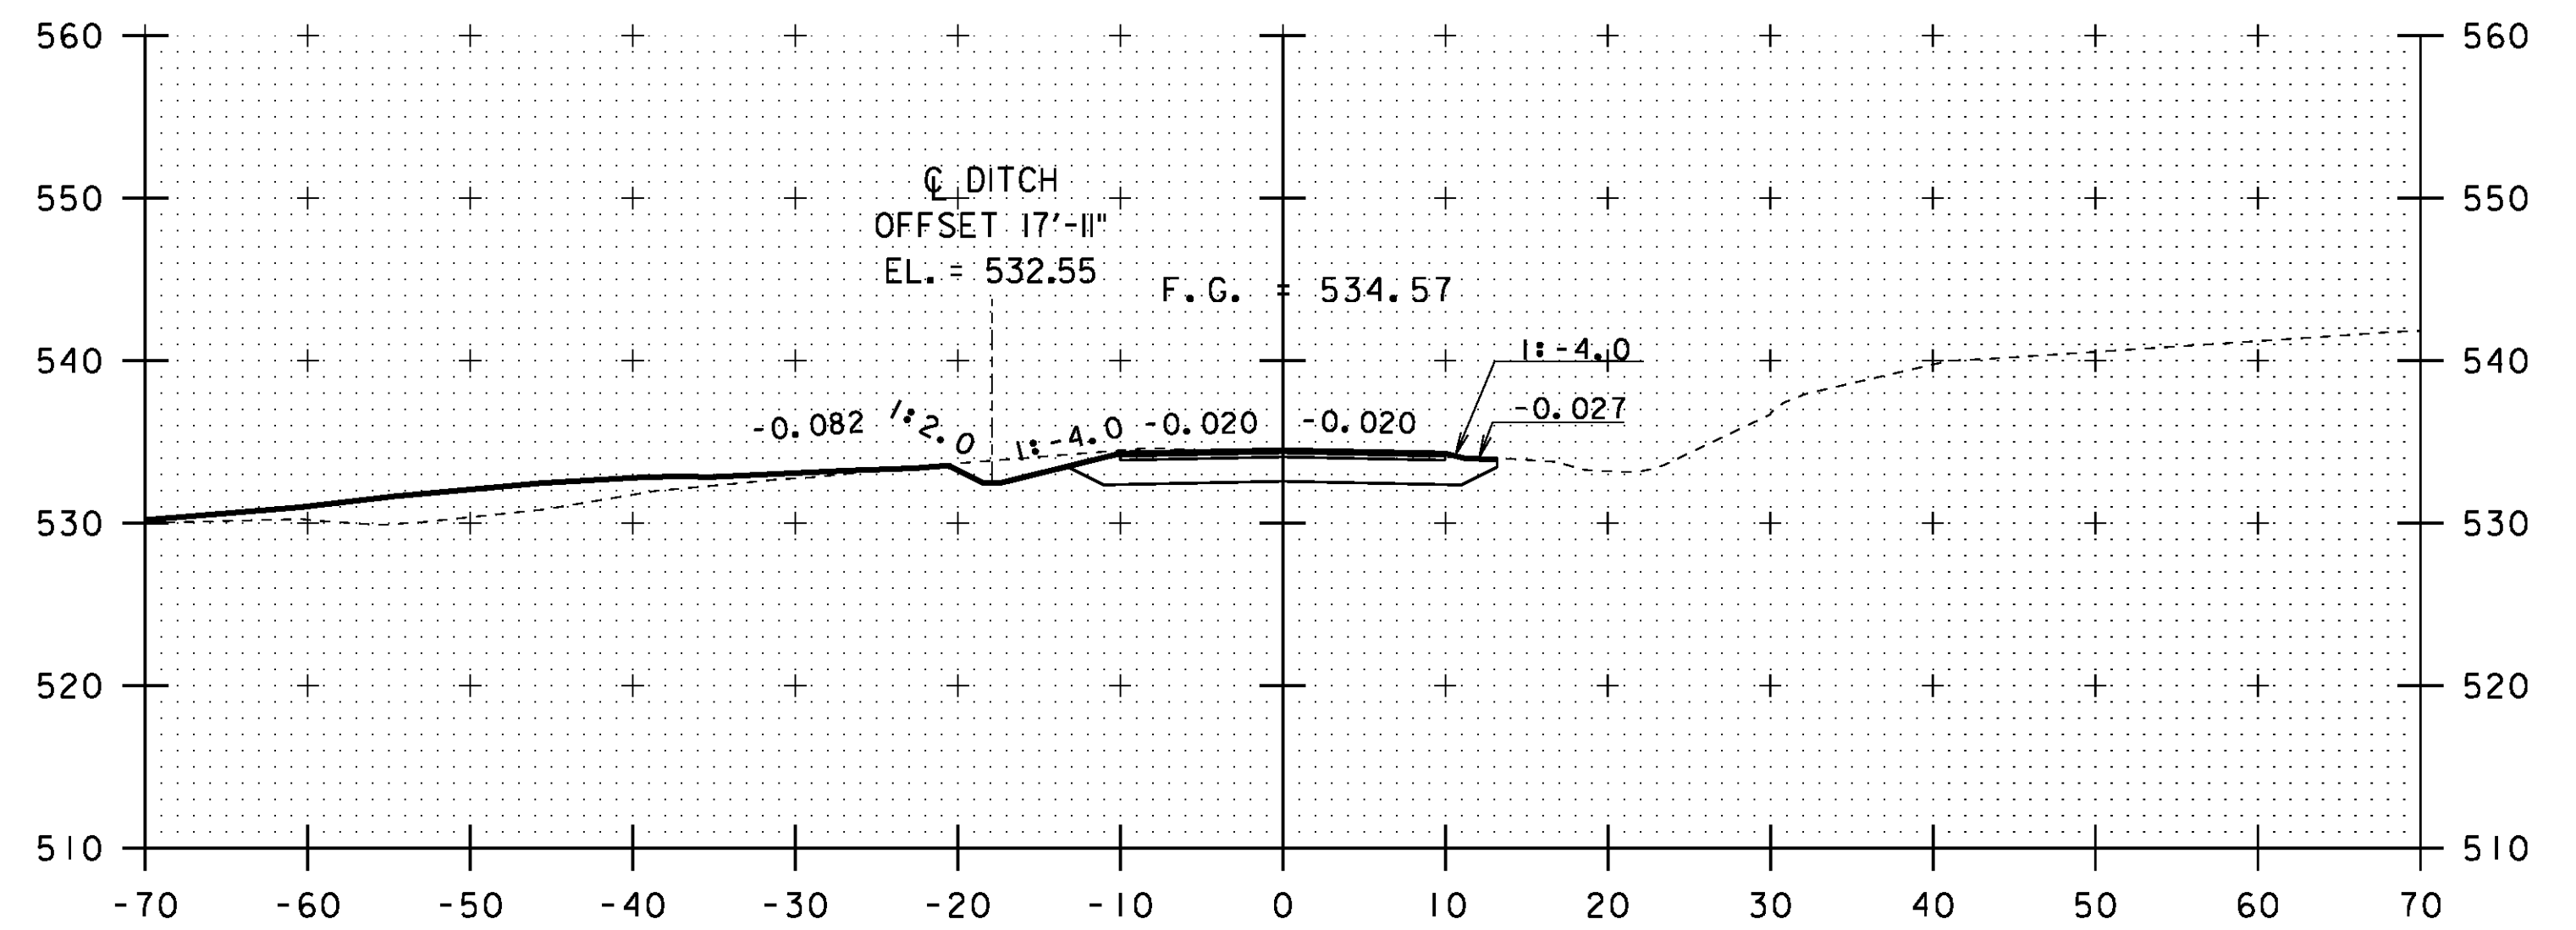

31+00



SCALE: 1" = 10'-0"

STA. 30+25 TO STA. 31+25

PROJECT NAME:	ROYALTON	FILE NAME:	\BR_28\86e055xsl_28.dgn	PLOT DATE:	08-OCT-2013
PROJECT NUMBER:	BRS 0147 (13)	PROJECT LEADER:	C. CARLSON	DRAWN BY:	STR3
		DESIGNED BY:	D. PETERSON	CHECKED BY:	C. CARLSON
		BRIDGE 28 TH 22 CROSS SECTIONS (1)		SHEET	155 OF 186