
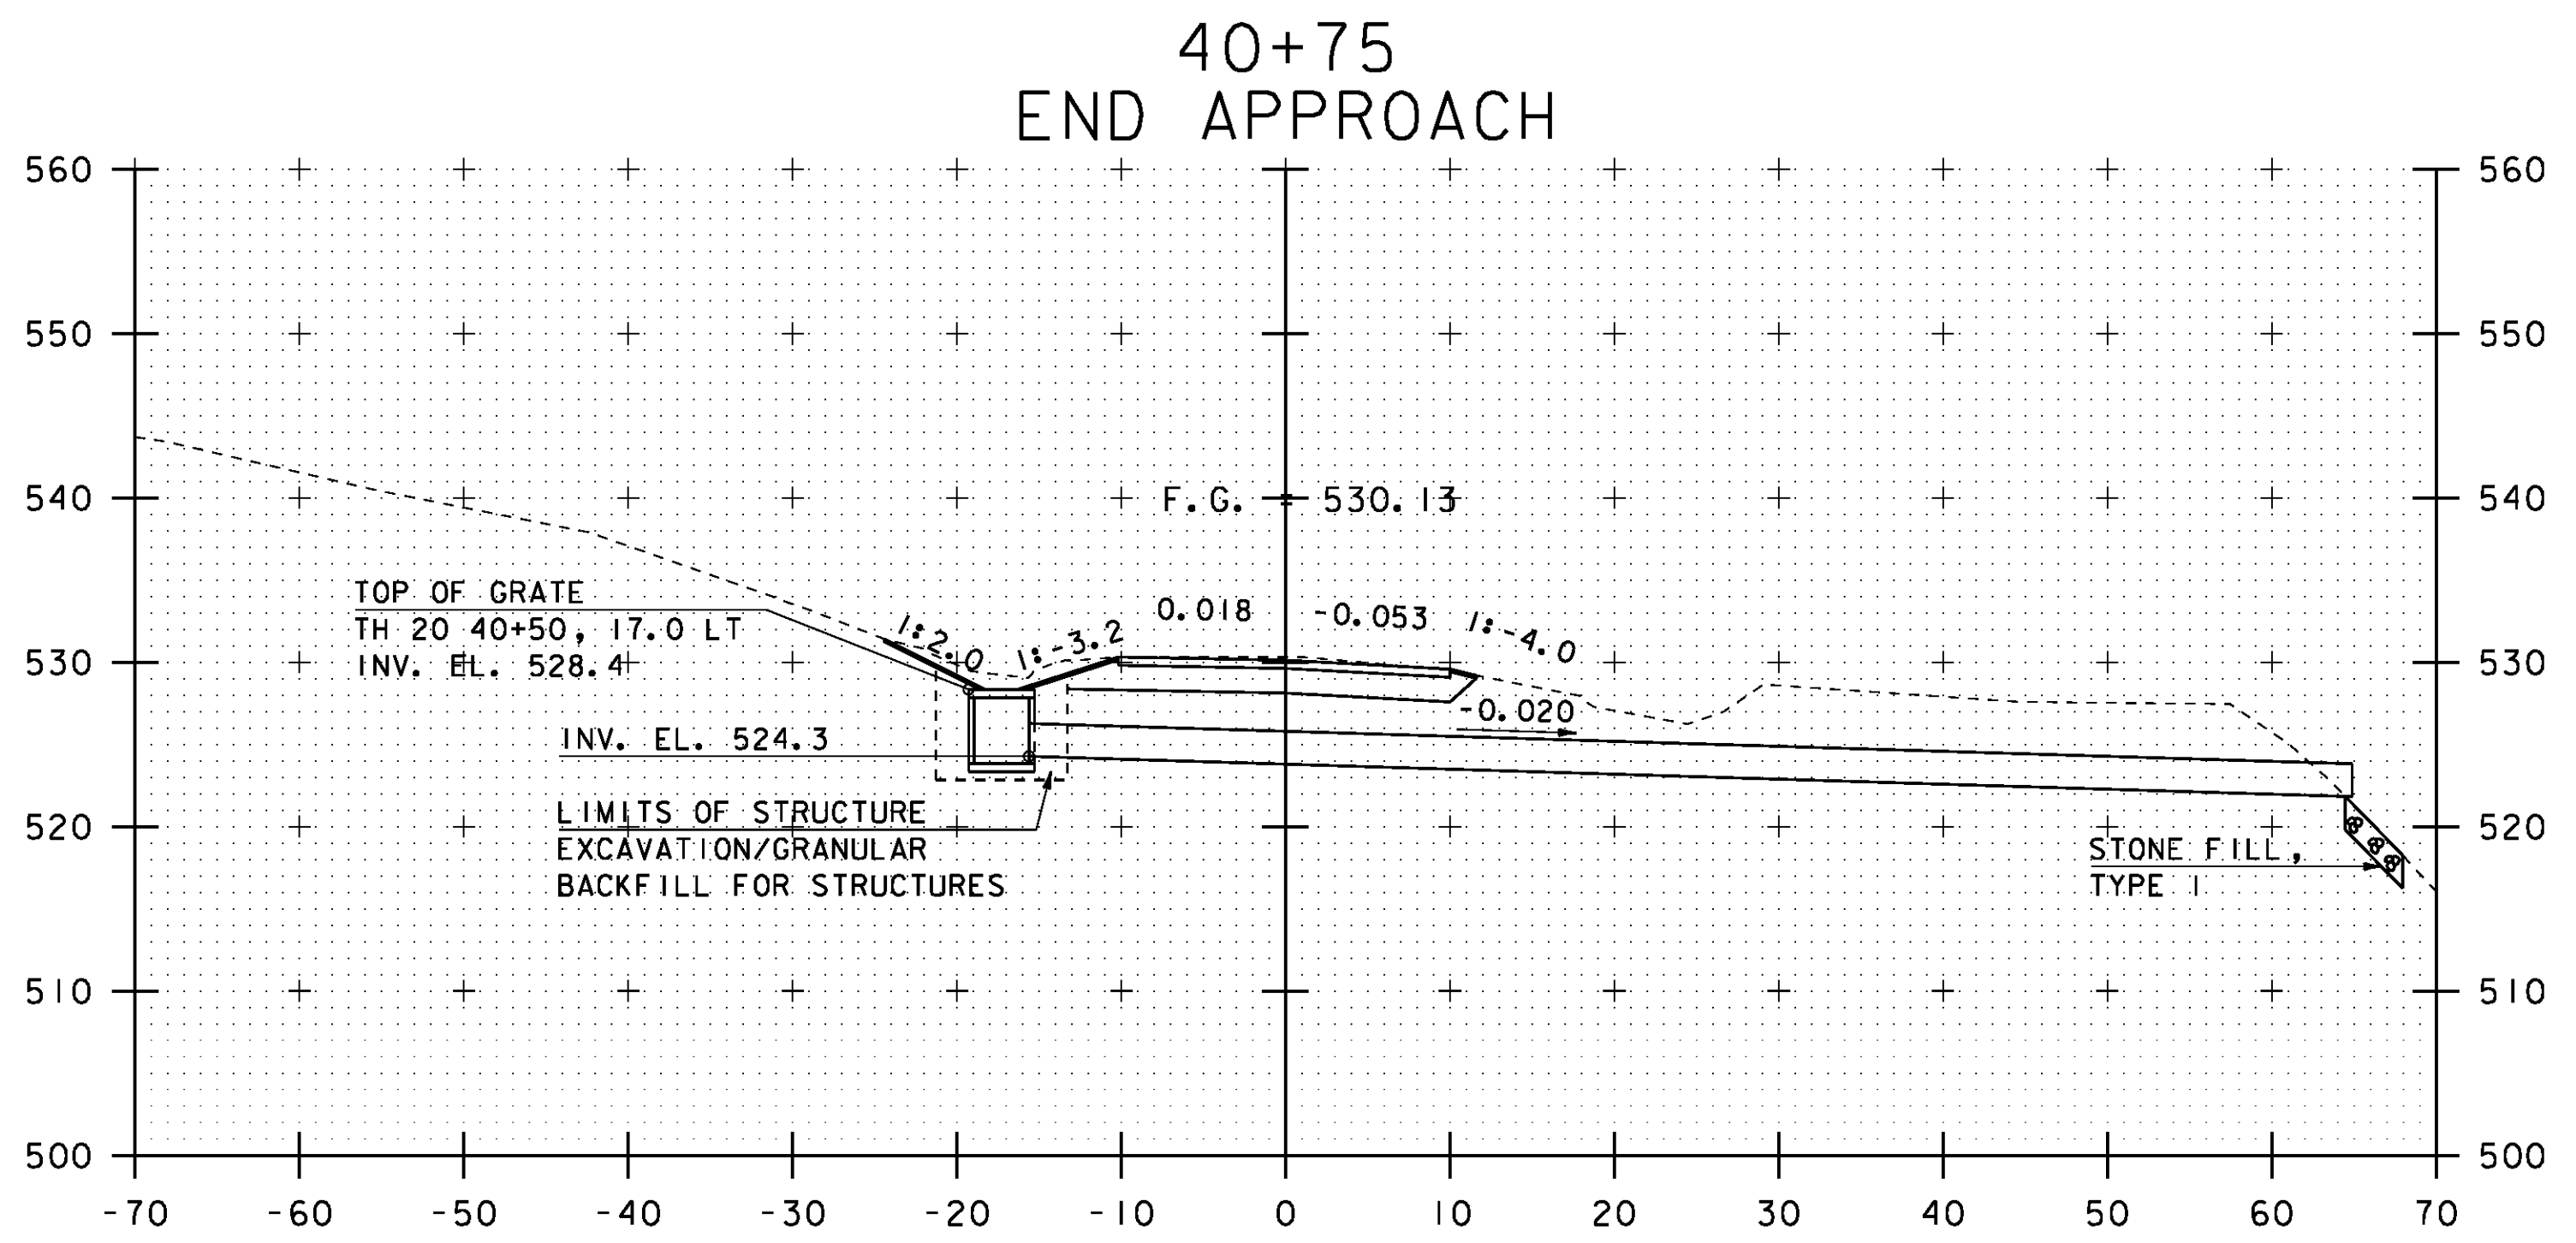
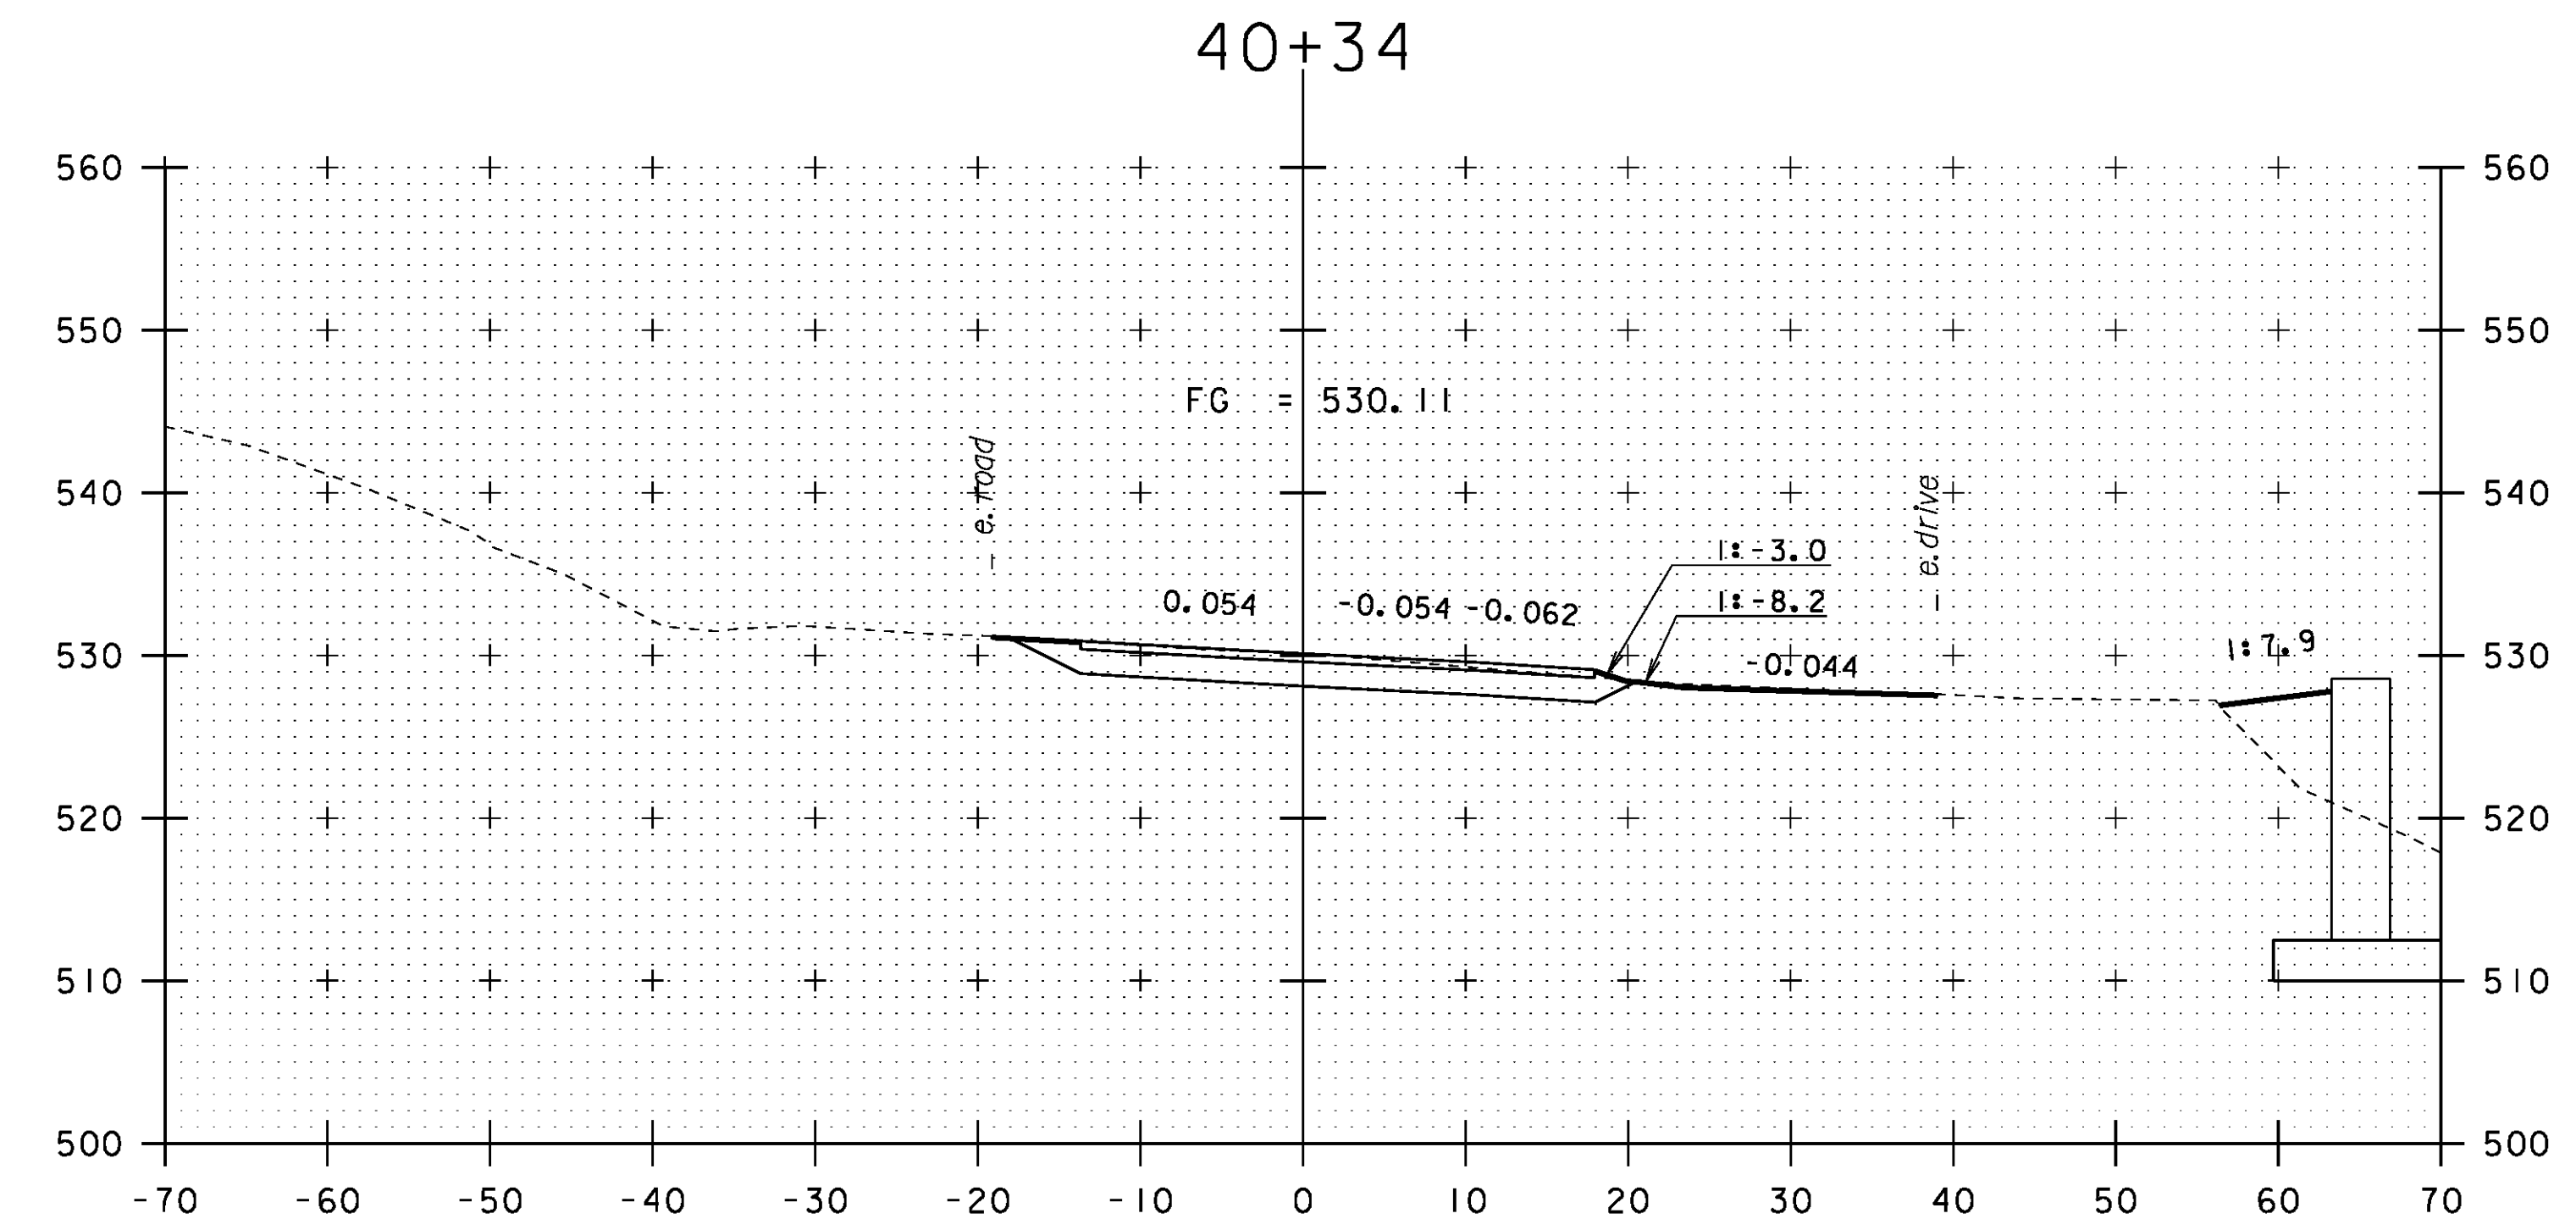
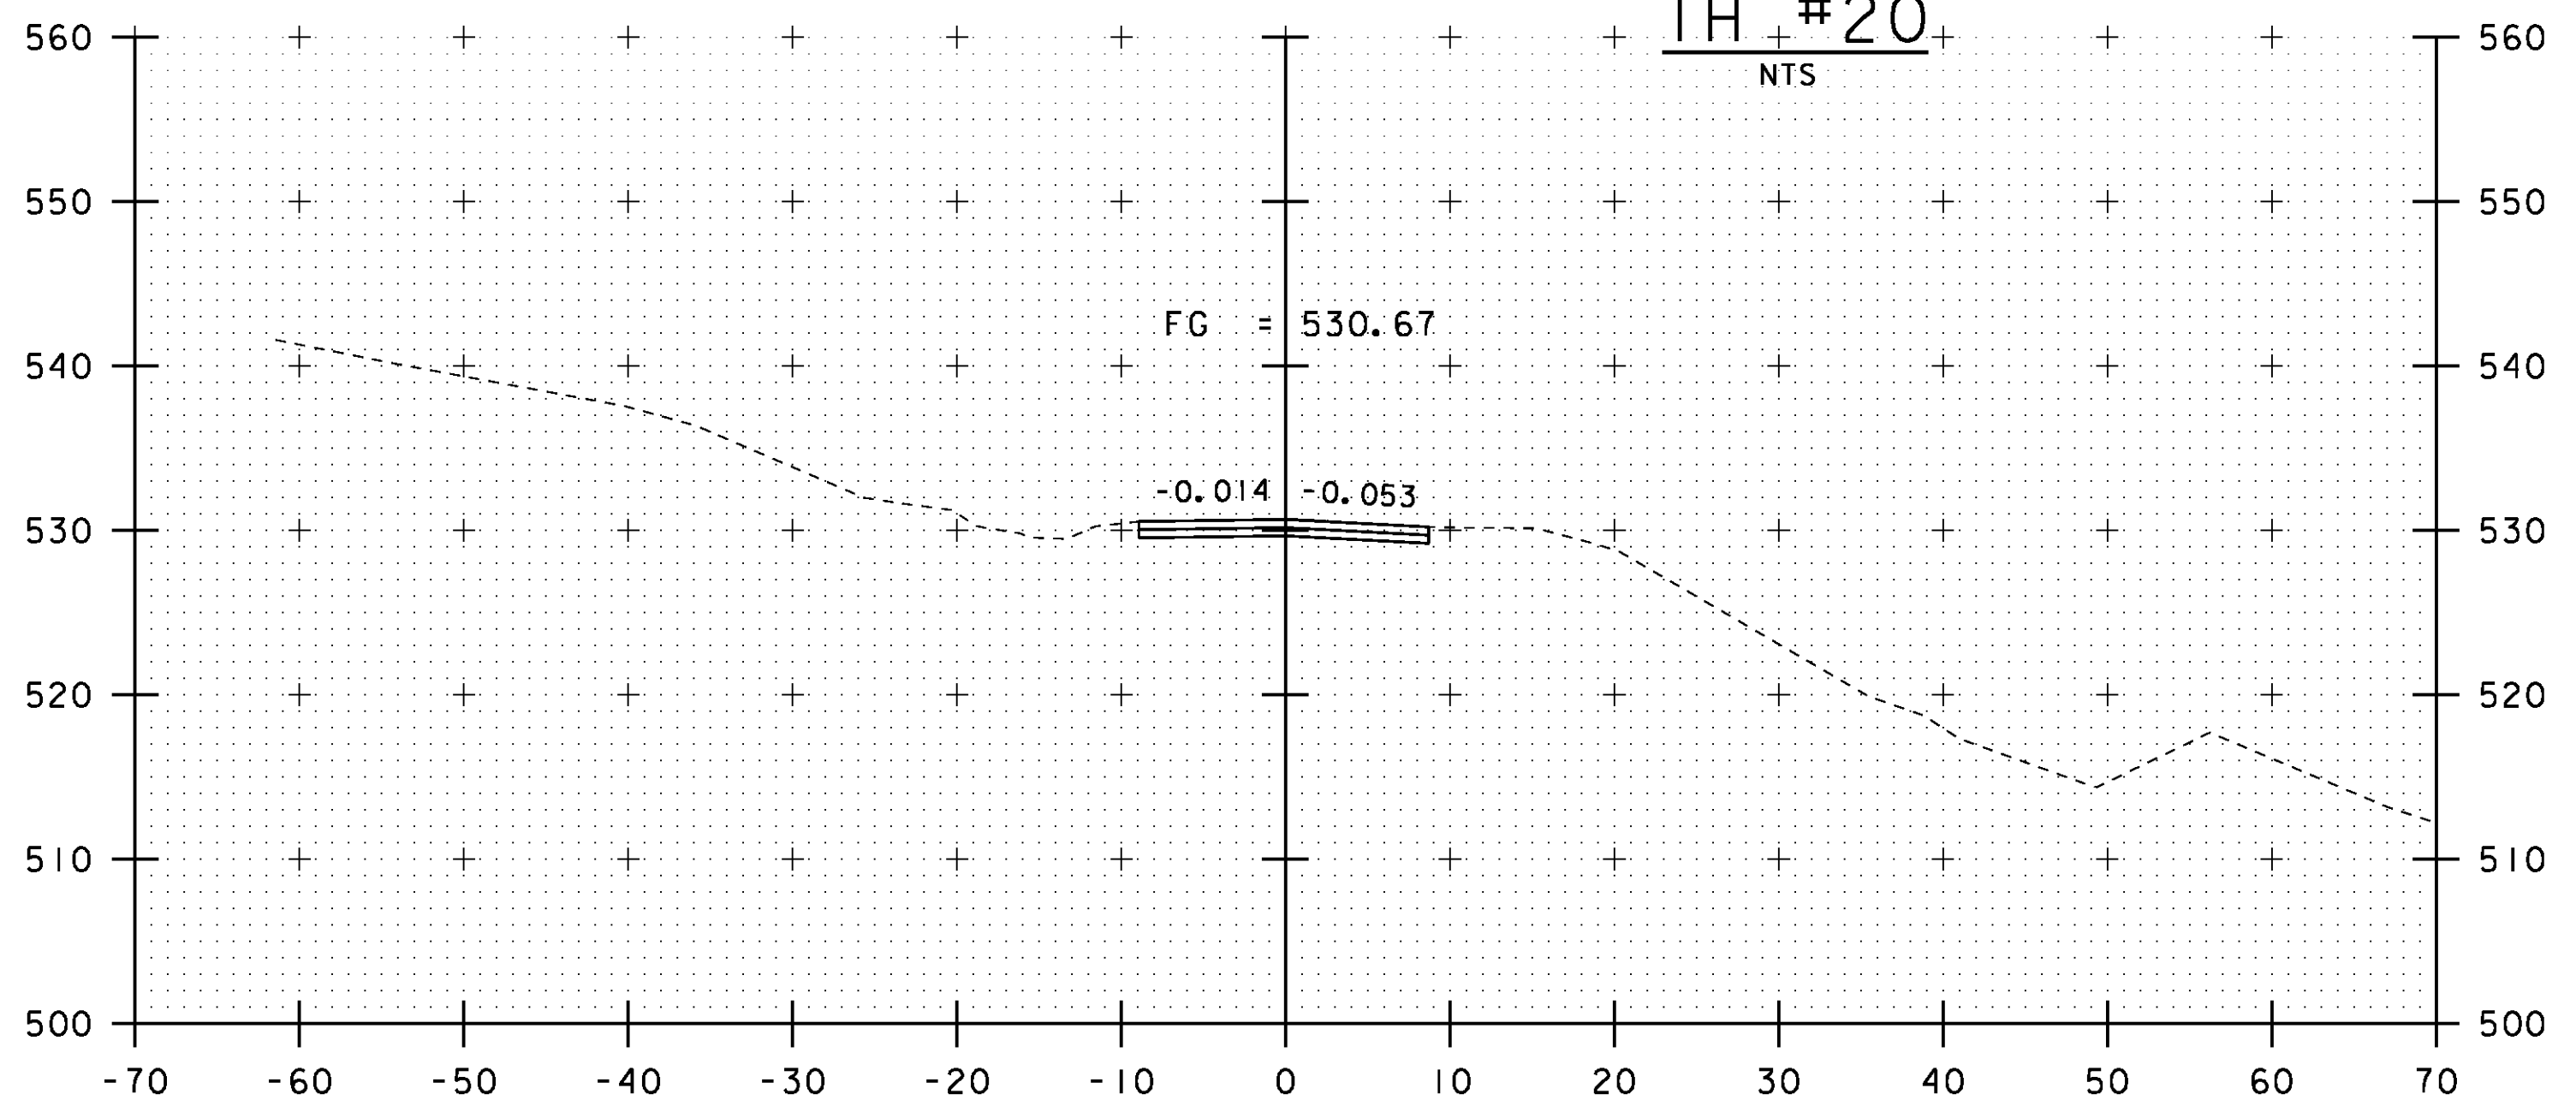



MATERIAL TRANSITION DIAGRAM

TH #20
NTS

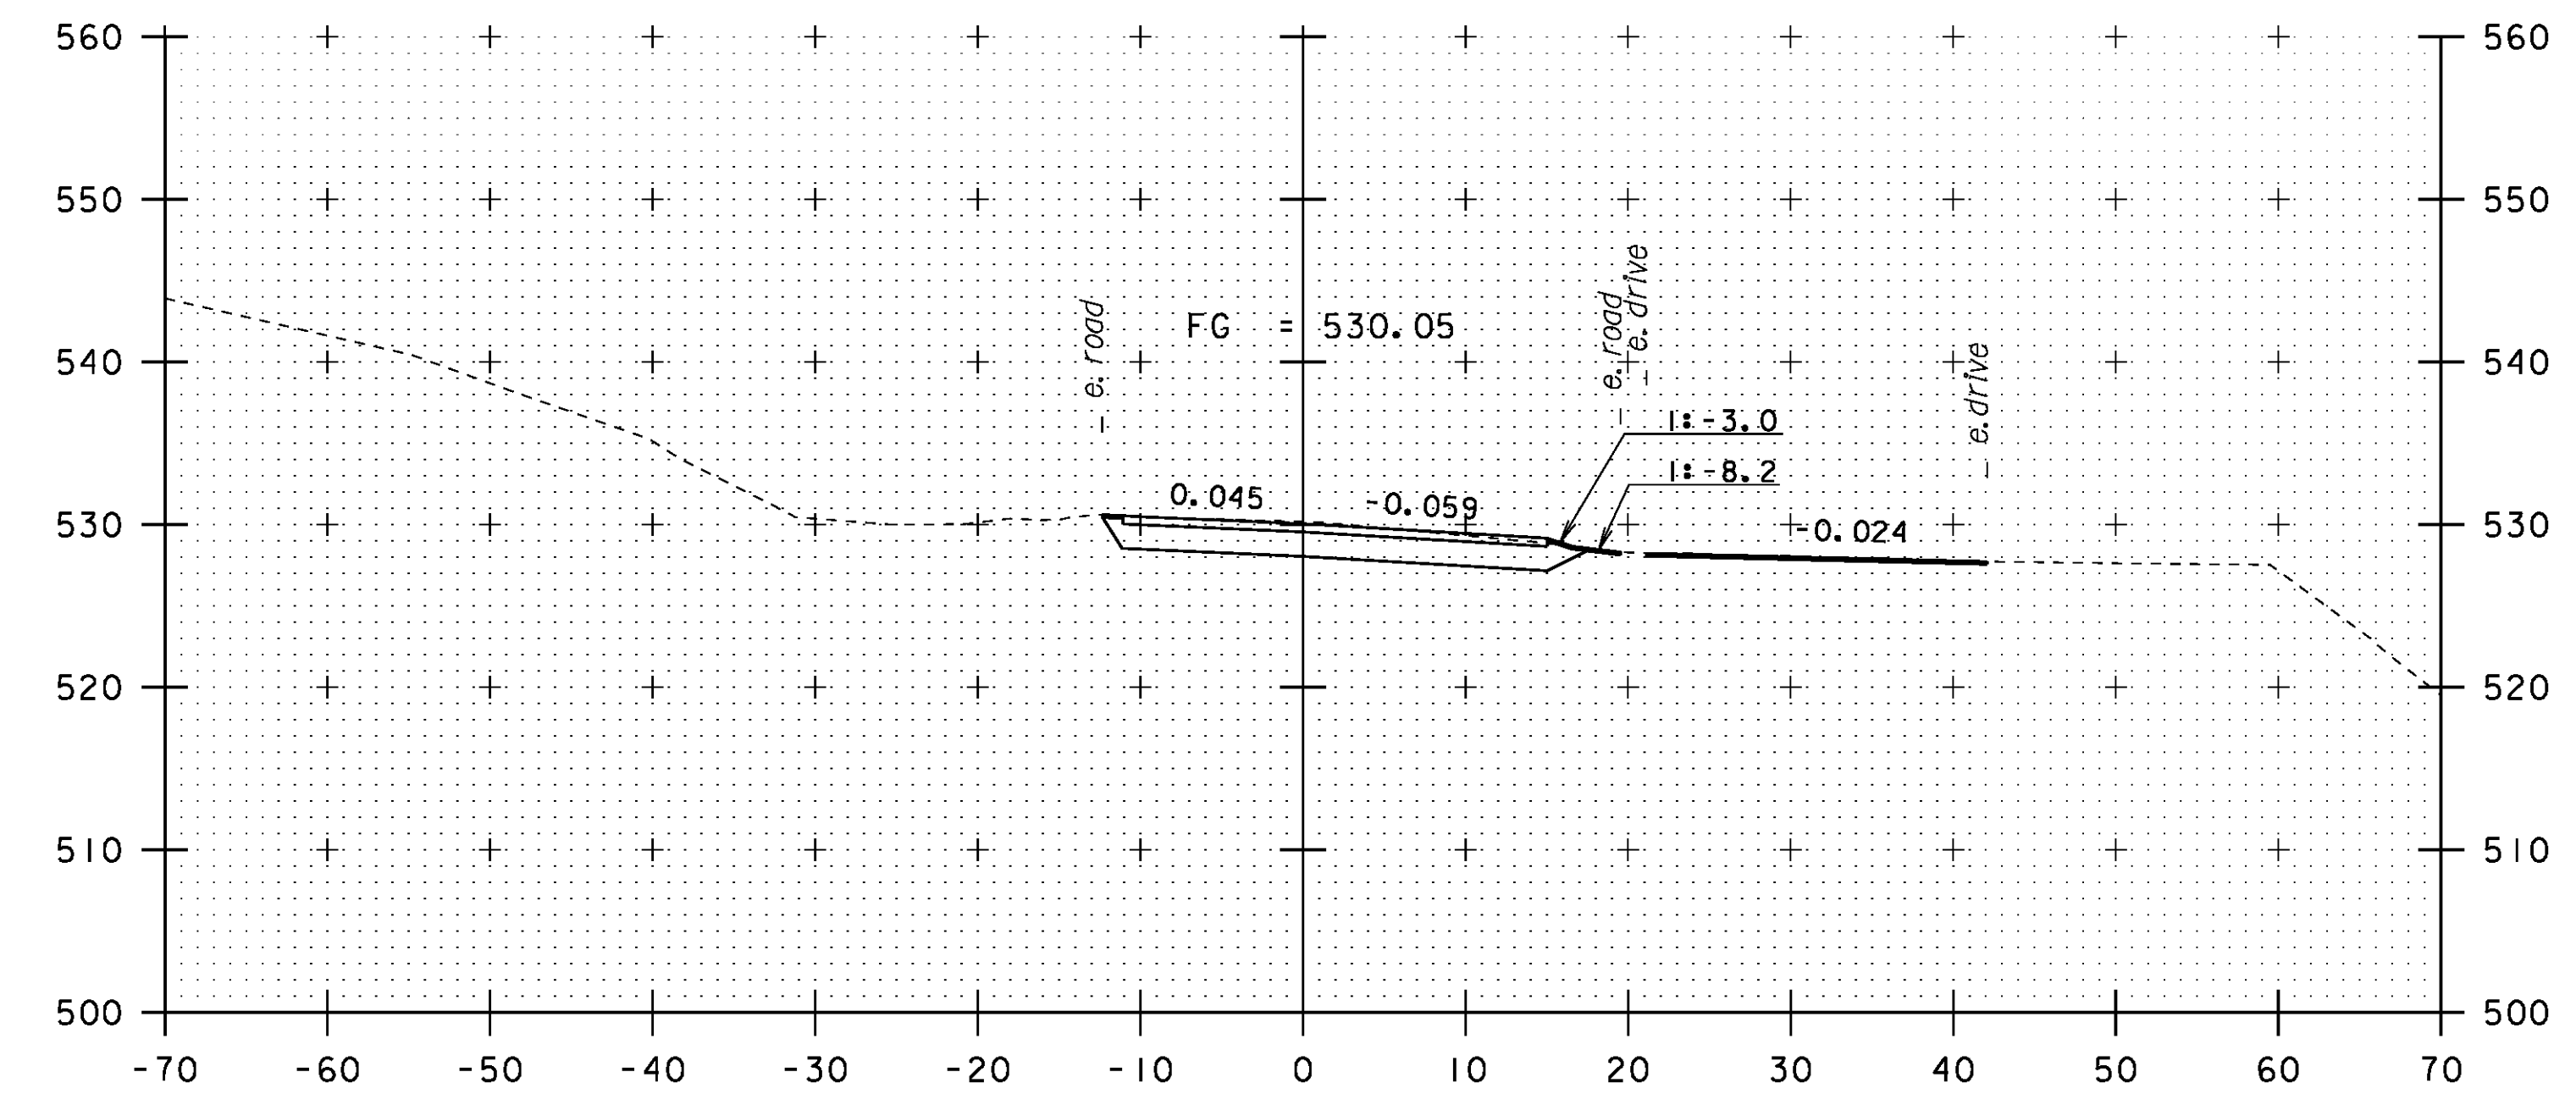

TH #20 STA 40+50 C/L
NEW PRECAST REINFORCED CONCRETE DROP INLET WITH CAST
IRON GRATE, TYPE D, NEW 24" X 85' PCCSP (0.064),
CAAP (0.060), RCP (CL. 111), OR CPEP (SL) OPTION W/
STONE FILL, TYPE I & OUTLET

40+50

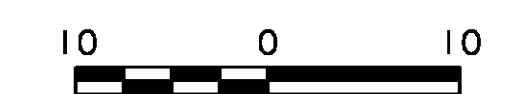

SCALE: 1" = 10' - 0"

STA. 40+25 TO STA. 40+75

PROJECT NAME:	ROYALTON	FILE NAME:	\BR_28\86e055xsl_28.dgn	PLOT DATE:	08-OCT-2013
PROJECT NUMBER:	BRS 0147 (13)	PROJECT LEADER:	C. CARLSON	DRAWN BY:	STR3
		DESIGNED BY:	D. PETERSON	CHECKED BY:	C. CARLSON
		BRIDGE 28 TH 20 CROSS SECTIONS		SHEET	157 OF 186