


NOTE:

1. SEE SHEET 175 FOR EPSC LAYOUT PLAN SYMBOLGY LEGEND

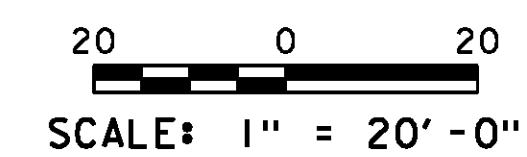

PROJECT NAME: ROYALTON
 PROJECT NUMBER: BRS 0147 (13)

FILE NAME: \BR 27\s86e055erobdr_27.dgn PLOT DATE: 08-OCT-2013
 PROJECT LEADER: C. CARLSON DRAWN BY: D. PETERSON
 DESIGNED BY: D. PETERSON CHECKED BY: C. CARLSON
 BRIDGE 27 EPSC EXISTING CONDITION (3) SHEET 162 OF 186