


NOTES:

1. SILT FENCE INSTALLATION MAY REQUIRE PHASING TO MAXIMIZE EFFECTIVENESS. INSTALL AND/OR MOVE SILT FENCE AS CONSTRUCTION PROGRESSES TO OBTAIN THE GREATEST PREVENTION OF SEDIMENT TRANSPORT.
2. SEE SHEET 175 FOR EPSC LAYOUT PLAN SYMBOLOGY LEGEND

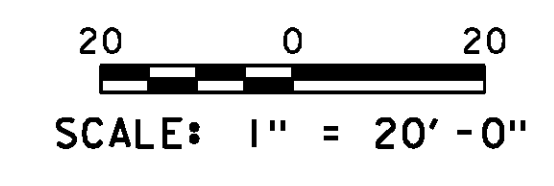

PROJECT NAME:	ROYALTON
PROJECT NUMBER:	BRS 0147 (13)
FILE NAME:	\BR 27\s86e055erobdr_27.dgn
PROJECT LEADER:	C. CARLSON
DESIGNED BY:	D. PETERSON
BRIDGE 27 EPSC CONSTRUCTION CONDITION (2)	
PLOT DATE:	08-OCT-2013
DRAWN BY:	D. PETERSON
CHECKED BY:	C. CARLSON
SHEET	164 OF 186