


- NOTES:
1. SEE CROSS SECTIONS FOR FINAL GRADE INFORMATION.
  2. SEE SHEET 175 FOR EPSC LAYOUT PLAN SYMBOLOGY LEGEND

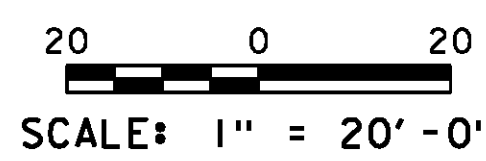

PROJECT NAME:	ROYALTON
PROJECT NUMBER:	BRS 0147 (13)
FILE NAME:	\BR 27\s86e055erobdr_27.dgn
PROJECT LEADER:	C. CARLSON
DESIGNED BY:	D. PETERSON
BRIDGE 27 EPSC FINAL CONDITION (3)	
PLOT DATE:	08-OCT-2013
DRAWN BY:	D. PETERSON
CHECKED BY:	C. CARLSON
SHEET	168 OF 186