
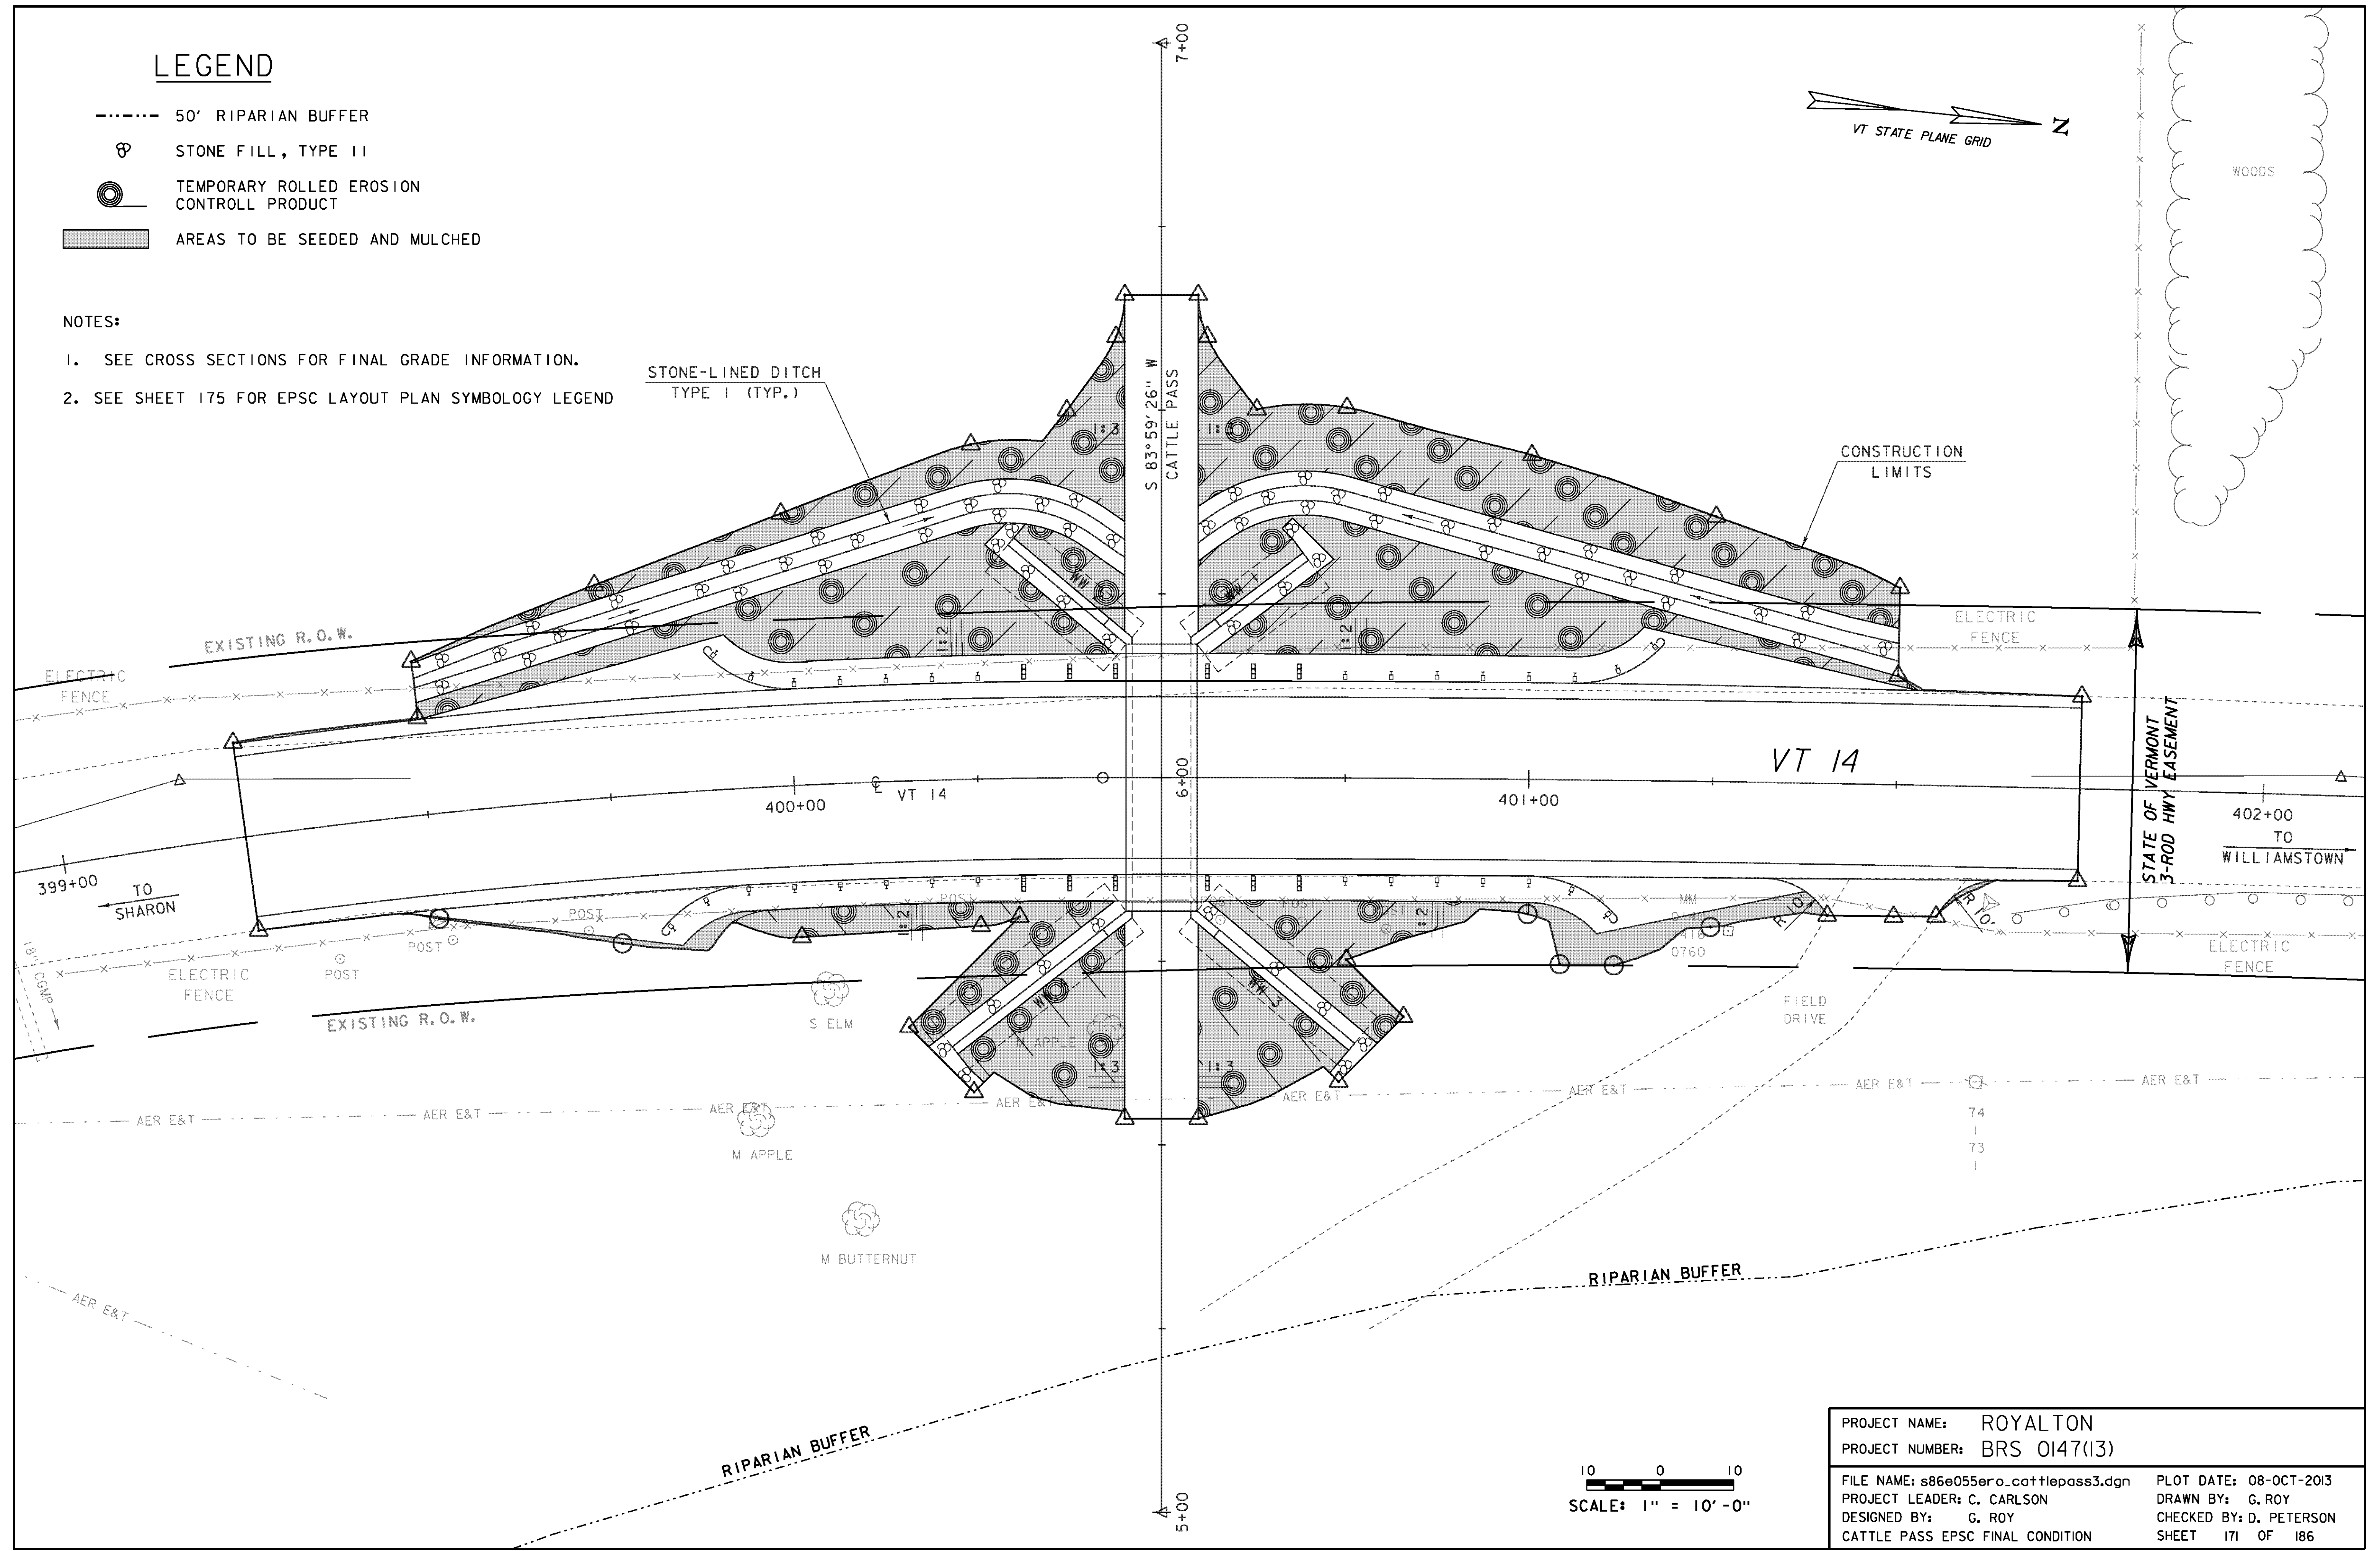


# LEGEND

- 50' RIPARIAN BUFFER
- ⊗ STONE FILL, TYPE II
- ⊙ TEMPORARY ROLLED EROSION CONTROL PRODUCT
- ▨ AREAS TO BE SEEDED AND MULCHED

- NOTES:
1. SEE CROSS SECTIONS FOR FINAL GRADE INFORMATION.
  2. SEE SHEET 175 FOR EPSC LAYOUT PLAN SYMBOLOGY LEGEND

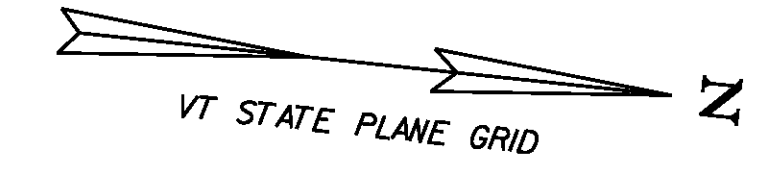

PROJECT NAME:	ROYALTON
PROJECT NUMBER:	BRS 0147(13)
FILE NAME:	s86e055ero_cattlepass3.dgn
PROJECT LEADER:	C. CARLSON
DESIGNED BY:	G. ROY
CATTLE PASS EPSC FINAL CONDITION	
PLOT DATE:	08-OCT-2013
DRAWN BY:	G. ROY
CHECKED BY:	D. PETERSON
SHEET	171 OF 186