


- NOTES:
1. SEE CROSS SECTIONS FOR FINAL GRADE INFORMATION.
 2. SEE SHEET 175 FOR EPSC LAYOUT PLAN SYMBOLOGY LEGEND

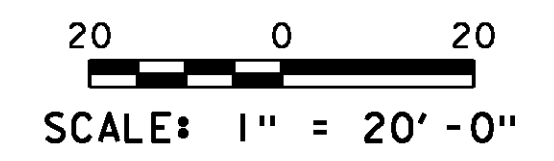

PROJECT NAME:	ROYALTON
PROJECT NUMBER:	BRS 0147 (I3)
FILE NAME:	\BR 28\s86e055erobdr_28.dgn
PROJECT LEADER:	C. CARLSON
DESIGNED BY:	L. BULLOCK
BRIDGE 28 EPSC FINAL CONDITION	
PLOT DATE:	08-OCT-2013
DRAWN BY:	C. MOONEY
CHECKED BY:	D. PETERSON
SHEET	174 OF 186