



**SPAULDING, GEORGE F.
& AGNES W.**

**SPAULDING, GEORGE F.
& AGNES W.**

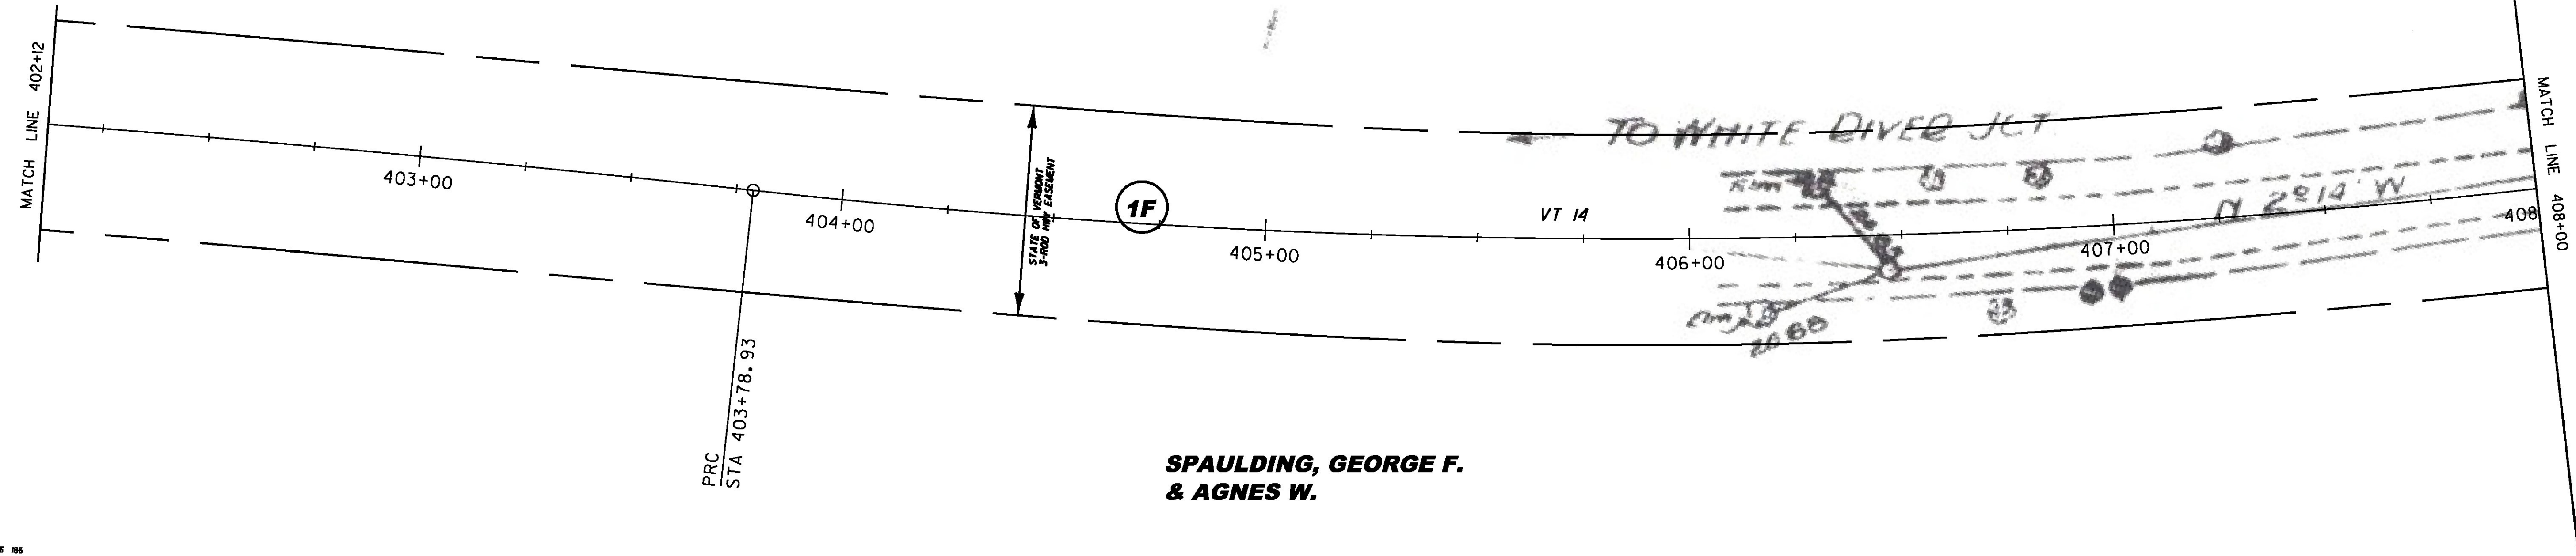

LINE SHOWN ON THIS PLAN AS EXISTING
PROPERTY LINES P/L ARE BELIEVED TO
BE ACCURATE BUT SHOULD NOT BE RELIED
UPON FOR PURPOSES UNRELATED TO THE
STATE OF VERMONT'S AQUISITION OF LAND
AND RIGHTS FOR THIS PROJECT.

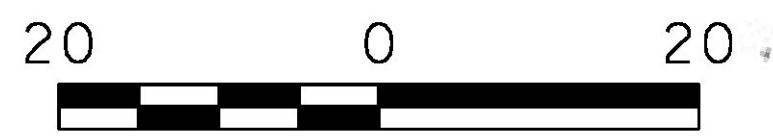

SCALE: 1" = 20' - 0"

86E055

PROJECT NAME: ROYALTON
PROJECT NUMBER: BRS 0147(13)

FILE NAME: \Layout 5.dgn
PROJECT LEADER: C. CARLSON
DESIGNED BY: D. PETERSON
ROW LAYOUT SHEET (5)

PLOT DATE: 08-OCT-2013
DRAWN BY: MR
CHECKED BY: JB
ROW SHEET 184 OF 186