


STATE OF VERMONT AGENCY OF TRANSPORTATION



PROPOSED IMPROVEMENT BRIDGE PROJECT TOWN OF ROYALTON COUNTY OF WINDSOR

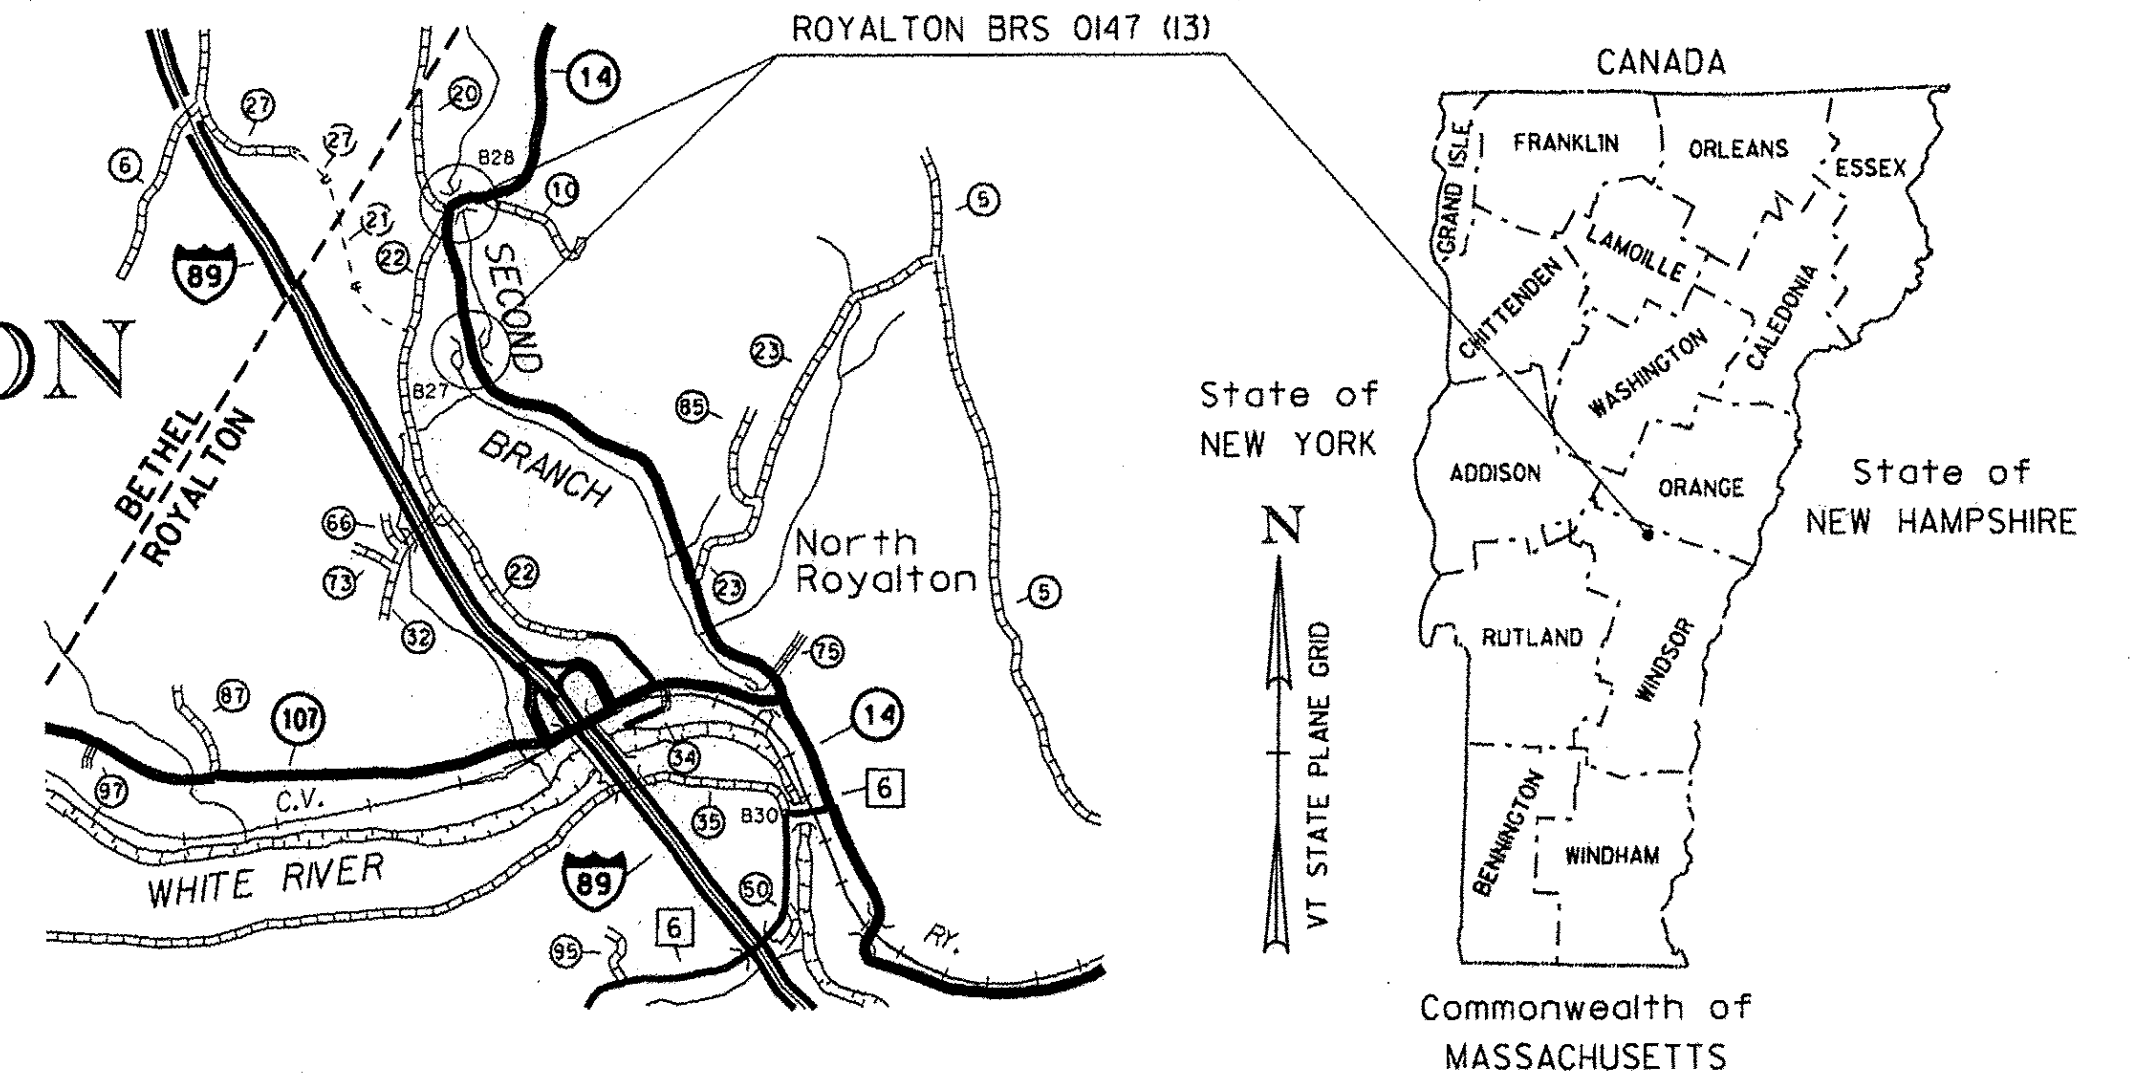

SEE SHEET 2 FOR INDEX OF SHEETS
AND STANDARDS


RECORD PLANS	
CONTRACTOR:	WINTerset, INC. - LYNDONVILLE, VT
RESIDENT ENGINEER:	TOM CHASE
CONSTRUCTION BEGAN:	APRIL 18, 2014
CONSTRUCTION COMPLETE:	SEPTEMBER 17, 2015
RECORD PLANS BY:	TOM CHASE & AARON JAMES
I HEREBY CERTIFY THAT ALL THE CONSTRUCTION REQUIRED BY THIS SET OF DRAWINGS HAS BEEN ACCOMPLISHED AS INDICATED HEREIN.	
BY	<i>Thomas A. Chase</i> RESIDENT ENGINEER
DATE	07/14/16
NOTE: Any further information concerning final quantities, amounts or other details relative to this project may be found at Central Files in the electronic archives.	

ROUTE NO: VT 14 MAJOR COLLECTOR BRIDGES NO: 27 & 28 & CATTLE PASS

PROJECT LOCATION : BEGINNING AT A POINT ON VT 14 APPROXIMATELY 1.418 MILES NORTHWESTERLY FROM THE INTERSECTION OF VT 107 AND VT 14 AND EXTENDING NORTHERLY 0.665 MILES ALONG VT 14.

PROJECT DESCRIPTION : REPLACEMENT OF THE EXISTING BRIDGES INCLUDING RELATED APPROACH ROADWAY AND CHANNEL WORK AT EACH BRIDGE.

LENGTH OF STRUCTURE (BRIDGE 27): 137.78 FEET
 LENGTH OF STRUCTURE (CATTLE PASS): 9.66 FEET
 LENGTH OF STRUCTURE (BRIDGE 28): 123.65 FEET
 LENGTH OF ROADWAY: 1473.91 FEET
 LENGTH OF PROJECT: 1745.00 FEET

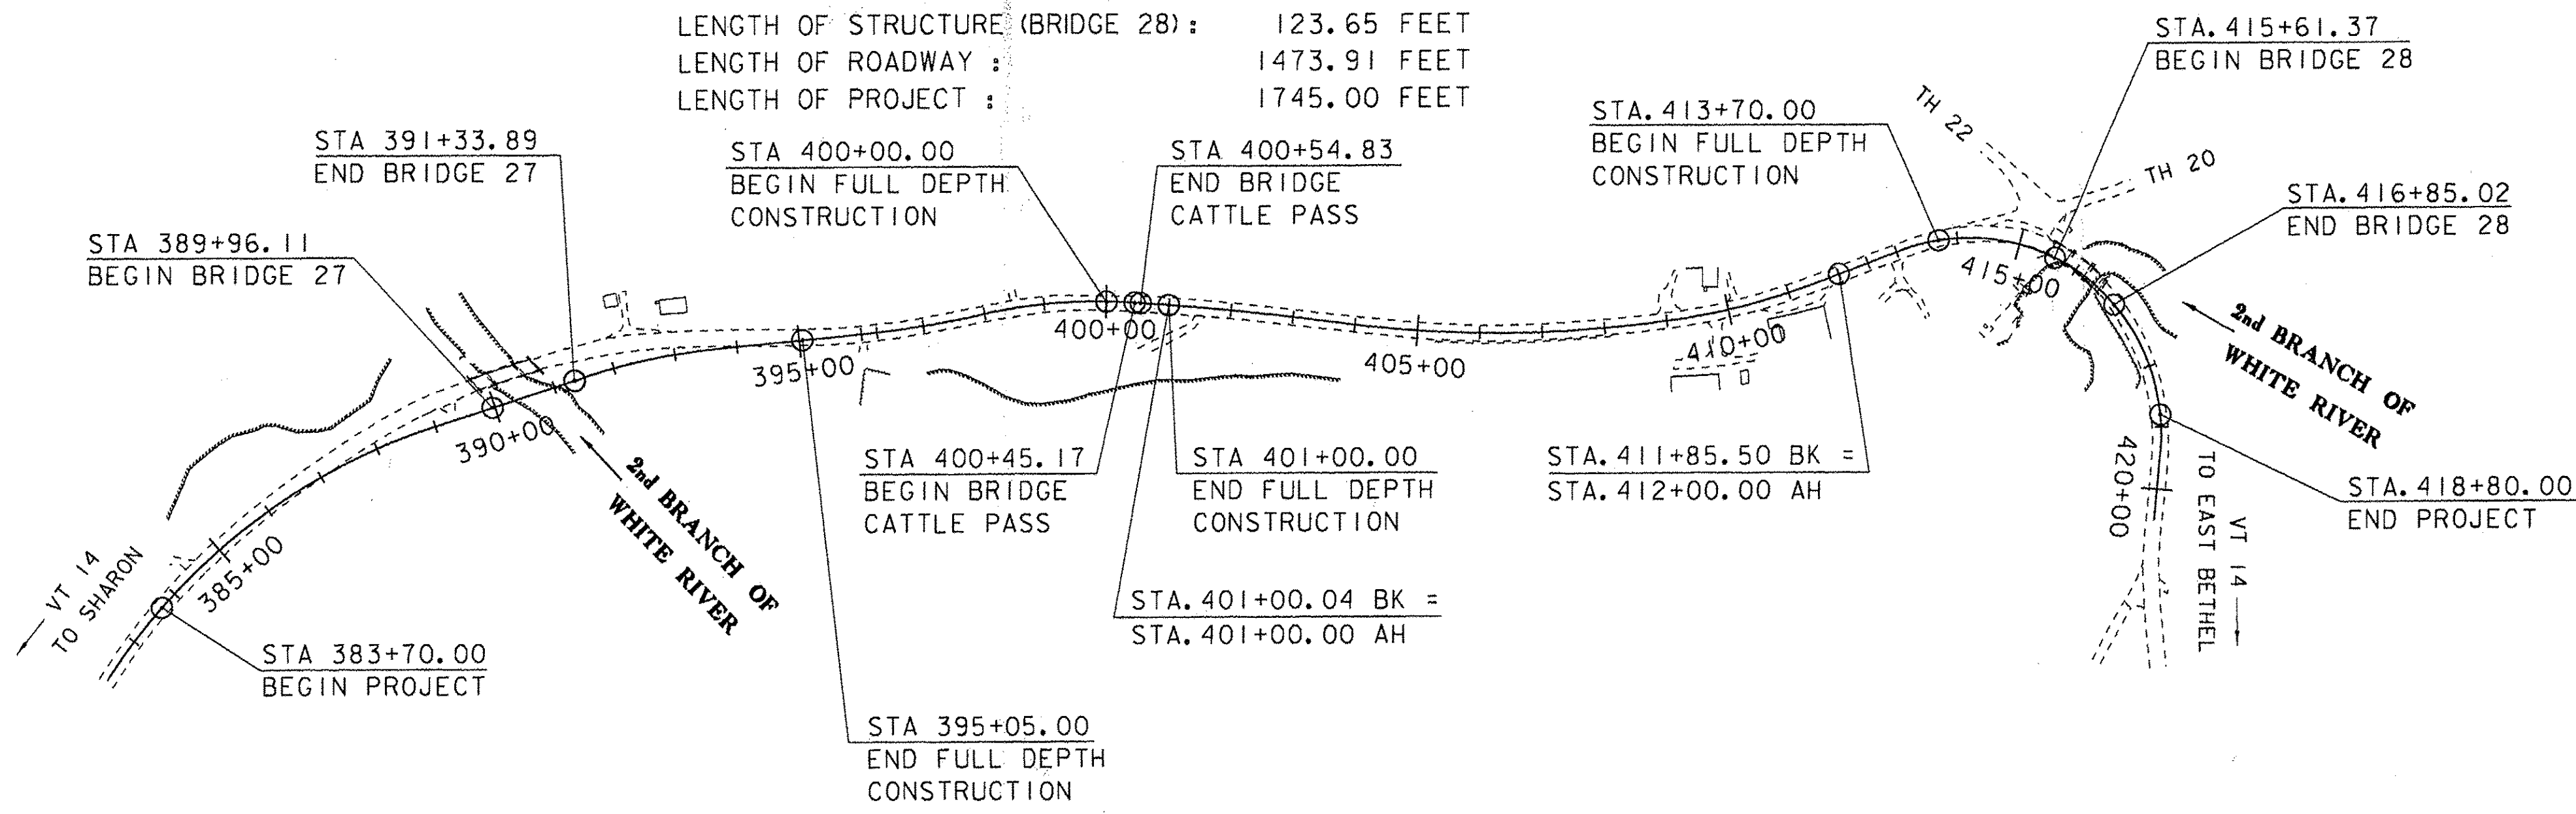

QUALITY ASSURANCE PROGRAM: LEVEL 2

CONVENTIONAL SYMBOLS	
COUNTY LINE	
TOWN LINE	
LIMITS OF ACCESS	
POINT OF ACCESS	
FENCE LINE	
STONE WALL	
TRAVELED WAY	
GUARD RAIL	
RAILROAD	
SURVEY LINE	
CULVERT	
POWER POLE	
TELEPHONE POLE	
TREES	
CONTROL OF ACCESS	
PROPERTY LINE	
R.O.W. TAKING LINE	
SLOPE RIGHTS	
TOP OF CUT	
TOE OF SLOPE	

SURVEYED BY : R. GILMAN
 SURVEYED DATE : 07-16-2001

DATUM
 VERTICAL NAVD 88
 HORIZONTAL NAD 83 (96)

200 0 200
 SCALE: 1" = 200' - 0"

THESE PLANS ARE SUBJECT TO SUCH ENGINEERING CHANGES AS MAY BE REQUIRED BY THE FEDERAL HIGHWAY ADMINISTRATION OR THE DIRECTOR OF PROGRAM DEVELOPMENT.

CONSTRUCTION IS TO BE CARRIED ON IN ACCORDANCE WITH THESE PLANS AND THE STANDARD SPECIFICATIONS FOR CONSTRUCTION DATED 2014, AS APPROVED BY THE FEDERAL HIGHWAY ADMINISTRATION ON JULY 20, 2011 FOR USE ON THIS PROJECT, INCLUDING ALL SUBSEQUENT REVISIONS AND SUCH REVISED SPECIFICATIONS AND SPECIAL PROVISIONS AS ARE INCORPORATED IN THESE PLANS.

DIRECTOR OF PROGRAM DEVELOPMENT
 APPROVED *Kevin A. Naudie* DATE 10/4/13

PROJECT MANAGER : C. CARLSON, P.E.

PROJECT NAME : ROYALTON
 PROJECT NUMBER : BRS 0147 (13)

SHEET 1 OF 186 SHEETS

PLAN SHEETS

STRUCTURES DETAIL SHEETS

1	TITLE SHEET
2	INDEX OF SHEETS
3	CONVENTIONAL SYMBOLOGY - LENGEND
4-5	PROJECT NOTES
6-9	QUANTITY SHEETS
10	BRIDGE 27 QUANTITY SHEET
11	CATTLE PASS QUANTITY SHEET
12	BRIDGE 28 QUANTITY SHEET

BRIDGE #28 PLAN SHEETS

87	BRIDGE 28 PRELIMINARY INFORMATION
88-90	BRIDGE 28 PROJECT TYPICAL SECTIONS
91	BRIDGE 28 TIE SHEET
92	BRIDGE 28 ALIGNMENT LAYOUT
93	BRIDGE 28 LAYOUT
94-95	BRIDGE 28 VT 14 PROFILE SHEETS
96	BRIDGE 28 VT 14 BANKING DIAGRAM AND MATERIAL TRANSITION
97	TH 20 AND TH 22 PROFILES
98	BRIDGE 28 TRAFFIC CONTROL
99	BRIDGE 28 EXISTING SIGNS
100	BRIDGE 28 NEW SIGNS AND PAVEMENT MARKINGS
101	BRIDGE 28 SIGN DETAILS
102	BRIDGE 28 TRAFFIC SIGN SUMMARY
103	BRIDGE 28 BORING LAYOUT
104-107	BRIDGE 28 BORING LOGS
108	BRIDGE 28 PLAN AND ELEVATION
109	BRIDGE 28 DECK REINFORCING DETAILS
110	BRIDGE 28 FRAMING PLAN AND GIRDER ELEVATION
111	BRIDGE 28 ABUT. NO.2 END DETAIL AND CAMBER TABLES
112	BRIDGE 28 GIRDER SPLICE DETAILS
113	BRIDGE 28 CROSSFRAME DETAILS
114	BRIDGE 28 DOWNSPOUT DETAILS
115	BRIDGE 28 APPROACH SLAB 1 AND 2 TYPICALS
116	BRIDGE 28 BEARING NOTES
117	BRIDGE 28 EXPANSION BEARING DETAILS
118	BRIDGE 28 GUIDED BEARING DETAILS
119	BRIDGE 28 ABUTMENT 1 PLAN
120	BRIDGE 28 ABUTMENT 1 ELEVATION
121	BRIDGE 28 ABUTMENT 1 TYPICAL
122	BRIDGE 28 WINGWALL 1 AND 2 ELEVATIONS
123	BRIDGE 28 WINGWALL 1 AND 2 TYPICALS
124	BRIDGE 28 ABUTMENT 1 FOOTING PLAN
125	BRIDGE 28 ABUTMENT 2 PLAN
126	BRIDGE 28 ABUTMENT 2 ELEVATION
127	BRIDGE 28 ABUTMENT 2 TYPICAL
128	BRIDGE 28 WINGWALL 3 AND 4 ELEVATIONS
129	BRIDGE 28 WINGWALL 3 AND 4 TYPICALS
130	BRIDGE 28 REINFORCING STEEL SCHEDULE
131	BRIDGE 28 RAIL LAYOUT
132	BRIDGE 28 BRIDGE RAIL DETAILS
133	BRIDGE 28 APPROACH RAIL PLAN AND ELEVATION
134-136	BRIDGE 28 APPROACH RAIL DETAILS
137-145	BRIDGE 28 VT 14 CROSS SECTION
146-154	BRIDGE 28 CHANNEL LINE CROSS SECTIONS
155-156	BRIDGE 28 TH 22 CROSS SECTIONS
157	BRIDGE 28 TH 20 CROSS SECTIONS

SD-501.00	CONCRETE DETAILS AND NOTES	2/9/2012
SD-502.00	CONCRETE DETAILS AND NOTES	10/10/2012
SD-516.10	BRIDGE JOINT ASPHALTIC PLUG	8/29/2011
SD-516.11a	BRIDGE EXPANSION JOINT, VERMONT	2/24/2011
SD-516.11b	BRIDGE EXPANSION JOINT, VERMONT	2/24/2011
SD-601.00	STRUCTURAL STEEL DETAILS AND NOTES	6/4/2010
SD-602.00	STRUCTURAL STEEL PLATE GIRDER DETAILS AND NOTES	5/2/2011

BRIDGE #27 PLAN SHEETS

13	BRIDGE 27 PRELIMINARY INFORMATION
14-15	BRIDGE 27 PROJECT TYPICAL SECTIONS
16-17	BRIDGE 27 TIE SHEETS
18-20	BRIDGE 27 ALIGNMENT LAYOUT
21-23	BRIDGE 27 LAYOUT
24-26	BRIDGE 27 VT 14 PROFILE SHEETS
27	BRIDGE 27 VT 14 BANKING DIAGRAM
28	BRIDGE 27 DRIVE PROFILES
29-31	BRIDGE 27 SIGNS & PAVEMENT MARKINGS
32	BRIDGE 27 BORING LAYOUT
33-34	BRIDGE 27 BORING LOGS
35	BRIDGE 27 PLAN AND ELEVATION
36	BRIDGE 27 DECK REINFORCING PLAN
37	BRIDGE 27 FRAMING PLAN
38	BRIDGE 27 BEARING DETAILS
39	BRIDGE 27 APPROACH SLAB DETAILS
40	BRIDGE 27 ABUTMENT TYPICAL SHEET
41	BRIDGE 27 ABUTMENT 1 PLAN AND ELEVATION
42	BRIDGE 27 ABUTMENT 2 PLAN AND ELEVATION
43	BRIDGE 27 WINGWALL DETAILS SHEET
44	BRIDGE 27 WINGWALLS 1 AND 2 ELEVATIONS
45	BRIDGE 27 WINGWALLS 3 AND 4 ELEVATIONS
46	BRIDGE 27 REINFORCING STEEL SCHEDULE
47	BRIDGE 27 APPROACH RAIL PLAN AND ELEVATION
48-50	BRIDGE 27 APPROACH RAIL DETAILS
51-61	BRIDGE 27 VT 14 CROSS SECTIONS
62	BRIDGE 27 VT 14 PIPE PROFILE
63	BRIDGE 27 VT 14 MATERIAL TRANSITION
64-71	BRIDGE 27 CHANNEL LINE CROSS SECTIONS

CATTLE PASS PLAN SHEETS

72	CATTLE PASS PROJECT TYPICAL SECTIONS
73	CATTLE PASS LAYOUT
74	VT 14 PROFILE AT CATTLE PASS
75	CATTLE PASS PROFILE
76	CATTLE PASS BOX DETAILS
77	CATTLE PASS BOX WINGWALL DETAILS
78	LONG SPAN GUARDRAIL DETAILS
79-81	VT 14 CROSS SECTIONS AT CATTLE PASS
82	BANKING DIAGRAM AND MATERIAL TRANSITION
83-86	CATTLE PASS CROSS SECTIONS

PERMIT AND REGULATOR PLAN SHEETS

158-159	EPSC NARRATIVE
160-162	BRIDGE 27 EPSC EXISTING CONDITION
163-165	BRIDGE 27 EPSC CONSTRUCTION CONDITION
166-168	BRIDGE 27 EPSC FINAL CONDITION
169	CATTLE PASS EPSC EXISTING CONDITION
170	CATTLE PASS EPSC CONSTRUCTION CONDITION
171	CATTLE PASS EPSC FINAL CONDITION
172	BRIDGE 28 EPSC EXISTING CONDITION
173	BRIDGE 28 EPSC CONSTRUCTION CONDITION
174	BRIDGE 28 EPSC FINAL CONDITION
175-177	EPSC DETAILS
178-179	ROW DETAIL SHEETS
180-182	BRIDGE 27 ROW LAYOUT SHEETS
183	CATTLE PASS - ROW LAYOUT SHEET
184-185	ROW LAYOUT SHEETS
186	BRIDGE 28 ROW LAYOUT SHEET

STANDARDS LIST

B-5	SLOPE GRADING, EMBANKMENTS, MUCK	06-01-1994
D-1	PRECAST REINFORCED CONCRETE DROP INLET DETAILS	06-01-1994
D-15	PRECAST REINF CONC. MH-GRATES, CAST IRON GRATE WITH FRAME, TYPE D & E	06-01-1994
D-30	UNDERDRAIN CONSTRUCTION DETAILS	08-13-2007
E-134	BRIDGE NUMBER PLAQUE	08-08-1995
E-141	REGULATORY SIGN DETAILS	09-20-1995
E-191	PAVEMENT MARKING DETAILS	02-01-1999
E-193	PAVEMENT MARKING DETAILS	08-18-1995
G-1	STEEL BEAM GUARDRAIL DETAILS (POST, DELINEATOR, TYPICALS)	01-03-2000
G-1B	BOX BEAM GUARD RAIL	06-01-1994
G-1D	STEEL BEAM GUARDRAIL DETAILS (END TERMINAL, ANCHOR, MEDIAN)	01-03-2000
G-19	GENERIC GRADING PLANS FOR GUARDRAIL END TERMINALS	11-15-2002
J-3	MAIL BOX SUPPORT DETAILS	08-07-1995
T-1	TRAFFIC CONTROL GENERAL NOTES	08-06-2012
T-10	CONVENTIONAL ROADS CONSTRUCTION APPROACH SIGNING	08-06-2012
T-17	TRAFFIC CONTROL MISCELLANEOUS DETAILS	08-06-2012
T-28	CONSTRUCTION SIGN DETAILS	08-06-2012
T-30	CONSTRUCTION SIGN DETAILS	08-06-2012
T-35	CONSTRUCTION ZONE LONGITUDNAL DROP-OFFS	08-06-2012
T-36	CONSTRUCTION ZONE LONGITUDNAL DROP-OFFS FOR PAVING	08-06-2012
T-45	SQUARE TUBE SIGN POST AND ANCHOR	08-06-2012
S-352A	BRIDGE RAILING, GALVANIZED STEEL TUBING/CONCRETE COMBINATION	08-22-2012
S-352B	BRIDGE RAILING, GALVANIZED STEEL TUBING/CONCRETE COMBINATION	08-22-2012
S-352C	BRIDGE RAILING, GALVANIZED STEEL TUBING/CONCRETE COMBINATION	08-22-2012

PROJECT NAME: ROYALTON
PROJECT NUMBER: BRS 0147 (13)

FILE NAME: s86e055indexofsheets.dgn	PLOT DATE: 08-OCT-2013
PROJECT LEADER: C. CARLSON	DRAWN BY: D. PETERSON
DESIGNED BY: D. PETERSON	CHECKED BY: C. BURRALL
INDEX OF SHEETS	SHEET 2 OF 186

GENERAL INFORMATION

SYMBOLY LEGEND NOTE

THE SYMBOLY ON THIS SHEET IS INTENDED TO COVER STANDARD CONVENTIONAL SYMBOLY. THE SYMBOLY IS USED FOR EXISTING & PROPOSED FEATURES WITH HEAVIER LINEWEIGHT, IN COMBINATION WITH PROJECT ANNOTATION, AS NOTED ON PROJECT PLAN SHEETS. THIS LEGEND SHEET COVERS THE BASICS. SYMBOLY ON PLANS MAY VARY, PLAN ANNOTATIONS AND NOTES SHOULD BE USED TO CLARIFY AS NEEDED.

R.O.W. ABBREVIATIONS (CODES) & SYMBOLS

POINT CODE	DESCRIPTION
CH	CHANNEL EASEMENT
CONST	CONSTRUCTION EASEMENT
CUL	CULVERT EASEMENT
D&C	DISCONNECT & CONNECT
DIT	DITCH EASEMENT
DR	DRAINAGE EASEMENT
DRIVE	DRIVEWAY EASEMENT
EC	EROSION CONTROL
I&M	INSTALL & MAINTAIN EASEMENT
LAND	LANDSCAPE EASEMENT
R&RES	REMOVE & RESET
R&REP	REMOVE & REPLACE
SR	SLOPE RIGHT
UE	UTILITY EASEMENT
(P)	PERMANENT EASEMENT
(T)	TEMPORARY EASEMENT
■	BNDNS BOUND SET
▣	BNDNS BOUND TO BE SET
●	IPNS IRON PIN SET
⊙	IPNS IRON PIN TO BE SET
⊗	CALC EXISTING ROW POINT
○	PROW PROPOSED ROW POINT
[LENGTH]	LENGTH CARRIED ON NEXT SHEET

COMMON TOPOGRAPHIC POINT SYMBOLS

POINT CODE DESCRIPTION

POINT CODE	DESCRIPTION
#	APL BOUND APPARENT LOCATION
•	BM BENCH MARK
□	BND BOUND
▣	CB CATCH BASIN
⊕	COMB COMBINATION POLE
▣	DITHR DROP INLET THROATED DNC
⊕	EL ELECTRIC POWER POLE
•	FPOLE FLAGPOLE
○	GASFIL GAS FILLER
○	GP GUIDE POST
×	GSO GAS SHUT OFF
•	GUY GUY POLE
•	GUYW GUY WIRE
×	GV GATE VALVE
⊗	H TREE HARDWOOD
△	HCTRL CONTROL HORIZONTAL
▲	HVCTRL CONTROL HORIZ. & VERTICAL
◇	HYD HYDRANT
•	IP IRON PIN
•	IPIPE IRON PIPE
⊕	LI LIGHT - STREET OR YARD
⊕	MB MAILBOX
○	MH MANHOLE (MH)
□	MM MILE MARKER
•	PM PARKING METER
□	PMK PROJECT MARKER
•	POST POST STONE/WOOD
⊕	RRSIG RAILROAD SIGNAL
•	RRSL RAILROAD SWITCH LEVER
⊗	S TREE SOFTWOOD
⊕	SAT SATELLITE DISH
⊕	SHRUB SHRUB
⊕	SIGN SIGN
⊕	STUMP STUMP
•	TEL TELEPHONE POLE
•	TIE TIE
⊕	TSIGN SIGN W/DOUBLE POST
⊕	VCTRL CONTROL VERTICAL
•	WELL WELL
×	WSO WATER SHUT OFF

THESE ARE COMMON VAOT SURVEY POINT SYMBOLS FOR EXISTING FEATURES, ALSO USED FOR PROPOSED FEATURES WITH HEAVIER LINEWEIGHT, IN COMBINATION WITH PROPOSED ANNOTATION.

PROPOSED GEOMETRY CODES

CODE	DESCRIPTION
PC	POINT OF CURVATURE
PI	POINT OF INTERSECTION
CC	CENTER OF CURVE
PT	POINT OF TANGENCY
PCC	POINT OF COMPOUND CURVE
PRC	POINT OF REVERSE CURVE
POB	POINT OF BEGINNING
POE	POINT OF ENDING
STA	STATION PREFIX
AH	AHEAD STATION SUFFIX
BK	BACK STATION SUFFIX
D	CURVE DEGREE OF (100FT)
R	CURVE RADUIS OF
T	CURVE TANGENT LENGTH
L	CURVE LENGTH OF
E	CURVE EXTERNAL DISTANCE

UTILITY SYMBOLY

UNDERGROUND UTILITIES

— UT —	TELEPHONE
— UE —	ELECTRIC
— UC —	CABLE (TV)
— UEC —	ELECTRIC+CABLE
— UET —	ELECTRIC+TELEPHONE
— UCT —	CABLE+TELEPHONE
— UECT —	ELECTRIC+CABLE+TELEP.
— G —	GAS LINE
— W —	WATER LINE
— S —	SANITARY SEWER (SEPTIC)

ABOVE GROUND UTILITIES (AERIAL)

— T —	TELEPHONE
— E —	ELECTRIC
— C —	CABLE (TV)
— EC —	ELECTRIC+CABLE
— ET —	ELECTRIC+TELEPHONE
— AER E&T —	ELECTRIC+TELEPHONE
— CT —	CABLE+TELEPHONE
— ECT —	ELECTRIC+CABLE+TELEP.
—	UTILITY POLE GUY WIRE

PROJECT CONSTRUCTION SYMBOLY

PROJECT DESIGN & LAYOUT SYMBOLY

— — — CZ — — —	CLEAR ZONE
— — — — —	PLAN LAYOUT MATCHLINE

PROJECT CONSTRUCTION FEATURES

▲ — — — — —	TOP OF CUT SLOPE
○ — — — — —	TOE OF FILL SLOPE
⊕ — — — — —	STONE FILL
⊕ — — — — —	BOTTOM OF DITCH
— — — — —	CULVERT PROPOSED
— — — — —	STRUCTURE SUBSURFACE
PDF — — — — —	PROJECT DEMARCATION FENCE
BF — — — — —	BARRIER FENCE
XXXXXXXXXXXX	TREE PROTECTION ZONE (TPZ)
//////	STRIPING LINE REMOVAL
~~~~~	SHEET PILES

**CONVENTIONAL BOUNDARY SYMBOLY**

**BOUNDARY LINES**

— — — — —	TOWN BOUNDARY LINE
— — — — —	COUNTY BOUNDARY LINE
— — — — —	STATE BOUNDARY LINE
— — — — —	PROPOSED STATE R.O.W. (LIMITED ACCESS)
— — — — —	PROPOSED STATE R.O.W.
— — — — —	STATE ROW (LIMITED ACCESS)
— — — — —	STATE ROW
— — — — —	TOWN ROW
— — — — —	PERMANENT EASEMENT LINE (P)
— — — — —	TEMPORARY EASEMENT LINE (T)
— — — — —	SURVEY LINE
P — — — — —	PROPERTY LINE (P/L)
SR — — — — —	SLOPE RIGHTS
6f — — — — —	6F PROPERTY BOUNDARY
4f — — — — —	4F PROPERTY BOUNDARY
HAZ — — — — —	HAZARDOUS WASTE

**EPSC LAYOUT PLAN SYMBOLY**

**EPSC MEASURES**

ONNOONNOONNO	FILTER CURTAIN
— — — — —	SILT FENCE
— — — — —	SILT FENCE WOVEN WIRE
— — — — —	CHECK DAM
— — — — —	DISTURBED AREAS REQUIRING RE-VEGETATION
— — — — —	EROSION MATTING

**ENVIRONMENTAL RESOURCES**

— — — — —	WETLAND BOUNDARY
— — — — —	RIPARIAN BUFFER ZONE
— — — — —	WETLAND BUFFER ZONE
— — — — —	SOIL TYPE BOUNDARY
T&E — — — — —	THREATENED & ENDANGERED SPECIES
HAZ — — — — —	HAZARDOUS WASTE AREA
AG — — — — —	AGRICULTURAL LAND
HABITAT — — — — —	FISH & WILDLIFE HABITAT
FLOOD PLAN — — — — —	FLOOD PLAN
OHW — — — — —	ORDINARY HIGH WATER (OHW)
— — — — —	STORM WATER
— — — — —	USDA FOREST SERVICE LANDS
— — — — —	WILDLIFE HABITAT SUIT/CONN

**ARCHEOLOGICAL & HISTORIC**

— — — — —	ARCHEOLOGICAL BOUNDARY
HISTORIC DIST — — — — —	HISTORIC DISTRICT BOUNDARY
HISTORIC — — — — —	HISTORIC AREA
(H)	HISTORIC STRUCTURE

**CONVENTIONAL TOPOGRAPHIC SYMBOLY**

**EXISTING FEATURES**

— — — — —	ROAD EDGE PAVEMENT
— — — — —	ROAD EDGE GRAVEL
— — — — —	DRIVEWAY EDGE
— — — — —	DITCH
— — — — —	FOUNDATION
x — — — — —	FENCE (EXISTING)
□ — — — — —	FENCE WOOD POST
○ — — — — —	FENCE STEEL POST
~~~~~	GARDEN
— — — — —	ROAD GUARDRAIL
	RAILROAD TRACKS
— — — — —	CULVERT (EXISTING)
— — — — —	STONE WALL
— — — — —	WALL
~~~~~	WOOD LINE
~~~~~	BRUSH LINE
~~~~~	HEDGE
~~~~~	BODY OF WATER EDGE
~~~~~	LEDGE EXPOSED

PROJECT NAME: ROYALTON  
PROJECT NUMBER: BRS 0147(13)

FILE NAME: s86e055legend.dgn PLOT DATE: 08-OCT-2013  
PROJECT LEADER: C. CARLSON DRAWN BY: D. PETERSON  
DESIGNED BY: D. PETERSON CHECKED BY: J. LACROIX  
CONVENTIONAL SYMBOLY - LEGEND SHEET 3 OF 186

**GENERAL**

1. ALL MATERIALS AND CONSTRUCTION SHALL CONFORM TO THE STATE OF VERMONT AGENCY OF TRANSPORTATION STANDARD SPECIFICATIONS FOR CONSTRUCTION DATED 2011 AND ITS LATEST REVISIONS, THE AASHTO LRFD BRIDGE DESIGN SPECIFICATIONS FIFTH EDITION, DATED 2010 AND ITS LATEST REVISIONS AND THE AASHTO LRFD BRIDGE CONSTRUCTION SPECIFICATIONS THIRD EDITION, DATED 2010 AND ITS LATEST REVISIONS.
2. BRIDGE #27 AND BRIDGE #28 WERE DESIGNED FOR THE HL-93 LIVE LOADS.
3. ALL DIMENSIONS SHOWN IN THE PLANS ARE HORIZONTAL OR VERTICAL AND ARE GIVEN AT 68 DEGREES FAHRENHEIT, UNLESS OTHERWISE NOTED.
4. THE CATTLE PASS SHALL BE CONSTRUCTED PRIOR TO ANY WORK ON BRIDGE #27 AND BRIDGE #28.
5. THE DETAILS AND DIMENSIONS SHOW ON THE PROJECT SPECIFIC PLAN AND DETAIL SHEETS TAKE PRECEDENCE OVER THE MORE GENERAL "STRUCTURES DETAIL SHEETS" PROVIDED AFTER THE PLAN SHEETS.
6. ADDITIONAL FENCING MAY BE REQUIRED TO HELP IN MAINTAINING FULL PROTECTION OF THE CATTLE. PLACEMENT OF ADDITIONAL FENCE SHALL DETERMINED BY THE ENGINEER WITH INPUT FROM THE PROPERTY OWNER. THE FENCE SHALL BE SIMILAR IN KIND TO THE EXISTING CATTLE FENCE. PAYMENT FOR ADDITIONAL FENCING WILL BE INCIDENTAL TO ITEM 620.50 REMOVING AND RESETTING FENCE.

**EARTHWORK AND RELATED ITEMS**

7. THE CONTRACTOR MAY SUBSTITUTE SUBBASE OF DENSE GRADED CRUSHED STONE FOR THE SAND BORROW SHOWN ON THE PLANS. IF PLACEMENT OF SUBBASE IS IN LIEU OF SAND BORROW, PLACE A GEOTEXTILE MEETING THE REQUIREMENTS OF SECTION 649 FOR "GEOTEXTILE FOR ROAD BED SEPARATOR" BETWEEN THE SUBGRADE AND THE SUBBASE MATERIAL. ANY SUBSTITUTED MATERIAL WILL BE PAID UNDER ITEM 203.31, "SAND BORROW". ALL COSTS ASSOCIATED WITH THE INSTALLATION OF THE GEOTEXTILE FOR ROADBED SEPARATOR SHALL BE INCIDENTAL TO ITEM 203.31, "SAND BORROW".
8. THE STONE FILL UNDER THE BRIDGES AS SHOWN IN THE PLANS SHALL BE PLACED BEFORE THE GIRDERS ARE SET.
9. THE GEOGRID USED FOR THE REINFORCED SOIL SLOPE SHALL HAVE A MINIMUM ULTIMATE TENSILE STRENGTH OF 3050 LB/FT.
10. PAYMENT FOR ITEM # 900.675, SPECIAL PROVISION (REINFORCED SOIL SLOPE) SHALL INCLUDE ALL GRANULAR BORROW AND GEOTEXTILE UNDER STONE FILL REQUIRED TO COMPLETE THE WORK.
11. ITEM 529.15 "REMOVAL OF STRUCTURE" SHALL INCLUDE:
  - THE REMOVAL OF THE EXISTING SUPERSTRUCTURE AND ANY PORTION OF THE EXISTING ABUTMENTS AND PIERS NOT REMOVED UNDER STRUCTURE EXCAVATION OR UNCLASSIFIED CHANNEL EXCAVATION.
  - THE CONCRETE PIERS SHALL BE REMOVED OR CUT OFF AT STREAM BED ELEVATION.

**STRUCTURAL STEEL**

12. ALL NEW STRUCTURAL STEEL SHALL CONFORM TO AASHTO M 270M/M 270, GRADE 50, WEATHERING STEEL.
13. CHARPY V-NOTCH TEST: TEST STRUCTURAL STEEL MEMBERS DESIGNATED "CVN" IN THE PLANS IN ACCORDANCE WITH SUBSECTION 714.01.
14. BOLTS FOR ALL BOLTED FIELD CONNECTIONS SHALL BE 7/8 INCH DIAMETER HIGH STRENGTH BOLTS IN 15/16 INCH DIAMETER HOLES UNLESS OTHERWISE NOTED.
15. CONNECTIONS NOT SHOWN IN THE PLANS SHALL BE DETAILED BY THE FABRICATOR IN THE FABRICATION DRAWINGS AND SUBMITTED TO THE RESIDENT ENGINEER FOR APPROVAL.
16. AFTER THE SUPERSTRUCTURE STEEL HAS BEEN ERECTED, ELEVATIONS ALONG THE TOP OF GIRDERS SHALL BE TAKEN UNDER DIRECTION OF THE RESIDENT ENGINEER FOR USE IN DETERMINING THE FINAL GRADE AND HAUNCH DEPTHS.
17. CONCRETE PORTIONS OF ABUTMENTS AND WINGWALLS ABOVE ADJACENT BRIDGE SEAT ELEVATIONS SHALL NOT BE PLACED UNTIL FINISH GRADES HAVE BEEN DETERMINED BY THE ENIGNEER.

18. FLEMING BRACKETS OR SIMILAR FALSE WORK: SPACE FLEMING BRACKETS OR SIMILAR FALSEWORK AS REQUIRED BY DESIGN WITH A MAXIMUM SPACING OF 4'-0". THE BRACKETS SHALL BEAR NEAR THE BOTTOM FLANGE AND IN NO CASE SHALL THEY BEAR ABOVE THE BOTTOM QUARTER OF THE WEB.
19. HOLES IN WEB: FILL ANY BOLT HOLES IN THE WEBS OF THE BEAMS NOT OTHERWISE FILLED WITH BUTTON HEAD OR HEX HEAD BOLTS MEETING AASHTO M164 TYPE I. TIGHTEN THE BOLTS IN ACCORDANCE WITH SUBSECTION 506.19 OF THE STANDARD SPECIFICATIONS.
20. GIRDER WEBS AND CROSS FRAMES/DIAPHRAGMS SHALL BE PLUMB IN THE FINAL POSITION.

**CONCRETE**

21. INDIVIDUAL POURED SEGMENTS ARE TO BE PLACED IN ONE CONTINUOUS POUR WITH A MAXIMUM DURATION OF EIGHT HOURS. IF CIRCUMSTANCES BEYOND THE CONTRACTOR'S CONTROL PREVENT THIS FROM BEING ACCOMPLISHED, A CONSTRUCTION JOINT SHALL BE USED BETWEEN ADJACENT POURS. A MINIMUM 96 HOUR DELAY BETWEEN ADJACENT POURS SHALL BE OBSERVED.
22. WATER REPELLENT, SILANE SHALL BE APPLIED TO ALL EXPOSED CONCRETE SURFACES, EXCEPT THE UNDERSIDE OF THE DECK BETWEEN DRIP NOTCHES.
23. ALL REINFORCING STEEL IN OR EXTENDING INTO CONCRETE, HPC A SHALL BE LEVEL II UNLESS OTHERWISE NOTED. REINFORCING STEEL WILL BE DENOTED AS LEVEL II ON THE REINFORCING STEEL SHEET BY PLACING ".2" AT THE END OF THE BAR MARK. (EX: 1A501.2). ALL OTHER REINFORCING STEEL SHALL BE LEVEL I. PAYMENT FOR REINFORCING STEEL WILL BE MADE UNDER THE APPROPRIATE SECTION 507 CONTRACT ITEM.

PROJECT NAME: ROYALTON  
PROJECT NUMBER: BRS 0147 (13)

FILE NAME: /Structures/86e055qty.dgn      PLOT DATE: 08-OCT-2013  
PROJECT LEADER: C. CARLSON      DRAWN BY: D. PETERSON  
DESIGNED BY: D. PETERSON      CHECKED BY: C. CARLSON  
PROJECT NOTES (1)      SHEET 4 OF 186

**BRIDGE #27**

**EARTHWORK AND RELATED ITEMS**

- 22. THE BACKFILL BEHIND THE ABUTMENTS SHALL NOT BE PLACED HIGHER THAN THE BRIDGE SEATS UNTIL THE ABUTMENTS AND DECK CONSTRUCTION IS COMPLETED. THE DIFFERENCE IN ELEVATION OF FILL BEHIND THE ABUTMENTS AT ANY TIME DURING BACKFILLING OPERATIONS SHALL NOT EXCEED 2 FEET.
- 23. IF LEDGE IS ENCOUNTERED IN THE SLOPE FROM APPROXIMATELY STA. 383+00 RT TO STA. 385+00 RT THE ENGINEER SHALL BE CONTACTED AND THE PLANS WILL BE REVISED ACCORDINGLY. PAYMENT FOR ANY LEDGE REMOVAL IN THE SLOPE SHALL BE PAID FOR UNDER ITEM 203.16, "SOLID ROCK EXCAVATION".

**CONCRETE**

- 24. ITEM 501.33, "CONCRETE, HIGH PERFORMANCE CLASS A" SHALL BE USED FOR THE DECK, BRIDGE RAIL, INTEGRAL ABUTMENT CURTAIN WALL AND WINGWALLS ABOVE THE PILE CAP CONSTRUCTION JOINT. ALL SUBSTRUCTURE BELOW THE BRIDGE SEATS AND THE APPROACH SLAB CONCRETE SHALL BE ITEM 501.34, "CONCRETE, HIGH PERFORMANCE CLASS B." THE RAIL CONCRETE WILL BE CONCRETE, HIGH PERFORMANCE CLASS SCC AND SHALL BE PAID FOR UNDER ITEM 525.45 BRIDGE RAILING, GALVANIZED STEEL TUBING/CONCRETE COMBINATION.
- 25. AESTHETIC DETAIL "B" SHALL BE USED ON THE TRAFFIC SIDE FACES OF THE CONCRETE FOR BRIDGE RAIL, GALVANIZED STEEL TUBING/CONCRETE COMBINATION. SEE STANDARD S-352A FOR DETAILS.
- 26. REINFORCING STEEL IN THE BRIDGE RAIL, DESIGNATED "BR" IN THE PLANS, SHALL BE PAID FOR UNDER ITEM 525.45 BRIDGE RAILING, GALVANIZED STEEL TUBING/CONCRETE COMBINATION. ALL BRIDGE RAIL REINFORCING STEEL SHALL BE LEVEL II.

**SUBSTRUCTURE**

- 27. ITEM 505.165 "STEEL PILING, HP 12 X 84". REINFORCE THE DRIVING TIP ACCORDING TO SUBSECTION 505.04(F).
- 28. ITEM 505.45 "DYNAMIC PILE LOADING TEST". A MINIMUM OF ONE DYNAMIC PILE TEST SHALL BE CONDUCTED PER ABUTMENT. MORE TESTS MAY BE REQUIRED BY THE RESIDENT ENGINEER. THE NOMINAL PILE DRIVING RESISTANCE FOR EACH PILE IS 612 KIPS. A PILE RESISTANCE FACTOR OF 0.65 WAS USED BASED ON THE DYNAMIC TESTING REQUIREMENT.
- 29. FOR ESTIMATING PURPOSES, THE PILE TIP ELEVATIONS WERE ASSUMED AND ARE SHOWN ON THE BORING LOGS. THE ACTUAL IN PLACE LENGTHS MAY VARY. PILES SHALL HAVE A MINIMUM EMBEDMENT OF 45 FT MEASURED FROM THE BOTTOM OF THE PILE CAP.
- 30. PILE SHOES SHALL BE REQUIRED AND SHALL CONFORM TO SUBSECTION 505.04.

**TRAFFIC CONTROL**

- 31. TRAFFIC SHALL BE MAINTAINED ON THE EXISTING BRIDGE #27 DURING CONSTRUCTION. ANY MAINTAINANCE OF THE EXISTING SUBSTRUCTURE, SUPERSTRUCTURE, OR BRIDGE SURFACE TO KEEP THE BRIDGE SAFE TO THE TRAVELLING PUBLIC WILL BE PAID UNDER ITEM 527.10 "MAINTENANCE OF STRUCTURES AND APPROACHES".

**MISCELLANEOUS**

- 32. THE 12 STONE POSTS FROM STA. 392+93.4 LT TO STA. 395+22.4 RT SHALL BE SAVED AND RETURNED TO THE PROPERTY OWNER.
- 33. A WOOD FENCE AND STONE WALL ON THE SMITH/FREEMAN PROPERTY CLOSE TO THE PROJECT LIMITS ARE NOT TO BE DISTURBED.

**CATTLE PASS**

**CONCRETE**

- 34. THE BOX CULVERT, HEADWALLS, WINGWALLS AND FOOTINGS SHALL BE PRECAST CONCRETE CONFORMING TO SECTION 540 OF THE SPECIFICATIONS, AND SHALL MEET THE DIMENSIONS INDICATED ON THE PLANS. ALL PRECAST COMPONENTS OF THE STRUCTURE WILL BE PAID FOR UNDER ITEM 540.10, "PRECAST CONCRETE STRUCTURE (8'-0" X 6'-0" X 36'-4" BOX)".
- 35. TRANSVERSE GROOVING SHALL BE PROVIDED ALONG THE LENGTH OF THE PRECAST BOX INVERT.
- 36. JOINTS BETWEEN ALL ABUTTING PRECAST UNITS SHALL BE WATERTIGHT AND MECHANICALLY CONNECTED.

**SUBSTRUCTURE**

- 37. ALL PRECAST CONCRETE COMPONENTS INCLUDING THE BOX CULVERT, HEADWALLS, WINGWALLS, FOOTINGS, AND ALL CONNECTIONS BETWEEN THESE COMPONENTS SHALL BE DESIGNED BY THE PRECAST FABRICATOR. THE SOIL PROPERTIES AND DESIGN PARAMETERS USED FOR THE BRIDGE SITE ARE AS INDICATED BELOW:
 

NOMINAL BEARING RESISTANCE:	4.0 KSF
FOUNDATION SOIL UNIT WEIGHT:	115 LB/SF
FOUNDATION SOIL FRICTION ANGLE:	29 DEGREES
BEARING RESISTANCE FACTOR:	0.45
SLIDING RESISTANCE FACTOR:	SEE AASHTO 10.6.3.4
DESIGN FILL OVER BOX:	IN ADDITION TO 9" OF PAVEMENT, APPROXIMATELY 30" OF SUBBASE WILL BE PLACED OVER THE BOX STRUCTURE.

- 38. THE DESIGN OF THE PRECAST CONCRETE BOX SHALL BE FOR HL-93 LIVE LOADING AND FOR A 75 YEAR DESIGN LIFE.

- 39. ALL REINFORCING STEEL IN THE PRECAST BOX SHALL BE LEVEL I, EPOXY COATED.

- 40. MEMBRANE WATERPROOFING SHALL BE APPLIED TO THE ENTIRE TOP OF THE CONCRETE BOX. A TWO (2) FOOT WIDE STRIP OF MEMBRANE SHALL BE PLACED AT EACH VERTICAL JOINT (SIDES). MEMBRANE SHALL BE CENTERED ON THE JOINT AND COVER THE FULL HEIGHT. THE SIDES SHALL BE COVERED PRIOR TO THE TOP. ANY OVERLAPPING OF MEMBRANE SHALL BE DONE IN A SINGLE TYPE STYLE TO SHED WATER AND SHALL OVERLAP A MINIMUM OF ONE FOOT. PAYMENT FOR MEMBRANE WILL BE INCLUDED IN THE UNIT PRICE BID FOR THE CONTRACT ITEM 540.10.

**TRAFFIC CONTROL**

- 41. AT A MINIMUM, ONE-LANE SHALL BE OPEN TO TRAFFIC AT ALL TIMES.

**MISCELLANEOUS**

- 42. THE 5 STONE POSTS FROM STA. 399+70.48 RT TO STA. 400+80.69 RT SHALL BE REMOVED, SAVED AND RETURNED TO THE PROPERTY OWNER.

**BRIDGE #28**

**STRUCTURAL STEEL**

- 43. THE WESTERN ENDS OF ALL FIVE GIRDERS SHALL BE PAINTED FOR A DISTANCE OF 10 FEET FROM THE CENTERLINE OF BEARING AT ABUTMENT 1. ALL CROSS-FRAMES, DIAPHRAGMS AND CONNECTION OR STIFFENER PLATES IN THIS AREA SHALL ALSO BE PAINTED. THE FINAL COLOR SHALL BE BROWN IN CONFORMANCE WITH SUBSECTION 708.03 OF THE STANDARD SPECIFICATIONS. BROWN GREASE, CONFORMING TO SUBSECTION 708.04 SHALL BE APPLIED TO ALL PAINTED AREAS. PAYMENT WILL BE MADE UNDER ITEM 900.645 SPECIAL PROVISION (QC/QA CLEANING AND PAINTING STRUCTURAL COMPONENTS).

- 44. THE DOWNSPOUT LOCATED AT ABUTMENT #1 WILL BE PAID FOR UNDER ITEM 506.75, STRUCTURAL STEEL.

**CONCRETE**

- 45. ALL APPROACH SLAB AND SUBSTRUCTURE CONCRETE SHALL BE CONCRETE, HIGH PERFORMANCE CLASS B UNLESS OTHERWISE NOTED AND SHALL BE PAID FOR UNDER ITEM 501.34, "CONCRETE, HIGH PERFORMANCE CLASS B". THE DECK CONCRETE SHALL BE CONCRETE, HIGH PERFORMANCE CLASS A AND SHALL BE PAID FOR UNDER ITEM 501.33, "CONCRETE, HIGH PERFORMANCE CLASS A". ANY CONCRETE REQUIRED FOR SUBFOOTINGS SHALL BE CONCRETE, CLASS C AND SHALL BE PAID FOR UNDER ITEM 541.30 "CONCRETE, CLASS C". THE RAIL CONCRETE WILL BE CONCRETE, HIGH PERFORMANCE CLASS ~~SCC~~ AND SHALL BE PAID FOR UNDER ITEM 900.640 SPECIAL PROVISION (BRIDGE RAILING, TEXAS). CHANGED TO CONCRETE CLASS AA

- 46. REINFORCING STEEL IN THE BRIDGE RAIL, DESIGNATED "BR" IN THE PLANS, SHALL BE PAID FOR UNDER ITEM 900.640 SPECIAL PROVISION (BRIDGE RAILING, TEXAS). ALL BRIDGE RAIL REINFORCING STEEL SHALL BE LEVEL II.

**SUBSTRUCTURE**

- 47. IT IS ANTICIPATED THAT THE BEDROCK WILL BE SEVERELY SLOPED AND VARIABLE AT WINGWALL #3.

- 48. FOOTINGS OR SUBFOOTINGS FOR SUBSTRUCTURES FOUNDED ON BEDROCK SHALL BE PLACED ON CLEAN COMPETENT ROCK. ALL LOOSE ROCK AND DEBRIS SHALL BE REMOVED.

- 49. UPON COMPLETION OF THE EXCAVATION FOR SUBSTRUCTURES FOUNDED ON BEDROCK AND PRIOR TO PLACING FORMWORK, THE RESIDENT ENGINEER SHALL NOTIFY THE PROJECT MANAGER AND THE VTRANS SOILS AND FOUNDATION ENGINEER. THE SOILS AND FOUNDATION ENGINEER WILL DETERMINE IF THE BEDROCK IS COMPETENT TO OBTAIN THE NOMINAL BEARING RESISTANCE AS SHOWN ON THE PLANS. FIVE (5) WORKING DAYS FROM NOTIFICATION SHALL BE ALLOWED TO MAKE THE INSPECTION AND THE DETERMINATION FOR THE COMPETENCY OF THE BEDROCK.

- 50. ONCE THE ELEVATION OF COMPETENT BEDROCK HAS BEEN DETERMINED, THE CONTRACTOR SHALL PROVIDE A BEDROCK PROFILE TO THE PROJECT MANAGER TO DETERMINE WHETHER THE DESIGN BOTTOM OF FOOTING ELEVATION SHALL BE RAISED OR LOWERED AND WHETHER A SUBFOOTING SHALL BE REQUIRED. FOOTING ELEVATIONS SHALL NOT BE ADJUSTED WITHOUT APPROVAL OF THE PROJECT MANAGER. THREE (3) WORKING DAYS FROM RECEIPT OF THE BEDROCK PROFILE SHALL BE ALLOWED TO MAKE THIS DETERMINATION. NO WORK SHALL BE DONE ON THE FOOTINGS UNTIL A REPLY IS RECEIVED.

- 51. THE LIMITS OF SUBFOOTINGS SHALL BE 6" OUTSIDE OF THE HORIZONTAL LIMITS OF THE FOOTING. THE TOP SURFACE OF ALL SUBFOOTINGS SHALL BE INTENTIONALLY ROUGHENED TO 1/4" AMPLITUDE.

- 52. ANY BEDROCK THAT NEEDS TO BE REMOVED SHALL BE PAID FOR WITH THE CORRESPONDING EXCAVATION ITEM INCLUDED IN THE CONTRACT.

- 53. OVERBREAKAGE BEYOND THE AVERAGE MAXIMUM ALLOWANCE SPECIFIED IN SUBSECTIONS 204.09(B) (1) AND 208.11(C) SHALL BE AT THE CONTRACTOR'S EXPENSE.

- 54. DOWELS SHALL BE DRILLED AND GROUTED INTO BEDROCK WHEN SHOWN ON THE PLANS OR AS ORDERED BY THE ENGINEER. THE DOWELS SHALL HAVE A 2'-0" MINIMUM EMBEDMENT IN THE BEDROCK AND SHALL EXTEND IN THE FOOTING OR SUBFOOTING A MINIMUM OF 1'-6", UNLESS NOTED OTHERWISE.

**TRAFFIC CONTROL**

- 55. TRAFFIC SHALL BE MAINTAINED ON A TWO-WAY TEMPORARY BRIDGE PLACED DOWNSTREAM OF THE EXISTING BRIDGE.

- 56. THE TEMPORARY BRIDGE APPROACHES SHALL BE PAVED.

- 57. A 14 FT WIDE TAPERED SHOULDER SHALL BE MAINTAINED FOR THE DURATION OF THE TEMPORARY BRIDGE. THE LOCATION IS SHOWN ON TRAFFIC CONTROL SHEET 100.

- 58. LIMITS OF THE TEMPORARY DETOUR MUST BE WITHIN THE TEMPORARY DETOUR RIGHT-OF-WAY. SEE ROW SHEETS.

- 59. THE AREA AROUND THE EXISTING STONE MILL SHALL BE FENCED OFF AND AVOIDED DURING CONSTRUCTION. THE ABUTMENT FOR THE TEMPORARY BRIDGE SHALL BE PLACED SO THAT THIS AREA WILL NOT BE DISTURBED DURING CONSTRUCTION.

PROJECT NAME: ROYALTON	
PROJECT NUMBER: BRS 0147 (13)	
FILE NAME: /Structures/86e055qty.dgn	PLOT DATE: 08-OCT-2013
PROJECT LEADER: C. CARLSON	DRAWN BY: D. PETERSON
DESIGNED BY: D. PETERSON	CHECKED BY: C. CARLSON
PROJECT NOTES (2)	SHEET 5 OF 186

# QUANTITY SHEET 1

SUMMARY OF ESTIMATED QUANTITIES										TOTALS		DESCRIPTIONS				DETAILED SUMMARY OF QUANTITIES		
ROADWAY	TRAINING	EROSION CONTROL	BRIDGE NO. 27 (STA. 390+63)	BRIDGE CATTLE PASS (STA. 400+50)	BRIDGE NO. 28 (STA. 416+52)	FULL C.E. ITEMS	GRAND TOTAL	FINAL	UNIT	ITEMS	ITEM NUMBER	ROUND	QUANTITIES	UNIT	ITEMS			
1							1		LS	CLEARING AND GRUBBING, INCLUDING INDIVIDUAL TREES AND STUMPS	201.10	-						
8040							8040		CY	COMMON EXCAVATION	203.15	20.71						
90							90		CY	SOLID ROCK EXCAVATION	203.16	-						
			1140		1640		2780		CY	UNCLASSIFIED CHANNEL EXCAVATION	203.27	15.51						
1420							1420		CY	SAND BORROW	203.31	2.99						
2205							2205		CY	TRENCH EXCAVATION OF EARTH	204.20	10.62						
3							3		CY	TRENCH EXCAVATION OF ROCK	204.21	-						
1							1		CY	TRENCH EXCAVATION OF EARTH, EXPLORATORY (N.A.B.I.)	204.22	-						
10			125	890			1025		CY	STRUCTURE EXCAVATION	204.25	8.72						
			270	670	590		1530		CY	GRANULAR BACKFILL FOR STRUCTURES	204.30	13.43						
225							225		SY	DRILLING AND BLASTING OF SOLID ROCK SUBGRADE	205.20	-						
					720		720		CY	COFFERDAM EXCAVATION, EARTH	208.30	7.72						
					10		10		CY	COFFERDAM EXCAVATION, ROCK	208.35	-						
					1		1		LS	COFFERDAM (ABUTMENT #1)	208.40	-						
					1		1		LS	COFFERDAM (ABUTMENT #2)	208.40	-						
1537							1537		SY	COLD PLANING, BITUMINOUS PAVEMENT	210.10	4.03						
4790							4790		CY	SUBBASE OF DENSE GRADED CRUSHED STONE	301.35	65						
334							334		CY	AGGREGATE SURFACE COURSE	401.10	2						
41							41		CWT	EMULSIFIED ASPHALT	404.65	0.23						
1							1		LU	PRICE ADJUSTMENT, ASPHALT CEMENT (N.A.B.I.)	406.50	-						
2952			72		68		3092		TON	SUPERPAVE BITUMINOUS CONCRETE PAVEMENT	490.30	1.8						
1							1		LU	AIR VOIDS PAY ADJUSTMENT (N.A.B.I.)	490.31	-						
1							1		LU	MAT DENSITY PAY ADJUSTMENT (N.A.B.I.)	490.32	-						
			174		114		288		CY	CONCRETE, HIGH PERFORMANCE CLASS A (FPQ)	501.33	0.95						
			129		365		494		CY	CONCRETE, HIGH PERFORMANCE CLASS B	501.34	0.39						
			1				1		LS	FURNISHING EQUIPMENT FOR DRIVING PILING	504.10	-						
			588				588		LF	STEEL PILING, HP 12 X 84	505.165	-						
			2				2		EACH	DYNAMIC PILE LOADING TEST	505.45	-						
			170085				170085		LB	STRUCTURAL STEEL, PLATE GIRDER (FPQ)	506.55	1.6						
					191903		191903		LB	STRUCTURAL STEEL, CURVED PLATE GIRDER (FPQ)	506.56	0.87						
					1		1		LS	STRUCTURAL STEEL	506.75	-						
			10009		34054		44063		LB	REINFORCING STEEL, LEVEL I	507.11	1.59						
			42486		31275		73761		LB	REINFORCING STEEL, LEVEL II	507.12	0.27						
					174		174		LF	DRILLING AND GROUTING DOWELS	507.16	-						
			1				1		LS	SHEAR CONNECTORS (1080 - 7/8" X 7")	508.15	-						
					1		1		LS	SHEAR CONNECTORS (1176 - 7/8" X 7")	508.15	-						
			30	10	30		70		GAL	WATER REPELLENT, SILANE	514.10	0.78						
			60				60		LF	BRIDGE EXPANSION JOINT, ASPHALTIC PLUG	516.10	-						
					38		38		LF	BRIDGE EXPANSION JOINT, VERMONT (FPQ)	516.11	0.2						
			429		405		834		SY	SHEET MEMBRANE WATERPROOFING, TORCH APPLIED (FPQ)	519.20	0.56						

PROJECT NAME: ROYALTON  
 PROJECT NUMBER: BRS 0147 (13)  
 FILE NAME: /Structures/86e055qty.dgn  
 PROJECT LEADER: C. CARLSON  
 DESIGNED BY: D. PETERSON  
 QUANTITY SHEET #1  
 PLOT DATE: 10-OCT-2013  
 DRAWN BY: D. PETERSON  
 CHECKED BY: J LACROIX  
 SHEET 6 OF 186

# QUANTITY SHEET 2

SUMMARY OF ESTIMATED QUANTITIES									TOTALS		DESCRIPTIONS				DETAILED SUMMARY OF QUANTITIES		
	ROADWAY	TRAINING	EROSION CONTROL	BRIDGE NO. 27 (STA. 390+63)	BRIDGE CATTLE PASS (STA. 400+50)	BRIDGE NO. 28 (STA. 416+52)	FULL C.E. ITEMS		GRAND TOTAL	FINAL	UNIT	ITEMS	ITEM NUMBER	ROUND	QUANTITIES	UNIT	ITEMS
				60		31			91		LF	JOINT SEALER, HOT POURED	524.11	-			
				278					278		LF	BRIDGE RAILING, GALVANIZED STEEL TUBING/CONCRETE COMBINATION (FPQ)	525.45	0.2			
	1								1		LS	MAINTENANCE OF STRUCTURES AND APPROACHES	527.10	-	4965	CY	BRIDGE #27 COMMON EXCAVATION VT 14
	1								1		LS	TWO-WAY TEMPORARY BRIDGE (5500 SF - EST.)	528.11	-	9	CY	DRIVE #1
						1			1		EACH	REMOVAL OF STRUCTURE (2550 SF - EST.)	529.15	-	6	CY	DRIVE #2
				1					1		EACH	REMOVAL OF STRUCTURE (2600 SF - EST.)	529.15	-	1100	CY	BRIDGE #27 SAND BORROW VT 14
						10			10		EACH	BEARING DEVICE ASSEMBLY, HIGH LOAD MULTI-ROTATIONAL	531.15	-	3020	CY	BRIDGE #27 SUBBASE OF DENSE GRADED CRUSHED STONE VT 14
				8					8		EACH	BEARING DEVICE ASSEMBLY, STEEL REINFORCED ELASTOMERIC PAD	531.17	-	40	CY	DRIVE #4
					1				1		LS	PRECAST CONCRETE STRUCTURE (8'-0" X 6'-0" X 36'-4" BOX)	540.10	-	68	CY	BRIDGE #27 AGGREGATE SURFACE COURSE VT 14
						10			10		CY	CONCRETE, CLASS C	541.30	-	18	CY	DRIVE #1
												BEGIN OPTION AA			38	CY	DRIVE #2
	212								212		LF	18" CAAP .060 (2-2/3 X 1/2)	601.0215	-	38	CY	DRIVE #3
	212								212		LF	18" PCCSP .064 (2-2/3 X 1/2)	601.0415	-	1824	TON	BRIDGE #27 SUPERPAVE BITUMINOUS CONCRETE PAVEMENT VT 14
	212								212		LF	18" RCP CLASS III	601.0815	-	10	TON	DRIVE #4
	212								212		LF	18" CPEP(SL)	601.2615	-			
												END OPTION AA					
												BEGIN OPTION BB					
	85								85		LF	24" CAAP .060 (2-2/3 X 1/2)	601.0225	-			
	85								85		LF	24" PCCSP .064 (2-2/3 X 1/2)	601.0425	-			
	85								85		LF	24" RCP CLASS III	601.0825	-			
	85								85		LF	24" CPEP(SL)	601.2620	-			
												END OPTION BB					
	1								1		EACH	PRECAST REINFORCED CONCRETE DROP INLET WITH CAST IRON GRATE	604.18	-			
	96								96		LF	6 INCH UNDERDRAIN PIPE	605.10	-			
	19								19		LF	6 INCH UNDERDRAIN CARRIER PIPE	605.20	-			
	1								1		EACH	UNDERDRAIN FLUSHING BASIN	605.95	-			
	56								56		CY	STONE FILL, TYPE I	613.10	1.17			
	1680								1680		CY	STONE FILL, TYPE II	613.11	7.38			
				1280					1280		CY	STONE FILL, TYPE III	613.12	6.8			
						650			650		CY	STONE FILL, TYPE IV	613.13	3.64			
	1								1		EACH	RELOCATE MAILBOX, SINGLE SUPPORT	617.10	-			
	130								130		LF	CHAIN-LINK FENCE, 4 FEET	620.11	0.7			
	2392								2392		LF	REMOVING AND RESETTNG FENCE	620.50	4.25			
	88								88		LF	HD STEEL BEAM GUARDRAIL, GALVANIZED (FPQ)	621.21	-			
	175								175		LF	HD STEEL BEAM GUARDRAIL, GALVANIZED/NESTED (FPQ)	621.216	-			
	1292								1292		LF	BOX BEAM GUARDRAIL (FPQ)	621.30	-			
	9								9		EACH	MANUFACTURED TERMINAL SECTION, TANGENT	621.51	-			
	4								4		EACH	ANCHOR FOR STEEL BEAM RAIL	621.60	-			
	624								624		LF	REMOVAL AND DISPOSAL OF GUARDRAIL	621.80	1.69			
	21								21		EACH	REMOVAL AND DISPOSAL OF GUIDE POSTS	621.81	-			

PROJECT NAME: ROYALTON  
PROJECT NUMBER: BRS 0147 (13)  
FILE NAME: /Structures/86e055qty.dgn  
PROJECT LEADER: C. CARLSON  
DESIGNED BY: D. PETERSON  
QUANTITY SHEET #2  
PLOT DATE: 28-OCT-2013  
DRAWN BY: D. PETERSON  
CHECKED BY: J LACROIX  
SHEET 7 OF 186

# QUANTITY SHEET 3

SUMMARY OF ESTIMATED QUANTITIES								TOTALS		DESCRIPTIONS				DETAILED SUMMARY OF QUANTITIES		
	ROADWAY	TRAINING	EROSION CONTROL	BRIDGE NO. 27 (STA. 390+63)	BRIDGE CATTLE PASS (STA. 400+50)	BRIDGE NO. 28 (STA. 416+52)	FULL C.E. ITEMS	GRAND TOTAL	FINAL	UNIT	ITEMS	ITEM NUMBER	ROUND	QUANTITIES	UNIT	ITEMS
	1							1		EACH	GUIDE POSTS	621.85	-			
	450							450		HR	UNIFORMED TRAFFIC OFFICERS	630.10	-			
	2500							2500		HR	FLAGGERS	630.15	-			
							1	1		LS	FIELD OFFICE, ENGINEERS	631.10	-			
							1	1		LS	TESTING EQUIPMENT, CONCRETE	631.16	-			
							1	1		LS	TESTING EQUIPMENT, BITUMINOUS	631.17	-			
							3000	3000		DL	FIELD OFFICE TELEPHONE (N.A.B.I.)	631.26	-			
		1040						1040		HR	EMPLOYEE TRAINEESHIP	634.10	-			
	1							1		LS	MOBILIZATION/DEMobilIZATION	635.11	-			
	4777							4777		LF	DURABLE 4 INCH WHITE LINE (FPQ)	646.400	-			
	4685							4685		LF	DURABLE 4 INCH YELLOW LINE (FPQ)	646.410	-			
	21							21		LF	DURABLE 24 INCH STOP BAR	646.480	-			
	1							1		EACH	DURABLE LETTER OR SYMBOL	646.490	-			
			4250					4250		SY	GEOTEXTILE UNDER STONE FILL	649.31	10.34			
			512					512		SY	GEOTEXTILE FOR SILT FENCE	649.51	2.59			
			198					198		SY	GEOTEXTILE FOR SILT FENCE, WOVEN WIRE REINFORCED	649.515	0.44			
			240					240		SY	GEOTEXTILE FOR FILTER CURTAIN	649.61	1.17			
			250					250		LB	SEED	651.15	13.18			
			150					150		LB	SEED, WINTER RYE	651.17	13.38			
			700					700		LB	FERTILIZER	651.18	44.85			
			6.25					6.25		TON	AGRICULTURAL LIMESTONE	651.20	1.78			
			5					5		TON	HAY MULCH	651.25	1.88			
			511					511		CY	TOPSOIL	651.35	5.39			
			1460					1460		SY	GRUBBING MATERIAL	651.40	6.29			
			1					1		LS	EPSC PLAN	652.10	-			
			500					500		HR	MONITORING EPSC PLAN	652.20	-			
			1					1		LU	MAINTENANCE OF EPSC PLAN (N.A.B.I.)	652.30	-			
			4260					4260		SY	TEMPORARY EROSION MATTING	653.20	10.1			
			270					270		SY	PERMANENT EROSION MATTING	653.21	1.81			
			164					164		CY	TEMPORARY STONE CHECK DAM, TYPE I	653.25	1.44			
			60					60		CY	VEHICLE TRACKING PAD	653.35	0.59			
			4					4		EACH	INLET PROTECTION DEVICE, TYPE I	653.40	-			
			1210					1210		LF	BARRIER FENCE	653.50	14.9			
			3130					3130		LF	PROJECT DEMARCATION FENCE	653.55	9.58			
	63							63		SF	TRAFFIC SIGNS, TYPE A	675.20	0.47			
	260							260		LF	SQUARE TUBE SIGN POST AND ANCHOR	675.341	-			
	21							21		EACH	REMOVING SIGNS	675.50	-			
	1							1		LU	PRICE ADJUSTMENT, FUEL (N.A.B.I.)	690.50	-			
	8							8		EACH	SPECIAL PROVISION (GUARDRAIL APPROACH SECTION TO CONCRETE COMBINATION BRIDGE RAILING)	900.620	-			
							242	242		LF	SPECIAL PROVISION (BRIDGE RAILING, TEXAS) (FPQ)	900.640	0.06			

PROJECT NAME: ROYALTON  
 PROJECT NUMBER: BRS 0147 (13)  
 FILE NAME: /Structures/86e055qty.dgn PLOT DATE: 28-OCT-2013  
 PROJECT LEADER: C. CARLSON DRAWN BY: D. PETERSON  
 DESIGNED BY: D. PETERSON CHECKED BY: J LACROIX  
 QUANTITY SHEET #3 SHEET 8 OF 186



# QUANTITY SHEET 4

SUMMARY OF ESTIMATED QUANTITIES									TOTALS		DESCRIPTIONS				DETAILED SUMMARY OF QUANTITIES			
			ROADWAY	TRAINING	EROSION CONTROL	BRIDGE NO. 27 (STA. 390+63)	BRIDGE CATTLE PASS (STA. 400+50)	BRIDGE NO. 28 (STA. 410+52)	FULL C.E. ITEMS	GRAND TOTAL	FINAL	UNIT	ITEMS	ITEM NUMBER	ROUND	QUANTITIES	UNIT	ITEMS
								1		1		LS	SPECIAL PROVISION (QC/QA CLEANING AND PAINTING STRUCTURAL COMPONENTS)	900.645	-			
			1							1		LS	SPECIAL PROVISION (TRAFFIC CONTROL, ALL-INCLUSIVE) (VT 14 - BRIDGE #27)	900.645	-			
			1							1		LS	SPECIAL PROVISION (TRAFFIC CONTROL, ALL-INCLUSIVE) (VT 14 - BRIDGE #28)	900.645	-			
			1							1		LS	SPECIAL PROVISION (TRAFFIC CONTROL, ALL-INCLUSIVE) (VT 14 - CATTLE PASS)	900.645	-			
			349							349		SY	SPECIAL PROVISION (REINFORCED SOIL SLOPE)	900.675	0.97			

PROJECT NAME: ROYALTON  
 PROJECT NUMBER: BRS 0147 (13)  
 FILE NAME: /Structures/86e055qty.dgn PLOT DATE: 28-OCT-2013  
 PROJECT LEADER: C. CARLSON DRAWN BY: D. PETERSON  
 DESIGNED BY: D. PETERSON CHECKED BY: J LACROIX  
 QUANTITY SHEET #4 SHEET 9 OF 186

# BRIDGE QUANTITY SHEET 1

SUMMARY OF BRIDGE QUANTITIES										TOTALS		DESCRIPTIONS			DETAILED SUMMARY OF QUANTITIES		
					SUPERSTRUCTURE	ABUTMENT NO. 1	ABUTMENT NO. 2	APPROACH SLAB NO. 1	APPROACH SLAB NO. 2	CHANNEL	BRIDGE TOTAL	UNIT	ITEMS	ITEM NUMBER	QUANTITIES	UNIT	ITEMS
										1140	1140	CY	UNCLASSIFIED CHANNEL EXCAVATION	203.27			
						75	50				125	CY	STRUCTURE EXCAVATION	204.25			
						140	130				270	CY	GRANULAR BACKFILL FOR STRUCTURES	204.30			
					72						72	TON	SUPERPAVE BITUMINOUS CONCRETE PAVEMENT	490.30			
					114	30	30				174	CY	CONCRETE, HIGH PERFORMANCE CLASS A (FPQ)	501.33			
						37	40	26	26		129	CY	CONCRETE, HIGH PERFORMANCE CLASS B	501.34			
						1					1	LS	FURNISHING EQUIPMENT FOR DRIVING PILING	504.10			
						315	273				588	LF	STEEL PILING, HP 12 X 84	505.165			
						1	1				2	EACH	DYNAMIC PILE LOADING TEST	505.45			
					170085						170085	LB	STRUCTURAL STEEL, PLATE GIRDER (FPQ)	506.55			
						1696	1820	3282	3211		10009	LB	REINFORCING STEEL, LEVEL I	507.11			
					26431	7752	7979	162	162		42486	LB	REINFORCING STEEL, LEVEL II	507.12			
						1					1	LS	SHEAR CONNECTORS (1080 - 7/8" X 7")	508.15			
						24	3	3			30	GAL	WATER REPELLENT, SILANE	514.10			
								30	30		60	LF	BRIDGE EXPANSION JOINT, ASPHALTIC PLUG	516.10			
					429						429	SY	SHEET MEMBRANE WATERPROOFING, TORCH APPLIED (FPQ)	519.20			
					60						60	LF	JOINT SEALER, HOT POURED	524.11			
					278						278	LF	BRIDGE RAILING, GALVANIZED STEEL TUBING/CONCRETE COMBINATION (FPQ)	525.45			
						1					1	EACH	REMOVAL OF STRUCTURE (2600 SF - EST.)	529.15			
						4	4				8	EACH	BEARING DEVICE ASSEMBLY, STEEL REINFORCED ELASTOMERIC PAD	531.17			
										1280	1280	CY	STONE FILL, TYPE III	613.12			

PROJECT NAME: ROYALTON  
 PROJECT NUMBER: BRS 0147 (13)  
 FILE NAME: /Structures/86e055qty.dgn  
 PROJECT LEADER: C. CARLSON  
 DESIGNED BY: D. PETERSON  
 BRIDGE 27 QUANTITY SHEET  
 PLOT DATE: 08-OCT-2013  
 DRAWN BY: D. PETERSON  
 CHECKED BY: J LACROIX  
 SHEET 10 OF 186

# BRIDGE QUANTITY SHEET 2

SUMMARY OF BRIDGE QUANTITIES													TOTALS		DESCRIPTIONS			DETAILED SUMMARY OF QUANTITIES		
													CATTLE PASS	BRIDGE TOTAL	UNIT	ITEMS	ITEM NUMBER	QUANTITIES	UNIT	ITEMS
													890	890	CY	STRUCTURE EXCAVATION	204.25			
													670	670	CY	GRANULAR BACKFILL FOR STRUCTURES	204.30			
													10	10	GAL	WATER REPELLENT, SILANE	514.10			
													1	1	LS	PRECAST CONCRETE STRUCTURE (8'-0" X 6'-0" X 36'-4" BOX)	540.10			

PROJECT NAME: ROYALTON  
PROJECT NUMBER: BRS 0147 (13)  
FILE NAME: /Structures/86e055qty.dgn  
PROJECT LEADER: C. CARLSON  
DESIGNED BY: D. PETERSON  
CATTLE PASS QUANTITY SHEET  
PLOT DATE: 08-OCT-2013  
DRAWN BY: D. PETERSON  
CHECKED BY: J LACROIX  
SHEET II OF 186

# BRIDGE QUANTITY SHEET 3

SUMMARY OF BRIDGE QUANTITIES										TOTALS		DESCRIPTIONS			DETAILED SUMMARY OF QUANTITIES		
					SUPERSTRUCTURE	ABUTMENT NO. 1	ABUTMENT NO. 2	APPROACH SLAB NO.1	APPROACH SLAB NO. 2	CHANNEL	BRIDGE TOTAL	UNIT	ITEMS	ITEM NUMBER	QUANTITIES	UNIT	ITEMS
										1640	1640	CY	UNCLASSIFIED CHANNEL EXCAVATION	203.27			
										590	590	CY	GRANULAR BACKFILL FOR STRUCTURES	204.30			
										720	720	CY	COFFERDAM EXCAVATION, EARTH	208.30			
						5	5				10	CY	COFFERDAM EXCAVATION, ROCK	208.35			
						1					1	LS	COFFERDAM (ABUTMENT #1)	208.40			
							1				1	LS	COFFERDAM (ABUTMENT #2)	208.40			
					68						68	TON	SUPERPAVE BITUMINOUS CONCRETE PAVEMENT	490.30			
					114						114	CY	CONCRETE, HIGH PERFORMANCE CLASS A (FPQ)	501.33			
						156	153	28	28		365	CY	CONCRETE, HIGH PERFORMANCE CLASS B	501.34			
					191903						191903	LB	STRUCTURAL STEEL, CURVED PLATE GIRDER (FPQ)	506.56			
						1					1	LS	STRUCTURAL STEEL	506.75			
						11718	15636	3475	3225		34054	LB	REINFORCING STEEL, LEVEL I	507.11			
					27039	2385	1851				31275	LB	REINFORCING STEEL, LEVEL II	507.12			
							174				174	LF	DRILLING AND GROUTING DOWELS	507.16			
					1						1	LS	SHEAR CONNECTORS (1176 - 7/8" X 7")	508.15			
					15	8	7				30	GAL	WATER REPELLENT, SILANE	514.10			
						38					38	LF	BRIDGE EXPANSION JOINT, VERMONT (FPQ)	516.11			
					405						405	SY	SHEET MEMBRANE WATERPROOFING, TORCH APPLIED (FPQ)	519.20			
					31						31	LF	JOINT SEALER, HOT Poured	524.11			
					1						1	EACH	REMOVAL OF STRUCTURE (2550 SF-EST.)	529.15			
						5	5				10	EACH	BEARING DEVICE ASSEMBLY, HIGH LOAD MULTI-ROTATIONAL	531.15			
						5	5				10	CY	CONCRETE, CLASS C	541.30			
										650	650	CY	STONE FILL, TYPE IV	613.13			
					242						242	LF	SPECIAL PROVISION (BRIDGE RAILING, TEXAS) (FPQ)	900.640			
					1						1	LS	SPECIAL PROVISION (QC/QA CLEANING AND PAINTING STRUCTURAL COMPONENTS)	900.645			

PROJECT NAME: ROYALTON  
 PROJECT NUMBER: BRS 0147 (13)  
 FILE NAME: /Structures/86e055qty.dgn PLOT DATE: 08-OCT-2013  
 PROJECT LEADER: C. CARLSON DRAWN BY: D. PETERSON  
 DESIGNED BY: D. PETERSON CHECKED BY: J LACROIX  
 BRIDGE 28 QUANTITY SHEET SHEET 12 OF 186

# PRELIMINARY INFORMATION SHEET (BRIDGE 27)

LRFD

INDEX OF SHEETS

PLAN SHEETS

SEE SHEET 2 FOR INDEX OF SHEETS

STANDARDS LIST

FINAL HYDRAULIC REPORT

HYDROLOGIC DATA

Date: December 2010

DRAINAGE AREA : 70.1 sq. mi.  
 CHARACTER OF TERRAIN : Mixture of woods and open fields  
 STREAM CHARACTERISTICS : Meandering and incised  
 NATURE OF STREAMBED : Silty sand

PEAK FLOW DATA

Q 2.33 = 3000 cfs                      Q 50 = 6400 cfs  
 Q 10 = 4300 cfs                      Q 100 = 7600 cfs  
 Q 25 = 5400 cfs                      Q 500 = 10,300 cfs

DATE OF FLOOD OF RECORD : unknown  
 ESTIMATED DISCHARGE : unknown  
 WATER SURFACE ELEV. : unknown  
 NATURAL STREAM VELOCITY : @ Q50 = 5.2 fps  
 ICE CONDITIONS : moderate  
 DEBRIS : light to moderate  
 DOES THE STREAM REACH MAXIMUM HIGHWATER ELEV. RAPIDLY? no  
 IS ORDINARY RISE RAPID? no  
 IS STAGE AFFECTED BY UPSTREAM OR DOWNSTREAM CONDITIONS? no  
 IF YES, DESCRIBE:

WATERSHED STORAGE : <1%      HEADWATERS :  
 UNIFORM : X  
 IMMEDIATELY ABOVE SITE :

EXISTING STRUCTURE INFORMATION

STRUCTURE TYPE : 3-span concrete T-beam bridge  
 YEAR BUILT : 1927  
 CLEAR SPAN(NORMAL TO STREAM): 89'  
 VERTICAL CLEARANCE ABOVE STREAMBED: 12.5'  
 WATERWAY OF FULL OPENING: 755 sq. ft.  
 DISPOSITION OF STRUCTURE: Remove and replace  
 TYPE OF MATERIAL UNDER SUBSTRUCTURE: See borings

WATER SURFACE ELEVATIONS AT:

Q2.33 = 501.1'                      VELOCITY = 9.0 fps  
 Q10 = 503.5'                      "                      8.2 fps  
 Q25 = 506.0'                      "                      7.7 fps  
 Q50 = 508.7'                      "                      8.9 fps  
 Q100 = 511.1'                      "                      9.7 fps

LONG TERM STREAMBED CHANGES : None

IS THE ROADWAY OVERTOPPED BELOW Q100: Yes  
 FREQUENCY: Below Q50  
 RELIEF ELEVATION: 507.6'  
 DISCHARGE OVER ROAD @Q100: 820 cfs

UPSTREAM STRUCTURE

TOWN: Royallton                      DISTANCE: 3100'  
 HIGHWAY #: VT 14                      STRUCTURE #: BR 28  
 CLEAR SPAN: 100'                      CLEAR HEIGHT: 15'  
 YEAR BUILT: 1925                      FULL WATERWAY: 630 sq. ft.  
 STRUCTURE TYPE: 3-span concrete T-beam

DOWNSTREAM STRUCTURE

TOWN: Royallton                      DISTANCE: 9230'  
 HIGHWAY #: VT 107                      STRUCTURE #: BR 21  
 CLEAR SPAN: 148'                      CLEAR HEIGHT: 31'  
 YEAR BUILT: 1937                      FULL WATERWAY: 3300 sq. ft.  
 STRUCTURE TYPE: 3-span rolled beam

LRFR LOAD RATING FACTORS

LOADING LEVELS	TRUCK						
	HL-93	HL-93	3S2	6 AXLE	3A STR	4A STR	5A SEMI
TONNAGE	20	36	36	66	30	34.5	38
INVENTORY	3.43	1.12					
POSTING							
OPERATING	4.44	1.45	2.94	1.77	3.04	2.69	
COMMENTS:							

AS BUILT "REBAR" DETAIL

LEVEL I	LEVEL II	LEVEL III
TYPE:	TYPE:	TYPE:
GRADE:	GRADE:	GRADE:

TRAFFIC DATA

YEAR	ADT	DHV	% D	% T	ADTT	20 year ESAL for flexible pavement from 2003 to 2023 : 2667000
2003	1500	210	59	8	170	40 year ESAL for flexible pavement from 2003 to 2043 : 6477000
2023	2000	280	59	8	230	Design Speed : 50 mph

PILE DRIVING AND TESTING REQUIREMENTS

- NOMINAL PILE DRIVING CAPACITY  $P_{nd}$ : 612.0 KIP
- PILE TEST RESISTANCE FACTOR  $\phi$ : 0.65
- MAXIMUM PILE TIP ELEVATION: 455 FT
- PERFORM ONE DYNAMIC LOAD TEST FOR EACH ABUTMENT.

PROPOSED STRUCTURE

STRUCTURE TYPE: Single span steel beam bridge

CLEAR SPAN(NORMAL TO STREAM): 107'  
 VERTICAL CLEARANCE ABOVE STREAMBED: 16.8'  
 WATERWAY OF FULL OPENING: 1280 sq. ft.

WATER SURFACE ELEVATIONS AT:

Q2.33 = 500.7'                      VELOCITY = 8.1 fps  
 Q10 = 503.2'                      "                      7.5 fps  
 Q25 = 505.5'                      "                      7.1 fps  
 Q50 = 507.7'                      "                      6.8 fps  
 Q100 = 509.8'                      "                      6.9 fps

IS THE ROADWAY OVERTOPPED BELOW Q100: No  
 FREQUENCY: N/A  
 RELIEF ELEVATION: 512.9'  
 DISCHARGE OVER ROAD @Q100: None

AVERAGE LOW ELEVATION OF SUPERSTRUCTURE: 509.3'  
 VERTICAL CLEARANCE: @ Q50 = 1.2'

SCOUR: 1.0' @ Q100 and 2.0' @ Q500

REQUIRED CHANNEL PROTECTION: Stone Fill, Type III

PERMIT INFORMATION

AVERAGE DAILY FLOW: 145 cfs                      DEPTH OR ELEVATION:  
 ORDINARY LOW WATER: 70 cfs                      2.0'  
 ORDINARY HIGH WATER: 1300 cfs                      6.0'

TEMPORARY BRIDGE REQUIREMENTS

STRUCTURE TYPE: None required  
 CLEAR SPAN(NORMAL TO STREAM):  
 VERTICAL CLEARANCE ABOVE STREAMBED:  
 WATERWAY AREA OF FULL OPENING:

ADDITIONAL INFORMATION

NAVD 88 elevations

TRAFFIC MAINTENANCE NOTES

- MAINTAIN TWO-WAY TRAFFIC ON THE EXISTING STRUCTURE.
- TRAFFIC SIGNALS ARE NOT NECESSARY.
- SIDEWALKS ARE NOT NECESSARY


DESIGN VALUES

1. DESIGN LIVE LOAD	HL-93
2. FUTURE PAVEMENT	$d_p$ : ---
3. DESIGN SPAN	$L$ : 136.00 FT
4. MIN. MID-SPAN POS. CAMBER @ RELEASE (PRESTRESSED UNITS)	$\Delta$ : ---
5. PRESTRESSING STRAND	$f_y$ : ---
6. PRESTRESSED CONCRETE STRENGTH	$f'c$ : ---
7. PRESTRESSED CONCRETE RELEASE STRENGTH	$f'cr$ : ---
8. CONCRETE, HIGH PERFORMANCE CLASS AA	$f'c$ : ---
9. CONCRETE, HIGH PERFORMANCE CLASS A	$f'c$ : 4.0 KSI
10. CONCRETE, HIGH PERFORMANCE CLASS B	$f'c$ : 3.5 KSI
11. CONCRETE, CLASS C	$f'c$ : ---
12. REINFORCING STEEL	$f_y$ : 60 KSI
13. STRUCTURAL STEEL AASHTO M270 (WEATHERING)	$f_y$ : 50 KSI
14. SOIL UNIT WEIGHT	$\gamma$ : 0.140 KCF
15. NOMINAL BEARING RESISTANCE OF SOIL	$q_n$ : ---
16. SOIL BEARING RESISTANCE FACTOR (REFER TO AASHTO LRFD)	$\phi$ : ---
17. NOMINAL BEARING RESISTANCE OF ROCK	$q_n$ : ---
18. ROCK BEARING RESISTANCE FACTOR (REFER TO AASHTO LRFD)	$\phi$ : ---
19. NOMINAL AXIAL PILE RESISTANCE	$q_p$ : 612.0 KIPS
20. PILE YIELD STRENGTH ASTM A572	$f_y$ : 50 KSI
21. PILE SIZE	HP 12X 84
22. EST. PILE LENGTH	$L_p$ : 58 FT
23. PILE RESISTANCE FACTOR	$\phi$ : 0.65
24. LATERAL PILE DEFLECTION	$\Delta$ : 0.52 INCH
25. BASIC WIND SPEED	$V_{3s}$ : ---
26. MINIMUM GROUND SNOW LOAD	$p_g$ : ---
27. SEISMIC DATA	PGA: --- $S_s$ : --- $S_f$ : ---

PROJECT NAME: ROYALTON

PROJECT NUMBER: BRS 0147(13)


FILE NAME: IBR 271s86e055pi_27.dgn      PLOT DATE: 10/4/2013  
 PROJECT LEADER: C. CARLSON      DRAWN BY: D. PETERSON  
 DESIGNED BY: D. PETERSON      CHECKED BY: C. CARLSON  
 BRIDGE 27 PRELIMINARY INFORMATION      SHEET 13 OF 186

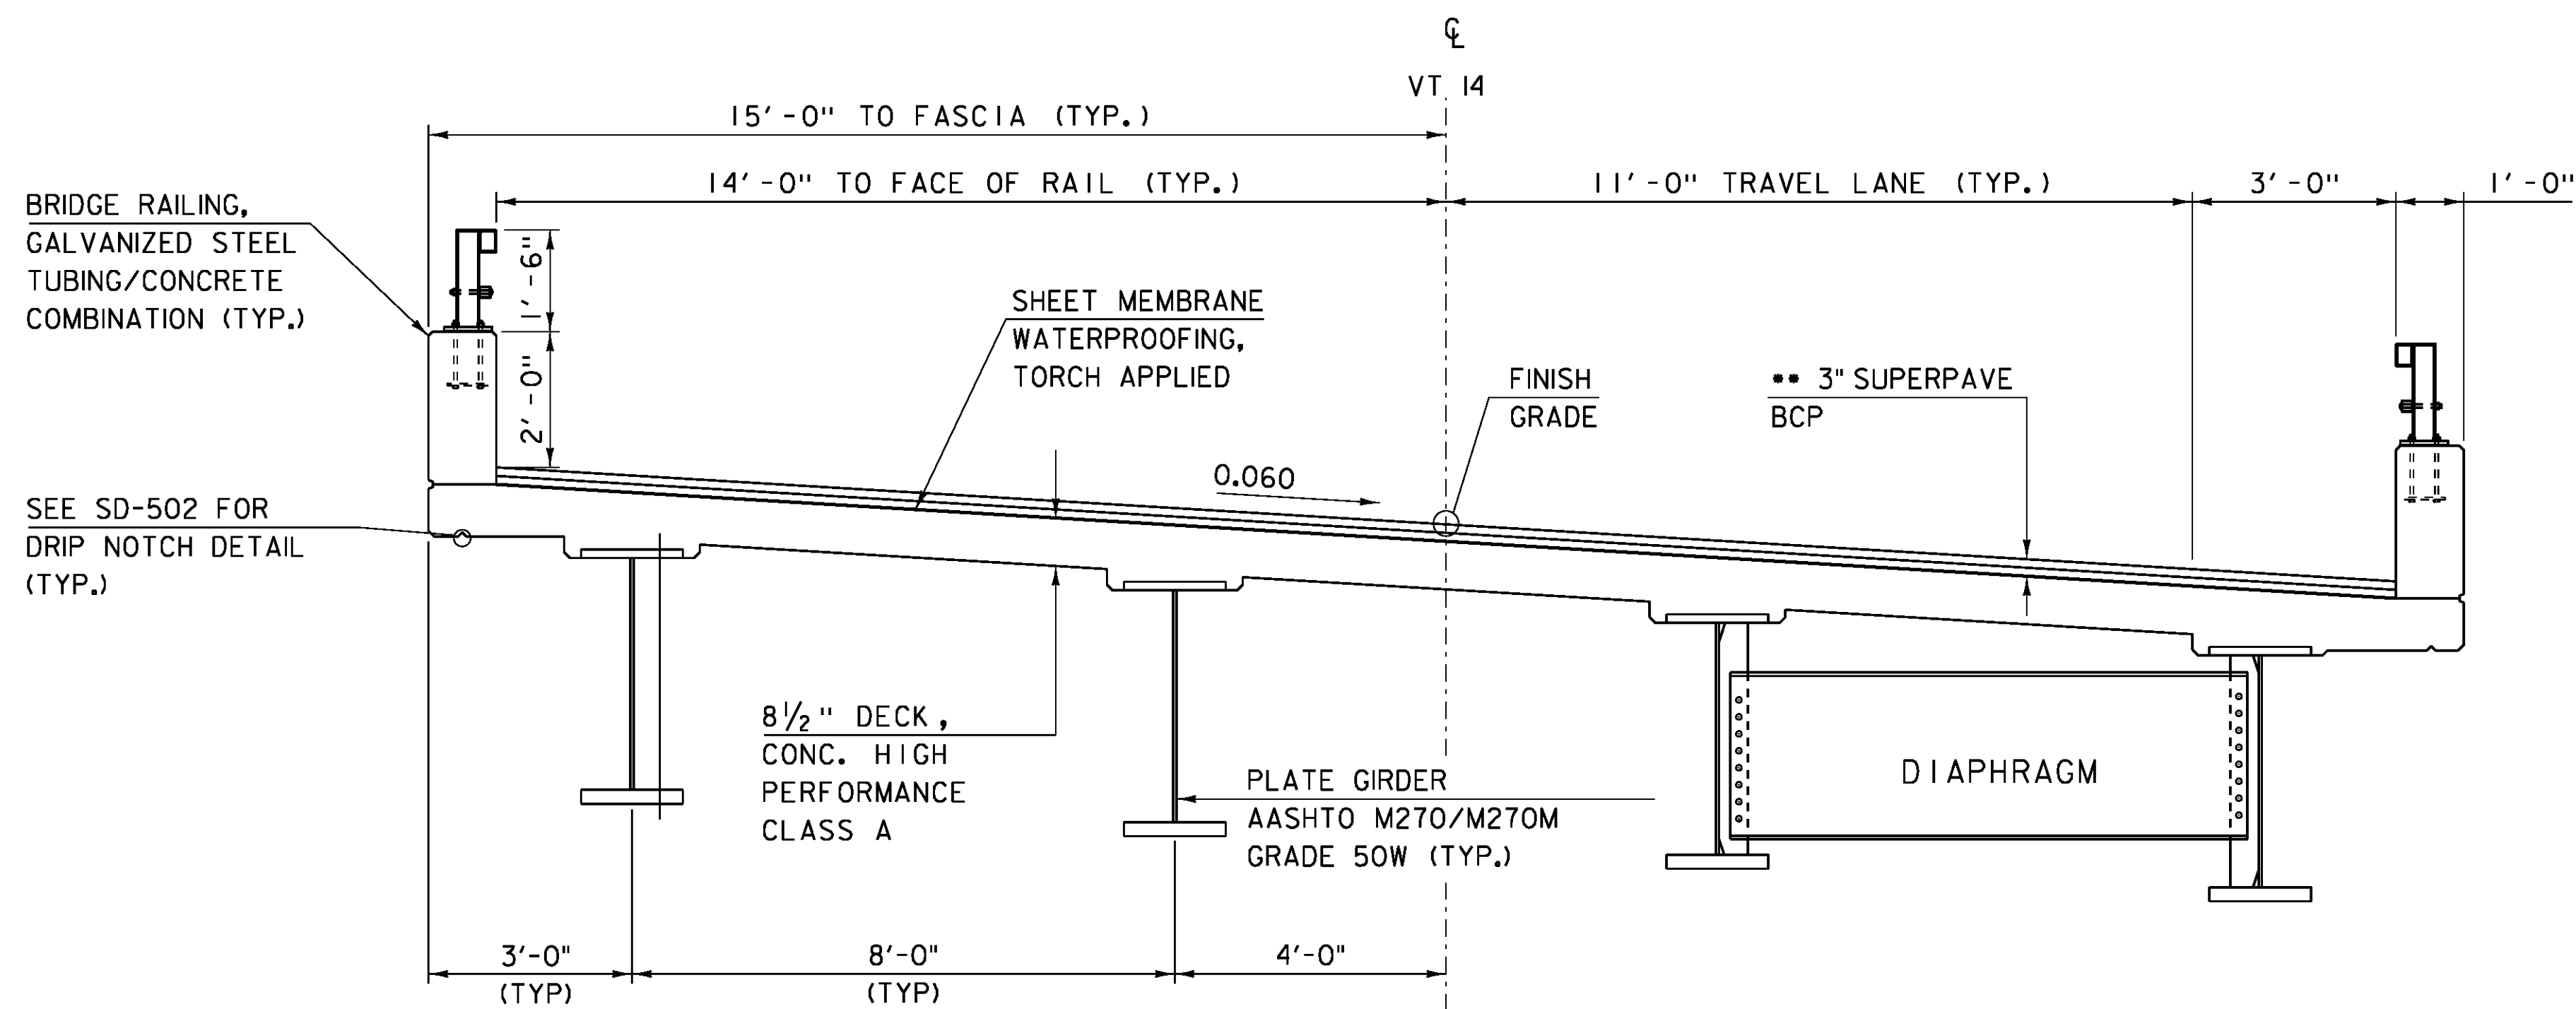

••BCP SHOULD BE READ AS BITUMINOUS CONCRETE PAVEMENT 1 1/2" TYPE IVS, OVER 1 1/2" TYPE IVS

**BRIDGE 27 TYPICAL SECTION**


SCALE 1/2" = 1' 0"

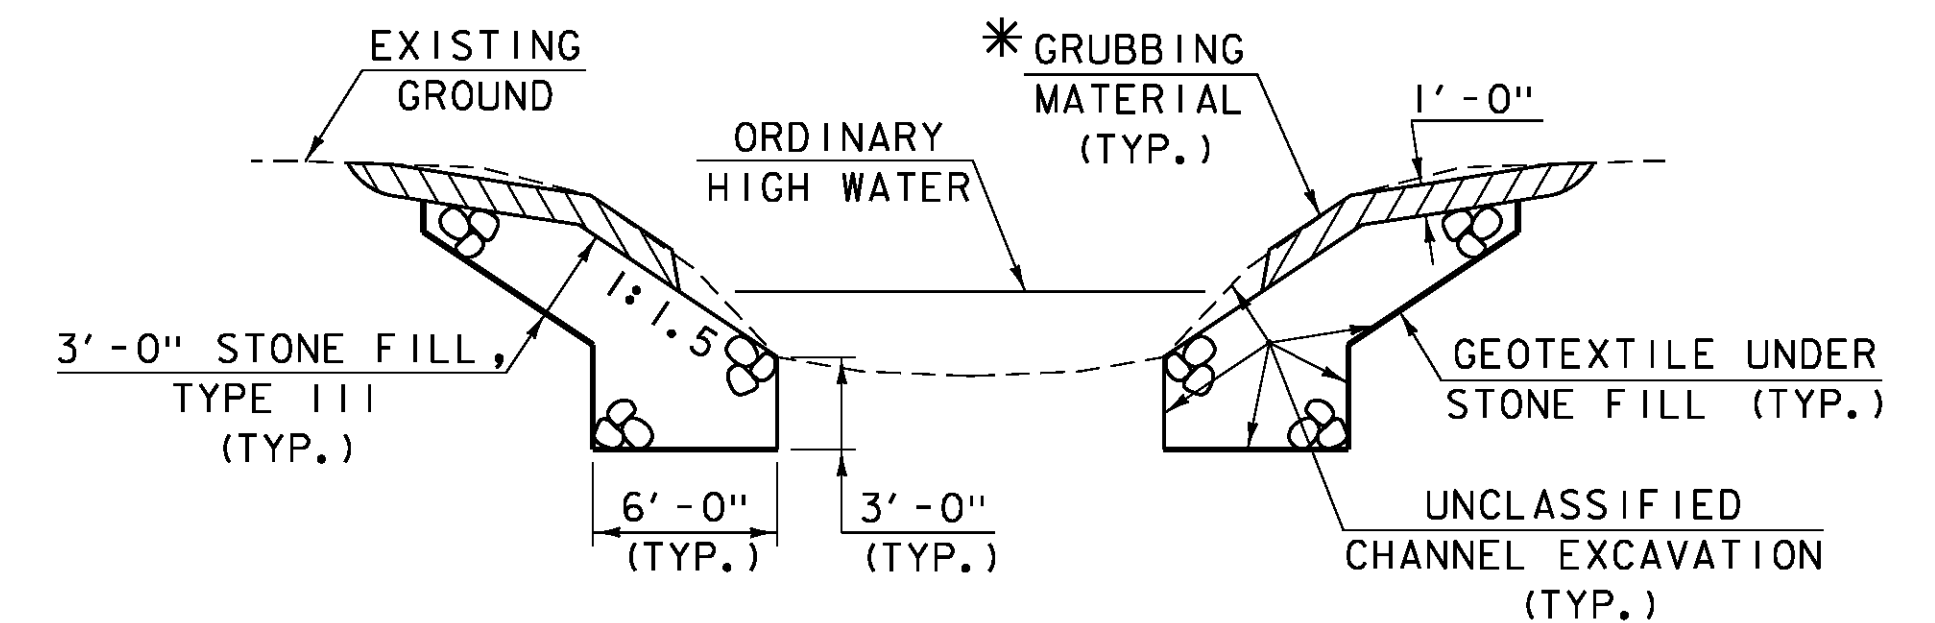

**CHANNEL TYPICAL SECTION**

(NOT TO SCALE)


* GRUBBING MATERIAL SHALL NOT BE PLACED ON THE STONE FILL IN THE AREA UNDER THE BRIDGE. WHENEVER CHANNEL SLOPE INTERSECTS ROADWAY SUBBASE, GRUBBING MATERIAL SHALL BEGIN AT THE BOTTOM OF SUBBASE.

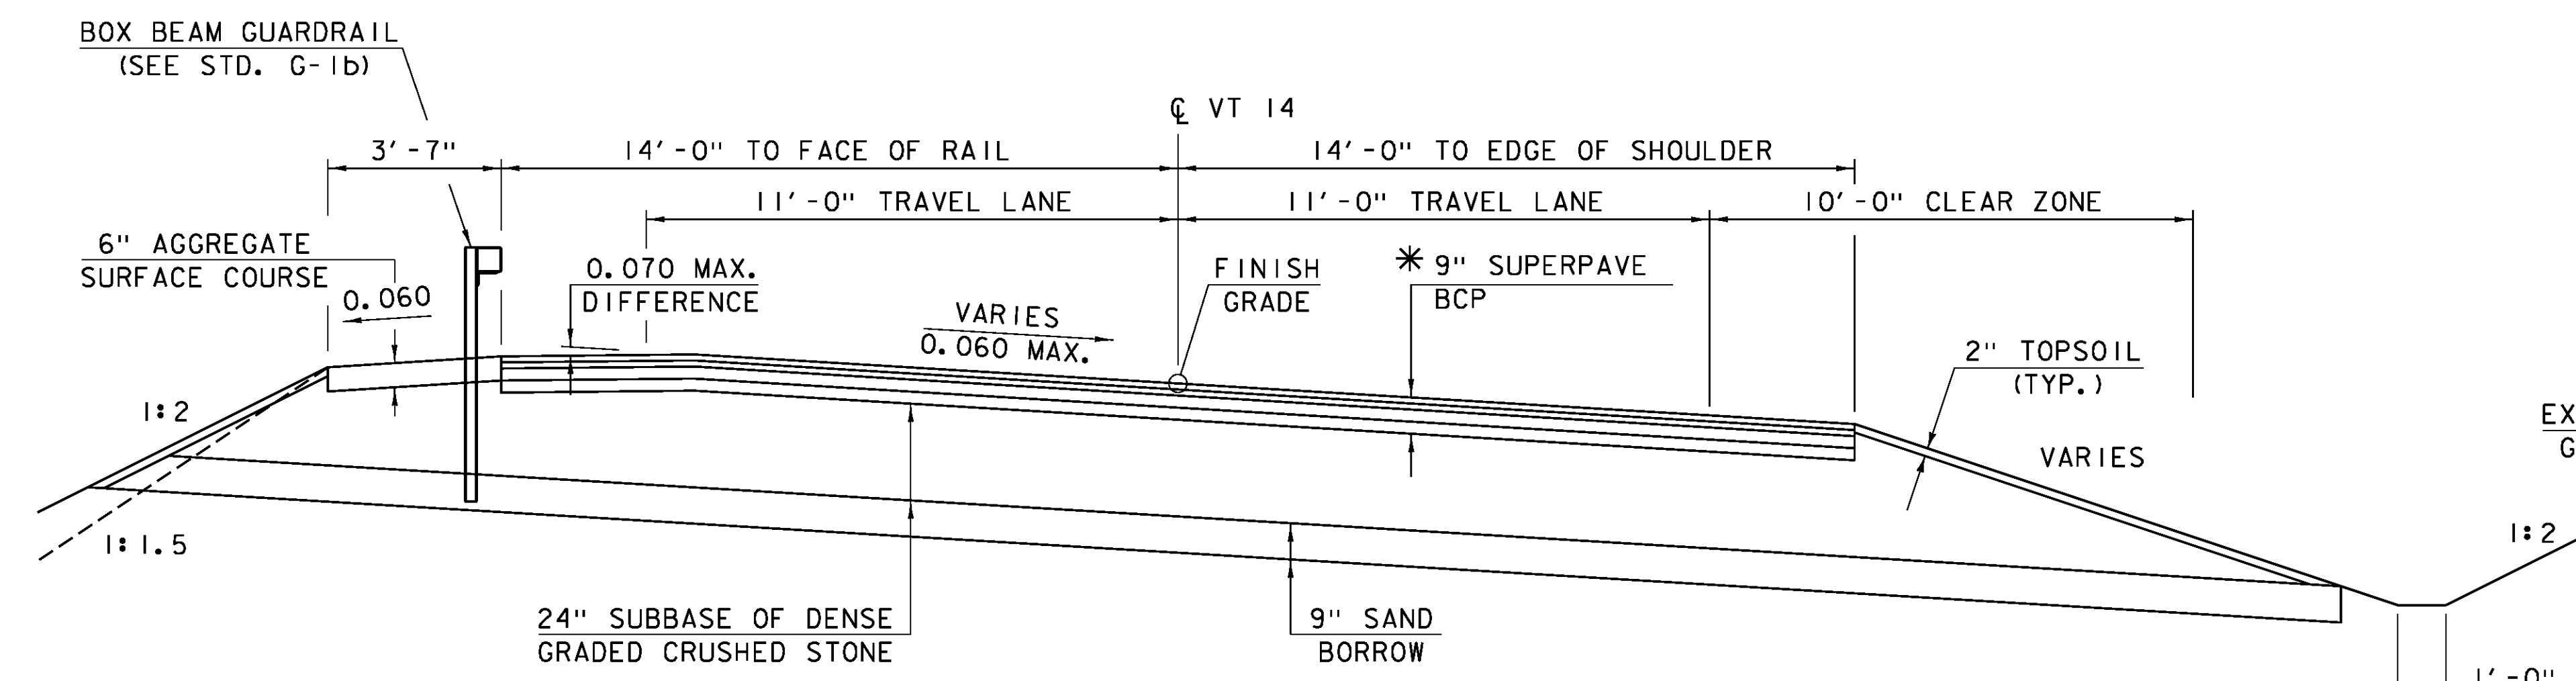

**VT 14 TYPICAL BANKED SECTION**

SCALE 3/8" = 1' 0"

* BCP SHOULD BE READ AS BITUMINOUS CONCRETE PAVEMENT 1 1/2" TYPE IVS OVER 1 1/2" TYPE IVS OVER 3" TYPE IIS OVER 3" TYPE IIS

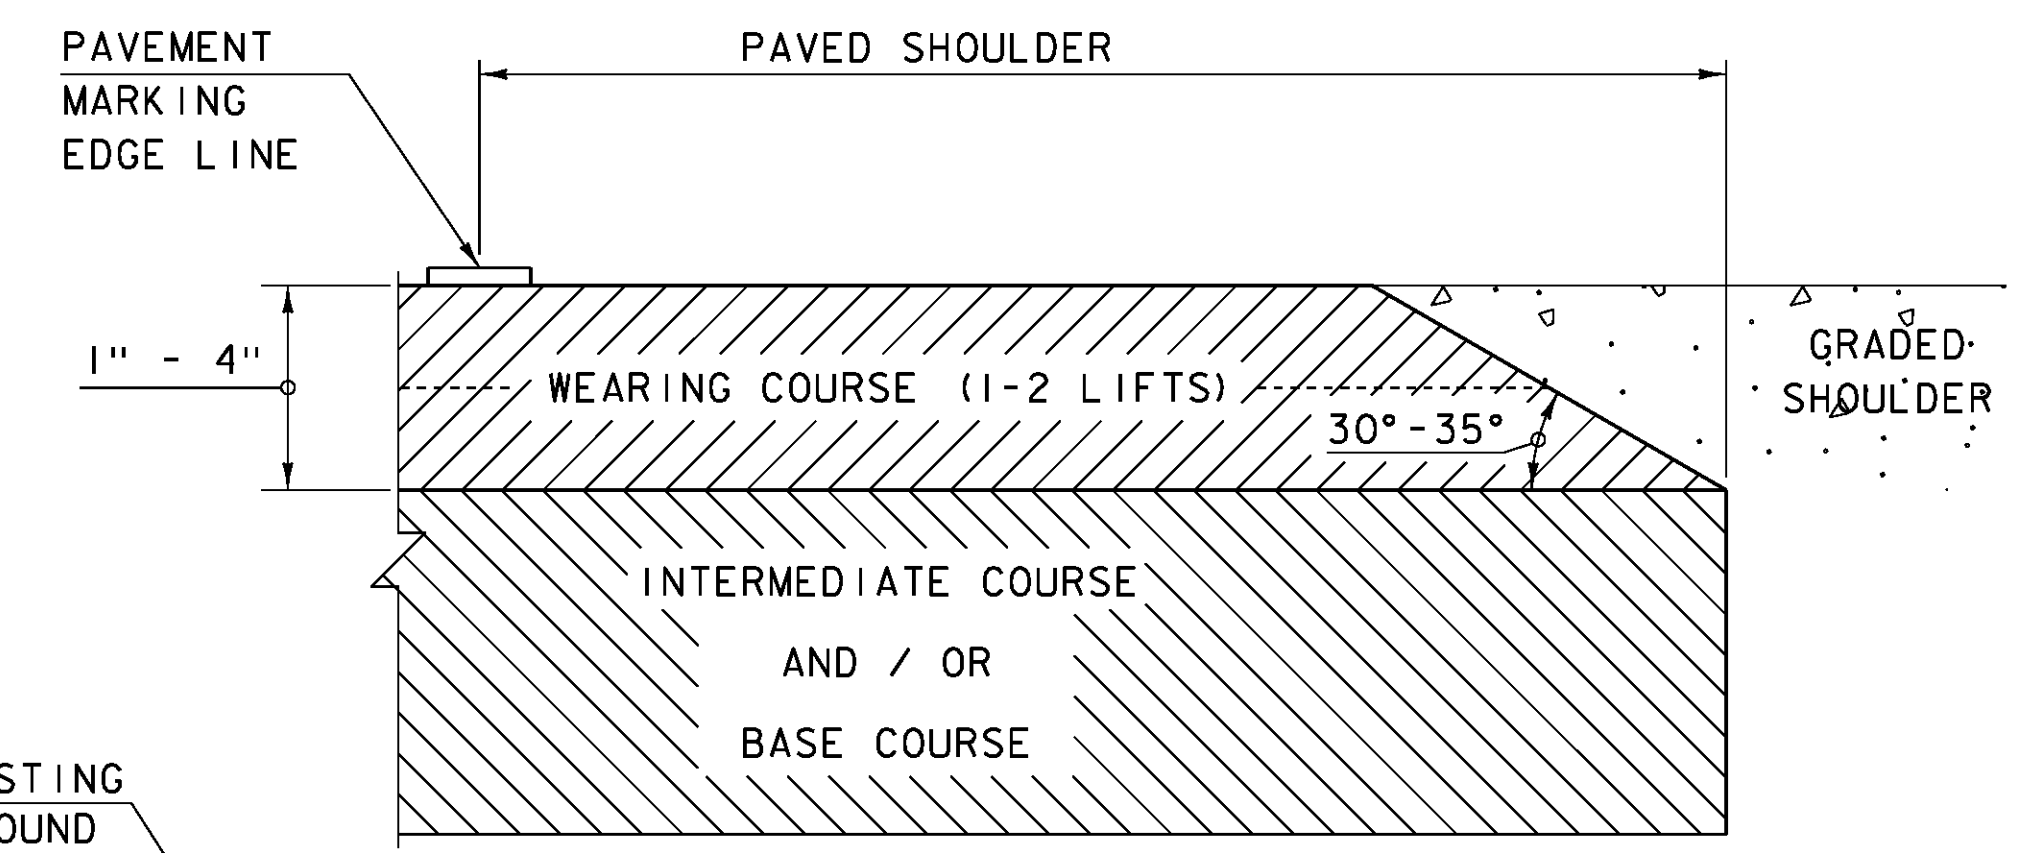


**SAFETY EDGE DETAIL**

NOT TO SCALE


- NOTES:
1. LEVELING COURSE MAY INCLUDE THE "SAFETY EDGE" AT THE CONTRACTOR'S CHOICE.
  2. THE EDGE OF PAVEMENT SHALL BE FORMED IN SUCH A WAY THAT THE BITUMINOUS CONCRETE PAVEMENT IS EXTRUDED OR COMPRESSED TO FORM THE 30 TO 35 DEGREE ANGLE. DEVICES THAT SIMPLY STRIKE-OFF THE MIX WITHOUT PROVIDING ANY COMPACTIVE EFFORT WILL NOT BE ALLOWED.

MATERIAL TOLERANCES (IF USED ON PROJECT)	
SURFACE	
- PAVEMENT (TOTAL THICKNESS)	+/- 1/4"
- AGGREGATE SURFACE COURSE	+/- 1/2"
SUBBASE	+/- 1"
SAND BORROW	+/- 1"


PROJECT NAME: ROYALTON  
 PROJECT NUMBER: BRS 0147 (13)  
 FILE NAME: \BR 27\s86e055+typ.27.dgn PLOT DATE: 08-OCT-2013  
 PROJECT LEADER: C. CARLSON DRAWN BY: D. PETERSON  
 DESIGNED BY: D. PETERSON CHECKED BY: C. CARLSON  
 BRIDGE 27 PROJECT TYPICAL SECTIONS (1) SHEET 14 OF 186

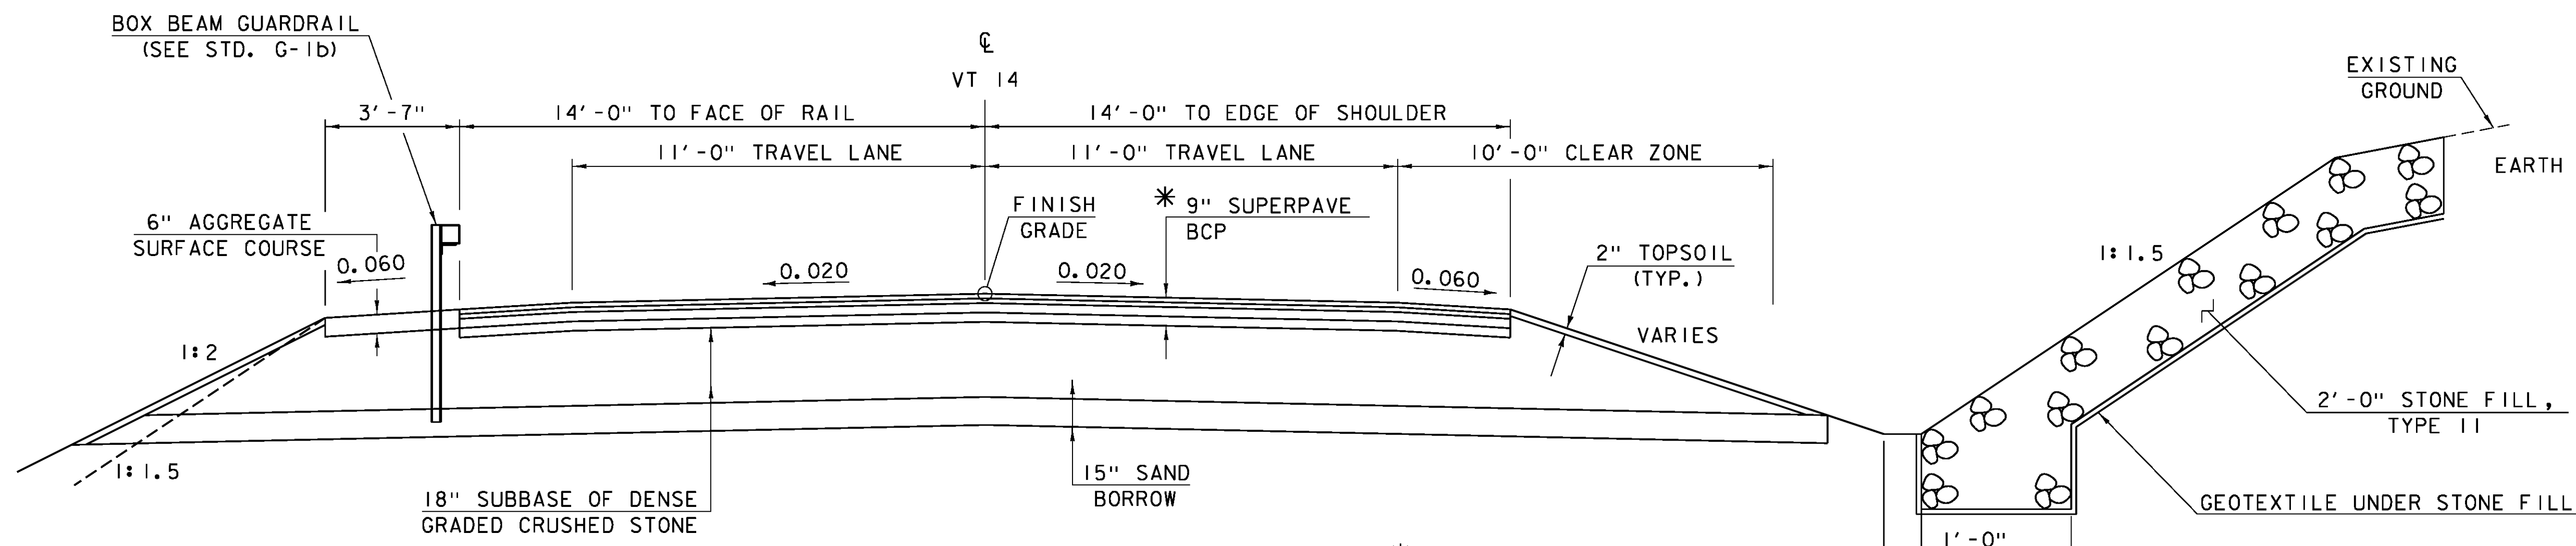

**VT 14 TYPICAL NORMAL SECTION**

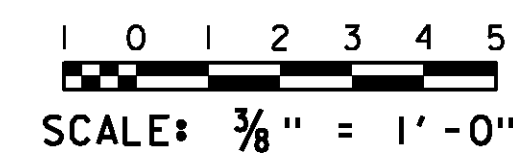


* BCP SHOULD BE READ AS BITUMINOUS CONCRETE PAVEMENT  
 1 1/2" TYPE IVS OVER  
 1 1/2" TYPE IVS OVER  
 3" TYPE IIS OVER  
 3" TYPE IIS

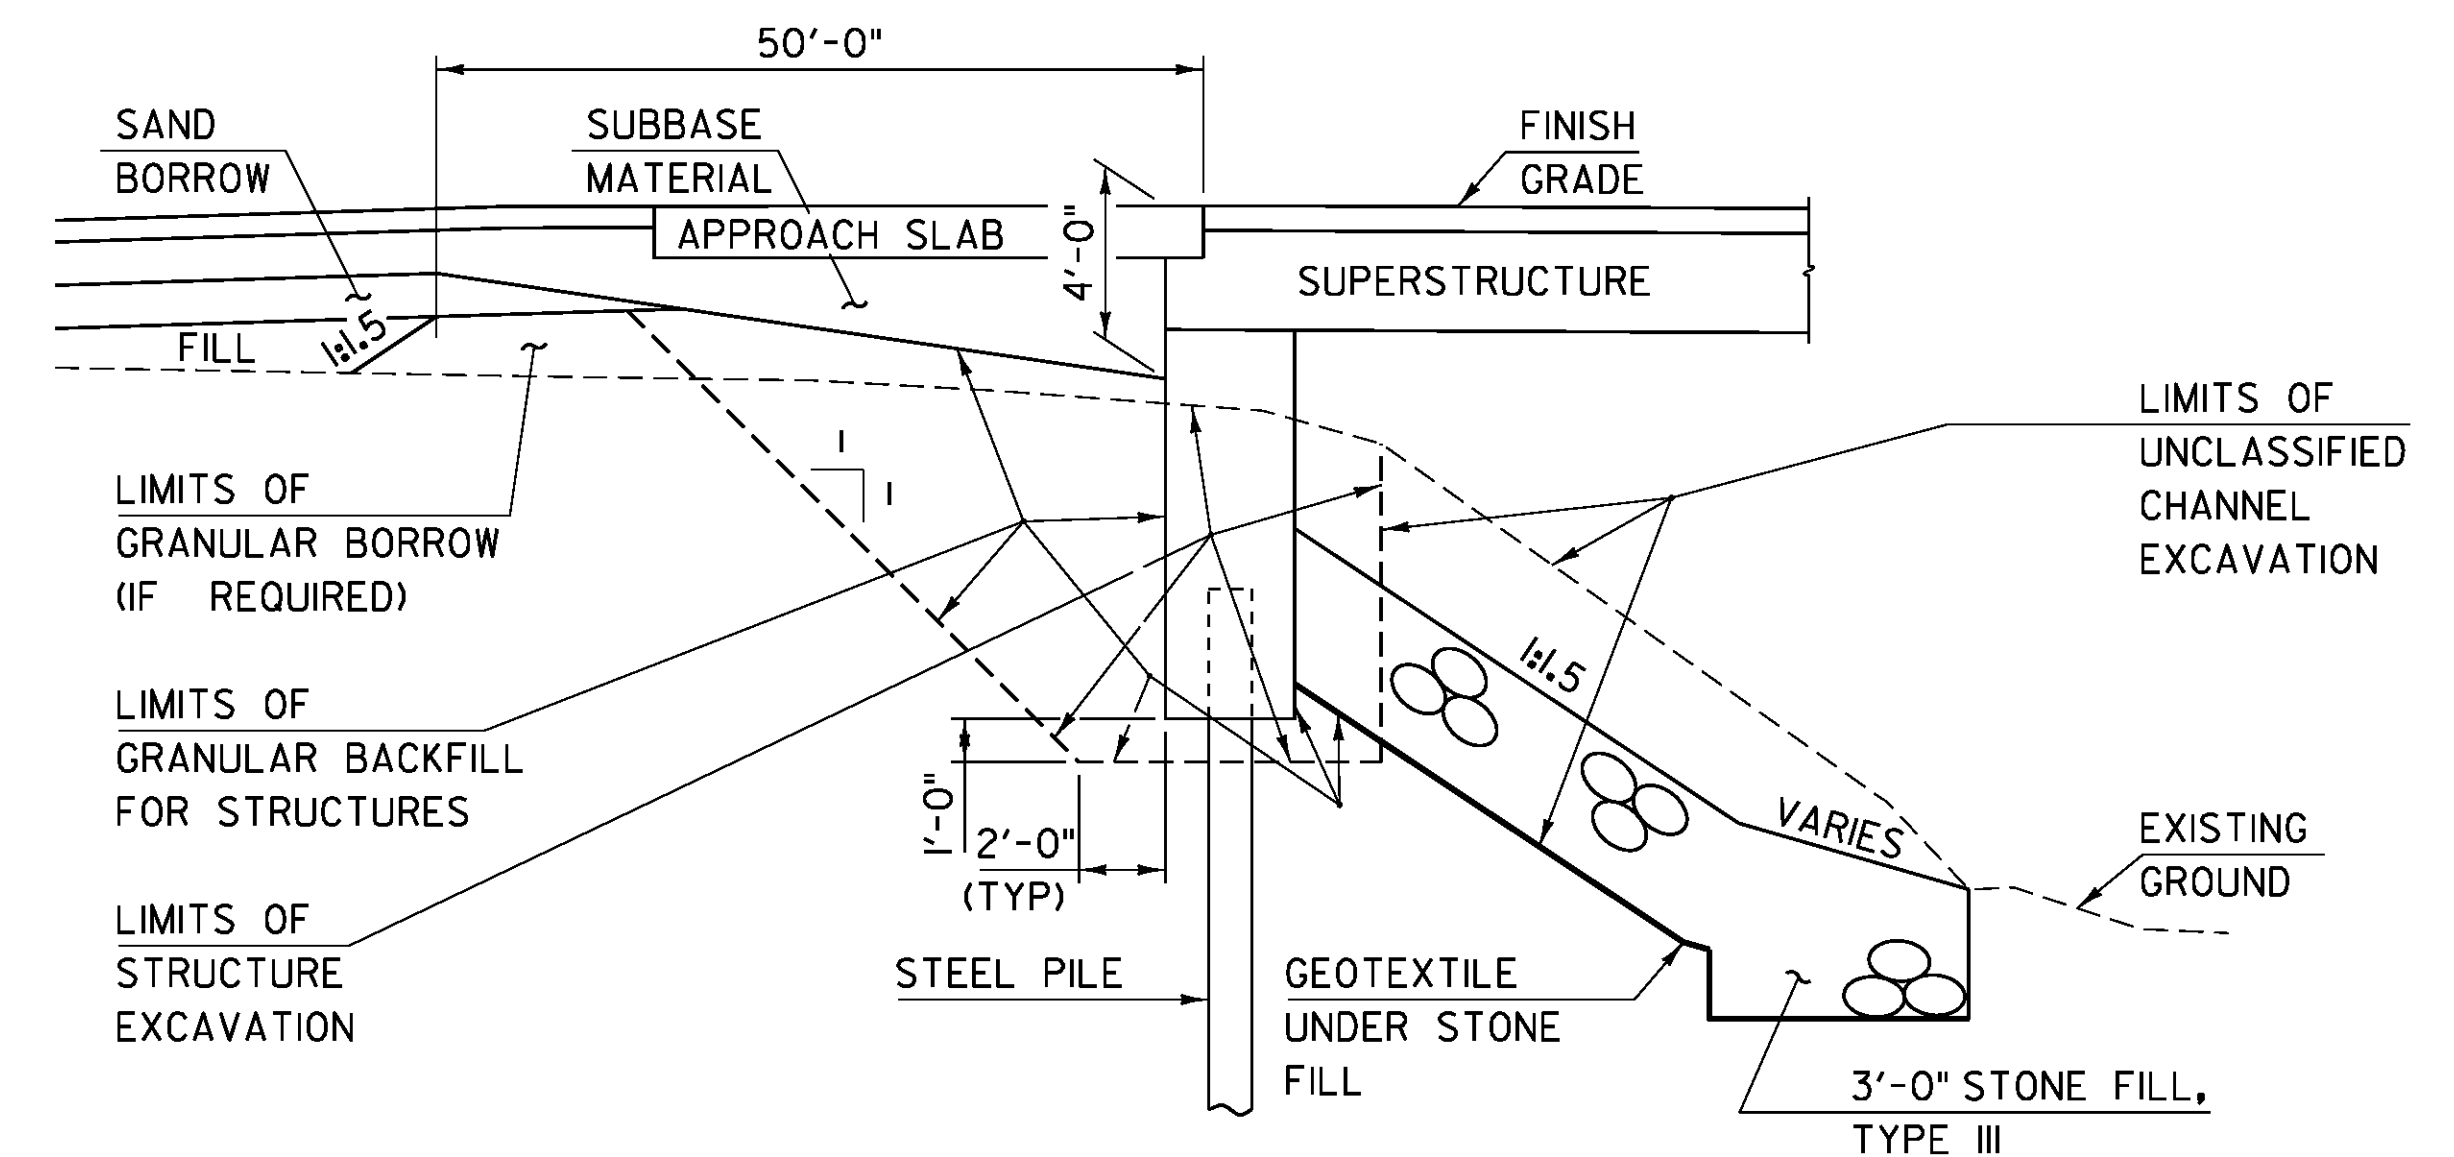


**ABUTMENT EARTHWORK TYPICAL SECTION**

NTS

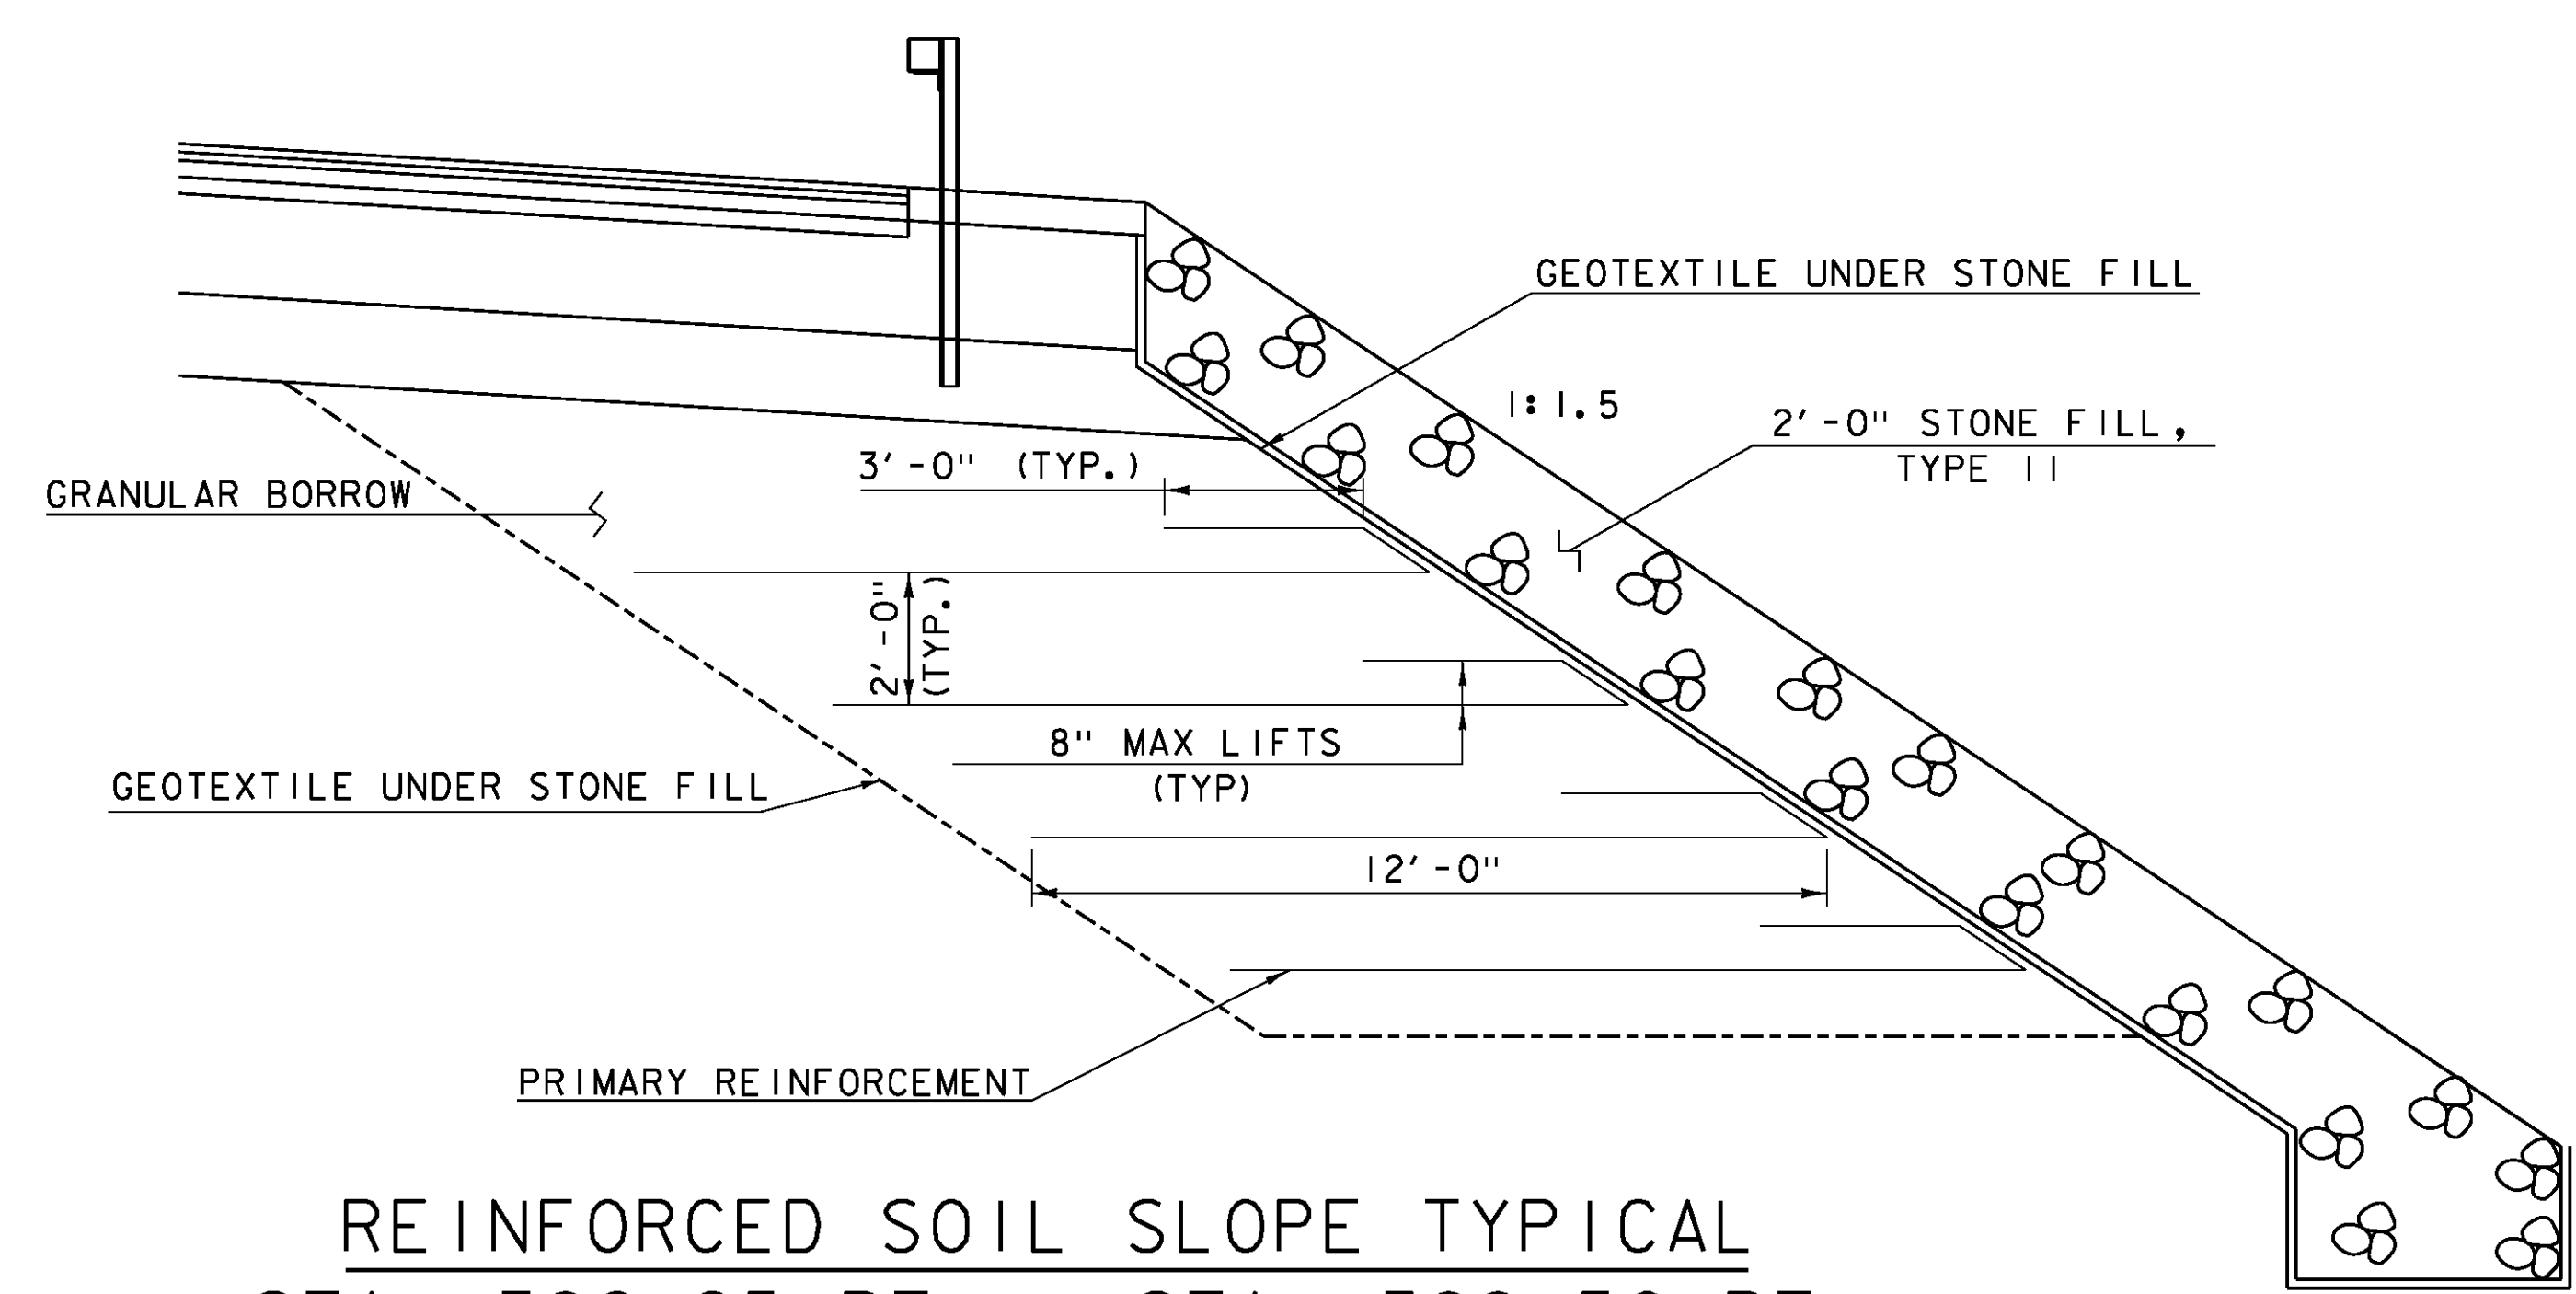

**REINFORCED SOIL SLOPE TYPICAL  
 STA. 386+25 RT. - STA. 388+50 RT.**

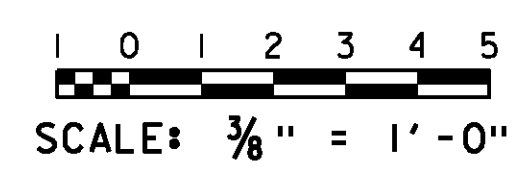

	SECTIONS 386+25 - 388+50
MINIMUM GEOGRID ULTIMATE TENSILE STRENGTH	3050 lb/ft
NUMBER OF REINFORCEMENT LAYERS	4
LENGTHS OF PRIMARY REINFORCEMENT	FOUR - 12 FT
VERTICAL SPACING OF PRIMARY REINFORCEMENT	2.0 FT
TOP REINFORCEMENT ELEVATION (NOT INCLUDING RE-IMBEDMENT HEIGHT)	VARIES, SEE CROSS SECTIONS FOR REINFORCEMENT ELEVATIONS

PROJECT NAME: ROYALTON  
 PROJECT NUMBER: BRS 0147 (13)  
 FILE NAME: \BR 27\s86e055+yp.27.dgn PLOT DATE: 08-OCT-2013  
 PROJECT LEADER: C. CARLSON DRAWN BY: D. PETERSON  
 DESIGNED BY: D. PETERSON CHECKED BY: C. CARLSON  
 BRIDGE 27 PROJECT TYPICAL SECTIONS (2) SHEET 15 OF 186

GPS CONTROL POINTS

HVCTRL #1

STANDARD DISK STAMPED  
Spaulding Az Mk  
N = 490047.972  
E = 1616877.024  
ELEV. = 655.248

GENERAL LOCATION, ROYALTON, VT. OWNERSHIP, GEORGE AND AGNES SPAULDING, 7783 VT RTE 14, SOUTH ROYALTON, VT 05068. TO REACH FROM THE INTERSECTION OF VT ROUTE 14 AND VT ROUTE 107 IN NORTH ROYALTON GO NORTH ALONG VT ROUTE 14 FOR 2.0 MI (3.2 KM) TO THE INTERSECTION OF MORSE ROAD (TH 20) STRAIGHT, WATERMAN ROAD (TH 22) LEFT, AND VT ROUTE 14 RIGHT. TURN LEFT AND GO SOUTHWEST AND SOUTH ALONG WATERMAN ROAD FOR 0.3 MI (0.5 KM) TO A GATE IN A WIRE FENCE LINE AND THE SITE OF THE MARK ON THE LEFT IN A FIELD. THE MARK IS SET FLUSH WITH GROUND SURFACE IN THE TOP OF A LOW LYING ROCK OUTCROP. IT IS 9.8 M (32.2 FT) EAST OF AND ABOUT 0.2 M (0.7 FT) LOWER THAN THE CENTERLINE OF WATERMAN ROAD, 25.6 M (84.0 FT) NORTH NORTHEAST OF A 25 CM TRIPLE TRUNK APPLE, 5.5 M (18.0 FT) NORTHEAST OF THE MOST NORTHERLY GATE POST, AND 5.2 M (17.1 FT) EAST OF THE WIRE FENCE AND A FIBERGLASS WITNESS POST.






• DESCRIPTION PROVIDED BY VERMONT AGENCY OF TRANSPORTATION GEODETIC SURVEY UNIT

HVCTRL #2

STANDARD DISK STAMPED  
Spaulding  
N = 488849.386  
E = 1617960.788  
ELEV. = 502.952


GENERAL LOCATION, ROYALTON, VT. -OWNERSHIP, GEORGE AND AGNES SPAULDING, 7783 VT RTE 14, SOUTH ROYALTON, VT 05068. TO REACH FROM THE INTERSECTION OF VT ROUTE 14 AND VT ROUTE 107 IN NORTH ROYALTON GO NORTH ALONG VT ROUTE 14 FOR 1.5 MI (2.4 KM) TO THE SITE OF THE MARK ON THE LEFT. IT IS ABOUT 95 M (311.7 FT) SOUTH OF THE SOUTH END OF A CONCRETE BRIDGE OVER THE SECOND BRANCH OF THE WHITE RIVER. THE MARK IS SET ABOUT 0.3 M (1.0 FT) ABOVE GROUND SURFACE IN THE TOP OF A MASSIVE ROCK OUTCROP. IT IS 15.5 M (50.9 FT) WEST NORTHWEST OF AND ABOUT 2.5 M (8.2 FT) LOWER THAN THE CENTERLINE OF VT ROUTE 14, 11.2 M (36.7 FT) NORTH NORTHEAST OF A 10 CM PINE, 3.9 M (12.8 FT) NORTH OF A GUY ANCHOR, AND 4.7 M (15.4 FT) WEST OF POLE NO 42 AND A FIBERGLASS WITNESS POST.

TRAVERSE TIES

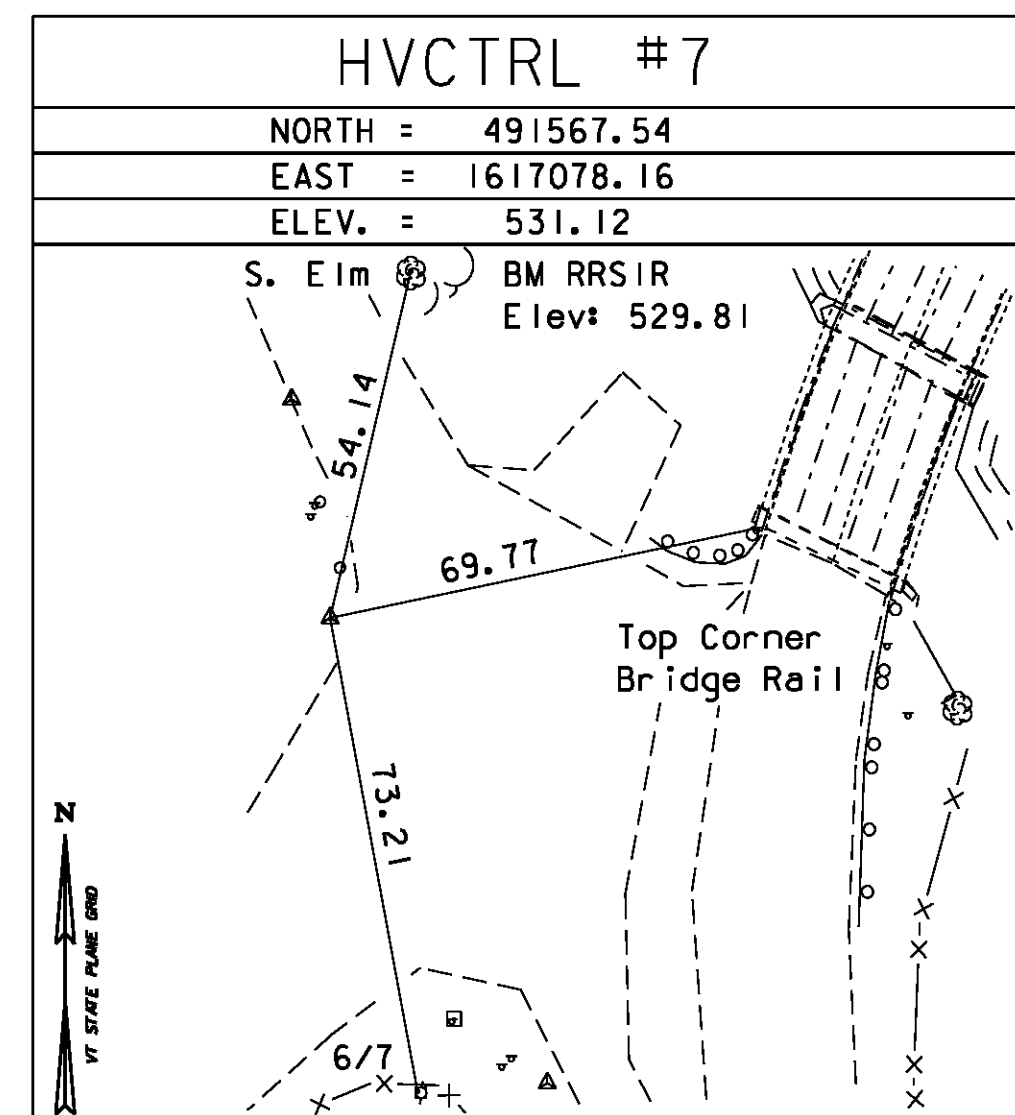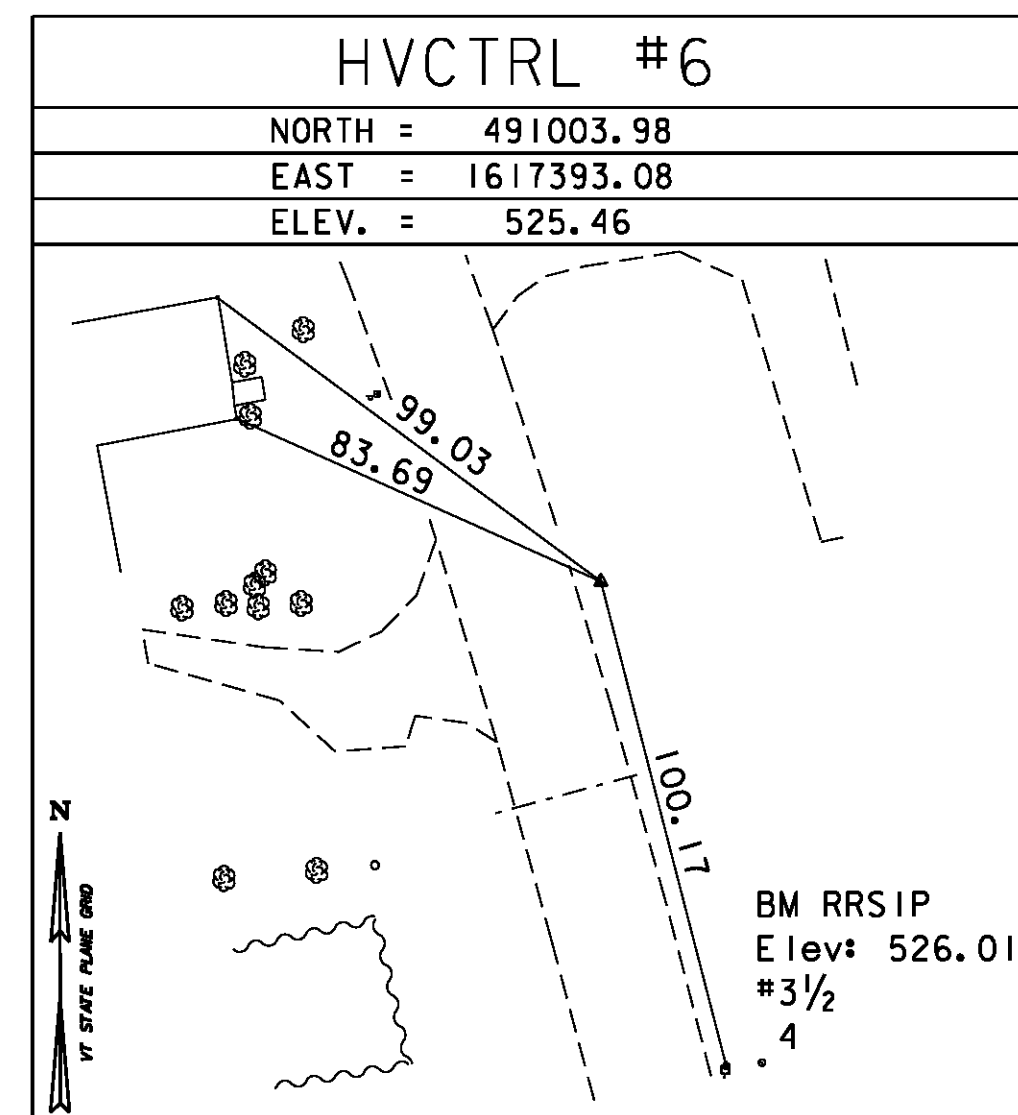
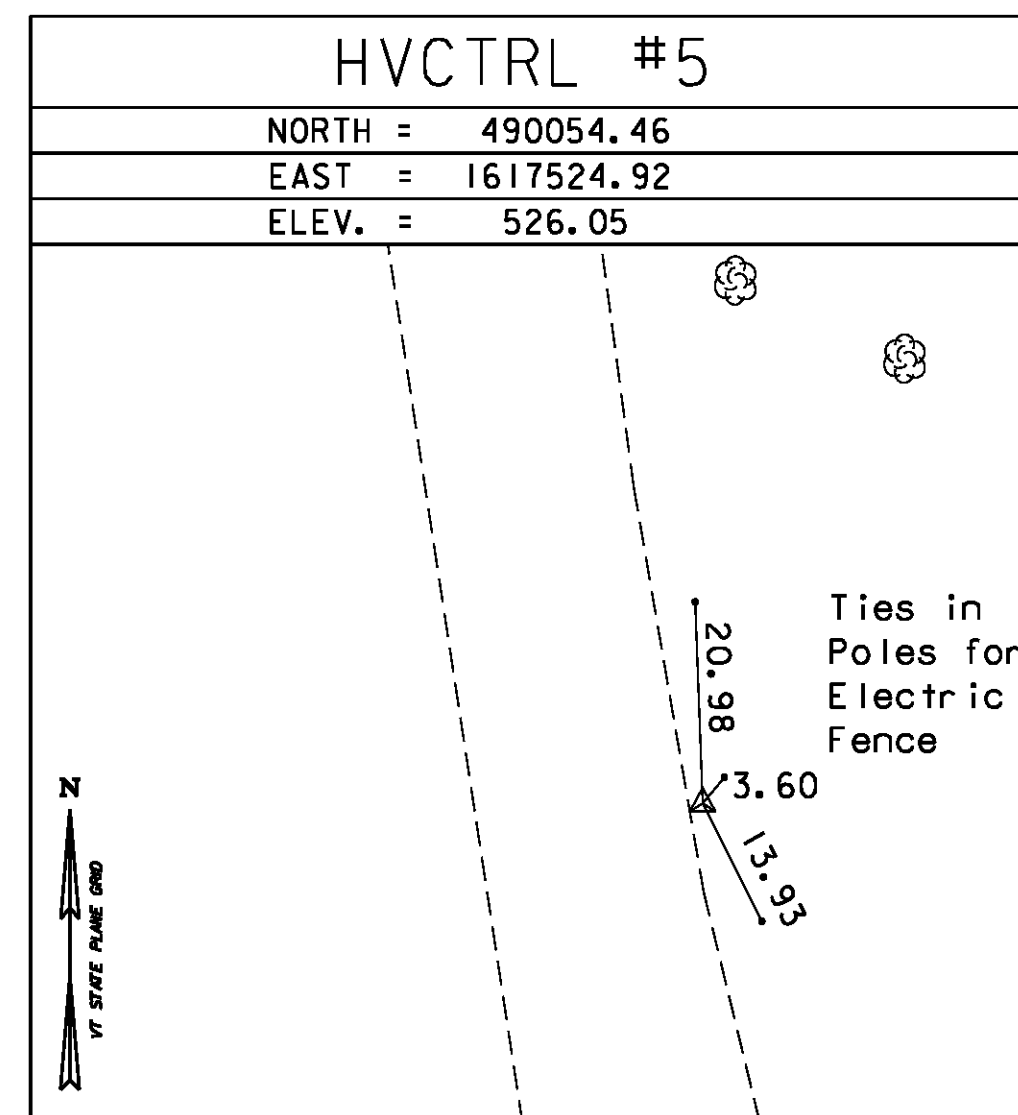
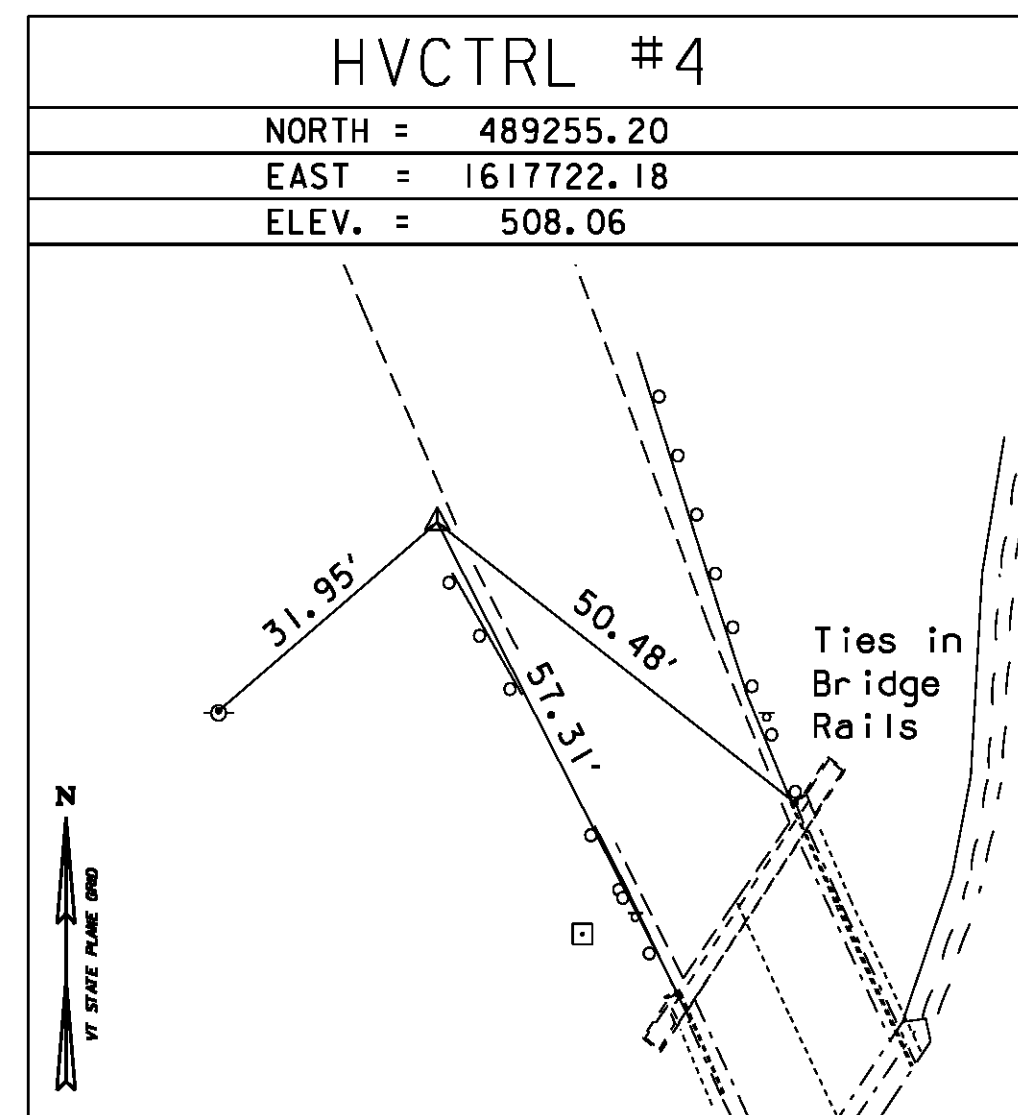
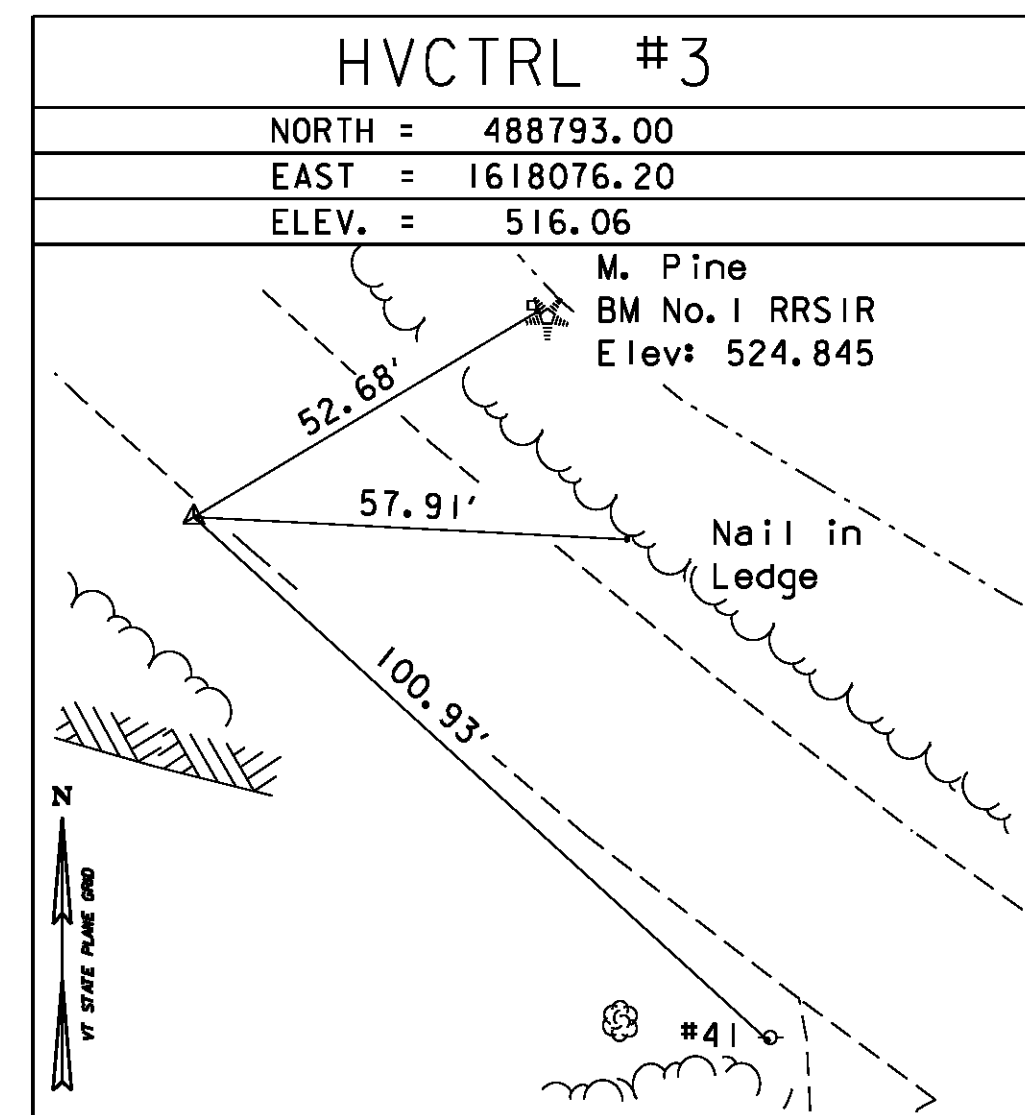


* MAIN TRAVERSE COMPLETED July 16,2001 Richard Gilman P.C. Paul Winters

TRAVERSE TIES

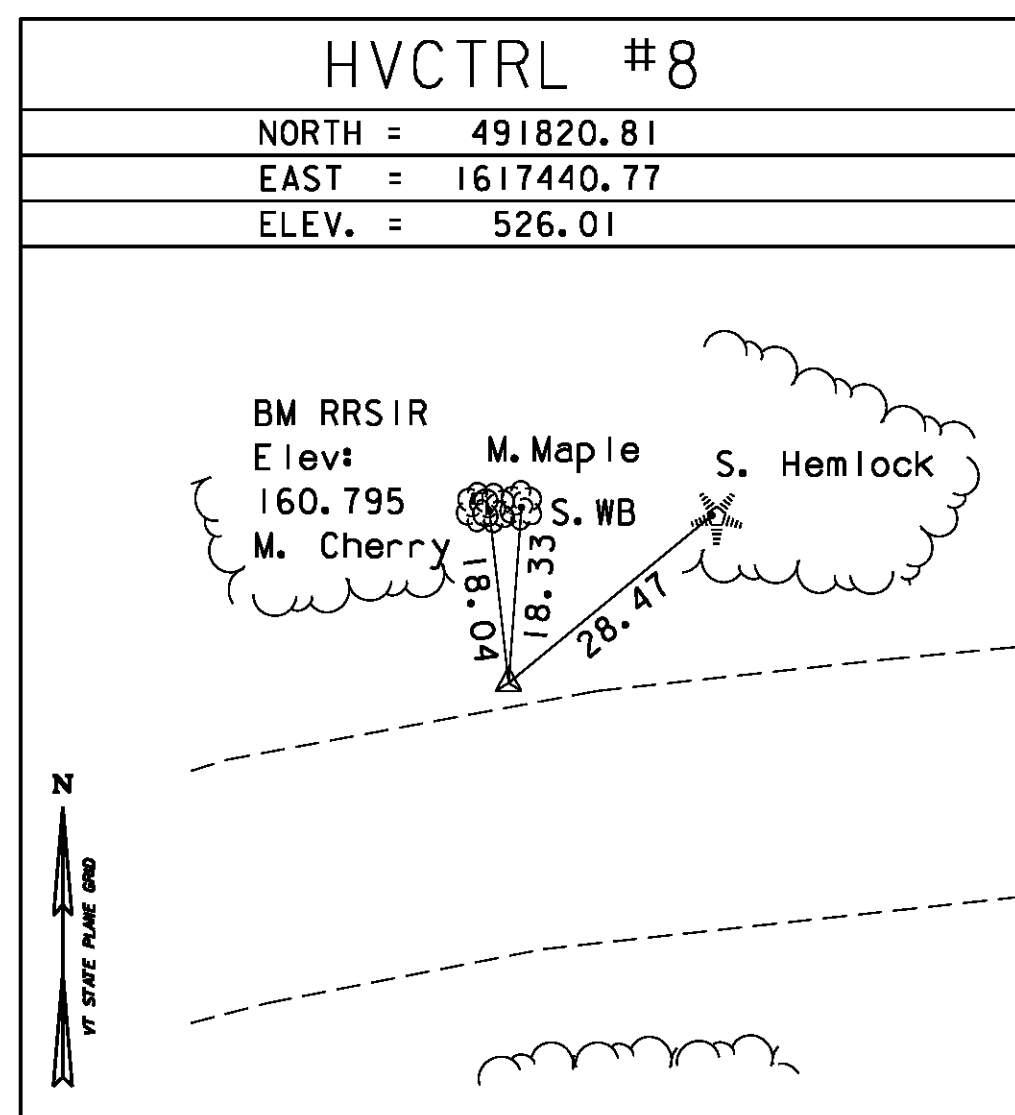

ALIGNMENT TIES

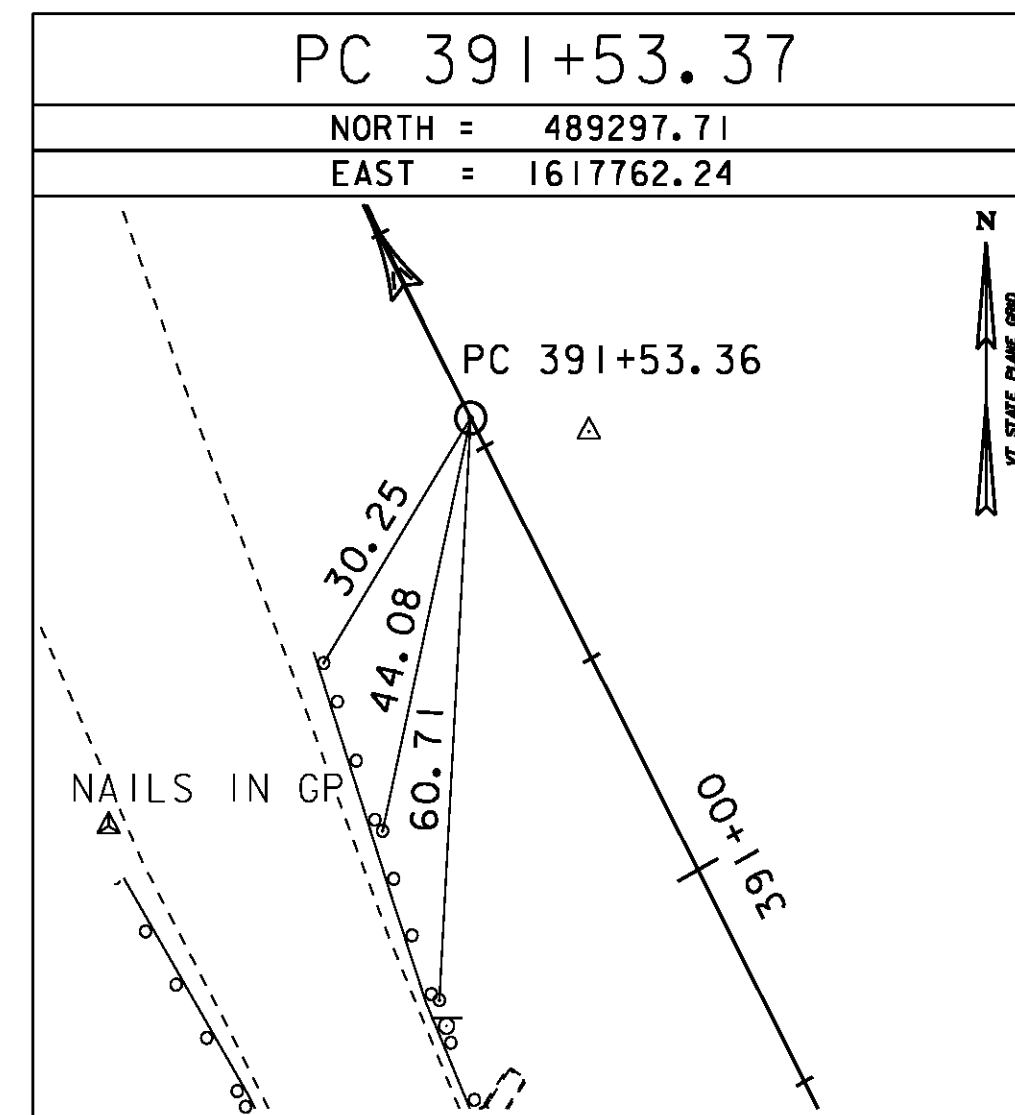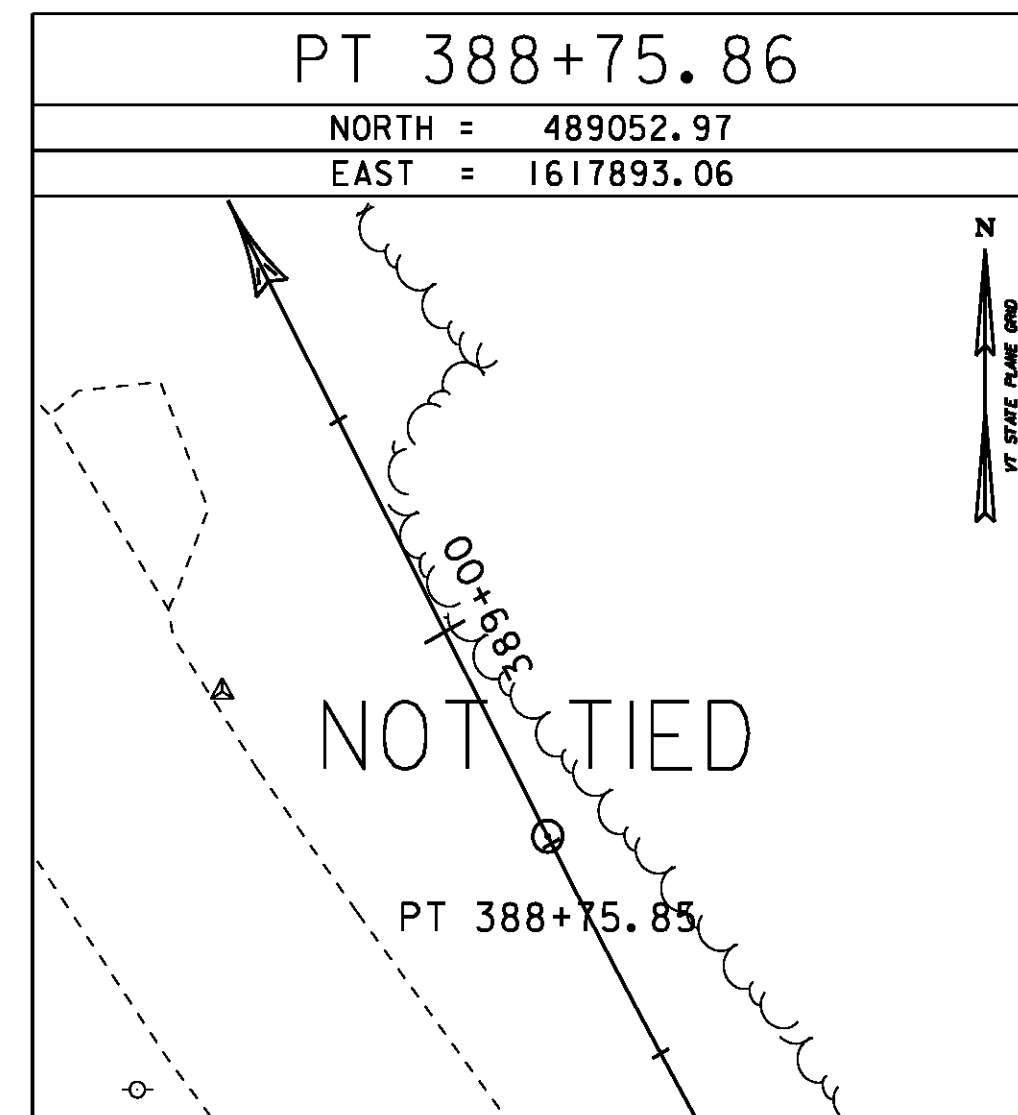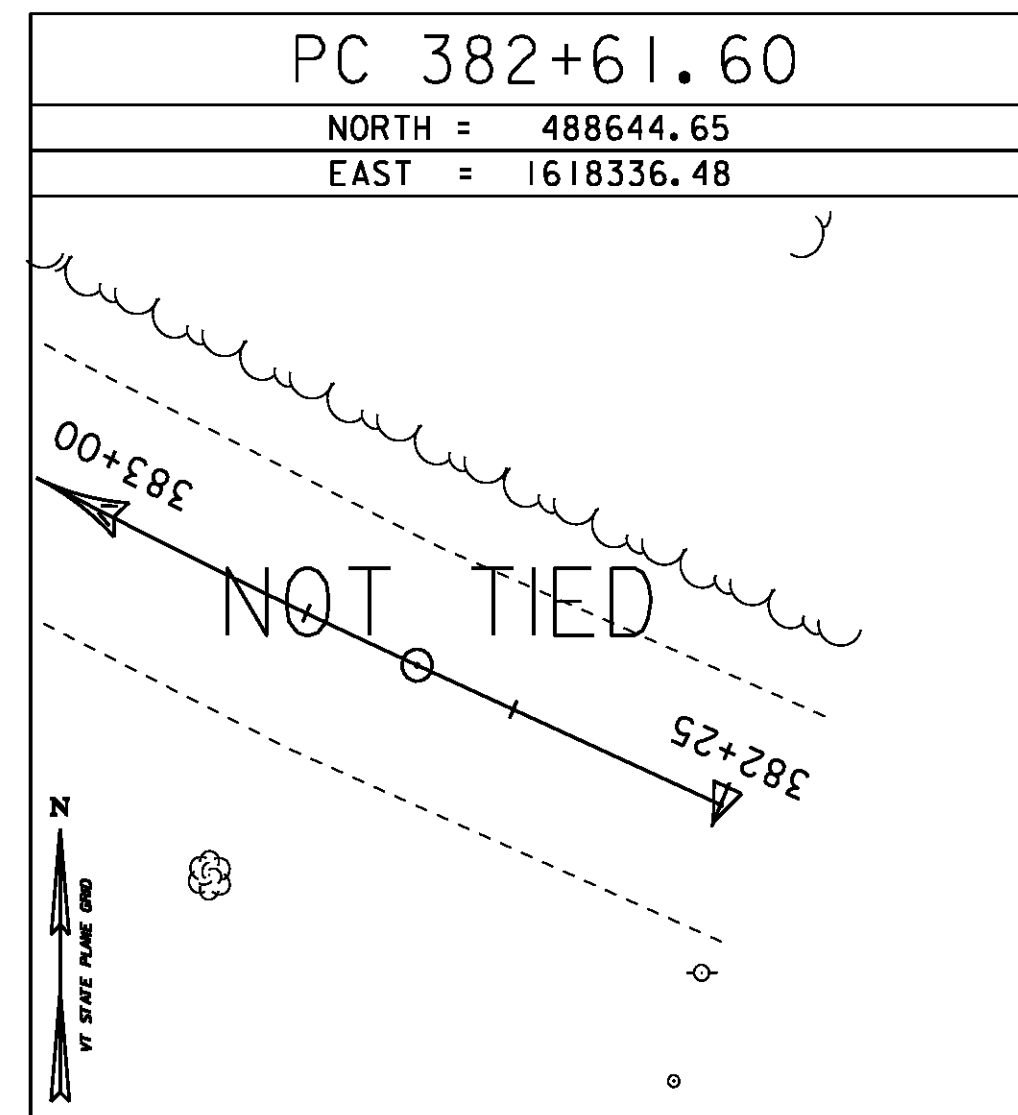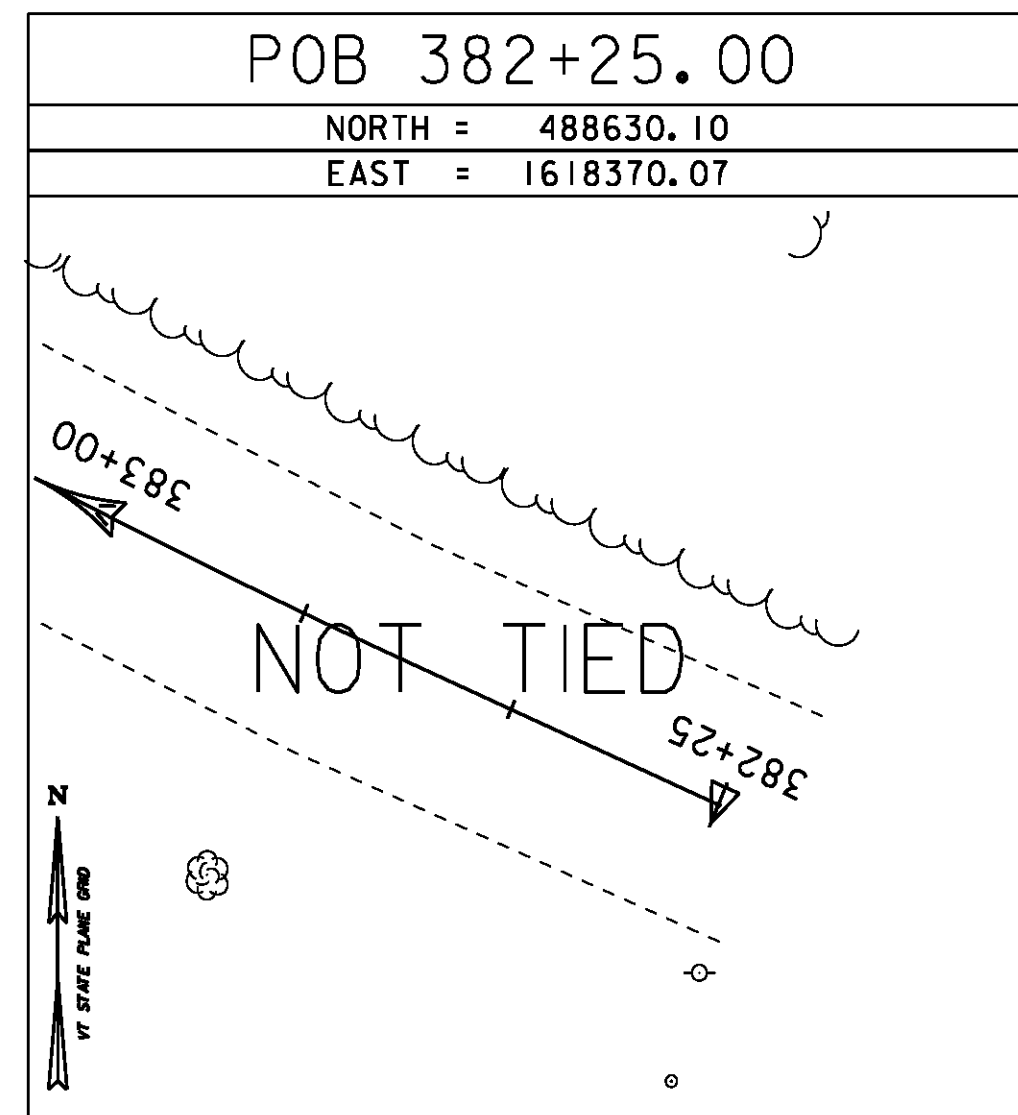






* Alignment Staked 06/05/06 by R.Gilman P.C. & P. Winters

DATUM	
VERTICAL	NAVD 88
HORIZONTAL	NAD 83 (96)
ADJUSTMENT	Compass

PROJECT NAME:	Royalton
PROJECT NUMBER:	BRS 0147 (13)
FILE NAME:	86e055\survey\86e055+1.dgn
PROJECT LEADER:	C. CARLSON
DESIGNED BY:	D. PETERSON
BRIDGE 27	TIE SHEET (1)
PLOT DATE:	08-OCT-2013
DRAWN BY:	R. Bullock
CHECKED BY:	C. CARLSON
	SHEET 16 OF 186




 ALIGNMENT TIES

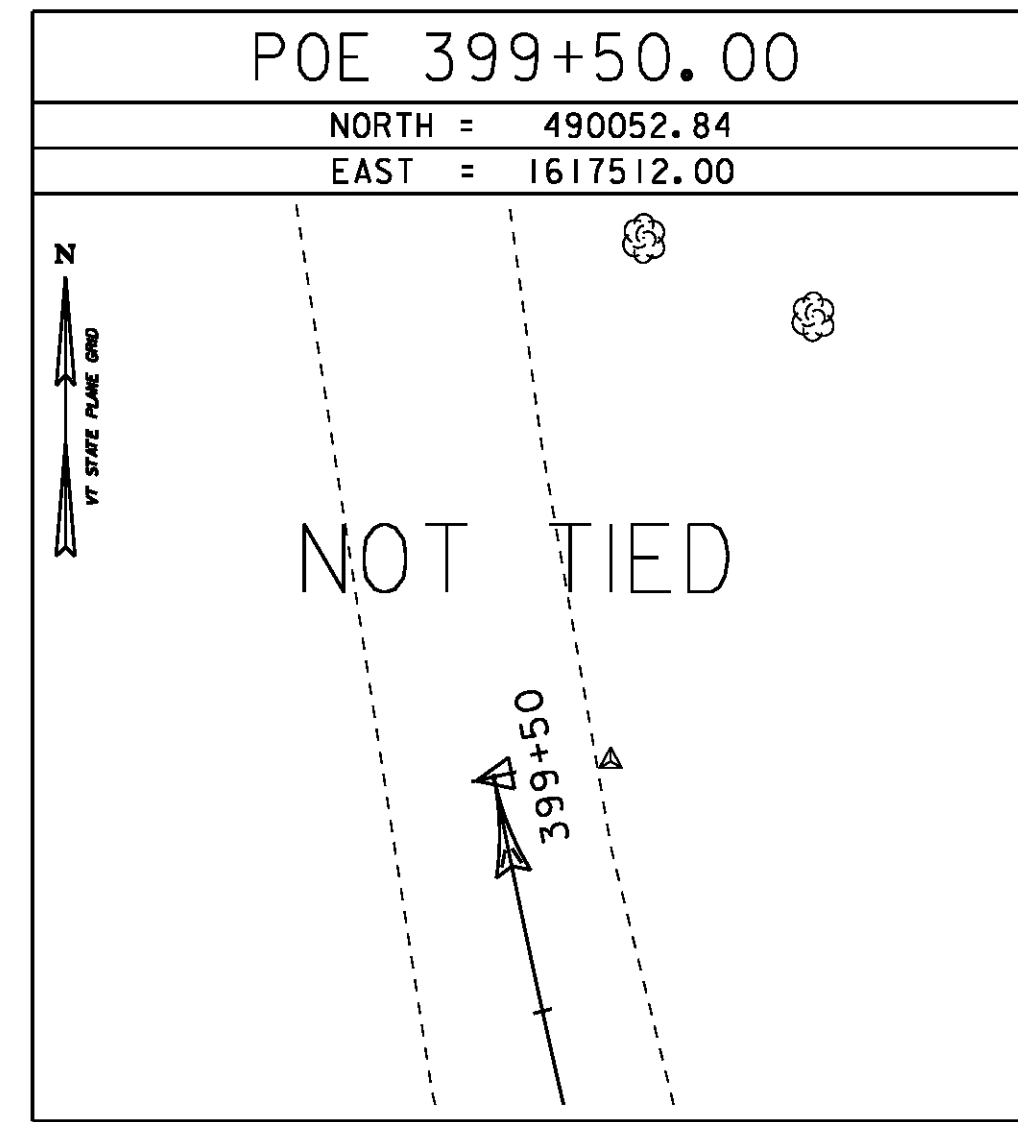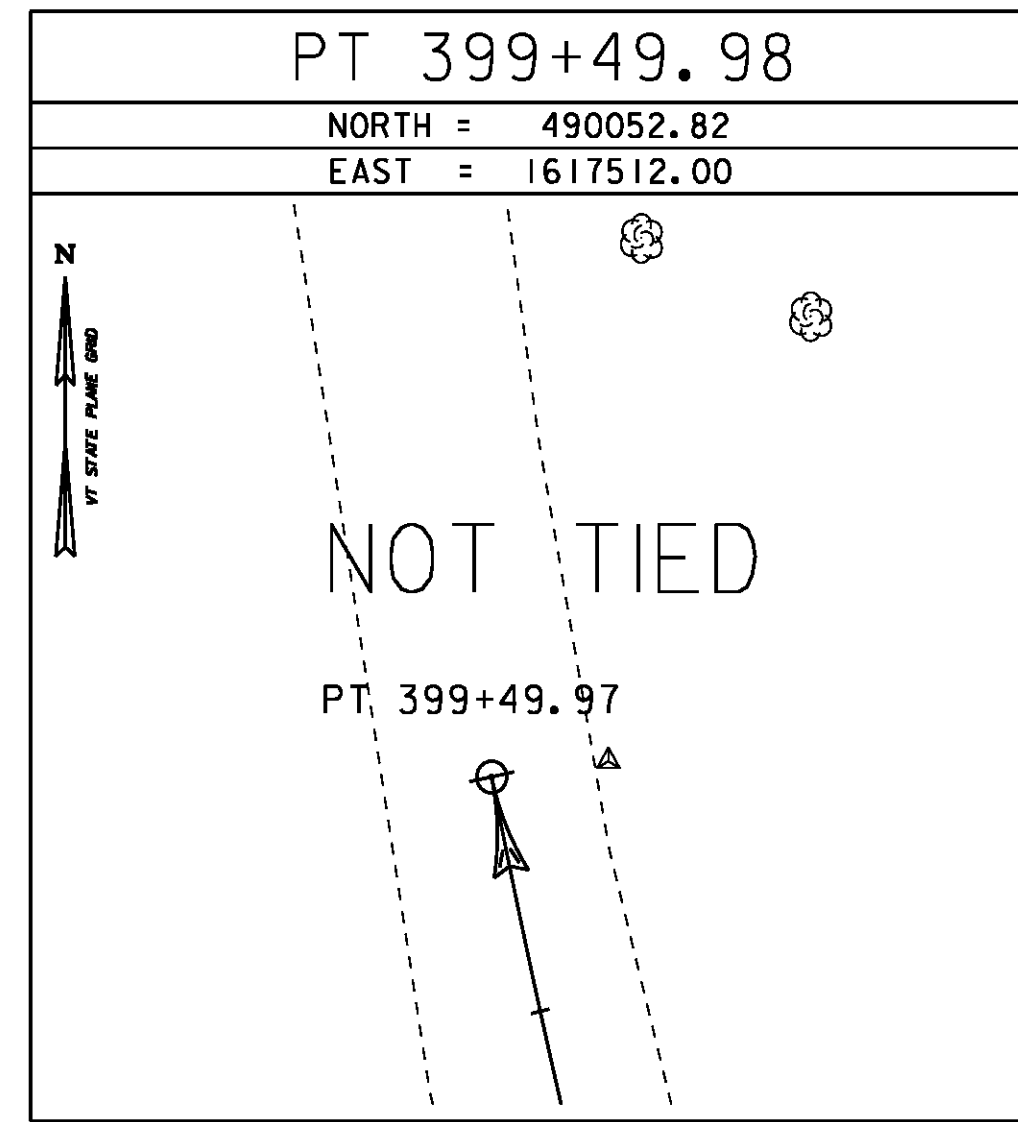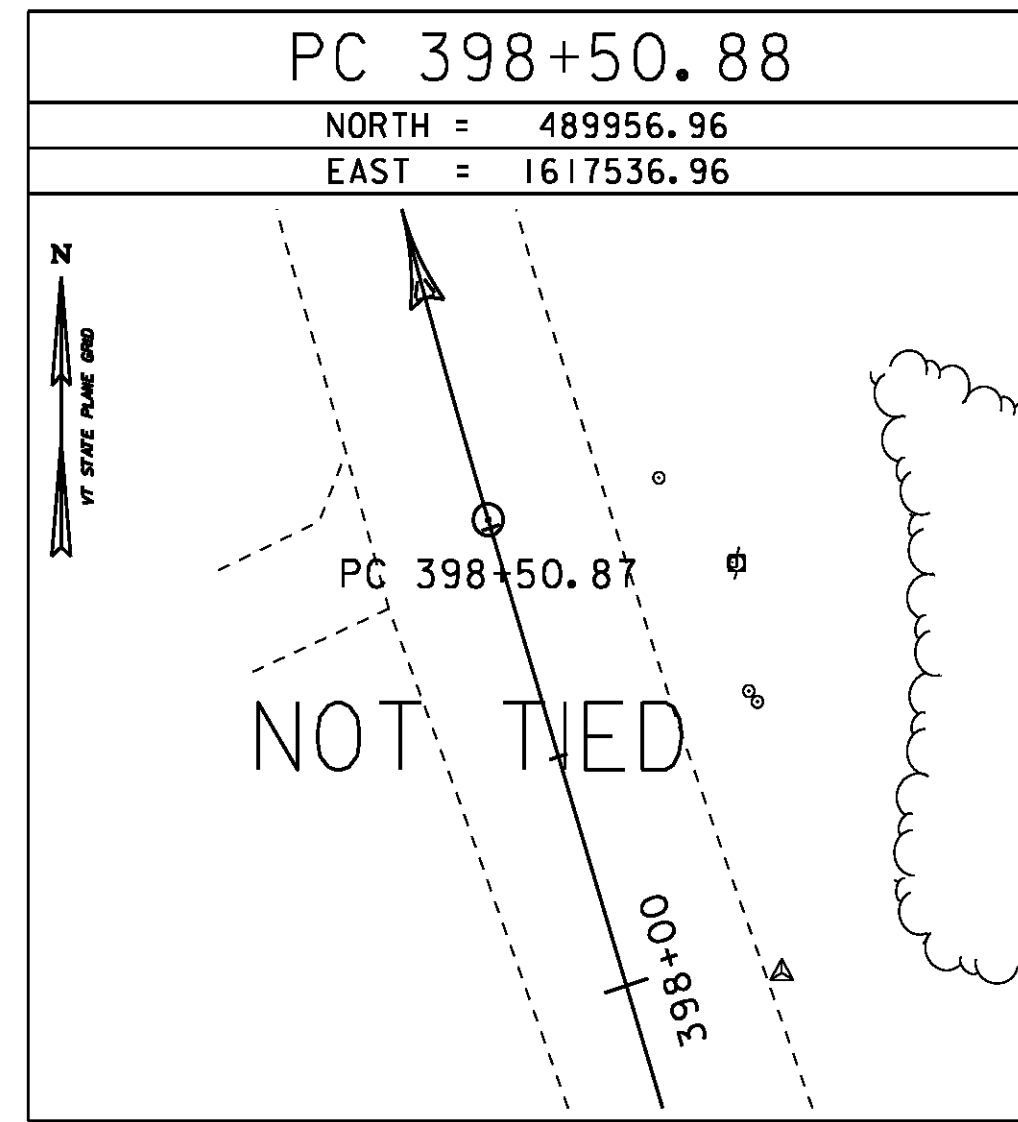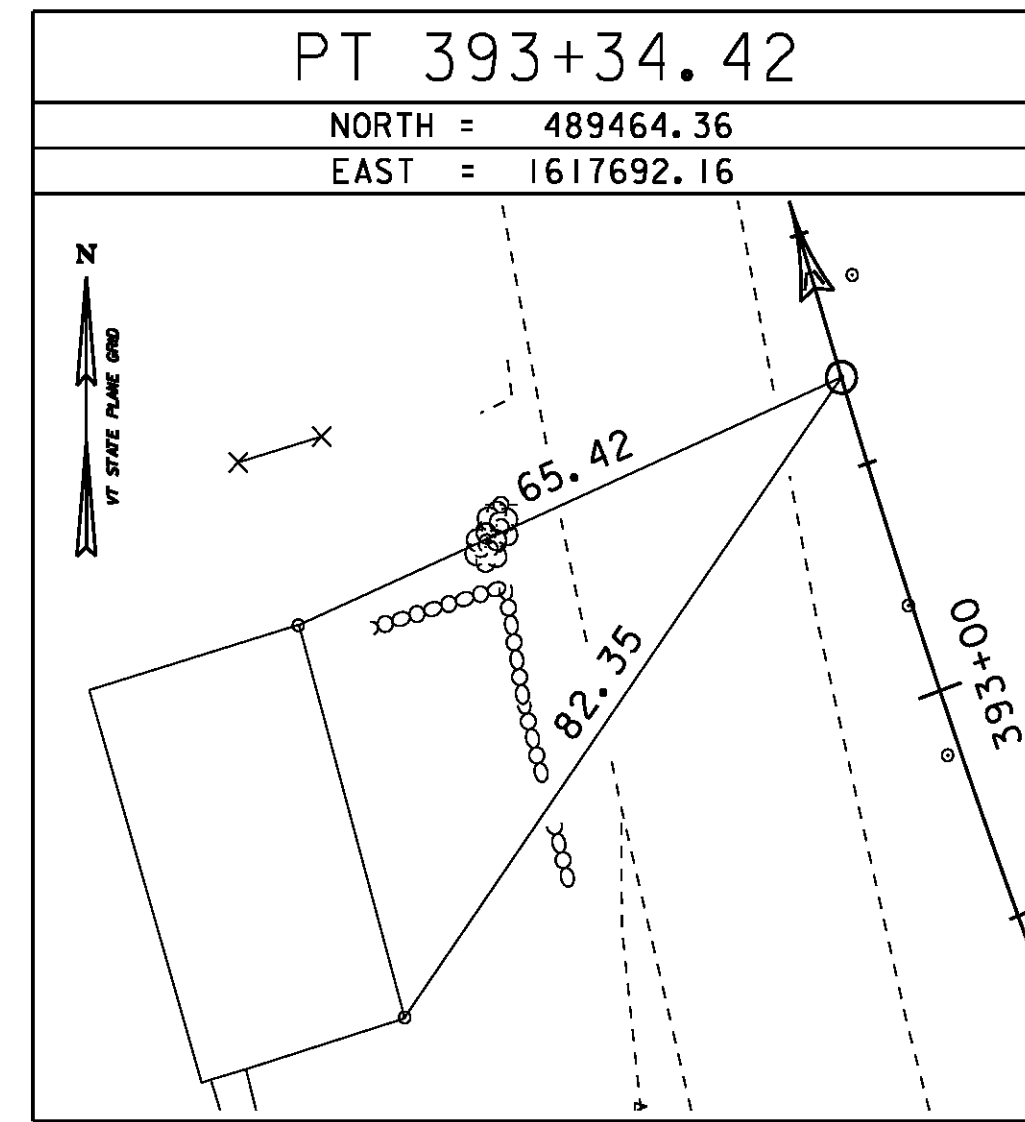

DATUM	
VERTICAL	NAVD 88
HORIZONTAL	NAD 83 (96)
ADJUSTMENT	Compass

PROJECT NAME:	Royalton
PROJECT NUMBER:	BRS 0147 (13)
FILE NAME:	86e055\survey\86e055+1.dgn
PLOT DATE:	08-OCT-2013
PROJECT LEADER:	C. CARLSON
DRAWN BY:	R. Bullock
DESIGNED BY:	D. PETERSON
CHECKED BY:	C. CARLSON
Bridge 27	TIE SHEET (2)
	SHEET 17 OF 186

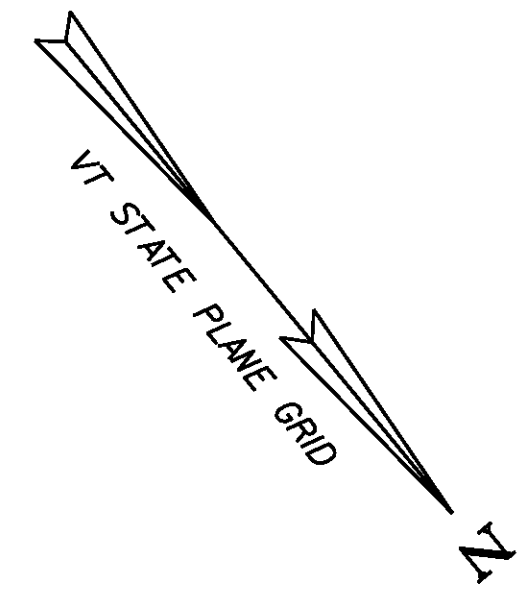

**DRIVE NO. 1 CURVE DATA**

Δ = 38°04'44" LT  
 D = 114°35'30"  
 R = 50.00'  
 T = 17.25'  
 L = 33.23'  
 E = 2.89'

**DRIVE NO. 1 PT**

STA 10+36.24  
 N = 488704.4220  
 E = 1618163.7429

**DRIVE NO. 1 POE**

STA 10+75.00  
 N = 488665.7003  
 E = 1618165.3611

**DRIVE NO. 1 PI**

STA 10+20.27 BK =  
 STA 10+18.99 AH  
 Δ = 38°04'44" LT  
 N = 488721.6618  
 E = 1618163.0224

**VT 14 PI NO. 1**

STA 385+76.39 BK =  
 STA 385+49.27 AH  
 Δ = 39°06'47" RT  
 N = 488764.9561  
 E = 1618047.0274

**DRIVE NO. 1 PC**

STA 10+03.01  
 N = 488735.6767  
 E = 1618173.0879

**VT 14 POB**

STA 382+23.00  
 N = 488628.2432  
 E = 1618372.8966

**VT 14 PC NO. 1**


STA 382+30.04  
 N = 488630.9657  
 E = 1618366.4072

**VT 14 STA 384+50.00 =**


DRIVE NO. 1 STA 10+00.00 POB  
 Δ = 90° LT FROM CURVE TANGENT  
 N = 488738.1251  
 E = 1618174.8463

**VT 14 CURVE NO. 1 DATA**


Δ = 39°06'47" RT  
 D = 5°52'35"  
 R = 975.00'  
 T = 346.35'  
 L = 665.58'  
 E = 59.69'

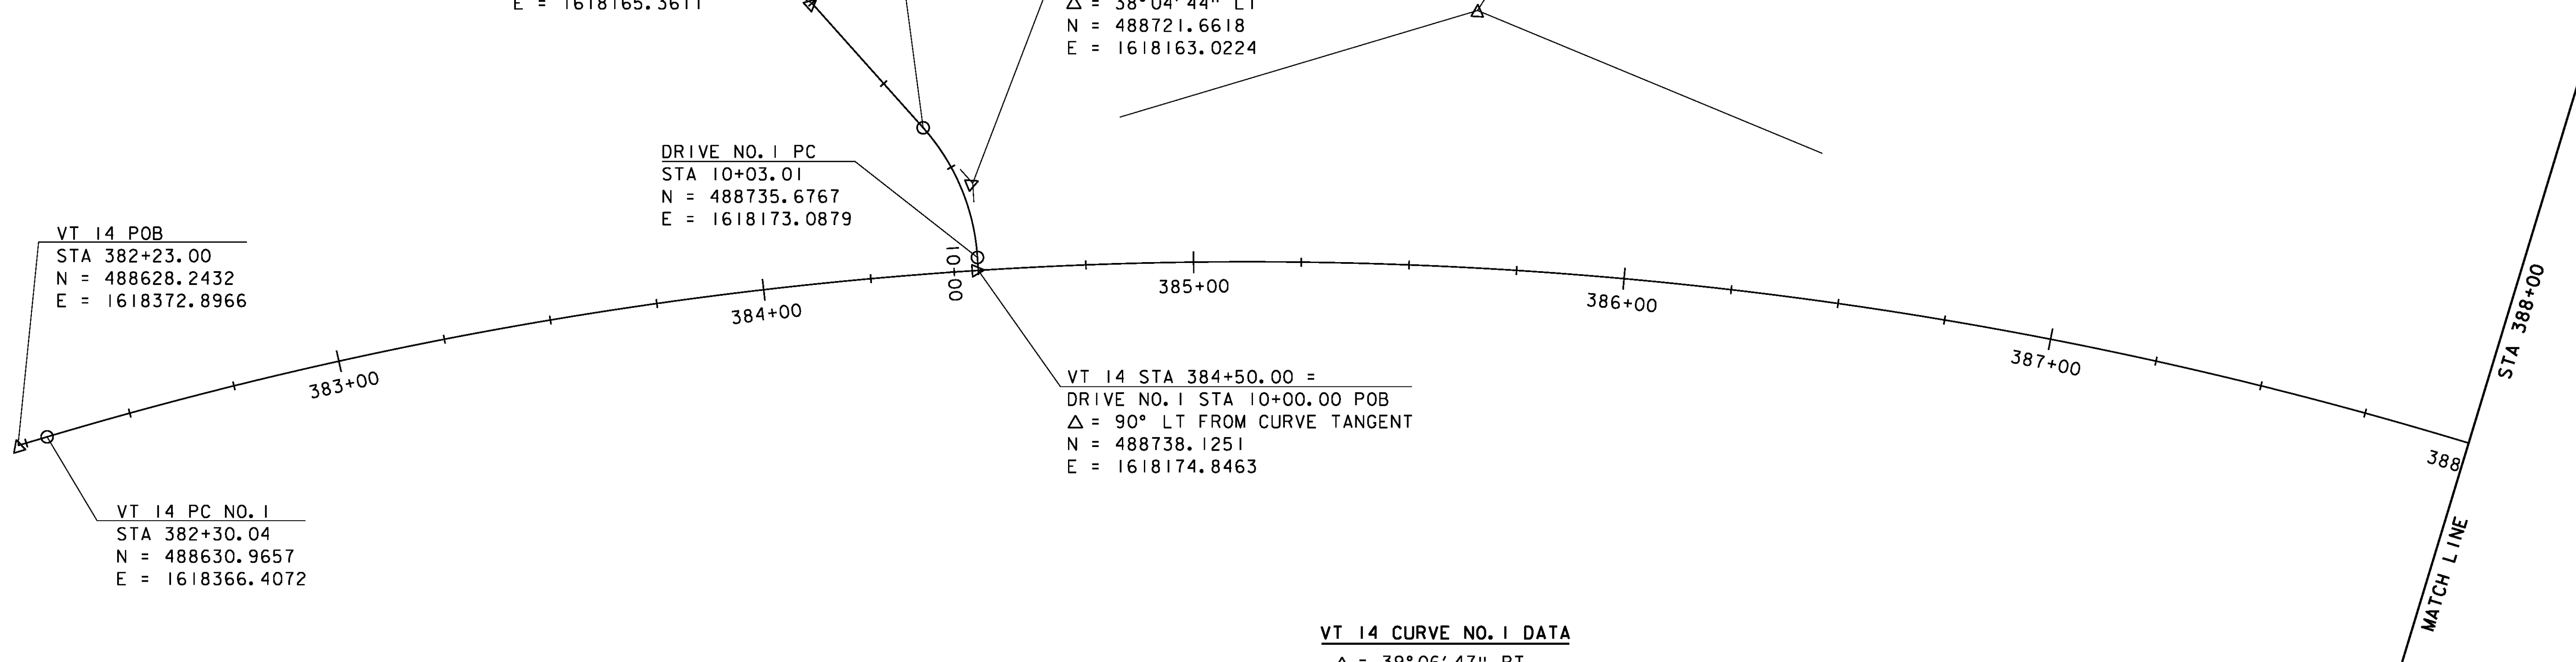

DATUM	
VERTICAL	NAVD 88
HORIZONTAL	NAD 83 (96)
ADJUSTMENT	Compass

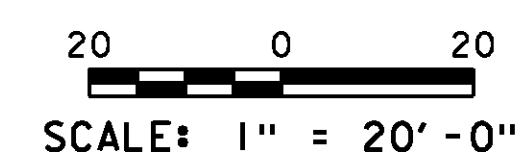

PROJECT NAME:	ROYALTON
PROJECT NUMBER:	BRS 0147(13)
FILE NAME:	\BR 27\s86e055alnbd_27.dgn
PROJECT LEADER:	C. CARLSON
DESIGNED BY:	D. PETERSON
BRIDGE 27 ALIGNMENT LAYOUT (1)	
PLOT DATE:	08-OCT-2013
DRAWN BY:	L. BULLOCK
CHECKED BY:	C. CARLSON
SHEET	18 OF 186

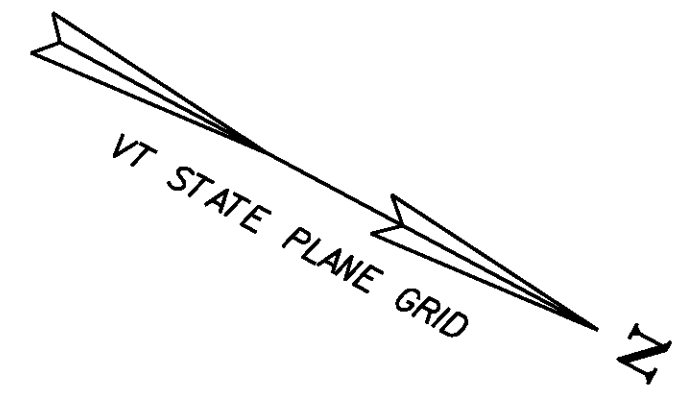

**DRIVE NO. 2 CURVE DATA NO. 1**

Δ = 97°57'59" RT  
 D = 190°59'09"  
 R = 30.00'  
 T = 34.49'  
 L = 51.30'  
 E = 15.71'

**CHANNEL LINE POE**

STA 51+25.00  
 N = 489047.3263  
 E = 1617762.8914

**DRIVE NO. 4 CURVE DATA**

Δ = 74°52'05" RT  
 D = 190°59'09"  
 R = 30.00'  
 T = 22.96'  
 L = 39.20'  
 E = 7.78'

**DRIVE NO. 4 POE**

STA 40+75.00  
 N = 489292.2799  
 E = 1617687.7131

**DRIVE NO. 3 POE**

STA 31+25.00  
 N = 489327.4629  
 E = 1617609.9639

**DRIVE NO. 2 PI NO. 1**

STA 20+50.25 BK =  
 STA 20+32.56 AH  
 Δ = 97°57'59" RT  
 N = 488982.5450  
 E = 1617876.7814

**DRIVE NO. 2 PT NO. 1**

STA 20+67.05  
 N = 489013.9771  
 E = 1617862.5820

**DRIVE NO. 2 PC NO. 1**

STA 20+15.76  
 N = 489000.9636  
 E = 1617905.9423

**DRIVE NO. 2 POE**

STA 21+25.00  
 N = 489066.7842  
 E = 1617838.7264

**DRIVE NO. 4 PI**

STA 40+50.10 BK =  
 STA 40+43.37 AH  
 Δ = 74°52'05" RT  
 N = 489310.1178  
 E = 1617713.8365

**DRIVE NO. 4 PT**

STA 40+66.33  
 N = 489297.1677  
 E = 1617694.8712

**DRIVE NO. 3 STA 30+32.60 =**

**DRIVE NO. 4 STA 40+00.00 POB**  
 Δ = 90°16'12" LT  
 N = 489357.4293  
 E = 1617697.3659

**VT 14 PI NO. 2**

STA 392+60.88 BK =  
 STA 392+60.01 AH  
 Δ = 12°35'05" RT  
 N = 489392.5190  
 E = 1617711.5550

**DRIVE NO. 4 PC**

STA 40+27.13  
 N = 489331.8061  
 E = 1617706.2862

**VT 14 PC NO. 2**

STA 391+53.37  
 N = 489297.7064  
 E = 1617762.2384

**VT 14 STA 392+31.49 =**


**DRIVE NO. 3 STA 30+00.00 POB**  
 Δ = 85°23'17" LT FROM CURVE TANGENT  
 N = 489368.0034  
 E = 1617728.2072

**VT 14 CURVE NO. 2 DATA**

Δ = 12°35'05" RT  
 D = 5°52'35"  
 R = 975.00'  
 T = 107.51'  
 L = 214.15'  
 E = 5.91'

**CHANNEL LINE POB**



STA 48+75.00  
 N = 489233.4838  
 E = 1617929.7607

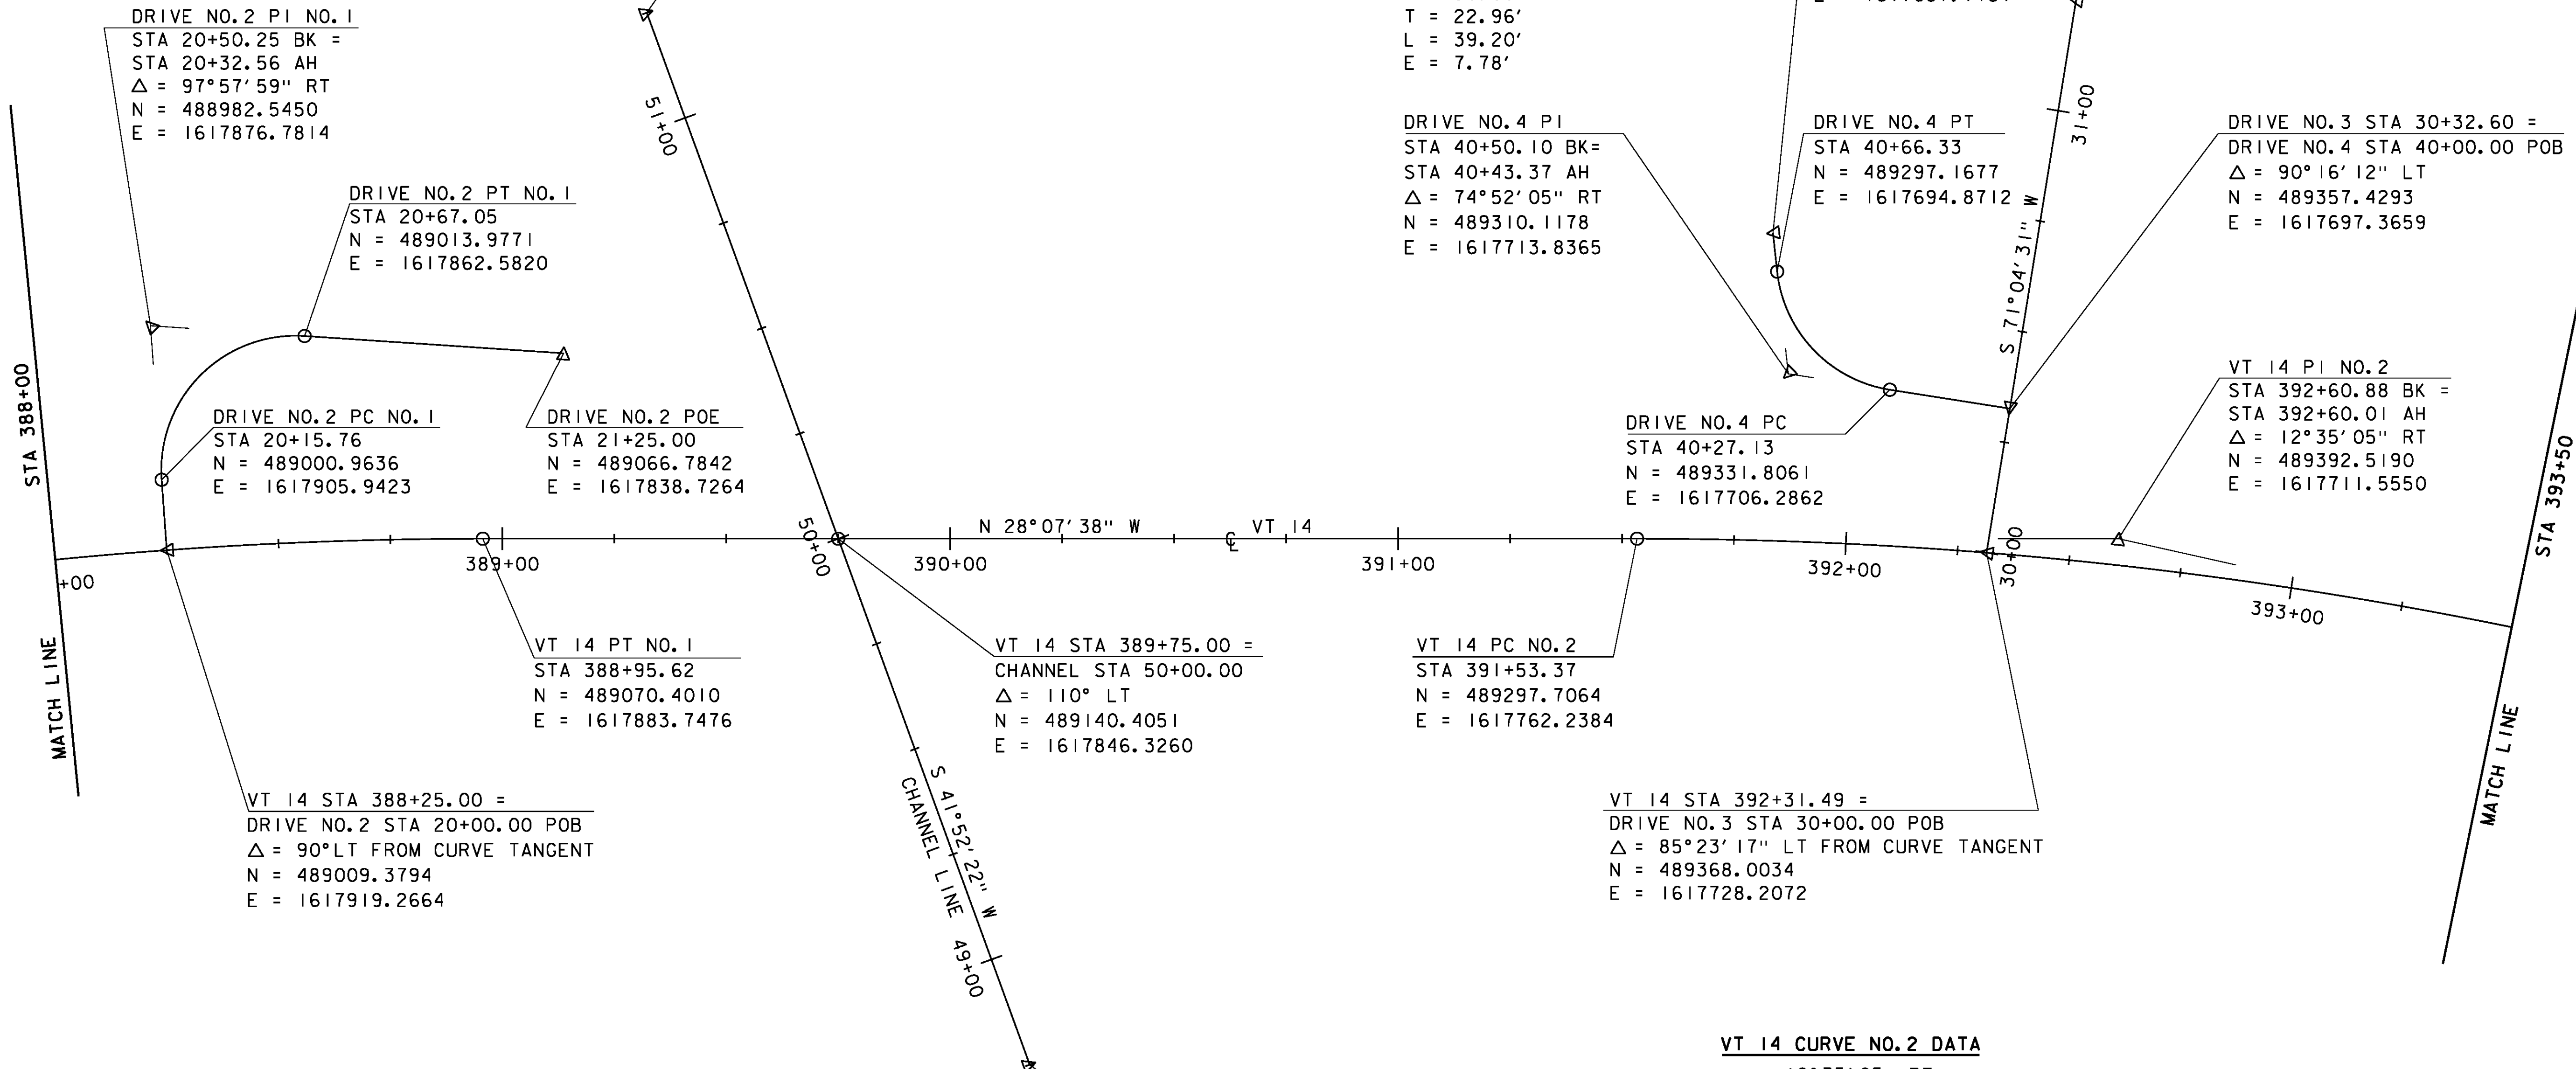

DATUM	
VERTICAL	NAVD 88
HORIZONTAL	NAD 83 (96)
ADJUSTMENT	Compass




PROJECT NAME:	ROYALTON
PROJECT NUMBER:	BRS 0147(13)
FILE NAME:	\BR 27\s86e055alnldr_27.dgn
PROJECT LEADER:	C. CARLSON
DESIGNED BY:	D. PETERSON
BRIDGE 27 ALIGNMENT LAYOUT (2)	
PLOT DATE:	08-OCT-2013
DRAWN BY:	L. BULLOCK
CHECKED BY:	C. CARLSON
SHEET	19 OF 186

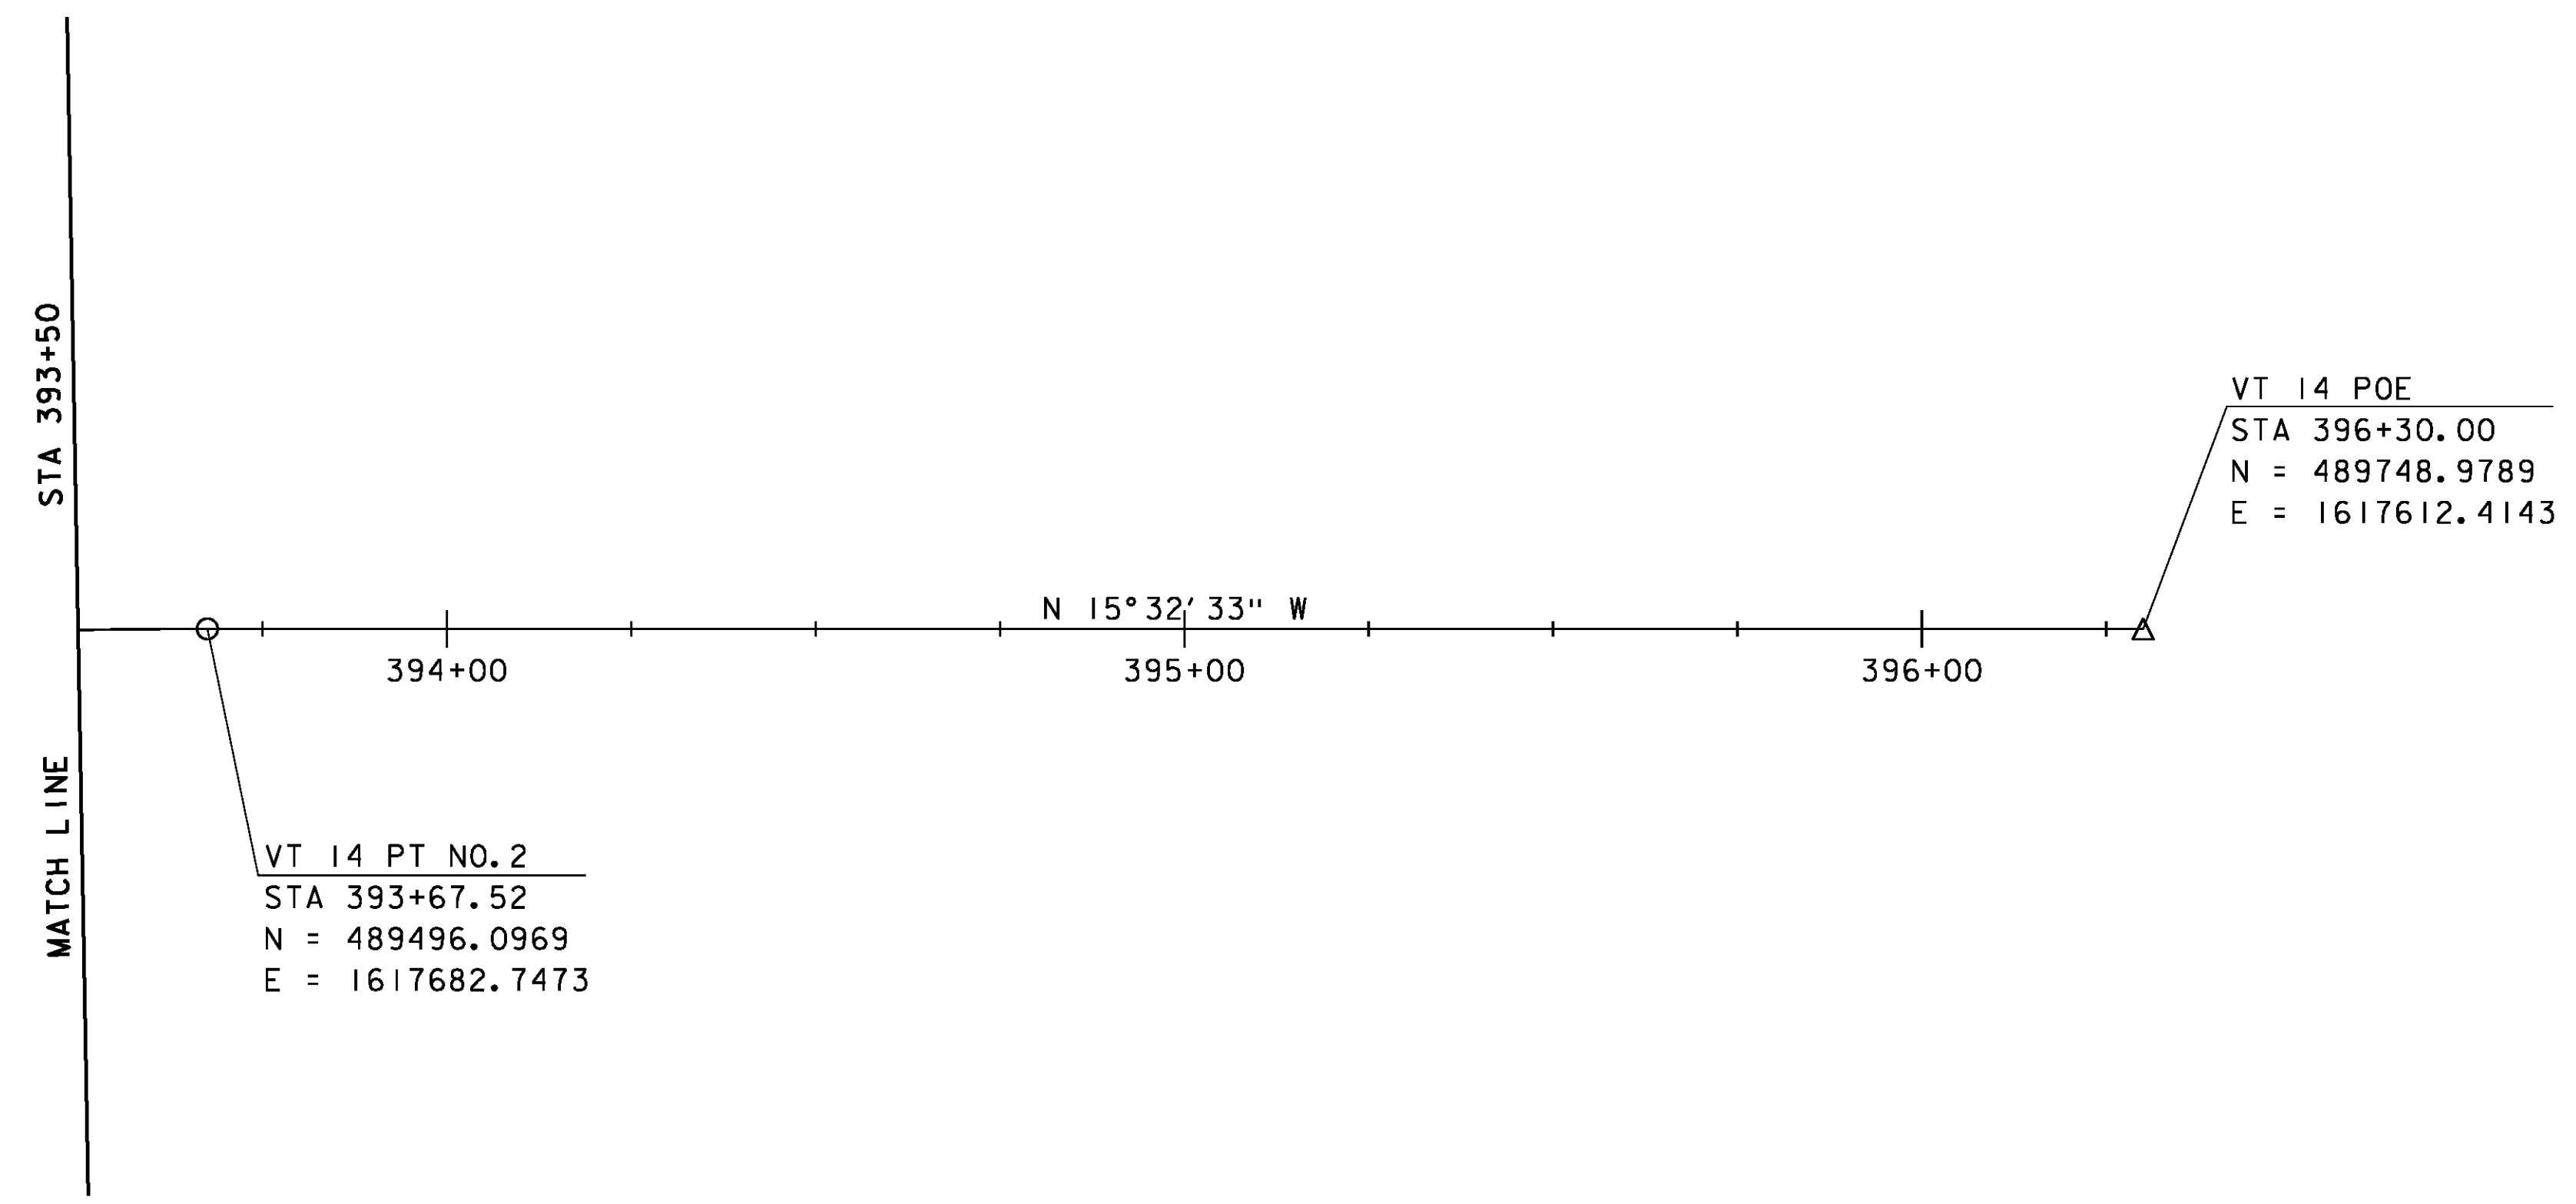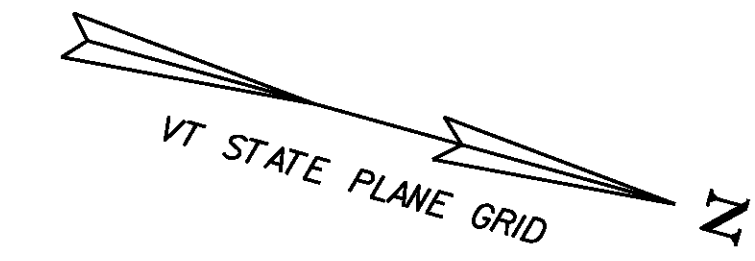

VT 14 PT NO. 2  
STA 393+67.52  
N = 489496.0969  
E = 1617682.7473

VT 14 POE  
STA 396+30.00  
N = 489748.9789  
E = 1617612.4143

DATUM	
VERTICAL	NAVD 88
HORIZONTAL	NAD 83 (96)
ADJUSTMENT	Compass

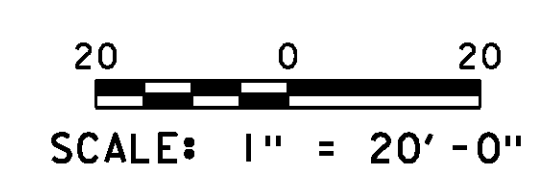

PROJECT NAME:	ROYALTON
PROJECT NUMBER:	BRS 0147(13)
FILE NAME:	\\BR 27\s86e055alnbdm_27.dgn
PROJECT LEADER:	C. CARLSON
DESIGNED BY:	D. PETERSON
BRIDGE 27 ALIGNMENT LAYOUT (3)	
PLOT DATE:	08-OCT-2013
DRAWN BY:	L. BULLOCK
CHECKED BY:	C. CARLSON
SHEET	20 OF 186

- ① VT 14 STA 382+75.0 RT - VT 14 STA 386+25.0 RT  
CONSTRUCT NEW GRASS-LINED DITCH
- ② VT 14 STA 383+91.3 RT - VT 14 STA 385+83.2 RT  
CONSTRUCT NEW DITCH LINED WITH STONE FILL, TYPE I

**CONSTRUCT 5' WIDE PAVED APRON**  
VT 14 STA 384+28.7 LT - VT 14 STA 384+67.8 LT

**CONSTRUCT GRAVEL DRIVE (10' WIDE)**  
VT 14 STA 384+50.0 LT

**CONSTRUCT SLOPE W/ STONE FILL, TYPE II**  
VT 14 STA 382+80.9 RT - VT 14 STA 386+15.0 RT



**SPECIAL PROVISION (REINFORCED SOIL SLOPE) W/ STONE FILL, TYPE II**  
VT 14 STA 386+25.0 RT - VT 14 STA 388+00.0 RT

**BOX BEAM GUARDRAIL**

VT 14 STA 384+87.1 LT - VT 14 STA 387+88.8 LT  
VT 14 STA 386+11.7 RT - VT 14 STA 388+00.0 RT

**MANUFACTURED TERMINAL SECTION, TANGENT**

VT 14 STA 384+73.3 LT - VT 14 STA 384+87.1 LT  
VT 14 STA 385+97.5 RT - VT 14 STA 386+11.7 RT  
VT 14 STA 387+88.8 LT - VT 14 STA 388+00.0 LT

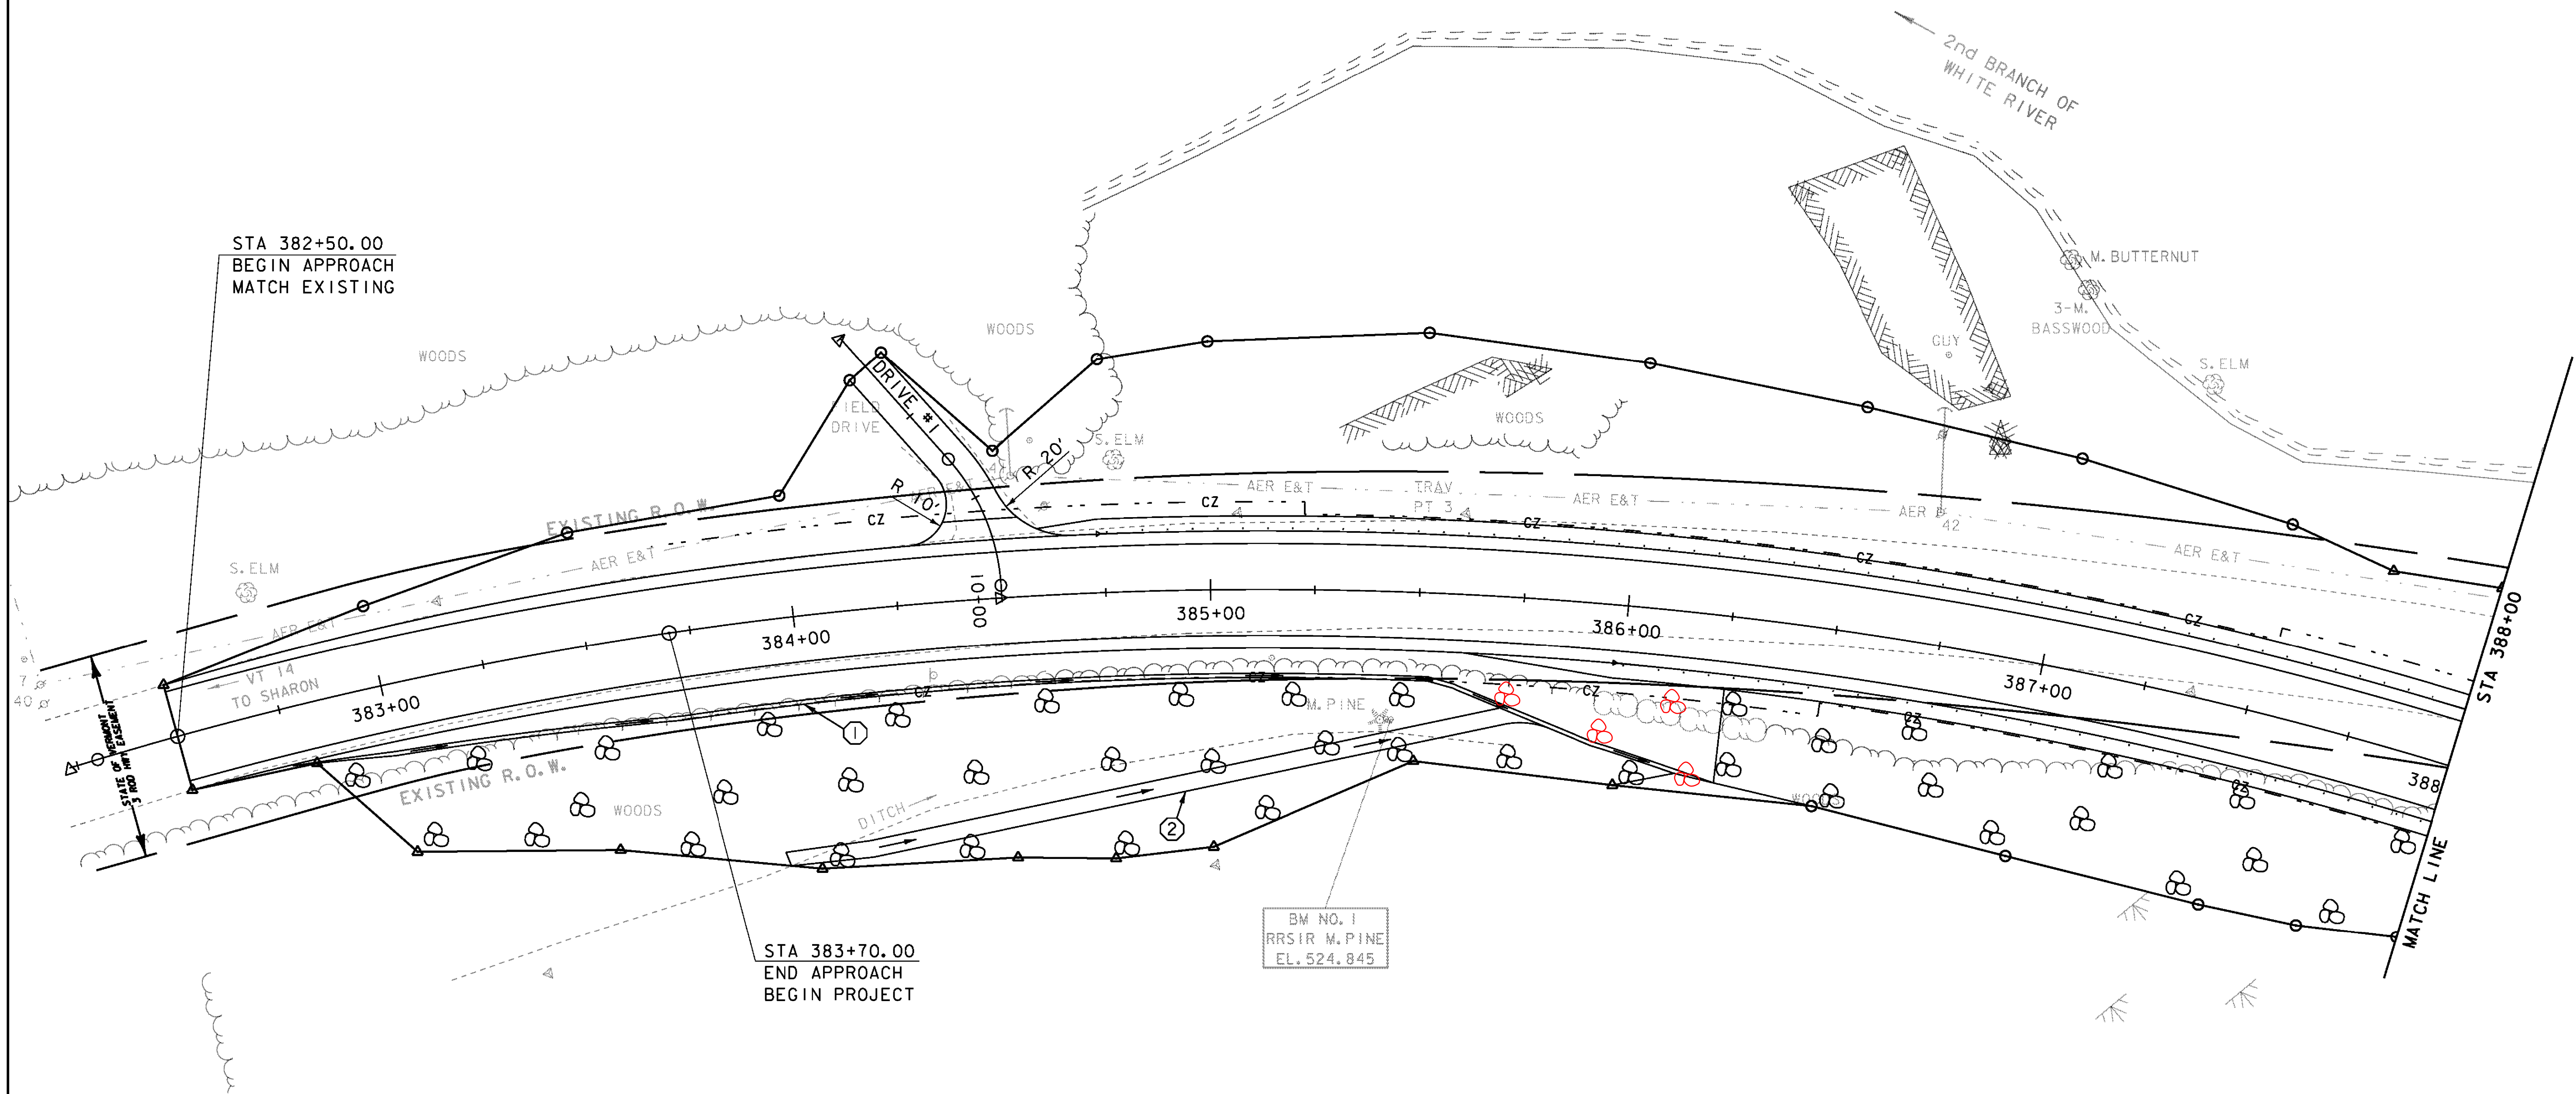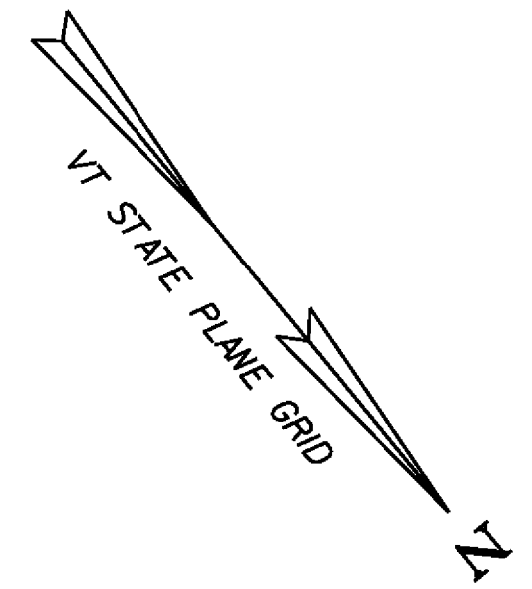

STA 382+50.00  
BEGIN APPROACH  
MATCH EXISTING

STA 383+70.00  
END APPROACH  
BEGIN PROJECT

BM NO. 1  
RRSIR M. PINE  
EL. 524.845

20 0 20  
SCALE: 1" = 20'-0"

PROJECT NAME: ROYALTON	PLOT DATE: 08-OCT-2013
PROJECT NUMBER: BRS 0147(13)	DRAWN BY: L. BULLOCK
FILE NAME: \BR 27\s86e055bdr_27.dgn	CHECKED BY: C. CARLSON
PROJECT LEADER: C. CARLSON	SHEET 21 OF 186
DESIGNED BY: D. PETERSON	
BRIDGE 27 LAYOUT (1)	

**CONSTRUCT 5' WIDE PAVED APRON**

VT 14 STA 388+02.2 LT - VT 14 STA 388+43.1 LT

**CONSTRUCT GRAVEL DRIVE (12' WIDE)**

VT 14 STA 388+25.0 LT  
DRIVE NO.3 STA 30+32.6 LT

**CONSTRUCT PAVED DRIVE (10' WIDE)**

VT 14 STA 392+31.5 LT

**SPECIAL PROVISION (REINFORCED SOIL SLOPE) W/ STONE FILL, TYPE III**

VT 14 STA 388+00.0 RT - VT 14 STA 388+50.0 RT

**RELOCATE MAILBOX, SINGLE SUPPORT**

FROM DRIVE NO.3 STA 30+50.5 RT TO VT 14 STA 392+50.0 LT.

**REMOVING AND RESETING FENCE**

VT 14 STA 390+78.7 LT - VT 14 STA 392+04.7 LT  
VT 14 STA 390+89.7 LT - VT 14 STA 393+50.0 RT  
VT 14 STA 391+48.7 RT - VT 14 STA 393+50.0 RT  
VT 14 STA 393+44.9 LT - VT 14 STA 393+50.0 LT

**BOX BEAM GUARDRAIL**

VT 14 STA 388+00.0 RT - VT 14 STA 389+66.8 RT  
VT 14 STA 388+57.9 LT - VT 14 STA 389+56.3 LT  
VT 14 STA 391+63.1 LT - VT 14 STA 391+89.7 LT  
VT 14 STA 391+73.7 RT - VT 14 STA 392+74.1 RT

**MANUFACTURED TERMINAL SECTION, TANGENT**

VT 14 STA 388+00.0 LT - VT 14 STA 388+02.6 LT  
VT 14 STA 388+44.0 LT - VT 14 STA 388+57.9 LT  
VT 14 STA 391+89.7 LT - VT 14 STA 392+03.5 LT  
VT 14 STA 391+74.1 RT - VT 14 STA 392+88.3 RT

**REMOVAL AND DISPOSAL OF GUARDRAIL**

VT 14 STA 389+34.8 LT - VT 14 STA 389+72.9 LT  
VT 14 STA 389+46.6 LT - VT 14 STA 389+83.8 LT  
VT 14 STA 390+78.7 LT - VT 14 STA 391+29.2 LT  
VT 14 STA 390+89.7 LT - VT 14 STA 391+40.1 LT

**REMOVAL AND DISPOSAL OF GUIDE POSTS**

DRIVE NO.3 STA 30+58.3 LT  
DRIVE NO.3 STA 30+58.5 RT  
VT 14 392+93.4 LT  
VT 14 393+09.5 LT  
VT 14 393+44.3 RT


**SPECIAL PROVISION (GUARDRAIL APPROACH SECTION TO CONCRETE COMBINATION BRIDGE RAILING)**

VT 14 STA 389+56.3 LT - VT 14 STA 389+90.3 LT  
VT 14 STA 389+66.8 RT - VT 14 STA 390+00.8 RT  
VT 14 STA 391+29.2 LT - VT 14 STA 391+63.1 LT  
VT 14 STA 391+39.7 RT - VT 14 STA 391+73.7 RT


**BRIDGE RAILING, GALVANIZED STEEL**

**TUBING/CONCRETE COMBINATION**

VT 14 STA 389+90.3 LT - VT 14 STA 391+29.2 LT  
VT 14 STA 390+00.8 RT - VT 14 STA 391+39.7 RT

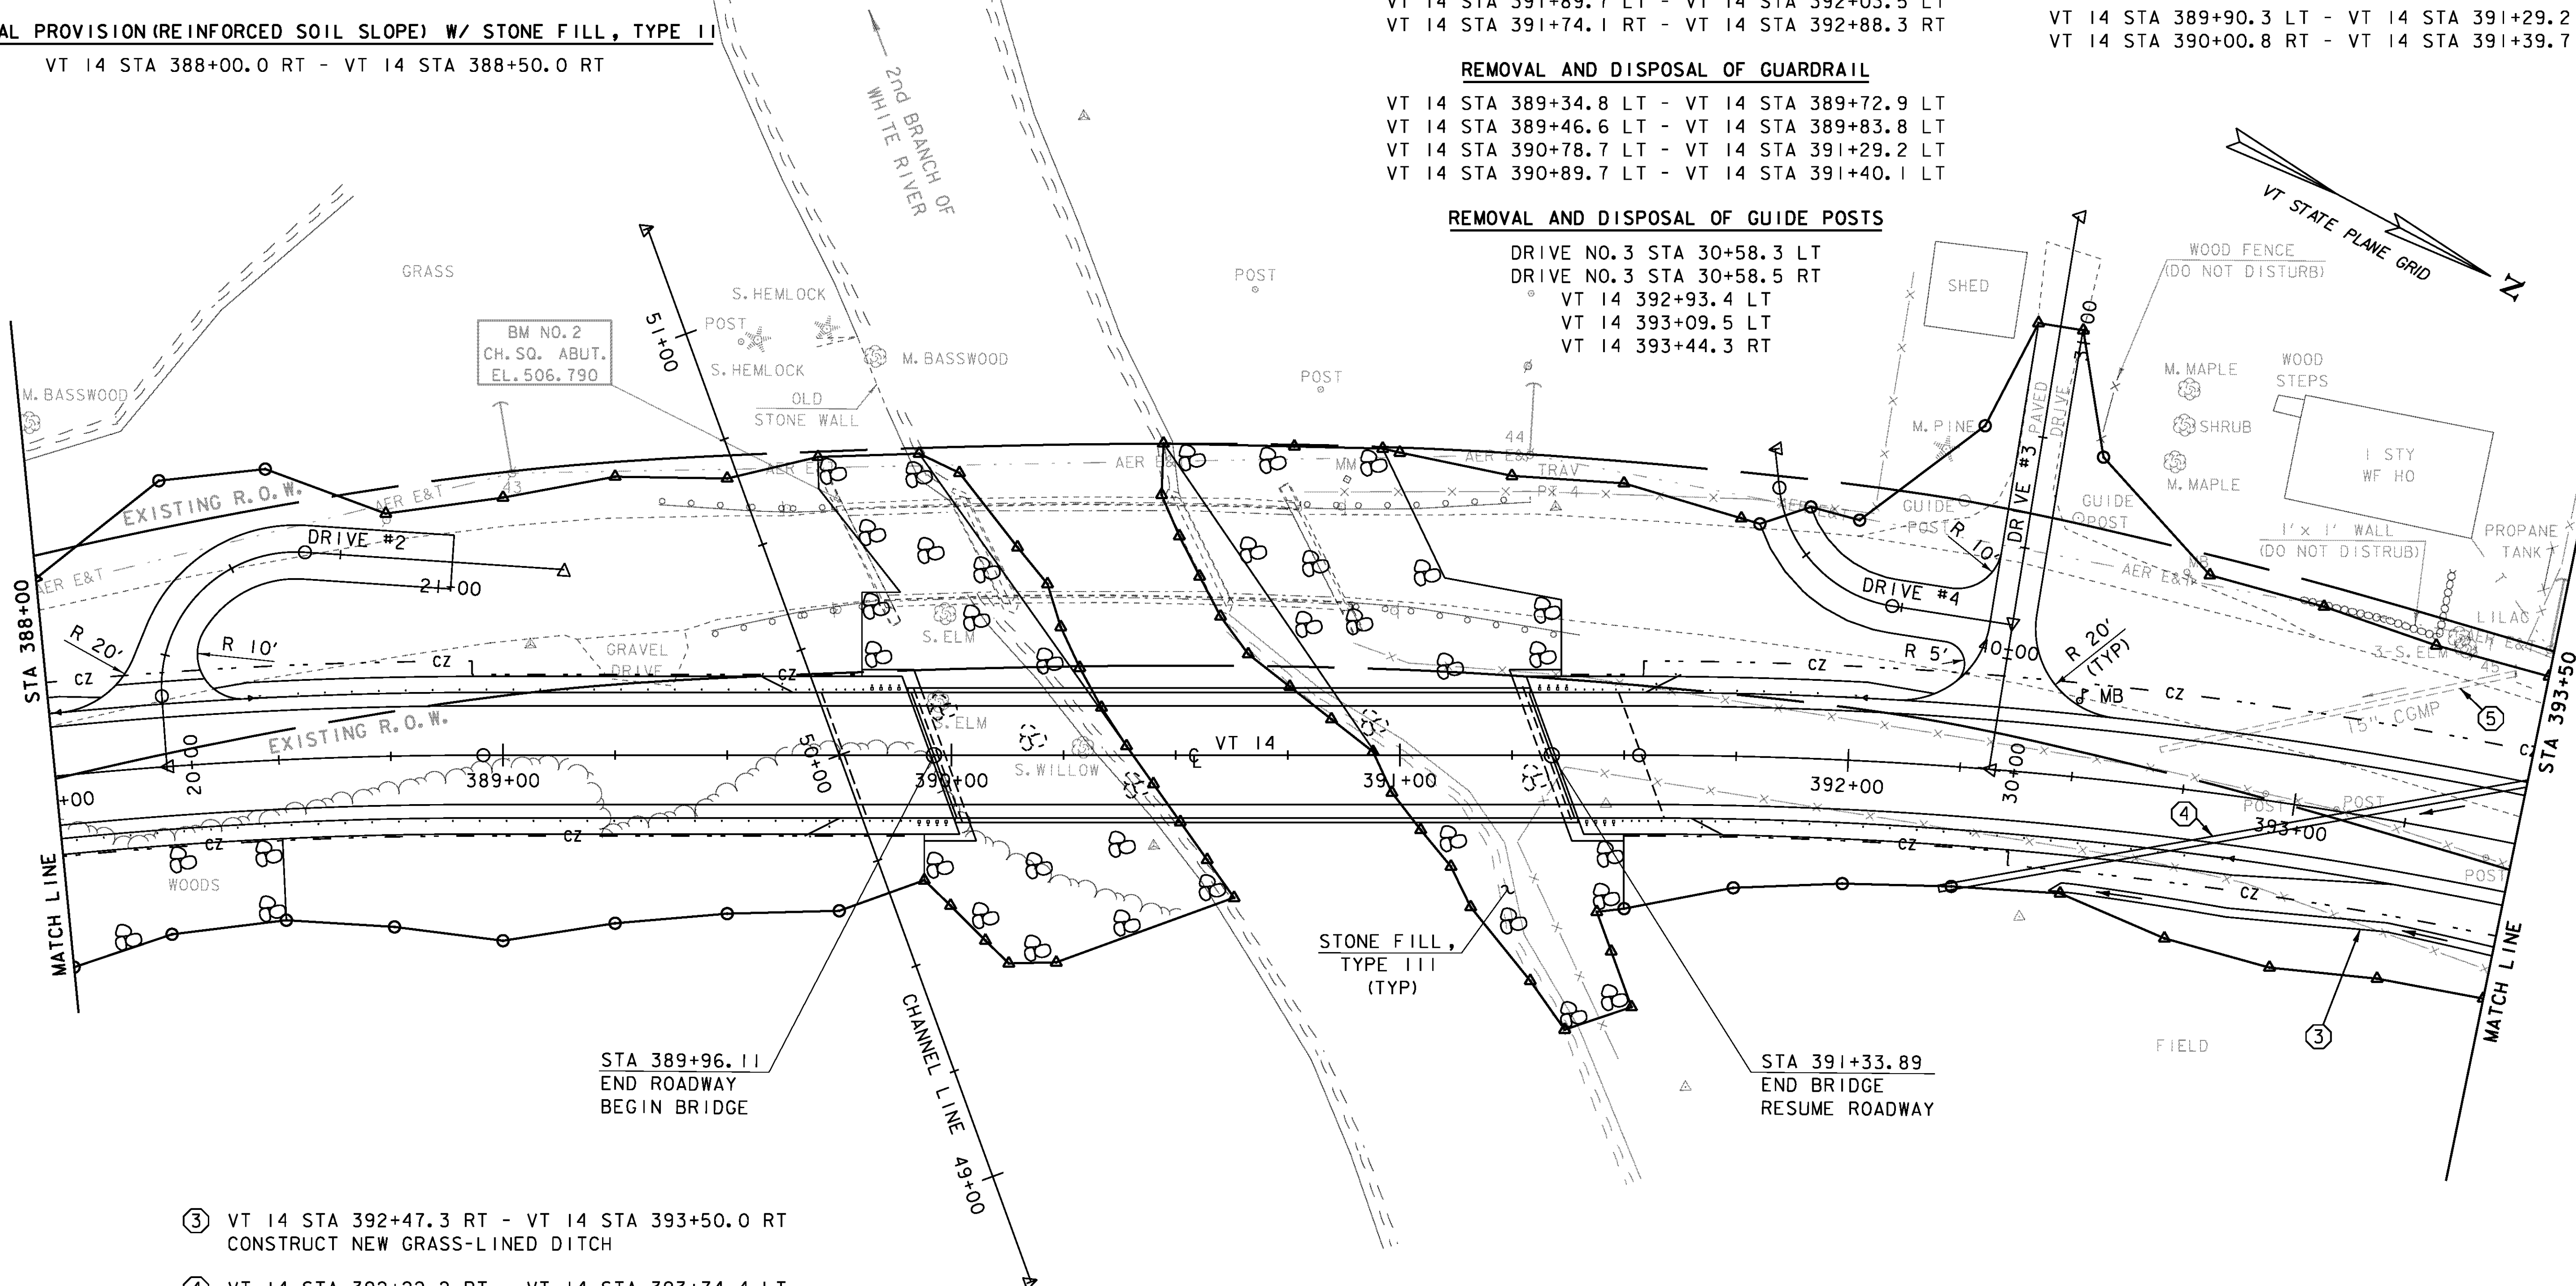

- ③ VT 14 STA 392+47.3 RT - VT 14 STA 393+50.0 RT  
CONSTRUCT NEW GRASS-LINED DITCH
- ④ VT 14 STA 392+22.2 RT - VT 14 STA 393+74.4 LT  
NEW 18" X 160' PCCSP (0.064), CAAP (0.060),  
RCP CL. III OR CPEP (SL) OPTION
- ⑤ VT 14 STA 392+68.9 LT - VT 14 STA 393+43.0 LT  
EXISTING 15" CGMP & INLET HEADWALL - REMOVE

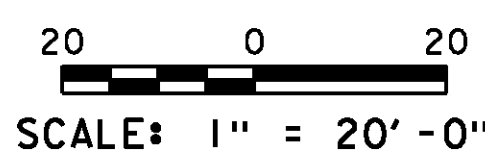

**EXISTING BRIDGE DATA**

THREE-SPAN CONCRETE T-BEAM SUPERSTRUCTURE  
WITH ASPHALT OVERLAY  
  
CAST-IN-PLACE CONCRETE ABUTMENTS, WINGWALLS  
AND PIERS  
  
BRIDGE LENGTH: 105'  
BRIDGE WIDTH (FASCIA TO FASCIA): 23.7'  
VERTICAL CLEARANCE UNDER BRIDGE: 12'

PROJECT NAME:	ROYALTON	FILE NAME:	\BR 27\s86e055bdr_27.dgn
PROJECT NUMBER:	BRS 0147(I3)	PLOT DATE:	08-OCT-2013
DESIGNED BY:	D. PETERSON	DRAWN BY:	L. BULLOCK
BRIDGE 27 LAYOUT (2)		CHECKED BY:	C. CARLSON
		SHEET	22 OF 186

**CONSTRUCT 5' WIDE PAVED APRON**



VT 14 STA 395+82.2 RT - VT 14 STA 396+21.4 RT

**REMOVAL AND DISPOSAL OF GUIDE POSTS**


- VT 14 STA 393+80.9 RT
- VT 14 STA 393+98.7 RT
- VT 14 STA 394+12.4 RT
- VT 14 STA 394+27.6 RT
- VT 14 STA 394+40.9 RT
- VT 14 STA 394+57.7 RT
- VT 14 STA 394+74.9 RT
- VT 14 STA 394+91.0 RT
- VT 14 STA 395+22.4 RT

**REMOVING AND RESETTING FENCE**


VT 14 STA 393+50.0 RT - VT 14 STA 394+73.3 RT  
 VT 14 STA 393+50.0 RT - VT 14 STA 395+93.4 RT  
 VT 14 STA 393+50.0 RT - VT 14 STA 395+95.7 LT

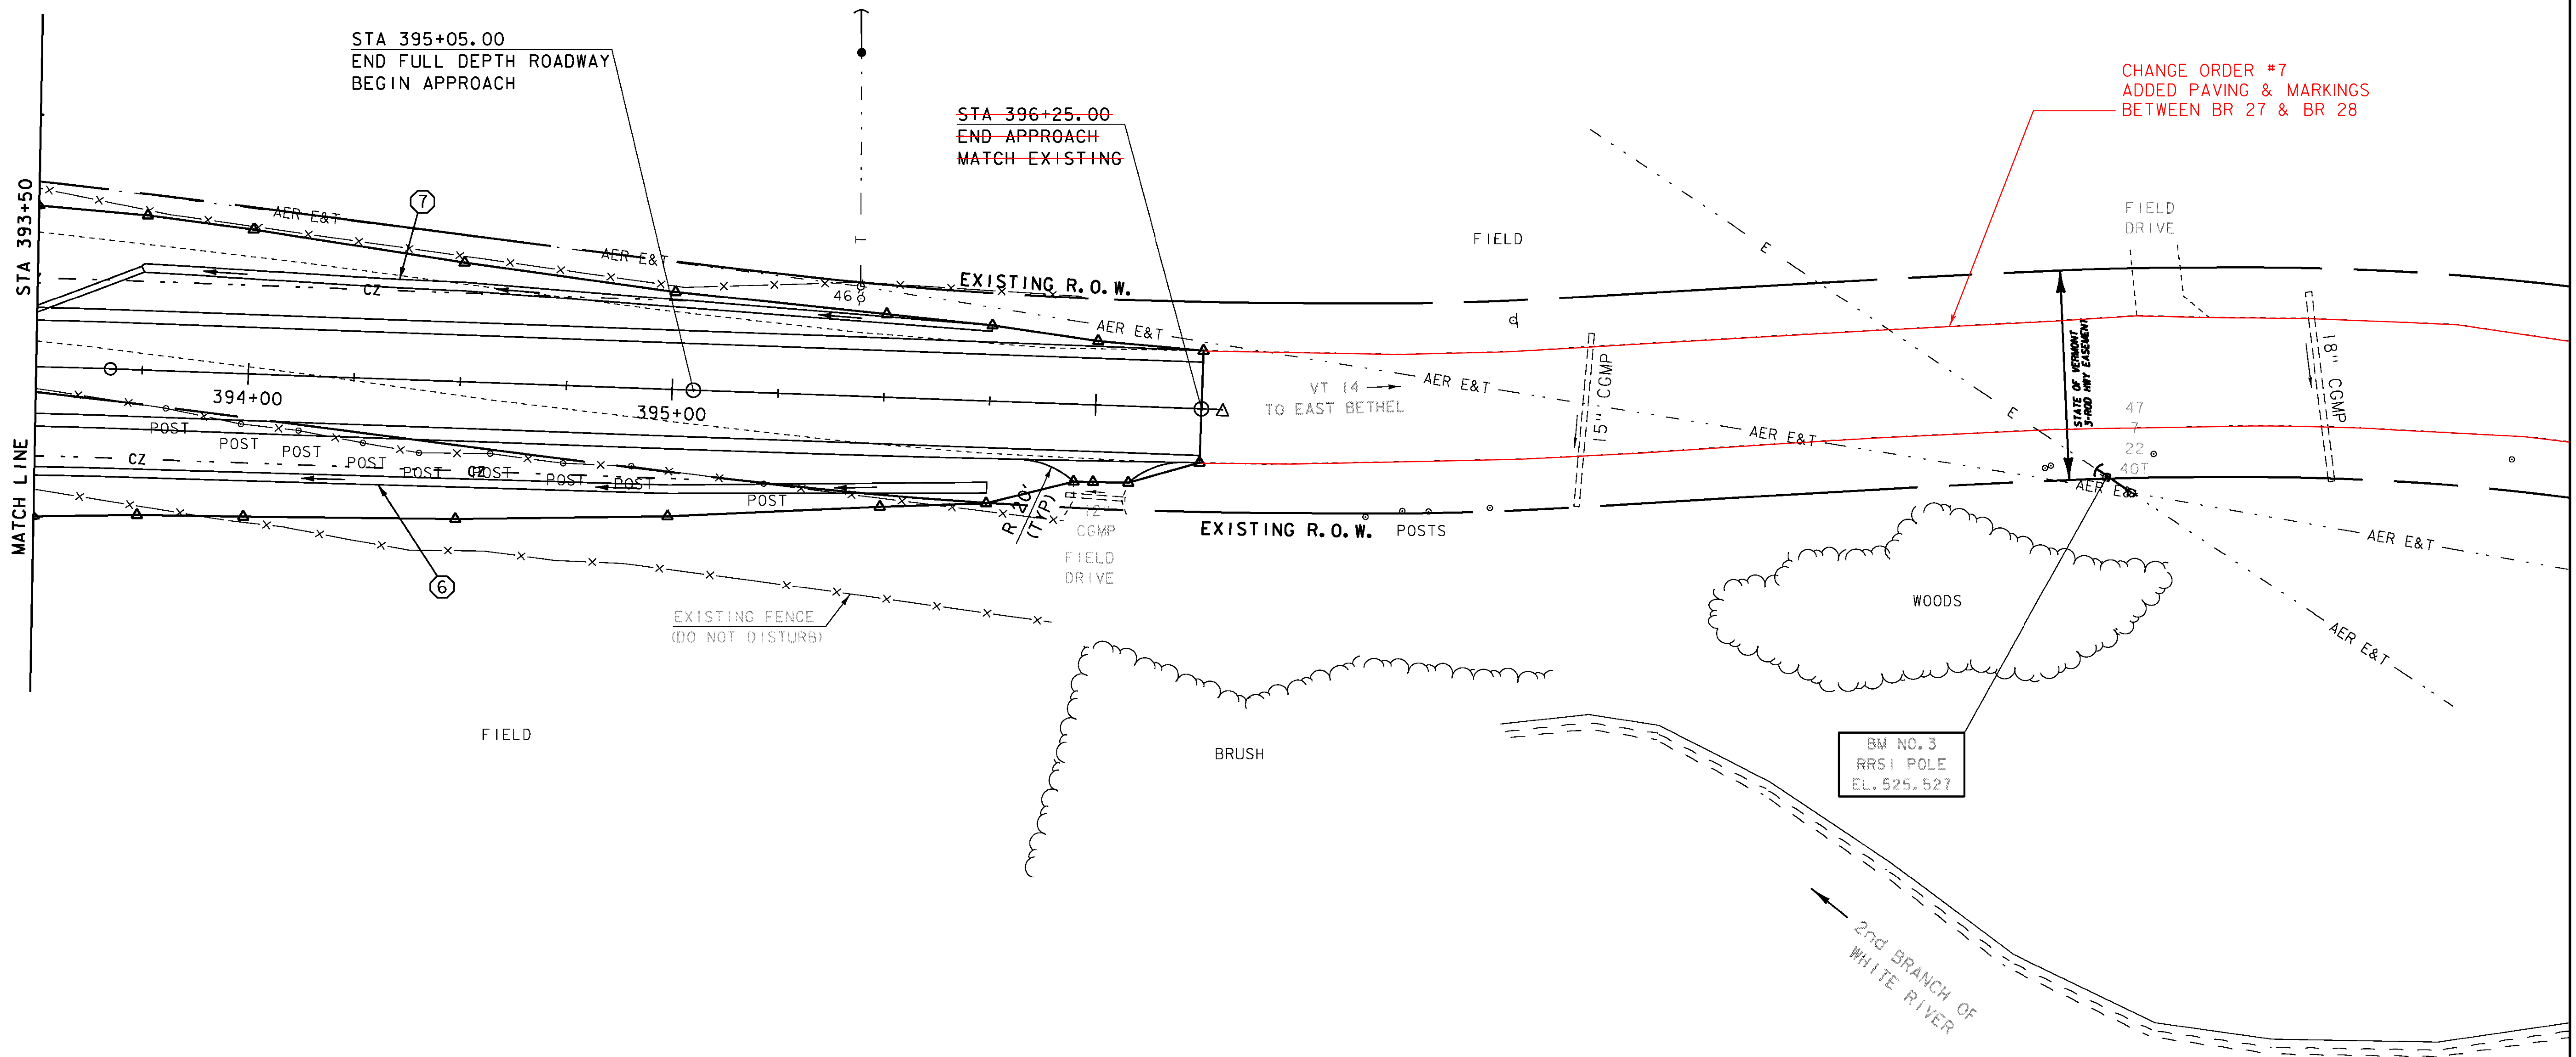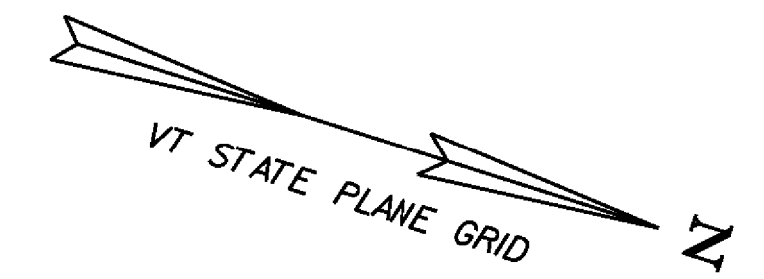

- ⑥ VT 14 STA 393+50.0 RT - VT 14 STA 395+75.0 RT  
CONSTRUCT NEW GRASS-LINED DITCH
- ⑦ VT 14 STA 393+75.0 LT - VT 14 STA 395+75.0 LT  
CONSTRUCT NEW GRASS-LINED DITCH

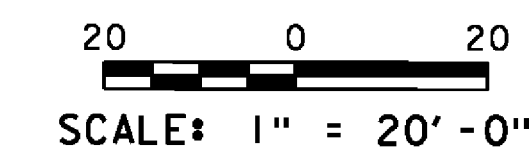

PROJECT NAME:	ROYALTON
PROJECT NUMBER:	BRS 0147(13)
FILE NAME:	\\BR 27\s86e055bdr_27.dgn
PROJECT LEADER:	C. CARLSON
DESIGNED BY:	D. PETERSON
BRIDGE 27 LAYOUT (3)	
PLOT DATE:	08-OCT-2013
DRAWN BY:	L. BULLOCK
CHECKED BY:	C. CARLSON
SHEET	23 OF 186

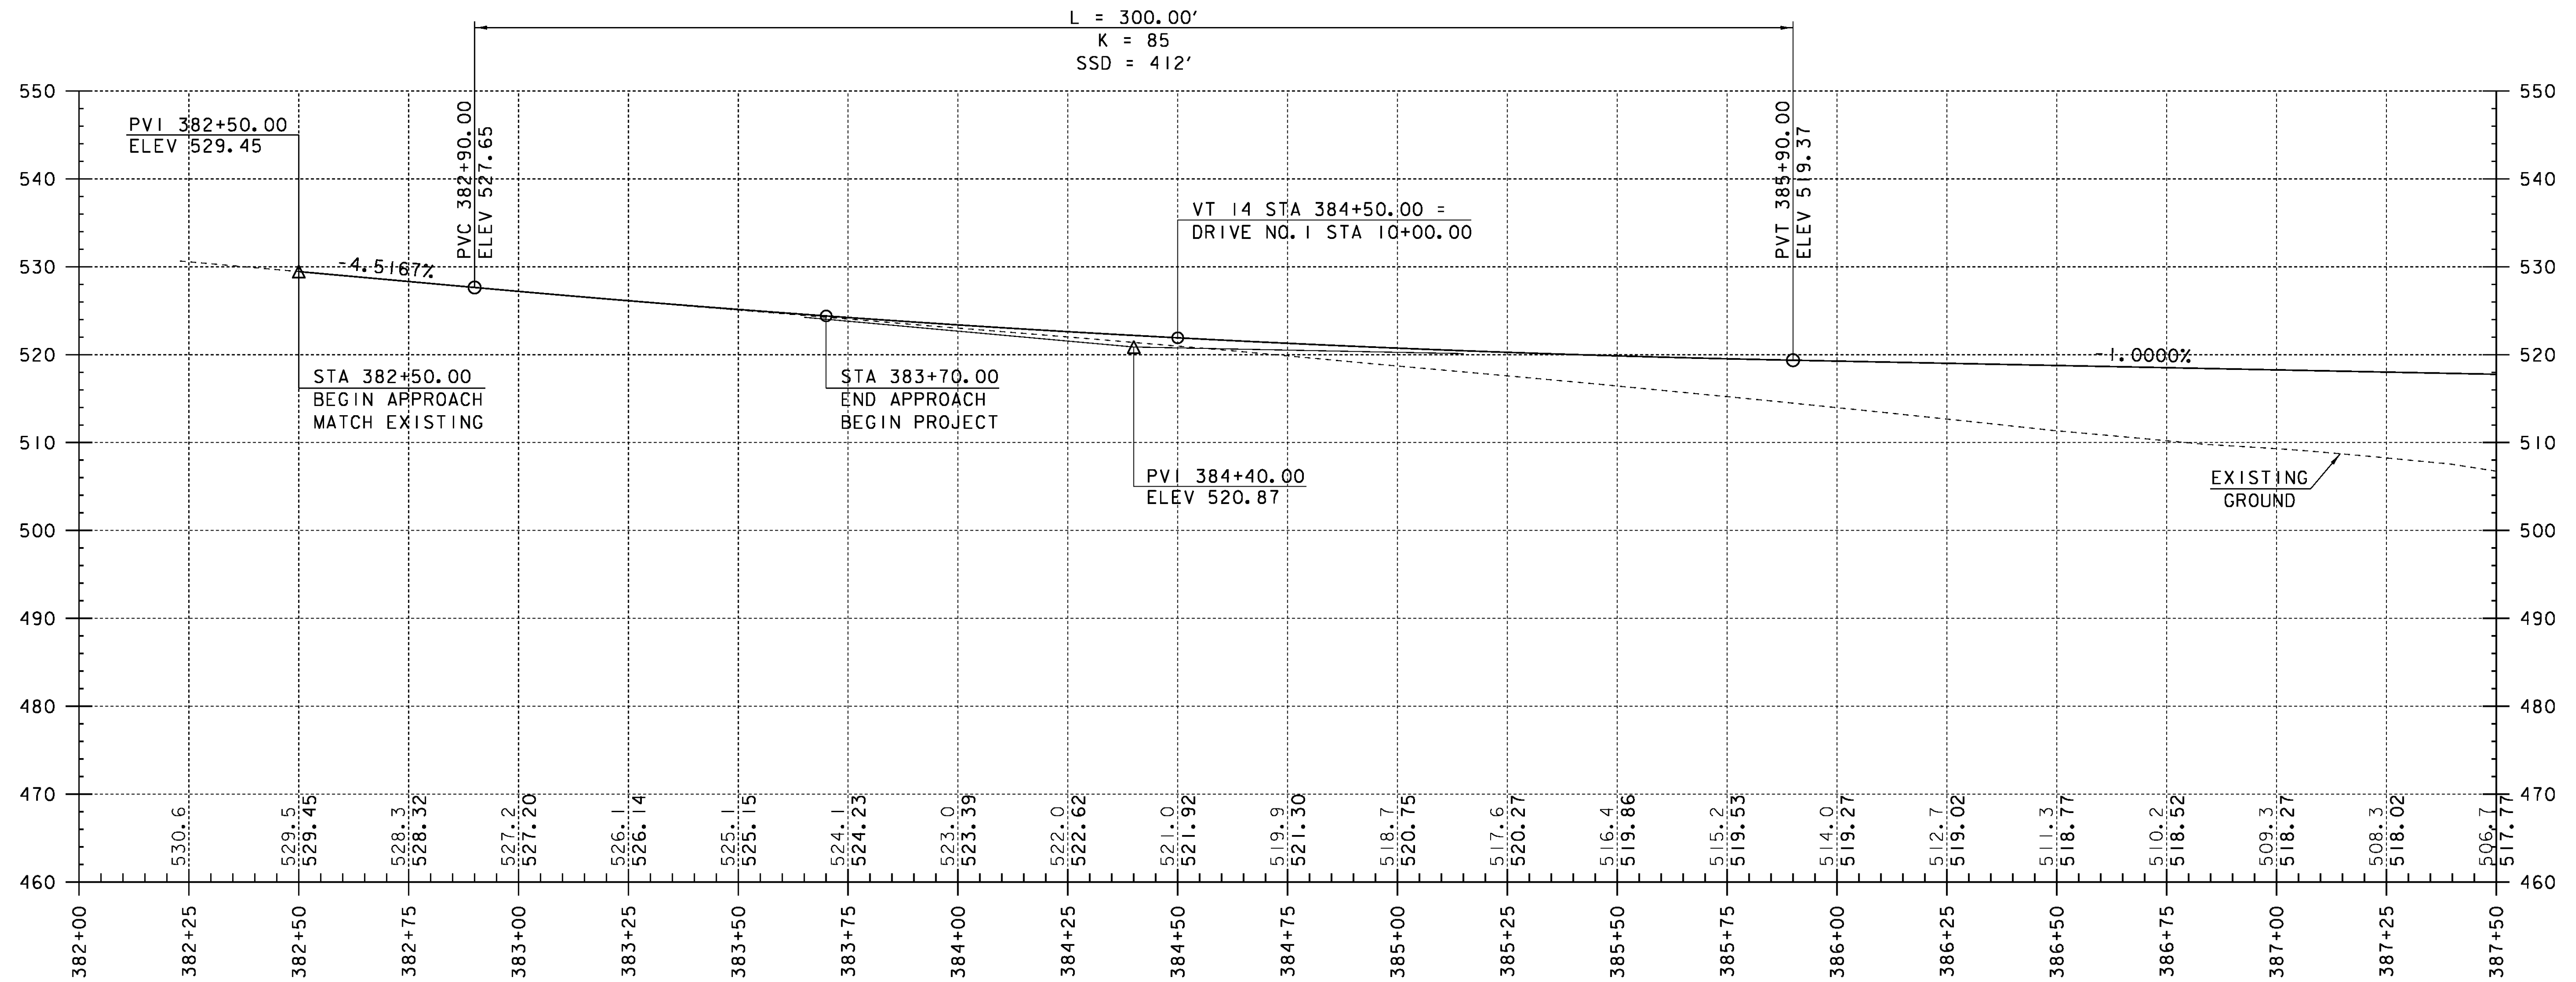

**PROFILE ALONG VT 14**

HORIZONTAL SCALE: 1" = 20'-0"  
 VERTICAL SCALE: 1" = 10'-0"


**NOTE:**

ELEVATIONS SHOWN TO THE NEAREST TENTH ARE  
 EXISTING GROUND ALONG PROPOSED CENTERLINE.

ELEVATIONS SHOWN TO THE NEAREST HUNDREDTH ARE  
 FINISH GRADES ALONG PROPOSED CENTERLINE.

PROJECT NAME: ROYALTON	PLOT DATE: 08-OCT-2013
PROJECT NUMBER: BRS 0147 (13)	DRAWN BY: D. PETERSON
FILE NAME: s86e055pro.27.dgn	CHECKED BY: C. CARLSON
PROJECT LEADER: C. CARLSON	DESIGNED BY: D. PETERSON
BRIDGE 27 VT 14 PROFILE SHEET (1)	SHEET 24 OF 186



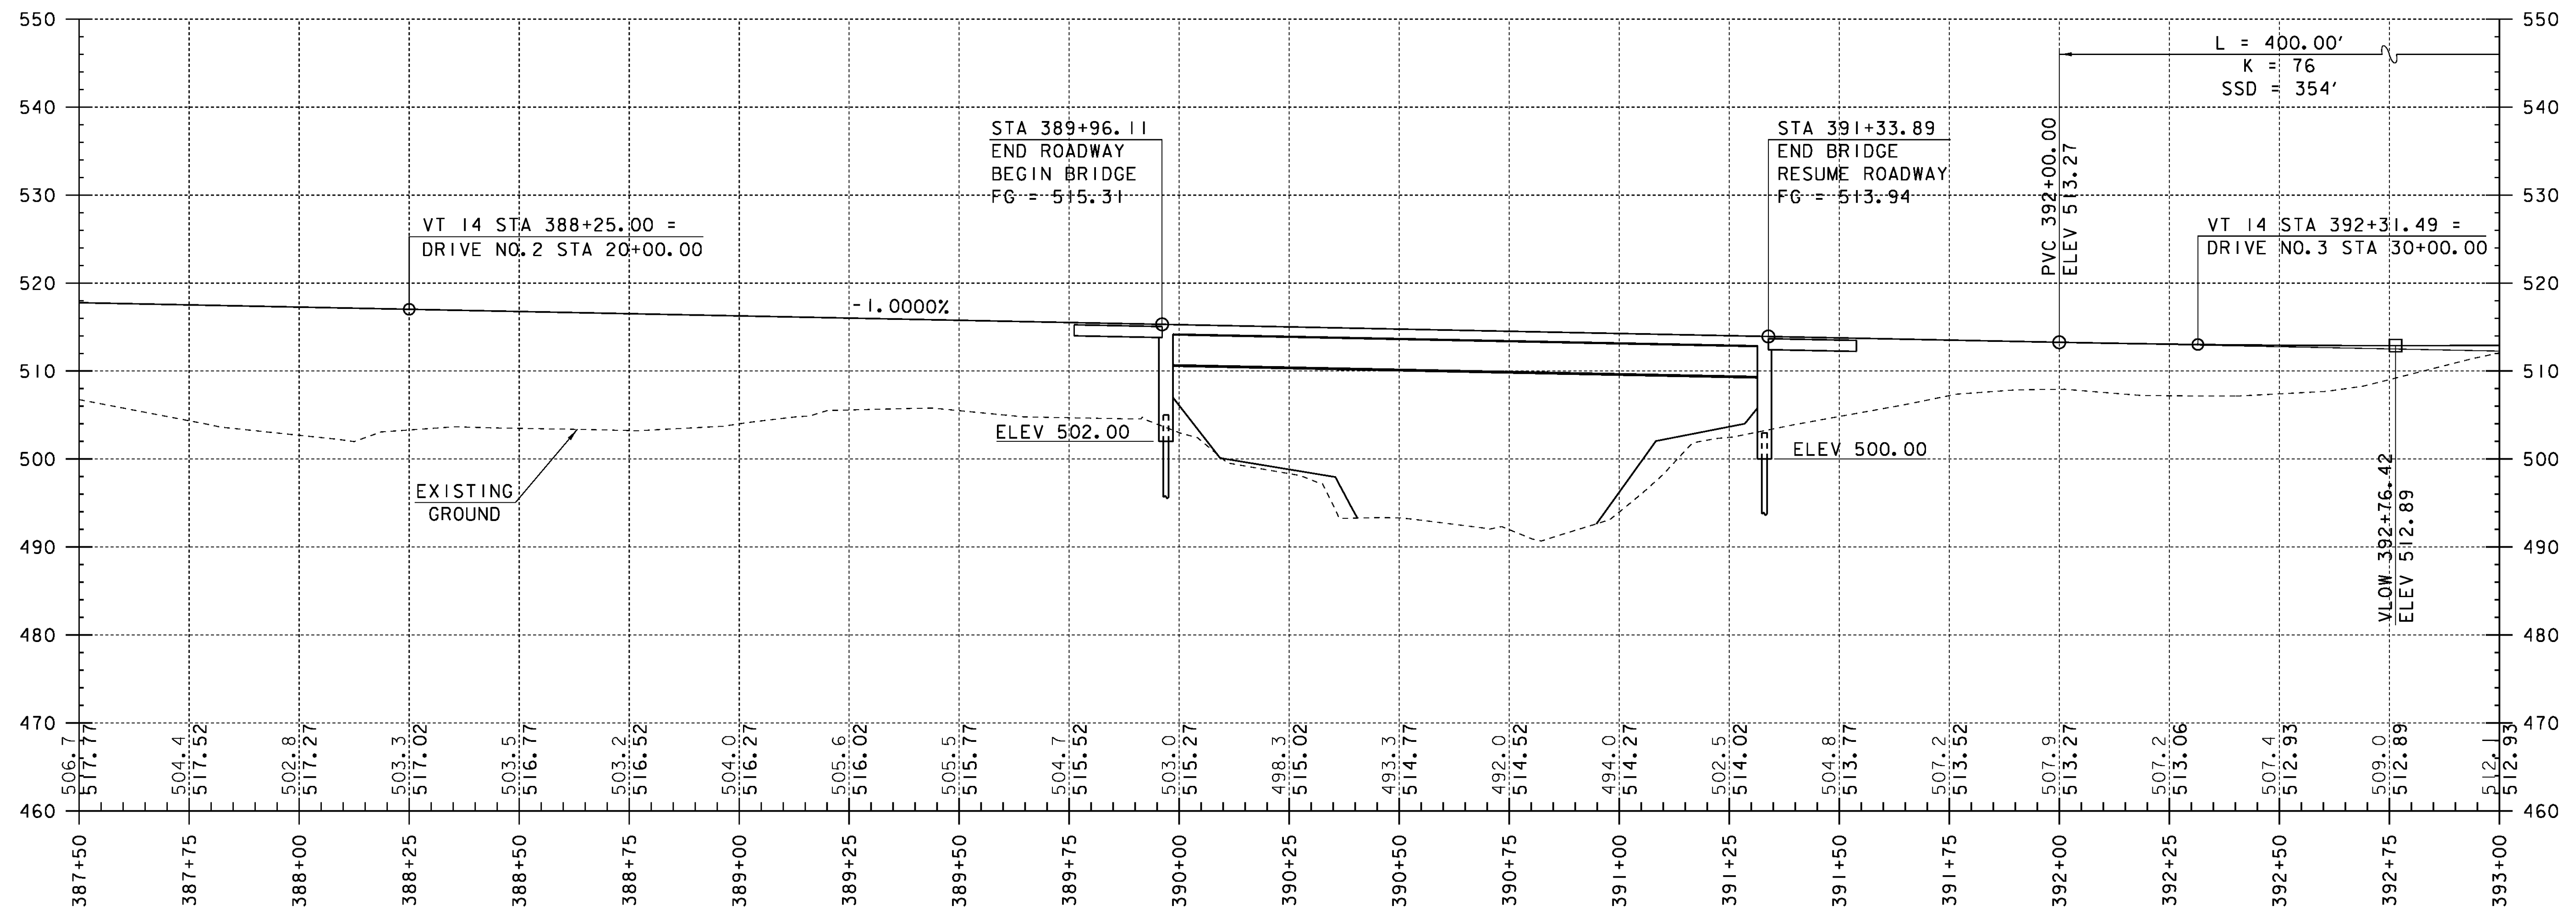

NOTE:

ELEVATIONS SHOWN TO THE NEAREST TENTH ARE  
EXISTING GROUND ALONG PROPOSED CENTERLINE.

ELEVATIONS SHOWN TO THE NEAREST HUNDREDTH ARE  
FINISH GRADES ALONG PROPOSED CENTERLINE.


PROFILE ALONG VT 14

HORIZONTAL SCALE: 1" = 20'-0"  
VERTICAL SCALE: 1" = 10'-0"

PROJECT NAME: ROYALTON  
PROJECT NUMBER: BRS 0147 (13)

FILE NAME: s86e055pro_27.dgn  
PROJECT LEADER: C. CARLSON  
DESIGNED BY: D. PETERSON  
BRIDGE 27 VT 14 PROFILE SHEET (2)

PLOT DATE: 08-OCT-2013  
DRAWN BY: D. PETERSON  
CHECKED BY: C. CARLSON  
SHEET 25 OF 186

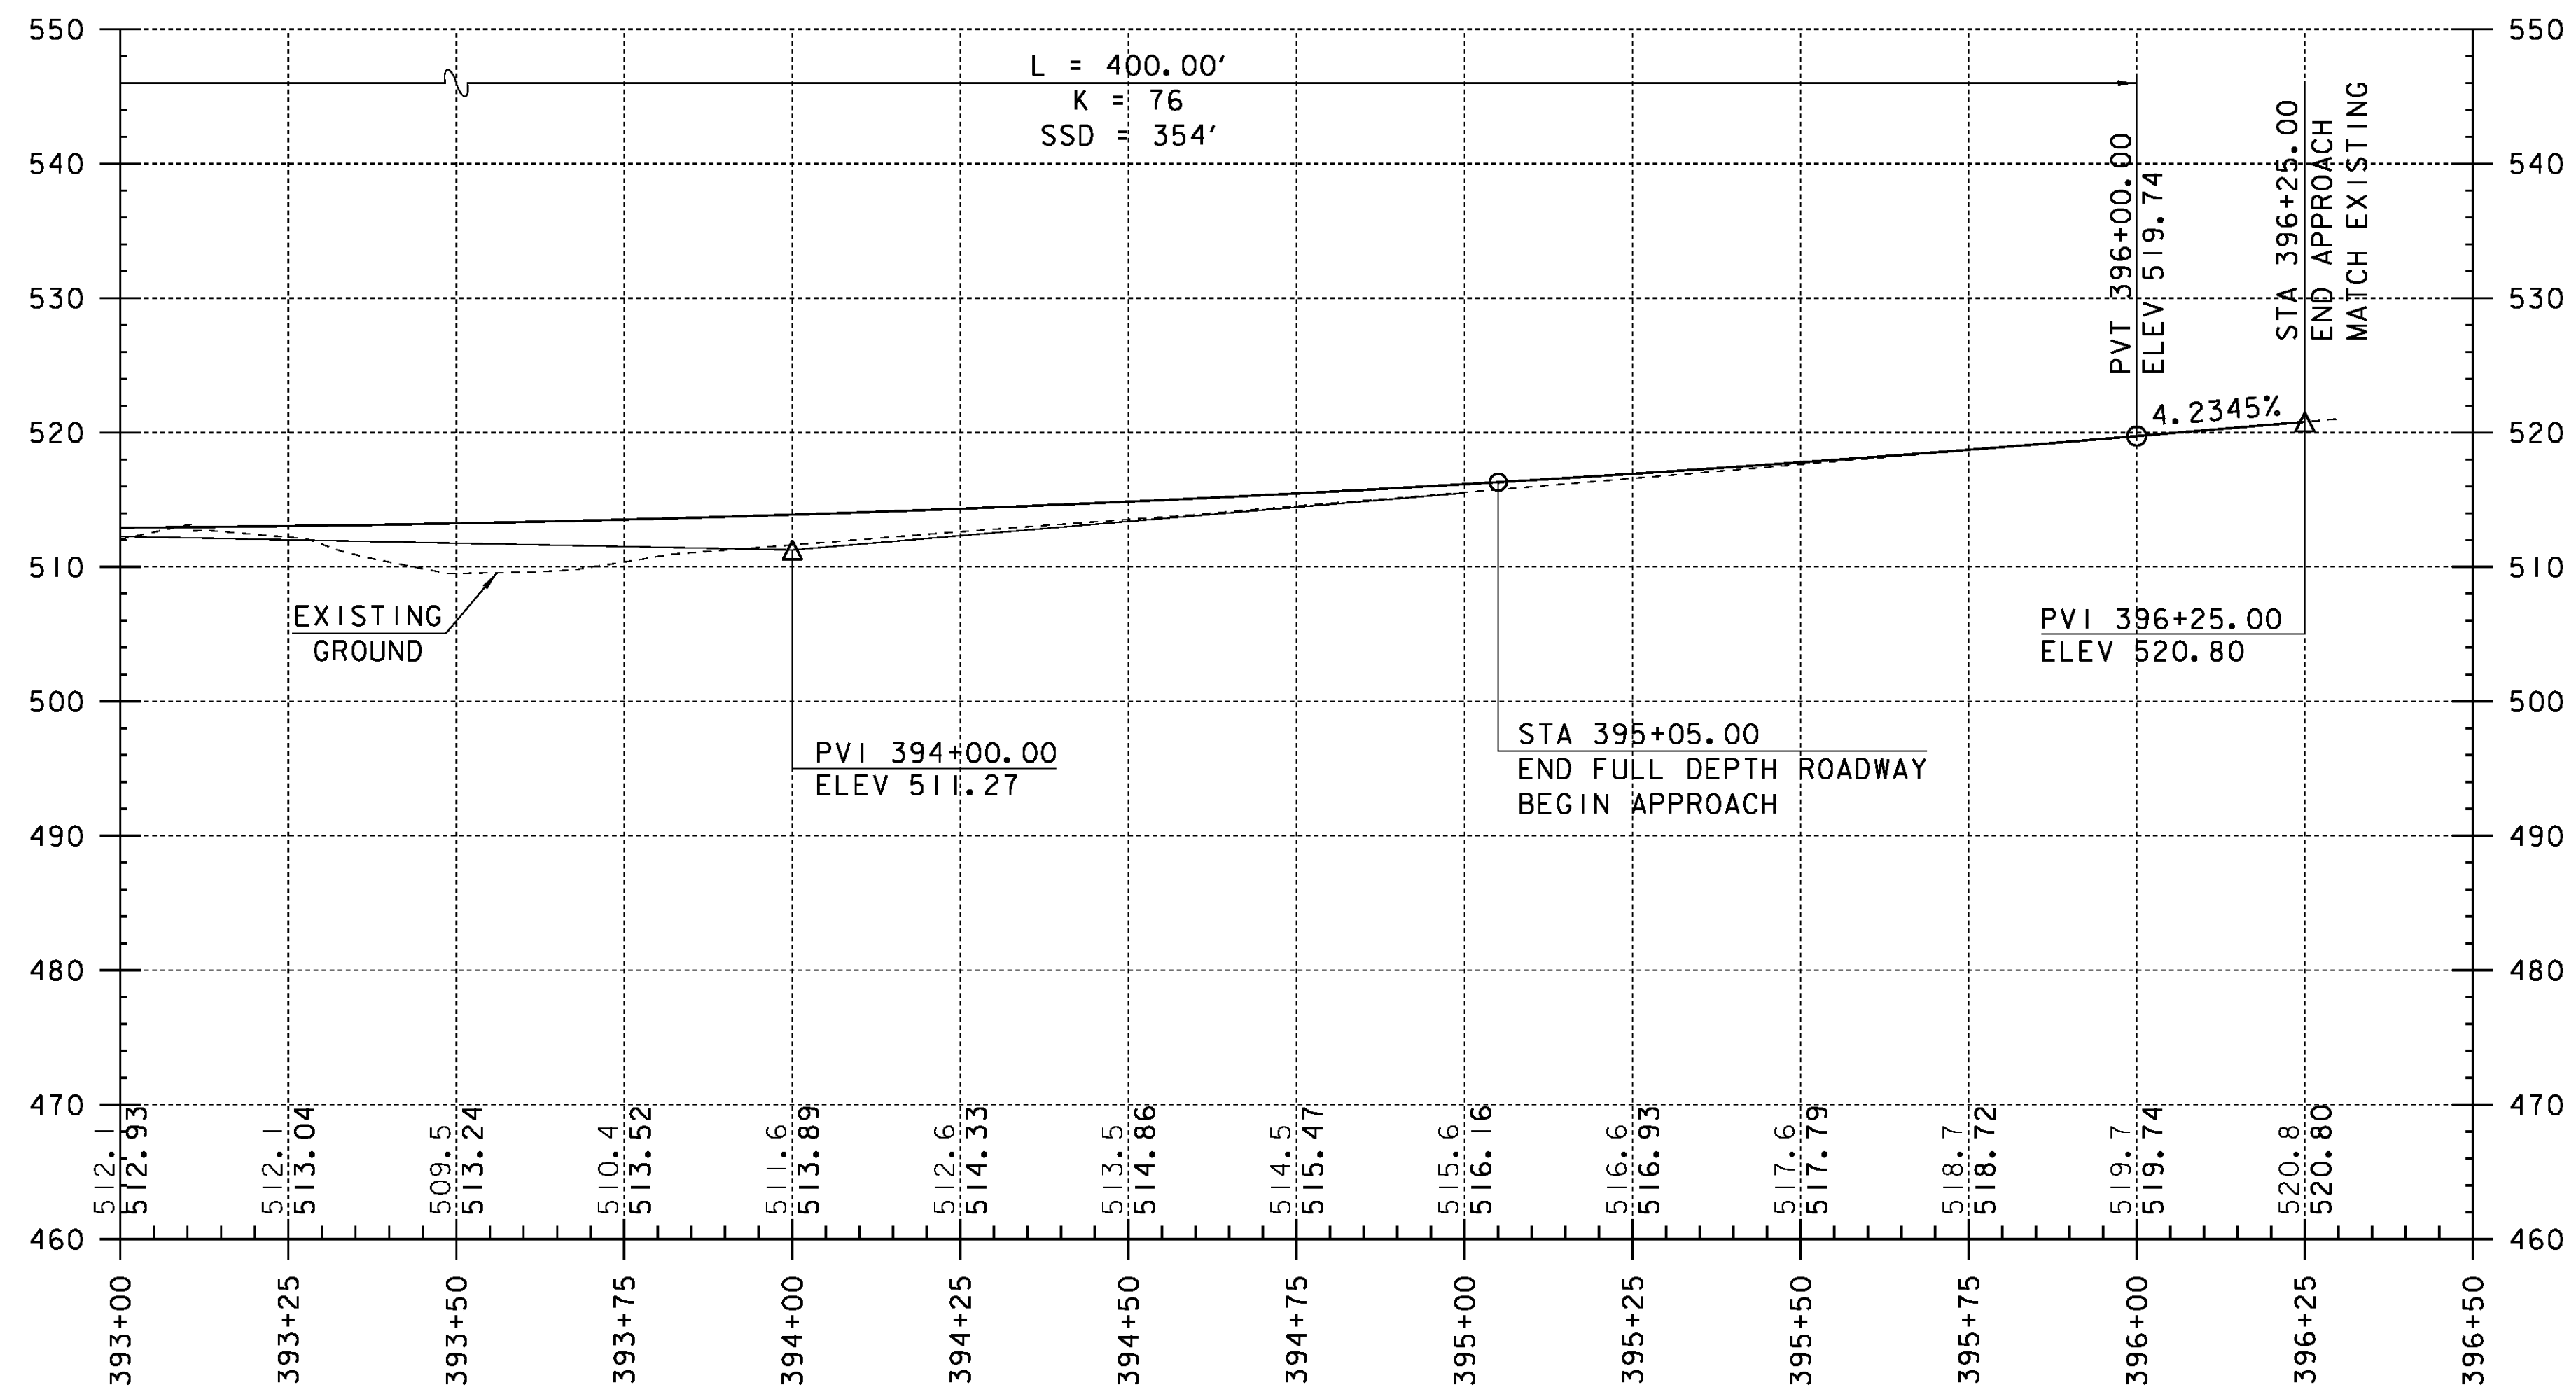

PROFILE ALONG VT 14

HORIZONTAL SCALE: 1" = 20'-0"  
 VERTICAL SCALE: 1" = 10'-0"

NOTE:



ELEVATIONS SHOWN TO THE NEAREST TENTH ARE  
 EXISTING GROUND ALONG PROPOSED CENTERLINE.

ELEVATIONS SHOWN TO THE NEAREST HUNDREDTH ARE  
 FINISH GRADES ALONG PROPOSED CENTERLINE.

PROJECT NAME: ROYALTON  
 PROJECT NUMBER: BRS 0147 (13)

FILE NAME: s86e055pro_27.dgn  
 PROJECT LEADER: C. CARLSON  
 DESIGNED BY: D. PETERSON  
 BRIDGE 27 VT 14 PROFILE SHEET (3)


PLOT DATE: 08-OCT-2013  
 DRAWN BY: D. PETERSON  
 CHECKED BY: C. CARLSON  
 SHEET 26 OF 186

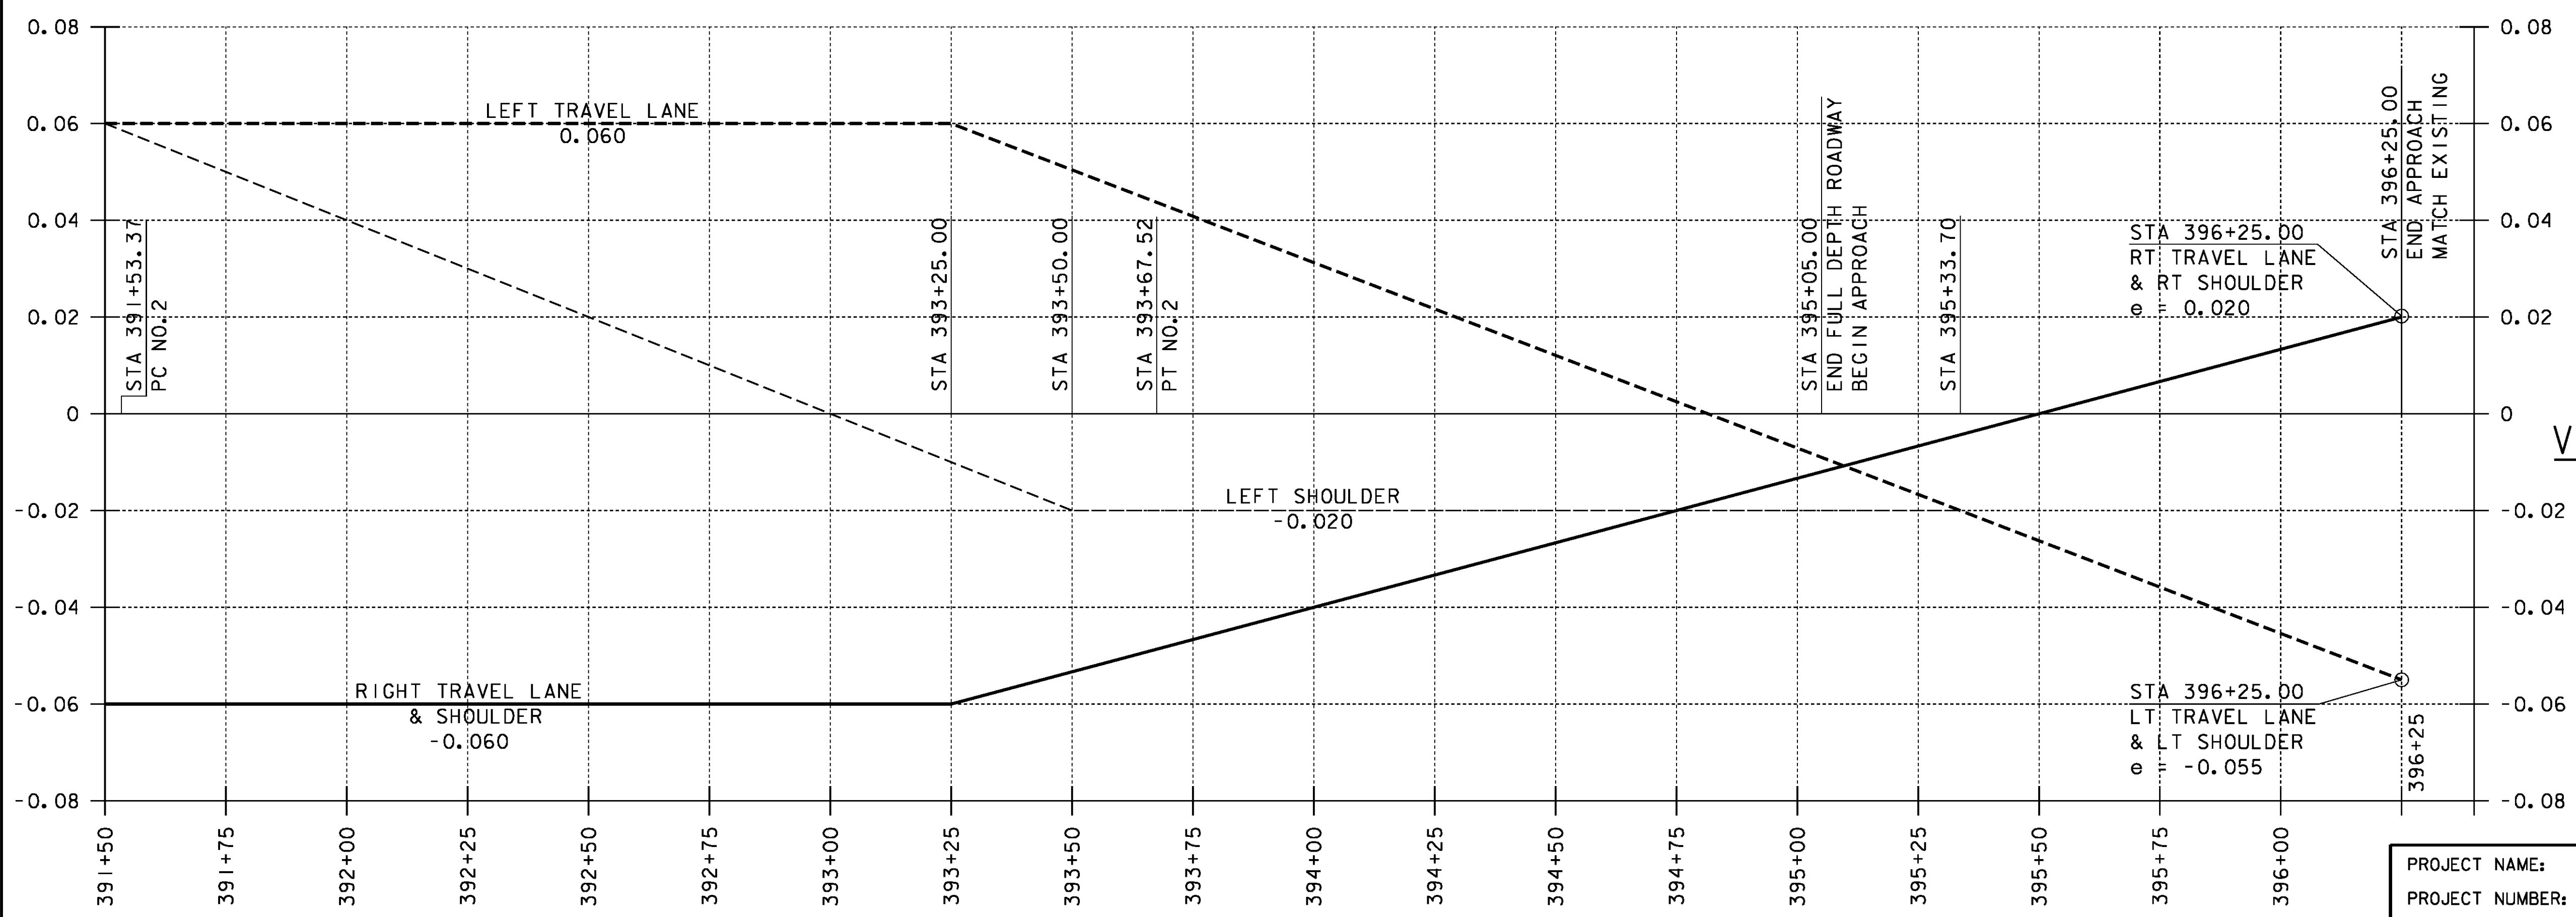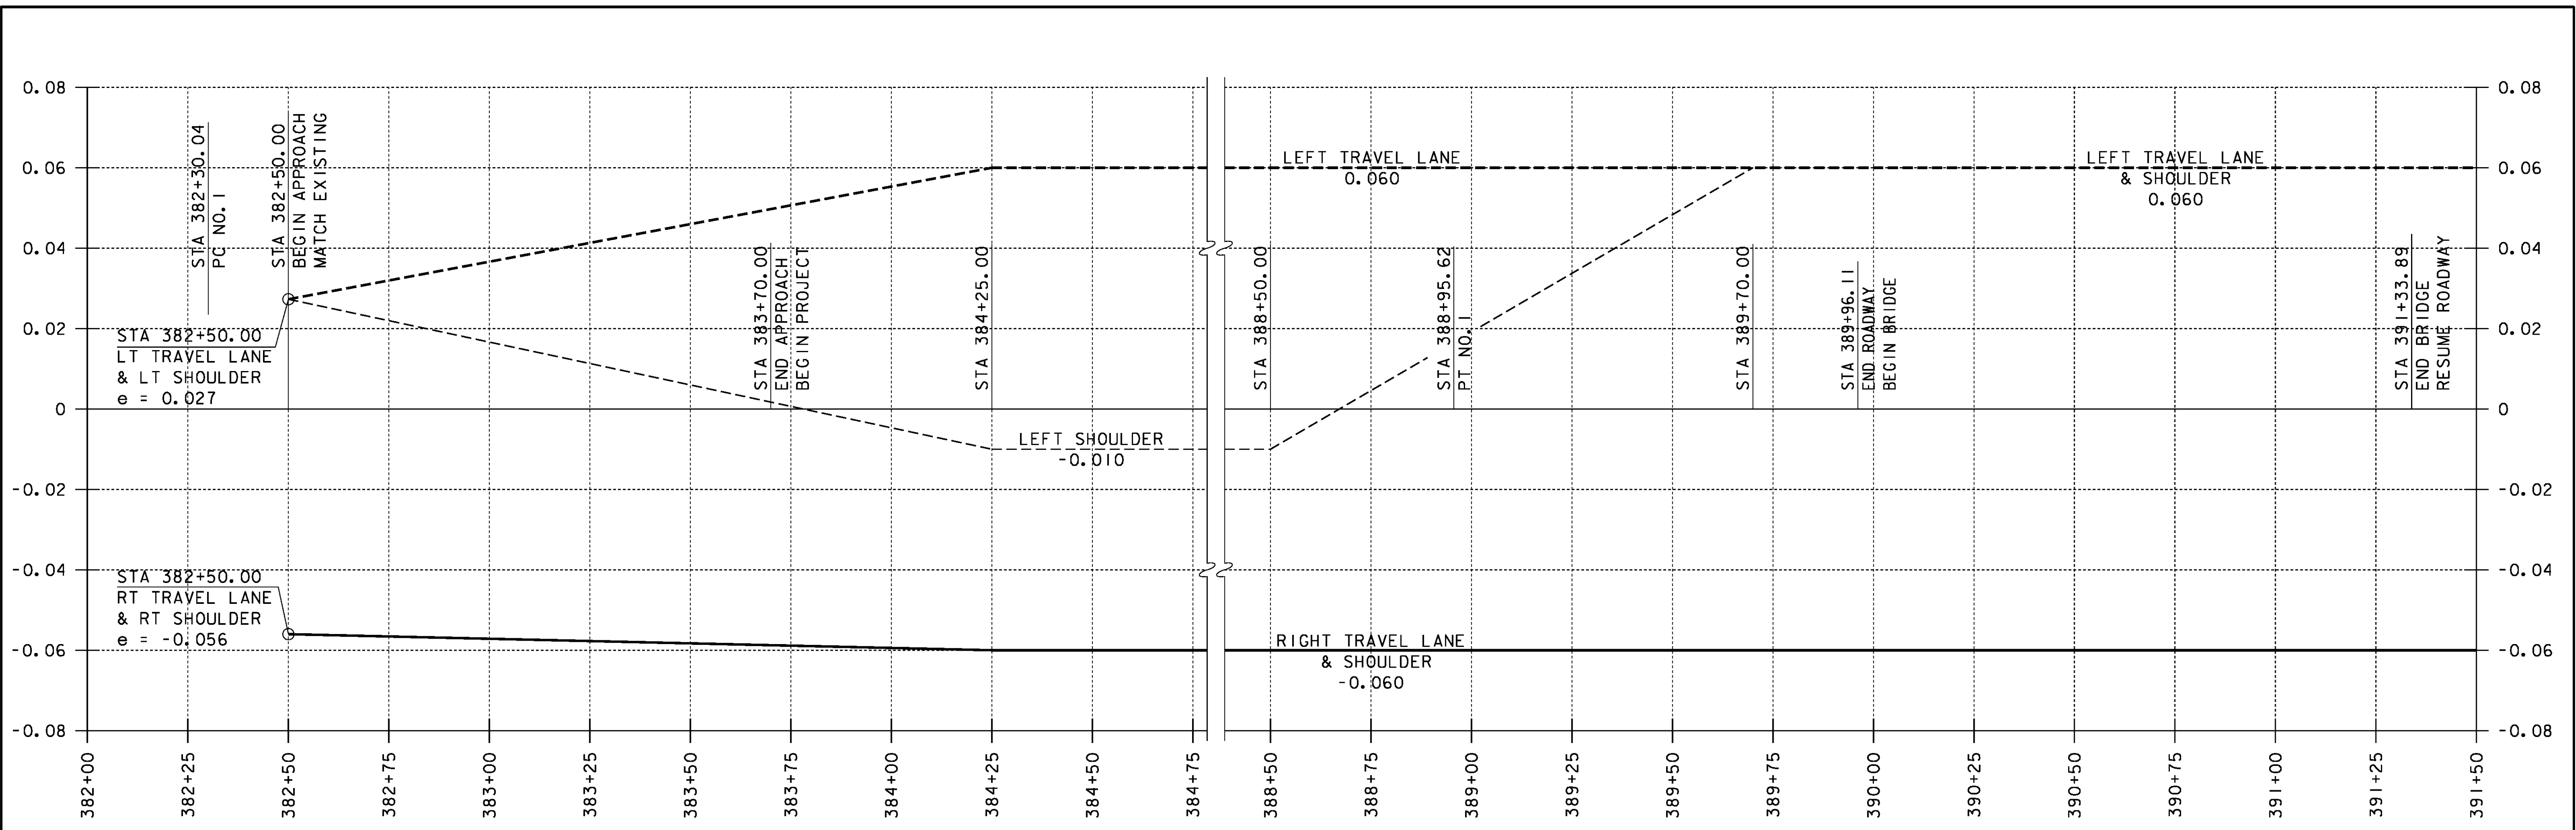

**VT 14 BANKING DIAGRAM**


HORIZONTAL SCALE: 1" = 20' - 0"  
 VERTICAL SCALE: 1" = 0.02' / 1"

PROJECT NAME:	ROYALTON	FILE NAME:	s86e055pro_27.dgn	PLOT DATE:	08-OCT-2013
PROJECT NUMBER:	BRS 0147 (13)	PROJECT LEADER:	C. CARLSON	DRAWN BY:	D. PETERSON
		DESIGNED BY:	D. PETERSON	CHECKED BY:	C. CARLSON
		BRIDGE 27 VT 14 BANKING DIAGRAM		SHEET	27 OF 186

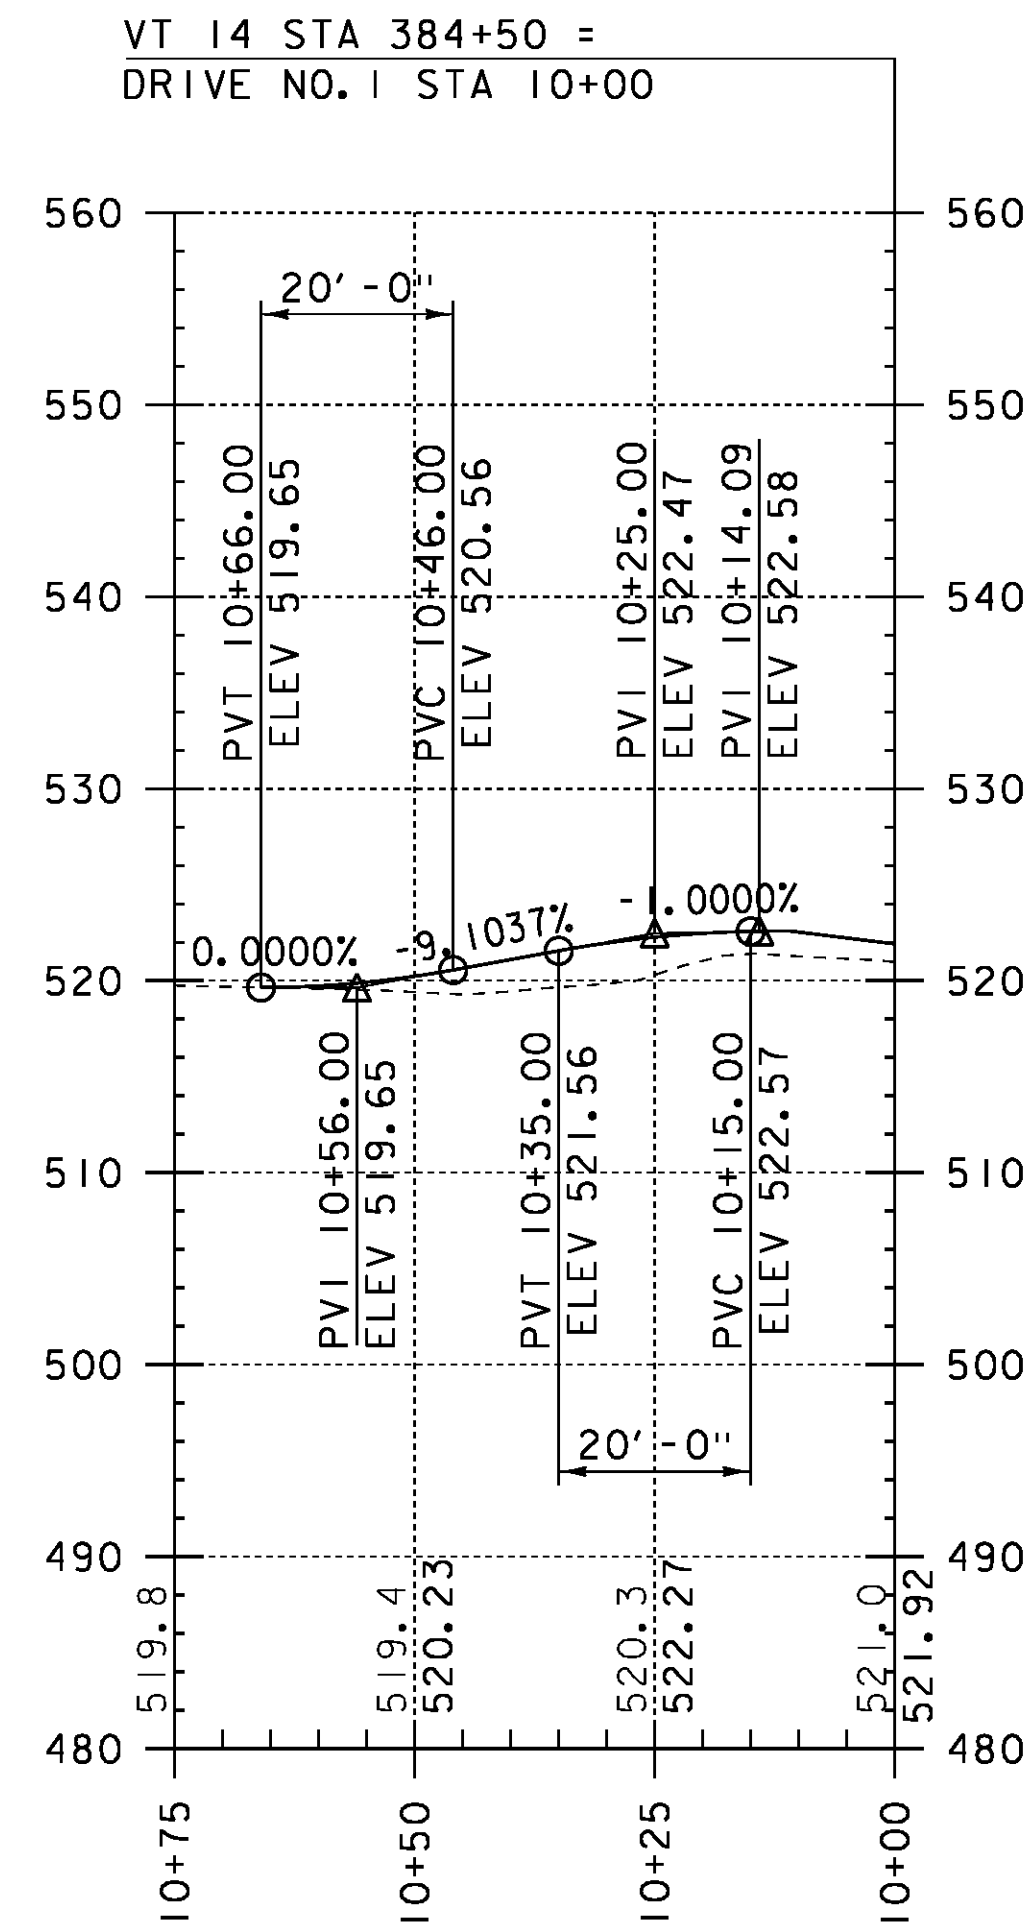


PROFILE ALONG DRIVE NO. 1

HORIZONTAL SCALE: 1" = 20' - 0"  
VERTICAL SCALE: 1" = 10' - 0"

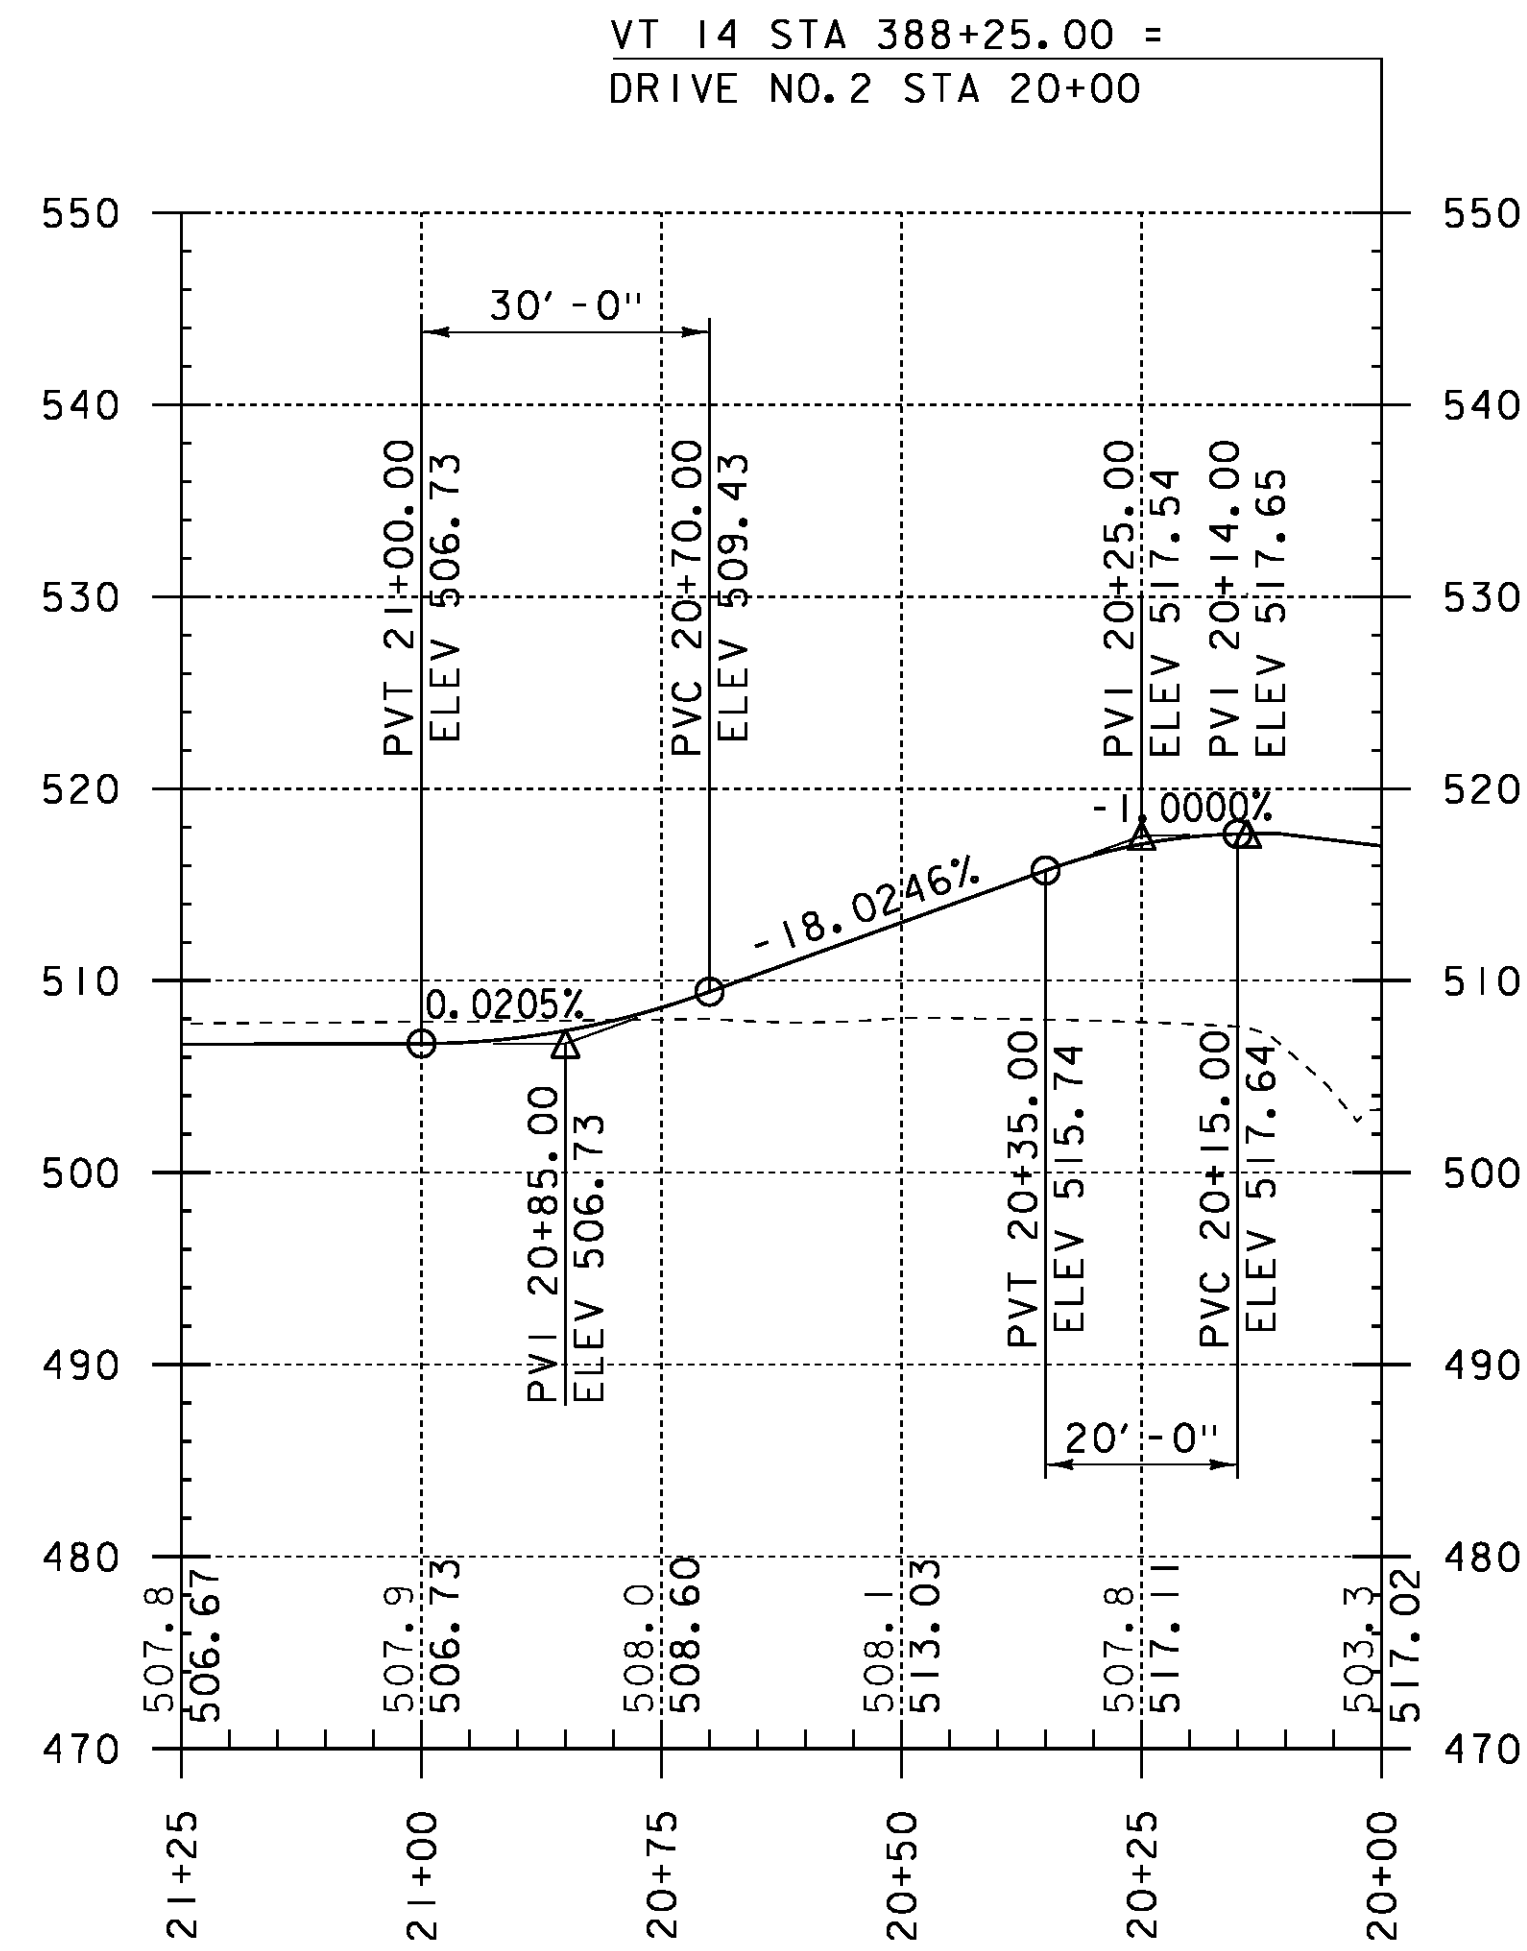


PROFILE ALONG DRIVE NO. 2

HORIZONTAL SCALE: 1" = 20' - 0"  
VERTICAL SCALE: 1" = 10' - 0"

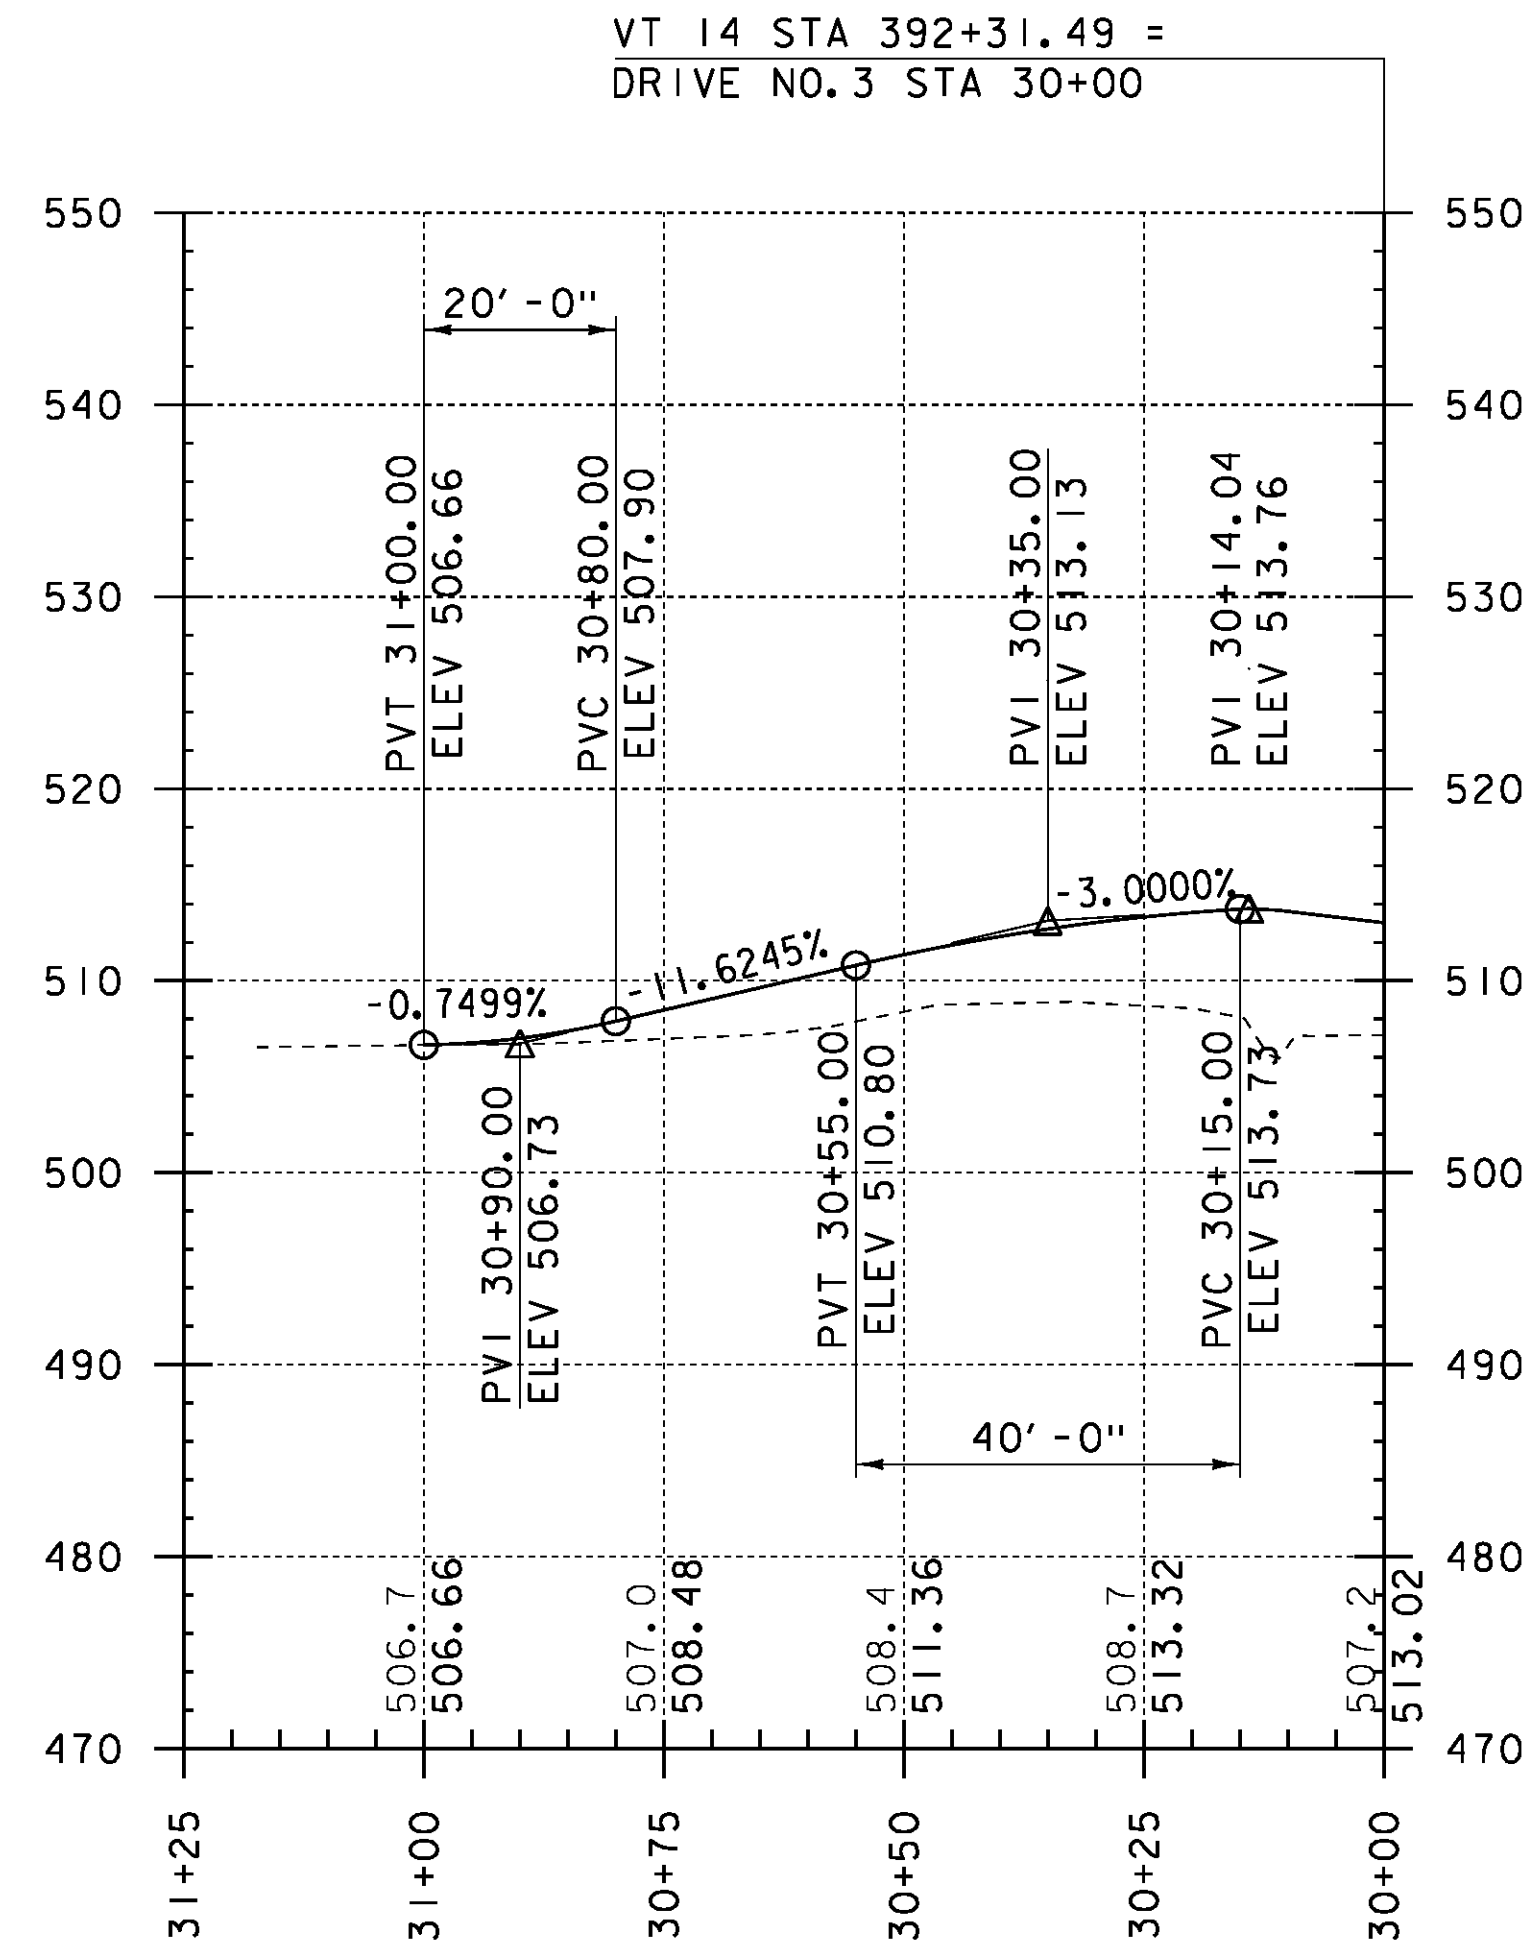

PROFILE ALONG DRIVE NO. 3

HORIZONTAL SCALE: 1" = 20' - 0"  
VERTICAL SCALE: 1" = 10' - 0"

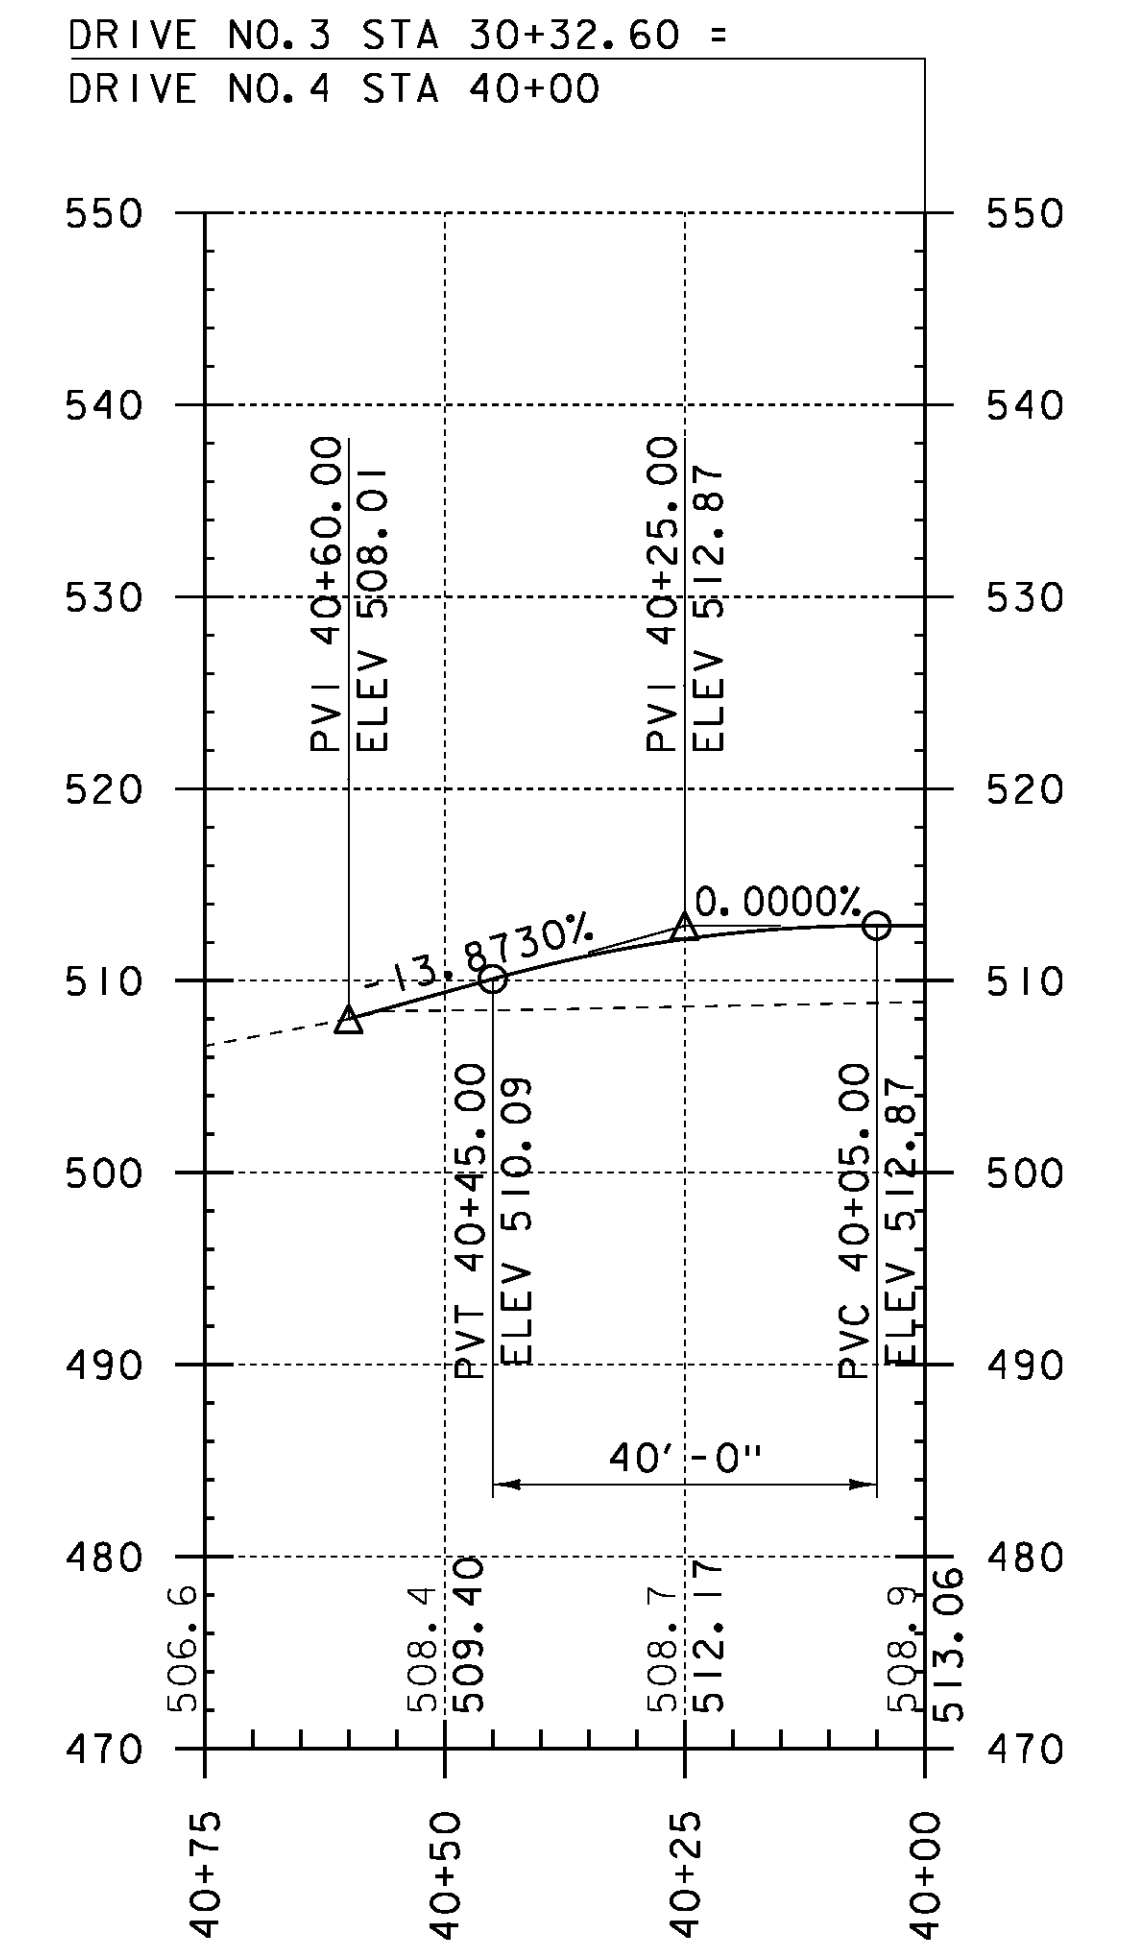

PROFILE ALONG DRIVE NO. 4

HORIZONTAL SCALE: 1" = 20' - 0"  
VERTICAL SCALE: 1" = 10' - 0"

NOTE:

ELEVATIONS SHOWN TO THE NEAREST TENTH ARE  
EXISTING GROUND ALONG PROPOSED CENTERLINE.





ELEVATIONS SHOWN TO THE NEAREST HUNDREDTH ARE  
FINISH GRADES ALONG PROPOSED CENTERLINE.

PROJECT NAME: ROYALTON	PLOT DATE: 08-OCT-2013
PROJECT NUMBER: BRS 0147 (13)	DRAWN BY: D. PETERSON
FILE NAME: s86e055pro_27.dgn	CHECKED BY: C. CARLSON
PROJECT LEADER: C. CARLSON	SHEET 28 OF 186
DESIGNED BY: D. PETERSON	
BRIDGE 27 DRIVE PROFILES	

**DURABLE 4 INCH WHITE LINE**  
 VT 14 STA 382+50.0 RT - VT 14 STA 388+00.0 RT  
 VT 14 STA 382+50.0 LT - VT 14 STA 388+00.0 LT

**DURABLE 4 INCH YELLOW LINE**  
 VT 14 STA 382+50.0 C - VT 14 STA 388+00.0 C (DOUBLE)

**REMOVING SIGNS**  
 VT 14 STA 384+32.2 RT

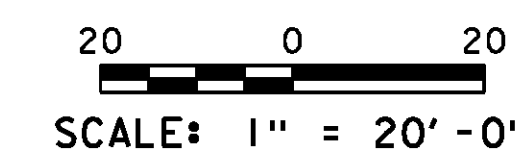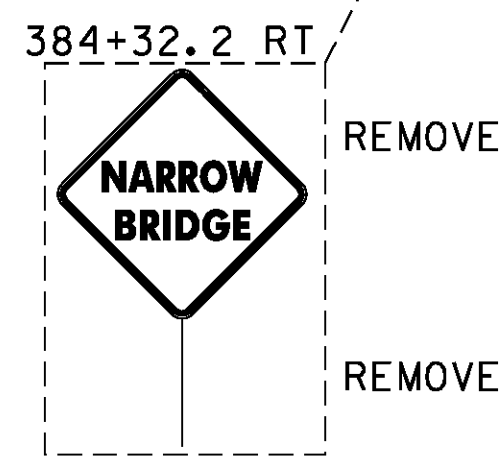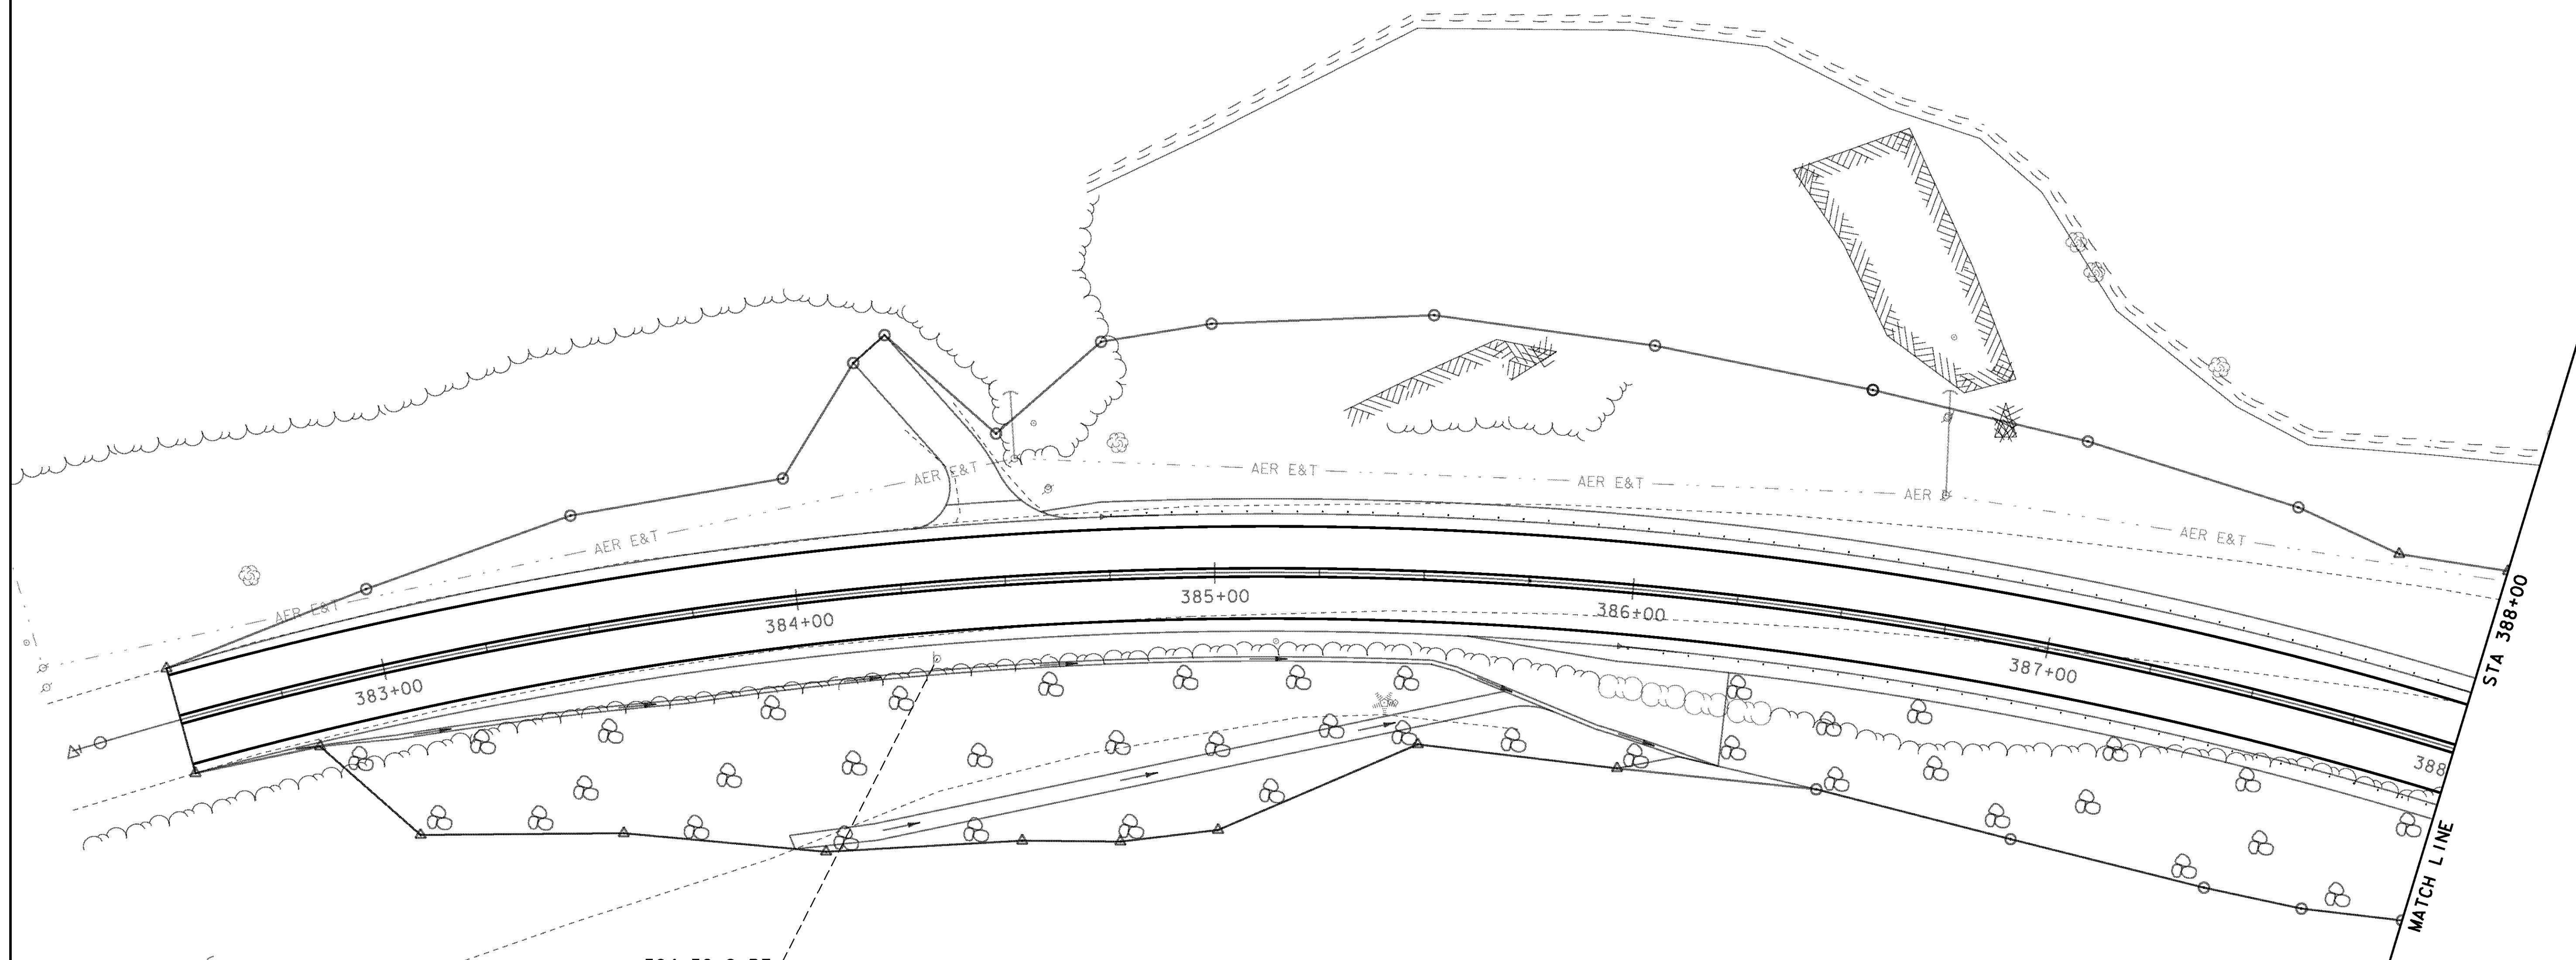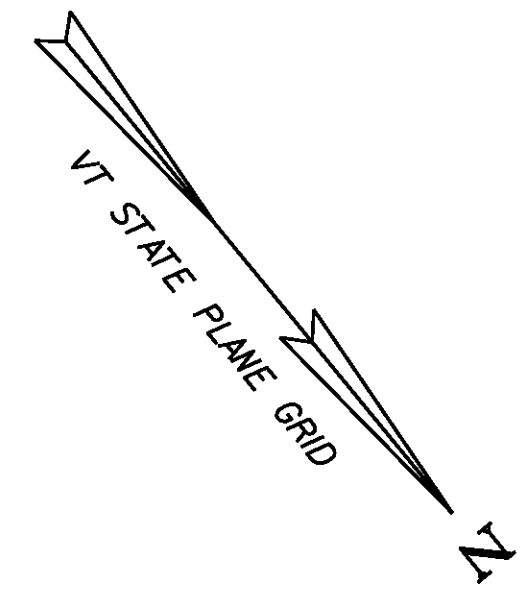

PROJECT NAME:	ROYALTON
PROJECT NUMBER:	BRS 0147 (13)
FILE NAME:	\BR 27\s86e055trfbr_27.dgn
PROJECT LEADER:	C. CARLSON
DESIGNED BY:	D. PETERSON
BRIDGE 27 SIGNS & PAVEMENT MARKINGS (1)	SHEET 29 OF 186
PLOT DATE:	08-OCT-2013
DRAWN BY:	D. PETERSON
CHECKED BY:	C. CARLSON

**DURABLE 4 INCH WHITE LINE**






VT 14 STA 388+00.0 RT - VT 14 STA 393+50.0 RT  
VT 14 STA 388+00.0 LT - VT 14 STA 393+50.0 LT

**DURABLE 4 INCH YELLOW LINE**

VT 14 STA 388+00.0 C - VT 14 STA 393+50.0 C (DOUBLE)

**REMOVING SIGNS**

VT 14 STA 389+63.3 LT  
VT 14 STA 389+74.6 LT  
VT 14 STA 390+86.9 LT  
VT 14 STA 390+98.8 LT

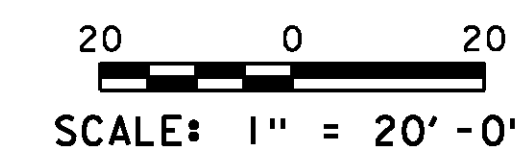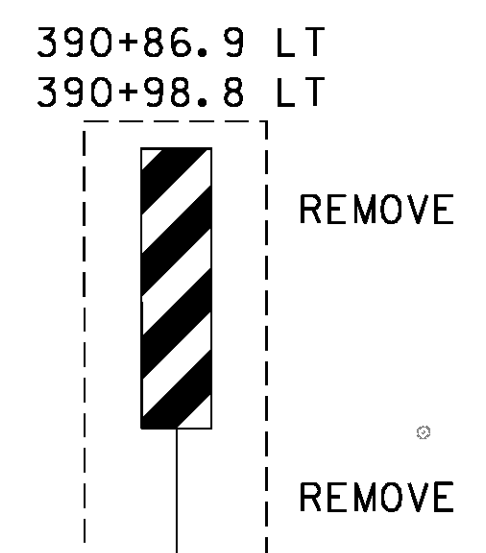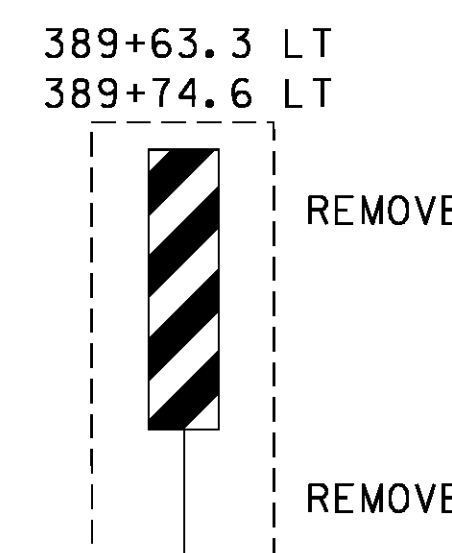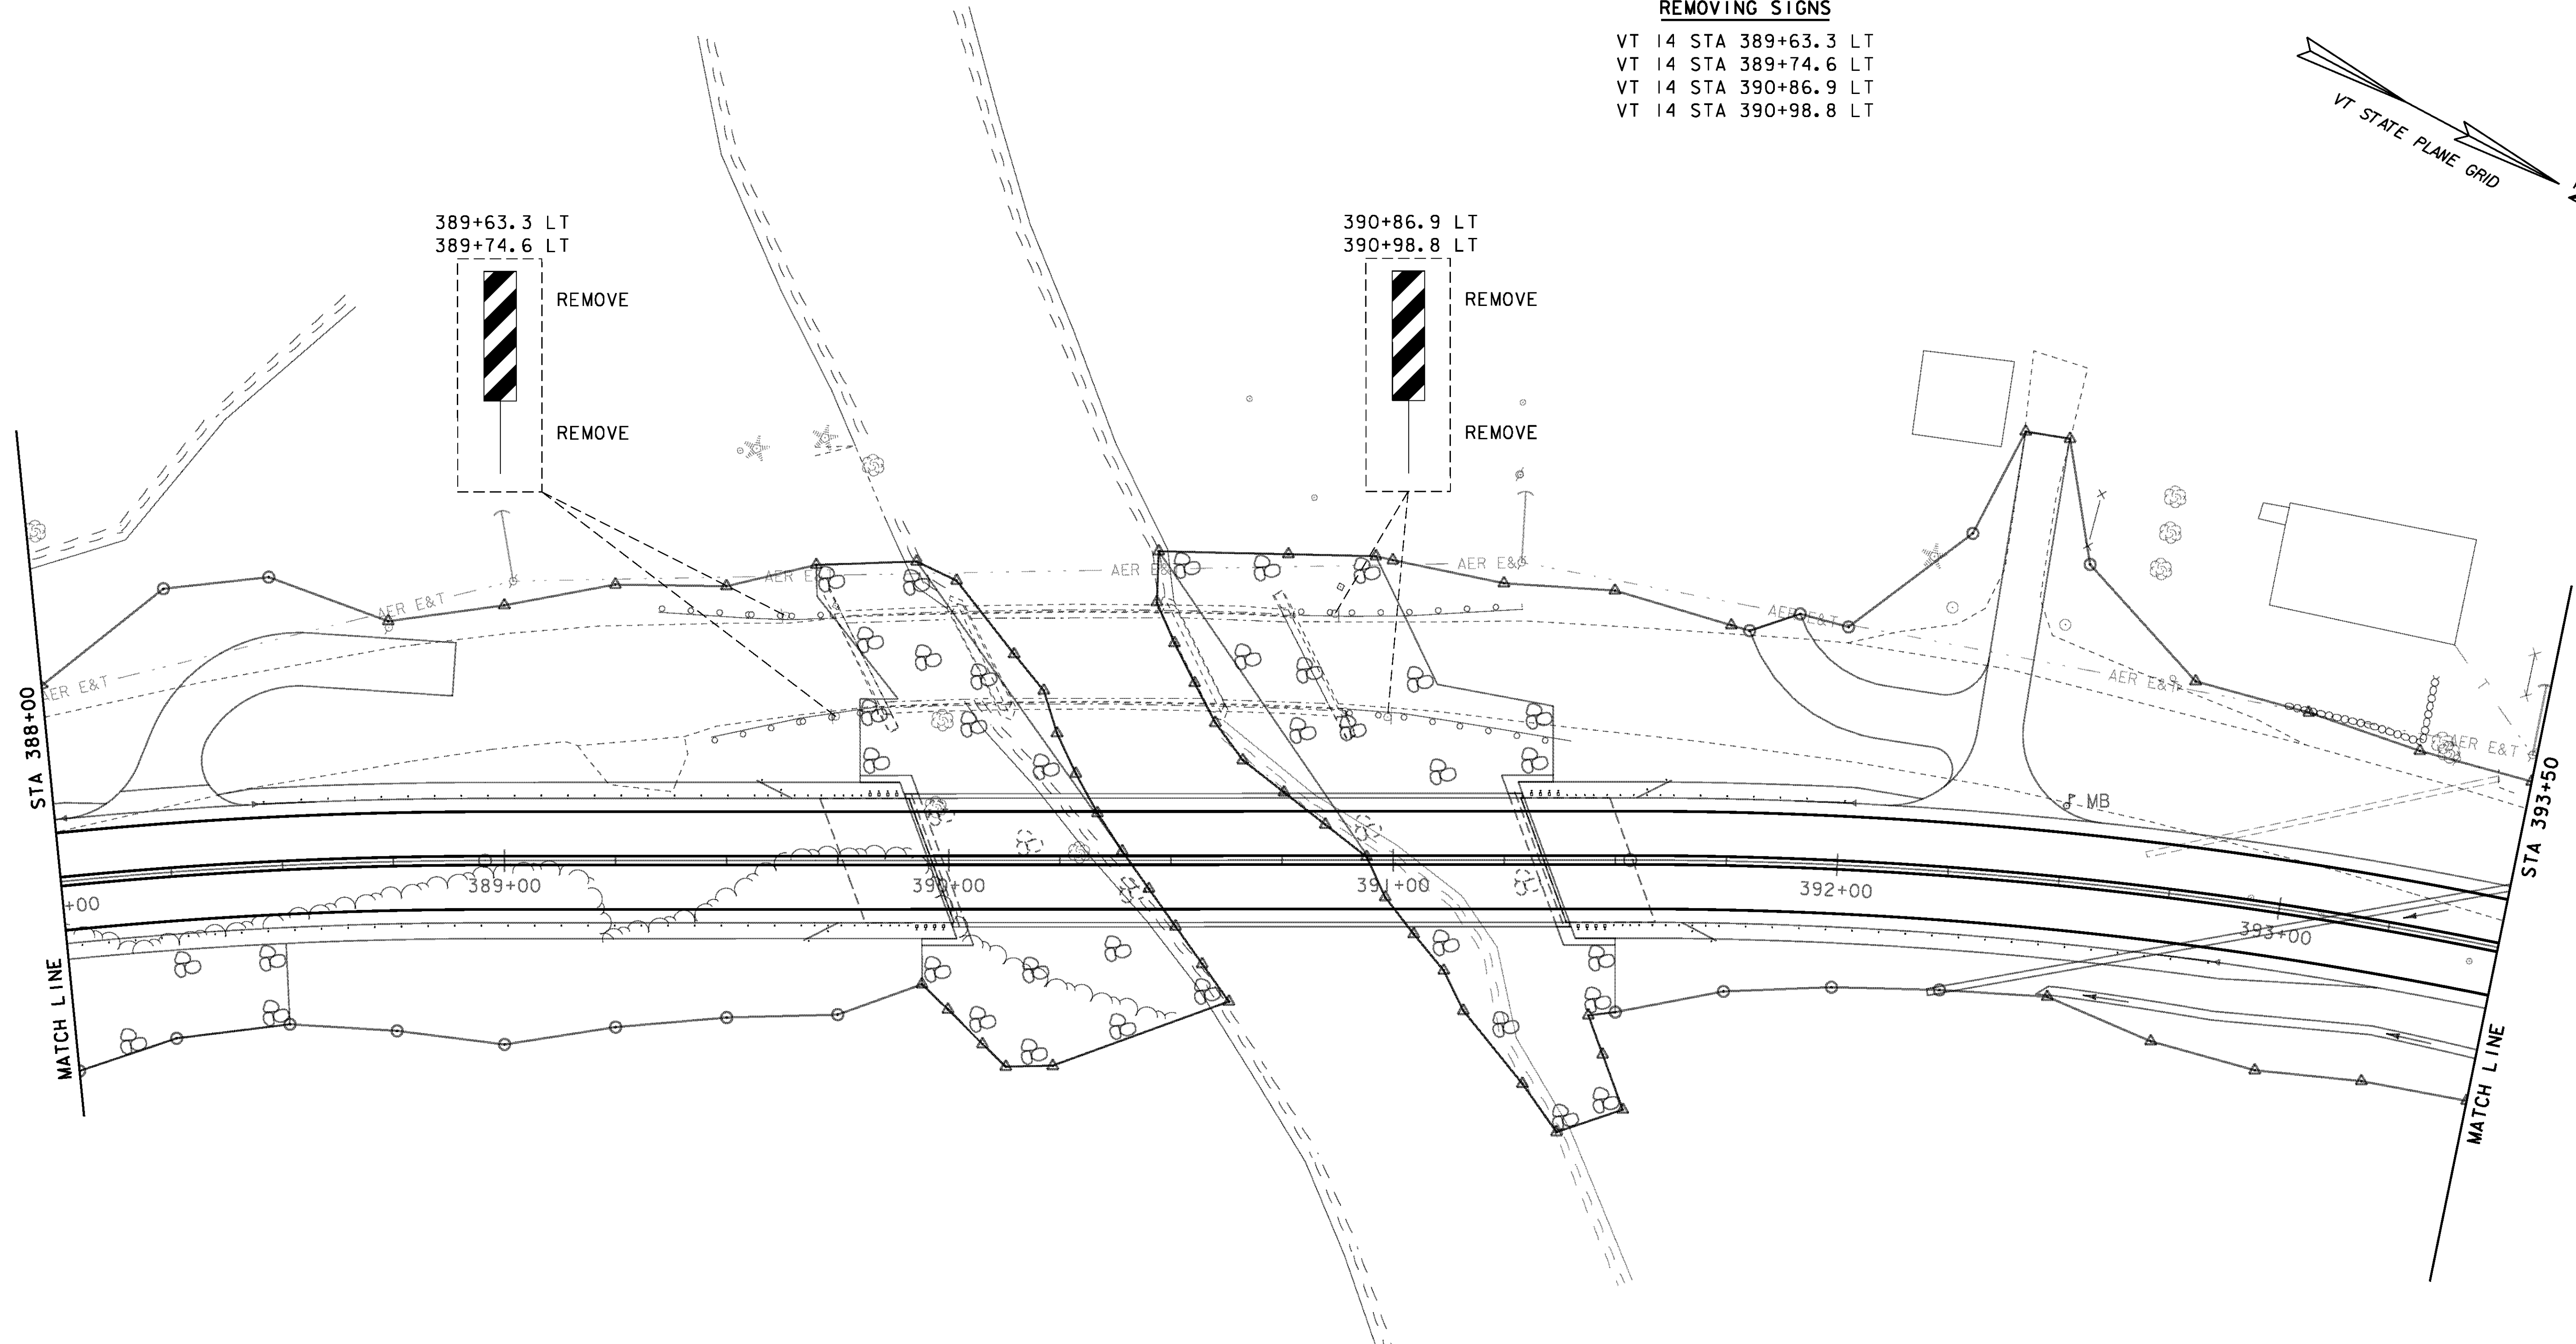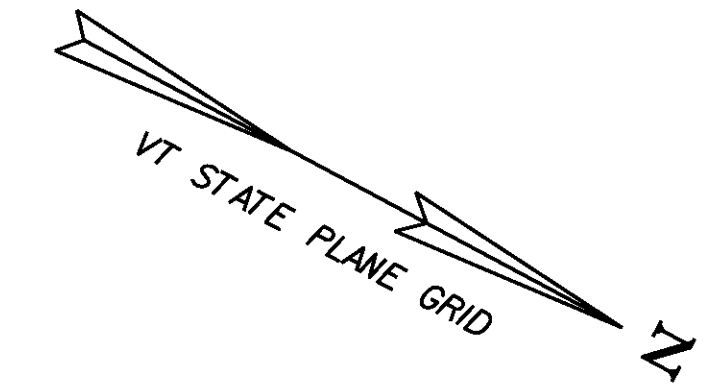

PROJECT NAME:	ROYALTON
PROJECT NUMBER:	BRS 0147 (13)
FILE NAME:	\BR 27\s86e055trfbdr_27.dgn
PROJECT LEADER:	C. CARLSON
DESIGNED BY:	D. PETERSON
BRIDGE 27 SIGNS & PAVEMENT MARKINGS (2)	
PLOT DATE:	08-OCT-2013
DRAWN BY:	D. PETERSON
CHECKED BY:	C. CARLSON
SHEET	30 OF 186

**DURABLE 4 INCH WHITE LINE**




VT 14 STA 393+50.0 RT - VT 14 ~~STA 396+25.0 RT~~  
VT 14 STA 393+50.0 LT - VT 14 ~~STA 396+25.0 LT~~

**DURABLE 4 INCH YELLOW LINE**

VT 14 STA 393+50.0 C - VT 14 STA 396+25.0 C (DOUBLE)

**REMOVING SIGNS**

VT 14 STA 397+00.0 LT

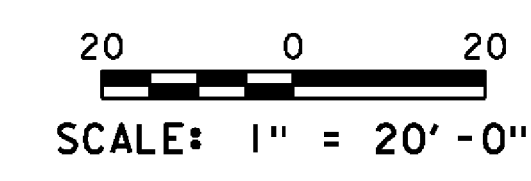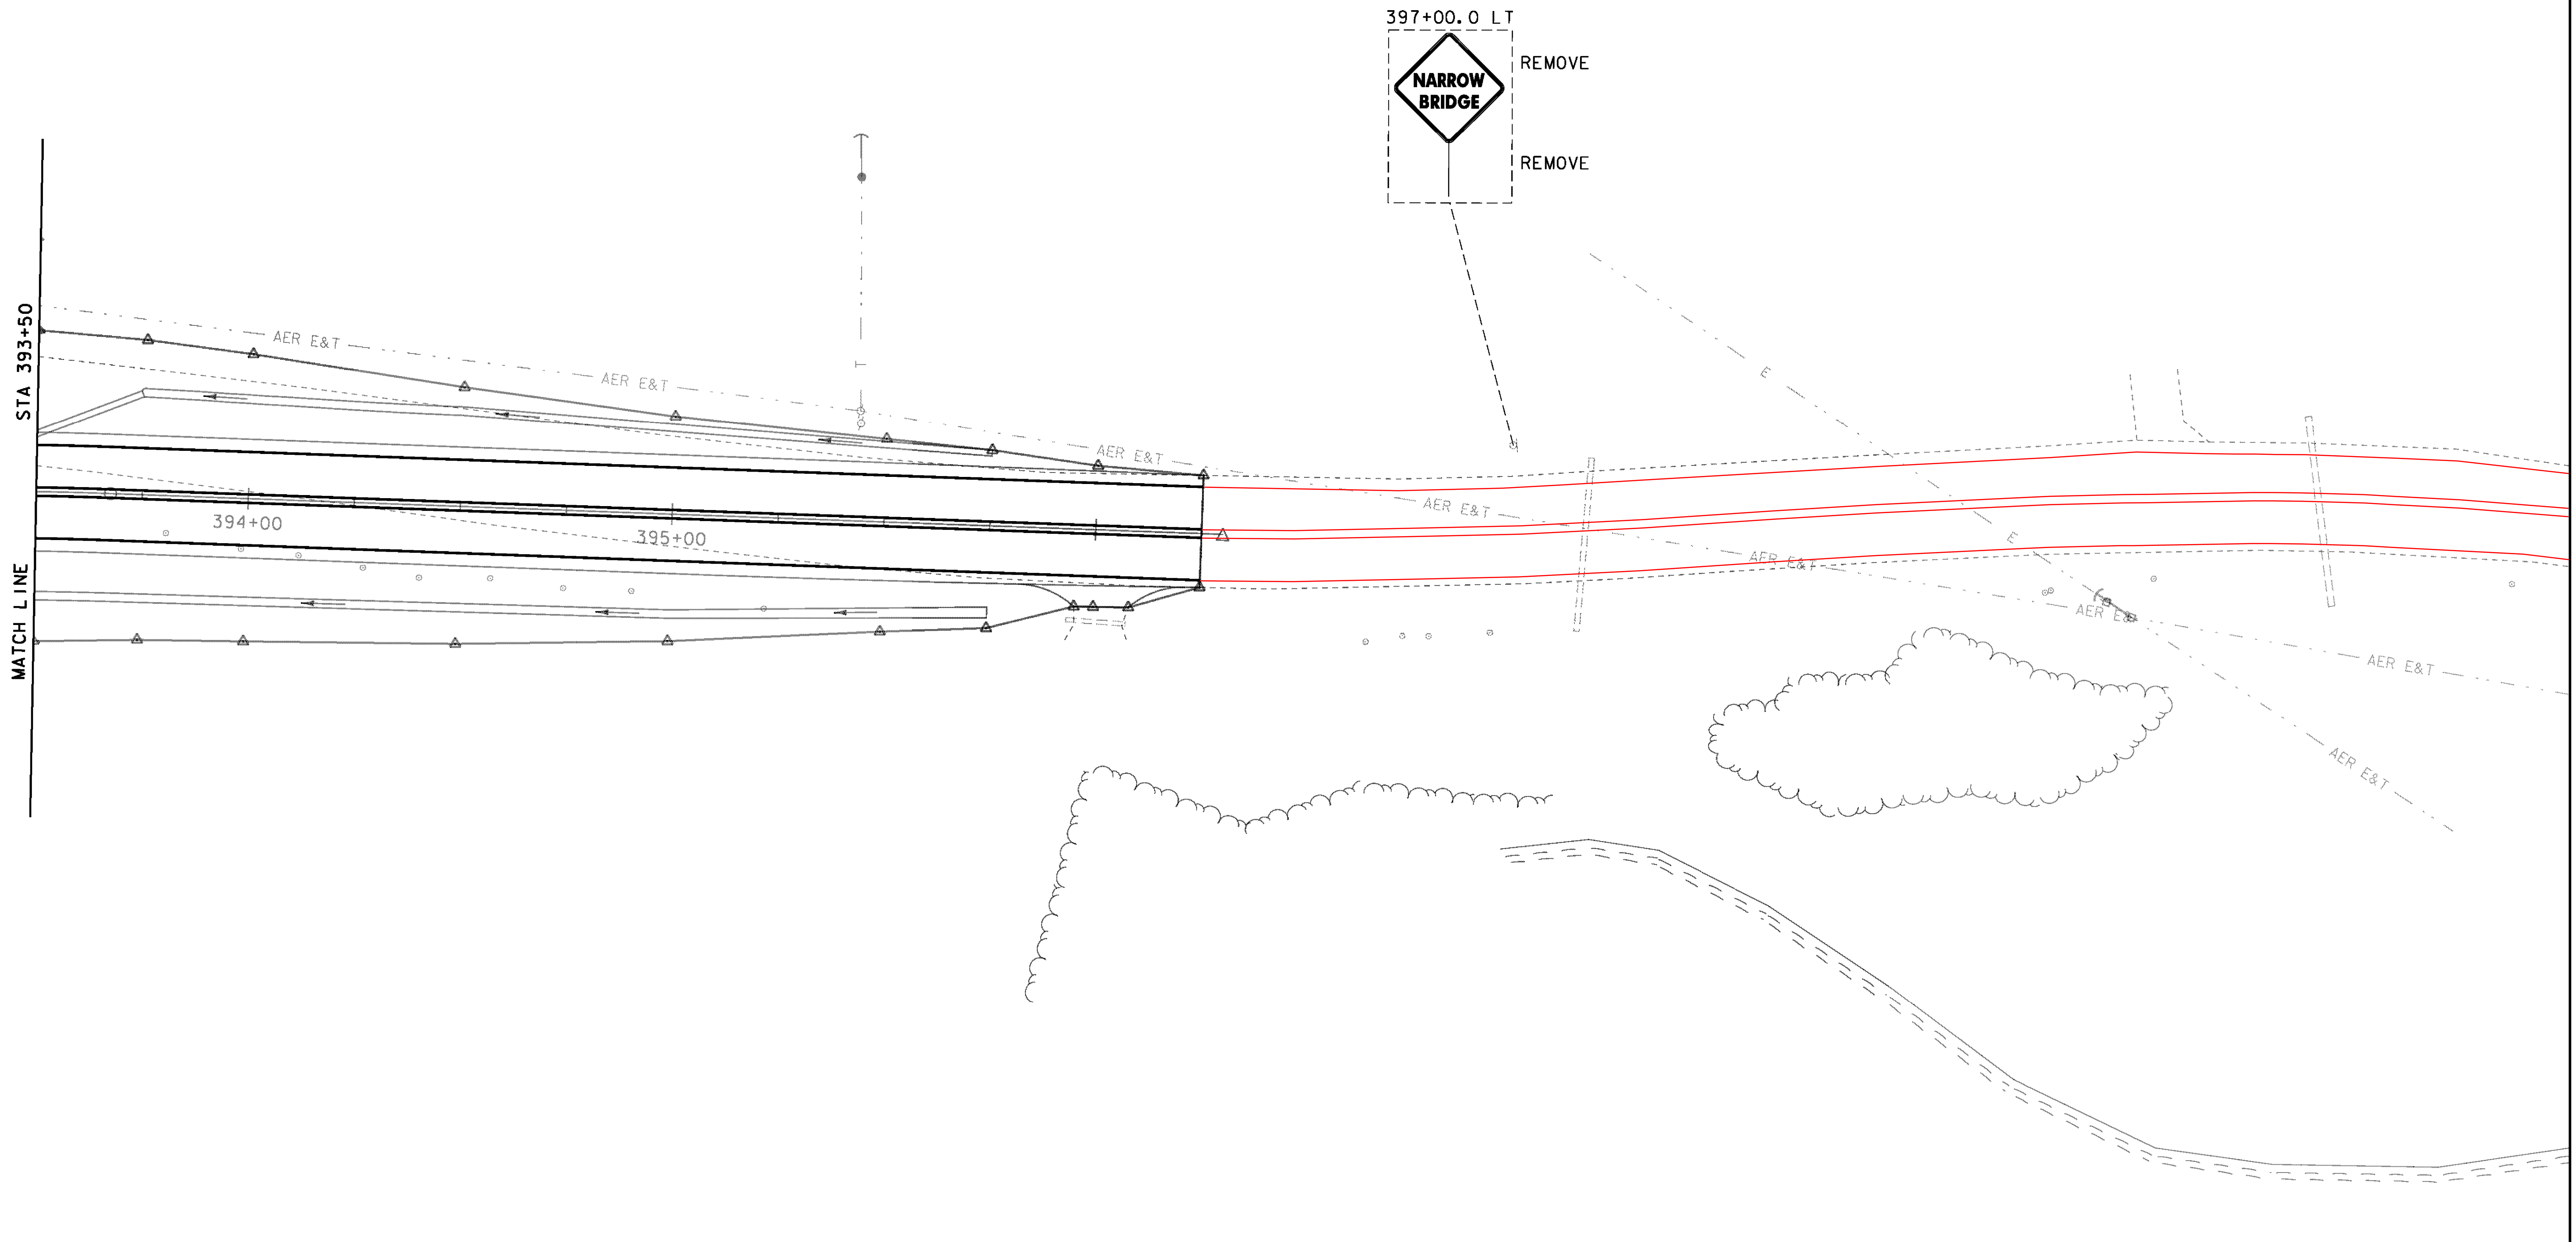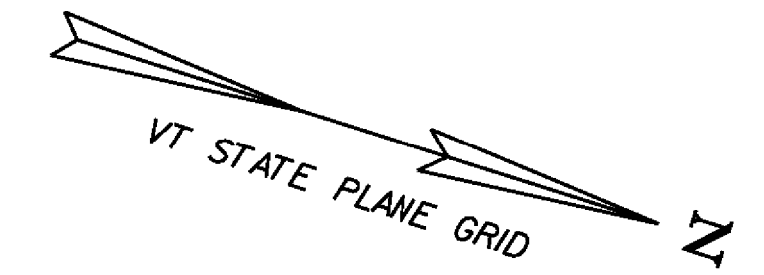

PROJECT NAME:	ROYALTON
PROJECT NUMBER:	BRS 0147 (13)
FILE NAME:	\\BR 27\s86e055\trfbdr_27.dgn
PROJECT LEADER:	C. CARLSON
DESIGNED BY:	D. PETERSON
BRIDGE 27 SIGNS & PAVEMENT MARKINGS (3)	
PLOT DATE:	08-OCT-2013
DRAWN BY:	D. PETERSON
CHECKED BY:	C. CARLSON
SHEET	31 OF 186

**SOIL CLASSIFICATION**

**AASHTO**

A1	Gravel and Sand
A3	Fine Sand
A2	Silty or Clayey Gravel and Sand
A4	Silty Soil - Low Compressibility
A5	Silty Soil - Highly Compressible
A6	Clayey Soil - Low Compressibility
A7	Clayey Soil - Highly Compressible

**ROCK QUALITY DESIGNATION**

R.Q.D. (%)	ROCK DESCRIPTION
<25	Very Poor
25 to 50	Poor
51 to 75	Fair
76 to 90	Good
>90	Excellent

**SHEAR STRENGTH**

UNDRAINED SHEAR STRENGTH IN P.S.F.	CONSISTENCY
<250	Very Soft
250-500	Soft
500-1000	Med. Stiff
1000-2000	Stiff
2000-4000	Very Stiff
>4000	Hard


**CORRELATION GUIDE OF "N" TO DENSITY/CONSISTENCY**

DENSITY (GRANULAR SOILS)		CONSISTENCY (COHESIVE SOILS)	
N	DESCRIPTIVE TERM	N	DESCRIPTIVE TERM
<5	Very Loose	<2	Very Soft
5-10	Loose	2-4	Soft
11-24	Med. Dense	5-8	Med. Stiff
25-50	Dense	9-15	Stiff
>50	Very Dense	16-30	Very Stiff
		31-60	Hard
		>60	Very Hard

**COMMONLY USED SYMBOLS**

- ▼ Water Elevation
- ⊕ Standard Penetration Boring
- ⊙ Auger Boring
- Rod Sounding
- S Sample
- N Standard Penetration Test
- Blow Count Per Foot For:
  - 2" O.D. Sampler
  - 1 3/8" I.D. Sampler
  - Hammer Weight Of 140 Lbs.
  - Hammer Fall Of 30"
- VS Field Vane Shear Test
- US Undisturbed Soil Sample
- B Blast
- DC Diamond Core
- MD Mud Drill
- WA Wash Ahead
- HSA Hollow Stem Auger
- AX Core Size 1 1/8"
- BX Core Size 1 3/8"
- NX Core Size 2 1/8"
- M Double Tube Core Barrel Used
- LL Liquid Limit
- PL Plastic Limit
- PI Plasticity Index
- NP Non Plastic
- w Moisture Content (Dry Wgt. Basis)
- D Dry
- M Moist
- MTW Moist To Wet
- W Wet
- Sat Saturated
- Bo Boulder
- Gr Gravel
- Sa Sand
- Sl Silt
- Cl Clay
- HP Hardpan
- Le Ledge
- NLTD No Ledge To Depth
- CNPF Can Not Penetrate Further
- TLOB To Ledge Or Boulder
- NR No Recovery
- Rec. Recovery
- %Rec. Percent Recovery
- RQD Rock Quality Designation
- CBR California Bearing Ratio
- < Less Than
- > Greater Than
- R Refusal (N > 100)

COLOR			
blk	Black	pnk	Pink
bl	Blue	pu	Purple
brn	Brown	rd	Red
dk	Dark	tn	Tan
gry	Gray	wh	White
gn	Green	yel	Yellow
lt	Light	mltc	Multicolored
or	Orange		

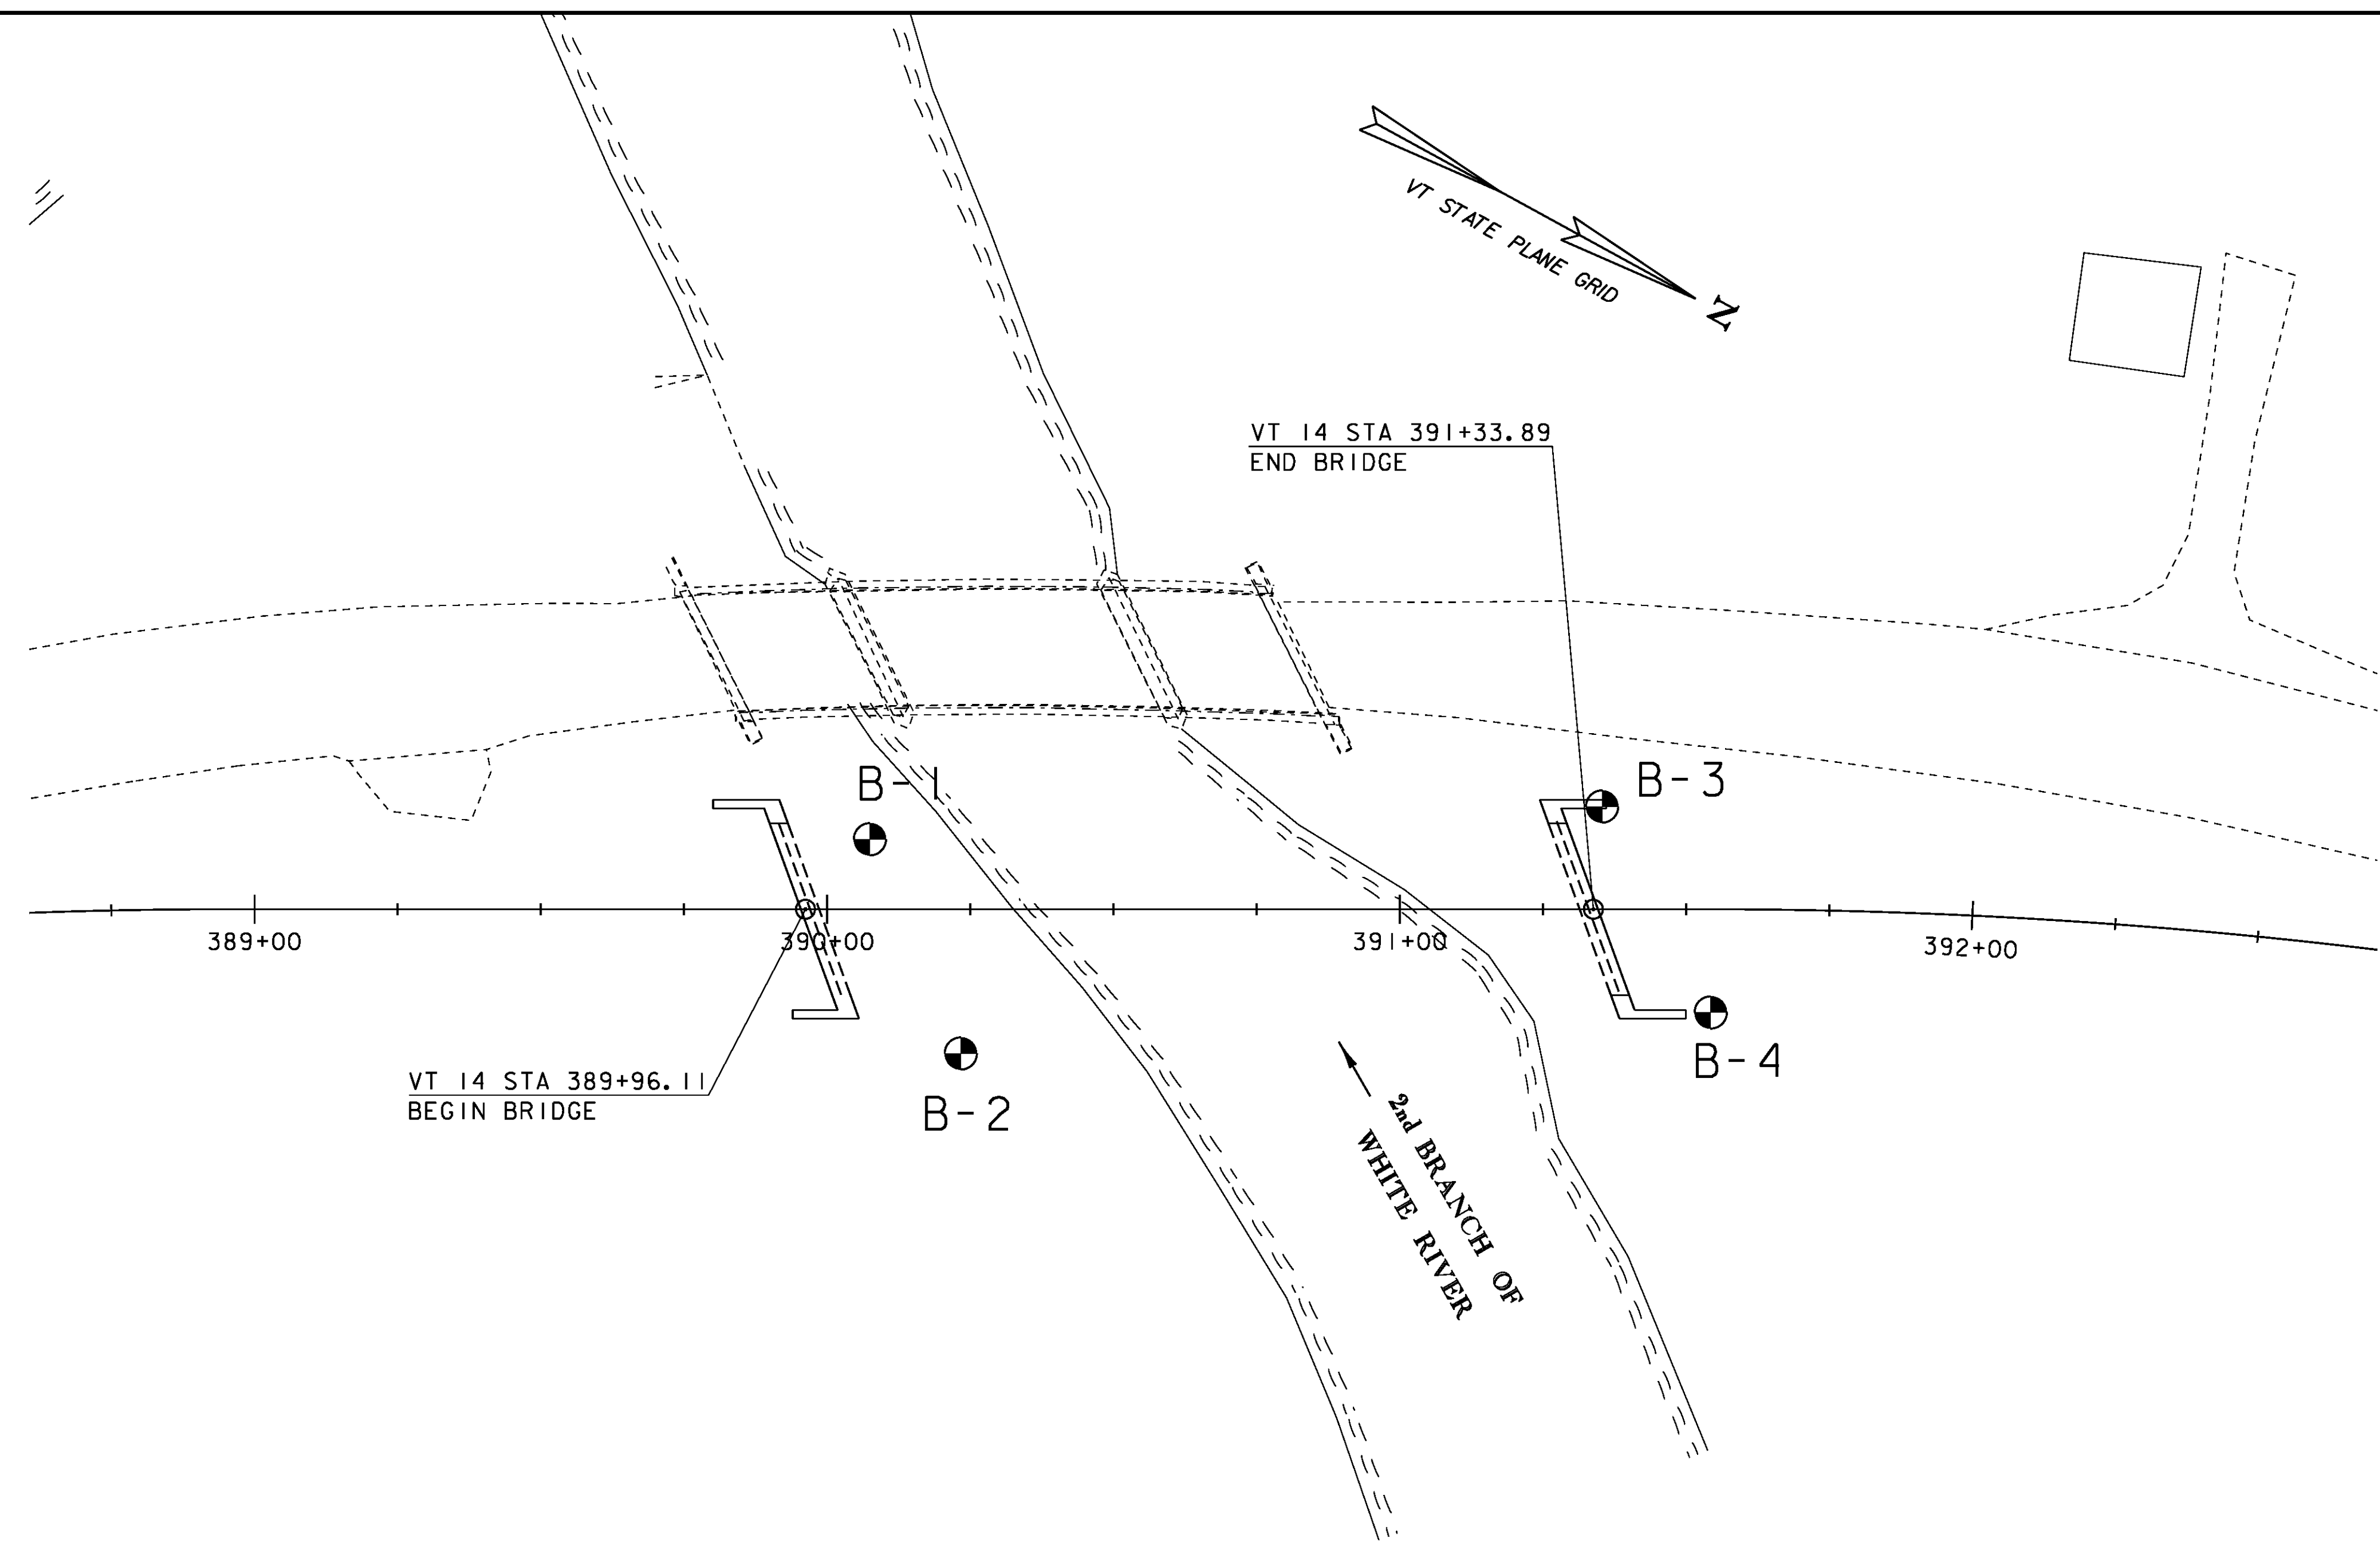


**BORING CHART**

HOLE NO.	STATION	OFFSET	GROUND ELEVATION	ELEV. TLOB	NORTHING	EASTING
B1	390+07.45	12.22' LT	499.35	444.35	489163.25	1617280.25
B2	390+23.33	25.18' RT	499.94	439.34	489194.90	1617845.74
B3	391+35.32	17.94' LT	504.61	448.61	489273.33	1617754.92
B4	391+54.31	18.02' RT	505.36	446.36	489307.02	1617777.69

**GENERAL NOTES**

- The subsurface explorations shown herein were made between 01/17/1992 and 01/31/1992 by the Agency.
- Soil and rock classifications, properties and descriptions are based on engineering interpretation from available subsurface information by the Agency and may not necessarily reflect actual variations in subsurface conditions that may be encountered between individual boring or sample locations.
- Observed water levels and/or conditions indicated are as recorded at the time of exploration and may vary according to the prevailing rainfall, methods of exploration and other factors.
- Engineering judgement was exercised in preparing the subsurface information presented herein. Analysis and interpretation of subsurface data was performed and interpreted for Agency design and estimating purposes. Presentation of the information in the Contract is intended to provide the Contractor access to the same data available to the Agency. The subsurface information is presented in good faith and is not intended as a substitute for personal investigation, independent interpretation, independent analysis or judgement by the Contractor.
- Pictorial structure details shown on the boring plan layout or soils profile are for illustrative purposes only and may not accurately portray final contract details.
- Terminology used on boring logs to describe the hardness, degree of weathering, and spacing of fractures, joints and other discontinuities in the bedrock is defined in the AASHTO Manual on Subsurface Investigations, 1988.

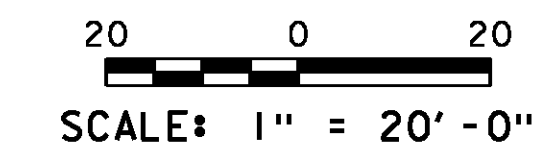

**DEFINITIONS (AASHTO)**

- BEDROCK (LEDGE)** - Rock in its native location of indefinite thickness.
- BOULDER** - A rock fragment with an average dimension > 12 inches.
- COBBLE** - Rock fragments with an average dimension between 3 and 12 inches.
- GRAVEL** - Rounded particles of rock < 3" and > 0.075" (#10 sieve).
- SAND** - Particles of rock < 0.075" (#10 sieve) and > 0.0025" (#200 sieve).
- SILT** - Soil < 0.0025" (#200 sieve), non or slightly plastic and exhibits no strength when air-dried.
- CLAY** - Fine grained soil, exhibits plasticity when moist and considerable strength when air-dried.
- VARVED** - Alternate layers of silt and clay.
- HARDPAN** - Extremely dense soil, cemented layer, not softened when wet.
- MUCK** - Soft organic soil (containing > 10% organic material).
- MOISTURE CONTENT** - Weight of water divided by dry weight of soil.
- FLOWING SAND** - Granular soil so saturated (loose) that it flows into drill casing during extraction of wash rod.
- STRIKE** - Angle from magnetic north to line of intersection of bed with a horizontal plane.
- DIP** - Inclination of bed with a horizontal plane.

PROJECT NAME: ROYALTON  
PROJECT NUMBER: BRS 0147 (13)

FILE NAME: \BR 27\s86e055bor_27.dgn  
PROJECT LEADER: C. CARLSON  
DESIGNED BY: D. PETERSON  
BRIDGE 27 BORING LAYOUT

PLOT DATE: 08-OCT-2013  
DRAWN BY: G. ROY  
CHECKED BY: D. PETERSON  
SHEET 32 OF 186





STATE OF VERMONT  
AGENCY OF TRANSPORTATION  
MATERIALS & RESEARCH SECTION  
SUBSURFACE INFORMATION

BORING NUMBER: B-1  
SHEET 1 of 1  
DATE STARTED: 1/30/92  
DATE COMPLETED: 1/31/92

PROJECT NAME: ROYALTON  
SITE NAME: BR-27 & BR-28  
STATION: 390+07.45  
OFFSET: -12.22  
VTSPG: N 489163.25 ft E 1617280.25 ft

PROJECT NUMBER: BRS 0147(13)  
SITE NUMBER: RT 14  
GROUND ELEVATION: 499.35 ft  
GROUNDWATER DEPTH: 4.3 ft  
PROJECT PIN NUMBER: 86E055

BORING CREW  
CREW CHIEF: McGLYNN  
DRILLER: WILLIS  
LOGGER: FELCH

BORING RIG:  
BORING TYPE: WASH BORE  
SAMPLE TYPE: SPLIT BARREL  
CHECKED BY: CCB

BOT.  
ABUT. #1  
EL. 502.00

DEPTH (ft)	SYMBOL	CLASSIFICATION OF MATERIALS (Description)	BLOWS PER FOOT	M.C. (%)	GRAVEL (%)	SAND (%)	FINES (%)
			RUN	REC (%)	RQD (%)	Dip (deg)	Drill Rate (min/ft)
5.0 - 7.0		No Recovery, 5.0 ft - 7.0 ft	2				
10		A-2-4, Sa, gry, Wet, Rec. = 1.2 ft	10	24.7			
		A-2-4, Sa, gry, Wet, Rec. = 1.6 ft	32	27.4			
20		A-2-4, Sa, gry, Wet, Rec. = 1.0 ft	24	11.9			
25.0 - 27.0		Boulders, No recovery, 25.0 ft - 27.0 ft	60				
30.0 - 32.0		Boulders, No recovery, 30.0 ft - 32.0 ft	49				
		A-1-a, SaGr, gry, Wet, Rec. = 0.5 ft	44	8.1			
40		A-1-a, SaGr, gry, Wet, Rec. = 1.0 ft	57	16.0			
		A-4, GrSiSa, gry, Wet, Rec. = 1.0 ft	24	13.2			
50.0 - 52.0		Boulders, No Recovery, 50.0 ft - 52.0 ft	R				
55.0 - 55.5		Possible Bedrock, No recovery, 55.0 ft - 55.5 ft	R				
60		Core consists of gray and light gray phyllite and schist. Phyllite is the dominant lithology. The core is moderately soft, unweathered, and competent., BXDC, 60.1 ft - 64.6 ft, Rec. = 4.5 ft	1	100	51	25	
		Same as Run #1, BXMDC, 64.6 ft - 69.6 ft, Rec. = 4.5 ft	2	90	36	25	
70		Hole stopped @ 69.6 ft					

LOG OF BORING ROYALTON BRS 0147(13).GPJ VT_ADT.GDT 12/13/06

APPROX.  
PILE TIP



STATE OF VERMONT  
AGENCY OF TRANSPORTATION  
MATERIALS & RESEARCH SECTION  
SUBSURFACE INFORMATION

BORING NUMBER: B-2  
SHEET 1 of 1  
DATE STARTED: 1/30/92  
DATE COMPLETED: 1/31/92

PROJECT NAME: ROYALTON  
SITE NAME: BR-27 & BR-28  
STATION: 390+23.33  
OFFSET: 25.18  
VTSPG: N 489194.90 ft E 1617845.74 ft

PROJECT NUMBER: BRS 0147(13)  
SITE NUMBER: RT 14  
GROUND ELEVATION: 499.94 ft  
GROUNDWATER DEPTH: 4.2 ft  
PROJECT PIN NUMBER: 86E055

BORING CREW  
CREW CHIEF: McGLYNN  
DRILLER: WILLIS  
LOGGER: FELCH

BORING RIG:  
BORING TYPE: WASH BORE  
SAMPLE TYPE: SPLIT BARREL  
CHECKED BY: CCB

BOT.  
ABUT. #1  
EL. 502.00

DEPTH (ft)	SYMBOL	CLASSIFICATION OF MATERIALS (Description)	BLOWS PER FOOT	M.C. (%)	GRAVEL (%)	SAND (%)	FINES (%)
			RUN	REC (%)	RQD (%)	Dip (deg)	Drill Rate (min/ft)
10		A-4, SaSi, brn, Moist, Rec. = 1.0 ft	4	51.6			
		Wood, 10.0 ft - 12.0 ft					
		A-2-4, Sa, gry, Wet, Rec. = 0.8 ft	14	21.5			
20		A-2-4, SiSa, gry, Wet, Rec. = 0.9 ft	17	29.0			
		A-4, SiSa, gry, Wet, Rec. = 1.0 ft	15	26.6			
30		A-2-4, Sa, gry, Wet, Rec. = 1.3 ft	27	19.4			
		A-1-b, Sa, gry, Wet, Rec. = 0.8 ft	27	12.3			
40		A-2-4, SiGrSa, gry, Wet, Rec. = 0.6 ft	58	12.9			
		No recovery, 45.0 ft - 47.0 ft	37				
50		No recovery, 50.0 ft - 52.0 ft	25				
		A-1-b, Sa, gry, Wet, Rec. = 0.5 ft	28	13.5			
60		No recovery, 60.0 ft - 60.6 ft	R				
		Same as Run #2, BX, 60.6 ft - 62.6 ft, Rec. = 1.2 ft	1				
		Core consists of gray and light gray interbedded phyllite and schist. The rock is moderately soft, slightly weathered on widely spaced fractures and competent overall., BXMDC, 62.6 ft - 67.6 ft, Rec. = 5.0 ft	2	100	65	45	
		Same as Run #2, BXMDC, 67.6 ft - 71.6 ft, Rec. = 3.2 ft	3	80	38	45	
70		Hole stopped @ 71.6 ft					

LOG OF BORING ROYALTON BRS 0147(13).GPJ VT_ADT.GDT 12/13/06

APPROX.  
PILE TIP

PROJECT NAME: ROYALTON  
PROJECT NUMBER: BRS 0147 (13)  
FILE NAME: \BR 27\86e055bor_27.dgn  
PROJECT LEADER: C. CARLSON  
DESIGNED BY: D. PETERSON  
BRIDGE 27 BORING LOGS (1)

PLOT DATE: 08-OCT-2013  
DRAWN BY: C. MOONEY  
CHECKED BY: G. ROY  
SHEET 33 OF 186



STATE OF VERMONT  
AGENCY OF TRANSPORTATION  
MATERIALS & RESEARCH SECTION  
SUBSURFACE INFORMATION

BORING NUMBER: B-3  
SHEET 1 of 1  
DATE STARTED: 1/24/92  
DATE COMPLETED: 1/28/92

PROJECT NAME: ROYALTON  
SITE NAME: BR-27 & BR-28  
STATION: 391+35.32  
OFFSET: -17.94  
VTSPG: N 489273.33 ft E 1617754.92 ft

PROJECT NUMBER: BRS 0147(13)  
SITE NUMBER: RT 14  
GROUND ELEVATION: 504.61 ft  
GROUNDWATER DEPTH: 13.1 ft  
PROJECT PIN NUMBER: 86E055

BORING CREW  
CREW CHIEF: McGLYNN  
DRILLER: WILLIS  
LOGGER: FELCH

BORING RIG:  
BORING TYPE: WASH BORE  
SAMPLE TYPE: SPLIT BARREL  
CHECKED BY: CCB

DEPTH (ft)	SYMBOL	CLASSIFICATION OF MATERIALS (Description)	BLOWS PER FOOT	M.C. (%)	GRAVEL (%)	SAND (%)	FINES (%)
			RUN	REC (%)	RQD (%)	Dip (deg)	Drill Rate (min/ft)
10		A-3, Sa, gry, Moist, Rec. = 1.3 ft	7	31.2			
10		A-3, Sa, gry, Moist, Rec. = 0.8 ft	2	29.5			
10		A-2-4, Sa, gry, Moist, Rec. = 1.4 ft	17	21.6			
20		A-2-4, Sa, gry, Moist, Rec. = 1.0 ft	17	18.6			
20		A-2-4, Sa, gry, Moist, Rec. = 1.2 ft	22	19.9			
30		A-2-4, SiSa, gry, Moist, Rec. = 1.0 ft	32	22.9			
30		A-1-a, SaGr, gry, Moist, Rec. = 0.5 ft	72	9.4			
40		A-1-a, SaGr, gry, Moist, Rec. = 1.0 ft	63	7.5			
40		Boulders, No recovery, 45.0 ft - 47.0 ft	82				
50		A-1-a, Gr, gry, Wet	63	8.2			
50		Field Note: Gravel or soft ledge, BXDC, Rec. = 1.4					
50		Top of Bedrock @ 56.0 ft	96	39	20		
60		Core consists of gray and light gray interbedded schist and phyllite. The rock is moderately soft, unweathered, and competent overall., BXMDC, 56.0 ft - 61.0 ft, Rec. = 4.8 ft	2	84	64	20	
60		Same as Run #1, BXMDC, 61.0 ft - 66.0 ft, Rec. = 4.2 ft					
70		Hole stopped @ 66.0 ft					

BOT.  
ABUT. #2  
EL. 500.00

APPROX.  
PILE TIP

LOG OF BORING ROYALTON BRS 0147(13) GPJ VT AOT.GOT 12/13/06



STATE OF VERMONT  
AGENCY OF TRANSPORTATION  
MATERIALS & RESEARCH SECTION  
SUBSURFACE INFORMATION

BORING NUMBER: B-4  
SHEET 1 of 1  
DATE STARTED: 1/17/92  
DATE COMPLETED: 1/21/92

PROJECT NAME: ROYALTON  
SITE NAME: BR-27 & BR-28  
STATION: 391+54.31  
OFFSET: 18.02  
VTSPG: N 489307.02 ft E 1617777.69 ft

PROJECT NUMBER: BRS 0147(13)  
SITE NUMBER: RT 14  
GROUND ELEVATION: 505.36 ft  
GROUNDWATER DEPTH: 12.6 ft  
PROJECT PIN NUMBER: 86E055

BORING CREW  
CREW CHIEF: McGLYNN  
DRILLER: WILLIS  
LOGGER: FELCH

BORING RIG:  
BORING TYPE: WASH BORE  
SAMPLE TYPE: SPLIT BARREL  
CHECKED BY: CCB

DEPTH (ft)	SYMBOL	CLASSIFICATION OF MATERIALS (Description)	BLOWS PER FOOT	M.C. (%)	GRAVEL (%)	SAND (%)	FINES (%)
			RUN	REC (%)	RQD (%)	Dip (deg)	Drill Rate (min/ft)
10		A-4, SaSi, brn, Moist, Rec. = 2.0 ft	14	27.8			
10		A-2-4, SiSa, brn, Moist, Rec. = 1.5 ft	8	29.2			
10		A-4, SiSa, brn, Moist, Rec. = 1.0 ft	8	26.7			
10		A-2-4, SiSa, brn, Moist, Rec. = 1.0 ft	4	15.6			
10		A-1-b, GrSa, gry, Moist, Rec. = 0.7 ft	8	15.9			
10		A-2-4, GrSiSa, gry, Moist, Rec. = 1.0 ft	8	23.8			
20		A-4, SaSi, gry, Wet, Rec. = 1.4 ft	9	26.4			
20		A-4, SaSi, gry, Wet, Rec. = 1.3 ft	11	26.3			
20		A-4, SiSa, gry, Wet, Rec. = 1.0 ft	10	22.5			
20		A-4, SiSa, gry, Wet, Rec. = 0.8 ft	11	27.1			
20		A-2-4, Sa, gry, Wet, Rec. = 0.9 ft	9	23.3			
20		A-2-4, Sa, gry, Wet, Rec. = 0.8 ft	17	24.3			
20		A-2-4, SiSa, gry, Wet, Rec. = 1.9 ft	16	19.9			
20		A-2-4, SiSa, gry, Wet, Rec. = 1.0 ft	25	22.2			
30		A-2-4, SiSa, gry, Wet, Rec. = 0.9 ft	13	24.3			
30		A-2-4, SiSa, gry, Wet, Rec. = 1.0 ft	13	19.4			
30		A-2-4, Sa, gry, Wet, Rec. = 1.0 ft	18	20.3			
30		A-2-4, SiSa, gry, Wet, Rec. = 1.0 ft	27	16.6			
30		A-2-4, Sa, gry, Wet, Rec. = 1.2 ft	34	20.7			
30		A-2-4, Sa, gry, Wet, Rec. = 1.1 ft	28	22.4			
30		A-2-4, SiSa, gry, Wet, Rec. = 1.5 ft	9	19.0			
40		A-2-4, Sa, gry, Wet, Rec. = 1.3 ft	48	12.4			
50		A-1-a, Gr, gry, Wet, Rec. = 0.8 ft	32	3.6			
50		A-1-a, SaGr, gry, Wet, Rec. = 0.4 ft	22	8.4			
50		Top of Bedrock @ 59.0 ft					
60		Core consists of interbedded gray and light gray phyllite and schist. The rock is moderately soft, slightly weathered, and competent overall., BXDC, 59.0 ft - 64.0 ft, Rec. = 2.8 ft	1	56	0	20	
60		Same as Run #1, AXDC, 64.0 ft - 69.0 ft, Rec. = 1.9 ft	2	38	0	20	
70		Same as Run #1, AXDC, 69.0 ft - 74.0 ft, Rec. = 3.0 ft	3	60	0	20	
70		Hole stopped @ 74.0 ft					


BOT.  
ABUT. #2  
EL. 500.00

APPROX.  
PILE TIP

LOG OF BORING ROYALTON BRS 0147(13) GPJ VT AOT.GOT 12/13/06


PROJECT NAME: ROYALTON  
PROJECT NUMBER: BRS 0147 (13)

FILE NAME: \BR 27\86e055bor_27.dgn PLOT DATE: 08-OCT-2013  
PROJECT LEADER: C. CARLSON DRAWN BY: C. MOONEY  
DESIGNED BY: D. PETERSON CHECKED BY: G. ROY  
BRIDGE 27 BORING LOGS (2) SHEET 34 OF 186

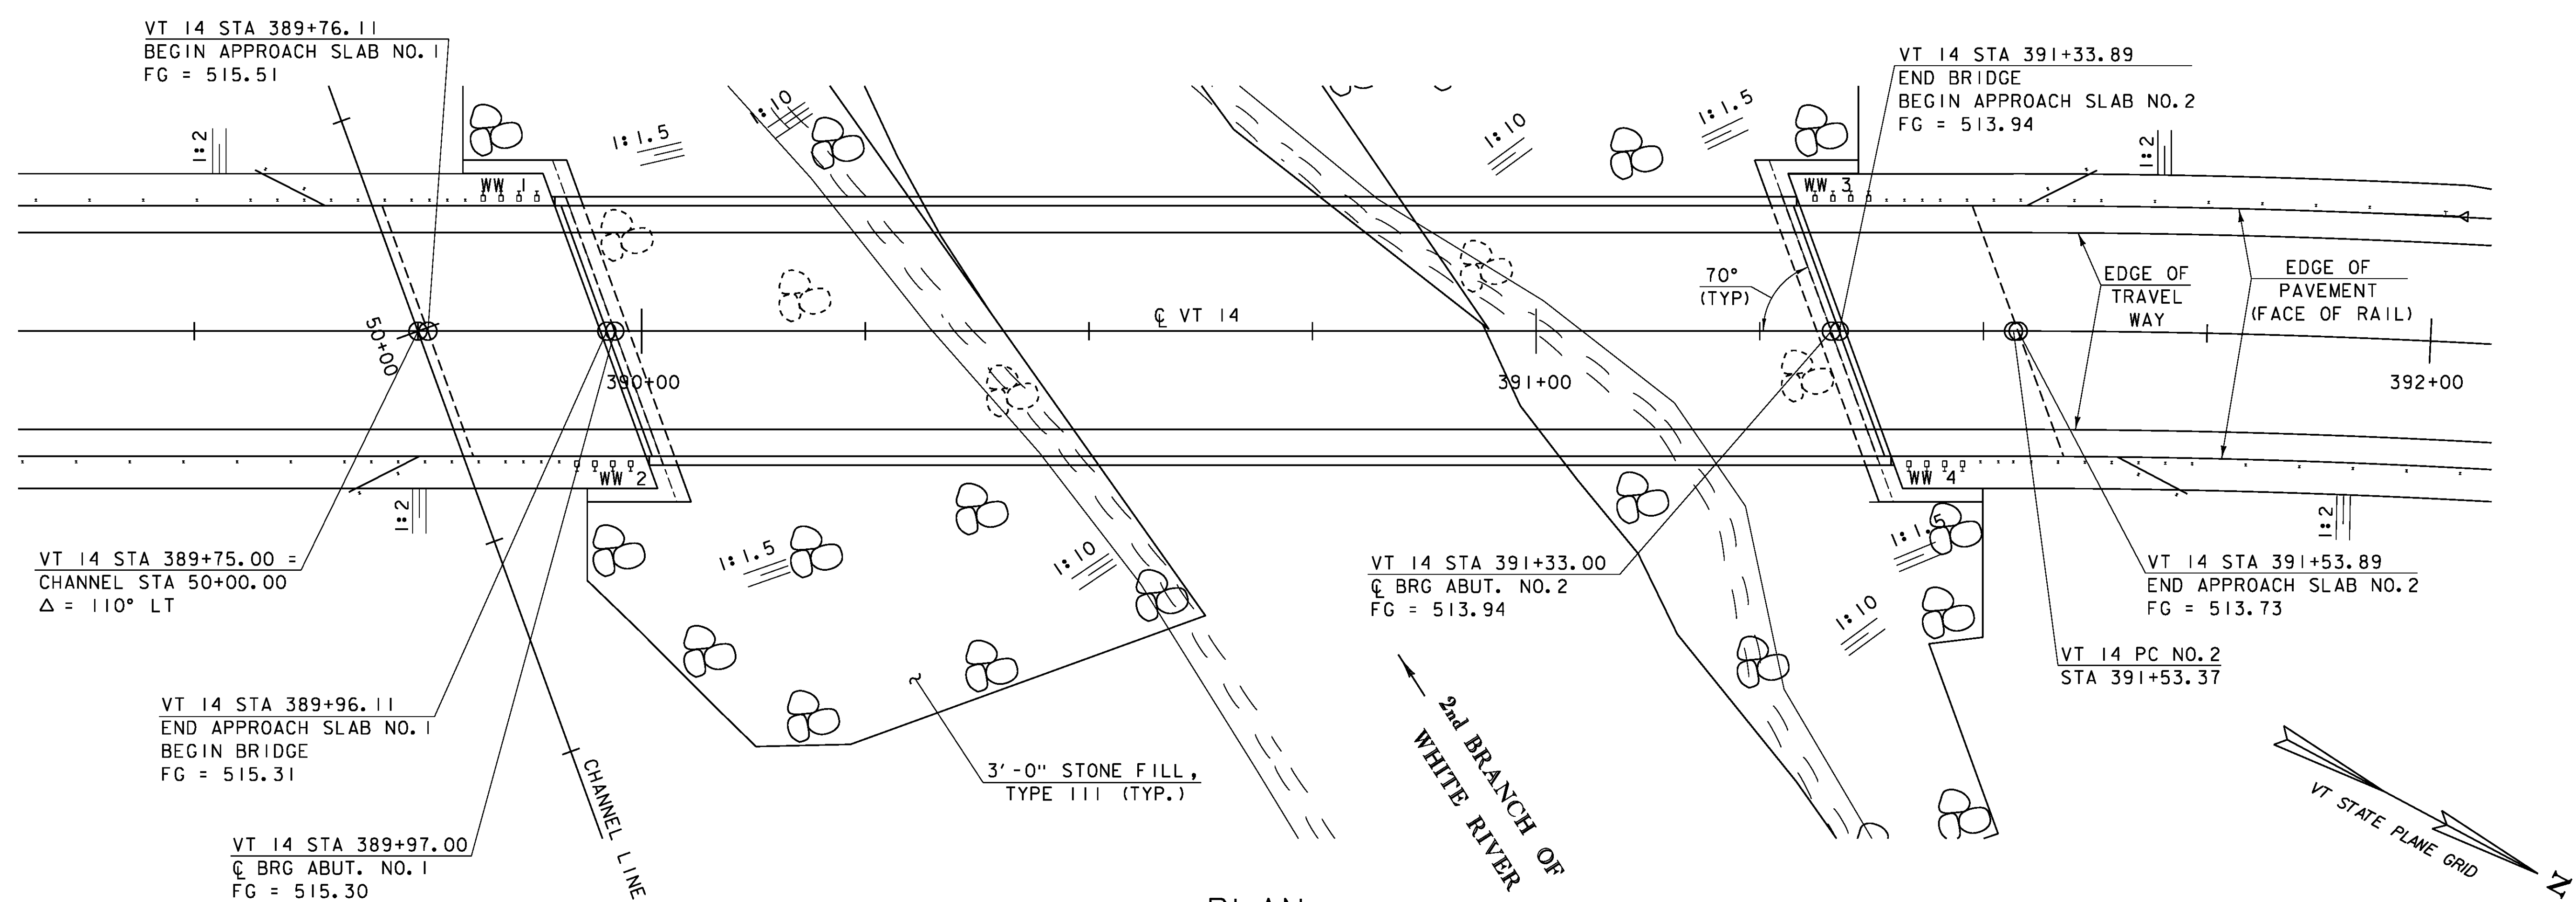

PLAN


SCALE 1" = 10'-0"  
 10 0 10

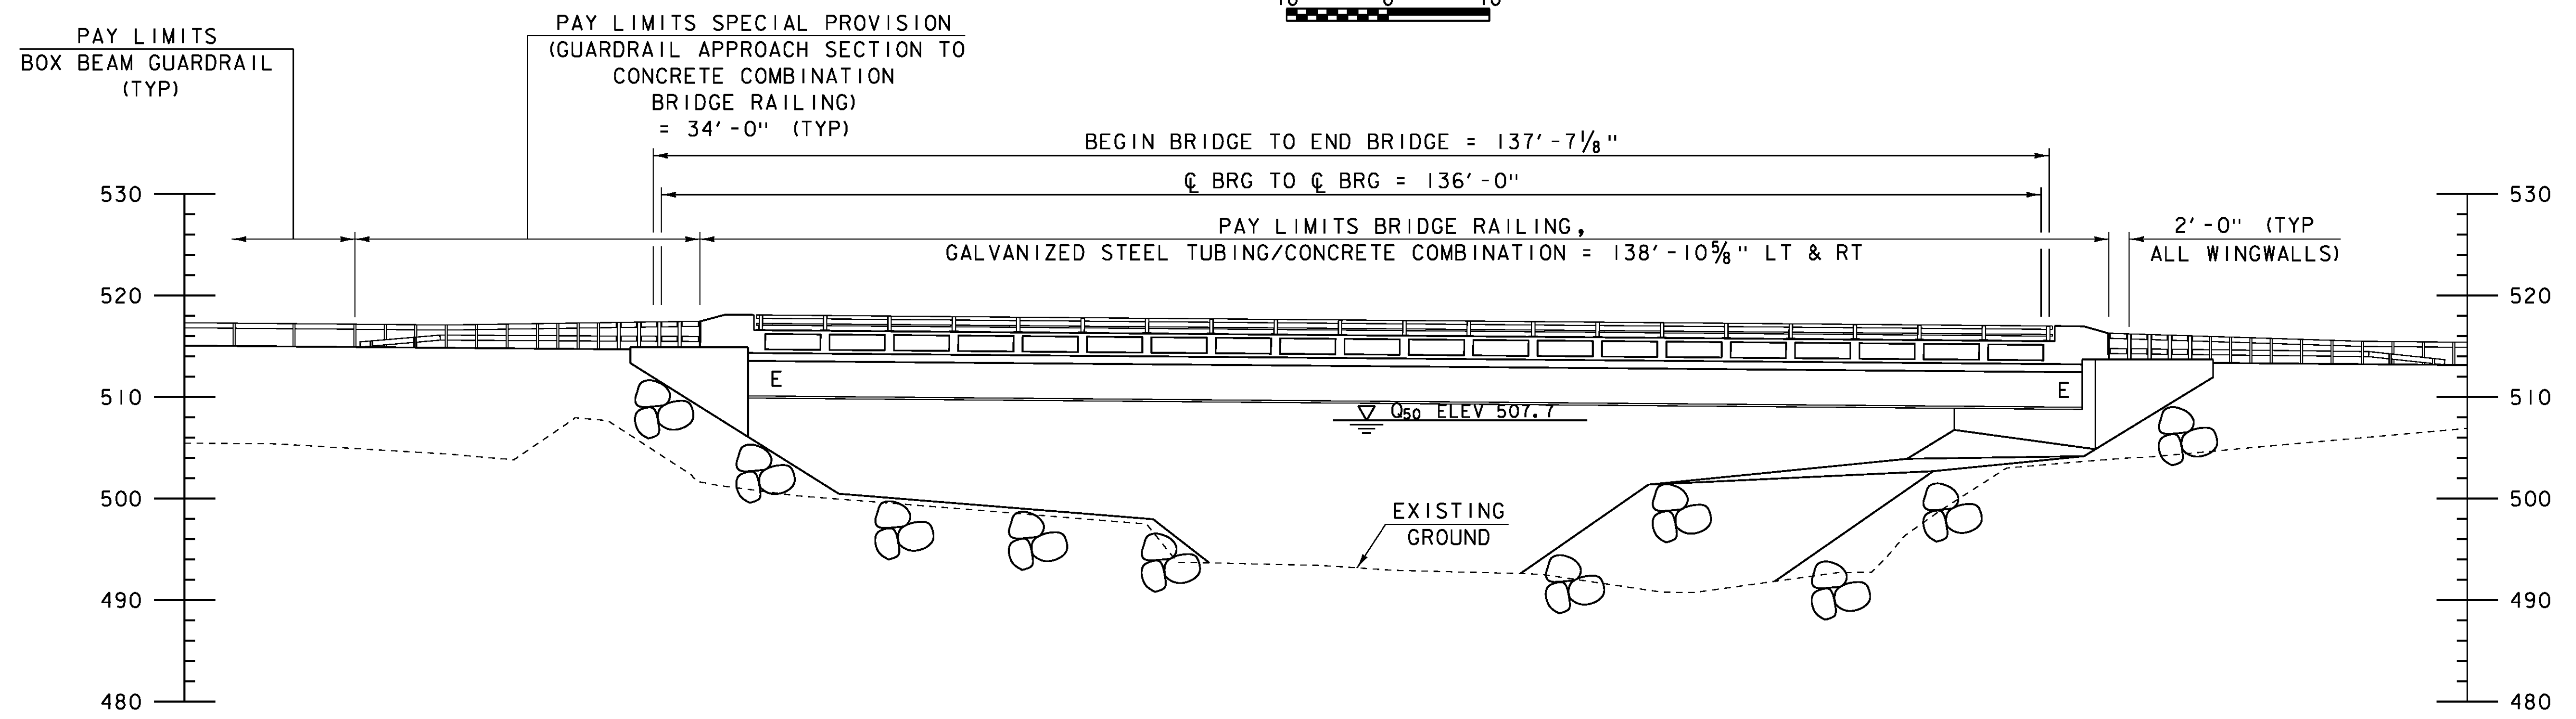

ELEVATION


SCALE 1" = 10'-0"  
 10 0 10

PROJECT NAME:	ROYALTON	PLOT DATE:	08-OCT-2013
PROJECT NUMBER:	BRS 0147 (13)	DRAWN BY:	D. PETERSON
FILE NAME:	\BR 27\s86e055pe.27.dgn	CHECKED BY:	C. CARLSON
PROJECT LEADER:	C. CARLSON	BRIDGE 27 PLAN AND ELEVATION	SHEET 35 OF 186

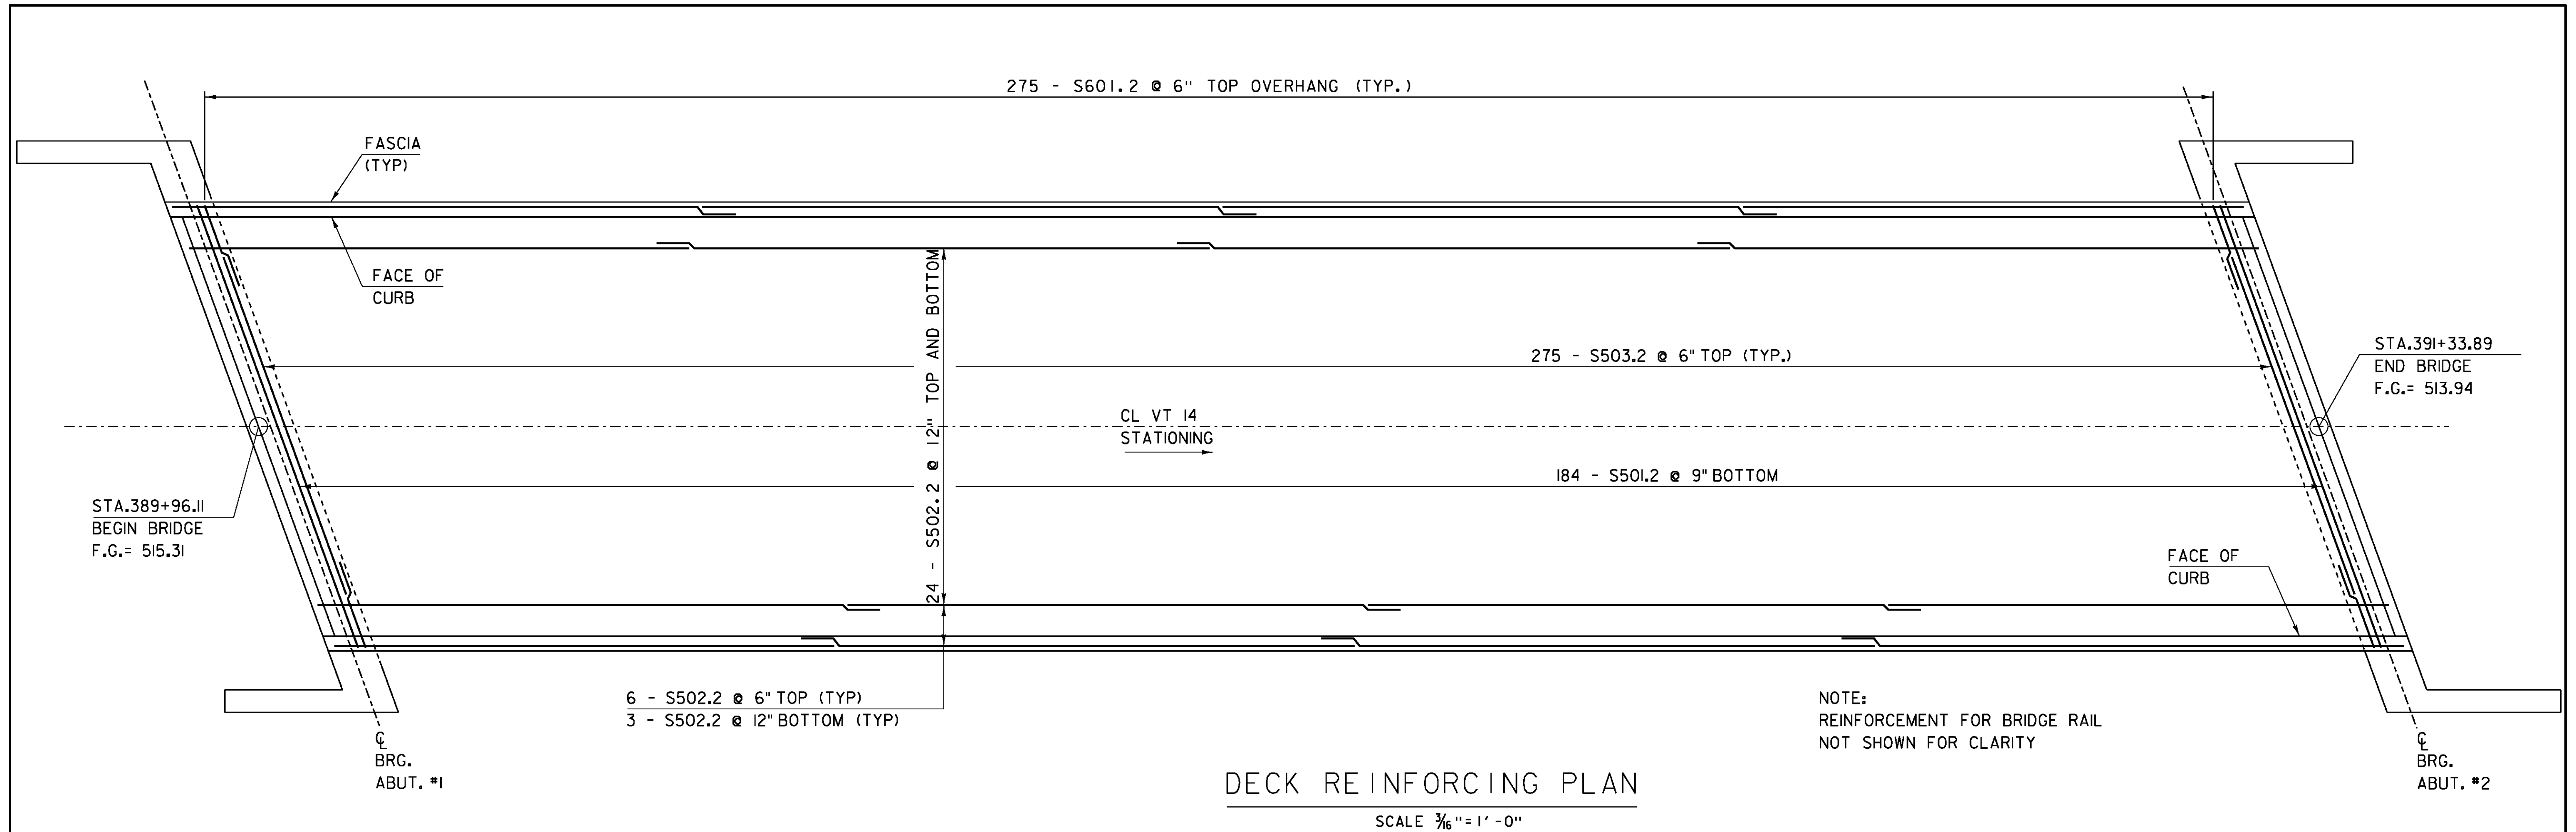

DECK REINFORCING PLAN

SCALE 3/16" = 1'-0"

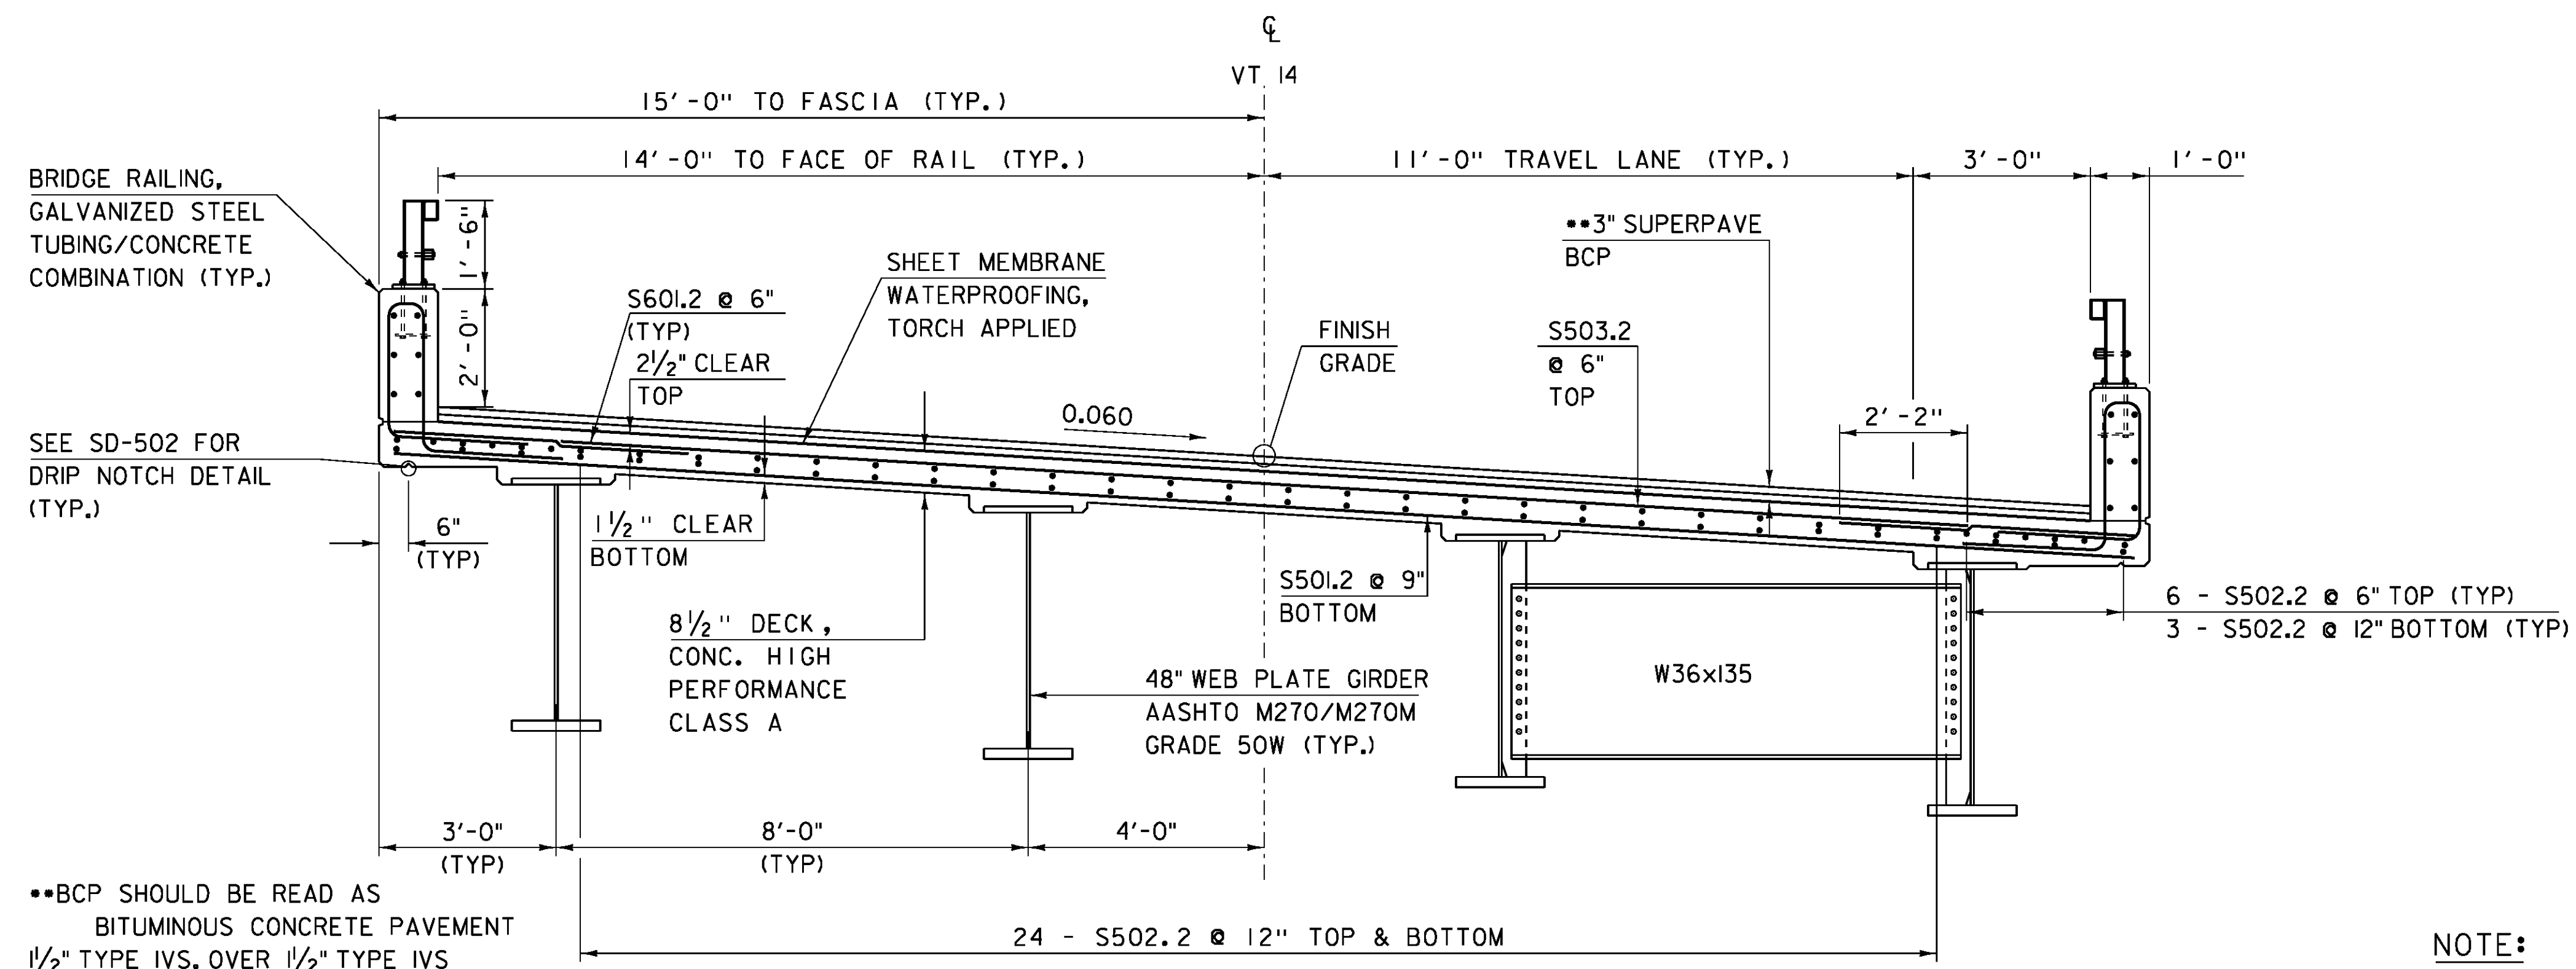


BRIDGE TYPICAL SECTION

SCALE 1/2" = 1'-0"


NOTE:

NF = NEAR FACE  
 FF = FAR FACE  
 EF = EACH FACE  
 ▲ = CUT TO FIT IN FIELD  
 3" CLEAR, UNLESS OTHERWISE SPECIFIED ON THE PLANS.  
 2'-2" BAR LAP UNLESS OTHERWISE SPECIFIED ON THE PLANS.


PROJECT NAME: ROYALTON	PLOT DATE: 08-OCT-2013
PROJECT NUMBER: BRS 0147(13)	DRAWN BY: N. COVEY
FILE NAME: s86e055sup.dgn	CHECKED BY: D. PETERSON
PROJECT LEADER: C. CARLSON	SHEET 36 OF 186
DESIGNED BY: D. PETERSON	
BRIDGE 27 DECK REINFORCING PLAN	

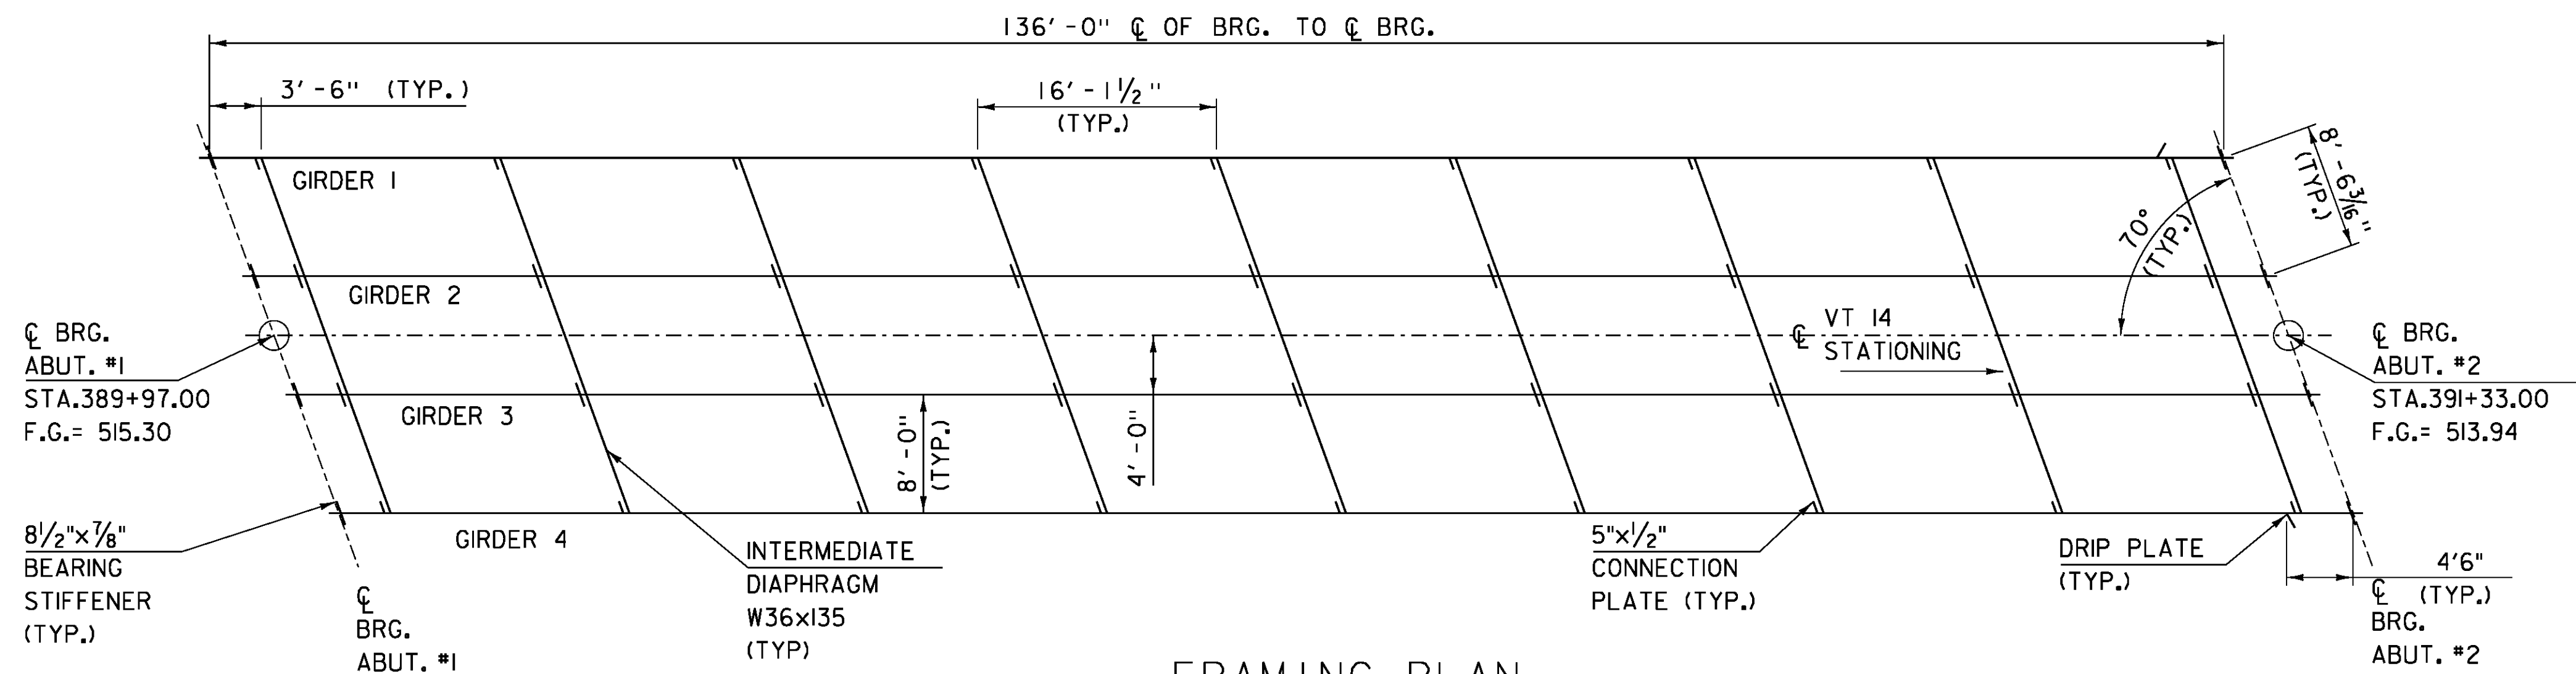

**FRAMING PLAN**  
SCALE 1/8" = 1'-0"

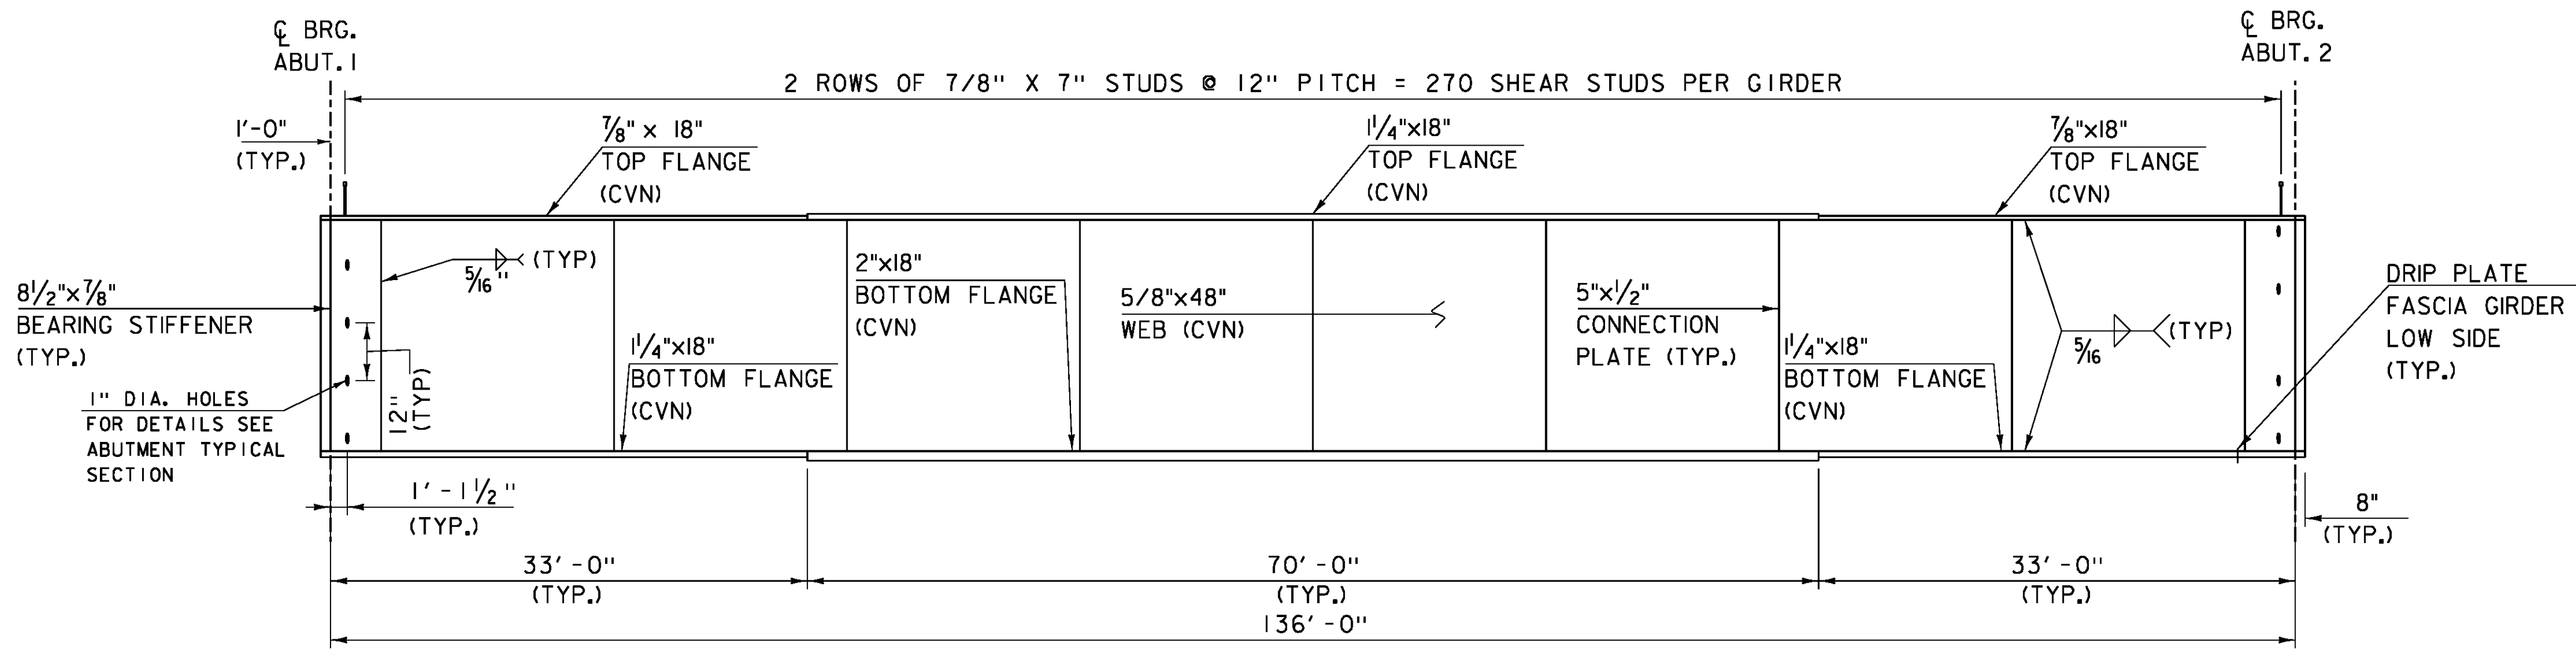


**GIRDER ELEVATION**  
HORIZONTAL SCALE 1/8" = 1'-0"  
VERTICAL SCALE 1/2" = 1'-0"

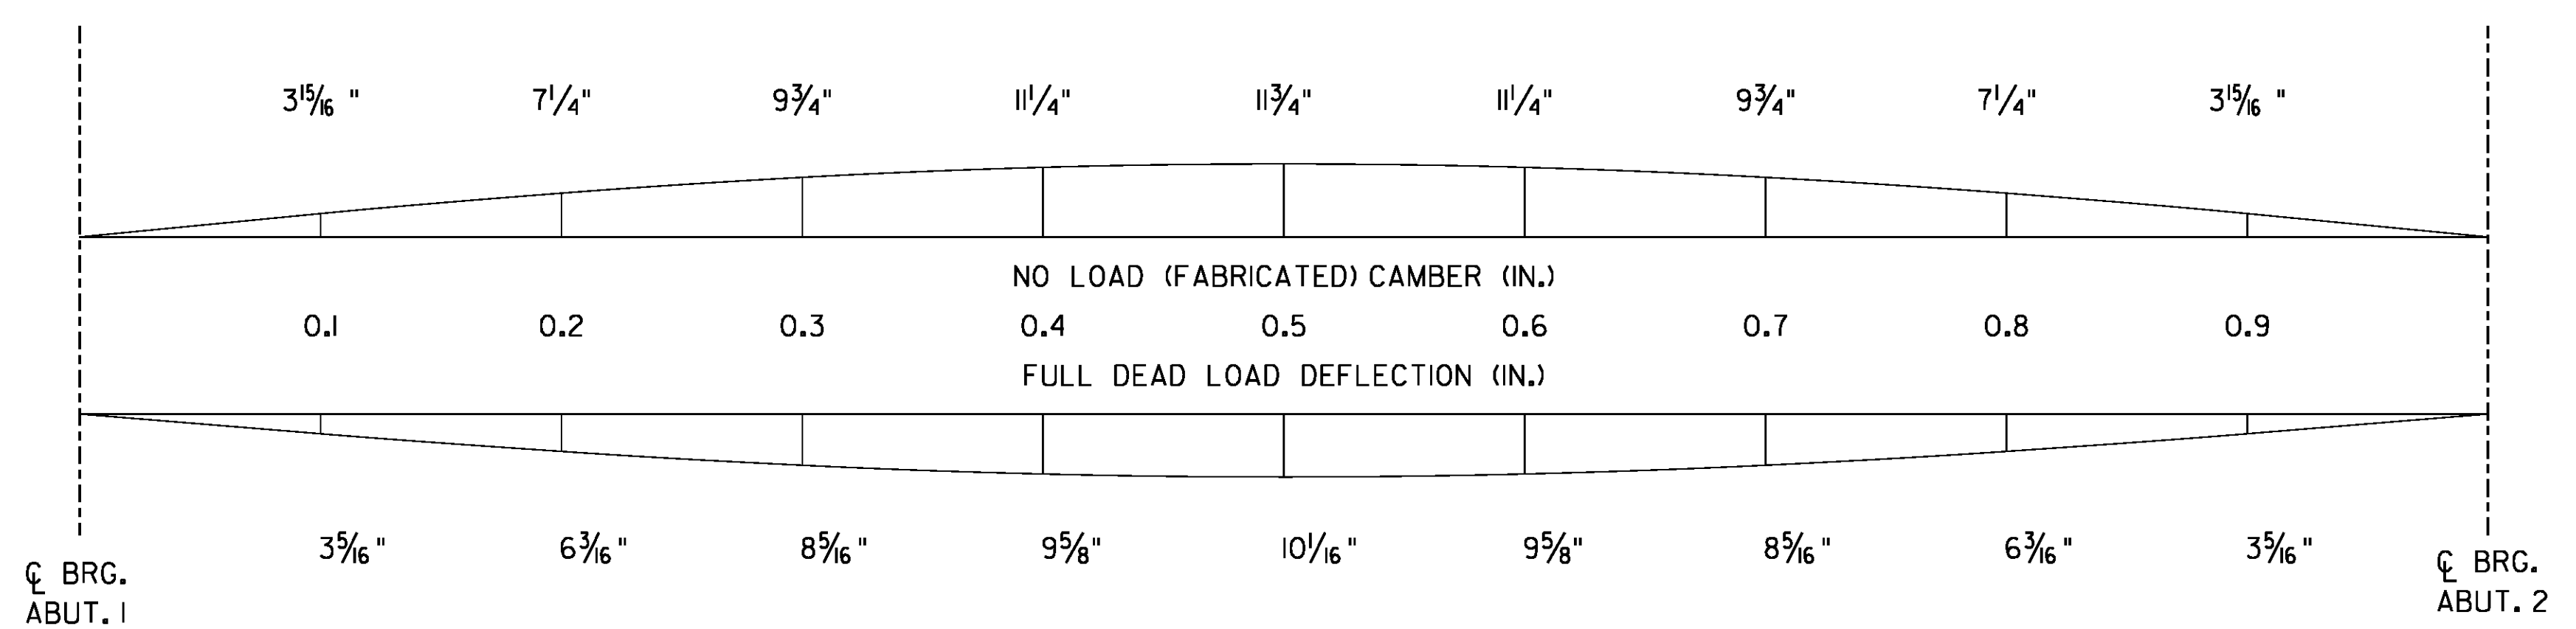

**CAMBER AND DEAD LOAD DEFLECTION**  
HORIZONTAL SCALE 1/8" = 1'-0"  
VERTICAL SCALE 1/2" = 1'-0"


**NOTE:**  
NF = NEAR FACE  
FF = FAR FACE  
EF = EACH FACE  
▲ = CUT TO FIT IN FIELD  
3" CLEAR, UNLESS OTHERWISE SPECIFIED ON THE PLANS.  
2'-2" BAR LAP UNLESS OTHERWISE SPECIFIED ON THE PLANS.

PROJECT NAME: ROYALTON	PLOT DATE: 08-OCT-2013
PROJECT NUMBER: BRS 0147(13)	DRAWN BY: N. COVEY
FILE NAME: s86e055sup.dgn	CHECKED BY: D. PETERSON
PROJECT LEADER: C. CARLSON	BRIDGE 27 FRAMING PLAN
DESIGNED BY: D. PETERSON	SHEET 37 OF 186

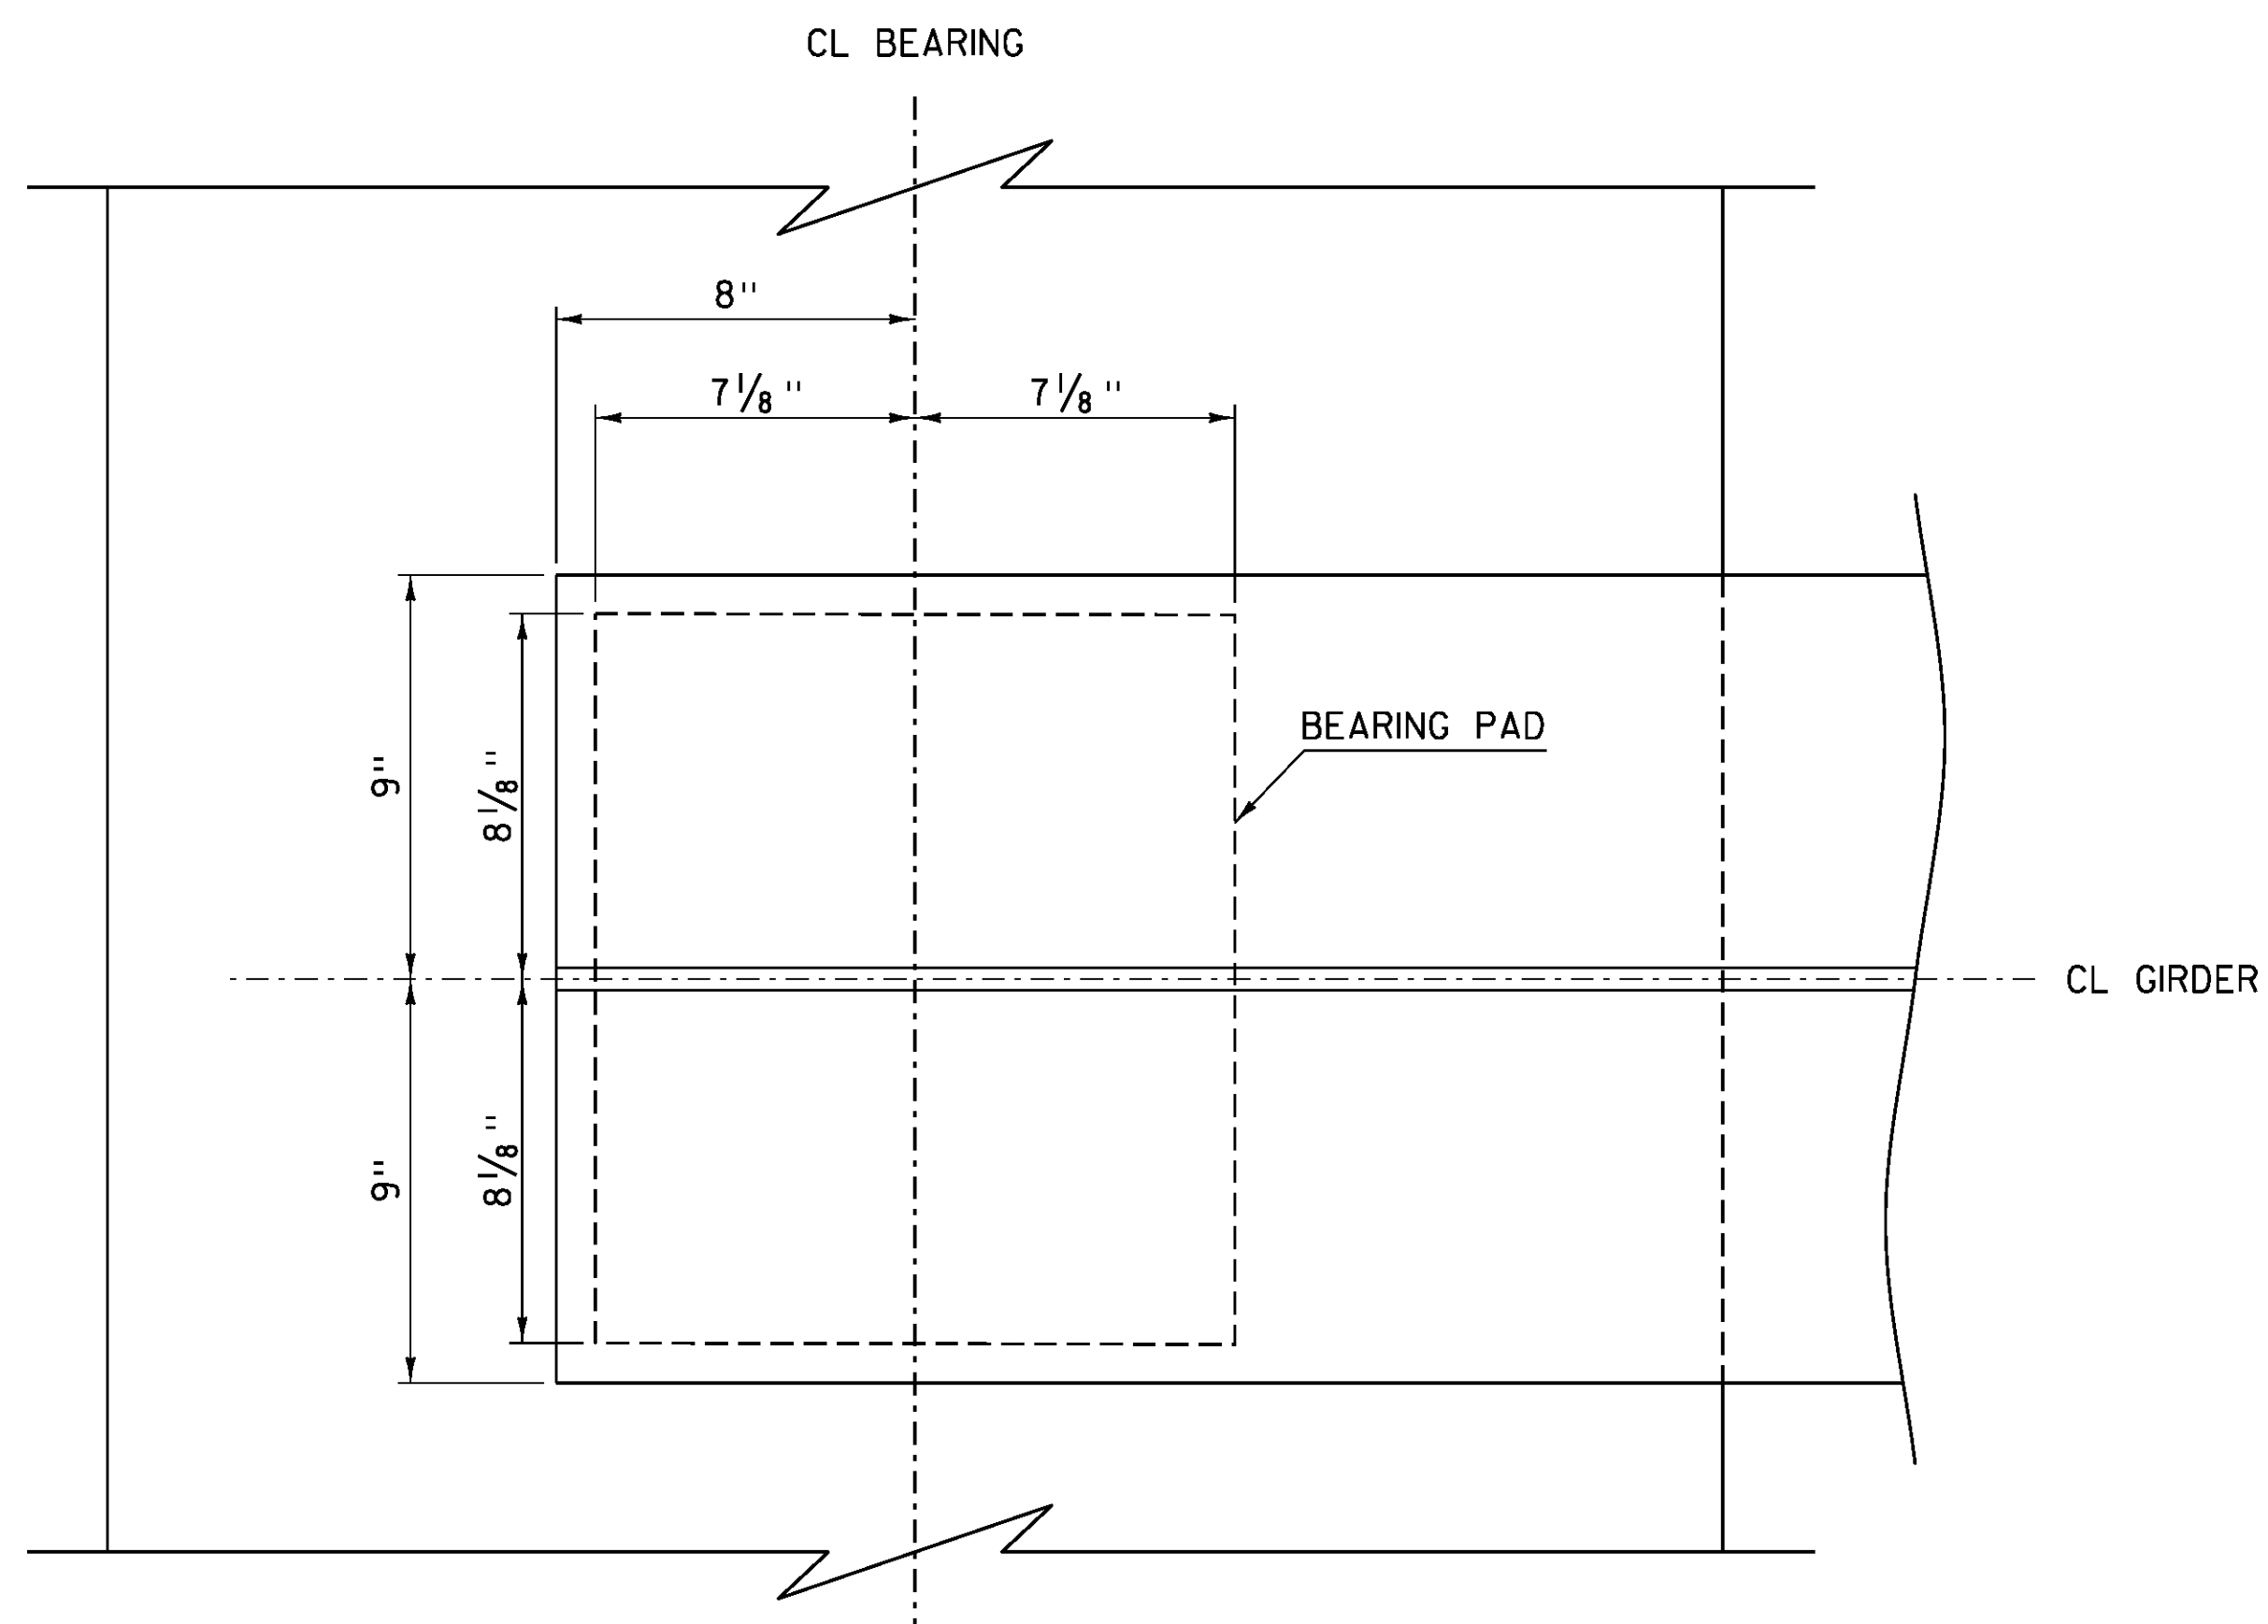


BEARING PLAN

SCALE: 3" = 1'-0"

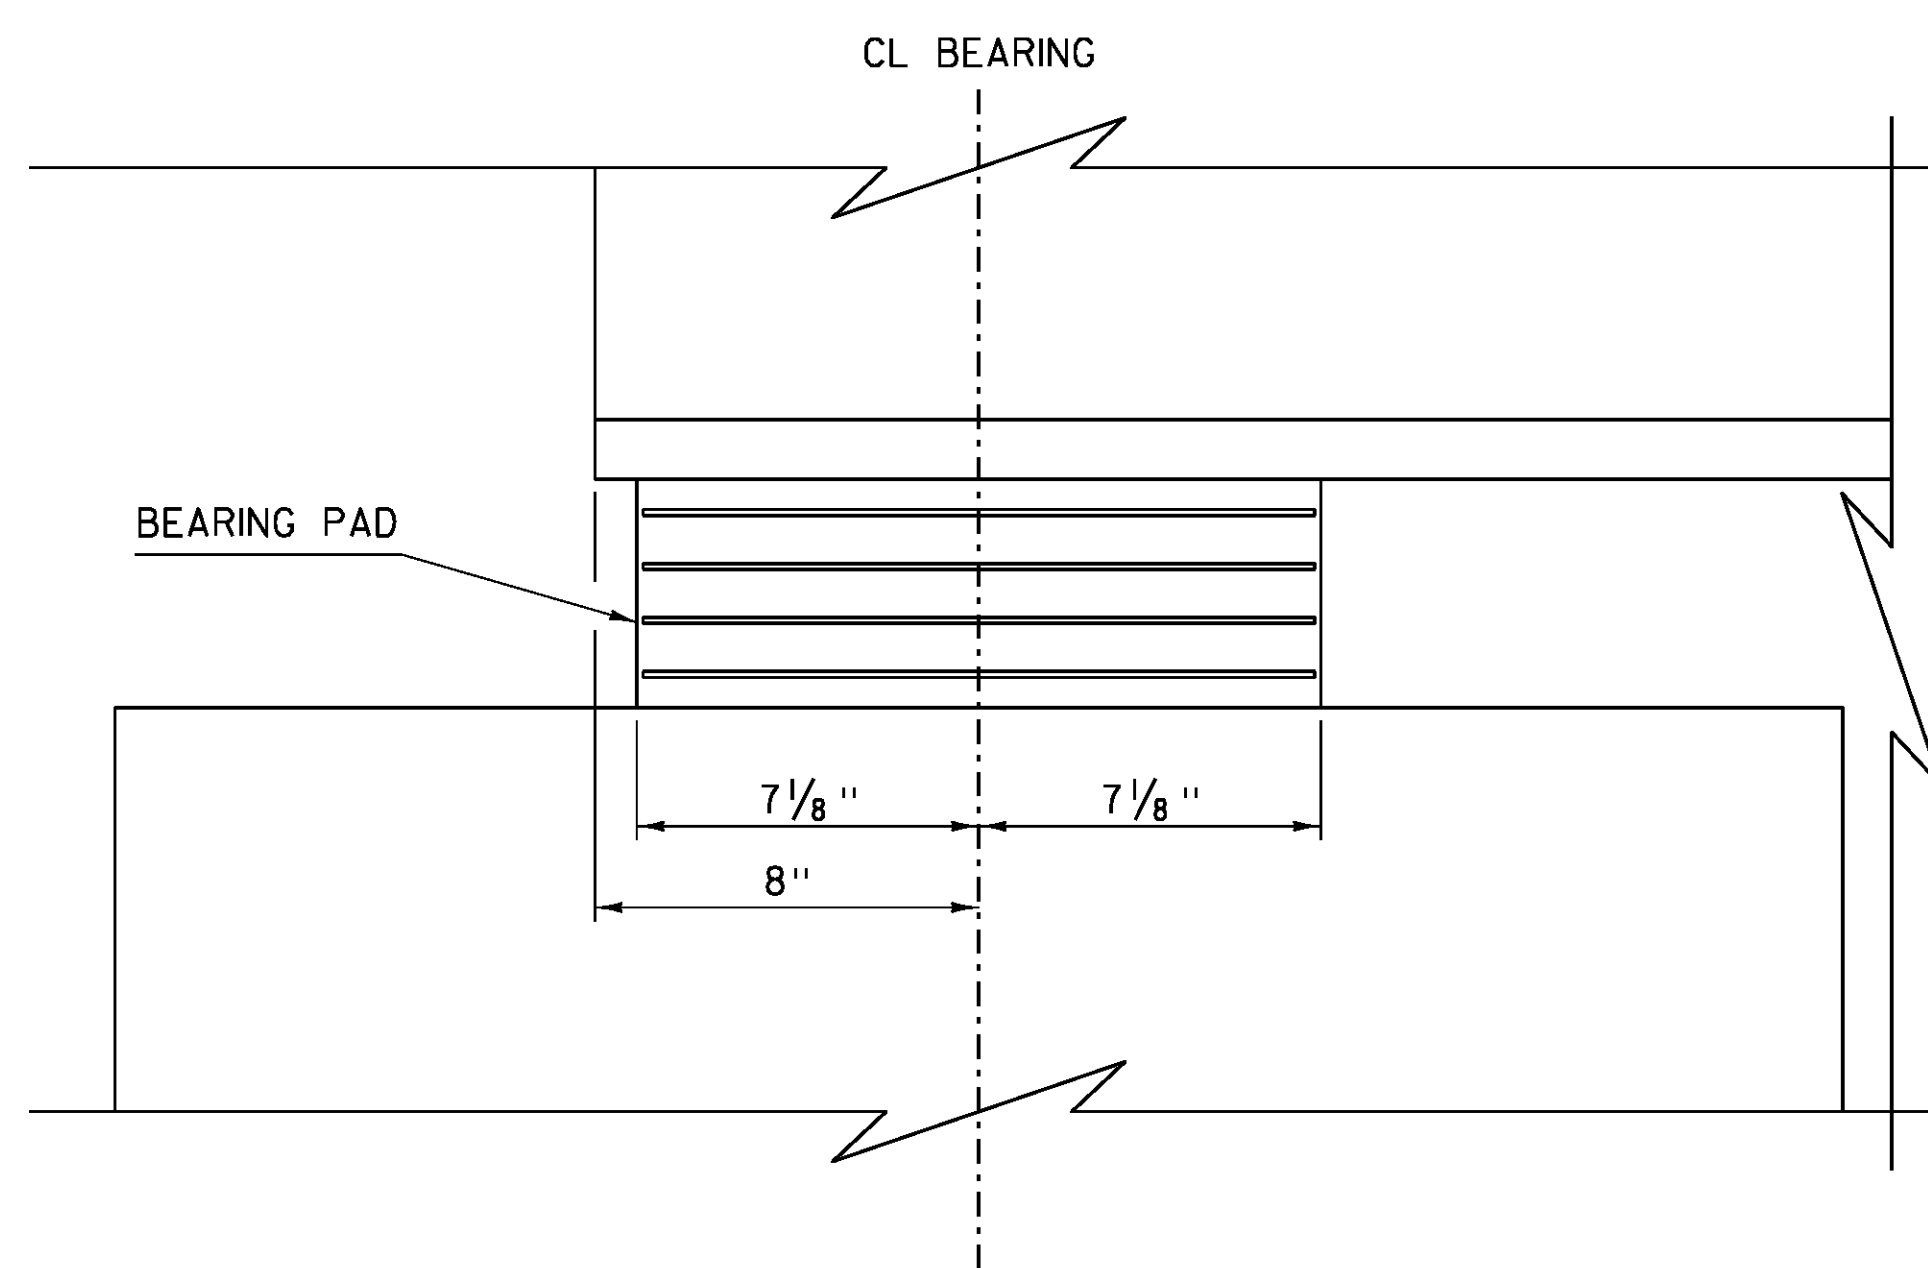

BEARING ELEVATION

SCALE: 3" = 1'-0"

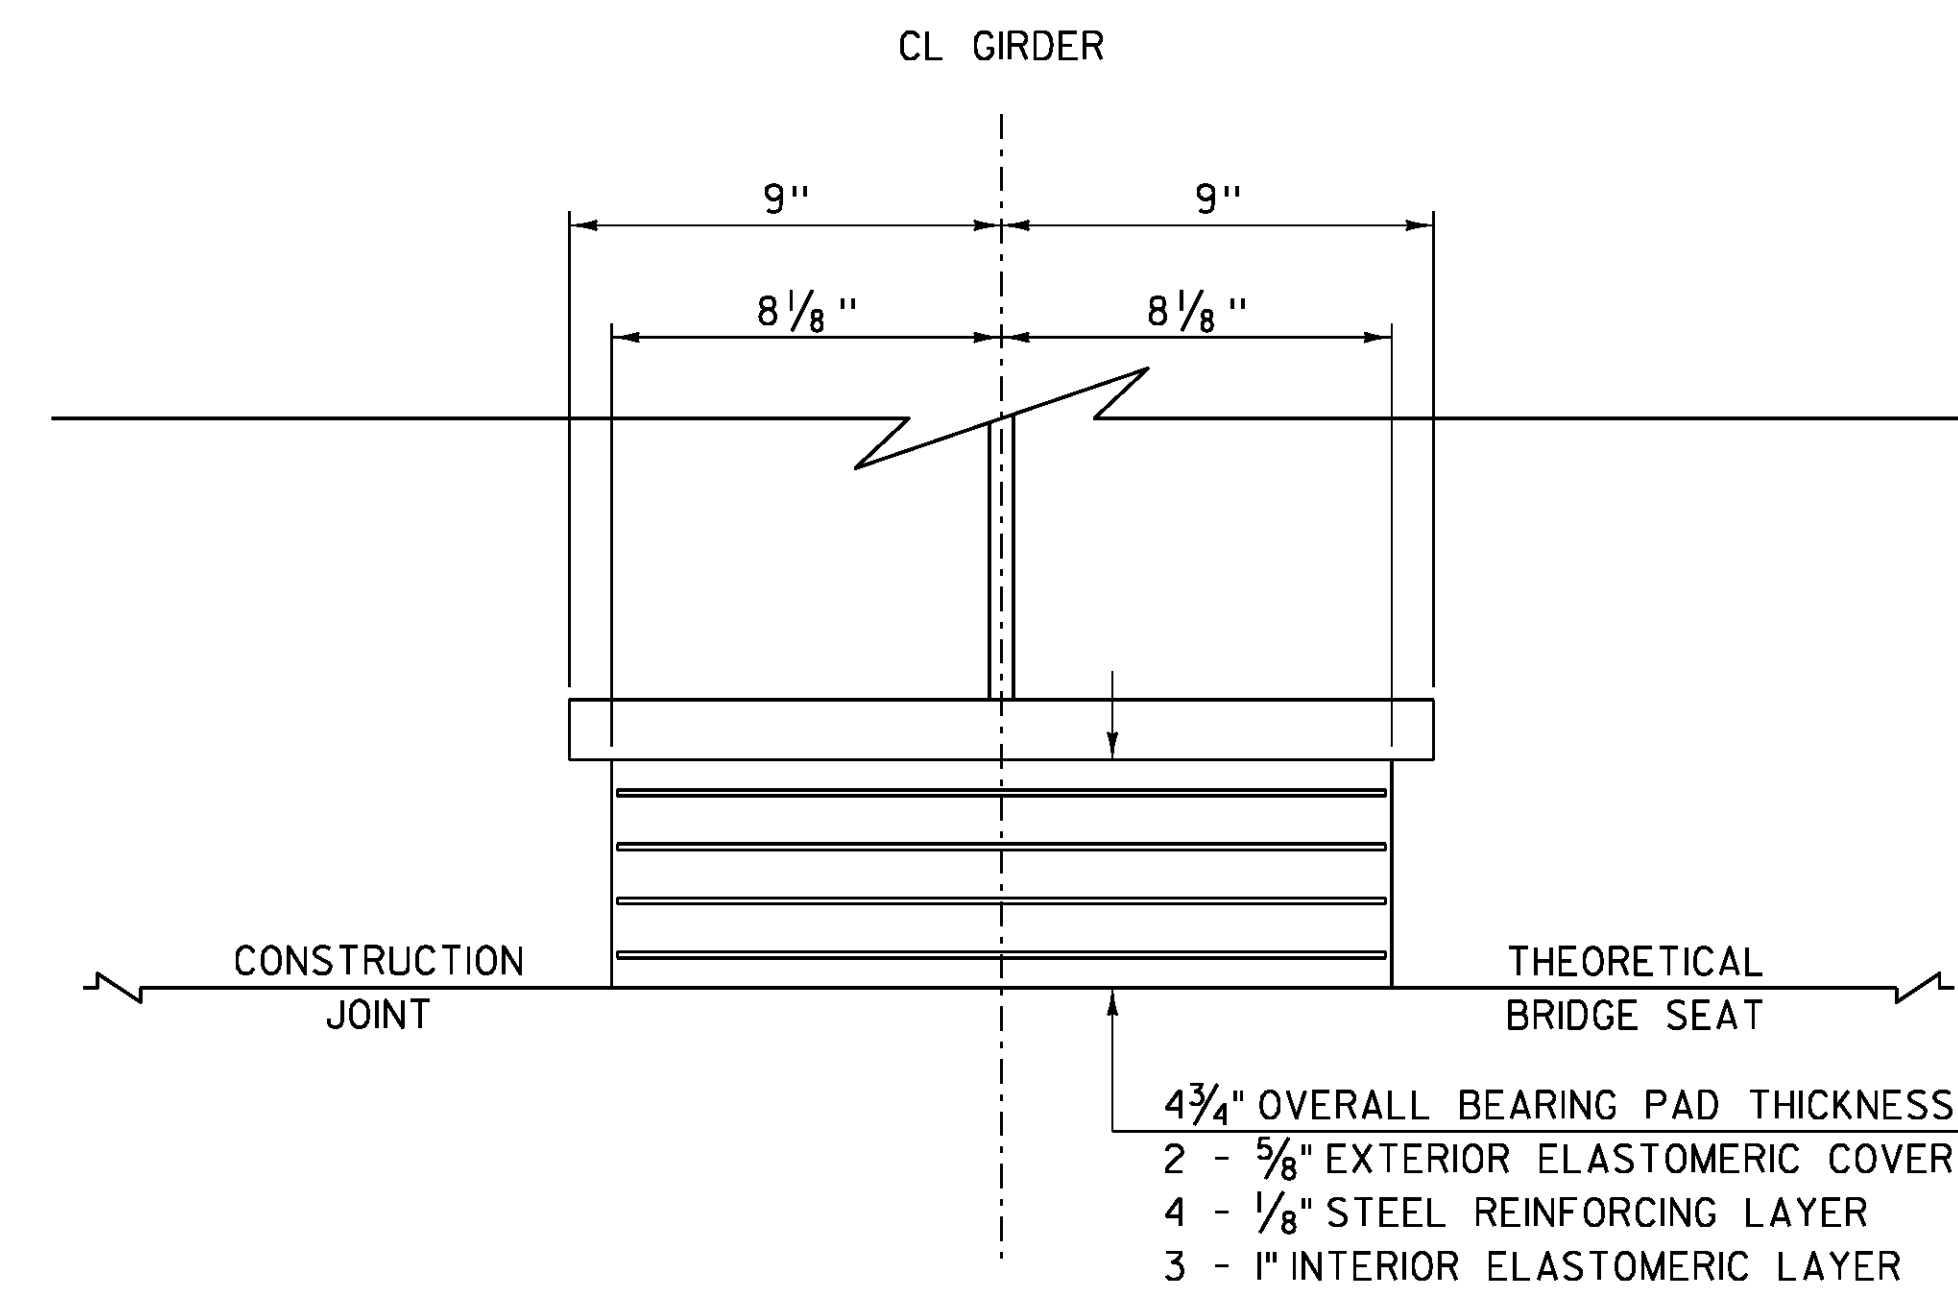


BEARING SECTION

SCALE: 3" = 1'-0"


BEARING DEVICE NOTES

1. BEARINGS SHALL BE PAID FOR UNDER THE ITEM 531.17 "BEARING DEVICE ASSEMBLY, STEEL REINFORCED ELASTOMERIC PAD" AND SHALL CONFORM TO APPLICABLE SUBSECTIONS OF SECTIONS 531 AND 731.
2. ALL REINFORCEMENT BETWEEN LAYERS OF ELASTOMERIC SHALL BE STEEL ASTM A36. ALL INTERNAL STEEL PLATES SHALL BE SAND BLASTED AND FREE OF COATINGS, RUST, AND MILL SCALE. THE PLATES SHALL BE FREE OF SHARP EDGES AND BURRS.
3. STEEL REINFORCED ELASTOMERIC PAD BEARINGS SHALL HAVE A MINIMUM OF 1/8" EDGE SEAL OF ELASTOMER INTEGRAL WITH THE BEARING OVER ALL INTERNAL PLATES.
4. FOR ELASTOMERIC BEARINGS, ALL MATERIALS SHALL CONFORM TO AASHTO M251M/M251.


PROJECT NAME: ROYALTON	PLOT DATE: 08-OCT-2013
PROJECT NUMBER: BRS 0147(I3)	DRAWN BY: N. COVEY
FILE NAME: s86e055sup.dgn	CHECKED BY: D. PETERSON
PROJECT LEADER: C. CARLSON	SHEET 38 OF 186
DESIGNED BY: D. PETERSON	
BRIDGE 27 BEARING DETAILS	

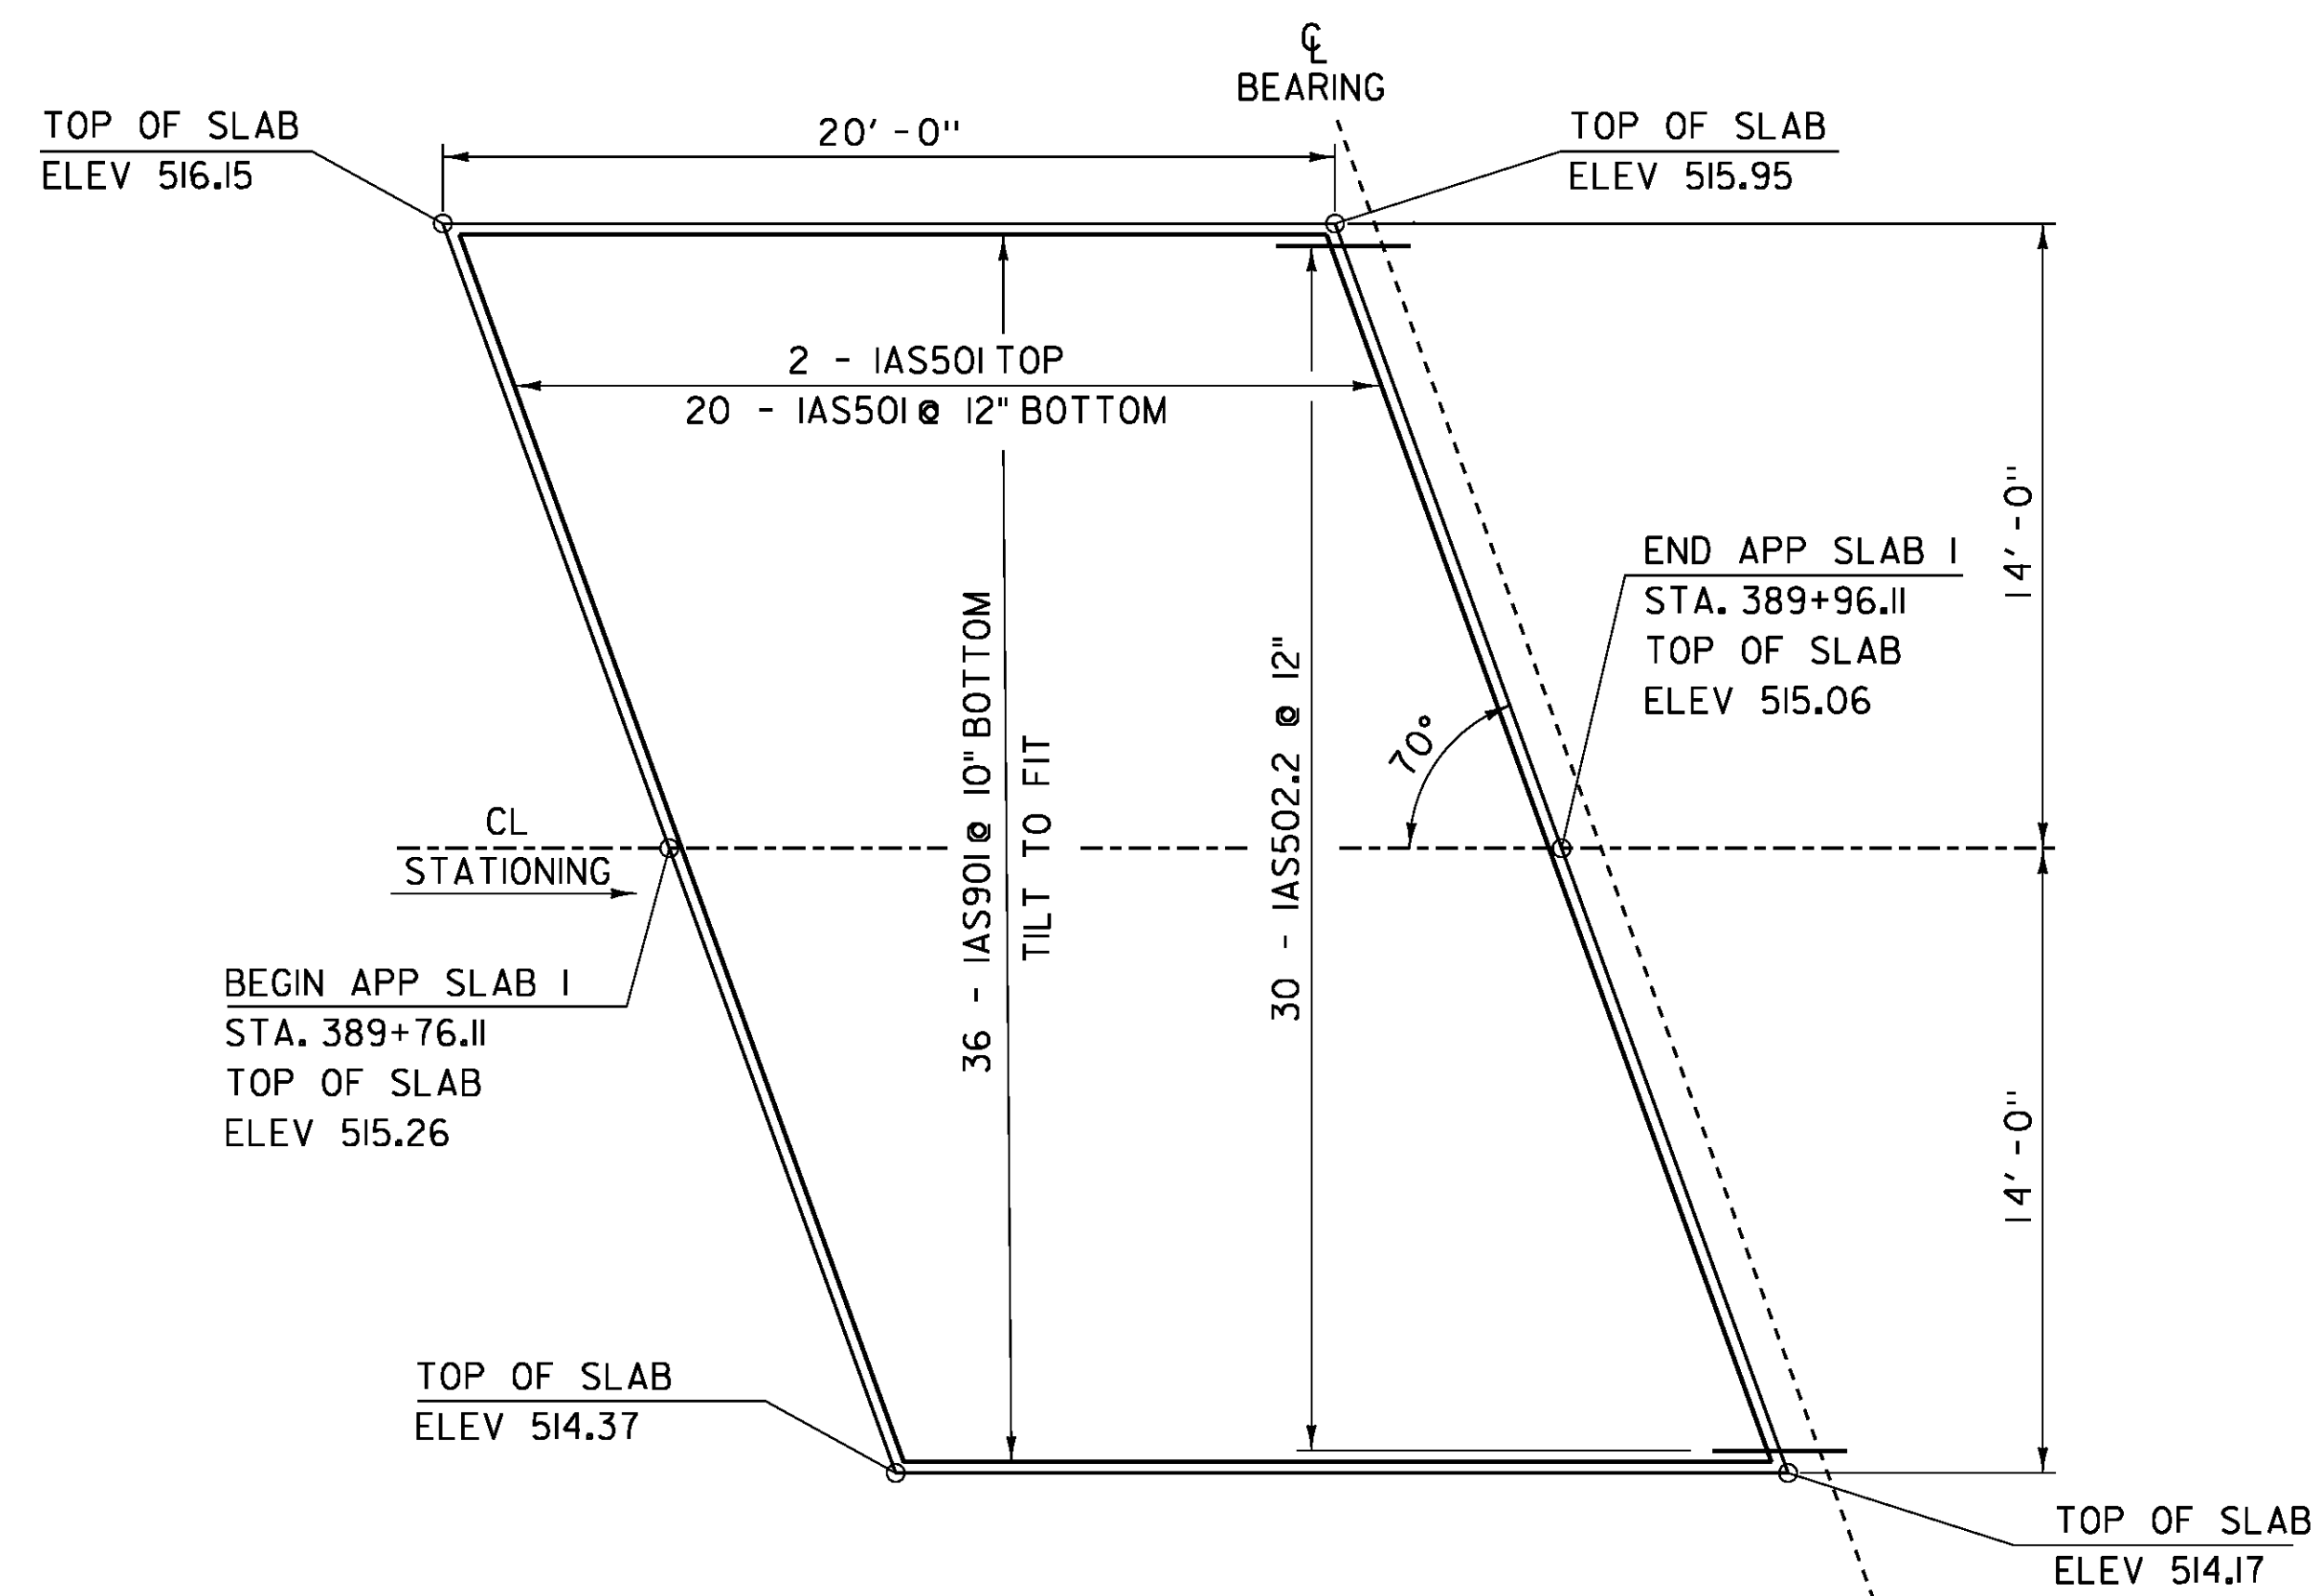

**APPROACH SLAB 1 PLAN**  
SCALE 1/4" = 1'-0"

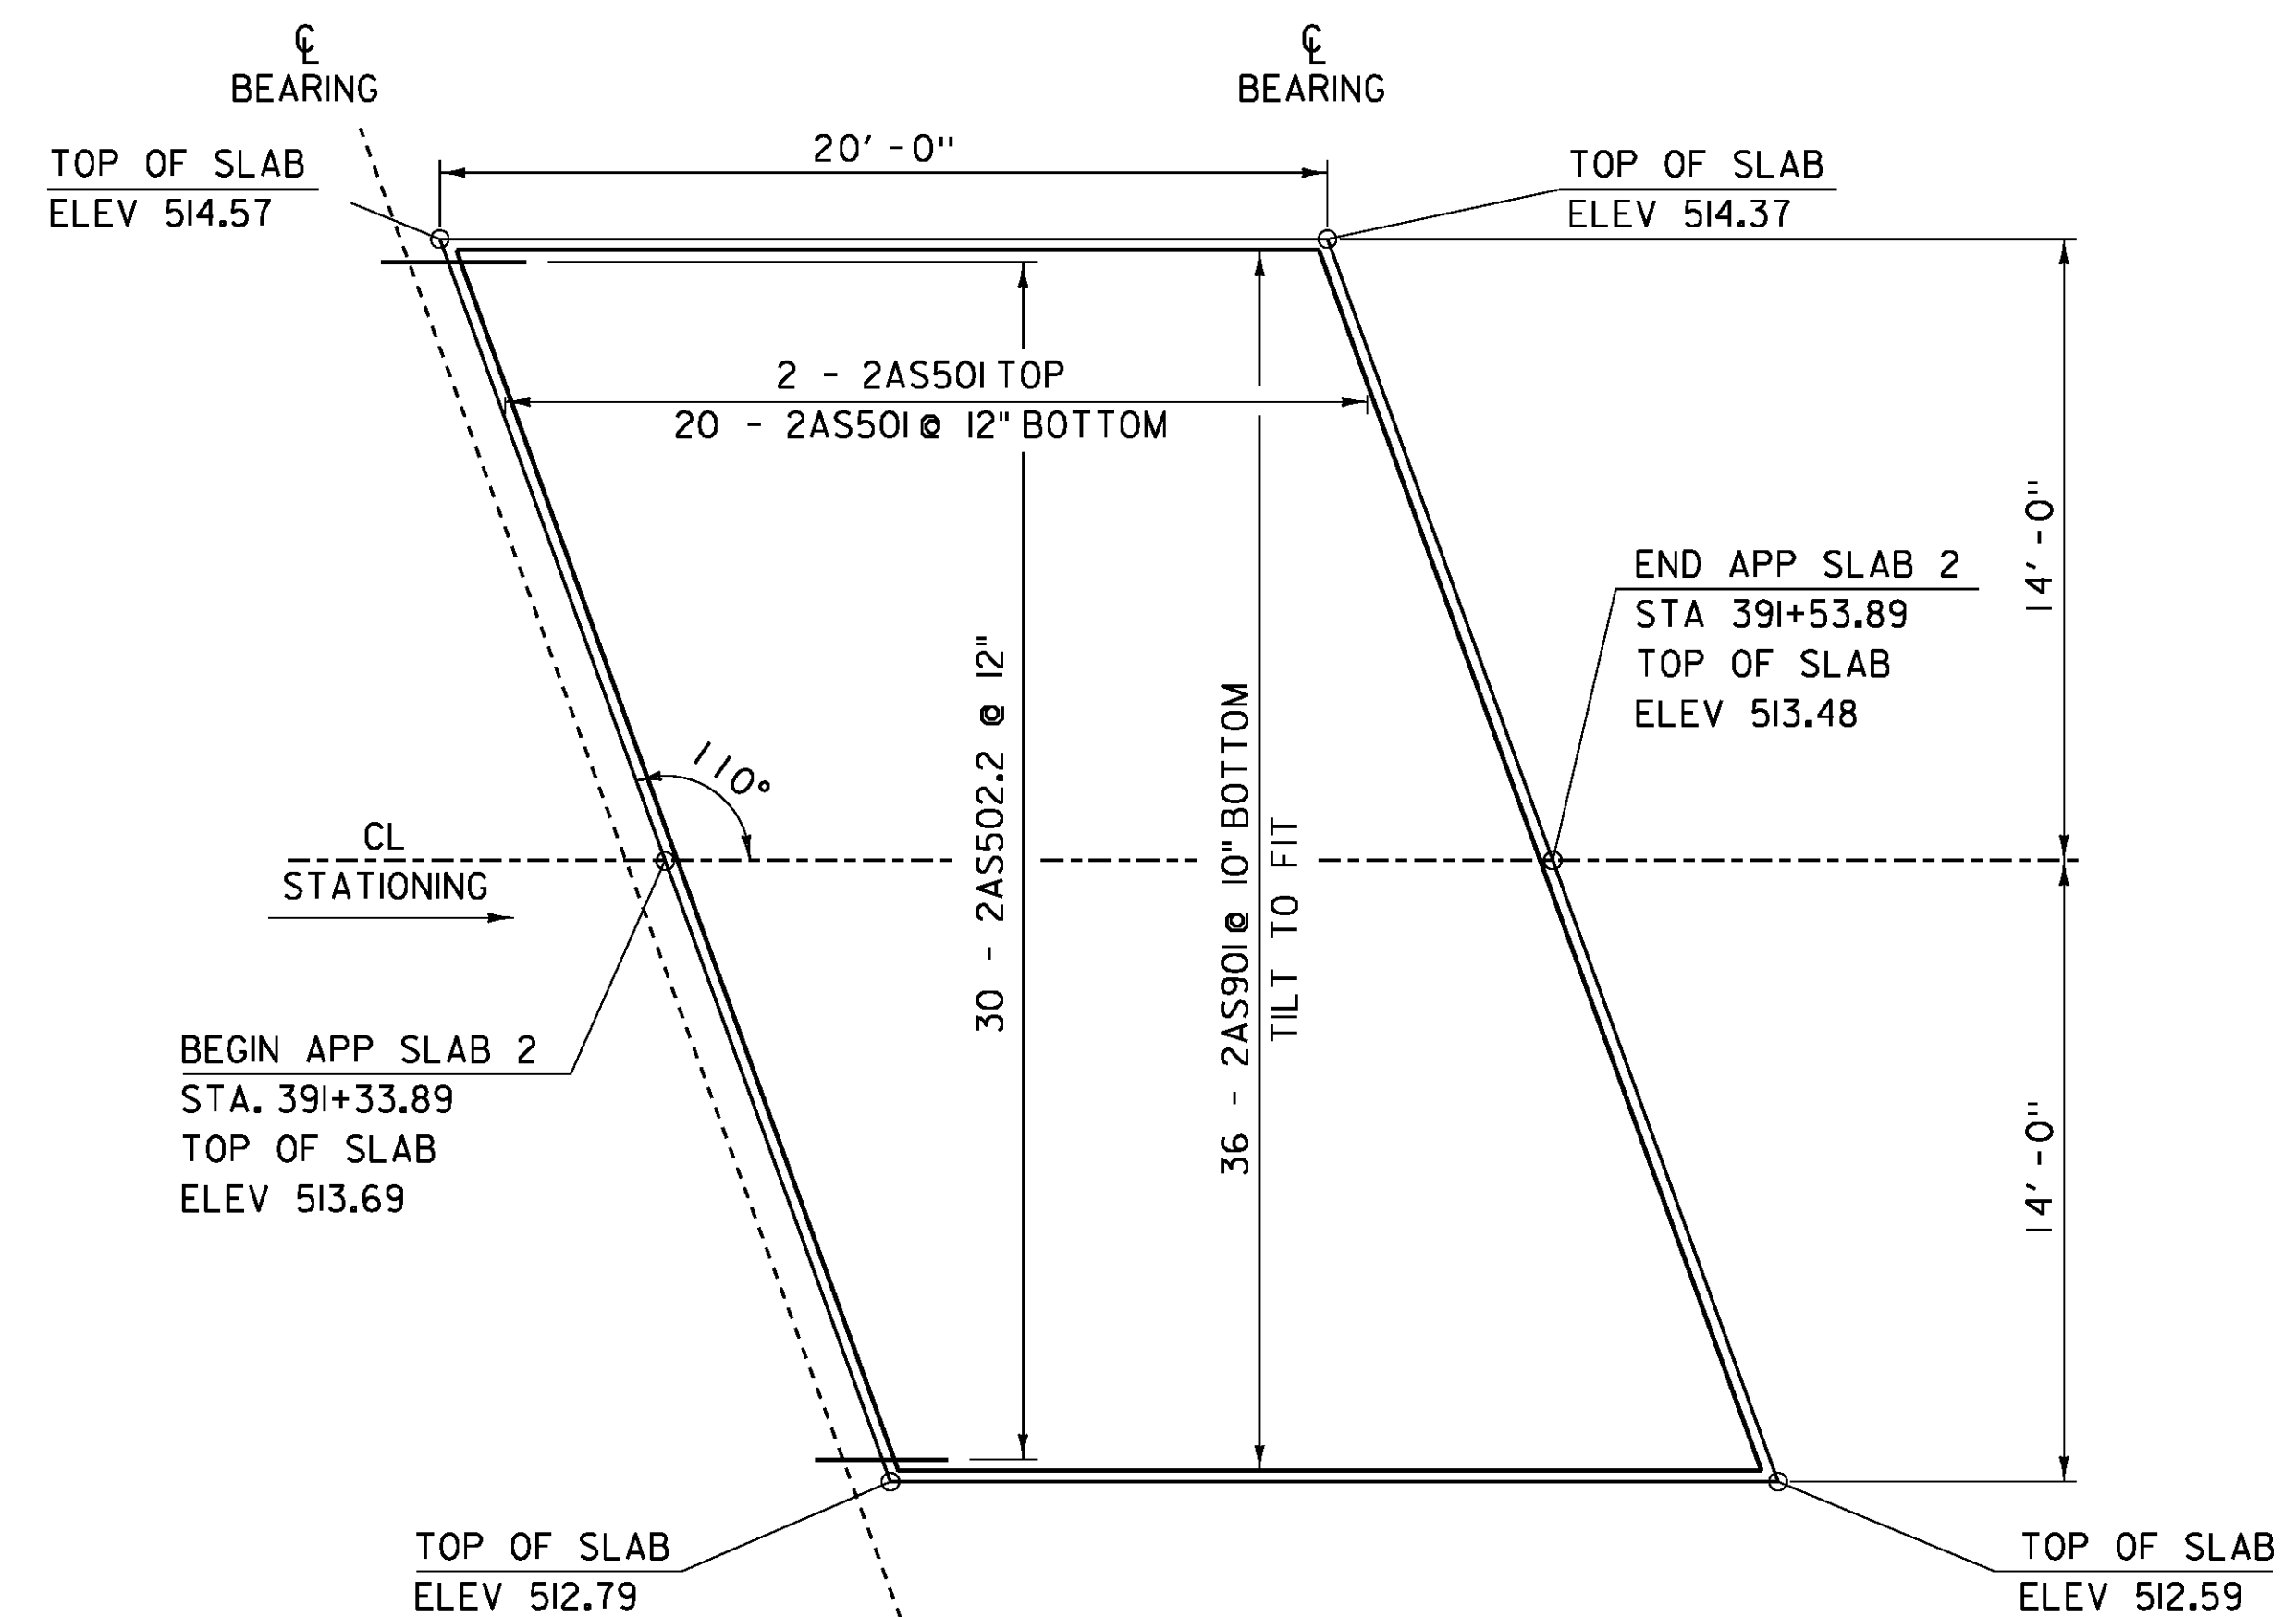

**APPROACH SLAB 2 PLAN**  
SCALE 1/4" = 1'-0"

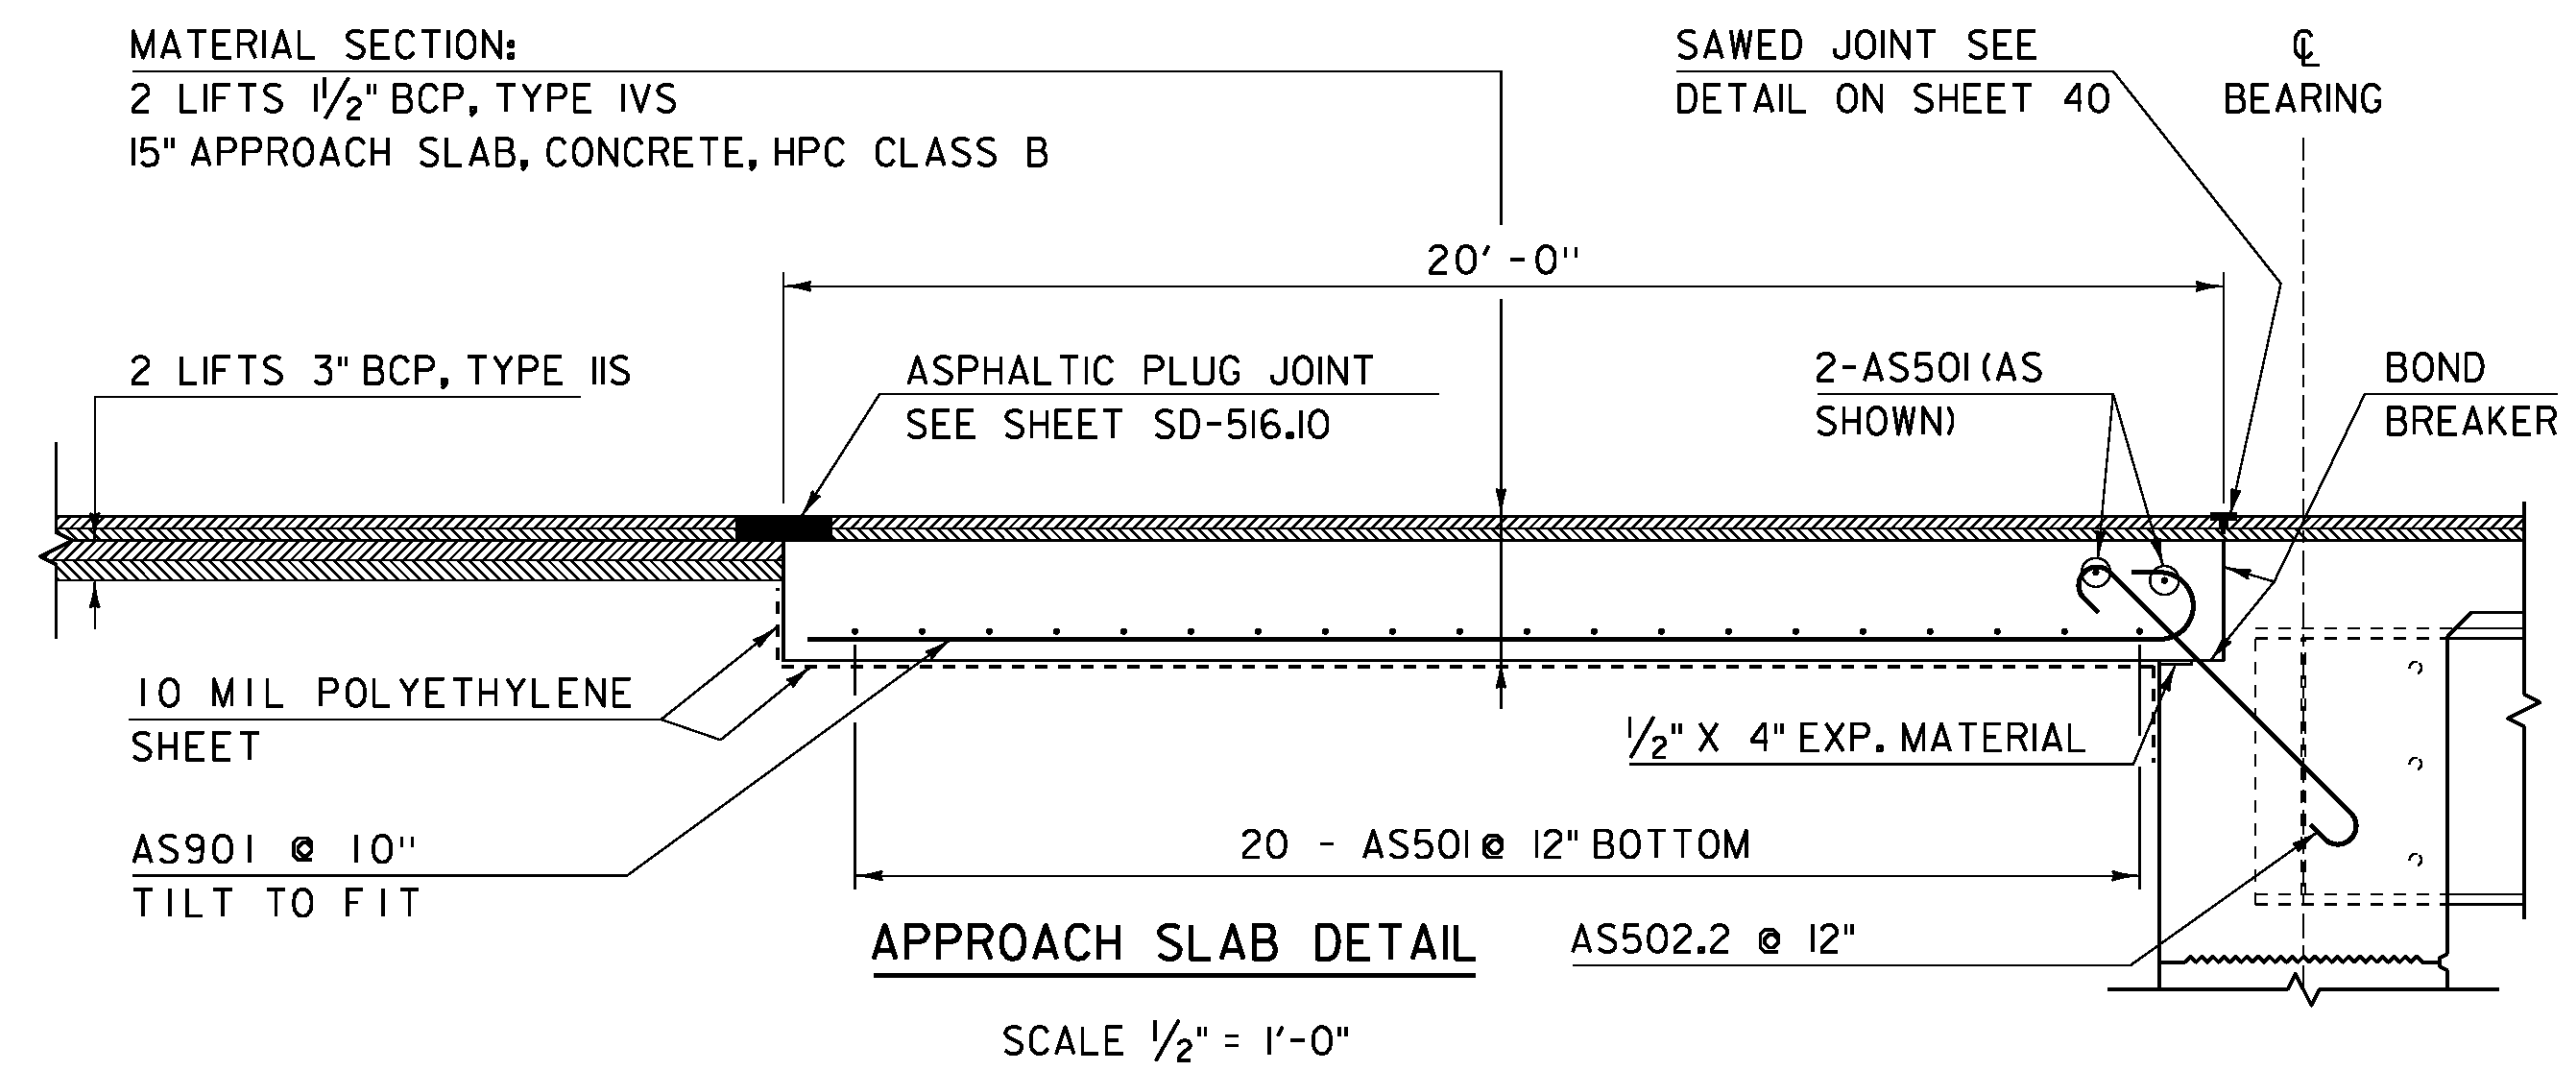

**APPROACH SLAB DETAIL**  
SCALE 1/2" = 1'-0"

**NOTES:**

1. SUBBASE. COMPACT THE SUBBASE IN THE AREA UNDER THE APPROACH SLAB TO A SMOOTH SURFACE.
2. 10 MIL POLYETHYLENE SHEETING. MATERIAL FOR POLYETHYLENE SHEETING SHALL MEET THE REQUIREMENTS OF SUBSECTION 725.01(c) OF THE STANDARD SPECIFICATIONS. PLACE THE SHEETING ON TOP OF THE FINISHED SUBBASE FOR THE FULL LENGTH AND WIDTH OF THE APPROACH SLAB, AS SHOWN IN THE APPROACH SLAB DETAIL. LAP SHEETING AT LEAST 24 INCHES. PAYMENT FOR ITEM 501.34 "CONCRETE, HIGH PERFORMANCE CLASS B" SHALL INCLUDE THIS SHEETING.
3. CONCRETE. POUR APPROACH SLAB CONCRETE IN THE EARLY MORNING BEFORE THE SUPERSTRUCTURE EXPANDS.
4. BOND BREAKER. APPLY 2 COATS TAR EMULSION. PAYMENT FOR ITEM 501.34 "CONCRETE, HIGH PERFORMANCE CLASS B" SHALL INCLUDE THIS BOND BREAKER.


**NOTE:**

NF = NEAR FACE  
FF = FAR FACE  
EF = EACH FACE  
▲ = CUT TO FIT IN FIELD  
3" CLEAR, UNLESS OTHERWISE SPECIFIED ON THE PLANS.  
2' - 2" BAR LAP UNLESS OTHERWISE SPECIFIED ON THE PLANS.


PROJECT NAME: ROYALTON  
PROJECT NUMBER: BRS 0147(I3)

FILE NAME: s86e055sup.dgn  
PROJECT LEADER: C. CARLSON  
DESIGNED BY: D. PETERSON  
BRIDGE 27 APPROACH SLAB DETAILS

PLOT DATE: 08-OCT-2013  
DRAWN BY: N. COVEY  
CHECKED BY: D. PETERSON  
SHEET 39 OF 186

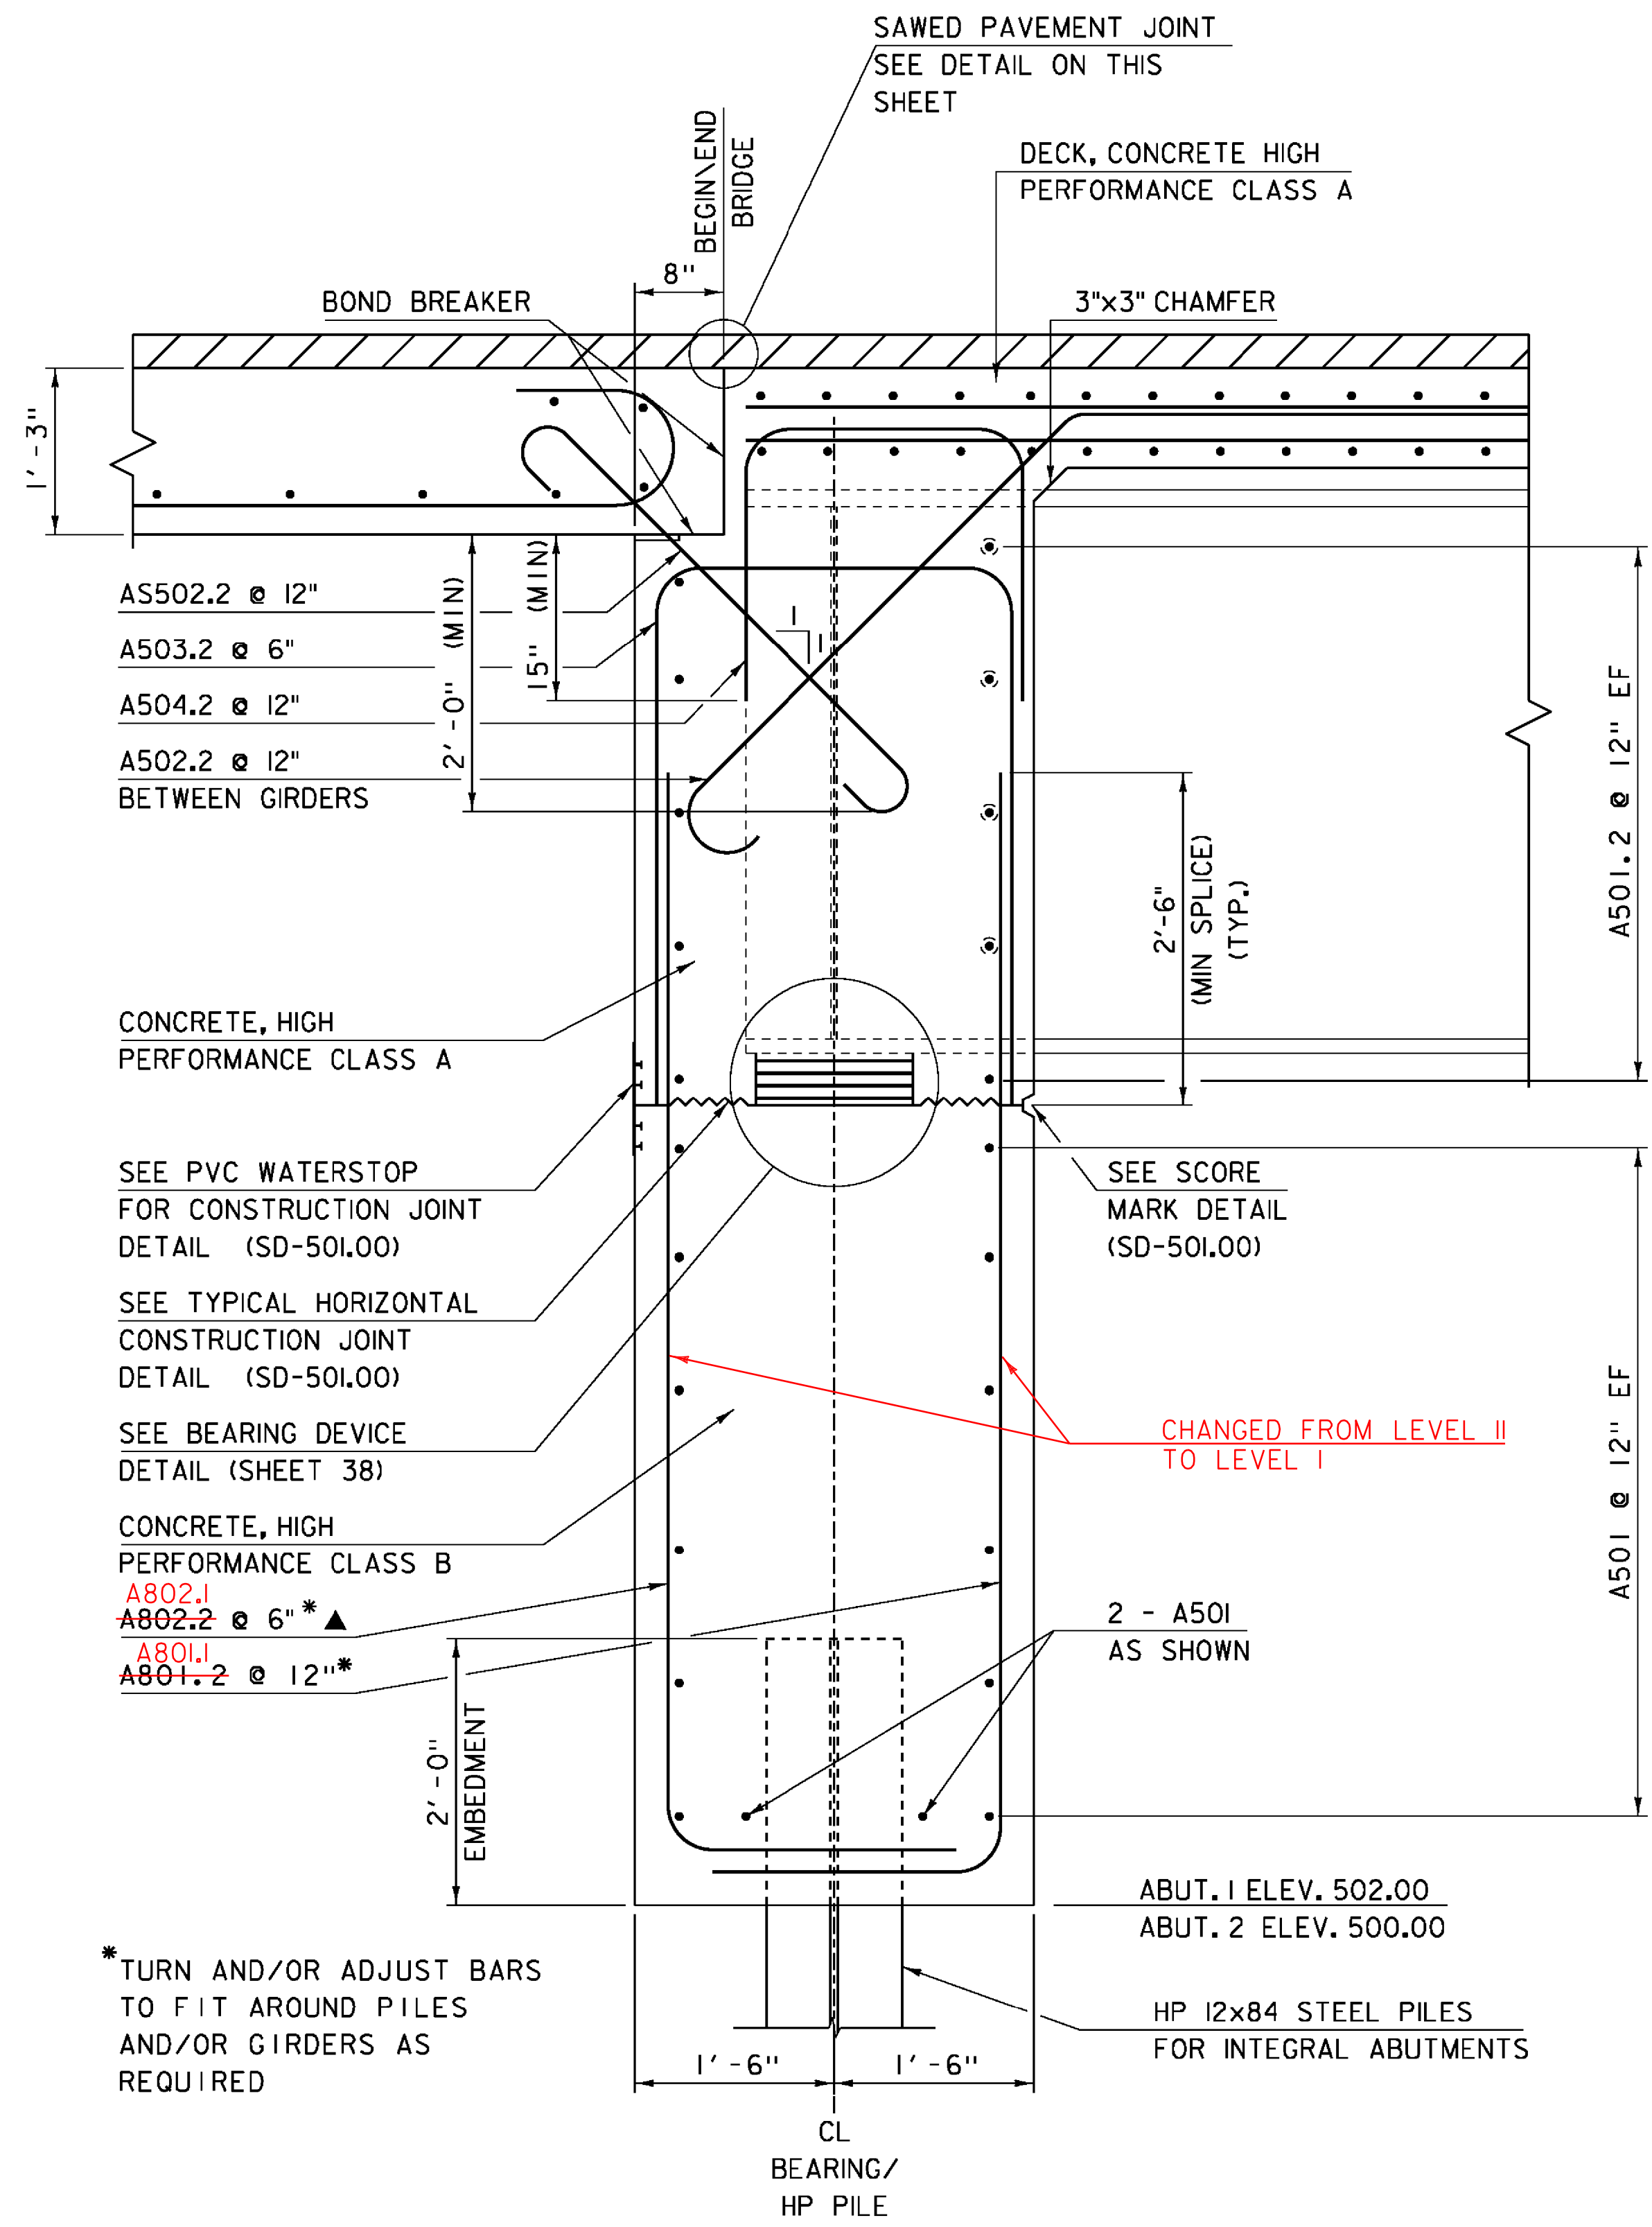

ABUTMENT 1 AND 2 TYPICAL  
SCALE 1"=1'-0"

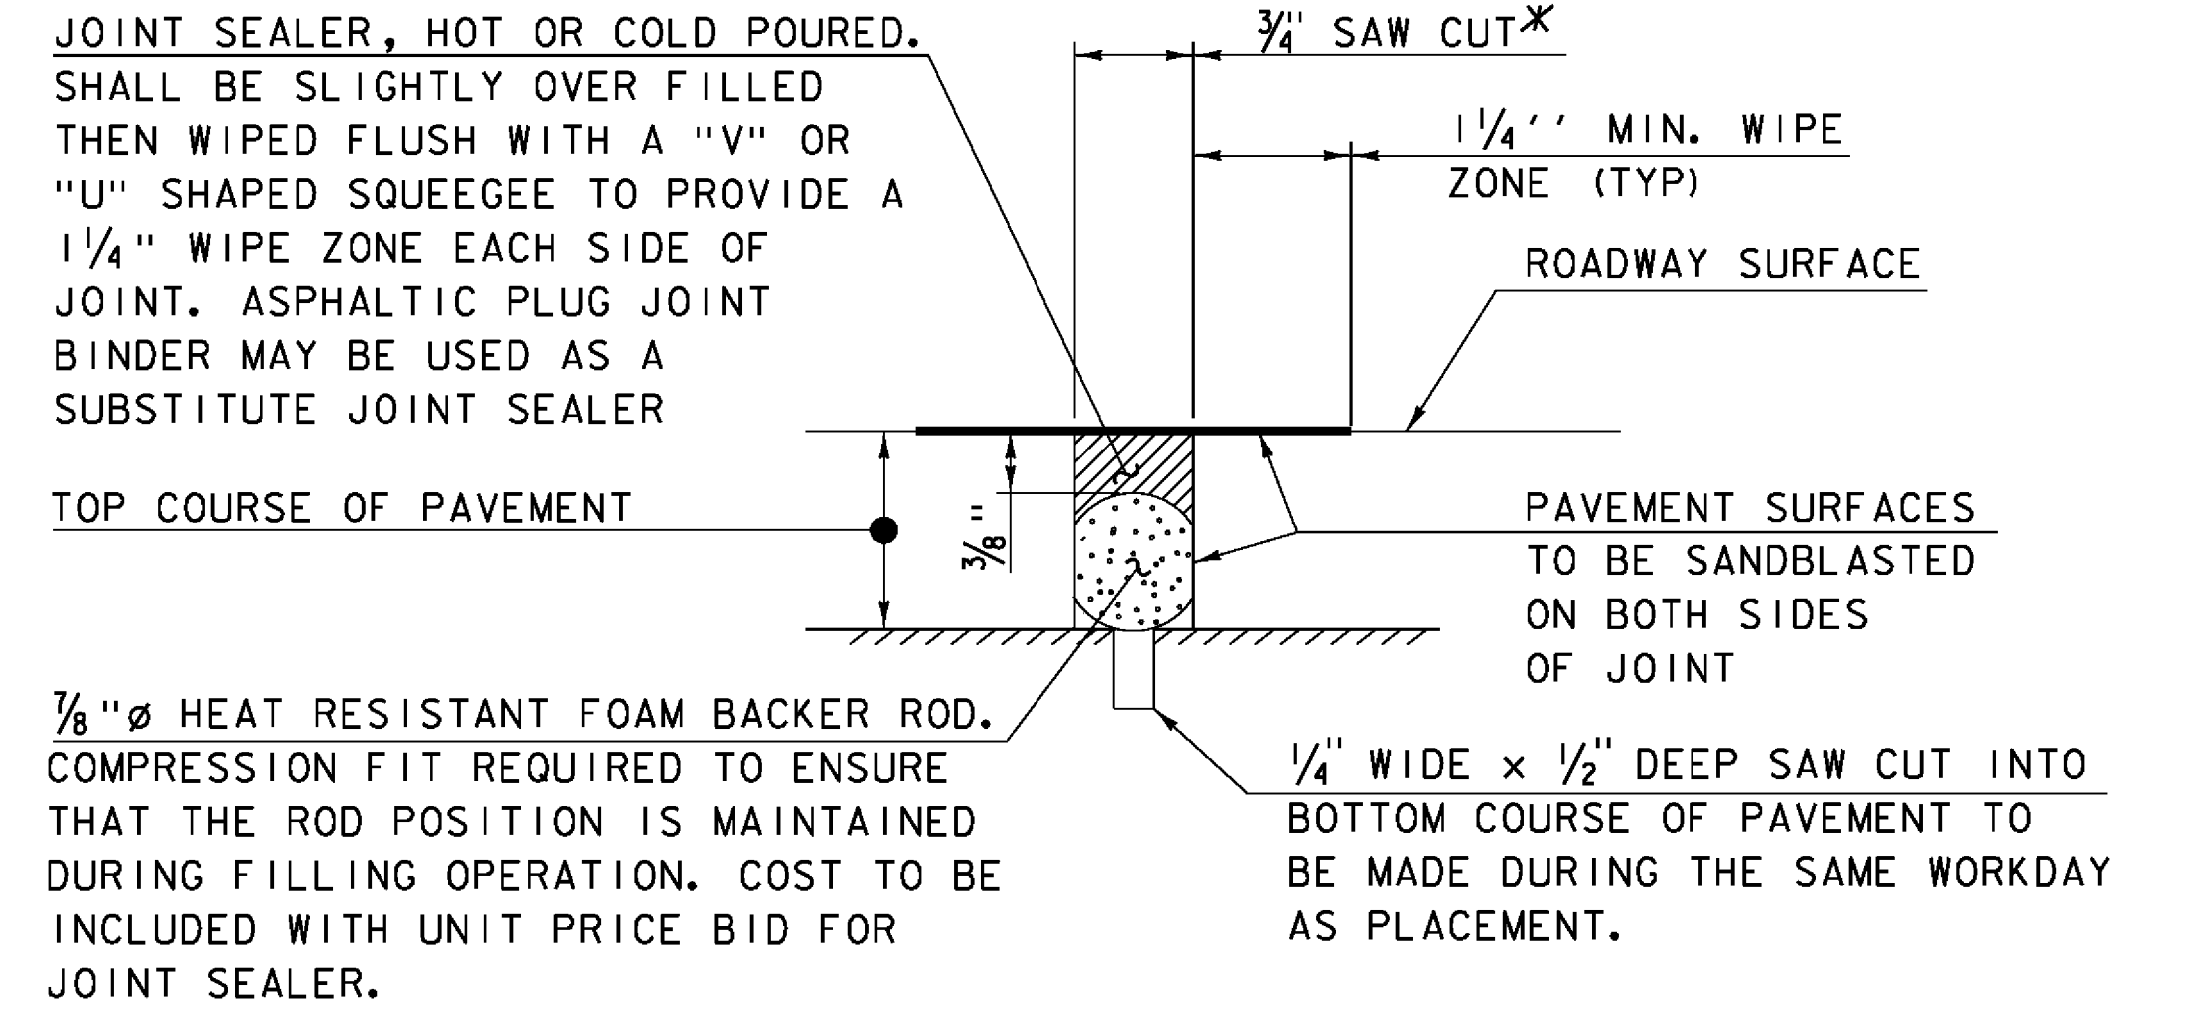

SAWED PAVEMENT JOINT DETAIL  
(NOT TO SCALE)


* JOINT IS TO BE LOCATED ACCURATELY BY STRING LINING, OR OTHER MEANS, PRIOR TO PAVING, SO THAT THE SAW CUTS WILL BE MADE DIRECTLY OVER THE END OF CONCRETE DECK. JOINT SHALL BE CUT DRY IN A SINGLE PASS AND BE SEALED WITHIN 24 HOURS OR PRIOR TO EXPOSURE TO TRAFFIC. JOINT SHALL BE CLEANED PRIOR TO APPLYING THE JOINT SEALER.

* TURN AND/OR ADJUST BARS TO FIT AROUND PILES AND/OR GIRDERS AS REQUIRED


**NOTE:**  
 NF = NEAR FACE  
 FF = FAR FACE  
 EF = EACH FACE  
 ▲ = CUT TO FIT IN FIELD  
 3" CLEAR, UNLESS OTHERWISE SPECIFIED ON THE PLANS.  
 2'-2" BAR LAP UNLESS OTHERWISE SPECIFIED ON THE PLANS.

PROJECT NAME: ROYALTON	PLOT DATE: 08-OCT-2013
PROJECT NUMBER: BRS 0147(13)	DRAWN BY: C. MOONEY
FILE NAME: s86e005sub.dgn	CHECKED BY: D. PETERSON
PROJECT LEADER: C. CARLSON	SHEET 40 OF 186
DESIGNED BY: D. PETERSON	
BRIDGE 27 ABUTMENT TYPICAL SHEET	



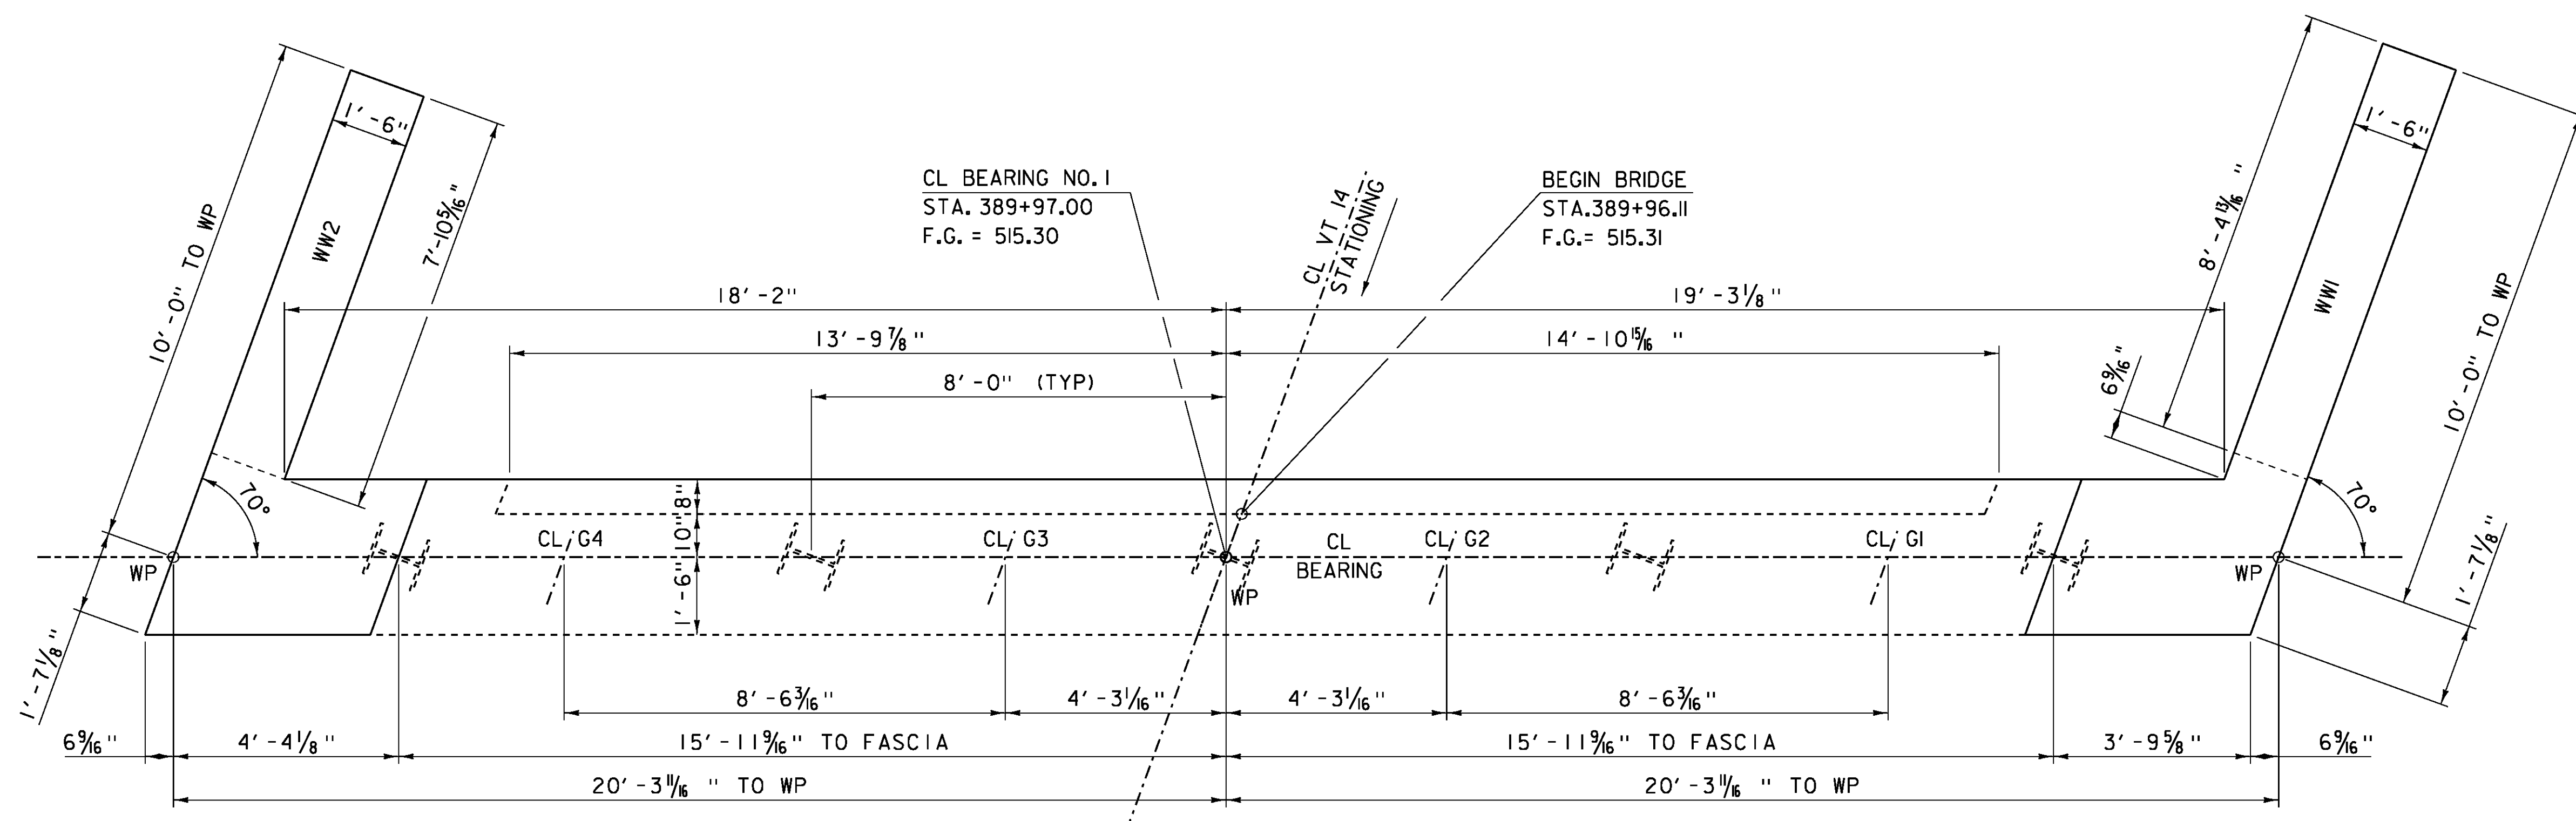


INTEGRAL ABUTMENT NO. 1 PLAN  
SCALE 1/2"=1'-0"

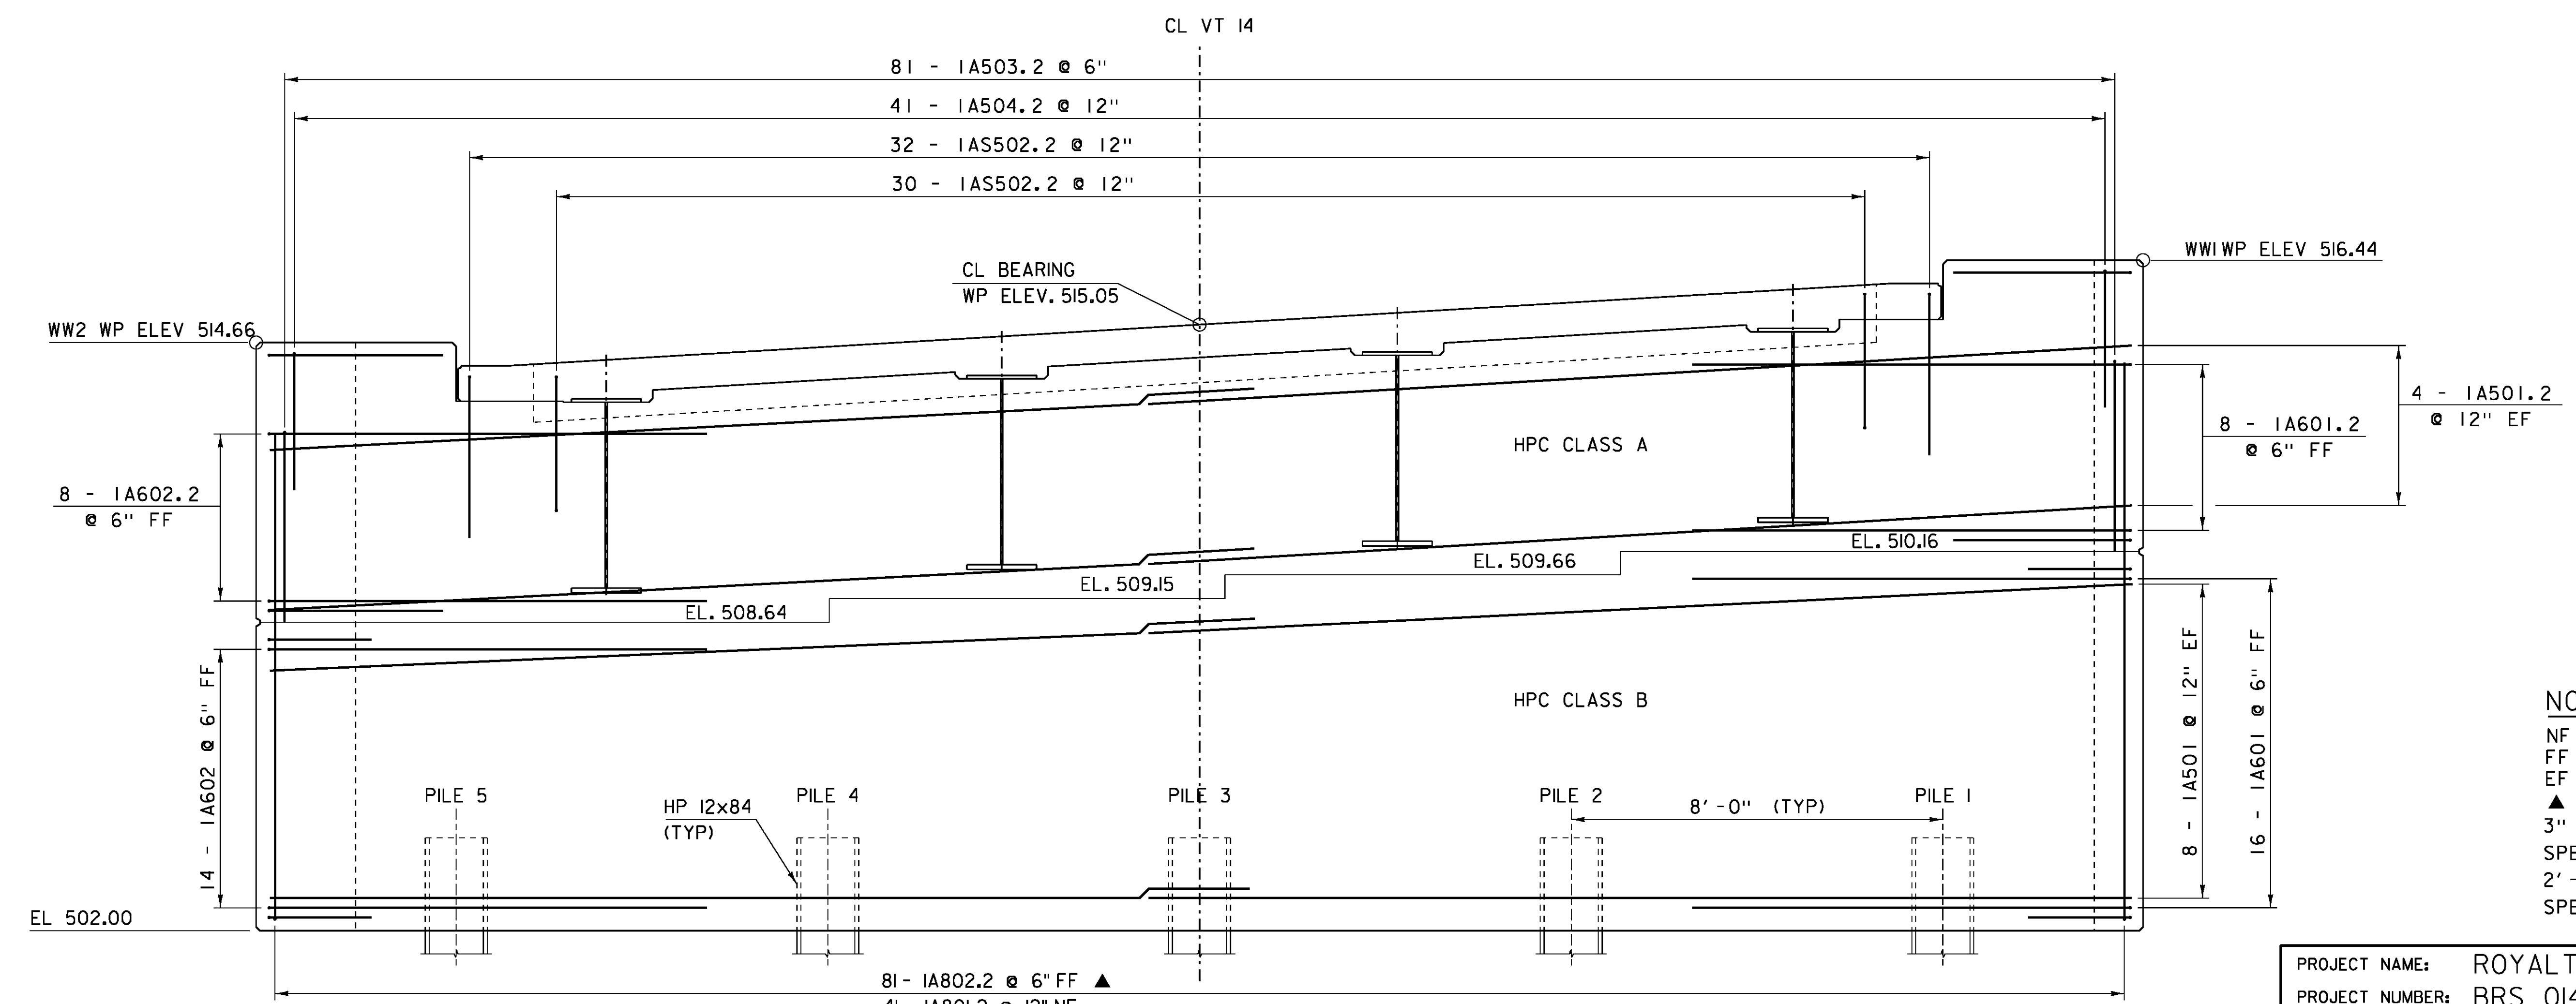


INTEGRAL ABUTMENT NO. 1 ELEVATION  
SCALE 1/2"=1'-0"

**NOTE:**  
 NF = NEAR FACE  
 FF = FAR FACE  
 EF = EACH FACE  
 ▲ = CUT TO FIT IN FIELD  
 3" CLEAR, UNLESS OTHERWISE SPECIFIED ON THE PLANS.  
 2'-2" BAR LAP UNLESS OTHERWISE SPECIFIED ON THE PLANS.

PROJECT NAME: ROYALTON	PLOT DATE: 08-OCT-2013
PROJECT NUMBER: BRS 0147(I3)	DRAWN BY: C. MOONEY
FILE NAME: s86e005sub.dgn	CHECKED BY: J. LACROIX
PROJECT LEADER: C. CARLSON	DESIGNED BY: D. PETERSON
BRIDGE 27 ABUTMENT 1 PLAN AND ELEVATION SHEET 41 OF 186	

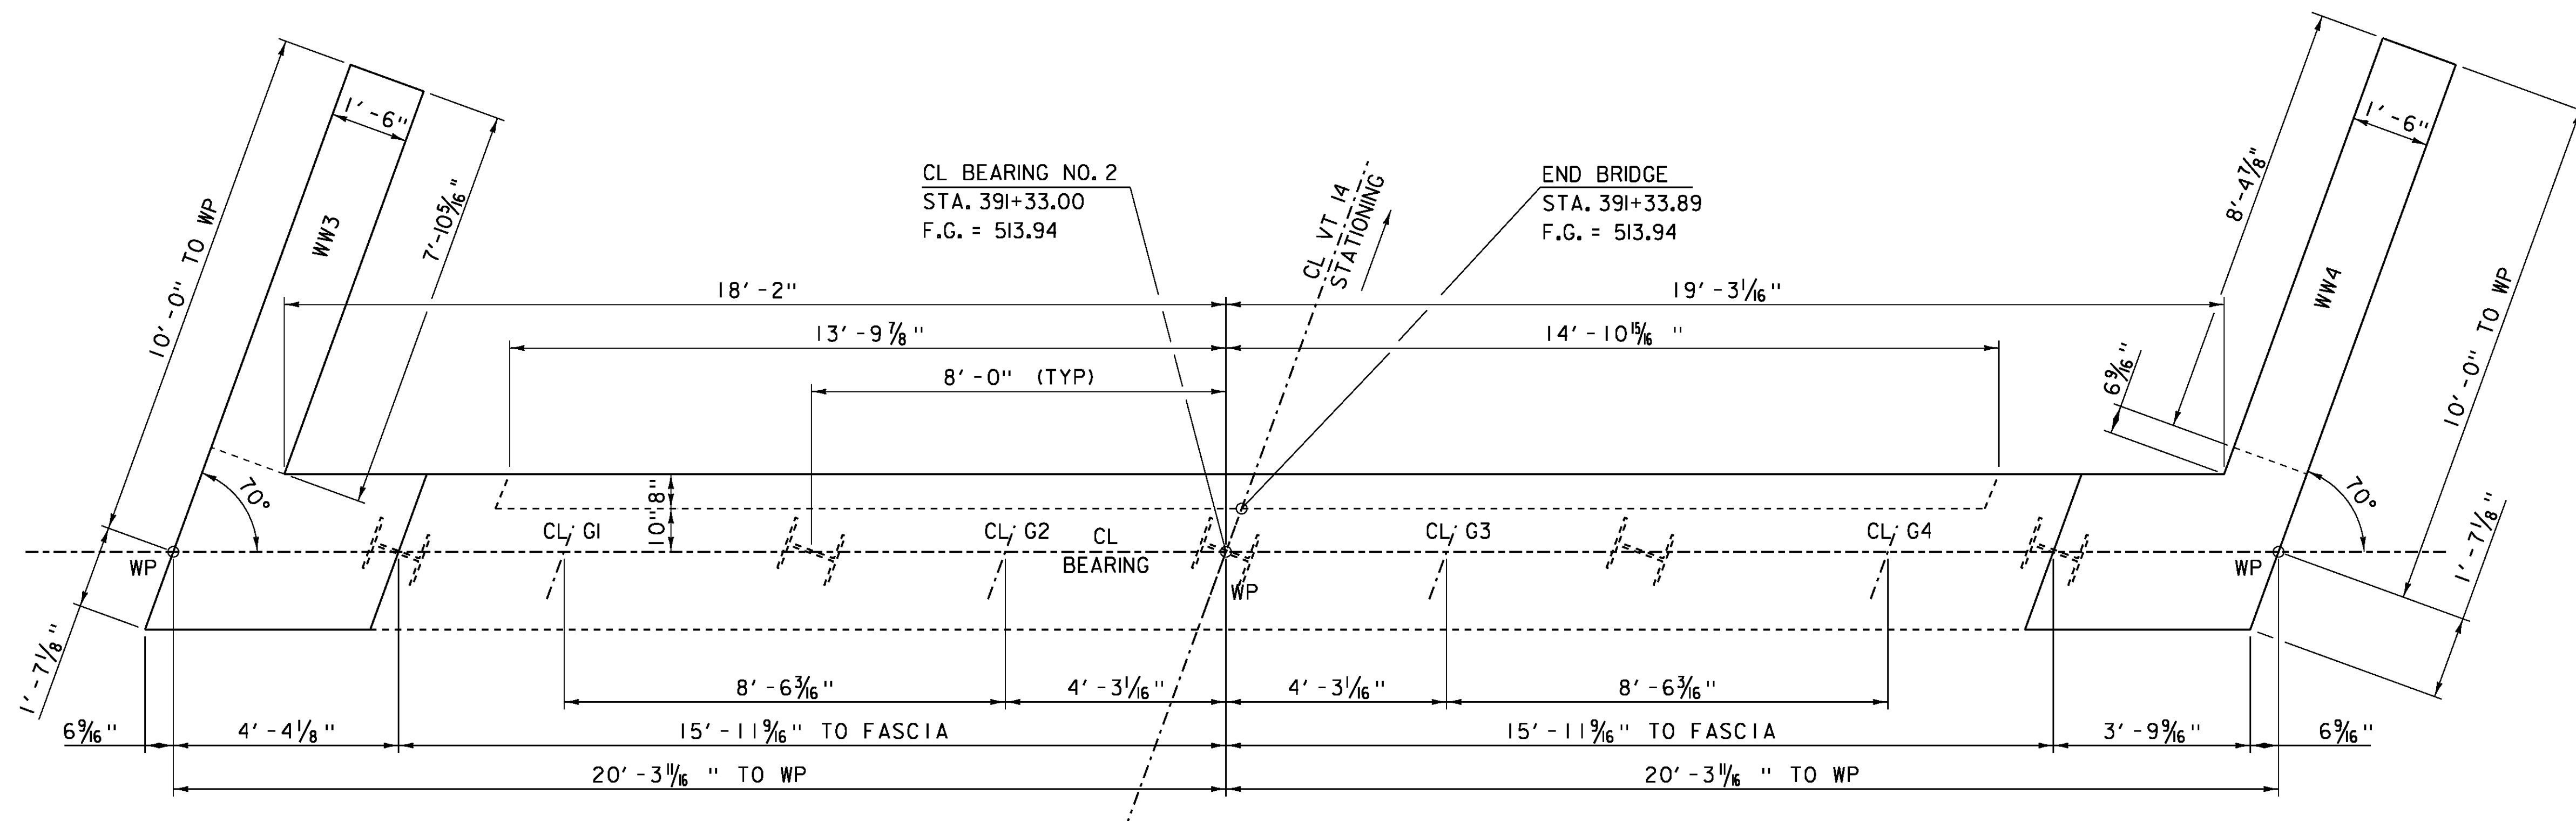




INTEGRAL ABUTMENT NO. 2 PLAN  
SCALE 1/2"=1'-0"

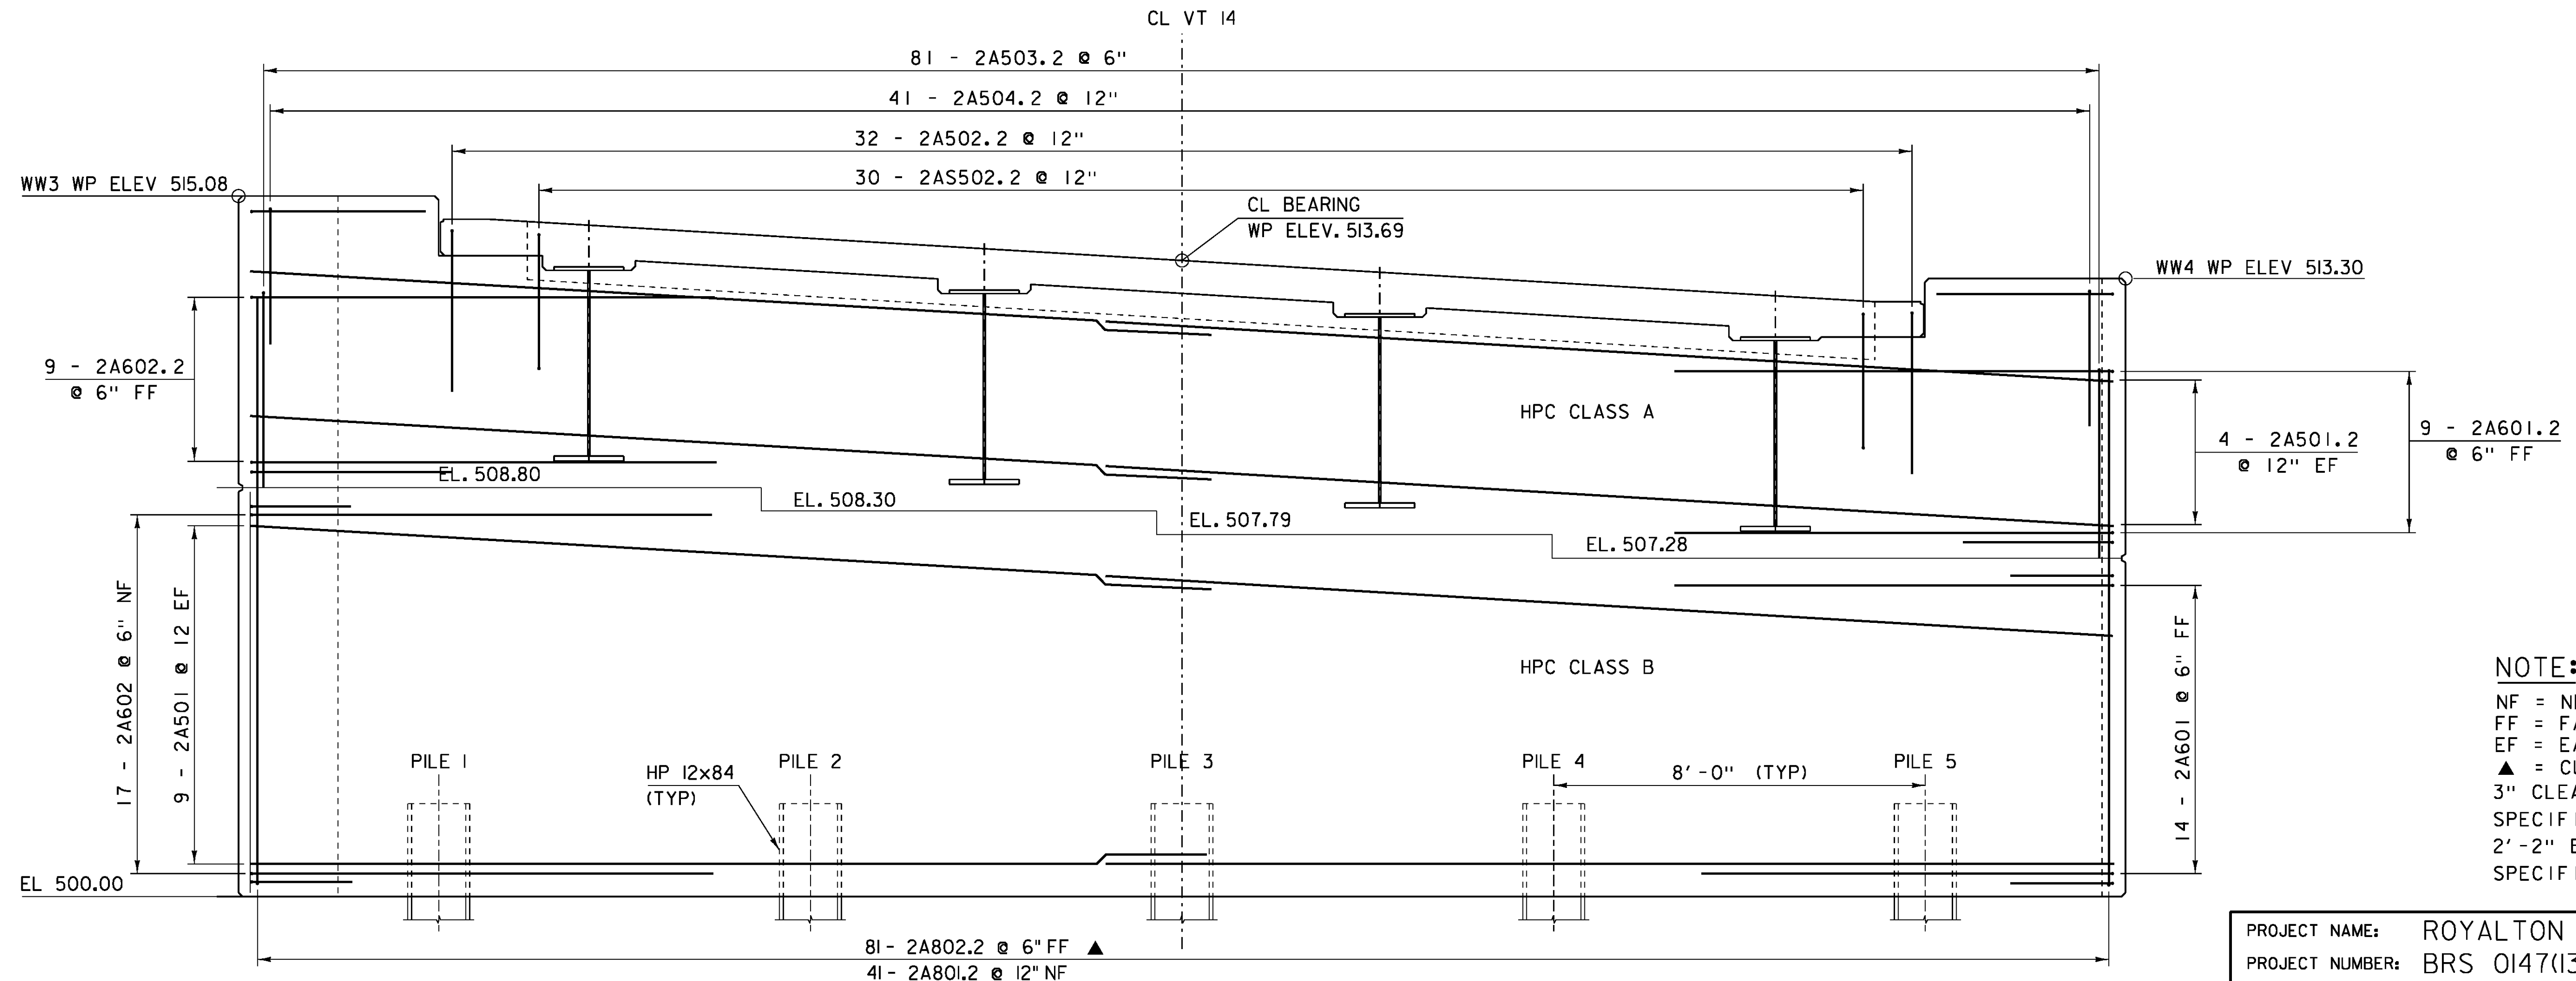

INTEGRAL ABUTMENT NO. 2 ELEVATION  
SCALE 1/2"=1'-0"


**NOTE:**  
 NF = NEAR FACE  
 FF = FAR FACE  
 EF = EACH FACE  
 ▲ = CUT TO FIT IN FIELD  
 3" CLEAR, UNLESS OTHERWISE SPECIFIED ON THE PLANS.  
 2'-2" BAR LAP UNLESS OTHERWISE SPECIFIED ON THE PLANS.

PROJECT NAME:	ROYALTON
PROJECT NUMBER:	BRS 0147(I3)
FILE NAME:	s86e005sub.dgn
PROJECT LEADER:	C. CARLSON
DESIGNED BY:	D. PETERSON
BRIDGE 27 ABUTMENT 2 PLAN AND ELEVATION	SHEET 42 OF 186
PLOT DATE:	08-OCT-2013
DRAWN BY:	C. MOONEY
CHECKED BY:	J. LACROIX

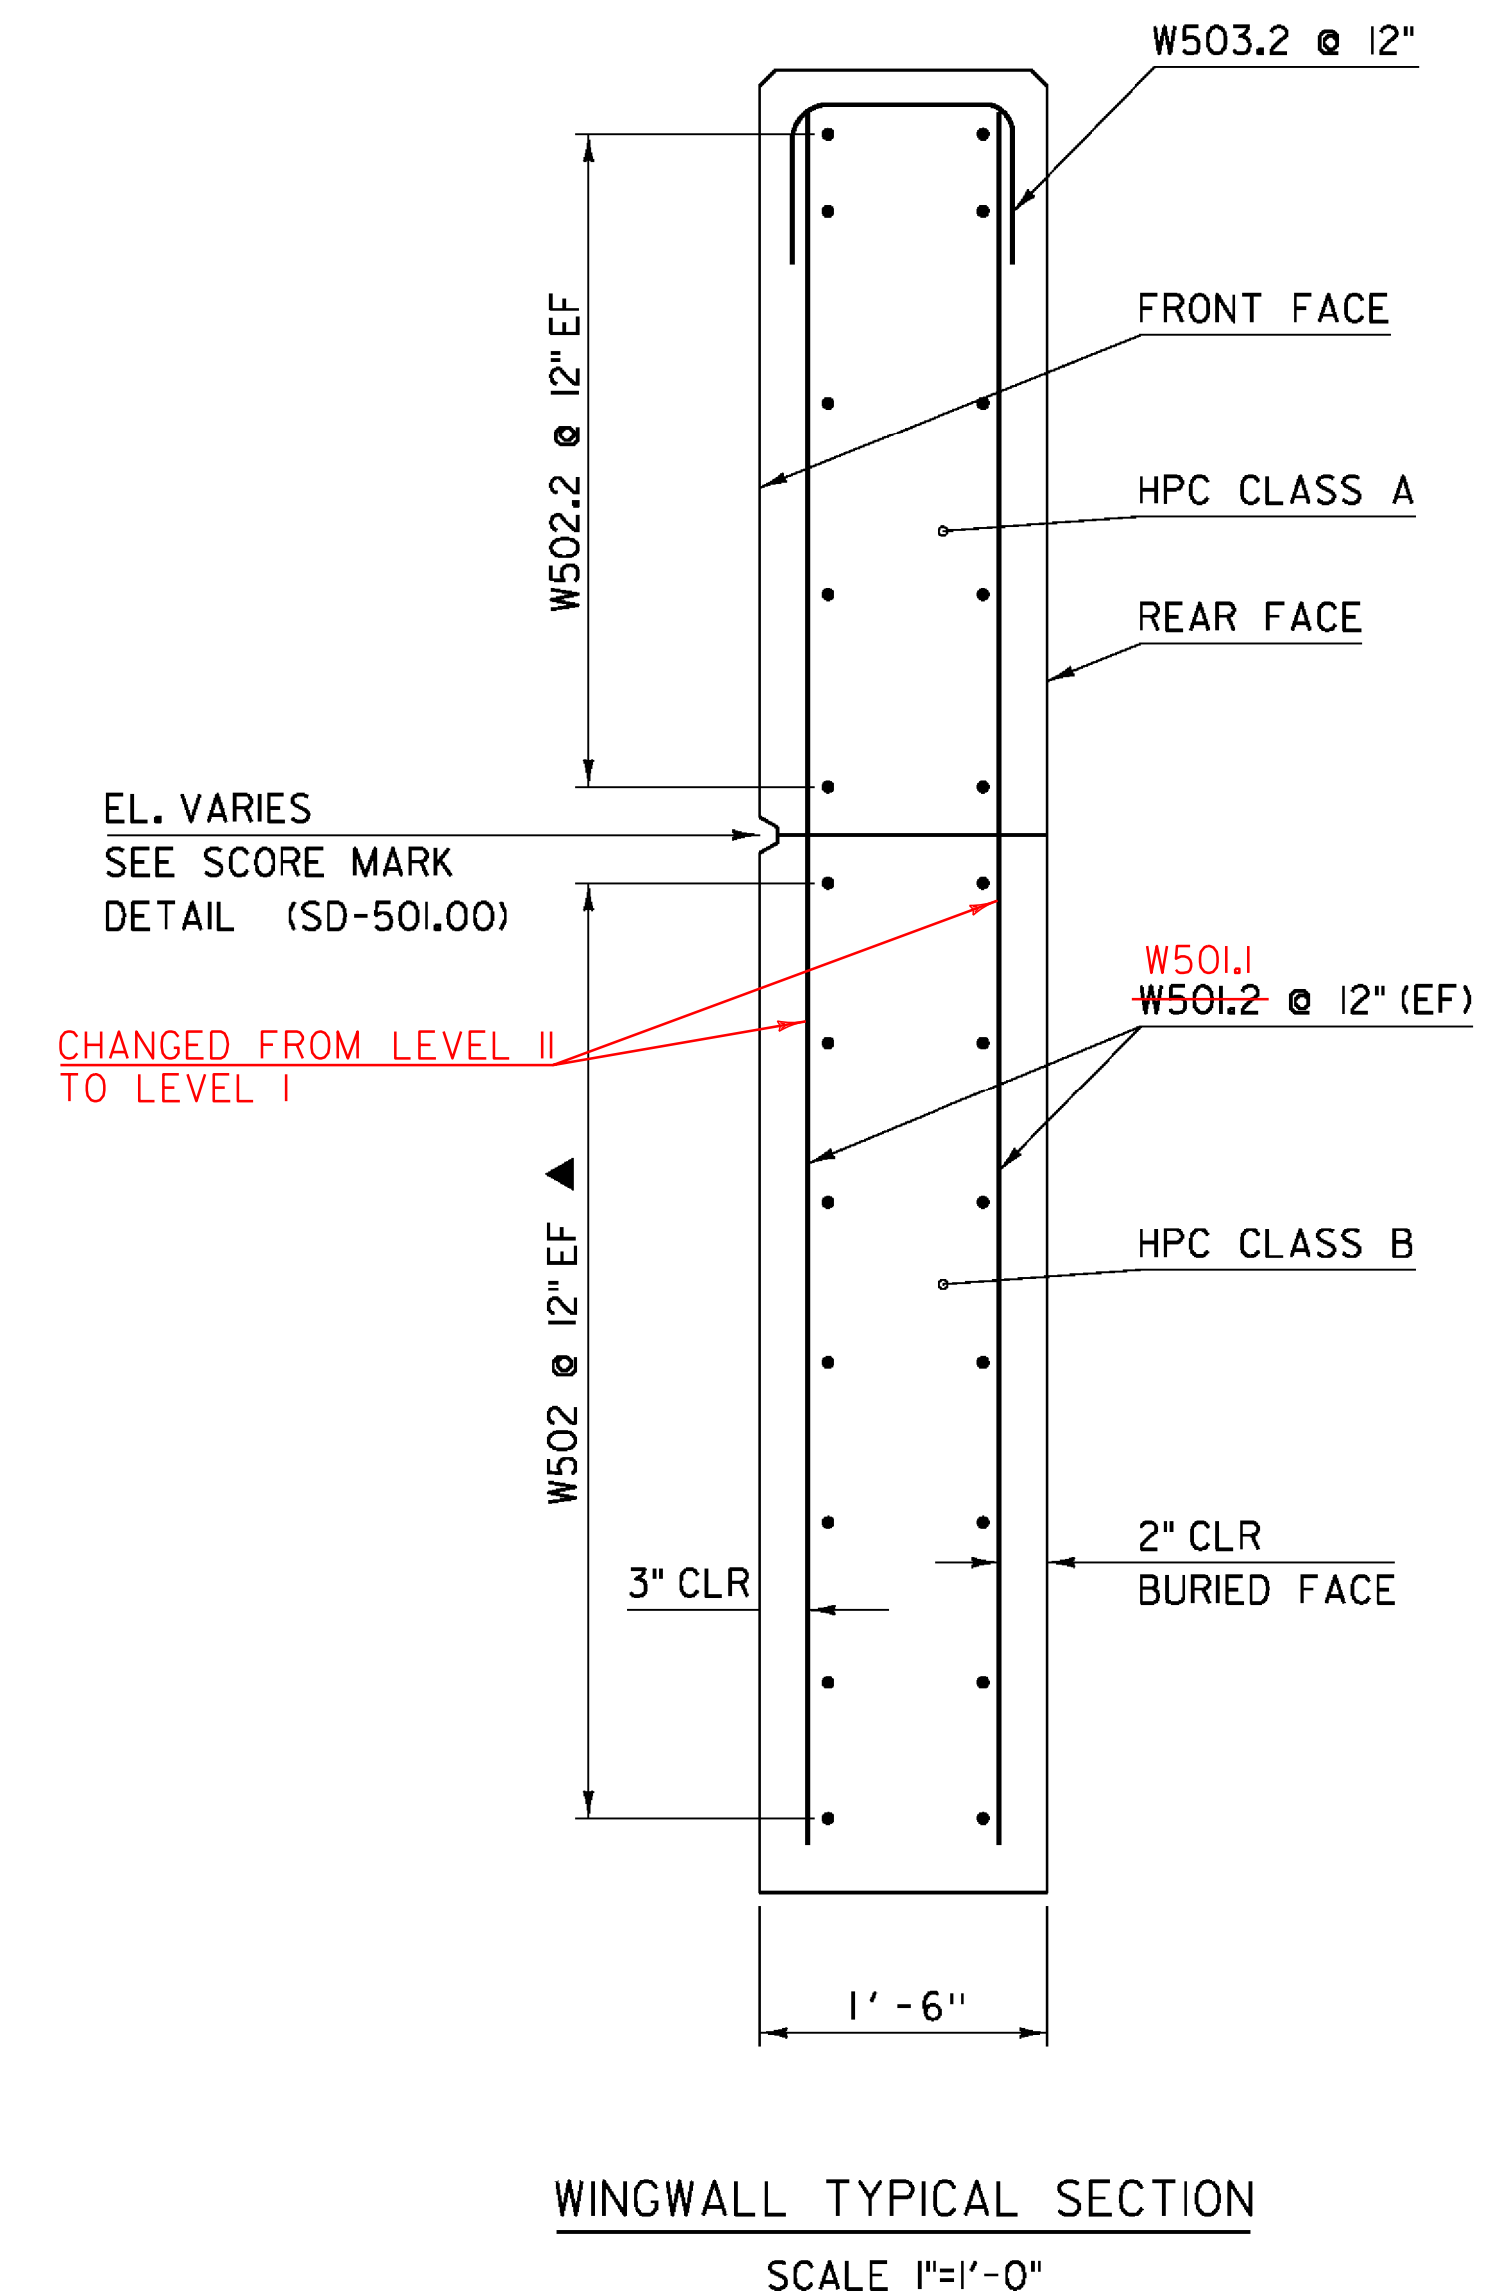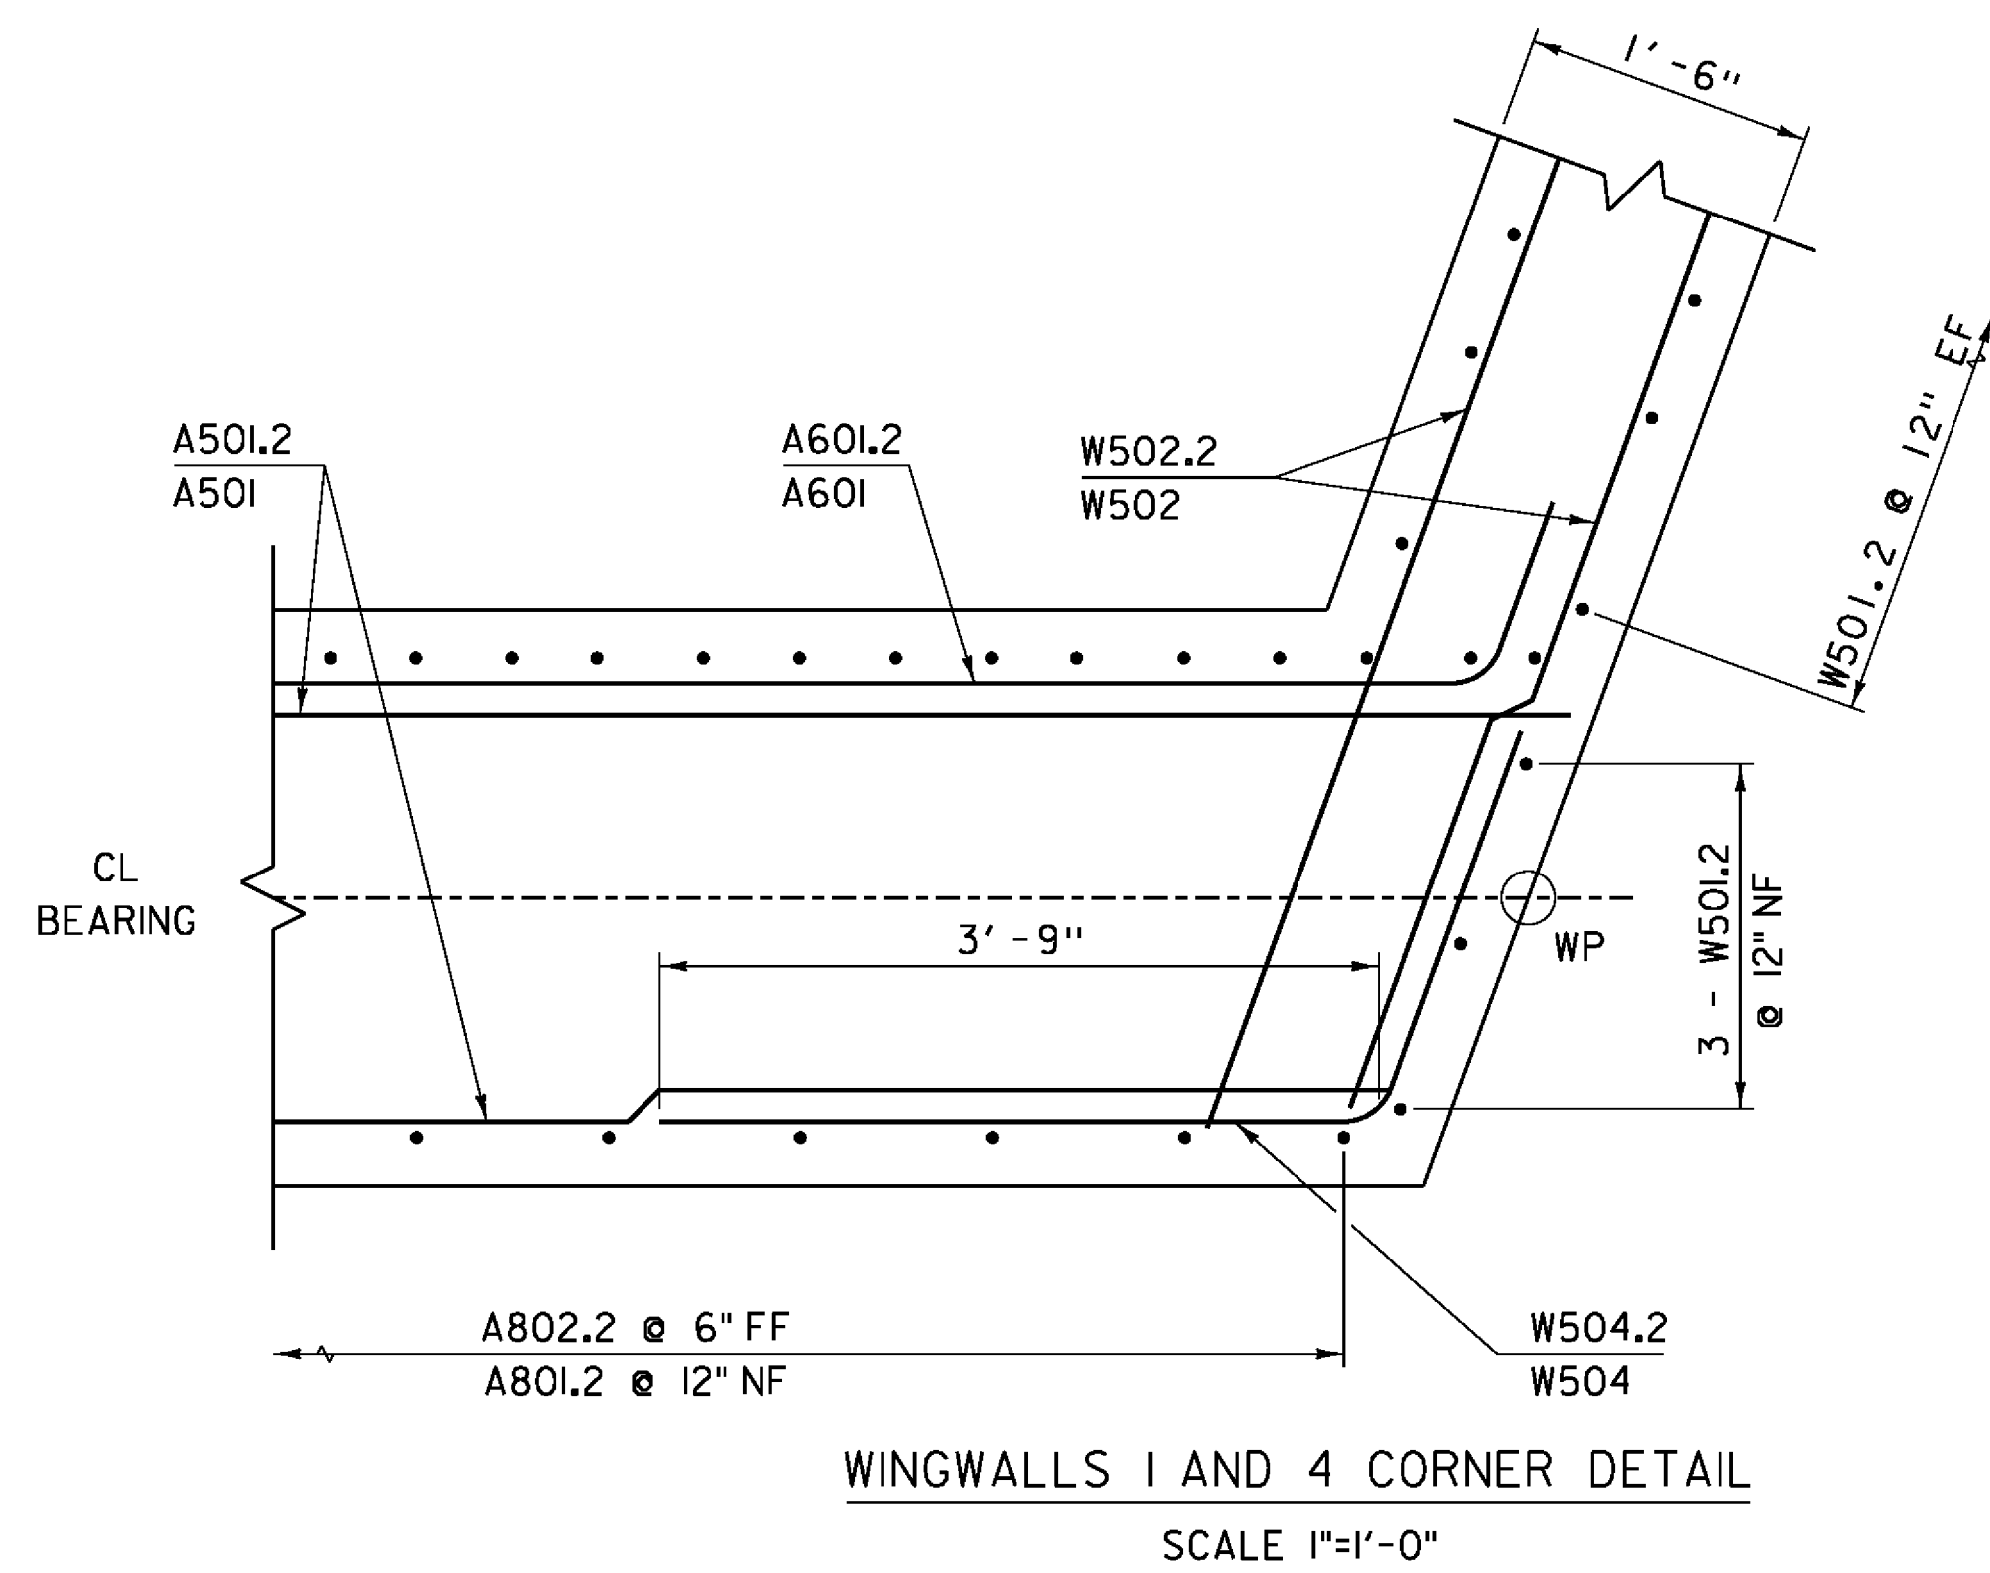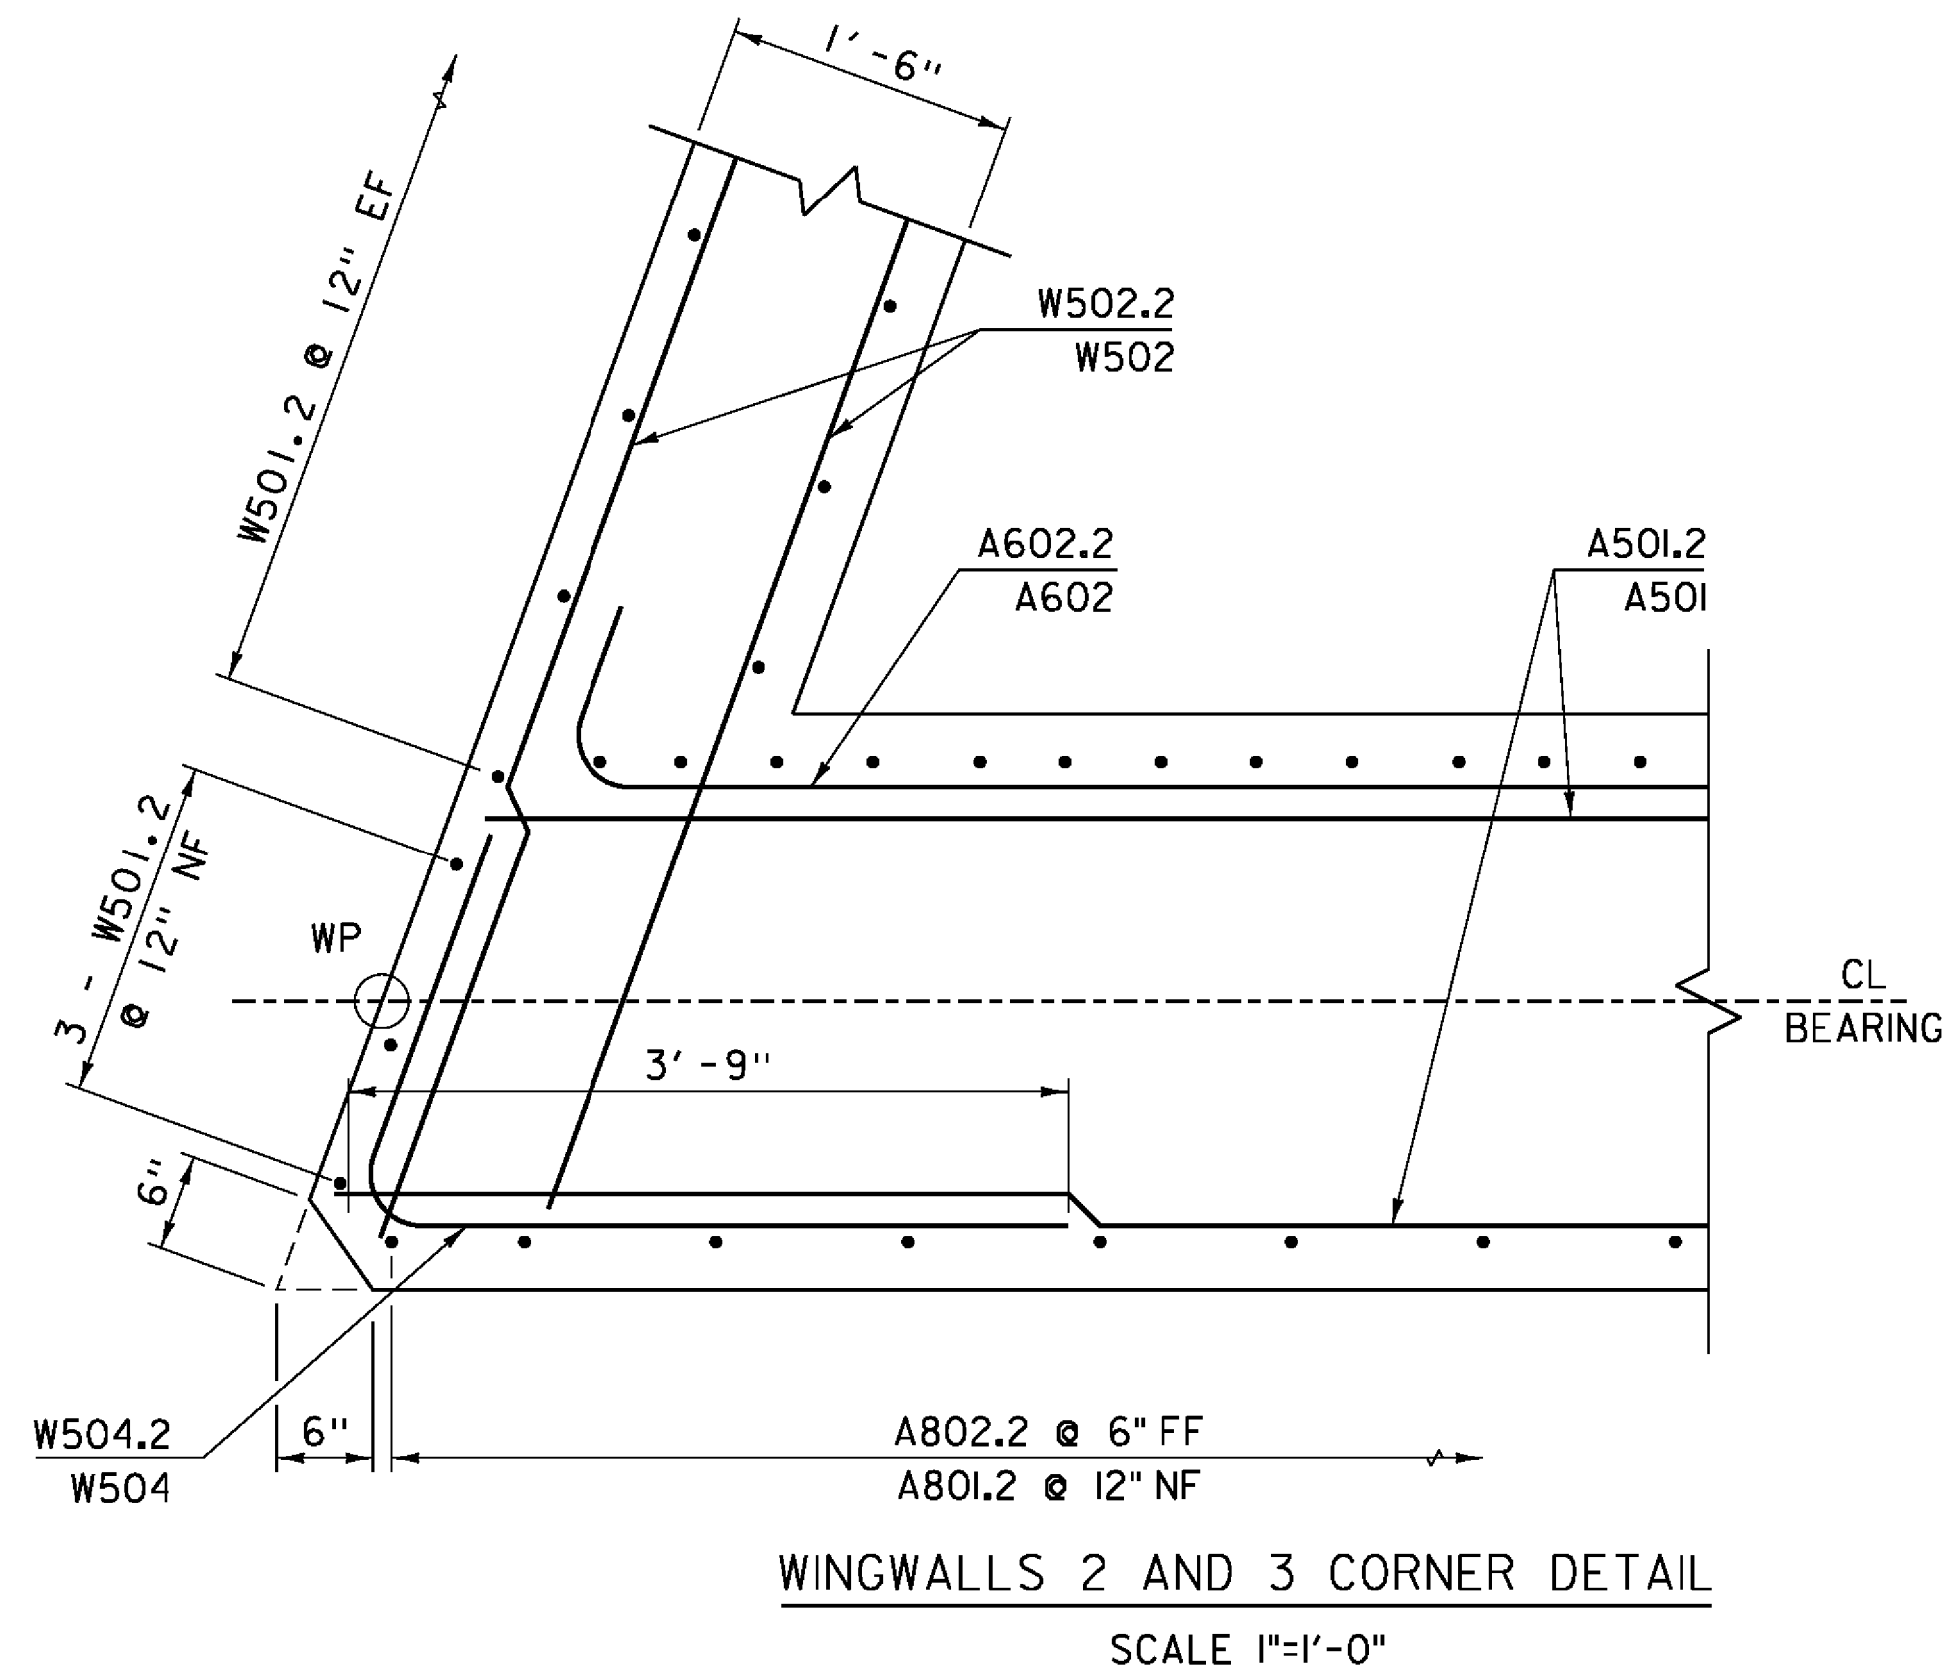


**NOTE:**  
 NF = NEAR FACE  
 FF = FAR FACE  
 EF = EACH FACE  
 ▲ = CUT TO FIT IN FIELD  
 3" CLEAR, UNLESS OTHERWISE SPECIFIED ON THE PLANS.  
 2'-2" BAR LAP UNLESS OTHERWISE SPECIFIED ON THE PLANS.

PROJECT NAME: ROYALTON	
PROJECT NUMBER: BRS 0147(13)	
FILE NAME: s86e005sub.dgn	PLOT DATE: 08-OCT-2013
PROJECT LEADER: C. CARLSON	DRAWN BY: C. MOONEY
DESIGNED BY: D. PETERSON	CHECKED BY: D. PETERSON
BRIDGE 27 WINGWALL DETAILS SHEET	SHEET 43 OF 186

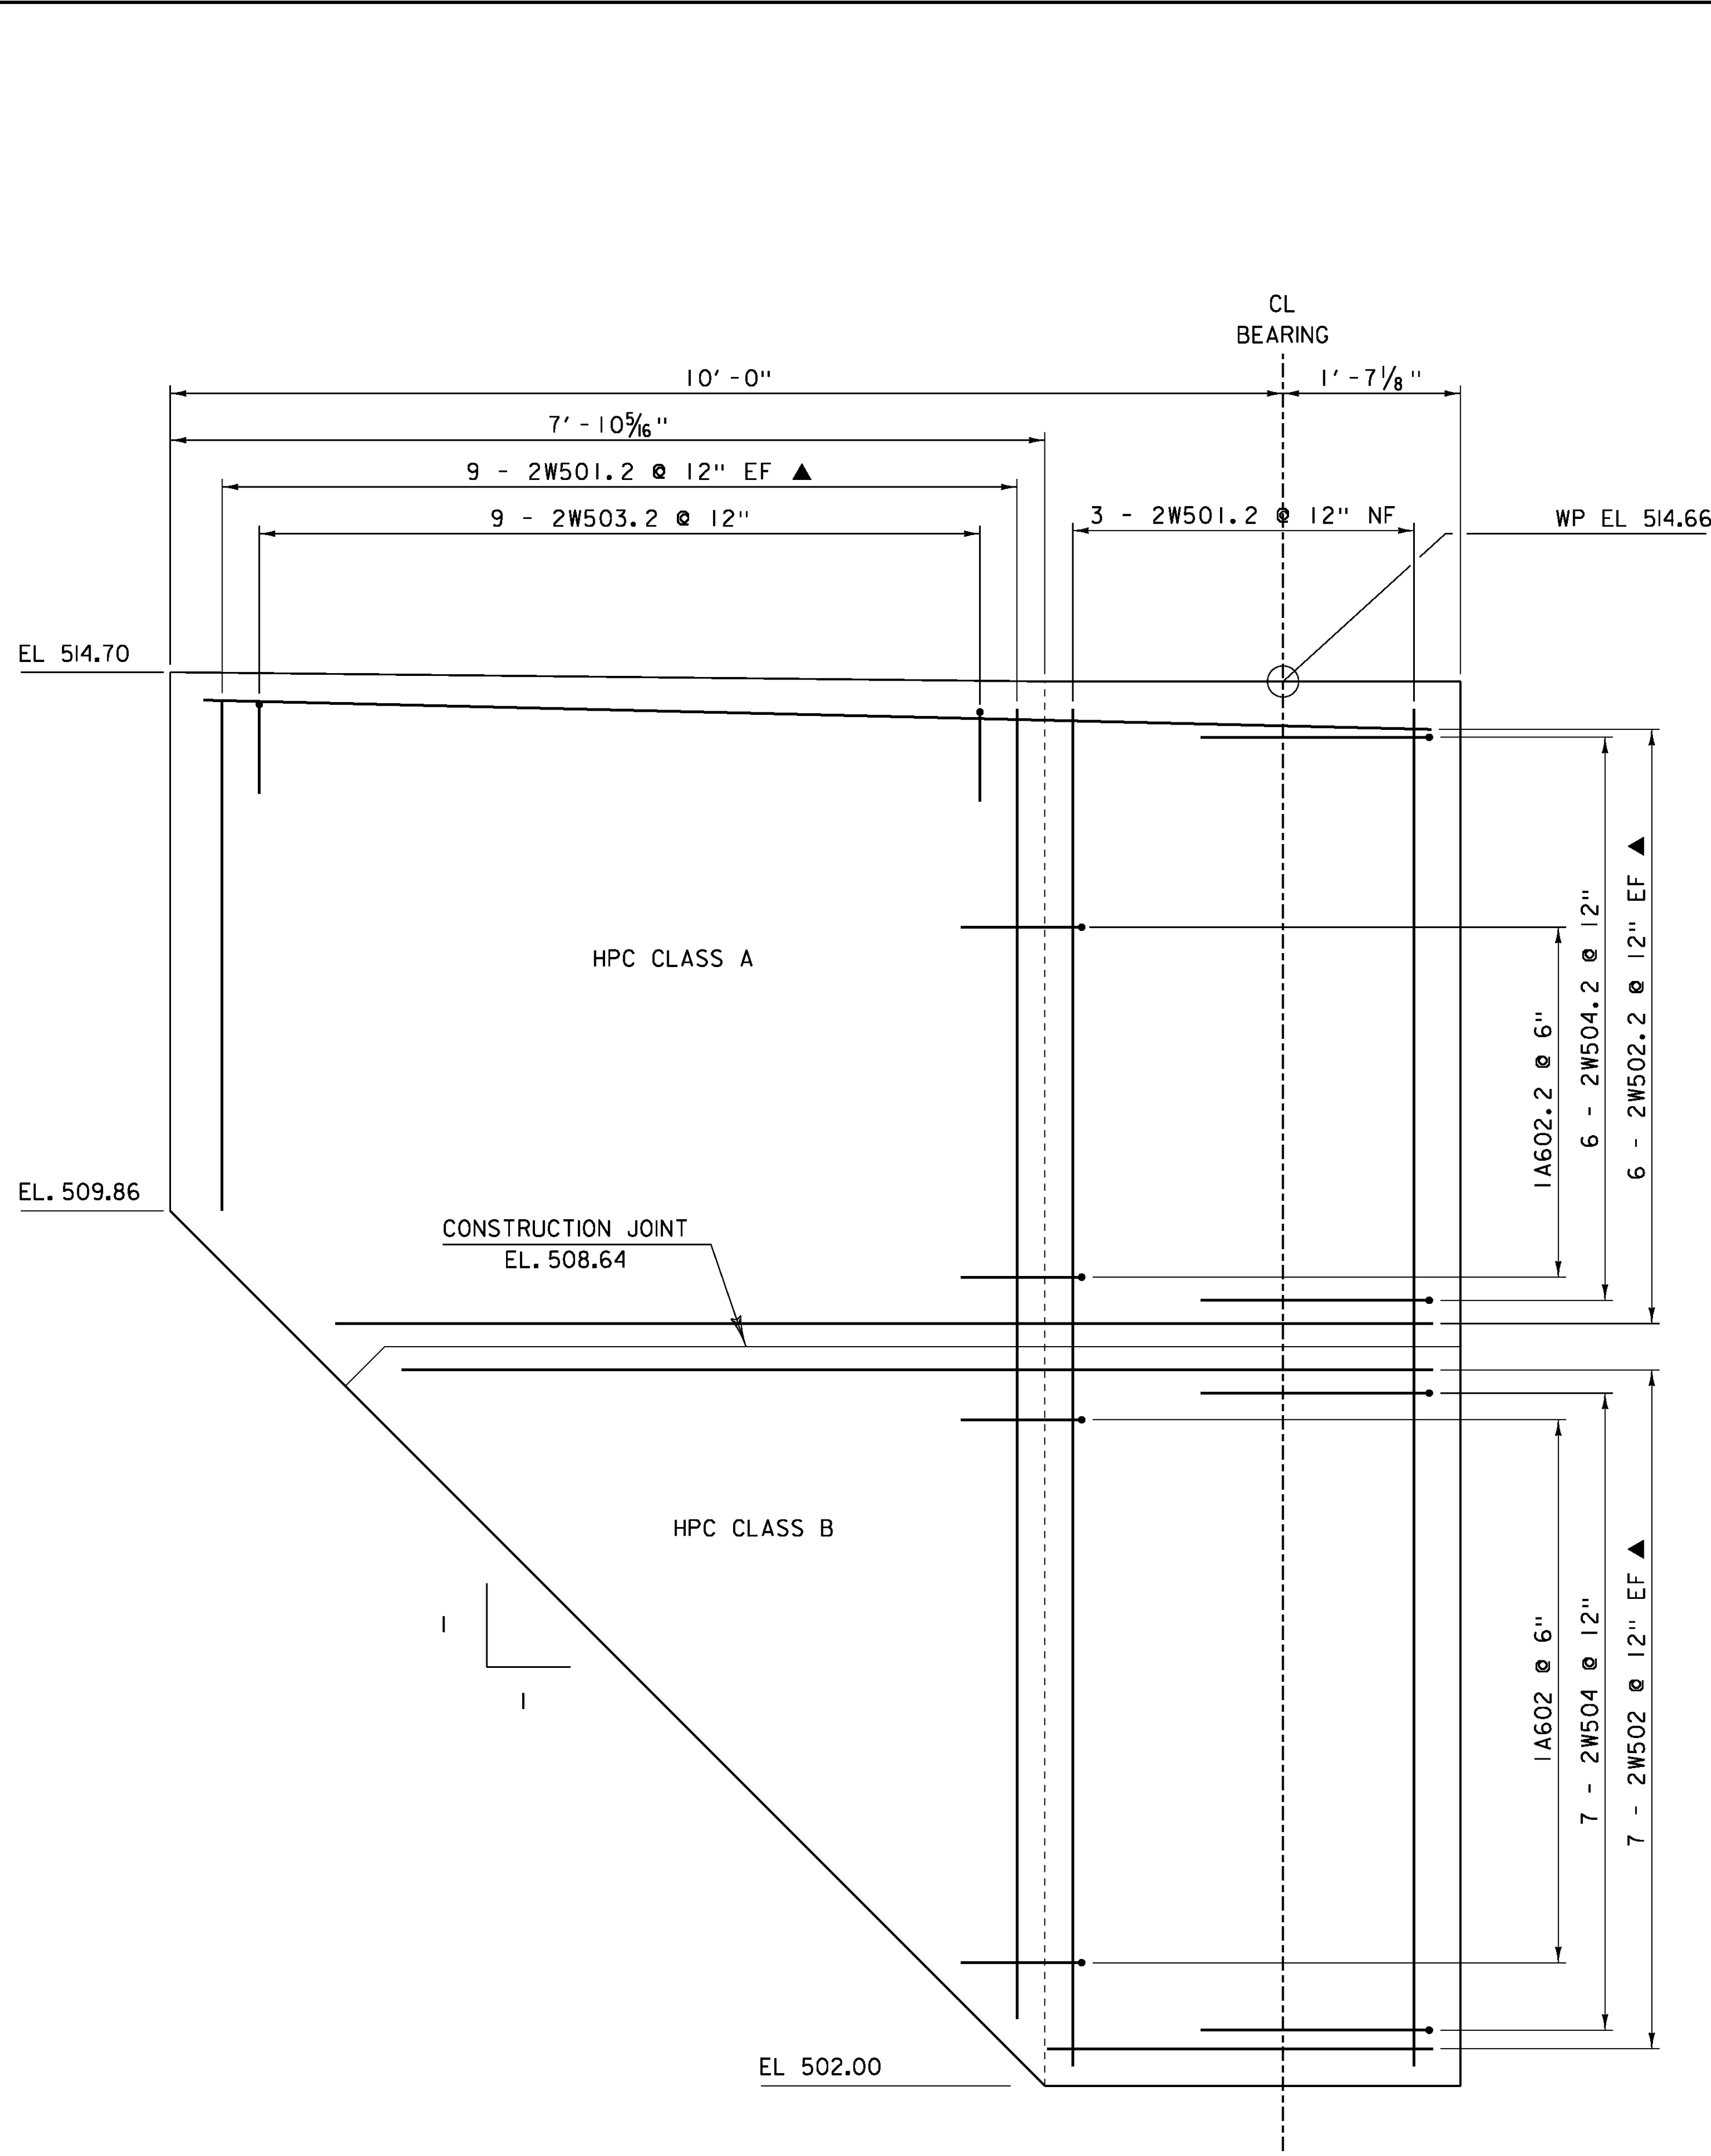


WINGWALL 2 ELEVATION  
SCALE 1"=1'-0"

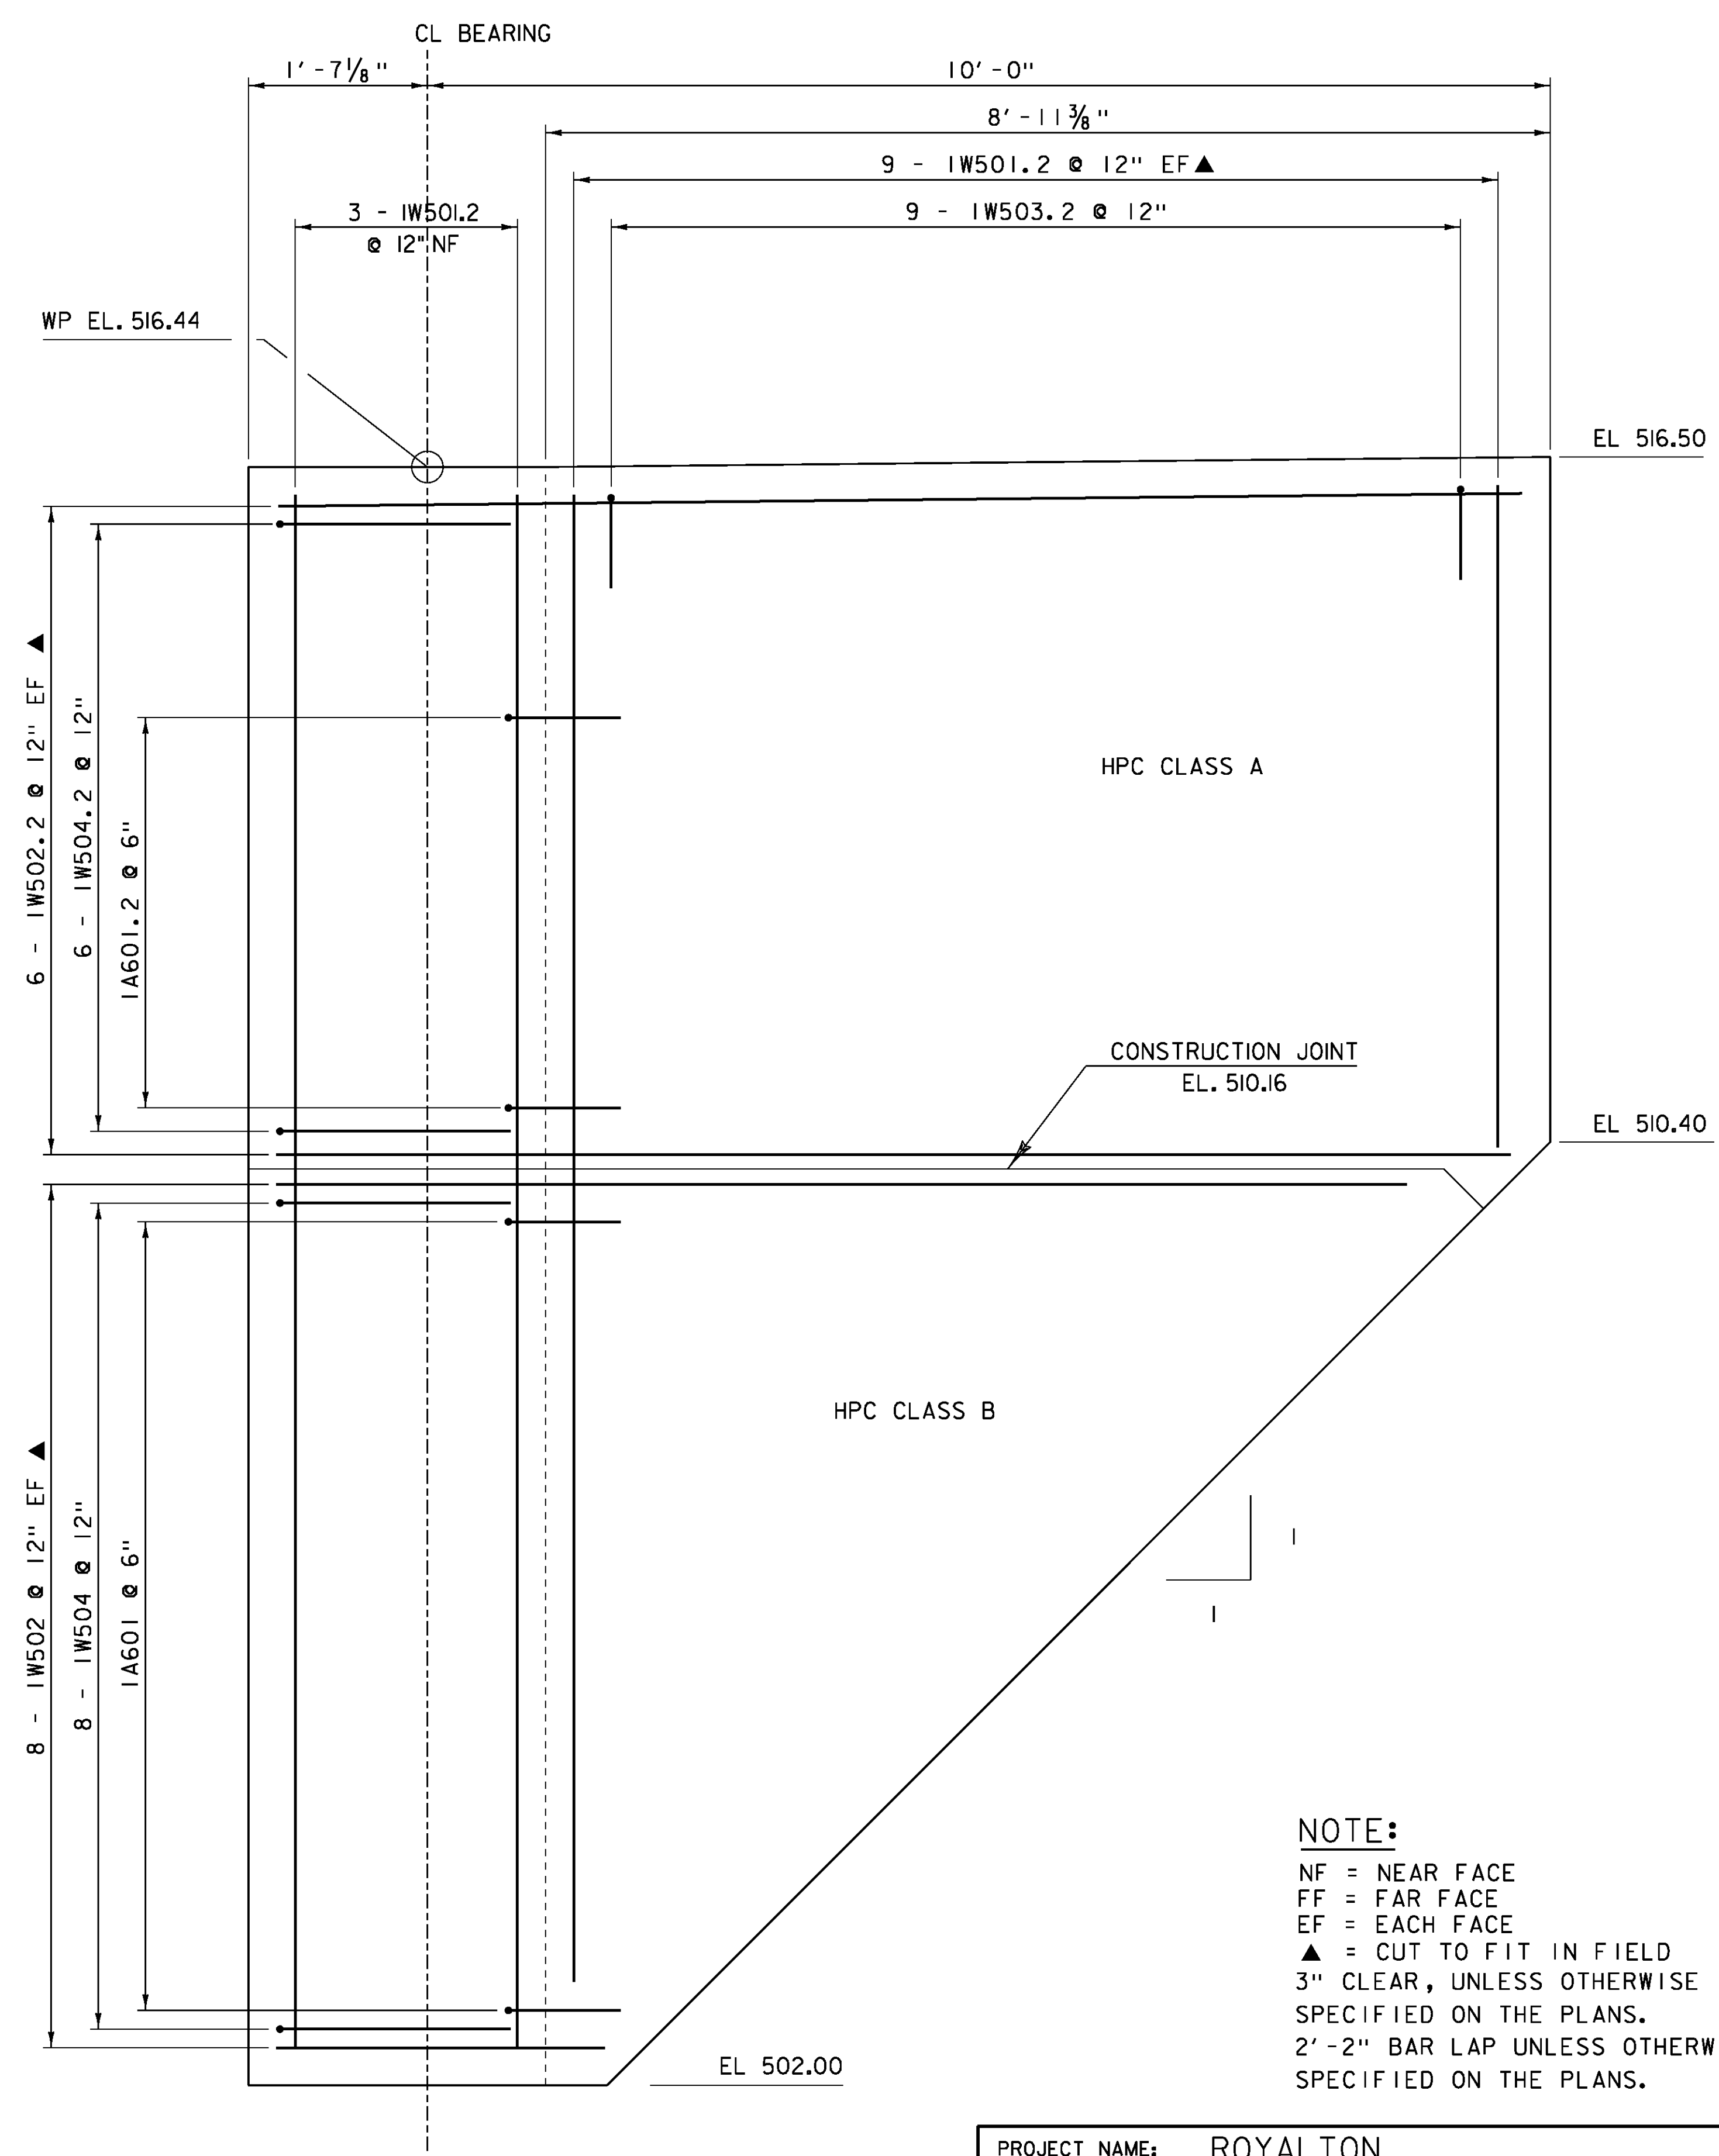


WINGWALL 1 ELEVATION  
SCALE 1"=1'-0"

**NOTE:**  
 NF = NEAR FACE  
 FF = FAR FACE  
 EF = EACH FACE  
 ▲ = CUT TO FIT IN FIELD  
 3" CLEAR, UNLESS OTHERWISE SPECIFIED ON THE PLANS.  
 2'-2" BAR LAP UNLESS OTHERWISE SPECIFIED ON THE PLANS.

PROJECT NAME:	ROYALTON
PROJECT NUMBER:	BRS 0147(13)
FILE NAME:	s86e005sub.dgn
PROJECT LEADER:	C. CARLSON
DESIGNED BY:	D. PETERSON
BRIDGE 27 WINGWALLS 1 AND 2 ELEVATIONS	SHEET 44 OF 186
PLOT DATE:	08-OCT-2013
DRAWN BY:	C. MOONEY
CHECKED BY:	J. LACROIX

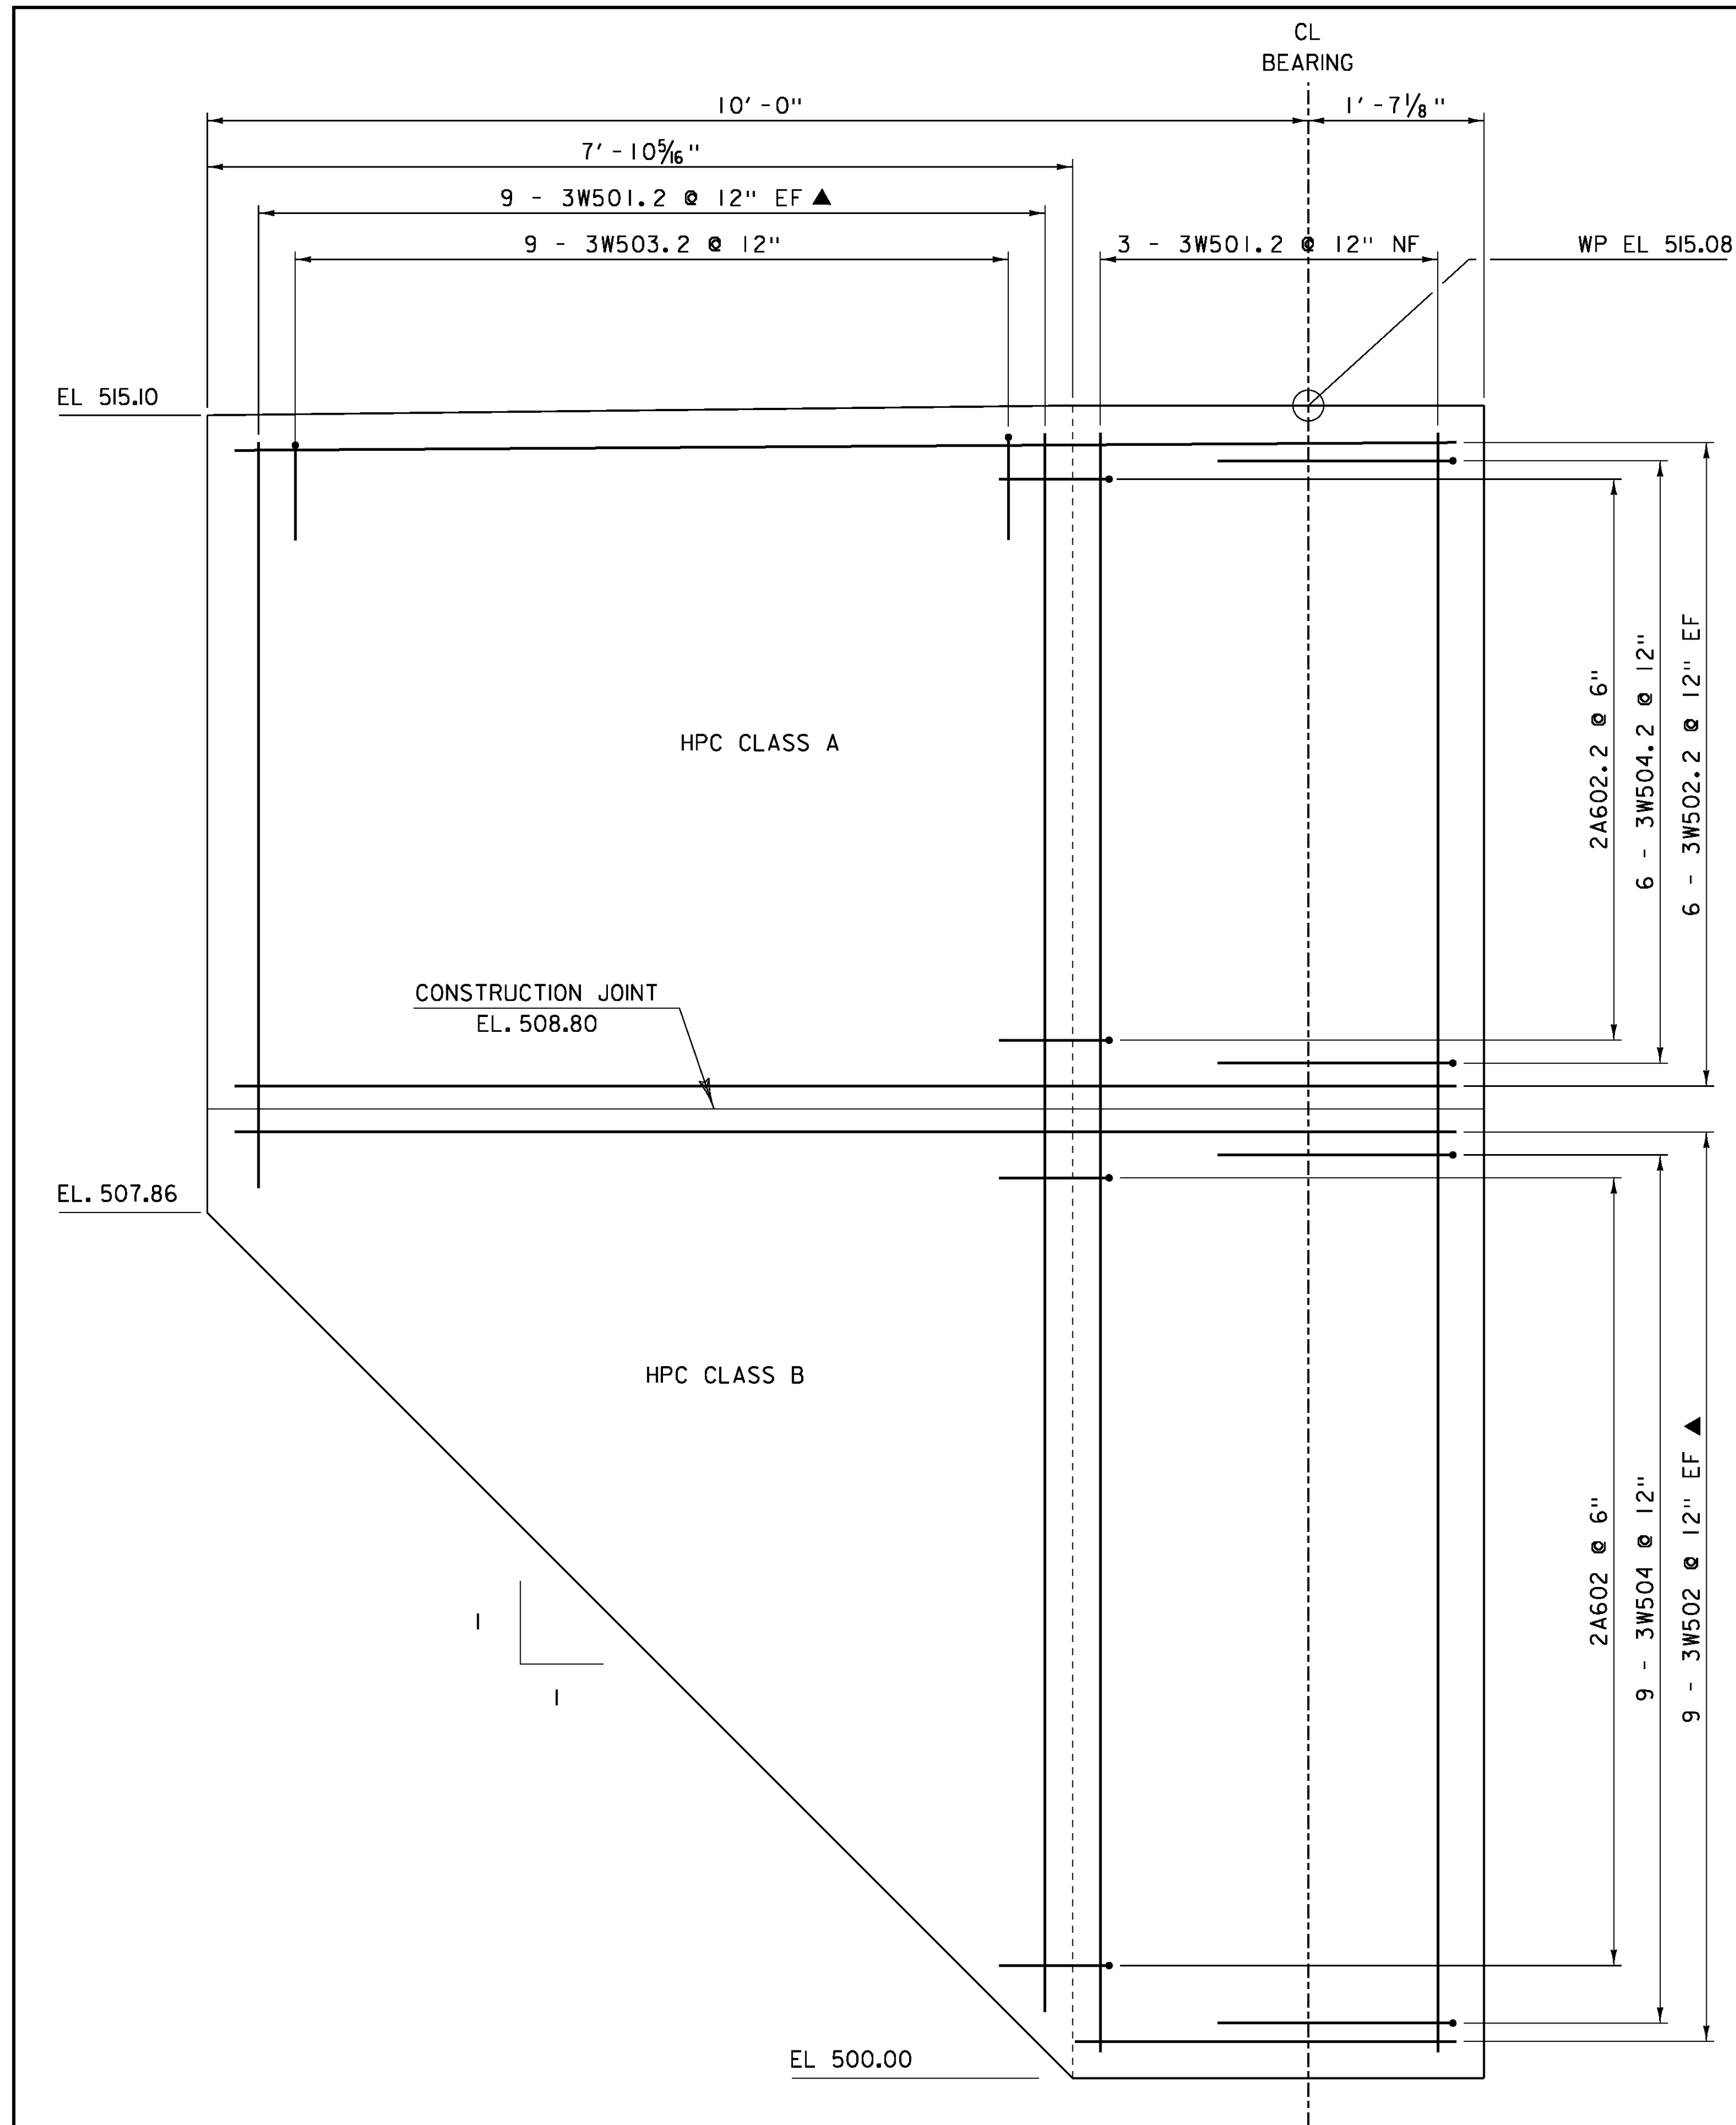

WINGWALL 3 ELEVATION  
SCALE 1"=1'-0"

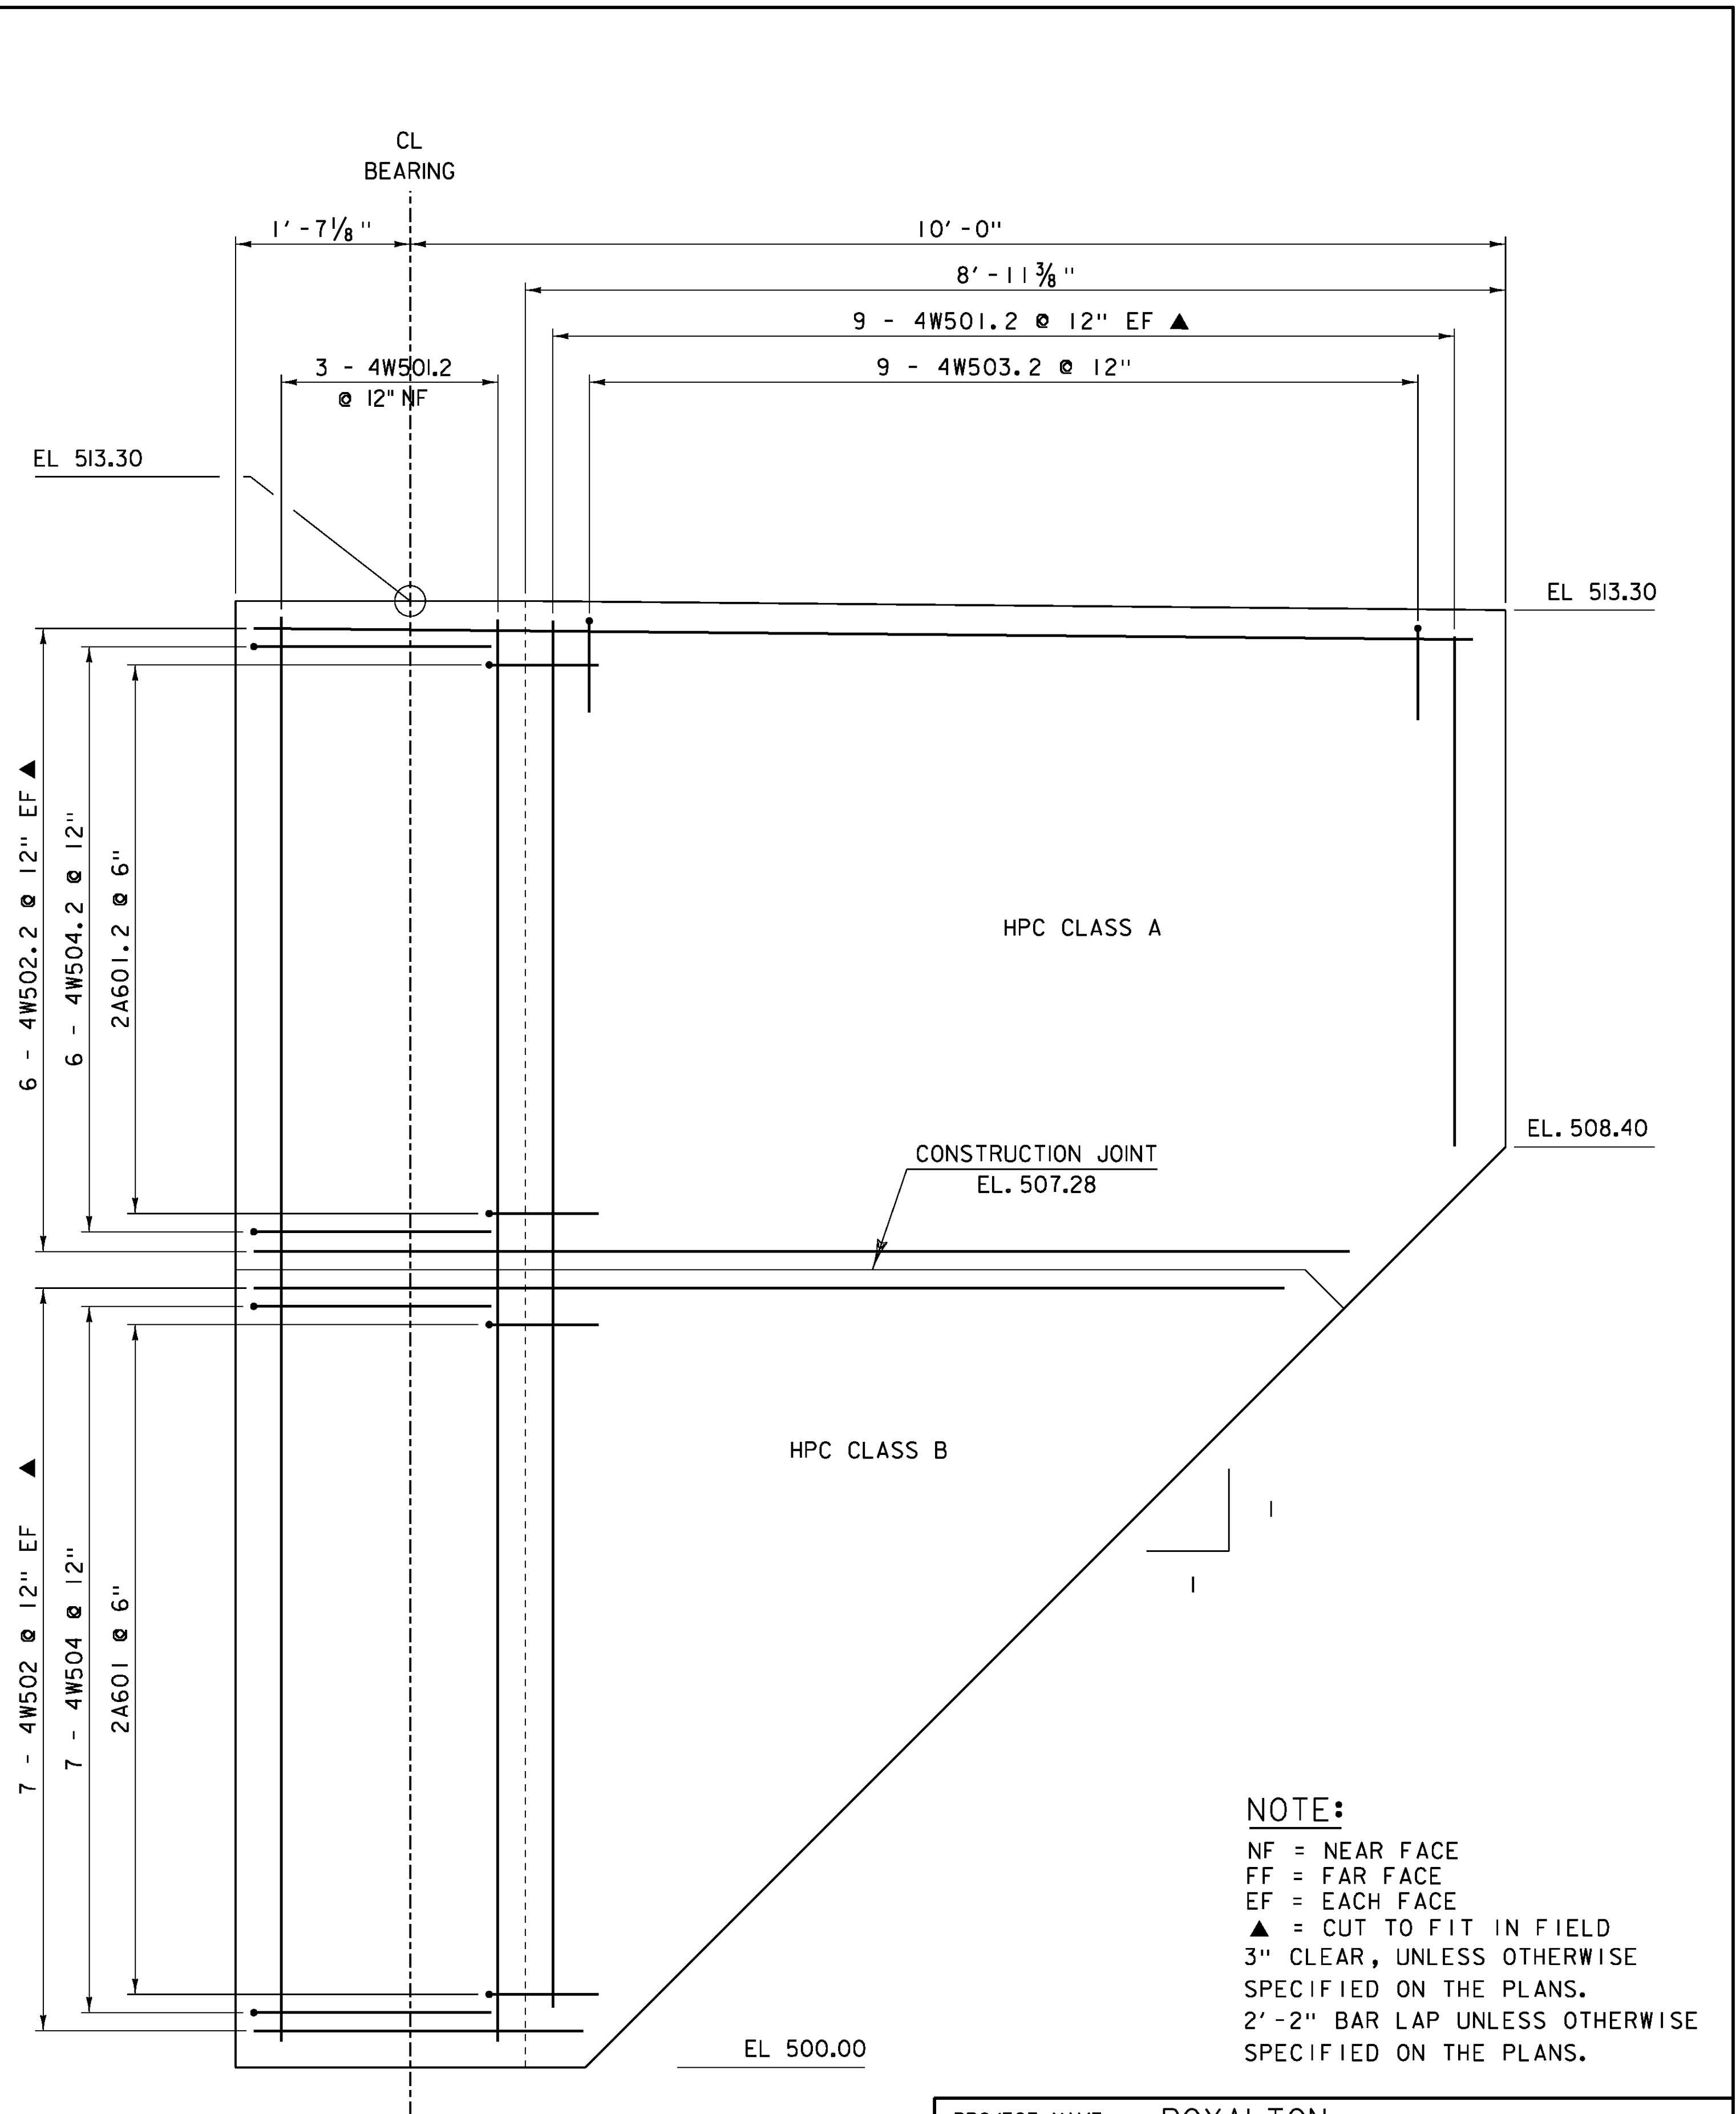

WINGWALL 4 ELEVATION  
SCALE 1"=1'-0"

**NOTE:**  
 NF = NEAR FACE  
 FF = FAR FACE  
 EF = EACH FACE  
 ▲ = CUT TO FIT IN FIELD  
 3" CLEAR, UNLESS OTHERWISE SPECIFIED ON THE PLANS.  
 2'-2" BAR LAP UNLESS OTHERWISE SPECIFIED ON THE PLANS.


PROJECT NAME:	ROYALTON
PROJECT NUMBER:	BRS 0147(I3)
FILE NAME:	s86e005sub.dgn
PROJECT LEADER:	C. CARLSON
DESIGNED BY:	D. PETERSON
BRIDGE 27 WINGWALLS 3 AND 4 ELEVATIONS	SHEET 45 OF 186
PLOT DATE:	08-OCT-2013
DRAWN BY:	C. MOONEY
CHECKED BY:	J. LACROIX

# REINFORCING STEEL SCHEDULE

ITEM	EACH	SIZE	LENGTH	MARK	TYPE	A	B	C	D	E	F	G	H	J	K	R	O
<b>DECK</b>																	
184	5	29'-6"	S501.2	STR													
264	5	36'-1"	S502.2	STR													
276	5	23'-6"	S503.2	STR													
* 551	6	4'-11"	S601.2	STR													
<b>APPROACH SLAB #1</b>																	
22	5	29'-3"	1AS501	STR													
* 37	9	20'-9"	1AS901	1	1'-3"	19'-6"						---		1'-0"			
30	5	5'-2"	1AS502.2	1	0'-7"	4'-0"						0'-7"		0'-5"			
<b>APPROACH SLAB #2</b>																	
22	5	29'-3"	2AS501	STR													
36	9	20'-9"	2AS901	1	1'-3"	19'-6"						---		1'-0"			
30	5	5'-2"	2AS502.2	1	0'-7"	4'-0"						0'-7"		0'-5"			
<b>ABUTMENT #1</b>																	
16	5	21'-2"	1A501.2	STR													
32	5	7'-7"	1A502.2	5	0'-7"	4'-10"	2'-2"	---				---	1'-6"	---	1'-6"	6'-4"	
81	5	10'-10"	1A503.2	S10		4'-2"	2'-6"	4'-2"									
41	5	7'-8"	1A504.2	S10		2'-11"	1'-10"	2'-11"									
8	6	9'-8"	1A601.2	19		8'-8"	1'-0"	---				0'-11"		0'-4"		9'-0"	
8	6	9'-8"	1A602.2	27		1'-0"	8'-8"	---				0'-11"		0'-4"		9'-0"	
*+ 42	8	14'-4"	1A801.2	17		2'-2"	12'-2"	---									
+▲ 81	8	14'-4"	1A802.2	17		2'-2"	12'-2"	---									
36	5	21'-2"	1A501	STR													
16	6	9'-8"	1A601	19		8'-8"	1'-0"	---				0'-11"		0'-4"		9'-0"	
* 15	6	9'-8"	1A602	27		1'-0"	8'-8"	---				0'-11"		0'-4"		9'-0"	
<b>WINGWALL #1</b>																	
+▲ 21	5	13'-5"	1W501.2	STR													
12	5	11'-1"	1W502.2	STR													
9	5	2'-9"	1W503.2	S10		0'-10"	1'-1"	0'-10"									
6	5	5'-11"	1W504.2	19		2'-2"	3'-9"	---				2'-0"		0'-9"		4'-6"	
*▲ 17	5	11'-1"	1W502	STR													
8	5	5'-11"	1W504	19		2'-2"	3'-9"	---				2'-0"		0'-9"		4'-6"	
<b>WINGWALL #2</b>																	
+▲ 21	5	11'-8"	2W501.2	STR													
*▲ 13	5	11'-1"	2W502.2	STR													
9	5	2'-9"	2W503.2	S10		0'-10"	1'-1"	0'-10"									
6	5	5'-11"	2W504.2	27		2'-2"	3'-9"	---				2'-0"		0'-9"			
▲ 14	5	11'-1"	2W502	STR													
7	5	5'-11"	2W504	27		2'-2"	3'-9"	---				2'-0"		0'-9"			
<b>ABUTMENT #2</b>																	
16	5	21'-2"	2A501.2	STR													
32	5	7'-7"	2A502.2	5	0'-7"	4'-10"	2'-2"	---				---	1'-6"	---	1'-6"	6'-4"	
81	5	10'-10"	2A503.2	S10		4'-2"	2'-6"	4'-2"									
41	5	7'-8"	2A504.2	S10		2'-11"	1'-10"	2'-11"									
9	6	9'-8"	2A601.2	19		8'-8"	1'-0"	---				0'-11"		0'-4"		9'-0"	
9	6	9'-8"	2A602.2	27		1'-0"	8'-8"	---				0'-11"		0'-4"		9'-0"	
+ 41	8	15'-0"	2A801.2	17		2'-2"	12'-10"	---									
+▲ 81	8	15'-0"	2A802.2	17		2'-2"	12'-10"	---									
40	5	21'-2"	2A501	STR													
14	6	9'-8"	2A601	19		8'-8"	1'-0"	---				0'-11"		0'-4"		9'-0"	
17	6	9'-8"	2A602	27		1'-0"	8'-8"	---				0'-11"		0'-4"		9'-0"	
<b>WINGWALL #3</b>																	
+▲ 21	5	14'-1"	3W501.2	STR													
12	5	11'-1"	3W502.2	STR													
9	5	2'-9"	3W503.2	S10		0'-10"	1'-1"	0'-10"									
6	5	5'-11"	3W504.2	27		2'-2"	3'-9"	---				2'-0"		0'-9"			
18	5	11'-1"	3W502	STR													
9	5	5'-11"	3W504	27		2'-2"	3'-9"	---				2'-0"		0'-9"			
<b>WINGWALL #4</b>																	
+▲ 21	5	12'-4"	4W501.2	STR													
12	5	11'-1"	4W502.2	STR													
9	5	2'-9"	4W503.2	S10		0'-10"	1'-1"	0'-10"									
6	5	5'-11"	4W504.2	19		2'-2"	3'-9"	---				2'-0"		0'-9"		4'-6"	
▲ 14	5	12'-4"	4W502	STR													
7	5	5'-11"	4W504	19		2'-2"	3'-9"	---				2'-0"		0'-9"		4'-6"	

~ NOTES ~

- UNLESS OTHERWISE DESIGNATED, ALL BAR REINFORCEMENT FOR CONCRETE IN SIZES UP TO AND INCLUDING NO. 18 SHALL CONFORM TO THE REQUIREMENTS OF THE "SPECIFICATIONS FOR DEFORMED BILLET-STEEL BARS FOR CONCRETE REINFORCEMENT", AASHTO M 31 (ASTM A 615-S1). ALL BARS SHALL BE GRADE 60, UNLESS OTHERWISE DESIGNATED.
- FOR TYPICAL BENDING DETAILS, RECOMMENDED PIN DIAMETER "D" OF BENDS AND HOOKS, AND OTHER STANDARD PRACTICE, SEE CURRENT CONCRETE REINFORCING STEEL INSTITUTE "MANUAL OF STANDARD PRACTICE".
- BARS WHICH REQUIRE MORE ACCURATE BENDING THAN STANDARD PRACTICES SHOULD HAVE LIMITS INDICATED.
- ALL DIMENSIONS ARE OUT TO OUT OF BAR EXCEPT "A" AND "G" ON STANDARD 180 DEGREE AND 135 DEGREE HOOKS.
- "J" DIMENSION ON 180 DEGREE HOOKS TO BE SHOWN ONLY WHERE NECESSARY TO RESTRICT HOOK SIZE. OTHERWISE, STANDARD HOOKS ARE TO BE USED.
- "H" DIMENSION ON STIRRUPS TO BE SHOWN ONLY WHEN NECESSARY TO MAINTAIN CLEARANCES.
- WHERE SLOPE DIFFERS FROM 45 DEGREES, DIMENSIONS "H" AND "K" MUST BE SHOWN.
- ▲ DENOTES BARS TO BE CUT IN FIELD.
- * DENOTES ONE EXTRA BAR ADDED FOR TESTING PURPOSES.
- △ DENOTES TWO EXTRA BARS ADDED FOR TESTING PURPOSES.
- E IN BAR MARK PREFIX DENOTES EPOXY COATED REINFORCING STEEL.
- + DENOTES BARS CHANGED FROM LEVEL II TO LEVEL I.

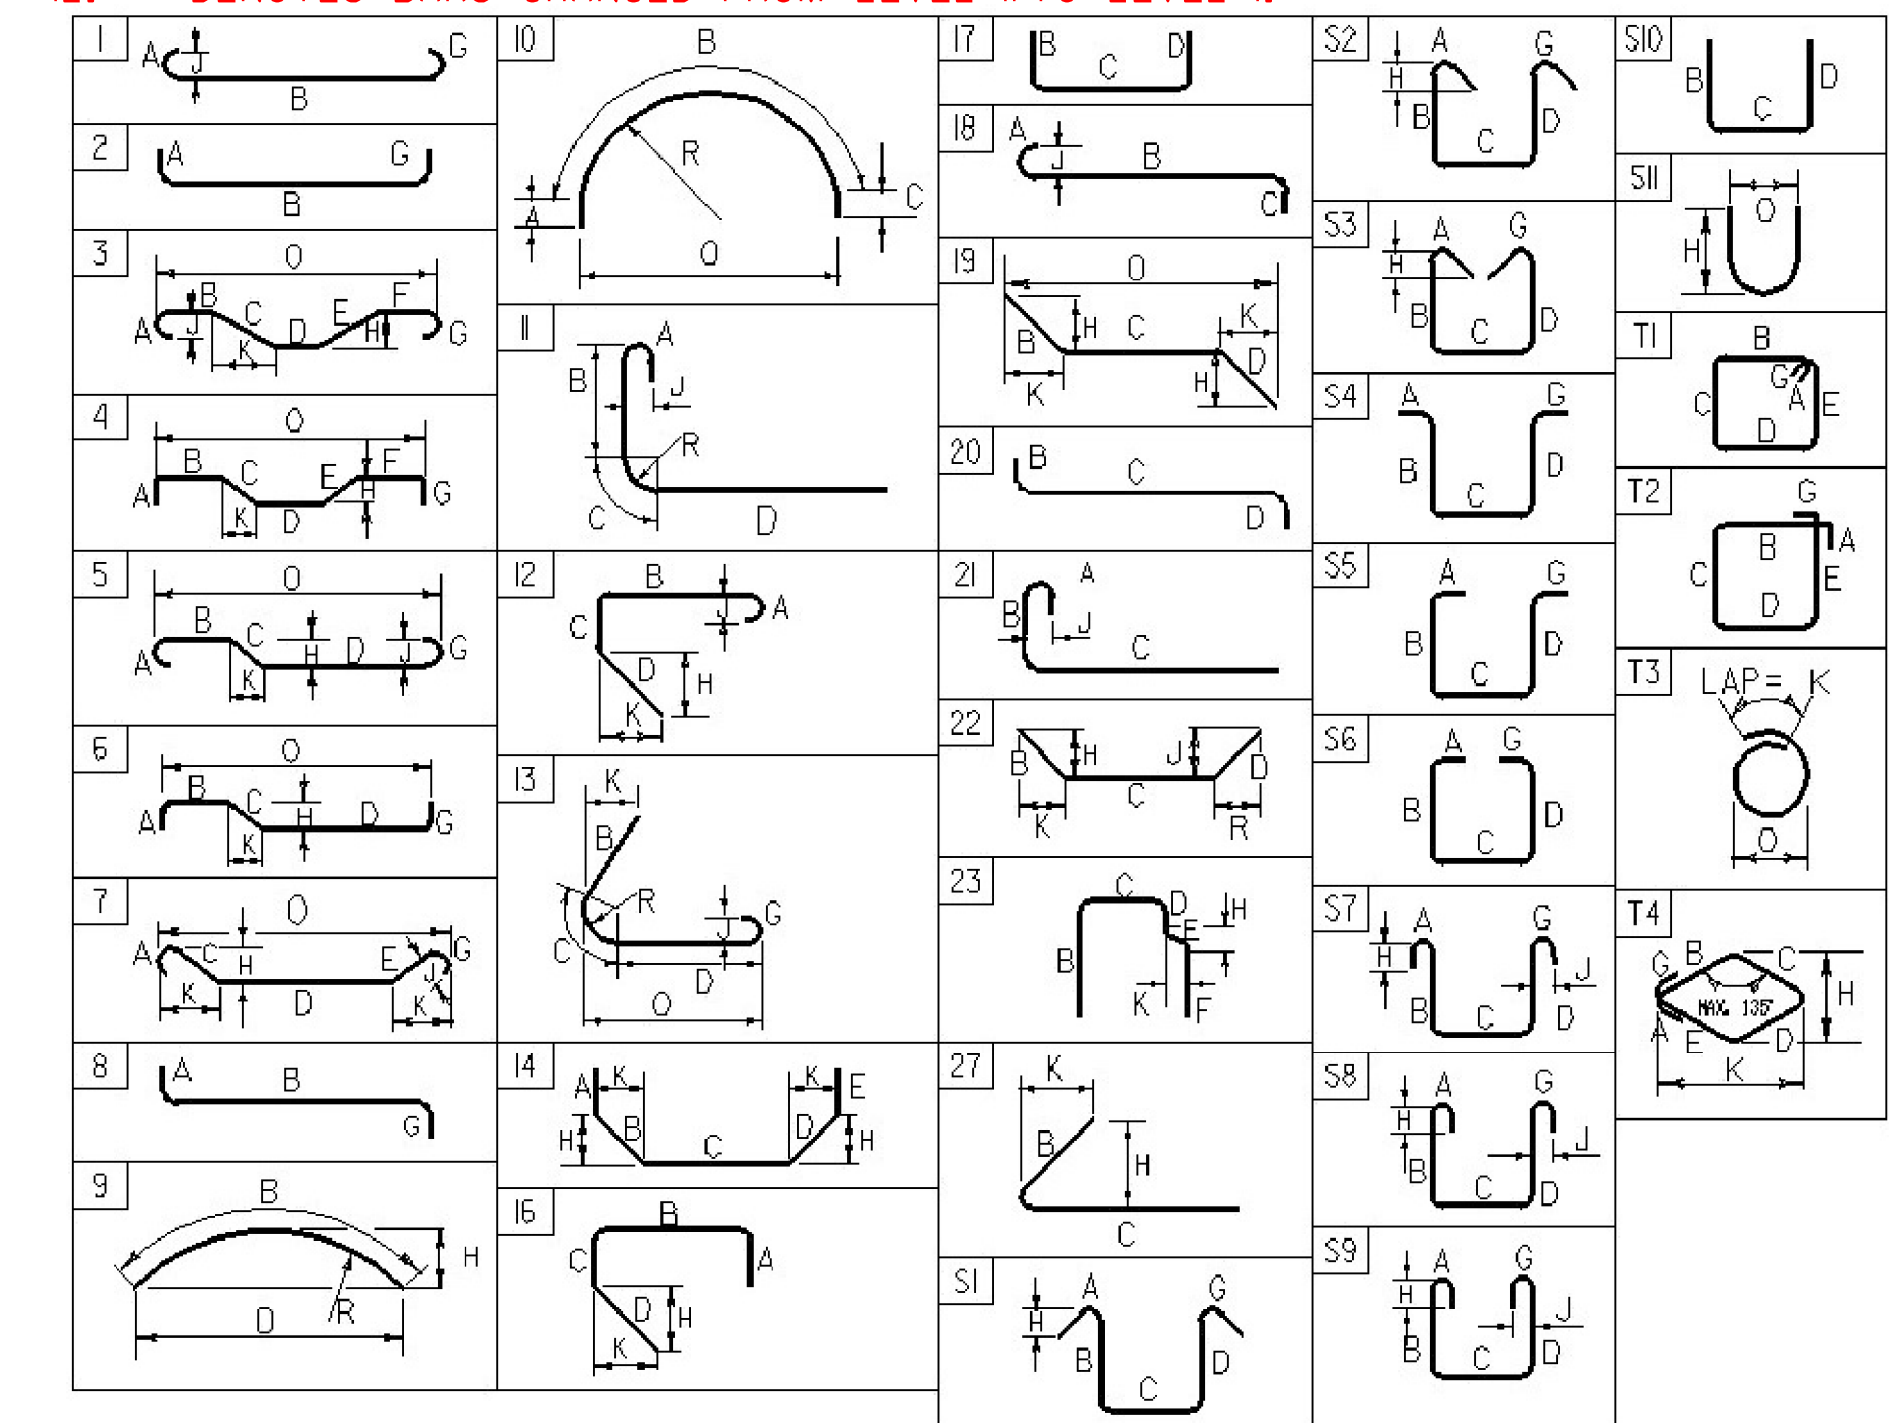


ASTM STANDARD REINFORCING BARS				
#3	0.376	0.375	0.11	1.178
#4	0.668	0.500	0.20	1.571
#5	1.043	0.625	0.31	1.963
#6	1.502	0.750	0.44	2.356
#7	2.04	0.875	0.60	2.749
#8	2.670	1.000	0.79	3.14
#9	3.400	1.13	1.00	3.54
#10	4.3	1.270	1.27	3.990
#11	5.31	1.410	1.56	4.430
#14	7.65	1.69	2.25	5.32
#18	13.60	2.26	4.00	7.09

~ REINFORCING STEEL CORROSION RESISTANCE LEVEL ~

THE REINFORCING STEEL MARKS IN THIS SCHEDULE INDICATE THE REQUIRED BAR CORROSION RESISTANCE LEVEL. CORROSION RESISTANCE LEVEL IS DENOTED WITH A. 2 FOR LEVEL TWO SUFFIX OR .3 FOR LEVEL THREE SUFFIX. 1 FOR LEVEL ONE IS TO BE OMITTED. THE BAR MATERIAL TYPE AND BAR STEEL GRADE PROVIDED FOR EACH CORROSION LEVEL WILL BE RECORDED ON THE PLAN SET PI SHEET FOR AS-BUILT RECORD PLAN ARCHIVES.

PROJECT NAME: **ROYALTON**  
PROJECT NUMBER: **BRS 0147 (13)**  
FILE NAME: **BR 27ls86e056rsls_27** PLOT DATE: **10/4/2013**  
PROJECT MANAGER: **C. CARLSON** DRAWN BY: **C. MOONEY**  
DESIGNED BY: **D. PETERSON** CHECKED BY: **D. PETERSON**  
**BRIDGE 27 REINFORCING STEEL SCHEDULE** SHEET **46** OF **186**

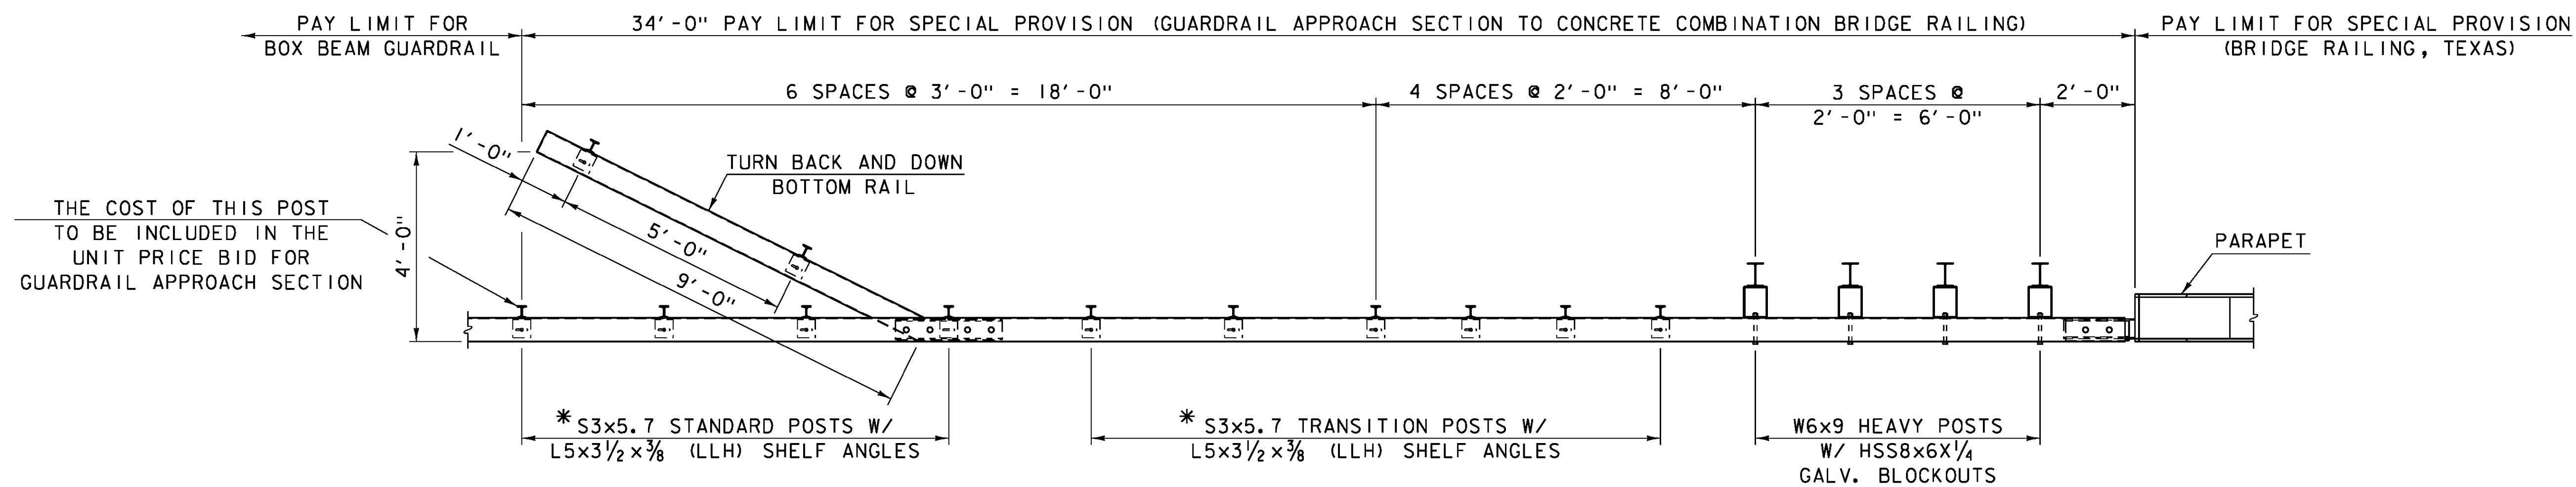


THE COST OF THIS POST TO BE INCLUDED IN THE UNIT PRICE BID FOR GUARDRAIL APPROACH SECTION

* SEE STD. G1-B FOR POST CONNECTION DETAILS

**APPROACH RAIL PLAN**

NOT TO SCALE

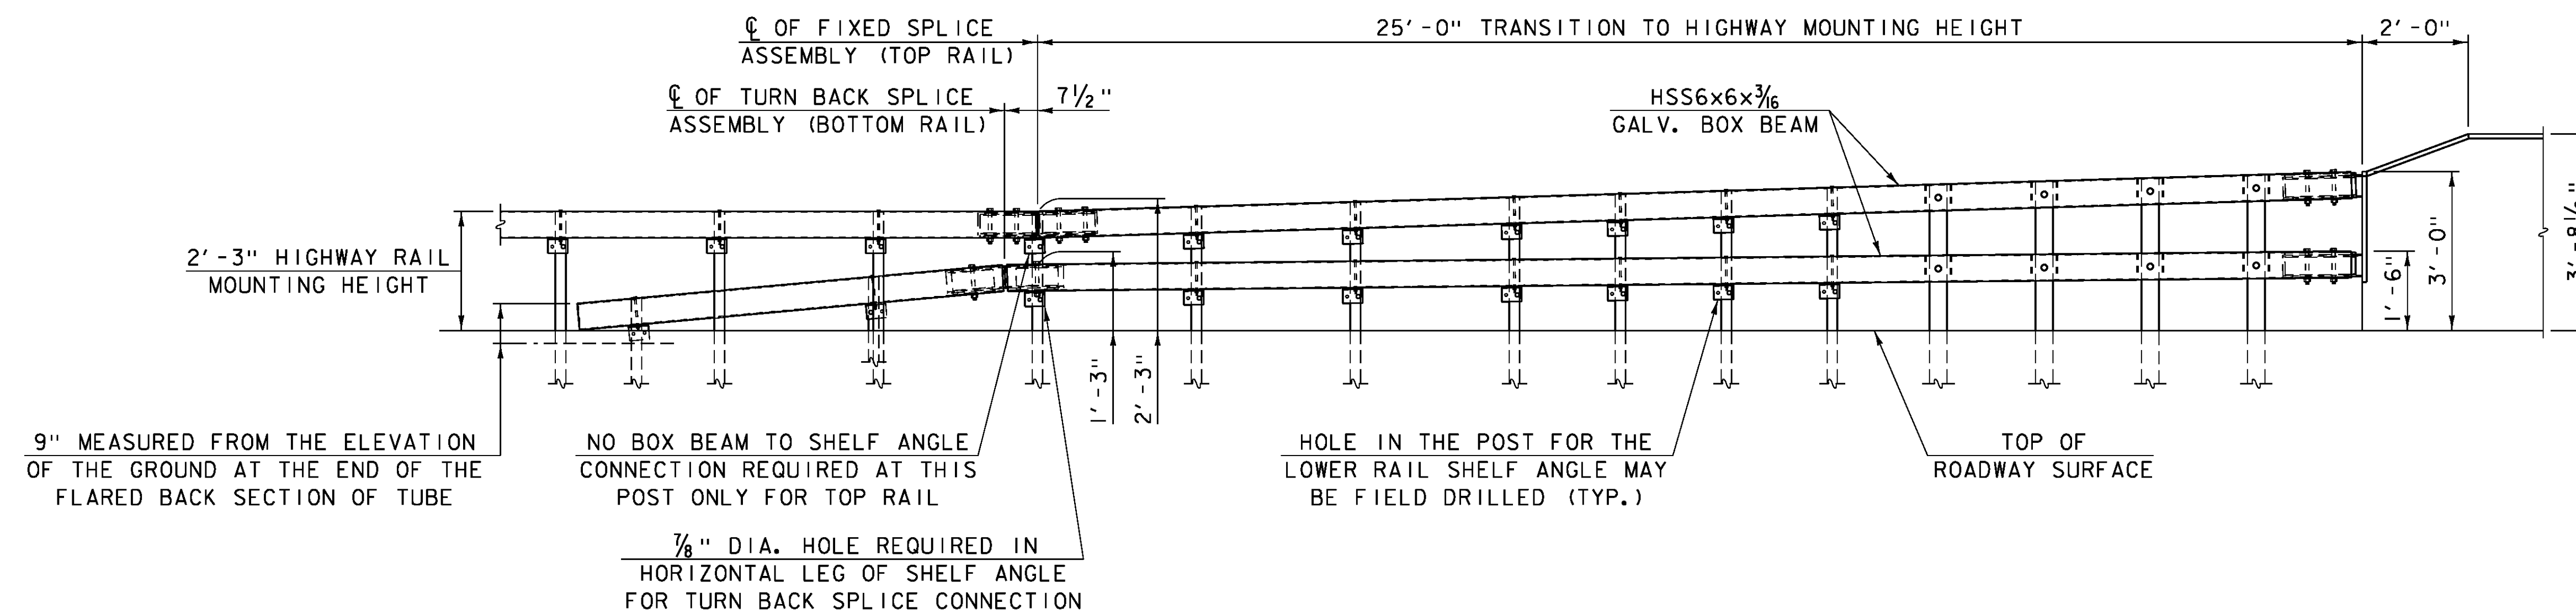

9" MEASURED FROM THE ELEVATION OF THE GROUND AT THE END OF THE FLARED BACK SECTION OF TUBE

NO BOX BEAM TO SHELF ANGLE CONNECTION REQUIRED AT THIS POST ONLY FOR TOP RAIL

HOLE IN THE POST FOR THE LOWER RAIL SHELF ANGLE MAY BE FIELD DRILLED (TYP.)

7/8" DIA. HOLE REQUIRED IN HORIZONTAL LEG OF SHELF ANGLE FOR TURN BACK SPLICE CONNECTION

**APPROACH RAIL ELEVATION**


NOT TO SCALE

NOTES:


1. SEE STANDARDS S-352A, S-352B AND S-352C FOR MORE DETAILS OF BRIDGE RAILING.
2. THE FACE OF RAIL OF THE APPROACH RAIL SHALL FOLLOW THE EDGE OF SHOULDER ALONG CURVE.

PROJECT NAME: ROYALTON  
PROJECT NUMBER: BRS 0147 (13)

FILE NAME: \BR 27\86e055rail.27.dgn PLOT DATE: 08-OCT-2013  
PROJECT LEADER: C. CARLSON DRAWN BY: D. PETERSON  
DESIGNED BY: D. PETERSON CHECKED BY: C. CARLSON  
BRIDGE 27 APPROACH RAIL PLAN AND ELEVATION SHEET 47 OF 186

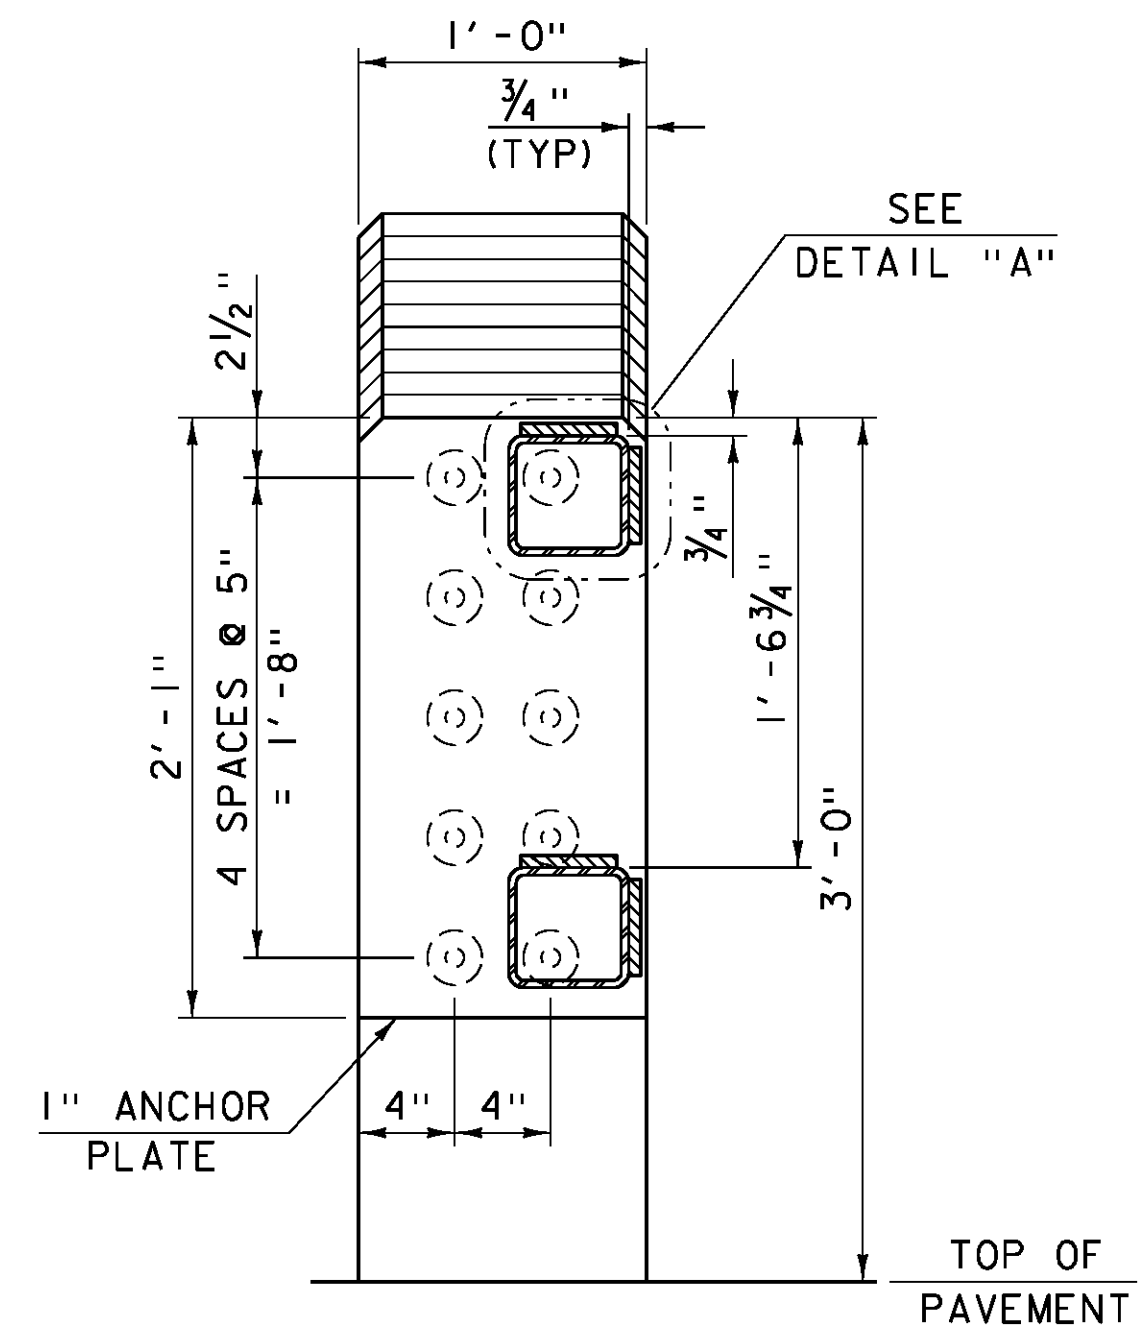


SECTION A-A  
NOT TO SCALE

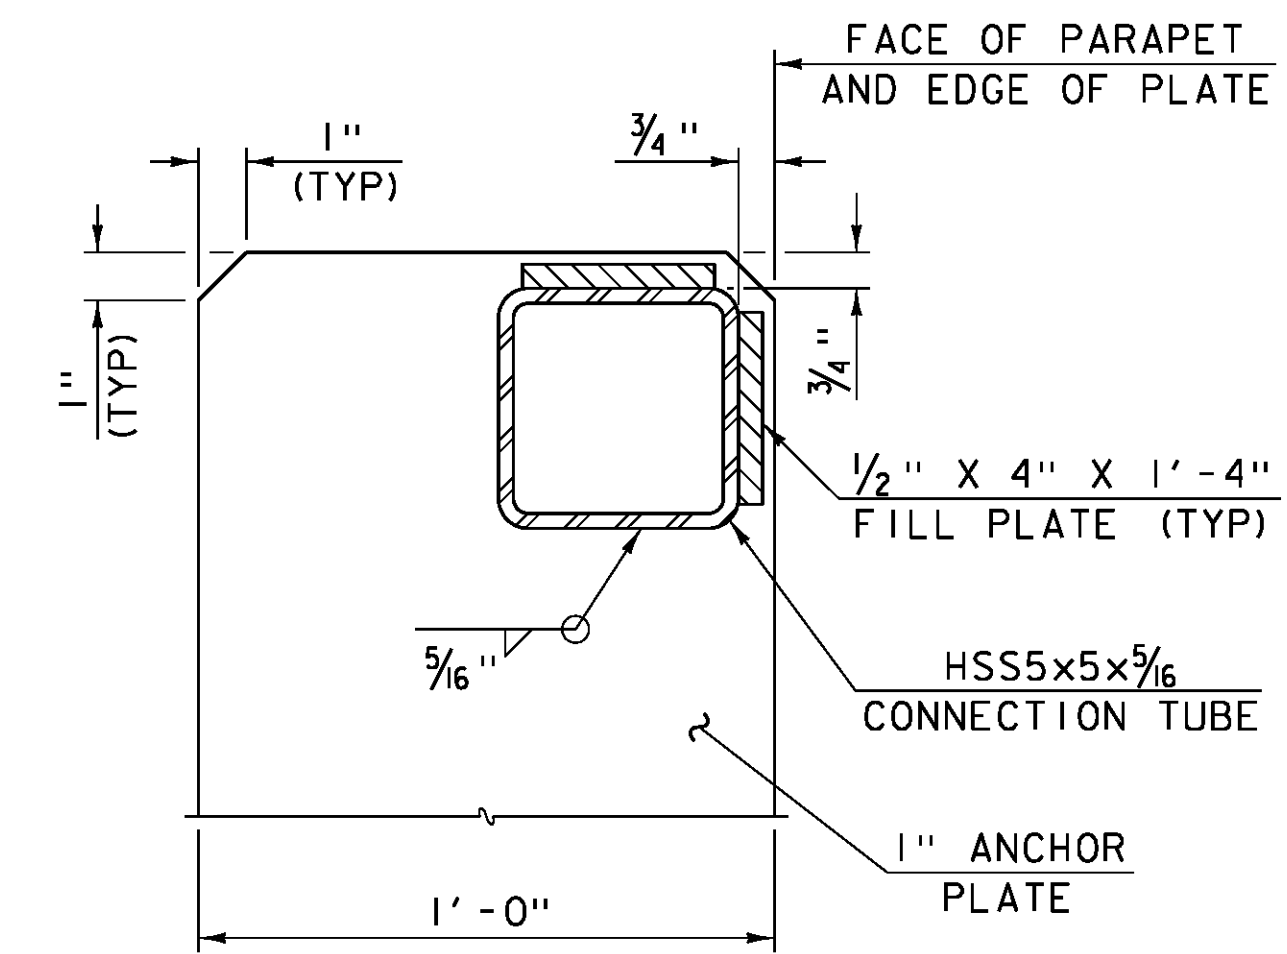


DETAIL "A"  
NOT TO SCALE

3/4" DIA X 7/2" BOLT (A325, TYPE 1)  
W/ STANDARD WASHERS AND SPRING LOCK WASHERS  
NUT TO BE FINGER TIGHT AND THE FIRST THREAD  
BELOW THE NUT TO BE DAMAGED TO PREVENT REMOVAL  
(TYP)

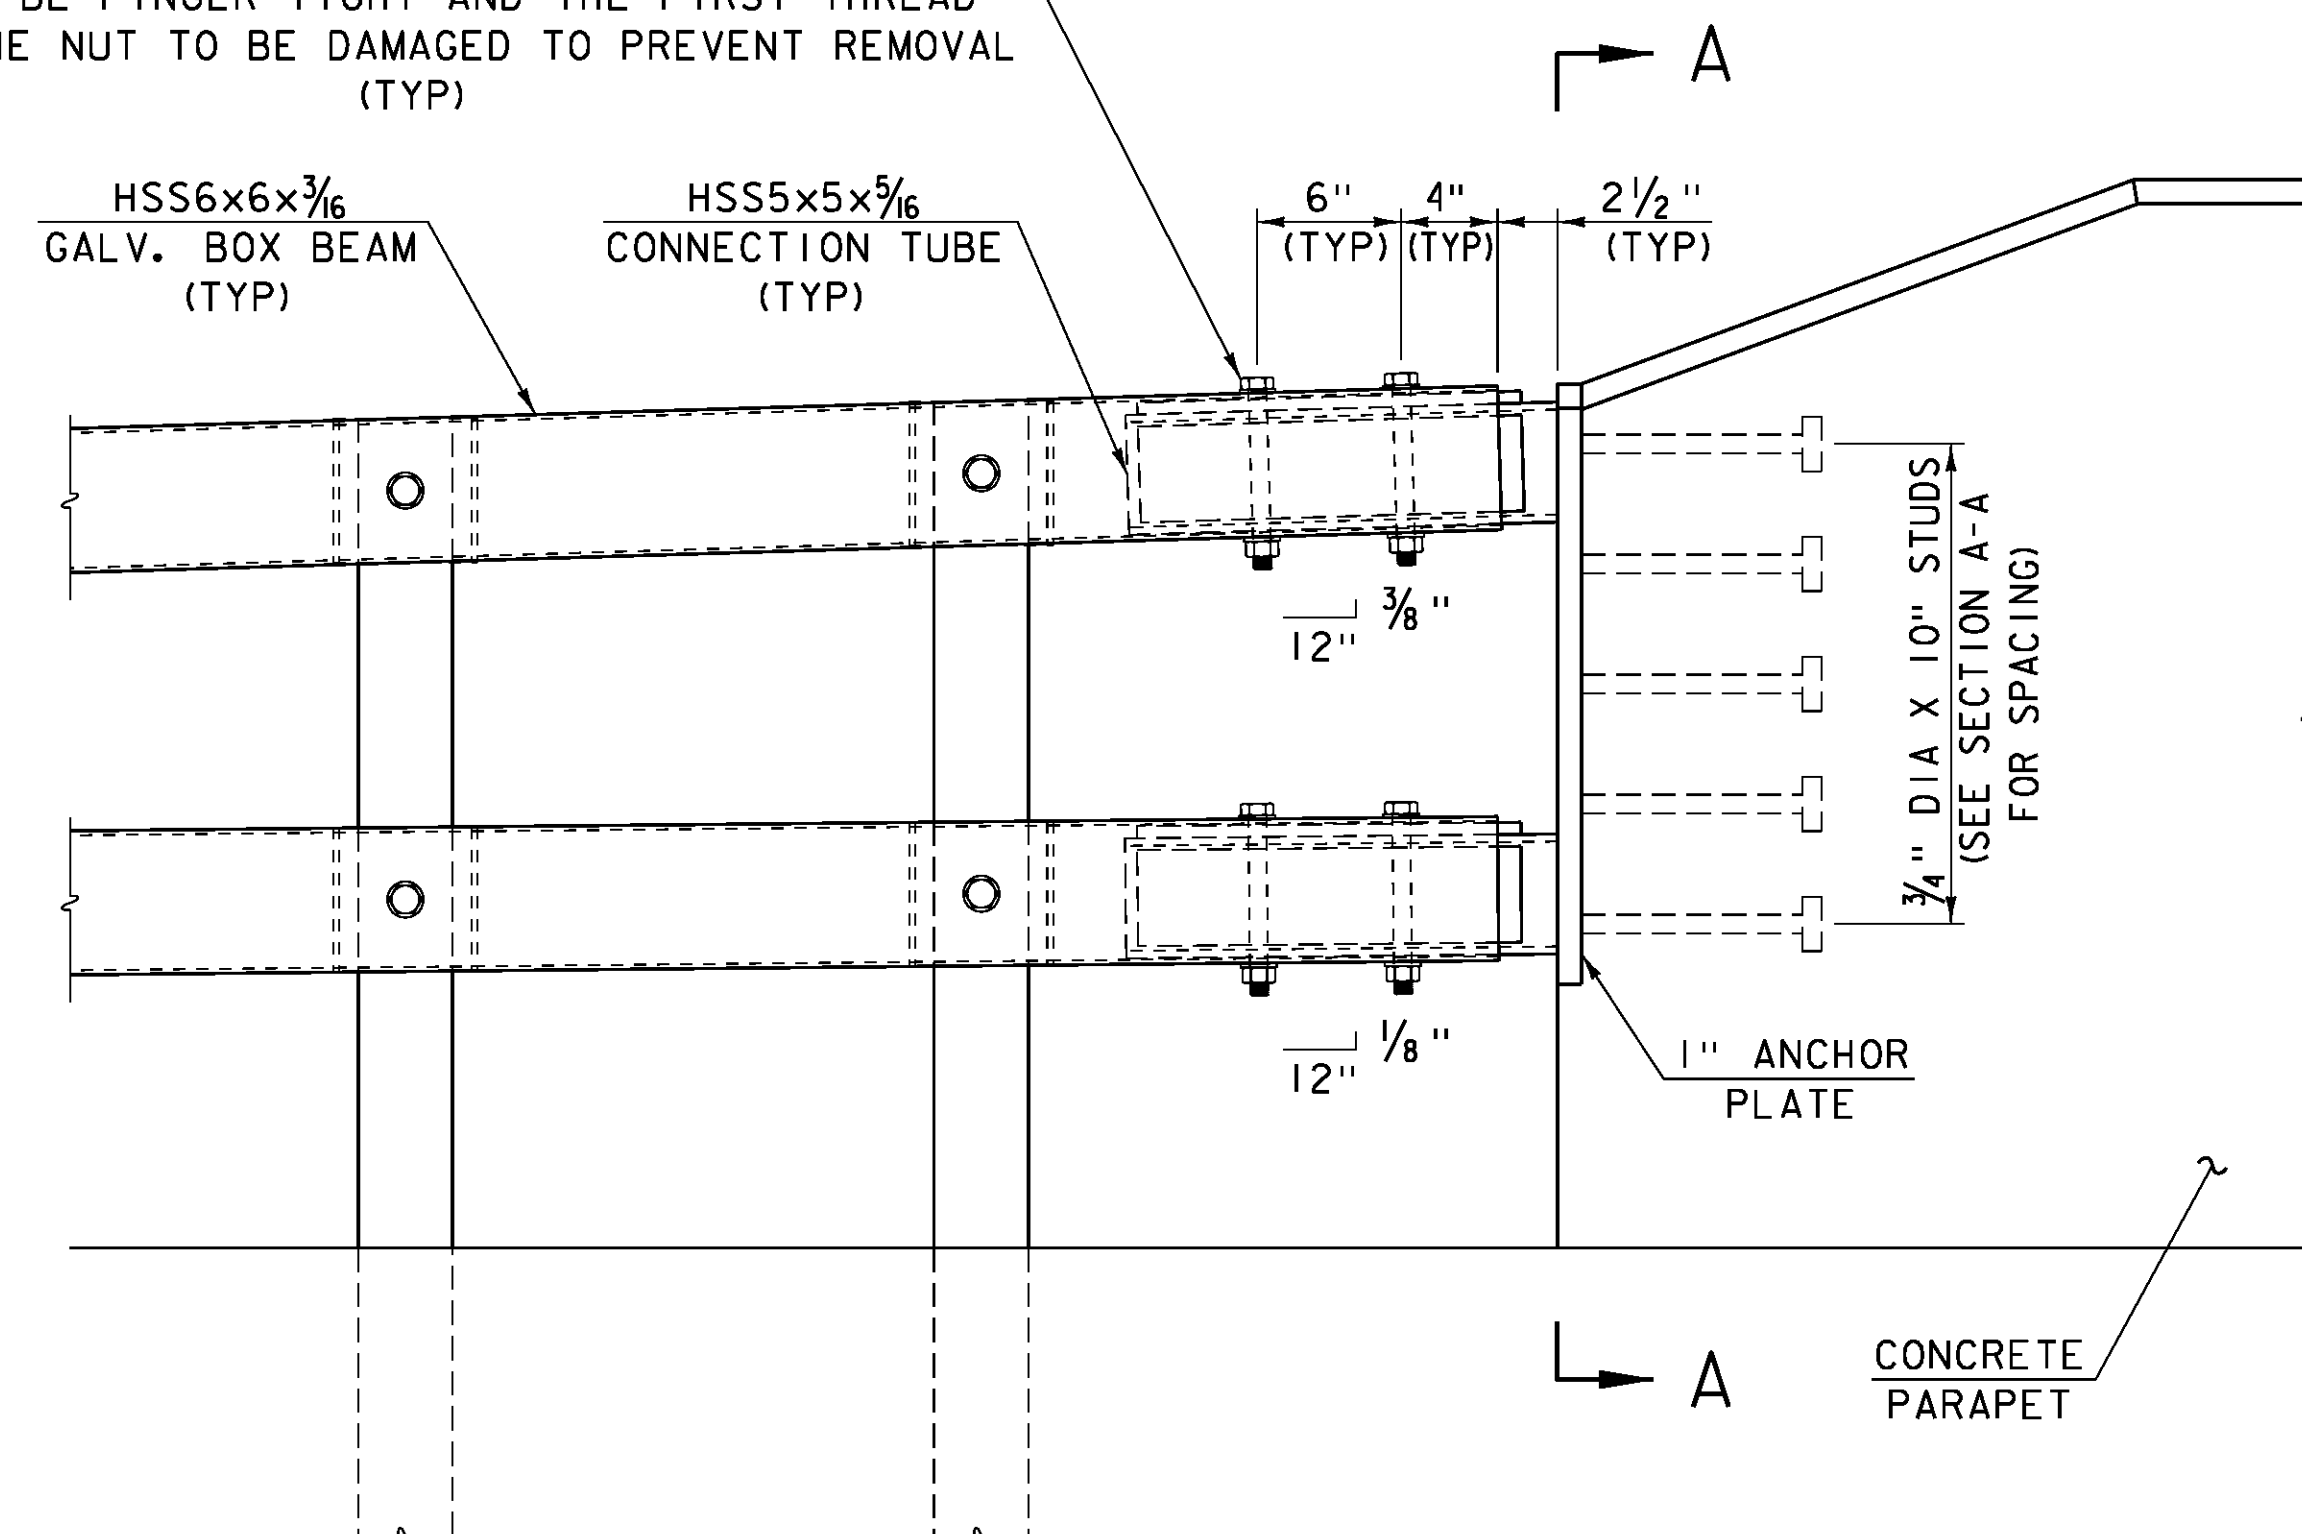

APPROACH RAIL CONNECTION DETAIL  
NOT TO SCALE

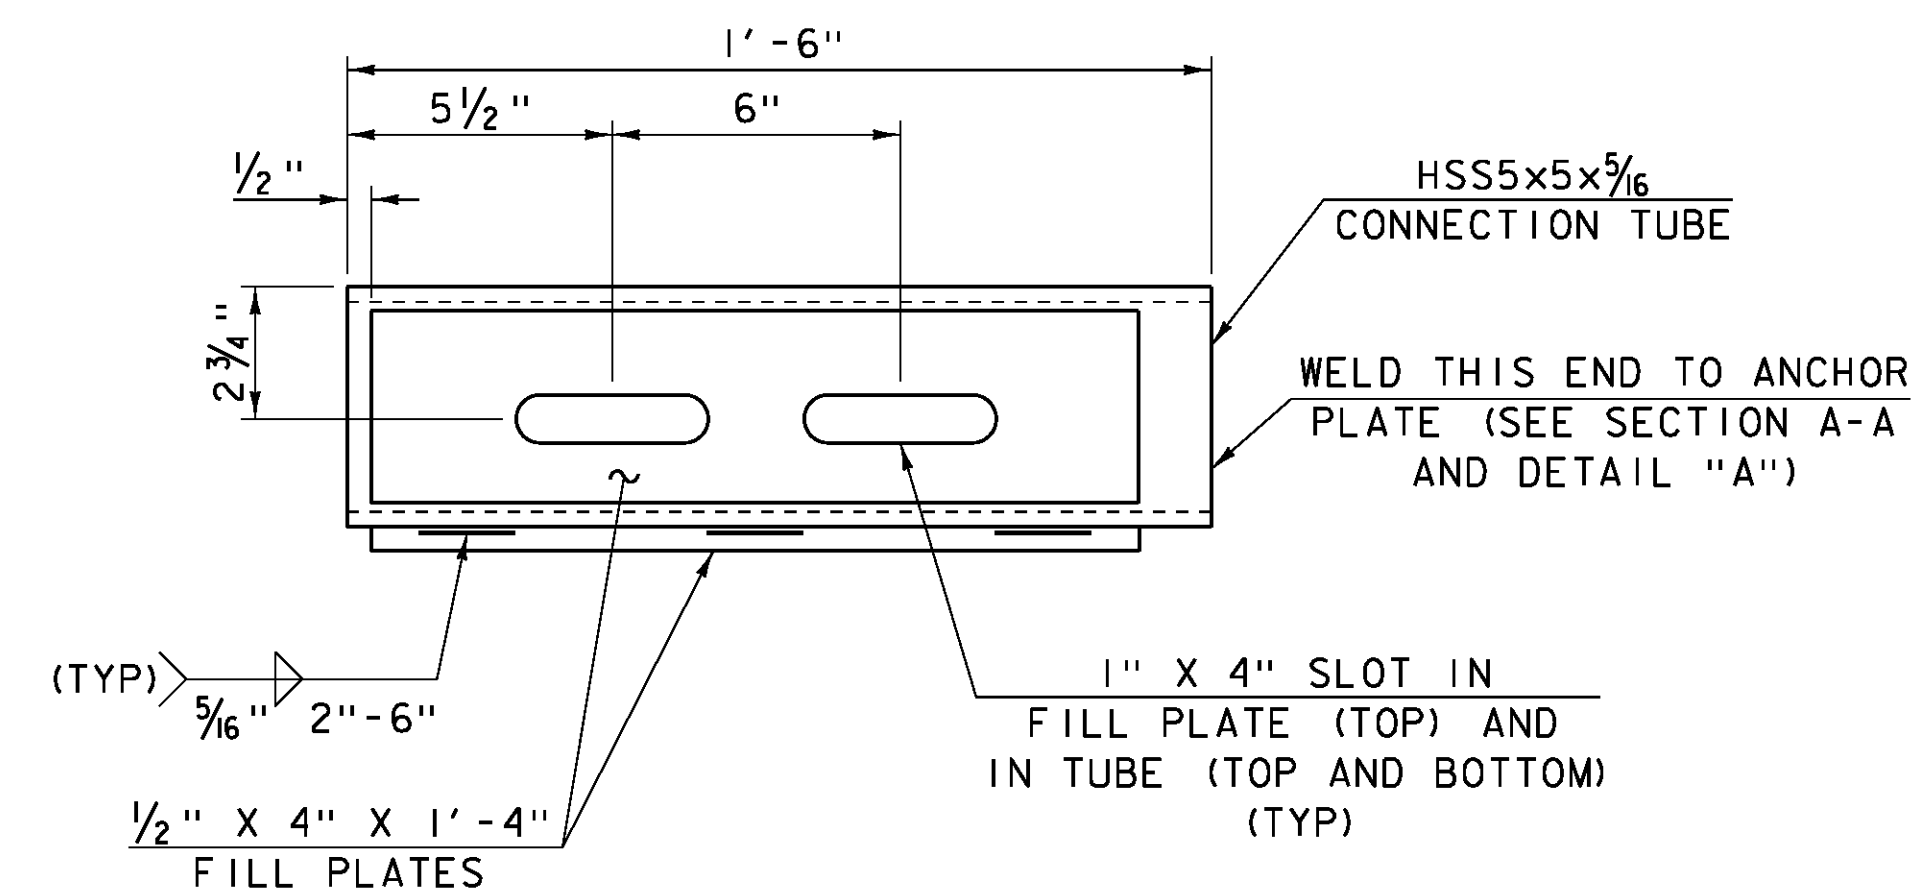


CONNECTION TUBE DETAIL PLAN  
NOT TO SCALE

PROJECT NAME: ROYALTON  
PROJECT NUMBER: BRS 0147 (13)


FILE NAME: \BR 27\86e055rail.27.dgn  
PROJECT LEADER: C. CARLSON  
DESIGNED BY: D. PETERSON  
BRIDGE 27 APPROACH RAIL DETAILS (1)

PLOT DATE: 08-OCT-2013  
DRAWN BY: D. PETERSON  
CHECKED BY: C. CARLSON  
SHEET 48 OF 186



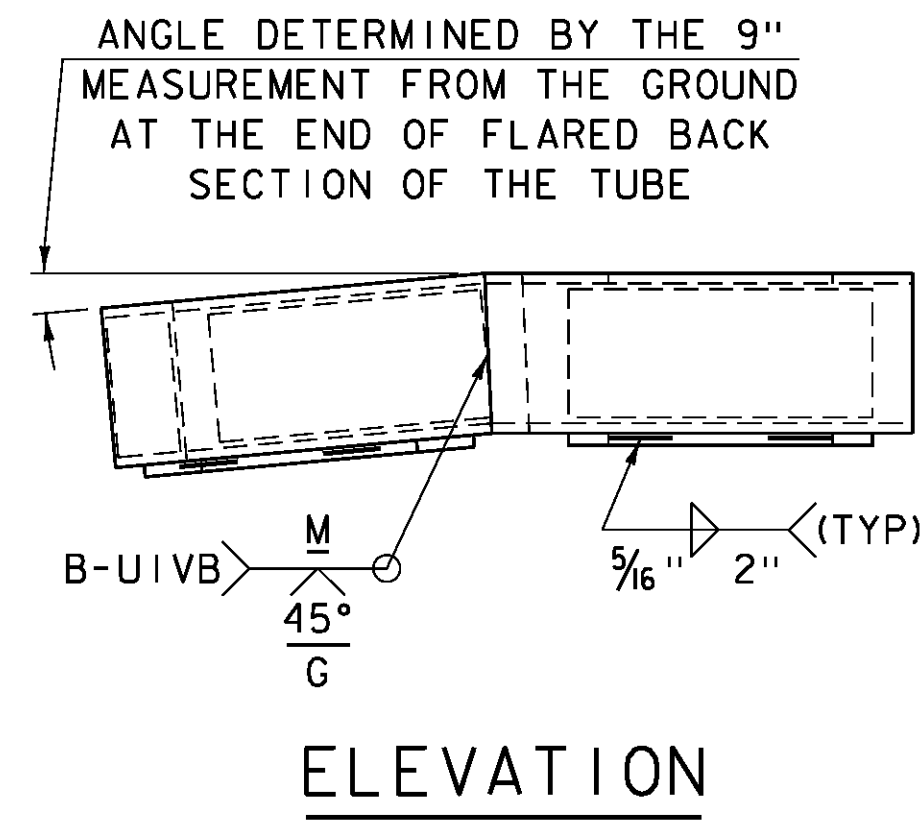


**ELEVATION**

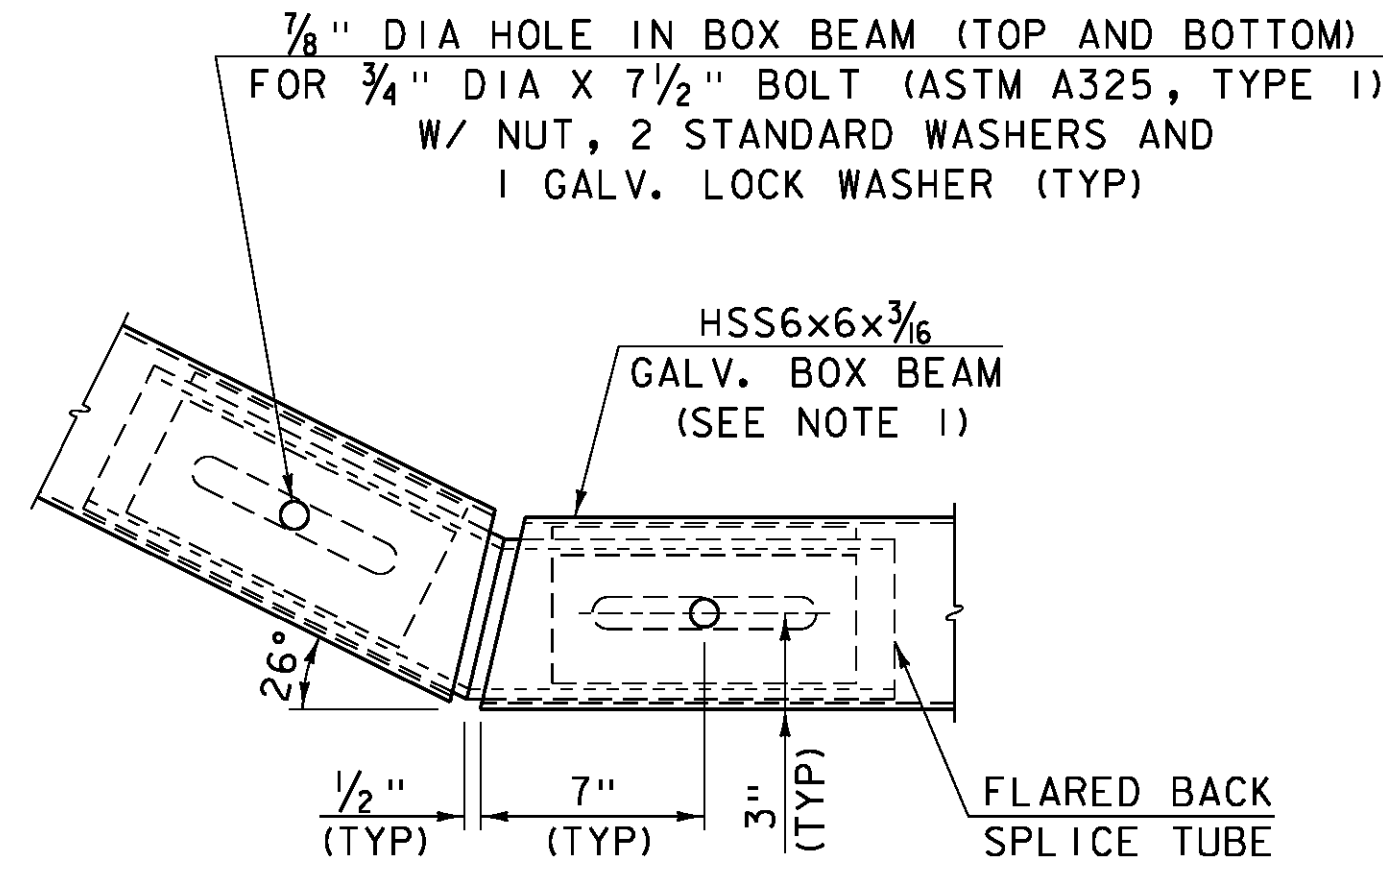


**PLAN BOTTOM RAIL FLARE BACK DETAIL**

NOT TO SCALE

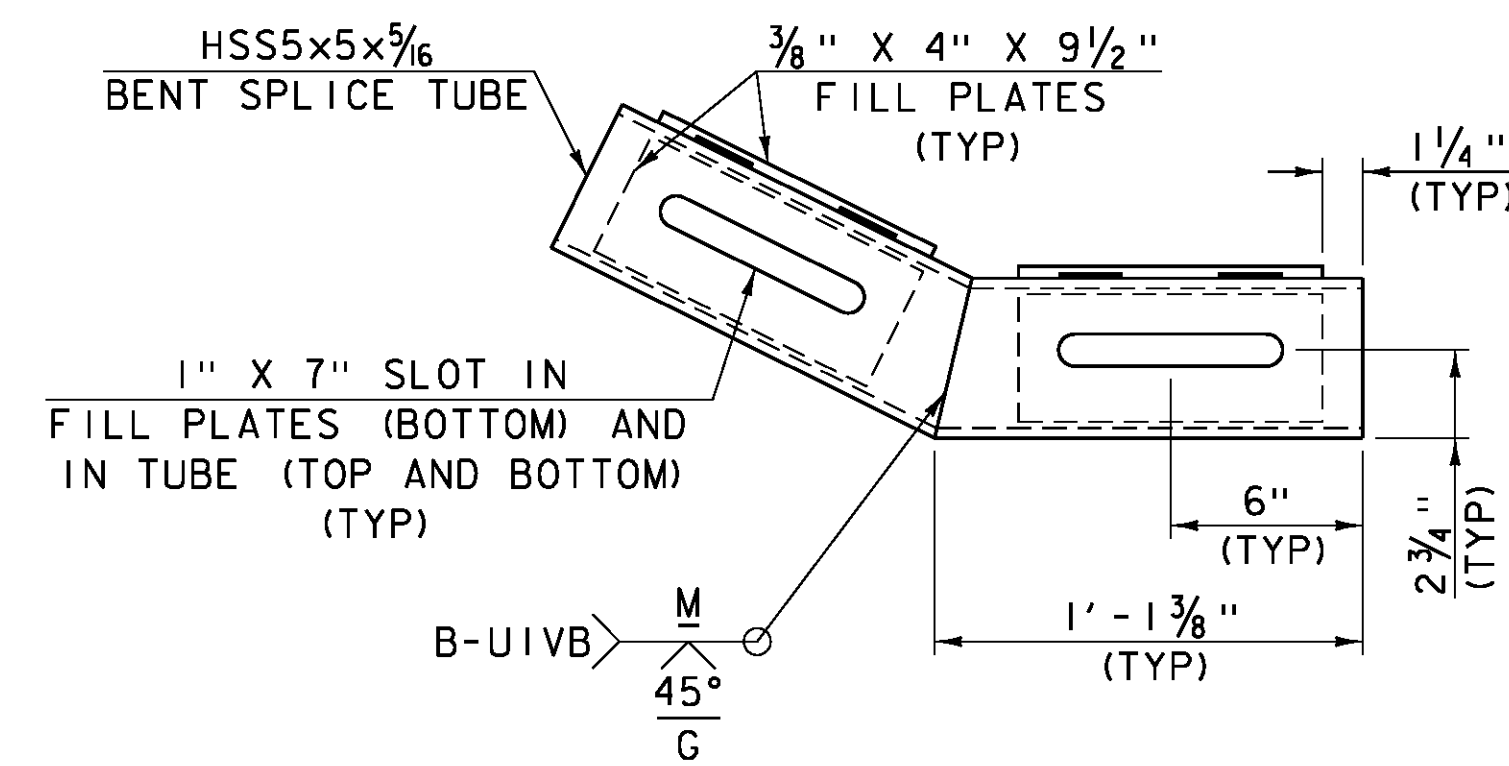


**PLAN FLARED BACK SPLICE TUBE DETAIL**

NOT TO SCALE

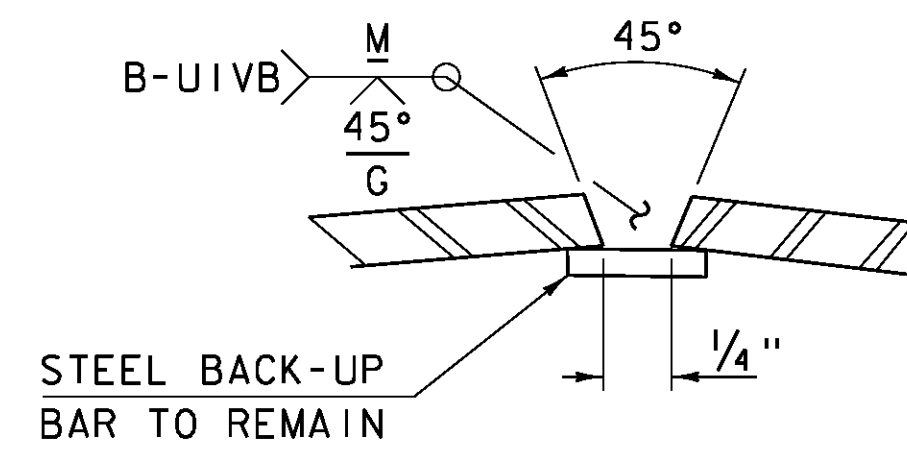



**WELD DETAIL FOR SPLICE TUBE**

NOT TO SCALE

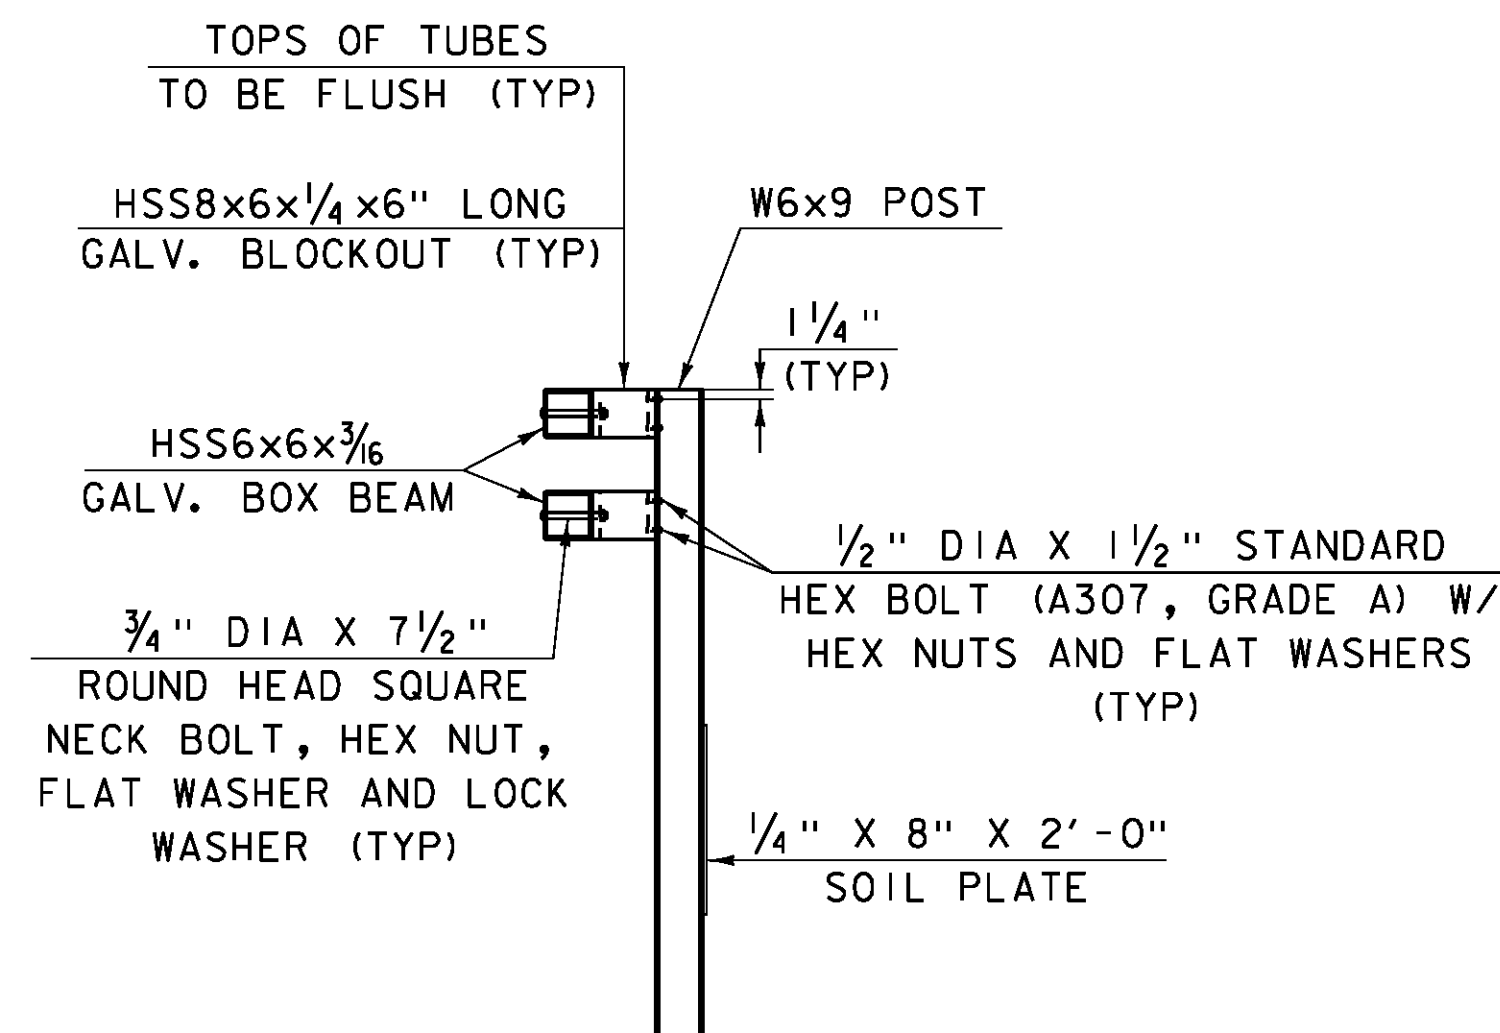



**HEAVY POST ELEVATION**

NOT TO SCALE

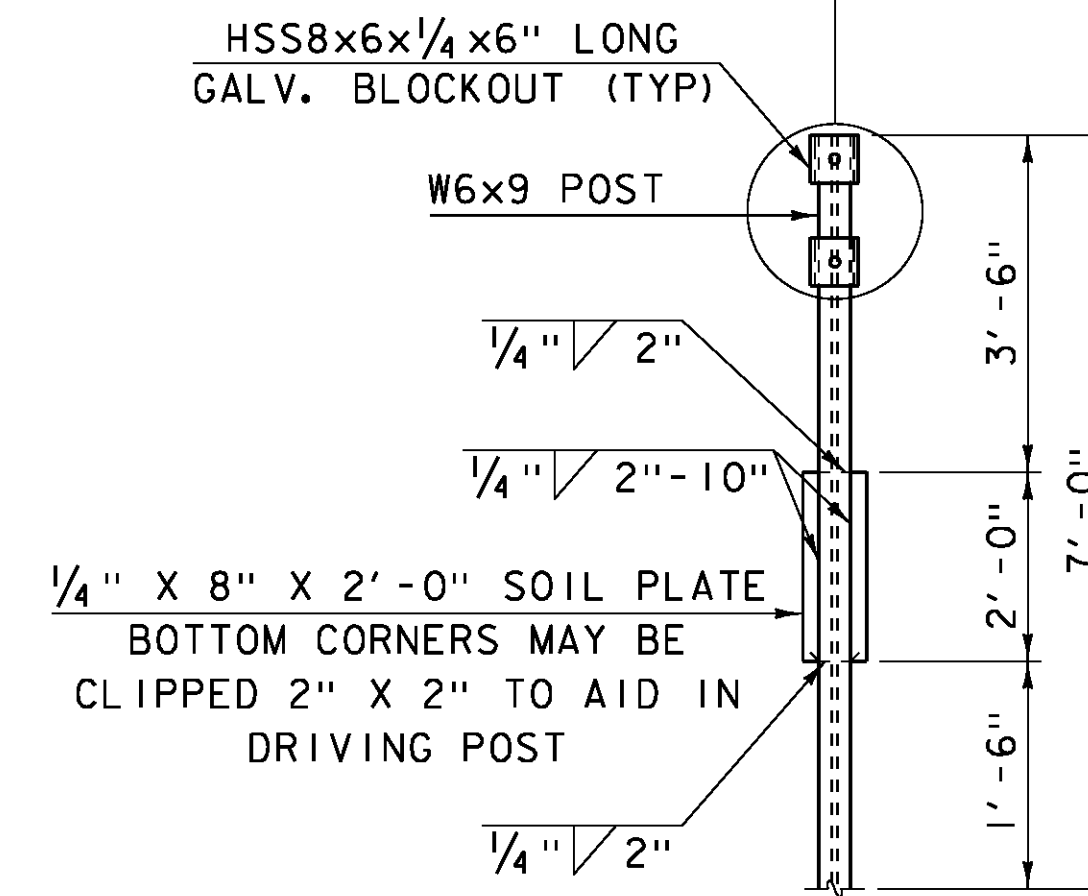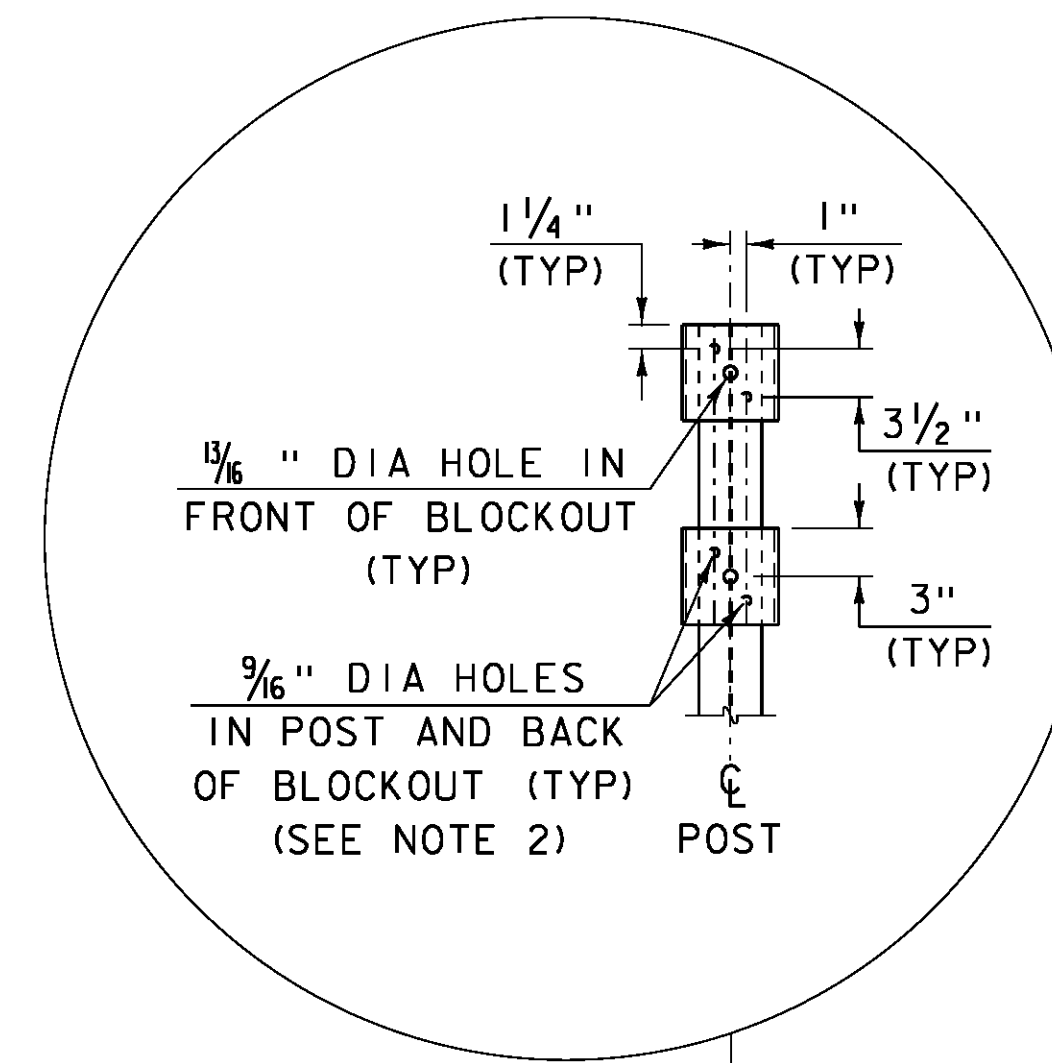

**HEAVY POST DETAIL**

NOT TO SCALE

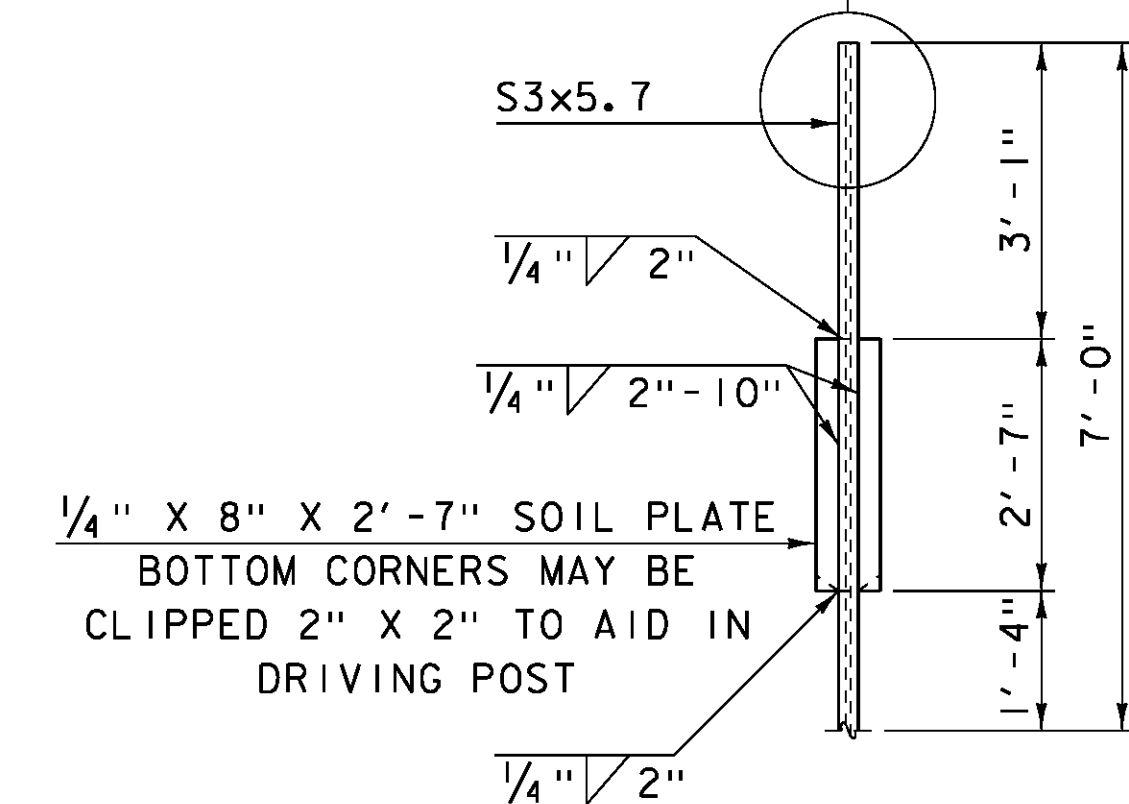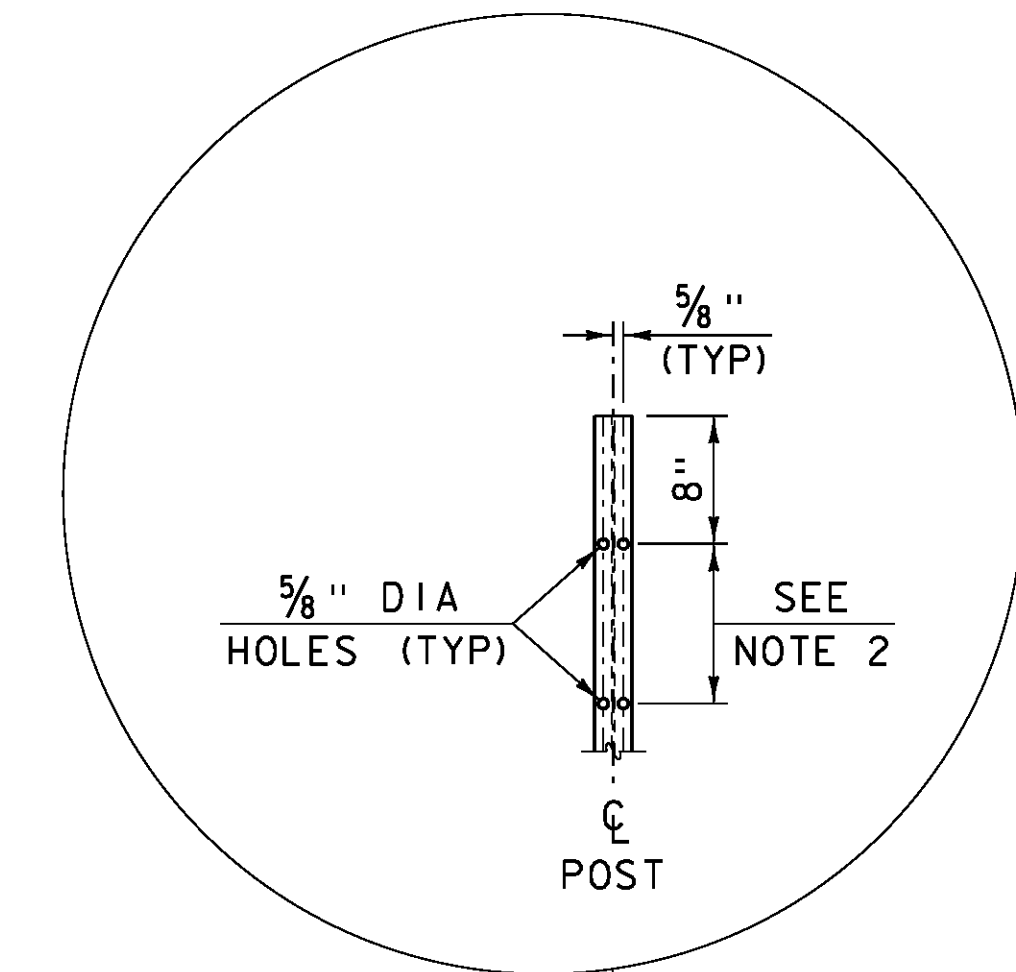

**TRANSITION POST DETAIL**


NOT TO SCALE

**NOTES:**


1. PROTRUSIONS CAUSED BY WELDING OR GALVANIZING ARE NOT PERMITTED ON THE ADJOINING SURFACES OF THE BOX BEAM RAILS, SPLICE TUBES AND FILL PLATES.
2. HOLES IN POST FOR LOWER RAIL MAY BE LOCATED AND DRILLED IN THE FIELD. IF SO, GALVANIZING SHALL BE REPAIRED.

PROJECT NAME: ROYALTON  
PROJECT NUMBER: BRS 0147 (13)


FILE NAME: \BR 27\86e055rail.27.dgn PLOT DATE: 08-OCT-2013  
PROJECT LEADER: C. CARLSON DRAWN BY: D. PETERSON  
DESIGNED BY: D. PETERSON CHECKED BY: C. CARLSON  
BRIDGE 27 APPROACH RAIL DETAILS (2) SHEET 49 OF 186

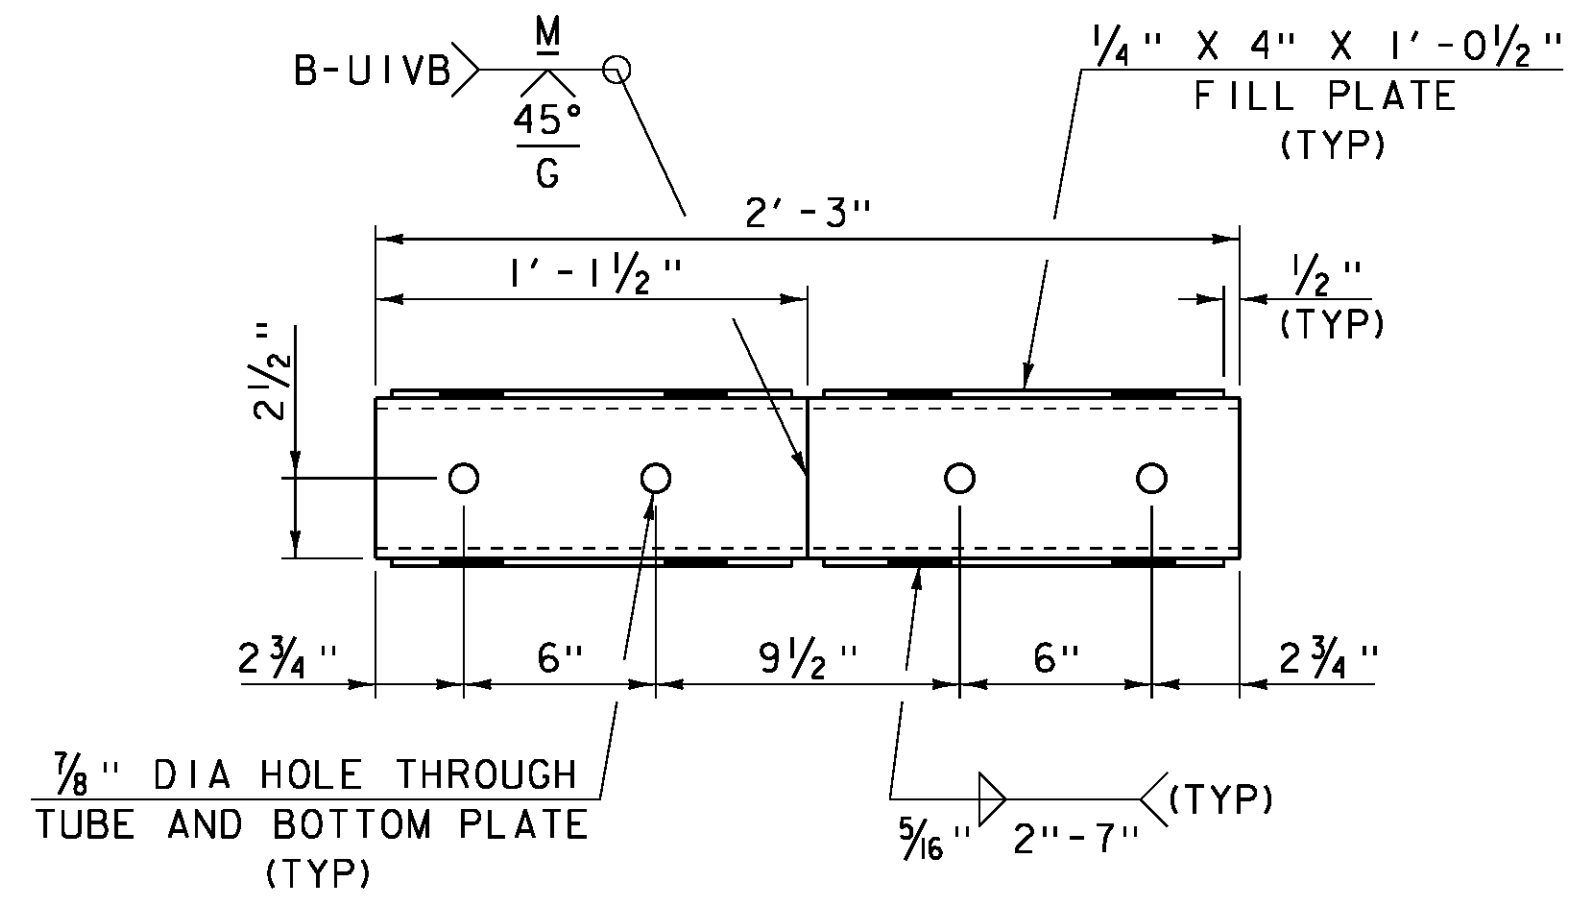


**FIXED SPLICE TUBE PLAN**  
NOT TO SCALE

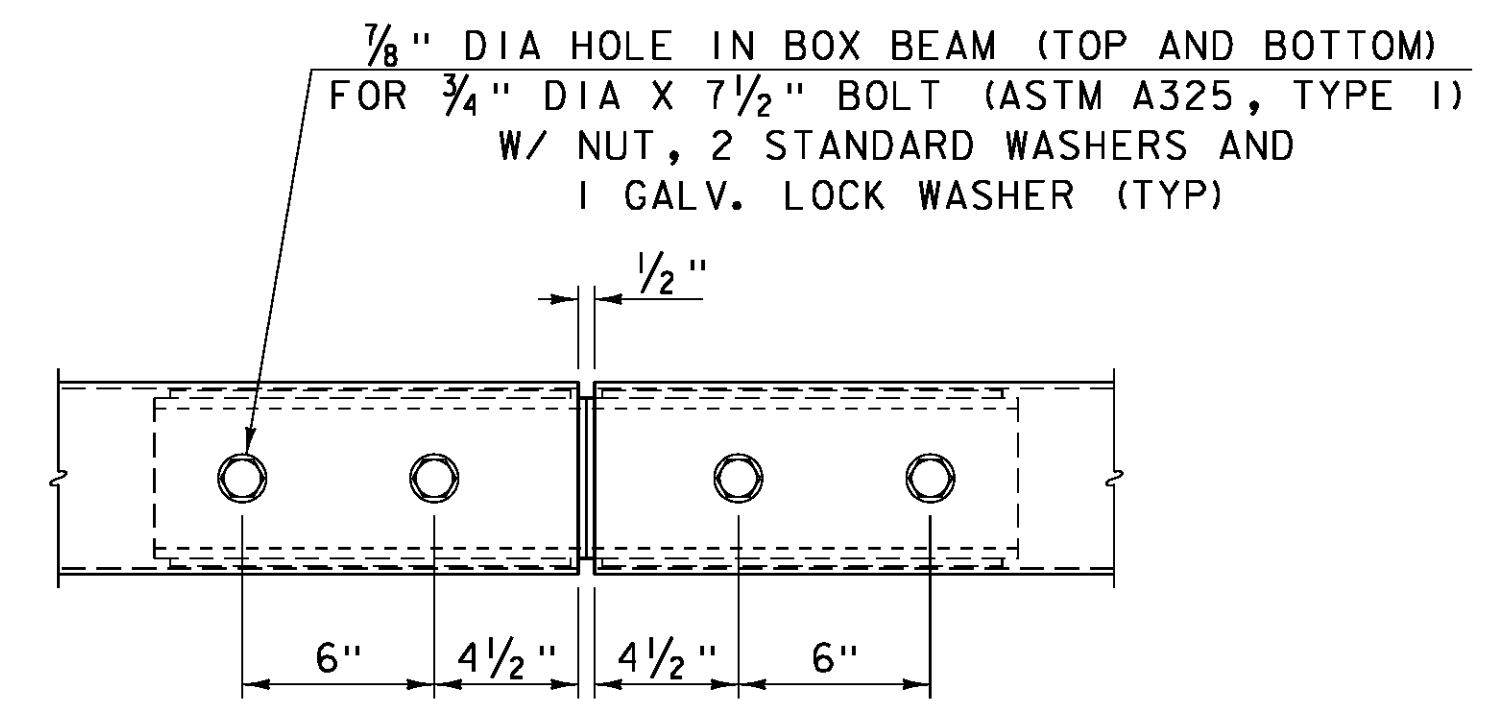


**FIXED SPLICE ASSEMBLY PLAN**  
NOT TO SCALE

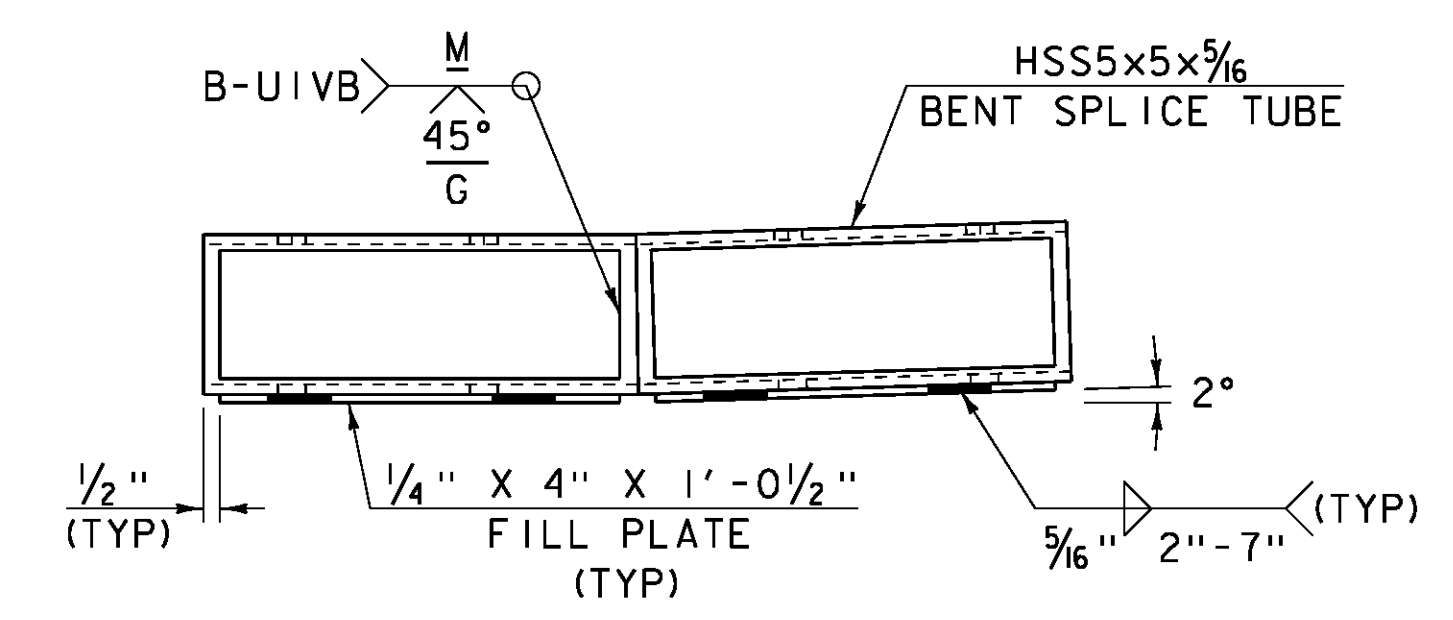

**FIXED SPLICE TUBE ELEVATION**  
NOT TO SCALE

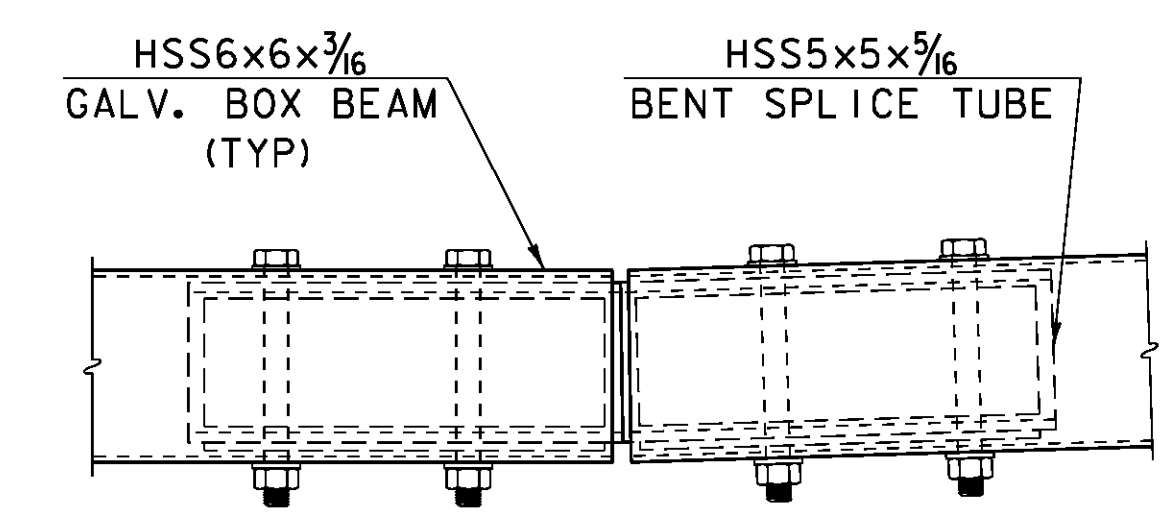


**FIXED SPLICE ASSEMBLY ELEVATION**  
NOT TO SCALE

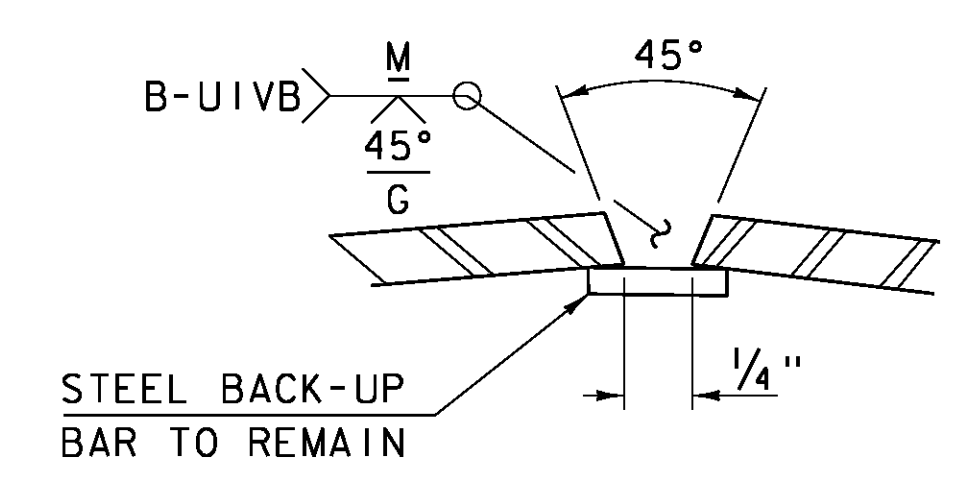


**WELD DETAIL FOR SPLICE TUBE**  
NOT TO SCALE

PROJECT NAME:	ROYALTON
PROJECT NUMBER:	BRS 0147 (13)
FILE NAME:	BR 27\86e055rail.27.dgn
PROJECT LEADER:	C. CARLSON
DESIGNED BY:	D. PETERSON
BRIDGE 27 APPROACH RAIL DETAILS (3)	
PLOT DATE:	08-OCT-2013
DRAWN BY:	D. PETERSON
CHECKED BY:	C. CARLSON
SHEET	50 OF 186

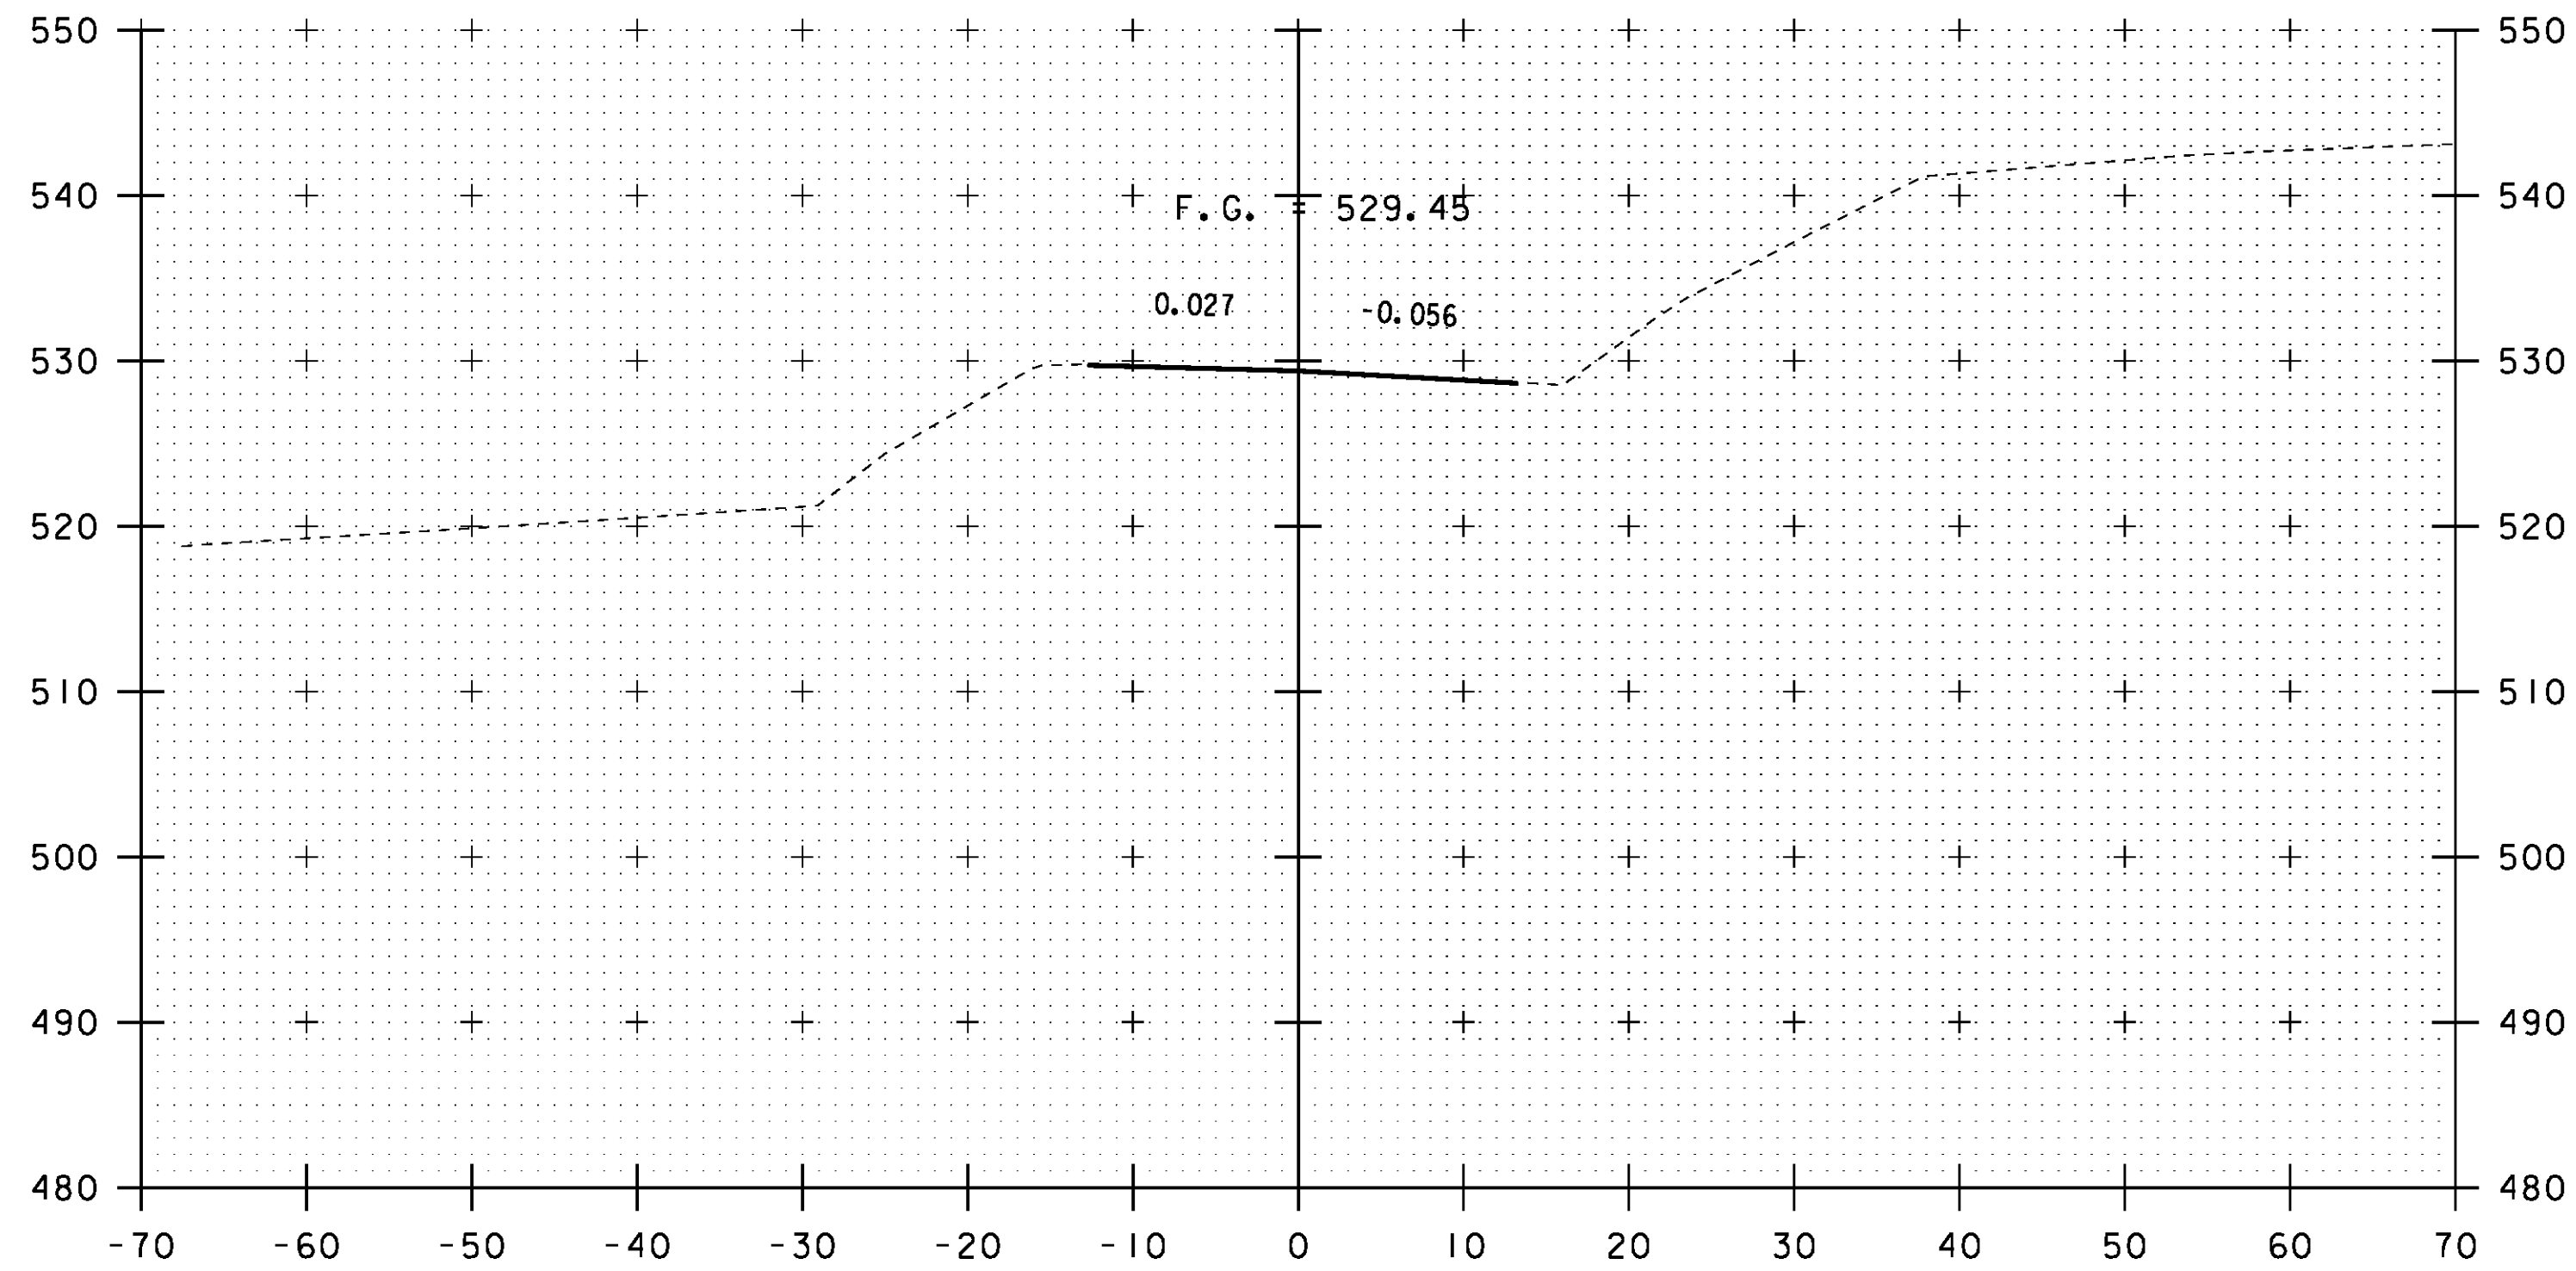


382+50


STA 382+50.00  
BEGIN APPROACH  
MATCH EXISTING

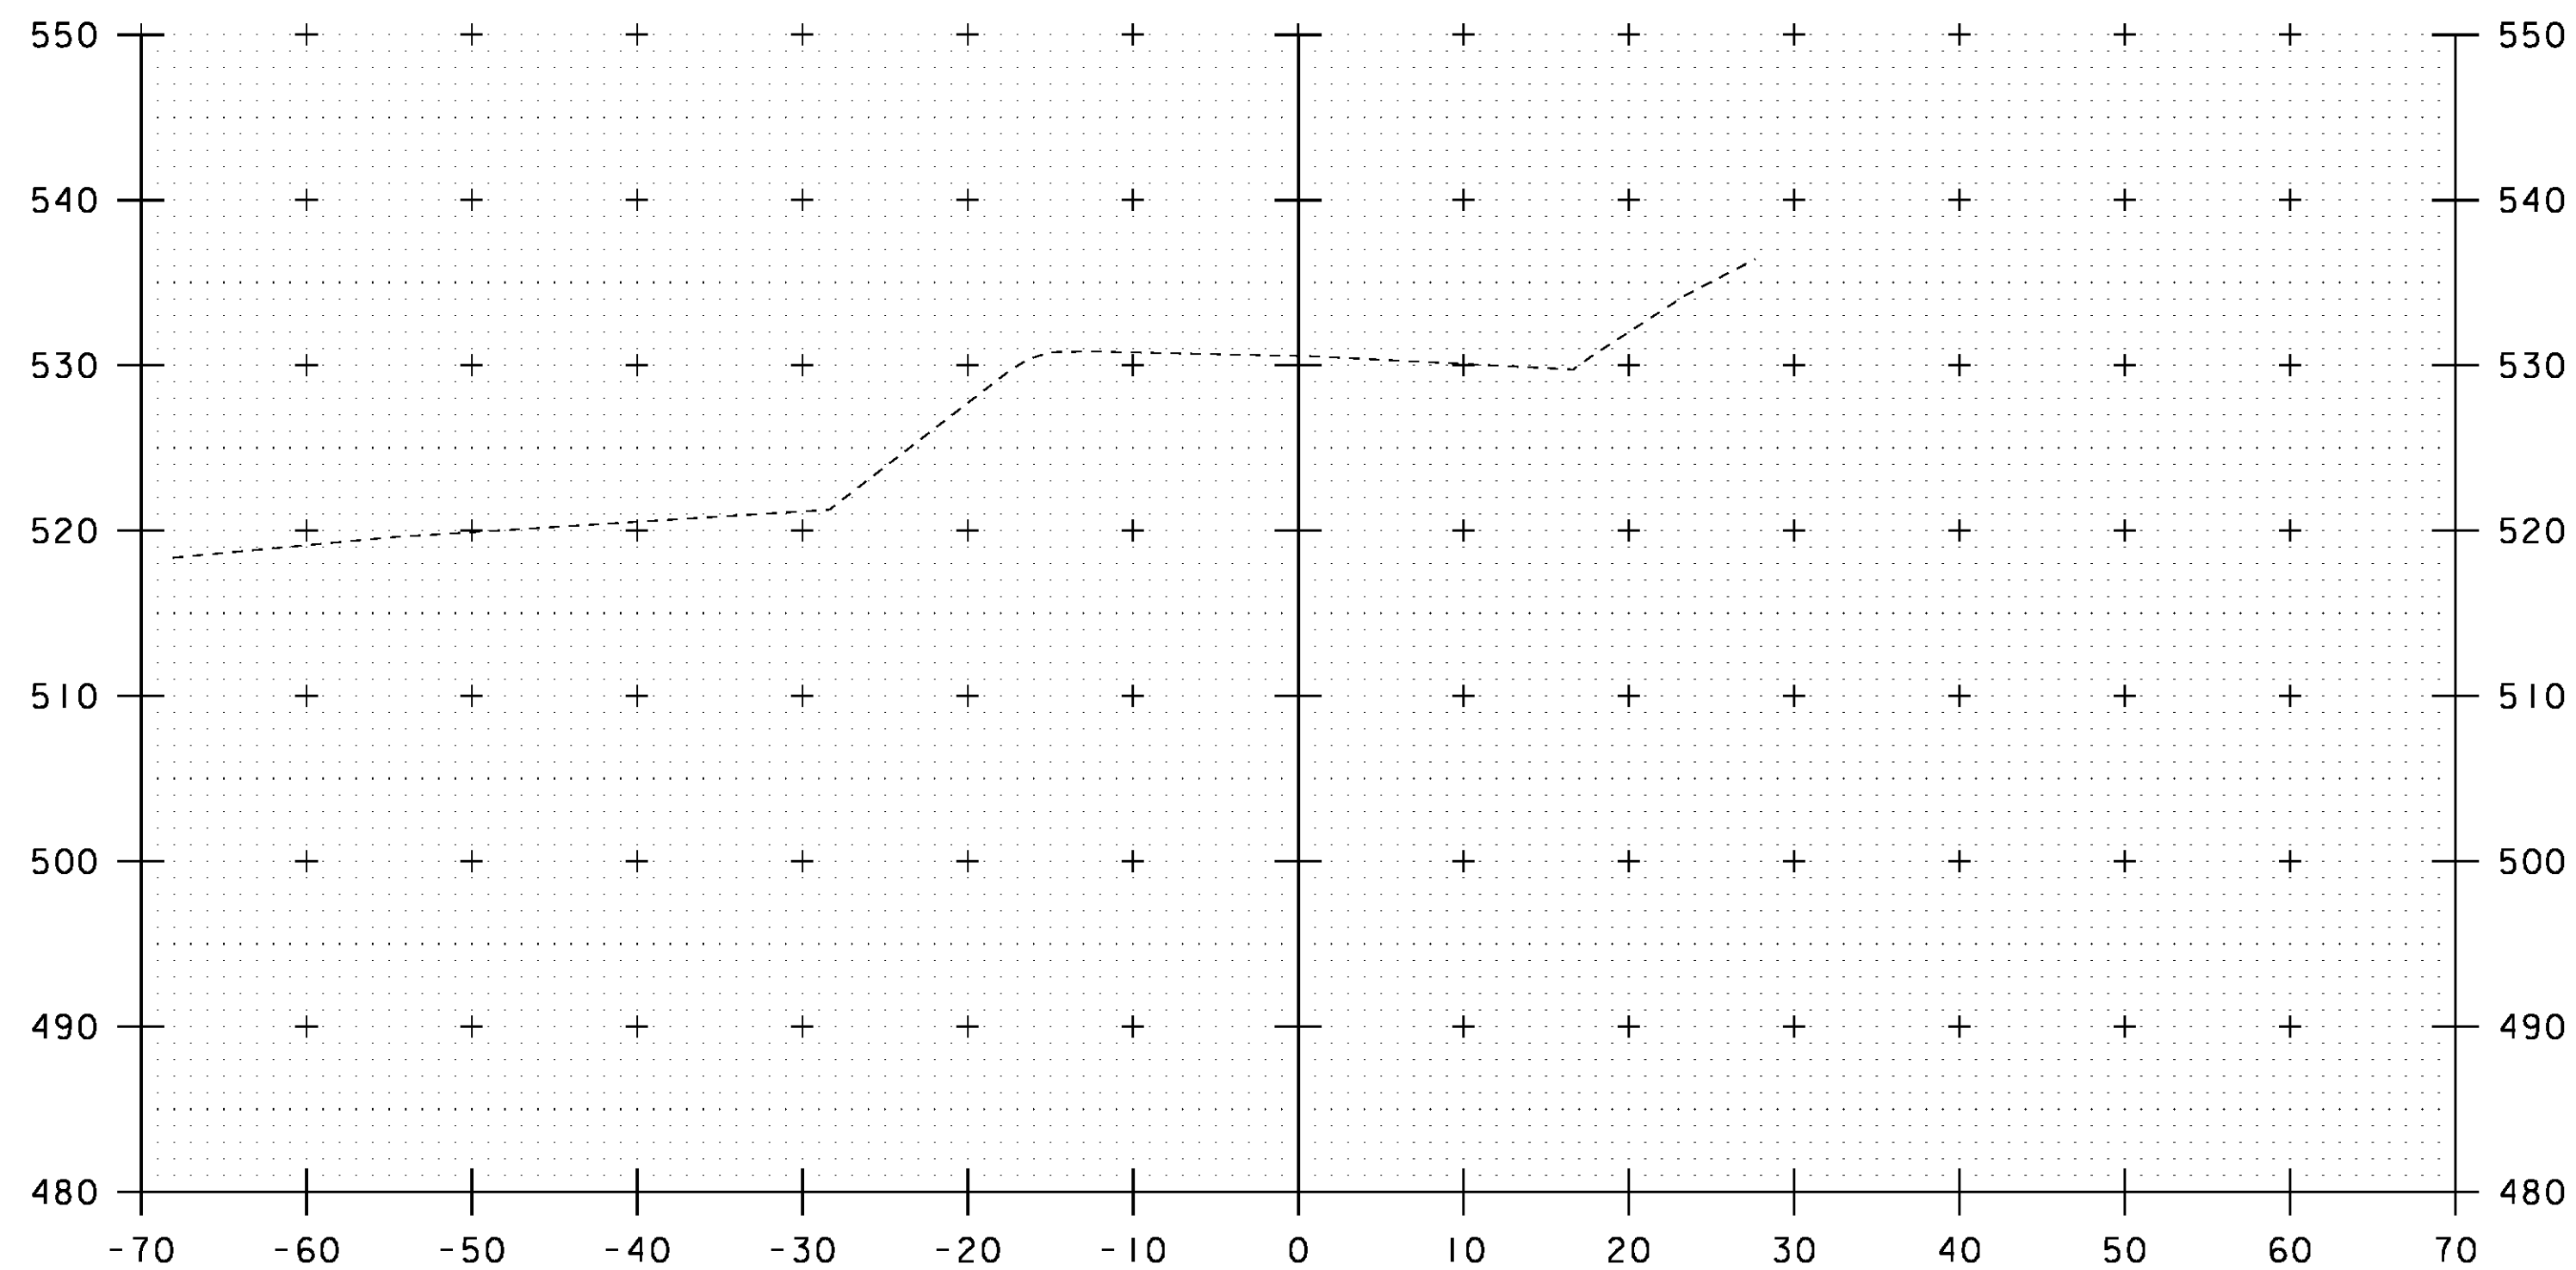

382+25

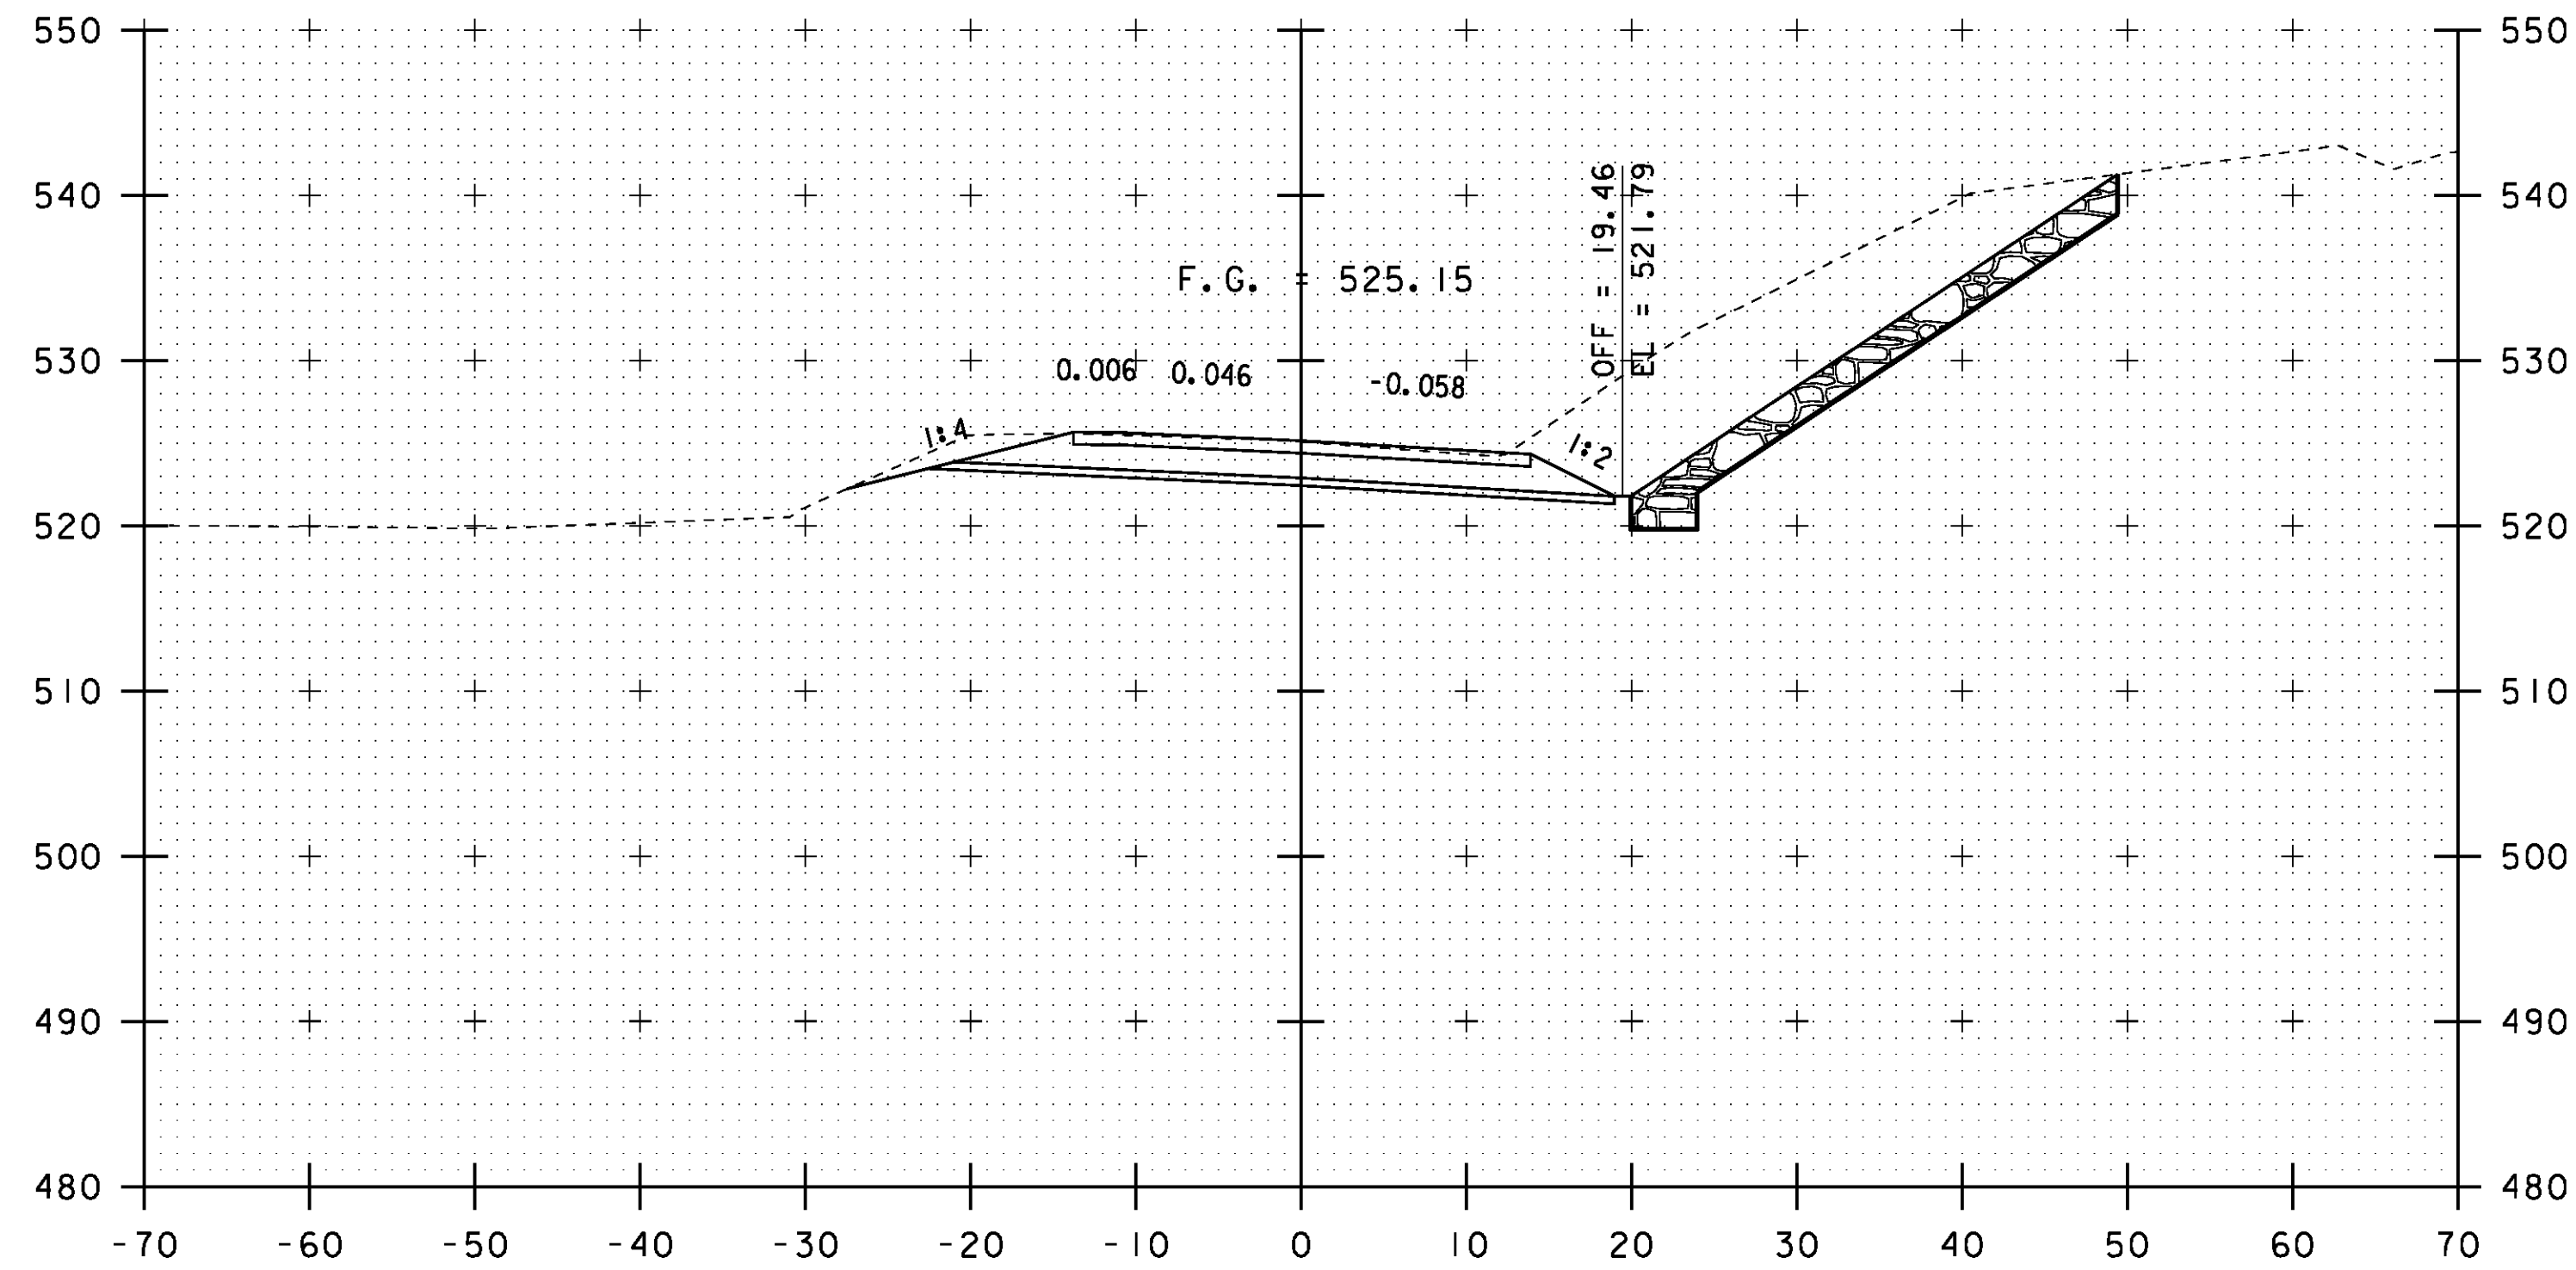

383+50

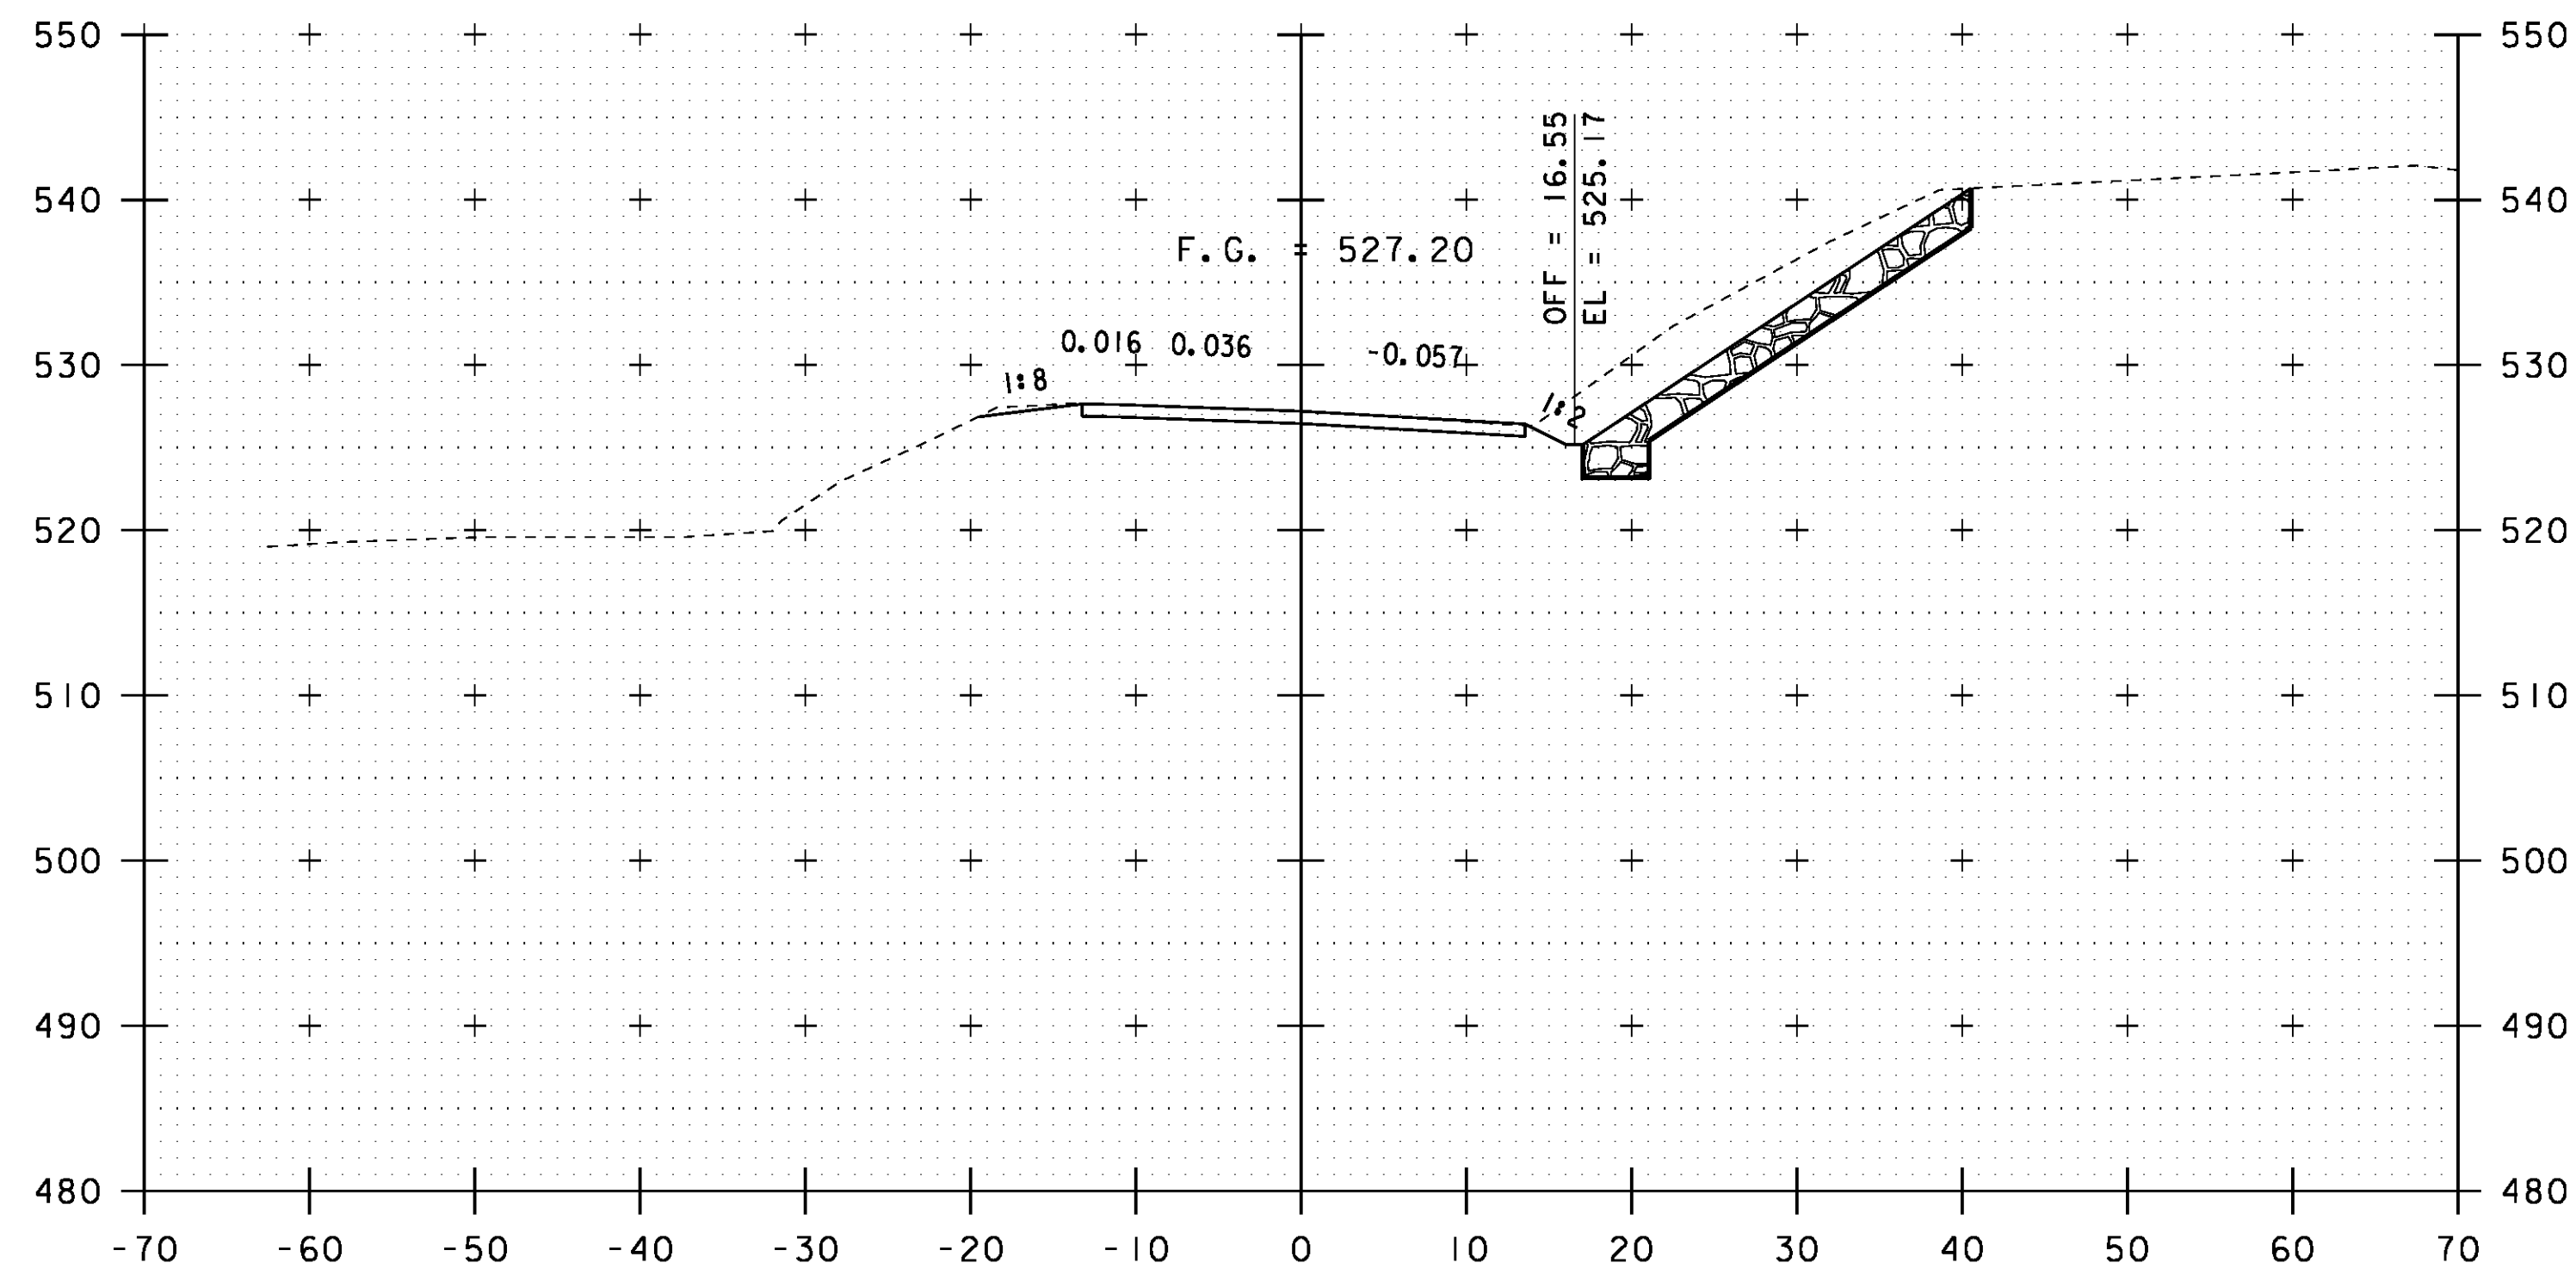


383+00

STA 382+80.9 RT - STA 386+15.0 RT  
CONSTRUCT SLOPE W/ STONE FILL, TYPE II  
STA 382+75.0 RT - STA 386+25.0 RT  
CONSTRUCT NEW GRASS-LINED DITCH




STA. 382+25 TO STA. 383+50

PROJECT NAME:	ROYALTON	FILE NAME:	\BR 27\s86e055xsl.27.dgn	PLOT DATE:	08-OCT-2013
PROJECT NUMBER:	BRS 0147 (13)	PROJECT LEADER:	C. CARLSON	DRAWN BY:	G. ROY
		DESIGNED BY:	G. ROY	CHECKED BY:	D. PETERSON
			BRIDGE 27 VT 14 CROSS SECTIONS (1)	SHEET	51 OF 186

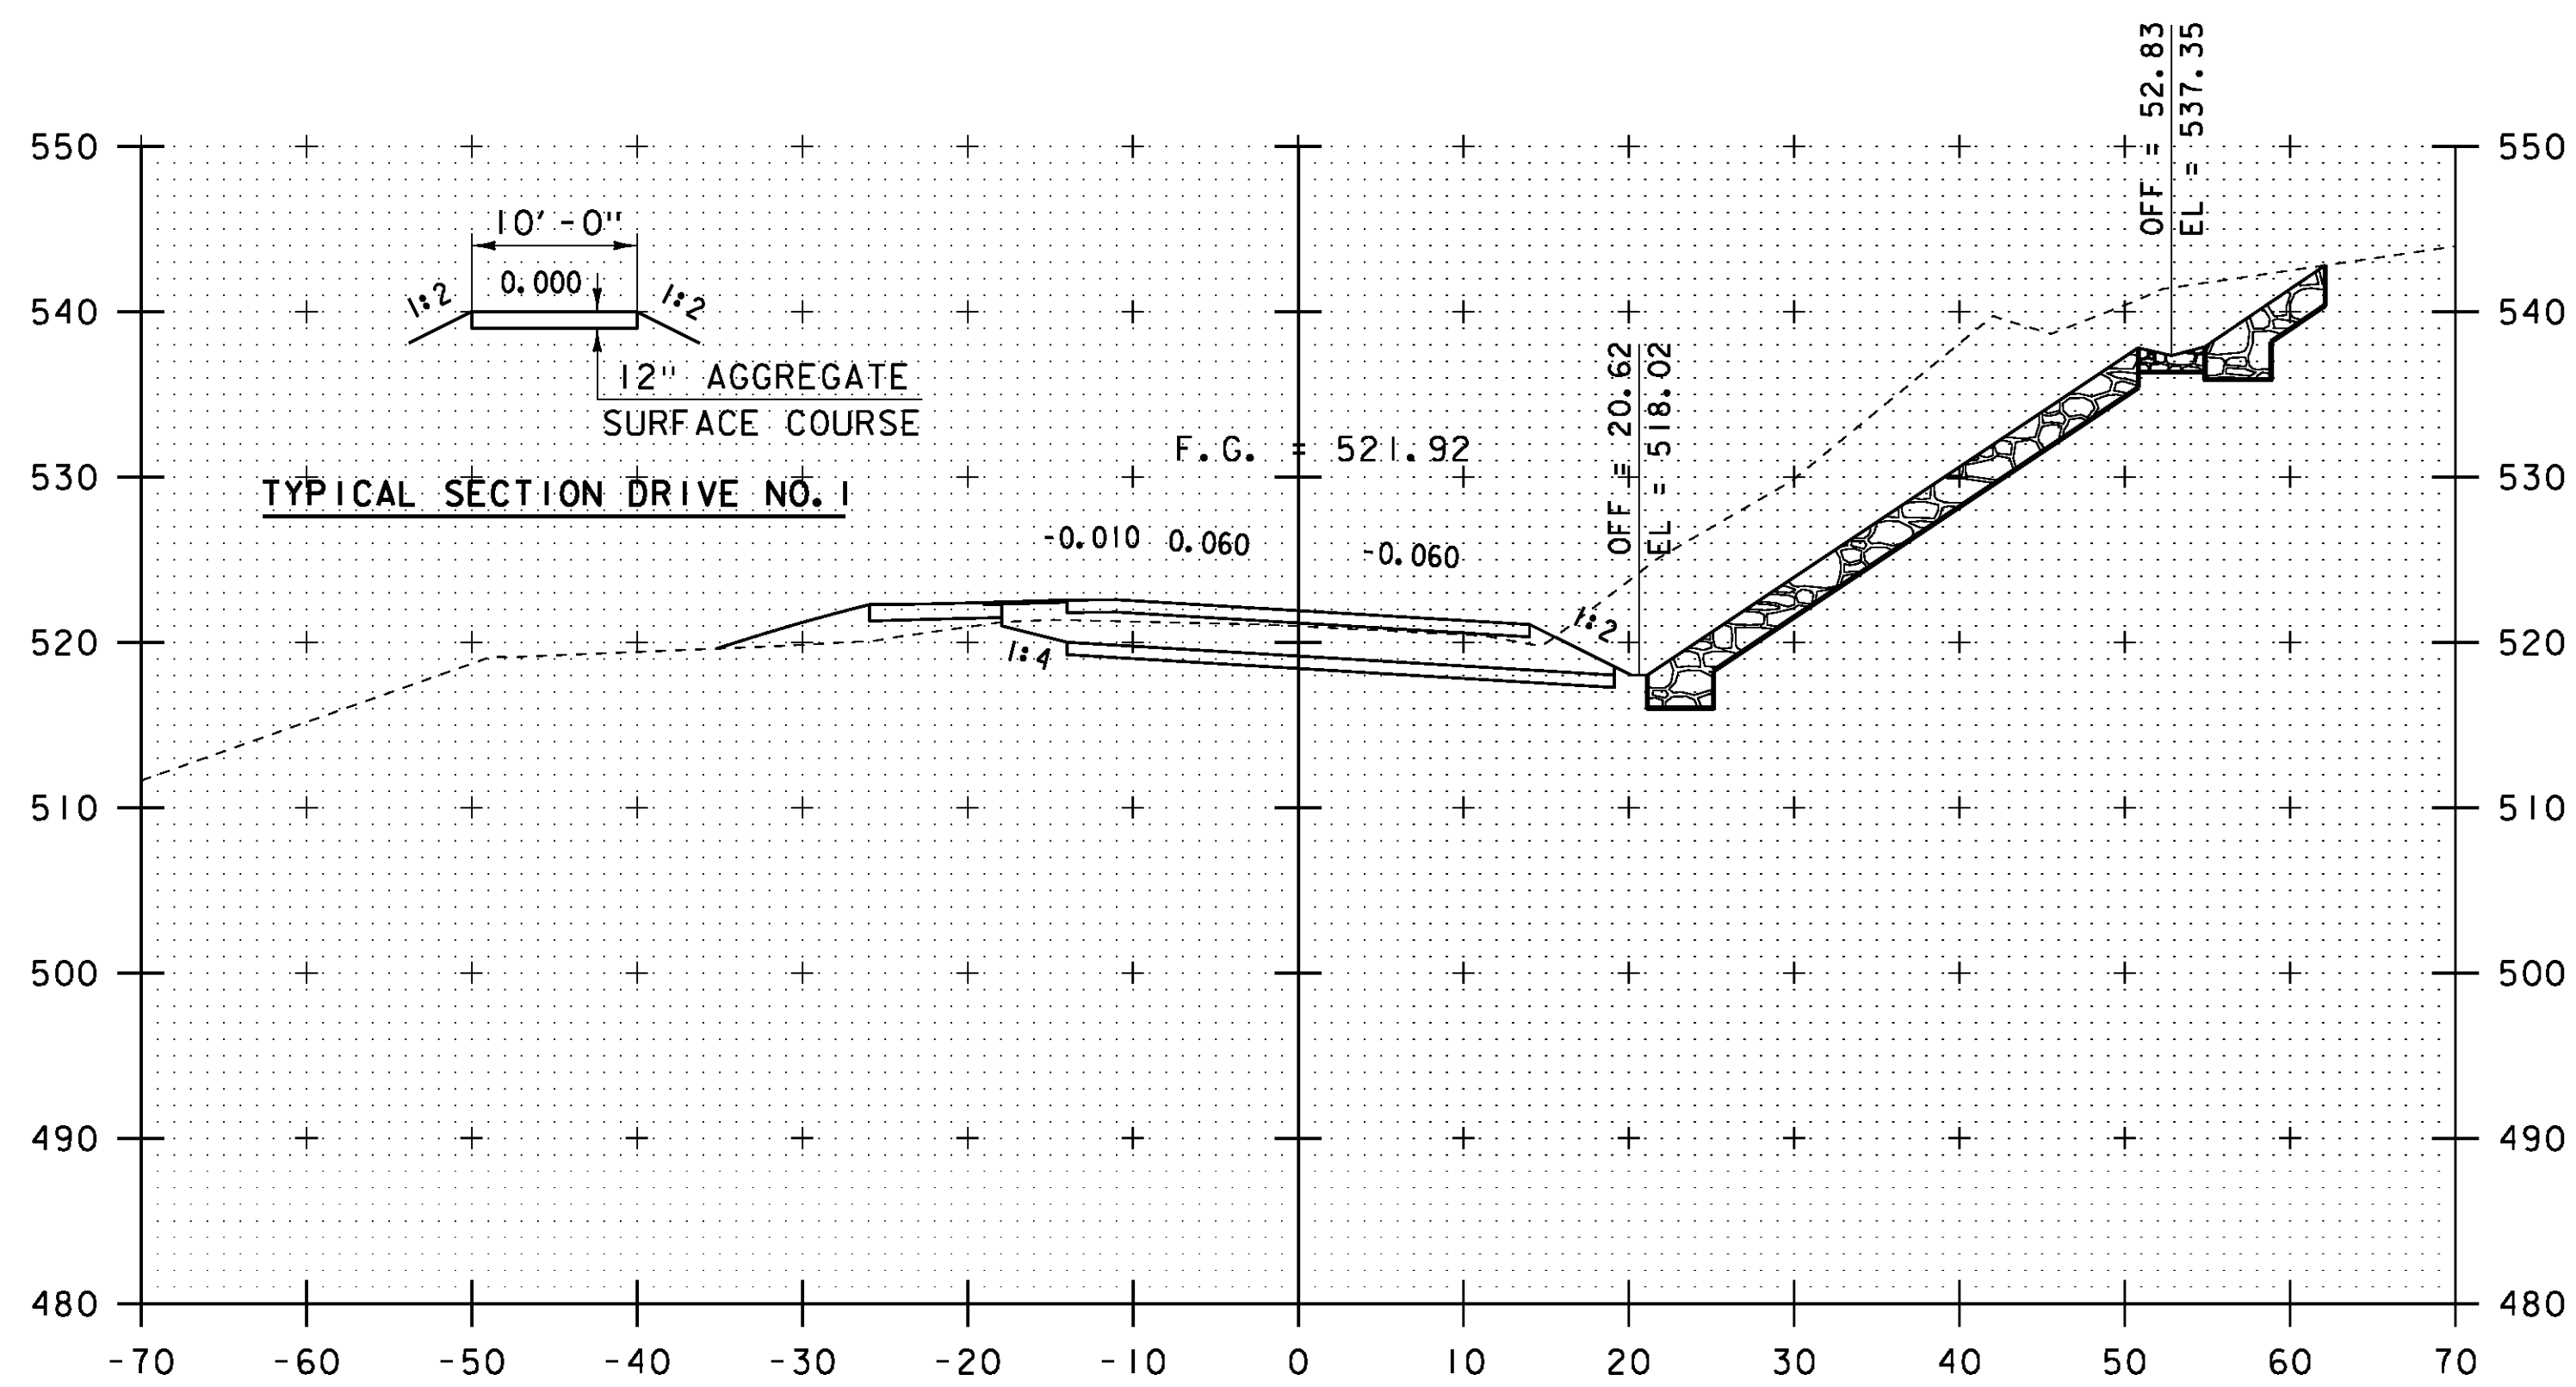

STA 384+50.0 LT  
CONSTRUCT DRIVE NO. 1


384+50

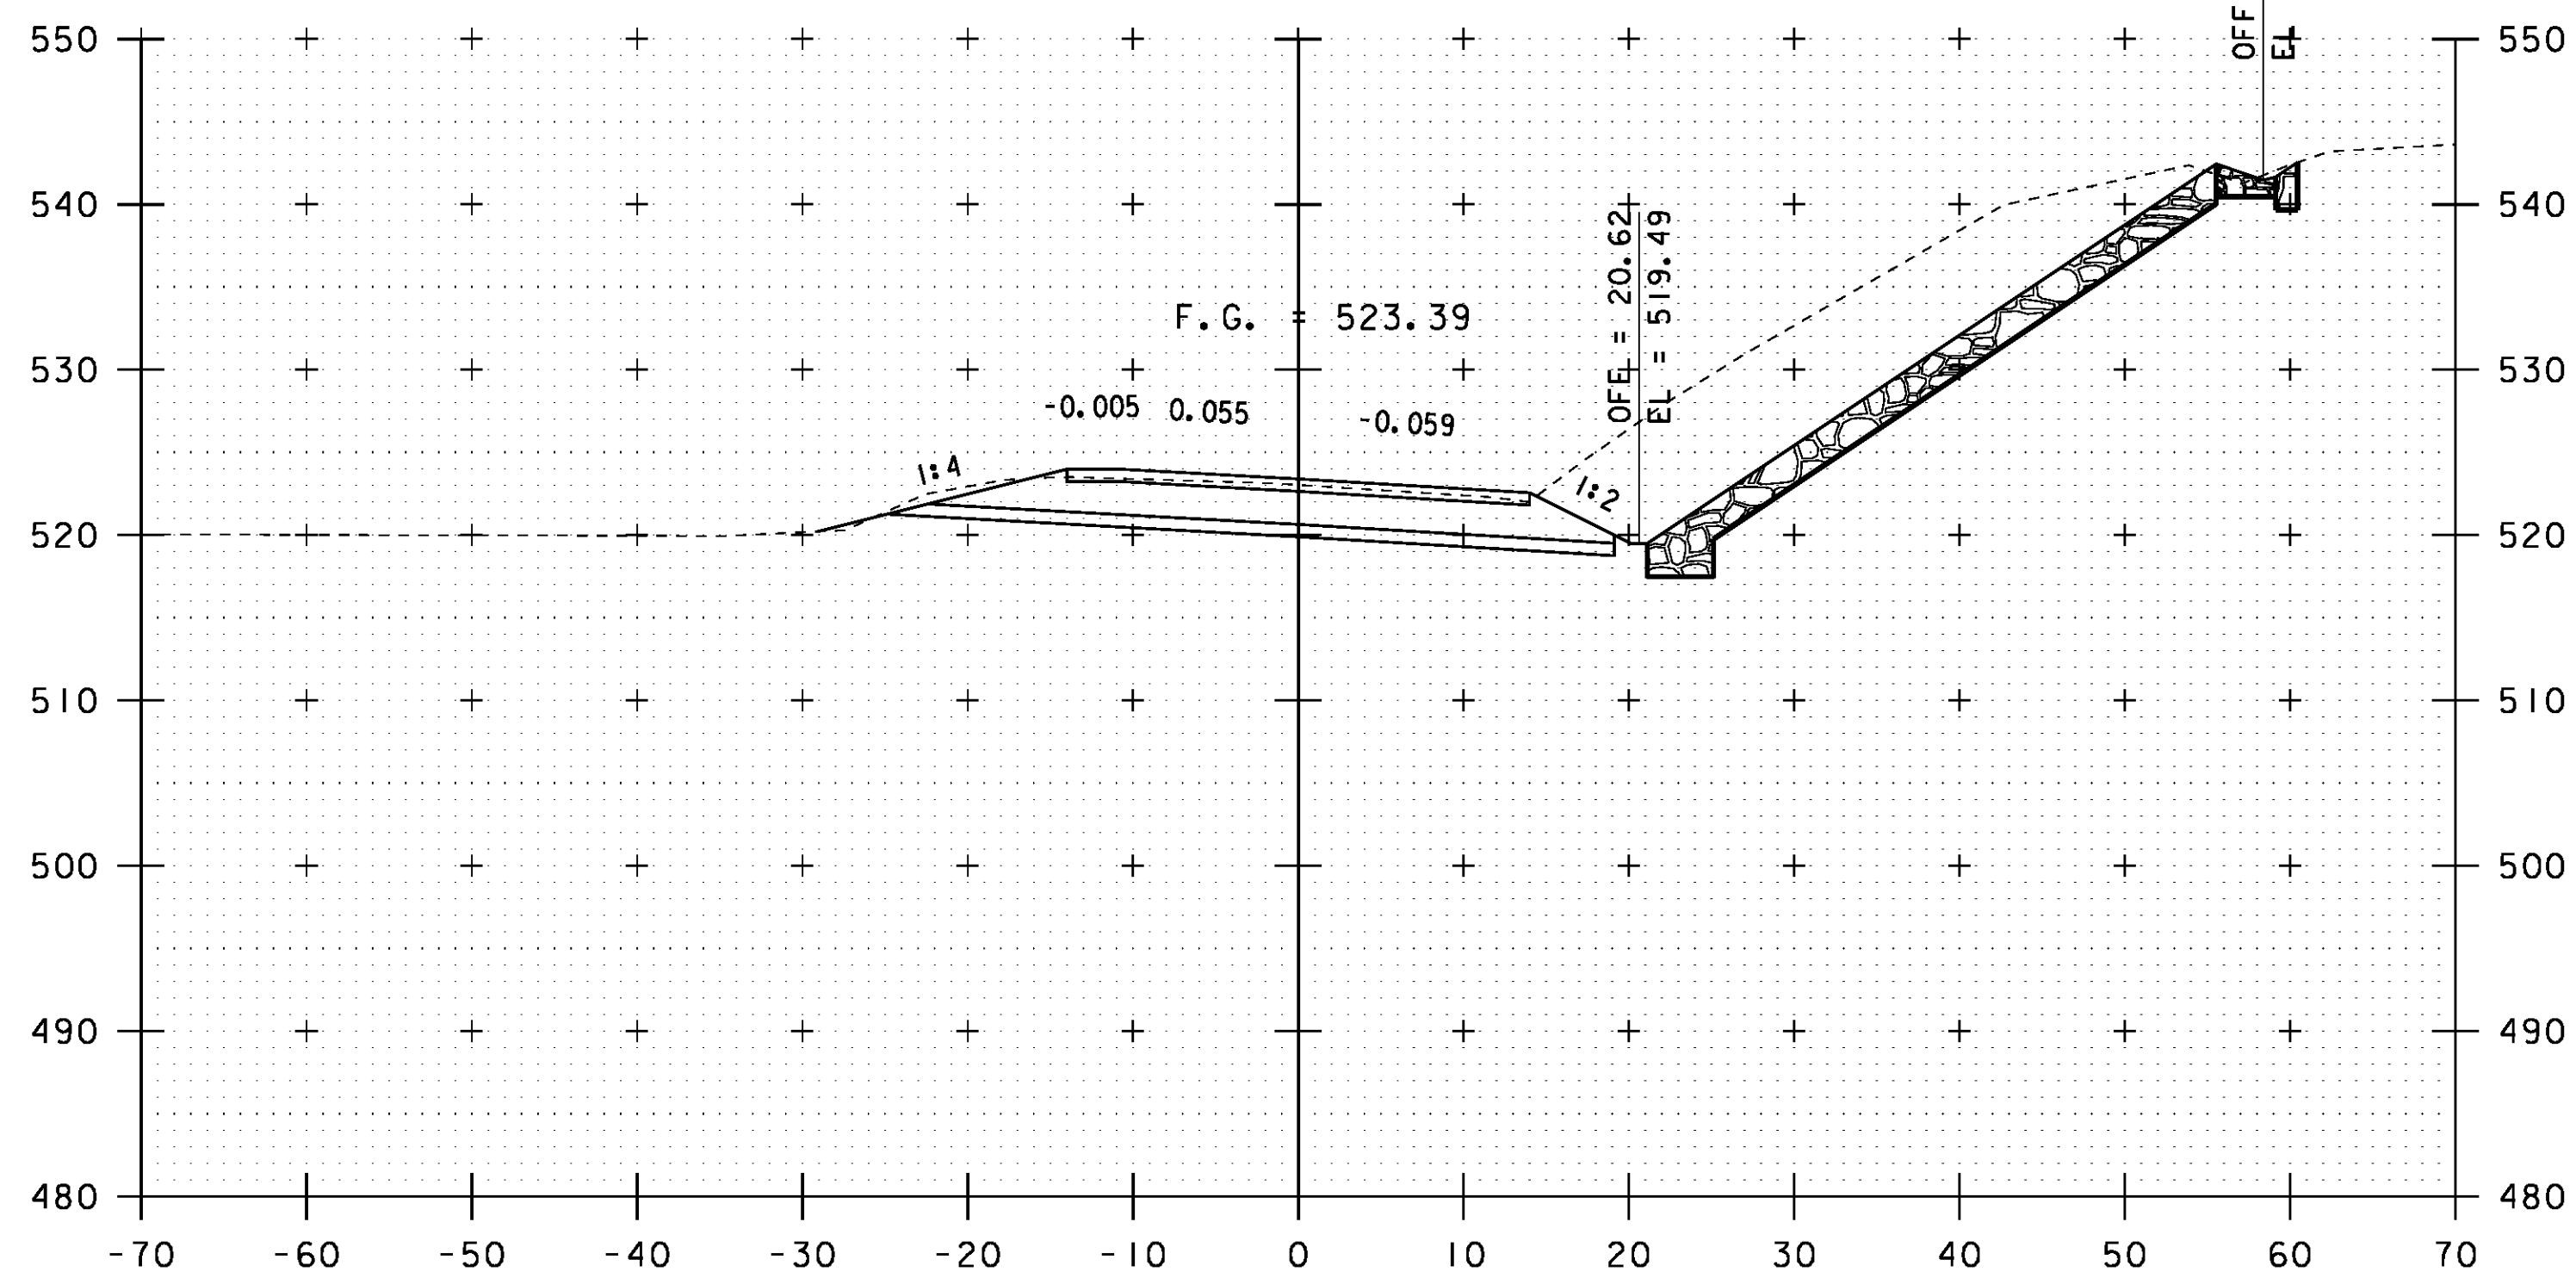


384+00

STA 383+91.3 RT - STA 385+83.2 RT  
CONSTRUCT NEW DITCH LINED WITH STONE FILL, TYPE 1


STA 383+70.00  
END APPROACH  
BEGIN PROJECT

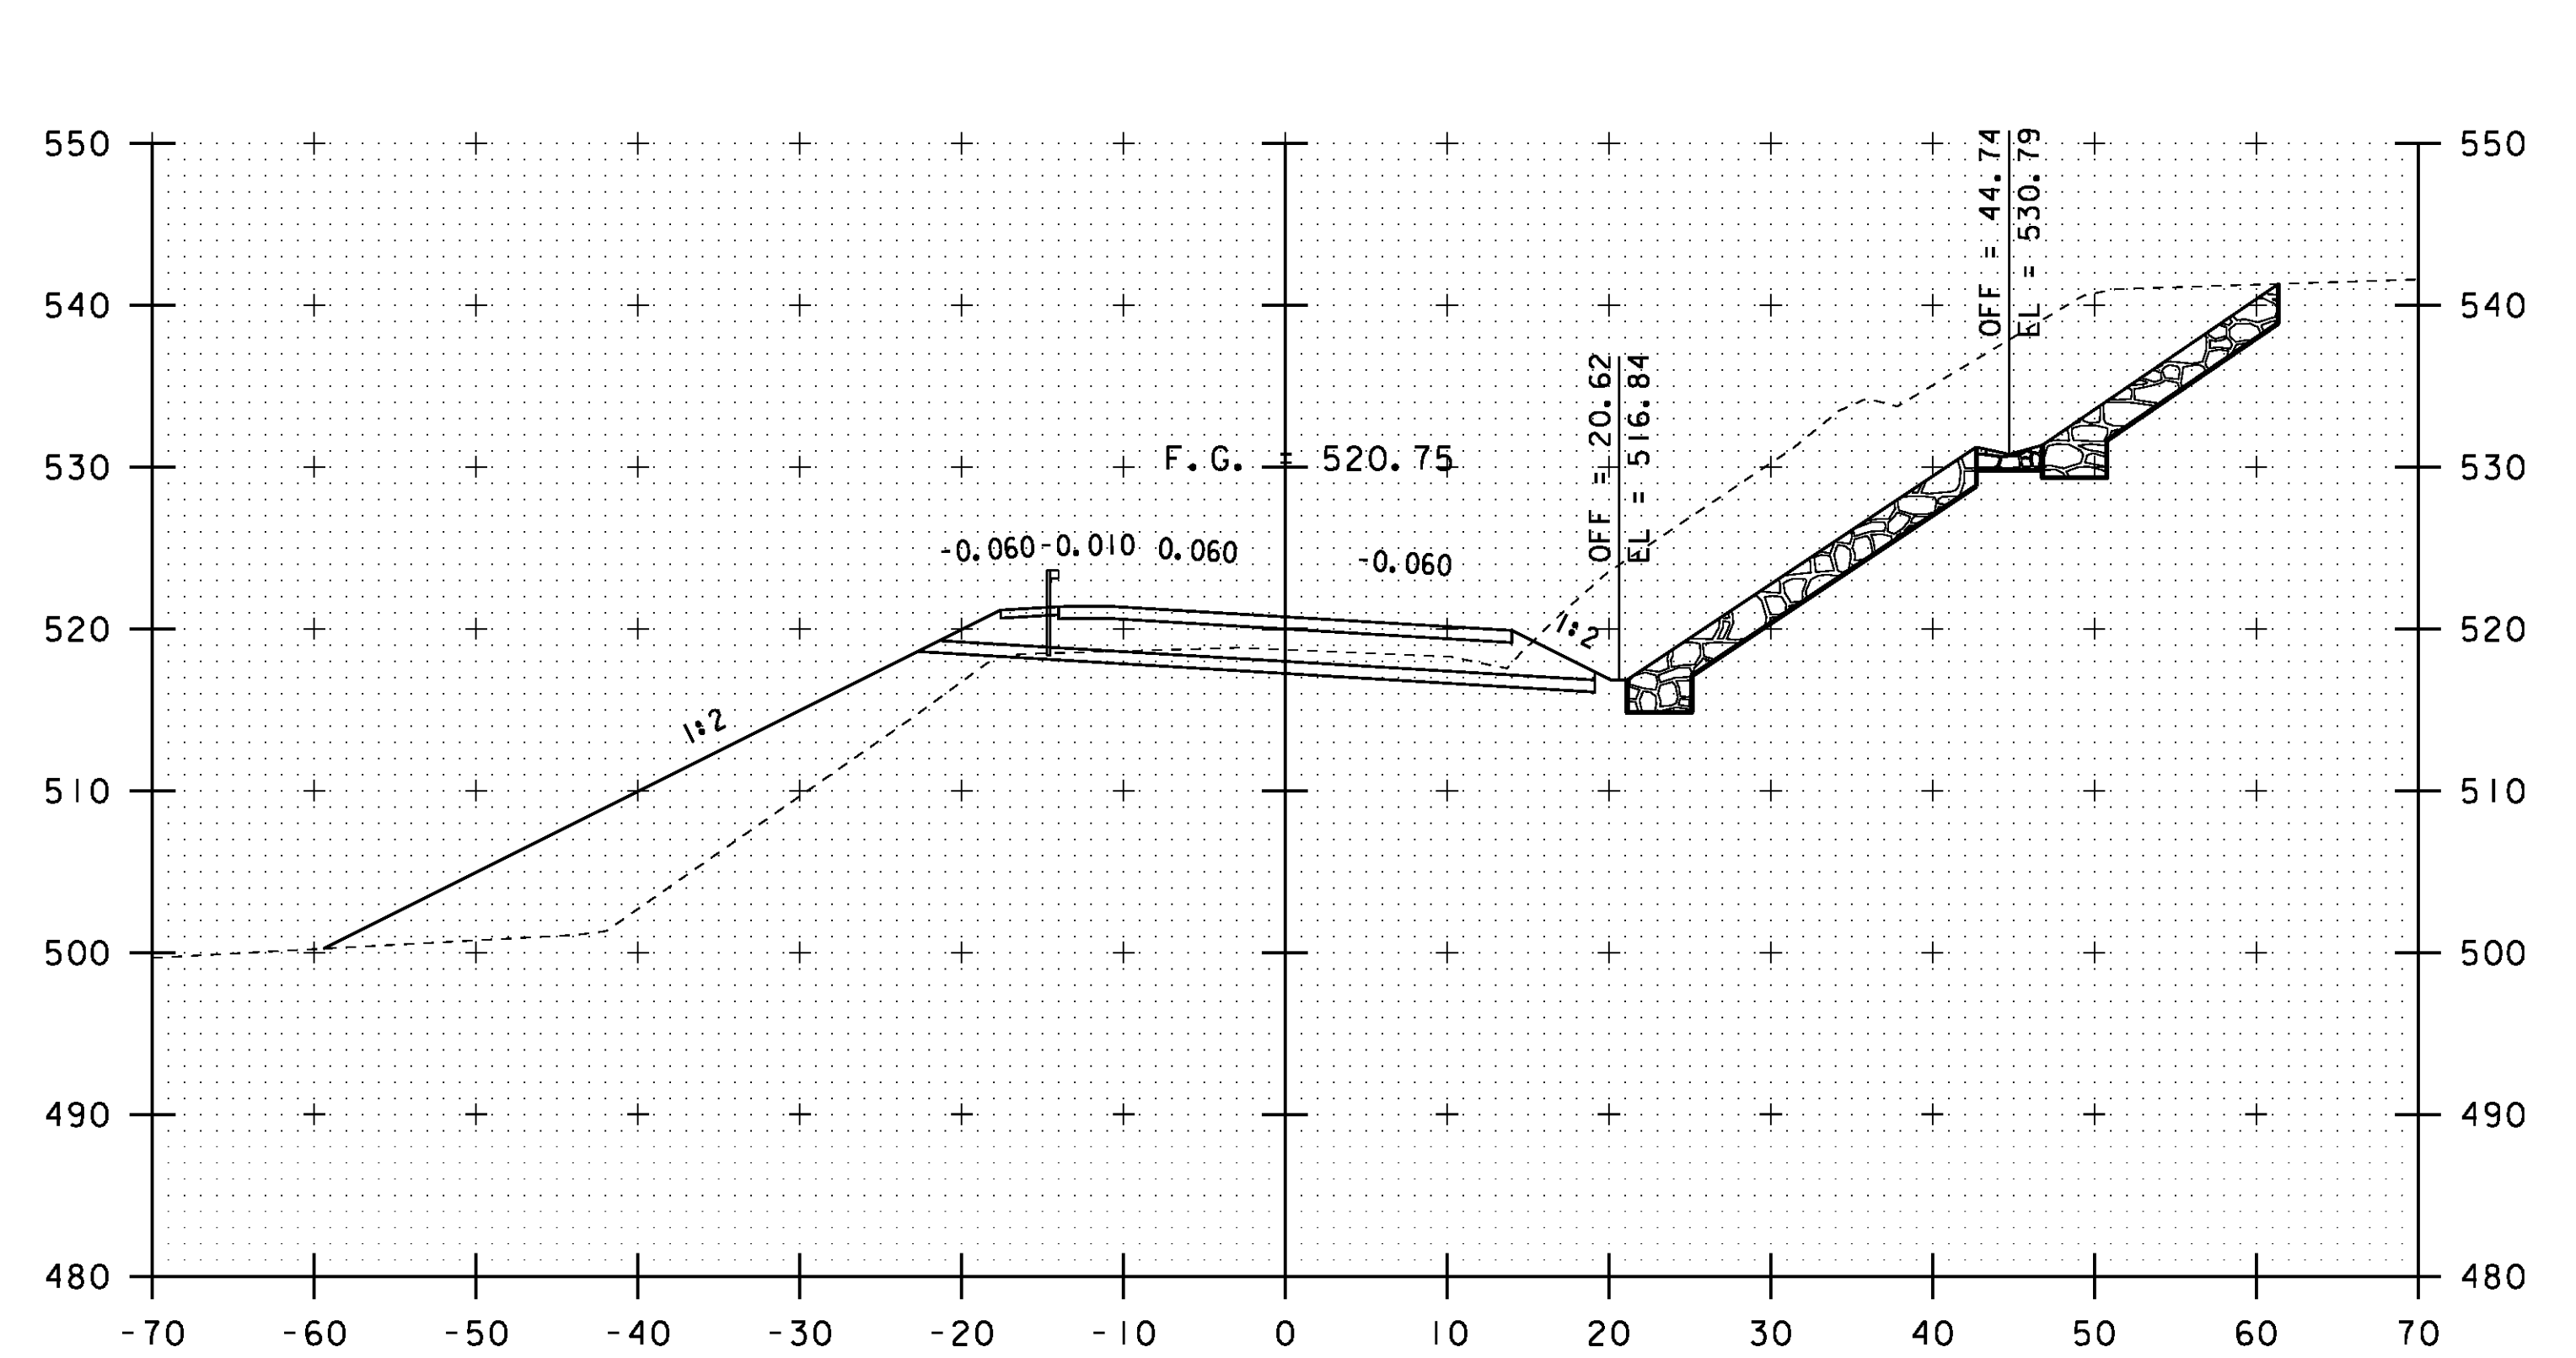

385+00

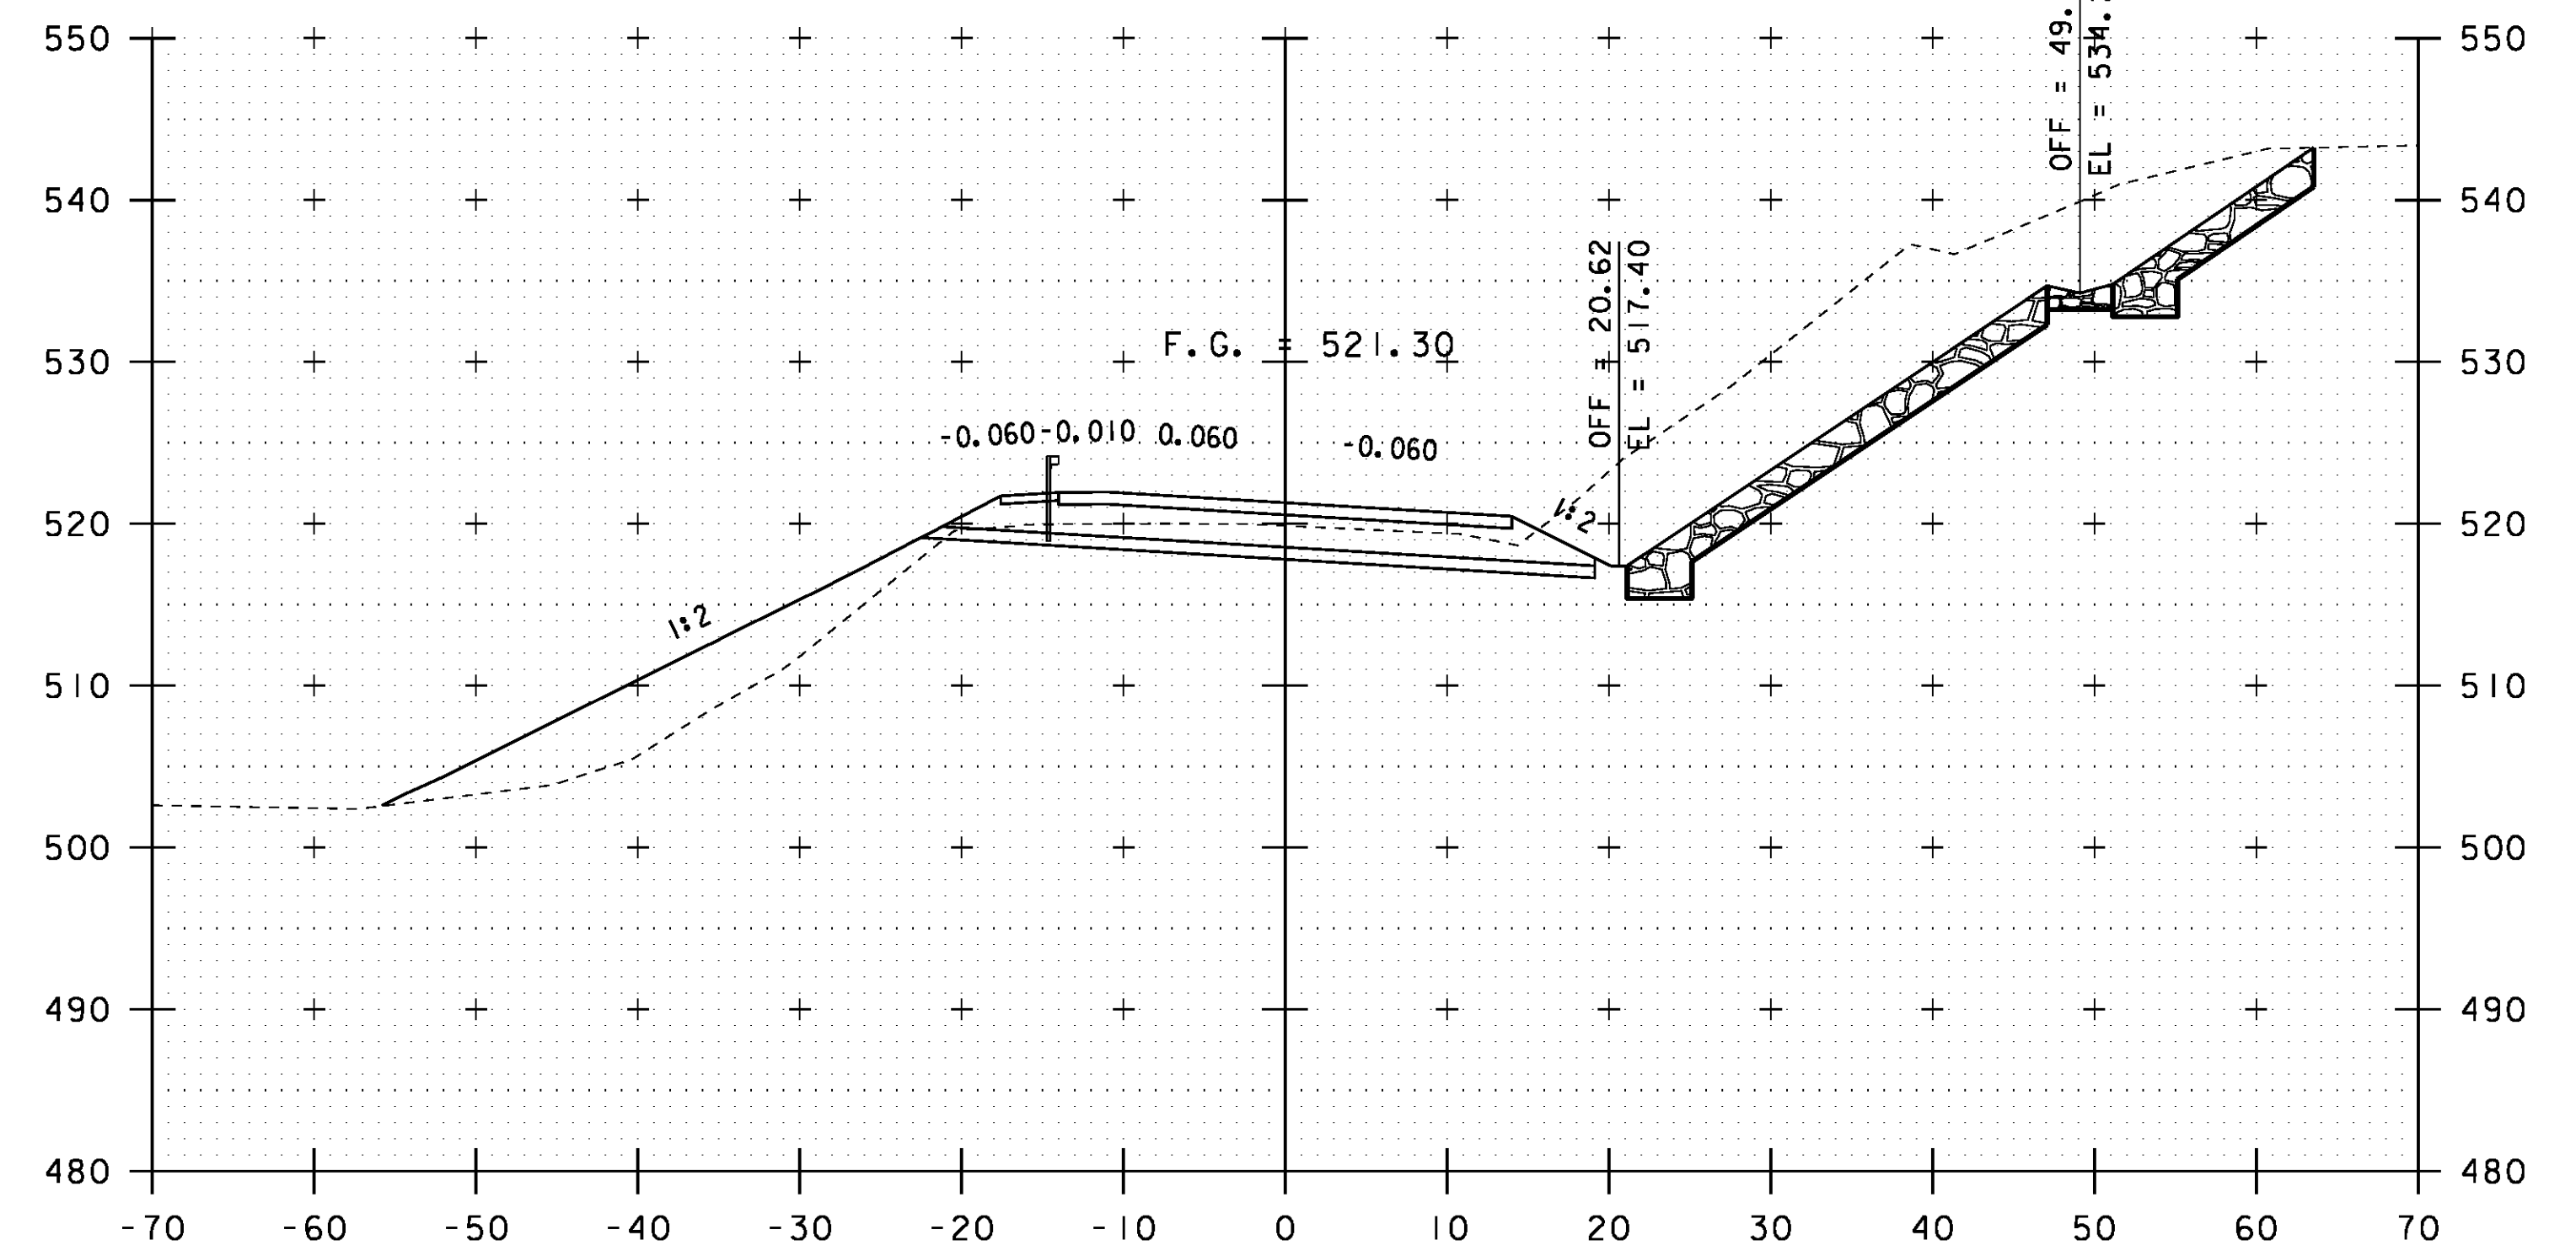

384+75

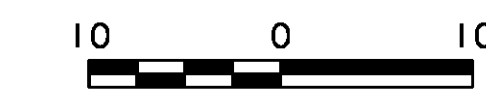


SCALE: 1" = 10'-0"

STA. 384+00 TO STA. 385+00

PROJECT NAME: ROYALTON  
PROJECT NUMBER: BRS 0147 (13)


FILE NAME: \BR 27\86e055\sl.27.dgn  
PROJECT LEADER: C. CARLSON  
DESIGNED BY: G. ROY  
BRIDGE 27 VT 14 CROSS SECTIONS (2)

PLOT DATE: 08-OCT-2013  
DRAWN BY: G. ROY  
CHECKED BY: D. PETERSON  
SHEET 52 OF 186

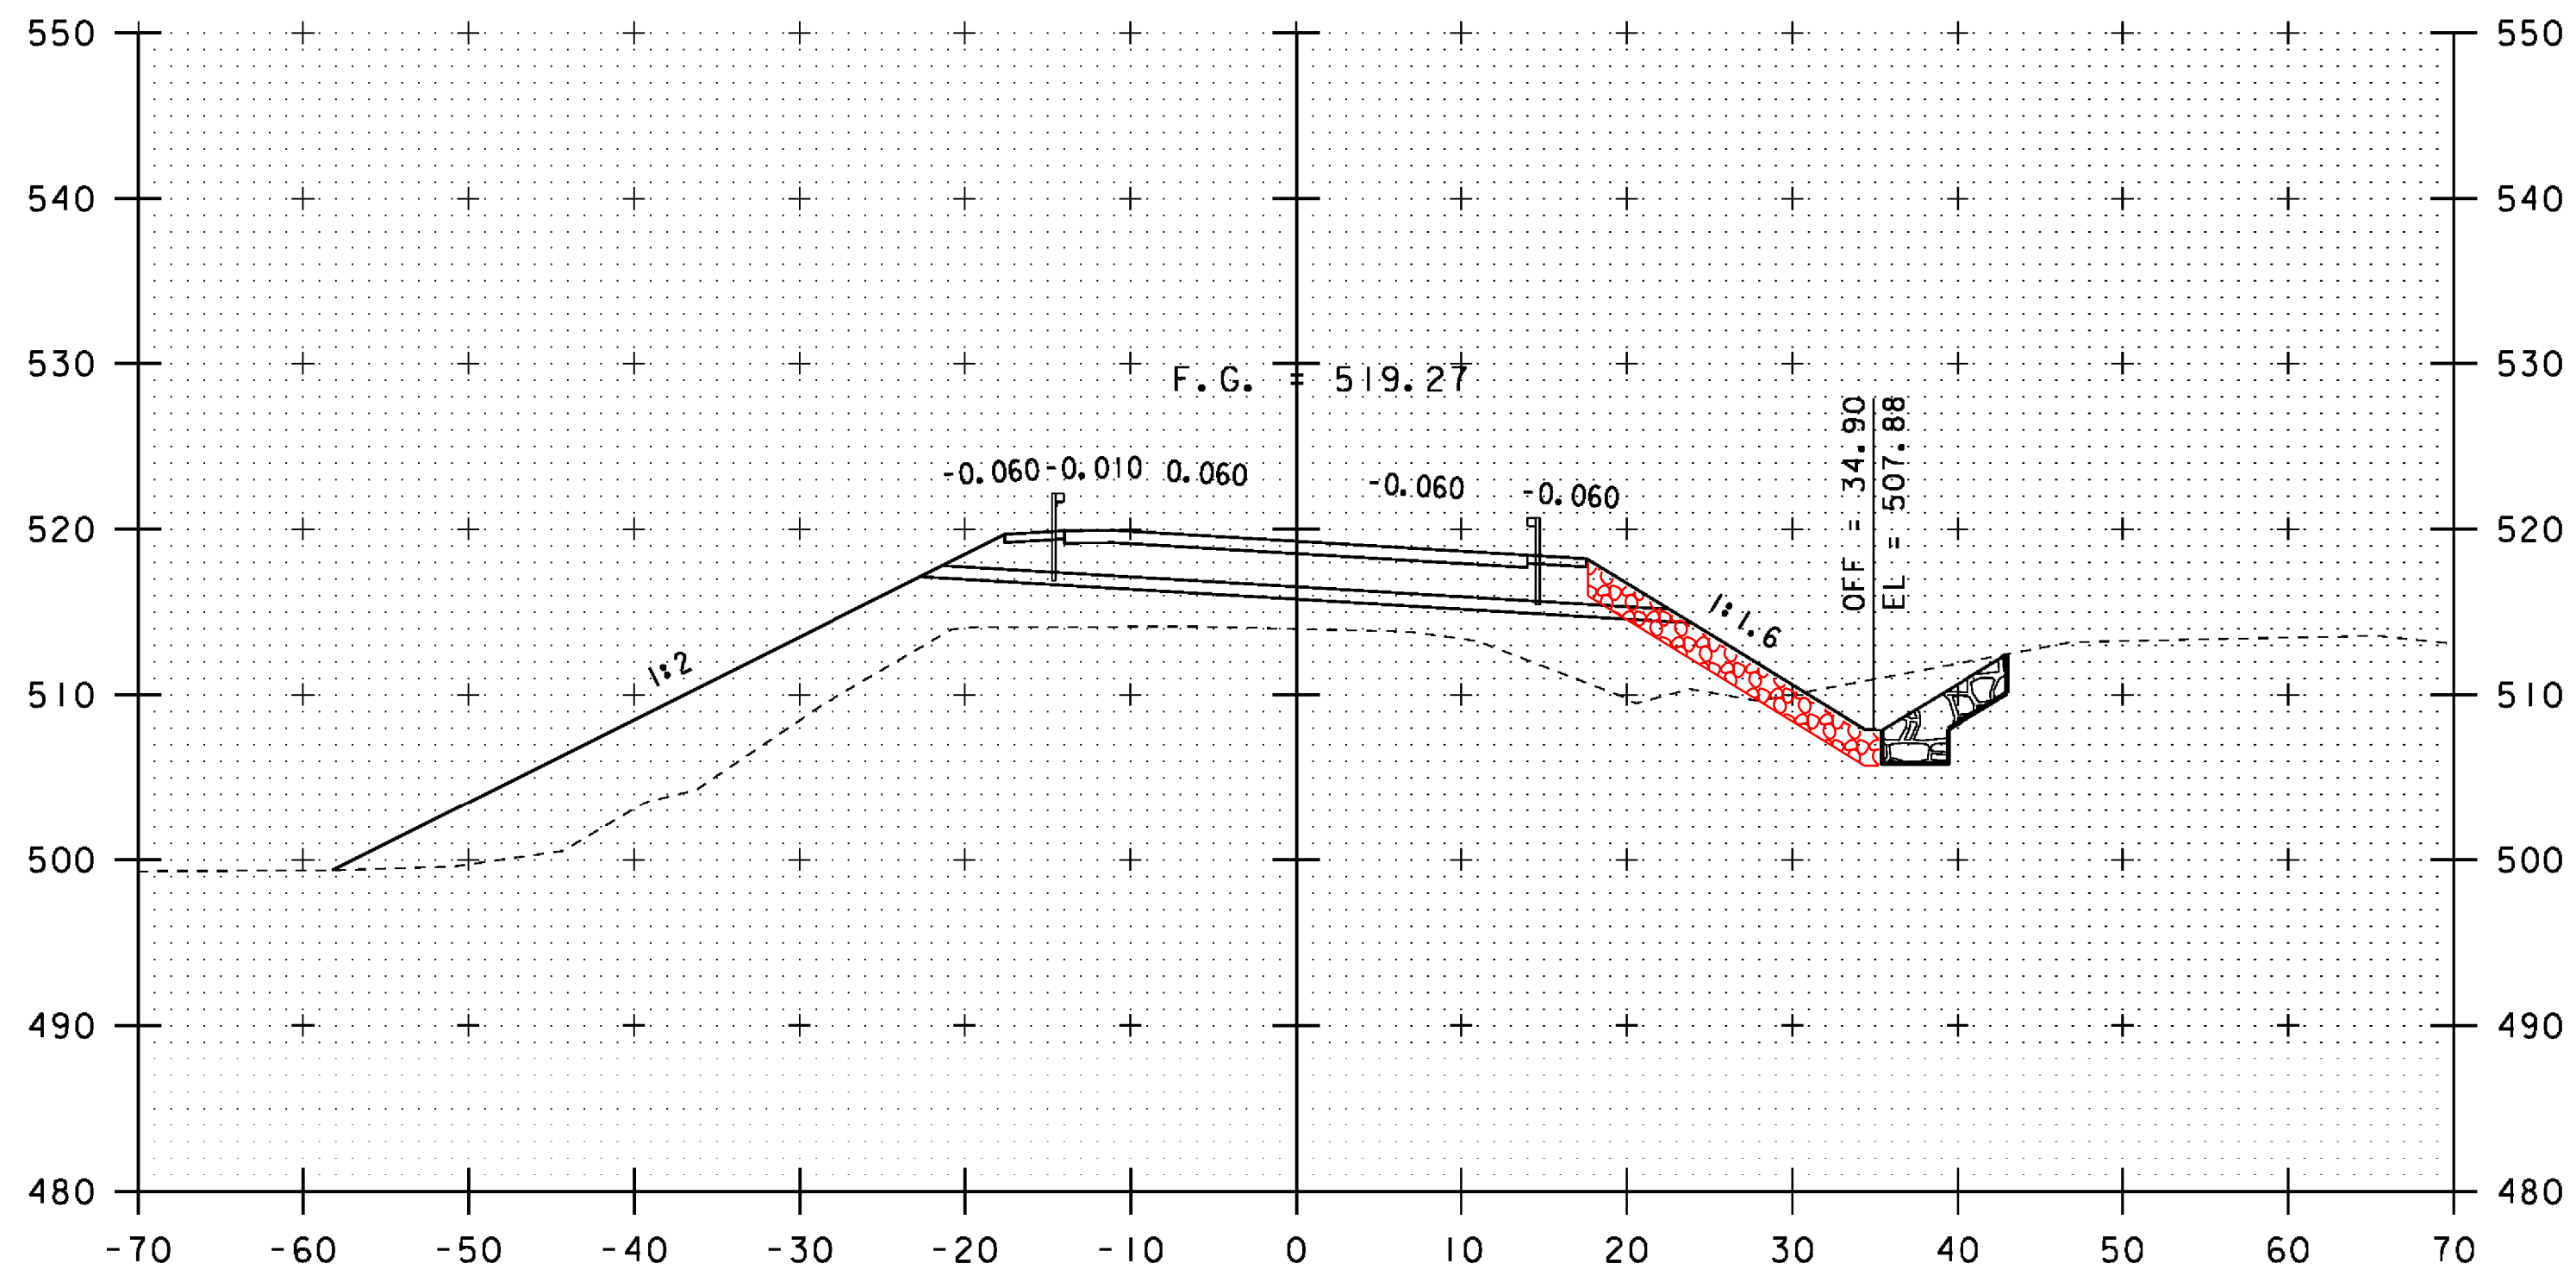


386+00


STA 383+70.00  
END APPROACH  
BEGIN PROJECT

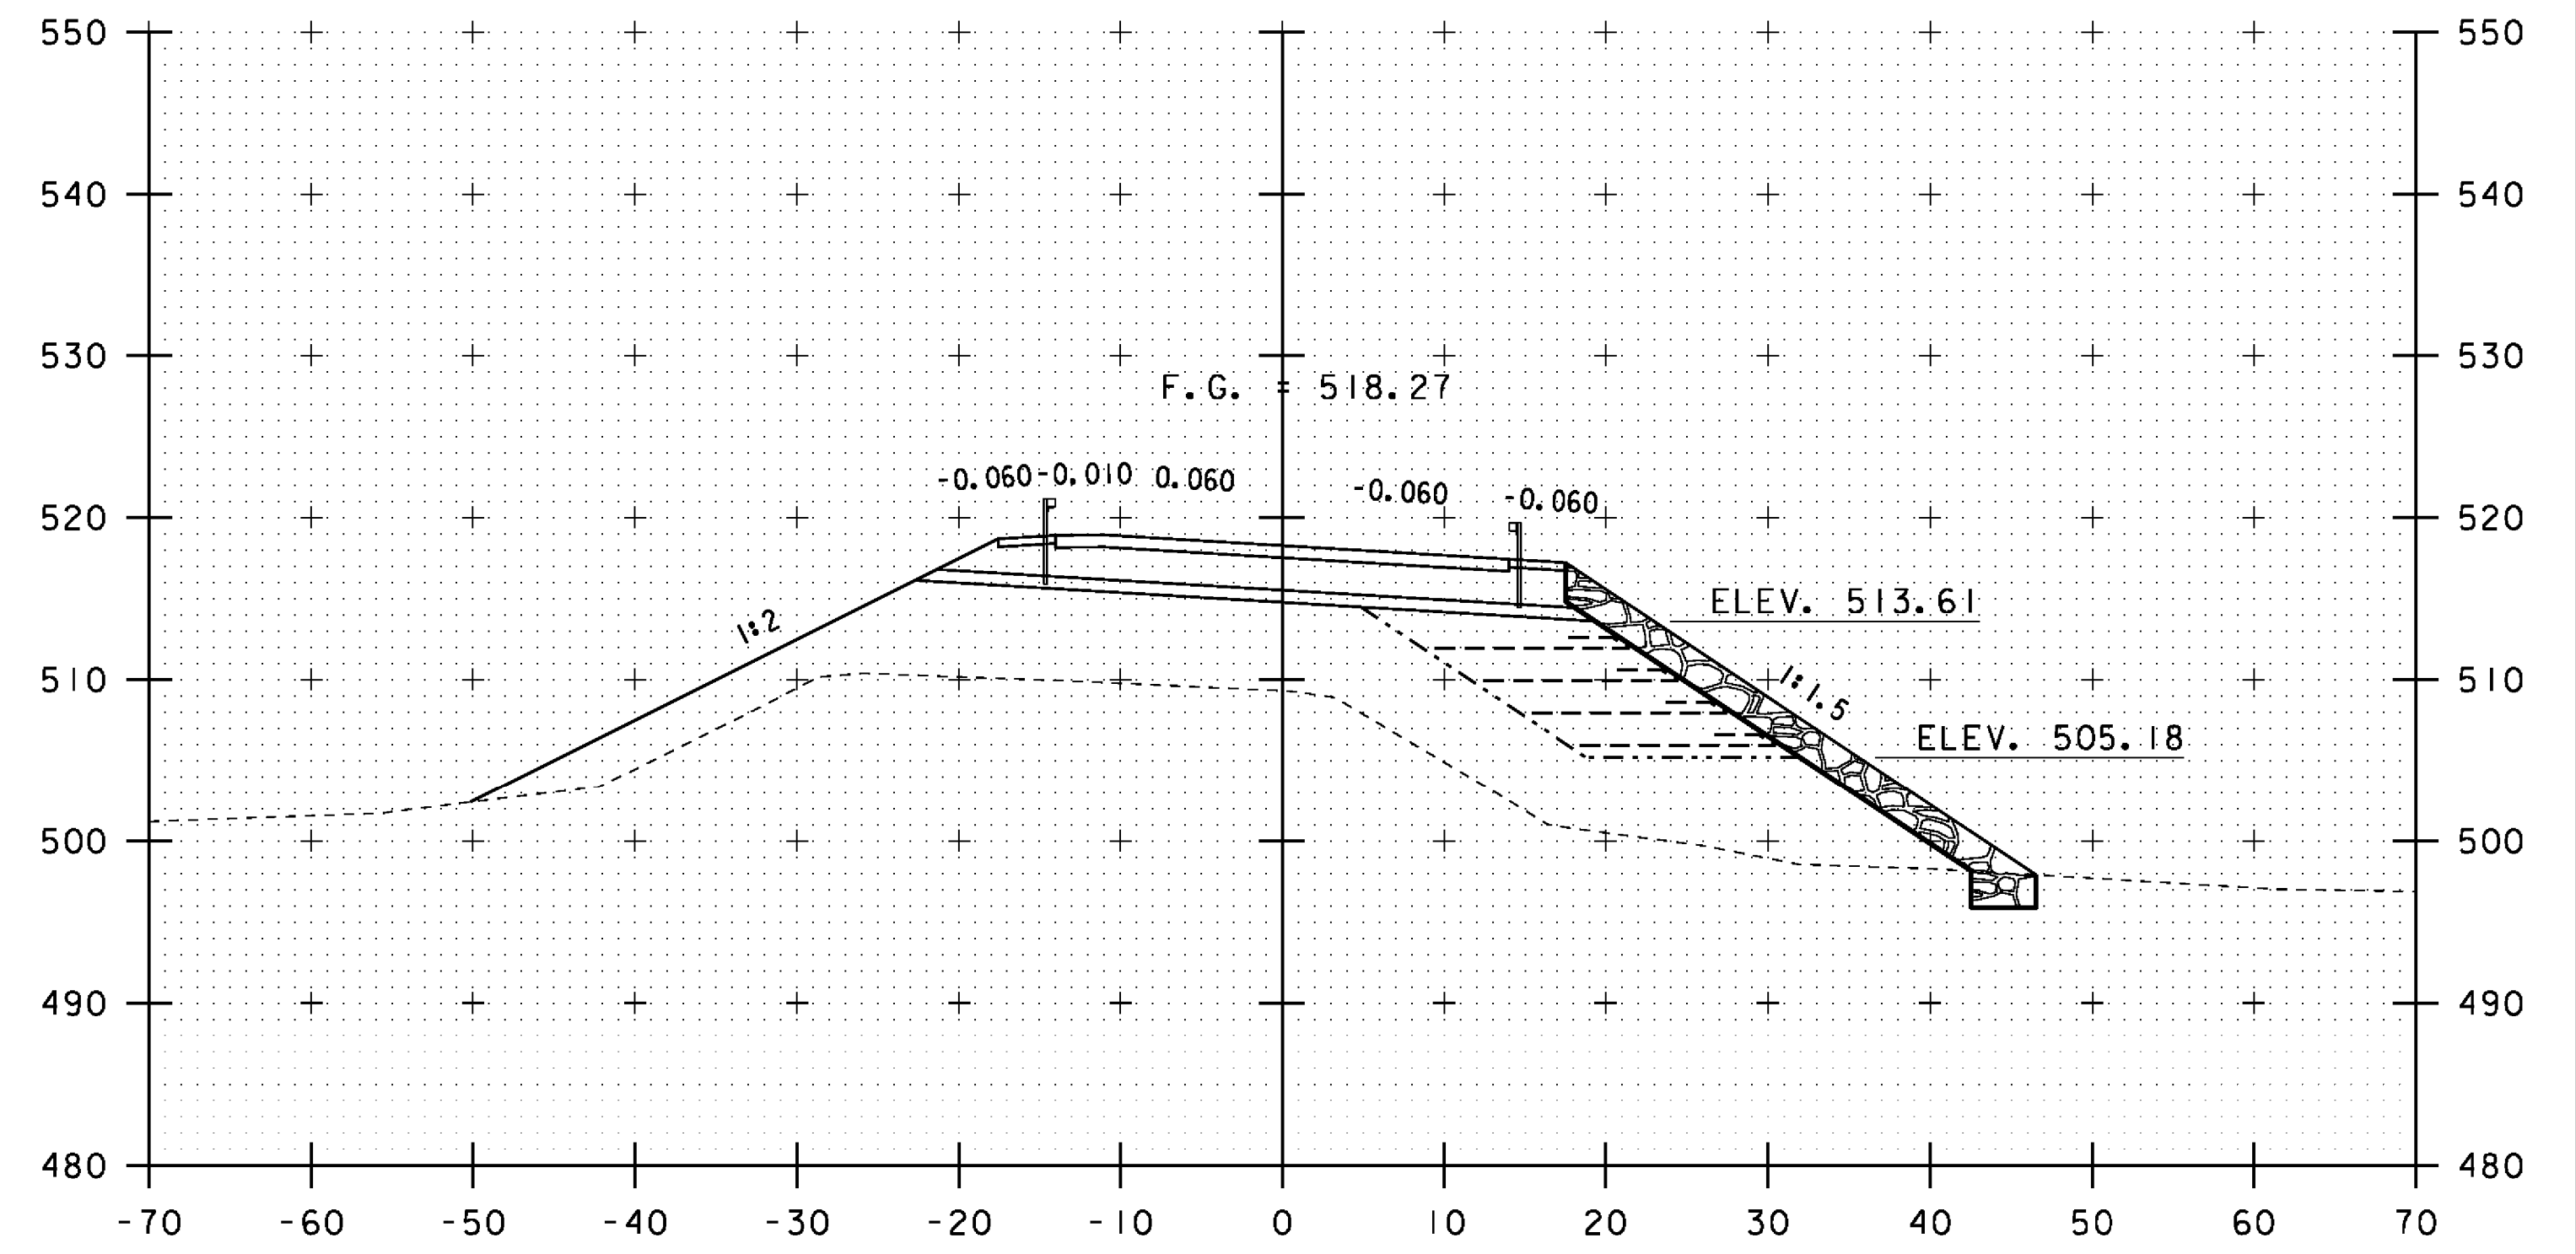

387+00

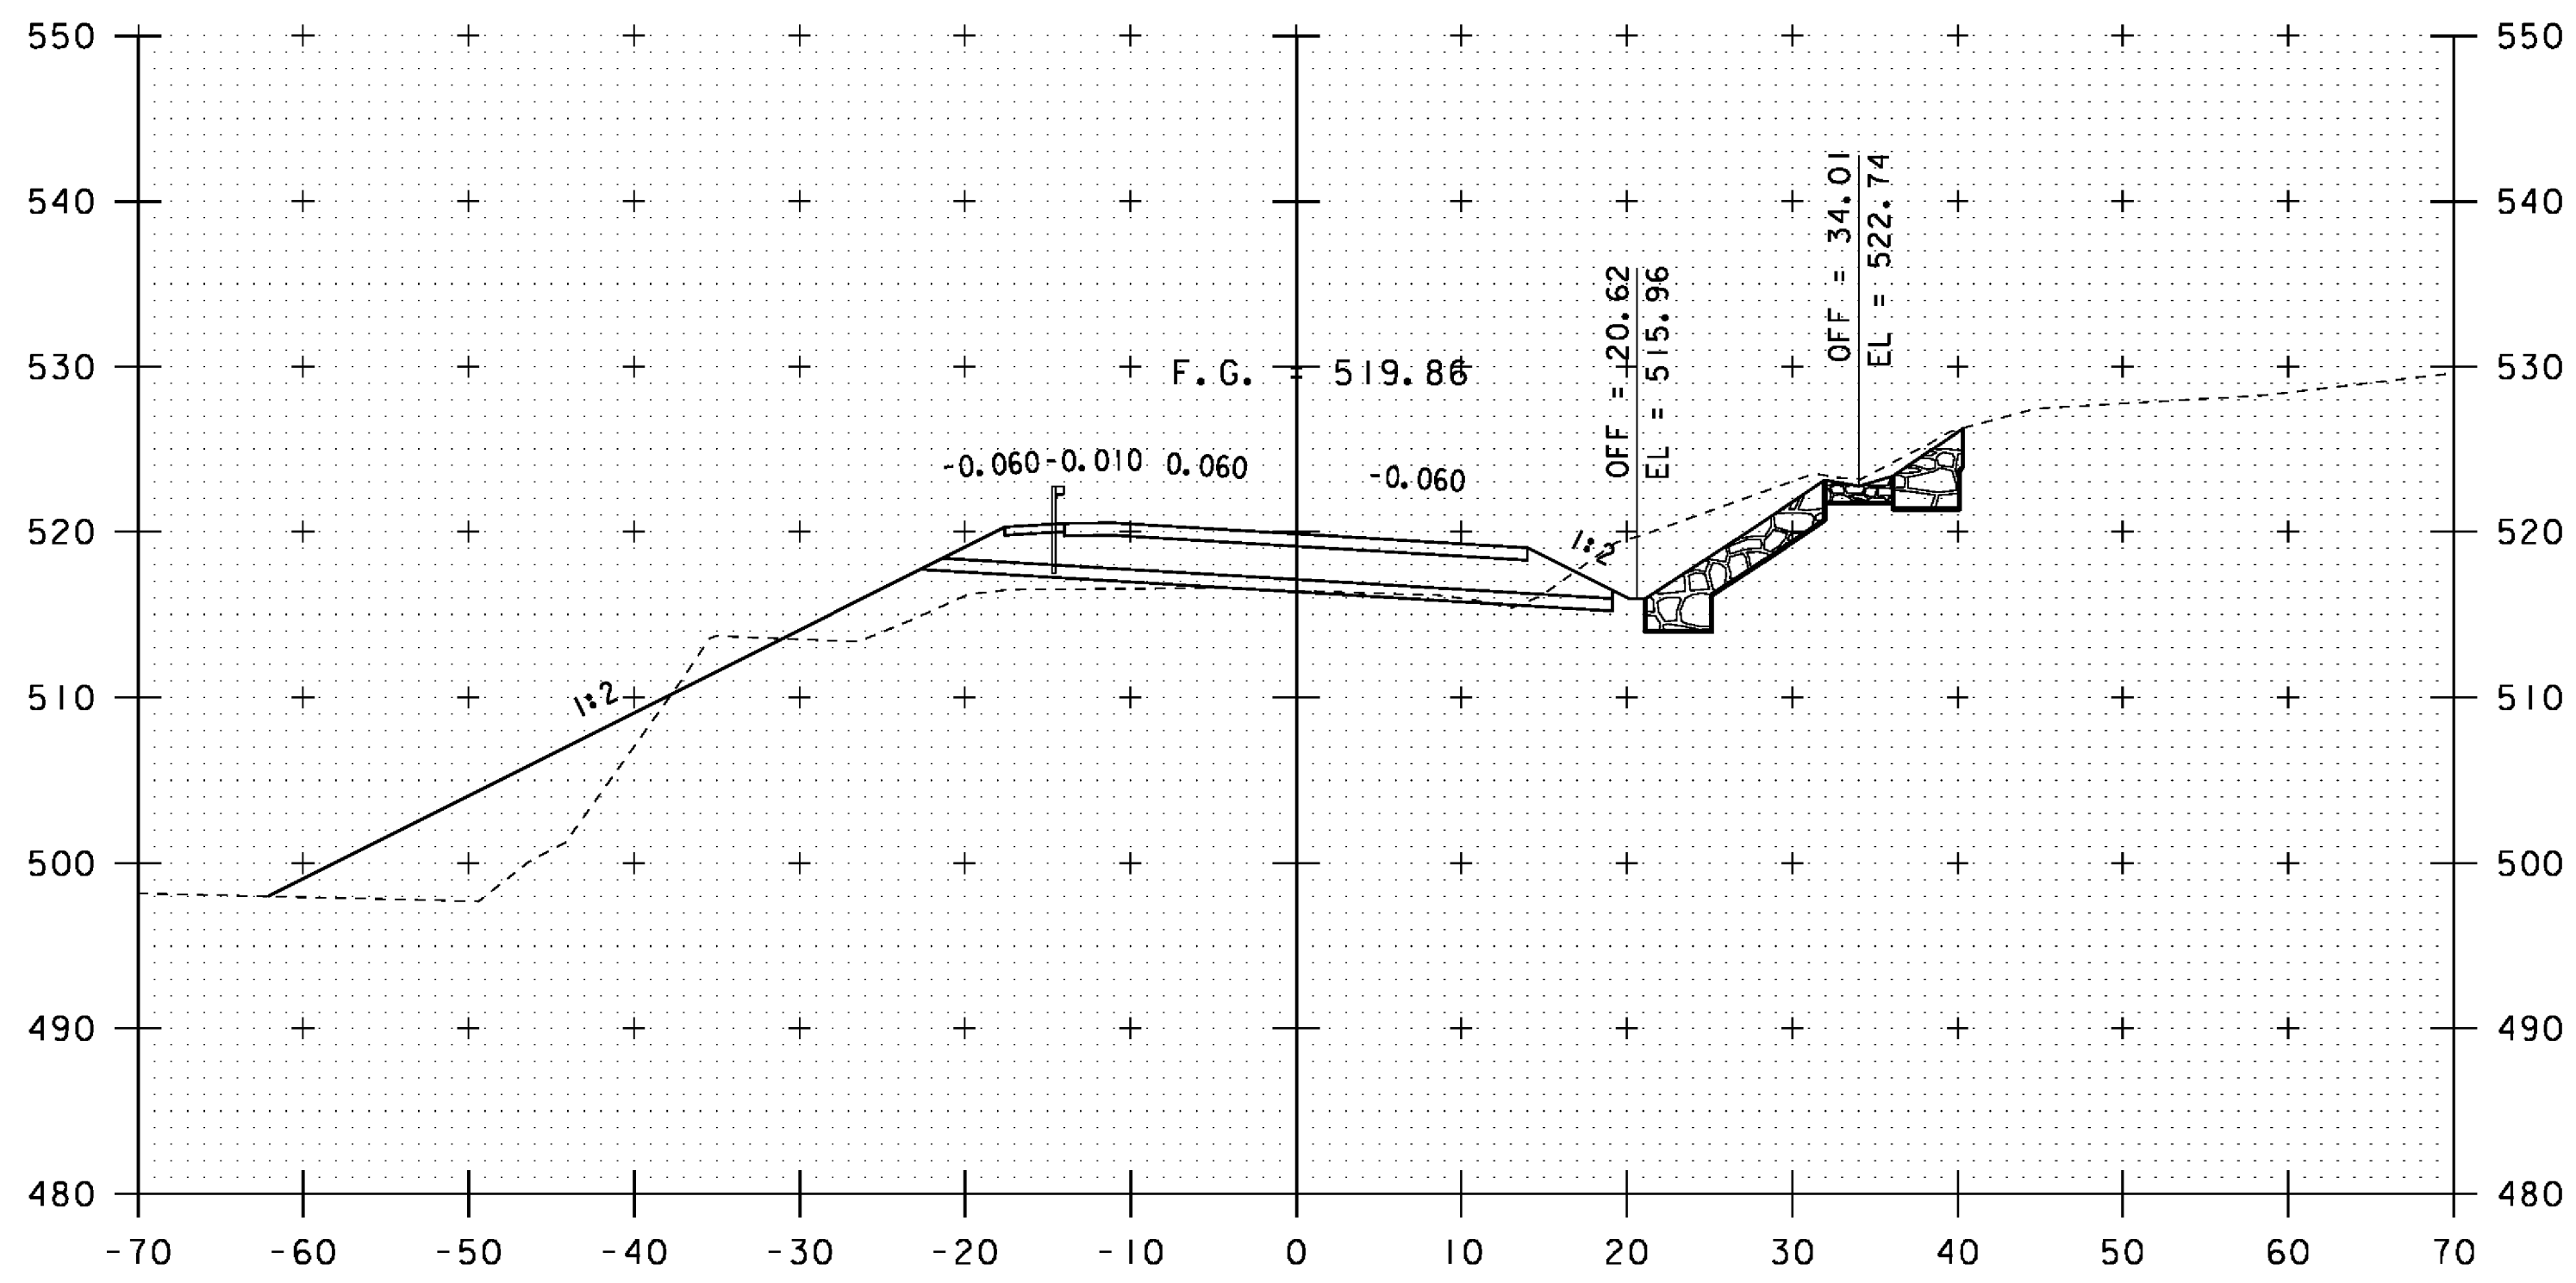

385+50

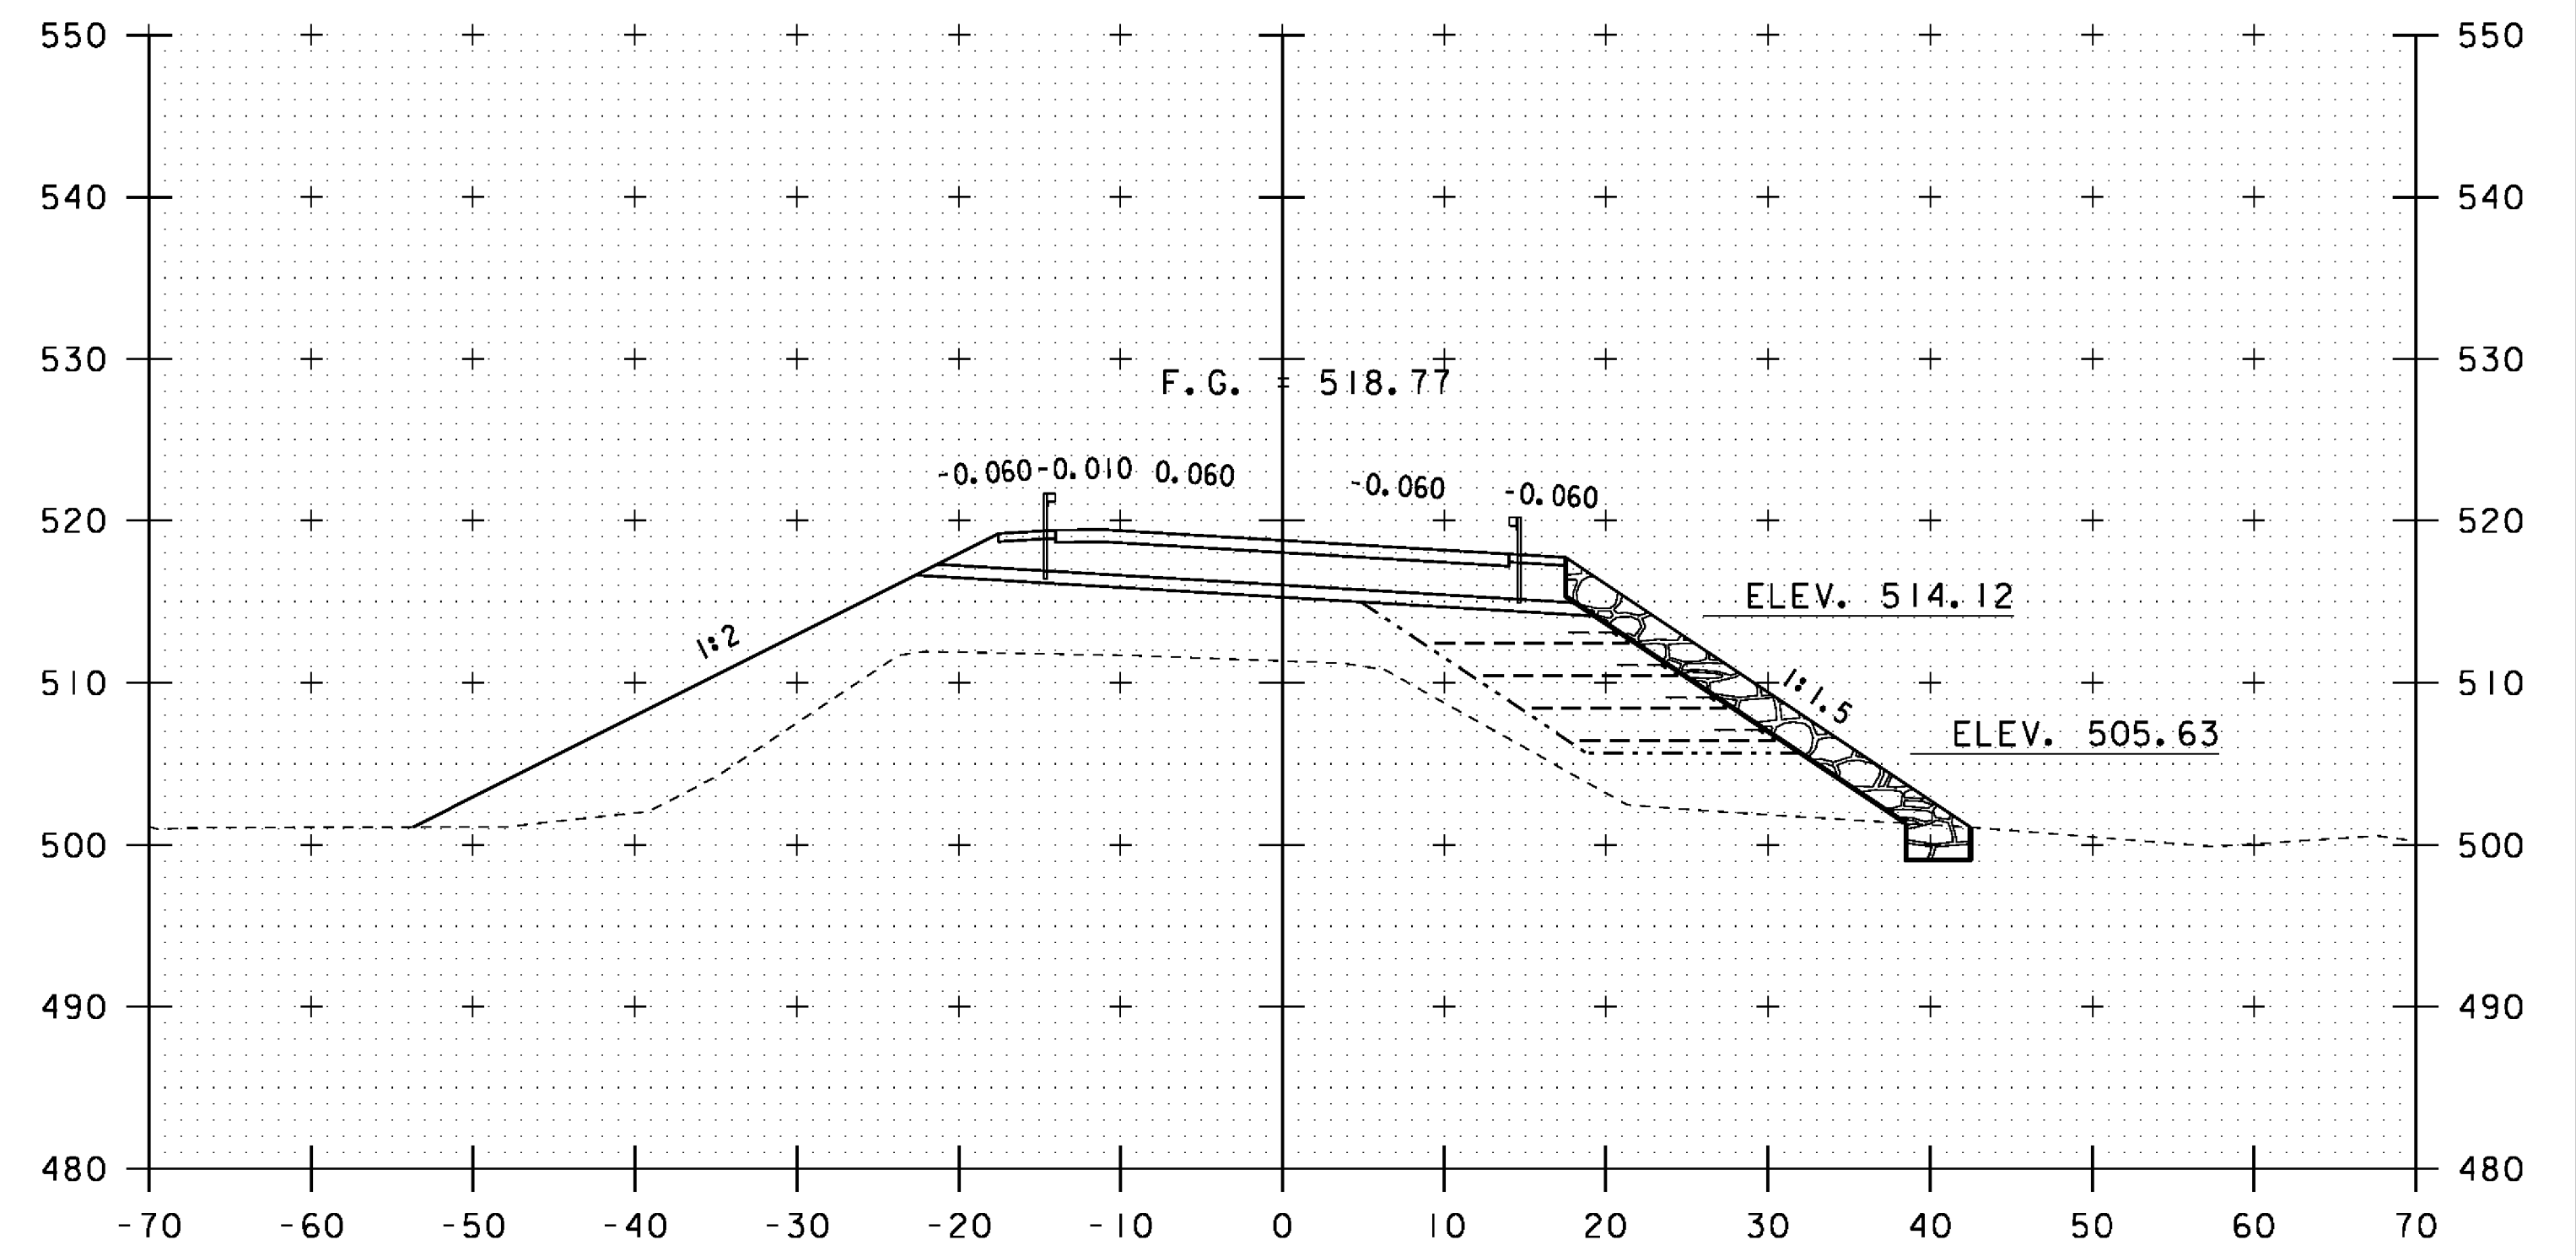

386+50

STA 386+25.0 RT - STA 388+50.0 RT  
CONSTRUCT REINFORCED SLOPE W/ STONE  
FILL, TYPE 11


10 0 10  
SCALE: 1" = 10' - 0"

STA. 385+50 TO STA. 387+00


PROJECT NAME: ROYALTON  
PROJECT NUMBER: BRS 0147 (13)

FILE NAME: \BR 27\86e055\sl.27.dgn  
PROJECT LEADER: C. CARLSON  
DESIGNED BY: G. ROY  
BRIDGE 27 VT 14 CROSS SECTIONS (3)

PLOT DATE: 08-OCT-2013  
DRAWN BY: G. ROY  
CHECKED BY: D. PETERSON  
SHEET 53 OF 186

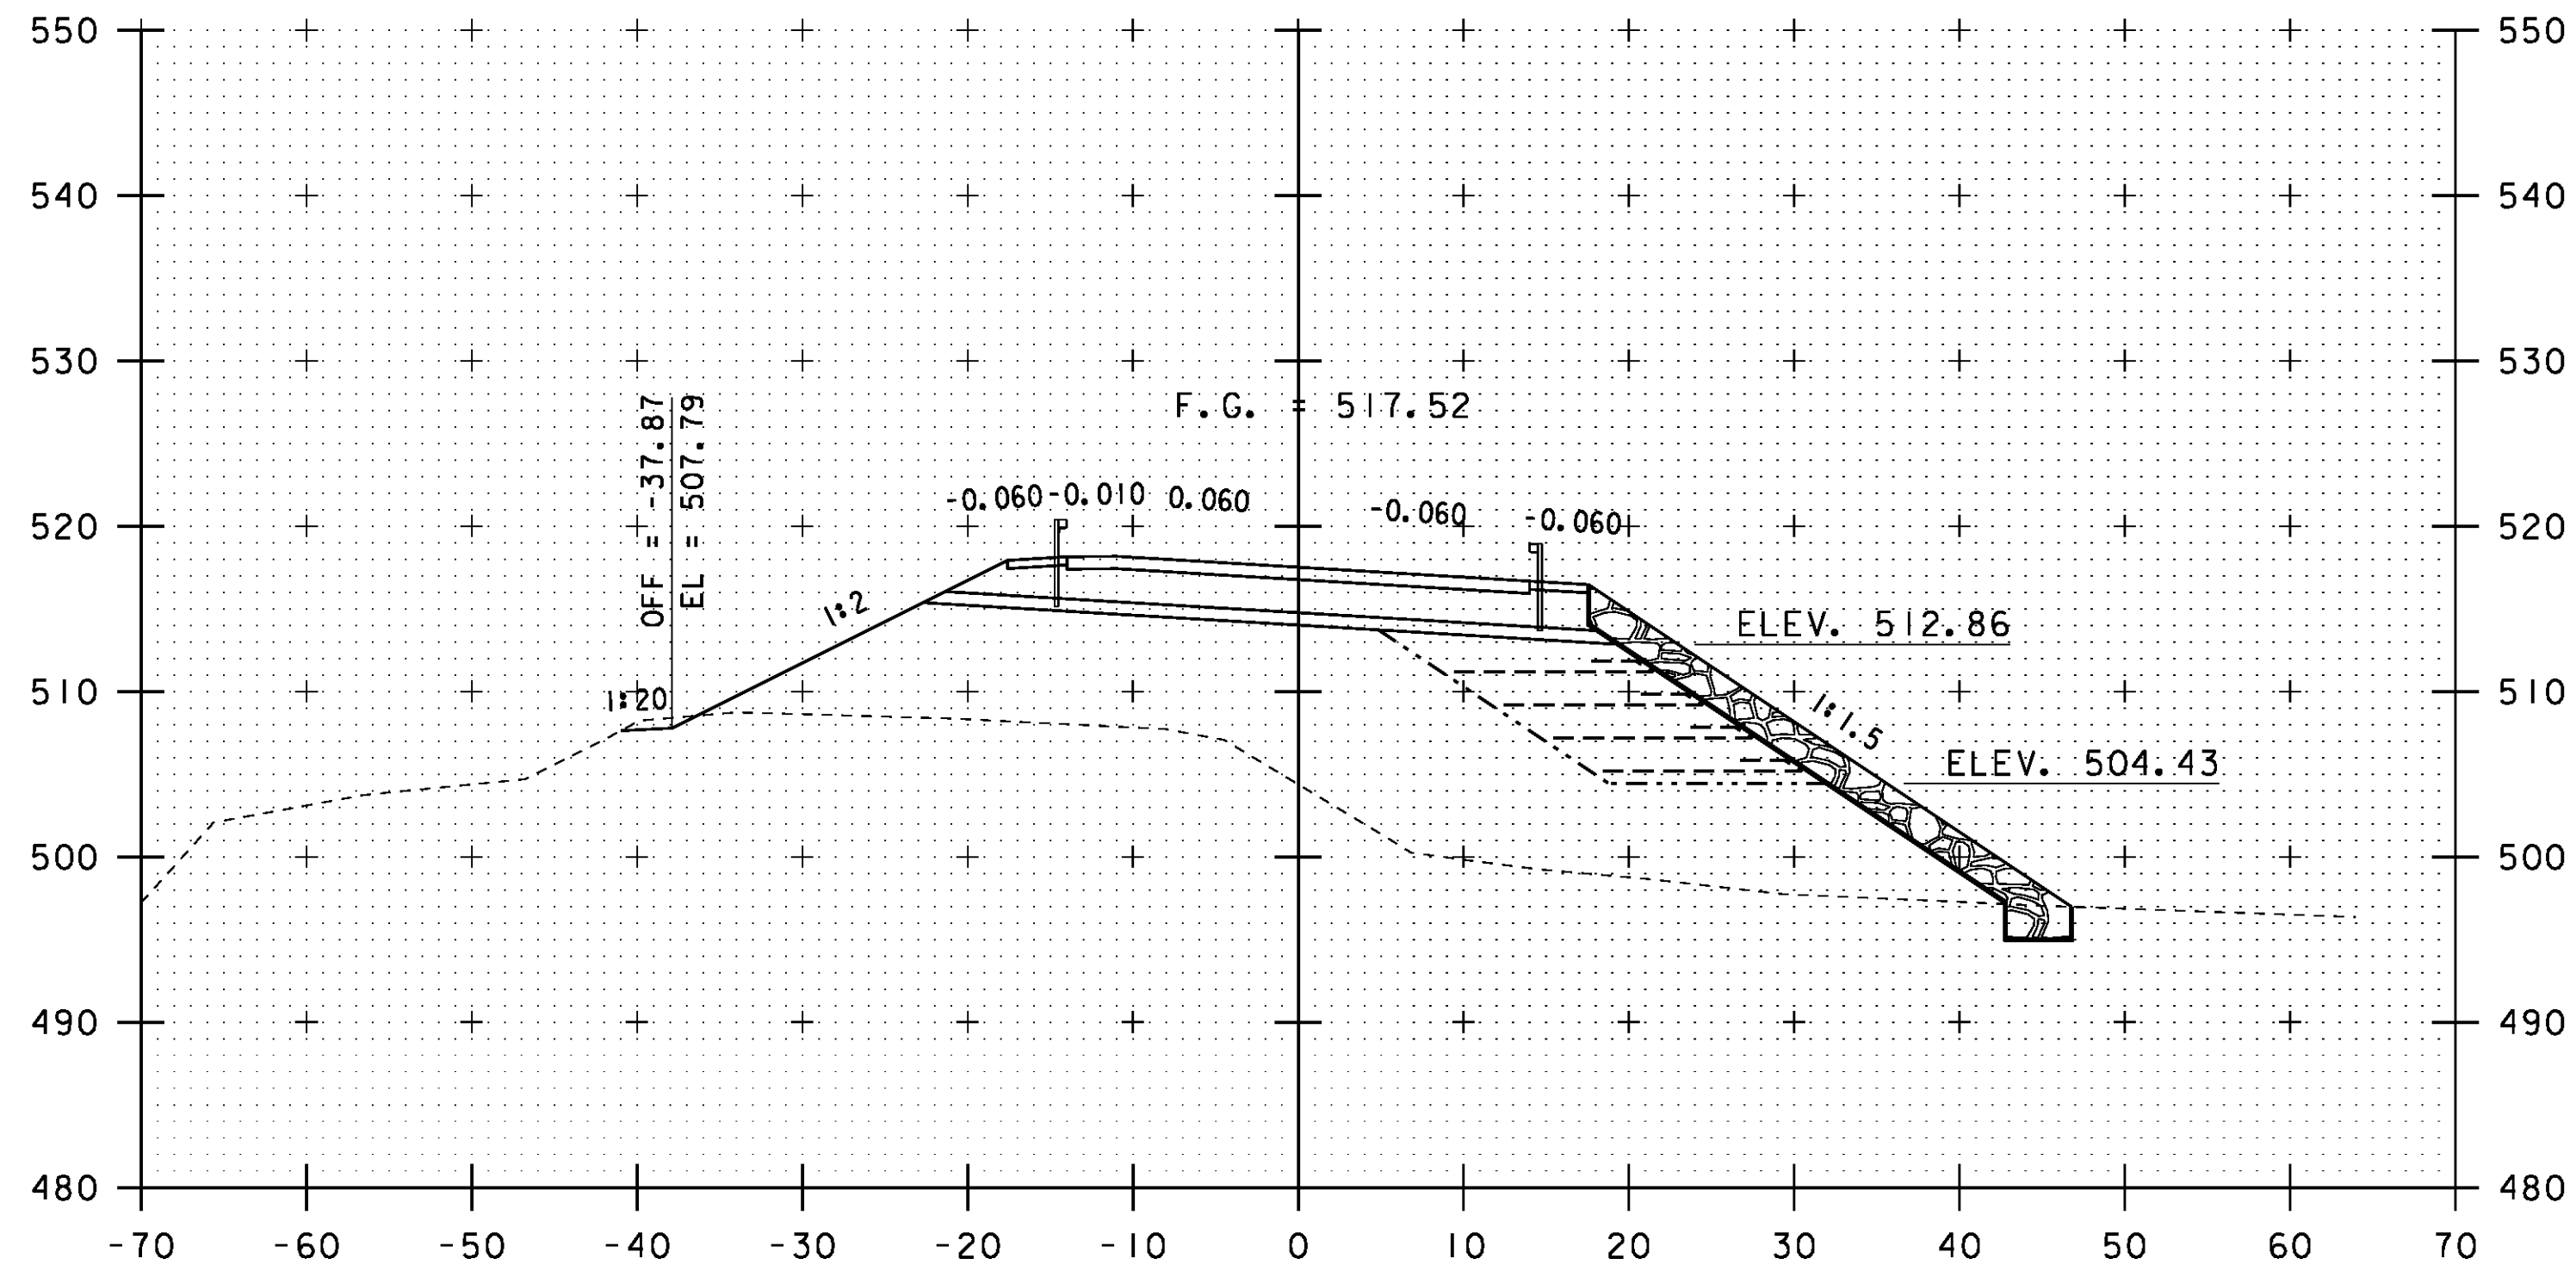


387+75

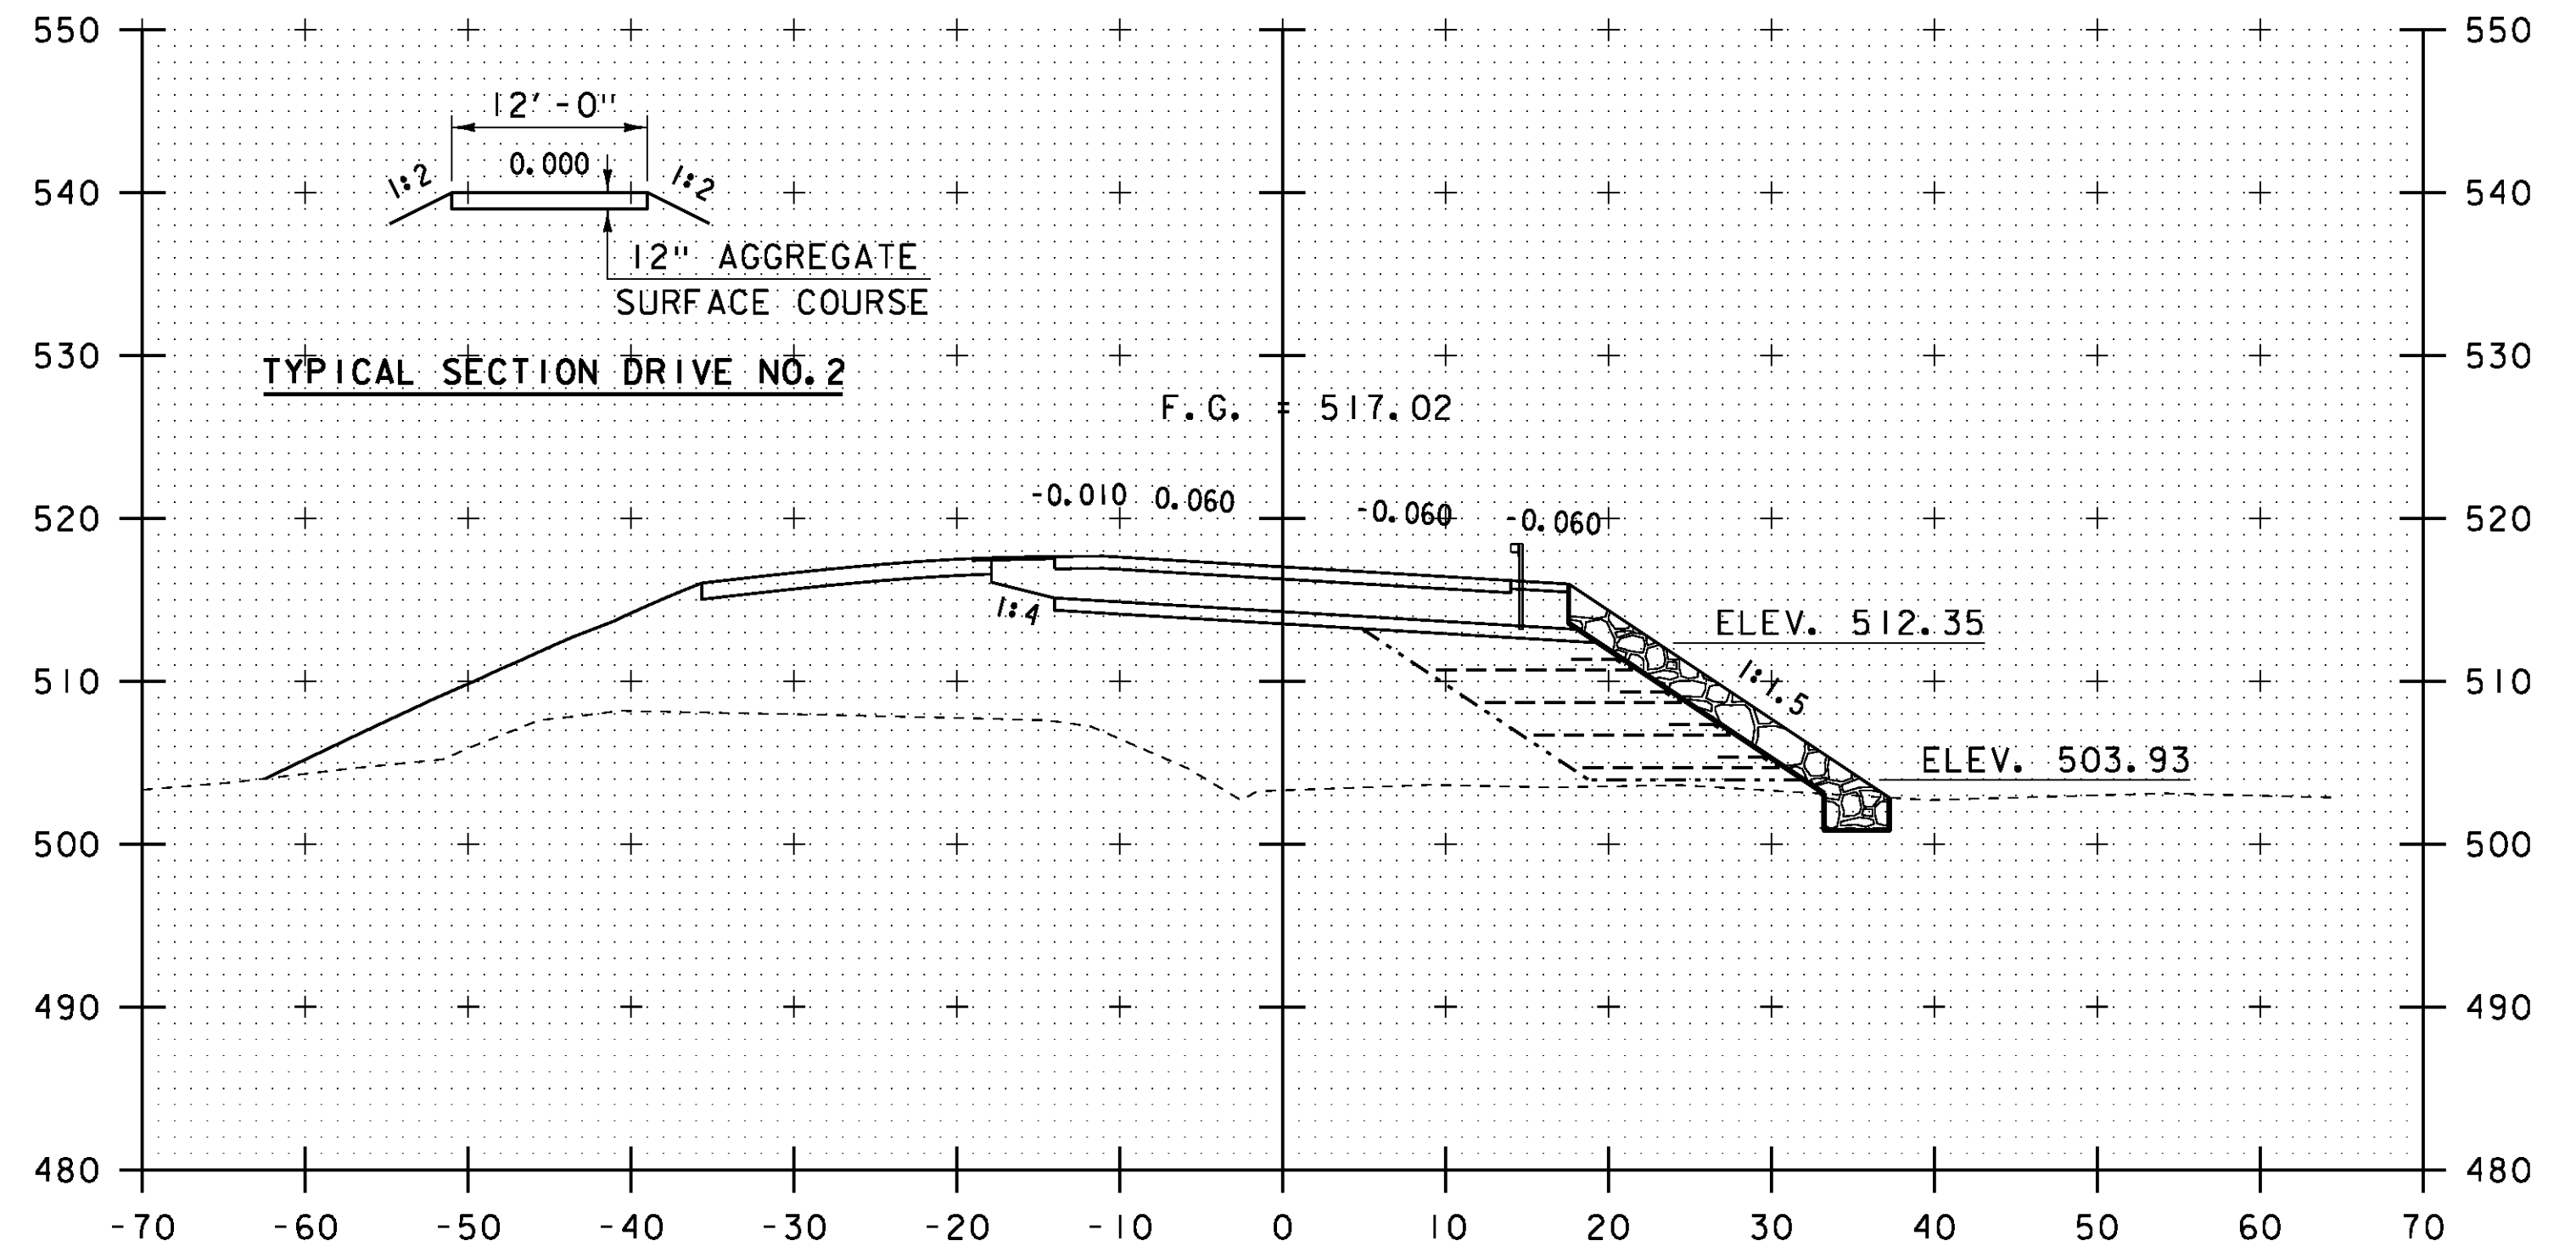


STA 388+25.0 LT  
CONSTRUCT DRIVE NO. 2


388+25

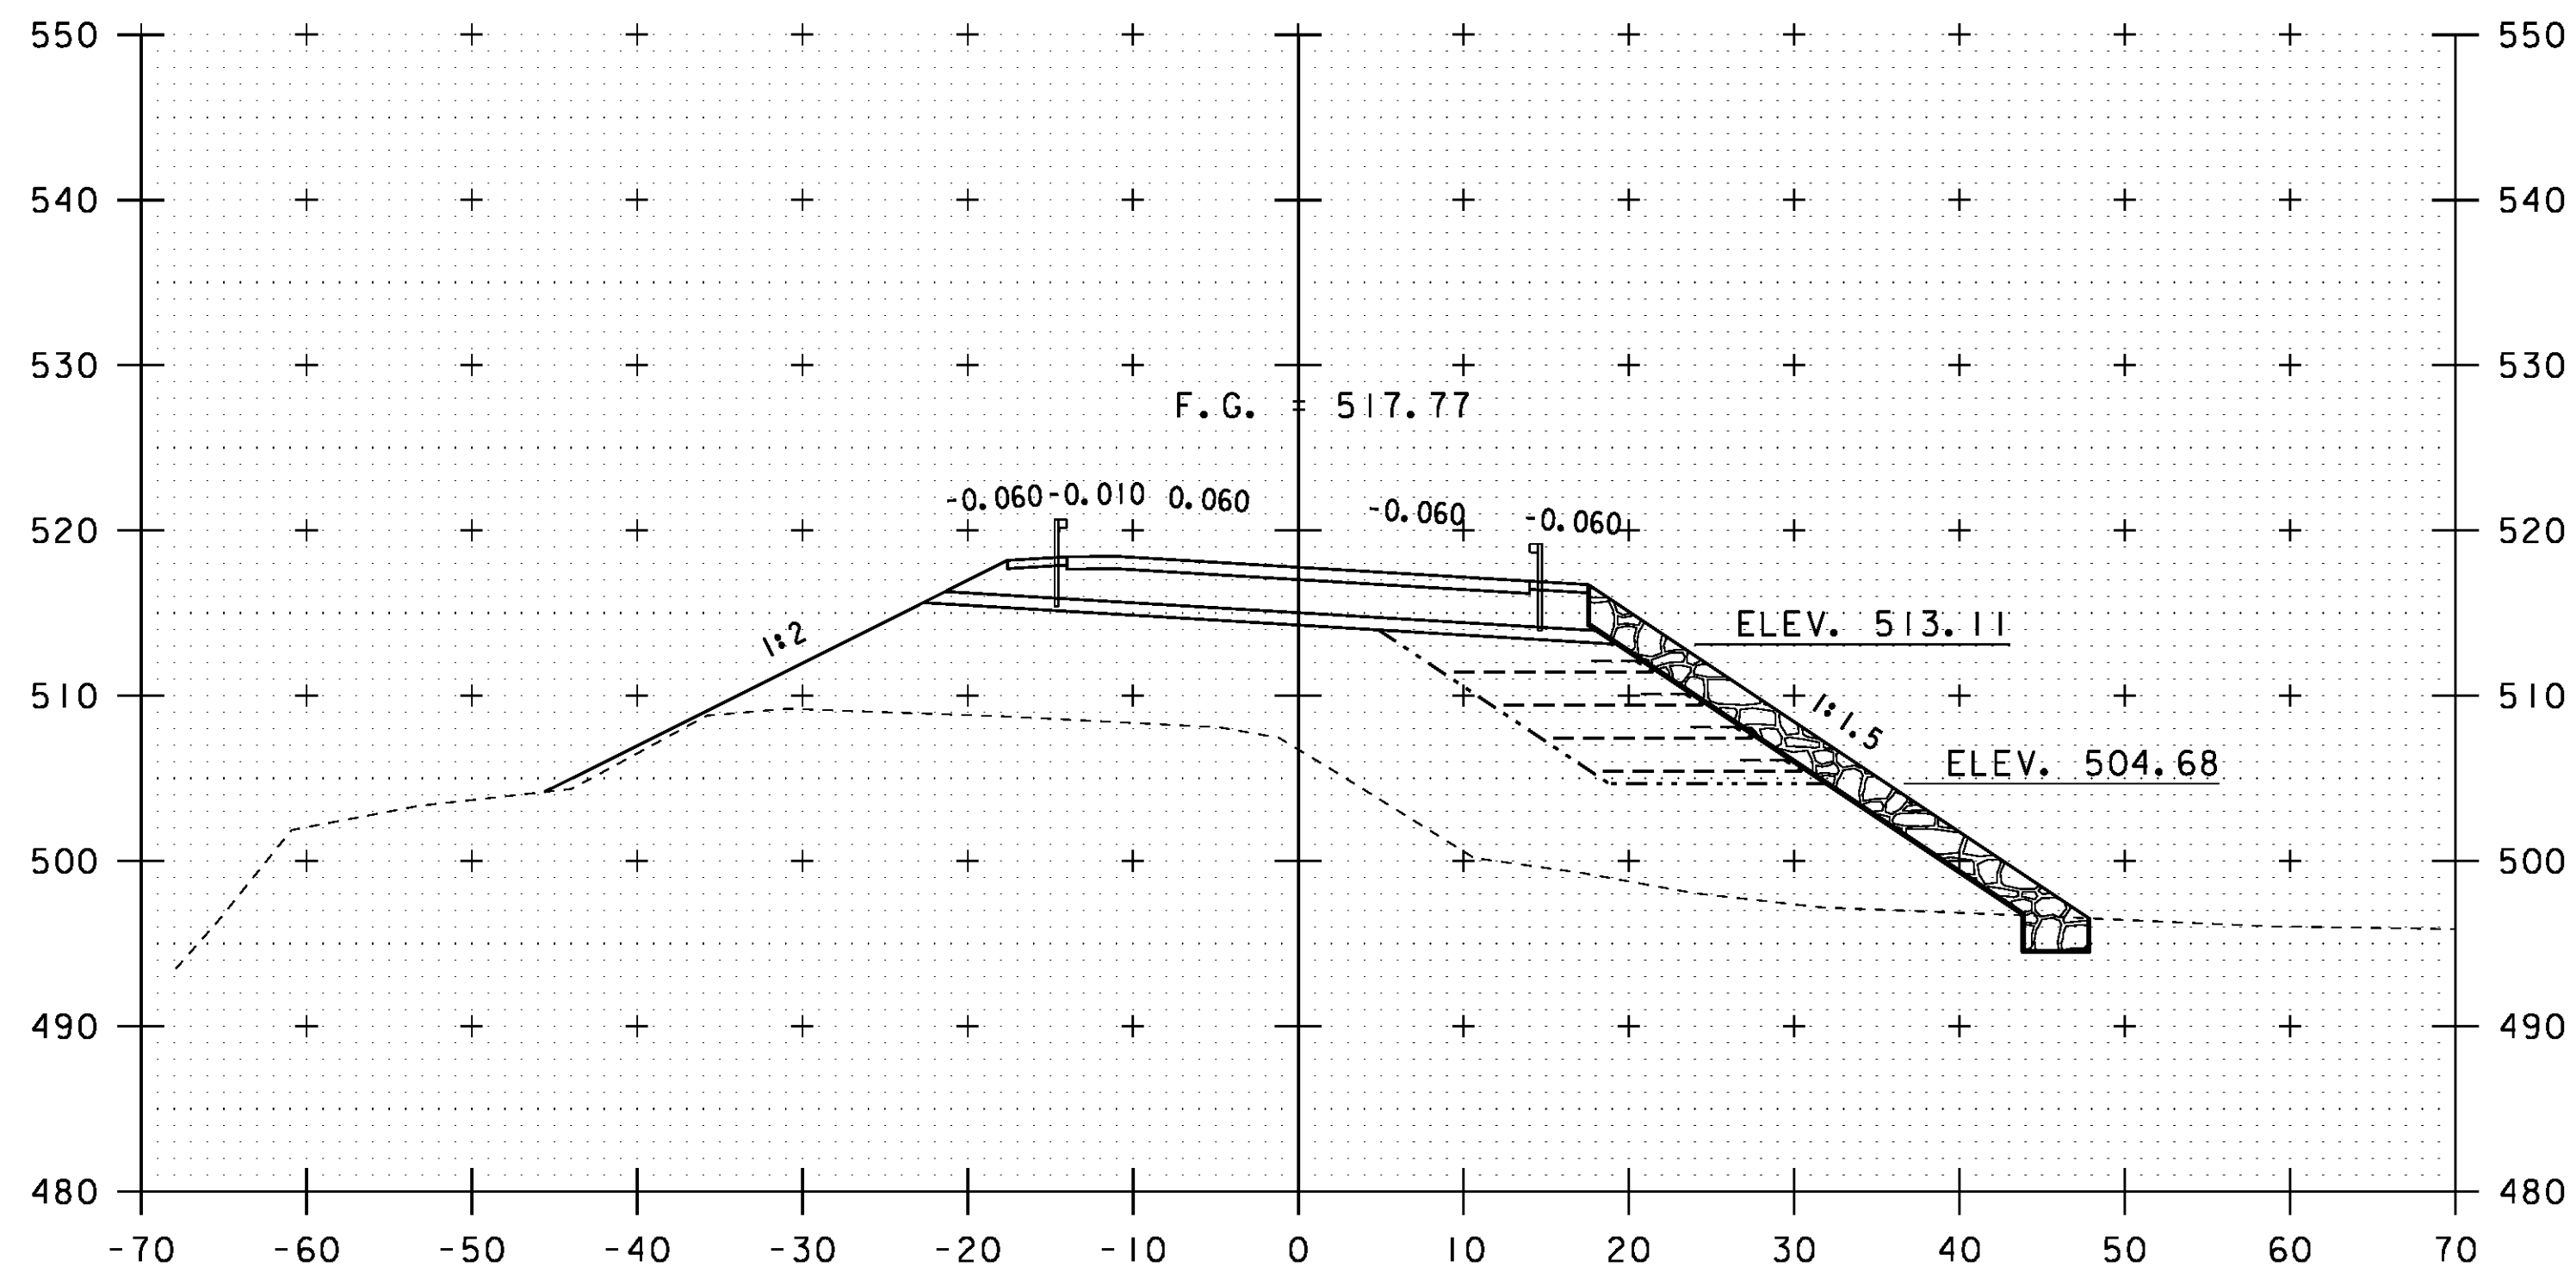

387+50

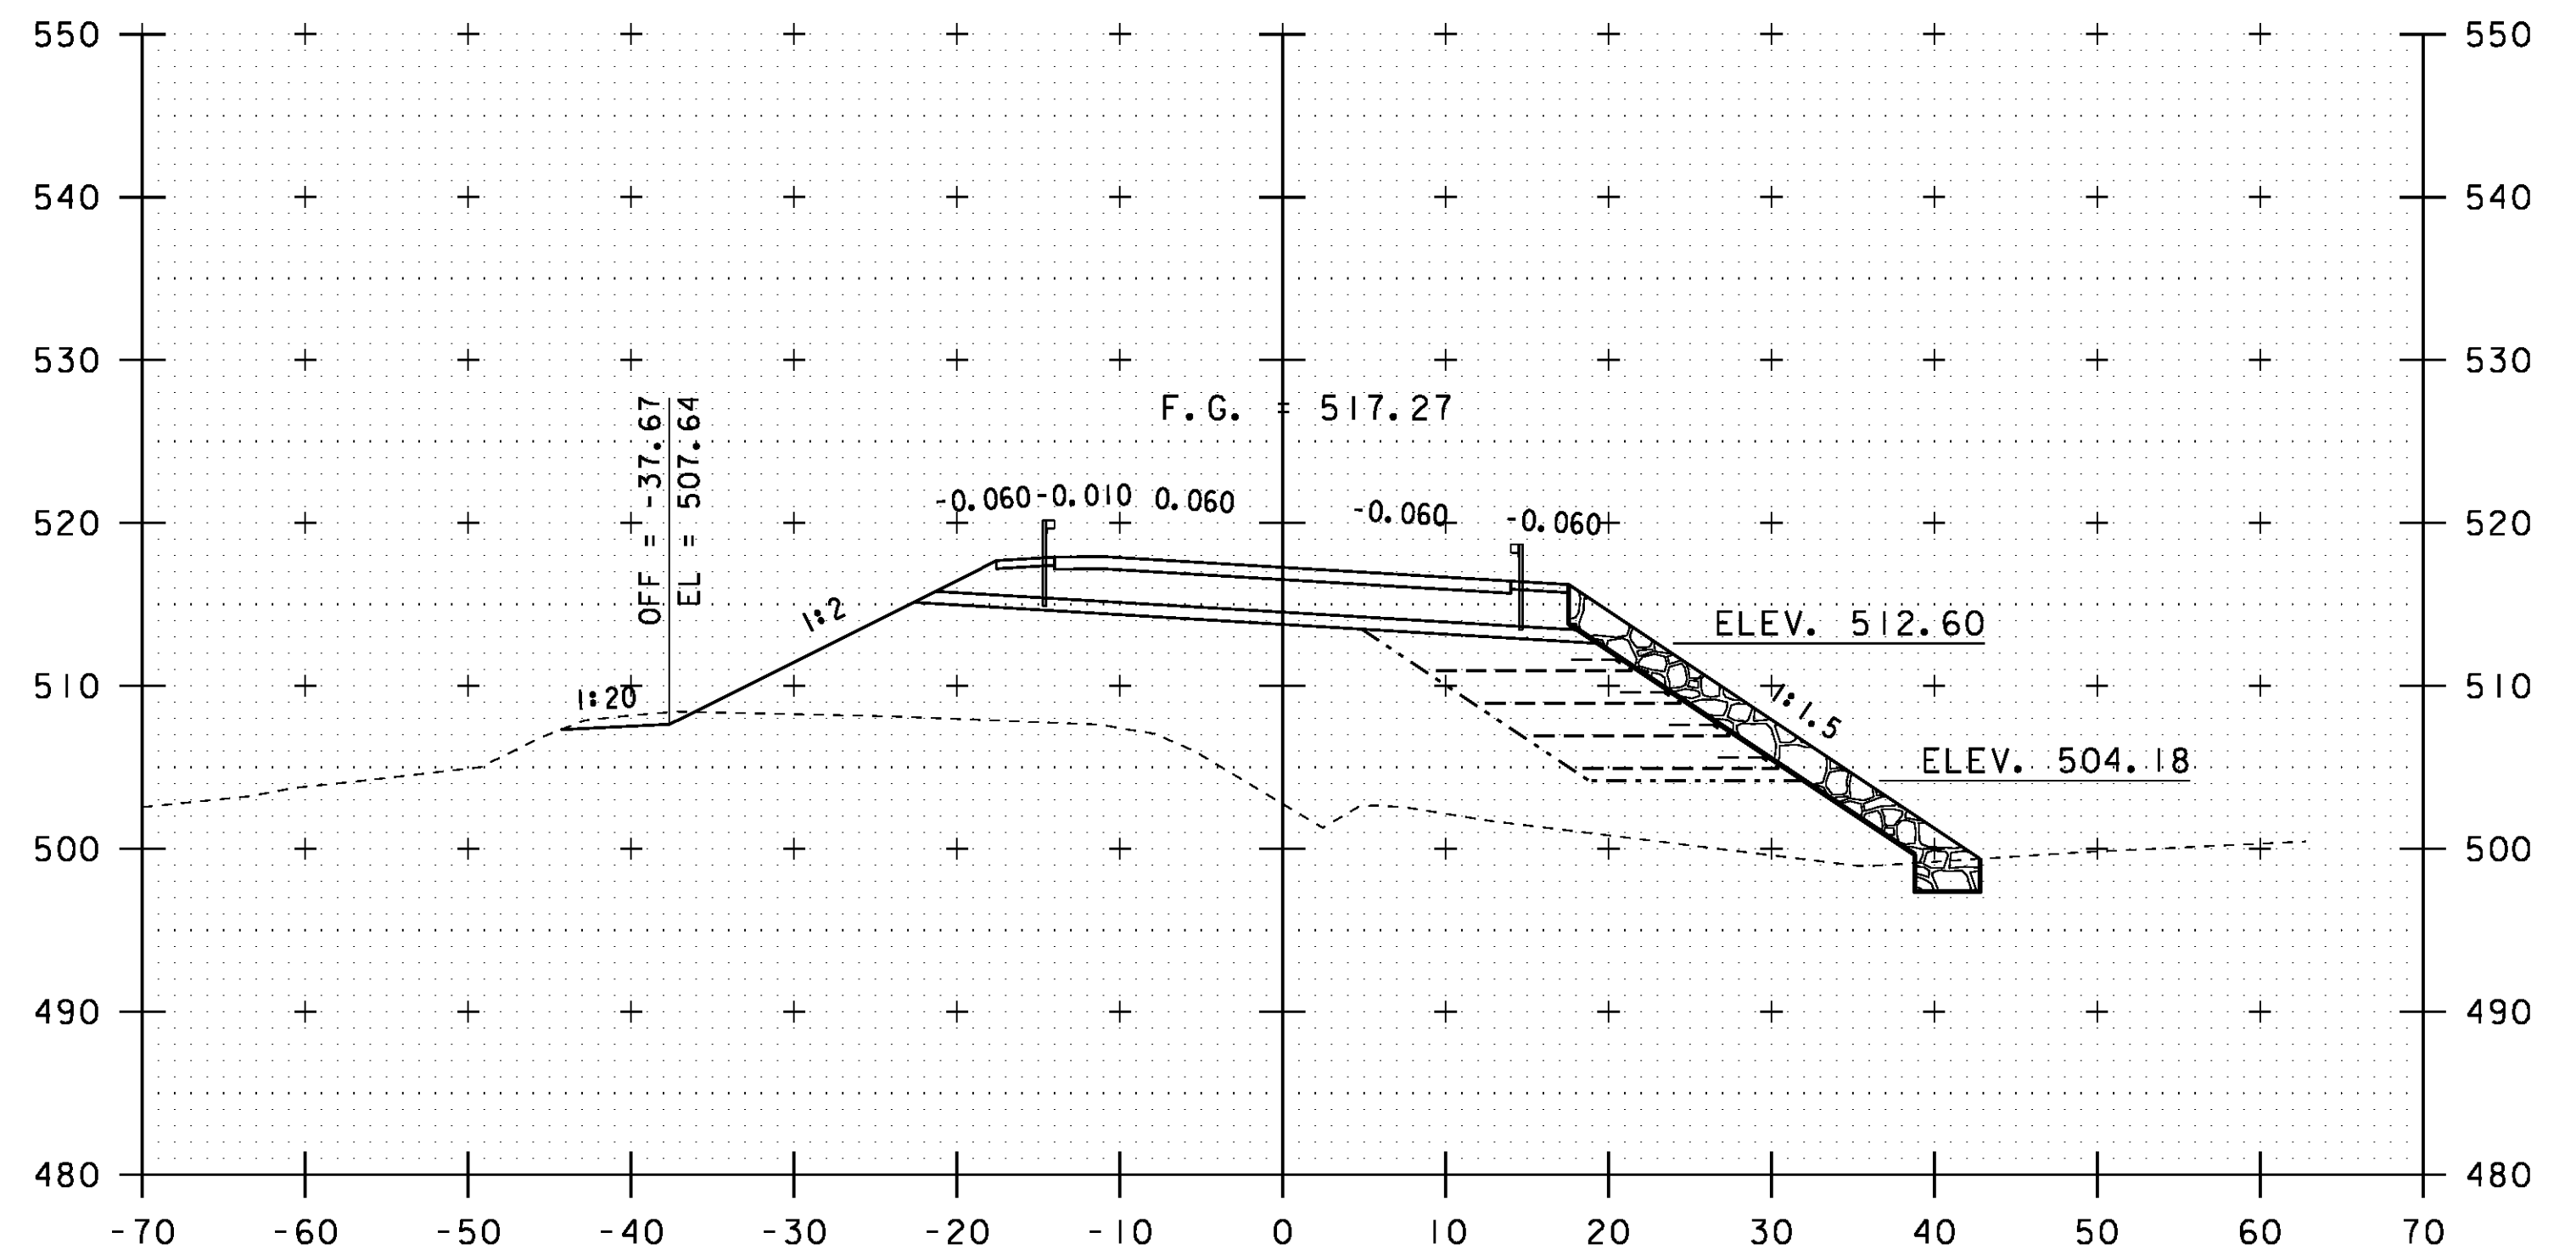

388+00

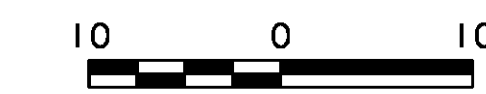


SCALE: 1" = 10'-0"

STA. 387+50 TO STA. 388+25


PROJECT NAME: ROYALTON  
PROJECT NUMBER: BRS 0147 (13)

FILE NAME: \BR 27\86e055xsl.27.dgn  
PROJECT LEADER: C. CARLSON  
DESIGNED BY: G. ROY  
BRIDGE 27 VT 14 CROSS SECTIONS (4)


PLOT DATE: 08-OCT-2013  
DRAWN BY: G. ROY  
CHECKED BY: D. PETERSON  
SHEET 54 OF 186

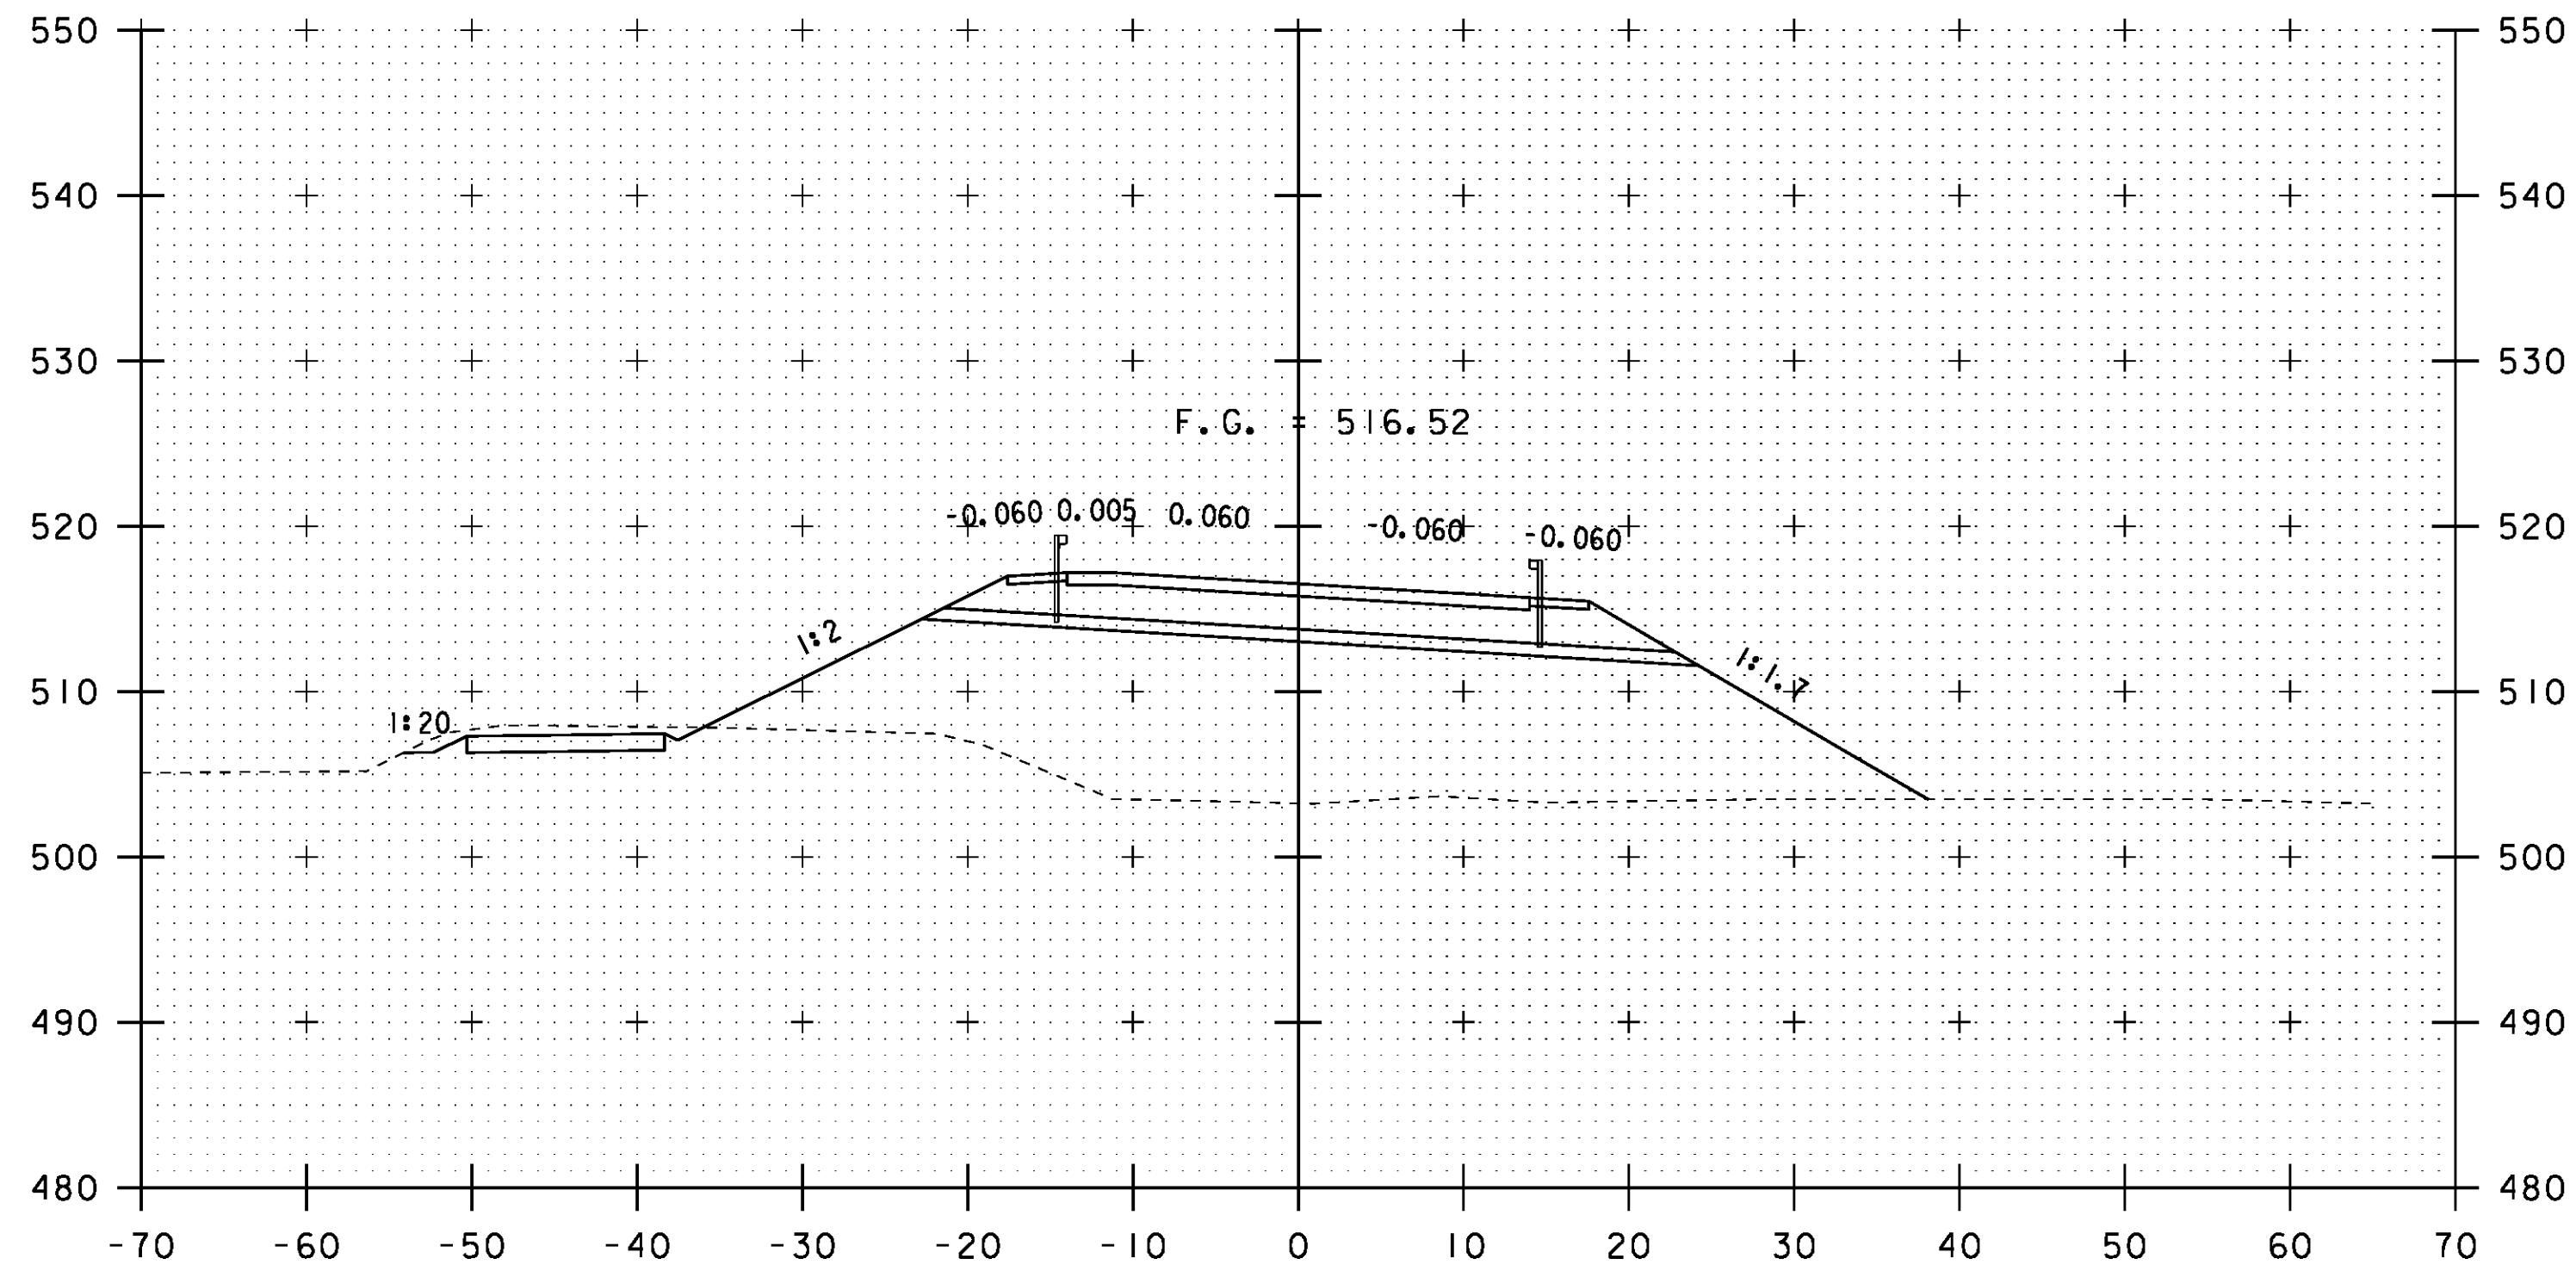


388+75

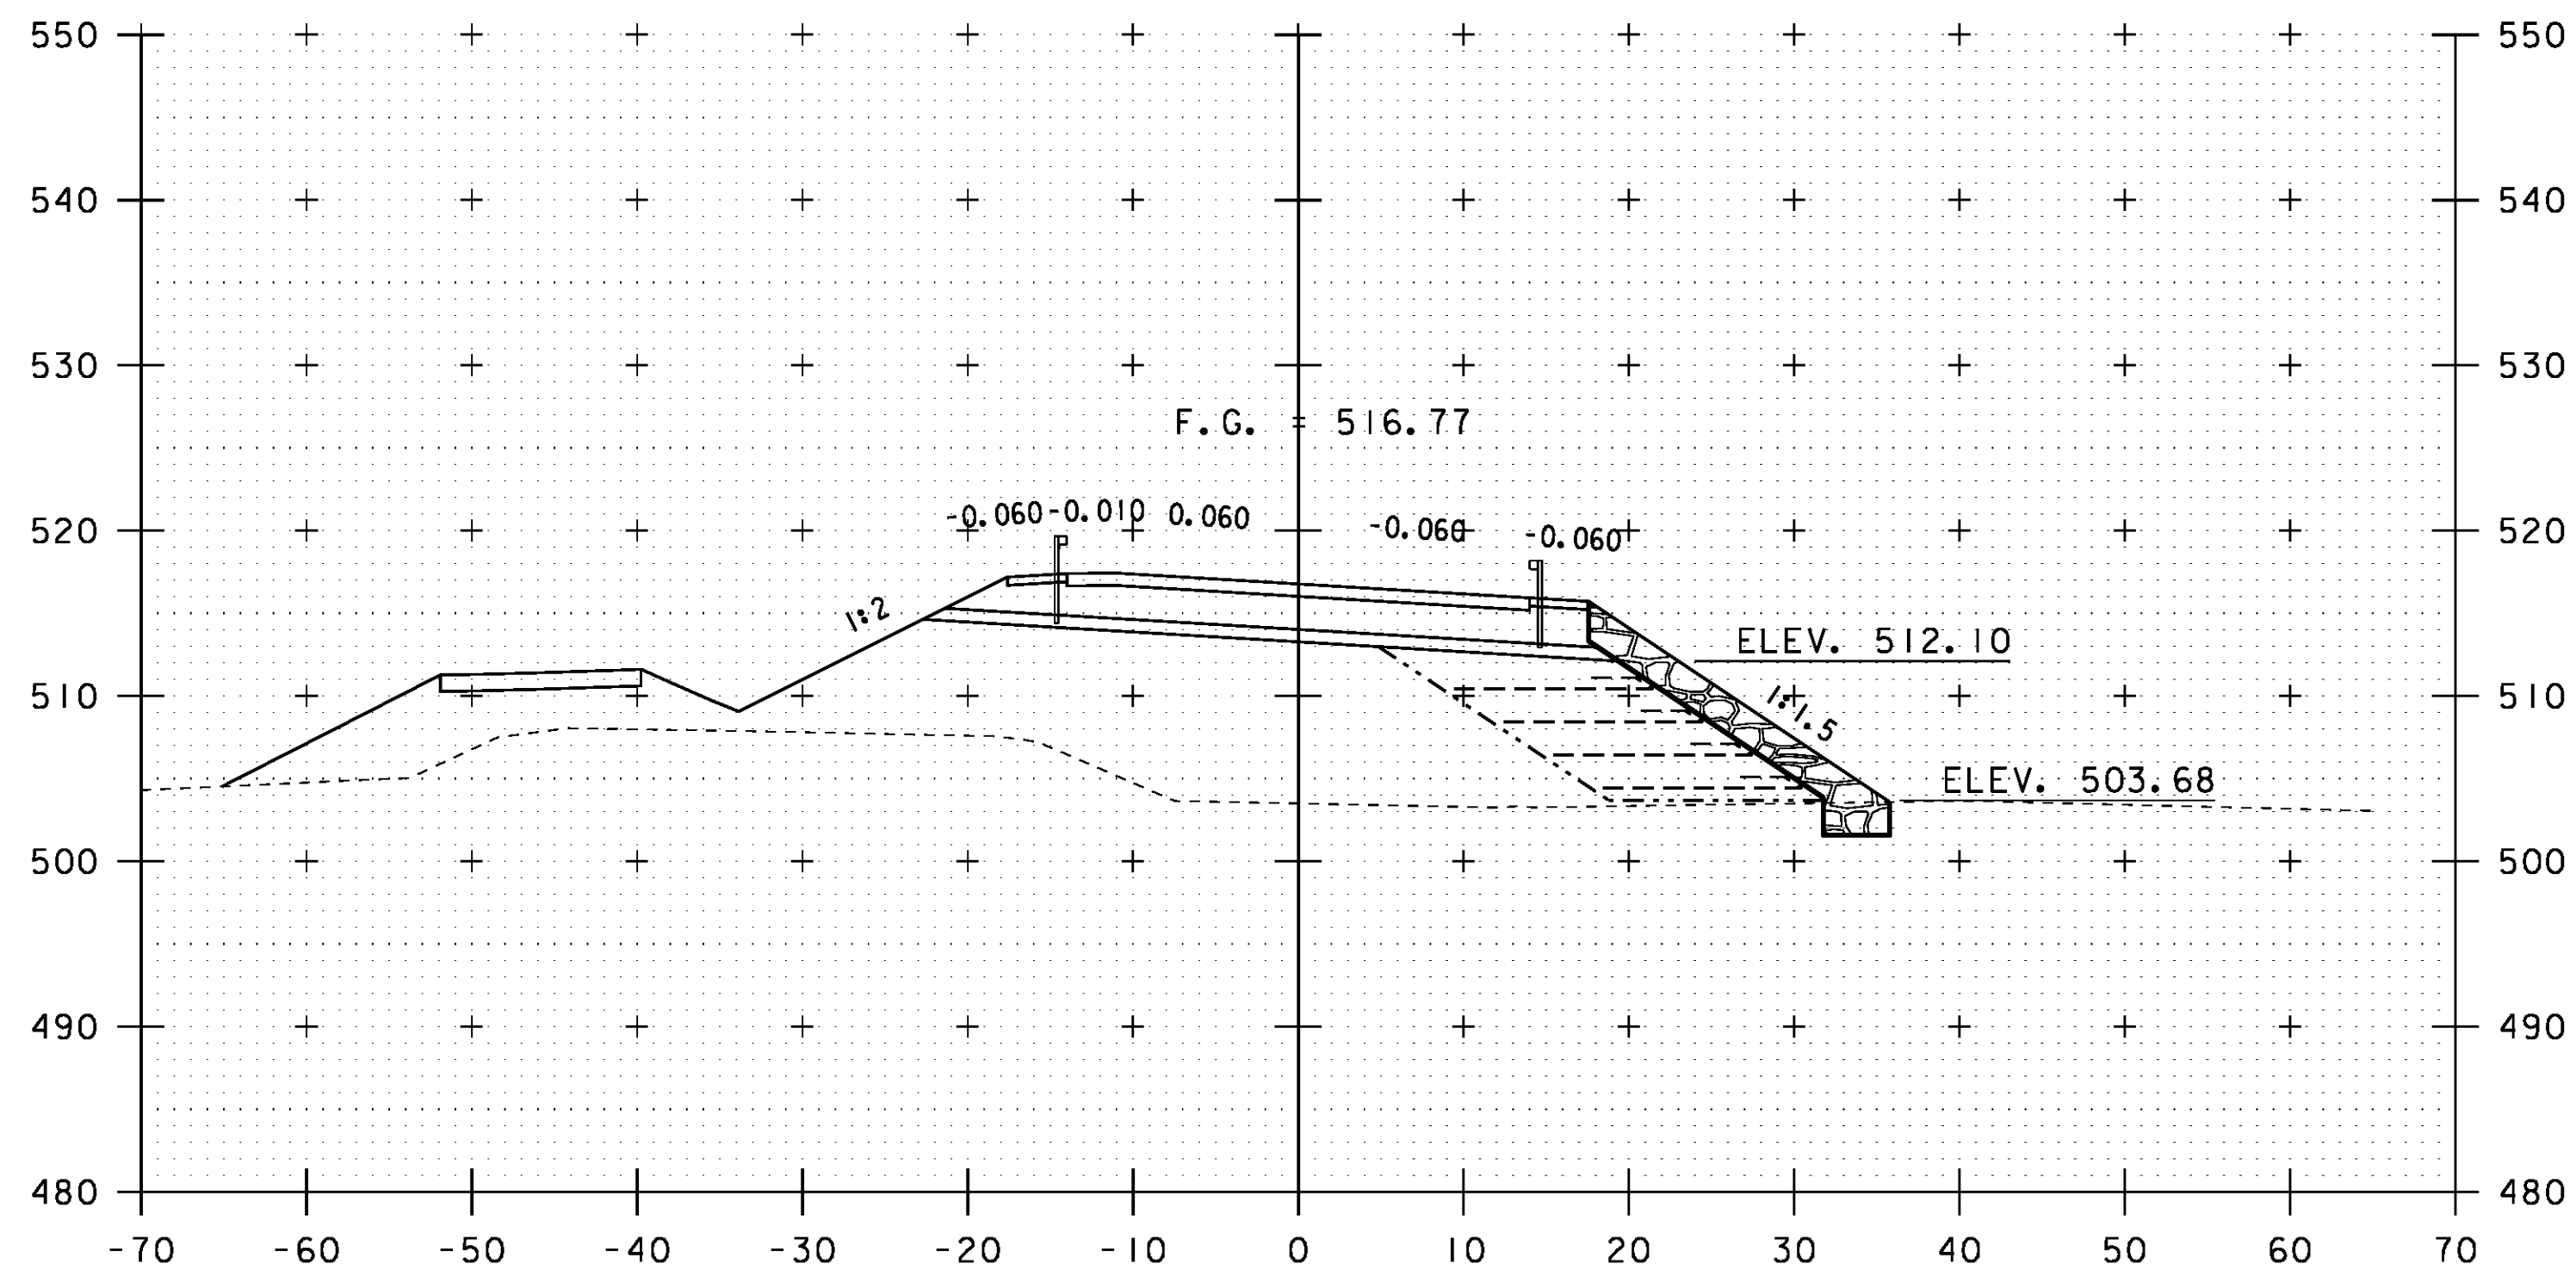


388+50

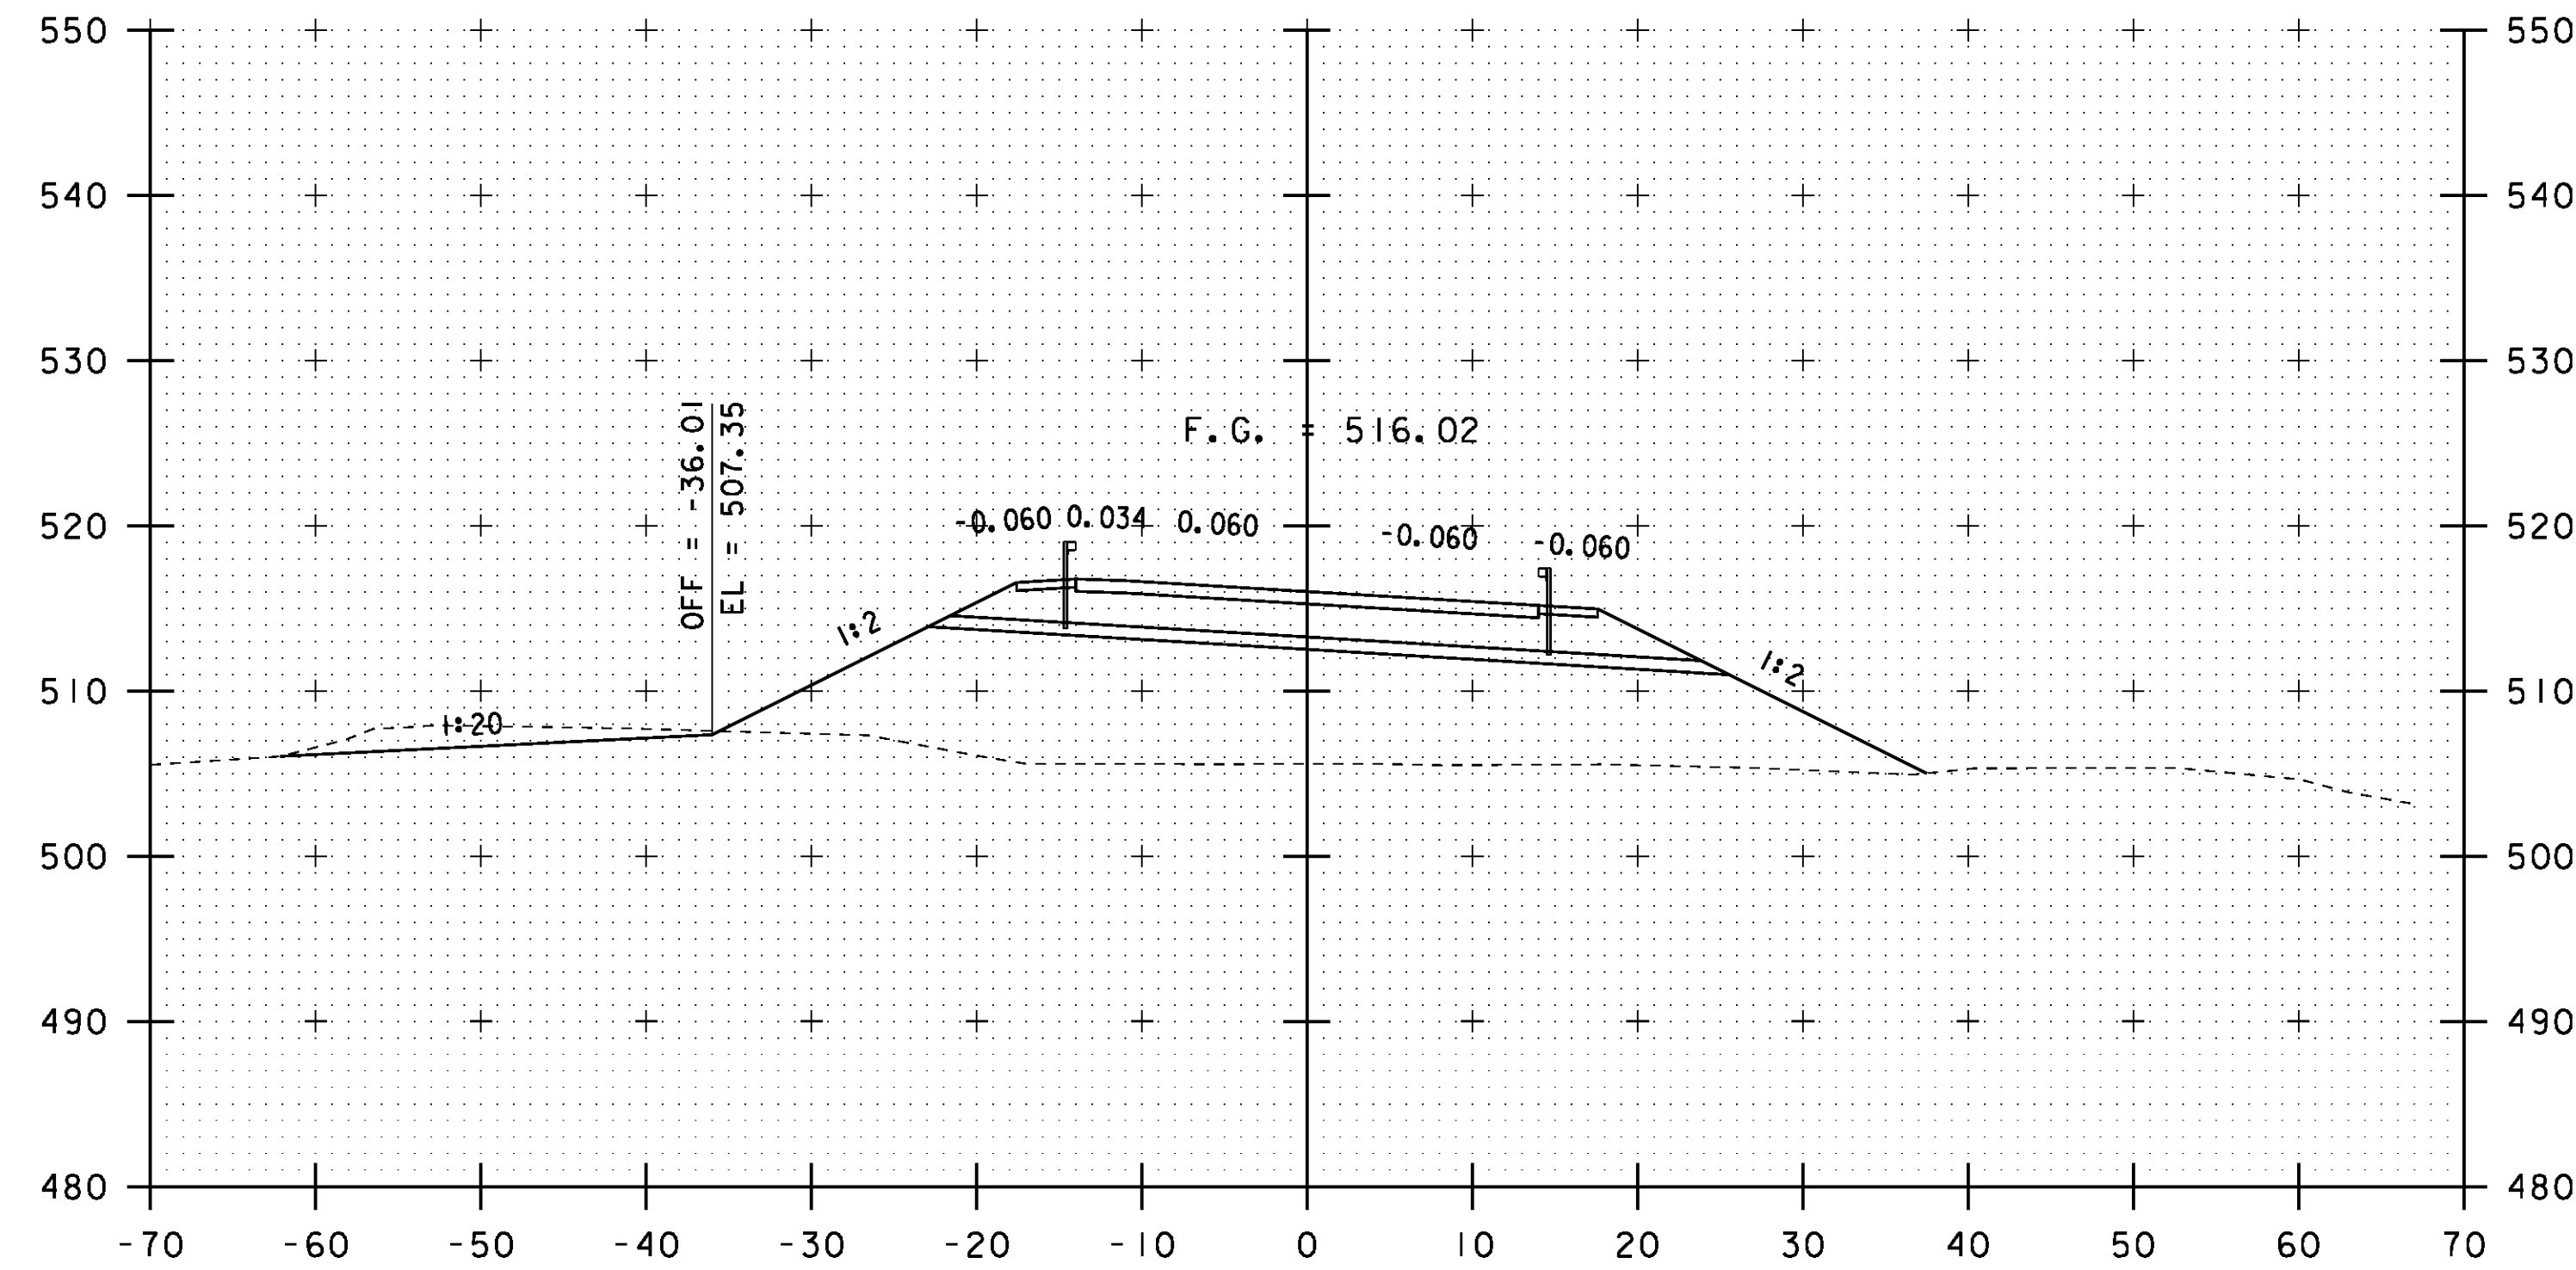

389+25

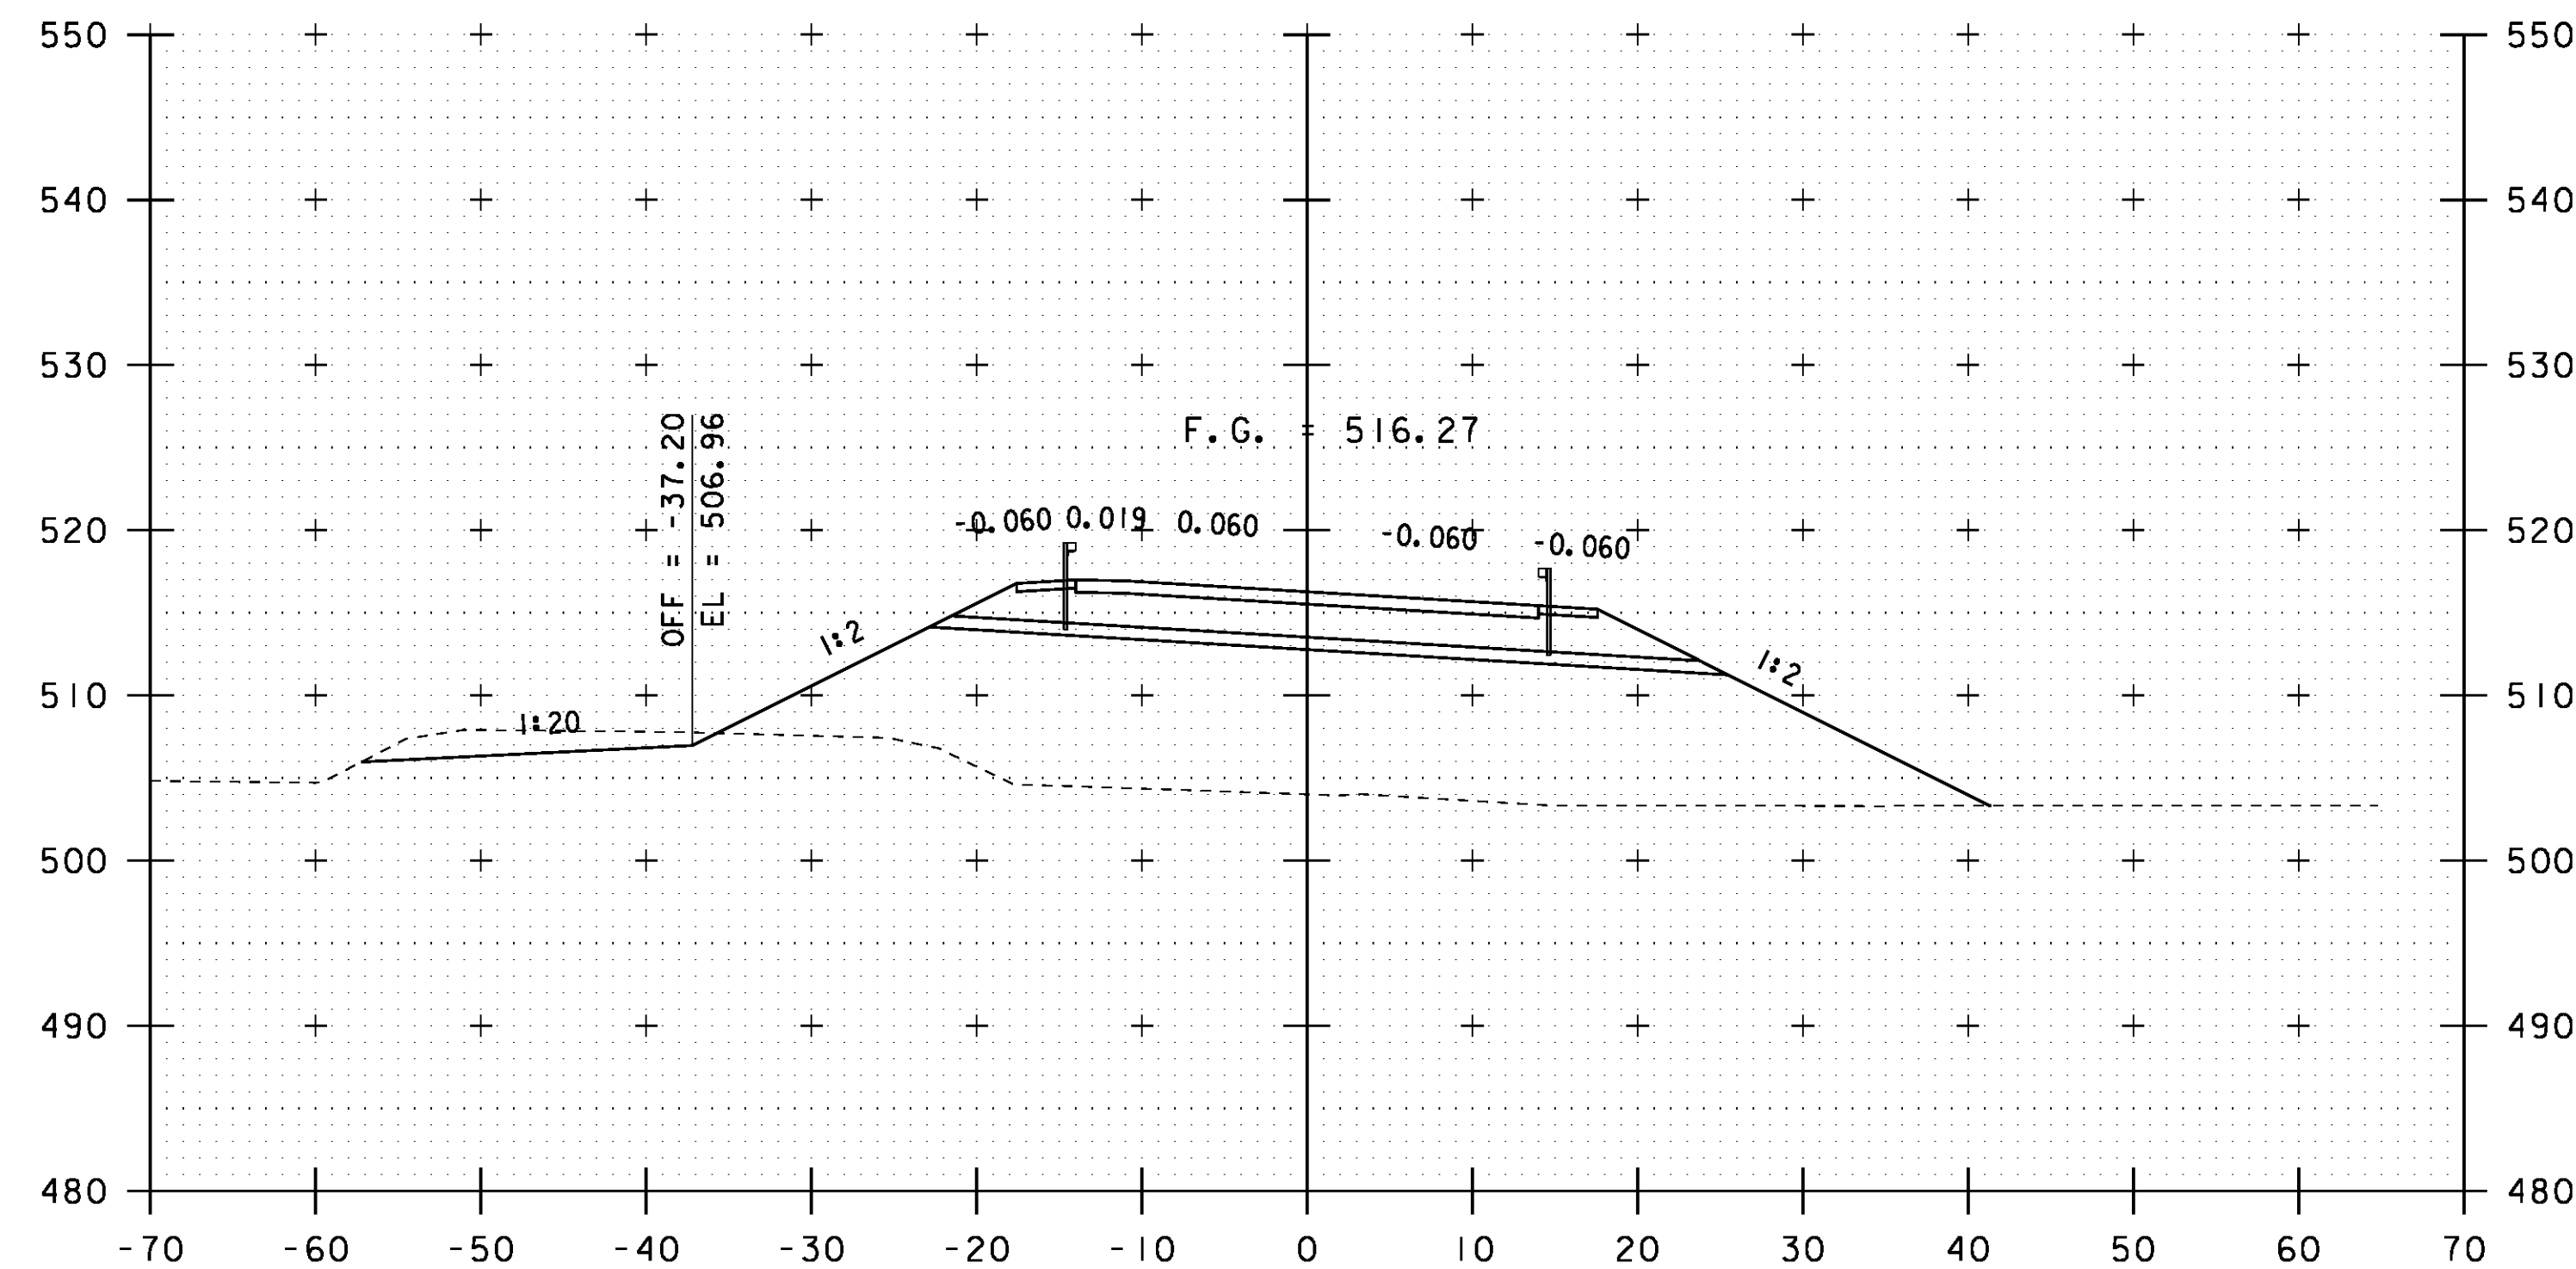


389+00

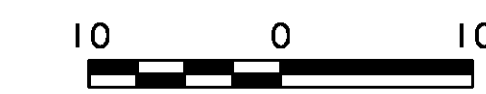


SCALE: 1" = 10'-0"

STA. 388+50 TO STA. 389+25


PROJECT NAME: ROYALTON	PLOT DATE: 08-OCT-2013
PROJECT NUMBER: BRS 0147 (13)	DRAWN BY: G. ROY
FILE NAME: \BR 27\86e055xsl.27.dgn	CHECKED BY: D. PETERSON
PROJECT LEADER: C. CARLSON	SHEET 55 OF 186
DESIGNED BY: G. ROY	BRIDGE 27 VT 14 CROSS SECTIONS (5)

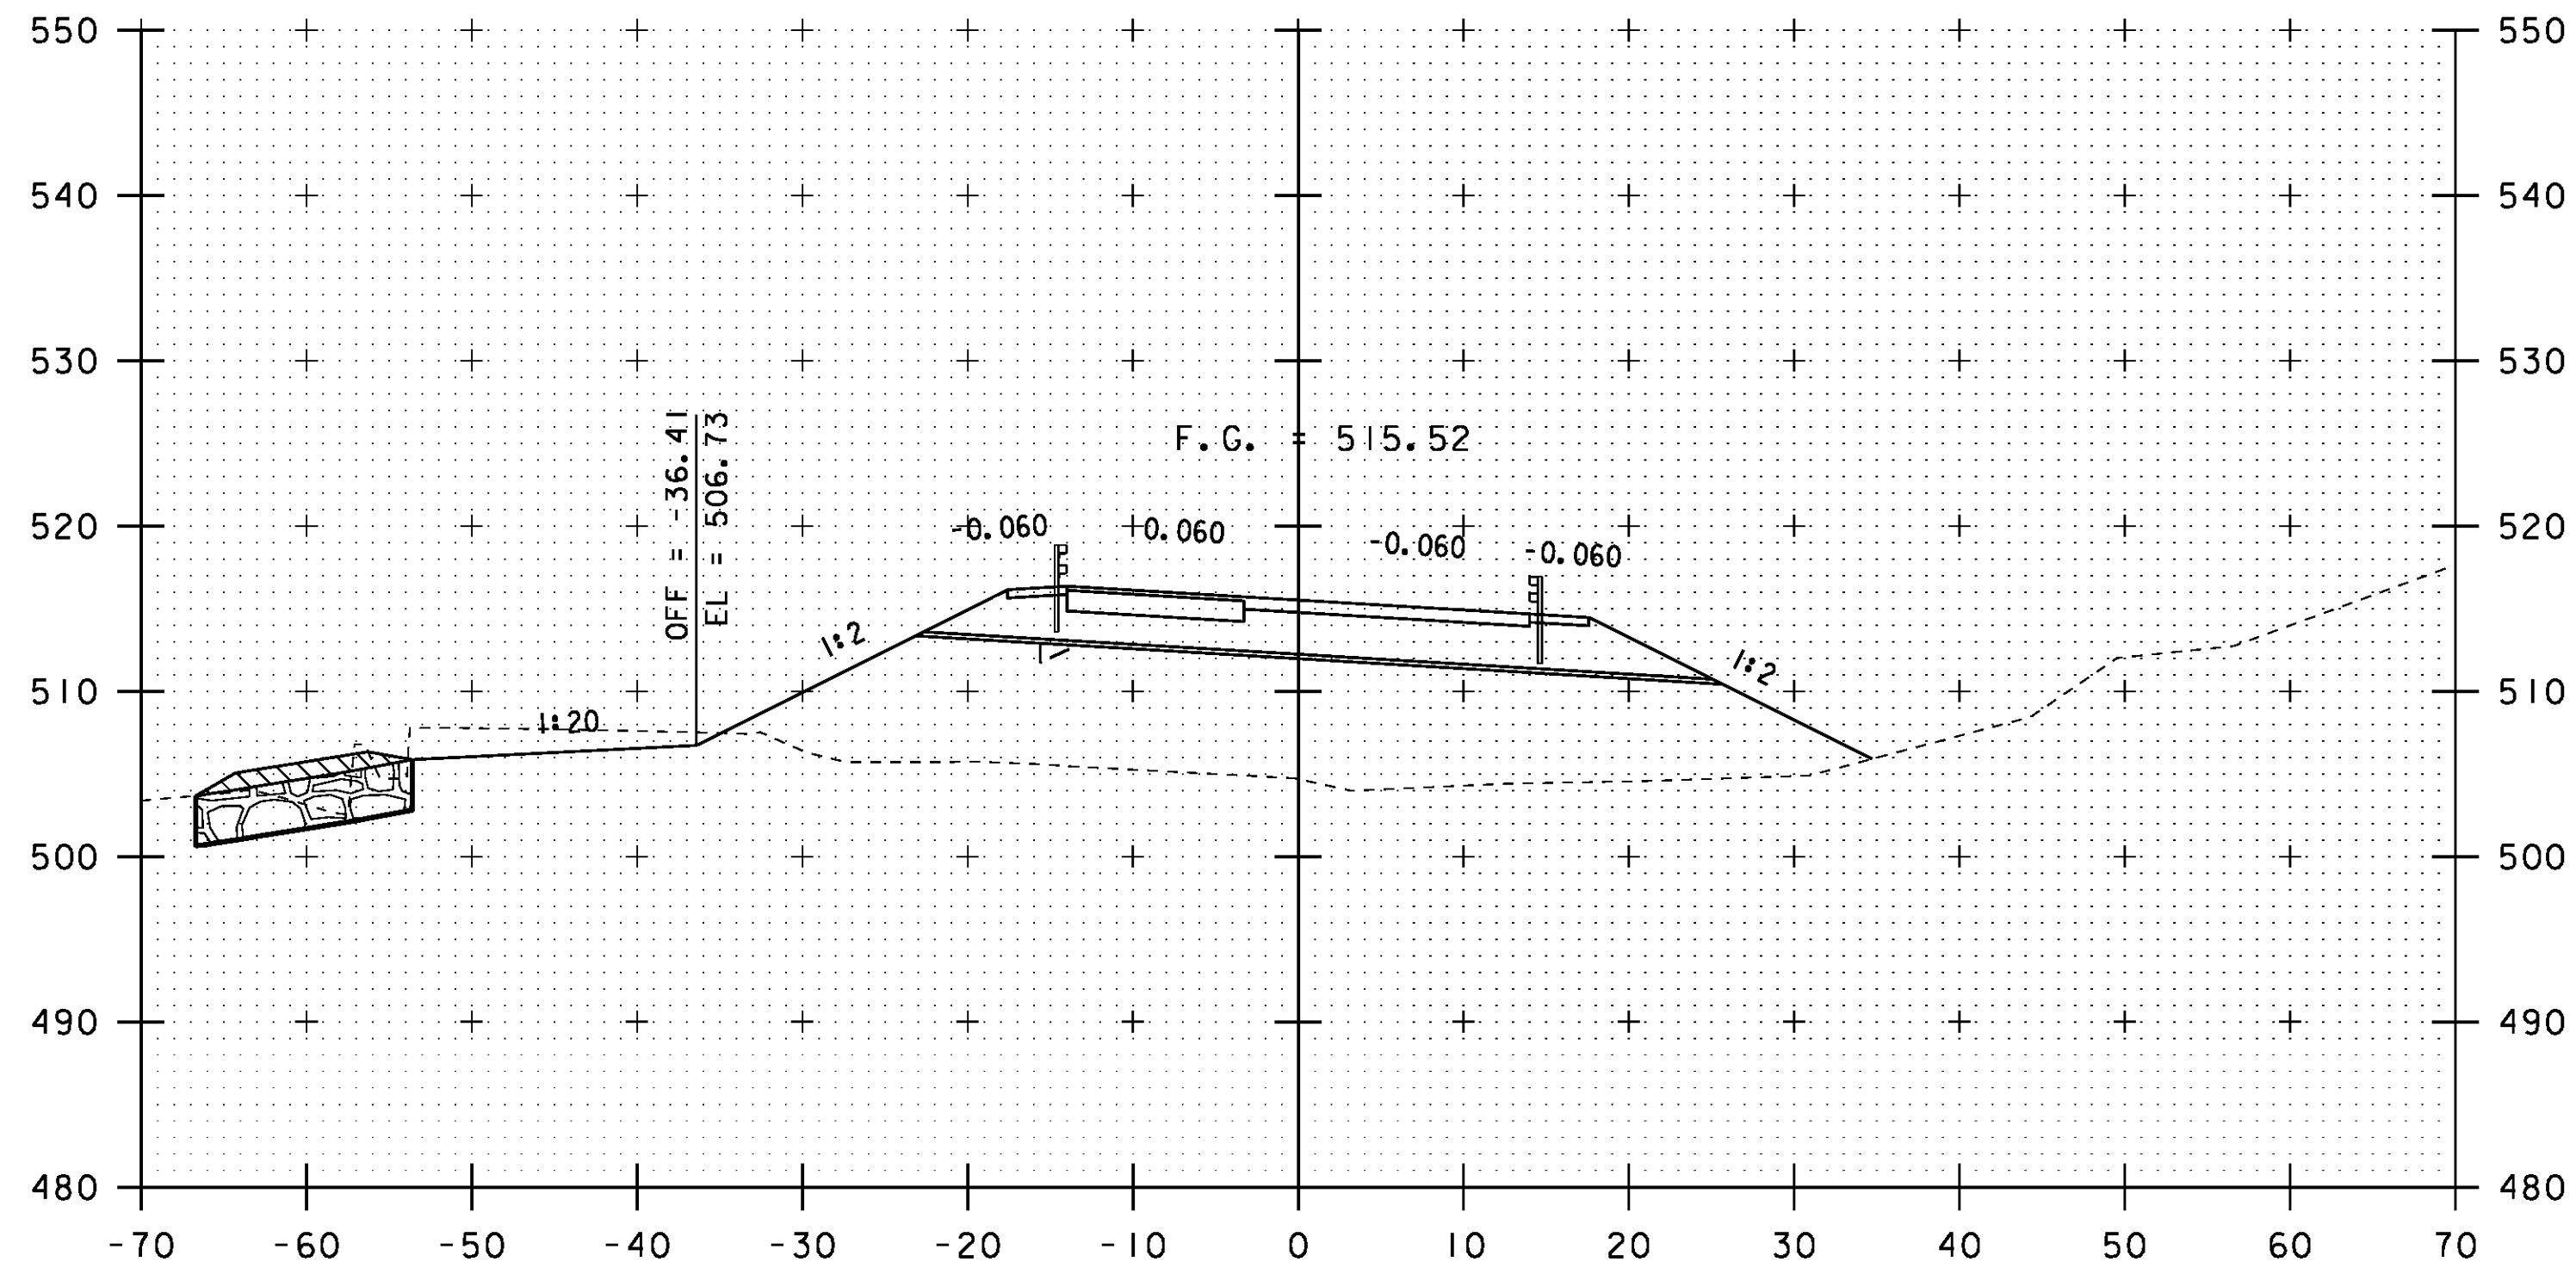


389+75

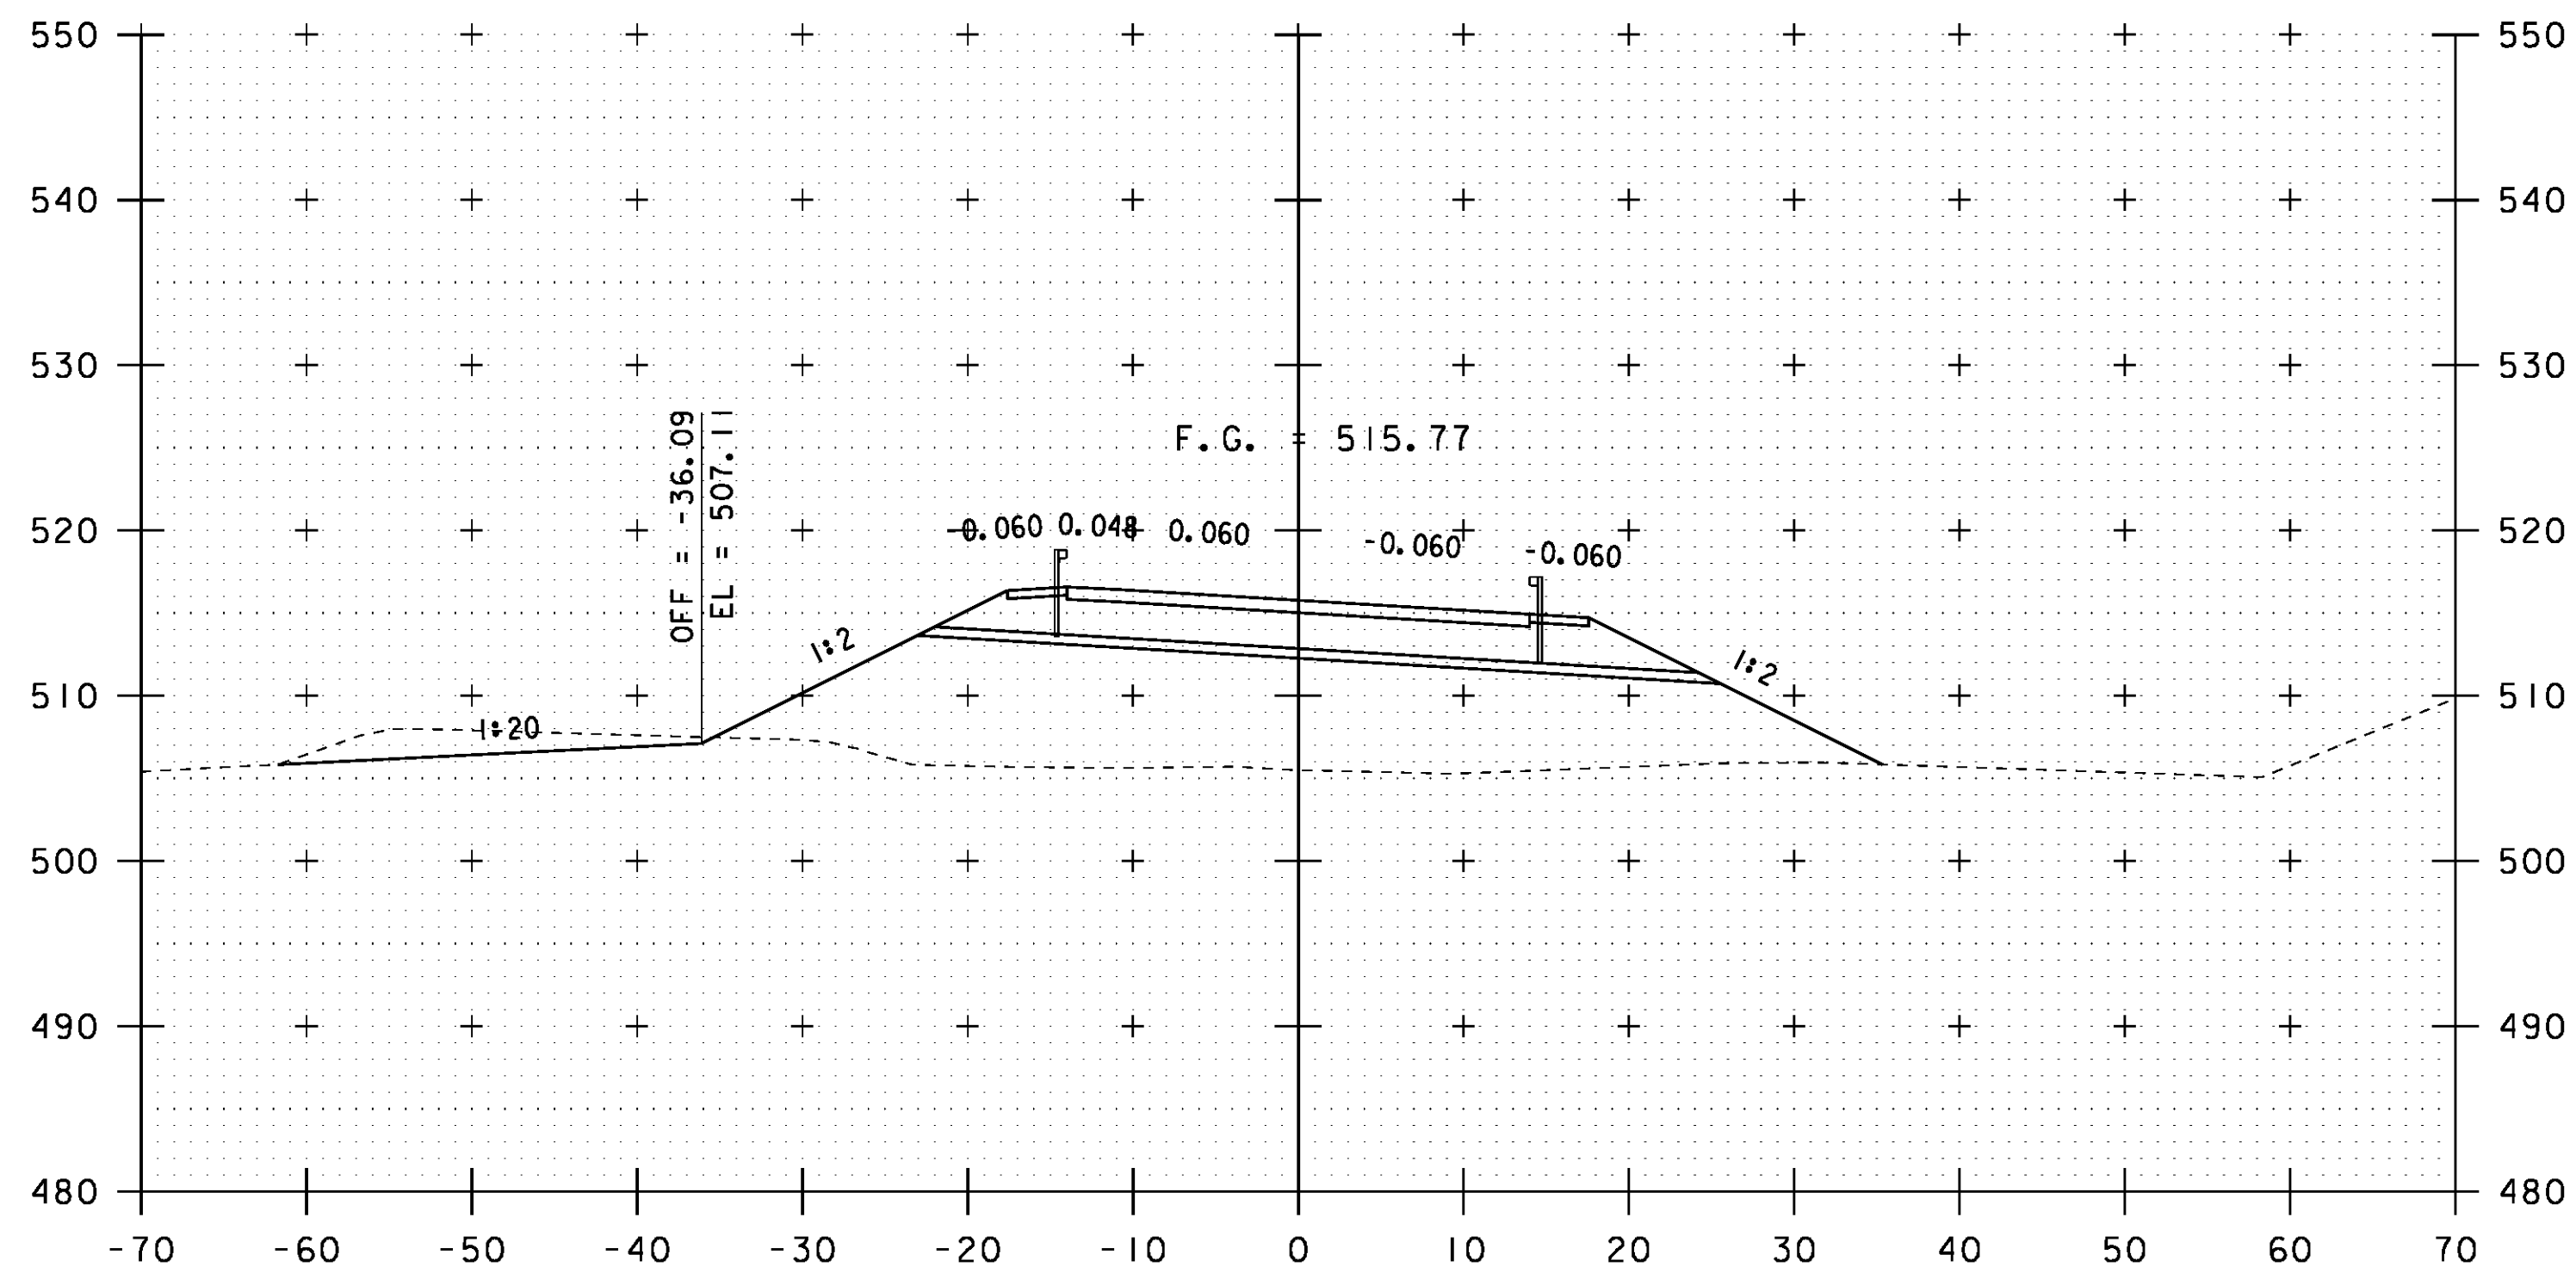

389+50

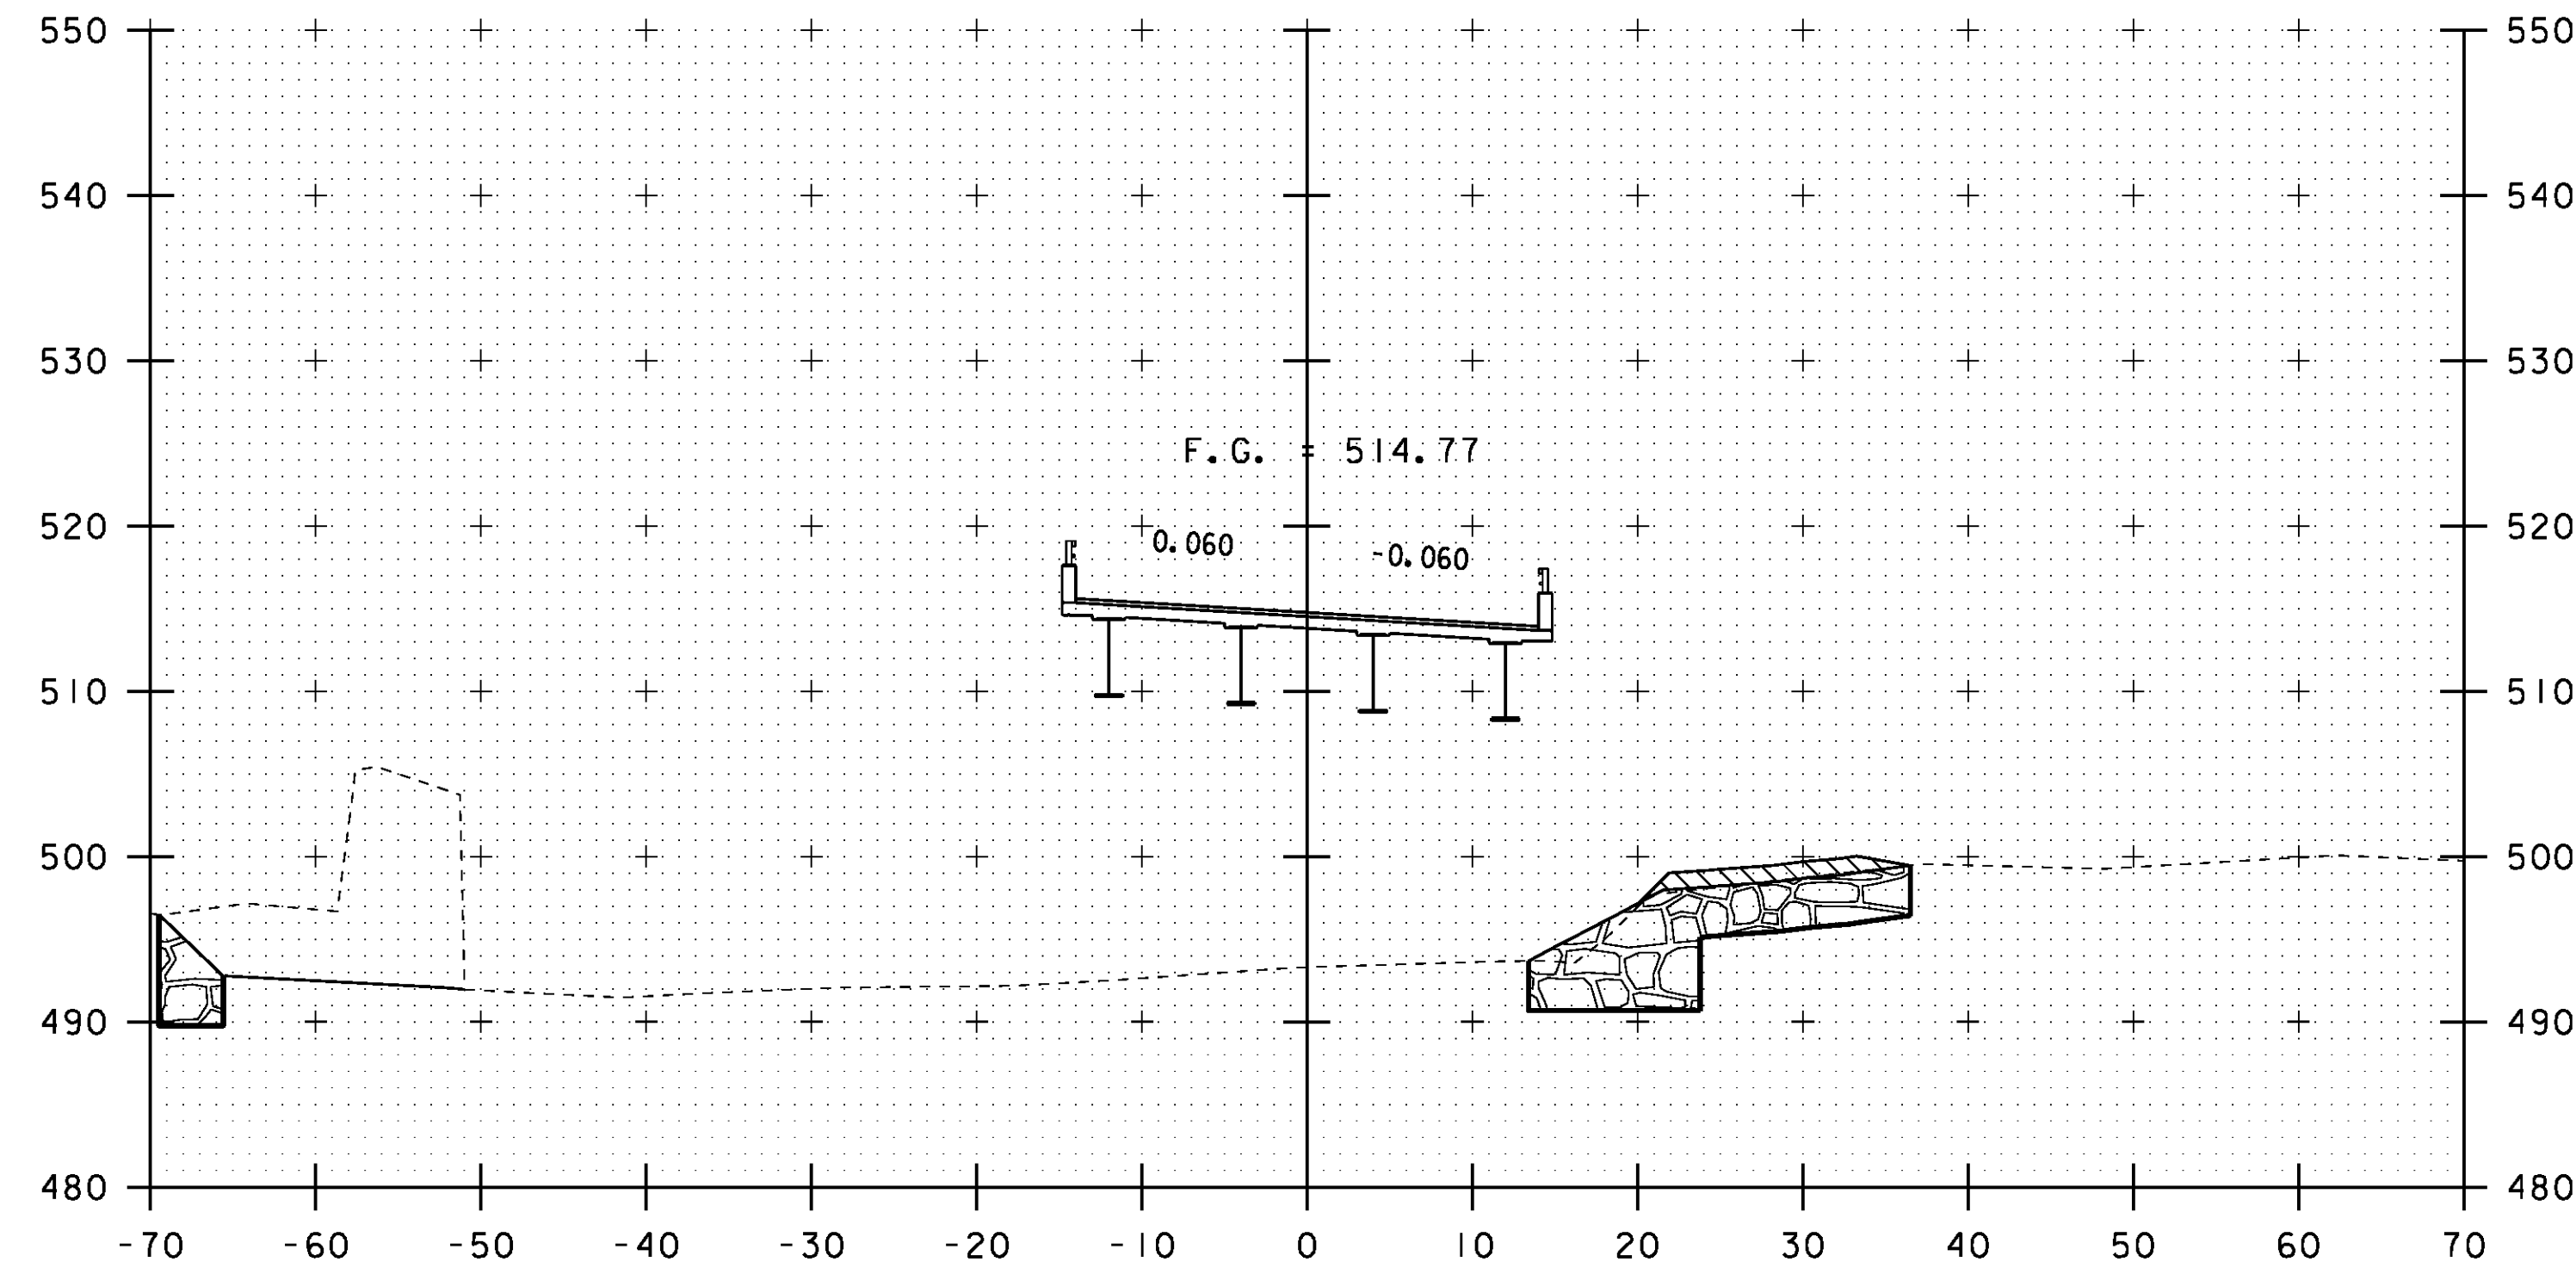


390+50

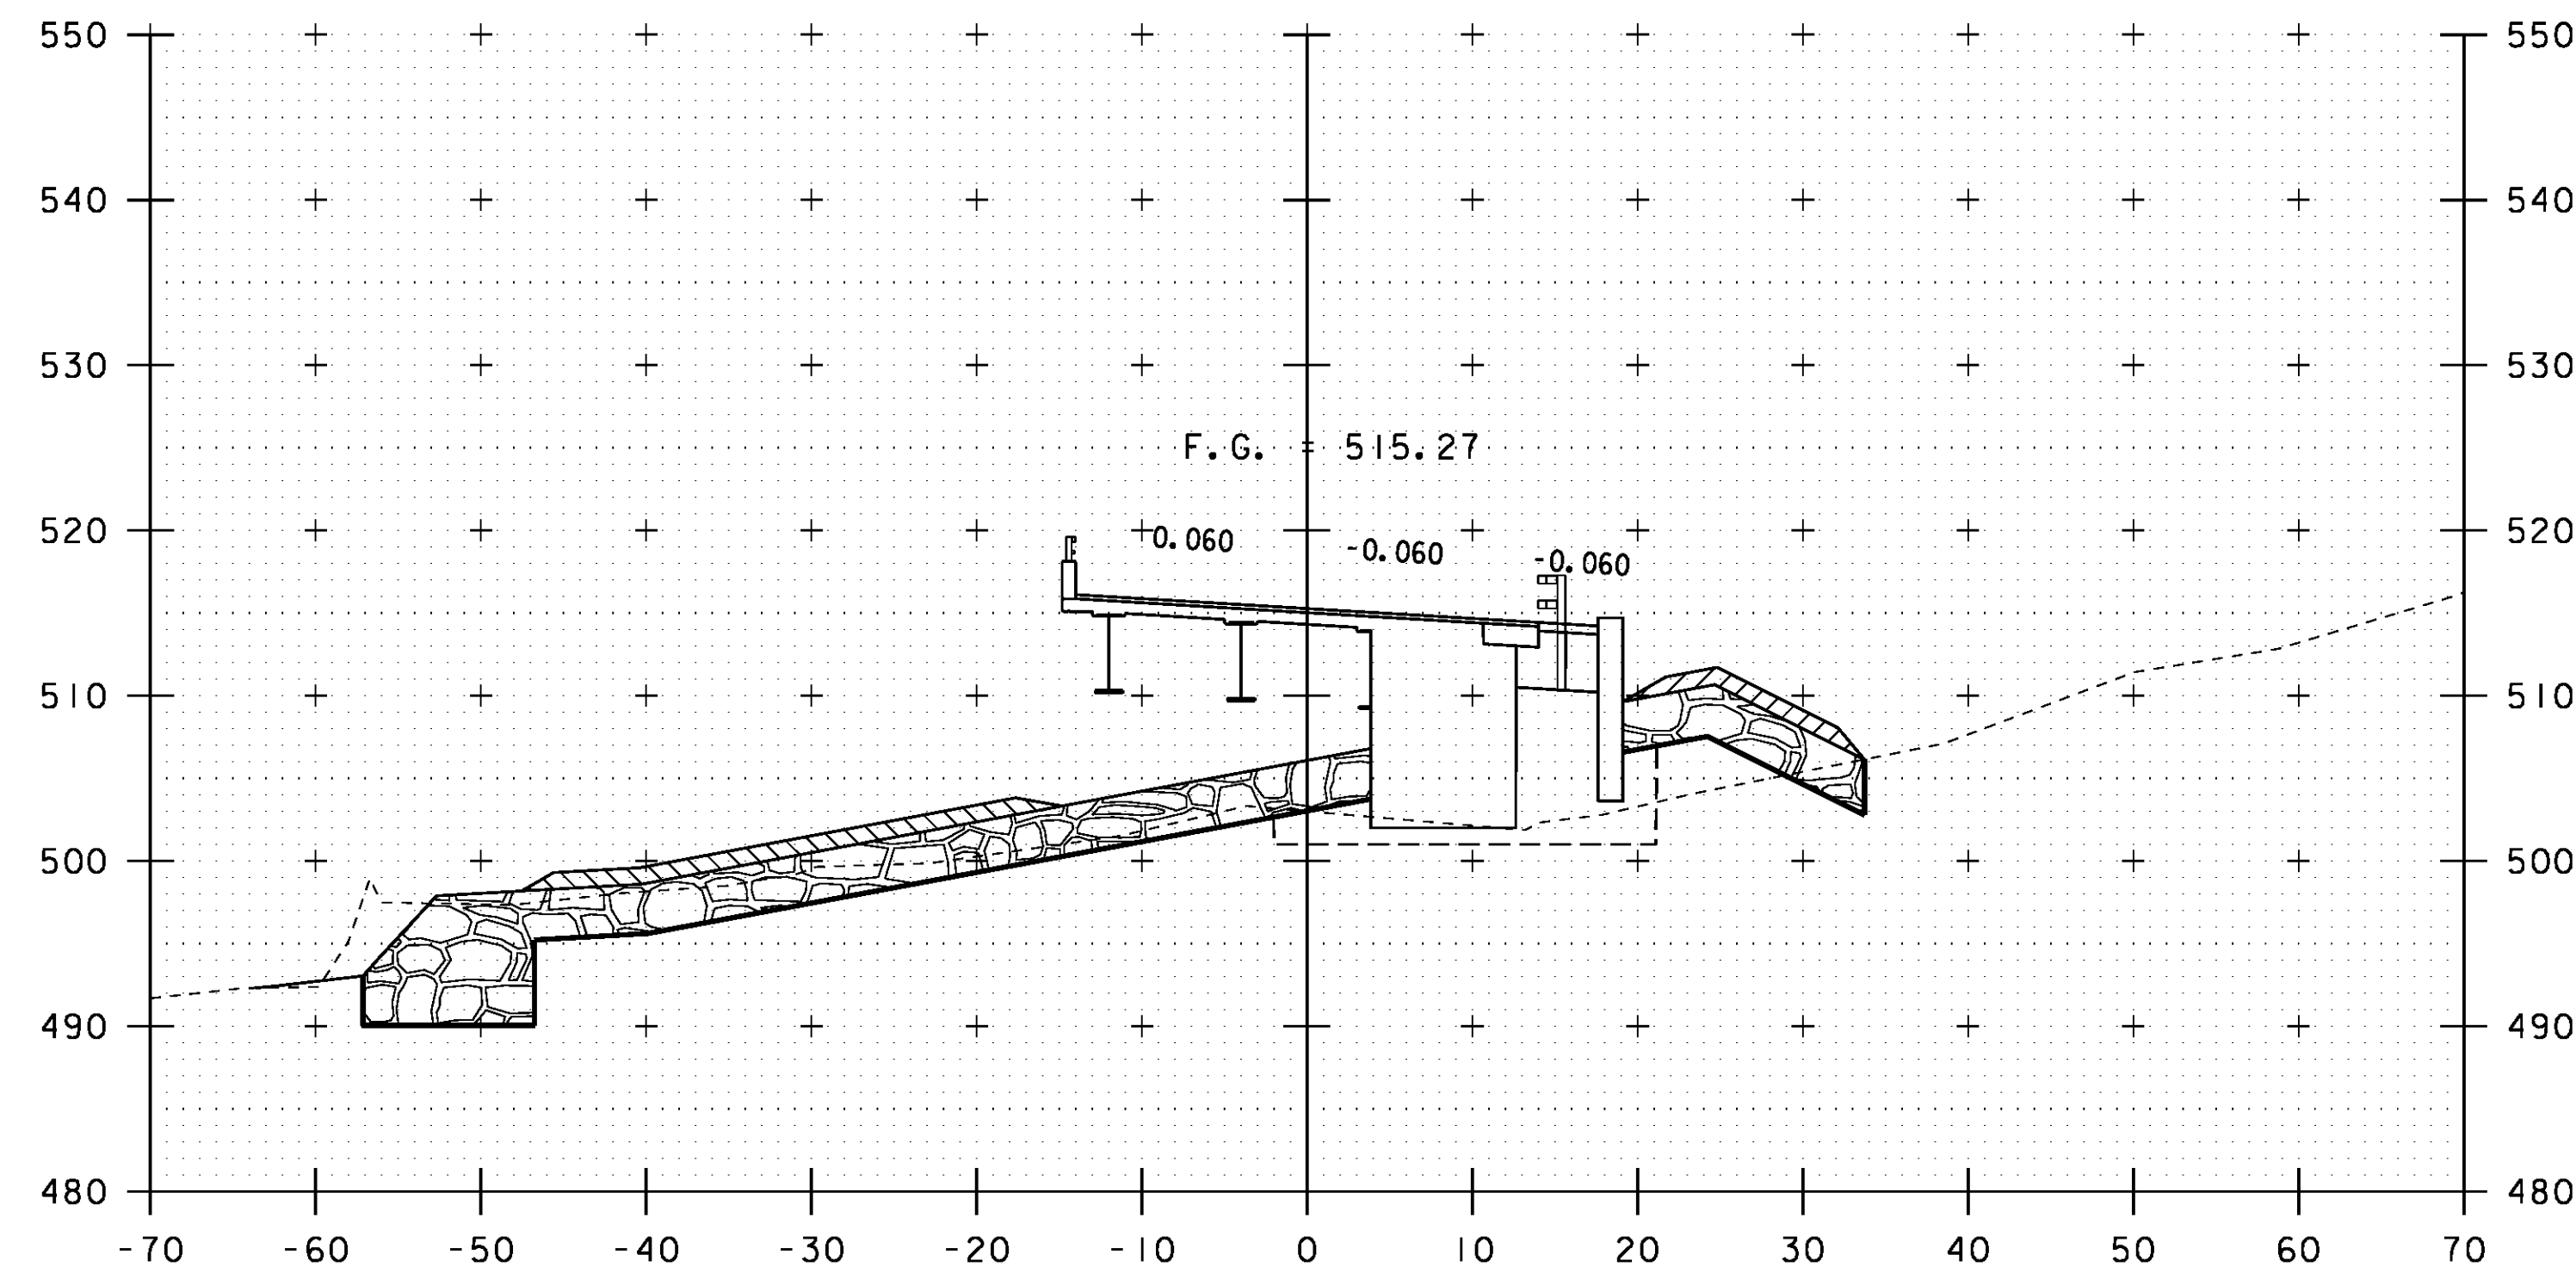

390+00

STA 389+96.11  
END ROADWAY  
BEGIN BRIDGE

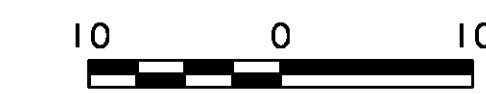


SCALE: 1" = 10'-0"

STA. 389+50 TO STA. 390+50


PROJECT NAME:	ROYALTON	FILE NAME:	\BR 27\86e055xsl.27.dgn	PLOT DATE:	08-OCT-2013
PROJECT NUMBER:	BRS 0147 (13)	PROJECT LEADER:	C. CARLSON	DRAWN BY:	G. ROY
		DESIGNED BY:	G. ROY	CHECKED BY:	D. PETERSON
		BRIDGE 27 VT 14 CROSS SECTIONS (6)		SHEET	56 OF 186



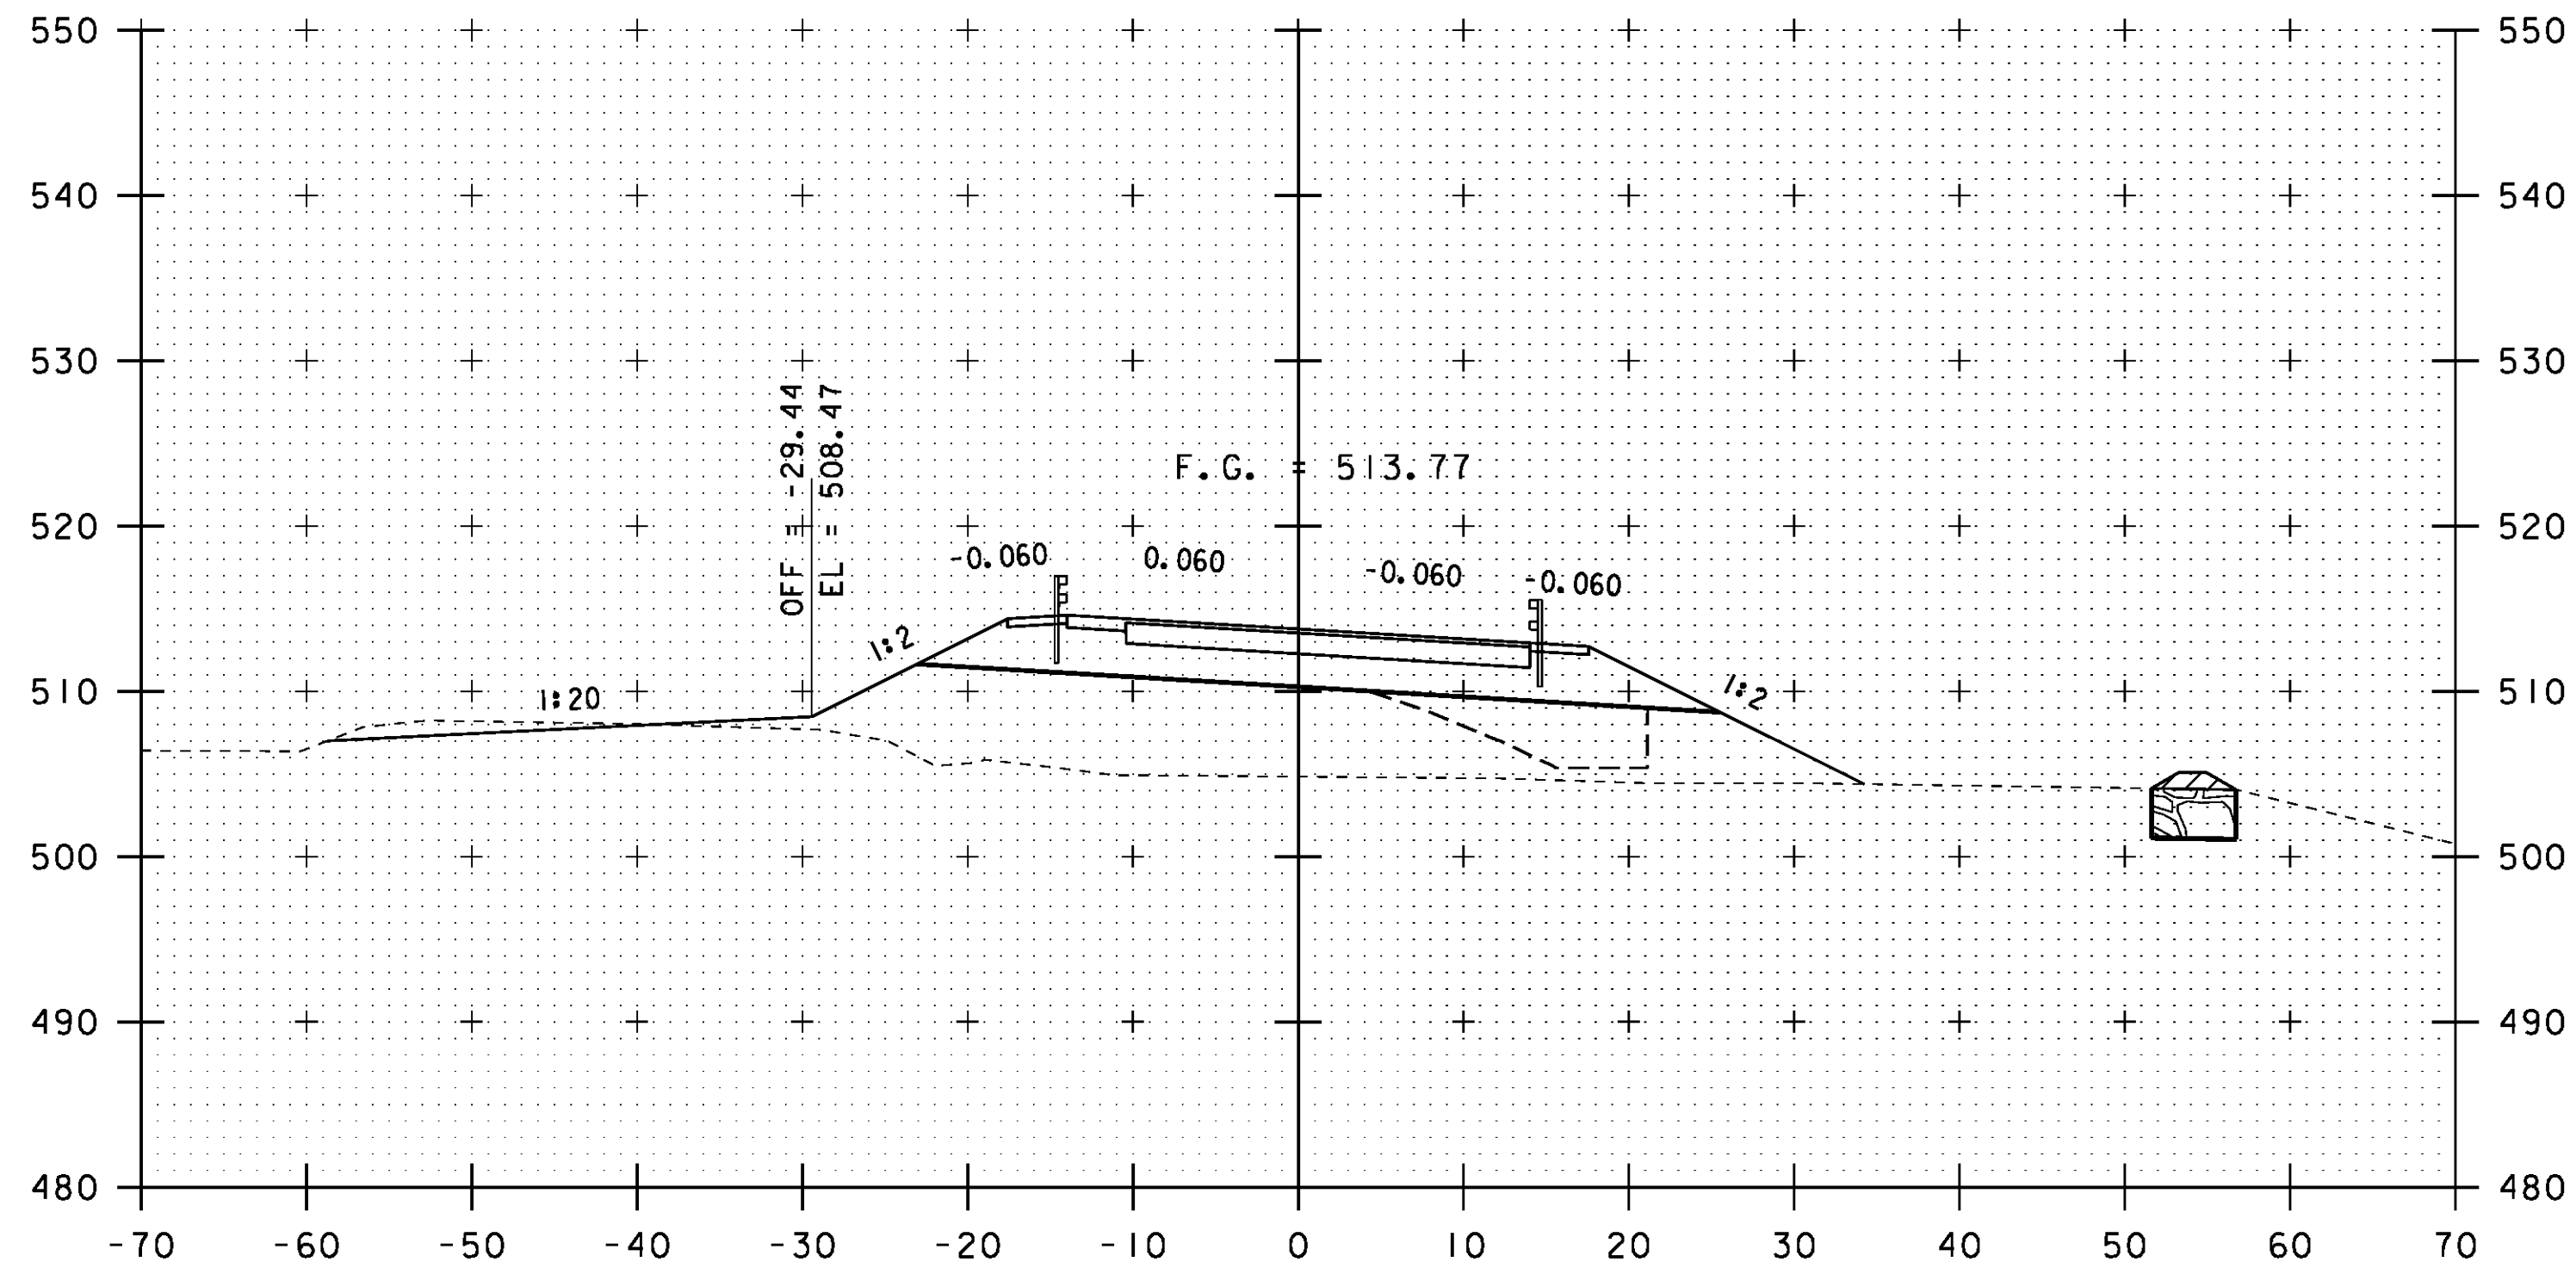


391+50


STA 391+33.89  
END BRIDGE  
RESUME ROADWAY

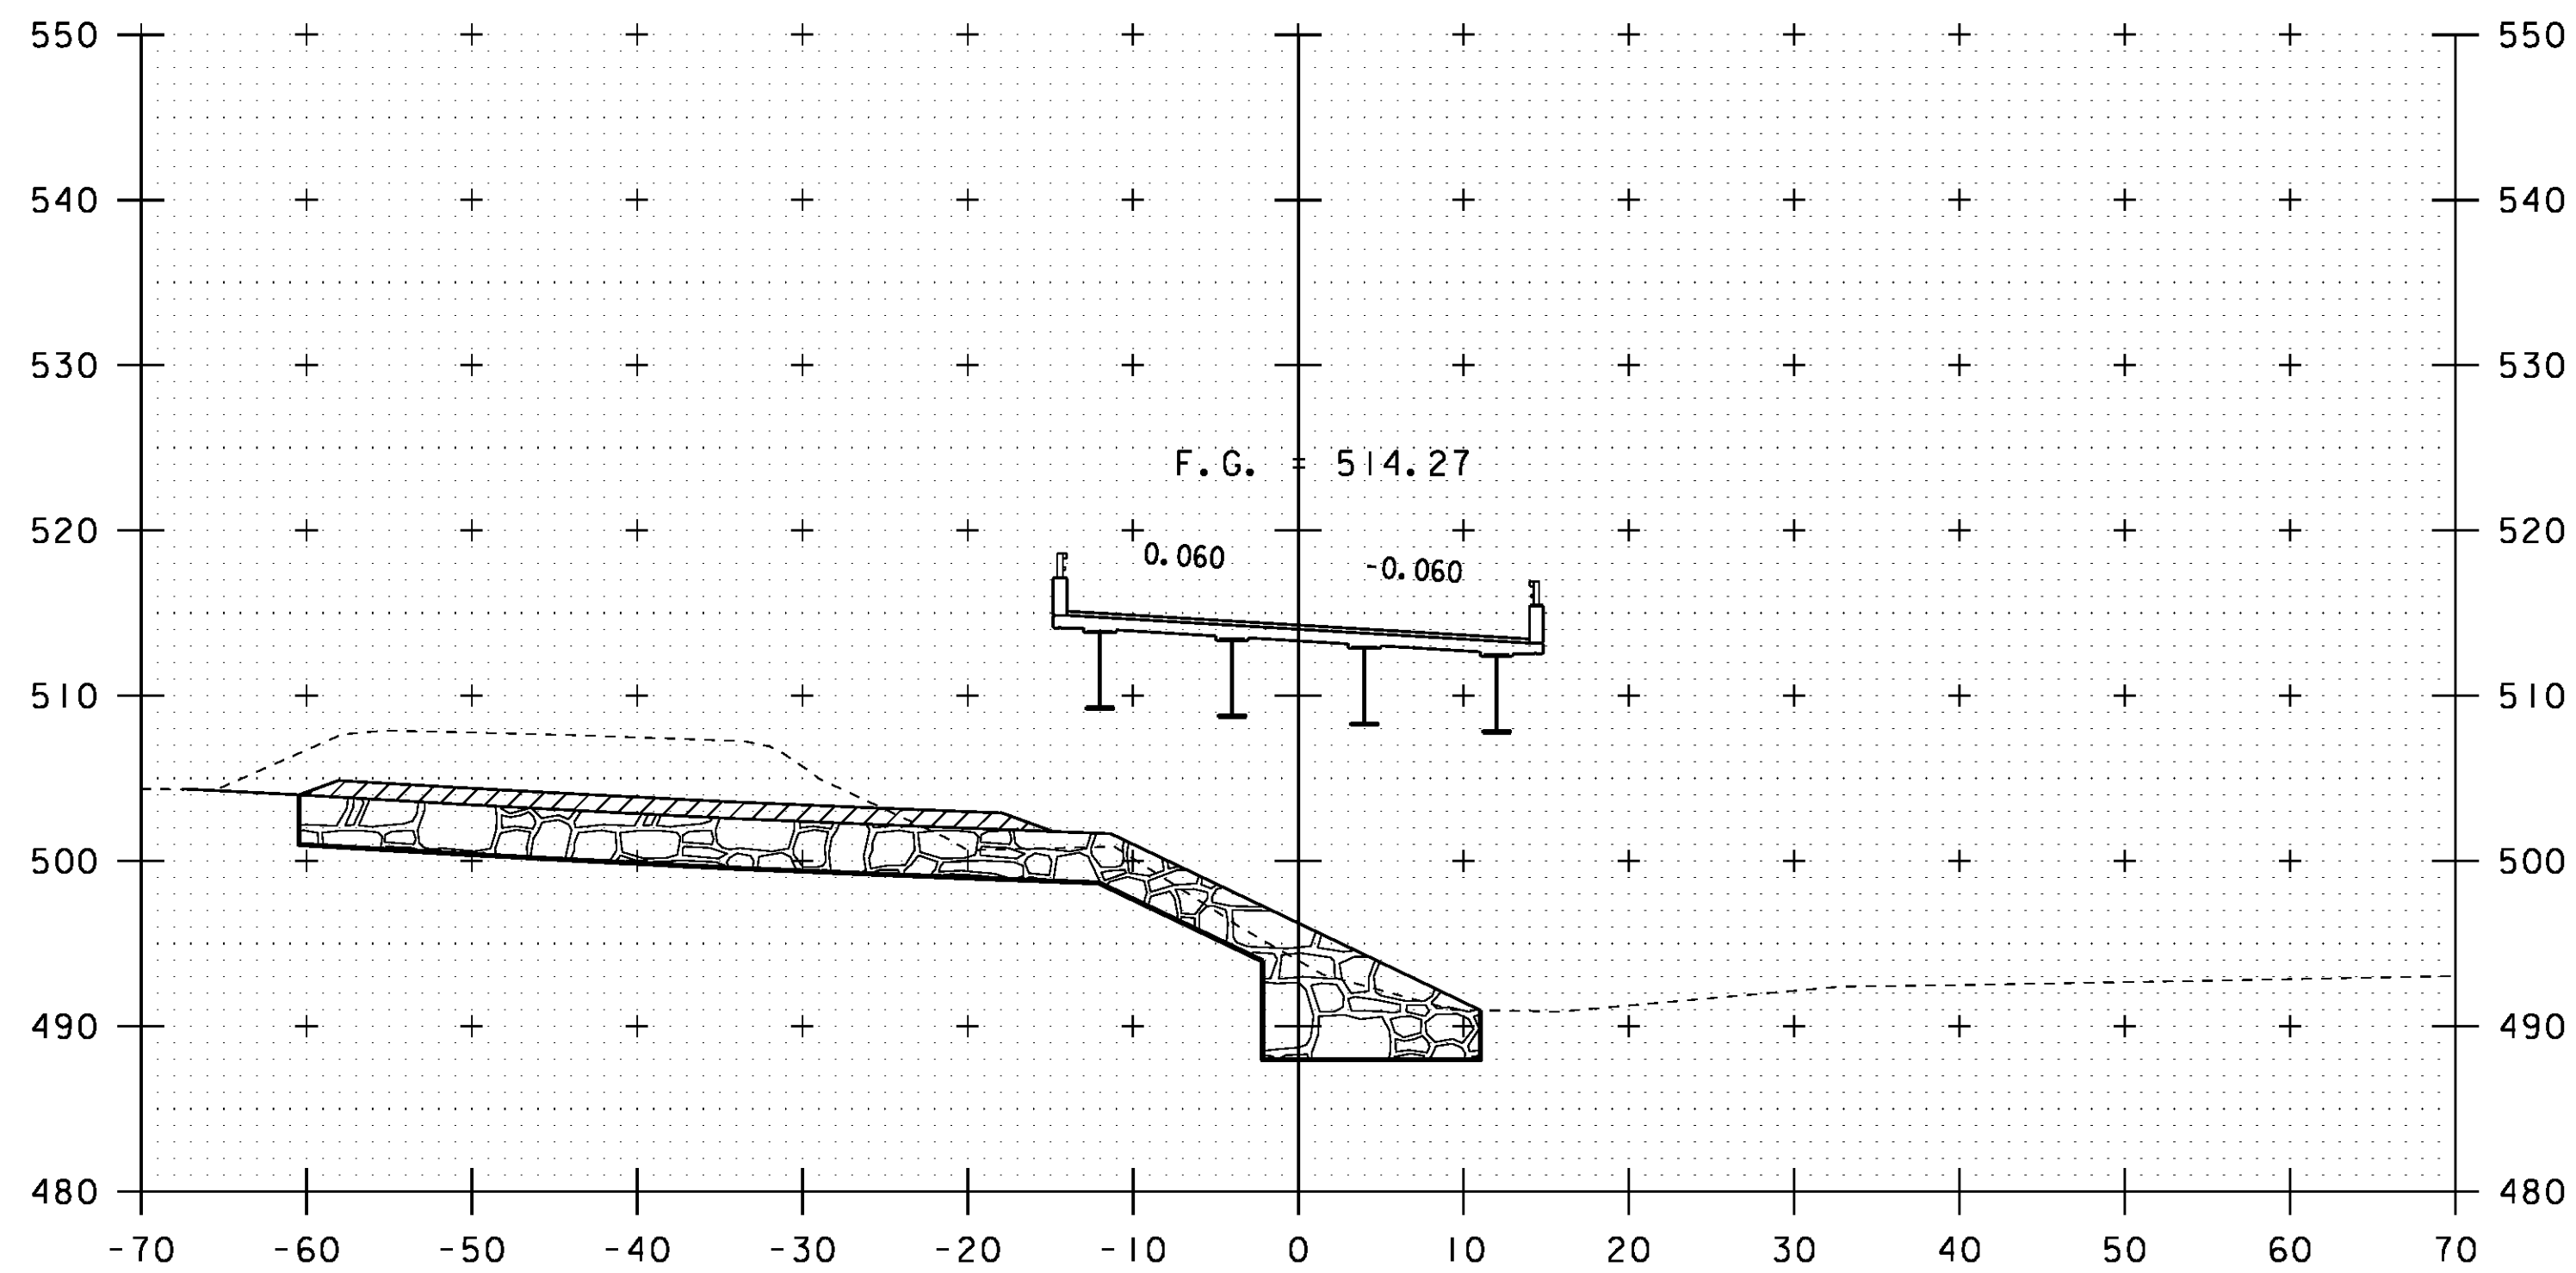


391+00

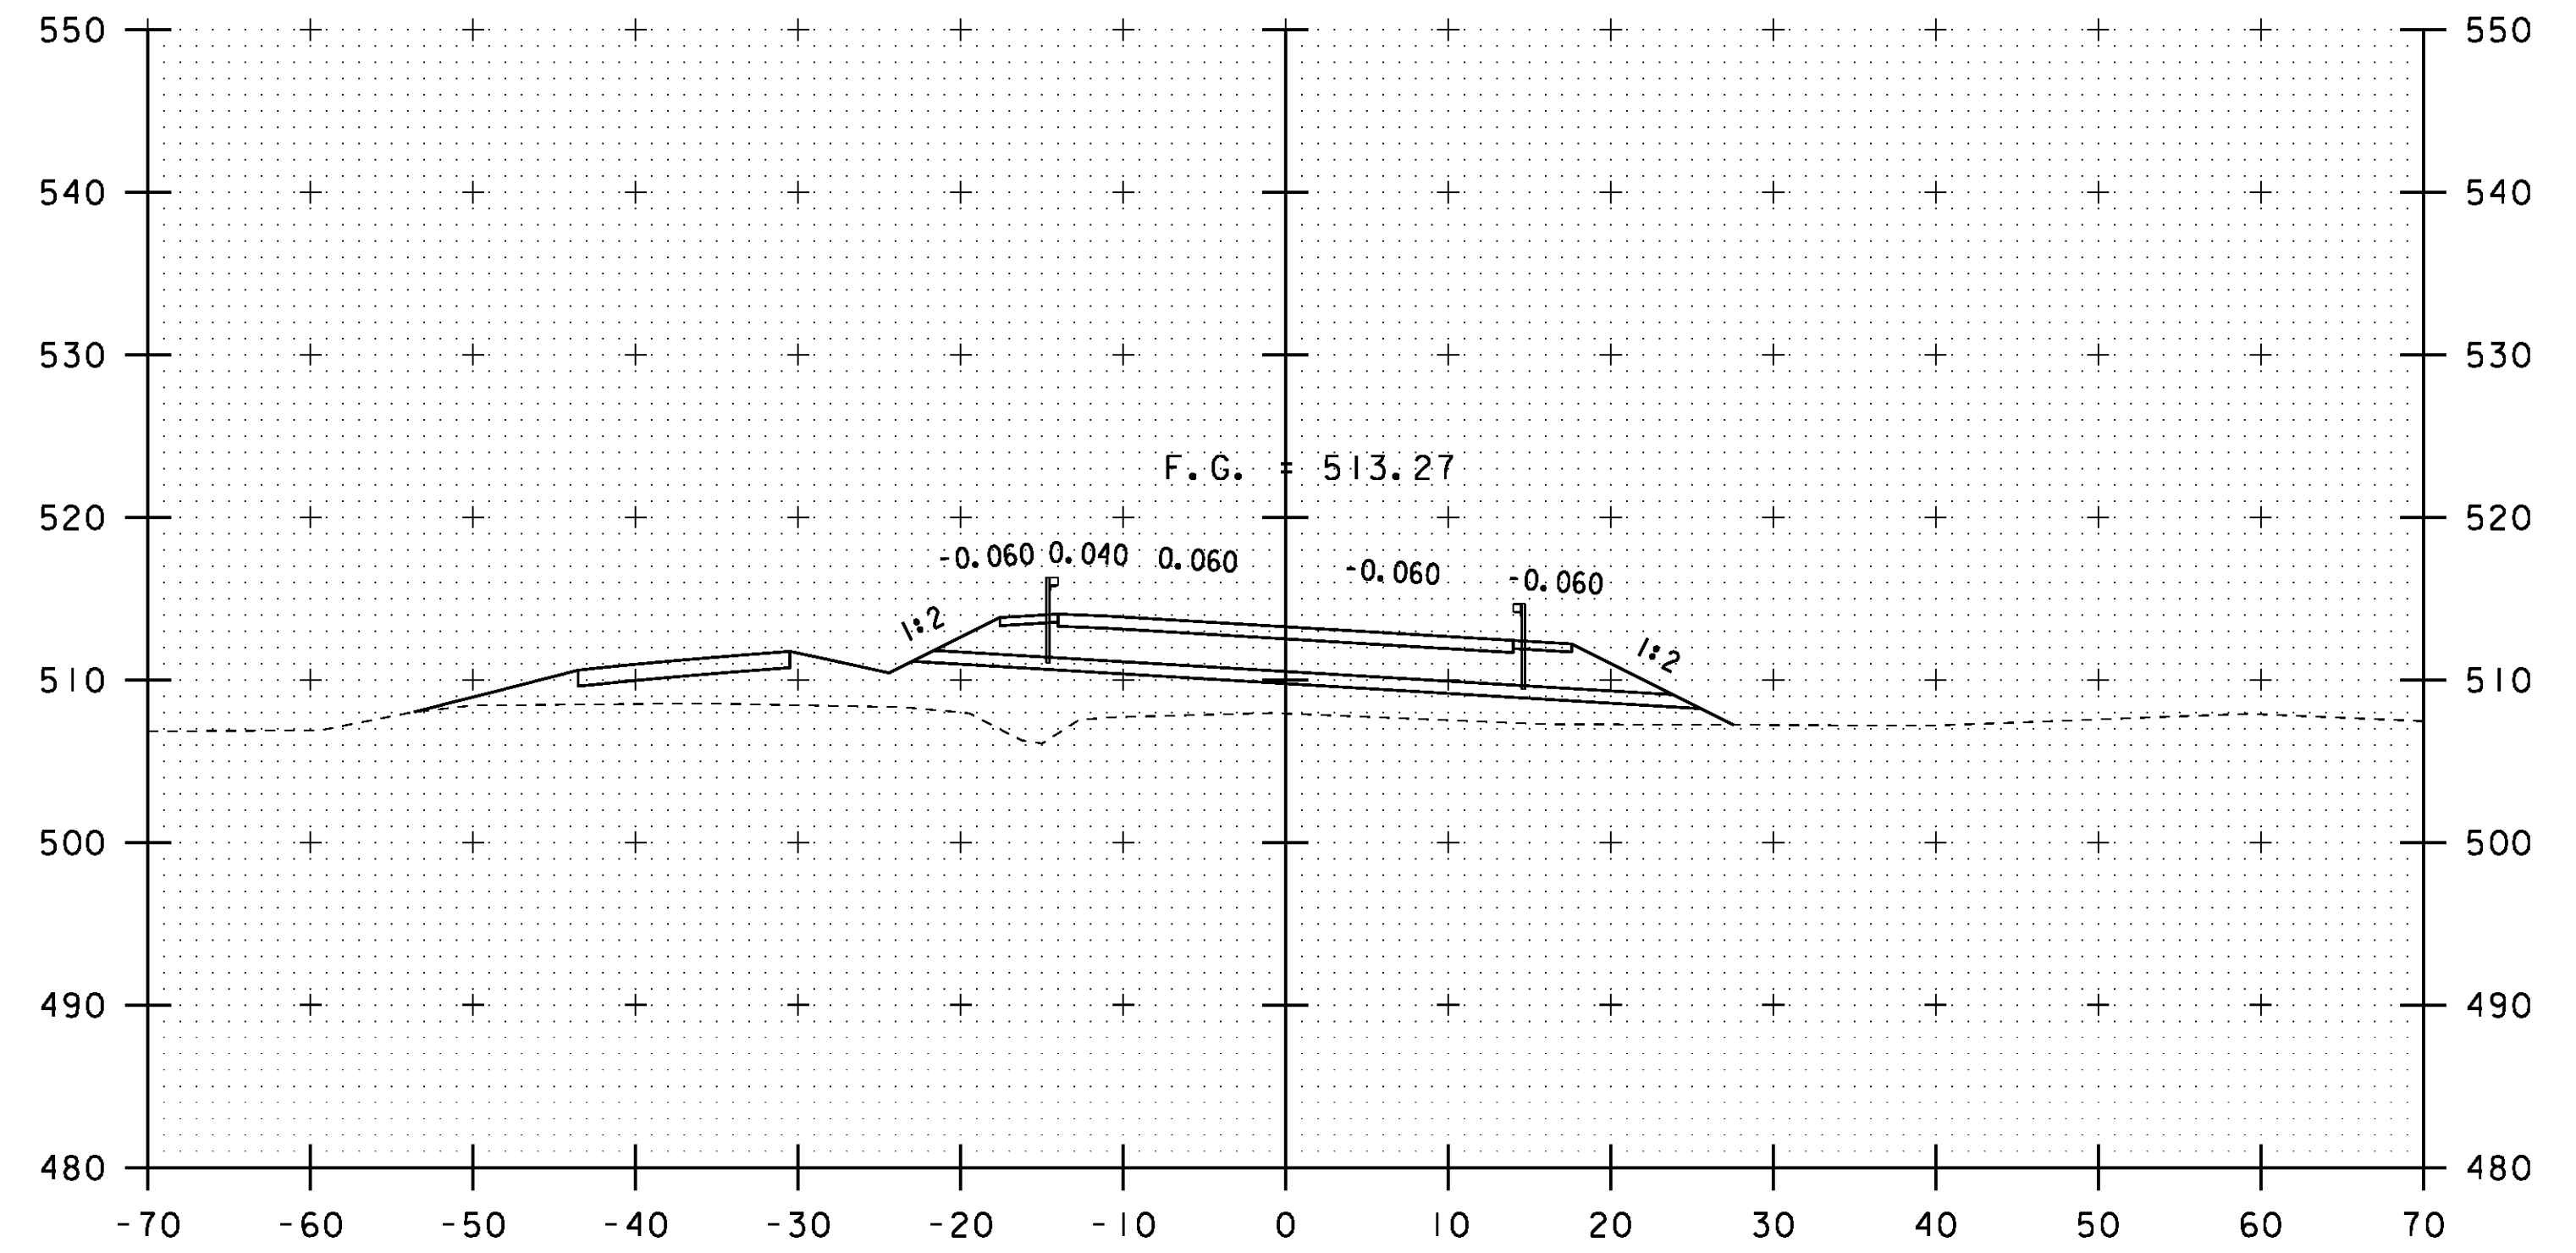

392+00

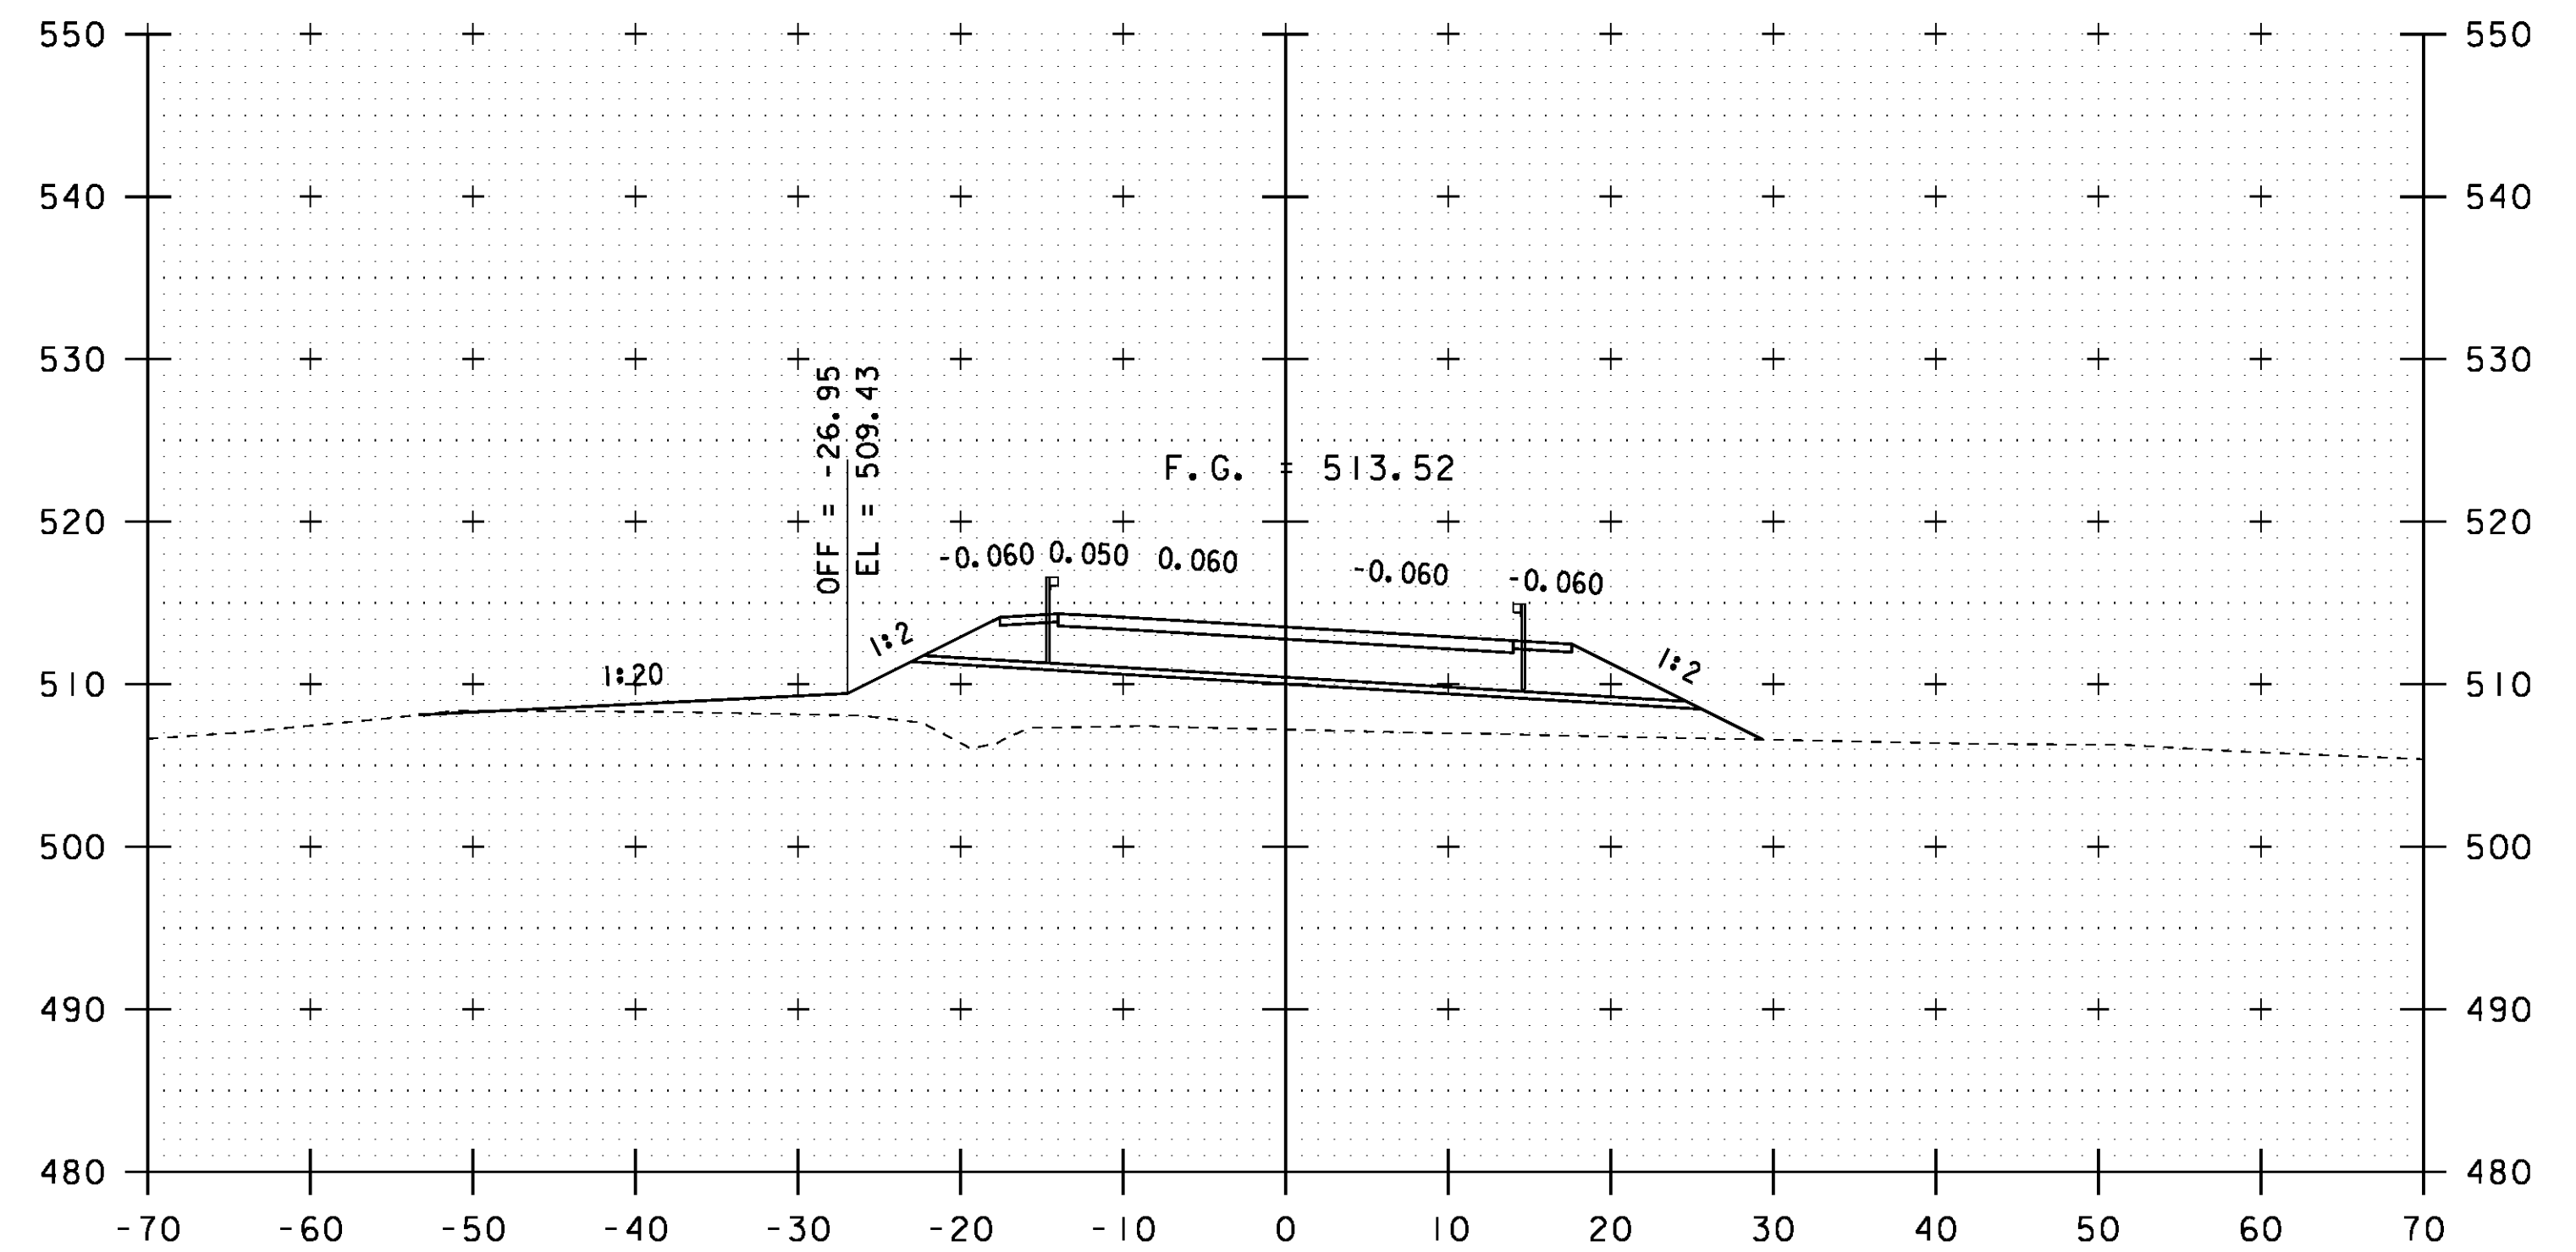

391+75

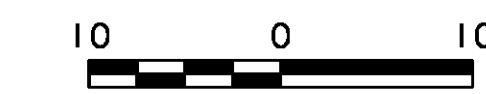


SCALE: 1" = 10'-0"

STA. 391+00 TO STA. 392+00

PROJECT NAME: ROYALTON  
PROJECT NUMBER: BRS 0147 (13)


FILE NAME: \BR 27\86e055xsl.27.dgn  
PROJECT LEADER: C. CARLSON  
DESIGNED BY: G. ROY  
BRIDGE 27 VT 14 CROSS SECTIONS (7)

PLOT DATE: 08-OCT-2013  
DRAWN BY: G. ROY  
CHECKED BY: D. PETERSON  
SHEET 57 OF 186

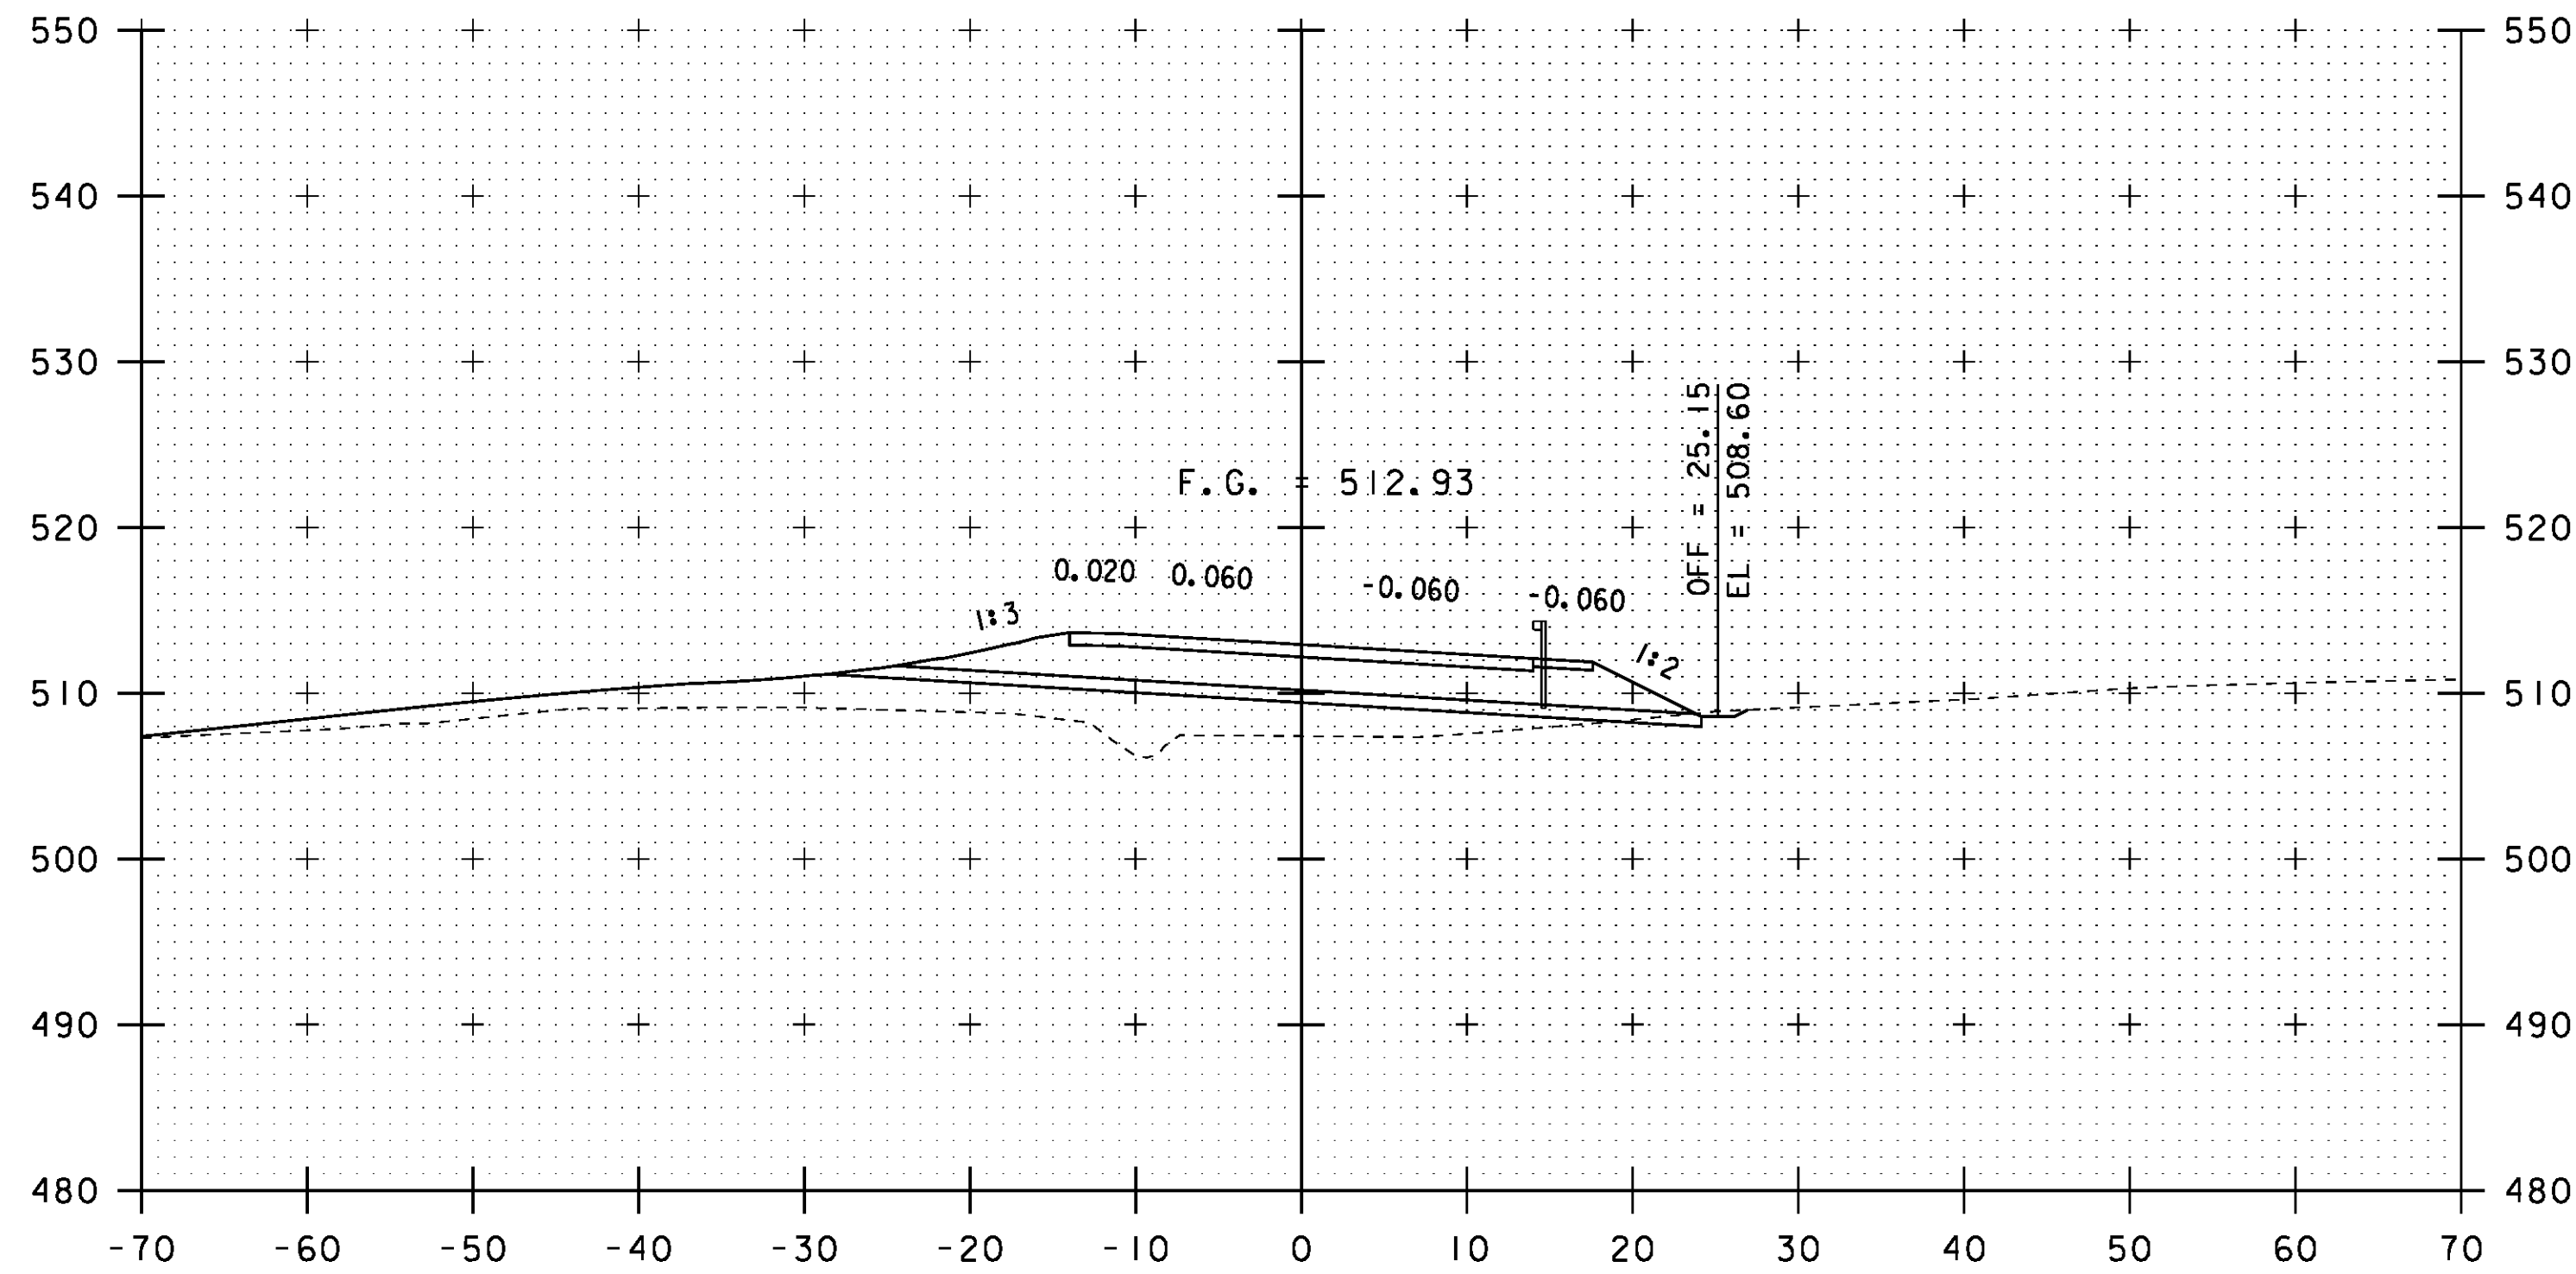


392+50

STA 392+47.3 RT - STA 393+75.0 RT  
CONSTRUCT NEW GRASS-LINED DITCH

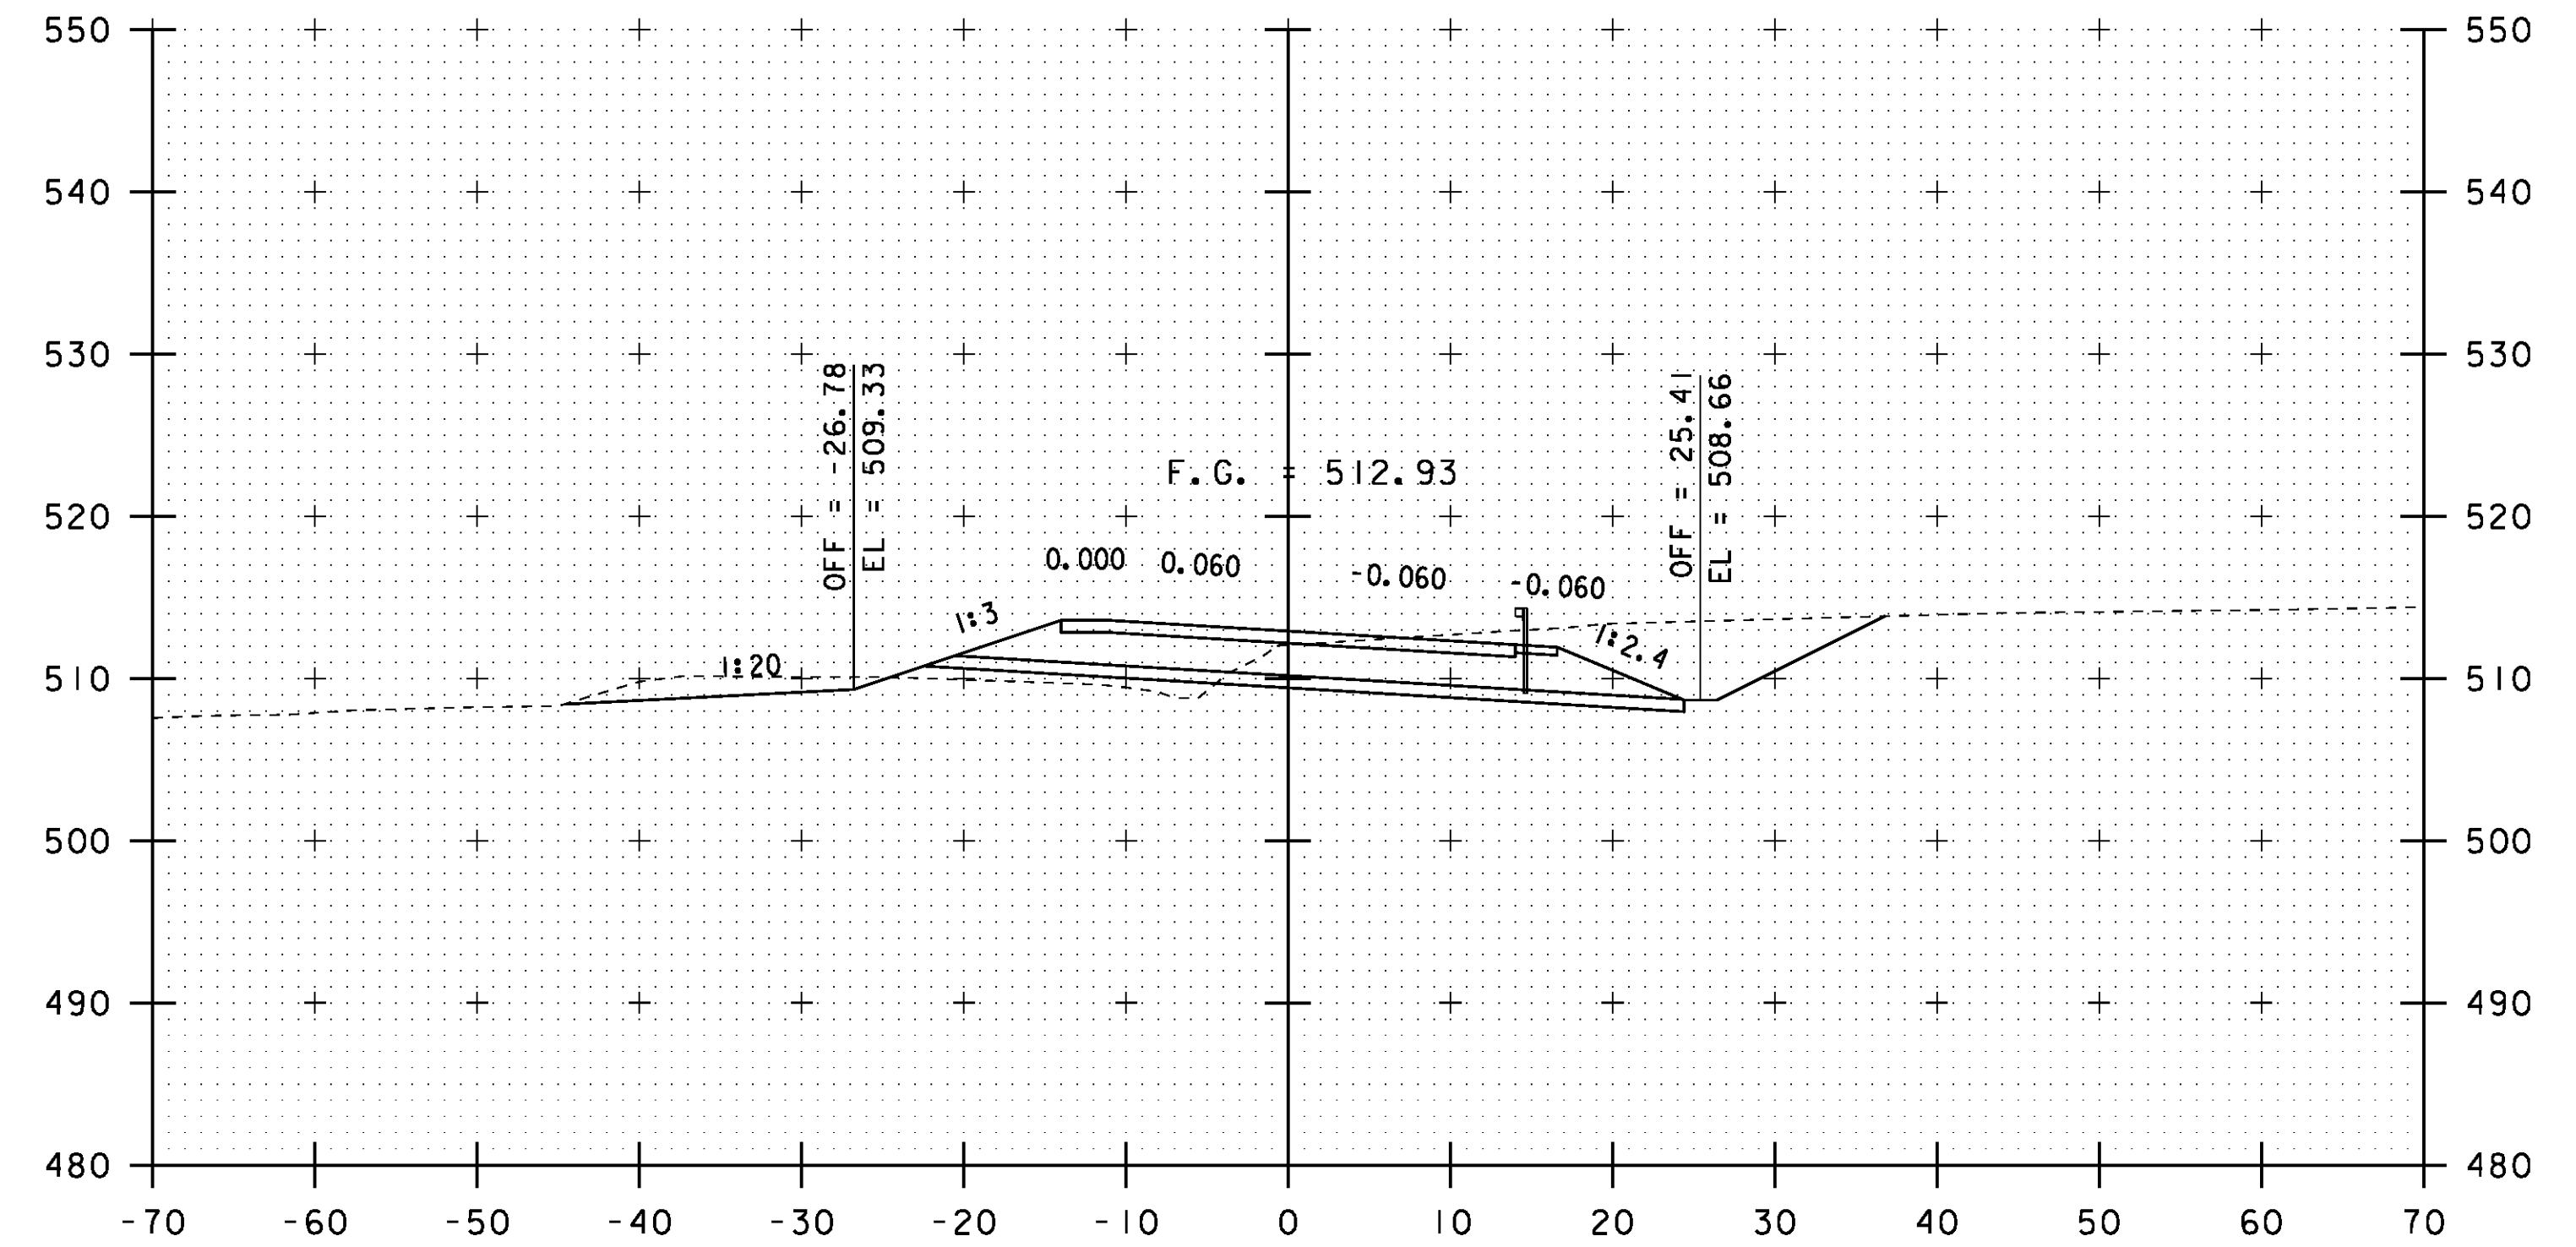


393+00

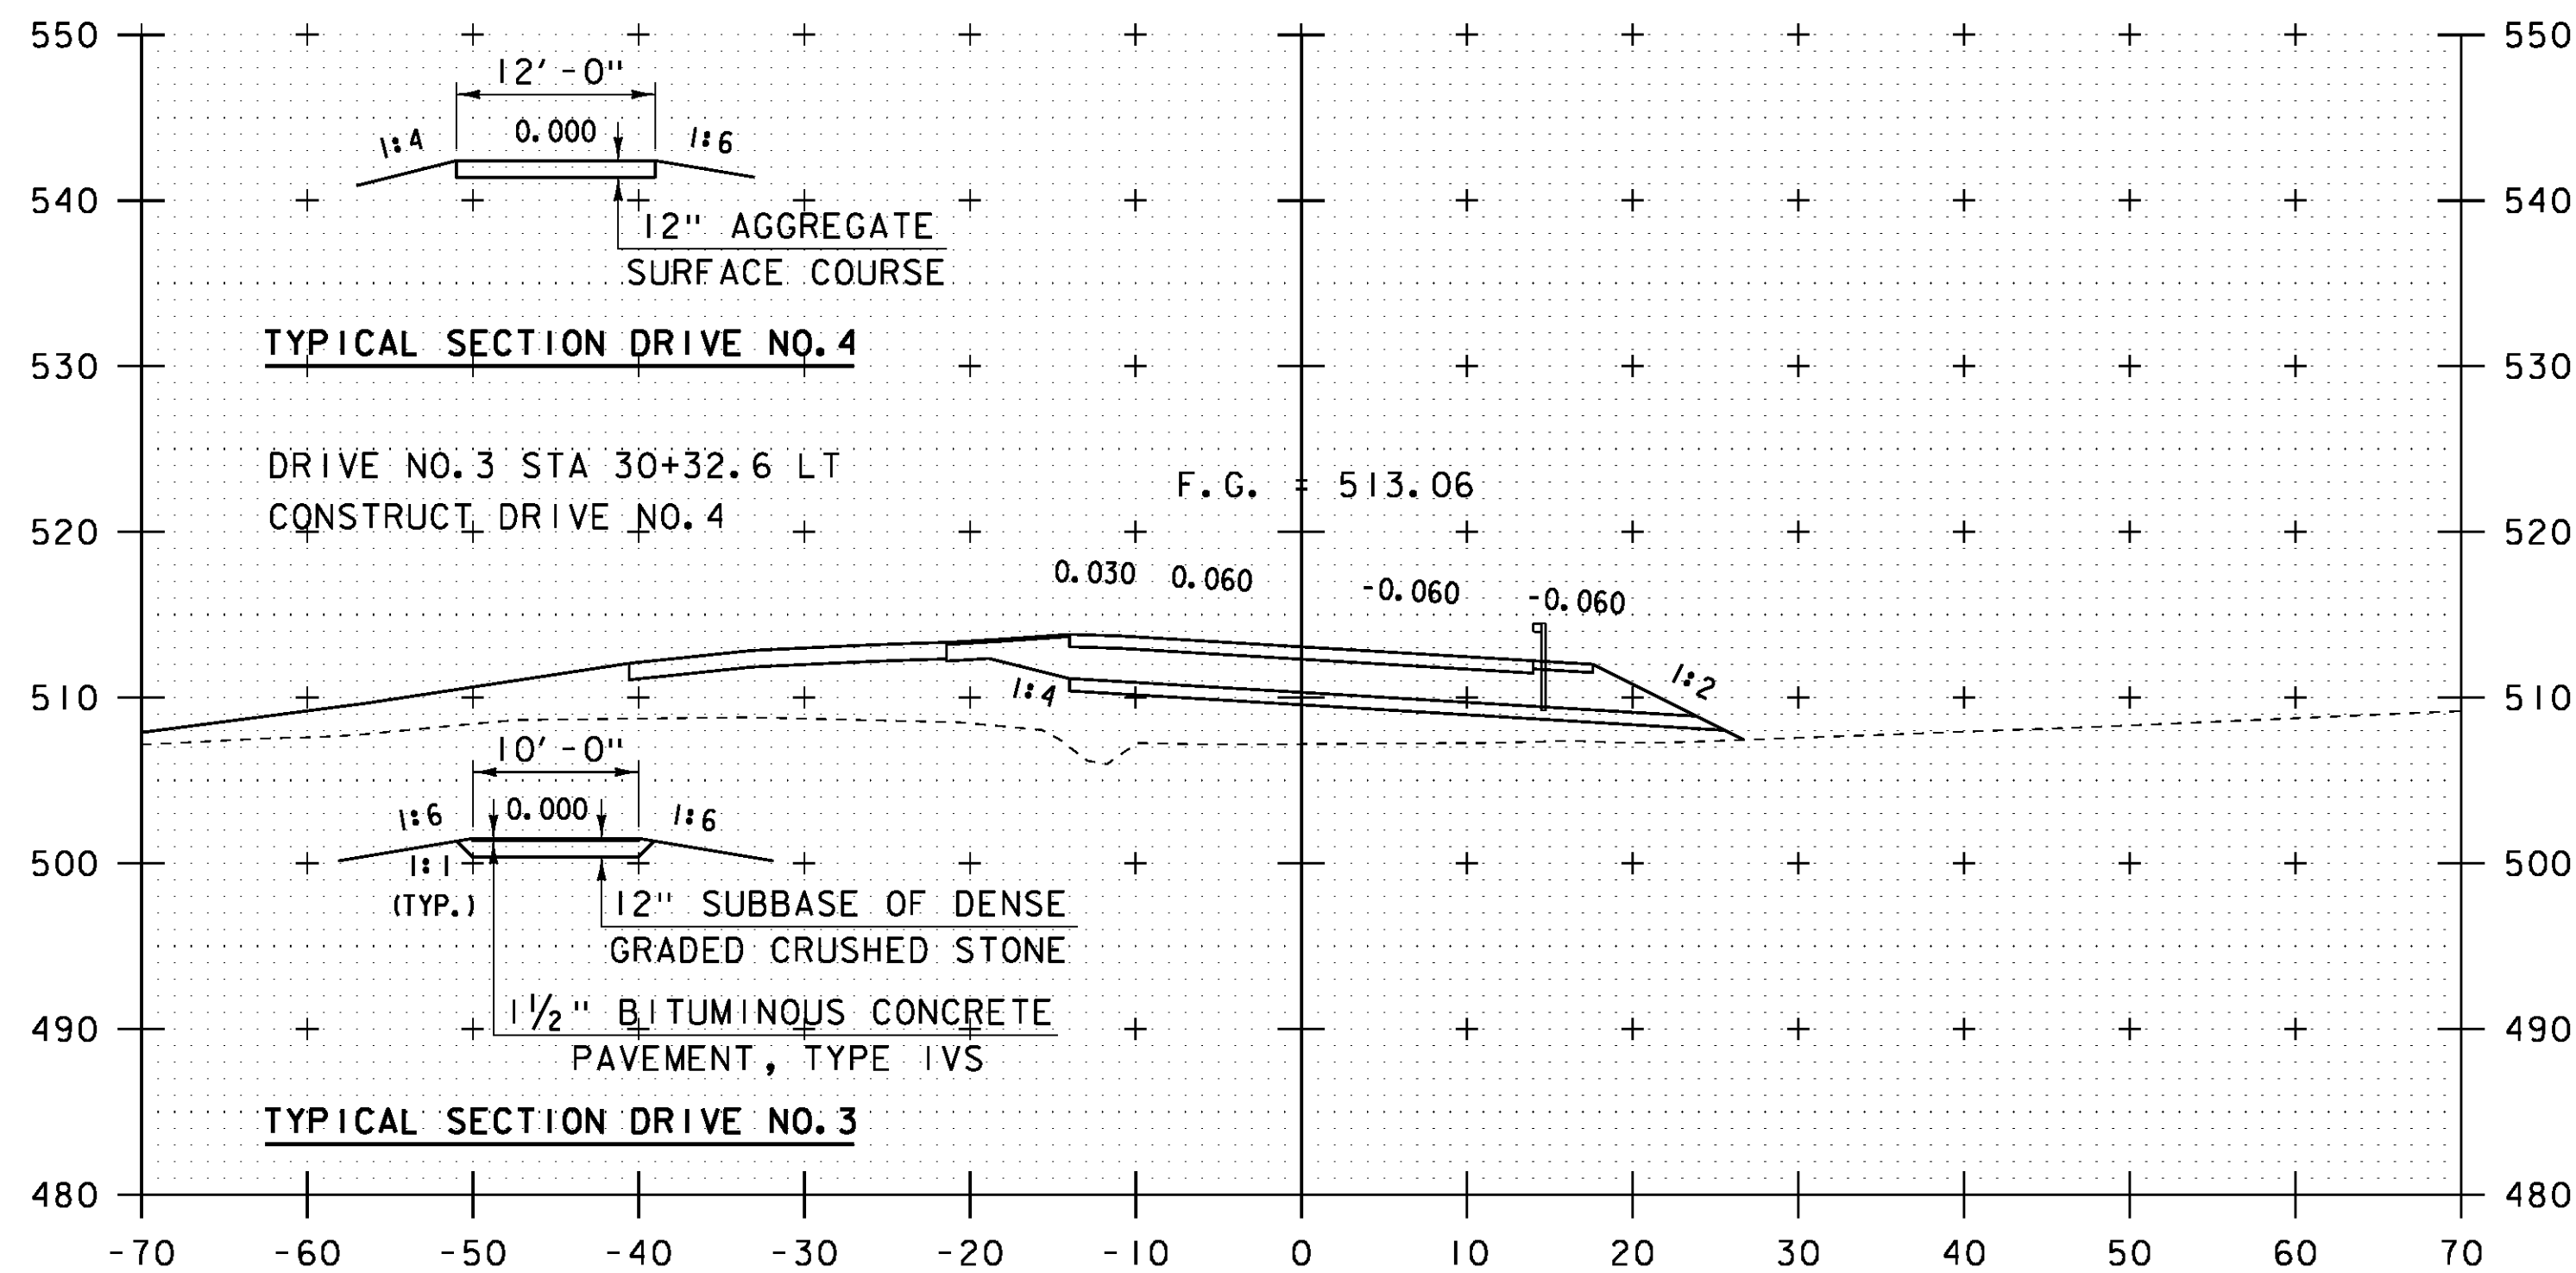


392+25

STA 392+31.5 LT  
CONSTRUCT DRIVE NO. 3

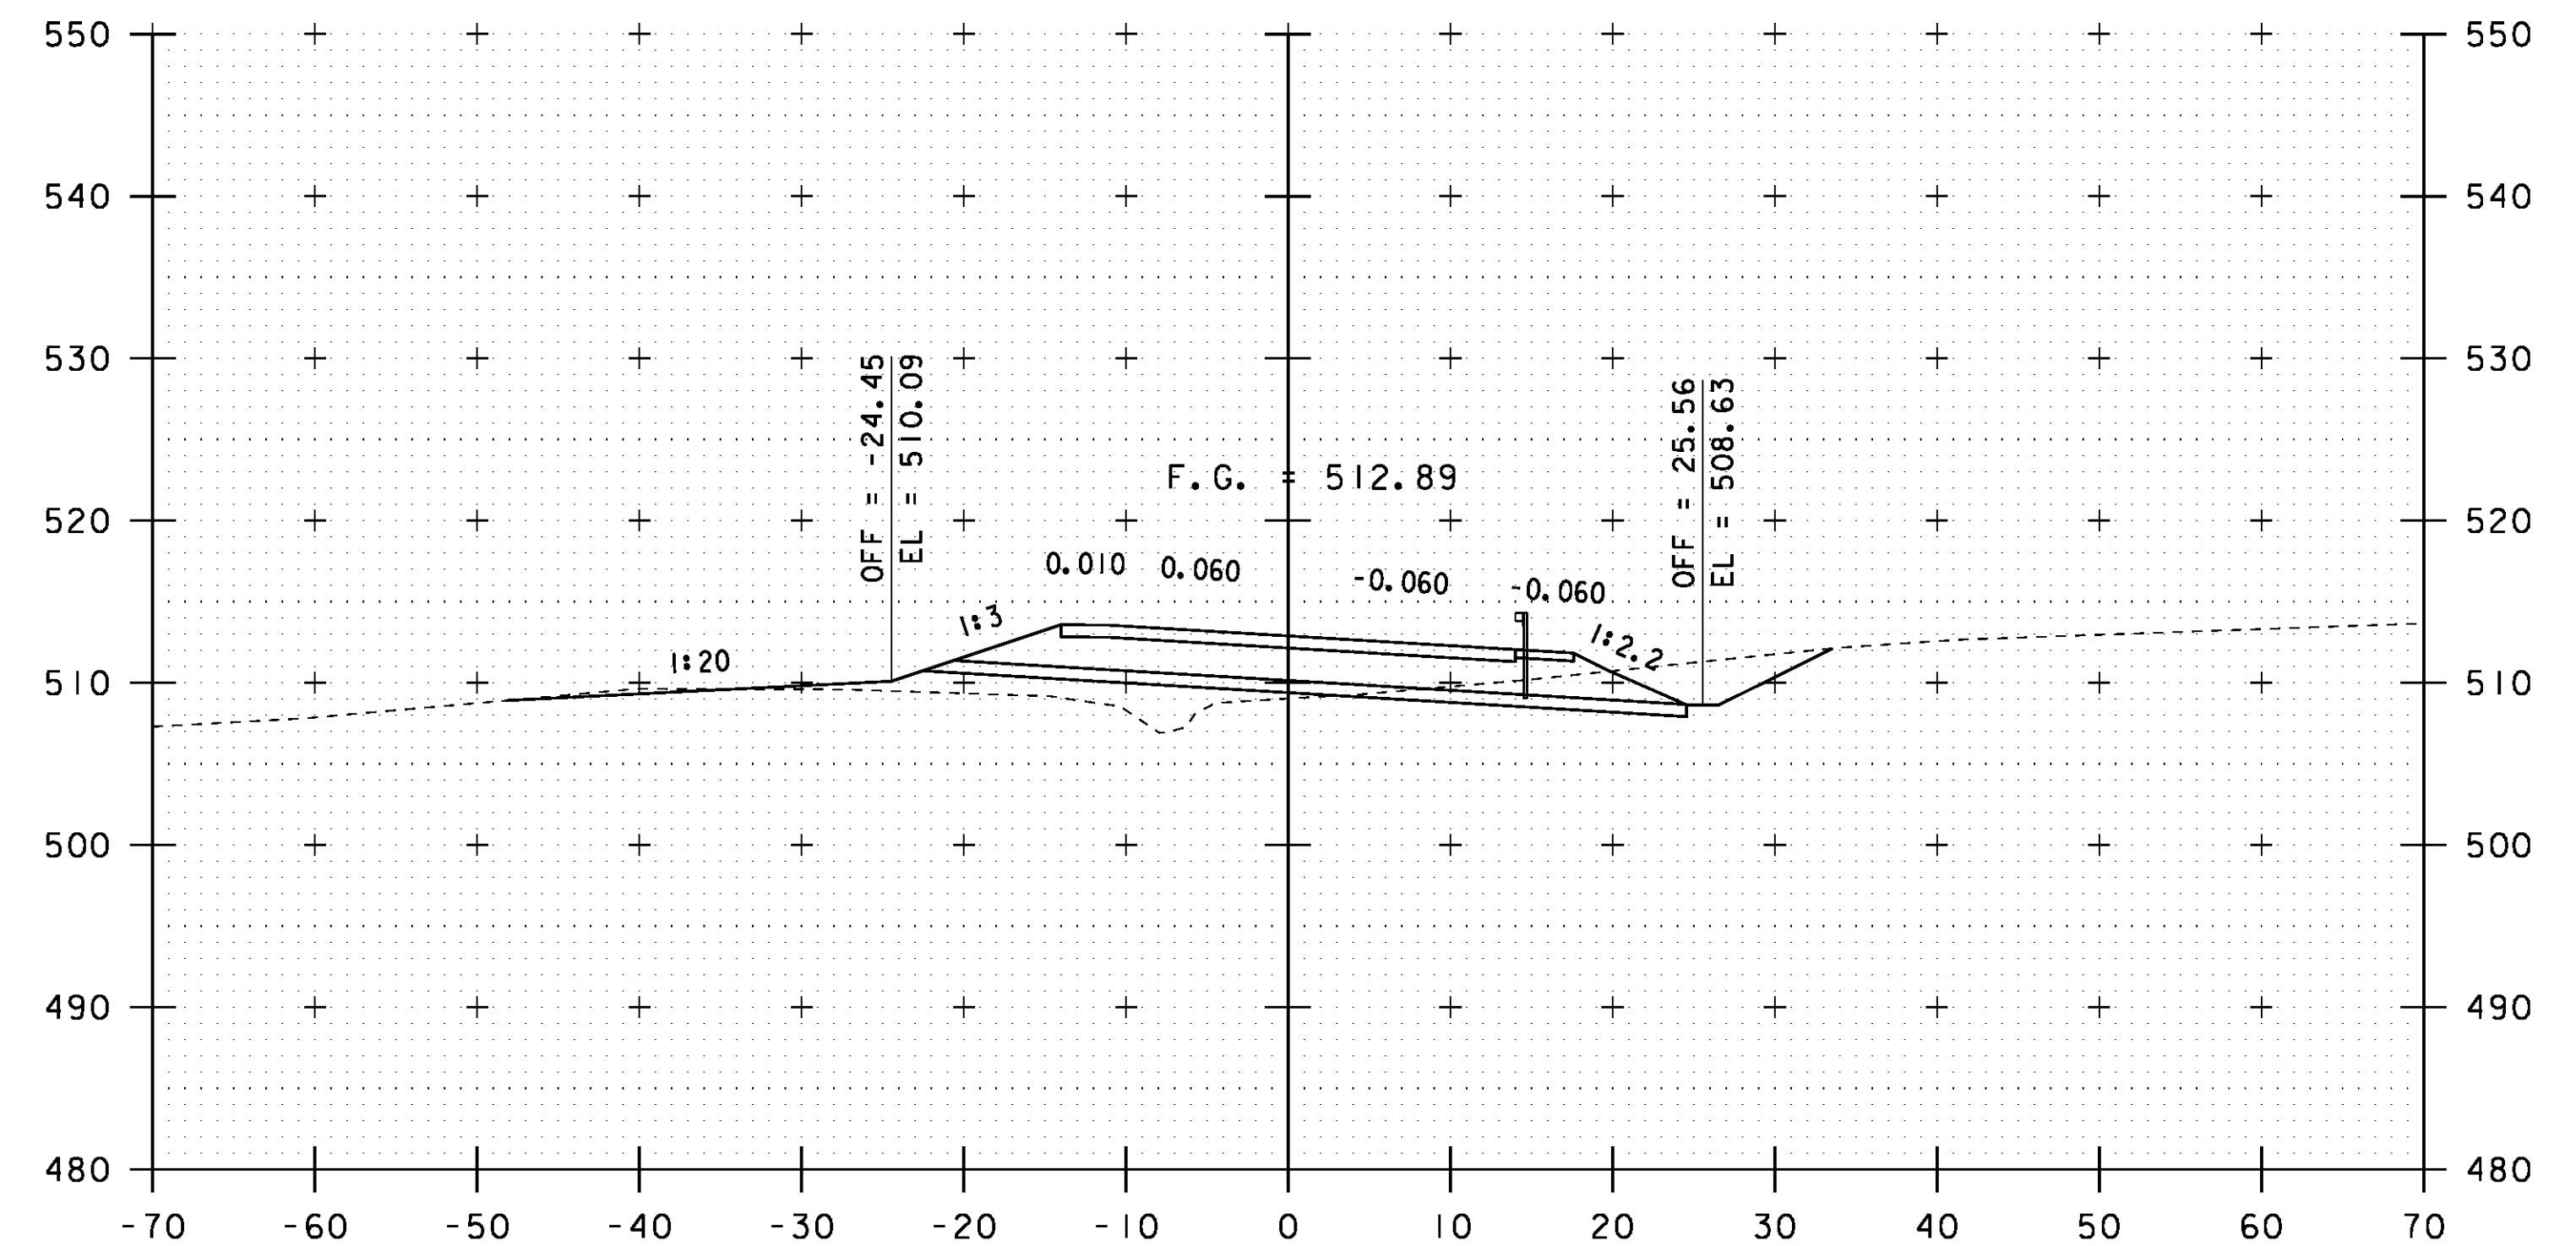


392+75

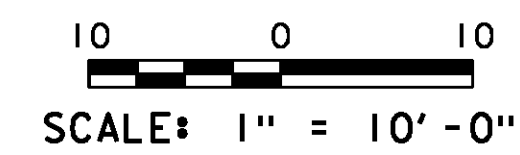


STA. 392+25 TO STA. 393+00


PROJECT NAME:	ROYALTON	FILE NAME:	\BR 27\86e055xsl.27.dgn	PLOT DATE:	08-OCT-2013
PROJECT NUMBER:	BRS 0147 (13)	PROJECT LEADER:	C. CARLSON	DRAWN BY:	G. ROY
		DESIGNED BY:	G. ROY	CHECKED BY:	D. PETERSON
		BRIDGE 27 VT 14 CROSS SECTIONS (8)		SHEET	58 OF 186

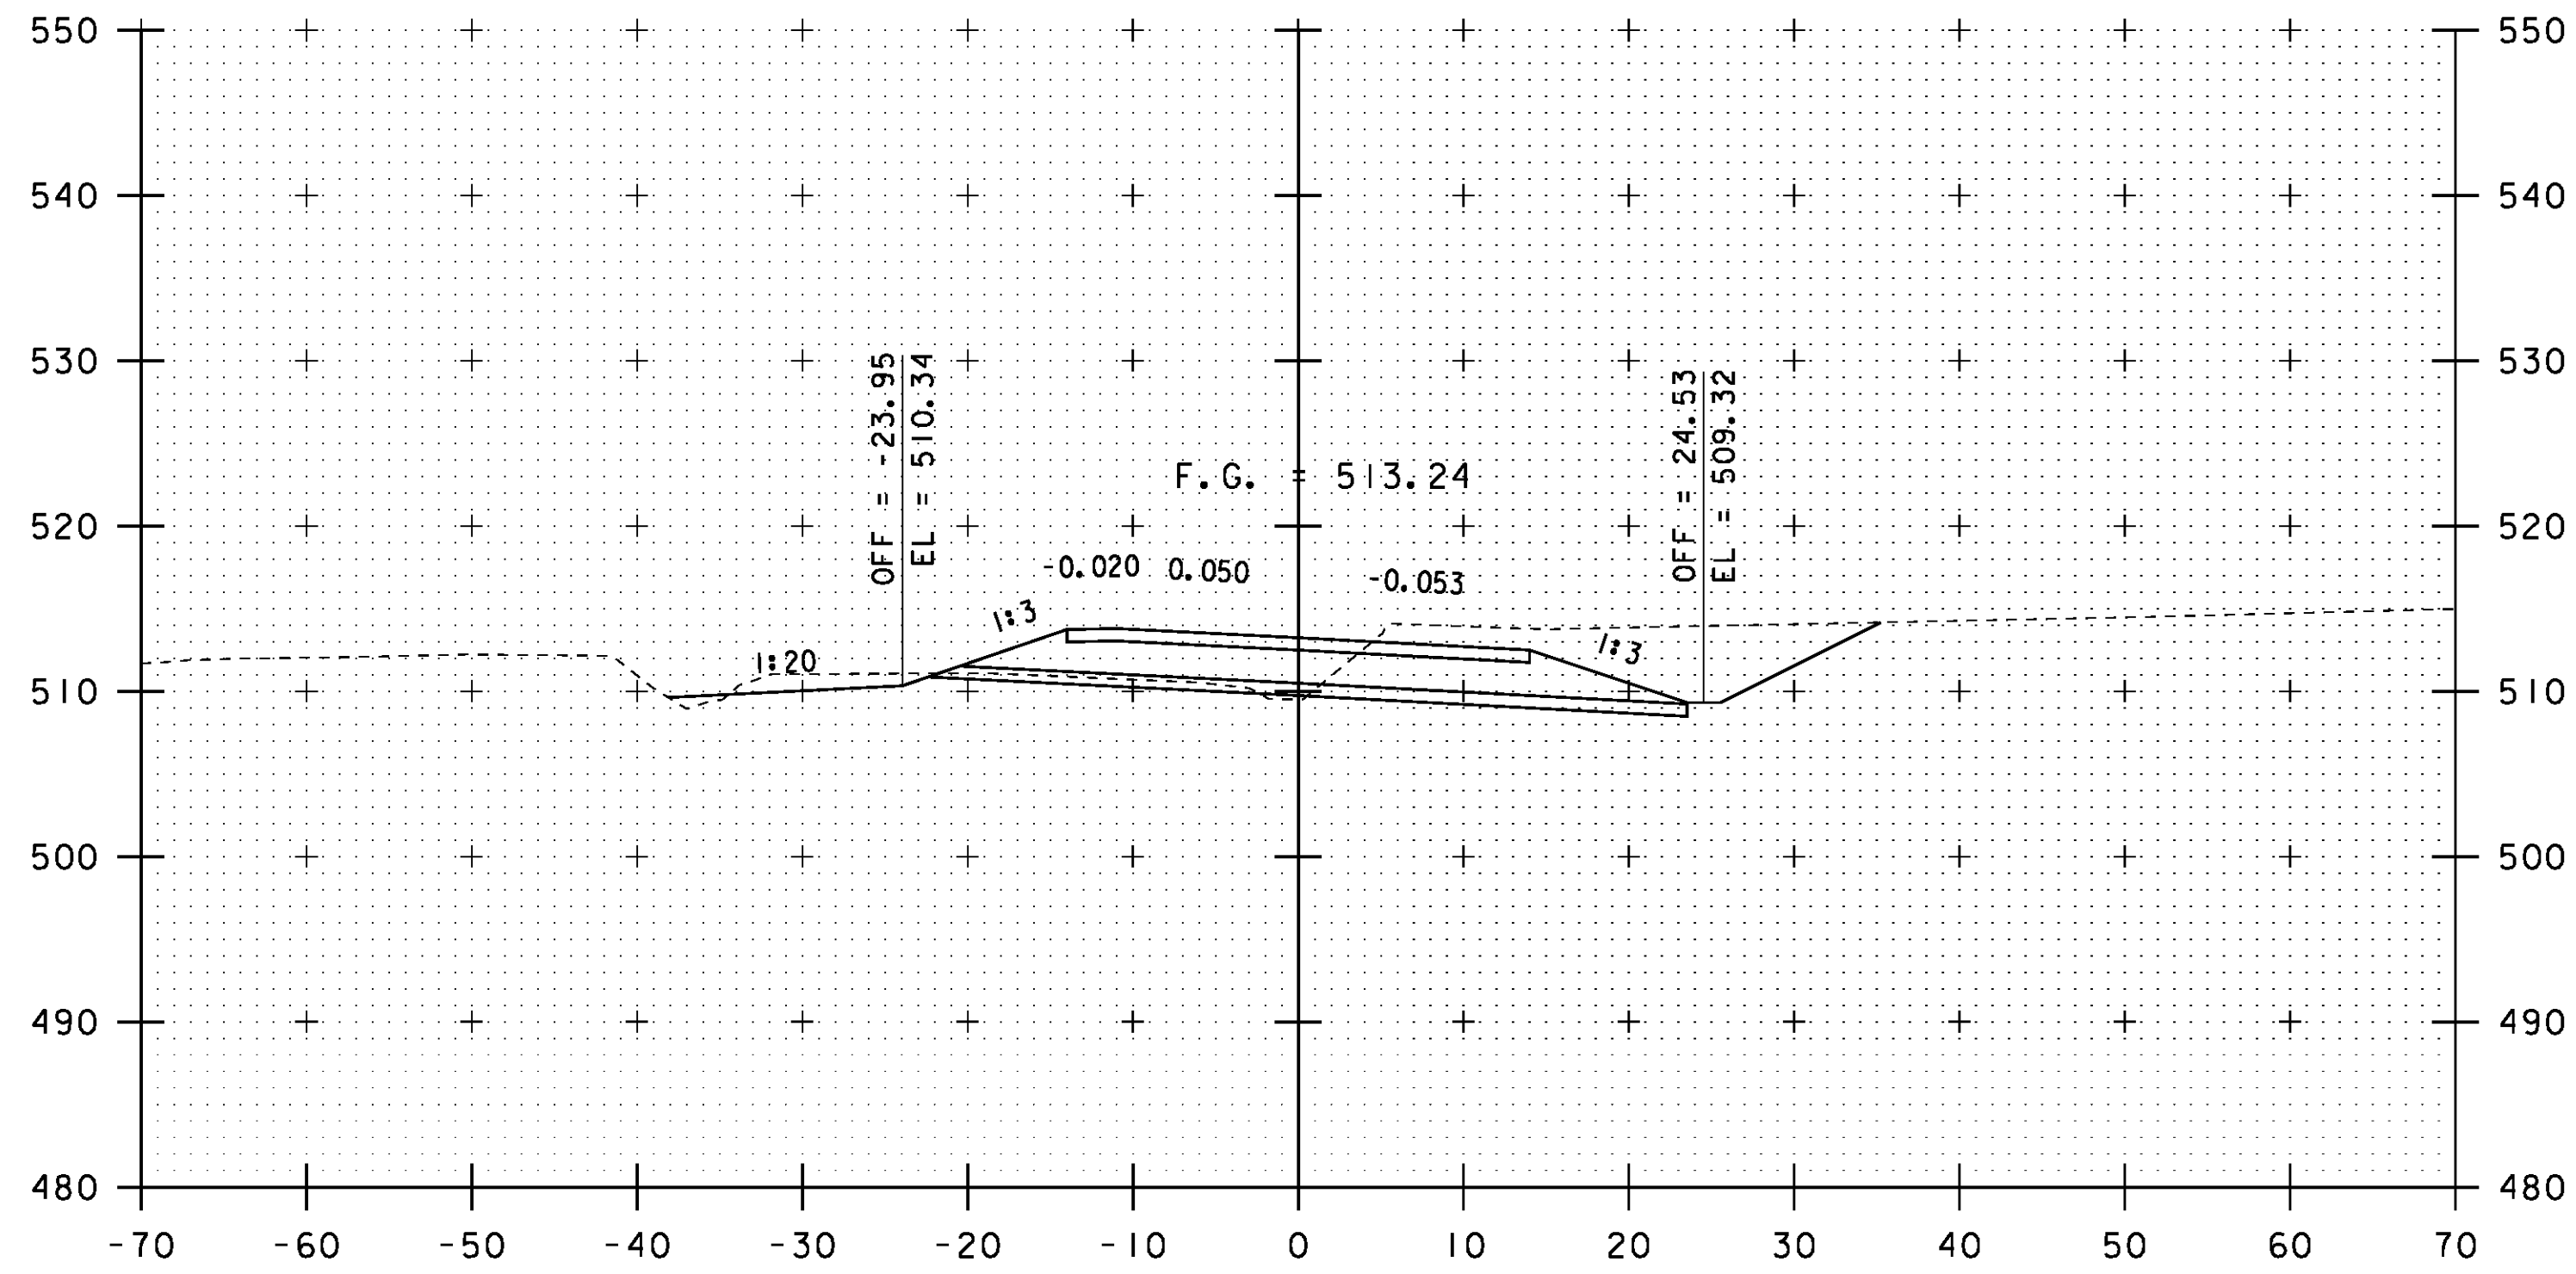


393+50

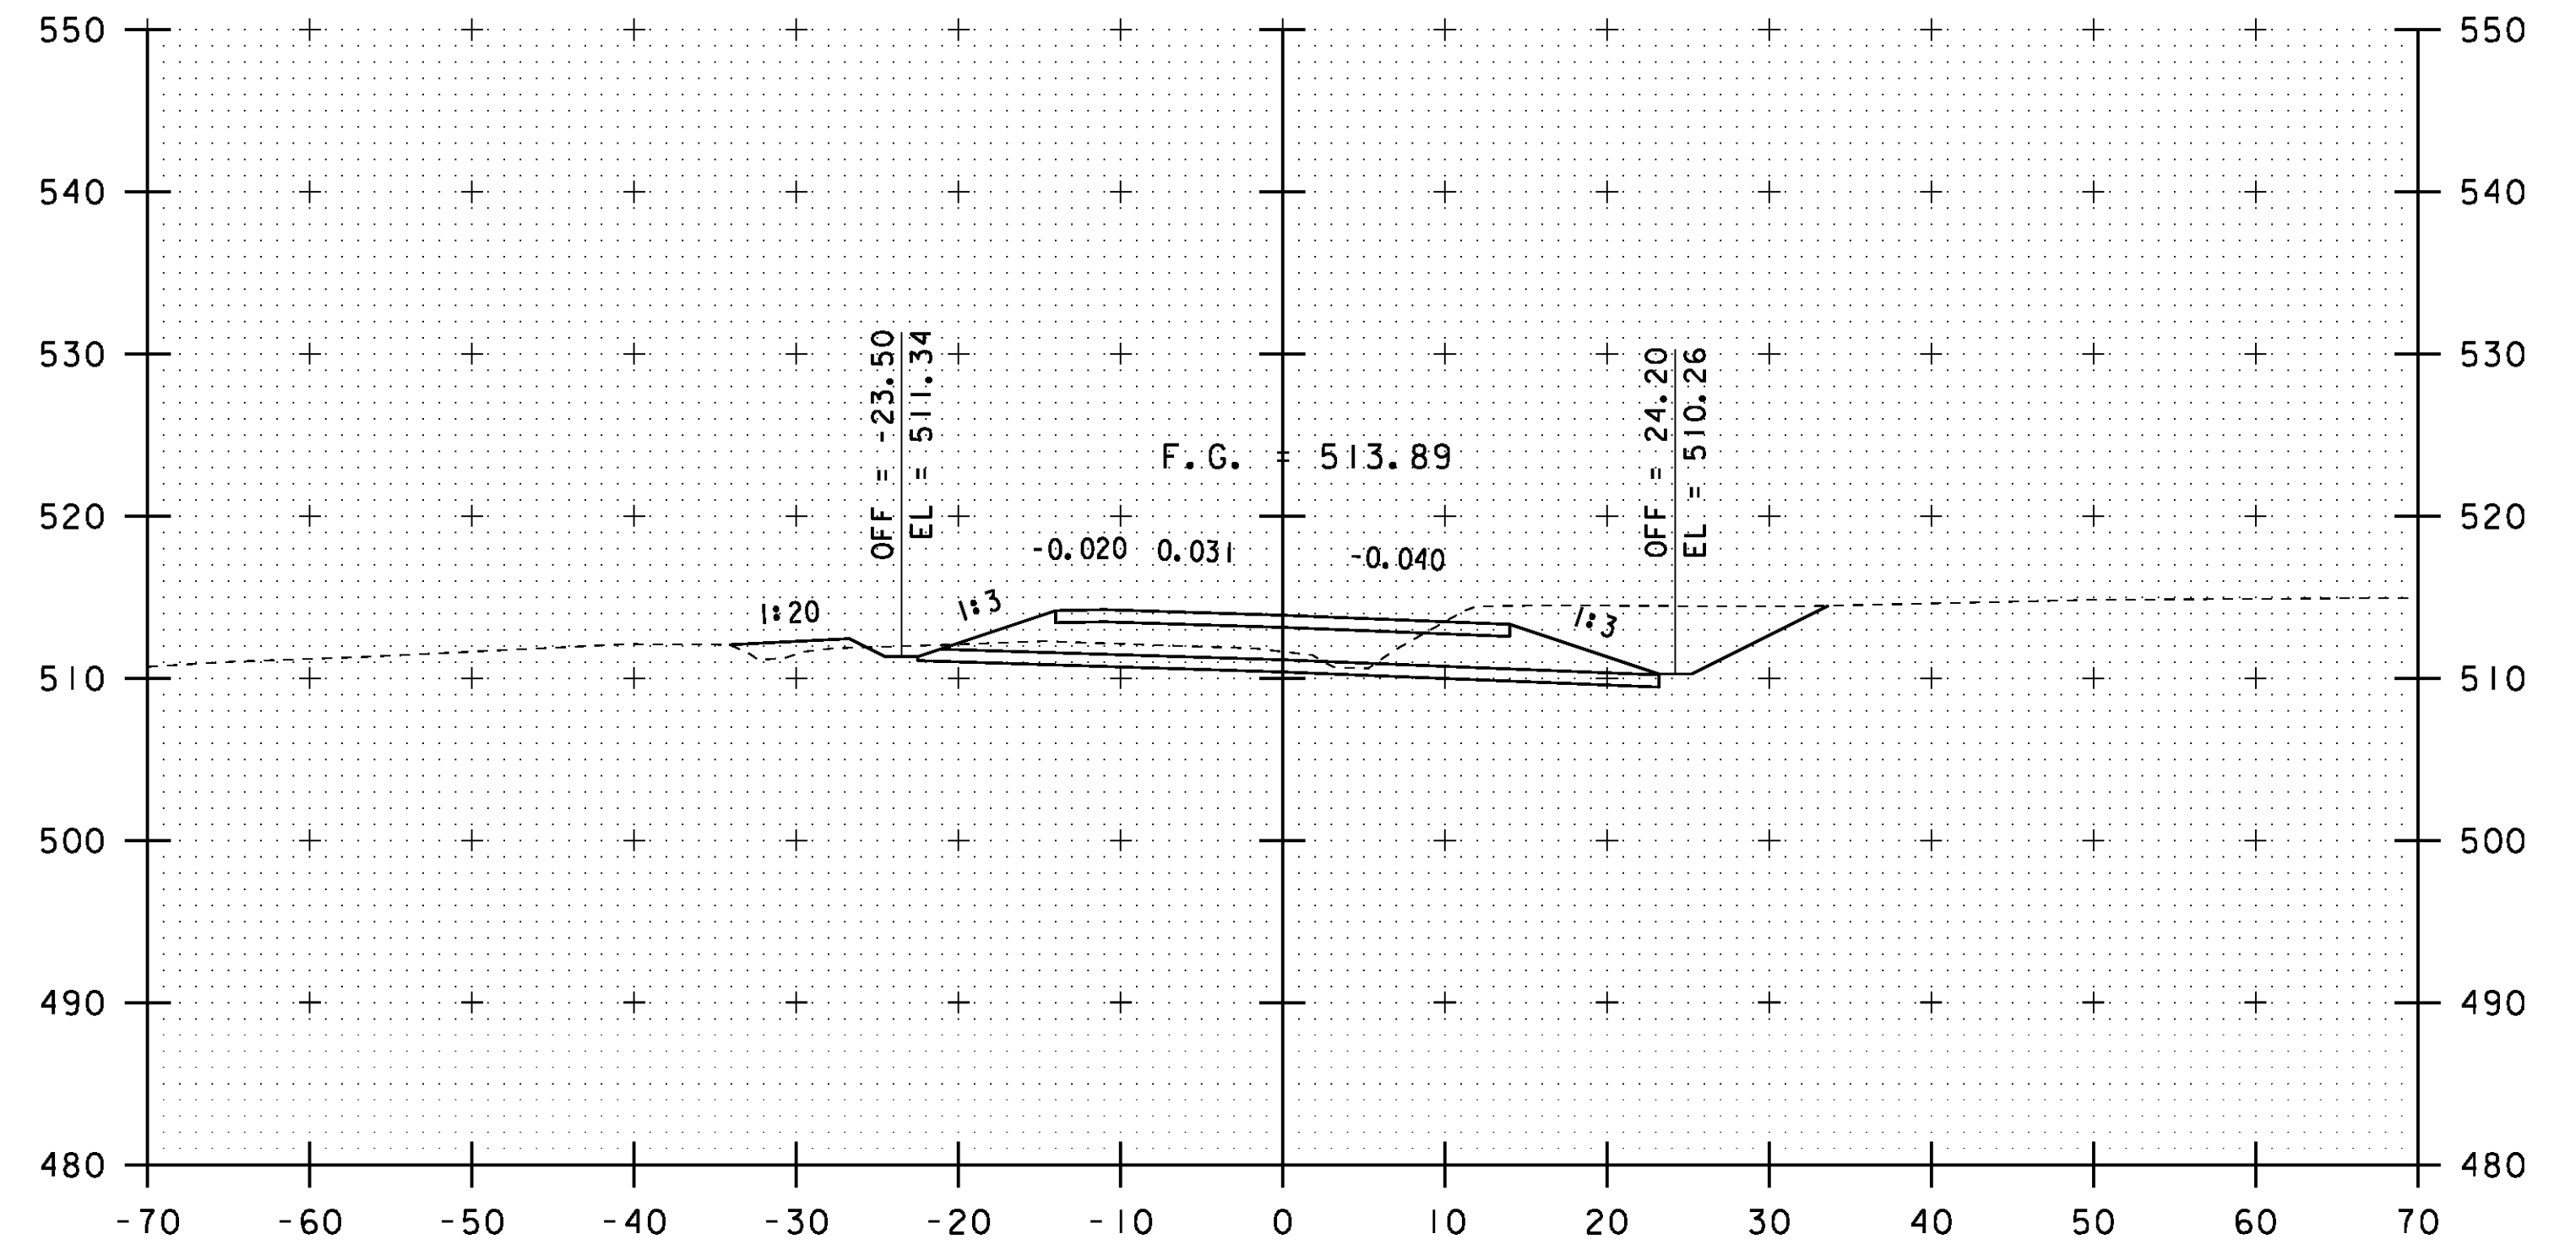

394+00

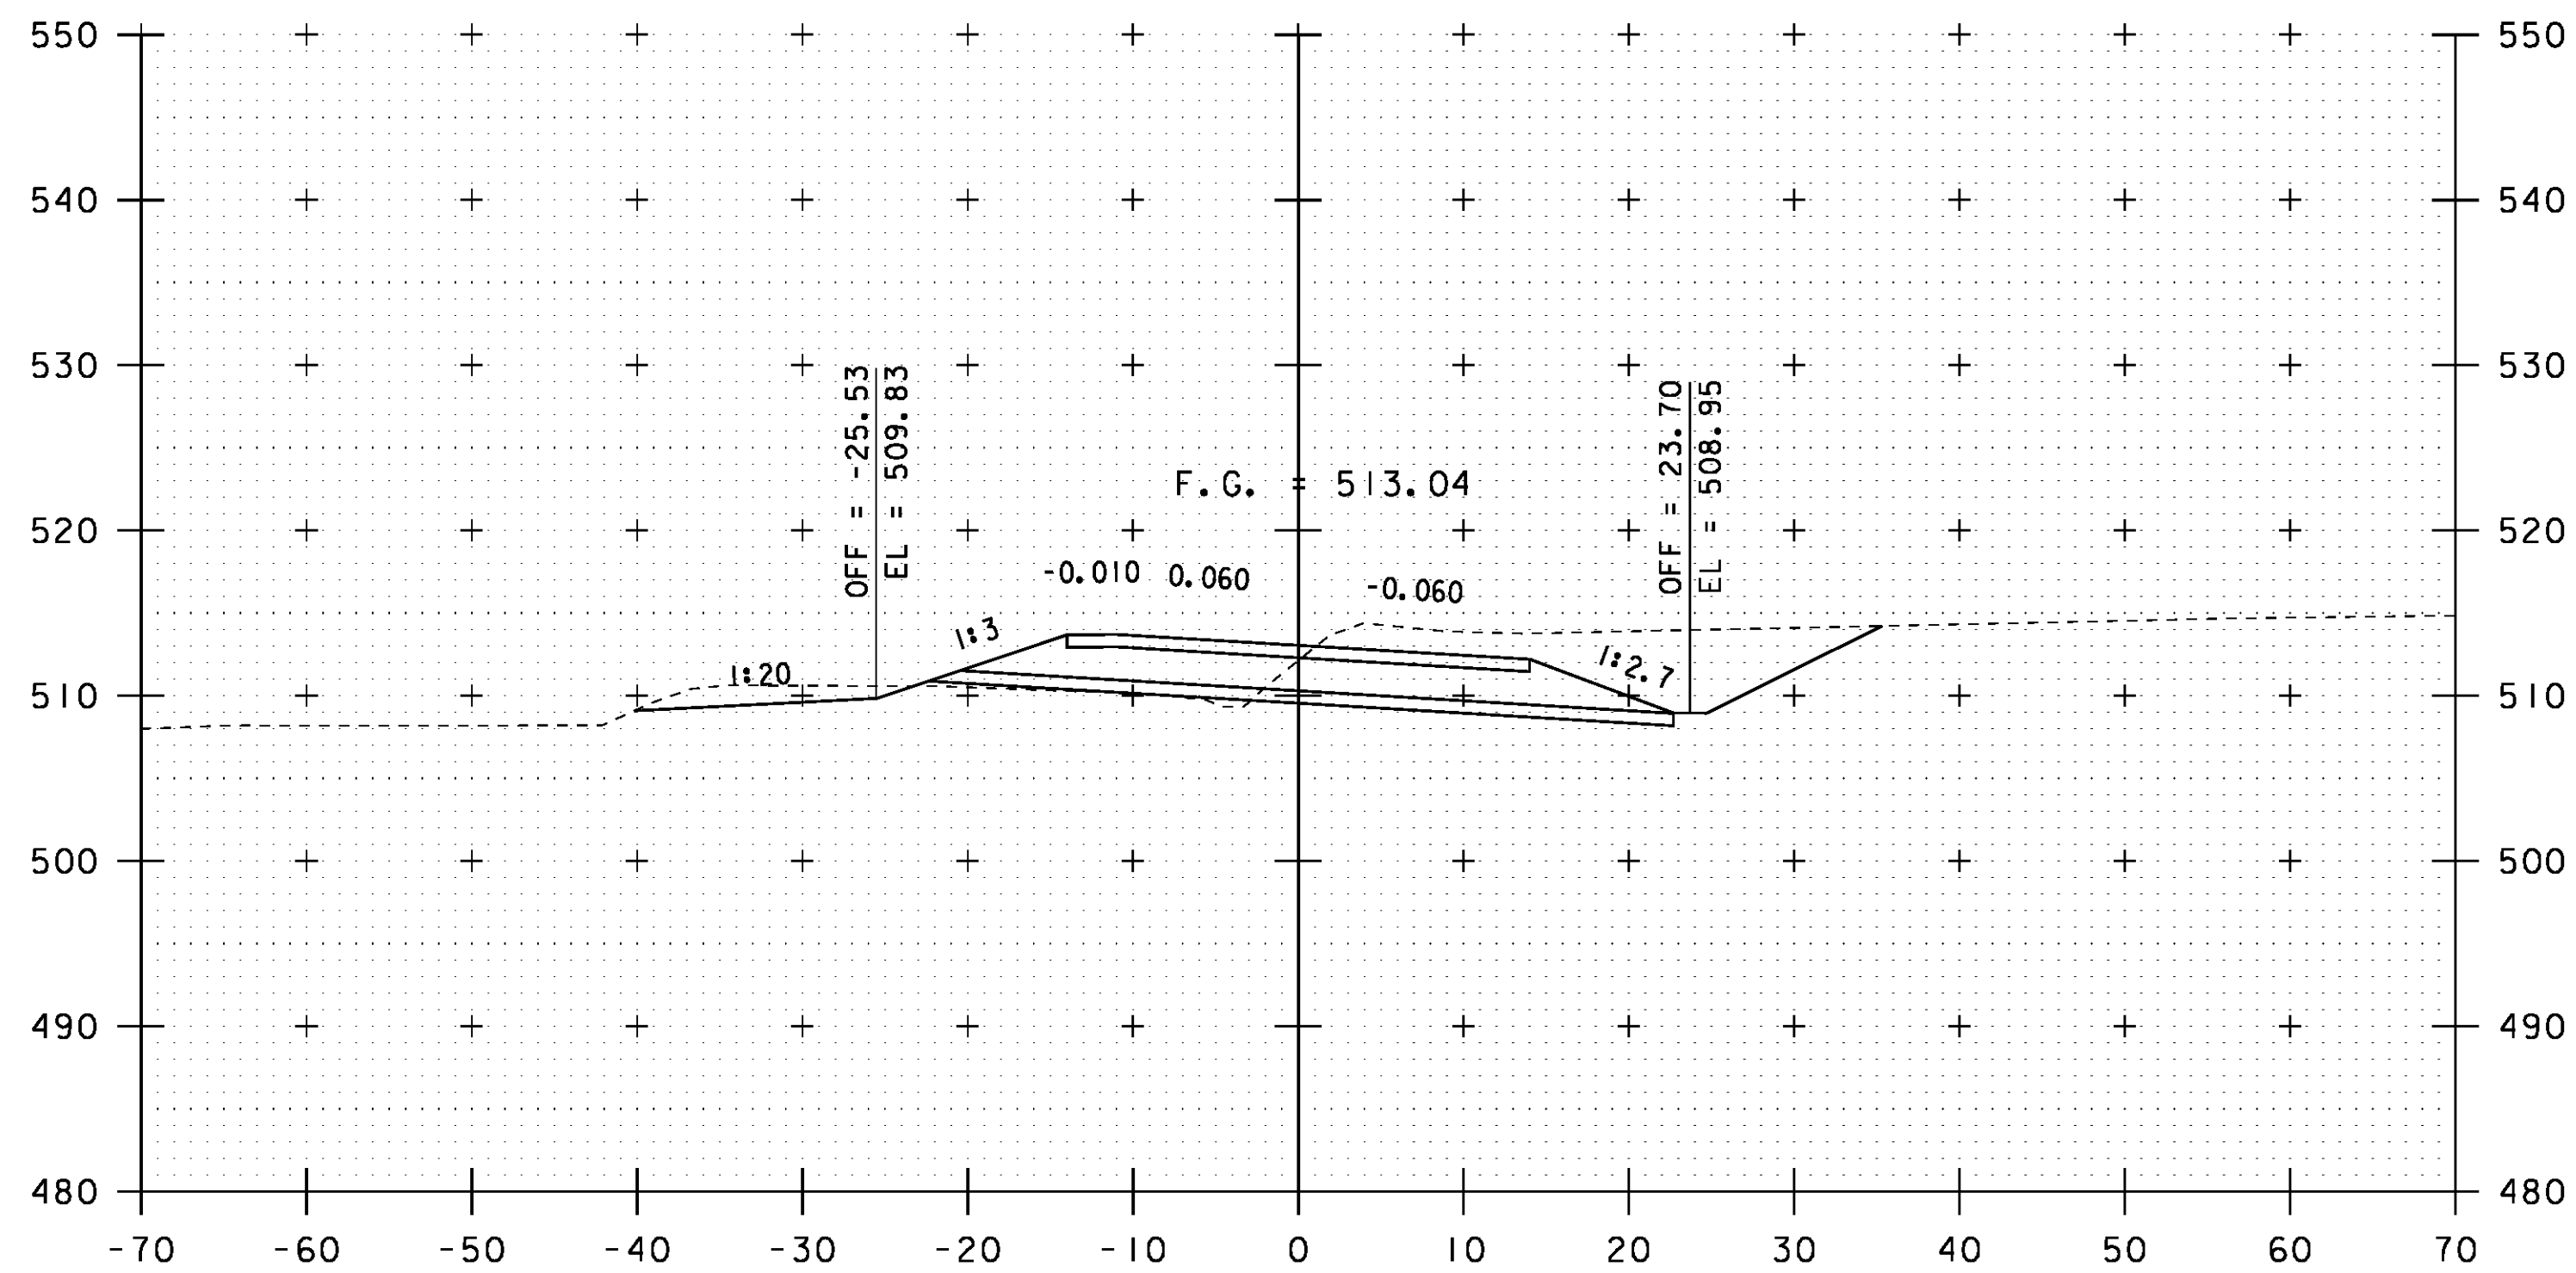


393+25

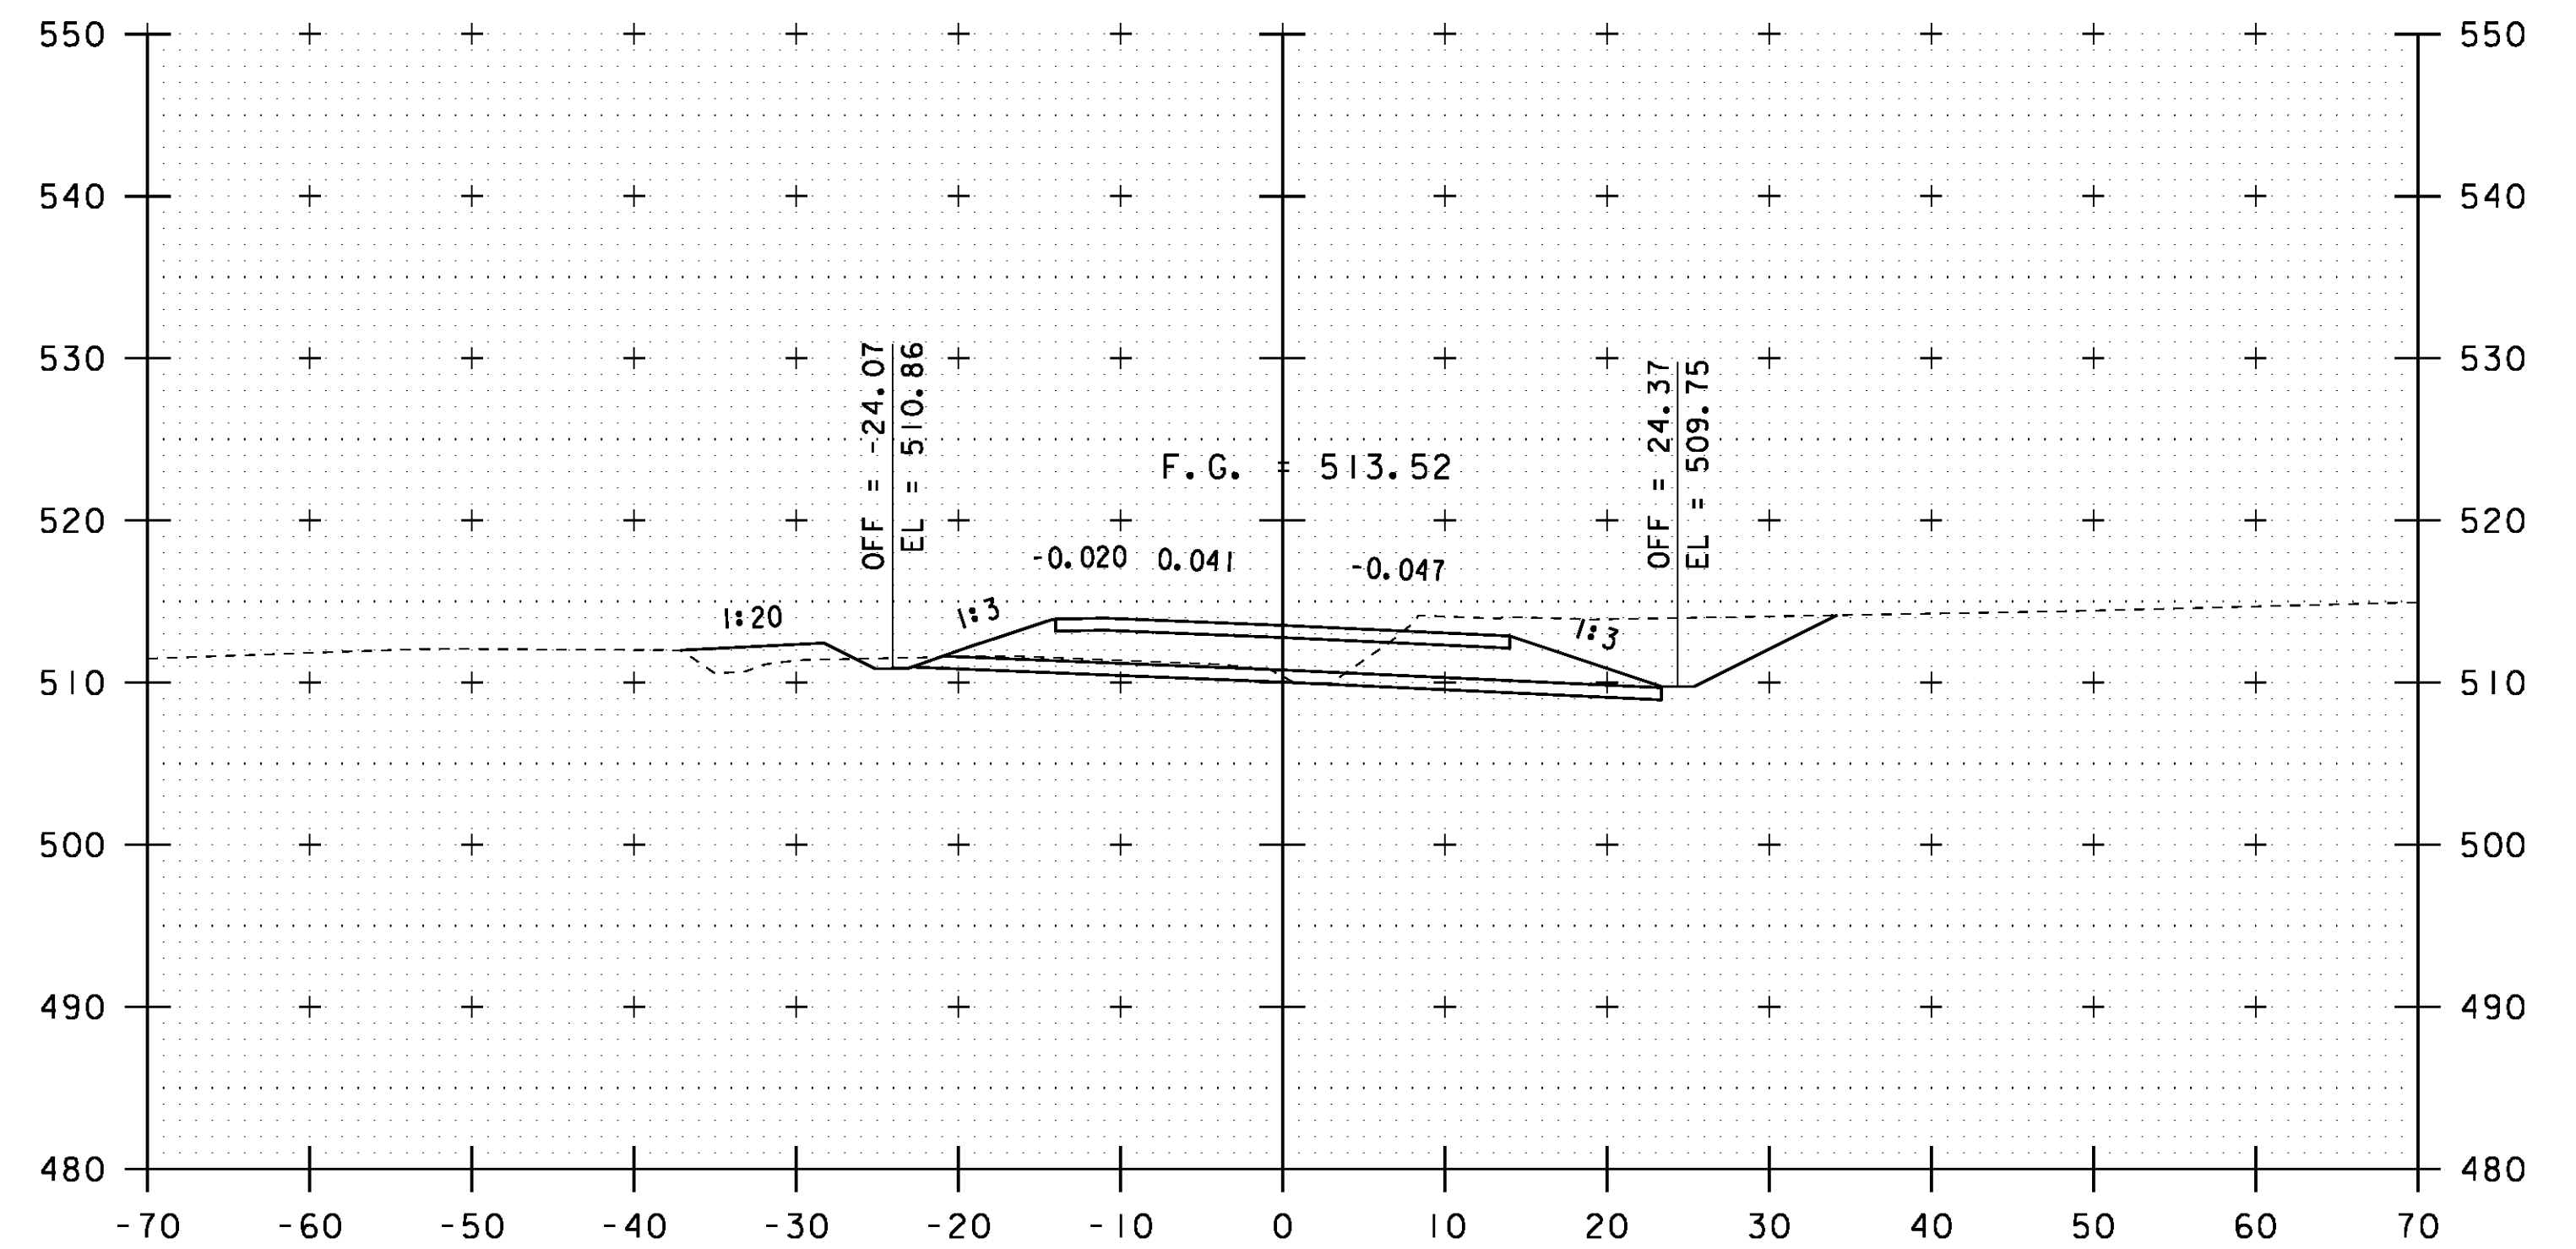

393+75


STA 393+75.0 LT - STA 395+75.0 LT  
 CONSTRUCT NEW GRASS-LINED DITCH

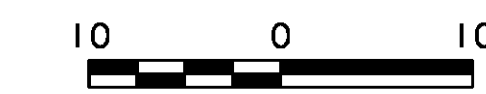

SCALE: 1" = 10'-0"


STA. 393+25 TO STA. 394+00

PROJECT NAME:	ROYALTON	FILE NAME:	\BR 27\86e055xsl.27.dgn	PLOT DATE:	08-OCT-2013
PROJECT NUMBER:	BRS 0147 (13)	PROJECT LEADER:	C. CARLSON	DRAWN BY:	G. ROY
		DESIGNED BY:	G. ROY	CHECKED BY:	D. PETERSON
		BRIDGE 27 VT 14 CROSS SECTIONS (9)		SHEET	59 OF 186

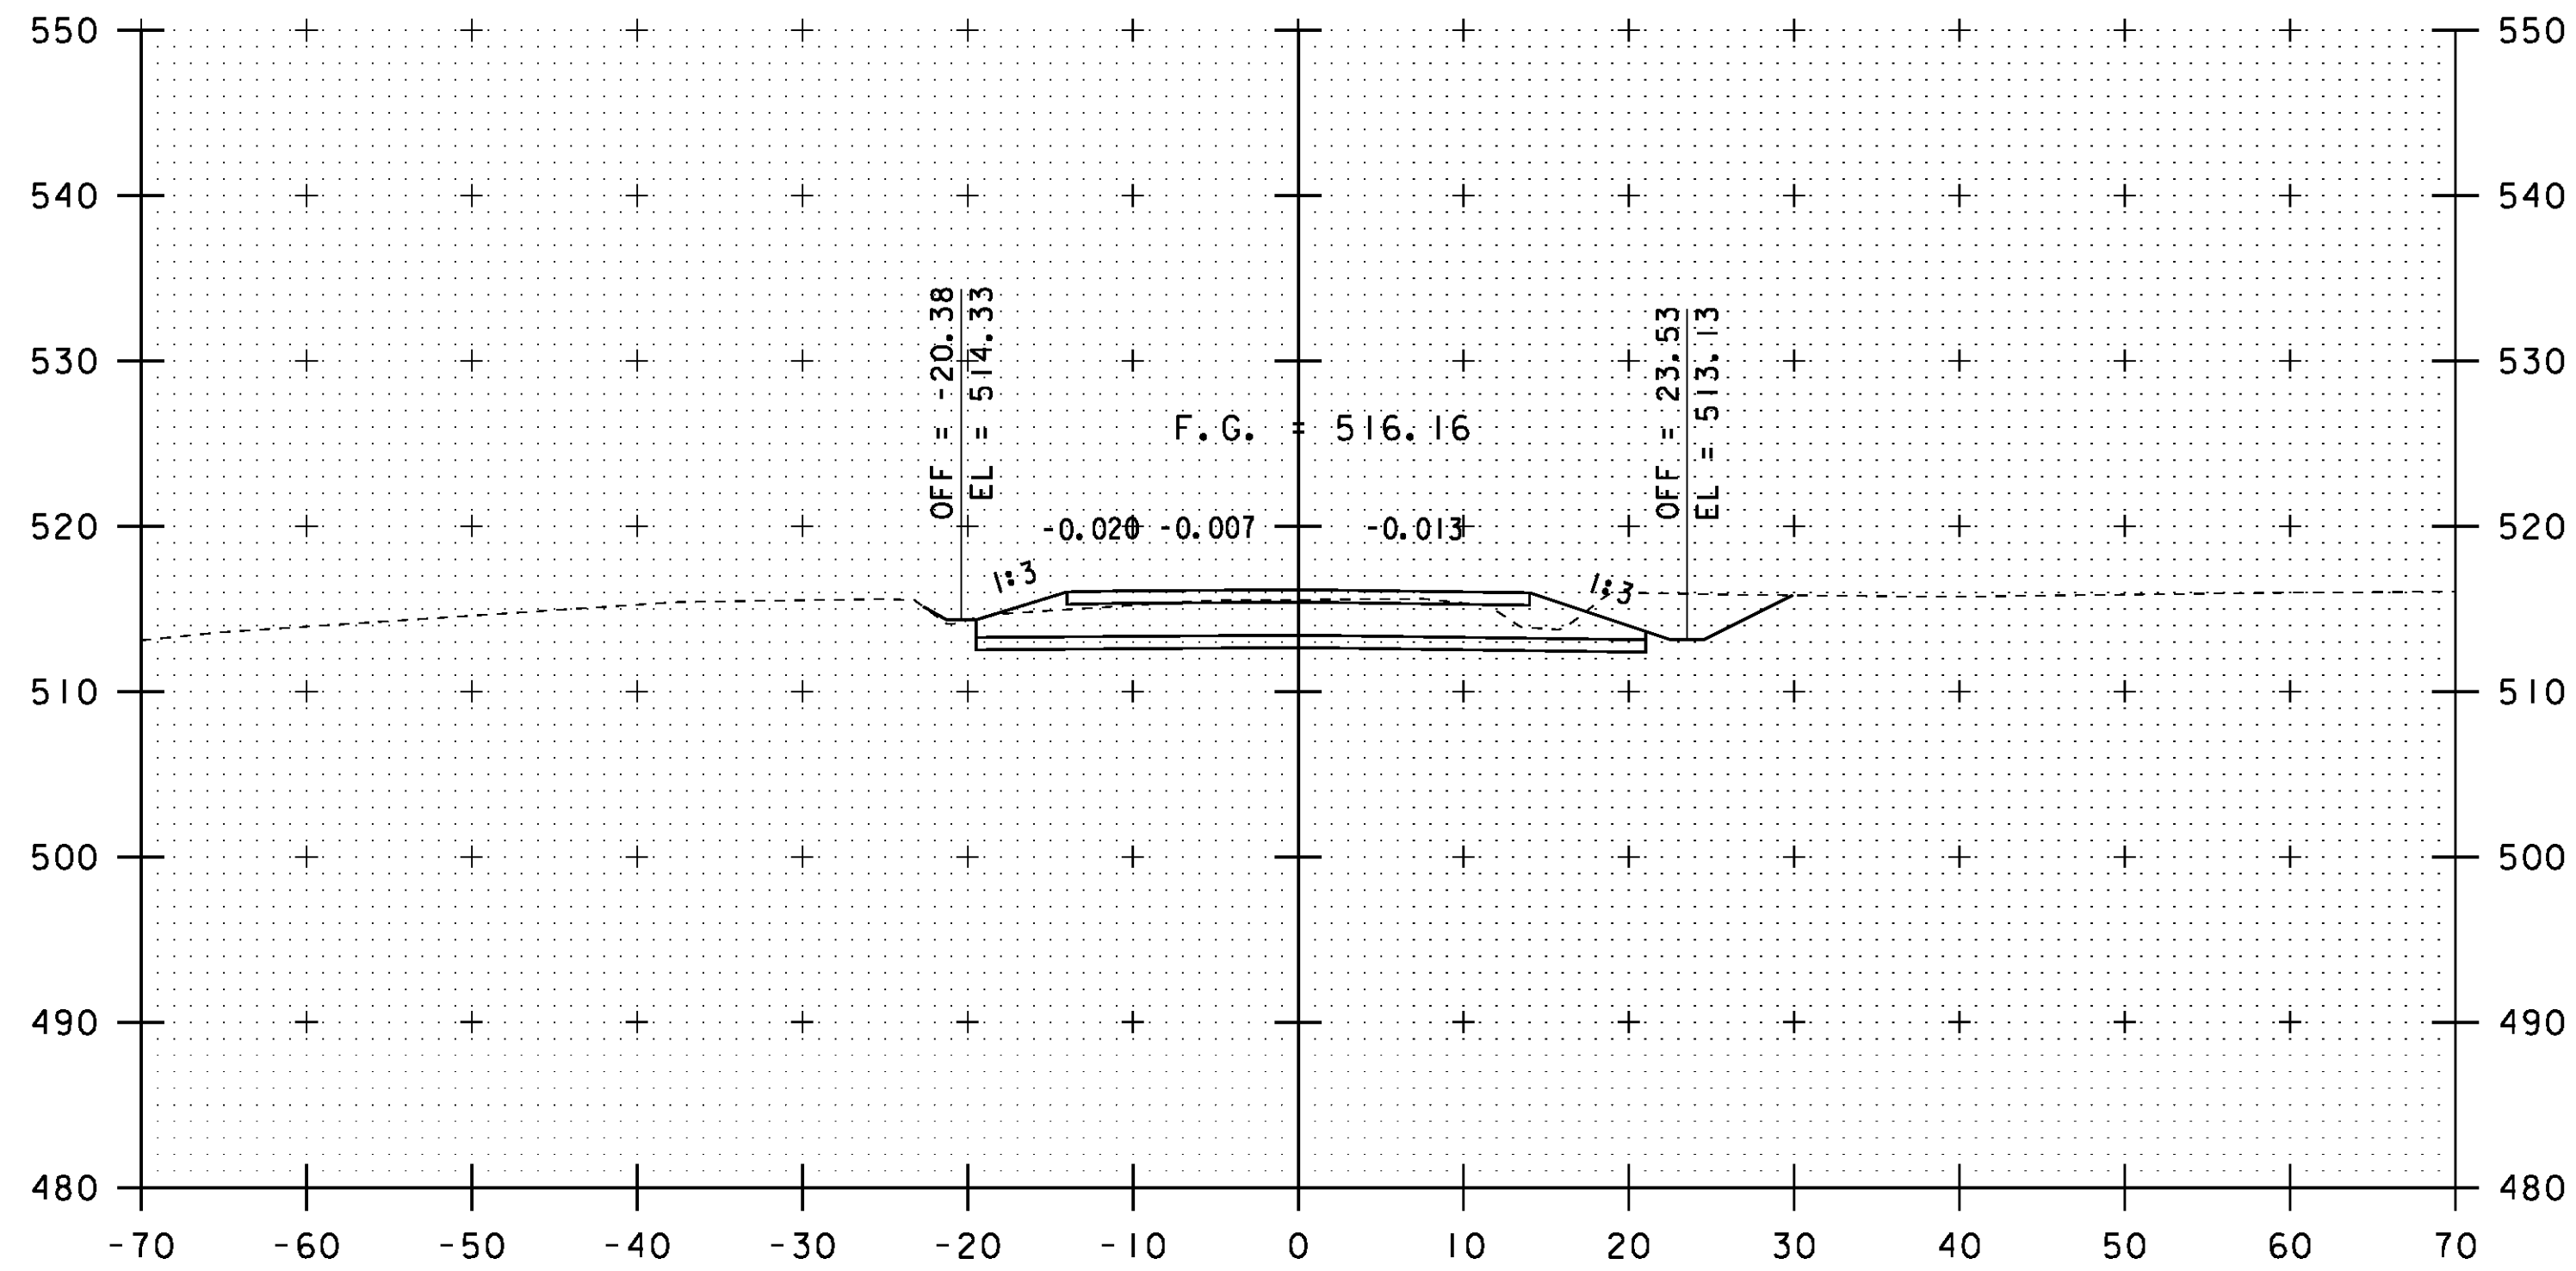


395+00


STA 395+05.00  
END FULL DEPTH ROADWAY  
BEGIN APPROACH

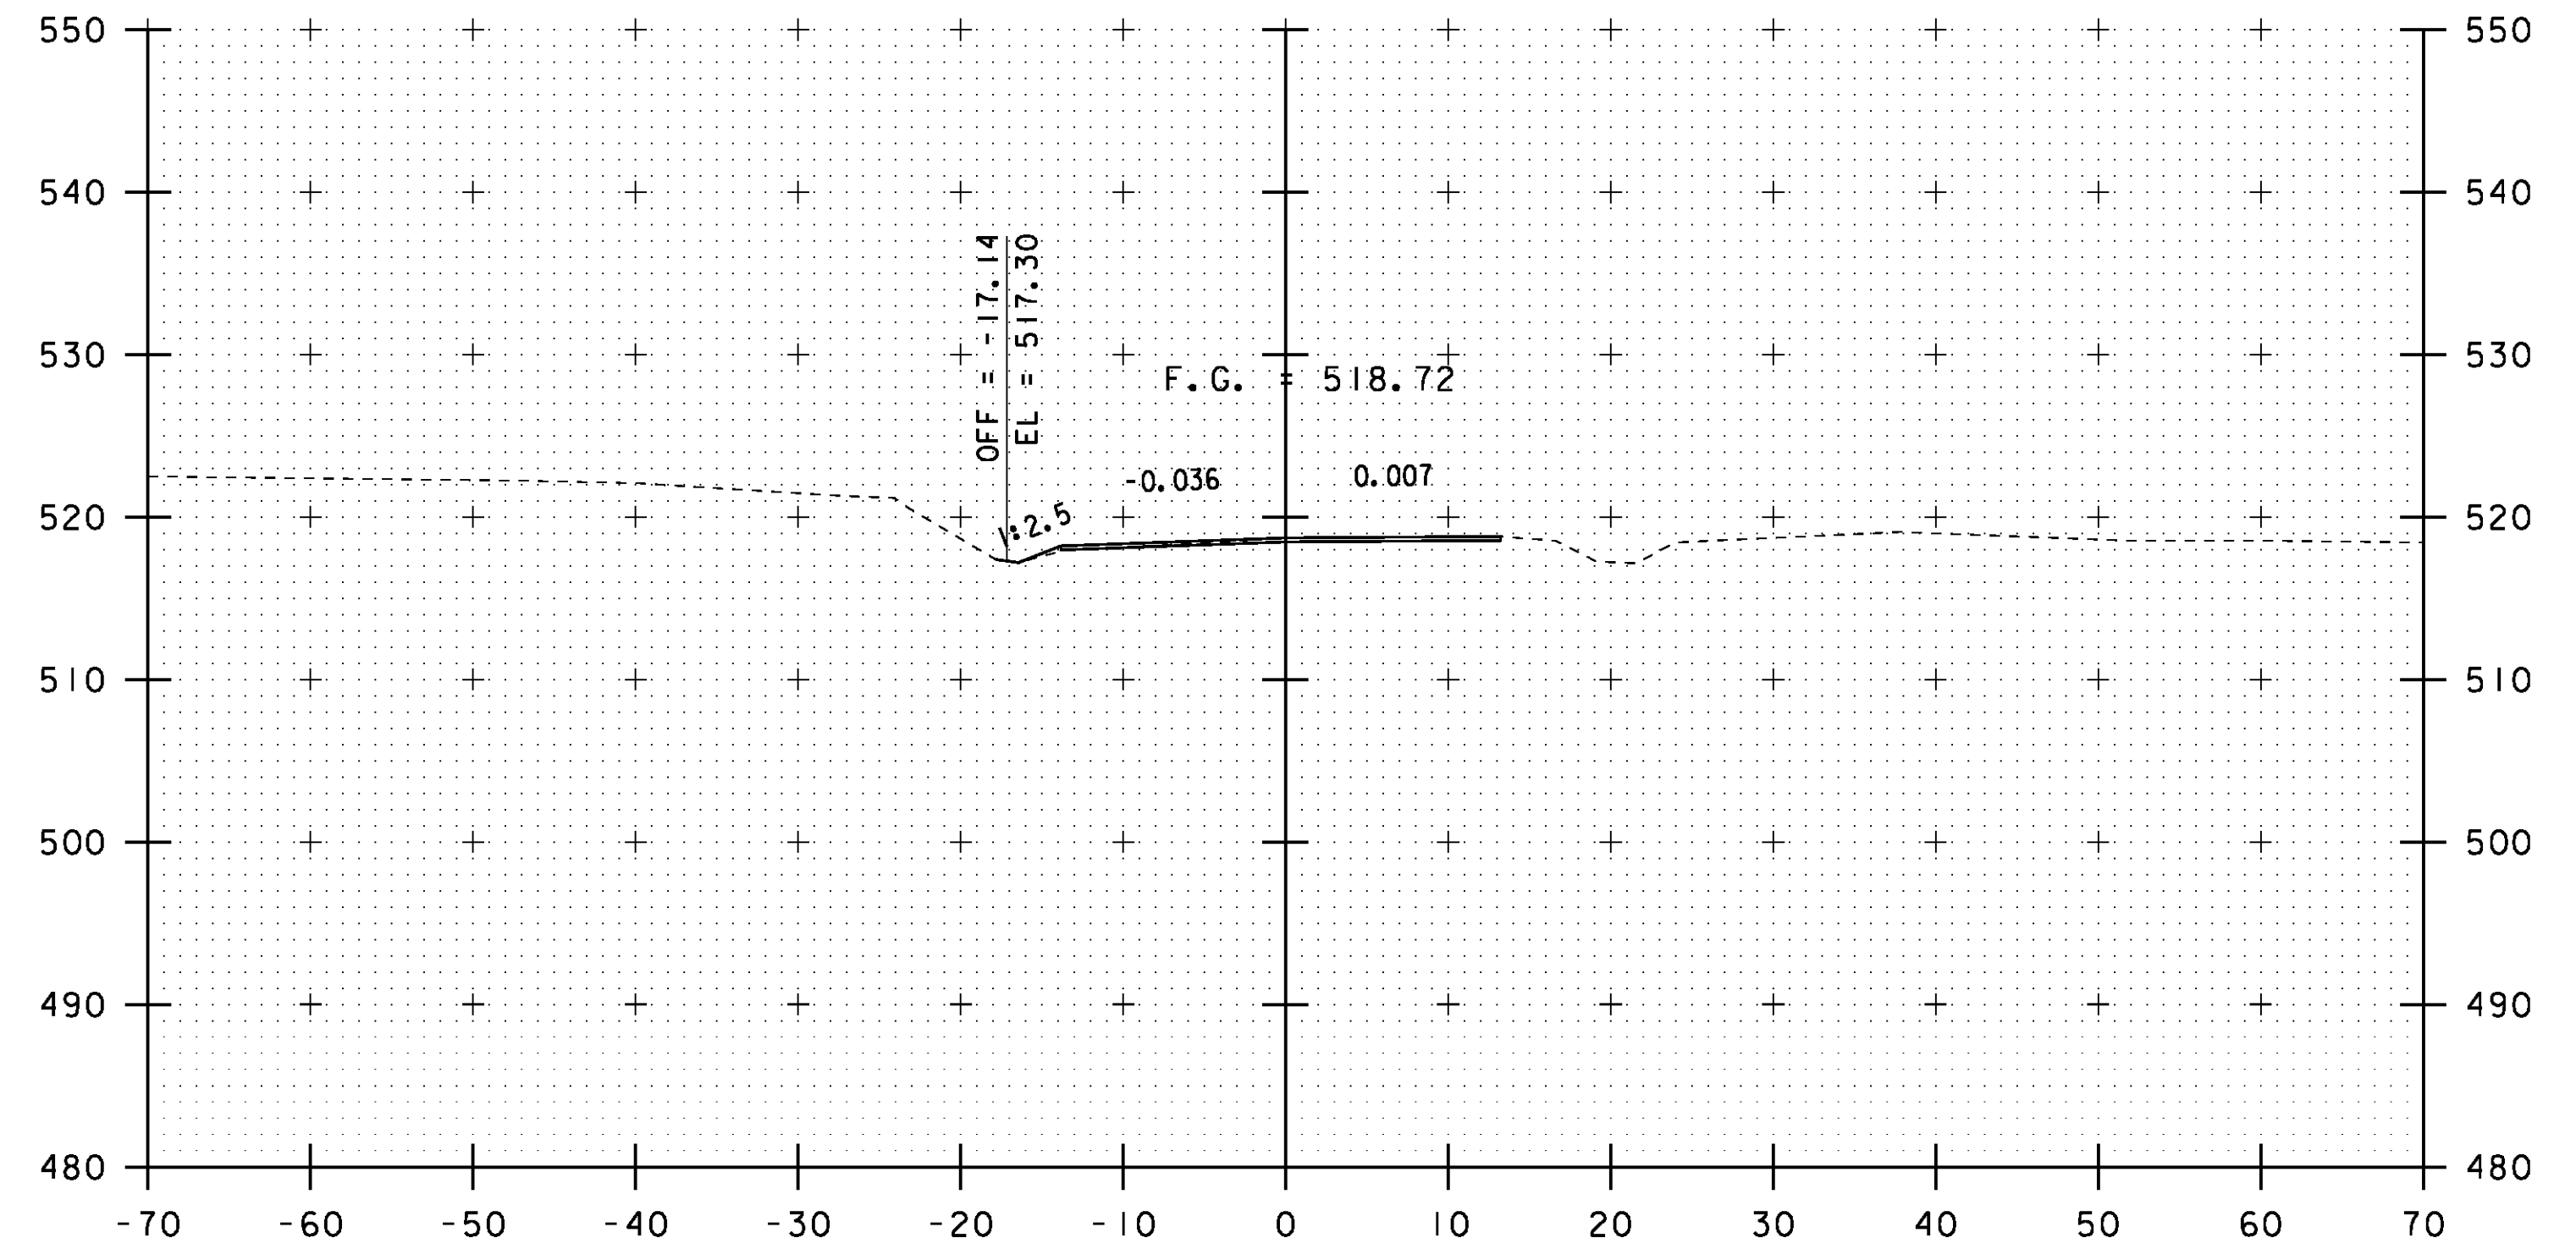


395+75

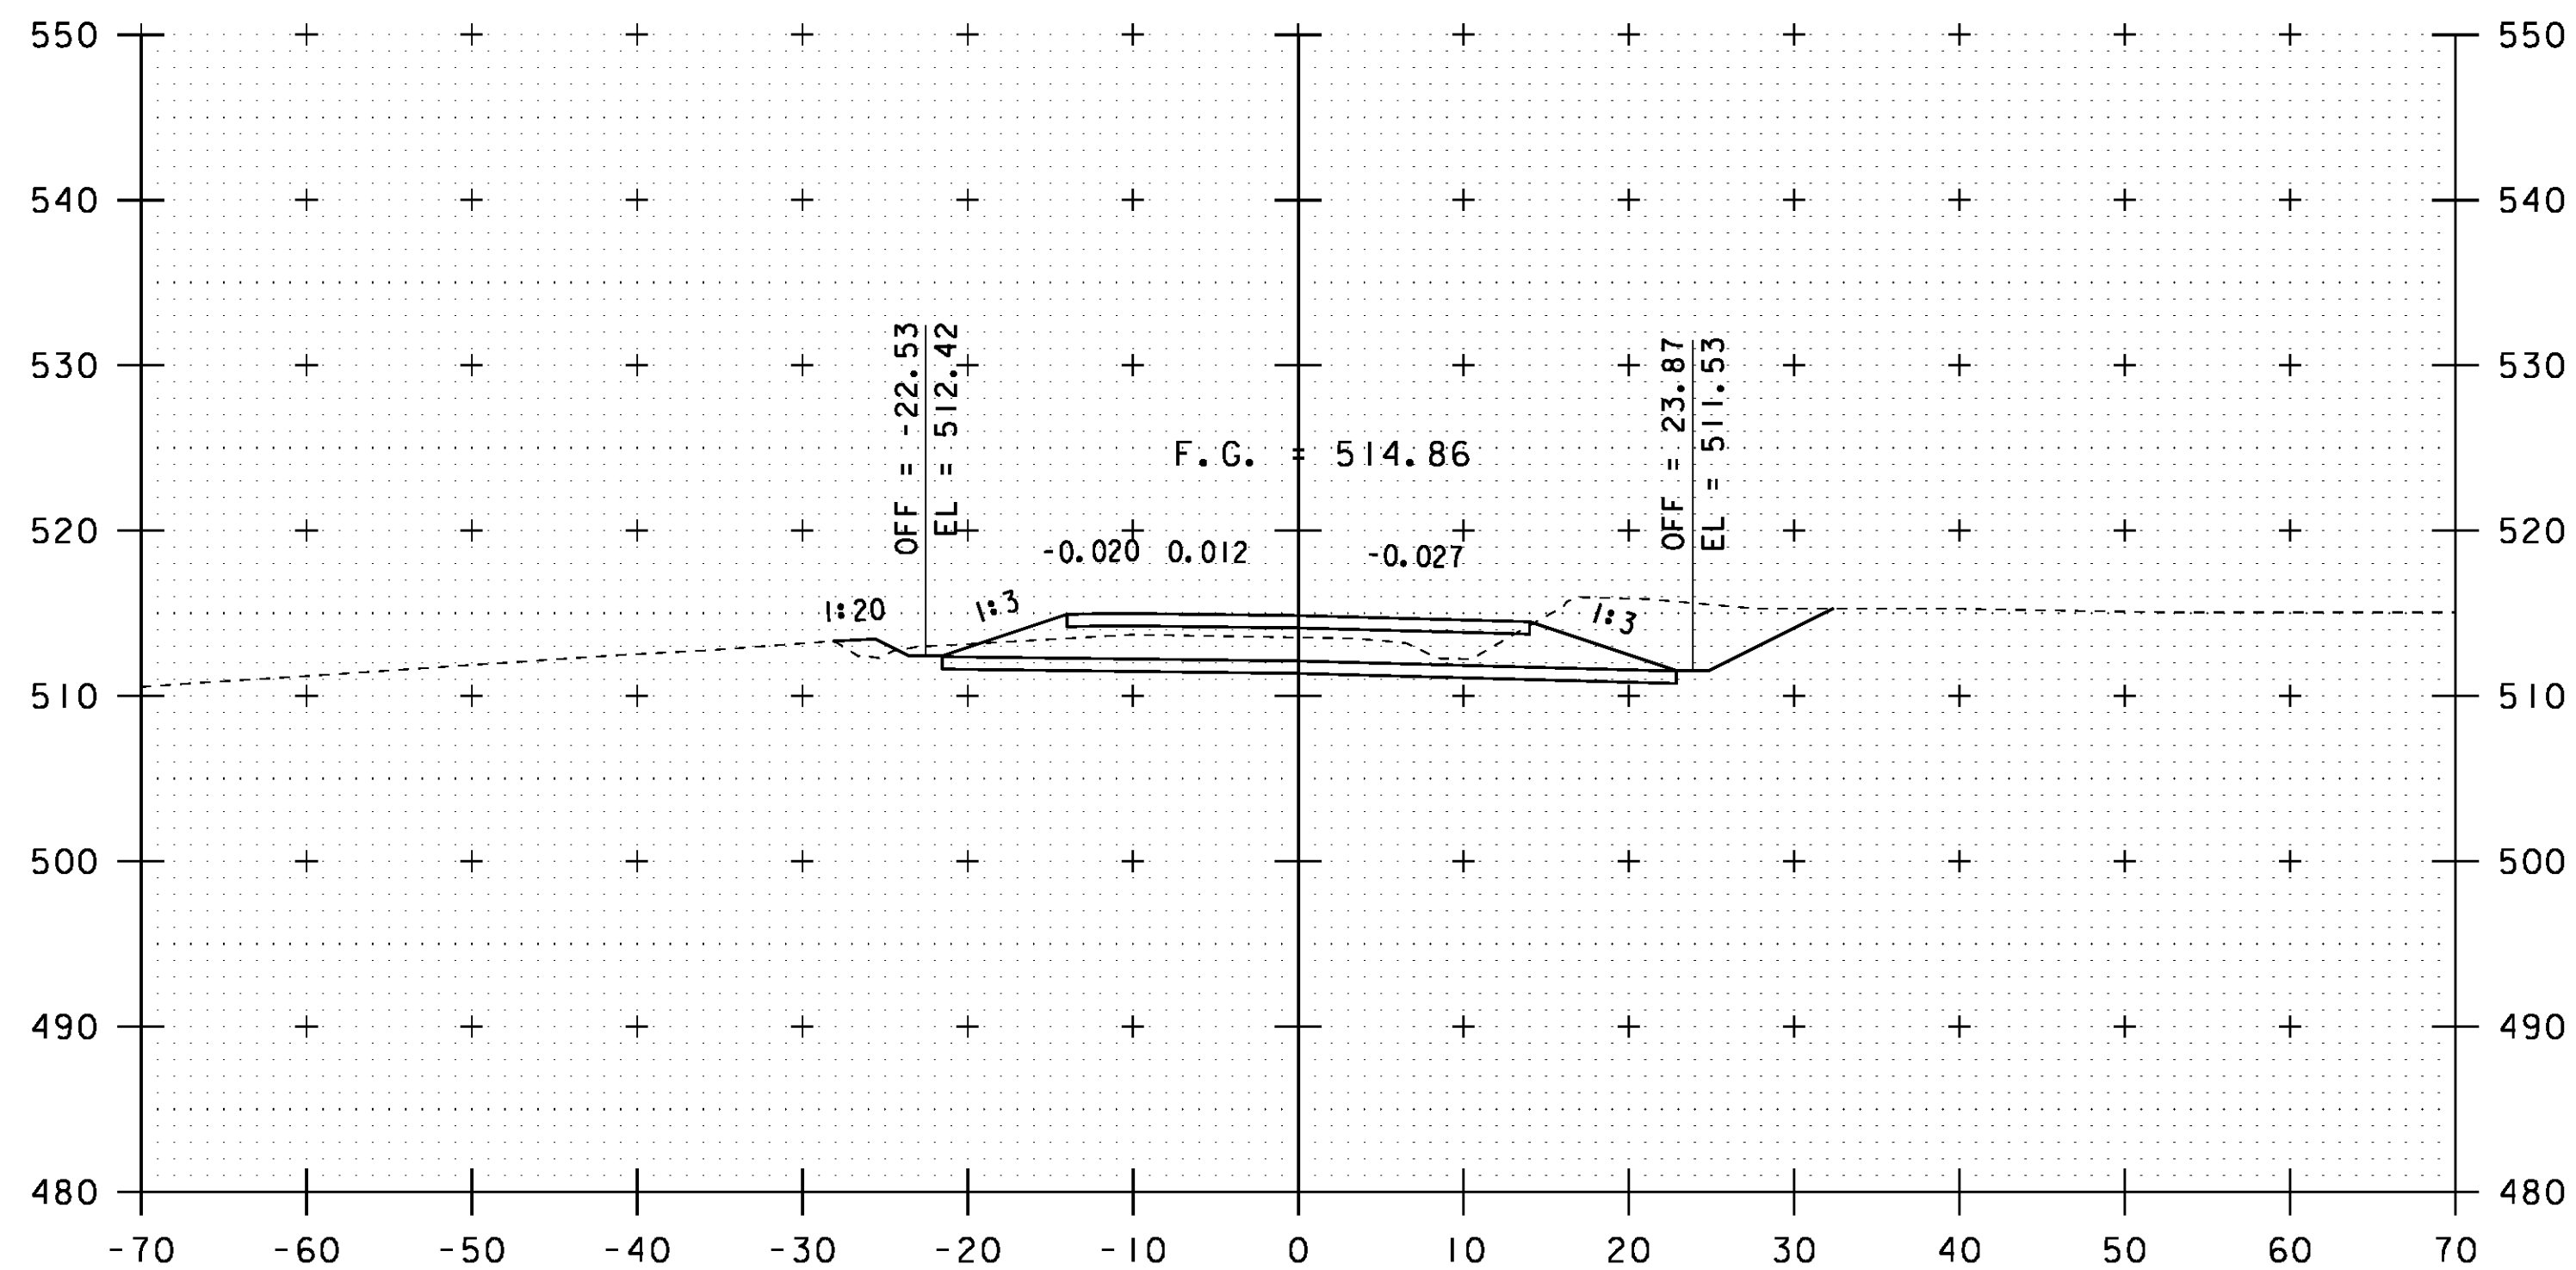

394+50

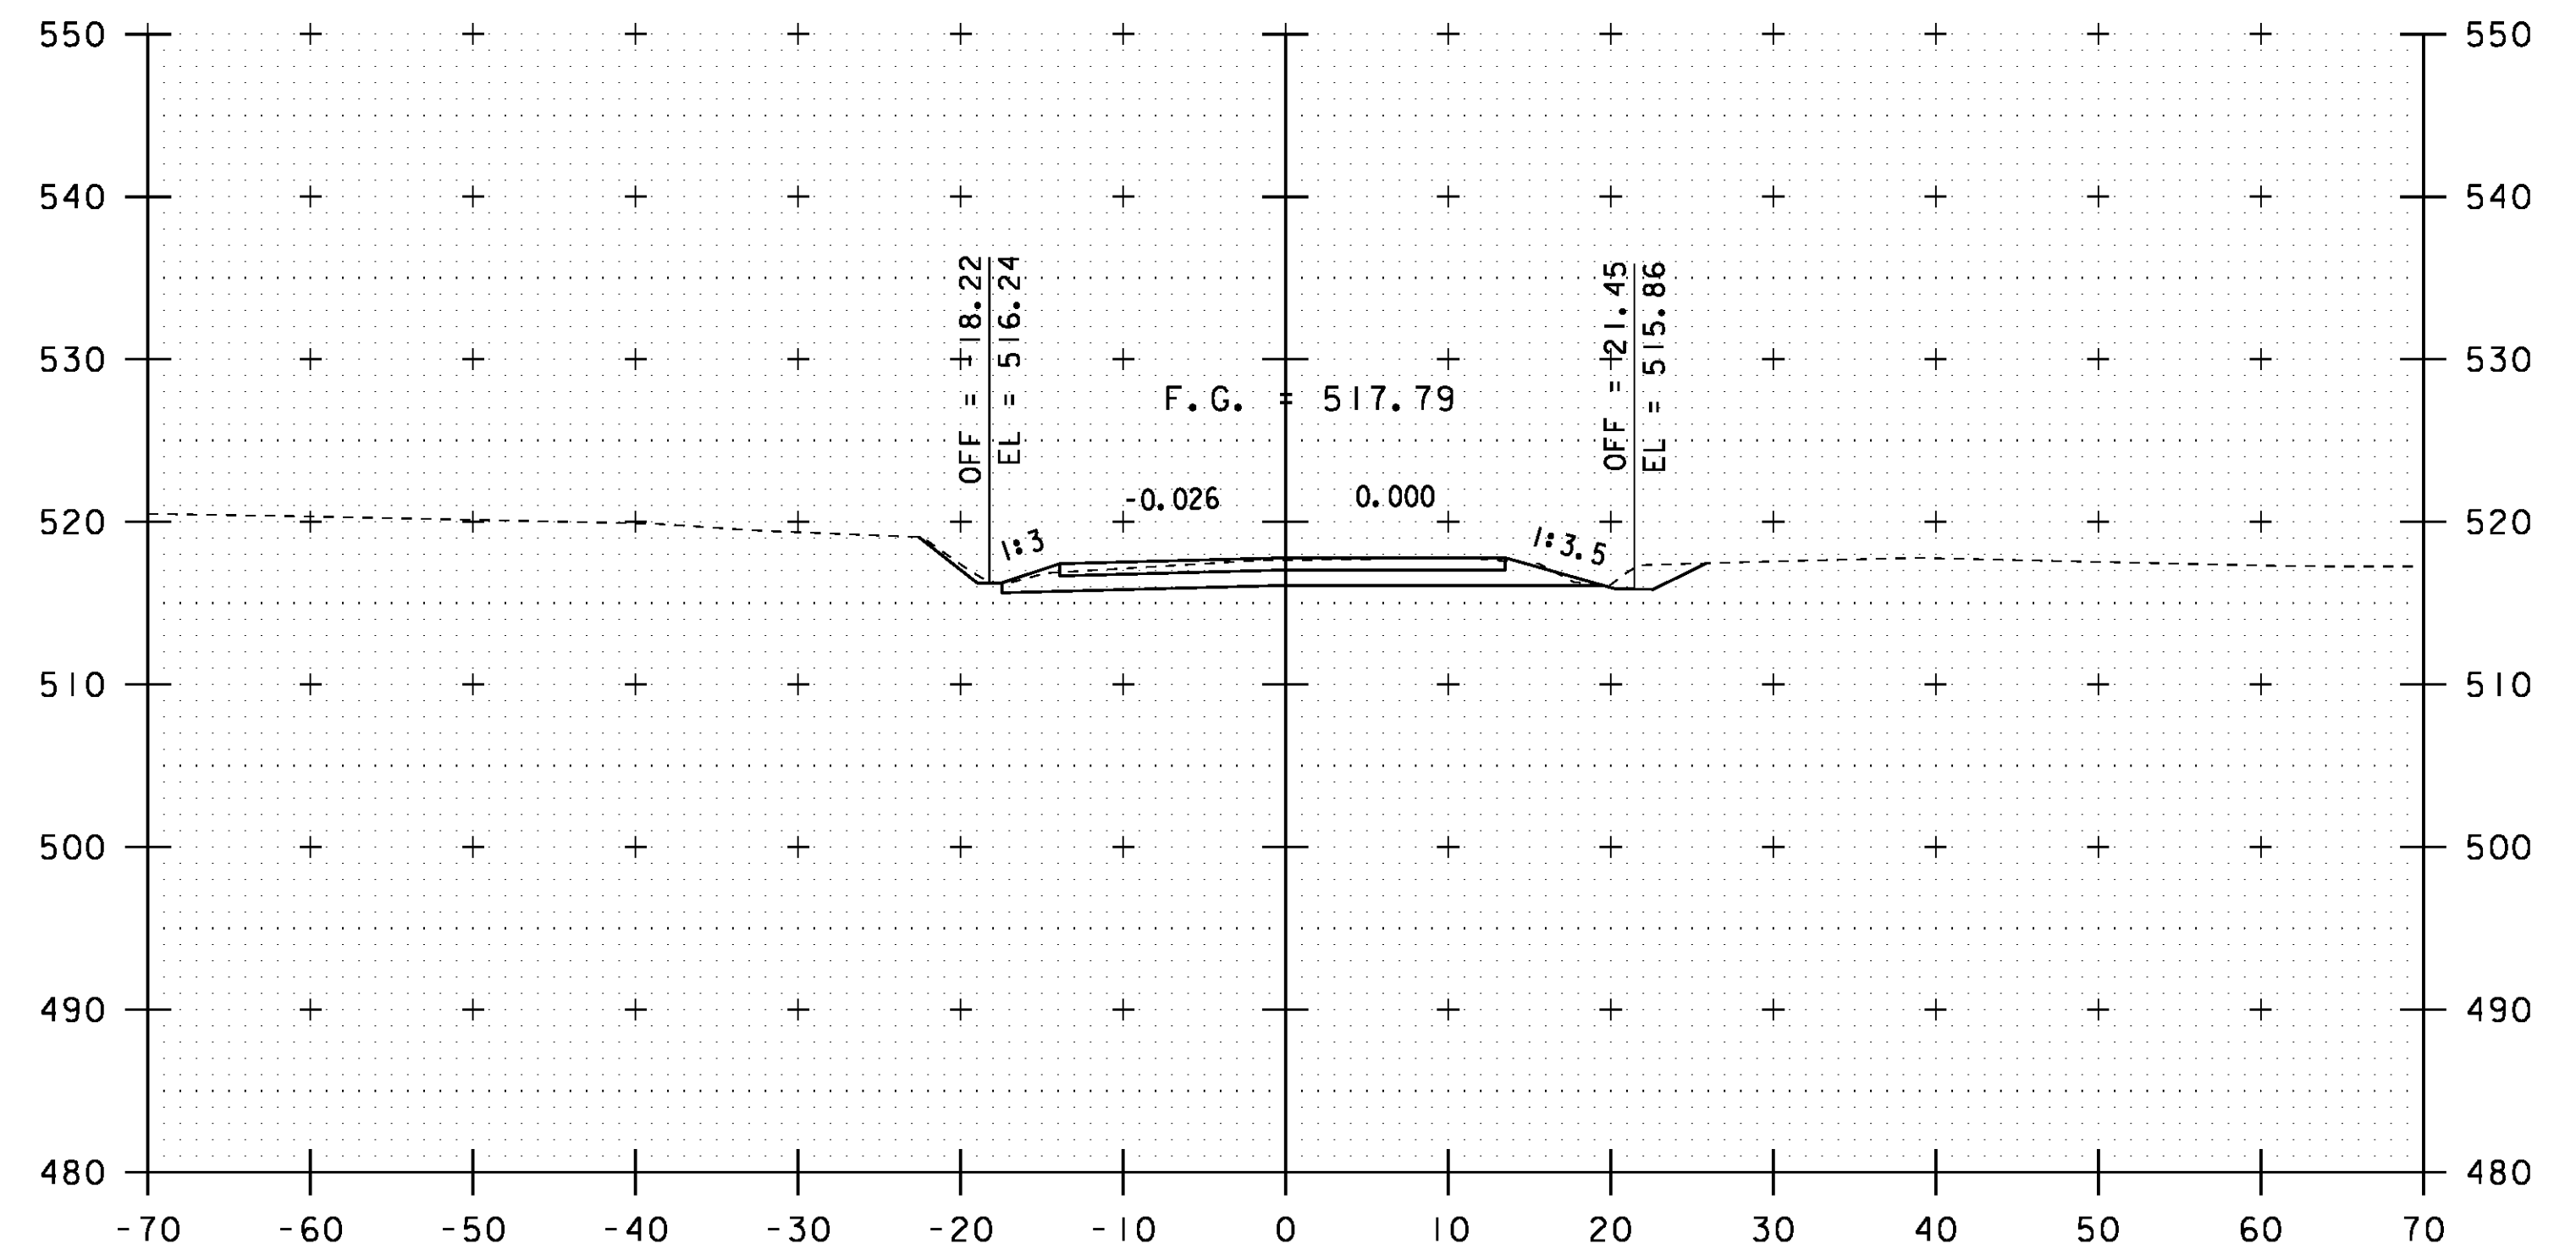

395+50

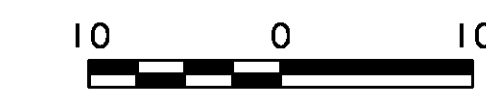


SCALE: 1" = 10'-0"

STA. 394+50 TO STA. 395+75

PROJECT NAME: ROYALTON  
PROJECT NUMBER: BRS 0147 (13)


FILE NAME: \BR 27\86e055xsl.27.dgn  
PROJECT LEADER: C. CARLSON  
DESIGNED BY: G. ROY  
BRIDGE 27 VT 14 CROSS SECTIONS (10)

PLOT DATE: 08-OCT-2013  
DRAWN BY: G. ROY  
CHECKED BY: D. PETERSON  
SHEET 60 OF 186

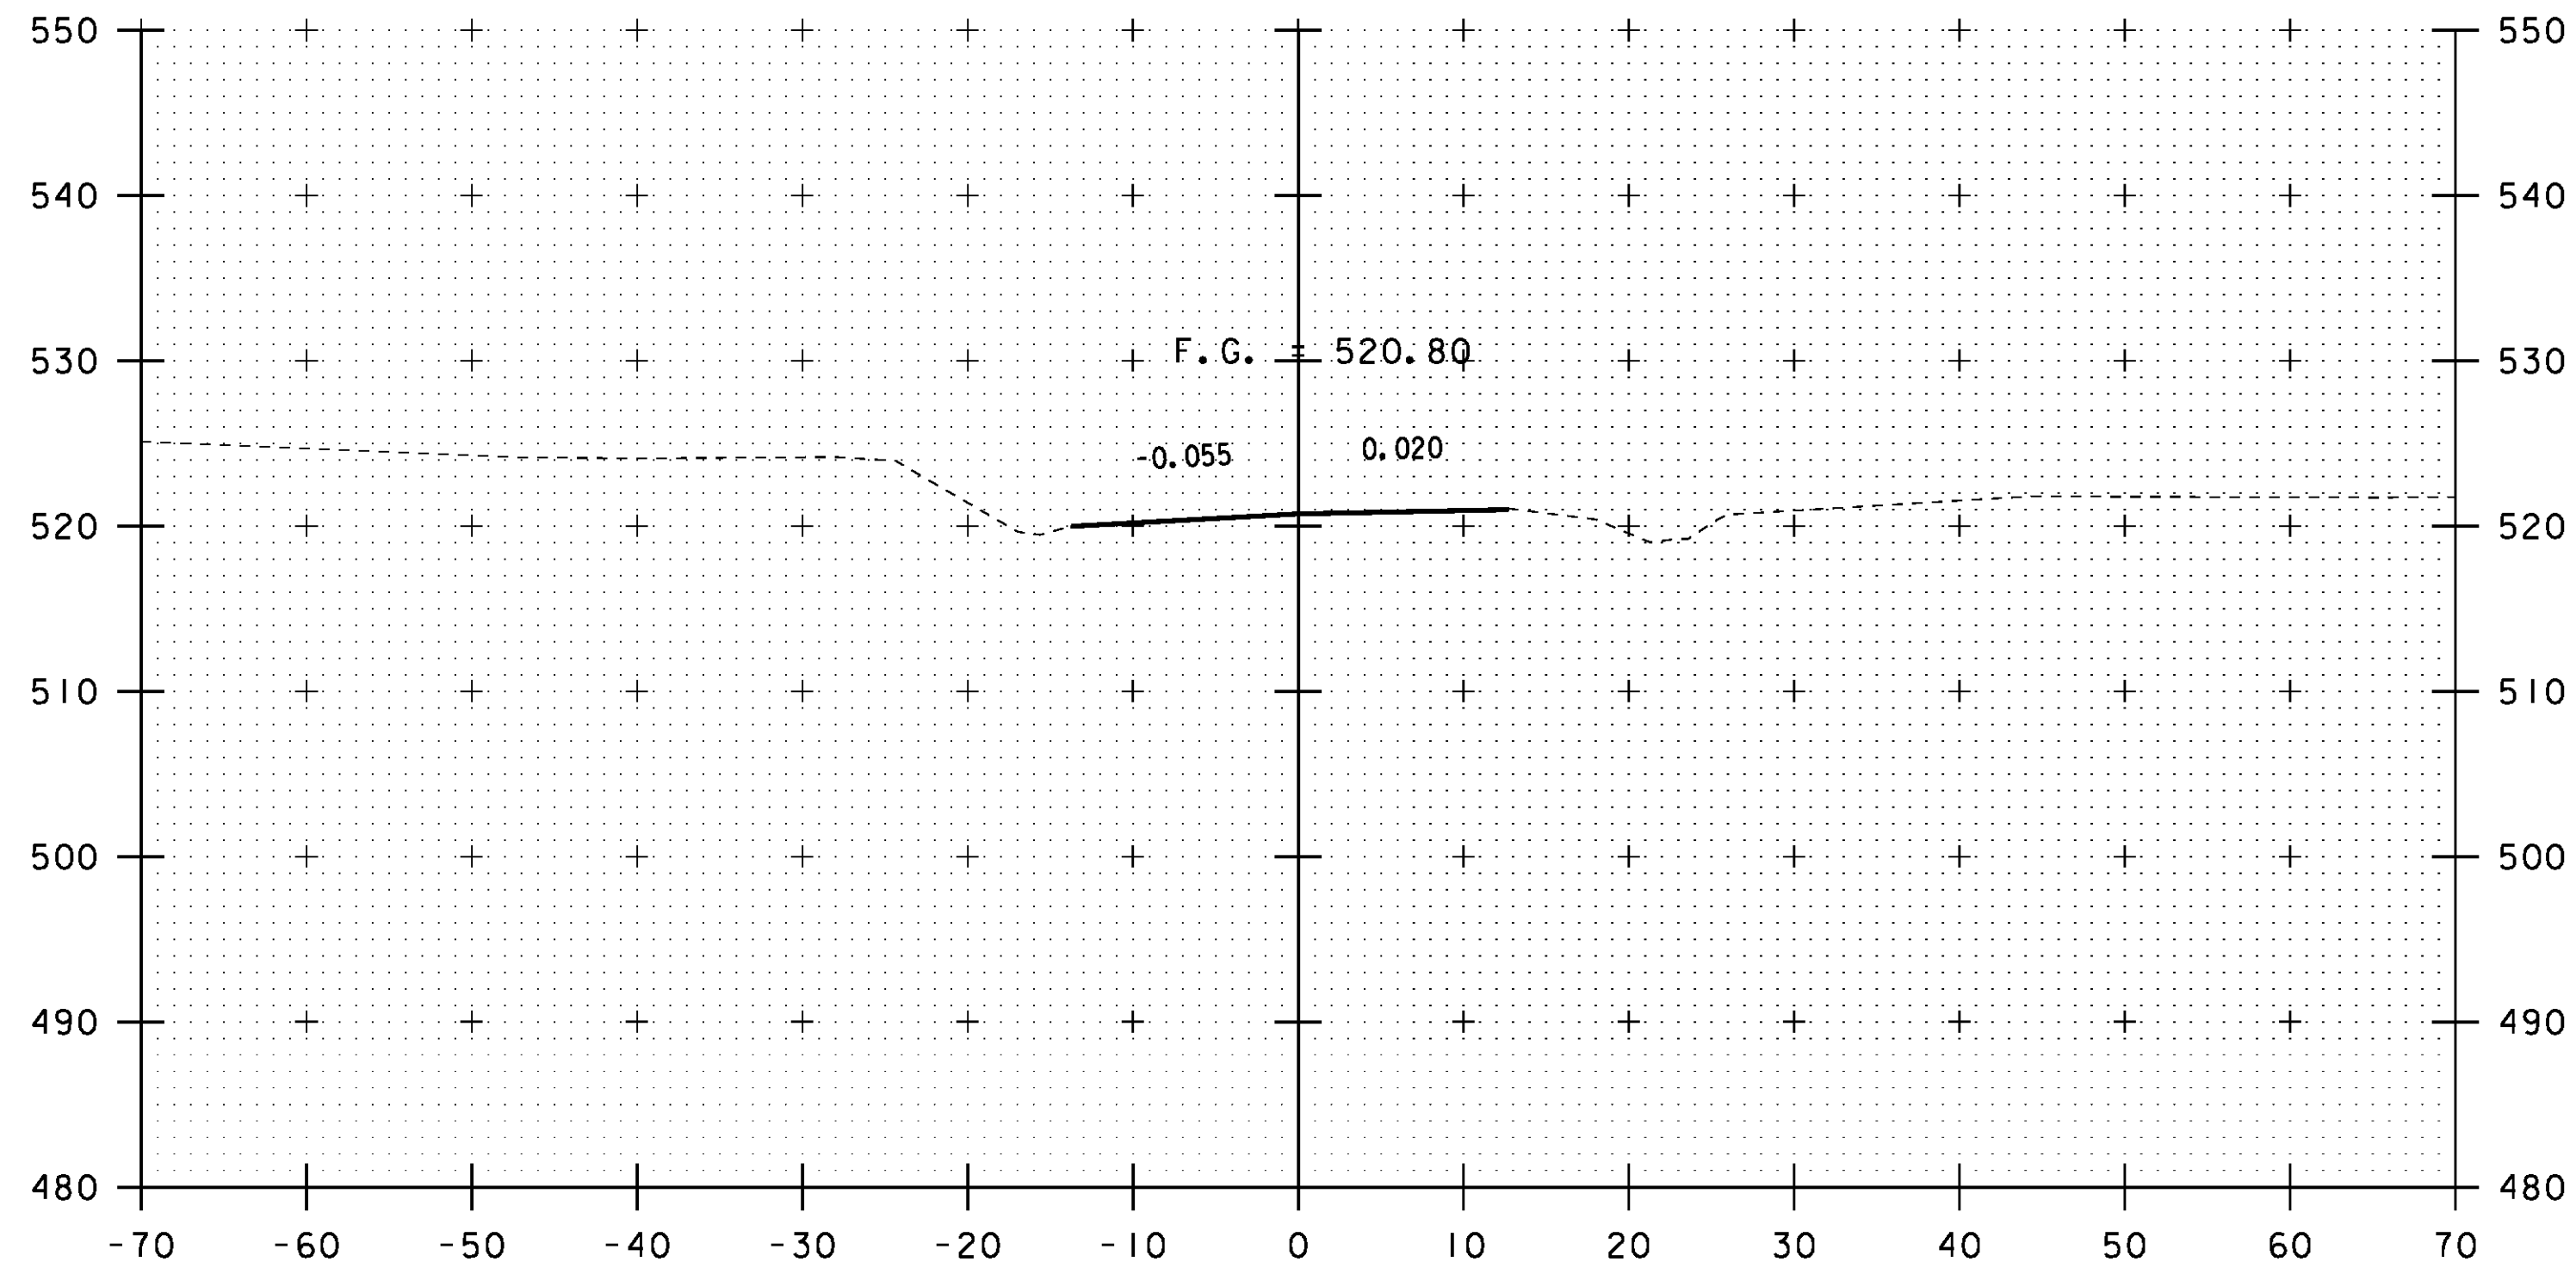


396+25

STA 396+25.00  
END APPROACH  
MATCH EXISTING

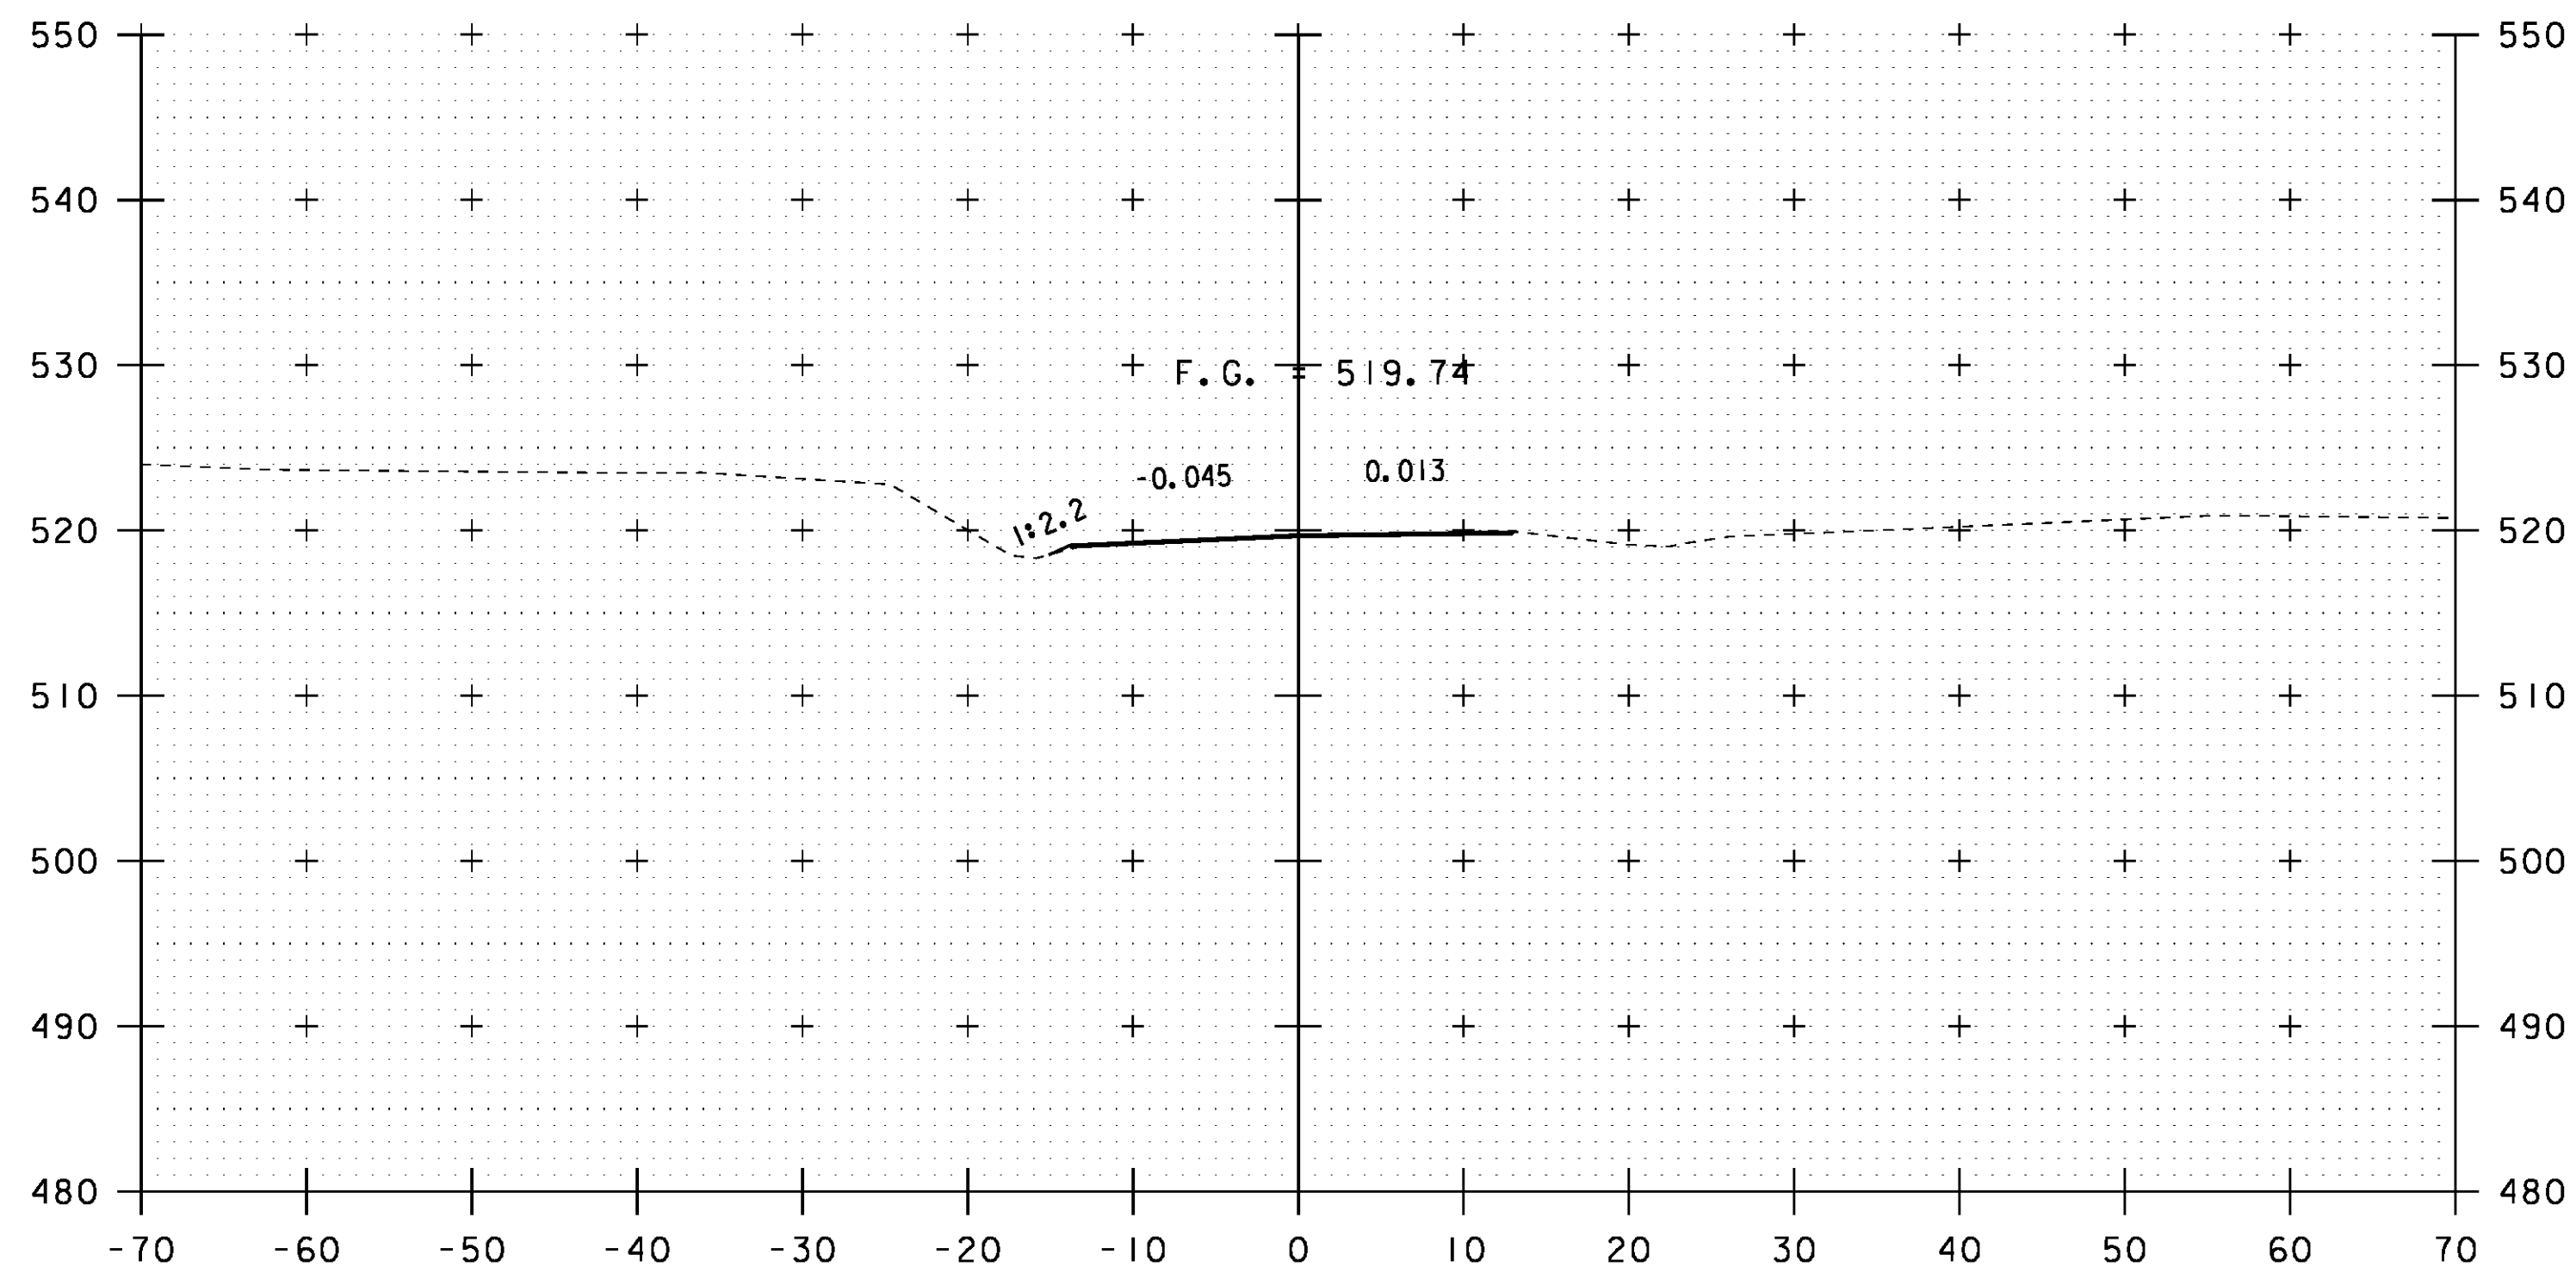

396+00

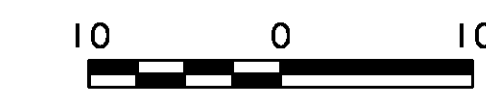


SCALE: 1" = 10'-0"

STA. 396+00 TO STA. 396+25


PROJECT NAME: ROYALTON  
PROJECT NUMBER: BRS 0147 (13)

FILE NAME: \BR 27\s86e055xsl.27.dgn  
PROJECT LEADER: C. CARLSON  
DESIGNED BY: G. ROY  
BRIDGE 27 VT 14 CROSS SECTIONS (11)

PLOT DATE: 08-OCT-2013  
DRAWN BY: G. ROY  
CHECKED BY: D. PETERSON  
SHEET 61 OF 186

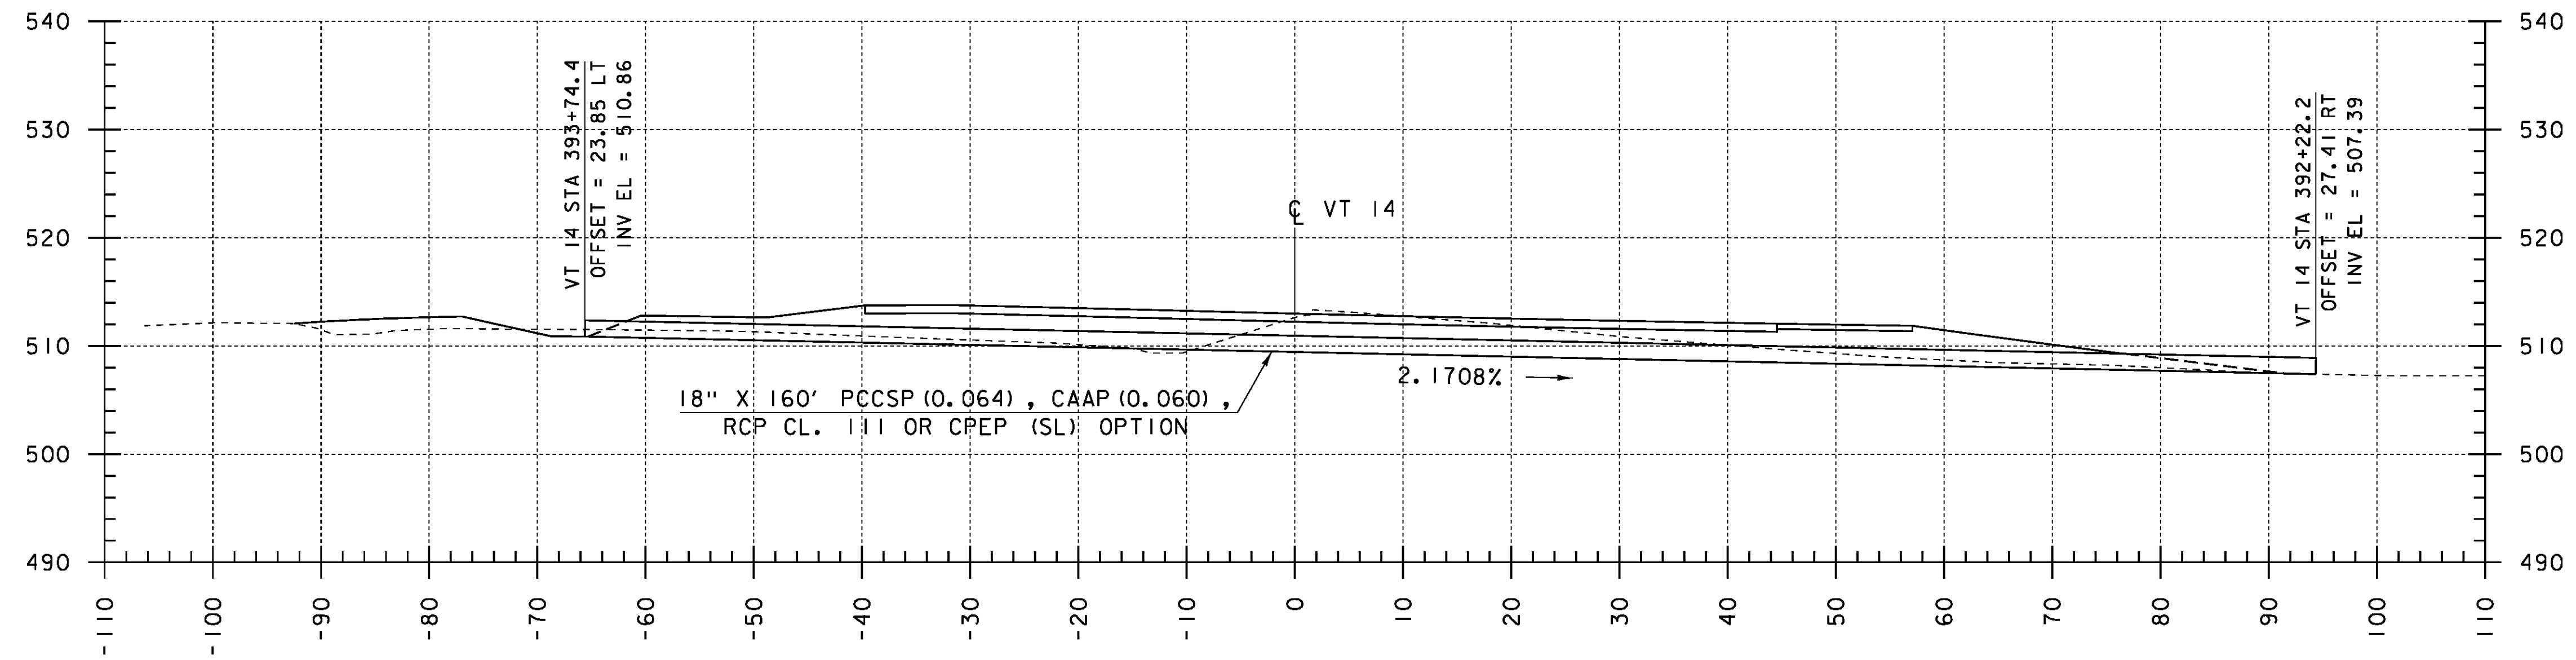


**PIPE PROFILE**  
 HORIZONTAL SCALE: 1" = 10'-0"  
 VERTICAL SCALE: 1" = 10'-0"

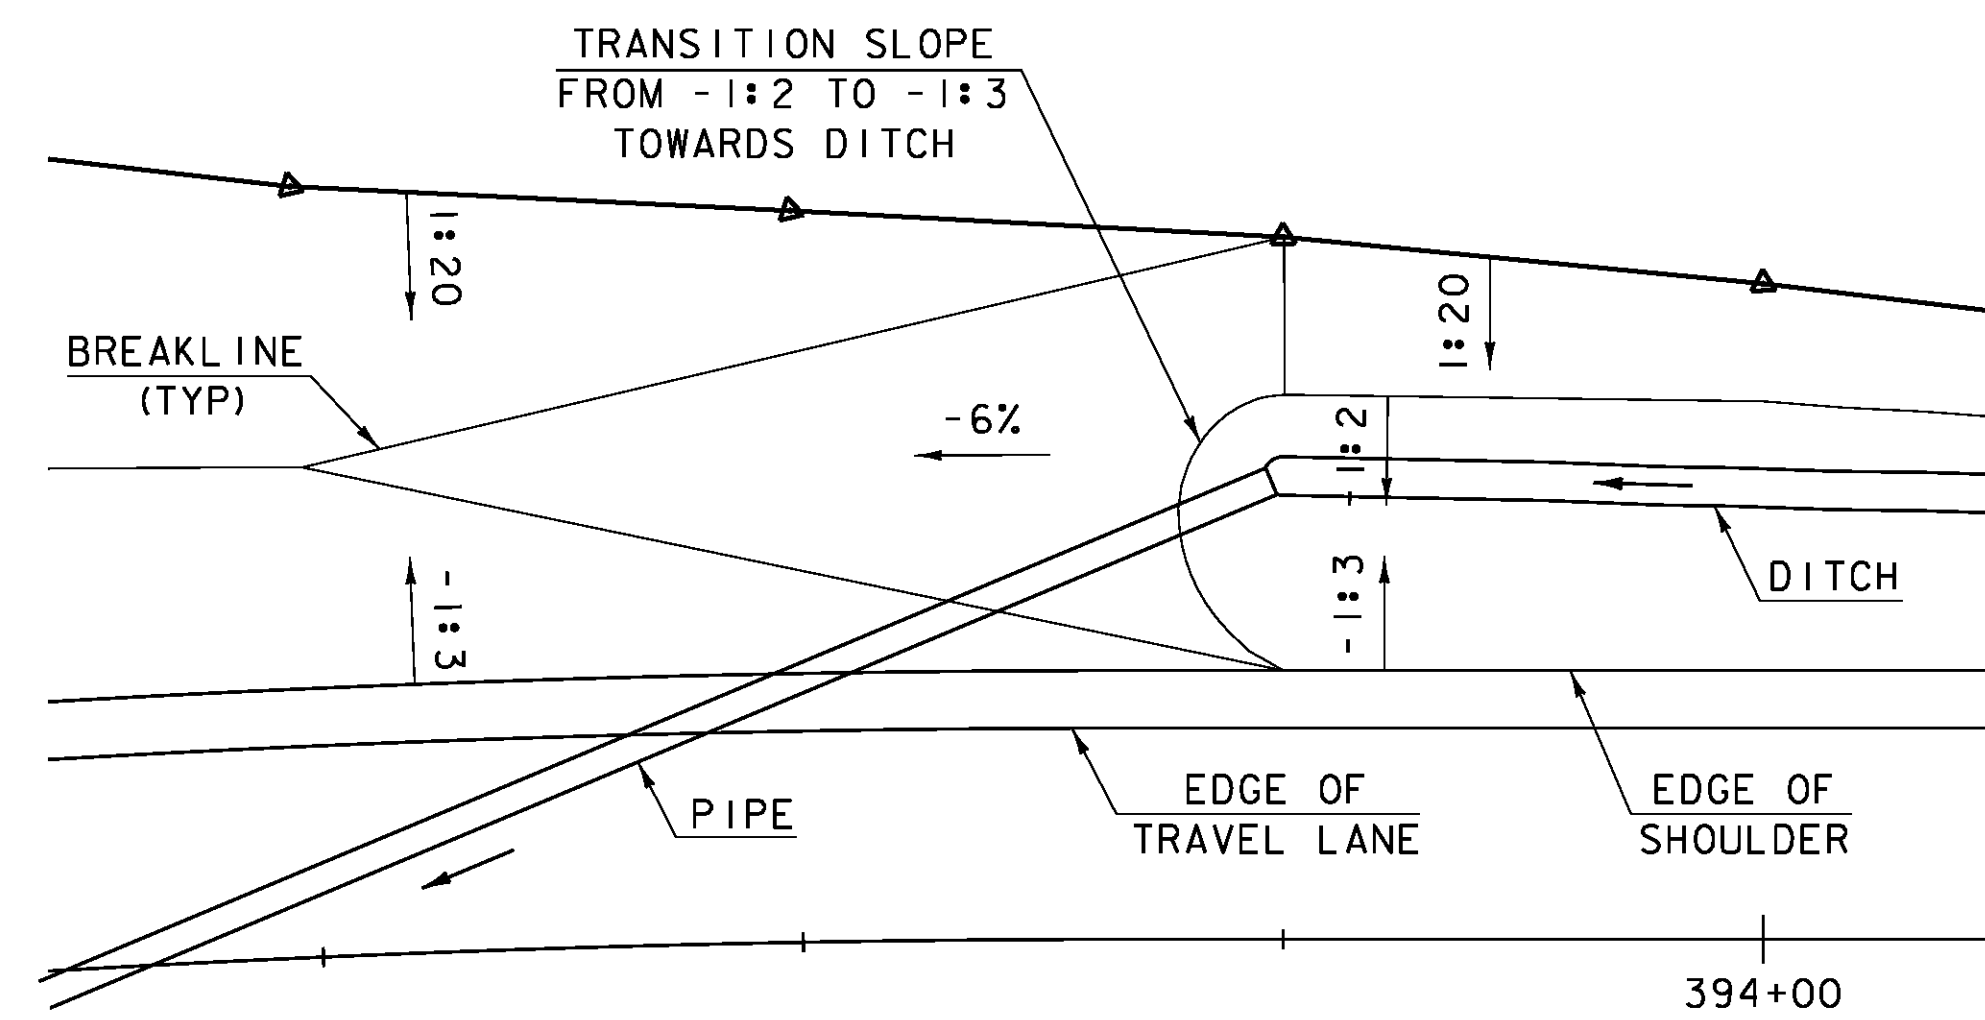

**GRADING PLAN**  
 SCALE: 1" = 10'-0"

PROJECT NAME: ROYALTON	PROJECT NUMBER: BRS 0147 (13)
FILE NAME: \BR 27\s86e055xsl.27.dgn	PLOT DATE: 08-OCT-2013
PROJECT LEADER: C. CARLSON	DRAWN BY: G. ROY
DESIGNED BY: G. ROY	CHECKED BY: D. PETERSON
BRIDGE 27 VT 14 PIPE PROFILE	SHEET 62 OF 186

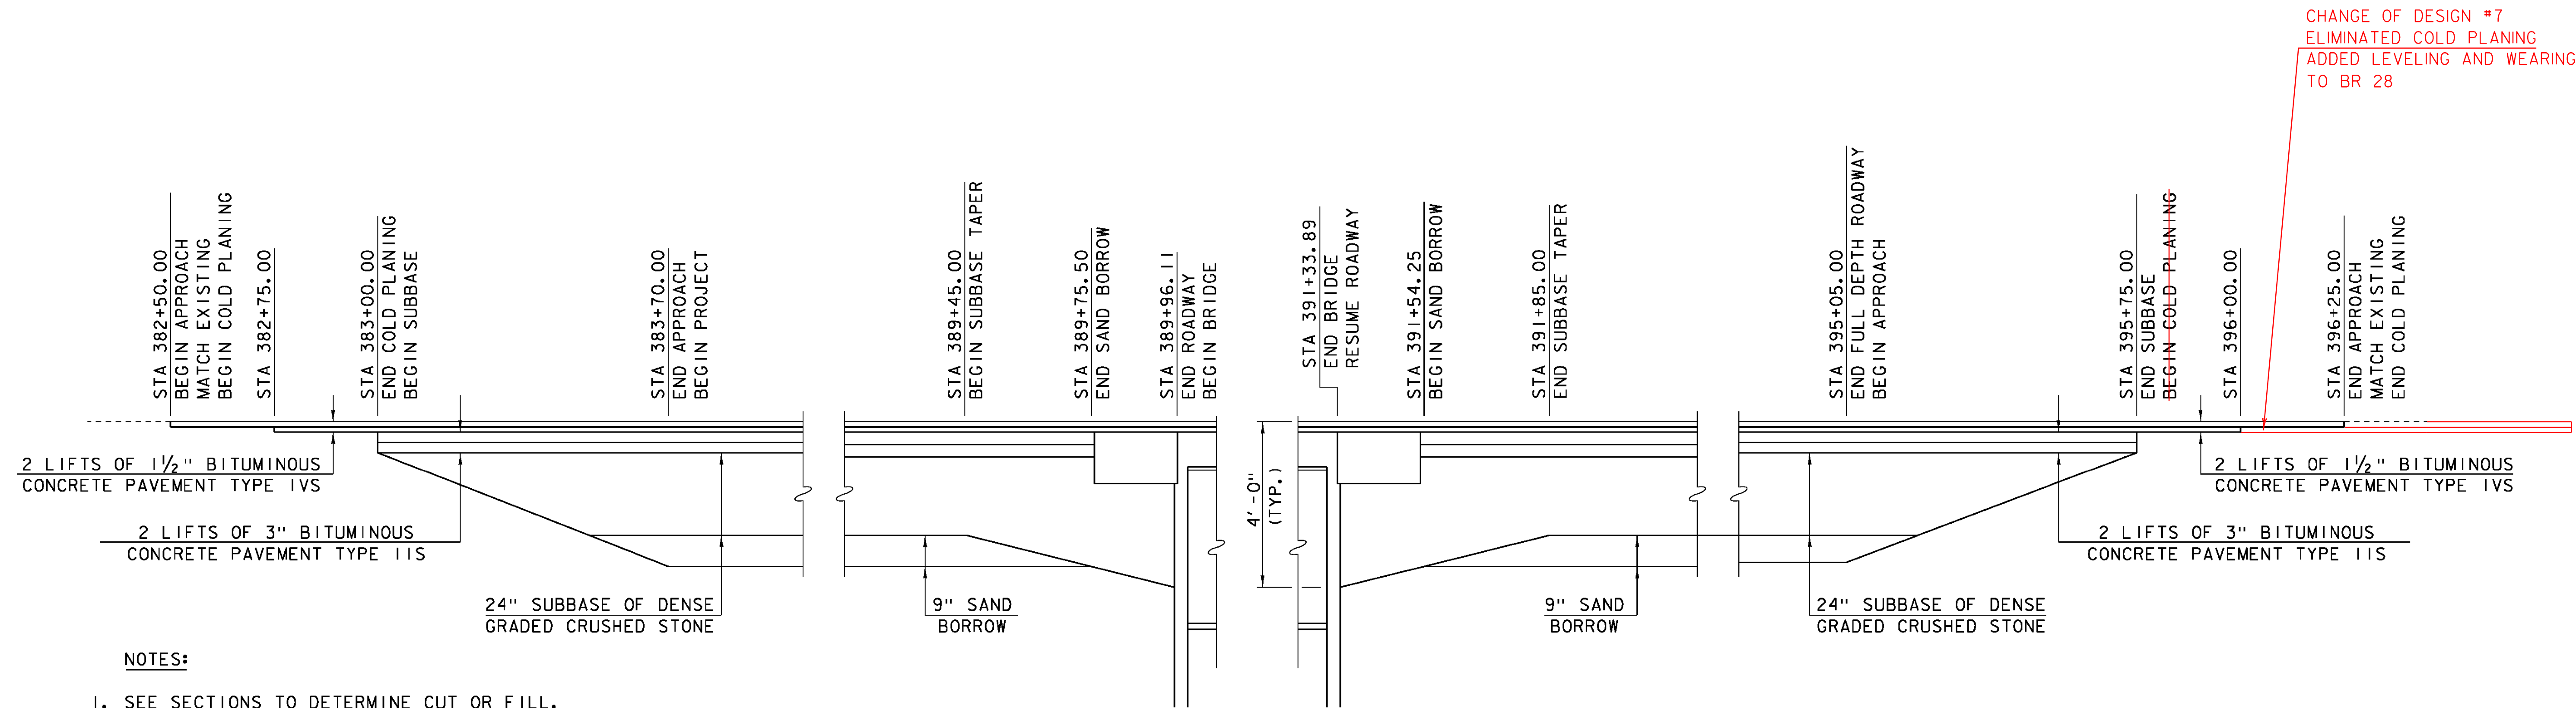


**NOTES:**

1. SEE SECTIONS TO DETERMINE CUT OR FILL.
2. SEE PROJECT TYPICAL SECTIONS FOR ABUTMENT EARTHWORK DETAILS.

**VT 14 MATERIAL TRANSITION DETAIL**


HORIZONTAL SCALE: 1" = 20'-0"  
 VERTICAL SCALE: 1" = 2'-0"

PROJECT NAME: ROYALTON	PLOT DATE: 08-OCT-2013
PROJECT NUMBER: BRS 0147 (13)	DRAWN BY: D. PETERSON
FILE NAME: s86e055pro_27.dgn	CHECKED BY: C. CARLSON
PROJECT LEADER: C. CARLSON	SHEET 63 OF 186
DESIGNED BY: D. PETERSON	
BRIDGE 27 VT 14 MATERIAL TRANSITION	

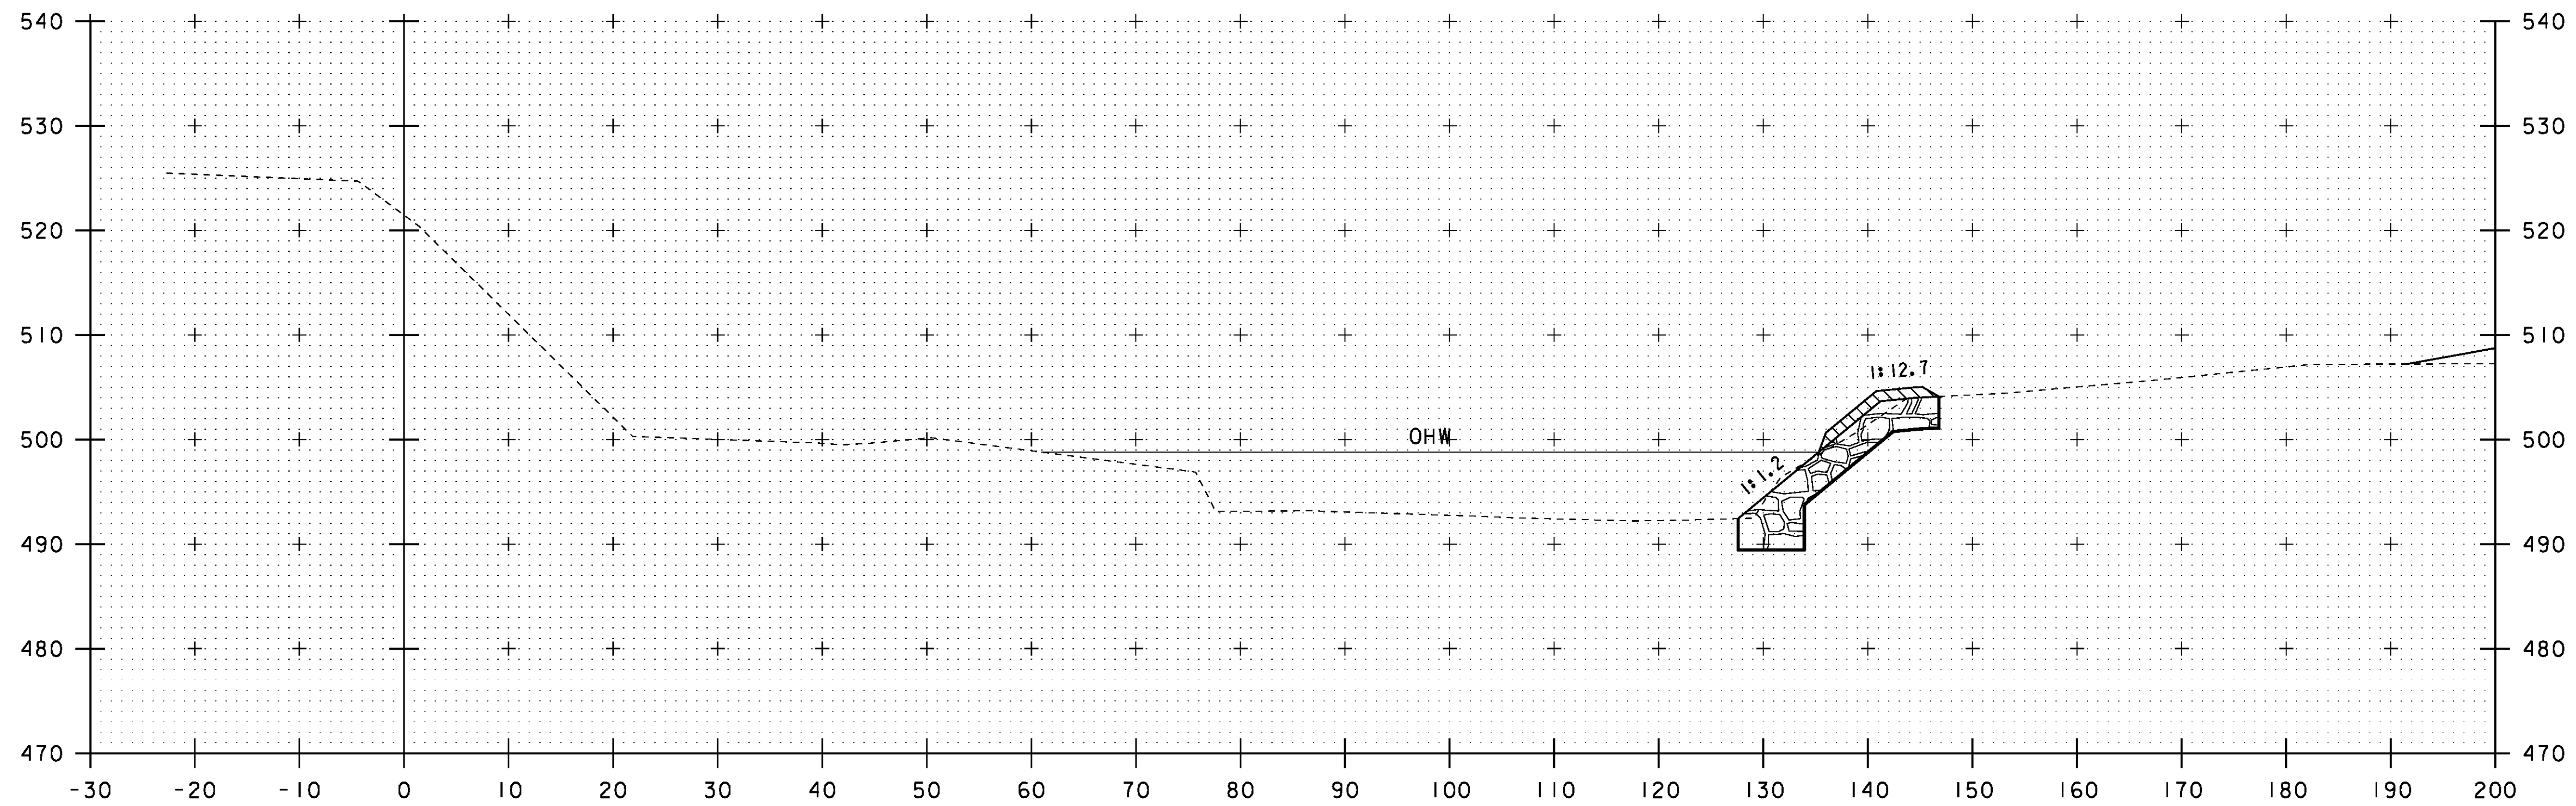


49+00

CHANNEL STA 48+87.2 FAR RT  
 BEGIN UNCLASSIFIED CHANNEL EXCAVATION  
 GEOTEXTILE UNDER STONE FILL  
 STONE FILL, TYPE III  
 GRUBBING MATERIAL

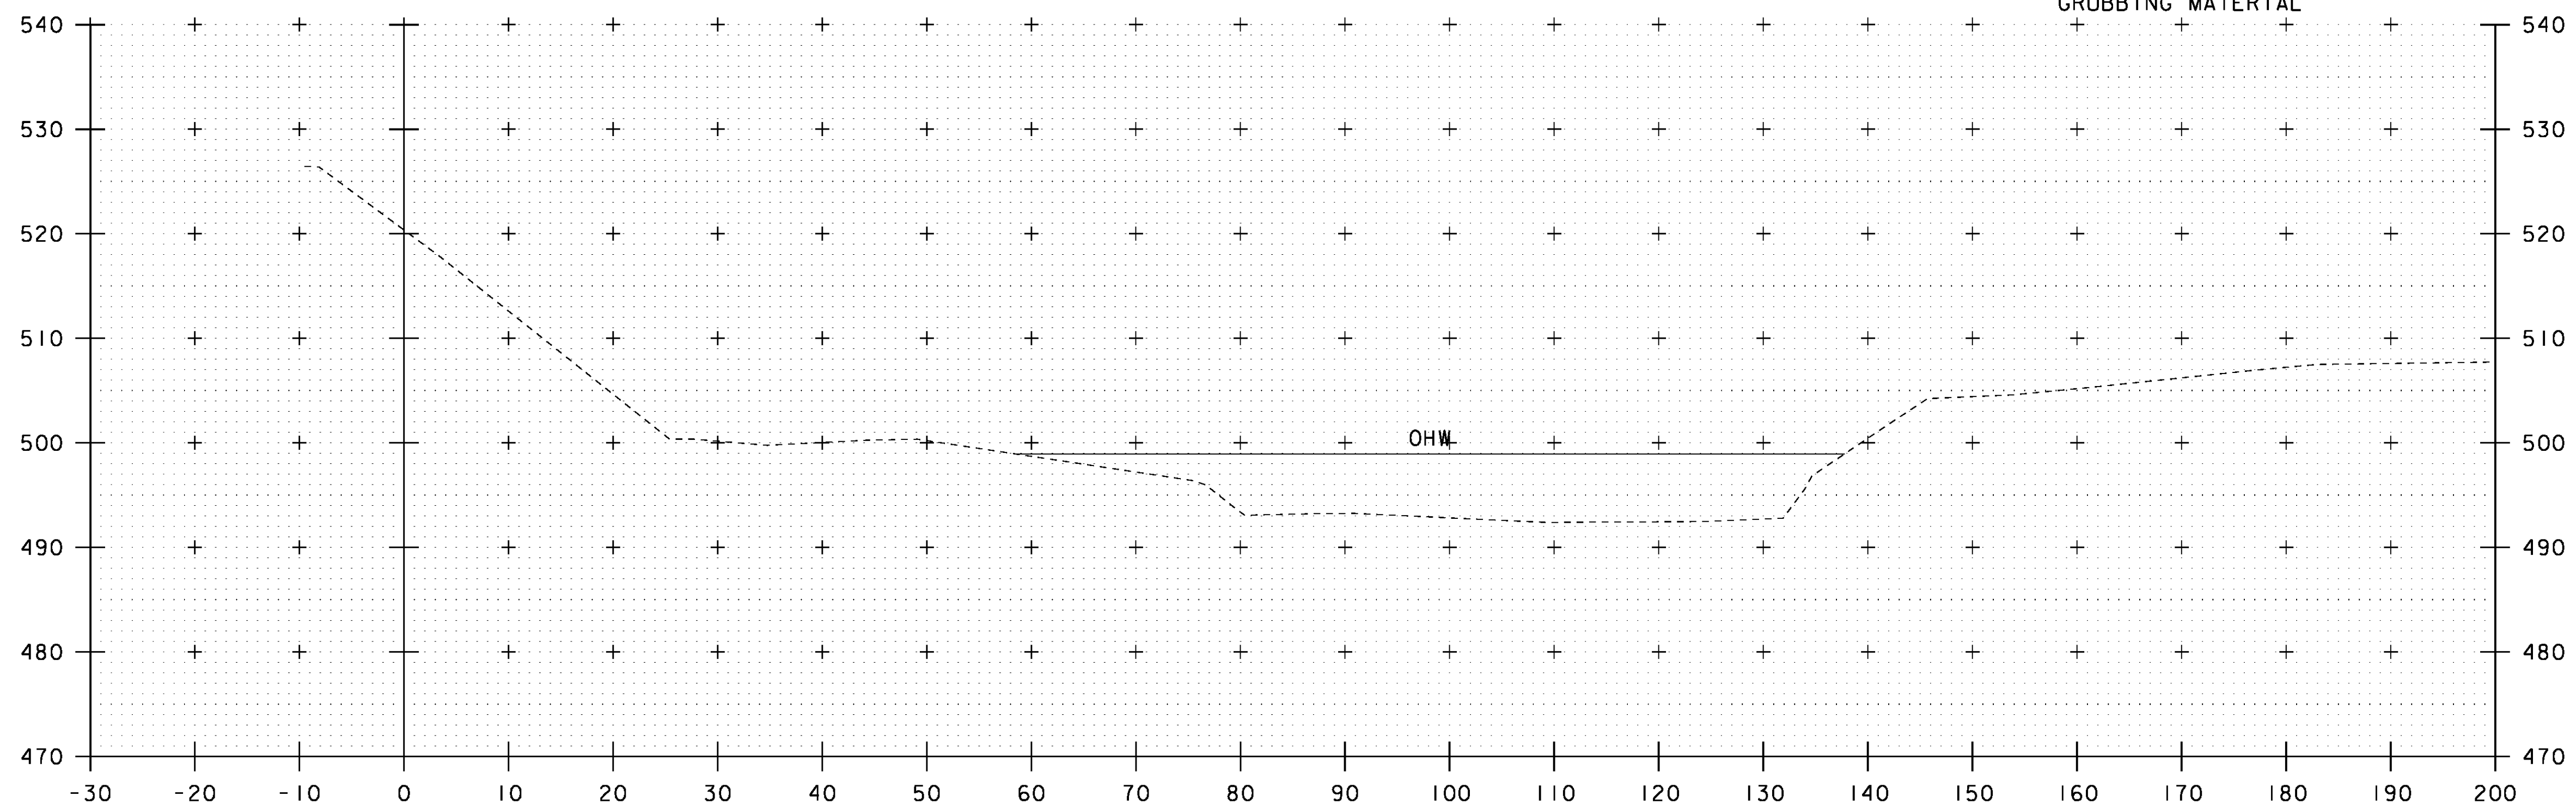

48+75

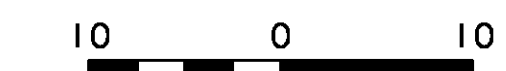


SCALE: 1" = 10'-0"

STA. 48+75 TO STA. 49+00


PROJECT NAME: ROYALTON  
 PROJECT NUMBER: BRS 0147 (13)

FILE NAME: \BR 27\86e055xsl.27.dgn PLOT DATE: 08-OCT-2013  
 PROJECT LEADER: C. CARLSON DRAWN BY: G. ROY  
 DESIGNED BY: G. ROY CHECKED BY: D. PETERSON  
 BRIDGE 27 CHANNEL LINE CROSS SECTIONS (1) SHEET 64 OF 186



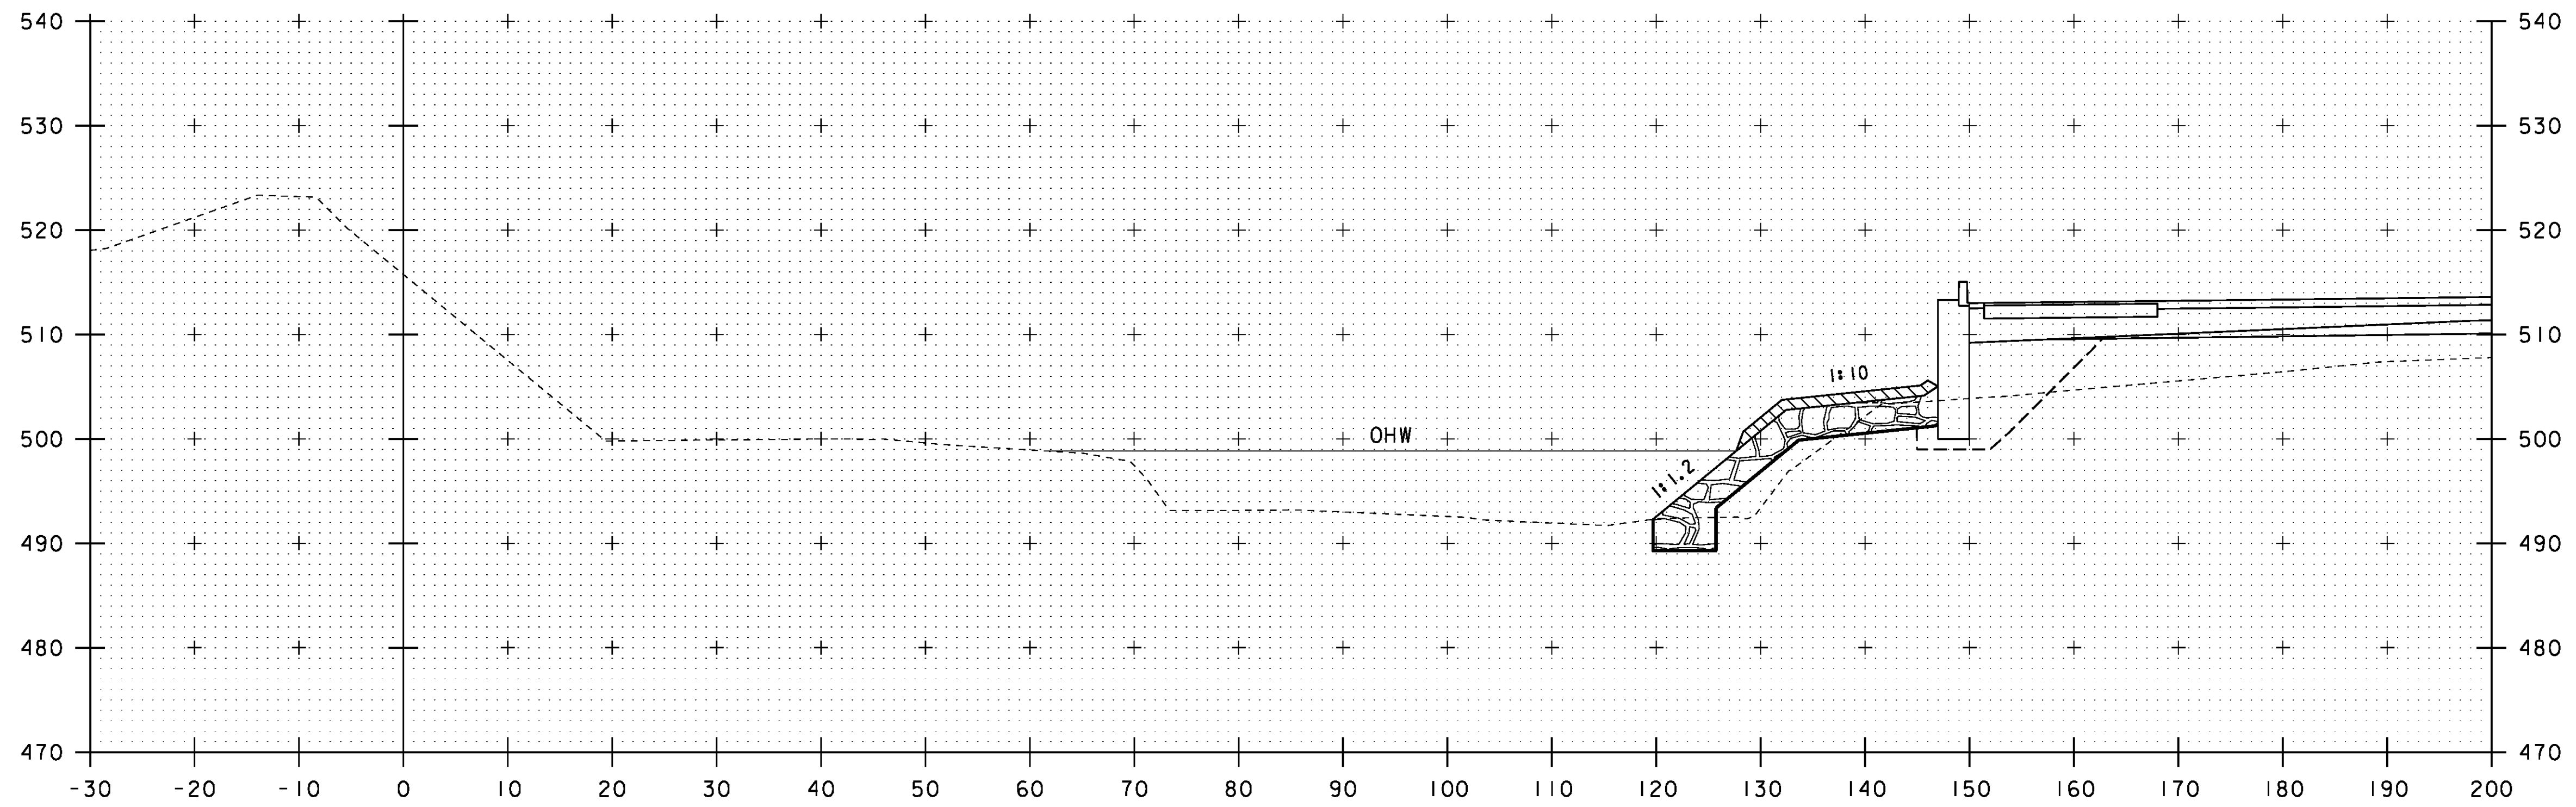


49+30

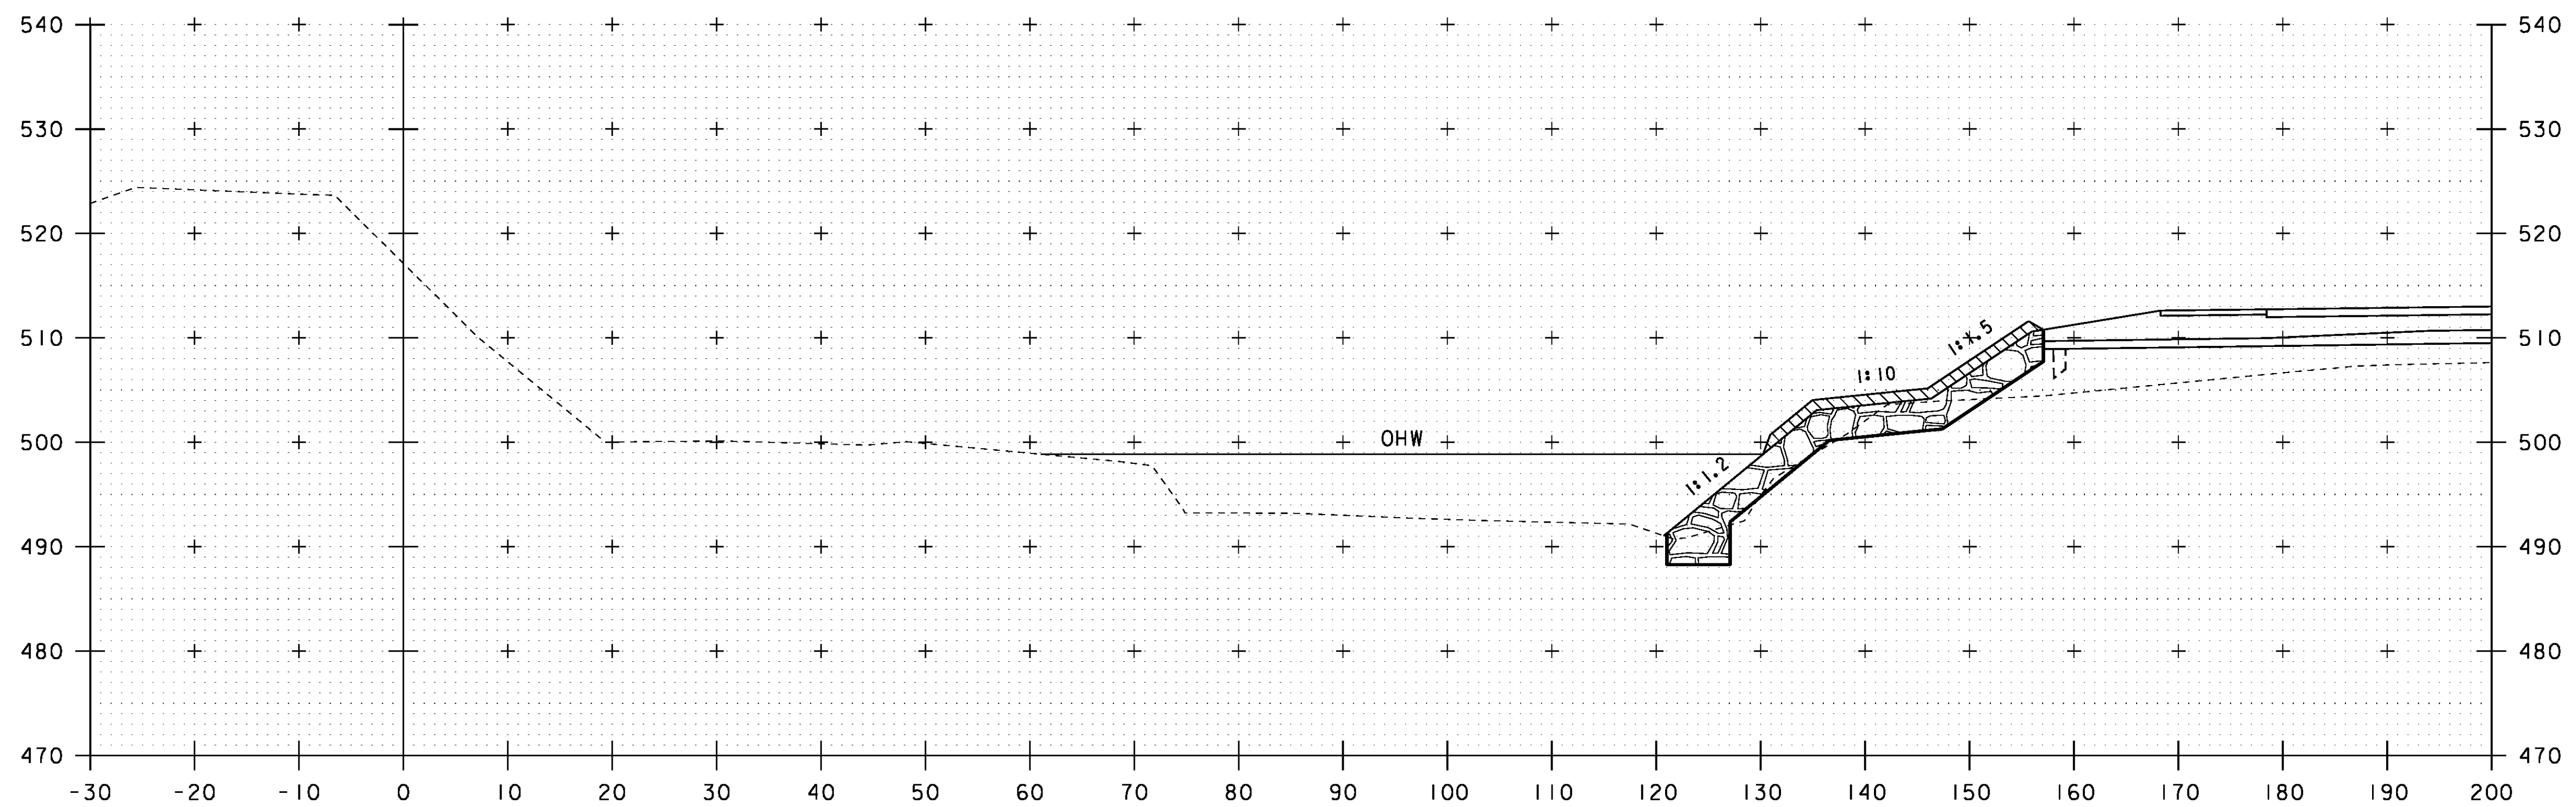


49+20

CHANNEL STA 49+19.6 FAR RT  
 BEGIN STRUCTURE EXCAVATION  
 GRANULAR BACKFILL FOR STRUCTURES

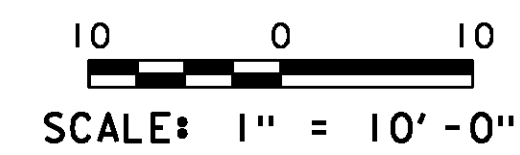


STA. 49+20 TO STA. 49+30

PROJECT NAME:	ROYALTON	FILE NAME:	\BR 27\s86e055xsl.27.dgn	PROJECT LEADER:	C. CARLSON	DESIGNED BY:	G. ROY	BRIDGE 27 CHANNEL LINE CROSS SECTIONS (2) SHEET	65 OF 186
PROJECT NUMBER:	BRS 0147 (13)	PLLOT DATE:	08-OCT-2013	DRAWN BY:	G. ROY	CHECKED BY:	D. PETERSON		

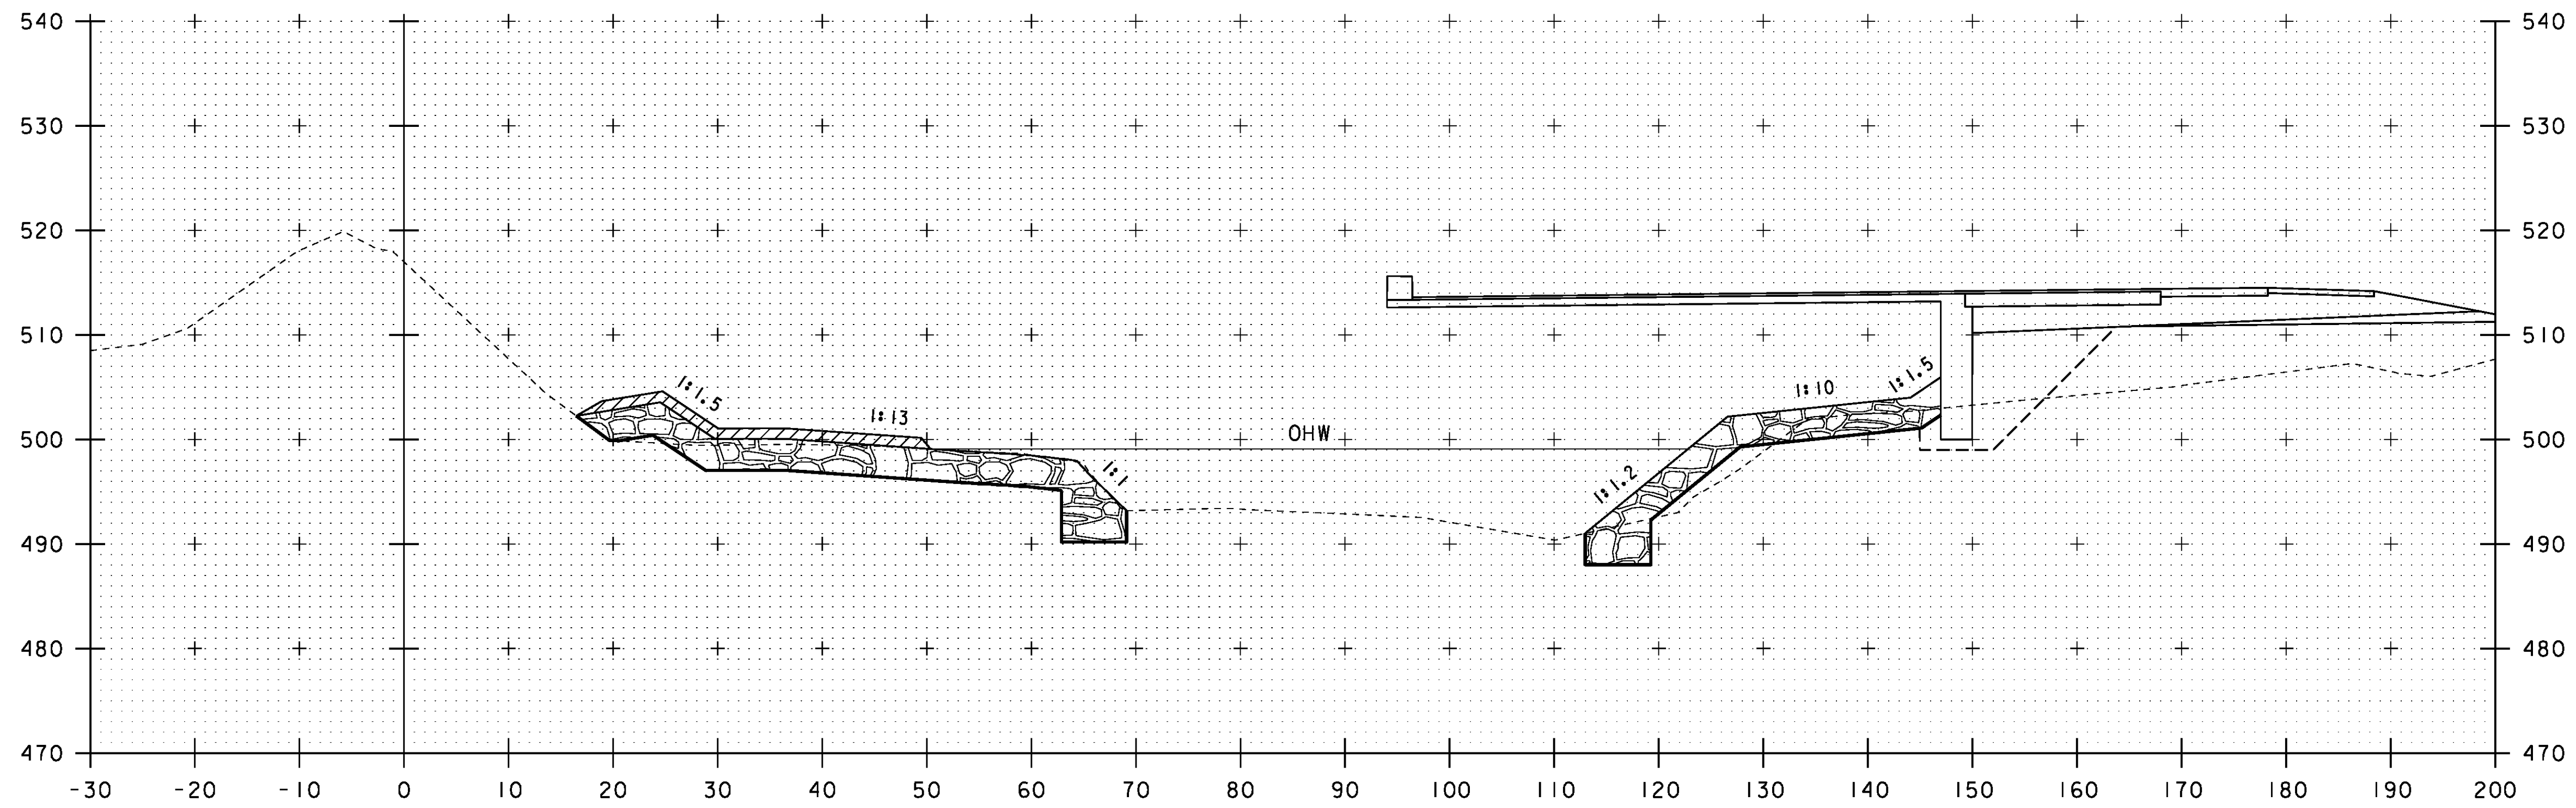


49+50

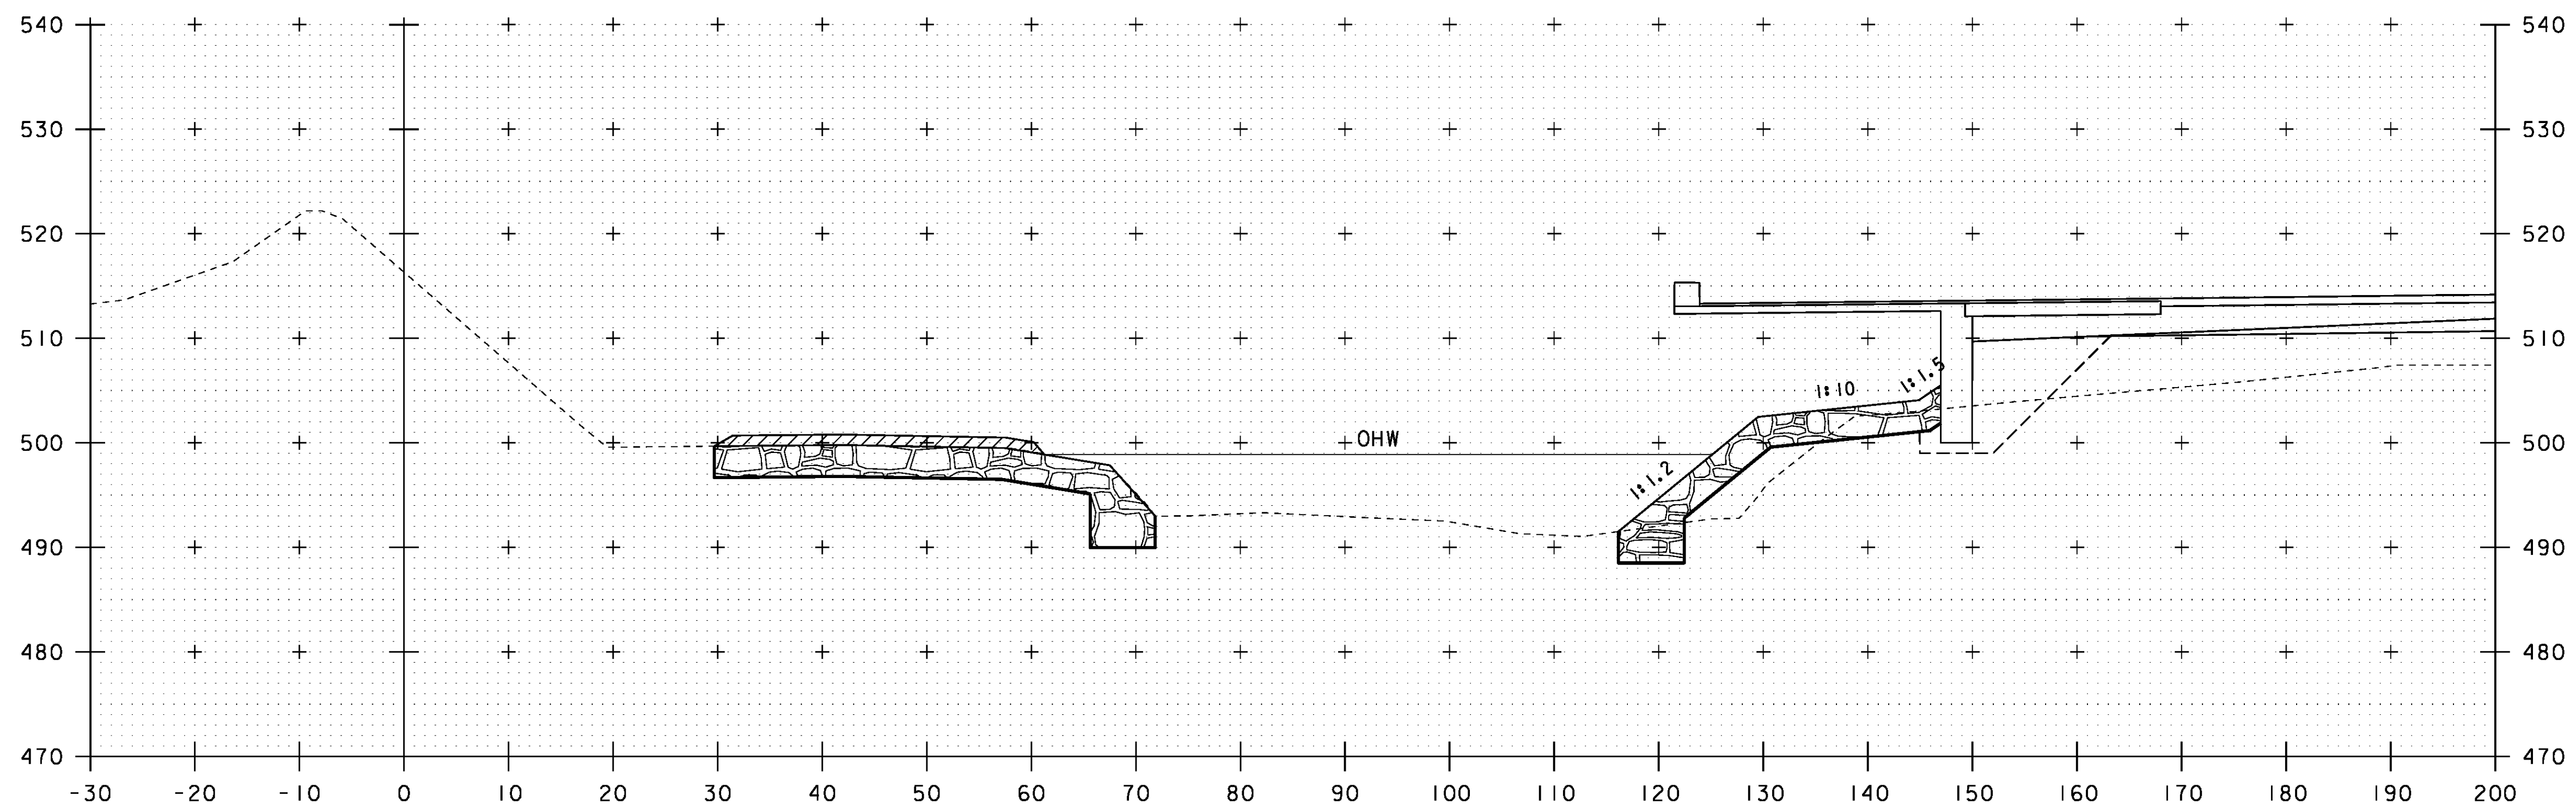




49+40

CHANNEL STA 49+40.0 RT  
 BEGIN UNCLASSIFIED CHANNEL EXCAVATION  
 GEOTEXTILE UNDER STONE FILL  
 STONE FILL, TYPE III  
 GRUBBING MATERIAL

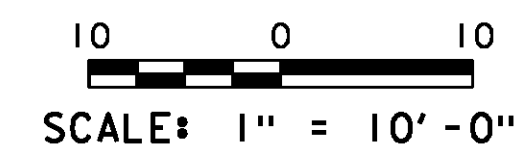


STA. 49+40 TO STA. 49+50

PROJECT NAME:	ROYALTON	PROJECT LEADER:	C. CARLSON	DESIGNED BY:	G. ROY	BRIDGE 27 CHANNEL LINE CROSS SECTIONS (3) SHEET	66 OF 186
PROJECT NUMBER:	BRS 0147 (13)	FILE NAME:	\BR 27\s86e055xsl.27.dgn	DRAWN BY:	G. ROY	PLOT DATE:	08-OCT-2013
				CHECKED BY:	D. PETERSON		

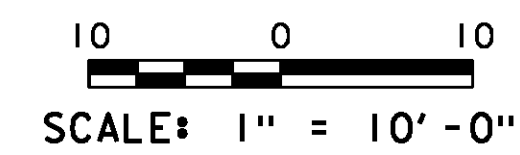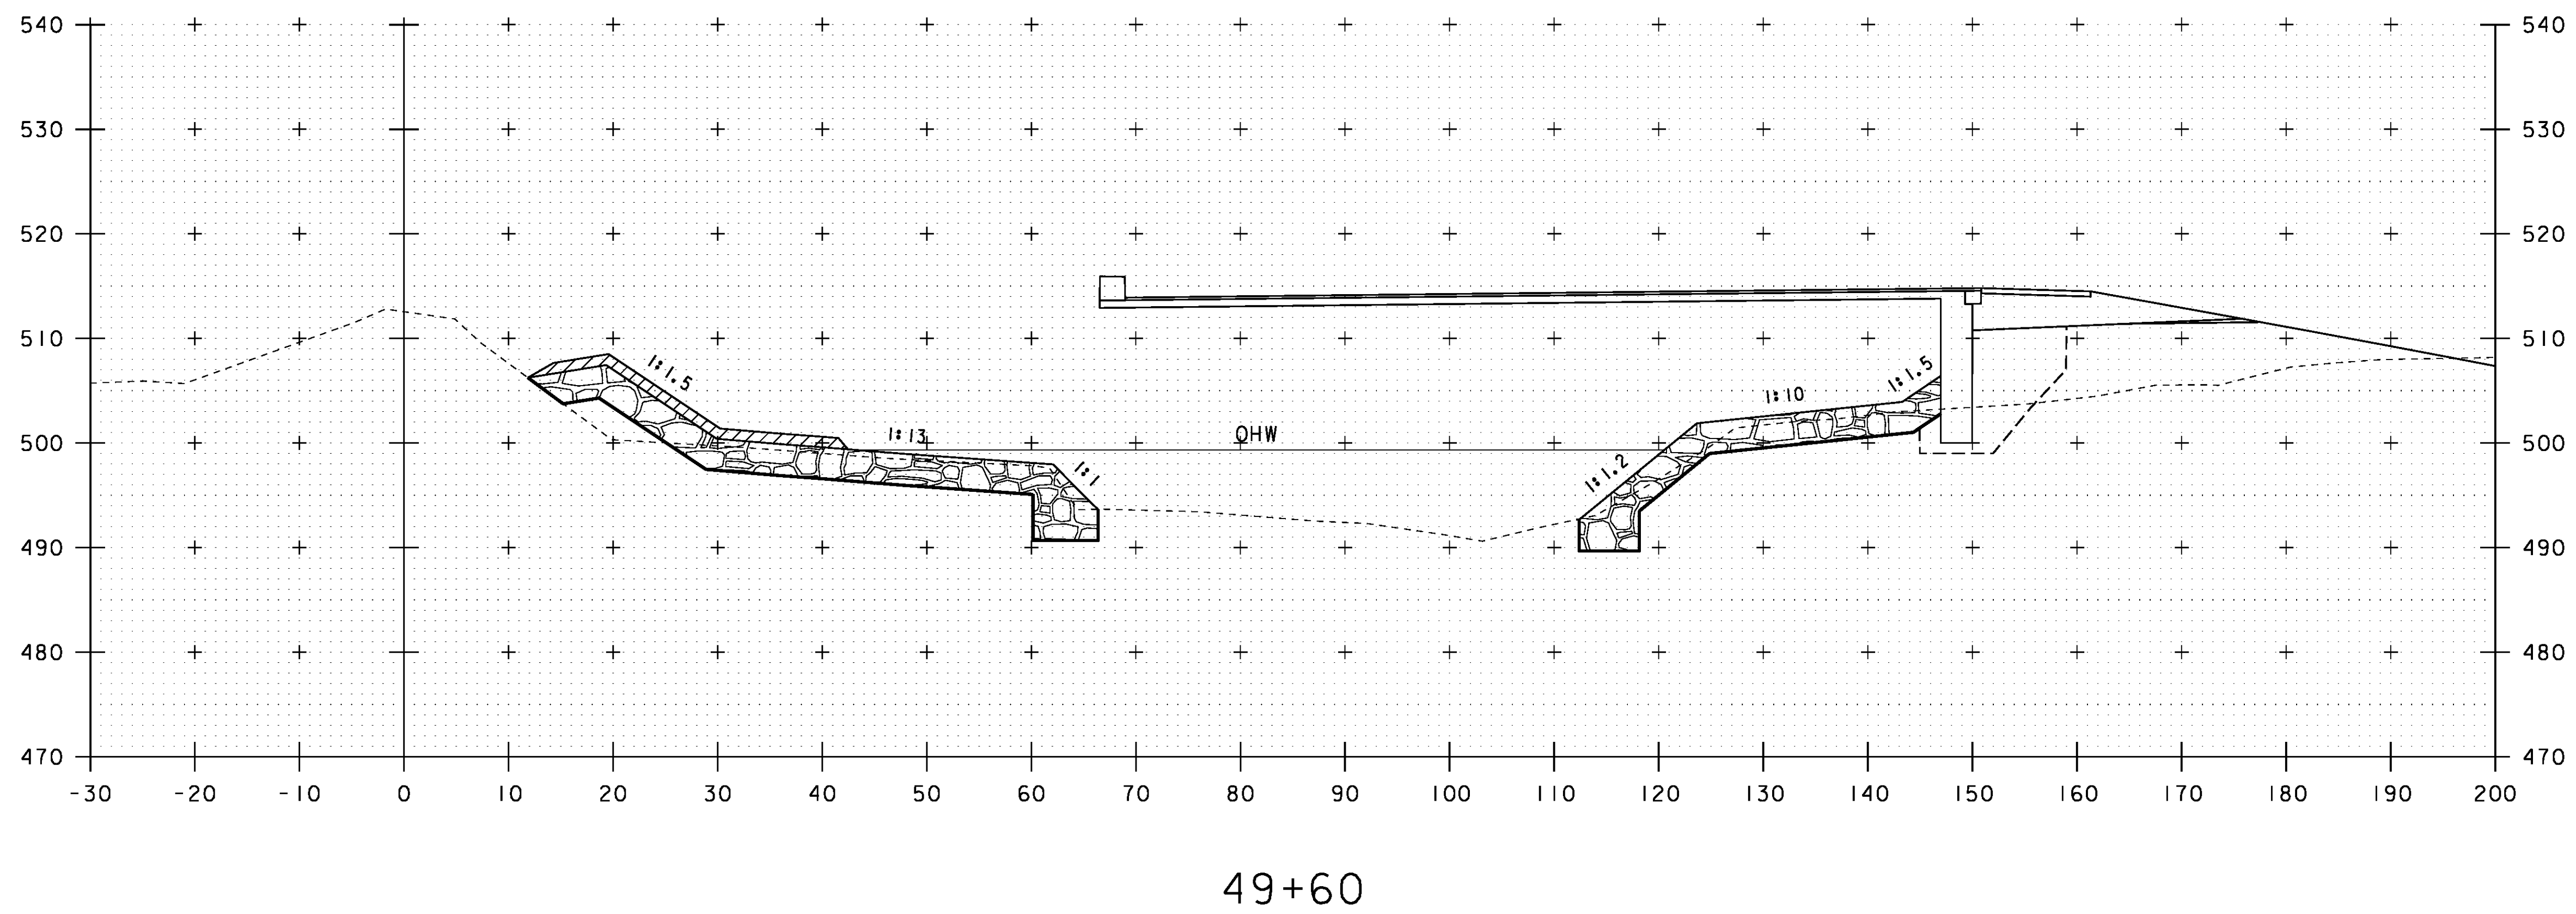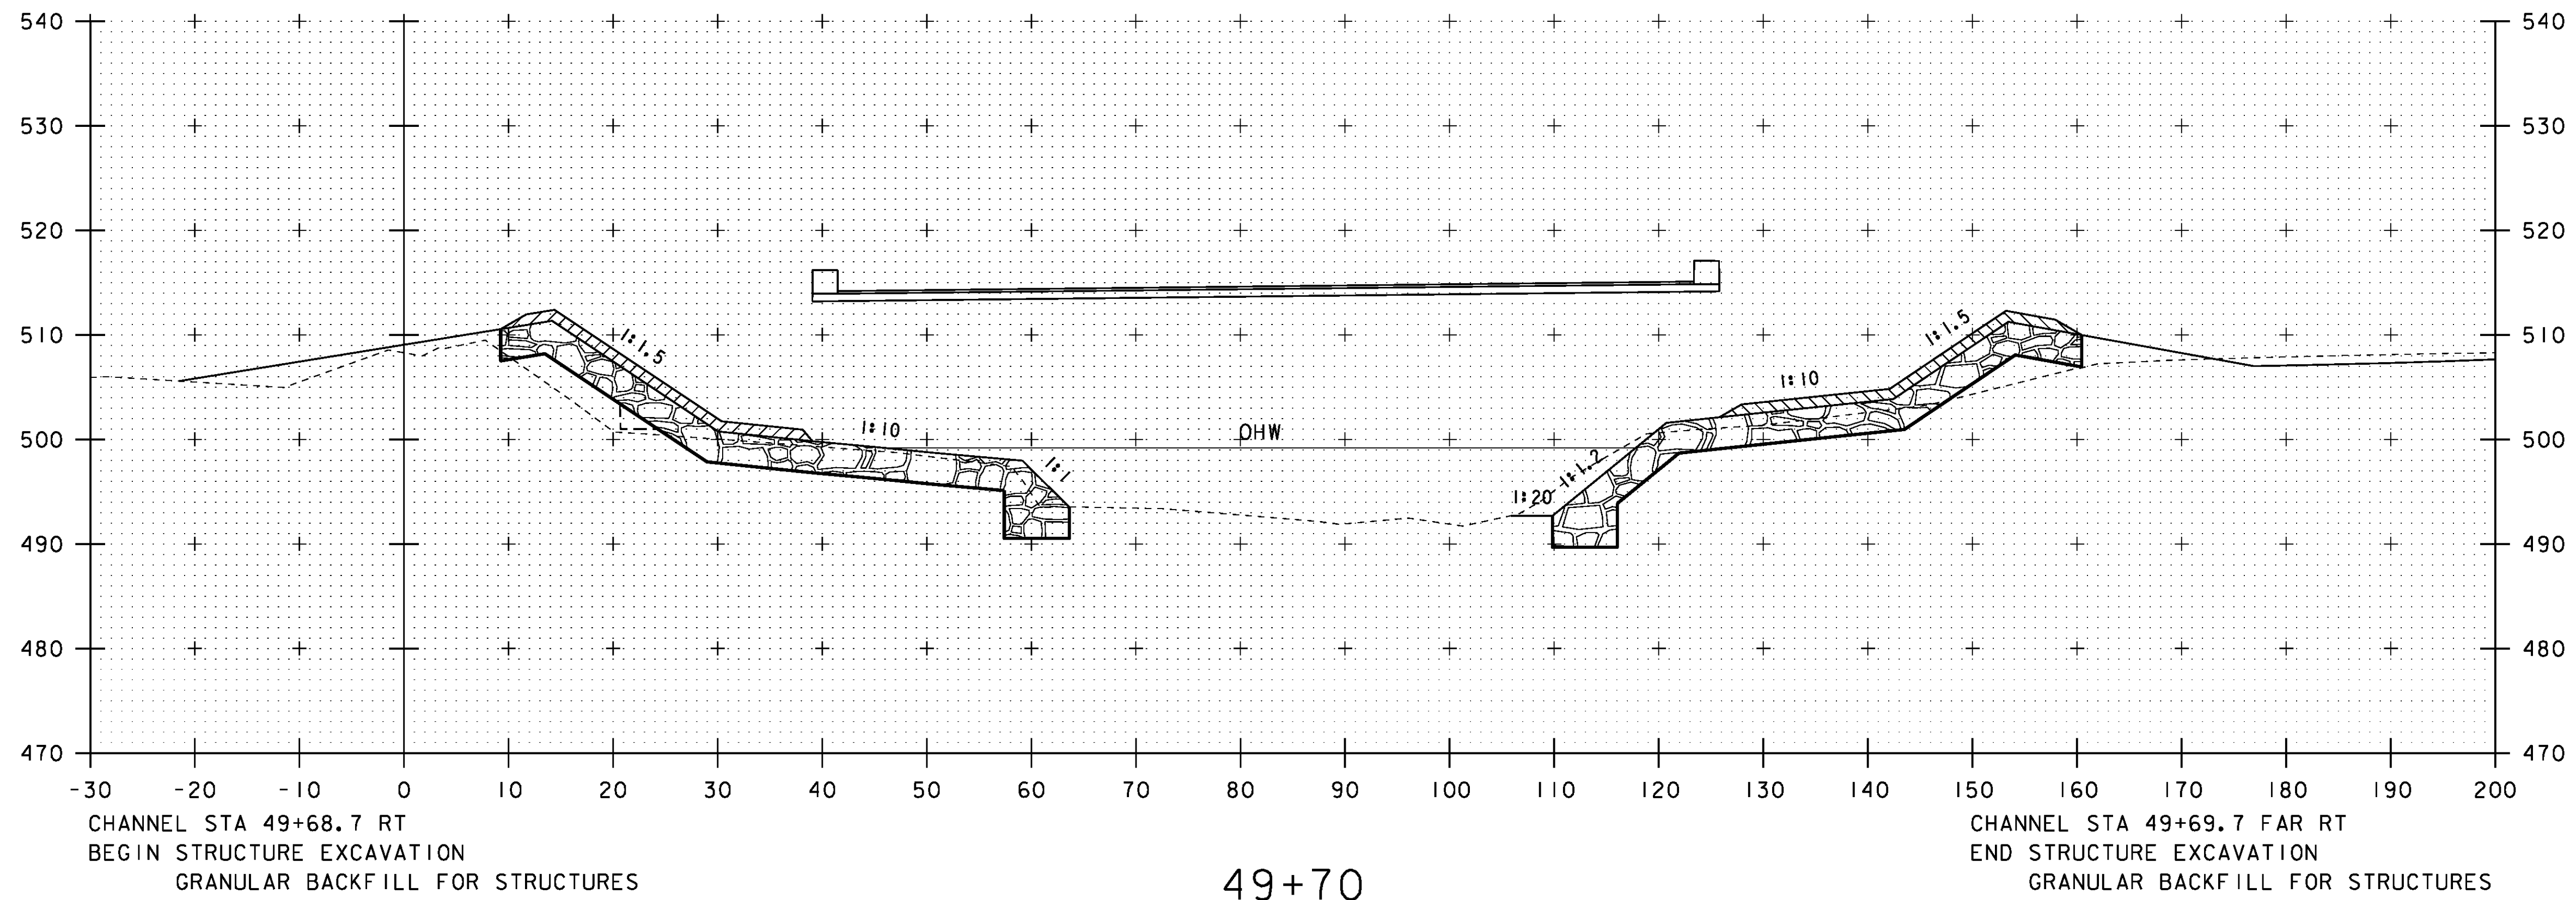


STA. 49+60 TO STA. 49+70


PROJECT NAME:	ROYALTON
PROJECT NUMBER:	BRS 0147 (13)
FILE NAME:	\BR 27\s86e055xsl.27.dgn
PROJECT LEADER:	C. CARLSON
DESIGNED BY:	G. ROY
BRIDGE 27 CHANNEL LINE CROSS SECTIONS (4) SHEET	67 OF 186
PLOT DATE:	08-OCT-2013
DRAWN BY:	G. ROY
CHECKED BY:	D. PETERSON

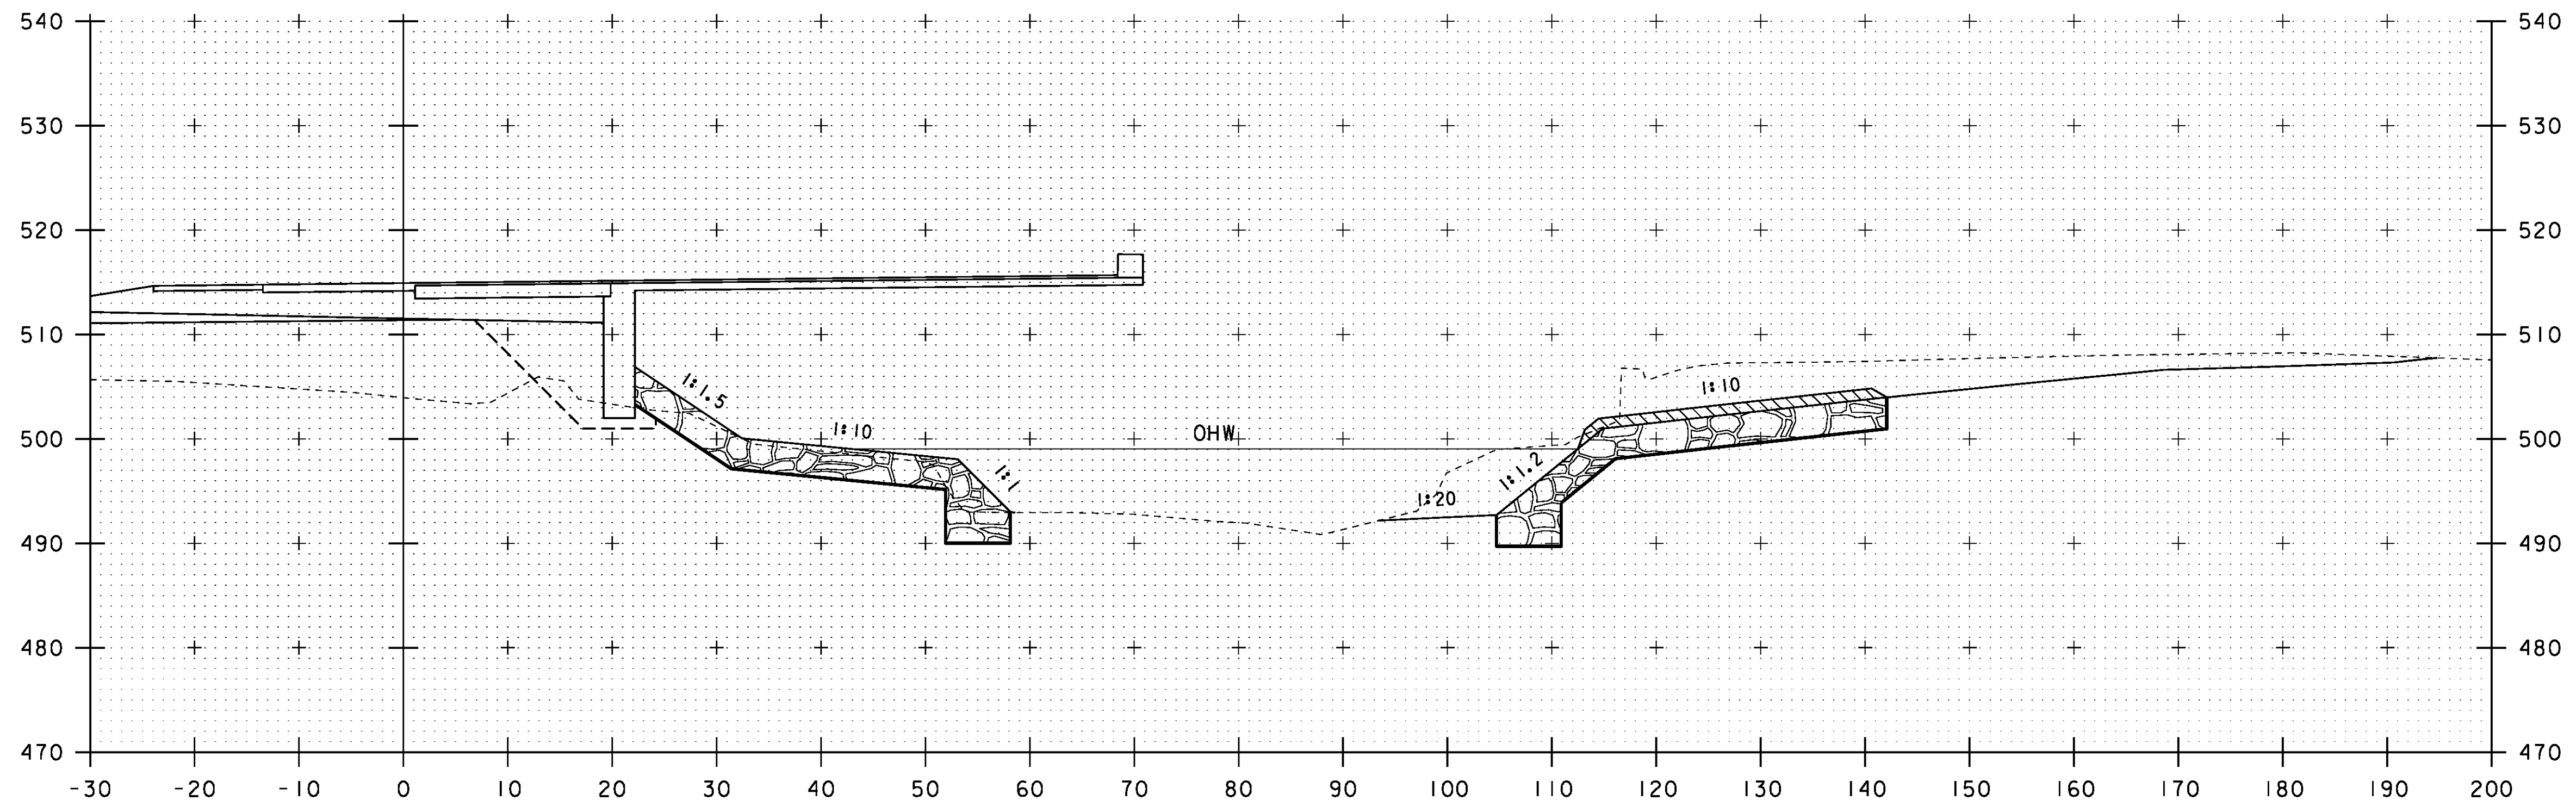

49+90

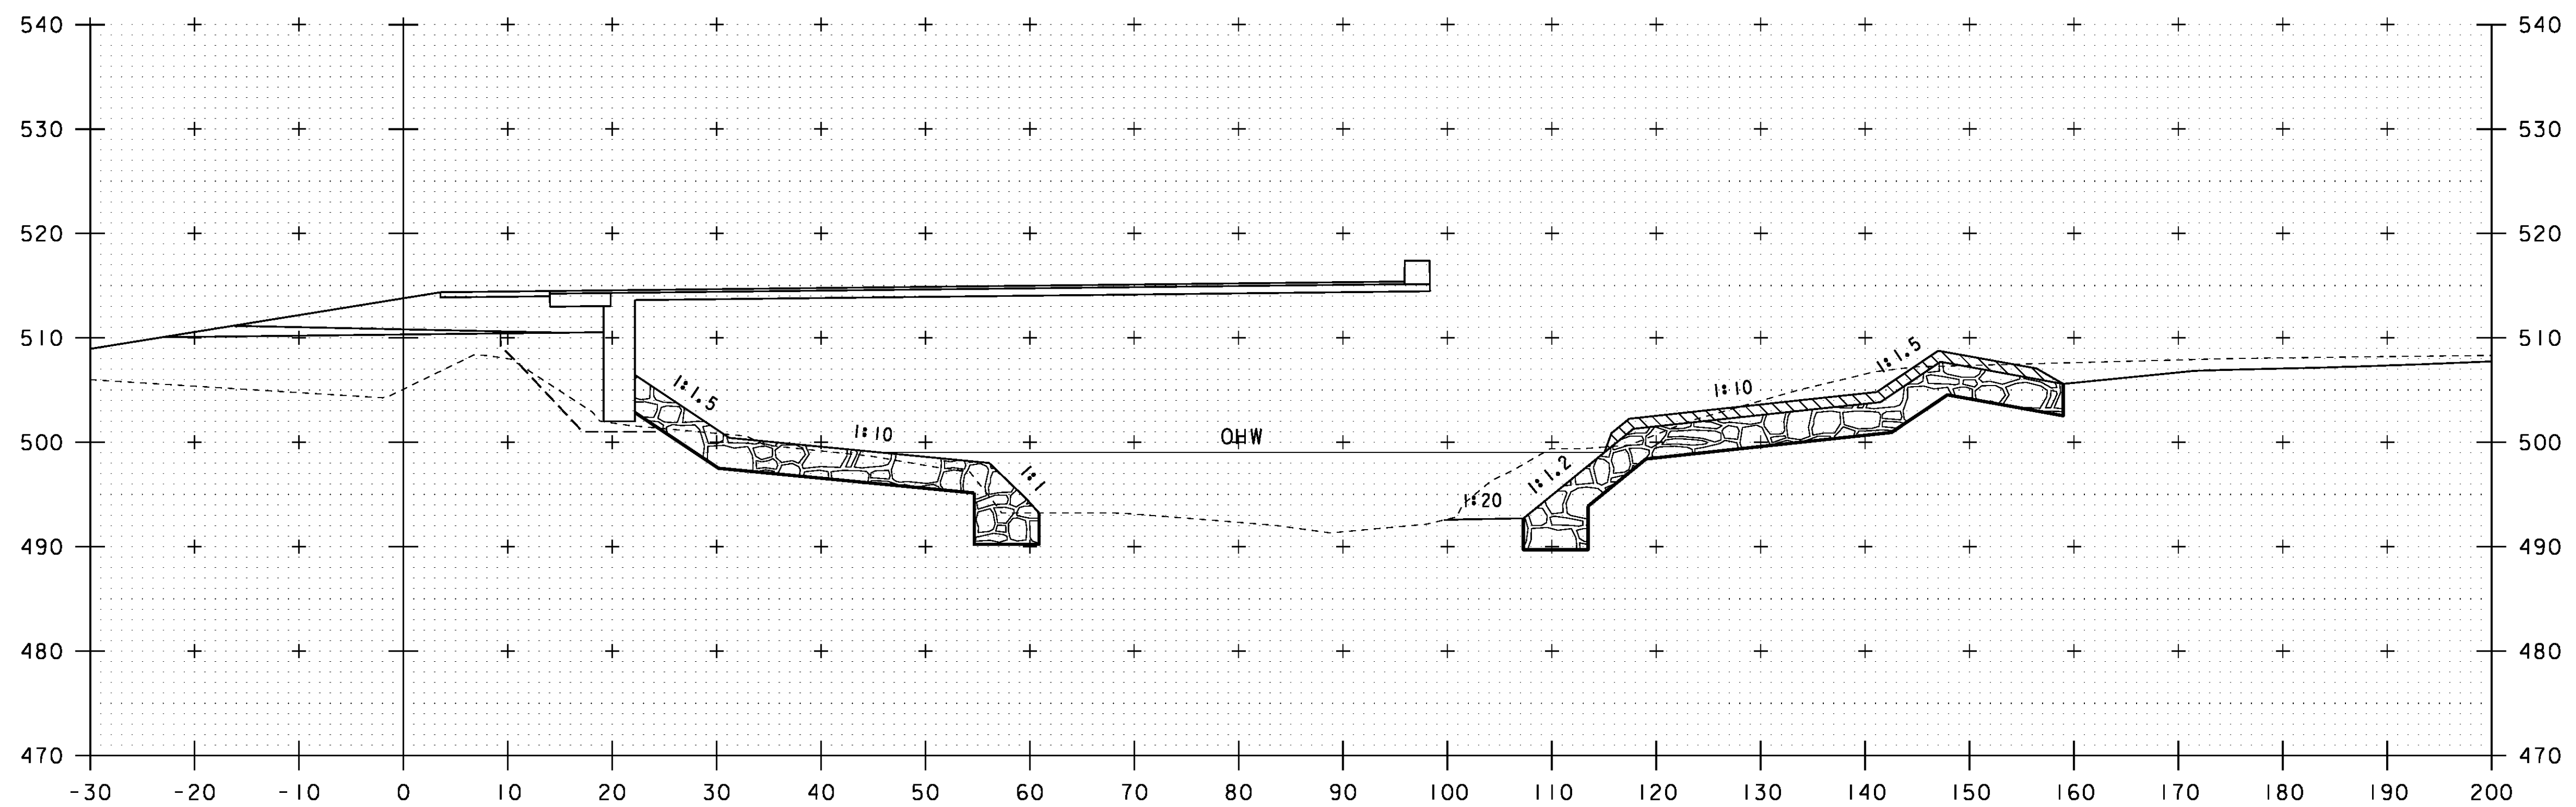


49+80

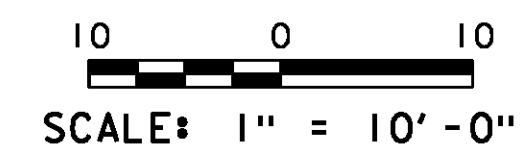


STA. 49+80 TO STA. 49+90


PROJECT NAME:	ROYALTON
PROJECT NUMBER:	BRS 0147 (13)
FILE NAME:	\BR 27\s86e055xsl.27.dgn
PROJECT LEADER:	C. CARLSON
DESIGNED BY:	G. ROY
BRIDGE 27 CHANNEL LINE CROSS SECTIONS (5) SHEET	68 OF 186
PLOT DATE:	08-OCT-2013
DRAWN BY:	G. ROY
CHECKED BY:	D. PETERSON

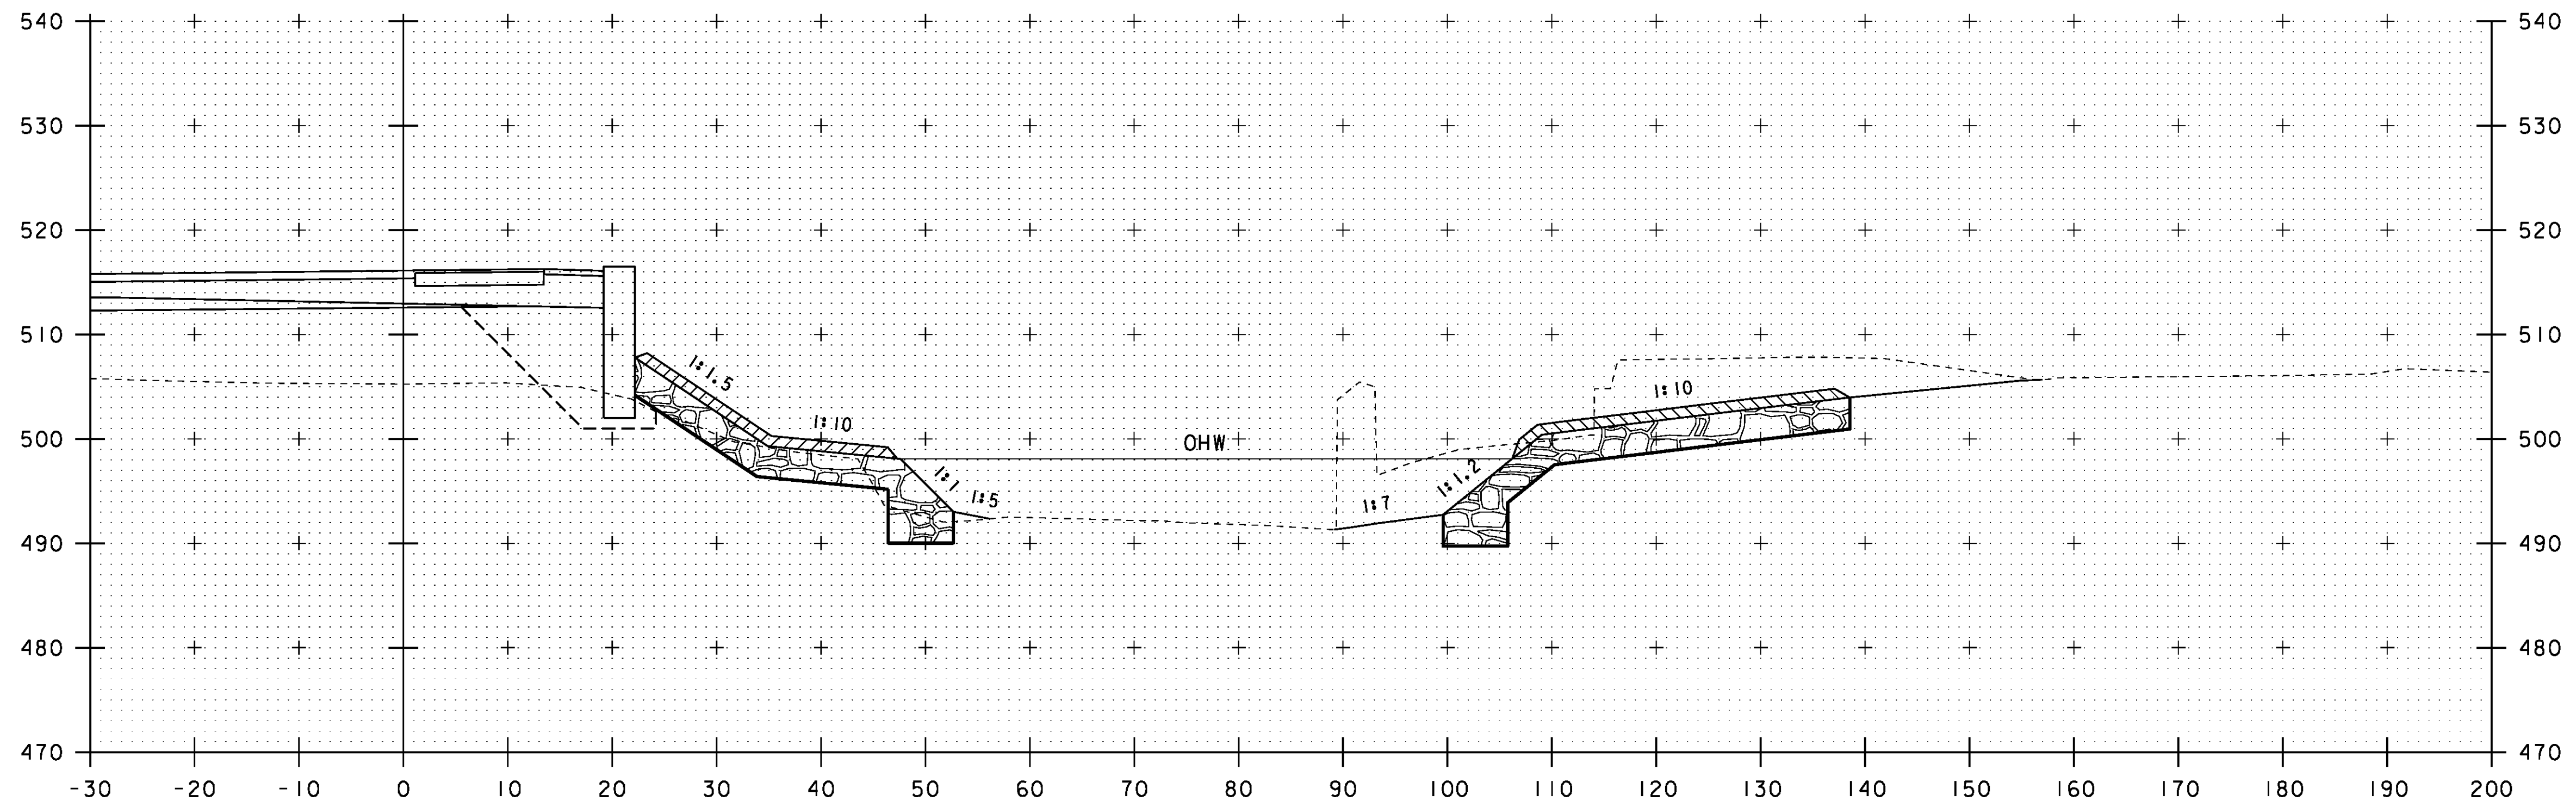

50+10

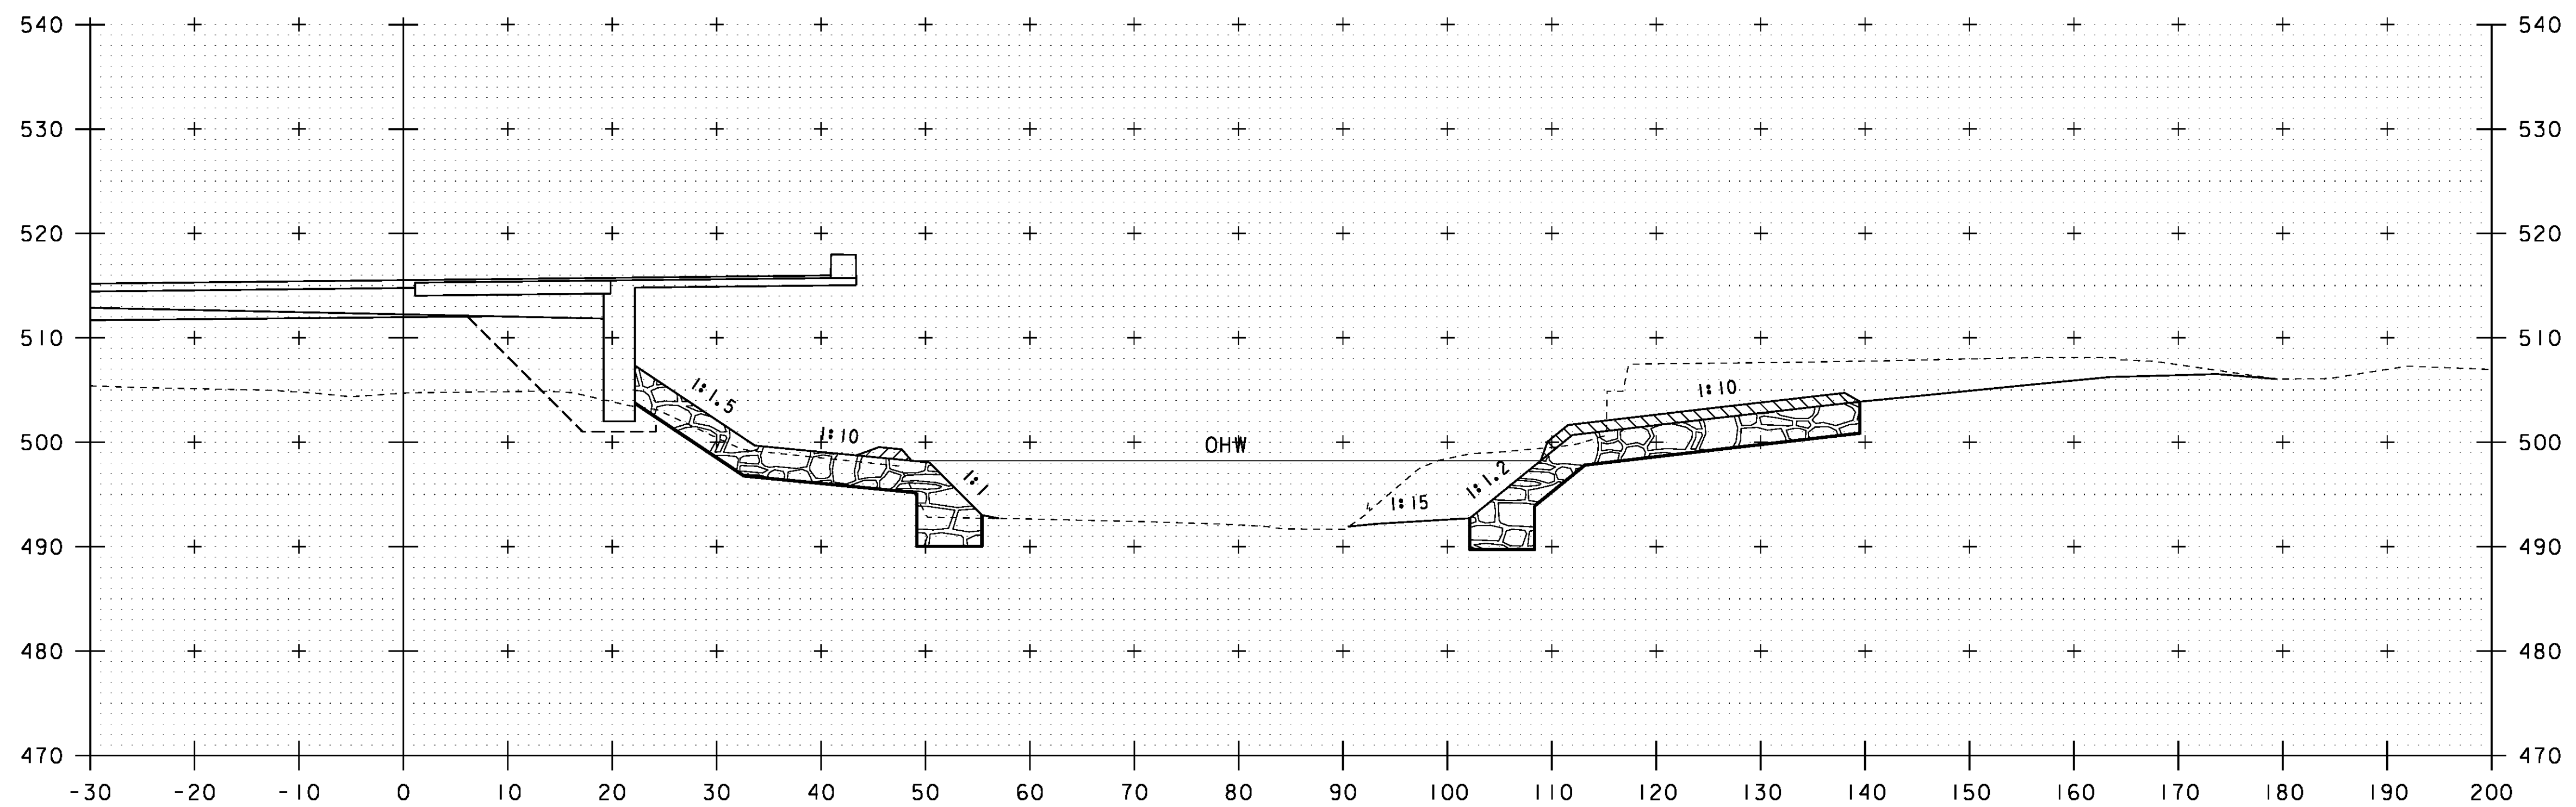


50+00

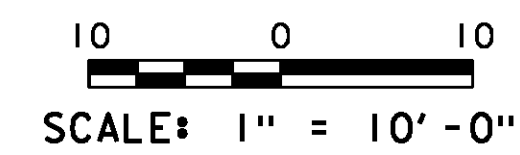


STA. 50+00 TO STA. 50+10

PROJECT NAME:	ROYALTON
PROJECT NUMBER:	BRS 0147 (13)
FILE NAME:	\BR 27\86e055xsl.27.dgn
PROJECT LEADER:	C. CARLSON
DESIGNED BY:	G. ROY
BRIDGE 27 CHANNEL LINE CROSS SECTIONS (6) SHEET	69 OF 186
PLOT DATE:	08-OCT-2013
DRAWN BY:	G. ROY
CHECKED BY:	D. PETERSON

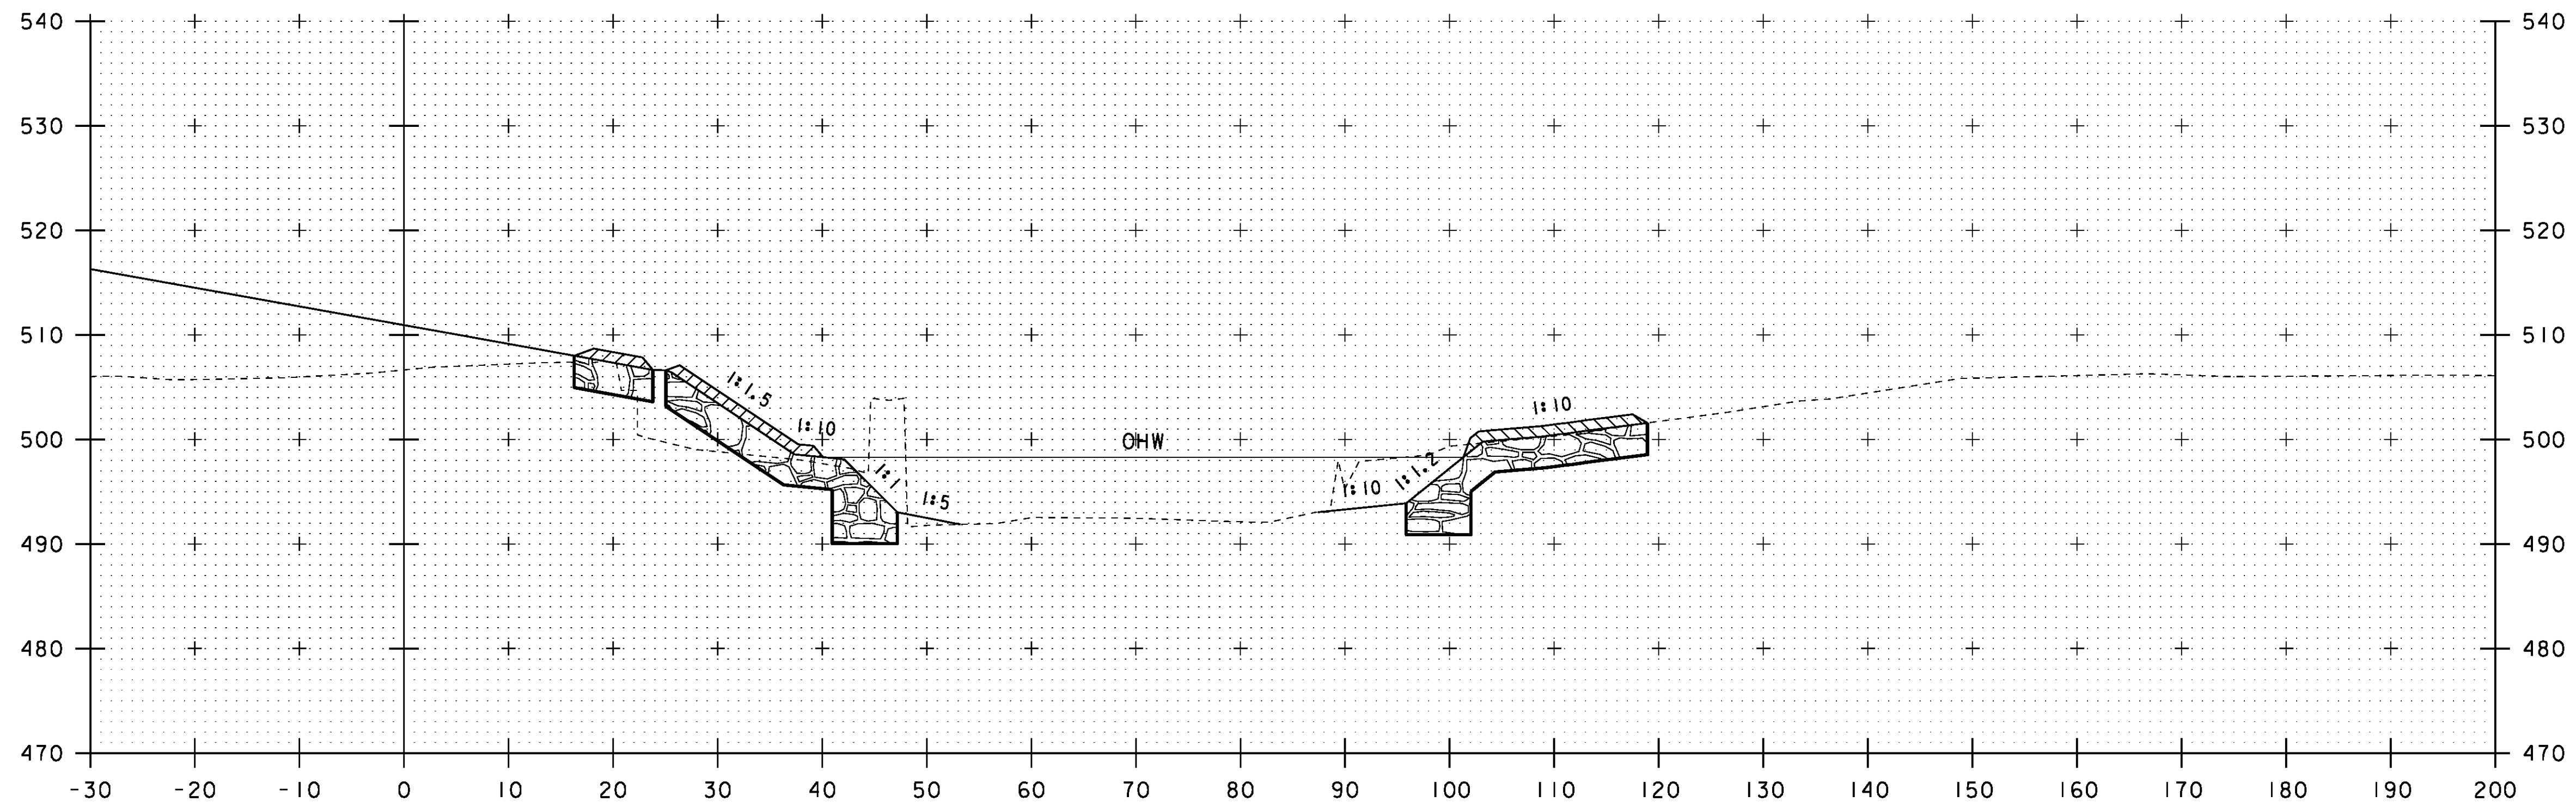


50+30

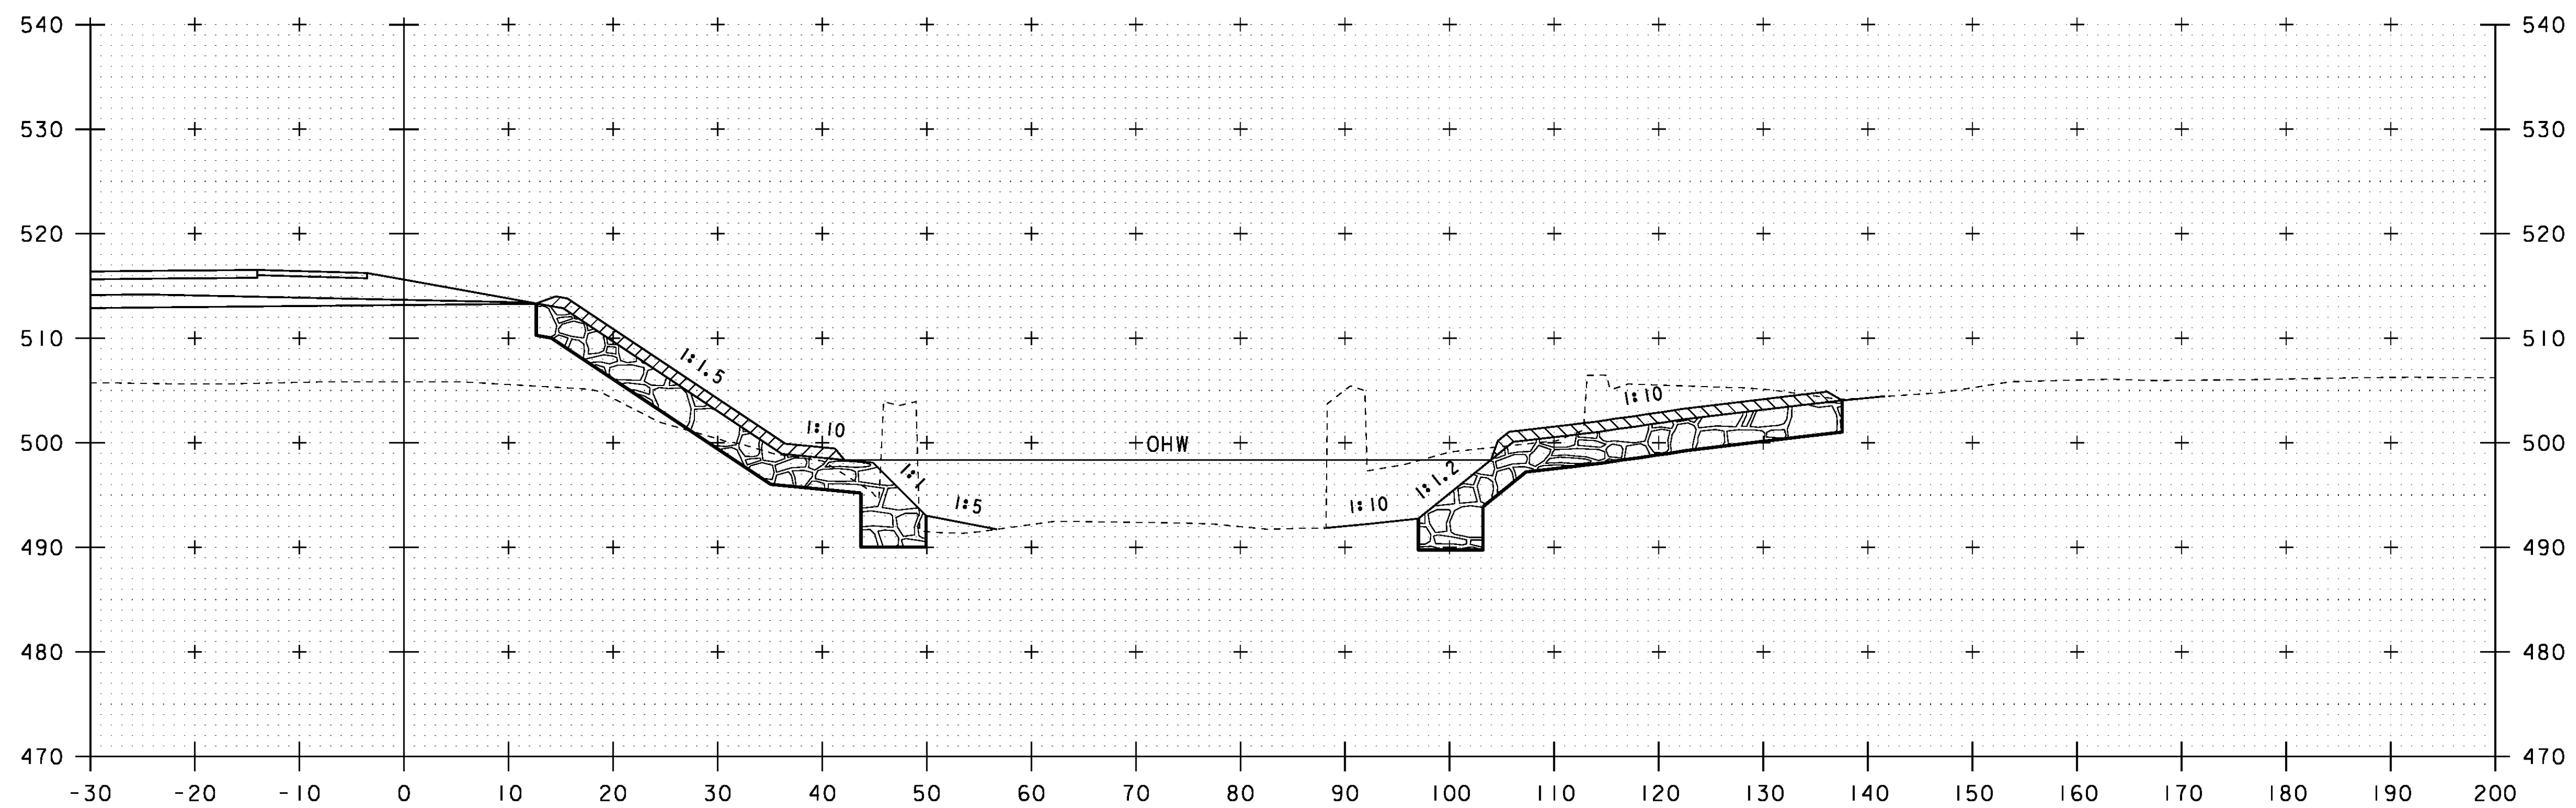

CHANNEL STA 50+18.8 RT  
 END STRUCTURE EXCAVATION  
 GRANULAR BACKFILL FOR STRUCTURES

50+20

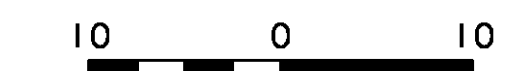


SCALE: 1" = 10'-0"

STA. 50+20 TO STA. 50+30


PROJECT NAME: ROYALTON  
 PROJECT NUMBER: BRS 0147 (13)

FILE NAME: \BR 27\86e055xsl.27.dgn PLOT DATE: 08-OCT-2013  
 PROJECT LEADER: C. CARLSON DRAWN BY: G. ROY  
 DESIGNED BY: G. ROY CHECKED BY: D. PETERSON  
 BRIDGE 27 CHANNEL LINE CROSS SECTIONS (7) SHEET 70 OF 186

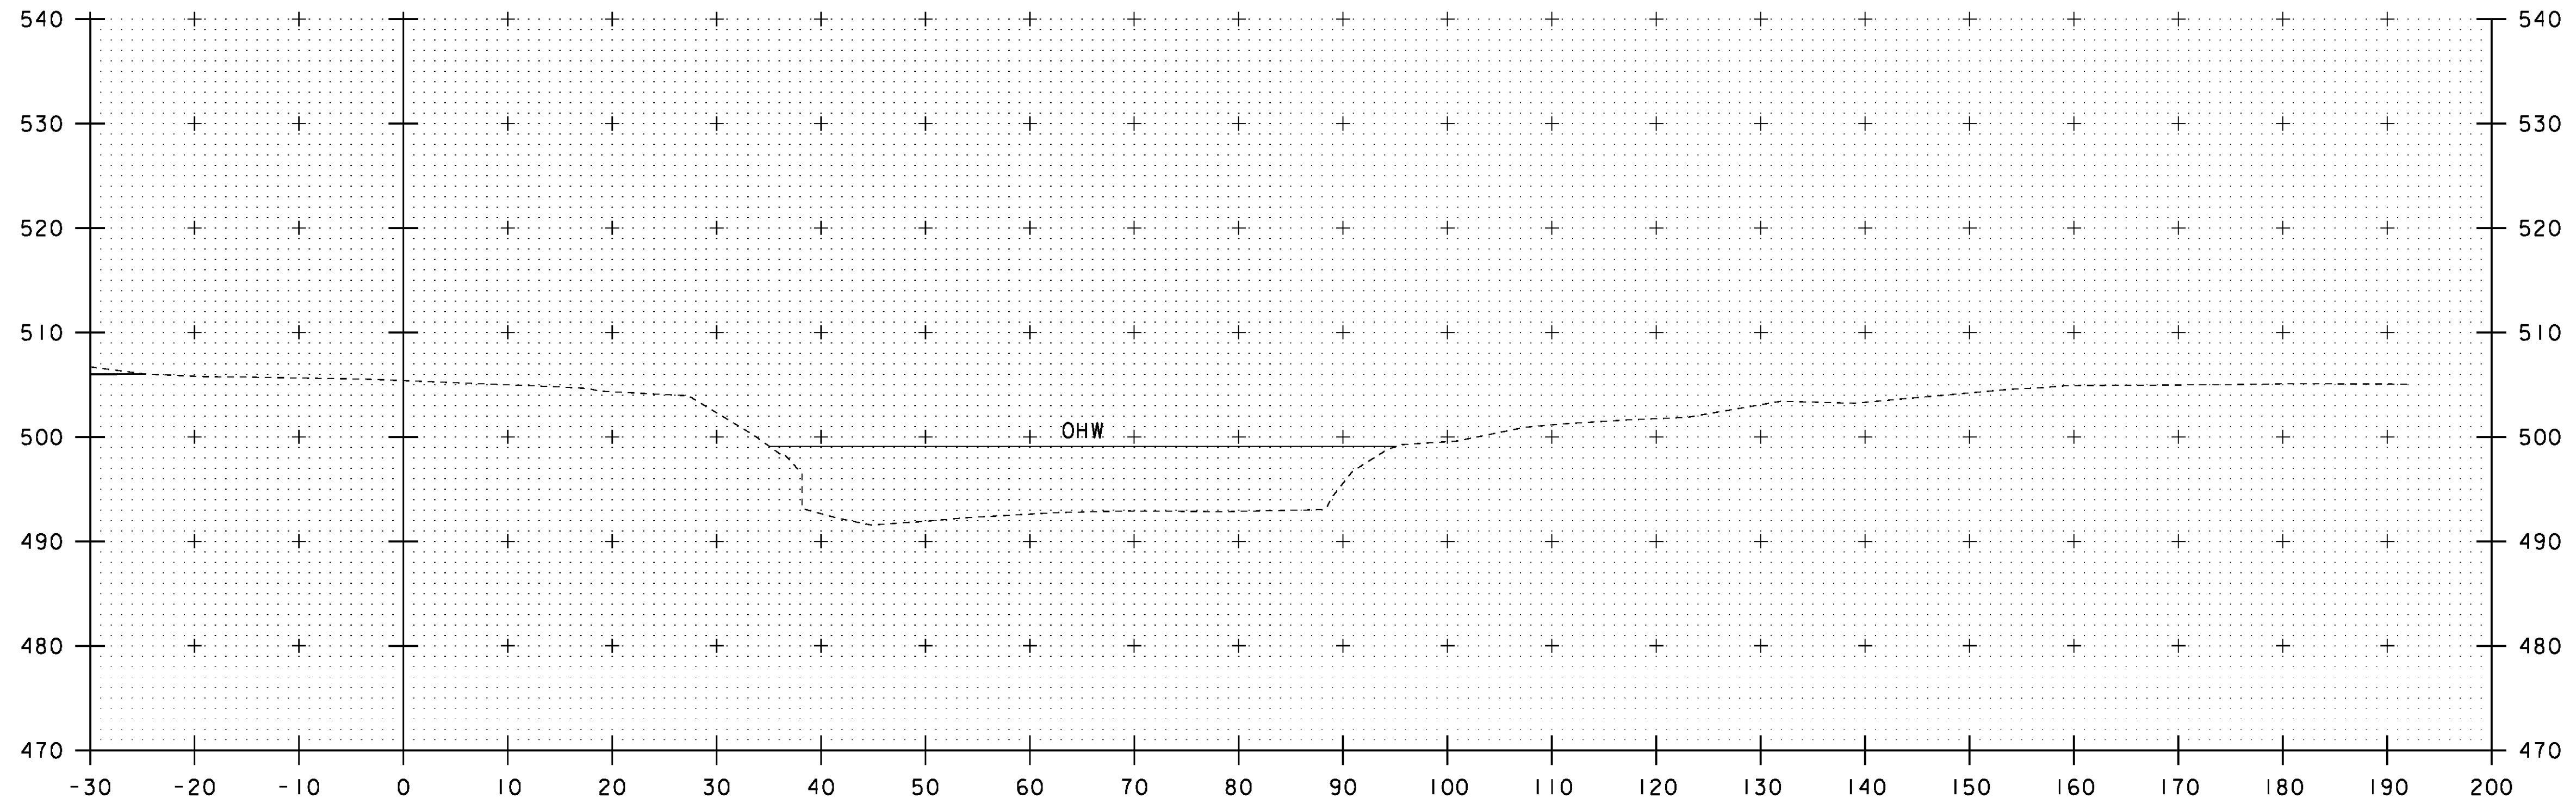


CHANNEL STA 50+64.1 RT  
 END UNCLASSIFIED CHANNEL EXCAVATION  
 GEOTEXTILE UNDER STONE FILL  
 STONE FILL, TYPE III  
 GRUBBING MATERIAL

50+75

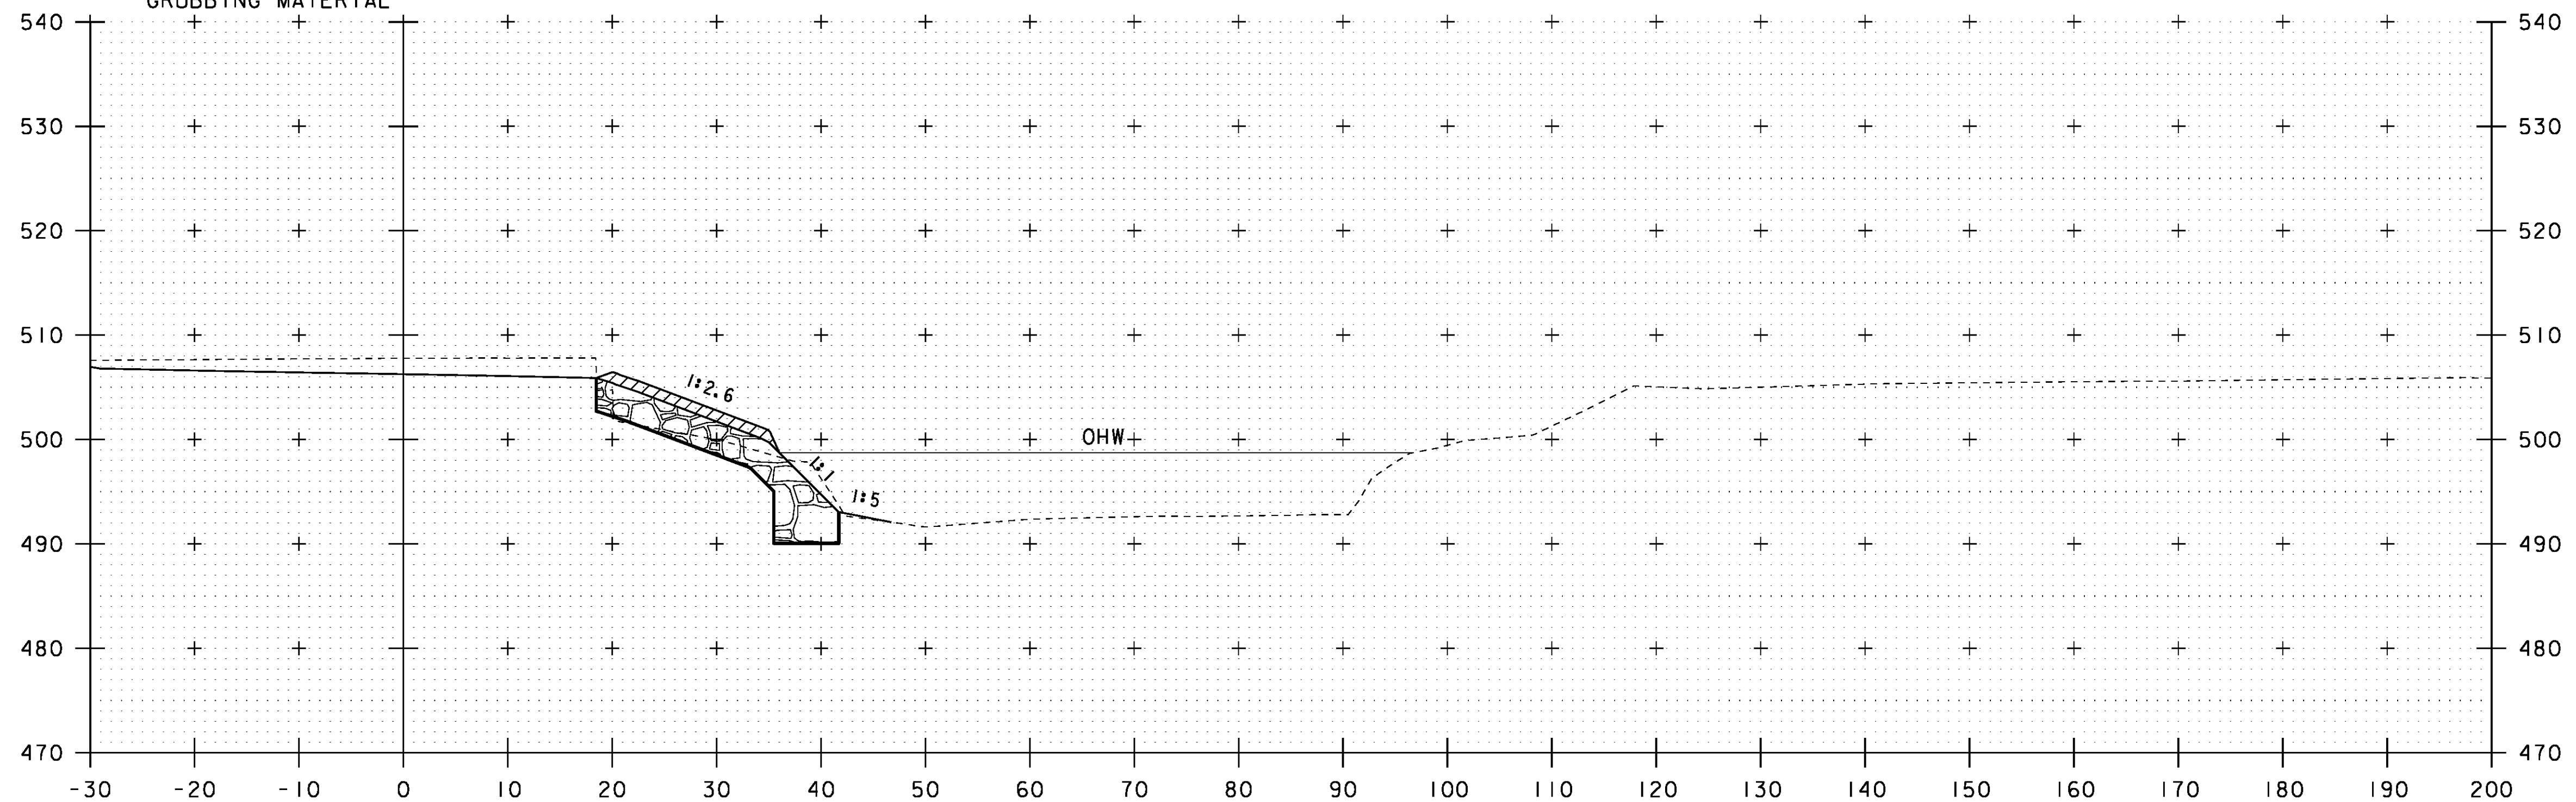

CHANNEL STA 50+40.6 FAR RT  
 END UNCLASSIFIED CHANNEL EXCAVATION  
 GEOTEXTILE UNDER STONE FILL  
 STONE FILL, TYPE III  
 GRUBBING MATERIAL

50+50




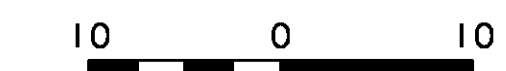


SCALE: 1" = 10'-0"

STA. 50+50 TO STA. 50+75


PROJECT NAME: ROYALTON  
 PROJECT NUMBER: BRS 0147 (13)

FILE NAME: \BR 27\s86e055xsl.27.dgn PLOT DATE: 08-OCT-2013  
 PROJECT LEADER: C. CARLSON DRAWN BY: G. ROY  
 DESIGNED BY: G. ROY CHECKED BY: D. PETERSON  
 BRIDGE 27 CHANNEL LINE CROSS SECTIONS (8) SHEET 71 OF 186

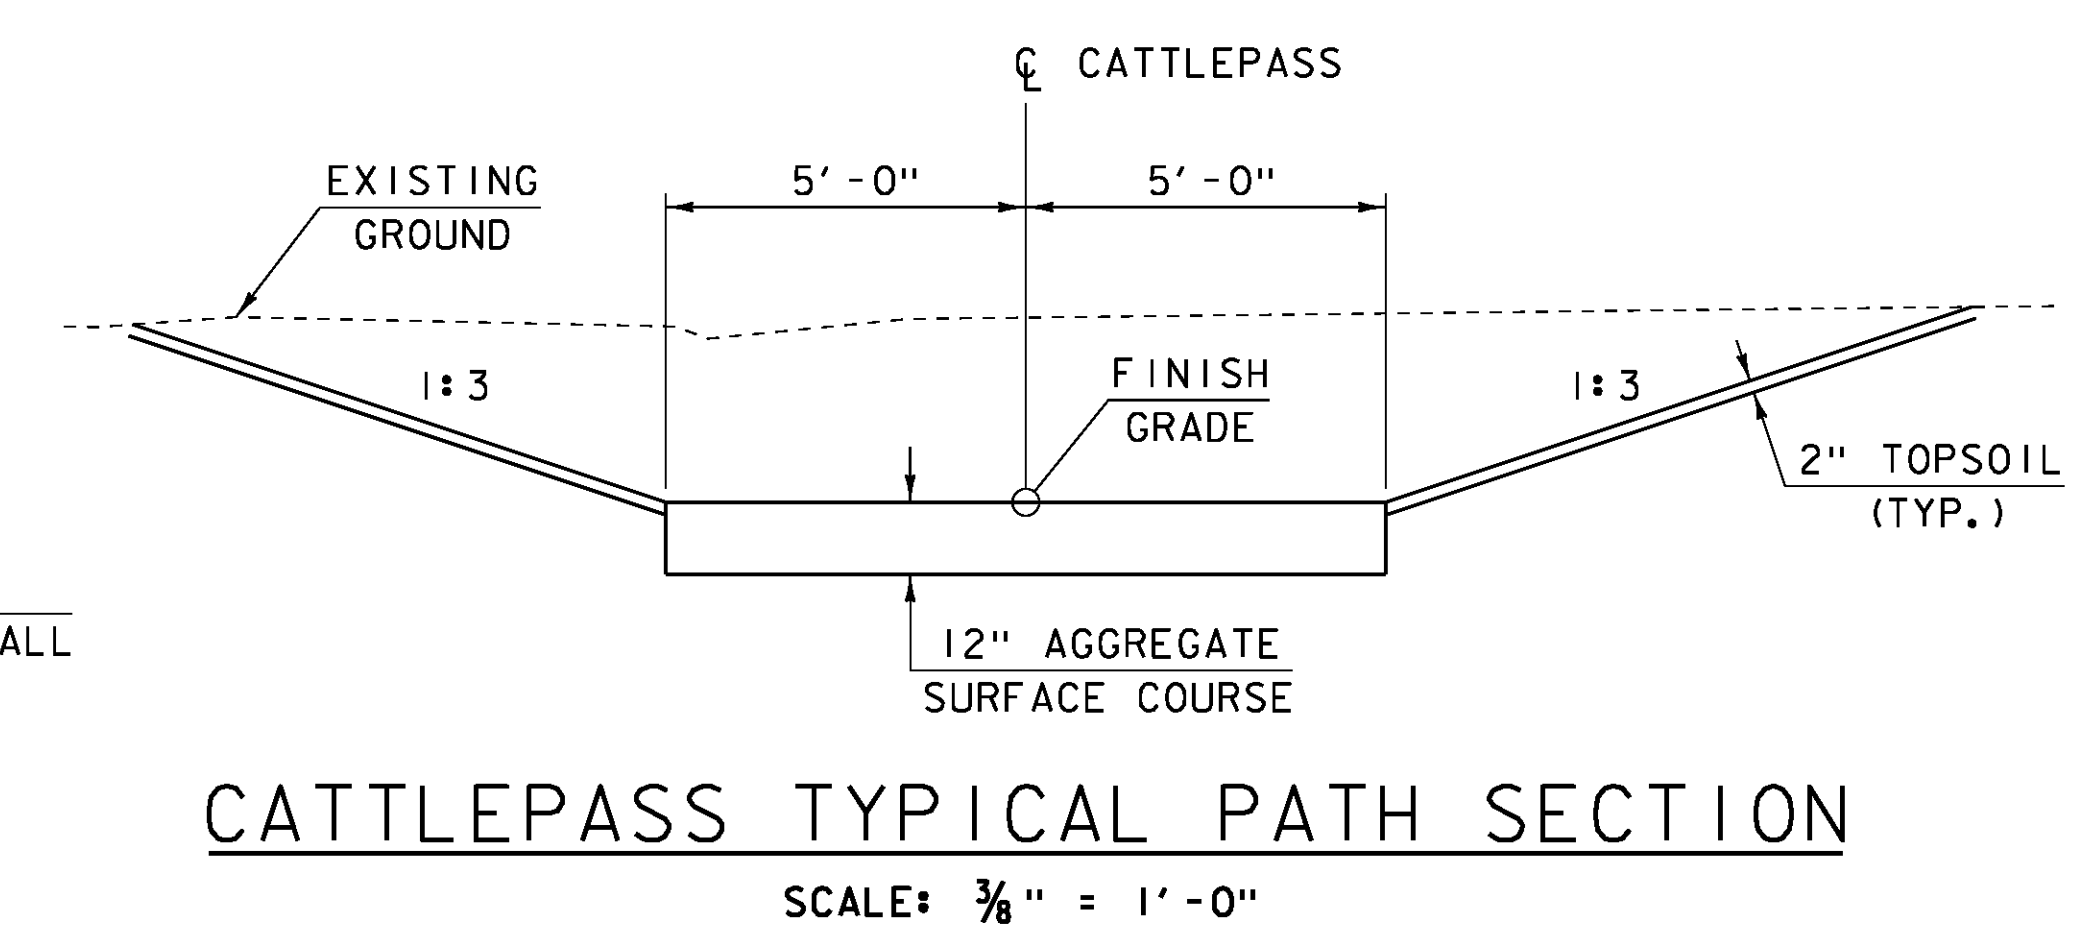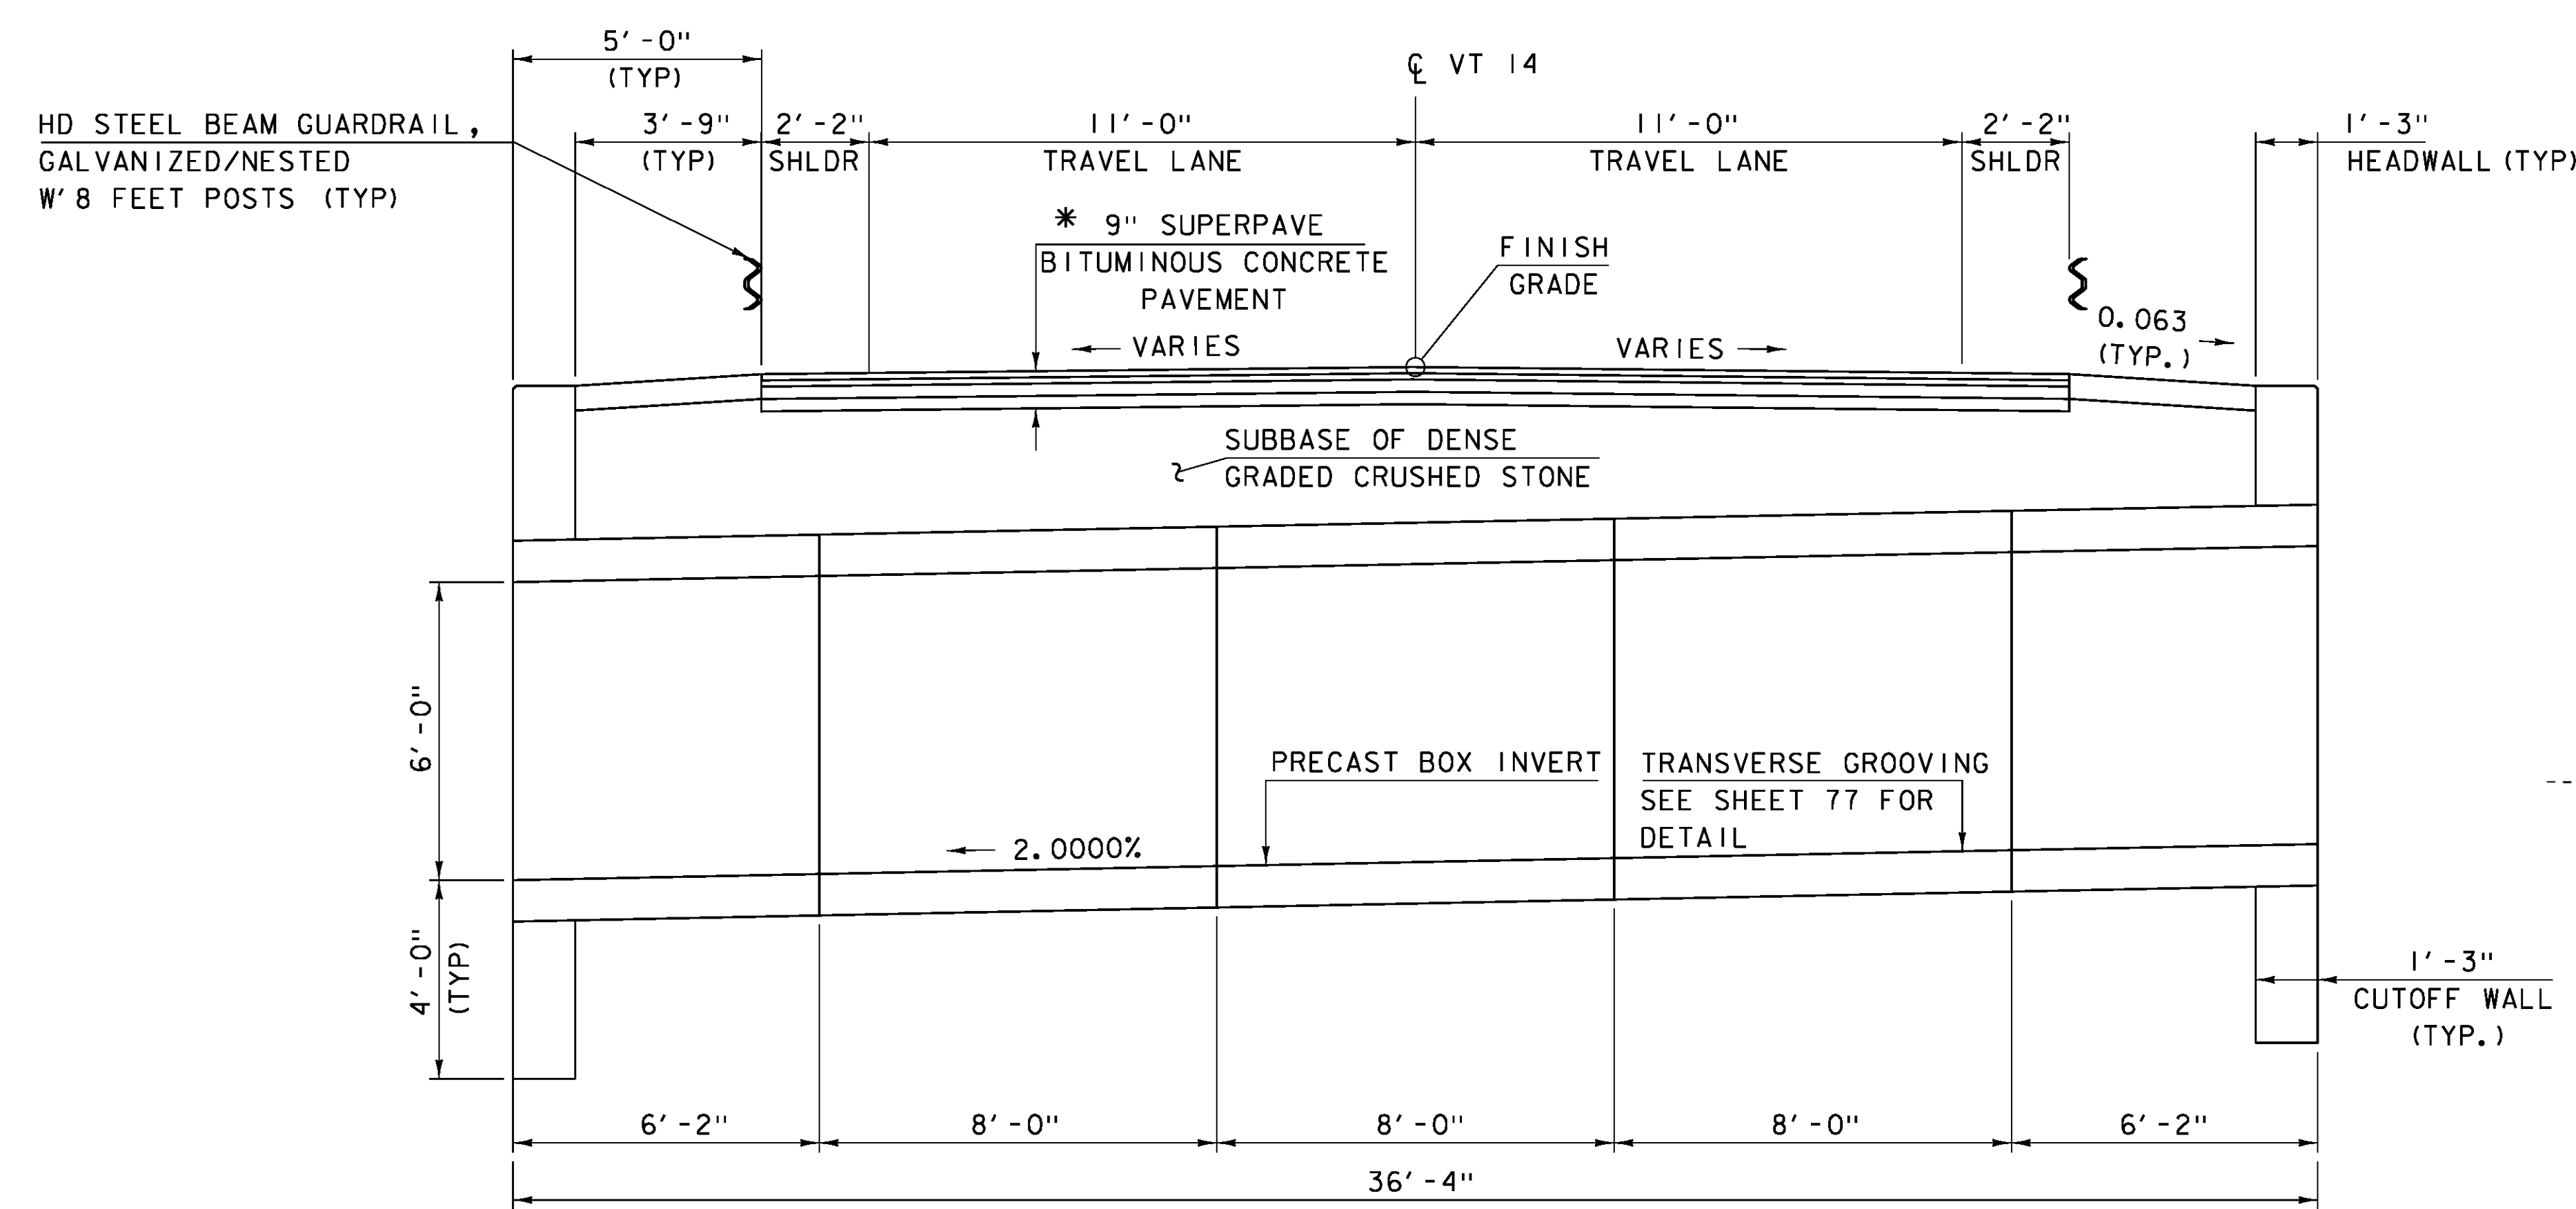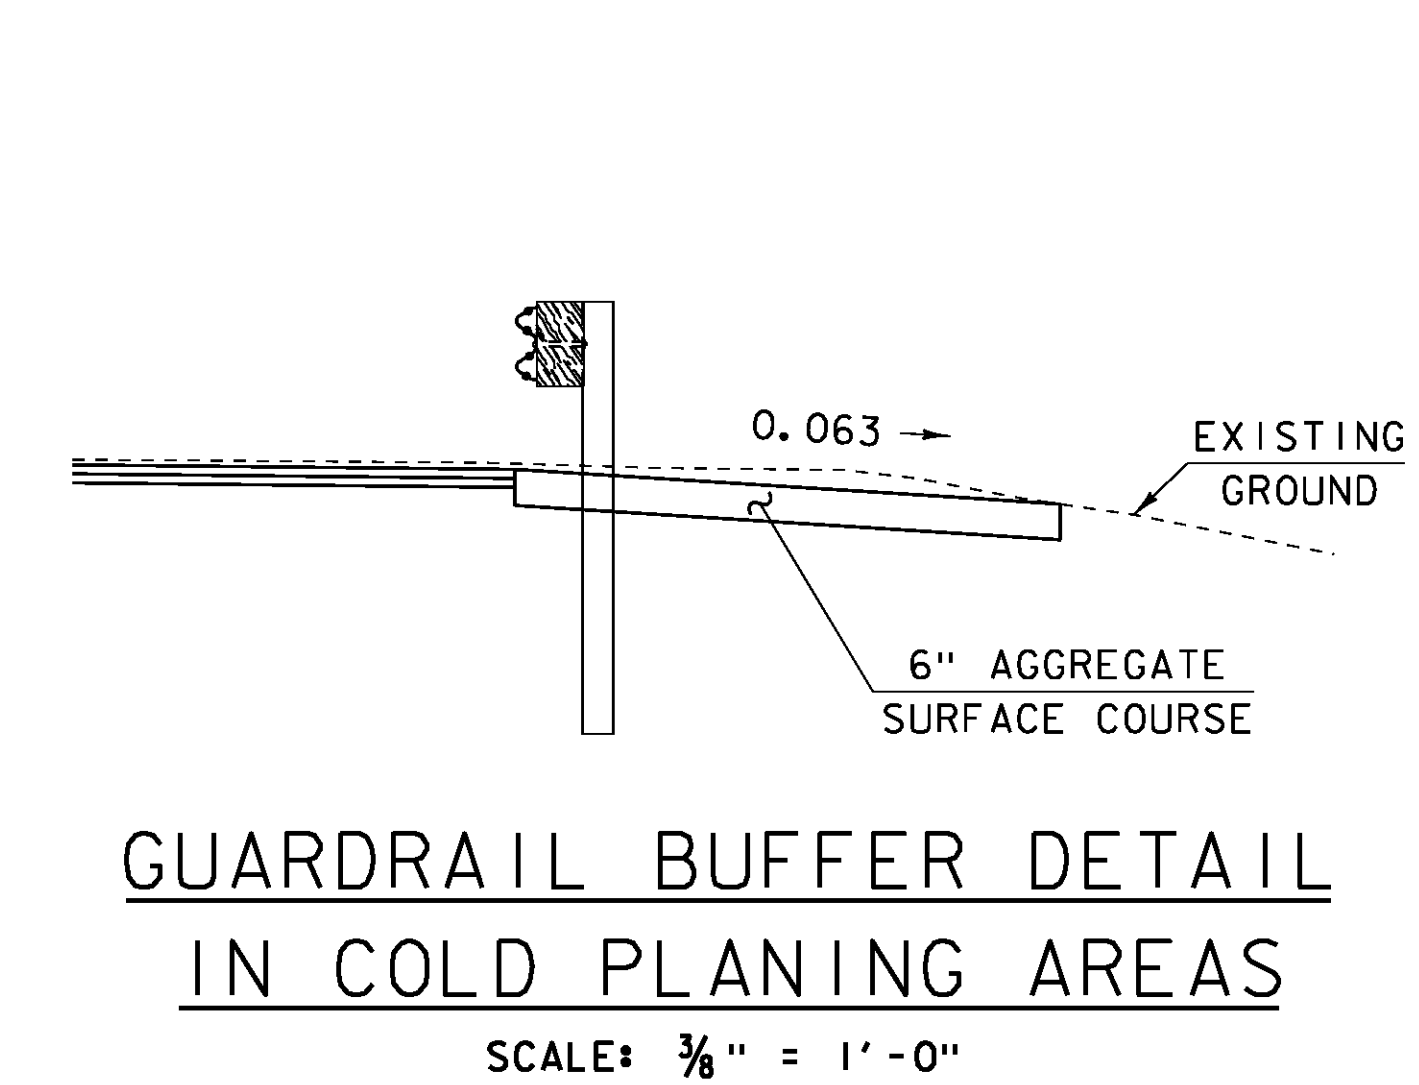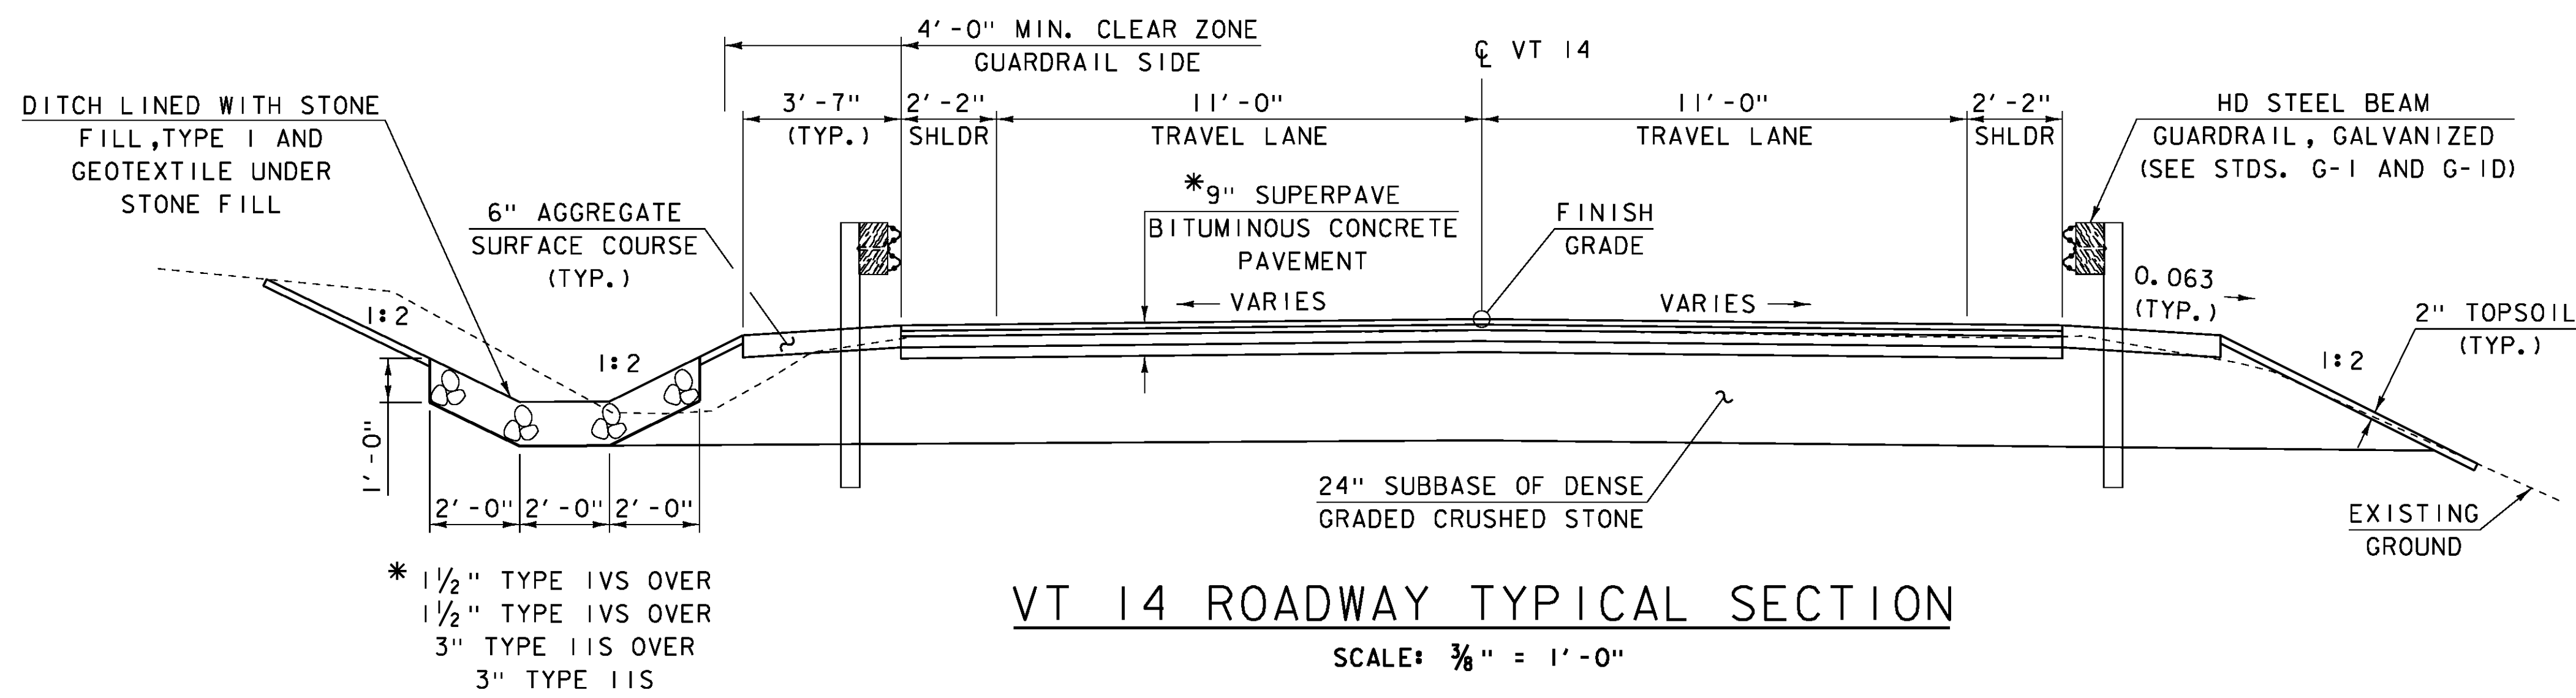

**MATERIAL TOLERANCES**  
(IF USED ON PROJECT)

SURFACE	
- PAVEMENT (TOTAL THICKNESS)	+/- 1/4"
- AGGREGATE SURFACE COURSE	+/- 1/2"
SUBBASE	+/- 1"
SAND BORROW	+/- 1"
GRANULAR BORROW	+/- 1"

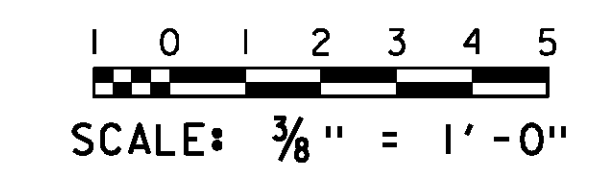

PROJECT NAME:	ROYALTON
PROJECT NUMBER:	BRS 0147(13)
FILE NAME:	s86e055typ.cattlepass3.dgn
PROJECT LEADER:	C. CARLSON
DESIGNED BY:	G. ROY
CATTLE PASS PROJECT TYPICAL SECTIONS	
PLOT DATE:	08-OCT-2013
DRAWN BY:	G. ROY
CHECKED BY:	D. PETERSON
SHEET	72 OF 186



**HD STEEL BEAM GUARDRAIL, GALVANIZED**  
 VT 14 STA 399+80.6 RT - VT 14 STA 400+05.68 RT  
 VT 14 STA 399+88.9 LT - VT 14 STA 400+06.80 LT  
 VT 14 STA 400+93.86 RT - VT 14 STA 401+12.3 RT  
 VT 14 STA 400+93.64 LT - VT 14 STA 401+18.2 LT

**HD STEEL BEAM GUARDRAIL, GALVANIZED/NESTED**  
 VT 14 STA 400+05.68 RT - VT 14 STA 400+93.86 RT  
 VT 14 STA 400+06.80 LT - VT 14 STA 400+93.64 LT

**ANCHOR FOR STEEL BEAM RAIL**  
 VT 14 STA 399+87.6 RT  
 VT 14 STA 399+95.7 LT  
 VT 14 STA 401+05.4 RT  
 VT 14 STA 401+11.0 LT

**CONSTRUCT 5' PAVED APRON**  
 VT 14 STA 401+32.2 RT - VT 14 STA 401+64.4 RT

STA 399+25.00  
 BEGIN APPROACH  
 MATCH EXISTING

PI NO. 1  
 STA 399+18.05 BK =  
 STA 399+16.31 AHD

EXISTING R.O.W.

ELECTRIC FENCE

399+00  
 TO SHARON

ELECTRIC FENCE

EXISTING R.O.W.

**CURVE DATA NO. 1**  
 $\Delta = 16^\circ 28' 40''$   
 $D = 6^\circ 36' 00''$   
 $R = 868.11'$   
 $T = 125.70'$   
 $L = 249.66'$   
 $E = 9.05'$   
 BANK = VARIES

STA 400+00.00  
 END APPROACH

**REMOVING AND RESETTING FENCE**  
 VT 14 STA 399+56.3 RT - VT 14 STA 401+53.6 RT  
 VT 14 STA 399+50.0 LT - VT 14 STA 401+50.0 LT

**DURABLE 4 INCH YELLOW LINE**  
 VT 14 STA 399+25 RT - VT 14 STA 401+75 RT  
 VT 14 STA 399+25 LT - VT 14 STA 401+75 LT

**DURABLE 4 INCH WHITE LINE**  
 VT 14 STA 399+25 RT - VT 14 STA 401+75 RT  
 VT 14 STA 399+25 LT - VT 14 STA 401+75 LT

CATTLE PASS POE  
 STA 7+00.00

END CATTLE PASS  
 STA 6+65.70

PCC  
 STA 400+42.01

STONE-LINED DITCH  
 TYPE I (TYP.)

S 83°59'26" W  
 CATTLE PASS

400+30  
**CONSTRUCT STONE-LINED DITCH, TYPE I**  
 VT 14 STA 399+50.0 LT - VT 14 STA 400+45.9 LT  
 VT 14 STA 400+55.0 LT - VT 14 STA 401+50.0 LT  
 400+70

VT 14 STA 400+50.00 =  
 CATTLE PASS STA 6+00.00  
 $\Delta = 90^\circ$  LT  
 FROM TANGENT TO CURVE

STA 401+00.00  
 BEGIN APPROACH

STA 401+75.00  
 END APPROACH  
 MATCH EXISTING

CONSTRUCTION LIMITS

PI NO. 2  
 STA 402+10.55 BK =  
 STA 402+10.43 AHD

ELECTRIC FENCE

STATE OF VERMONT  
 3-ROD HWY EASEMENT

402+00  
 TO WILLIAMSTOWN

ELECTRIC FENCE

400+00

VT 14

6+00

401+00

S ELM

M APPLE

M BUTTERNUT

BEGIN CATTLE PASS  
 STA 5+53.59

CATTLE PASS POB  
 STA 5+00.00

**REMOVAL AND DISPOSAL OF GUARDRAIL**

VT 14 STA 399+70.48 RT  
 VT 14 STA 400+22.18 RT  
 VT 14 STA 400+58.04 RT  
 VT 14 STA 400+69.21 RT  
 VT 14 STA 400+80.69 RT

**CHAIN LINK FENCE, 4 FEET**


VT 14 STA 400+18.29 RT - VT 14 STA 400+78.58 RT  
 VT 14 STA 400+27.62 LT - VT 14 STA 400+72.20 LT

**CURVE DATA NO. 2**


$\Delta = 3^\circ 44' 43''$   
 $D = 1^\circ 06' 41''$   
 $R = 5154.81'$   
 $T = 168.54'$   
 $L = 336.96'$   
 $E = 2.75'$   
 BANK = VARIES



WOODS

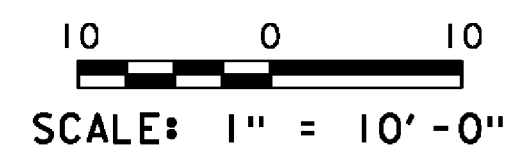

PROJECT NAME:	ROYALTON
PROJECT NUMBER:	BRS 0147(13)
FILE NAME:	s86e055bdr_cattlepass3.dgn
PROJECT LEADER:	C. CARLSON
DESIGNED BY:	G. ROY
CATTLE PASS LAYOUT	
PLOT DATE:	28-OCT-2013
DRAWN BY:	G. ROY
CHECKED BY:	D. PETERSON
SHEET	73 OF 186

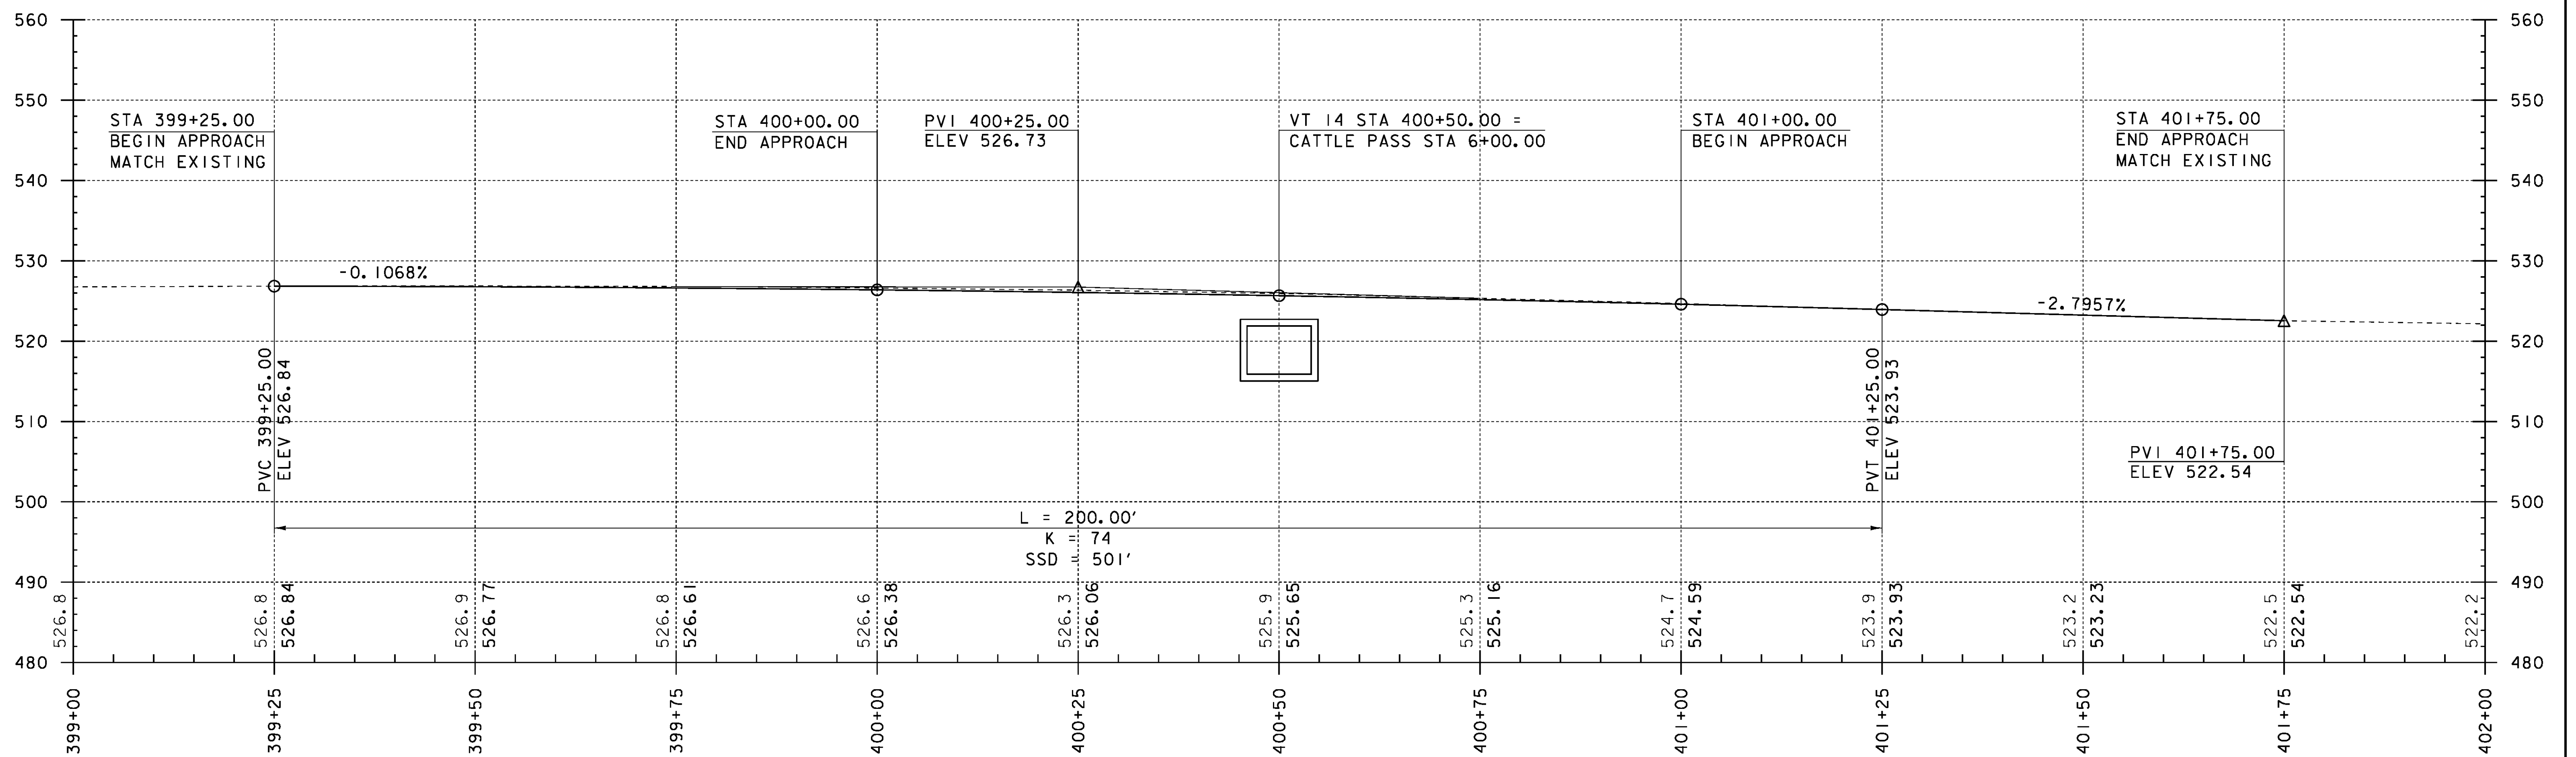

PROFILE ALONG VT 14


HORIZONTAL SCALE: 1" = 10' - 0"  
 VERTICAL SCALE: 1" = 10' - 0"

NOTE:

ELEVATIONS SHOWN TO THE NEAREST TENTH ARE  
 EXISTING GROUND ALONG PROPOSED CENTERLINE.

ELEVATIONS SHOWN TO THE NEAREST HUNDREDTH ARE  
 FINISH GRADES ALONG PROPOSED CENTERLINE.

PROJECT NAME: ROYALTON	PLOT DATE: 08-OCT-2013
PROJECT NUMBER: BRS 0147(I3)	DRAWN BY: G. ROY
FILE NAME: s86e055pro_cattlepass3.dgn	CHECKED BY: D. PETERSON
PROJECT LEADER: C. CARLSON	SHEET 74 OF 186
DESIGNED BY: G. ROY	
VT 14 PROFILE AT CATTLE PASS	

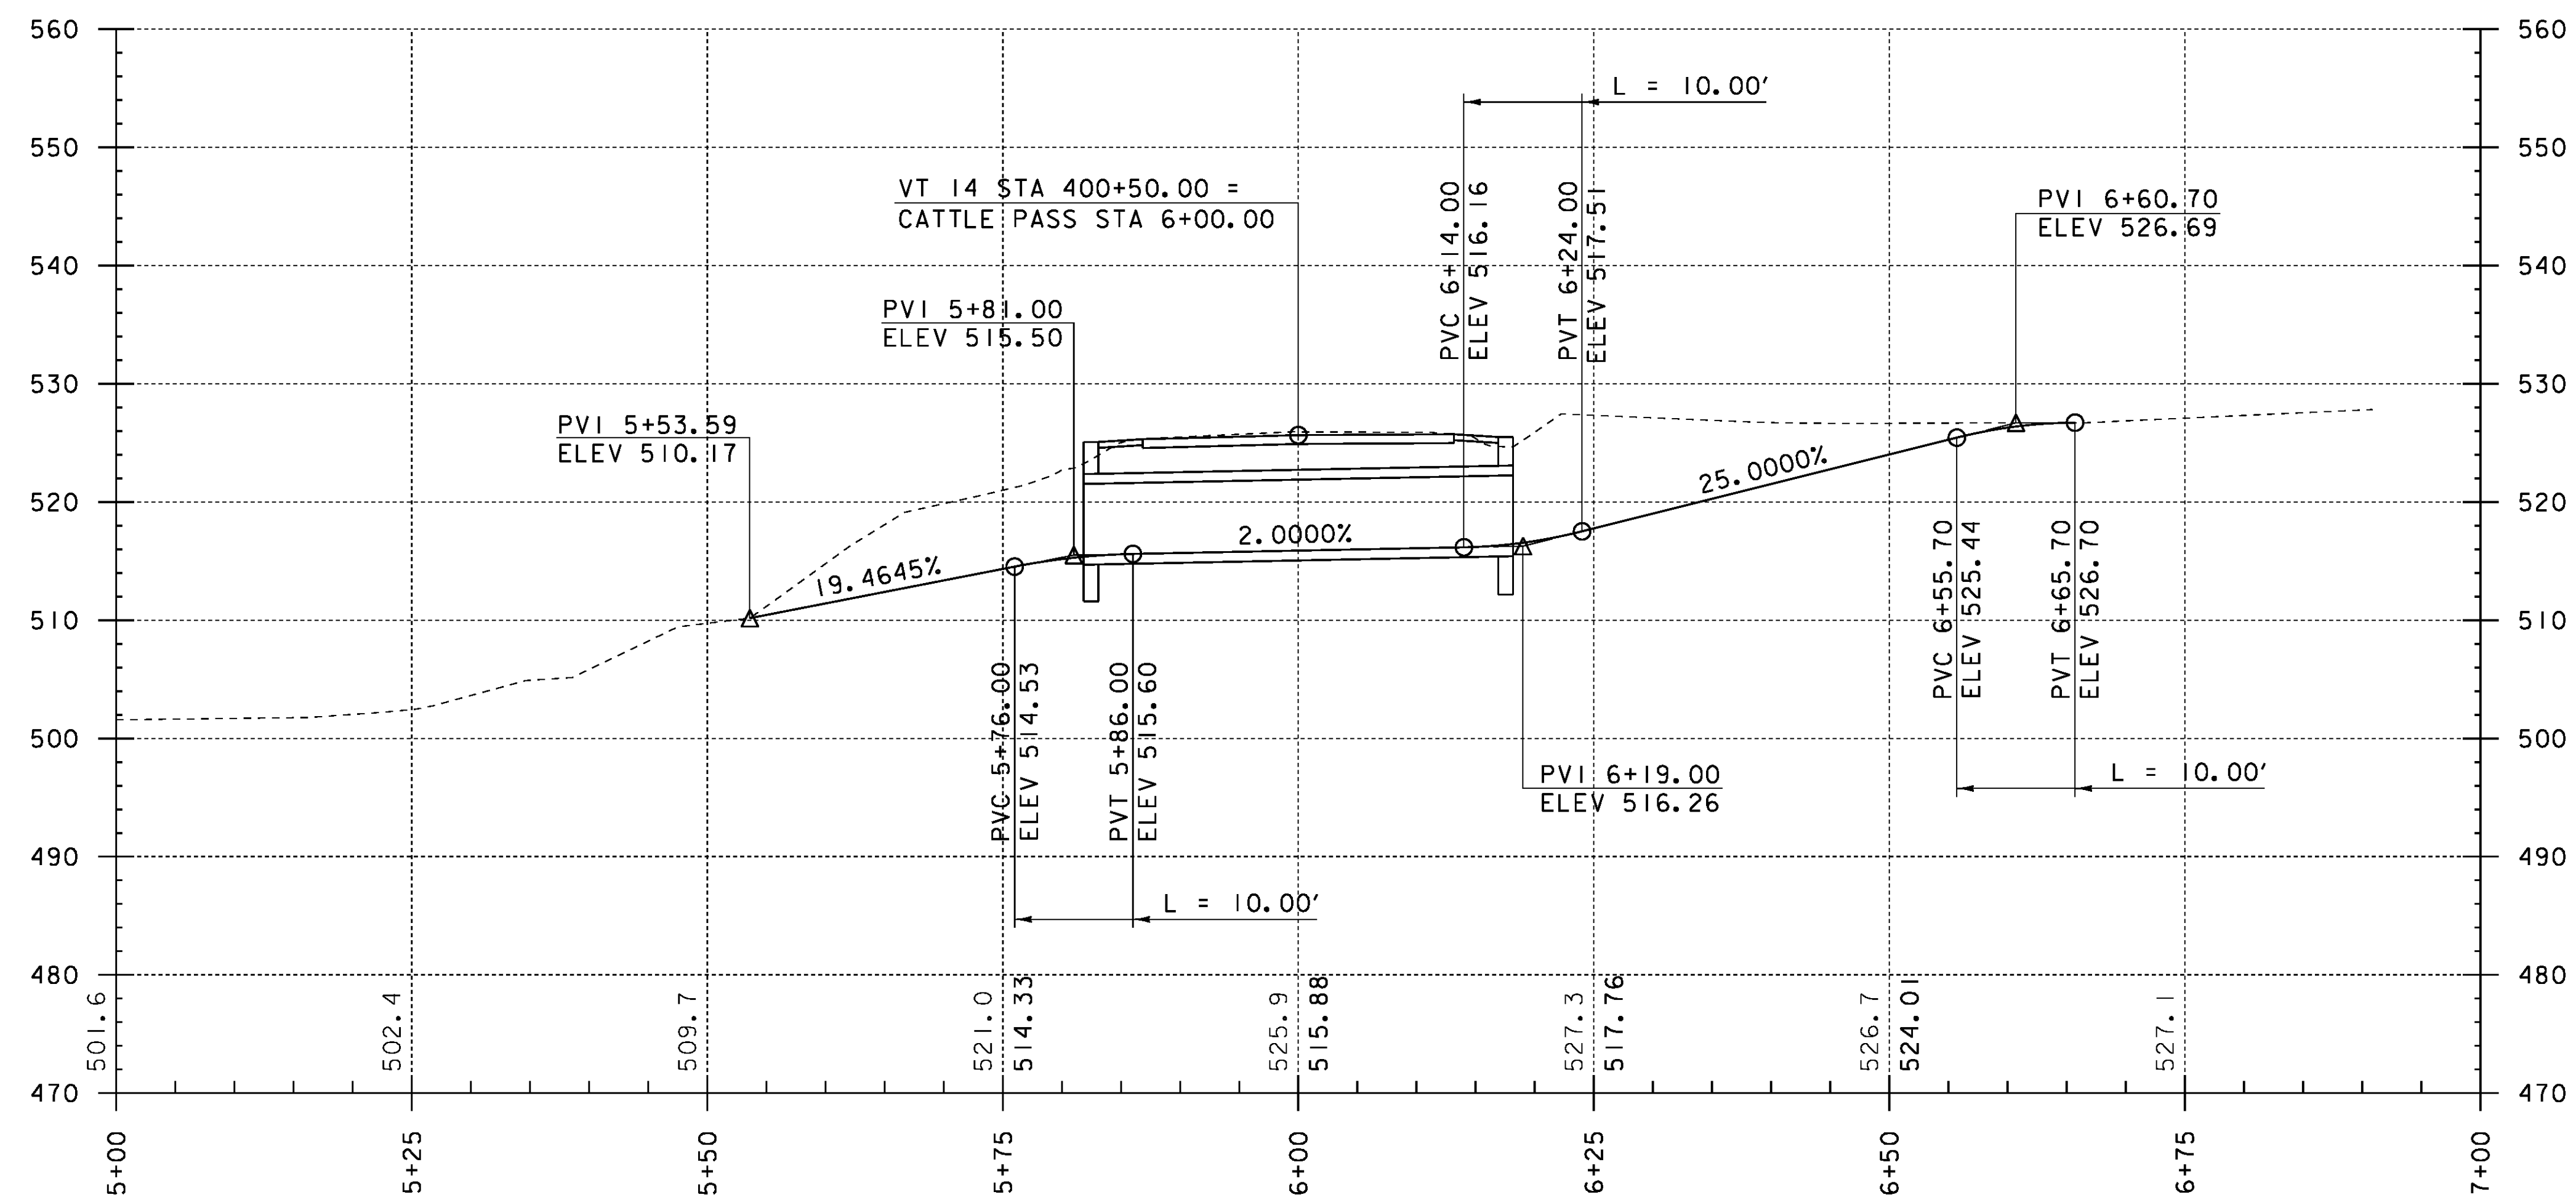

### PROFILE ALONG CATTLE PASS


HORIZONTAL SCALE: 1" = 10'-0"  
 VERTICAL SCALE: 1" = 10'-0"

**NOTE:**


ELEVATIONS SHOWN TO THE NEAREST TENTH ARE EXISTING GROUND ALONG PROPOSED CENTERLINE.

ELEVATIONS SHOWN TO THE NEAREST HUNDREDTH ARE FINISH GRADES ALONG PROPOSED CENTERLINE.


PROJECT NAME:	ROYALTON
PROJECT NUMBER:	BRS 0147(13)
FILE NAME:	s86e055pro_cattlepass3.dgn
PROJECT LEADER:	C. CARLSON
DESIGNED BY:	G. ROY
CATTLE PASS PROFILE	
PLOT DATE:	08-OCT-2013
DRAWN BY:	G. ROY
CHECKED BY:	D. PETERSON
SHEET	75 OF 186

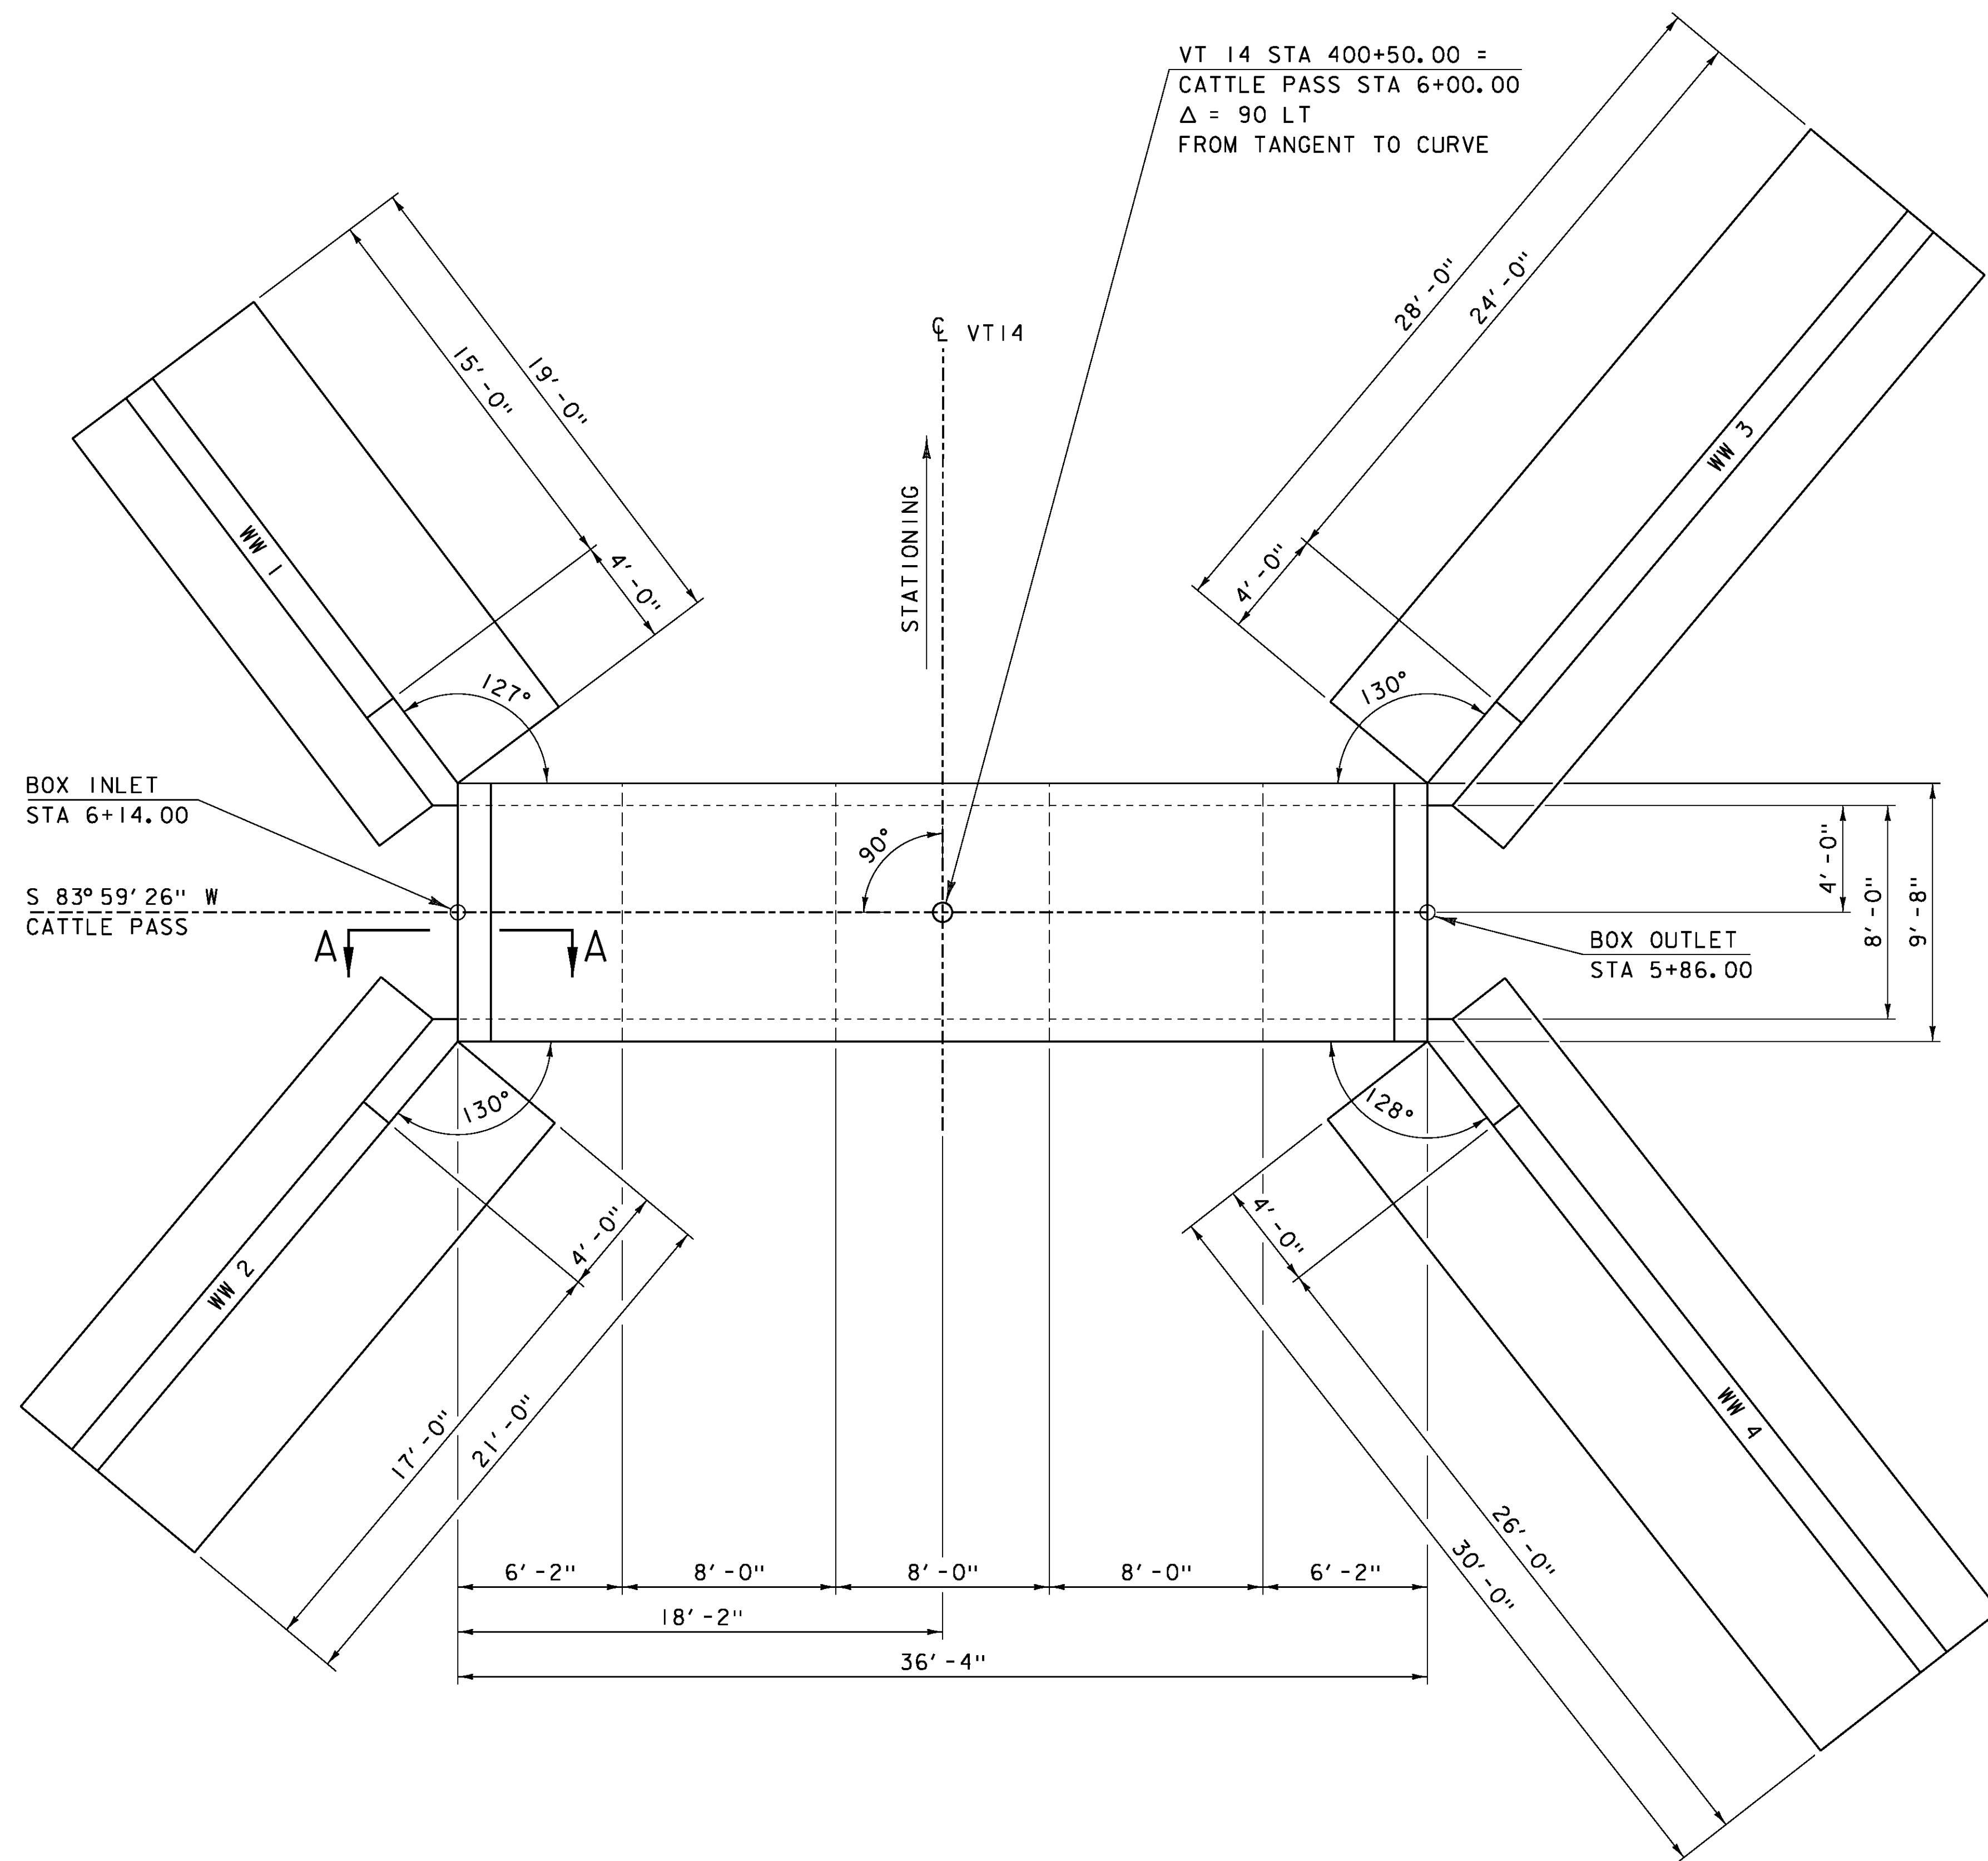

VT14 ROADWAY CATTLE PASS BOX PLAN  
SCALE: 1/4" = 1'-0"

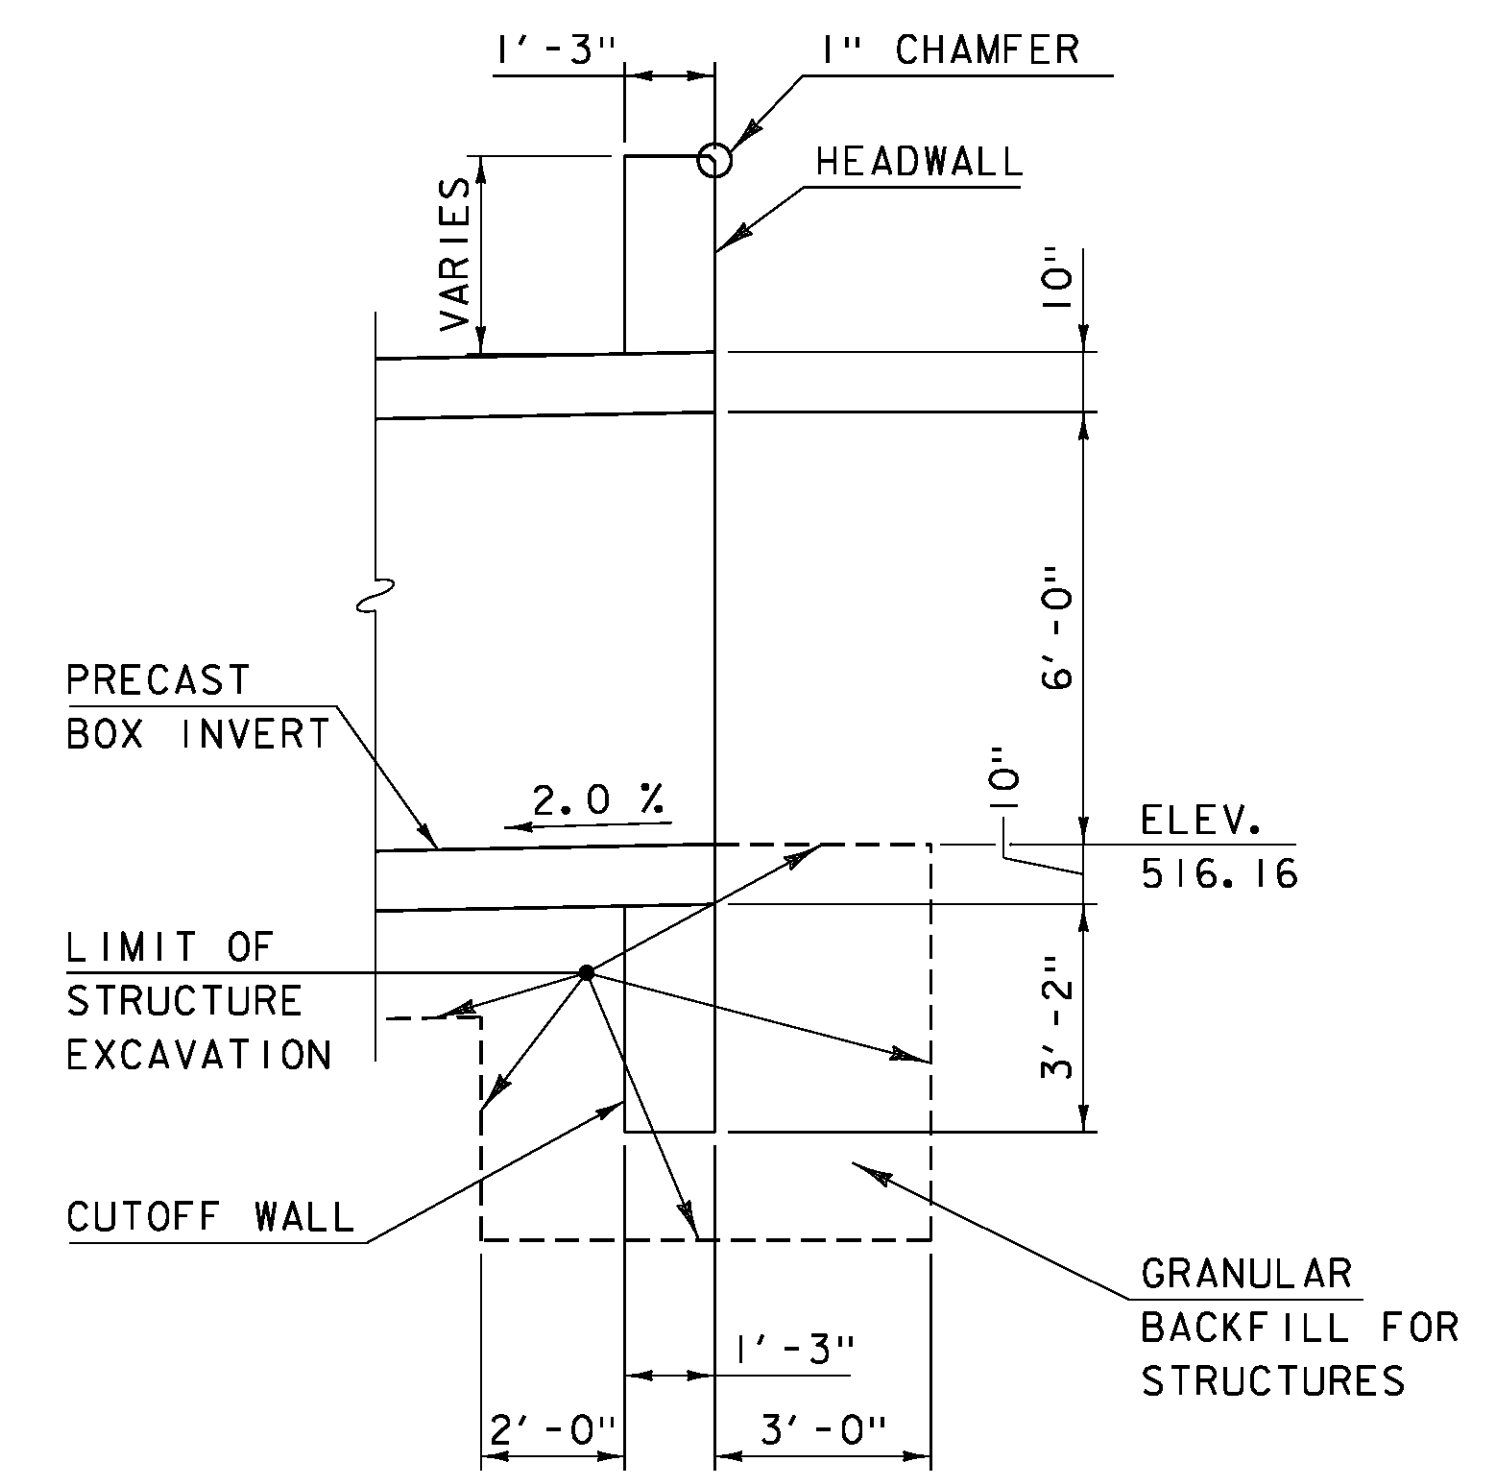


SECTION A-A  
SCALE: 3/8" = 1'-0"

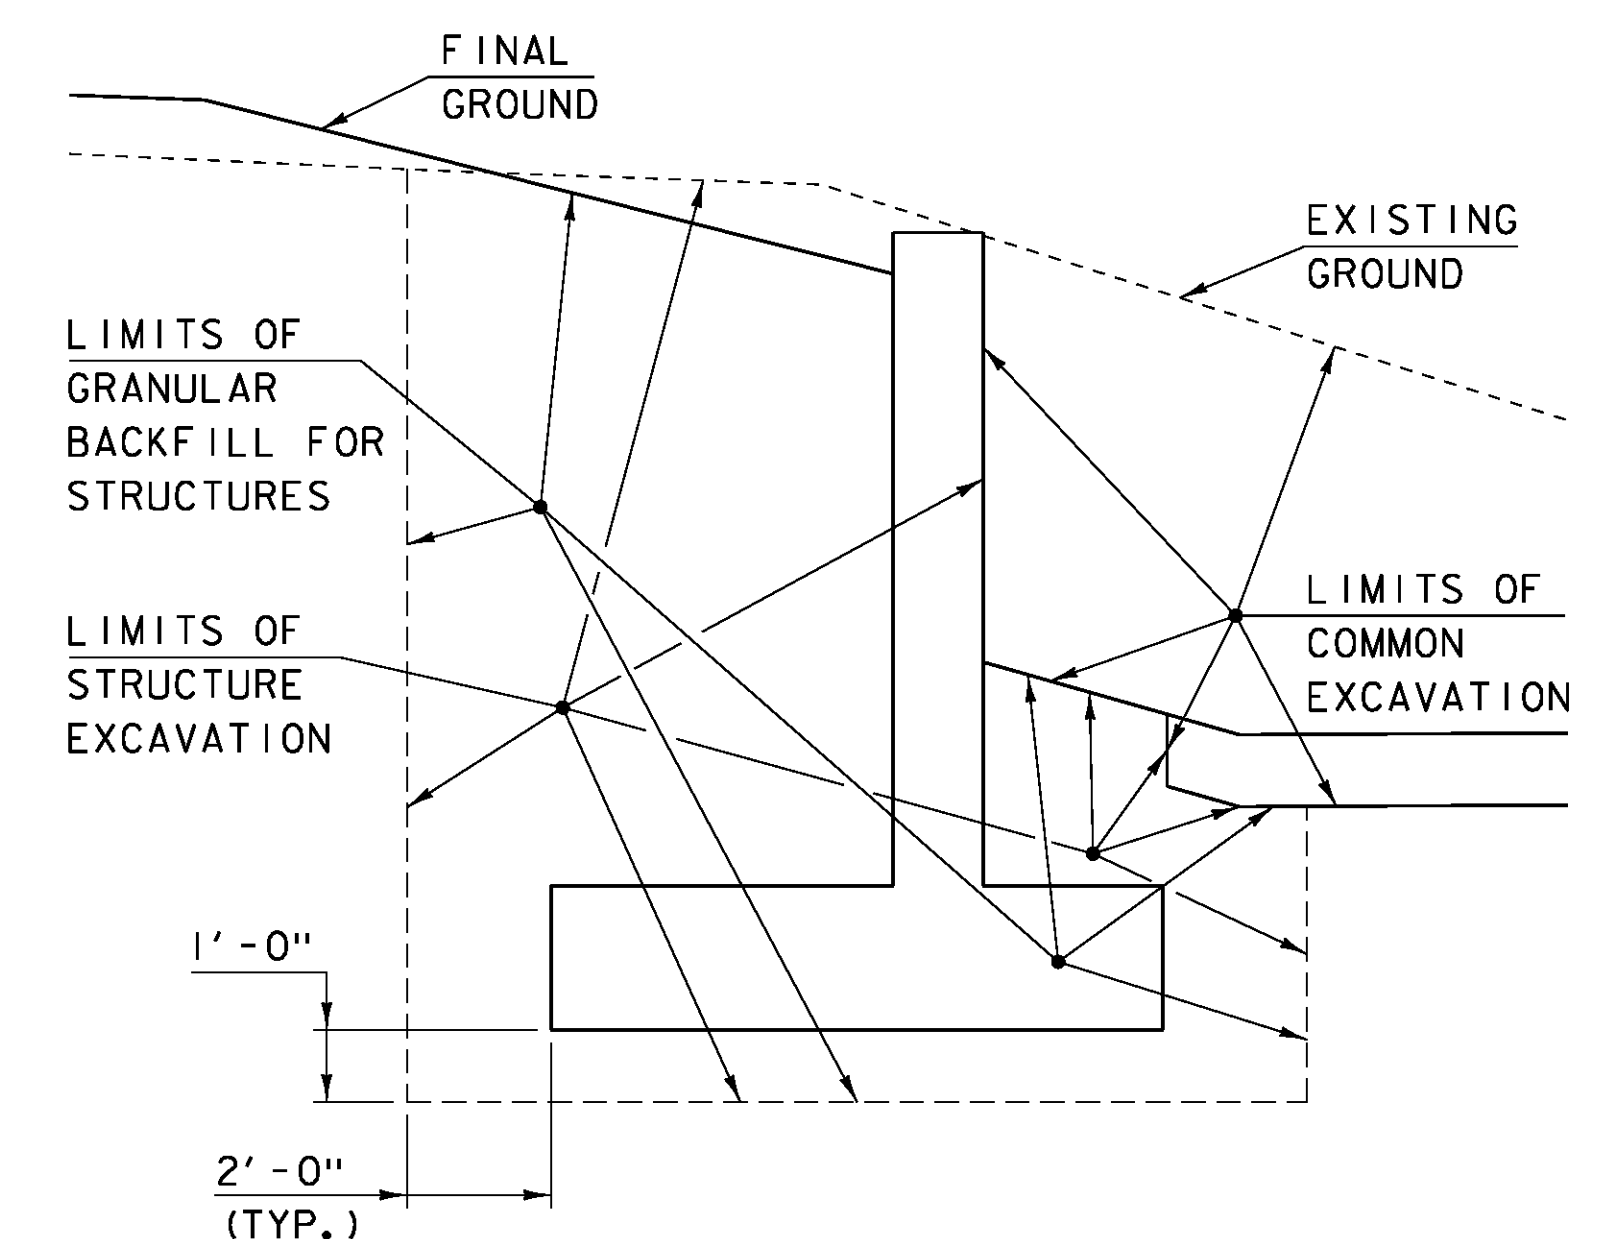


WINGWALL EXCAVATION  
AND FILL DETAIL  
SCALE: 3/8" = 1'-0"

PROJECT NAME:	ROYALTON
PROJECT NUMBER:	BRS 0147(13)
FILE NAME:	s86e055box.cattlepass3.dgn
PROJECT LEADER:	C. CARLSON
DESIGNED BY:	G. ROY
CATTLE PASS BOX DETAILS	
PLOT DATE:	08-OCT-2013
DRAWN BY:	DZENAN K.
CHECKED BY:	D. PETERSON
SHEET	76 OF 186

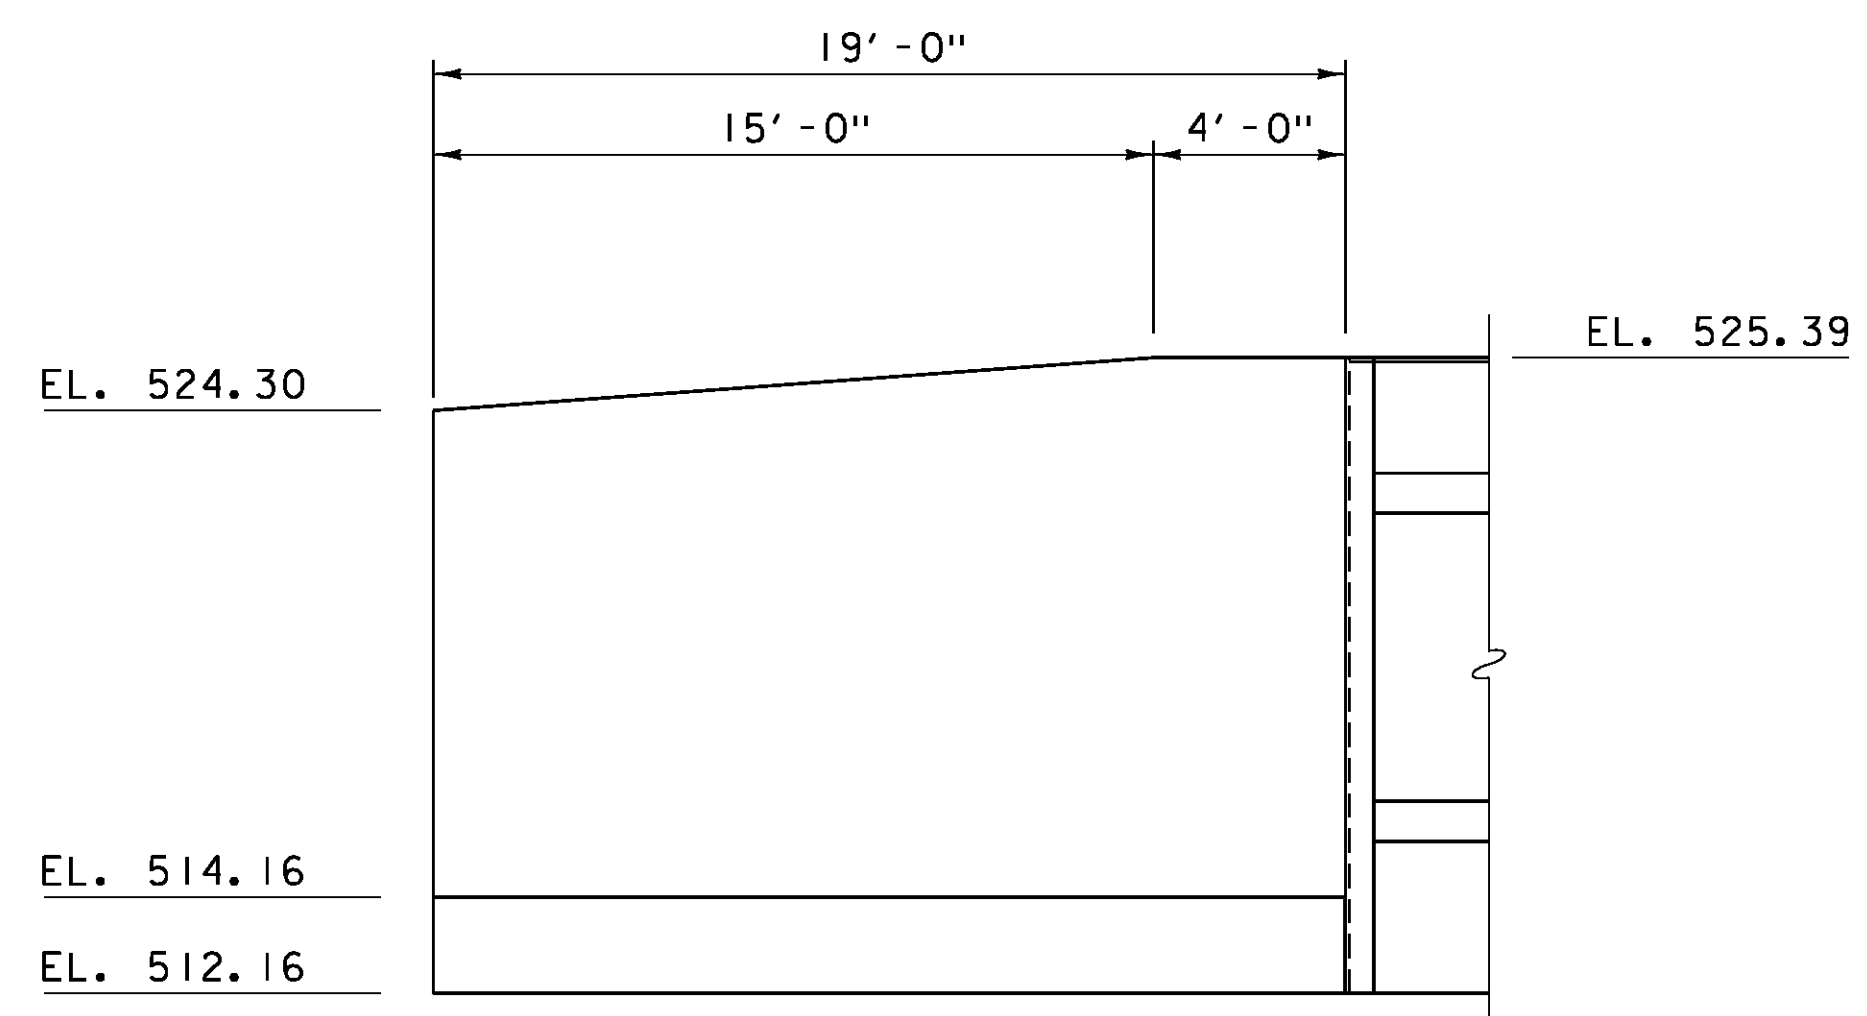


**WINGWALL NO. 1 ELEVATION**

SCALE: 1/4" = 1'-0"

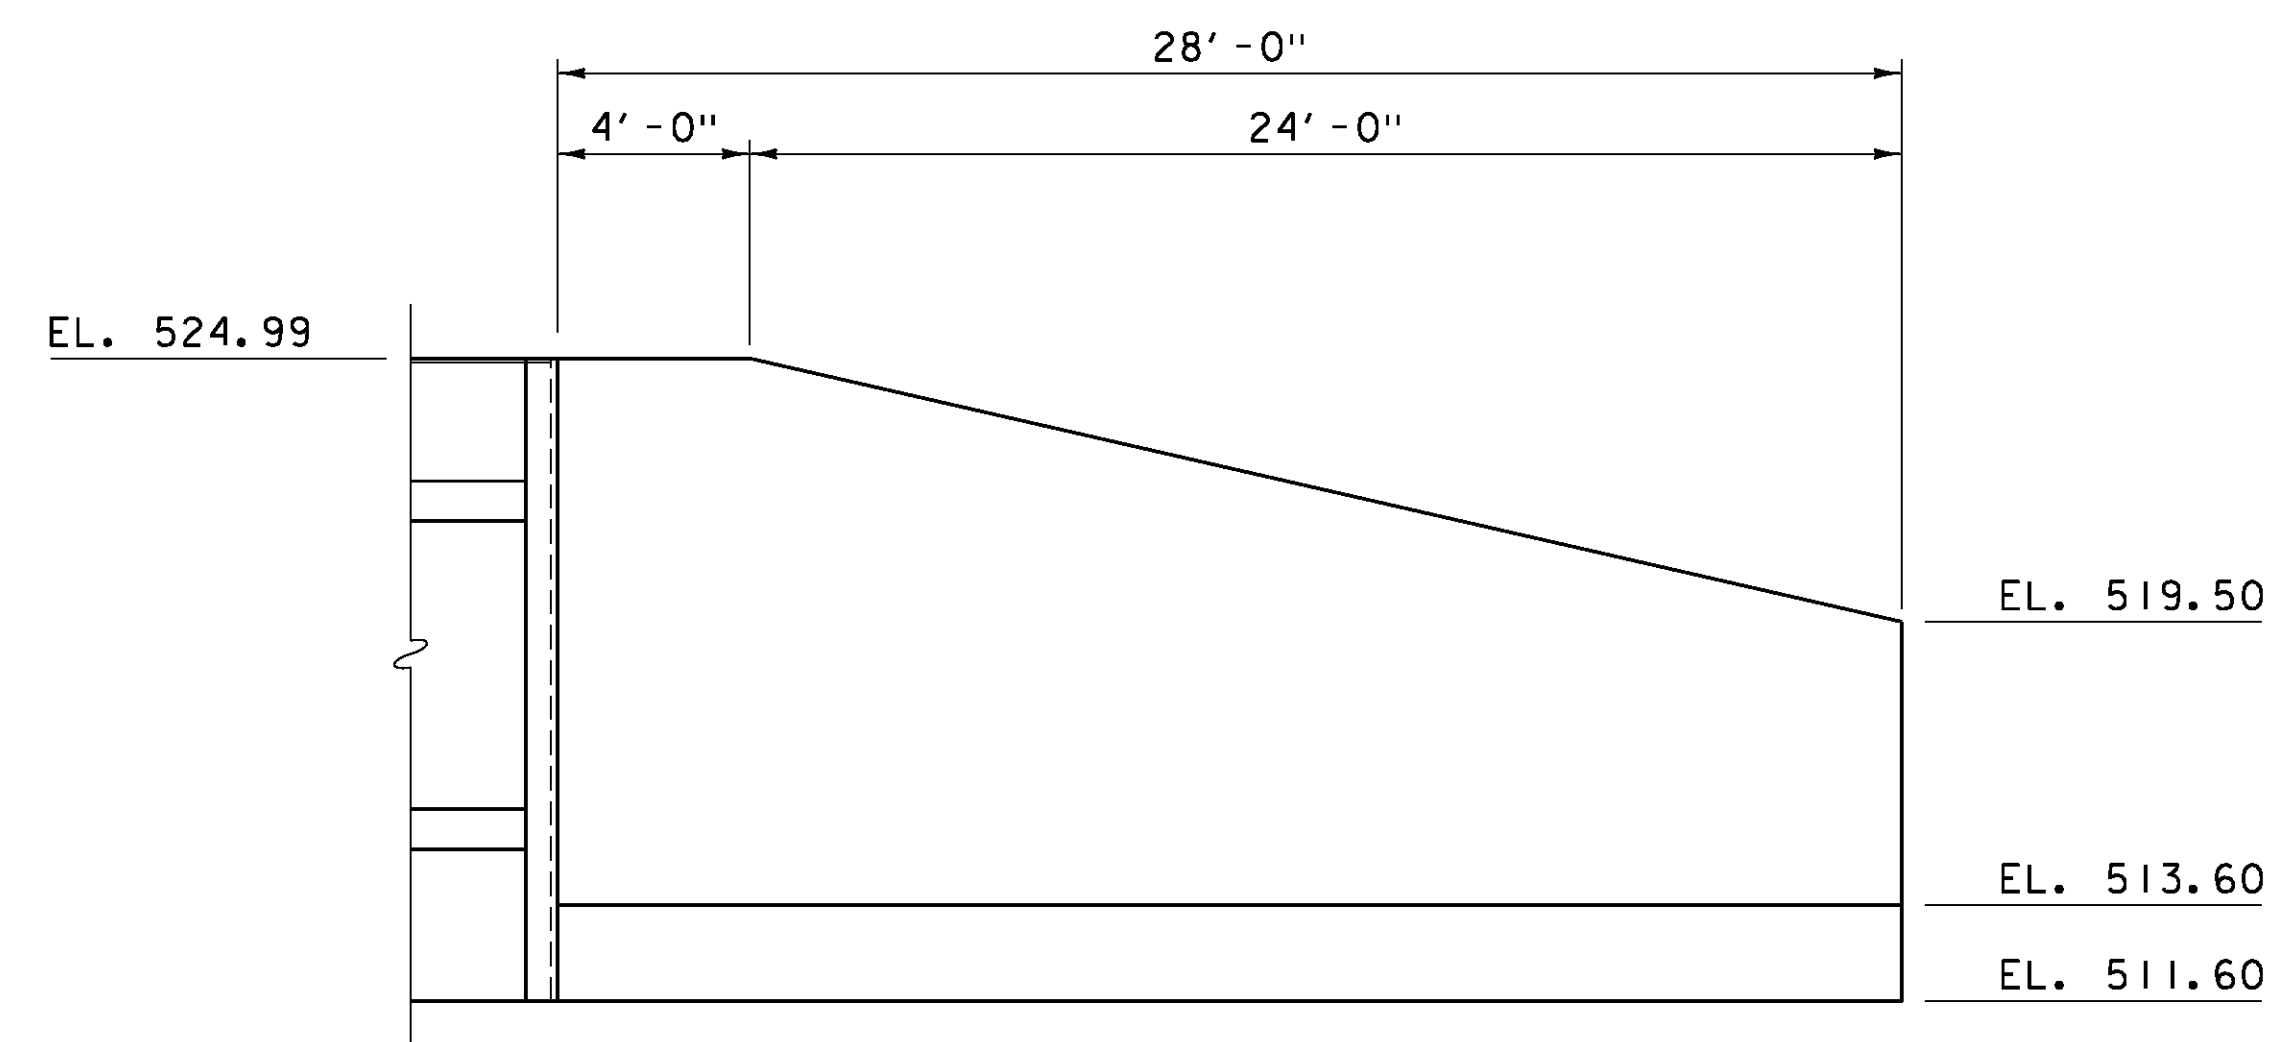


**WINGWALL NO. 3 ELEVATION**

SCALE: 1/4" = 1'-0"

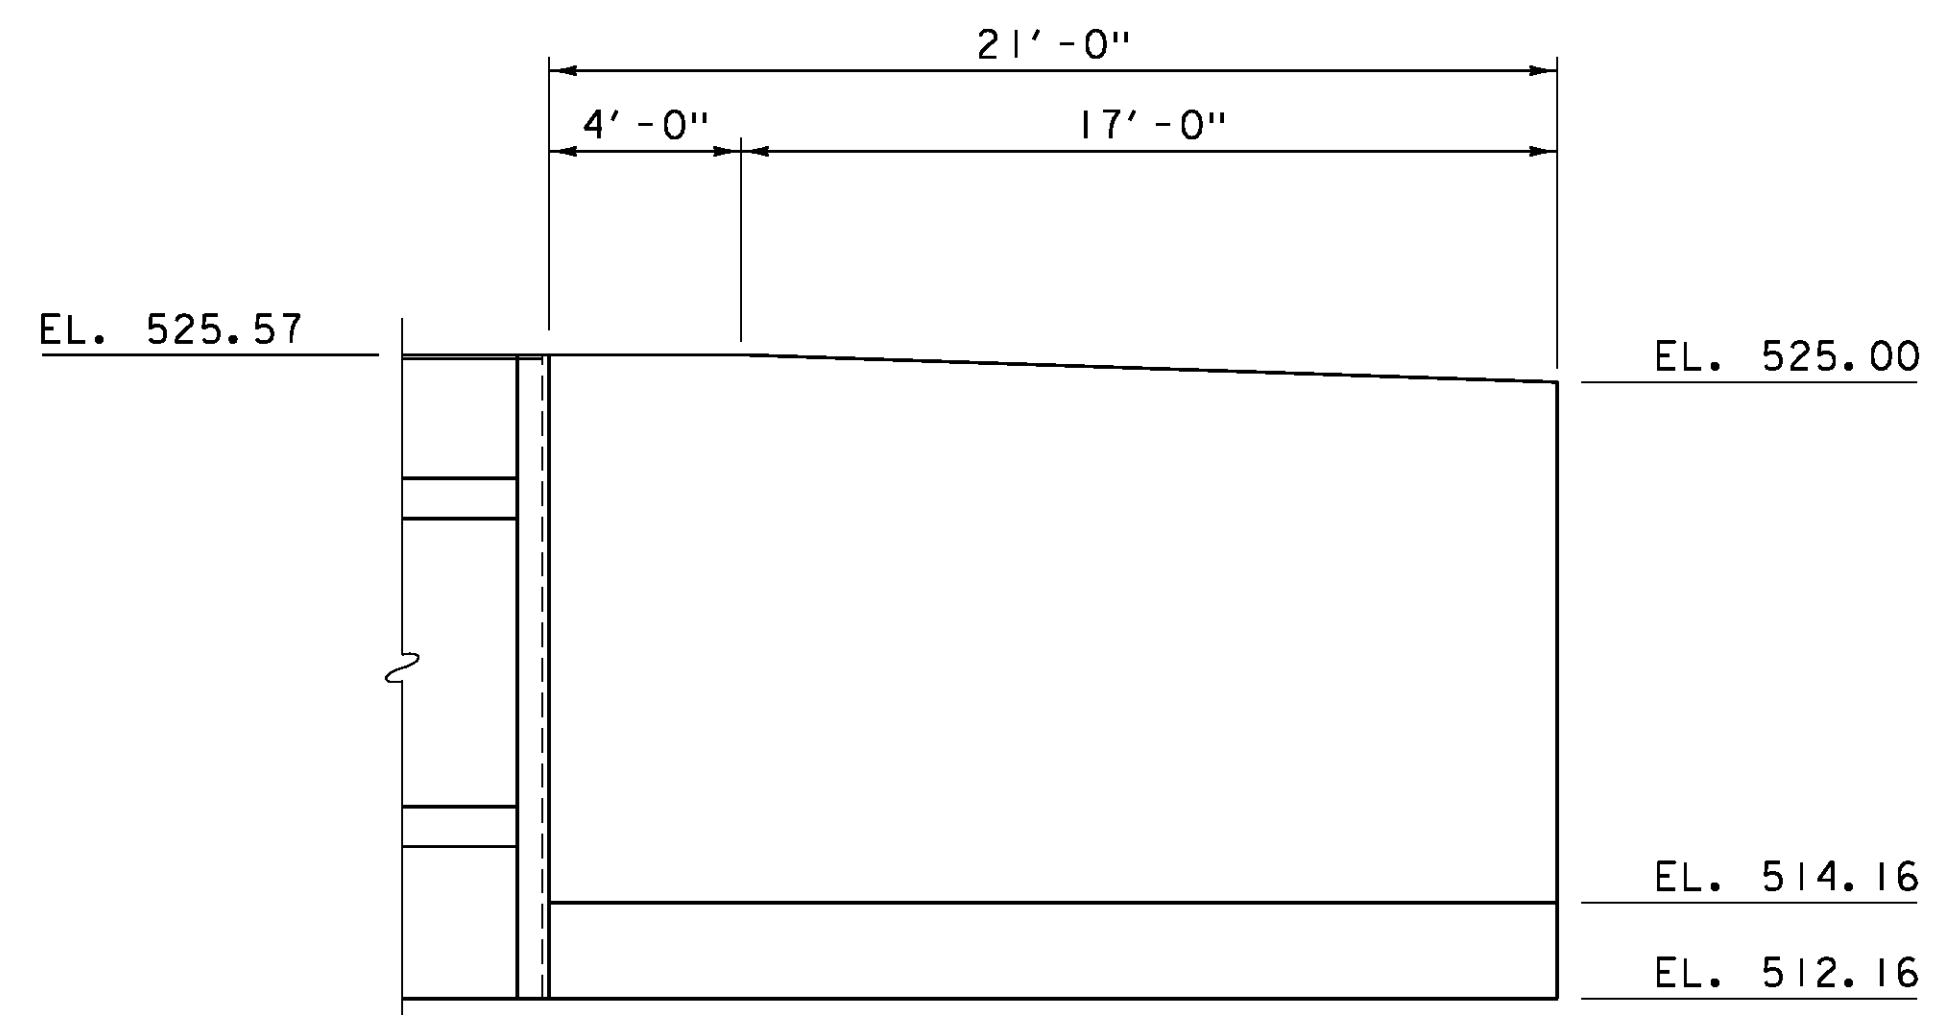


**WINGWALL NO. 2 ELEVATION**

SCALE: 1/4" = 1'-0"

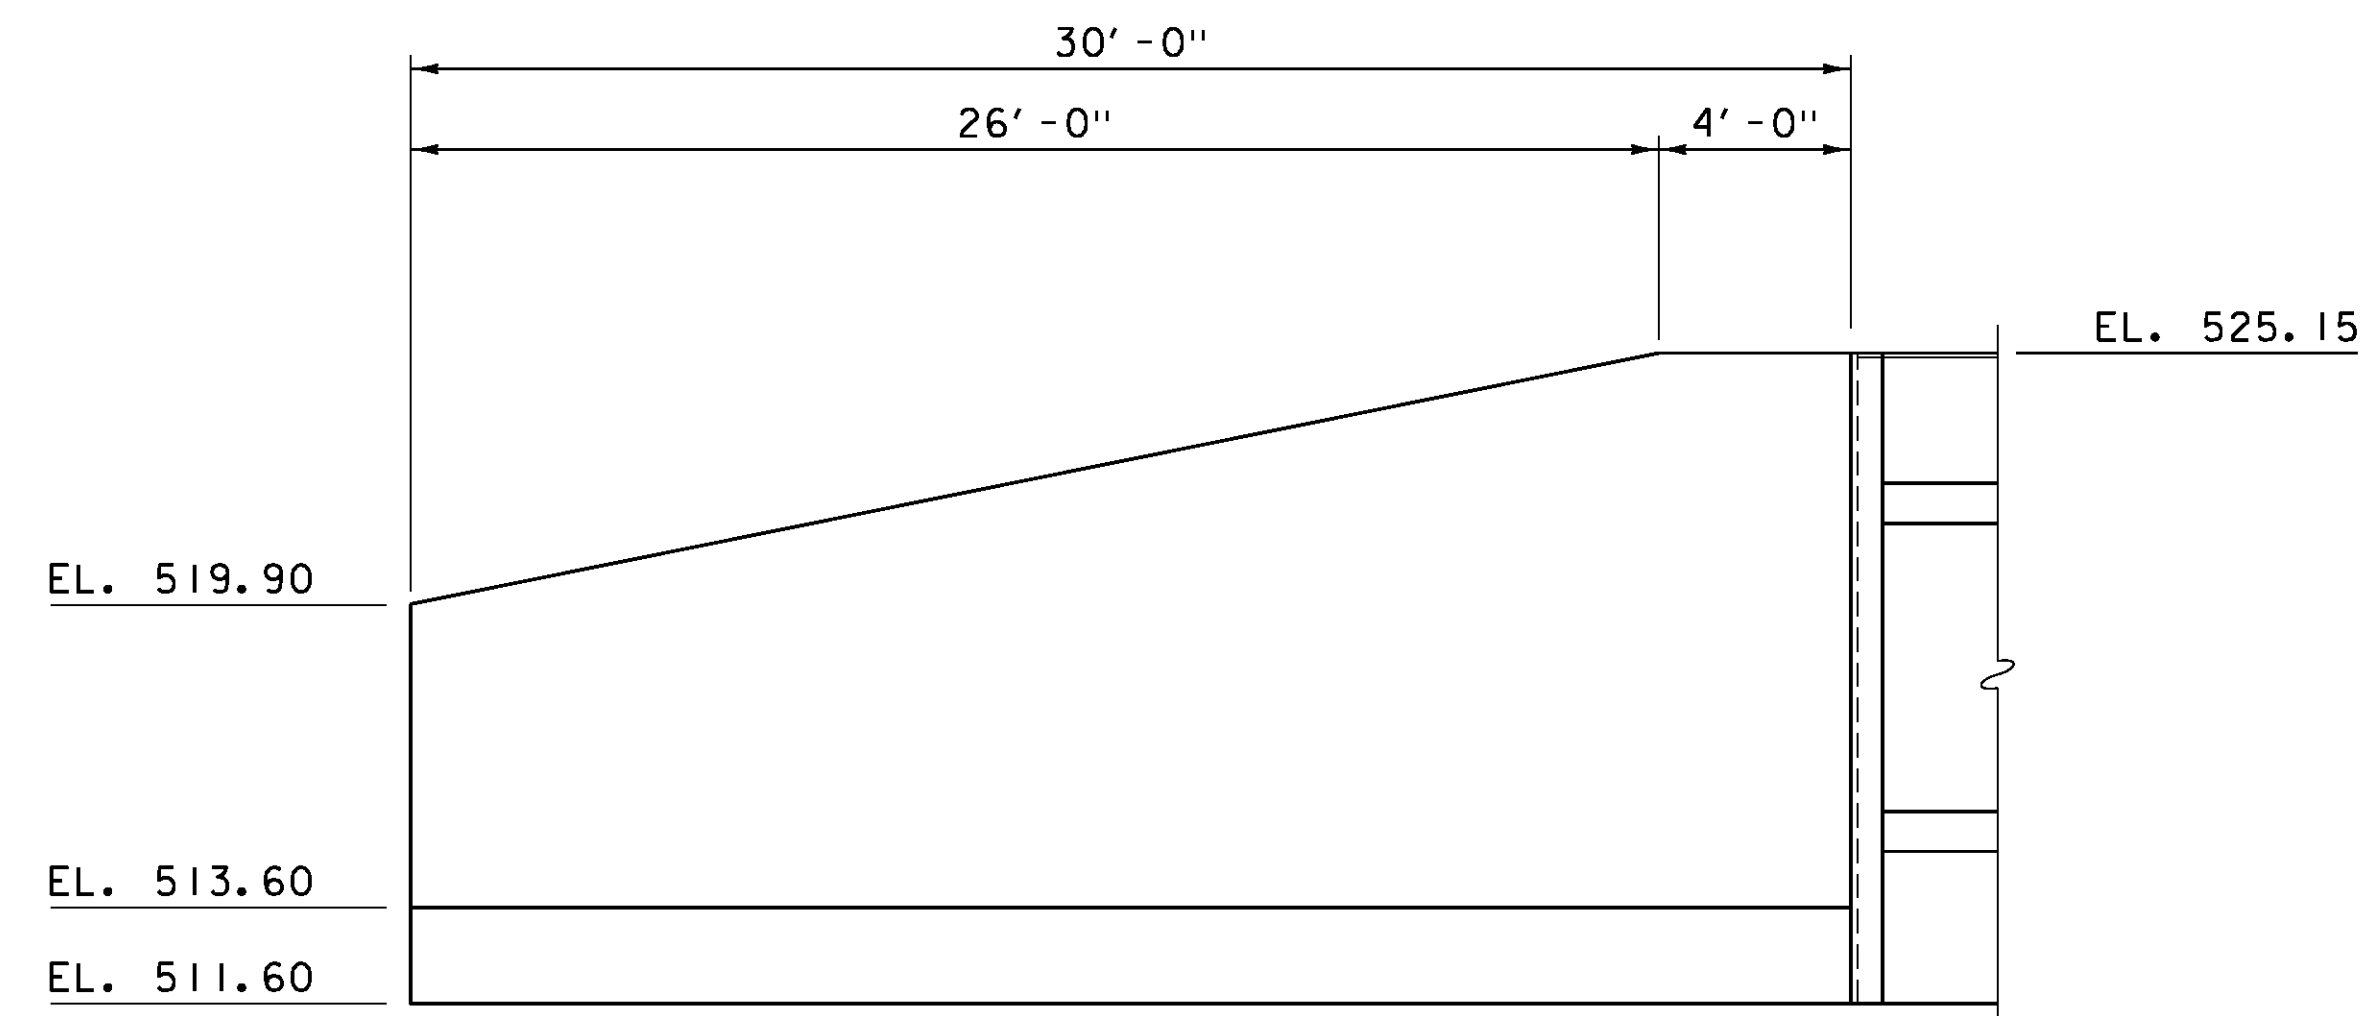


**WINGWALL NO. 4 ELEVATION**

SCALE: 1/4" = 1'-0"

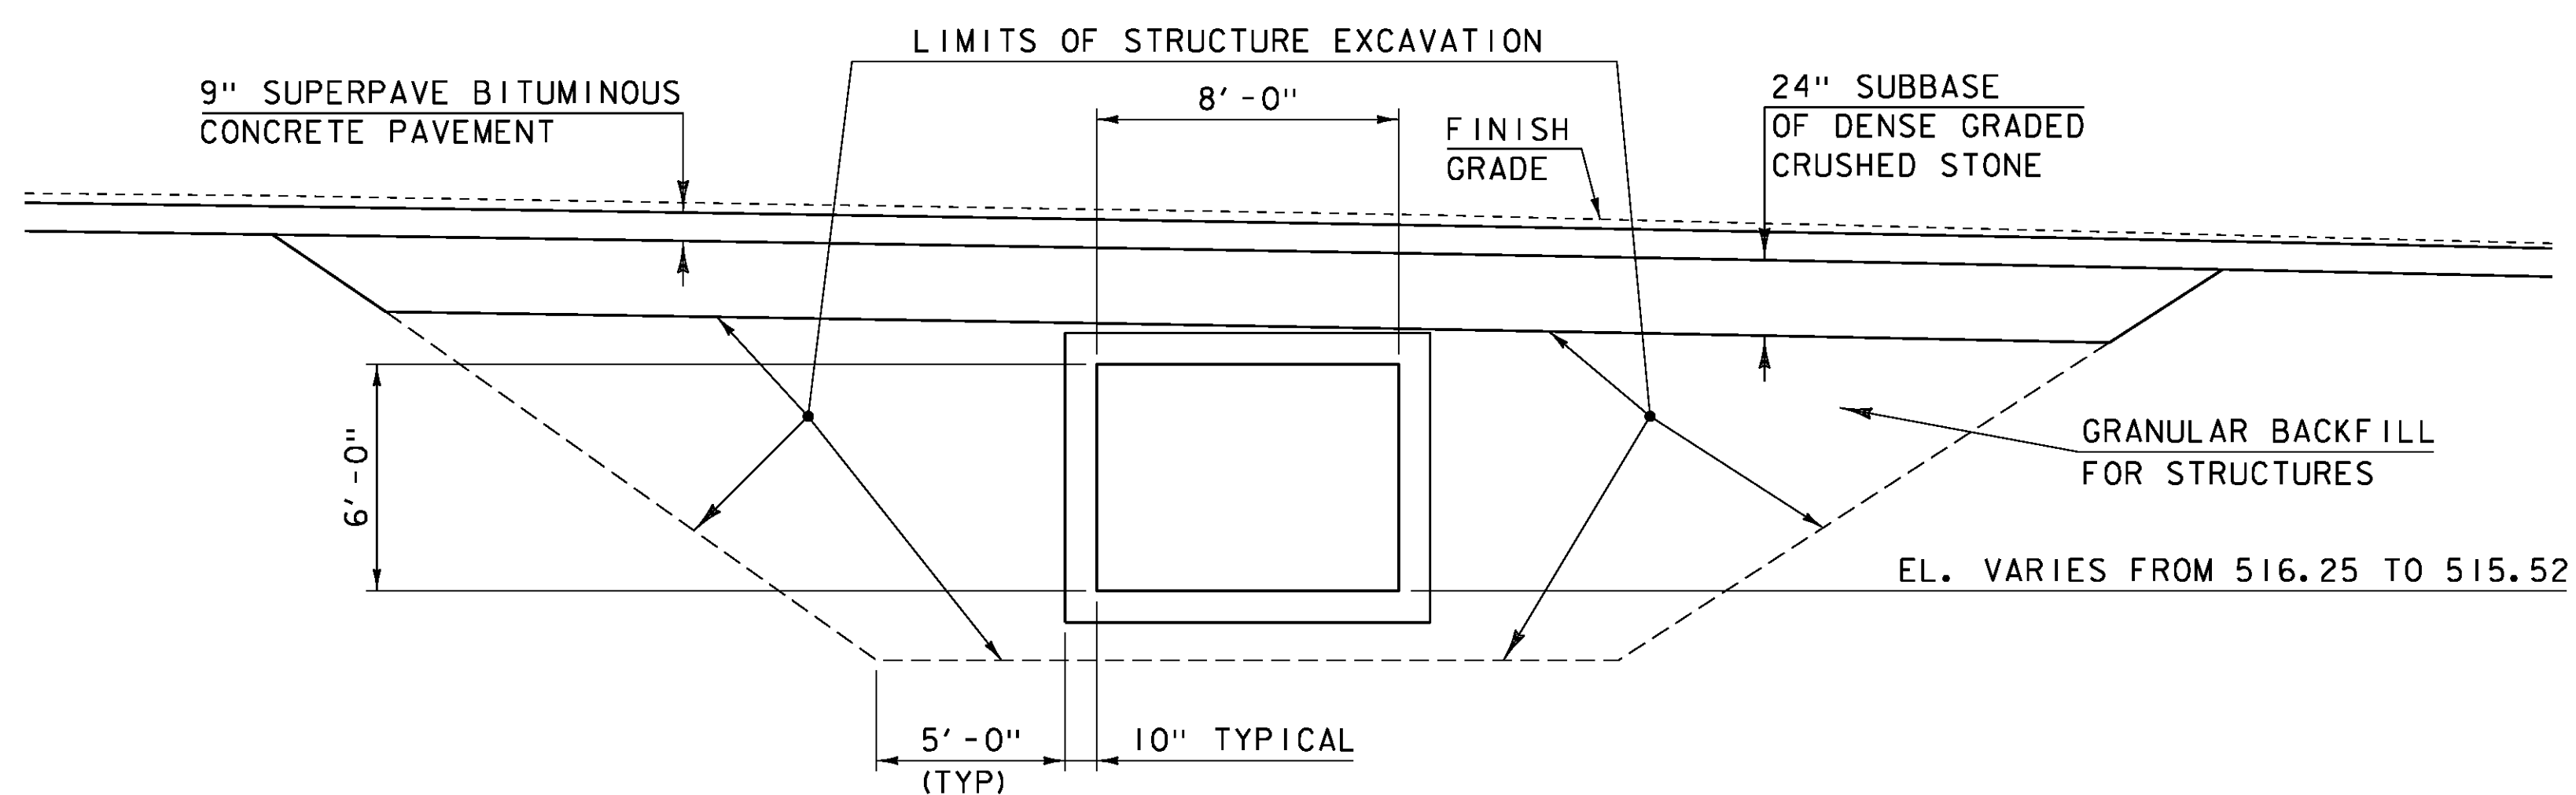

**VT14 ROADWAY CATTLE PASS BOX TYPICAL SECTION**


SCALE: 1/4" = 1'-0"

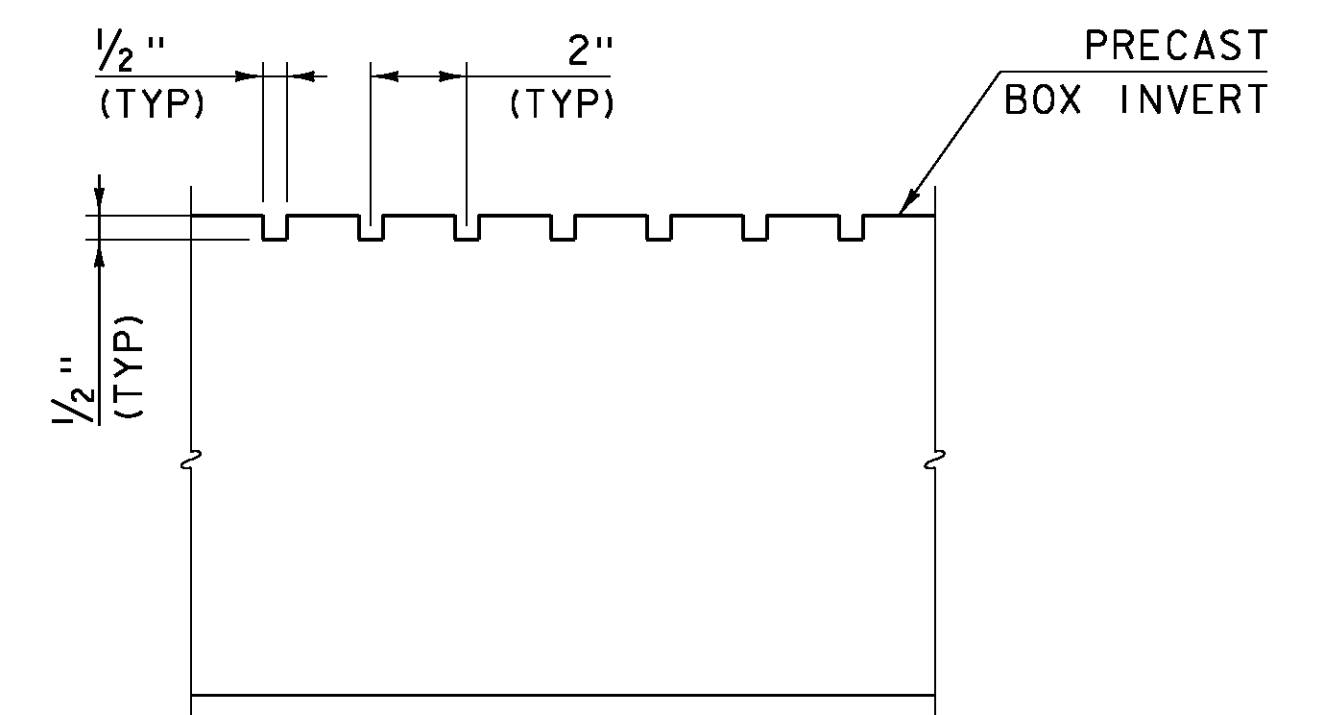

**TRANSVERSE GROOVING DETAIL**


NOT TO SCALE

PROJECT NAME:	ROYALTON	PLOT DATE:	08-OCT-2013
PROJECT NUMBER:	BRS 0147(13)	PROJECT LEADER:	C. CARLSON
DESIGNED BY:	G. ROY	DRAWN BY:	DZENAN K.
CATTLE PASS BOX WINGWALL DETAILS		CHECKED BY:	D. PETERSON
			SHEET 77 OF 186

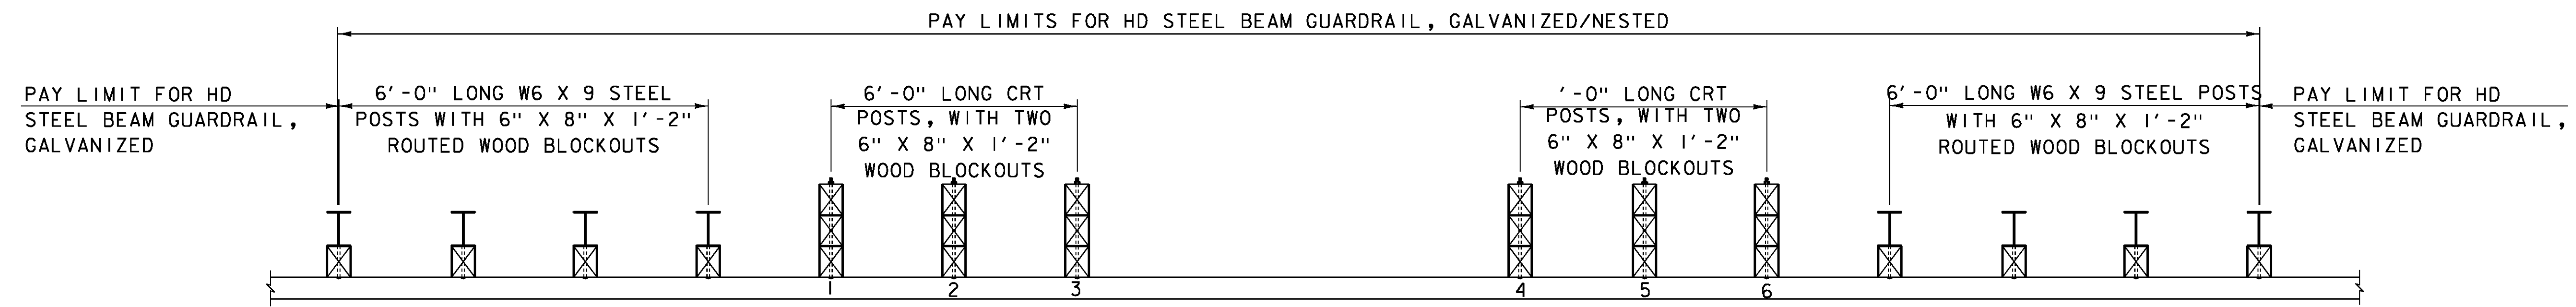

**NESTED RAILING PLAN VIEW**

(NOT TO SCALE)

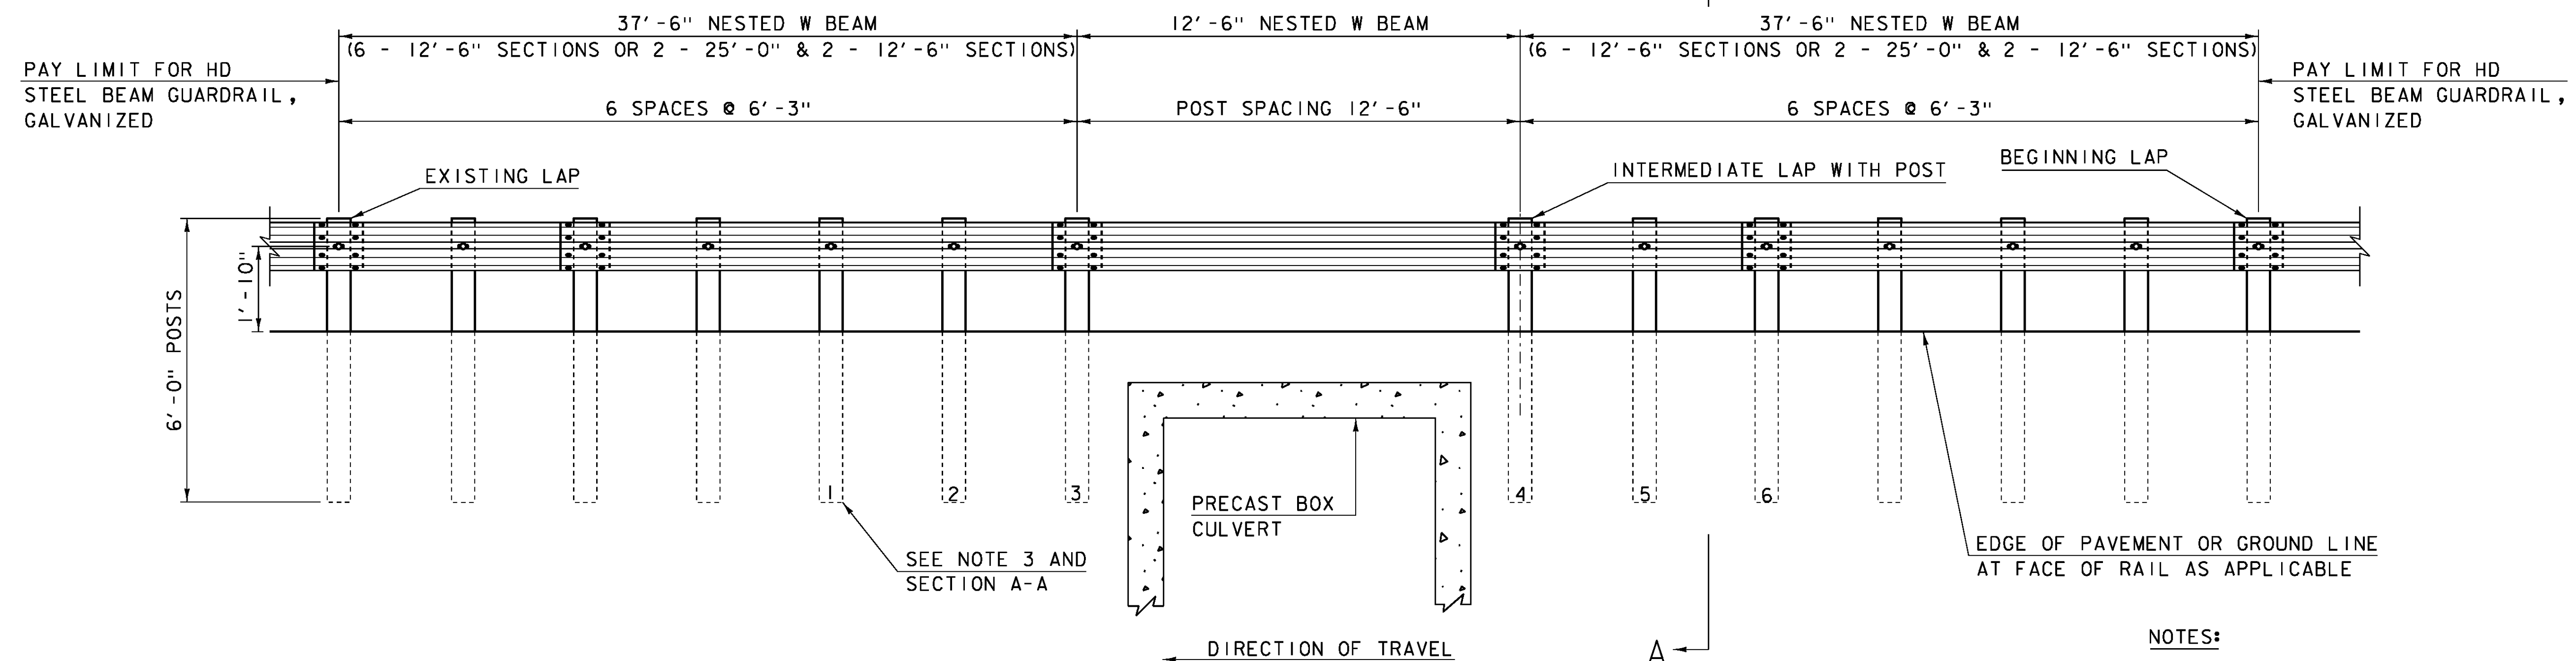


**NESTED RAILING ELEVATION VIEW**

(NOT TO SCALE)


**NOTES:**

1. RAIL MEETS TEST LEVEL 3 REQUIREMENTS OF NCHRP REPORT 350.
2. POSTS 1 THRU 6 ARE BREAKAWAY CONTROLLED RELEASING TERMINAL (CRT) POSTS, SEE SECTION A-A FOR DETAILS.
3. POSTS 1 THRU 6 HAVE TWO, 6" X 8" BLOCKOUTS. SEE SECTION A-A FOR DETAILS.
4. ON POSTS 1 THRU 6, GUARDRAIL BOLT "D", AS SHOWN ON STD G1, SHALL BE 26" LONG.
5. ON ALL POSTS WHERE THE RAIL IS NESTED GUARDRAIL BOLT "A", AS SHOWN ON STD G1, SHALL BE 2" LONG.
6. CLEAR AREA BEHIND 12'-6" OPEN SPAN SHALL BE 5 FEET MINIMUM FROM FACE OF RAIL.
7. SEE STD G1 FOR ADDITIONAL GUARDRAIL DETAILS.

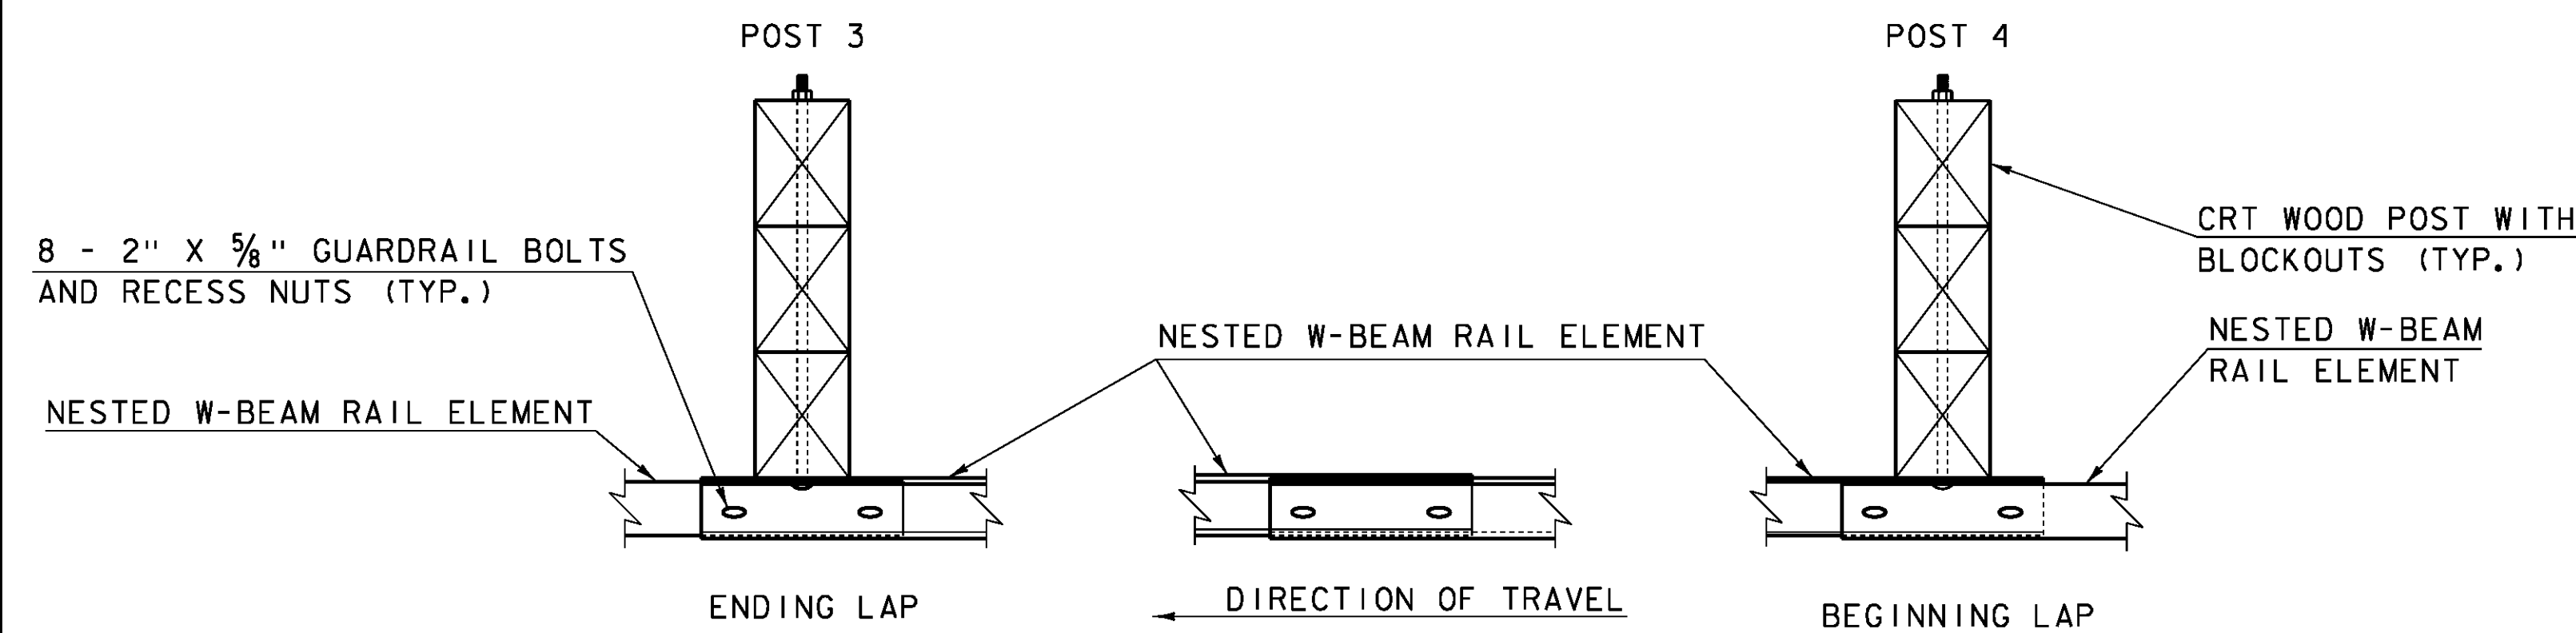

**INTERMEDIATE LAP WITHOUT POST**

(NOT TO SCALE)

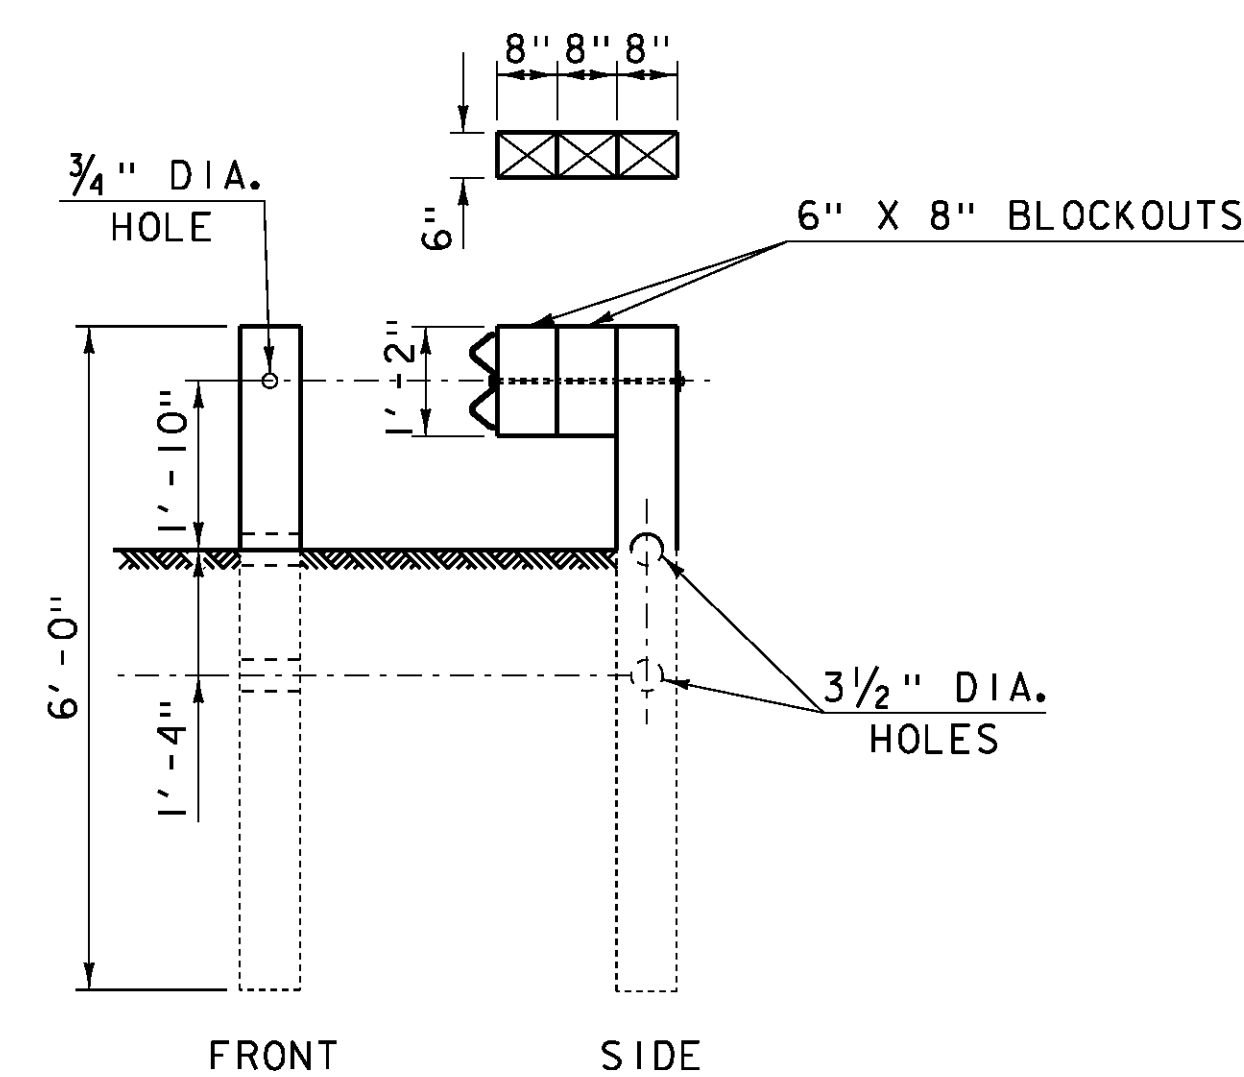


**SECTION A-A  
(POSTS 1 THRU 6)**

(SEE NOTES 3 & 4)


PROJECT NAME: ROYALTON  
PROJECT NUMBER: BRS 0147(13)

FILE NAME: s86e055rail_cattlepass3.dgn PLOT DATE: 08-OCT-2013  
PROJECT LEADER: C. CARLSON DRAWN BY: D. PETERSON  
DESIGNED BY: D. PETERSON CHECKED BY: C. CARLSON  
LONG SPAN GUARDRAIL DETAILS SHEET 78 OF 186

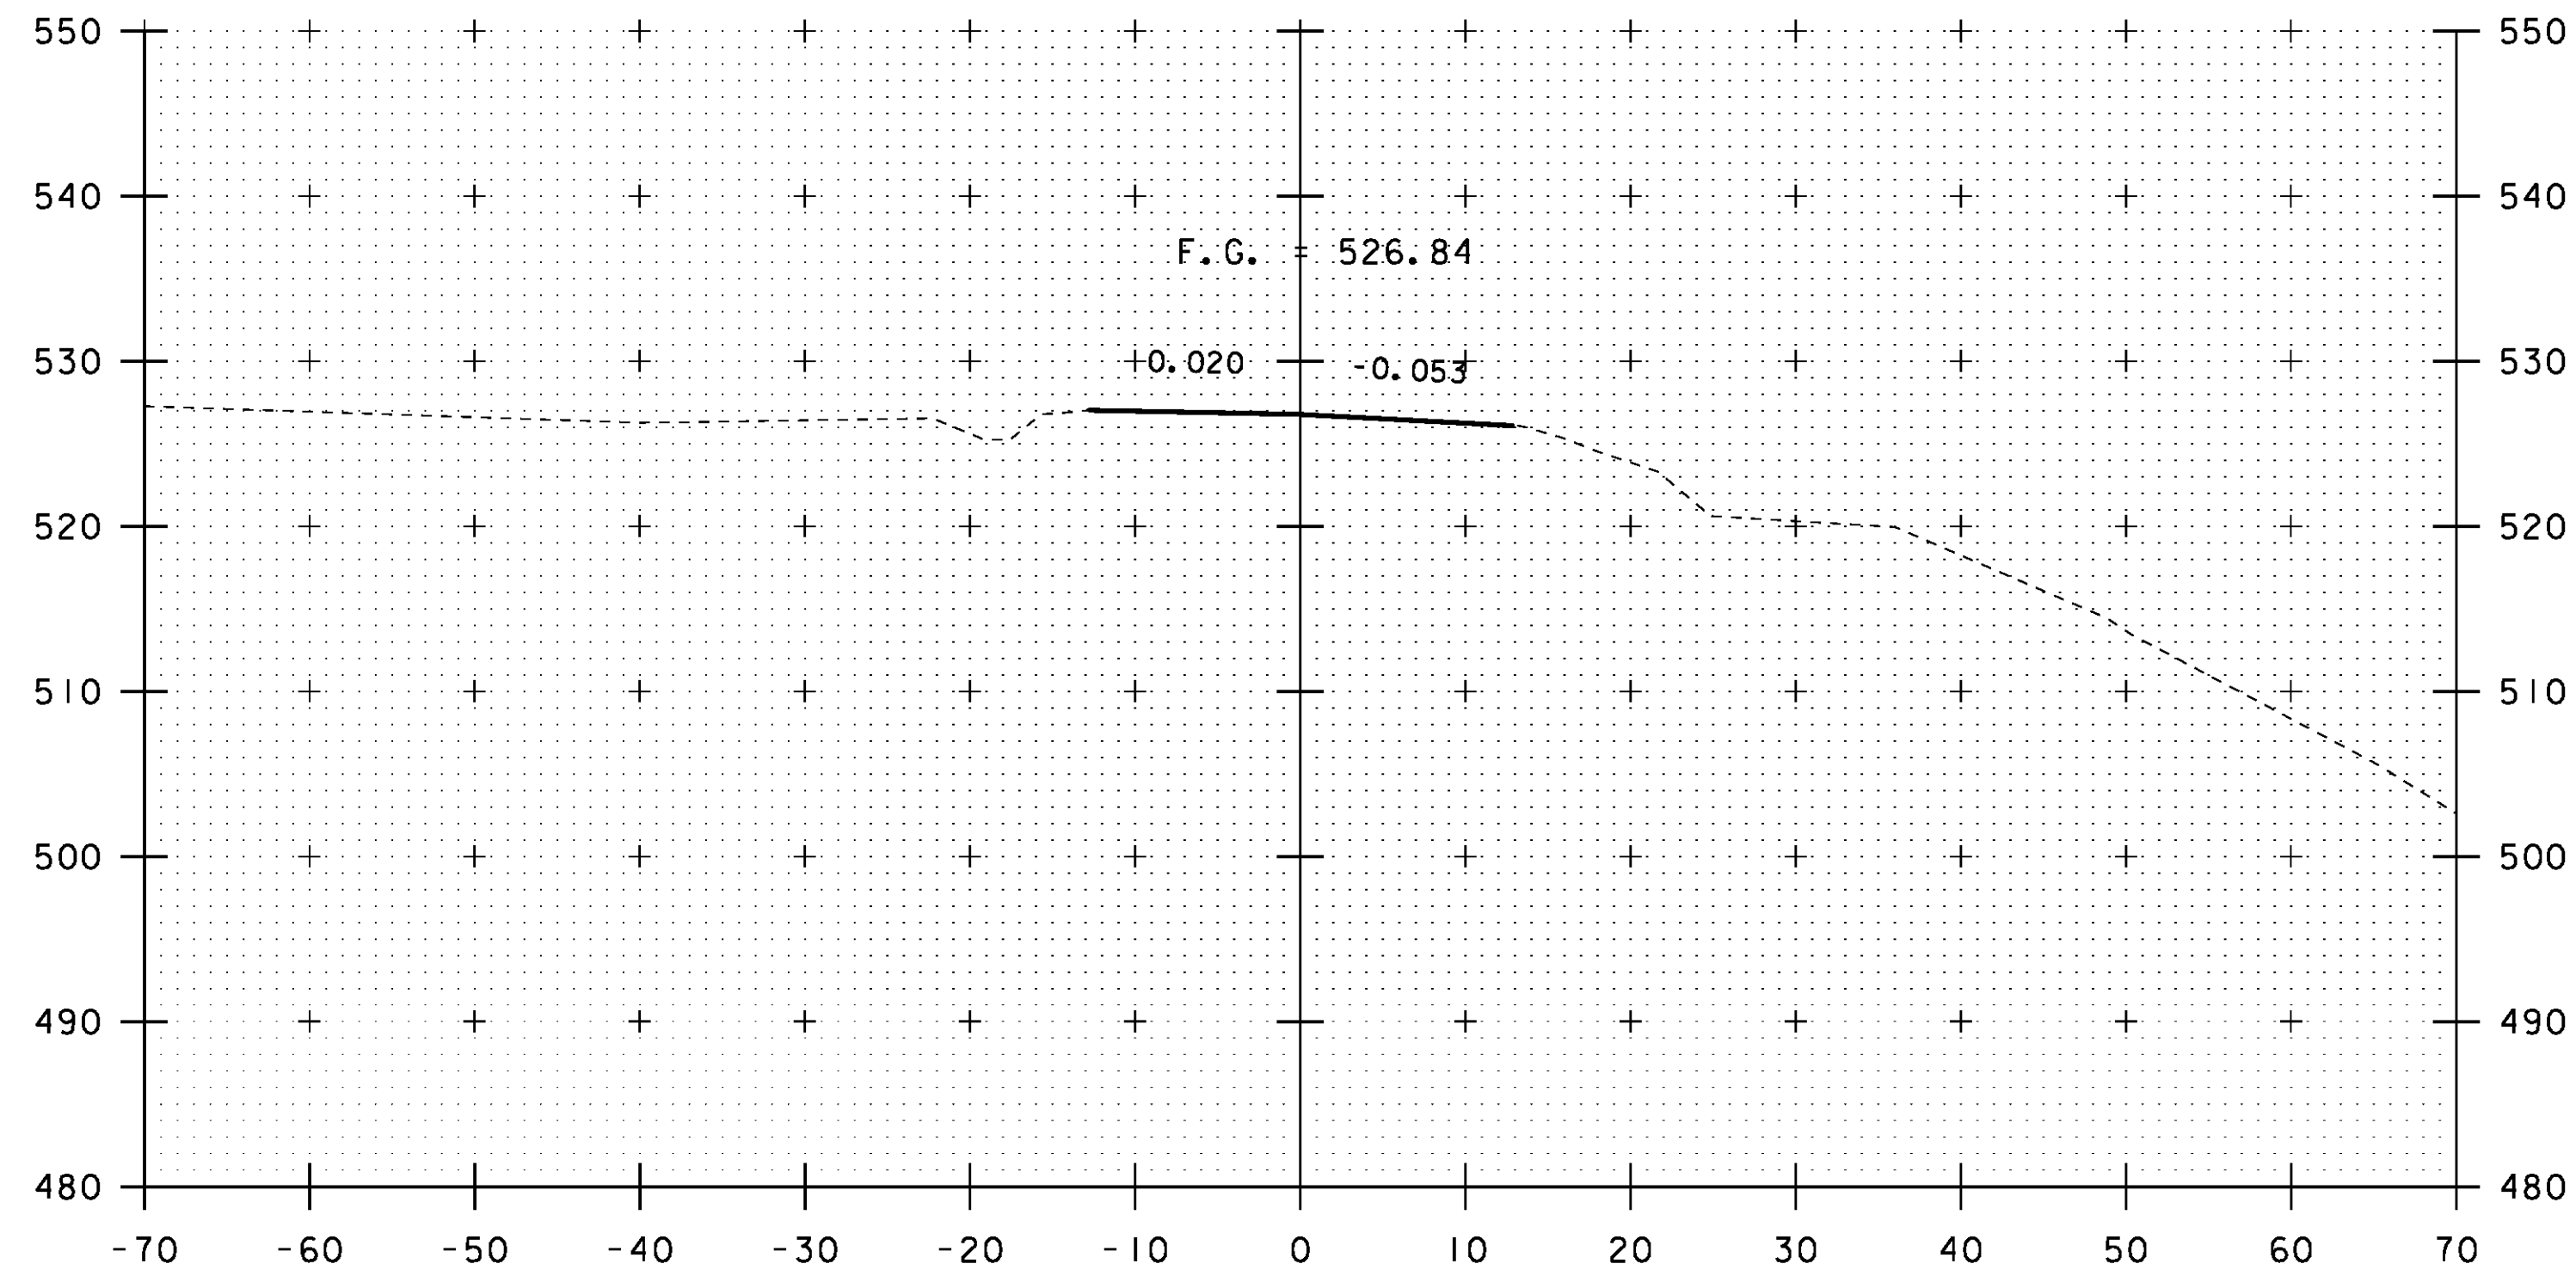


399+25


STA 399+25.00  
BEGIN APPROACH  
MATCH EXISTING

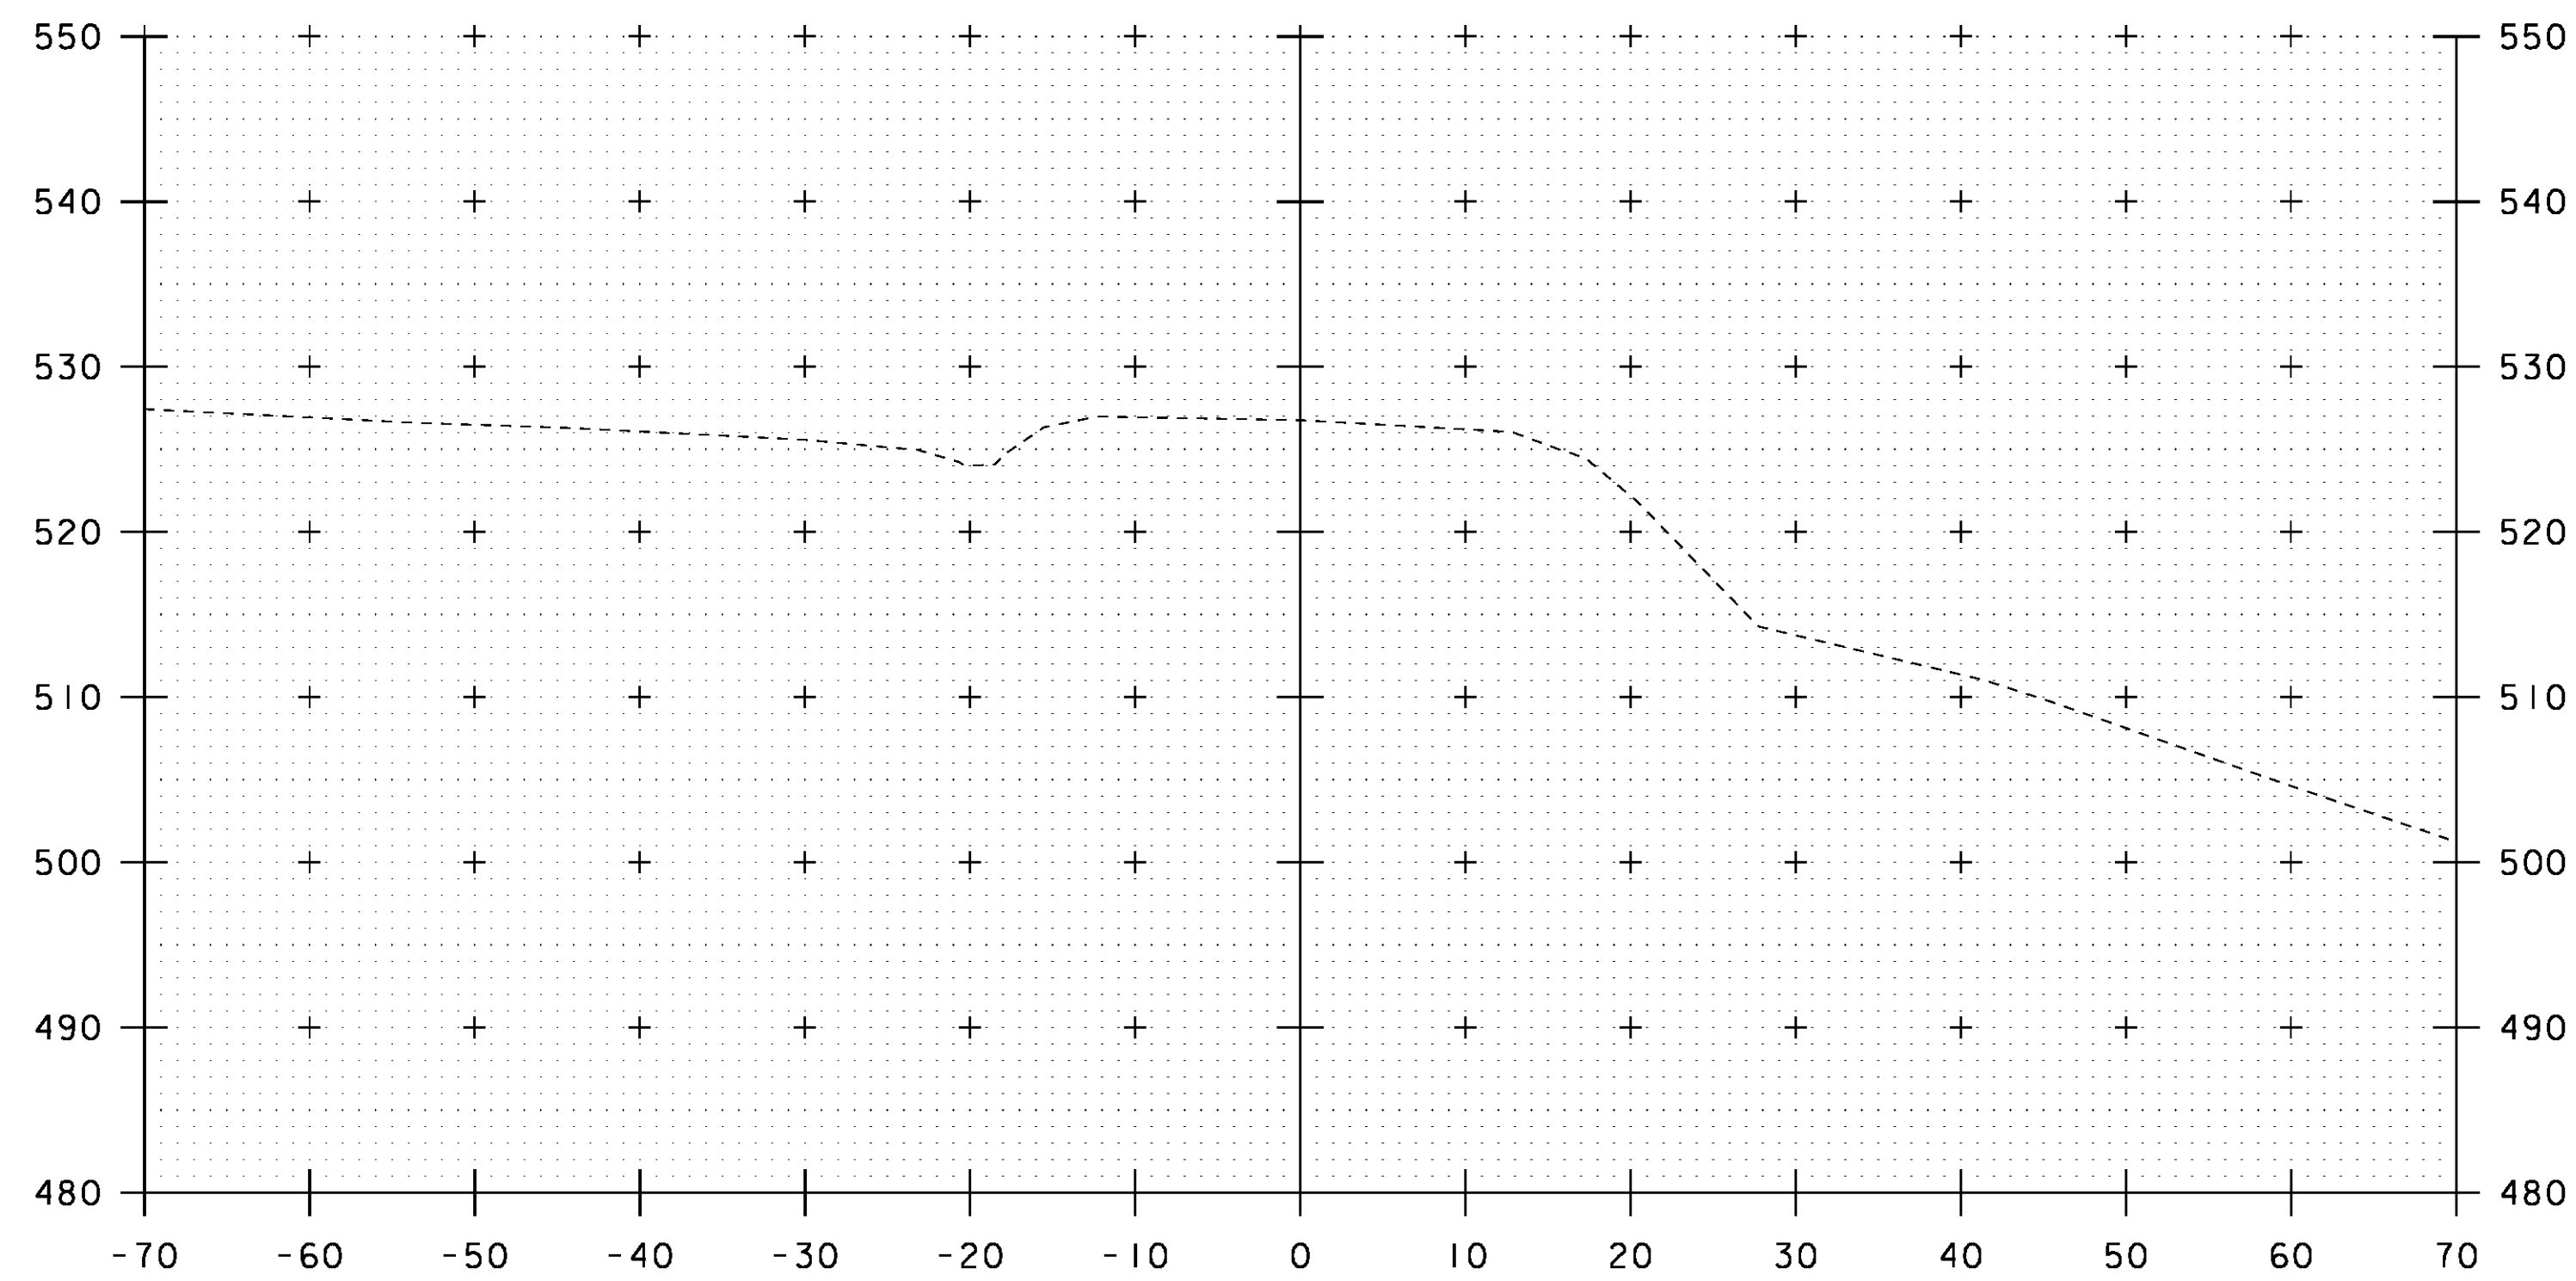


399+00

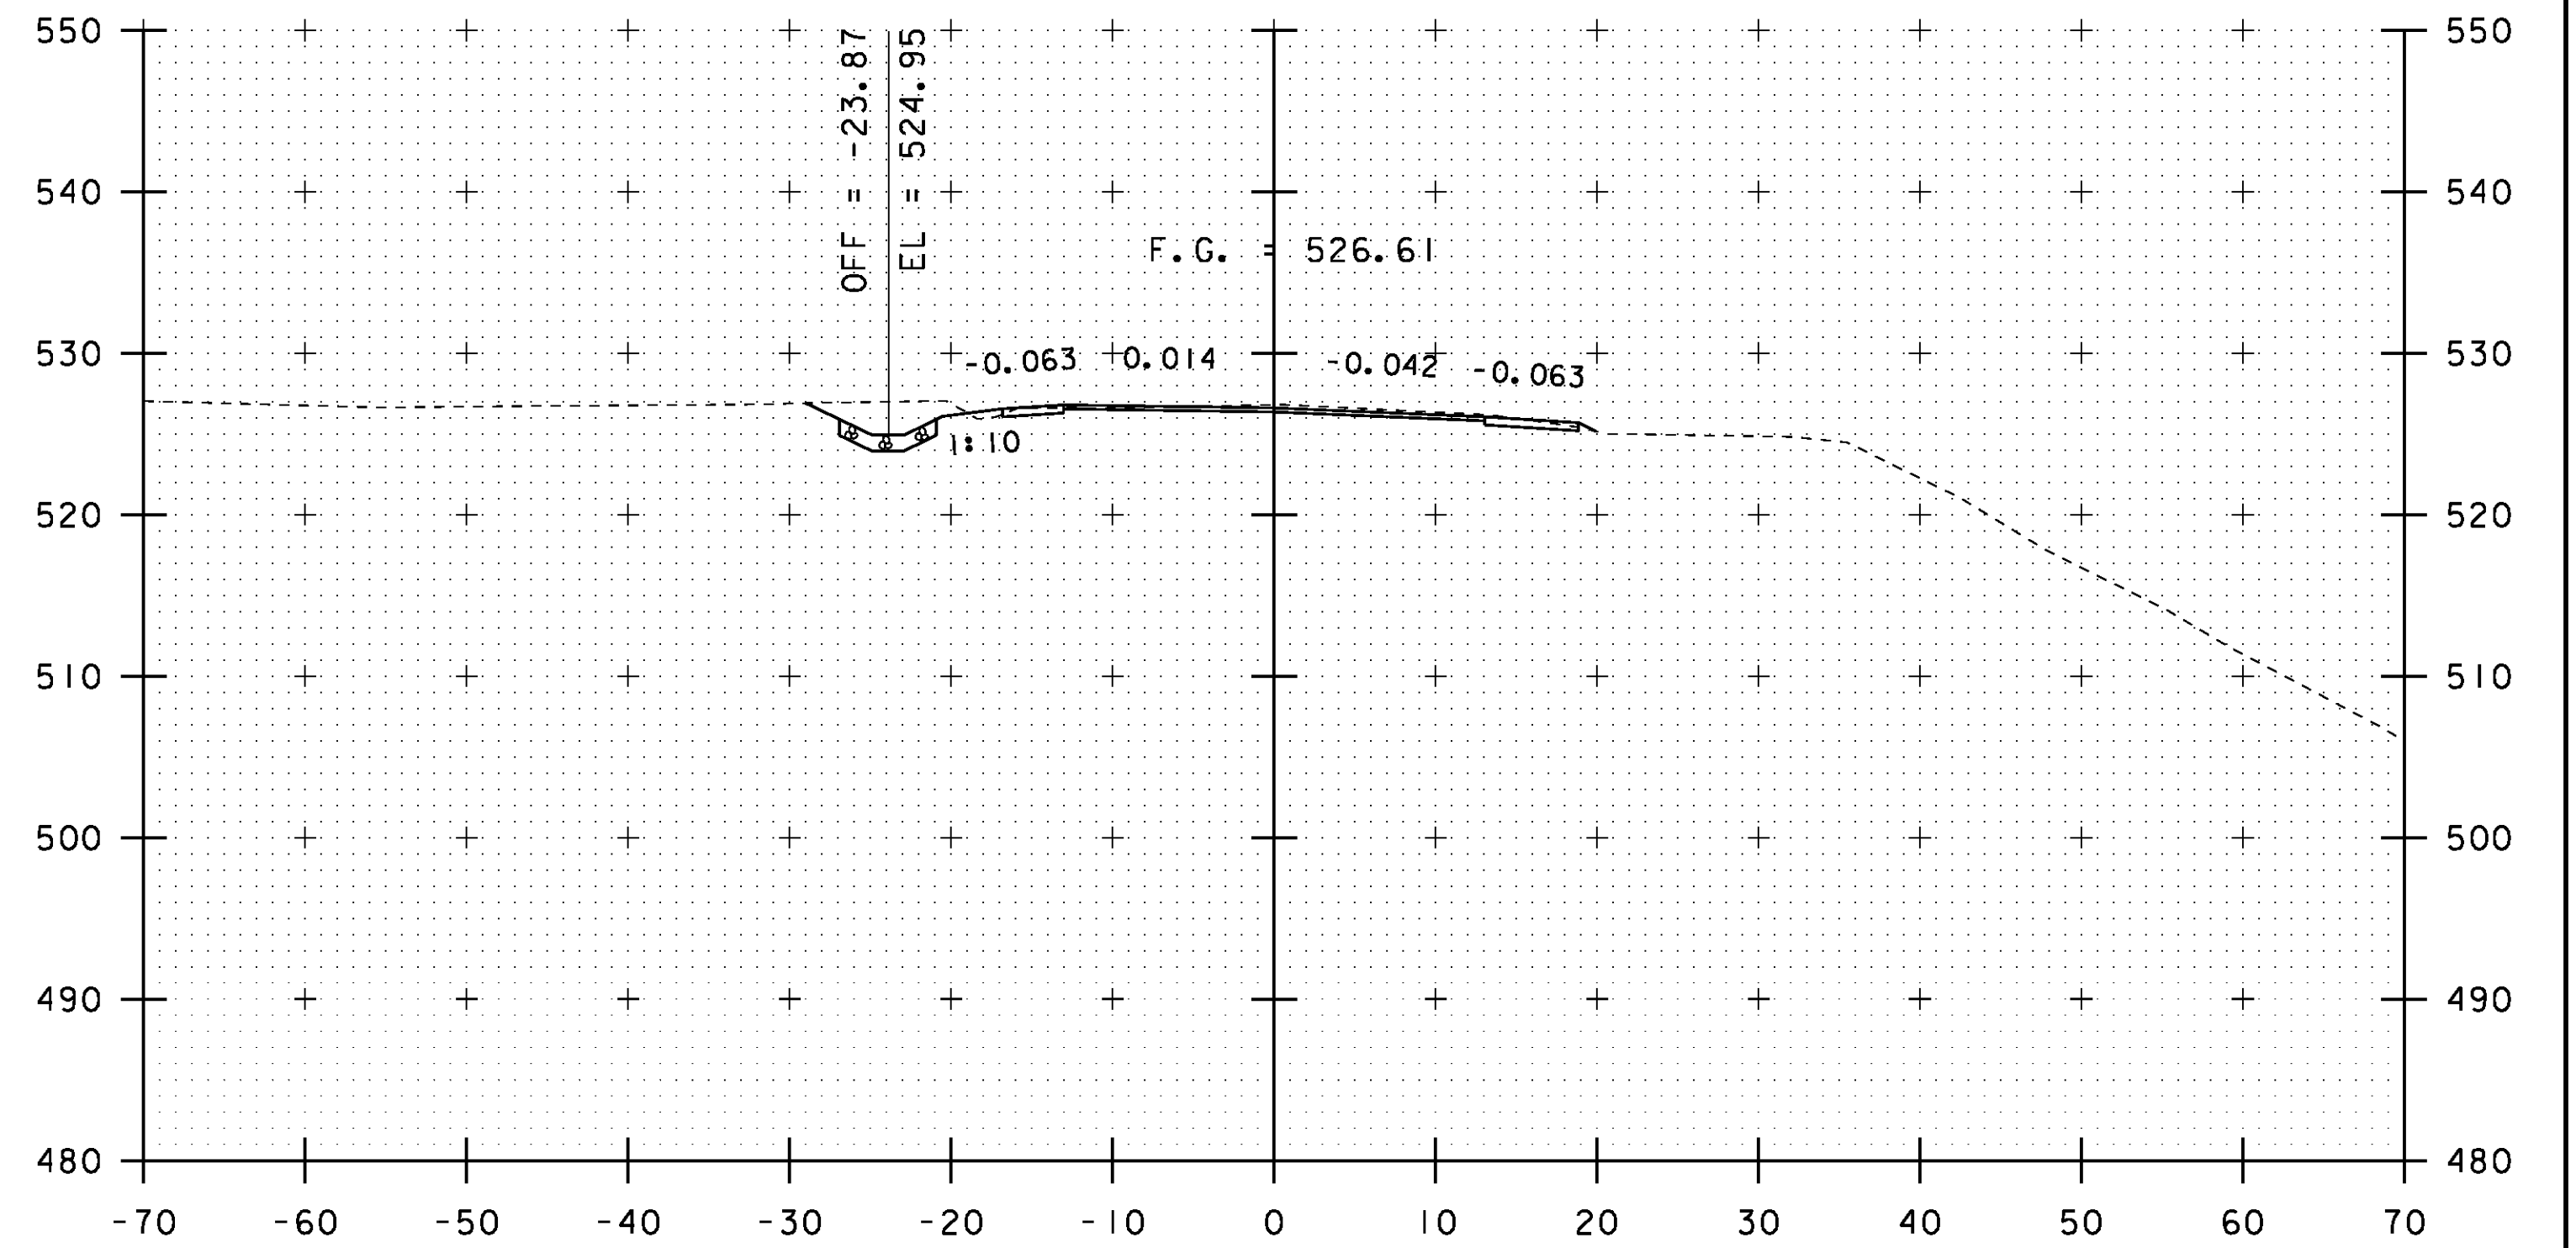

399+75

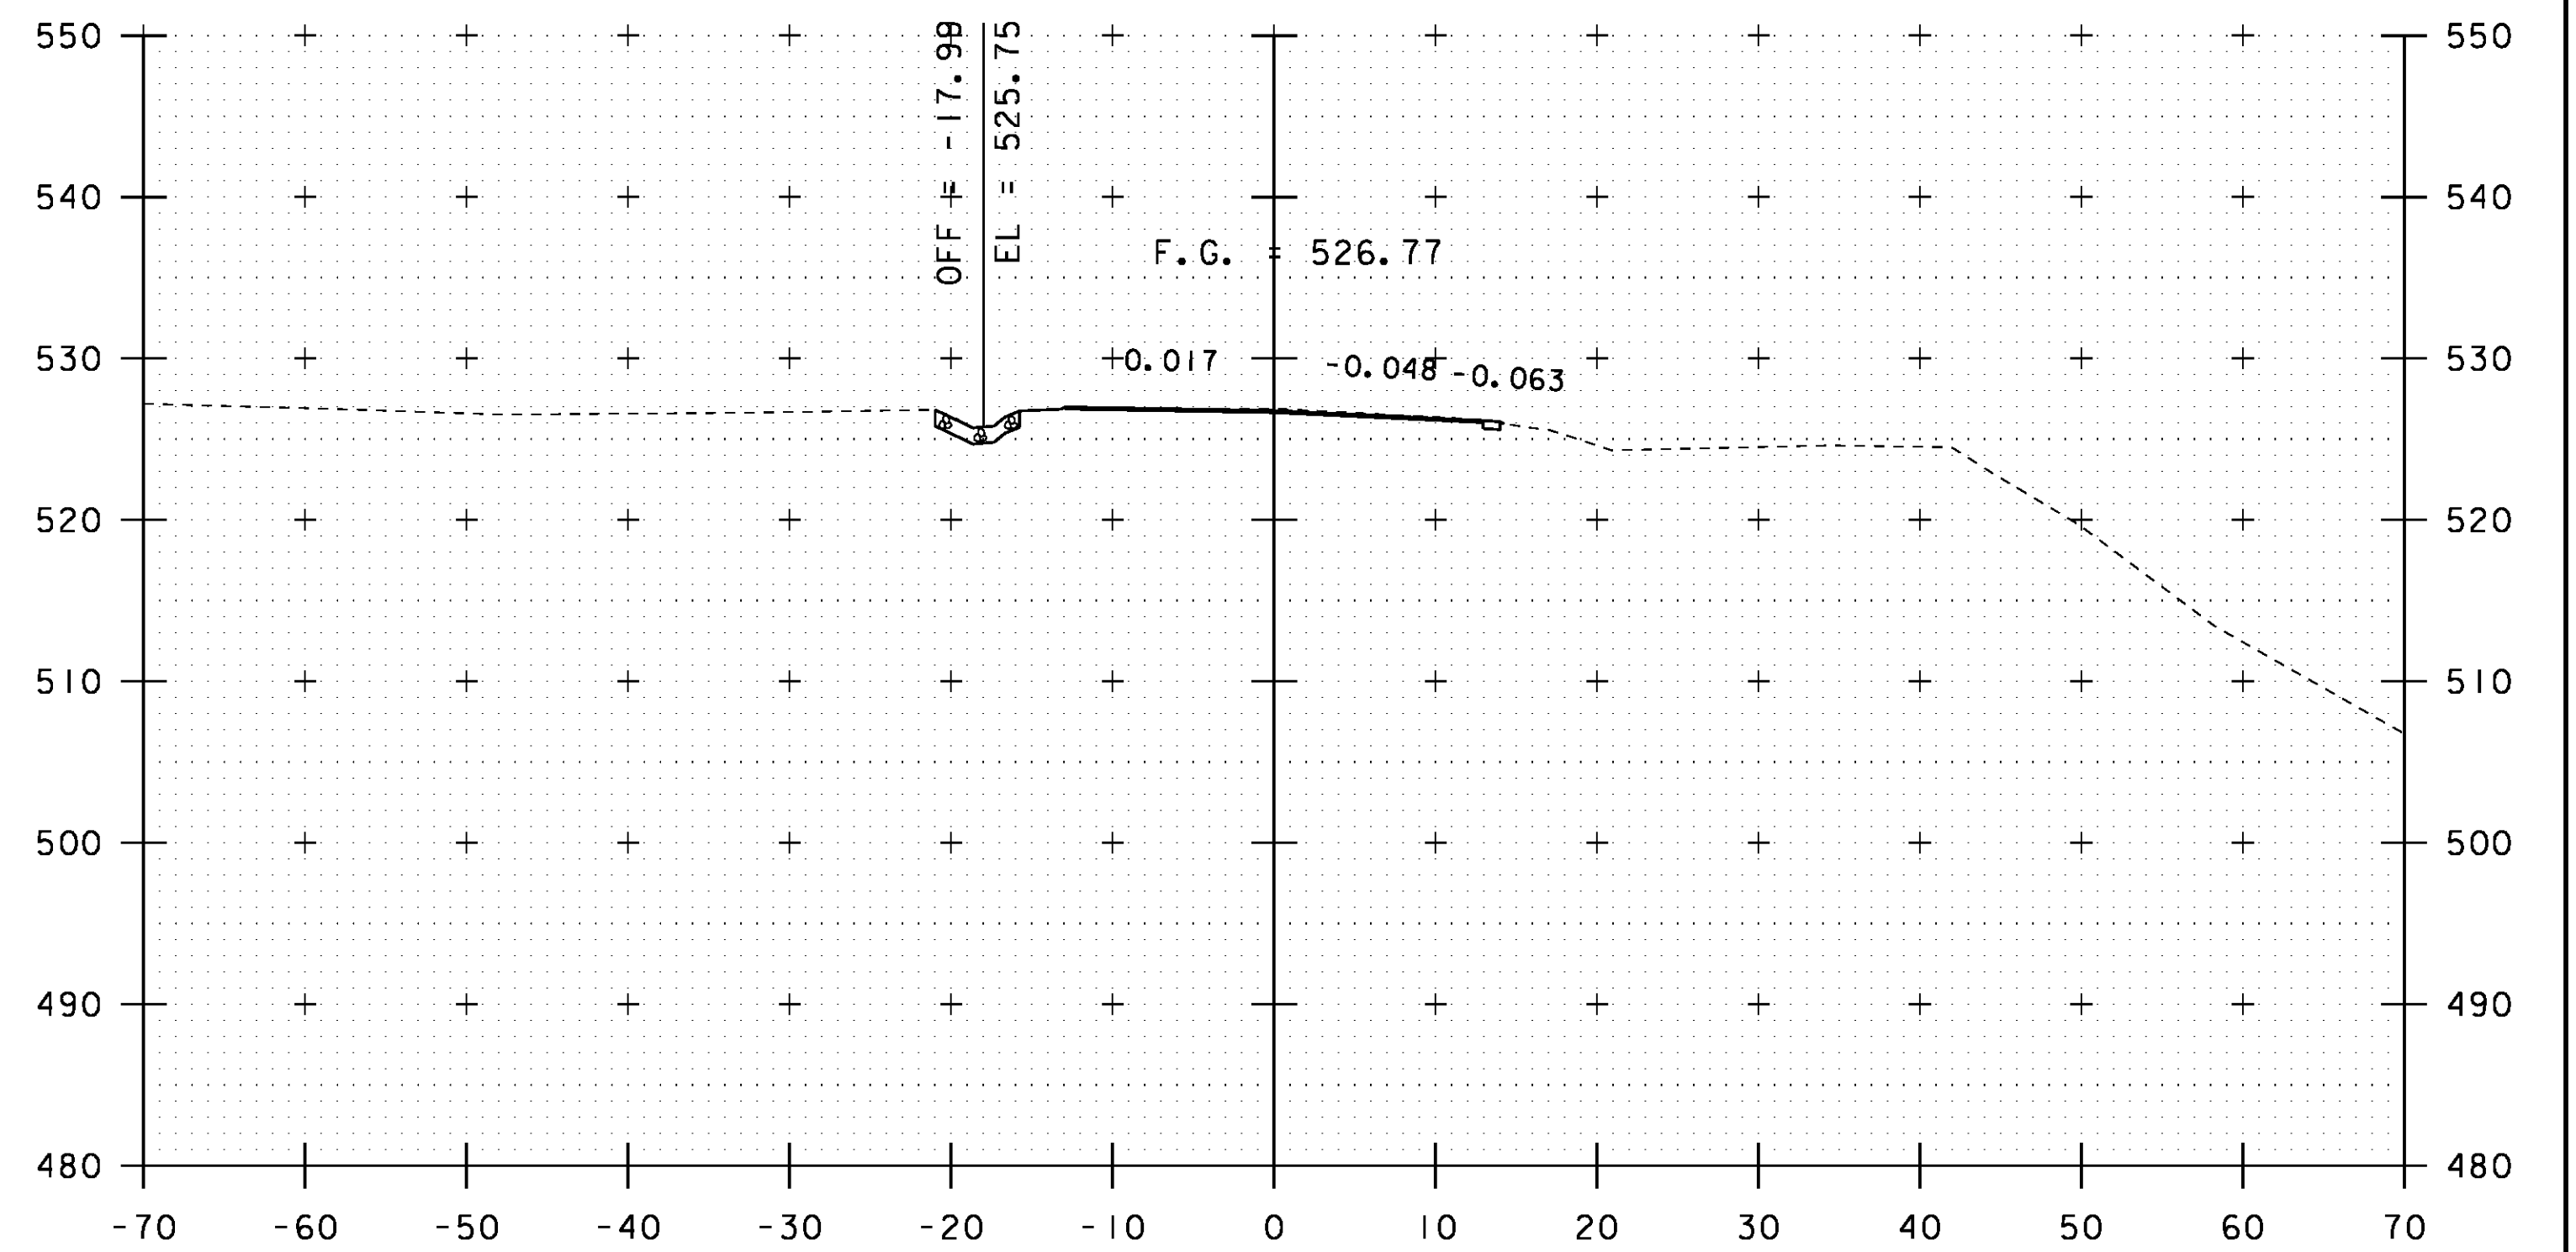


399+50

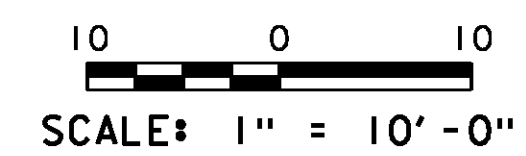


STA. 399+00 TO STA. 399+75

PROJECT NAME: ROYALTON	PLOT DATE: 08-OCT-2013
PROJECT NUMBER: BRS 0147(13)	DRAWN BY: G. ROY
FILE NAME: s86e05xsl_cattlepass3.dgn	CHECKED BY: D. PETERSON
PROJECT LEADER: C. CARLSON	
DESIGNED BY: G. ROY	
VT 14 CROSS SECTIONS AT CATTLE PASS (1) SHEET 79 OF 186	

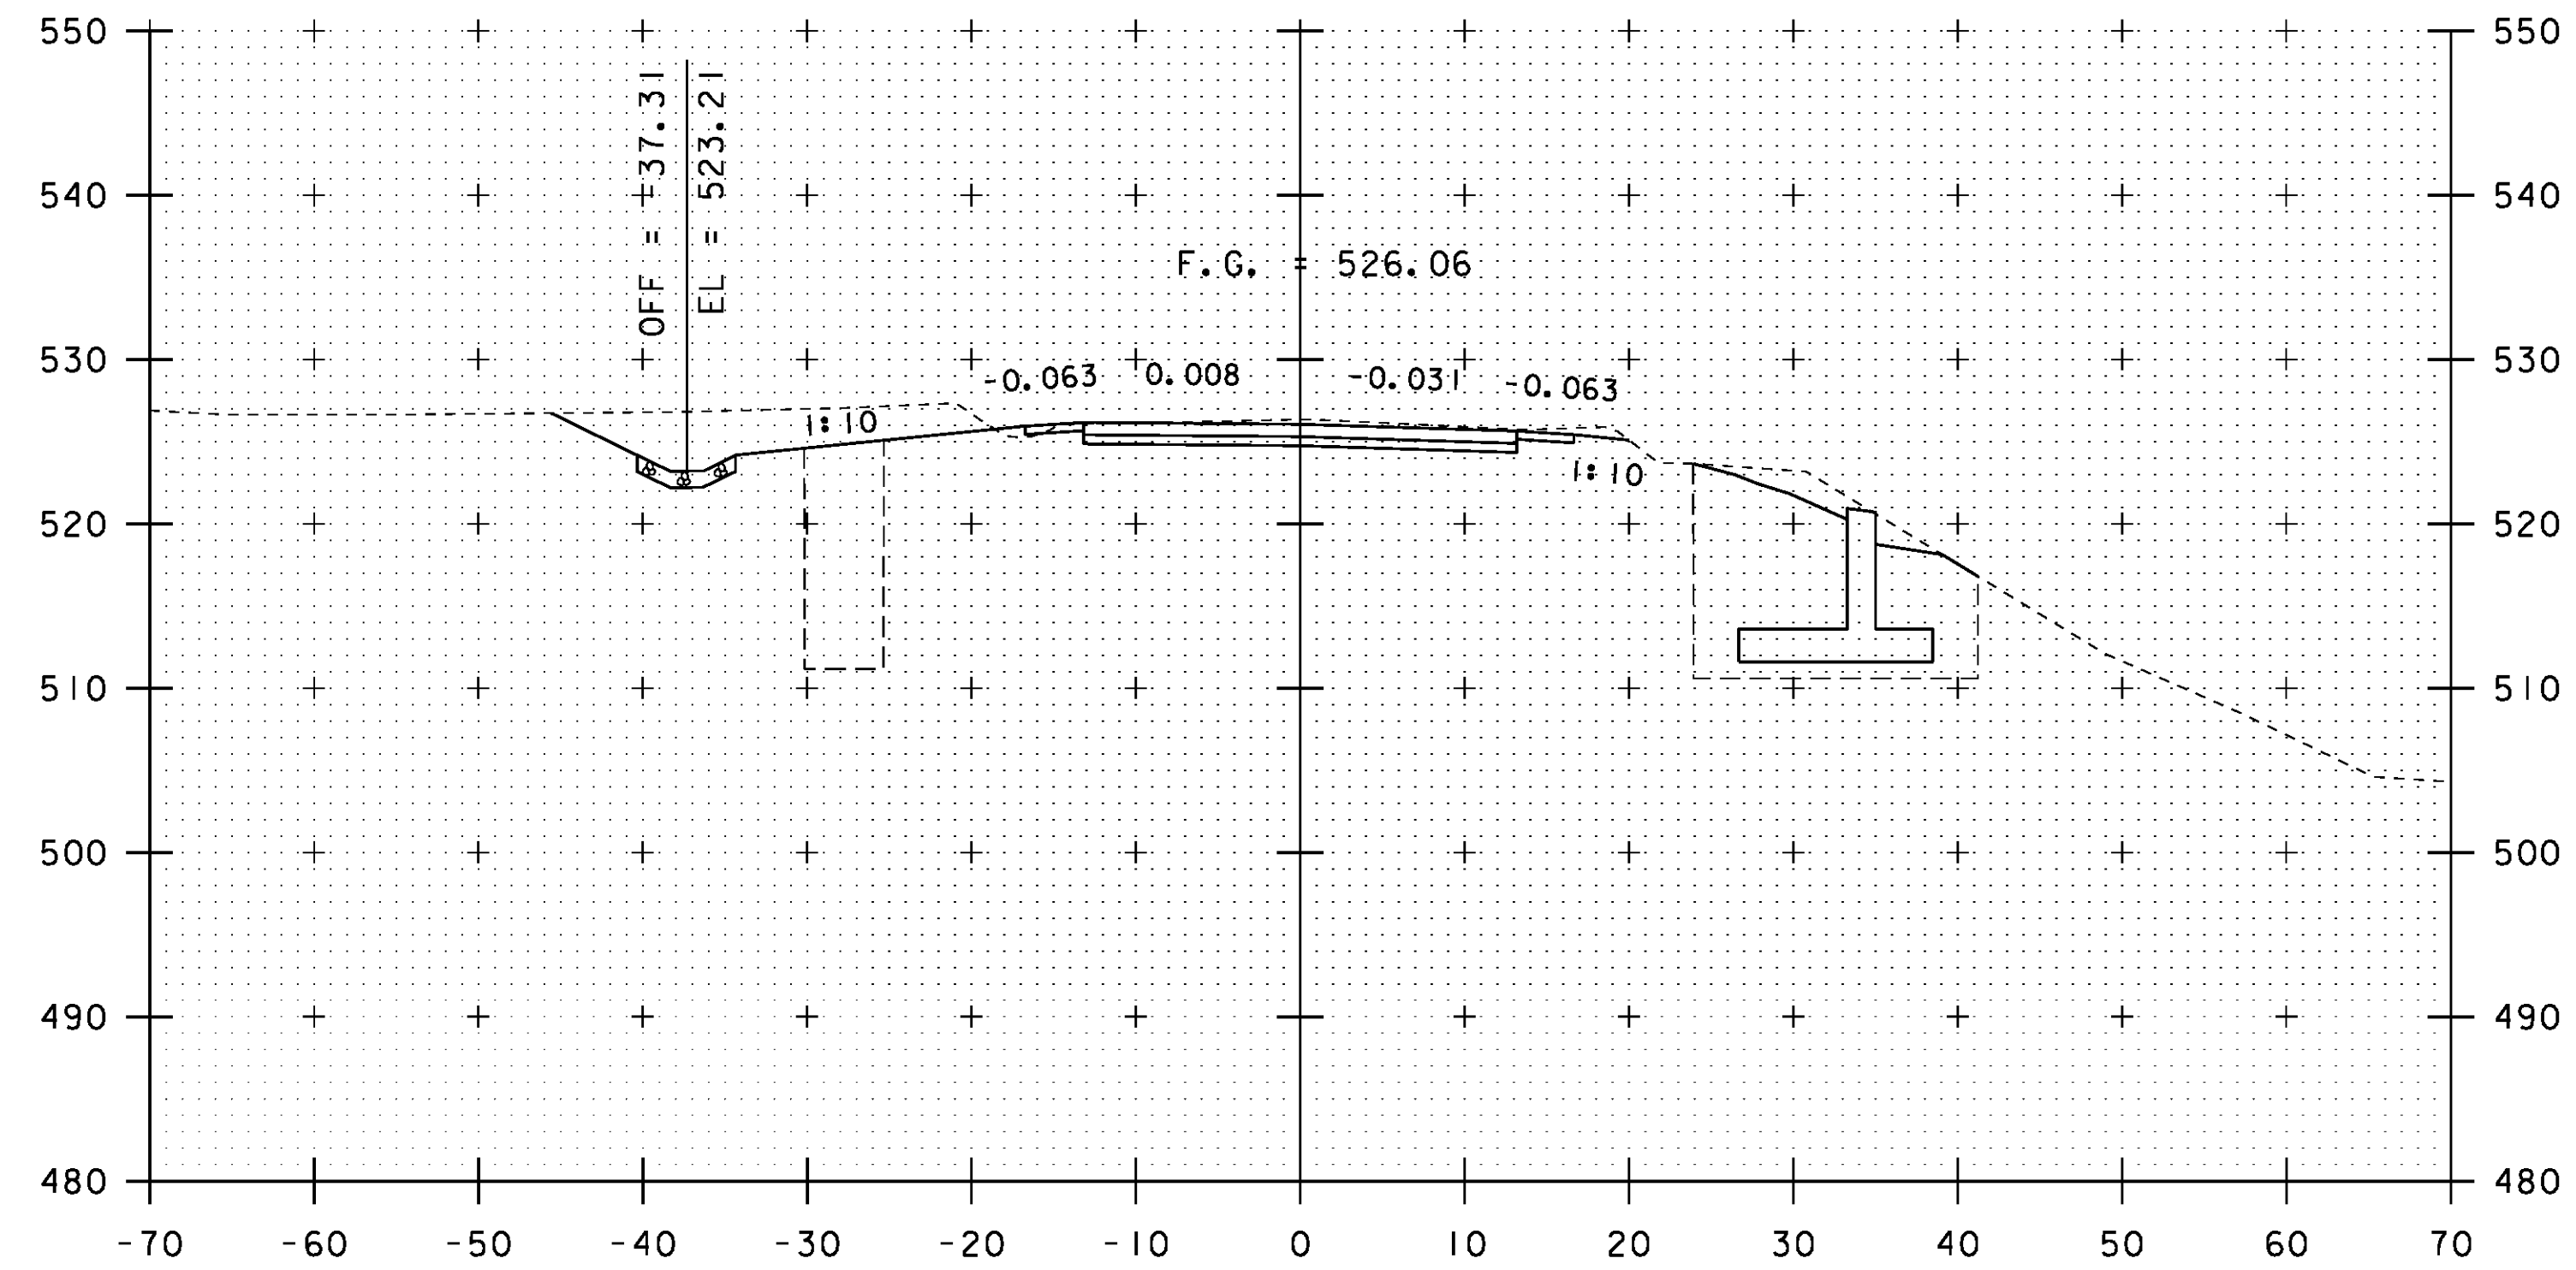


400+25

STA 400+25.00  
BEGIN FULL DEPTH CONSTRUCTION

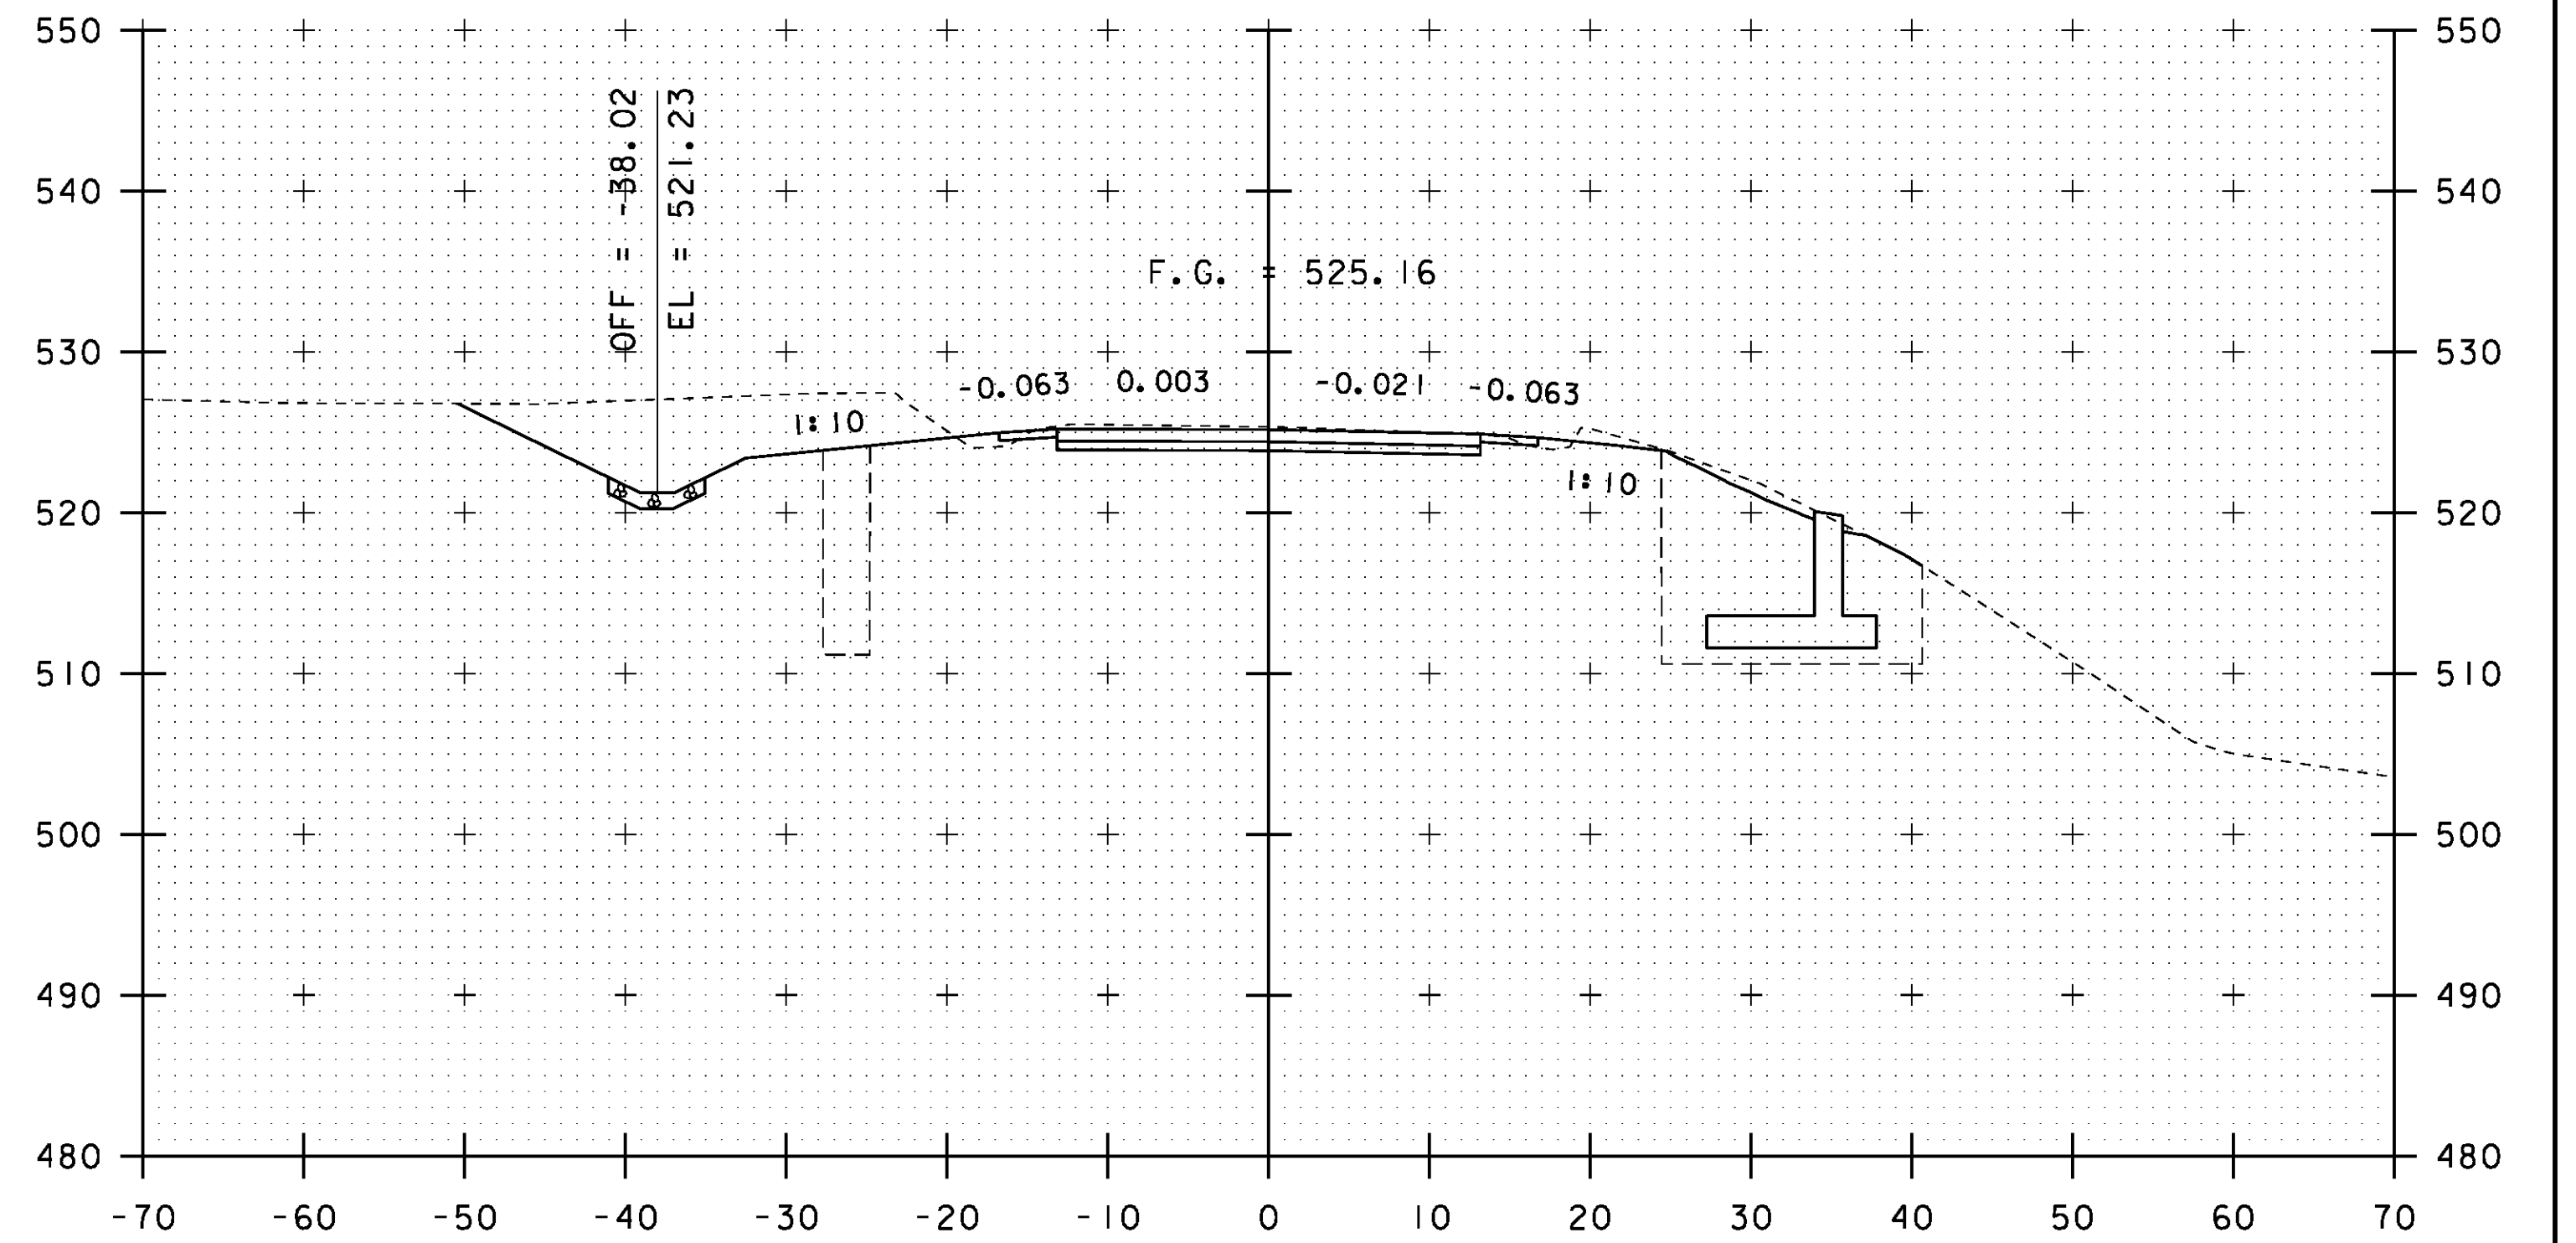


400+75

STA 400+75.00  
END FULL DEPTH CONSTRUCTION

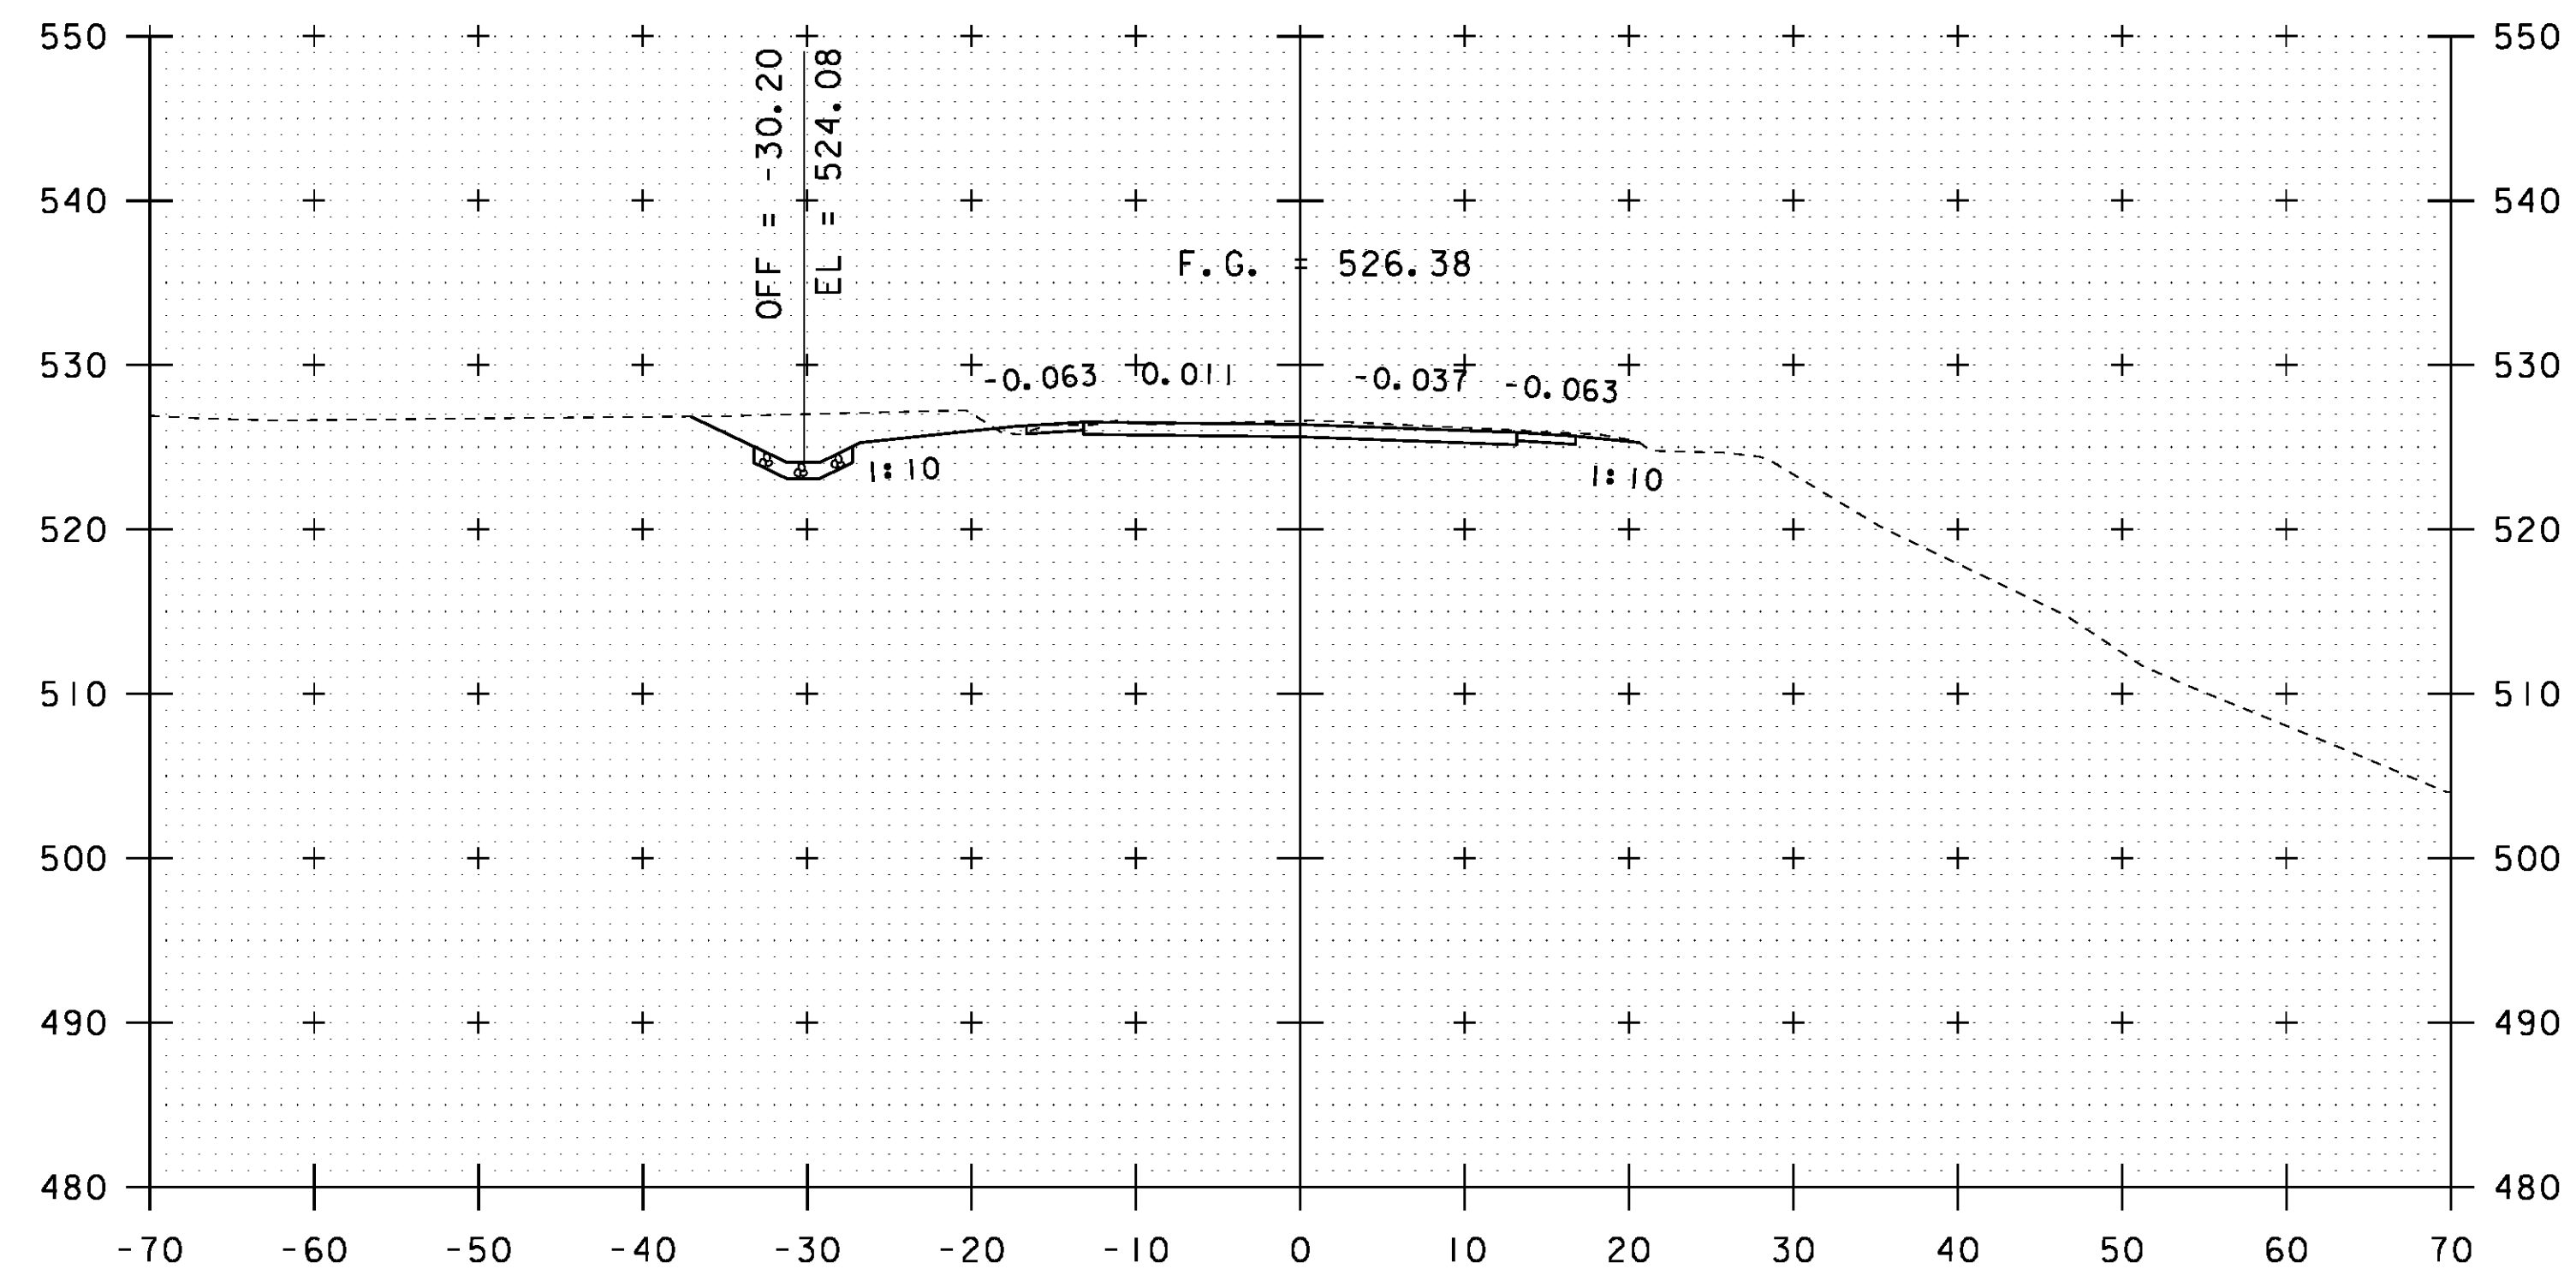


400+00

STA 400+00.00  
END APPROACH

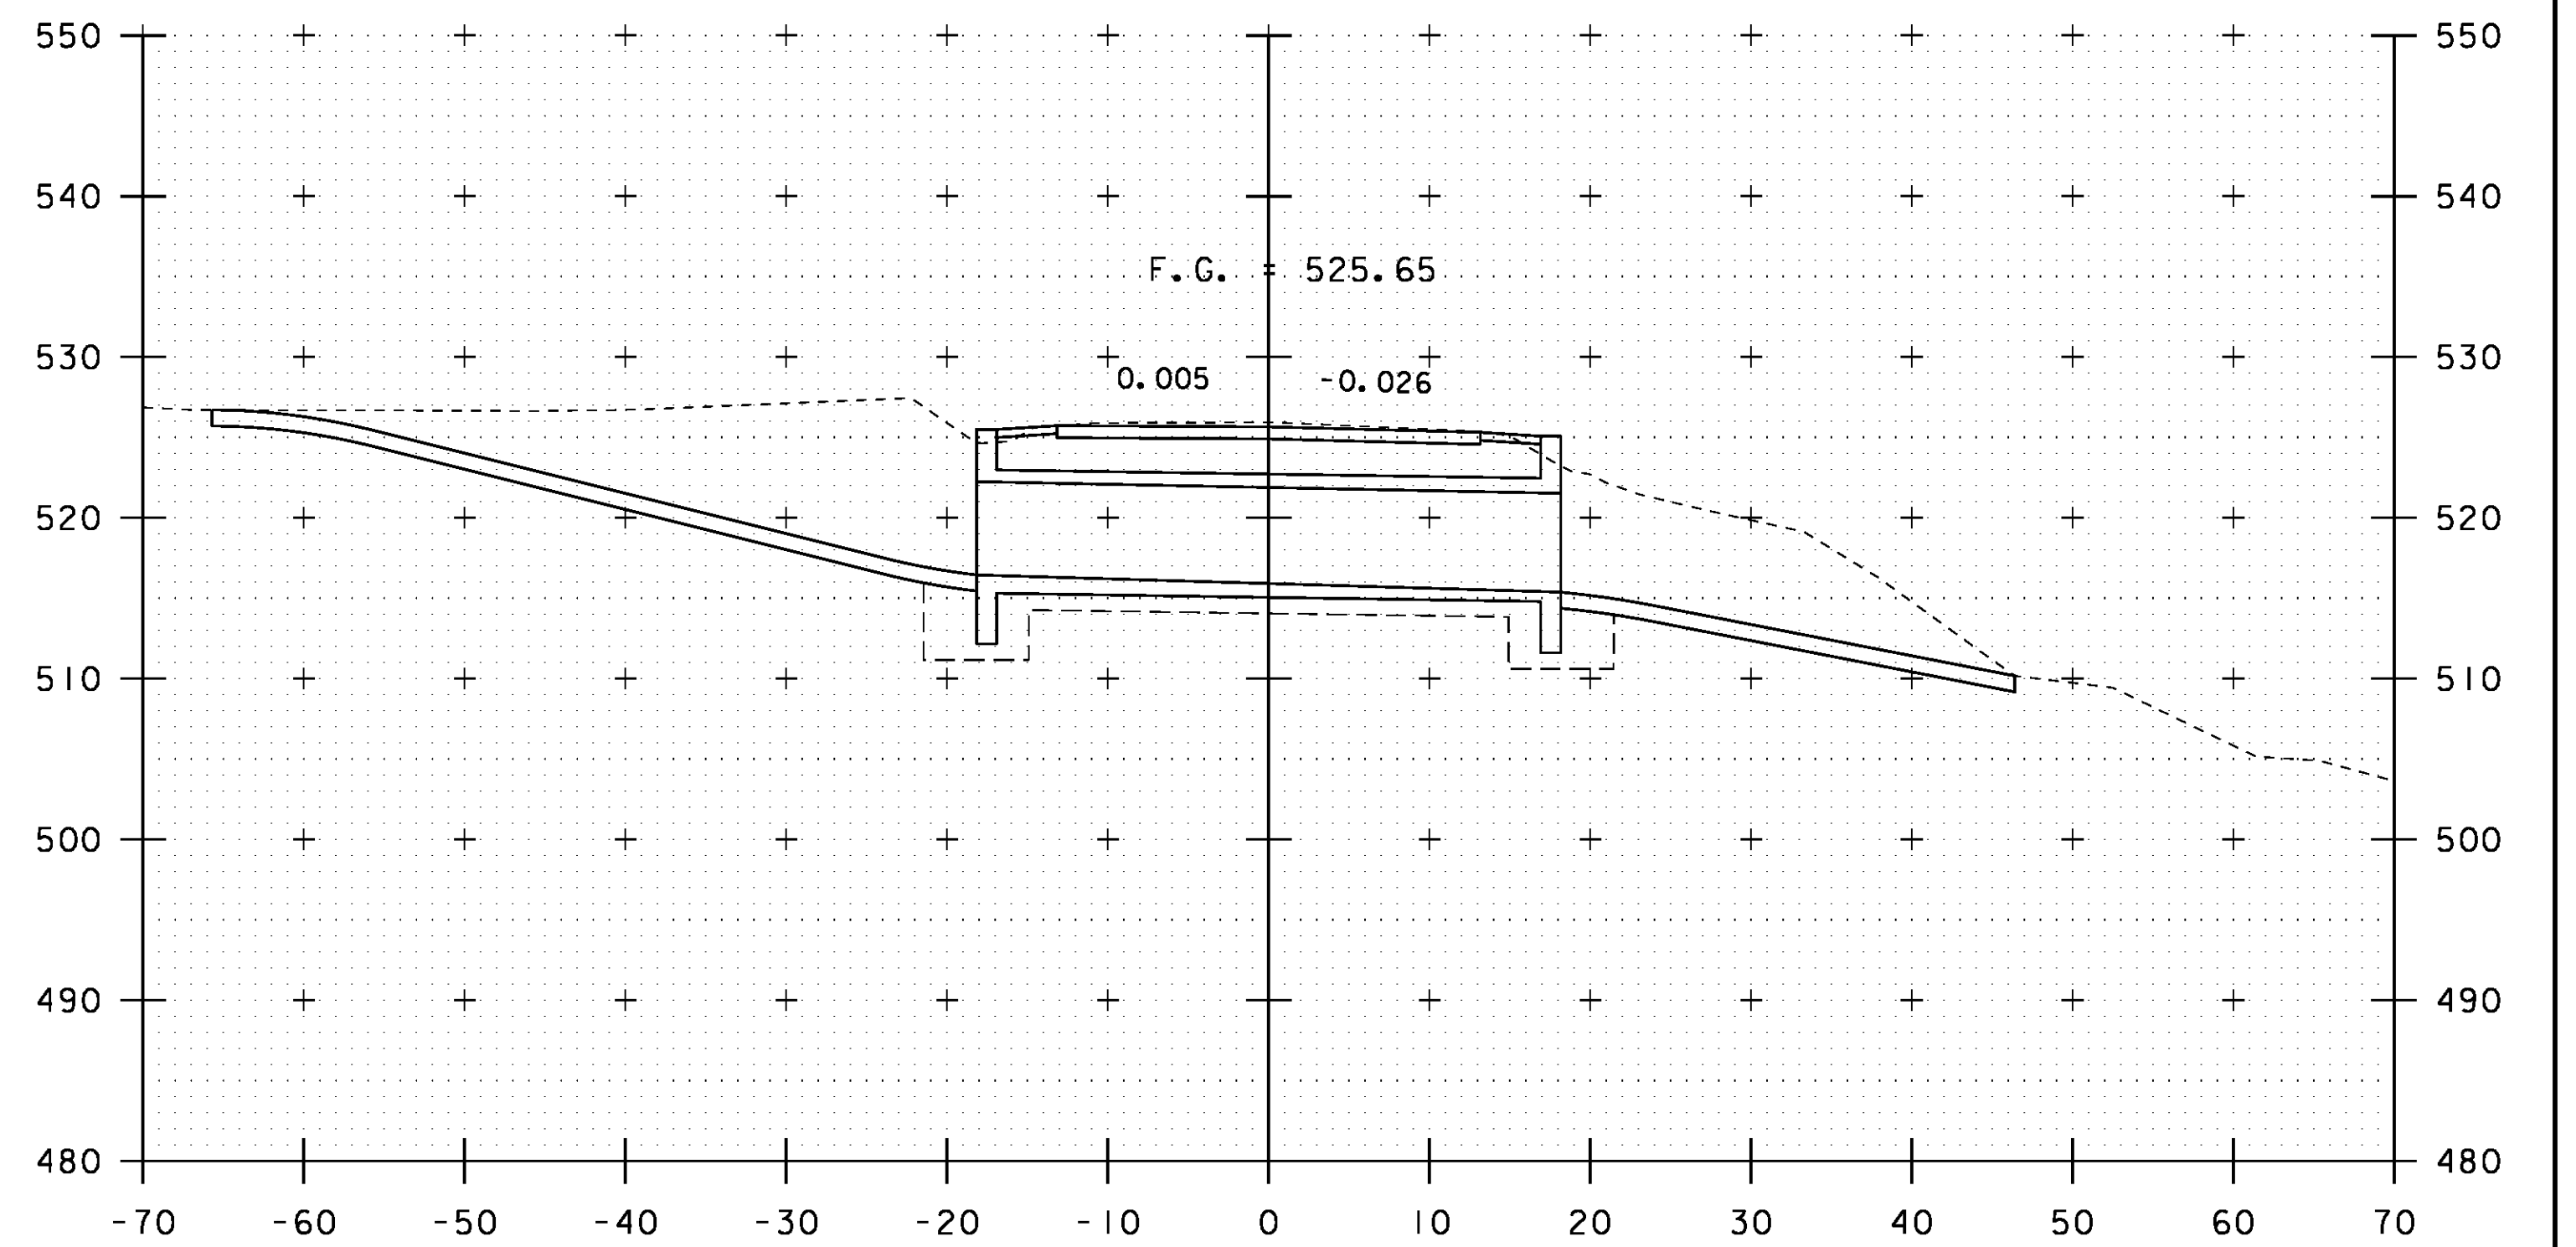

400+50


STA 400+50.00  
CONSTRUCT 8' W X 6' H X 36-4" BOX

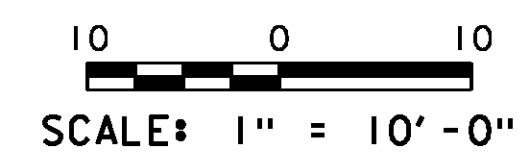


STA. 400+00 TO STA. 400+75

PROJECT NAME:	ROYALTON	PLOT DATE:	08-OCT-2013
PROJECT NUMBER:	BRS 0147(13)	DRAWN BY:	G. ROY
FILE NAME:	s86e05xsl_cattlepass3.dgn	DESIGNED BY:	G. ROY
PROJECT LEADER:	C. CARLSON	CHECKED BY:	D. PETERSON
VT 14 CROSS SECTIONS AT CATTLE PASS (2)		SHEET 80 OF 186	



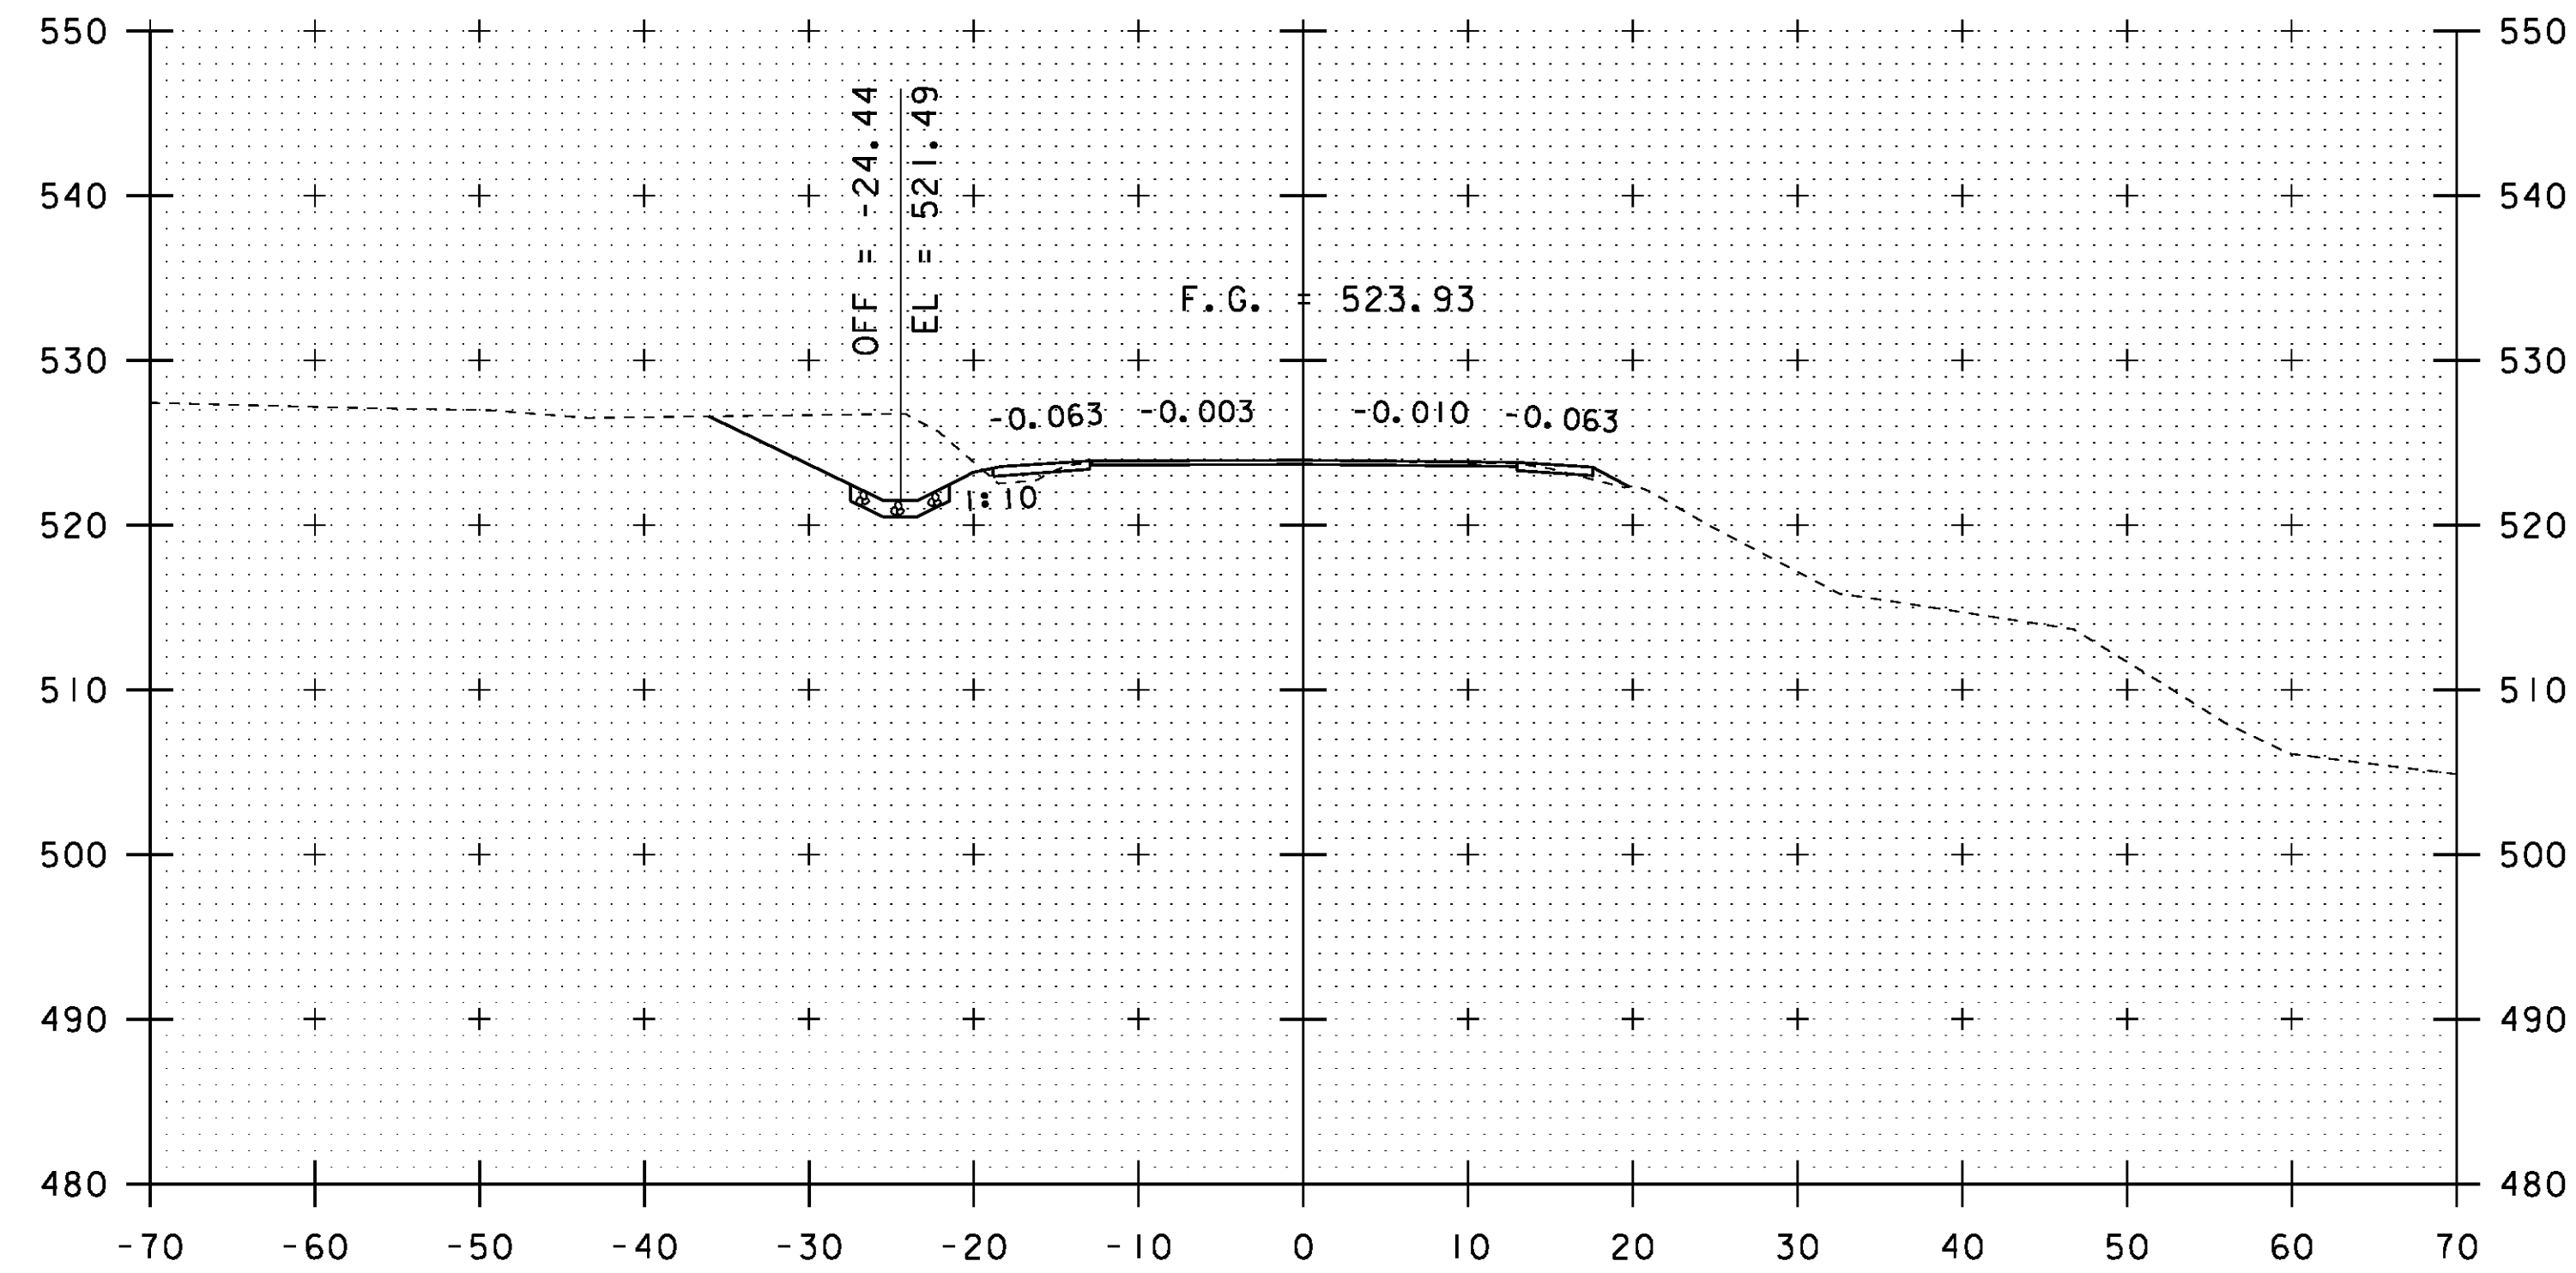


401+25

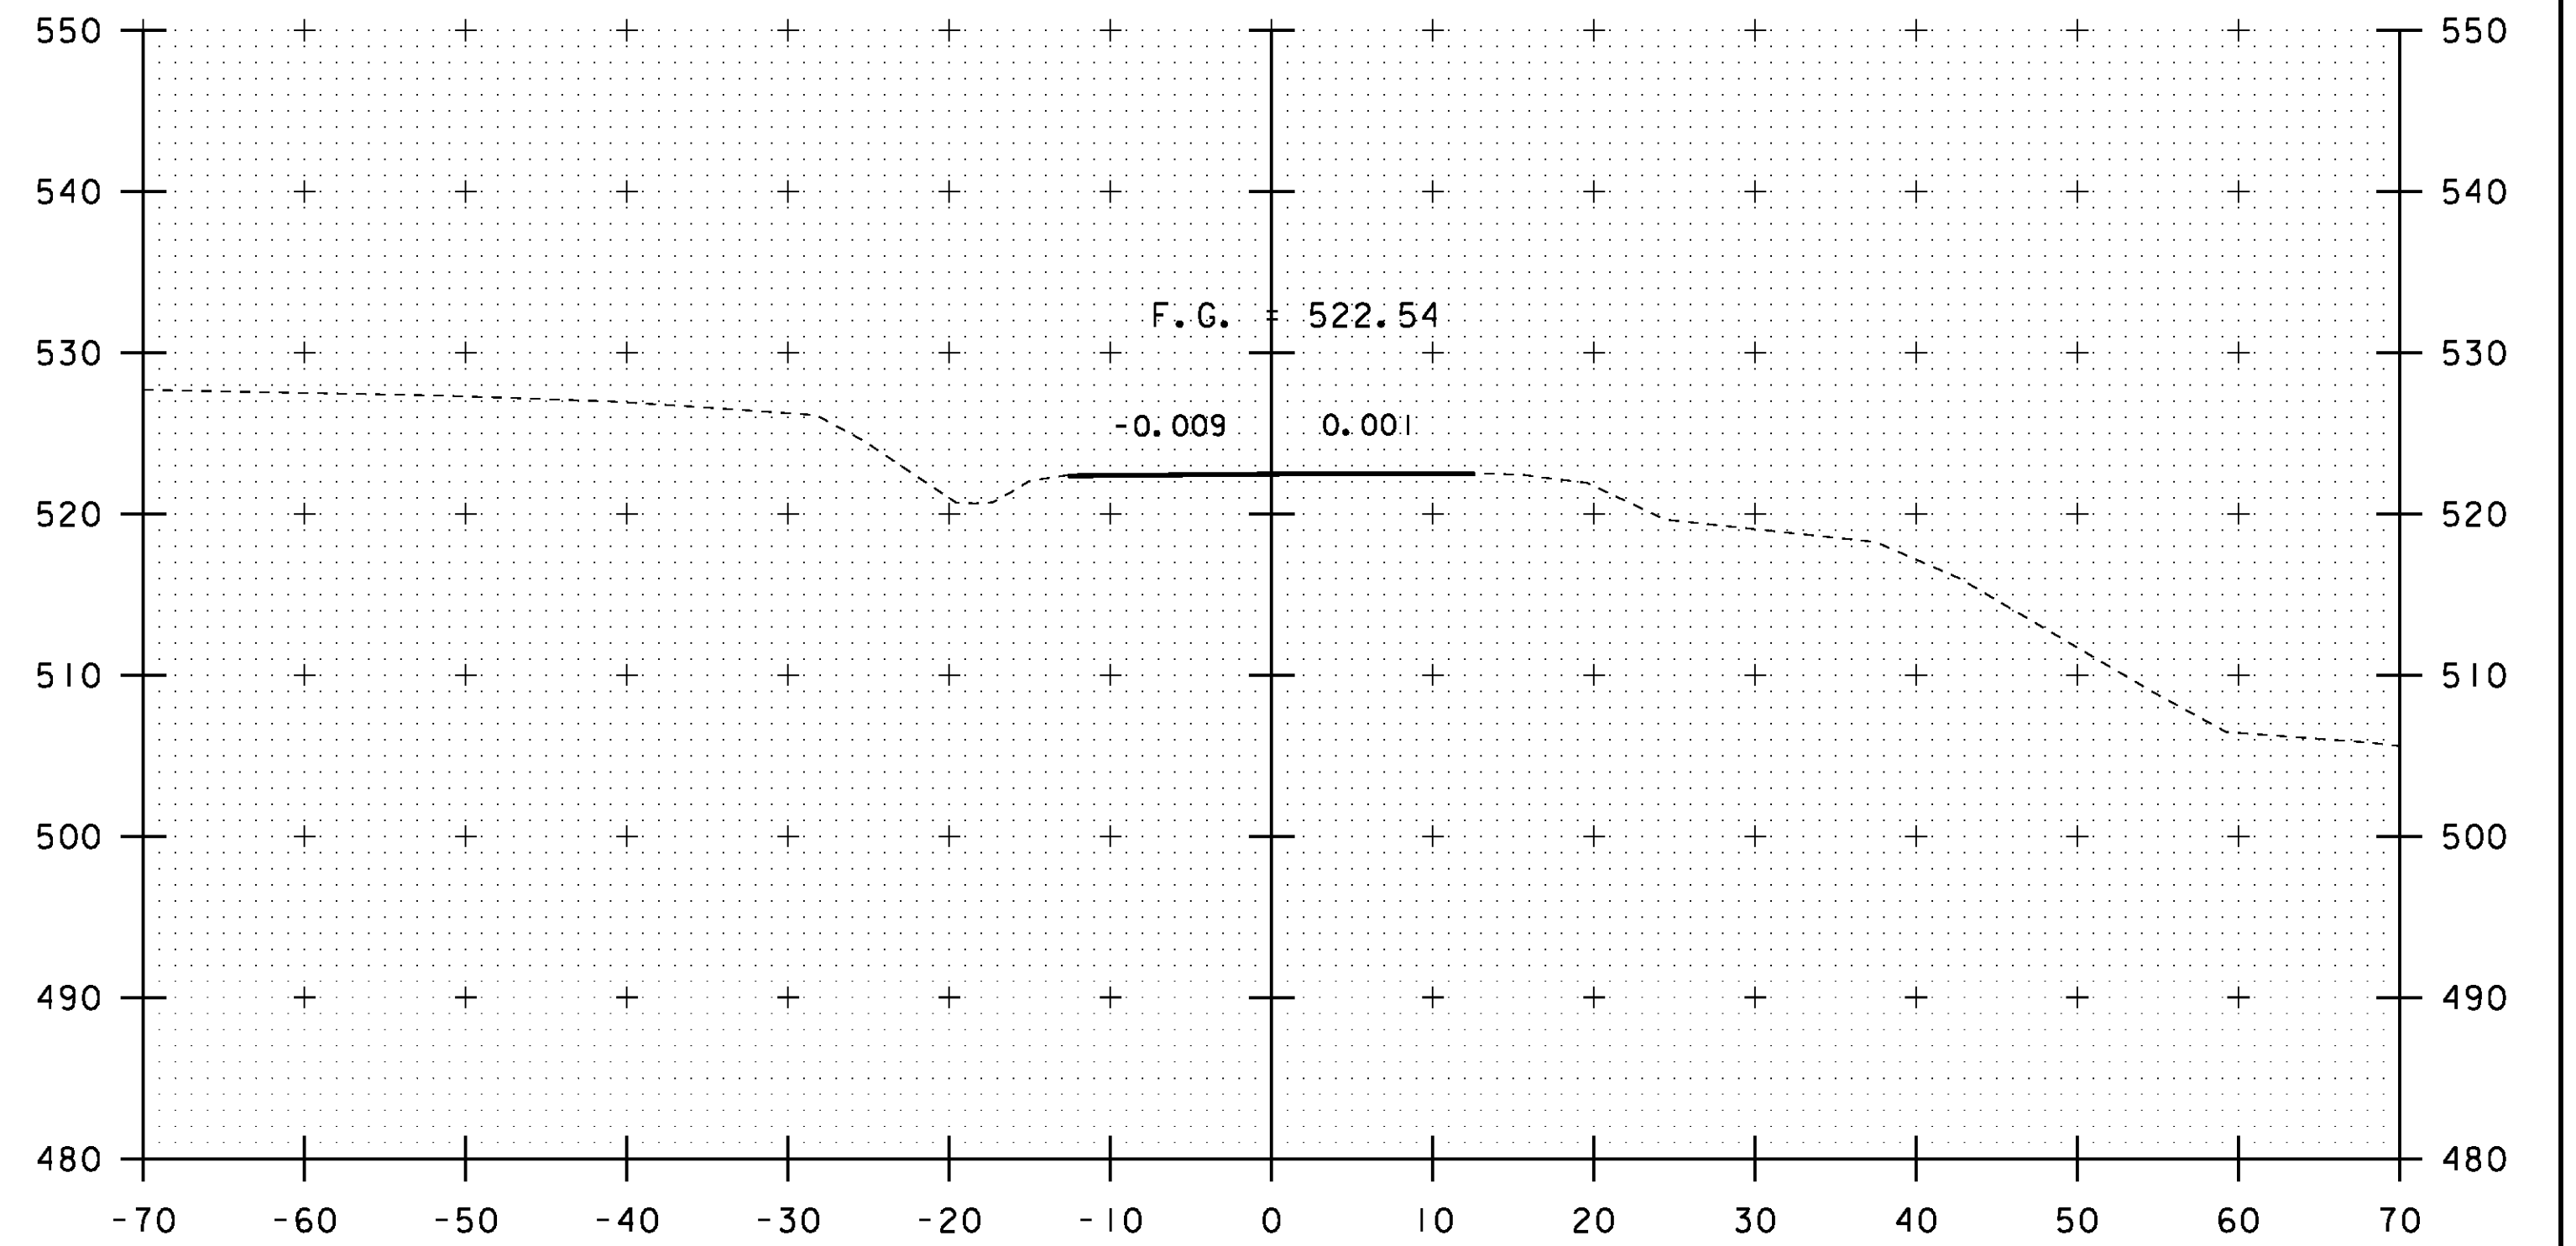


401+75

STA 401+75.00  
END APPROACH  
MATCH EXISTING

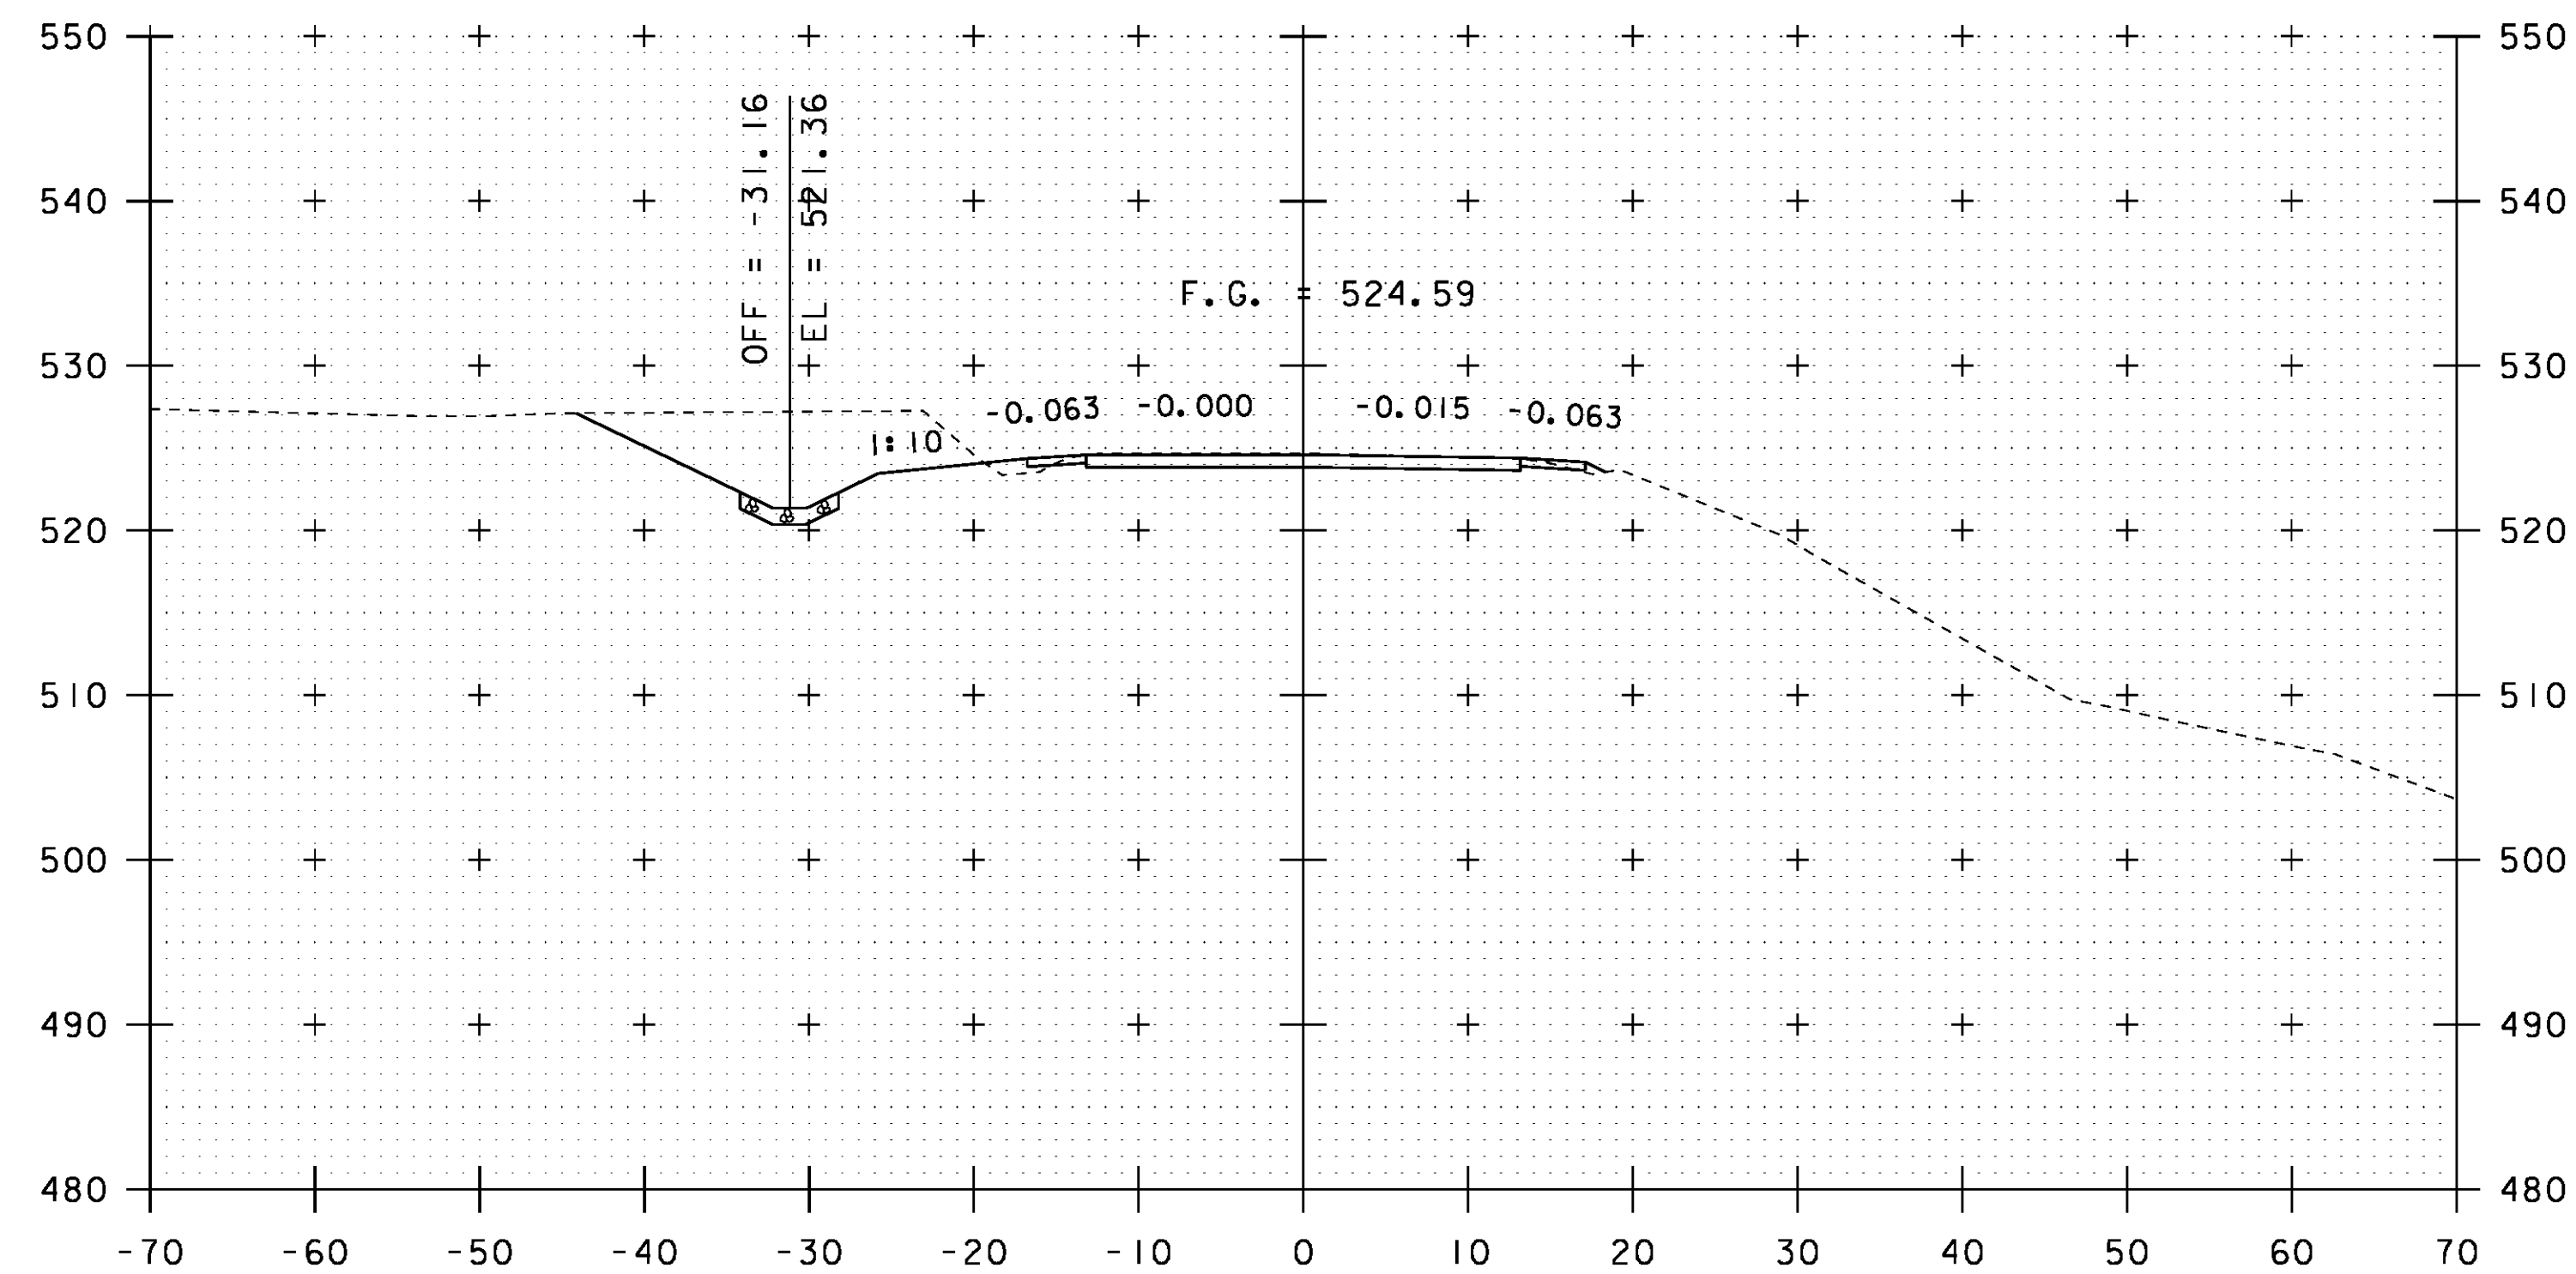


401+00

STA 401+00.00  
BEGIN APPROACH

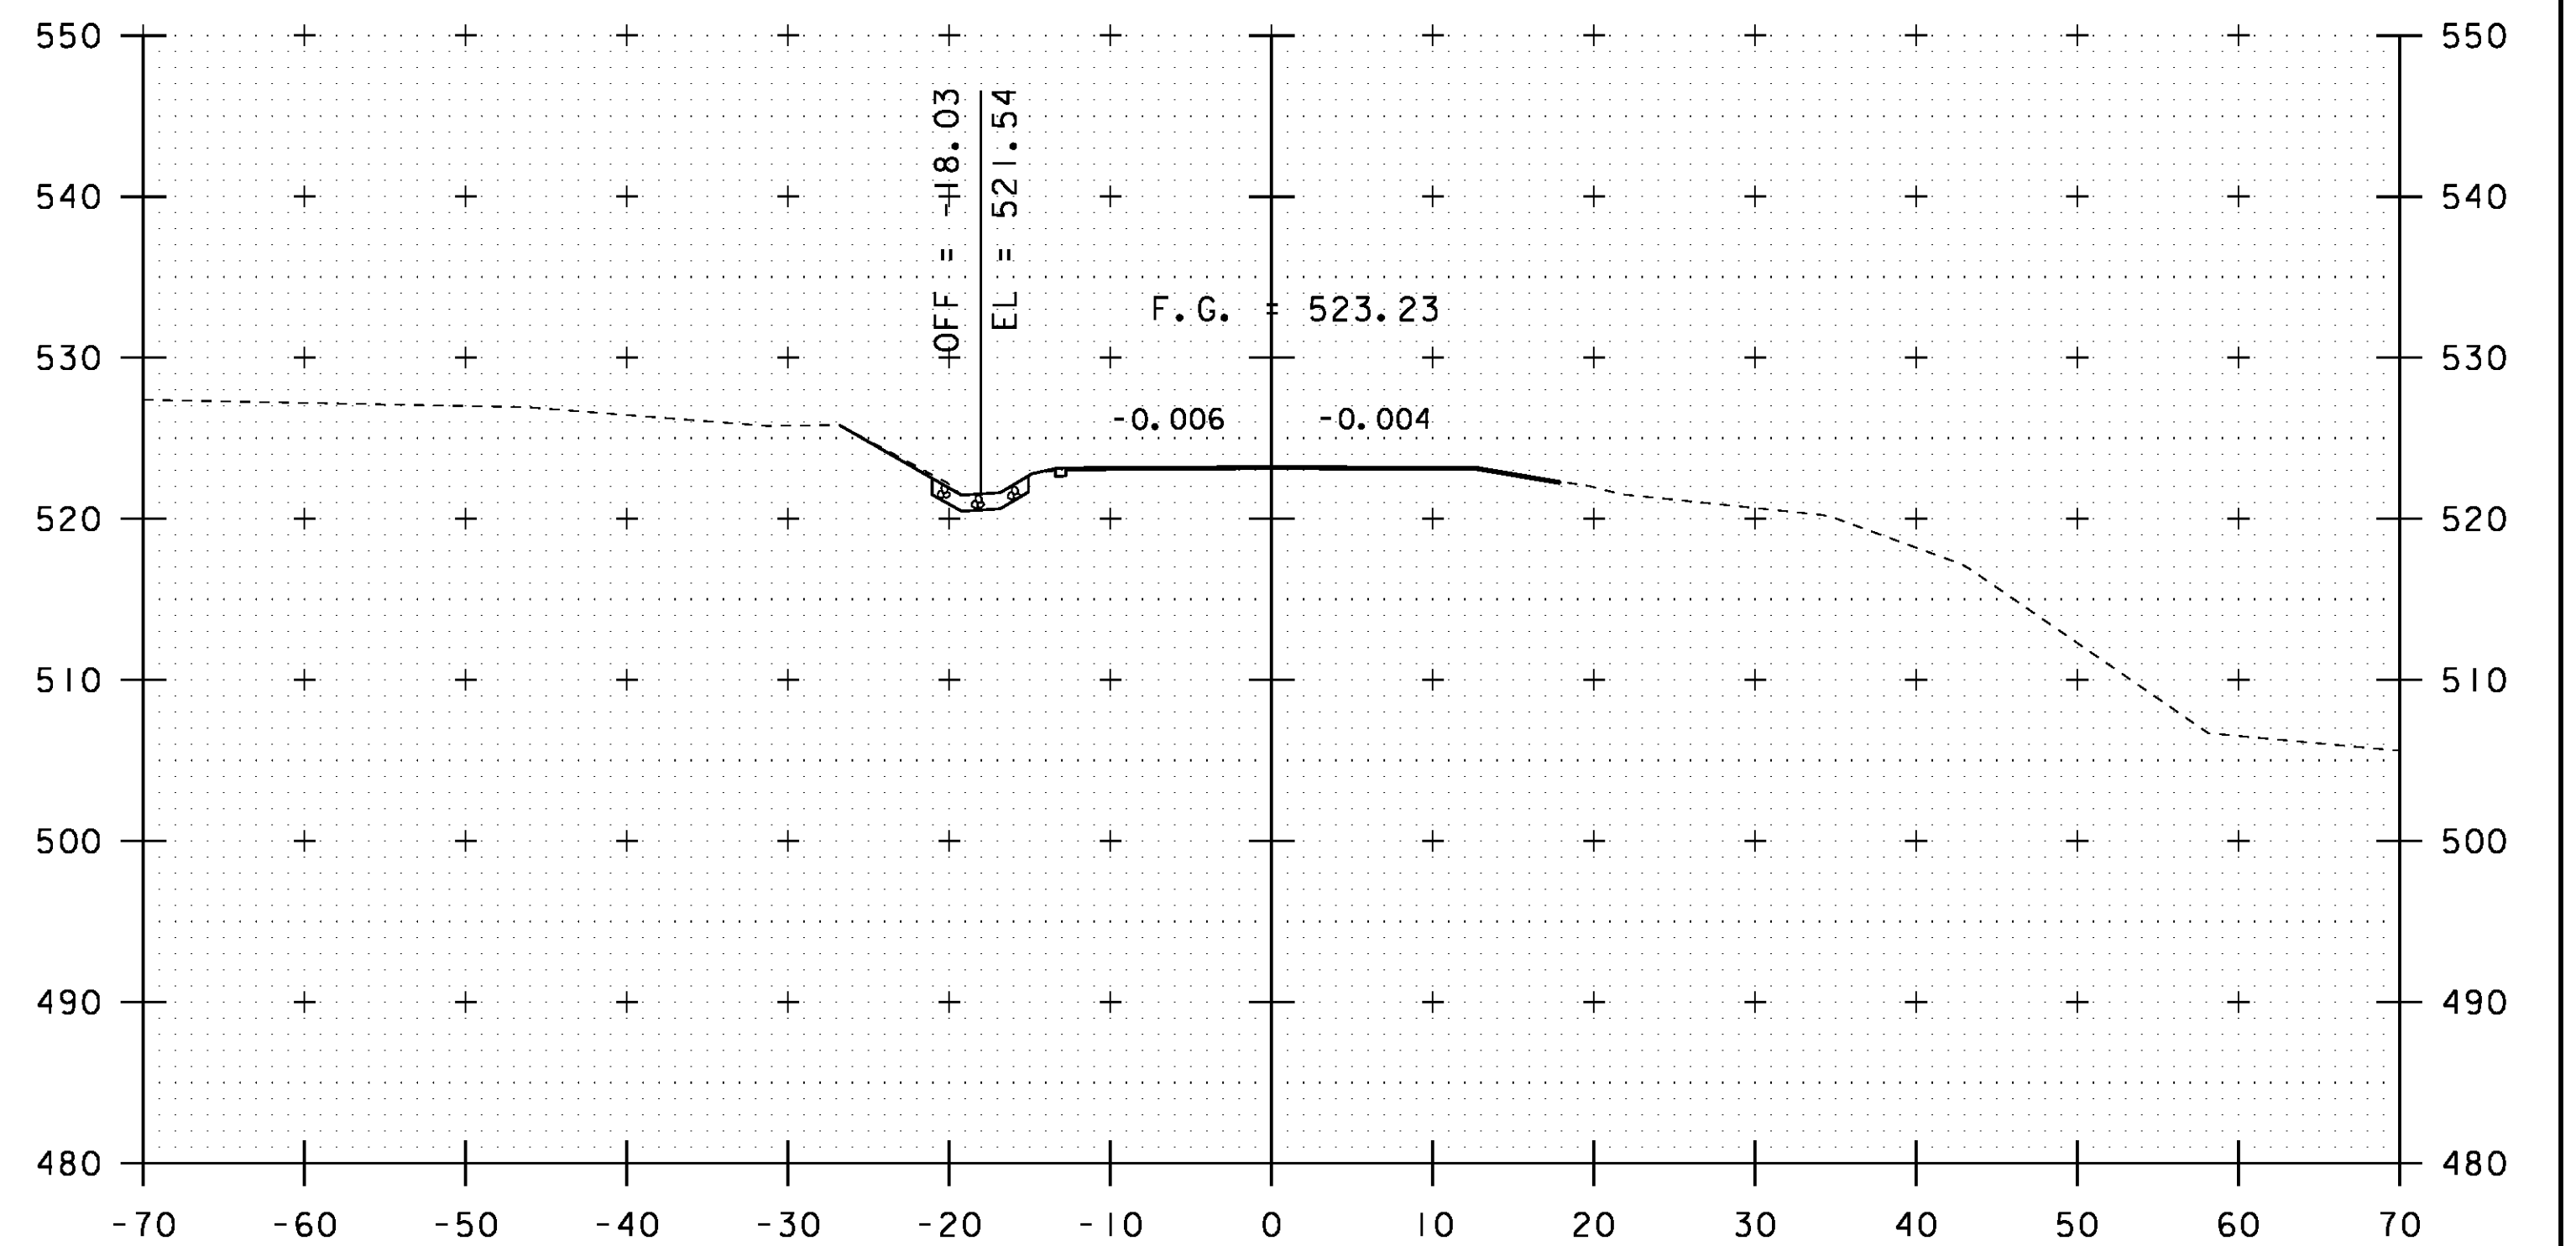


401+50

CONSTRUCT PAVED APRON  
STA 401+32.2 - 401+64.4 RT

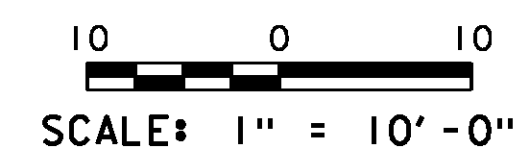


STA. 401+00 TO STA. 401+75

PROJECT NAME: ROYALTON	
PROJECT NUMBER: BRS 0147(13)	
FILE NAME: s86e055xsl_cattlepass3.dgn	PLOT DATE: 08-OCT-2013
PROJECT LEADER: C. CARLSON	DRAWN BY: G. ROY
DESIGNED BY: G. ROY	CHECKED BY: D. PETERSON
VT 14 CROSS SECTIONS AT CATTLE PASS (3) SHEET 81 OF 186	

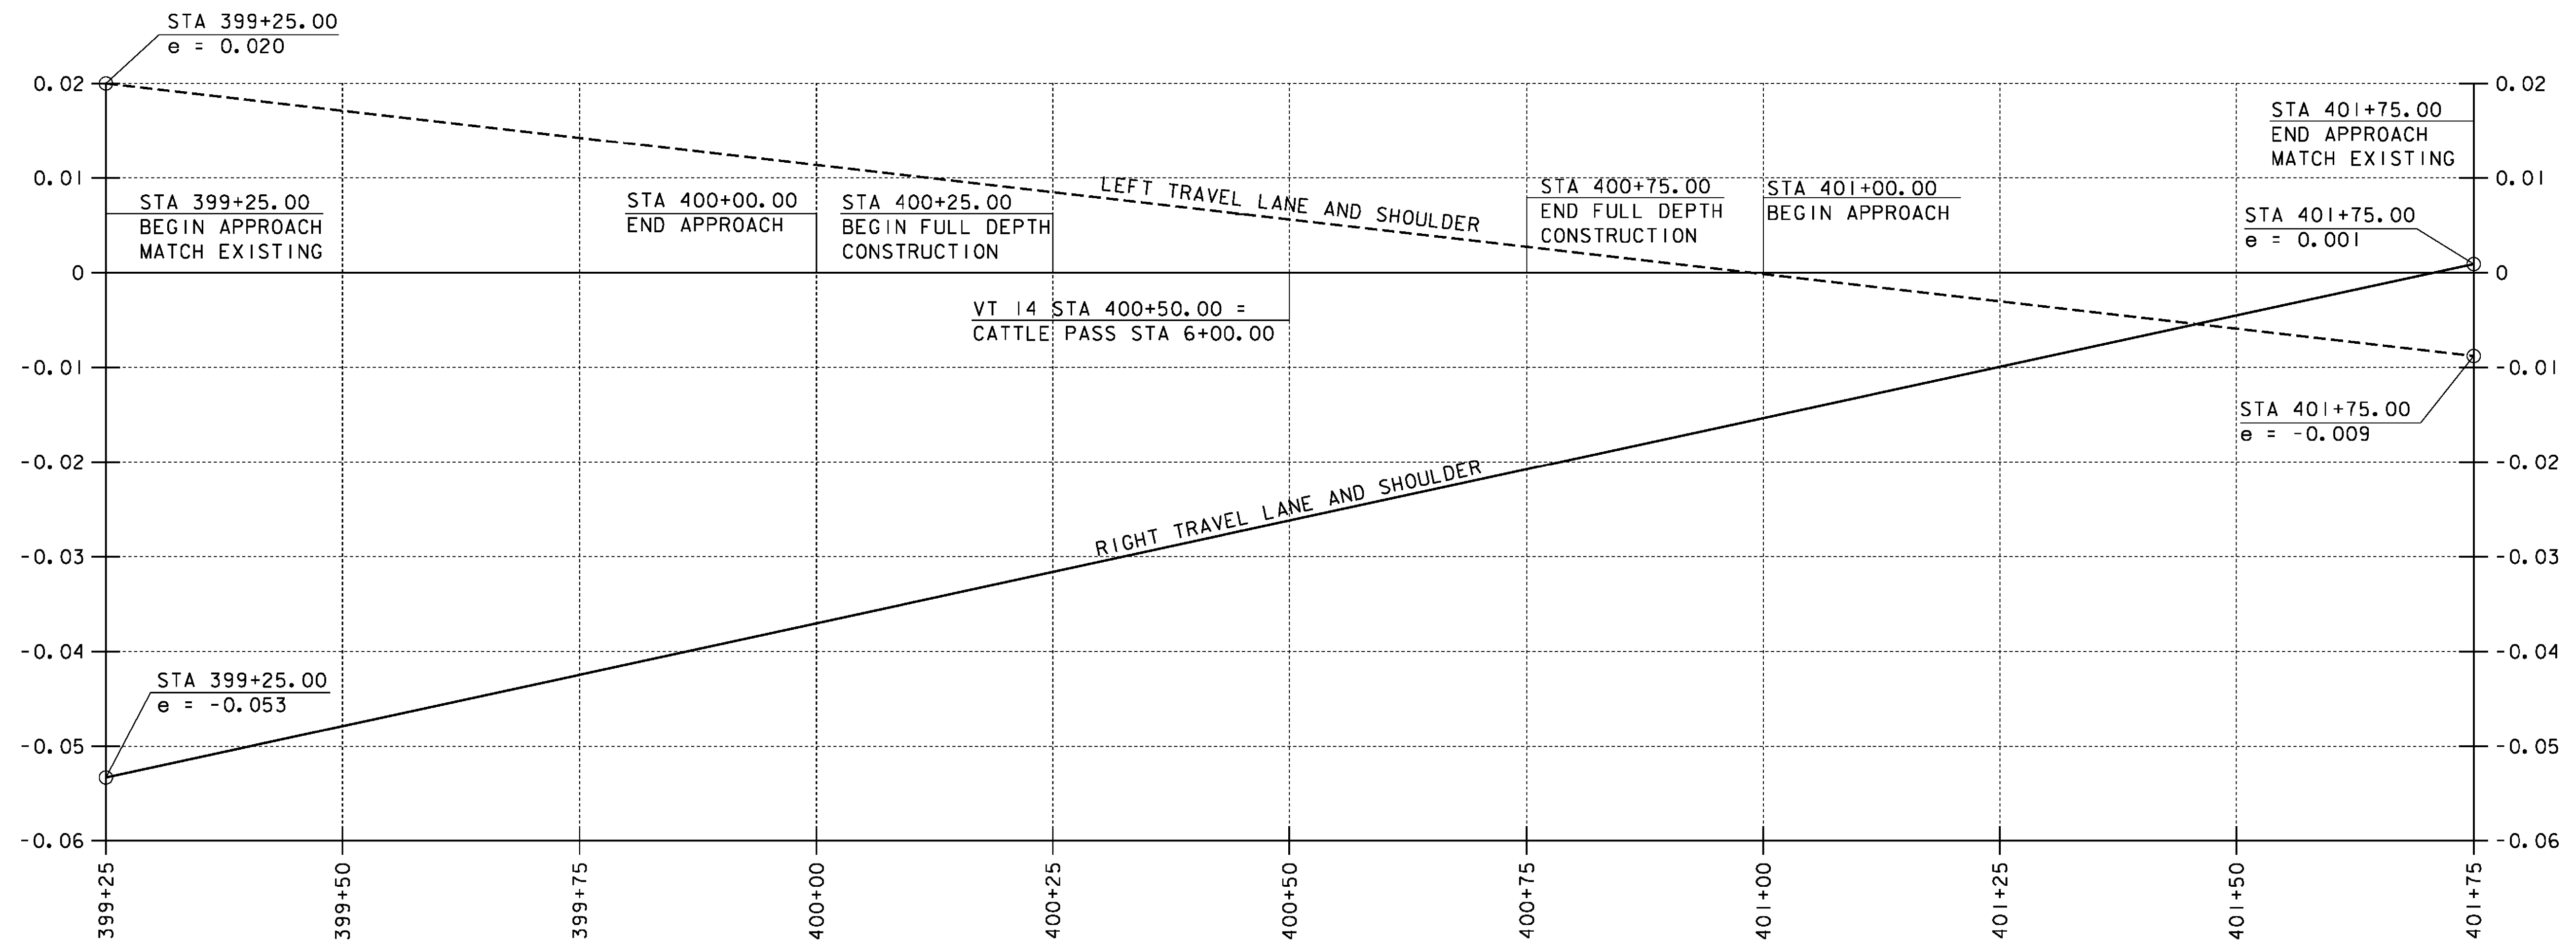

### VT 14 BANKING DIAGRAM


HORIZONTAL SCALE: 1" = 10'-0"  
 VERTICAL SCALE: 1" = 0.01'/'

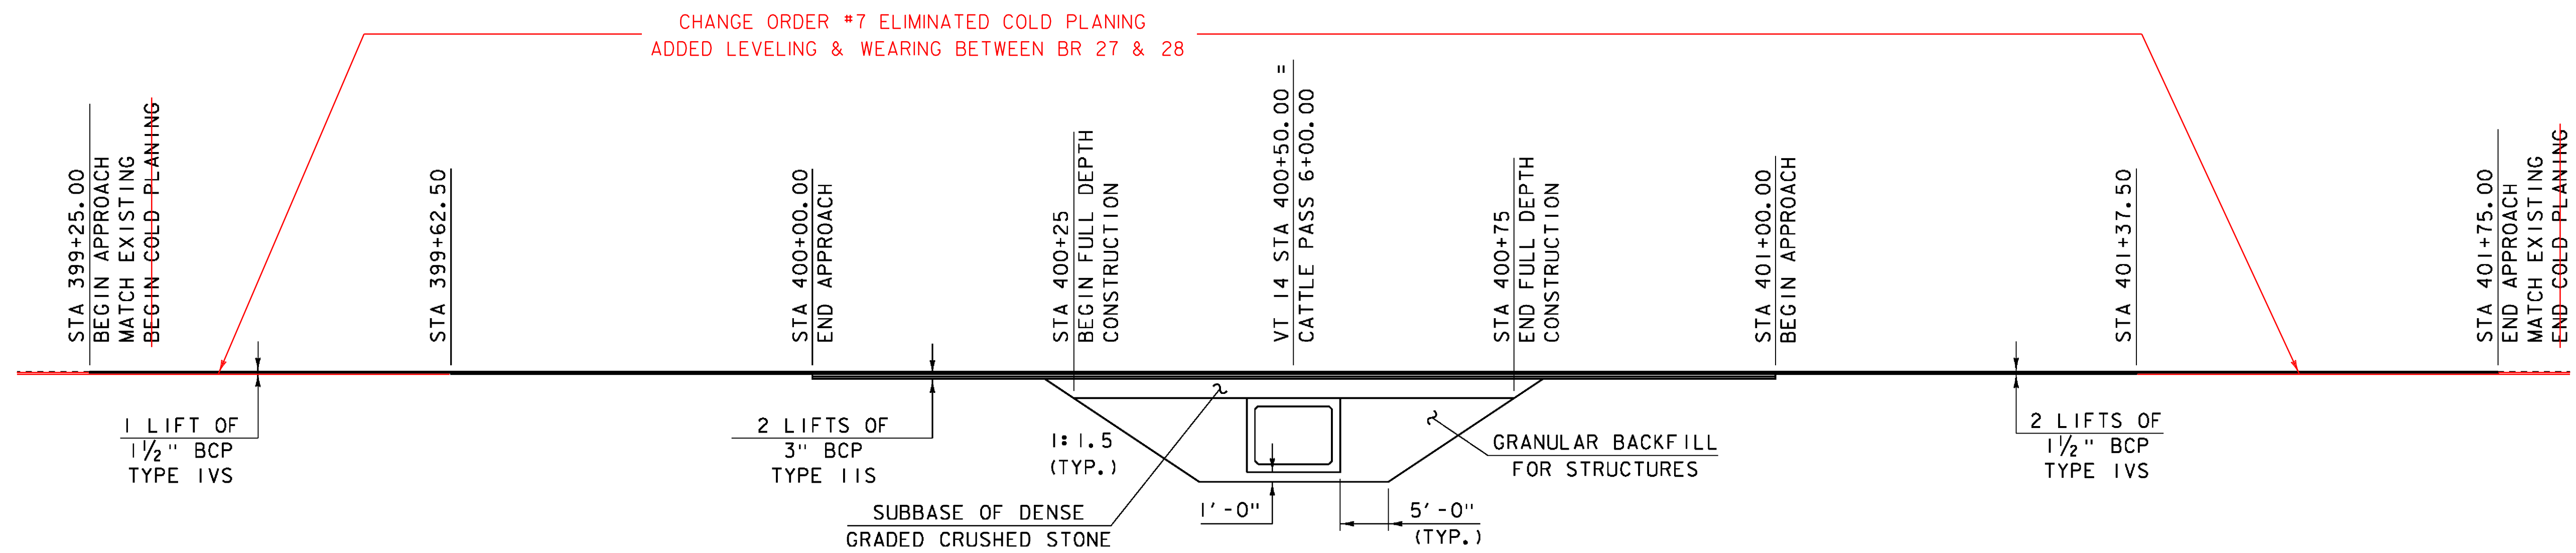


### VT 14 MATERIAL TRANSITION DETAIL

HORIZONTAL SCALE: 1" = 10'-0"  
 VERTICAL SCALE: 1" = 10'-0"


PROJECT NAME:	ROYALTON
PROJECT NUMBER:	BRS 0147(13)
FILE NAME: s86e055pro_cattlepass3.dgn	PLOT DATE: 08-OCT-2013
PROJECT LEADER: C. CARLSON	DRAWN BY: G. ROY
DESIGNED BY: G. ROY	CHECKED BY: D. PETERSON
BANKING DIAGRAM AND MATERIAL TRANSITION SHEET 82 OF 186	

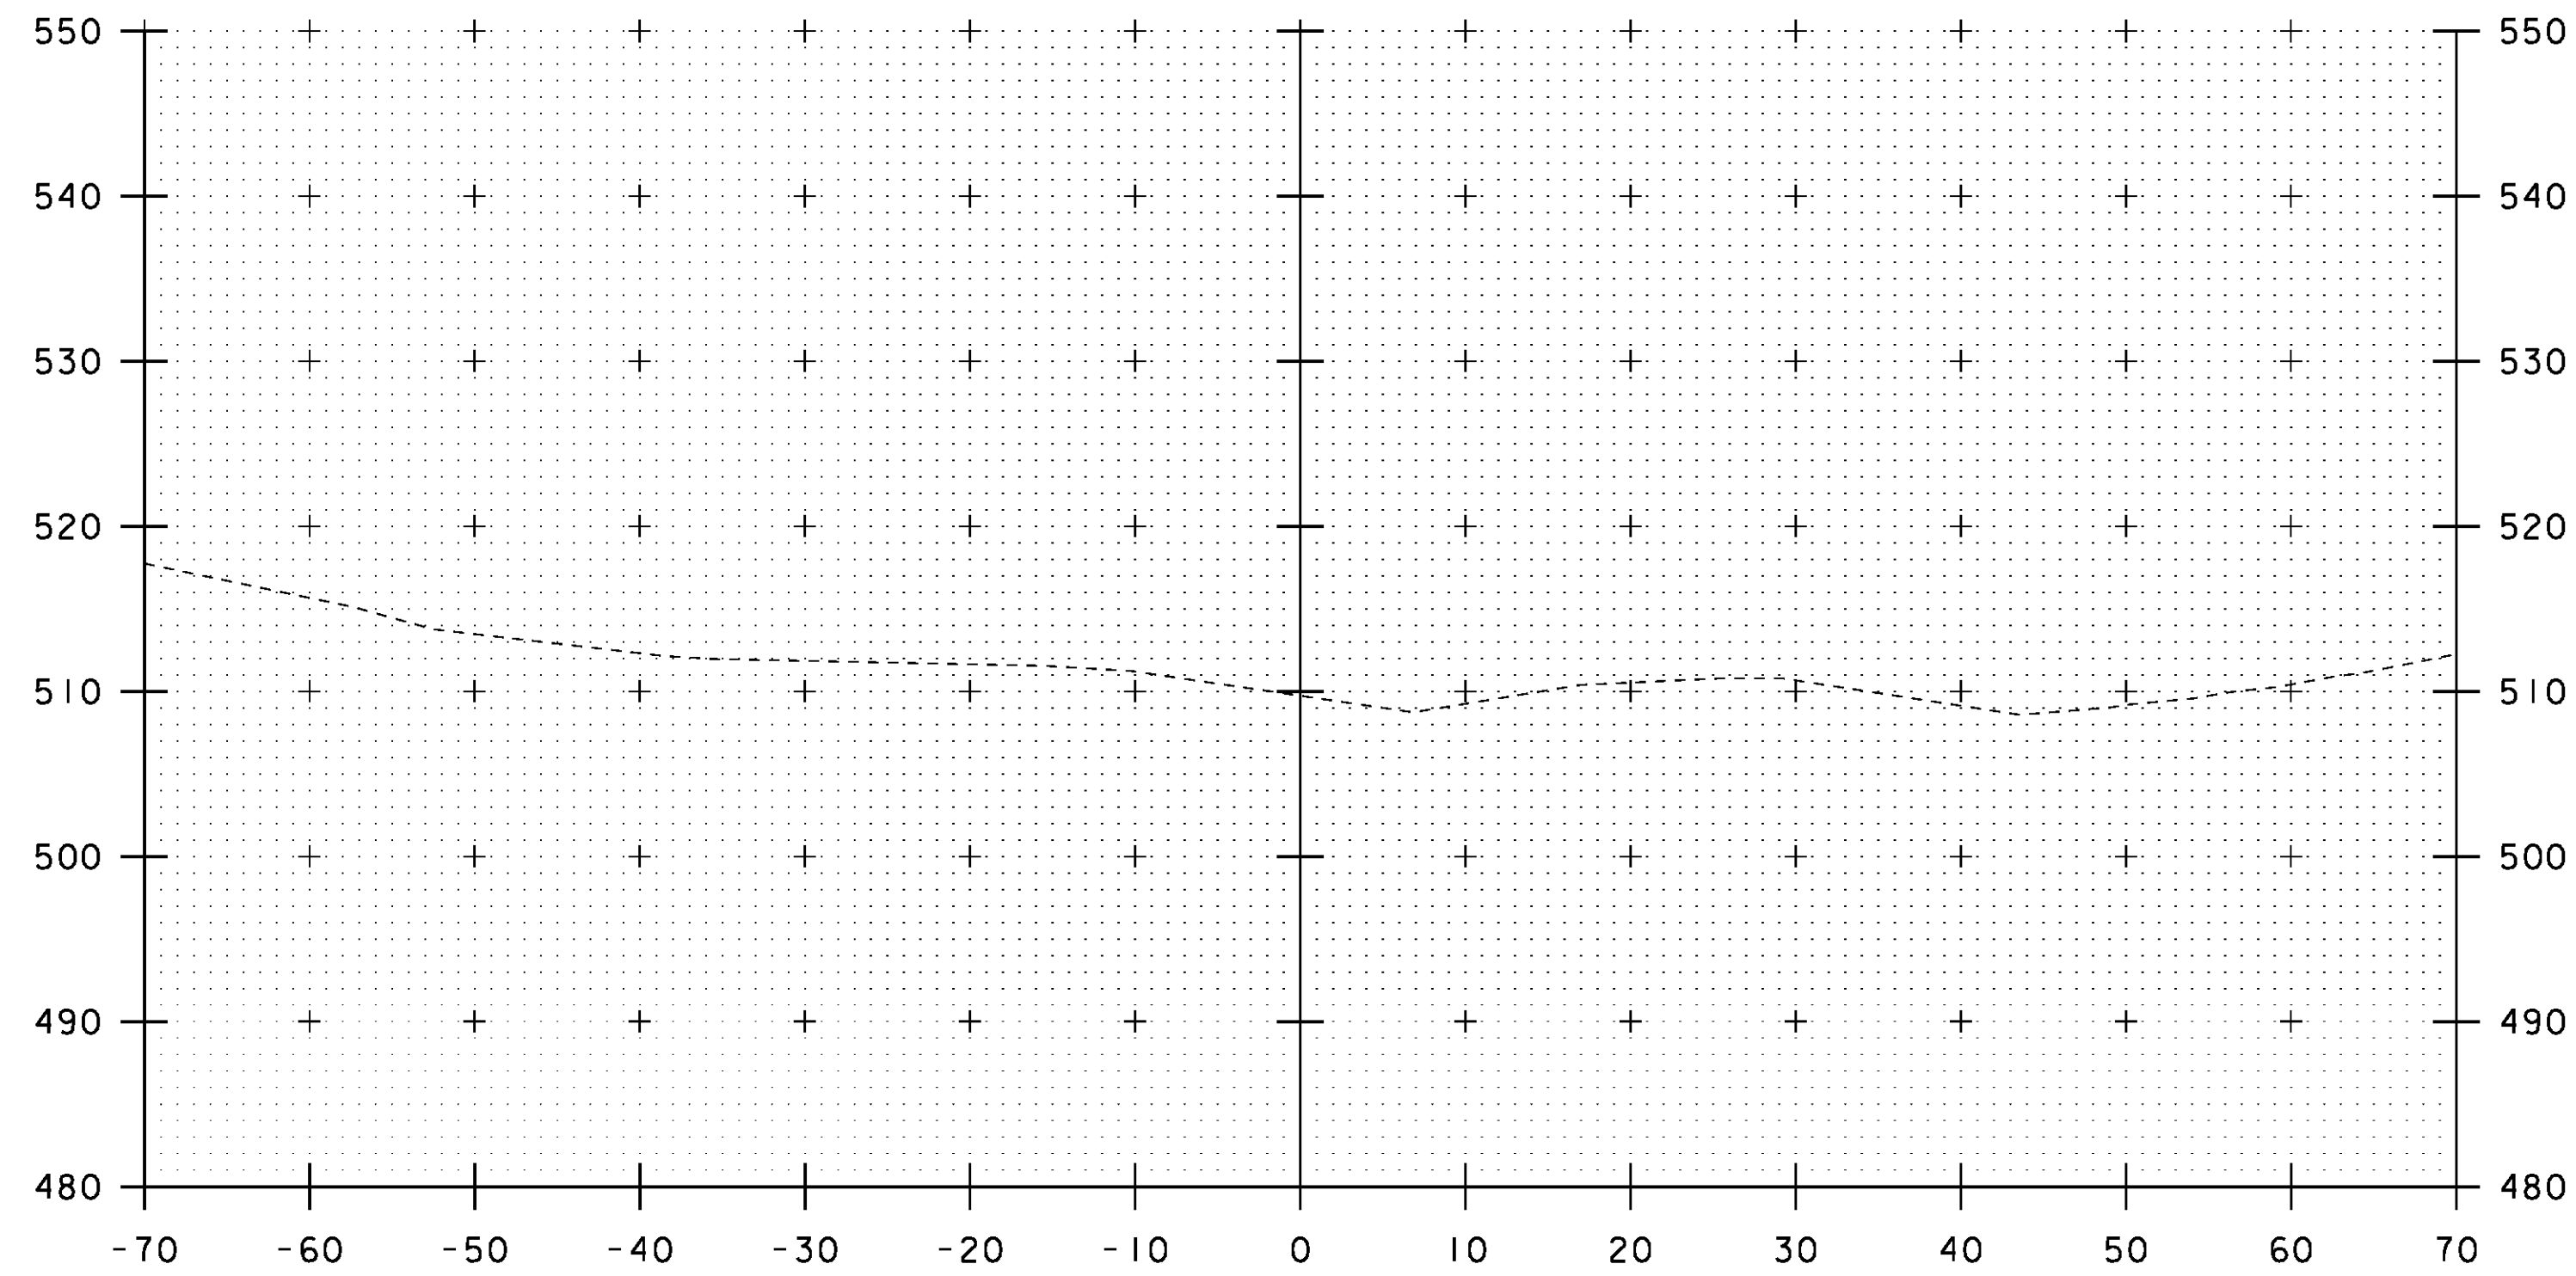


5+50

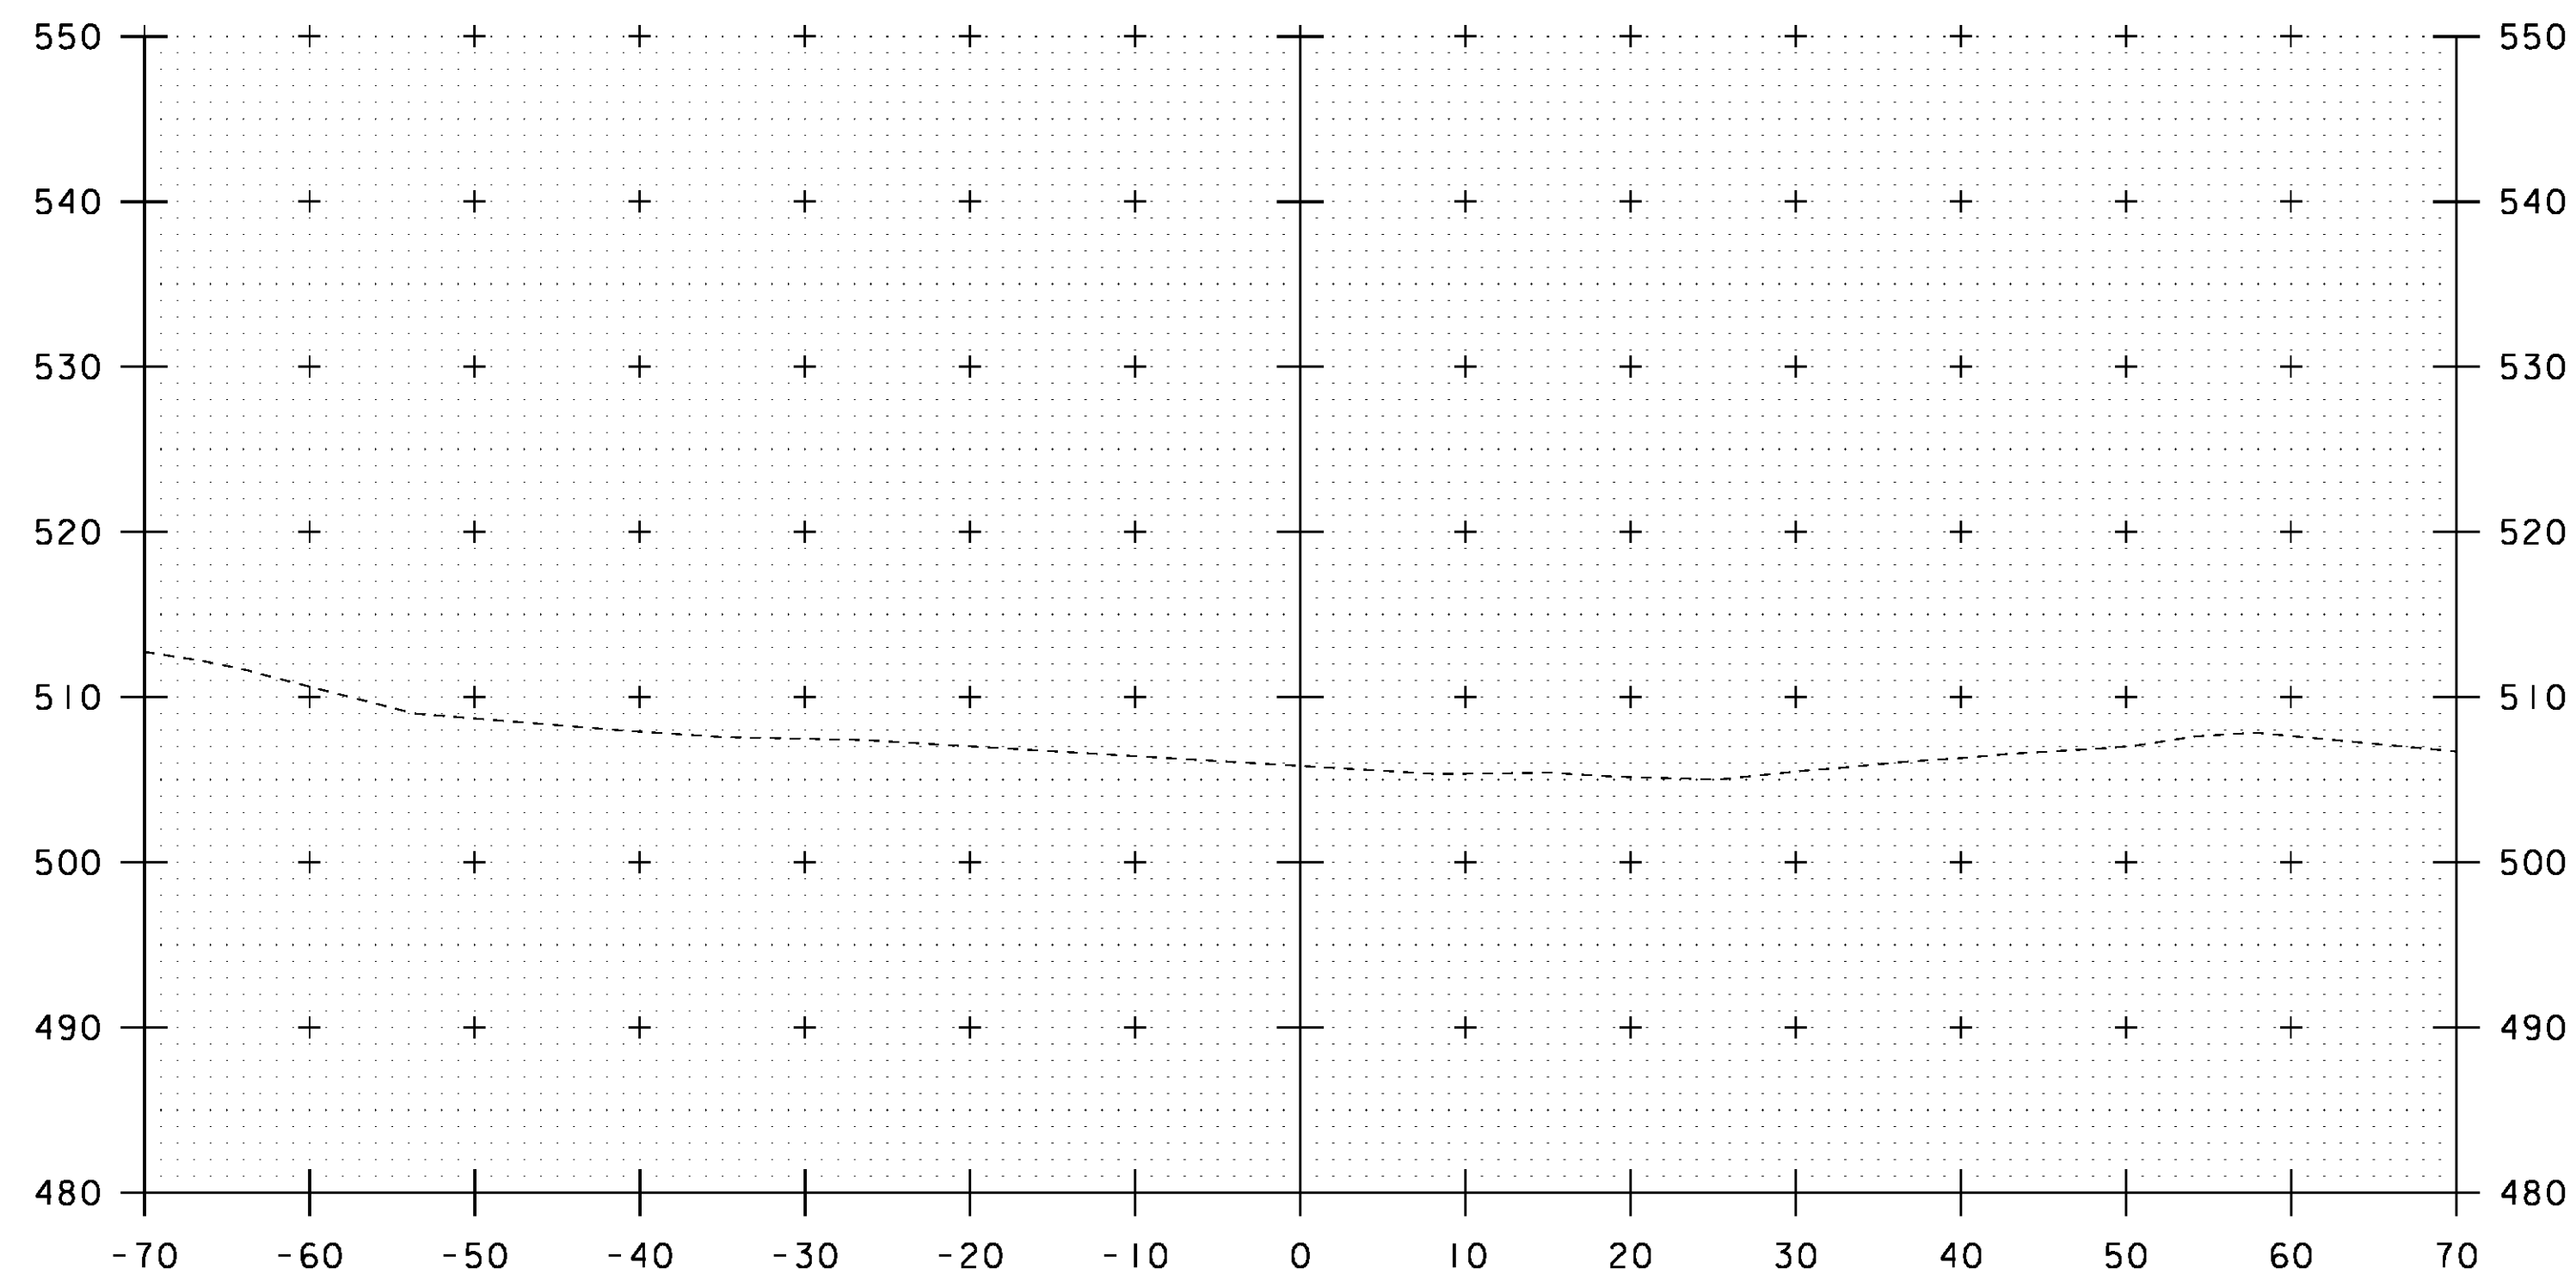

5+40

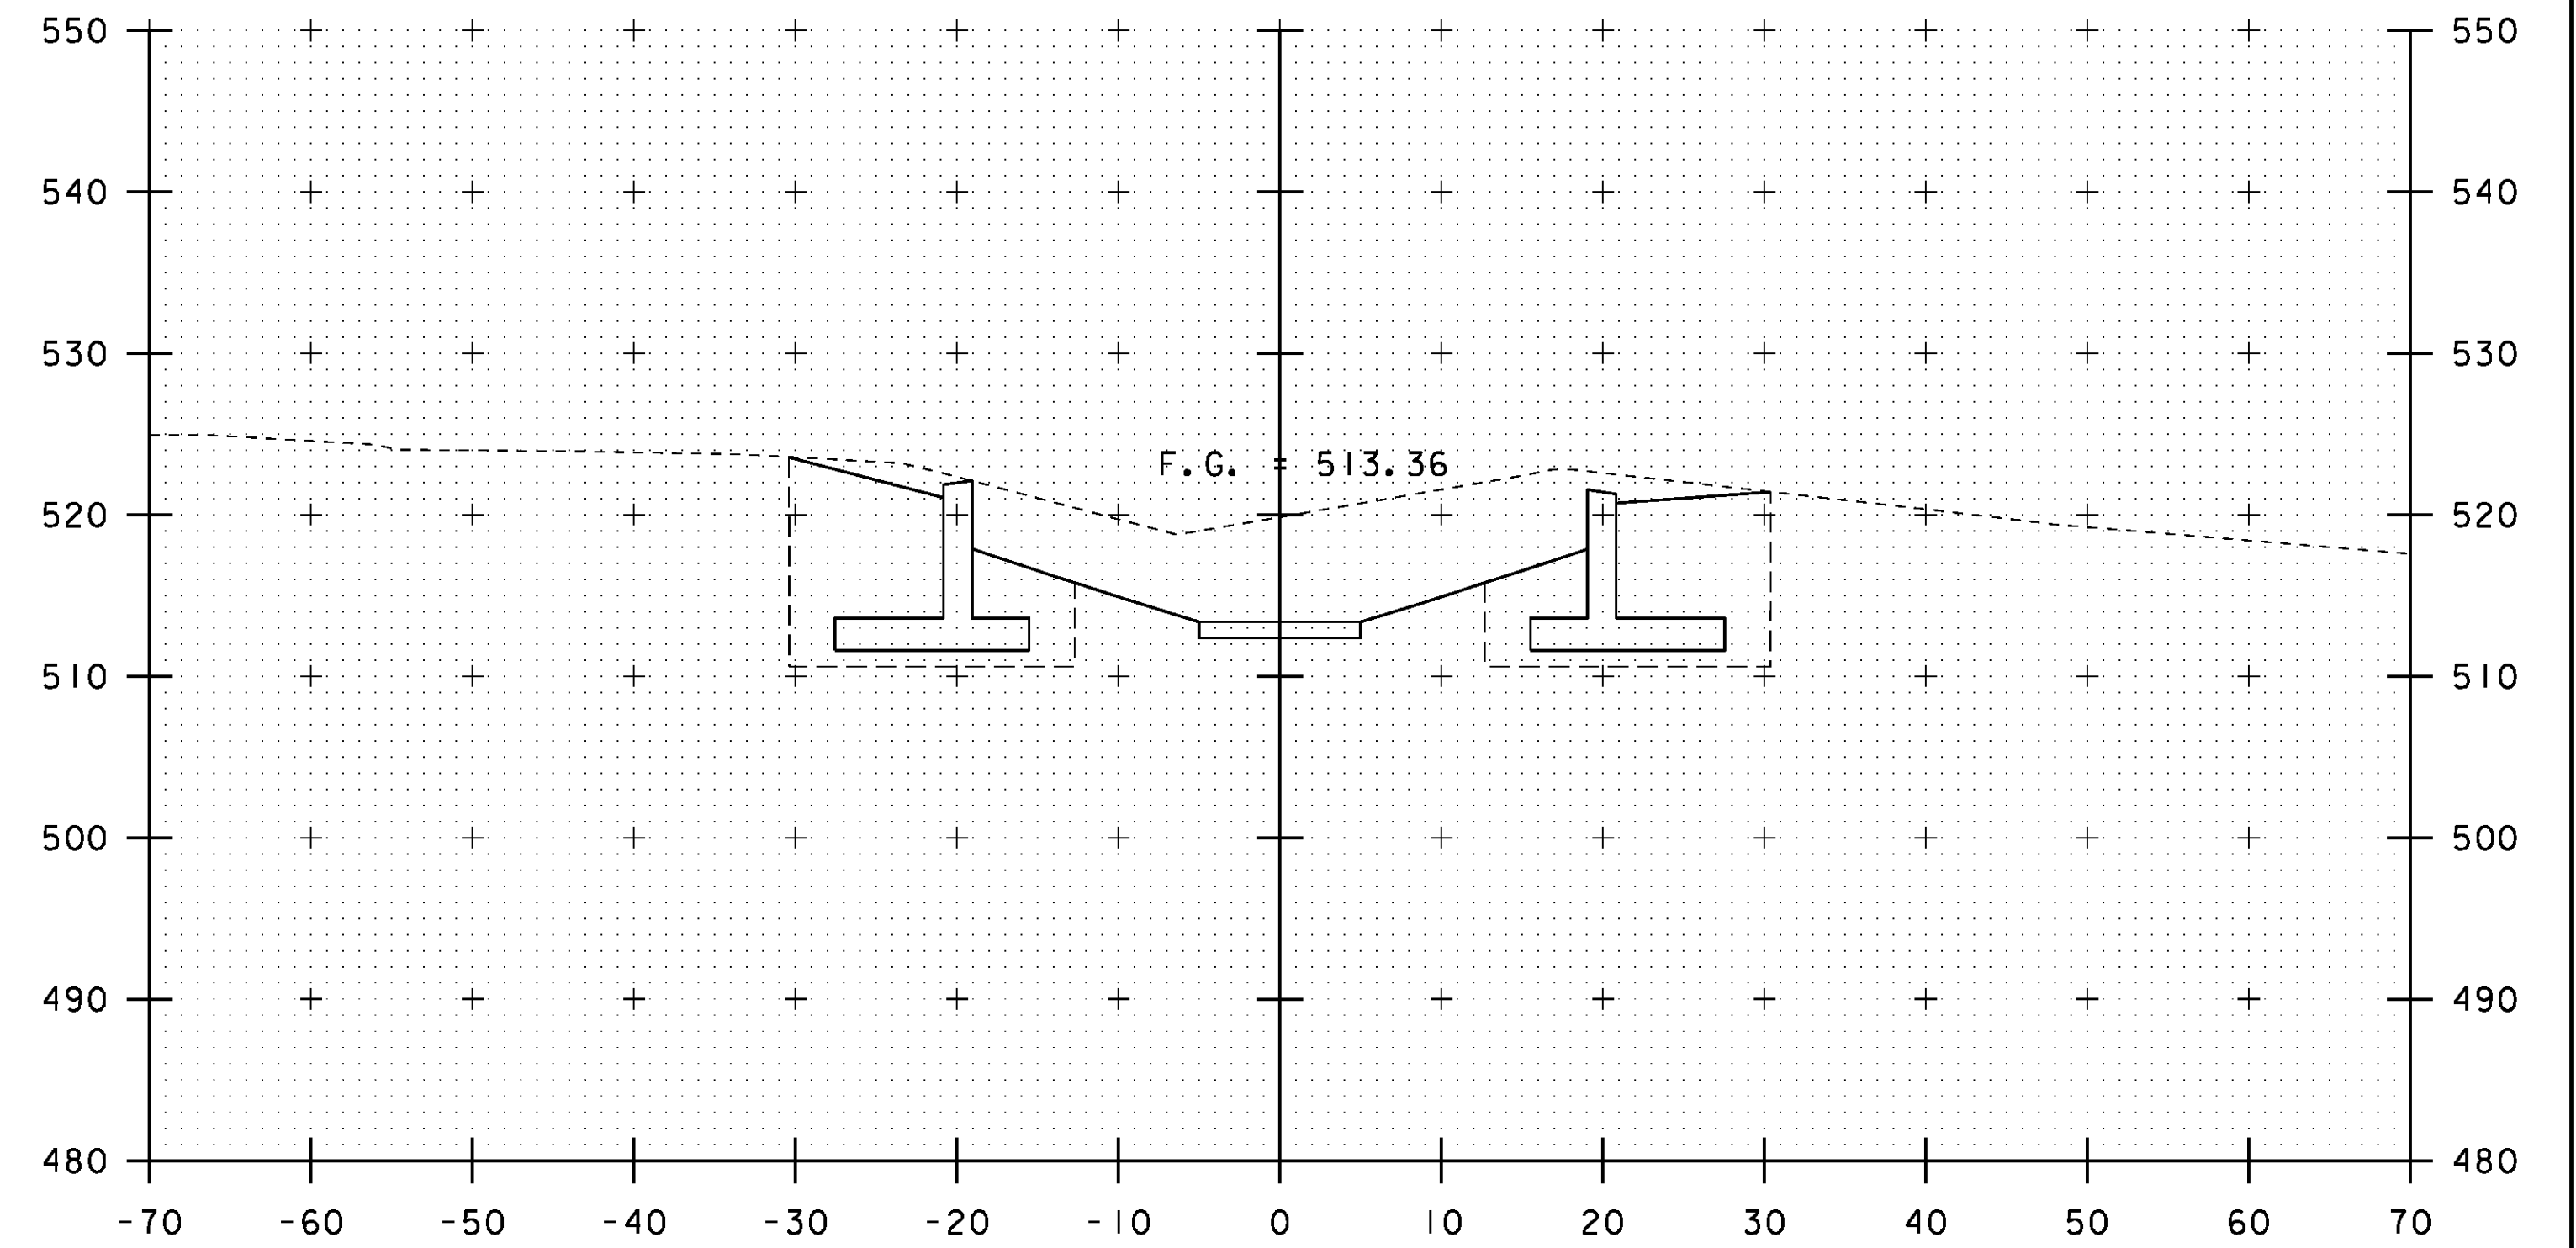


5+70

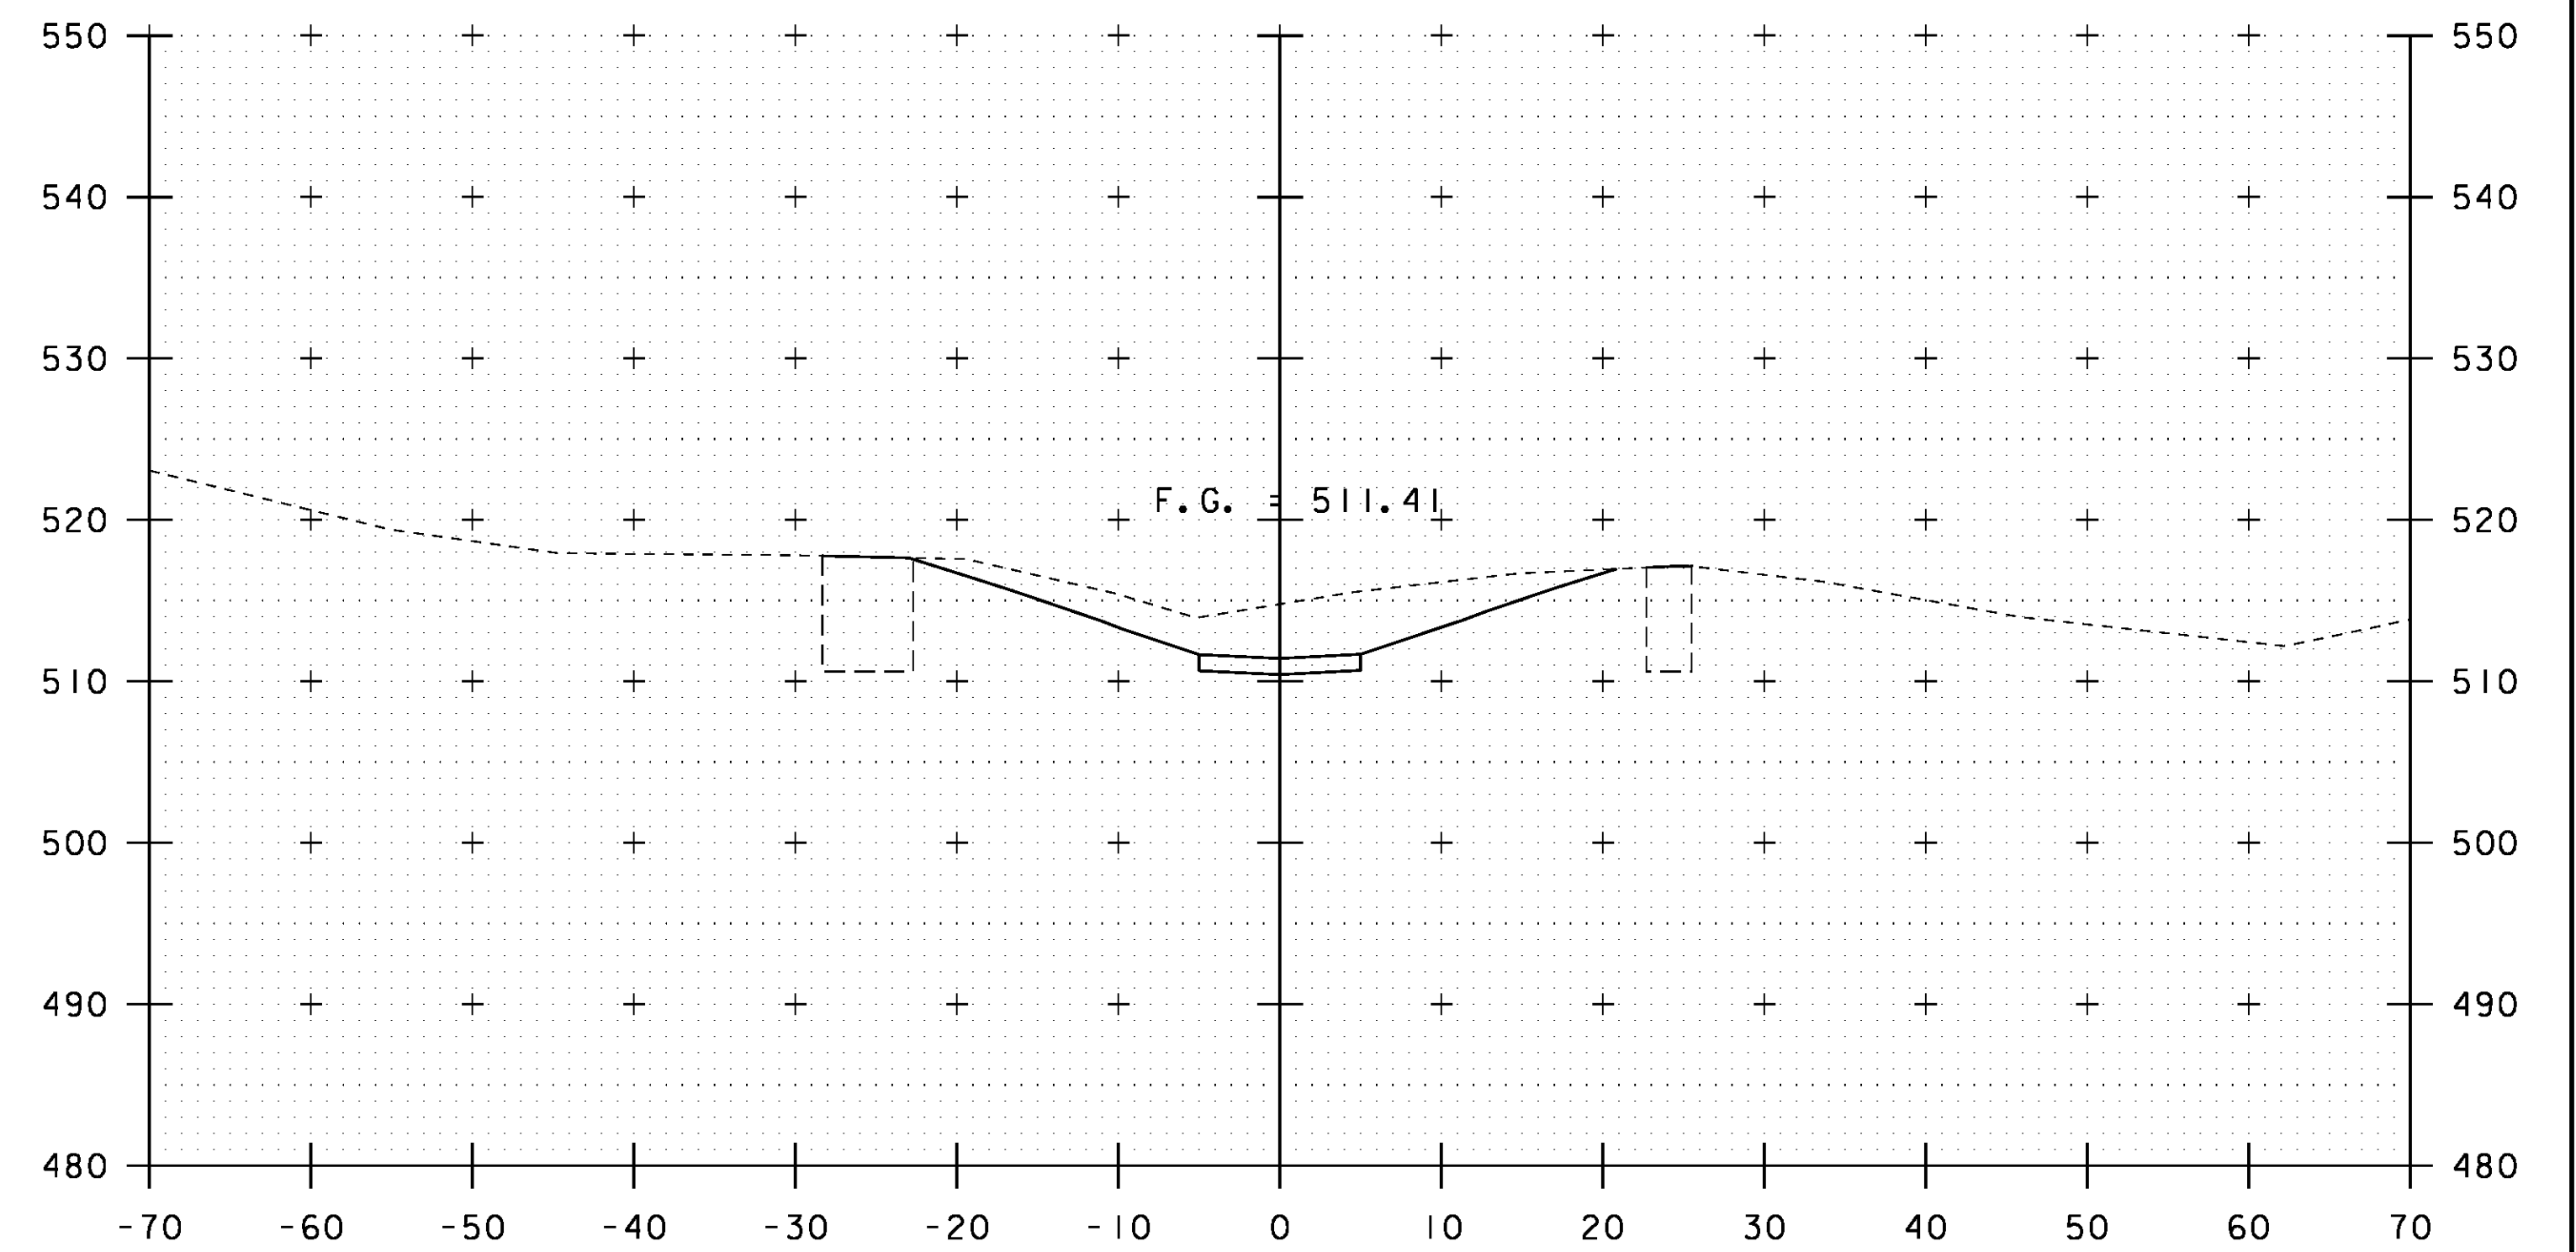


5+60

STA 5+53.59  
BEGIN CATTLE PASS  
MATCH EXISTING

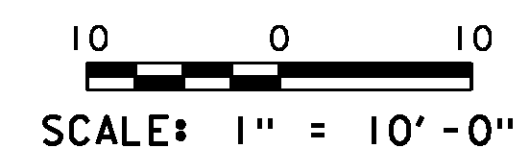


STA. 5+40 TO STA. 5+70


PROJECT NAME: ROYALTON	PLOT DATE: 08-OCT-2013
PROJECT NUMBER: BRS 0147(13)	DRAWN BY: G. ROY
FILE NAME: s86e05xsl_cattlepass3.dgn	CHECKED BY: D. PETERSON
PROJECT LEADER: C. CARLSON	SHEET 83 OF 186
DESIGNED BY: G. ROY	
CATTLE PASS CROSS SECTIONS (1)	

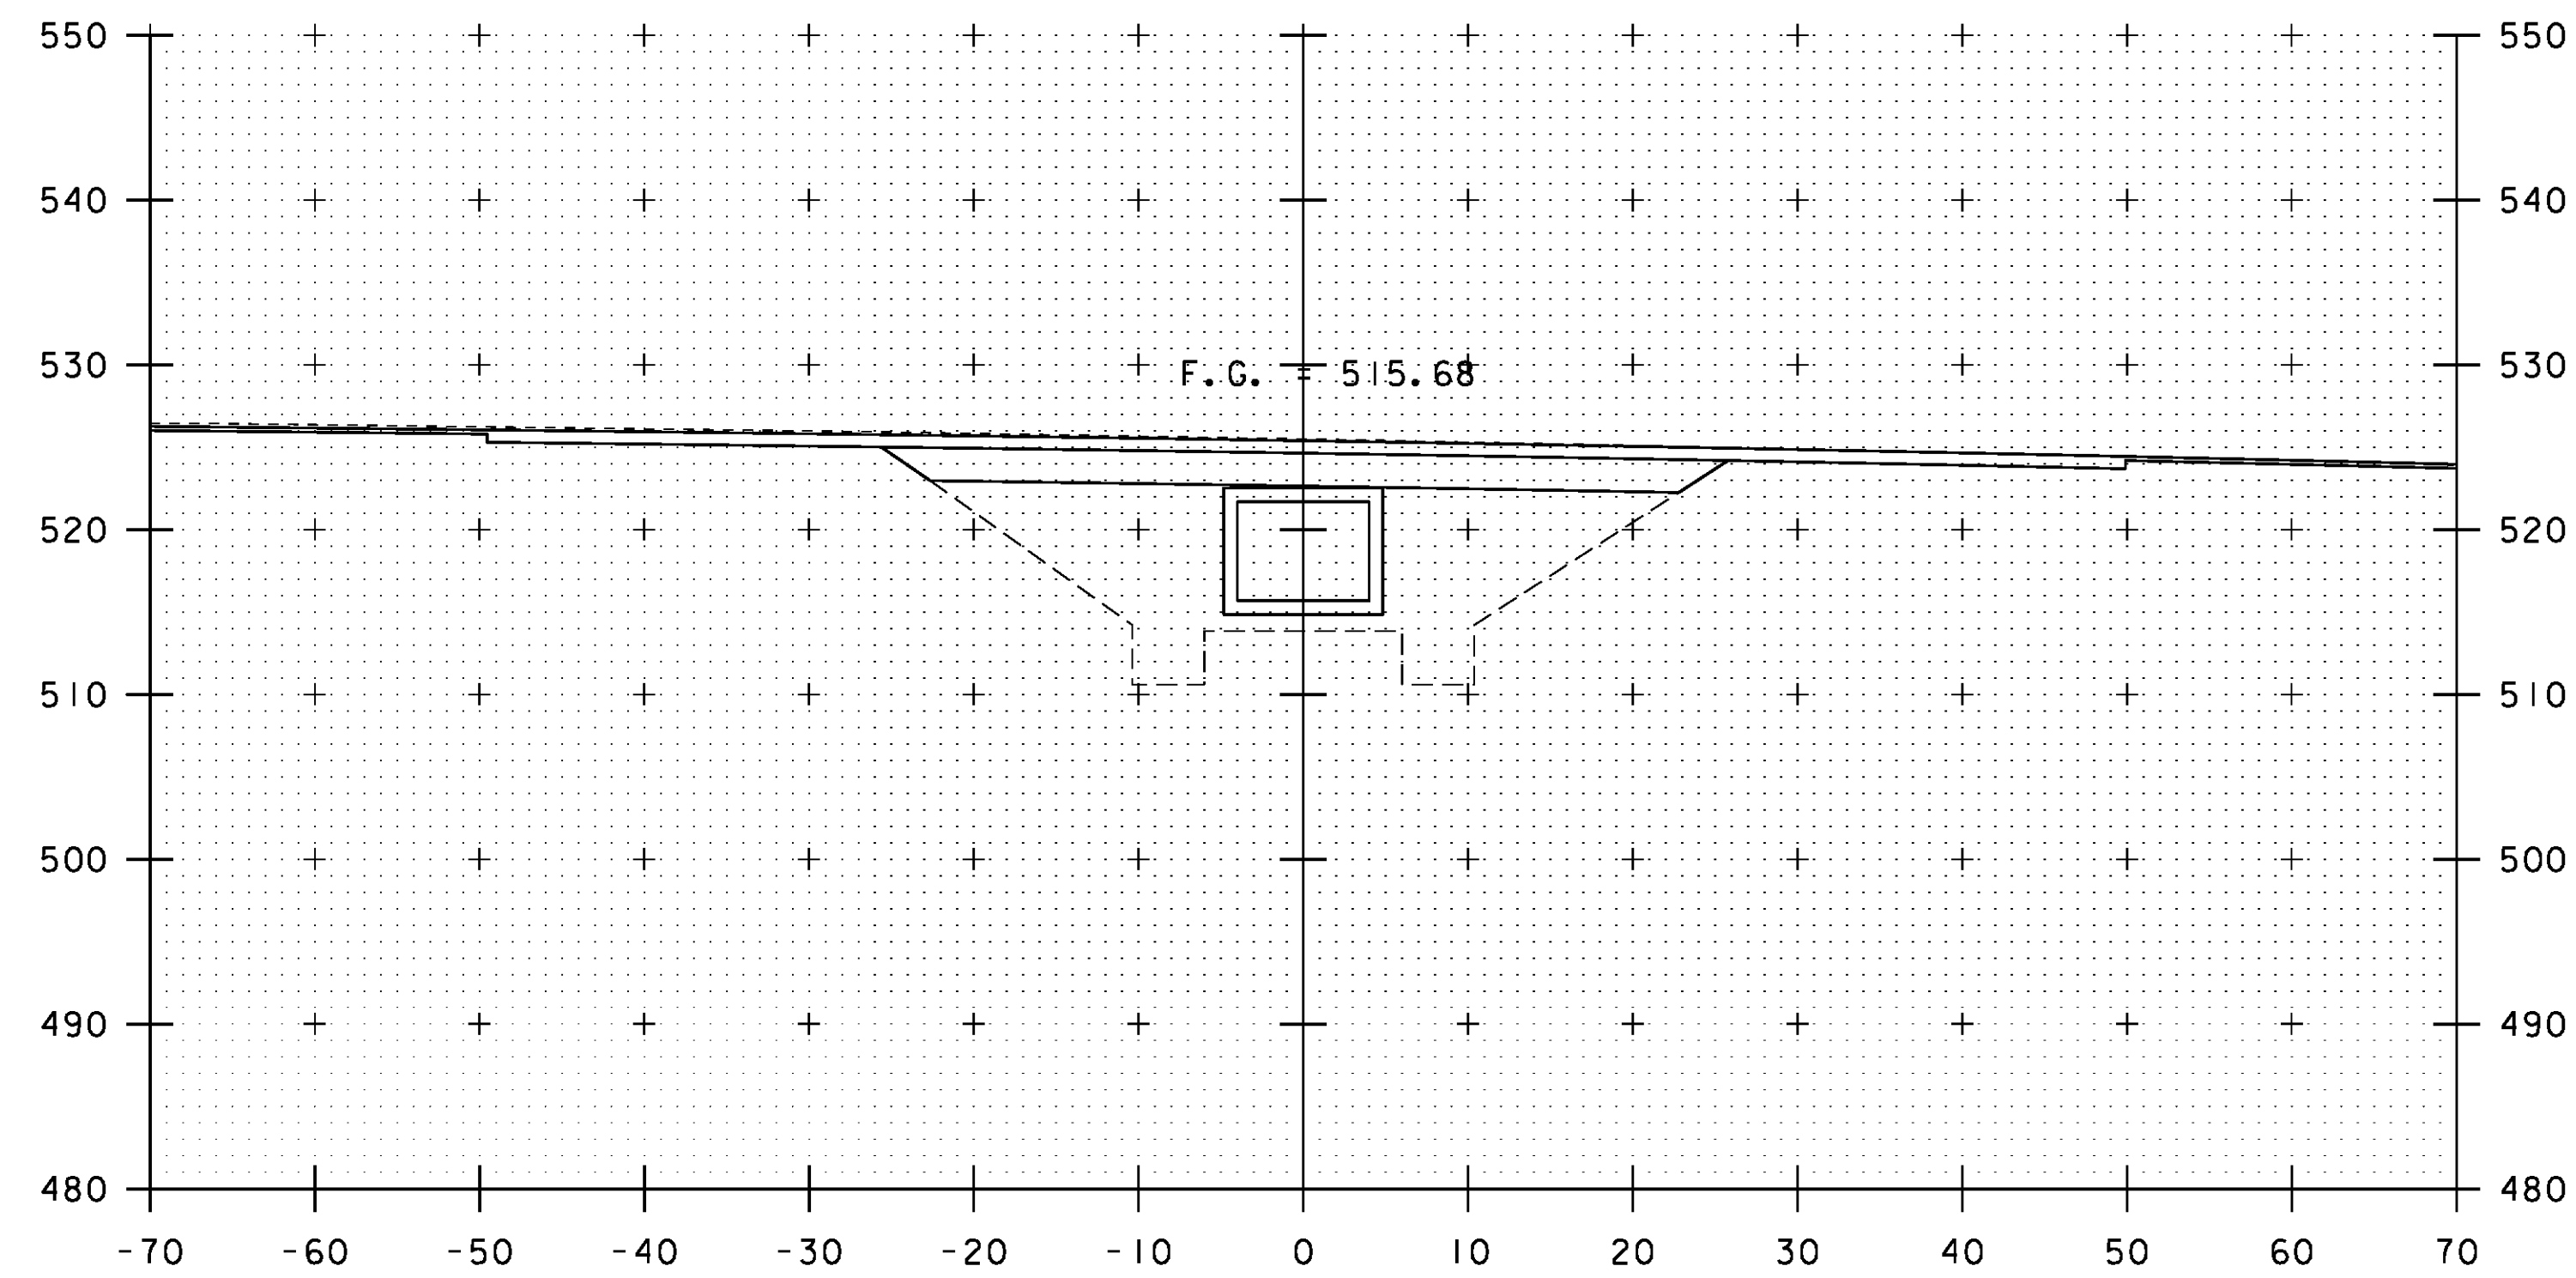


5+90

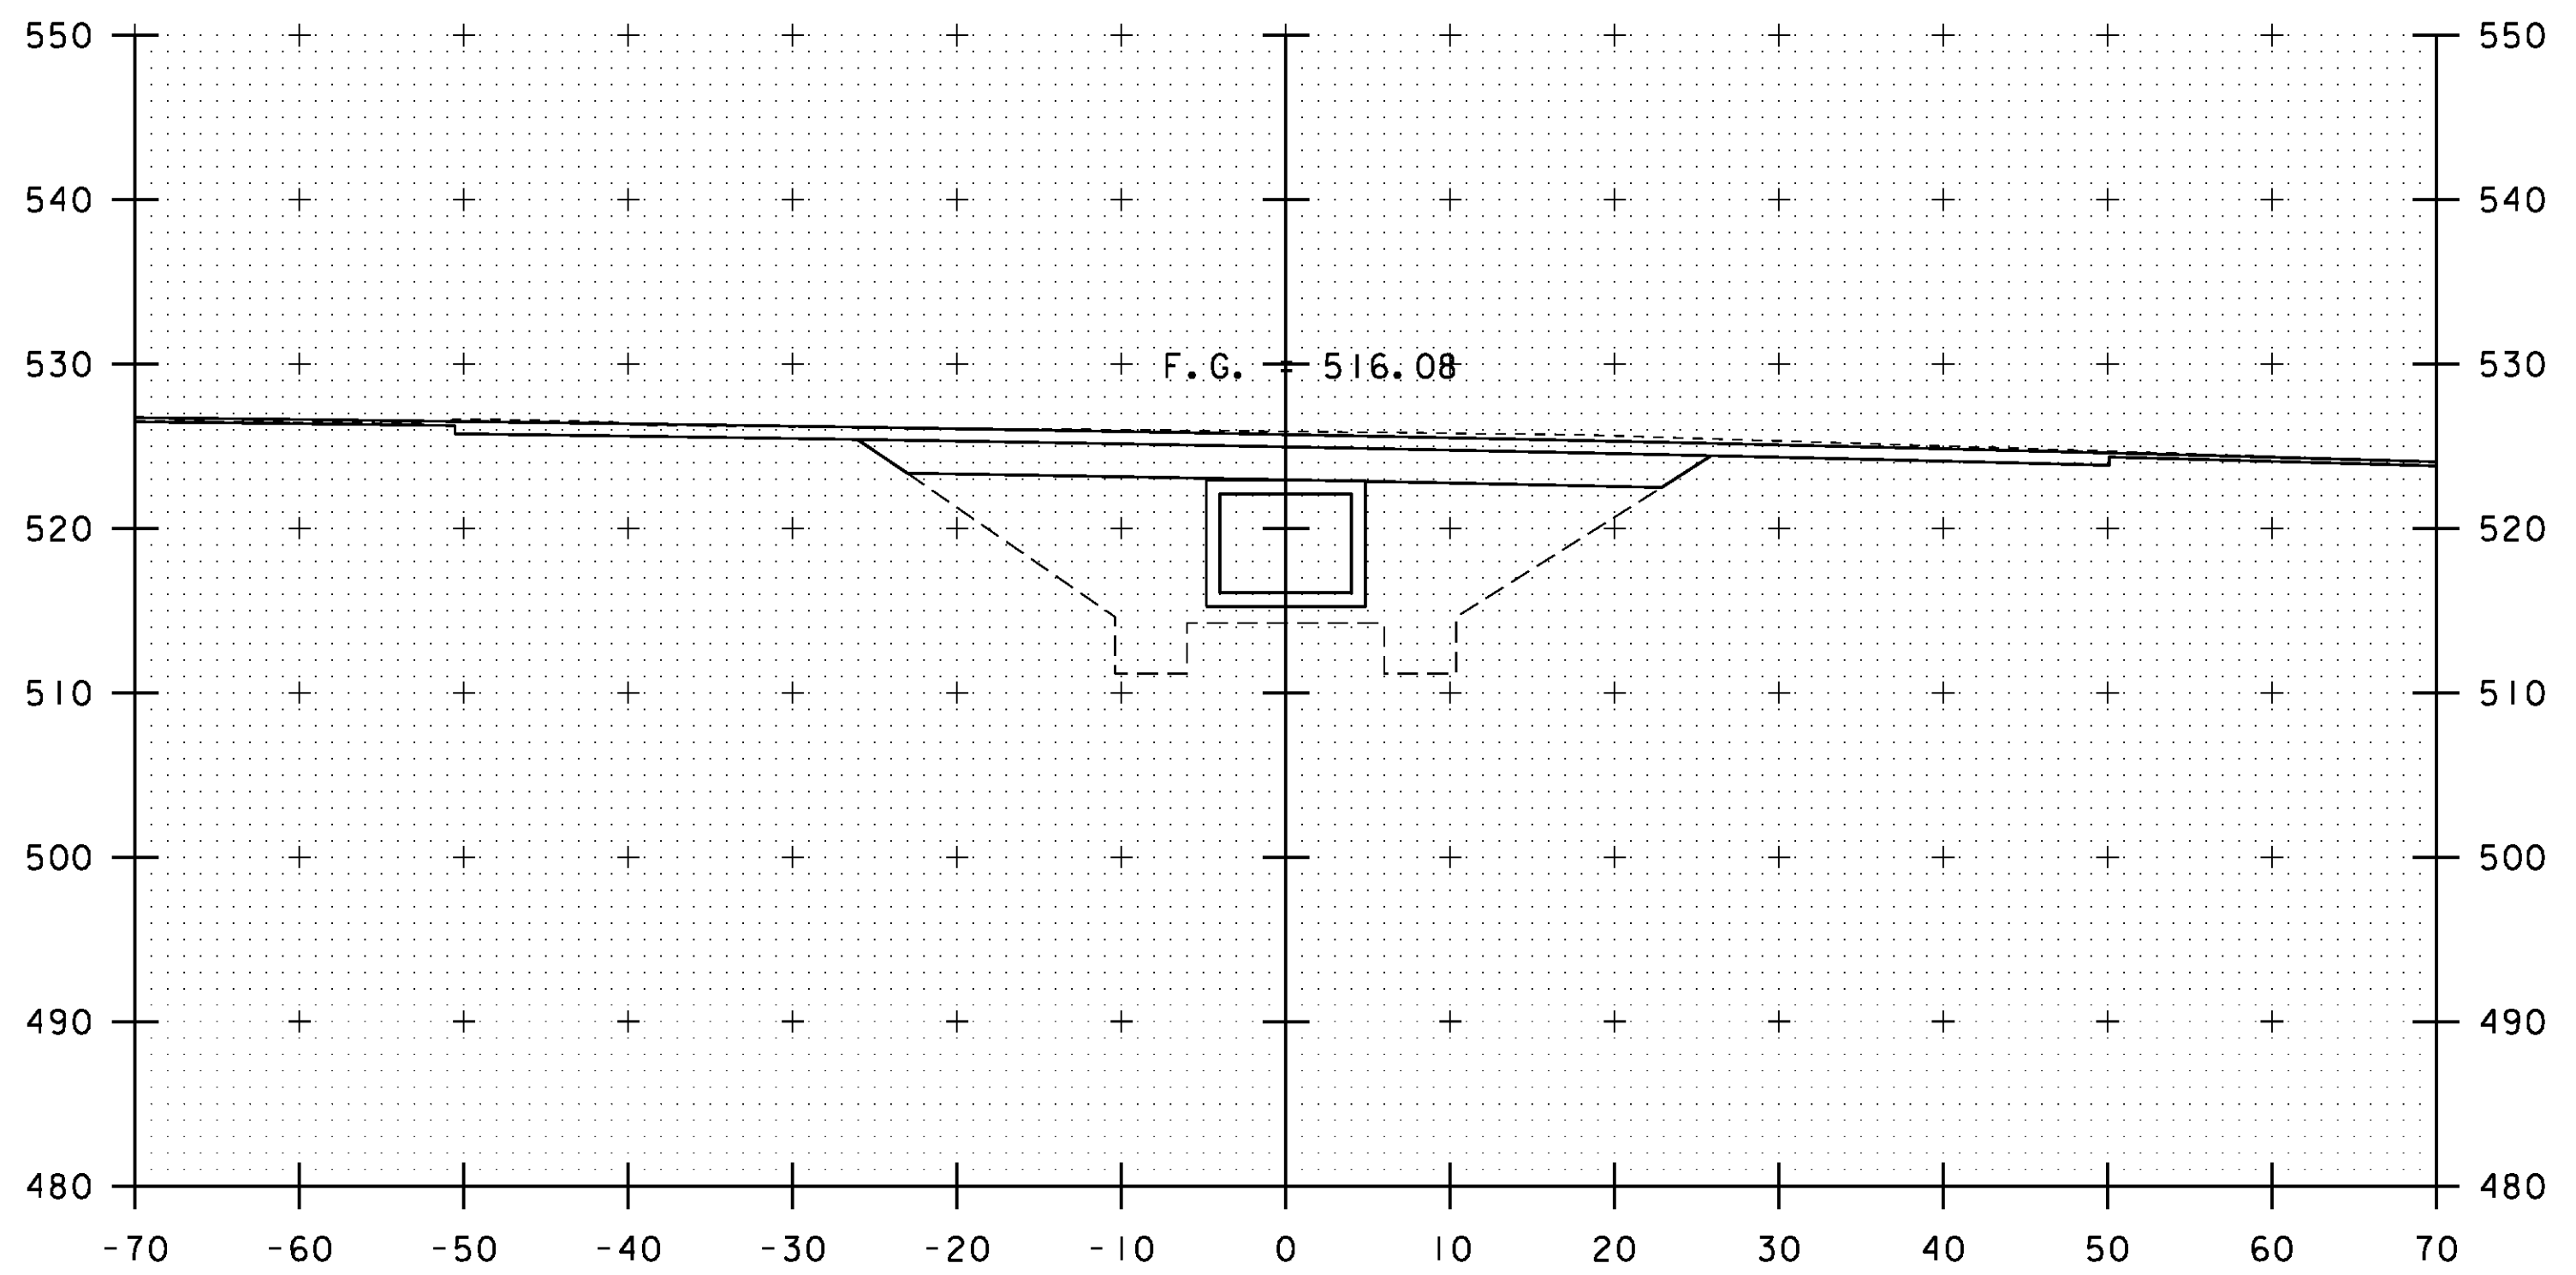


6+10

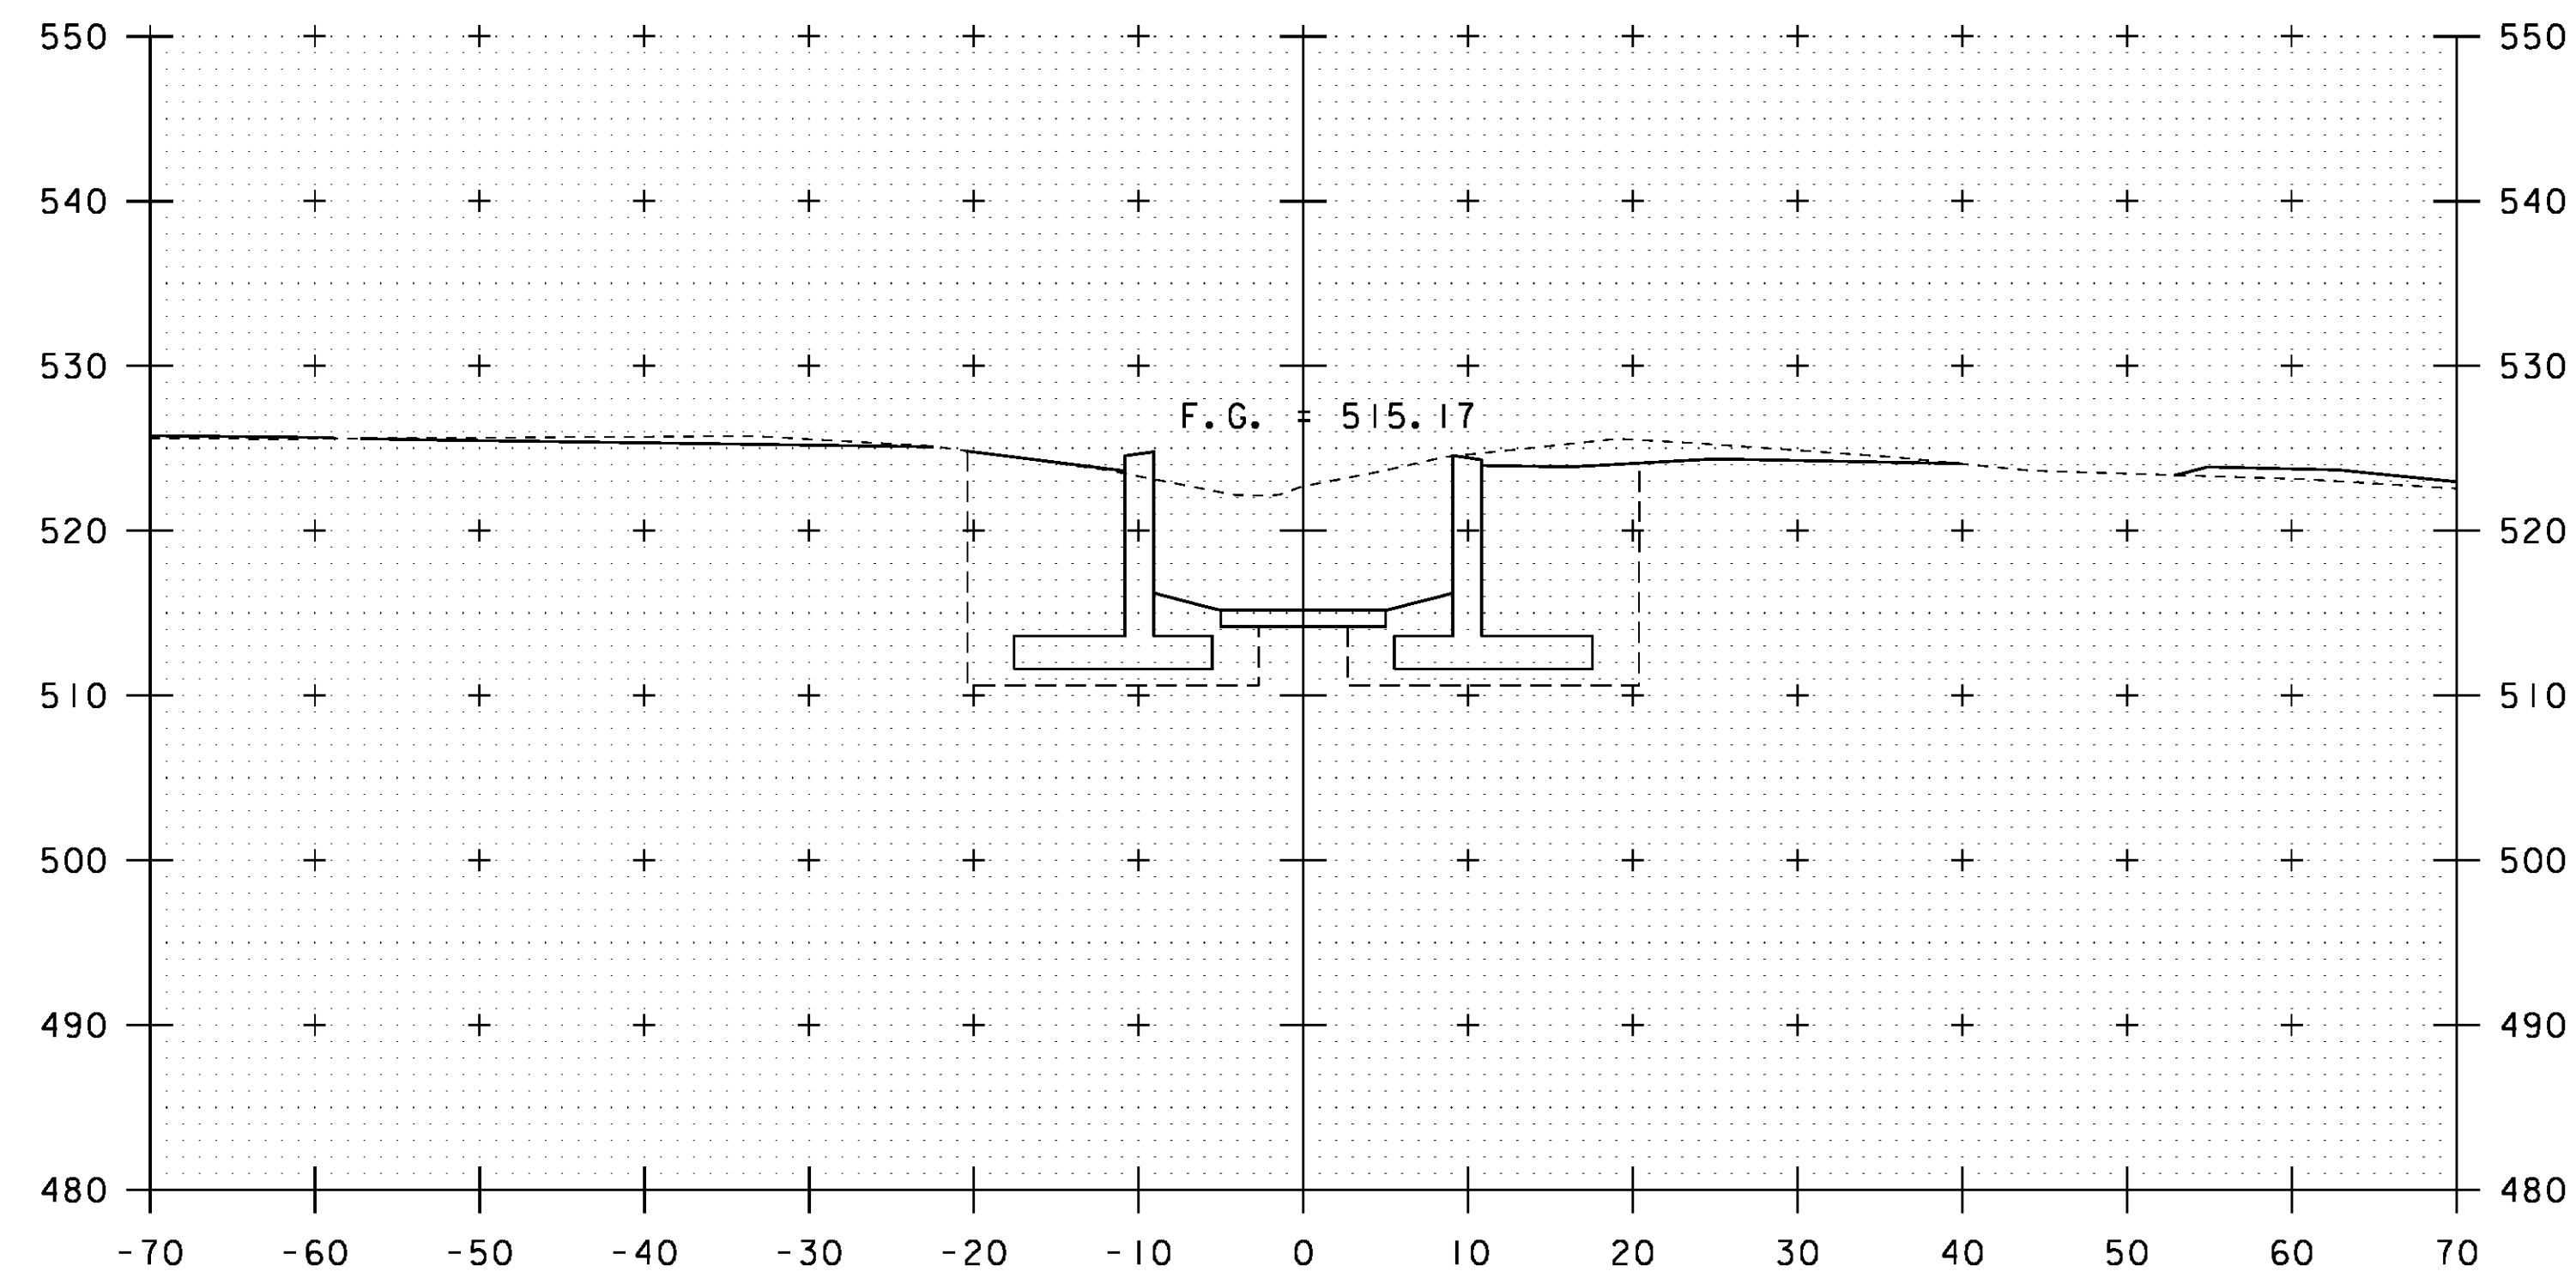

5+80

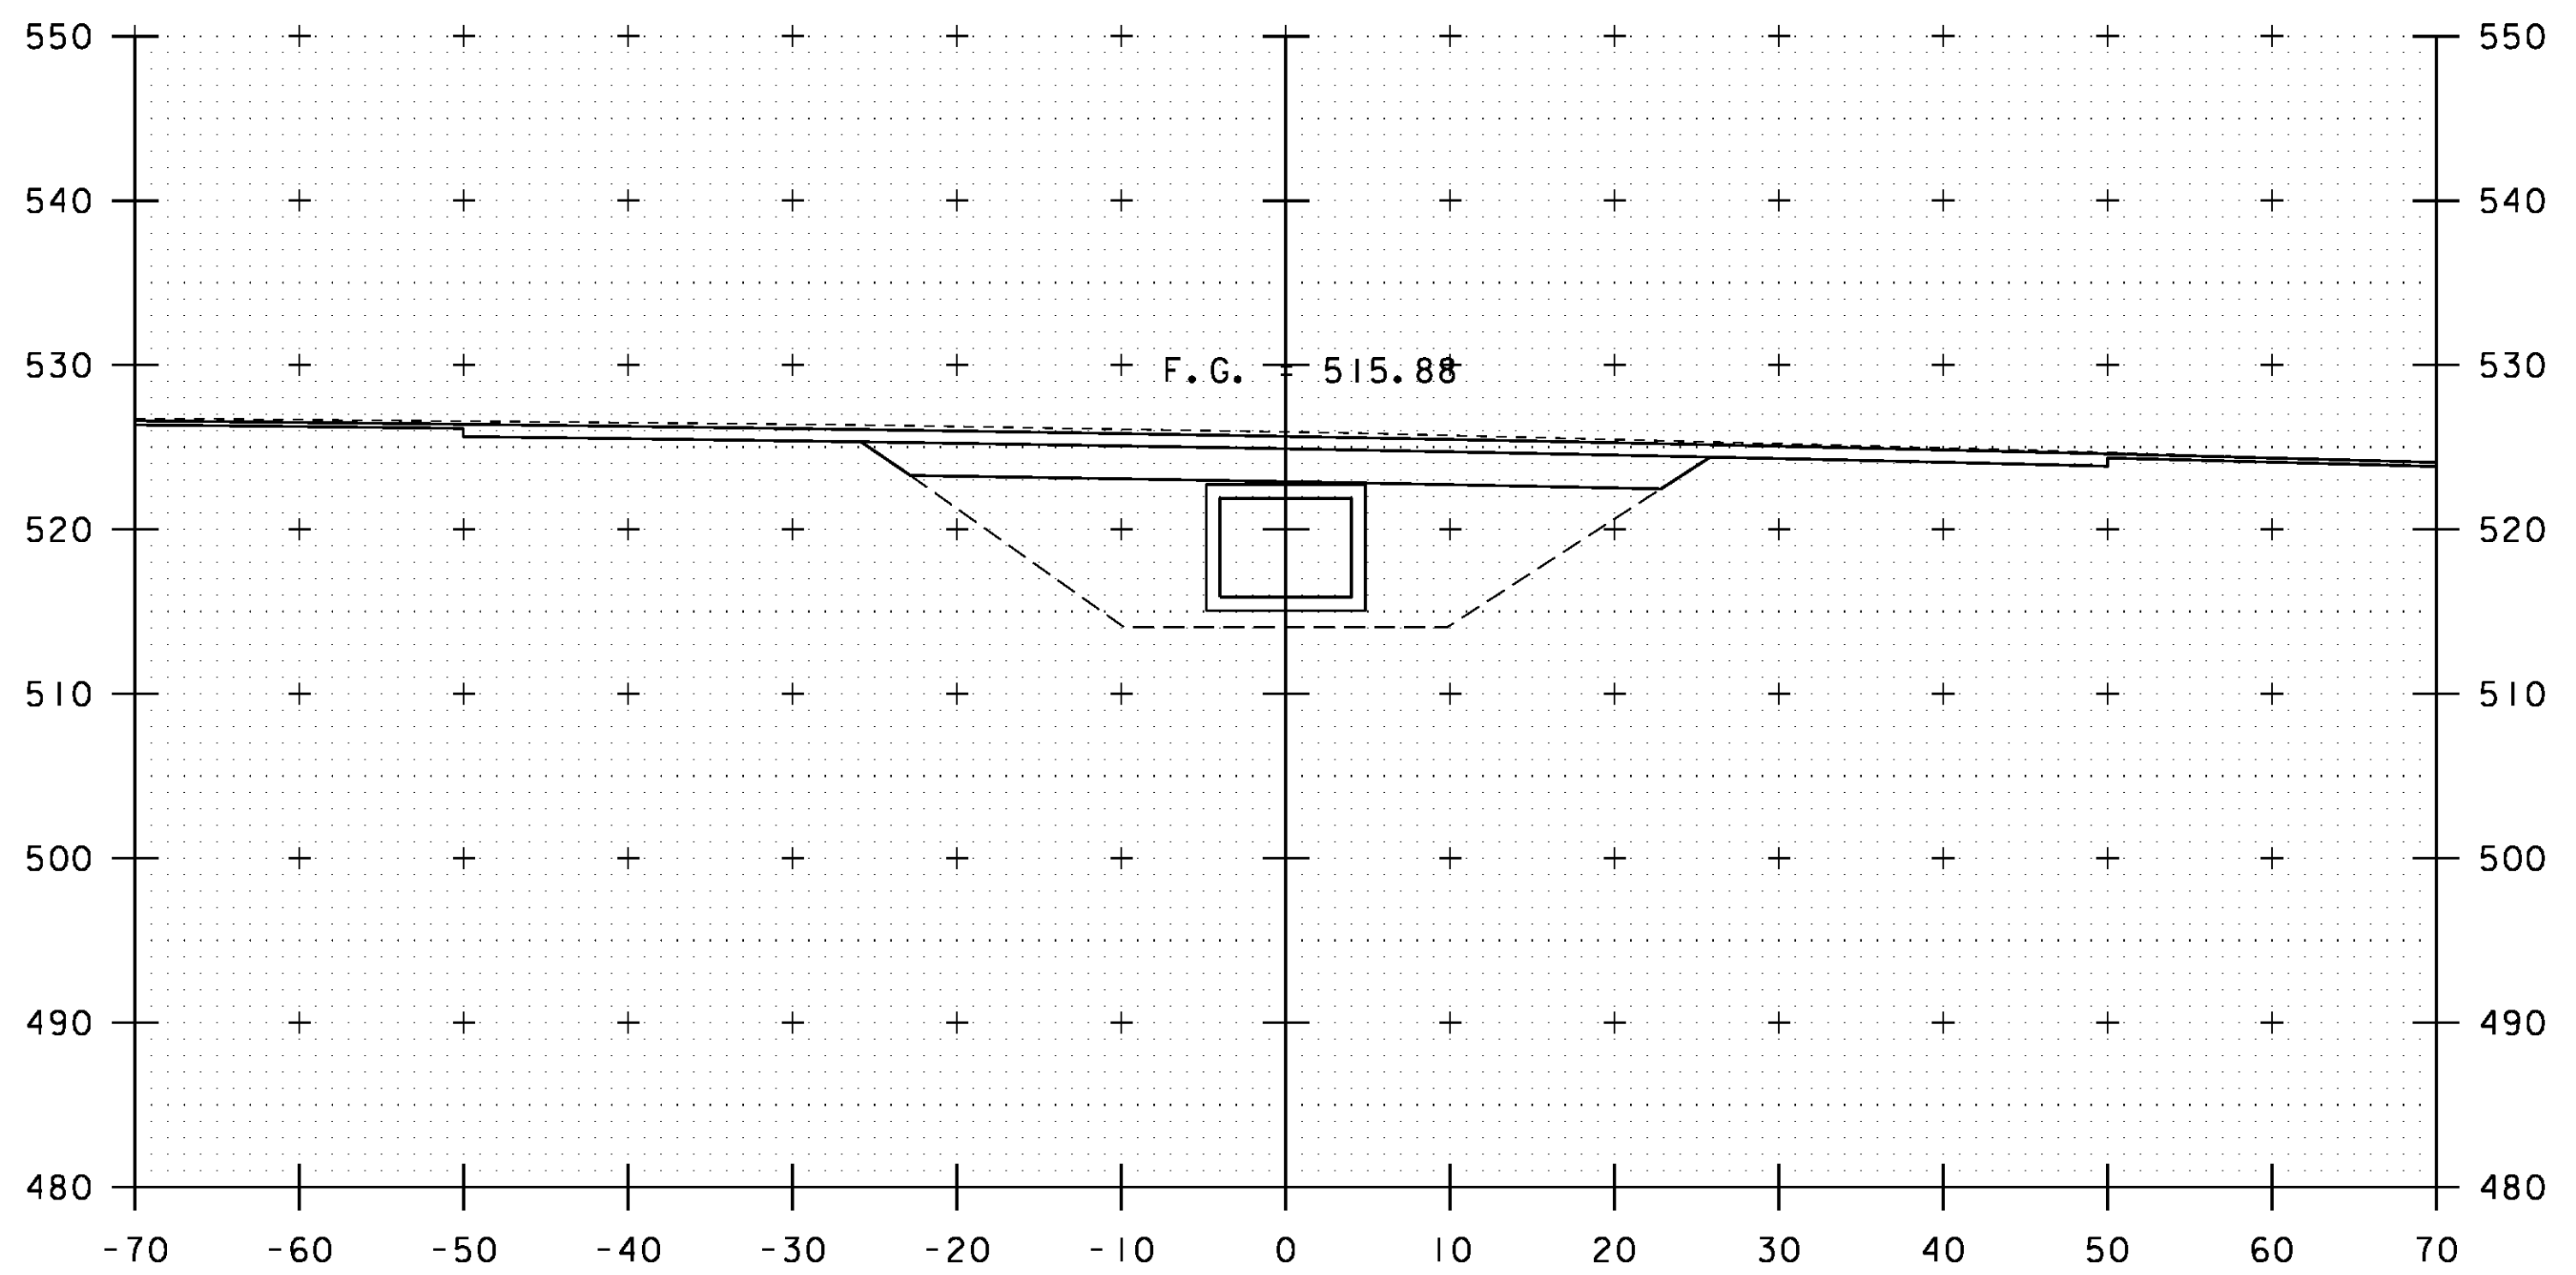


6+00

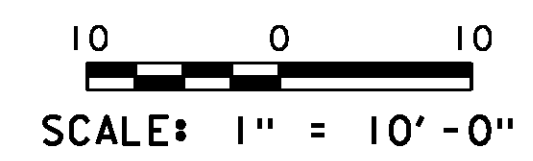


STA. 5+80 TO STA. 6+10


PROJECT NAME:	ROYALTON	PLOT DATE:	08-OCT-2013
PROJECT NUMBER:	BRS 0147(13)	DRAWN BY:	G. ROY
FILE NAME:	s86e05xsl_cattlepass3.dgn	CHECKED BY:	D. PETERSON
PROJECT LEADER:	C. CARLSON	CATTLE PASS CROSS SECTIONS (2)	SHEET 84 OF 186
DESIGNED BY:	G. ROY		

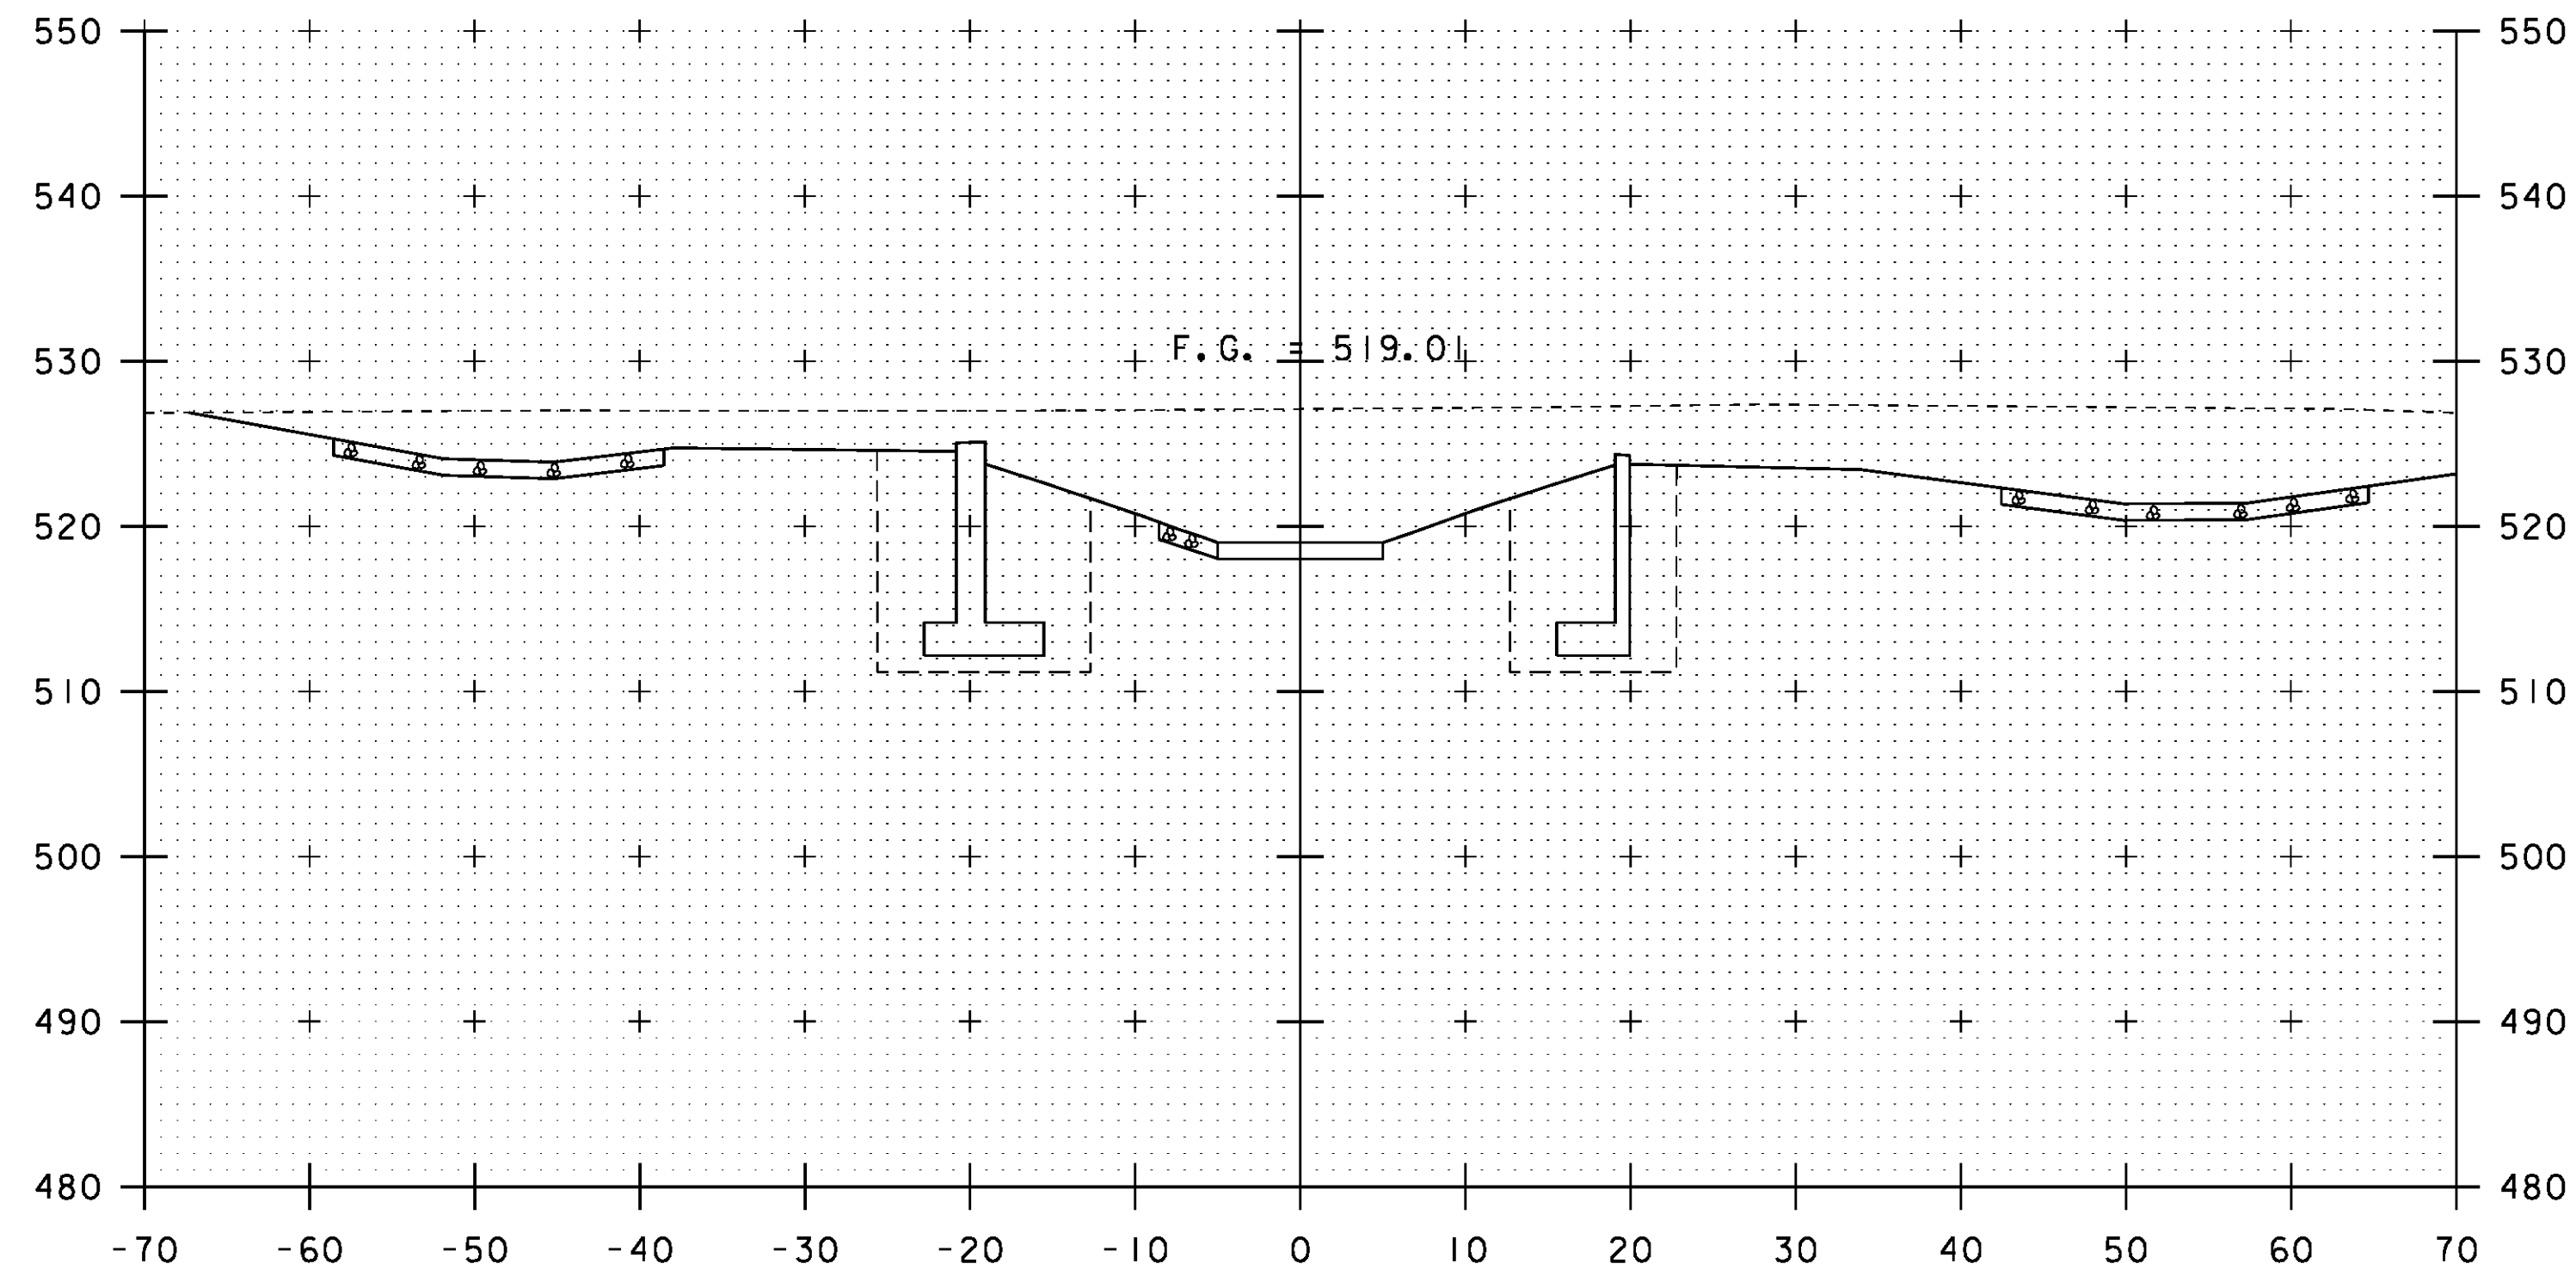


6+30

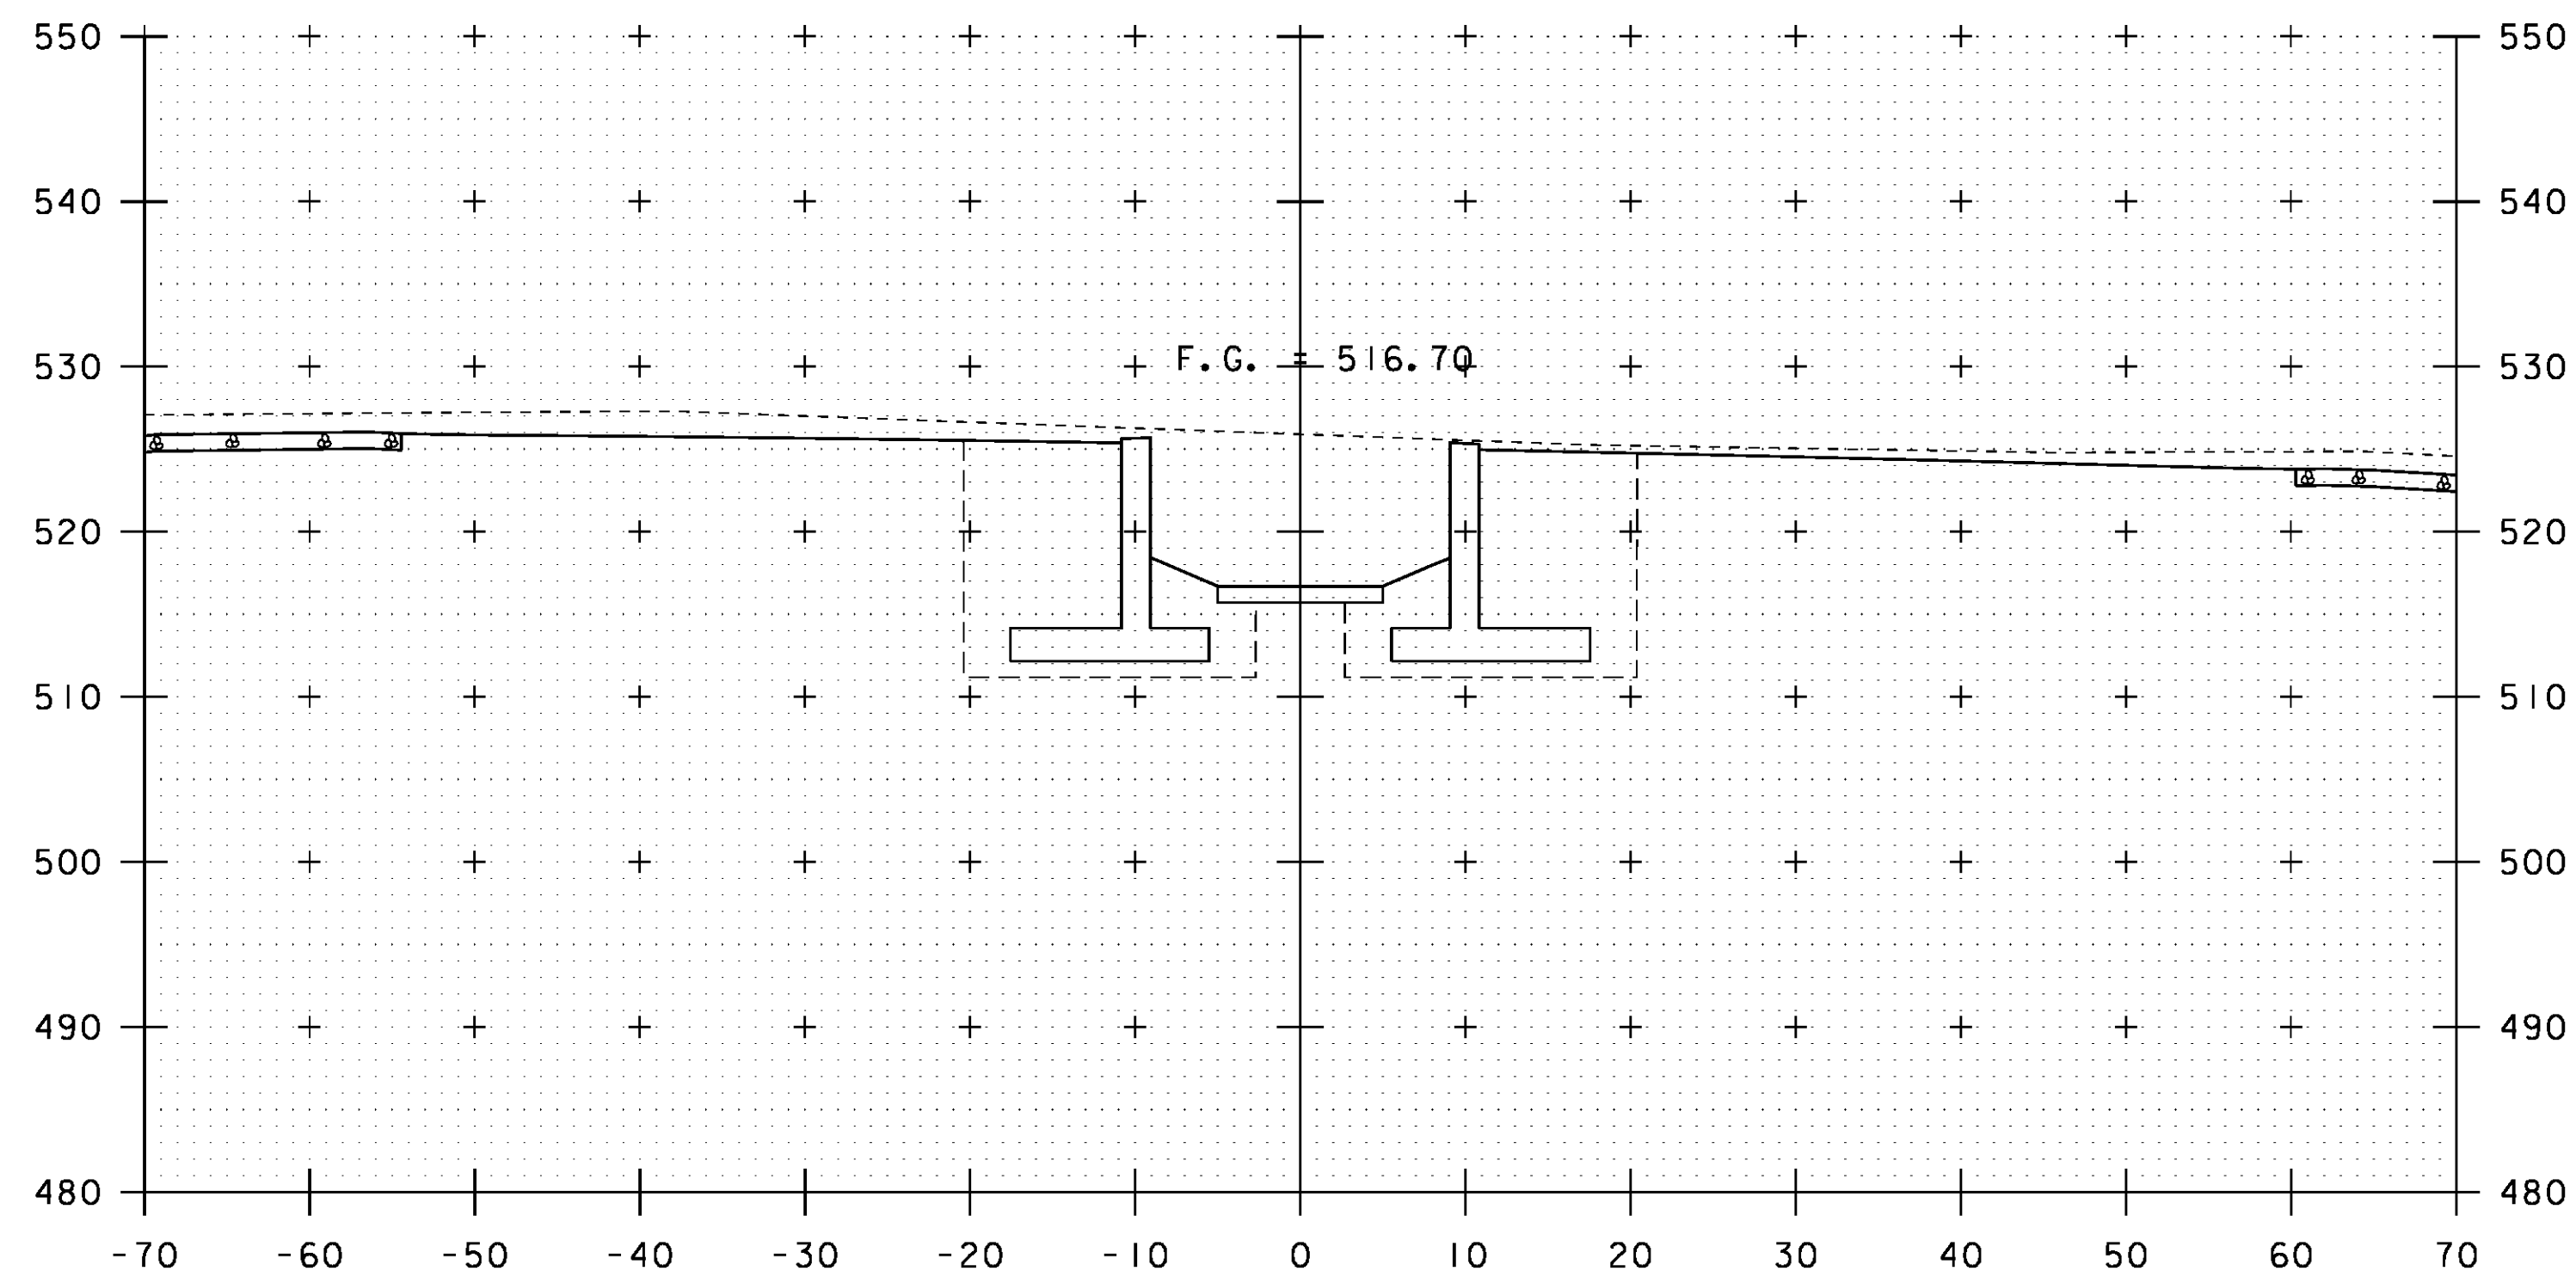

6+20

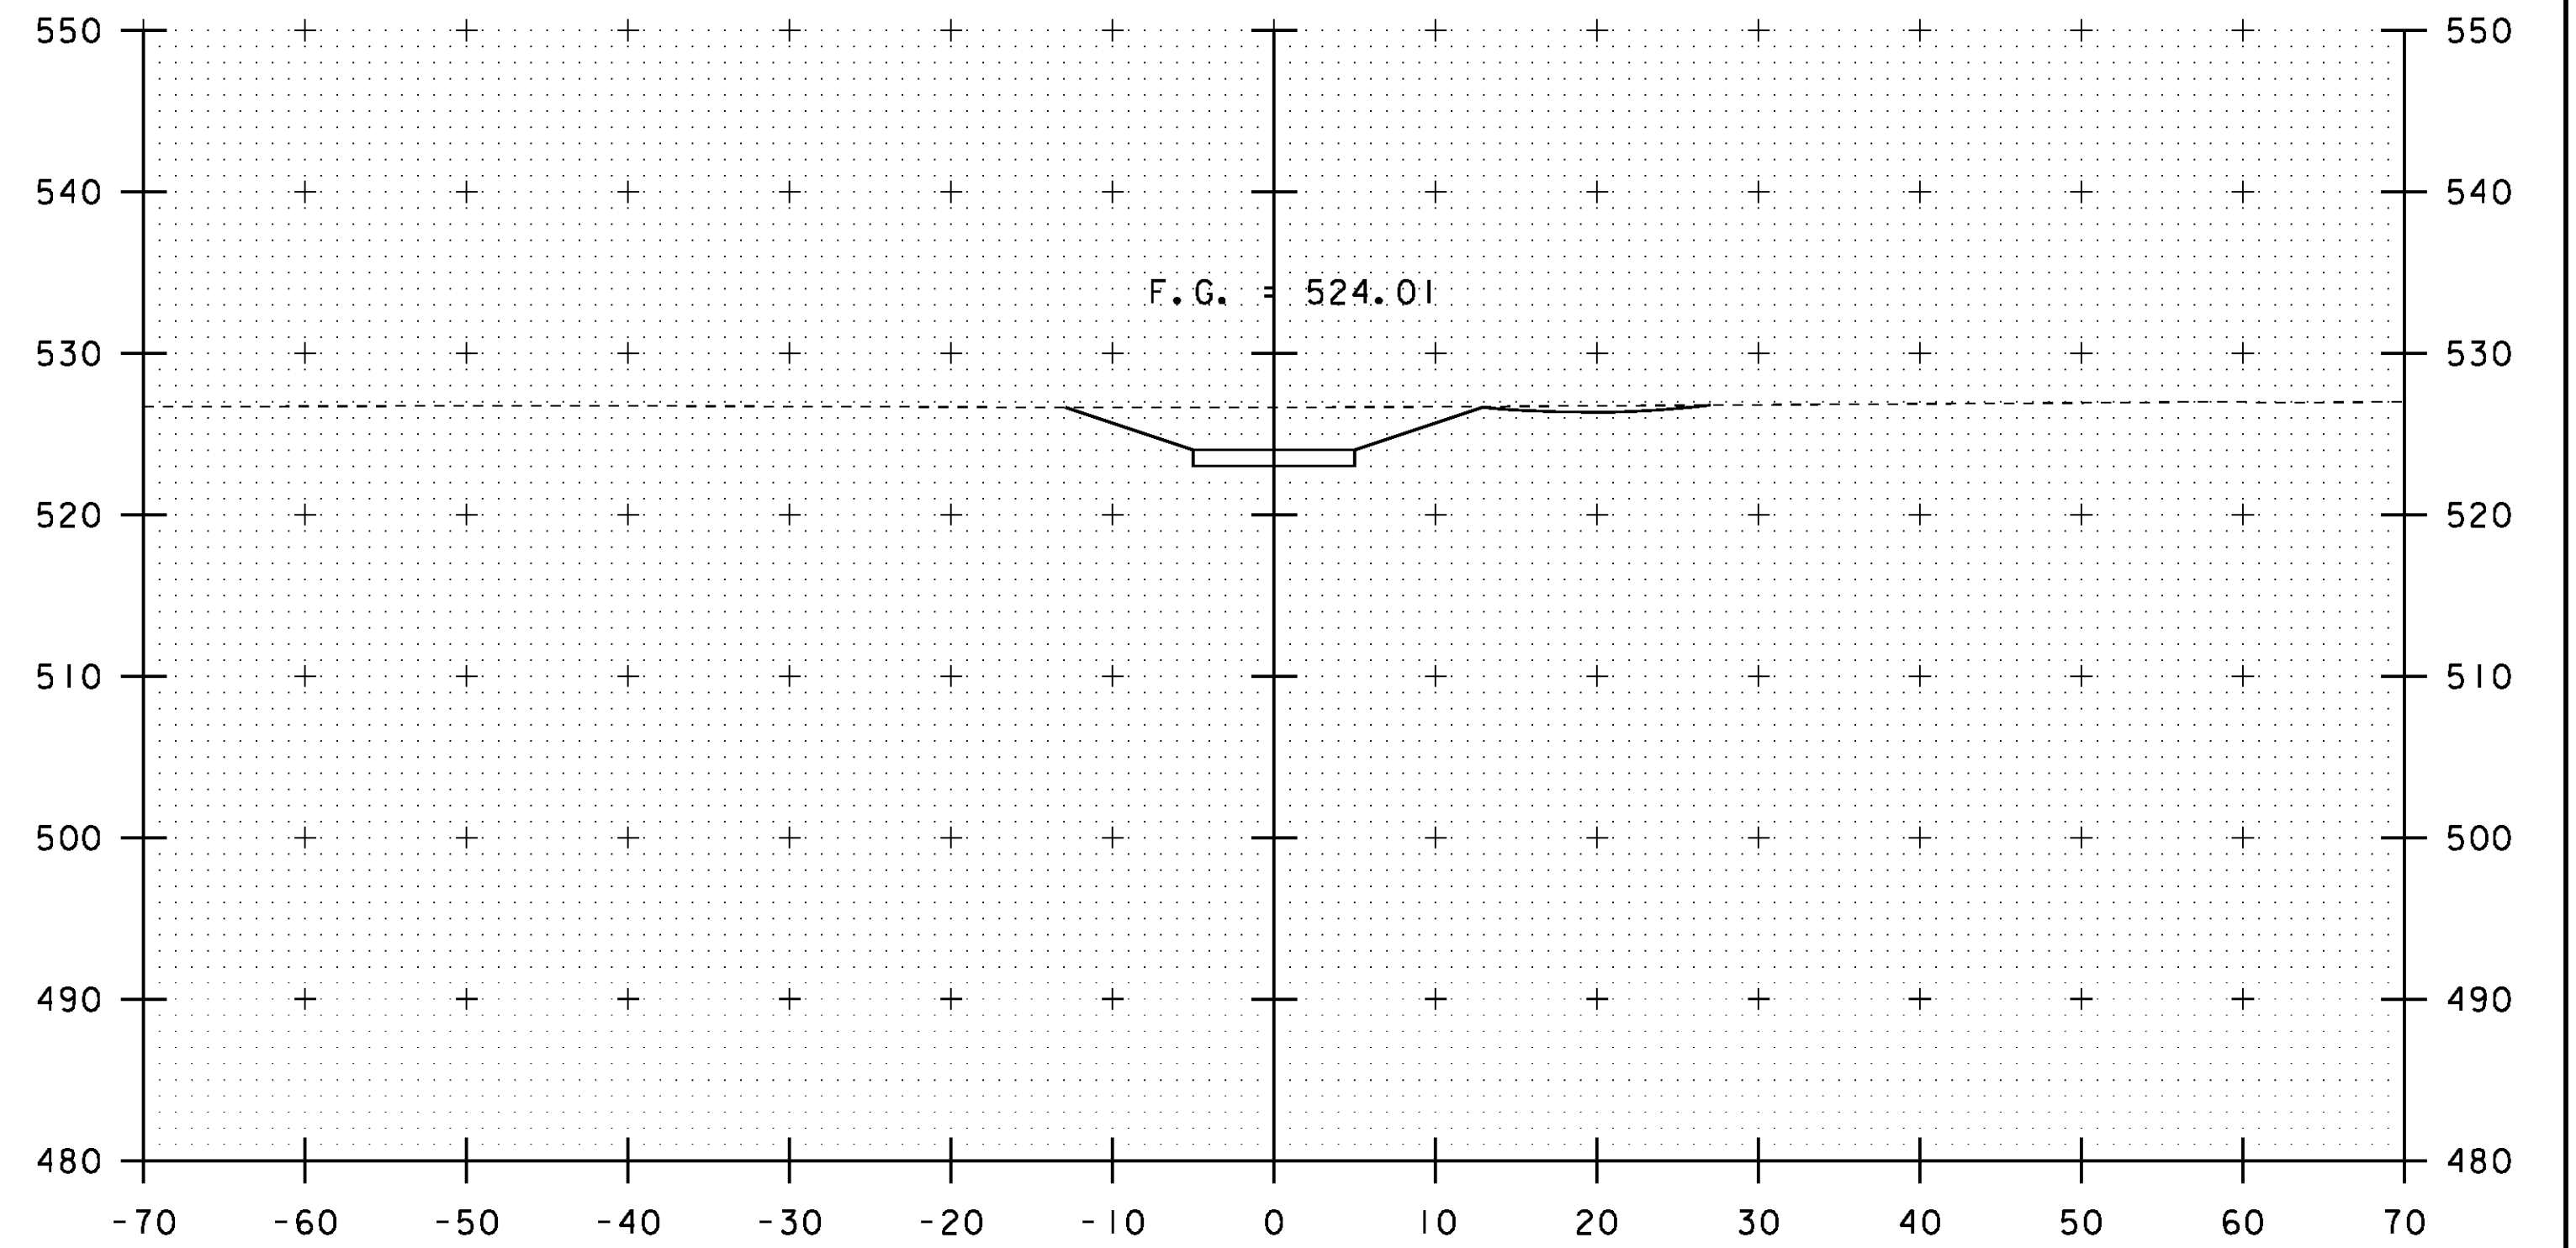

6+50

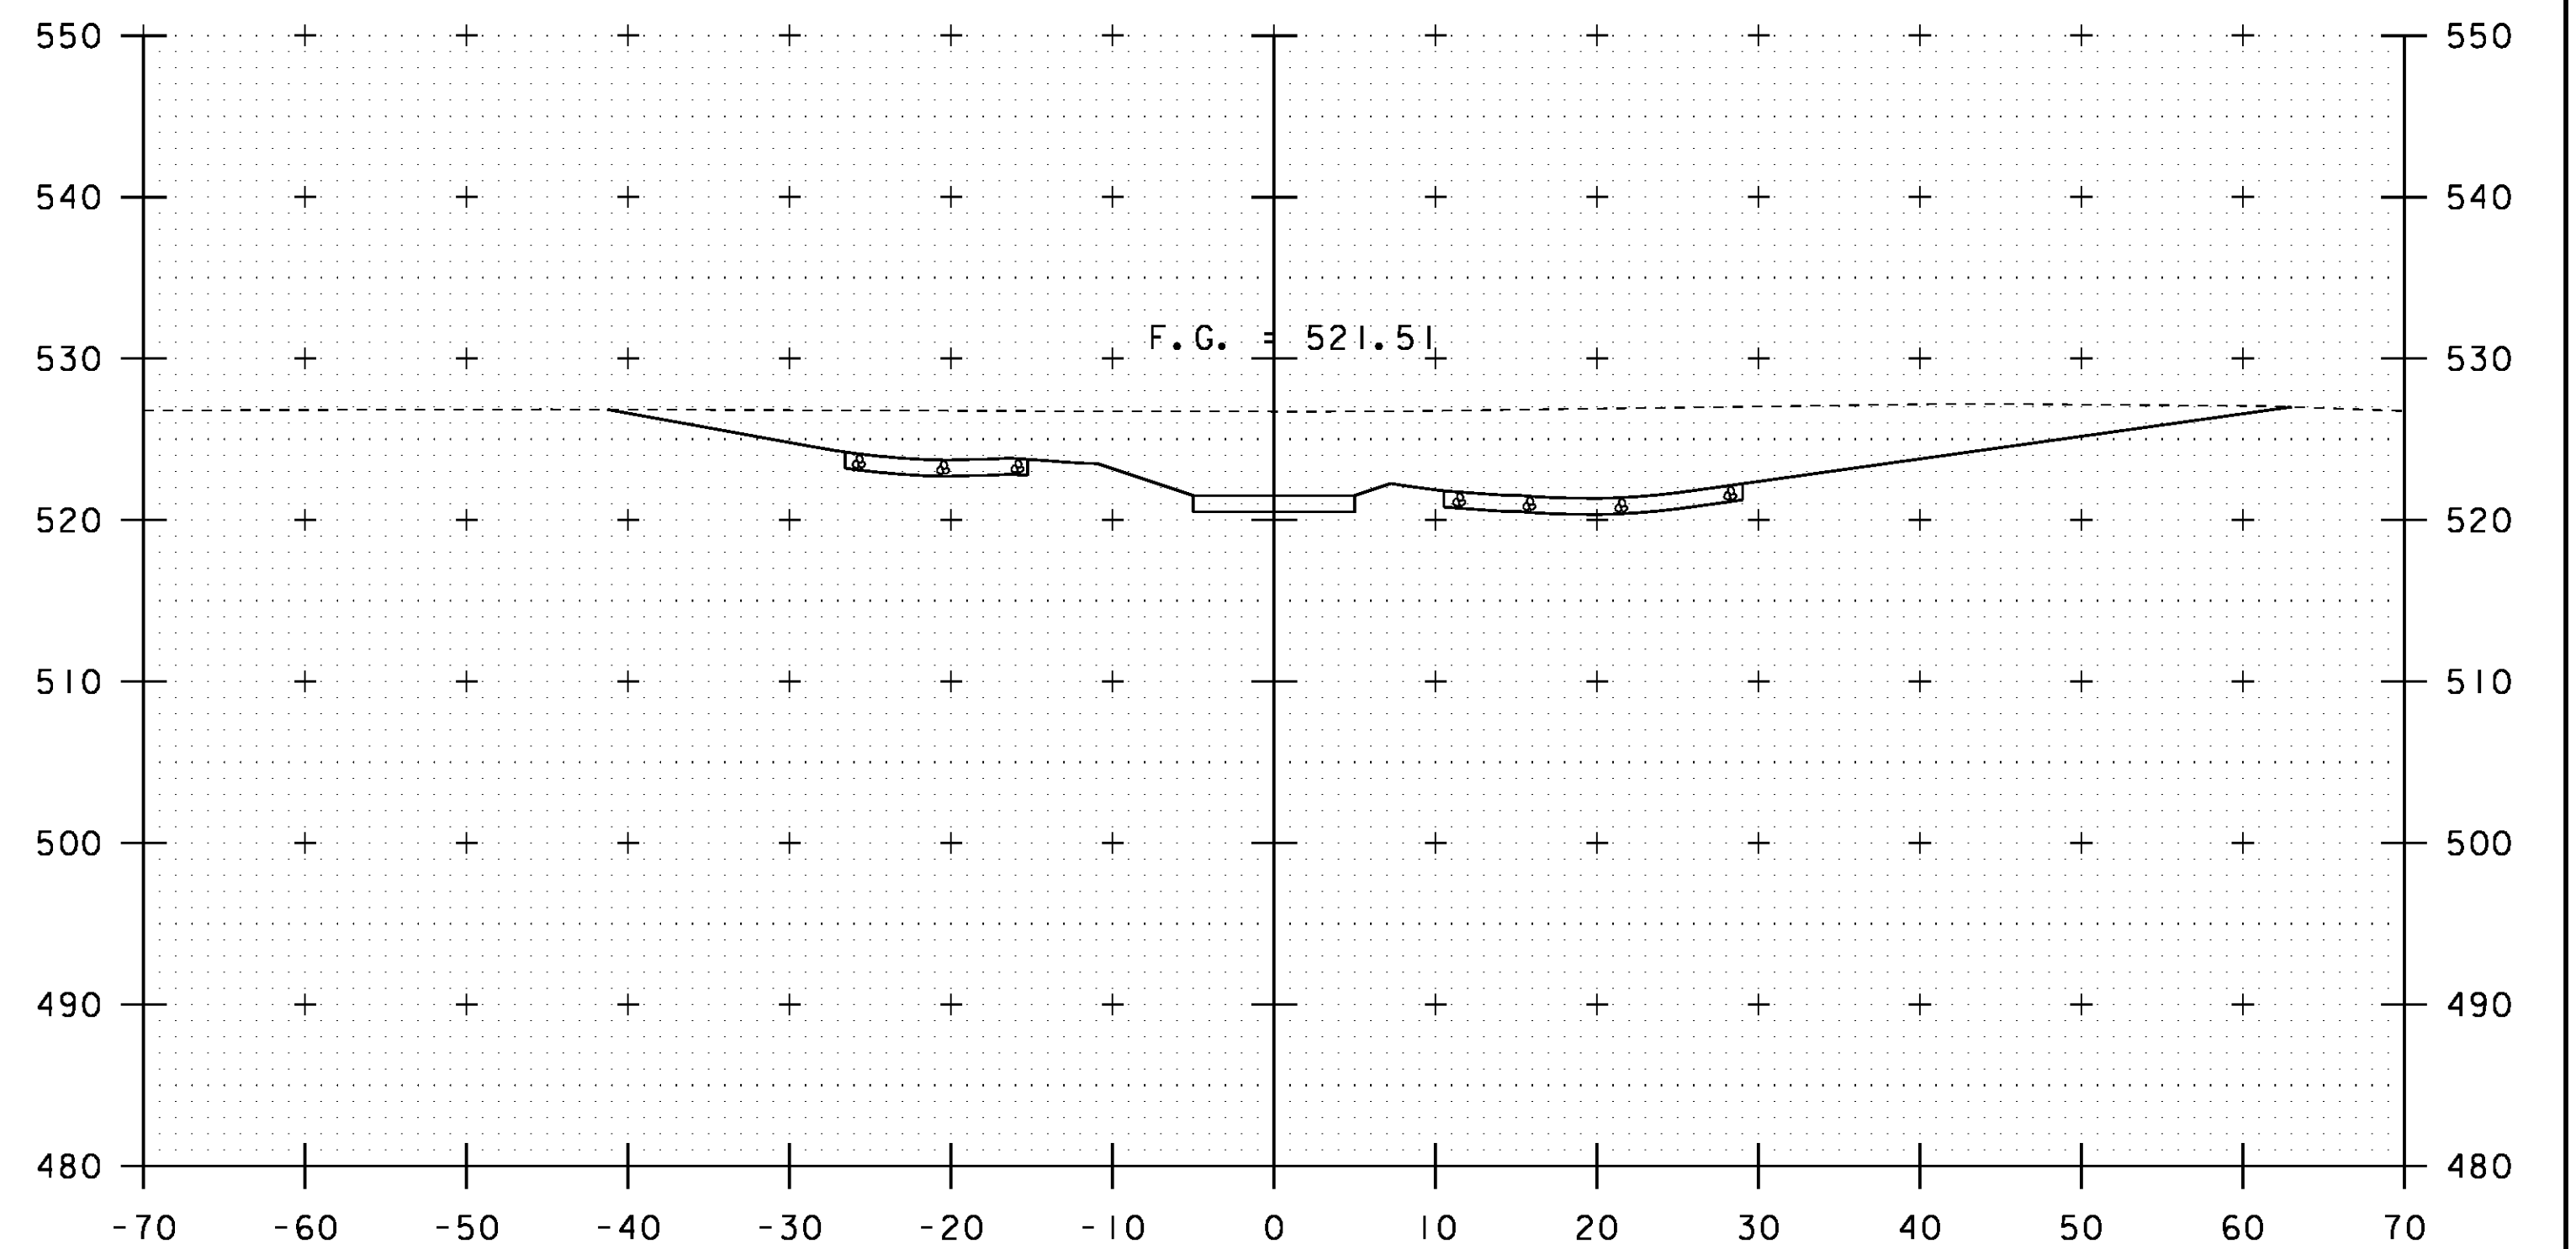


6+40

10 0 10  
SCALE: 1" = 10'-0"


STA. 6+20 TO STA. 6+50

PROJECT NAME: ROYALTON	PLOT DATE: 08-OCT-2013
PROJECT NUMBER: BRS 0147(13)	DRAWN BY: G. ROY
FILE NAME: s86e05xsl_cattlepass3.dgn	CHECKED BY: D. PETERSON
PROJECT LEADER: C. CARLSON	SHEET 85 OF 186
DESIGNED BY: G. ROY	
CATTLE PASS CROSS SECTIONS (3)	

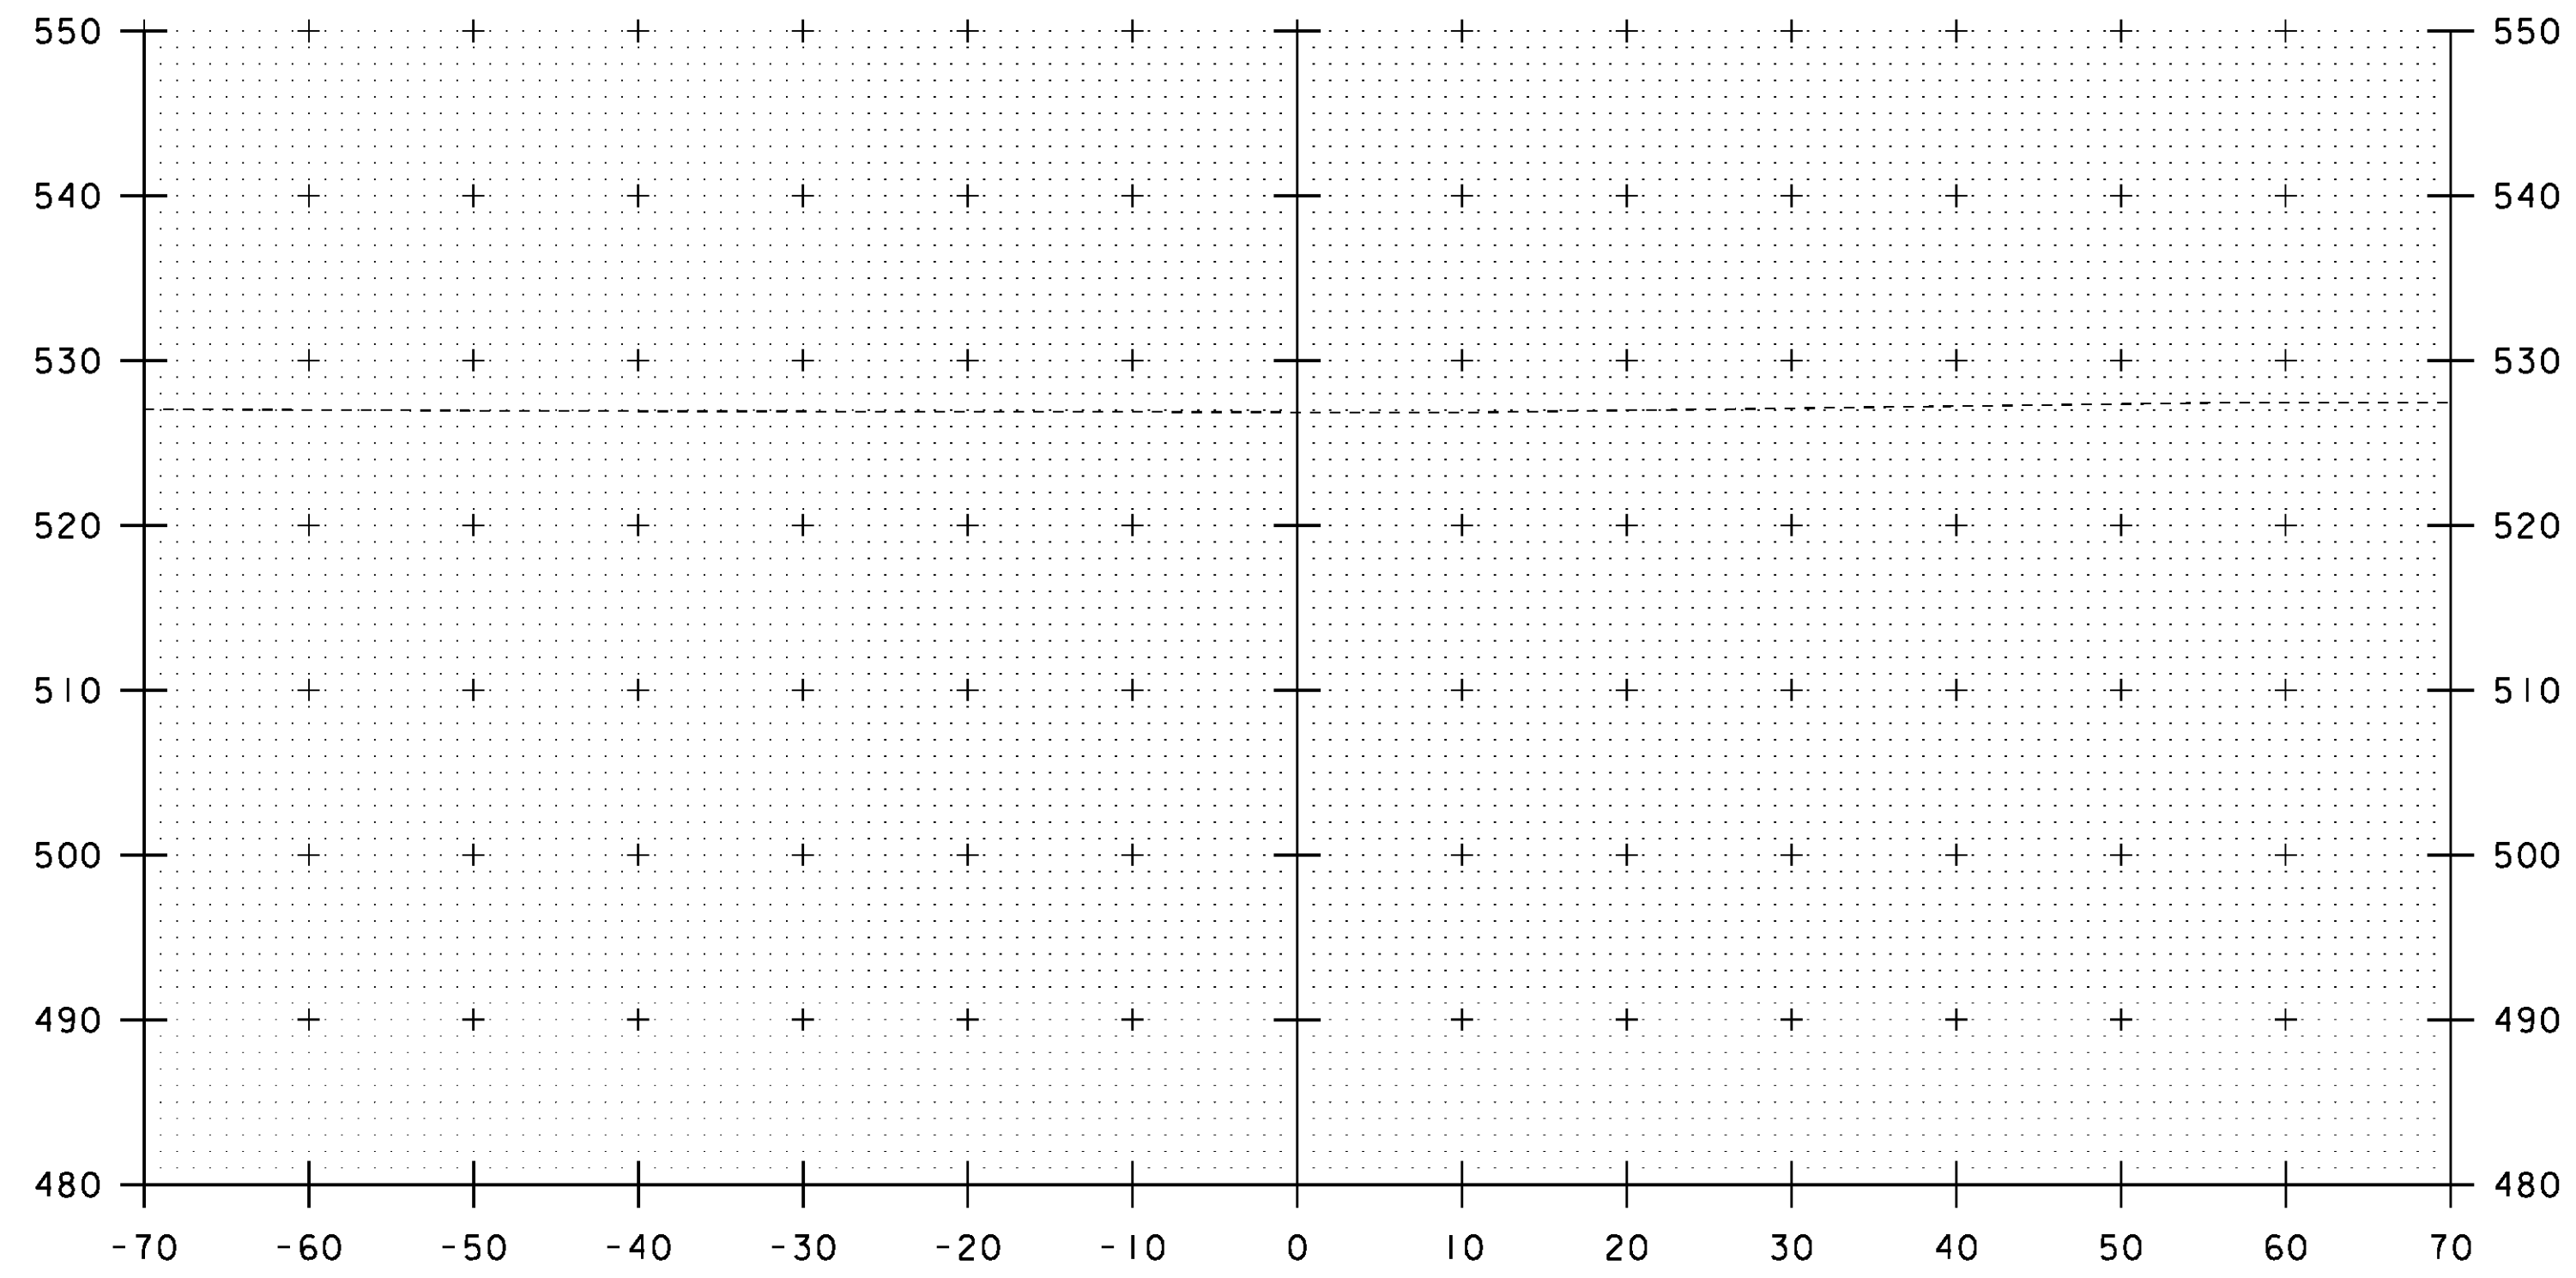

6+70

STA 6+65.70  
END CATTLE PASS  
MATCH EXISTING

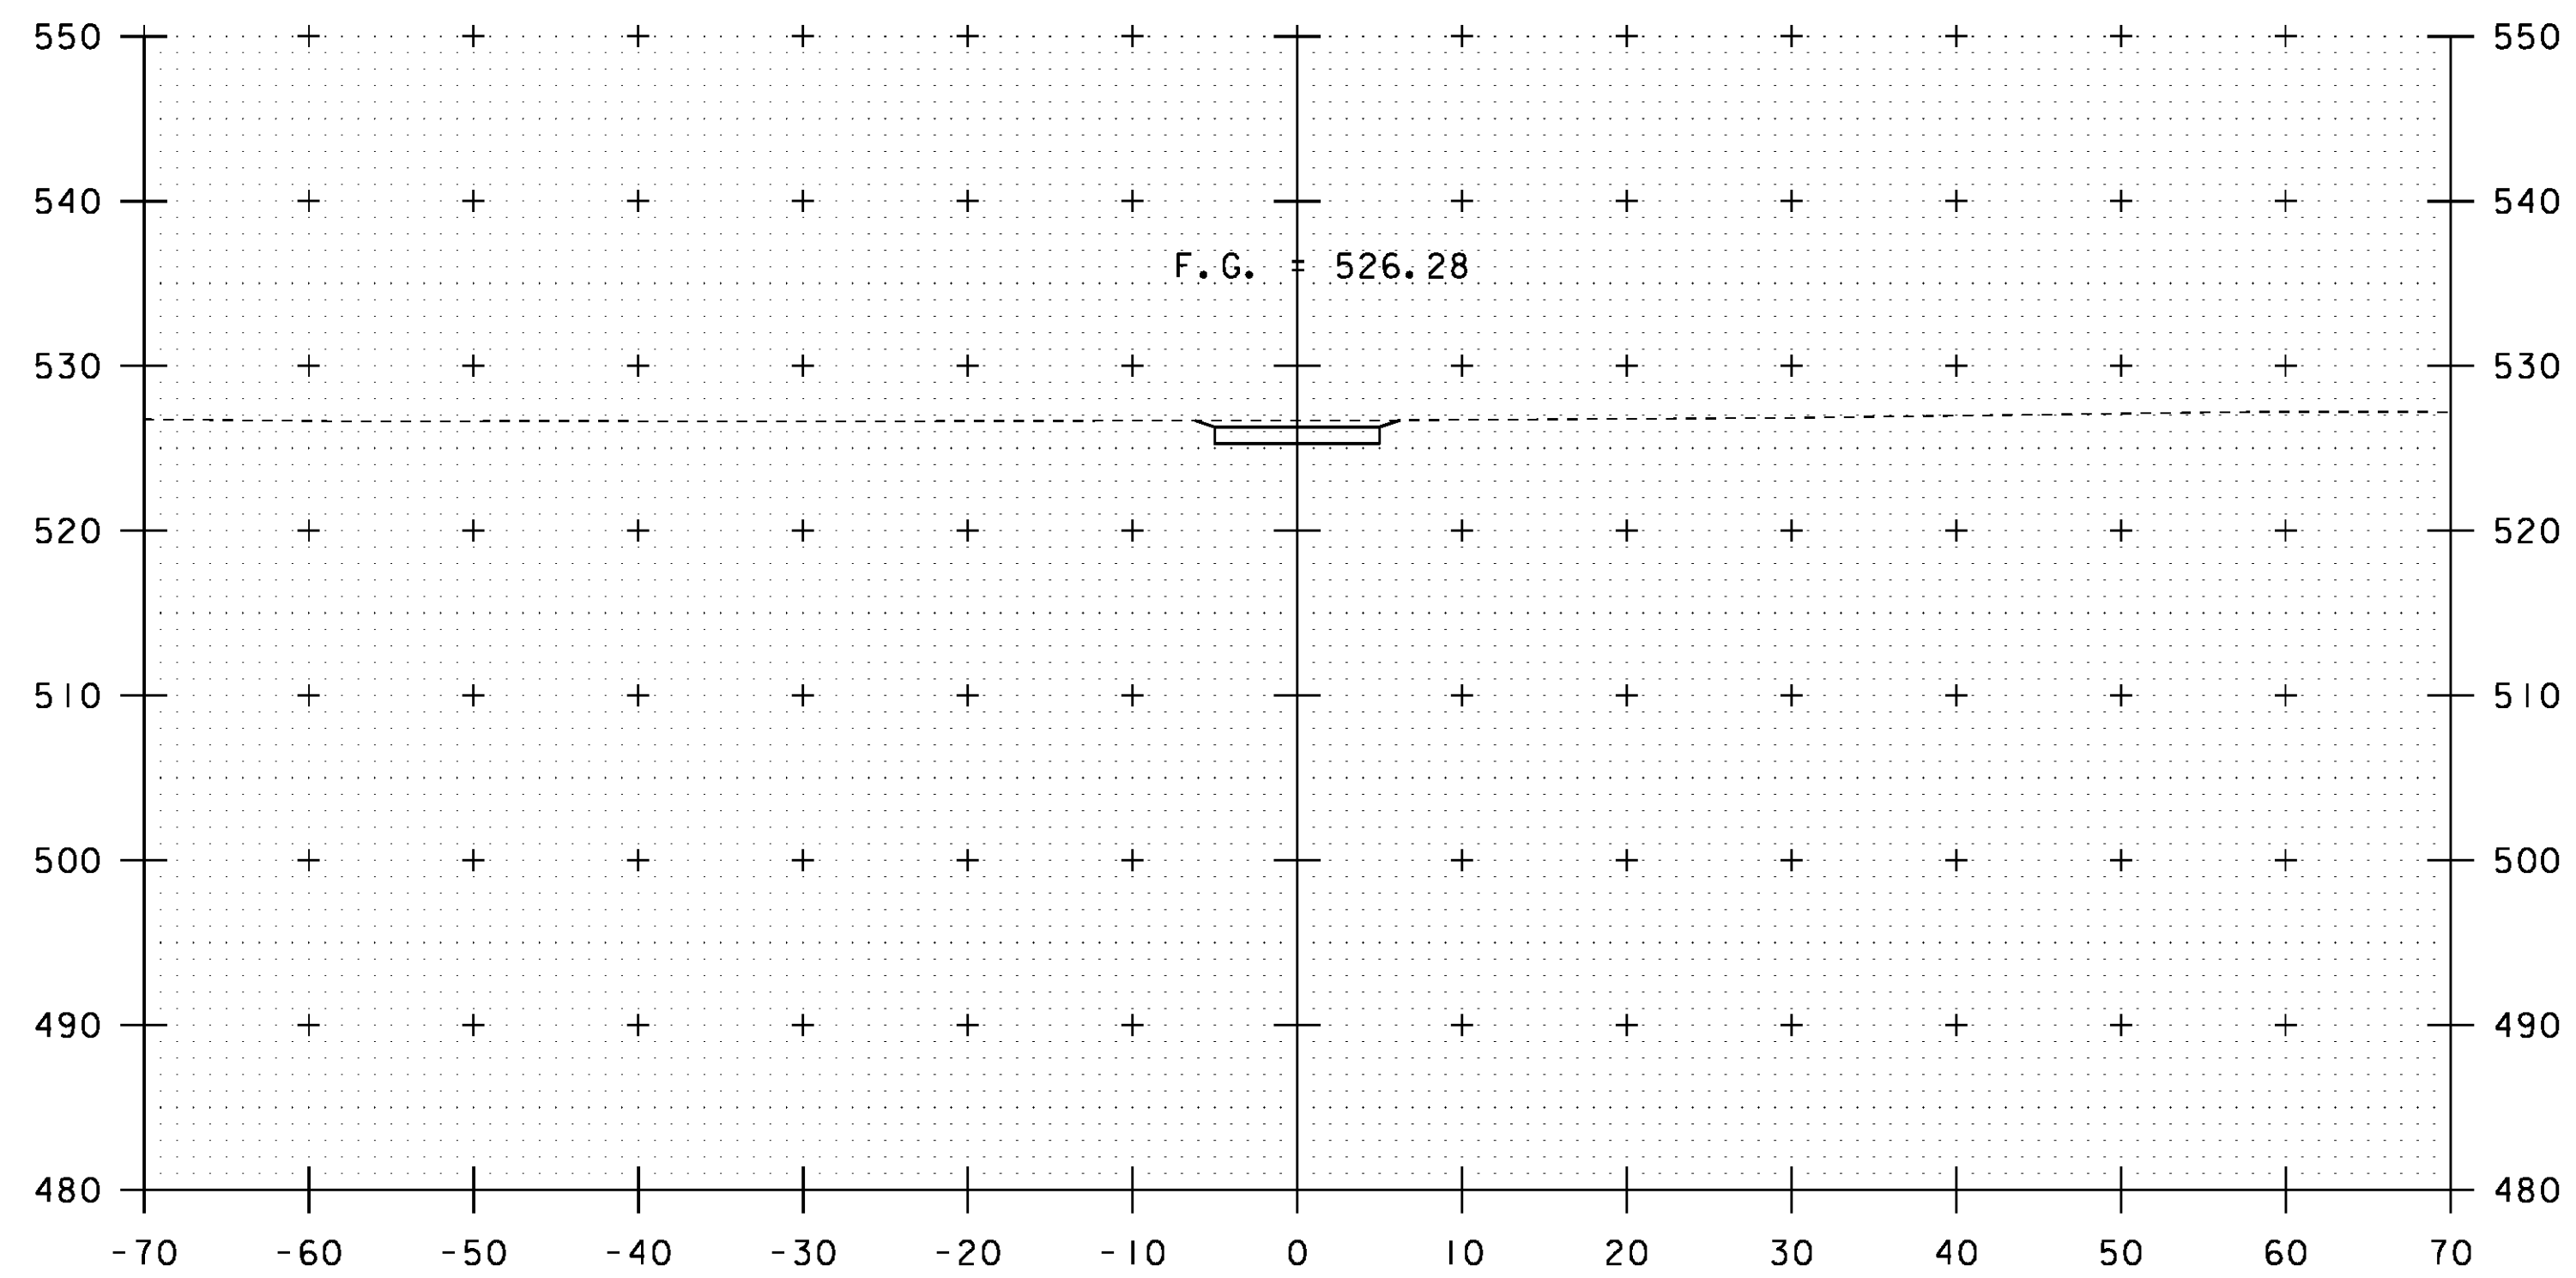

6+60

F.G. = 526.28

STA. 6+60 TO STA. 6+70

PROJECT NAME: ROYALTON	PLOT DATE: 08-OCT-2013
PROJECT NUMBER: BRS 0147(13)	DRAWN BY: G. ROY
FILE NAME: s86e05xsl_cattlepass3.dgn	CHECKED BY: D. PETERSON
PROJECT LEADER: C. CARLSON	SHEET 86 OF 186
DESIGNED BY: G. ROY	
CATTLE PASS CROSS SECTIONS (4)	

# PRELIMINARY INFORMATION SHEET (BRIDGE 28)

**LRFD**

**INDEX OF SHEETS**

**PLAN SHEETS**

SEE SHEET 2 FOR INDEX OF SHEETS

**STANDARDS LIST**

**FINAL HYDRAULIC REPORT**

**HYDROLOGIC DATA**

Date: November 2010

DRAINAGE AREA : 69.5 sq. mi.  
 CHARACTER OF TERRAIN : Mixture of woods and open fields  
 STREAM CHARACTERISTICS : Meandering and incised  
 NATURE OF STREAMBED : Silty sand, ledge waterfall downstream

**PEAK FLOW DATA**

Q 2.33 = 3000 cfs                      Q 50 = 6400 cfs  
 Q 10 = 4300 cfs                      Q 100 = 7600 cfs  
 Q 25 = 5400 cfs                      Q 500 = 10,300 cfs

DATE OF FLOOD OF RECORD : unknown  
 ESTIMATED DISCHARGE : unknown  
 WATER SURFACE ELEV. : unknown  
 NATURAL STREAM VELOCITY : @ Q50 = 10.6 fps  
 ICE CONDITIONS : moderate  
 DEBRIS : light to moderate  
 DOES THE STREAM REACH MAXIMUM HIGHWATER ELEV. RAPIDLY? no  
 IS ORDINARY RISE RAPID? no  
 IS STAGE AFFECTED BY UPSTREAM OR DOWNSTREAM CONDITIONS? no  
 IF YES, DESCRIBE:

WATERSHED STORAGE : <1%      HEADWATERS :  
 UNIFORM :   
 IMMEDIATELY ABOVE SITE :

**EXISTING STRUCTURE INFORMATION**

STRUCTURE TYPE : 3-span concrete T-beam bridge  
 YEAR BUILT : 1925  
 CLEAR SPAN(NORMAL TO STREAM) : 100'  
 VERTICAL CLEARANCE ABOVE STREAMBED : 15'  
 WATERWAY OF FULL OPENING : 630 sq. ft.  
 DISPOSITION OF STRUCTURE : Remove and replace  
 TYPE OF MATERIAL UNDER SUBSTRUCTURE : See borings

**WATER SURFACE ELEVATIONS AT:**

Q2.33 = 516.5'                      VELOCITY = 16.3 fps  
 Q10 = 518.7'                      "      18.5 fps  
 Q25 = 520.3'                      "      19.9 fps  
 Q50 = 521.8'                      "      21.1 fps  
 Q100 = 523.4'                      "      20.1 fps

LONG TERM STREAMBED CHANGES : None

IS THE ROADWAY OVERTOPPED BELOW Q100: No  
 FREQUENCY: N/A  
 RELIEF ELEVATION: 524.9'  
 DISCHARGE OVER ROAD @Q100: None

**UPSTREAM STRUCTURE**

TOWN: Bethel                      DISTANCE: 13,840'  
 HIGHWAY #: TH 6                      STRUCTURE #: BR 39  
 CLEAR SPAN: 49'                      CLEAR HEIGHT: 12.5'  
 YEAR BUILT: 1938                      FULL WATERWAY:  
 STRUCTURE TYPE: Rolled beam

**DOWNSTREAM STRUCTURE**

TOWN: Royalton                      DISTANCE: 3100'  
 HIGHWAY #: VT 14                      STRUCTURE #: BR 27  
 CLEAR SPAN: 89'                      CLEAR HEIGHT: 12'  
 YEAR BUILT: 1927                      FULL WATERWAY: 755 sq. ft.  
 STRUCTURE TYPE: 3-span concrete T-beam

**LRFR LOAD RATING FACTORS**


LOADING LEVELS	TRUCK						
	HL-93	HL-93	SS2	6 AXLE	3A STR	4A STR	5A SEMI
TONNAGE	20	36	36	66	30	34.5	38
INVENTORY	2.6	1.09					
POSTING							
OPERATING	3.36	1.14	2.34	1.39	2.43	2.14	
COMMENTS:							

**AS BUILT "REBAR" DETAIL**

LEVEL I	LEVEL II	LEVEL III
TYPE:	TYPE:	TYPE:
GRADE:	GRADE:	GRADE:

**TRAFFIC DATA**

**TEMPORARY BRIDGE PROFILE ALONG TEMP CL**

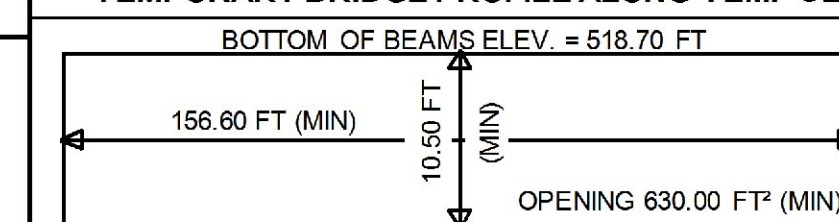

YEAR	ADT	DHV	% D	% T	ADTT	20 year ESAL for flexible pavement from 2003 to 2023 : 2667000
2003	1500	210	59	8	170	40 year ESAL for flexible pavement from 2003 to 2043 : 6477000
2023	2000	280	59	8	230	Design Speed : 30 mph

**PROPOSED STRUCTURE**

STRUCTURE TYPE: Single span steel beam bridge  
 CLEAR SPAN(NORMAL TO STREAM): 113'  
 VERTICAL CLEARANCE ABOVE STREAMBED: 13.5'  
 WATERWAY OF FULL OPENING: 1110 sq. ft.

**WATER SURFACE ELEVATIONS AT:**

Q2.33 = 514.2'                      VELOCITY = 15.4 fps  
 Q10 = 515.4'                      "      16.6 fps  
 Q25 = 516.5'                      "      17.5 fps  
 Q50 = 517.4'                      "      18.1 fps  
 Q100 = 518.5'                      "      18.8 fps

IS THE ROADWAY OVERTOPPED BELOW Q100: No  
 FREQUENCY: N/A  
 RELIEF ELEVATION: 525.8'  
 DISCHARGE OVER ROAD @Q100: None

AVERAGE LOW ELEVATION OF SUPERSTRUCTURE: 520.5'  
 VERTICAL CLEARANCE: @ Q50 = 3.1'

SCOUR: 2.0' @ Q100.

REQUIRED CHANNEL PROTECTION: Stone Fill, Type IV

**PERMIT INFORMATION**

AVERAGE DAILY FLOW: 145 cfs                      DEPTH OR ELEVATION:  
 ORDINARY LOW WATER: 70 cfs                      2.5'  
 ORDINARY HIGH WATER: 1300 cfs                      6.0'

**TEMPORARY BRIDGE REQUIREMENTS**

STRUCTURE TYPE: 2-span bridge  
 CLEAR SPAN (NORMAL TO STREAM): 56.8' + 99.7' = 156.6'  
 VERTICAL CLEARANCE ABOVE STREAMBED: 518.7' minimum  
 WATERWAY AREA OF FULL OPENING: 650 sq. ft.

**ADDITIONAL INFORMATION**

NAVD 88 elevations

**TRAFFIC MAINTENANCE NOTES**


1. MAINTAIN TWO-WAY TRAFFIC ON A TEMPORARY BRIDGE.
2. TRAFFIC SIGNALS ARE NOT NECESSARY.
3. SIDEWALKS ARE NOT NECESSARY
4. THE APPROACHES FOR THE TEMPORARY BRIDGE SHALL BE PAVED.

**DESIGN VALUES**

1. DESIGN LIVE LOAD	HL-93
2. FUTURE PAVEMENT	dp: 3.0 INCH
3. DESIGN SPAN	L: 119.00 FT
4. MIN. MID-SPAN POS. CAMBER @ RELEASE (PRESTRESSED UNITS)	Δ: ---
5. PRESTRESSING STRAND	fy: ---
6. PRESTRESSED CONCRETE STRENGTH	f'c: ---
7. PRESTRESSED CONCRETE RELEASE STRENGTH	f'ci: ---
8. CONCRETE, HIGH PERFORMANCE CLASS AA	f'c: 4.0 KSI
9. CONCRETE, HIGH PERFORMANCE CLASS A	f'c: 4.0 KSI
10. CONCRETE, HIGH PERFORMANCE CLASS B	f'c: 3.5 KSI
11. CONCRETE, CLASS C	f'c: 3.0 KSI
12. REINFORCING STEEL	fy: 60 KSI
13. STRUCTURAL STEEL AASHTO M270 (WEATHERING)	fy: 50 KSI
14. SOIL UNIT WEIGHT	γ: 0.140 KCF
15. NOMINAL BEARING RESISTANCE OF SOIL	qn: 4.0 KSF
16. SOIL BEARING RESISTANCE FACTOR (REFER TO AASHTO LRFD)	φ: 0.50
17. NOMINAL BEARING RESISTANCE OF ROCK	qn: 45.0 KSF
18. ROCK BEARING RESISTANCE FACTOR (REFER TO AASHTO LRFD)	φ: 0.45
19. NOMINAL AXIAL PILE RESISTANCE	qp: ---
20. PILE YIELD STRENGTH ASTM A572	fy: ---
21. PILE SIZE	---
22. EST. PILE LENGTH	Lp: ---
23. PILE RESISTANCE FACTOR	φ: ---
24. LATERAL PILE DEFLECTION	Δ: ---
25. BASIC WIND SPEED	V3s: ---
26. MINIMUM GROUND SNOW LOAD	pg: ---
27. SEISMIC DATA	PGA: --- S: --- Sf: ---


PROJECT NAME: **ROYALTON**  
 PROJECT NUMBER: **BRS 0147(13)**

FILE NAME: IBR 281s86e055pi_28.dgn      PLOT DATE: 8/8/2013  
 PROJECT LEADER: C. CARLSON      DRAWN BY: L. BULLOCK  
 DESIGNED BY: D. PETERSON      CHECKED BY: D. PETERSON  
**BRIDGE 28 PRELIMINARY INFORMATION**      SHEET **87** OF **186**

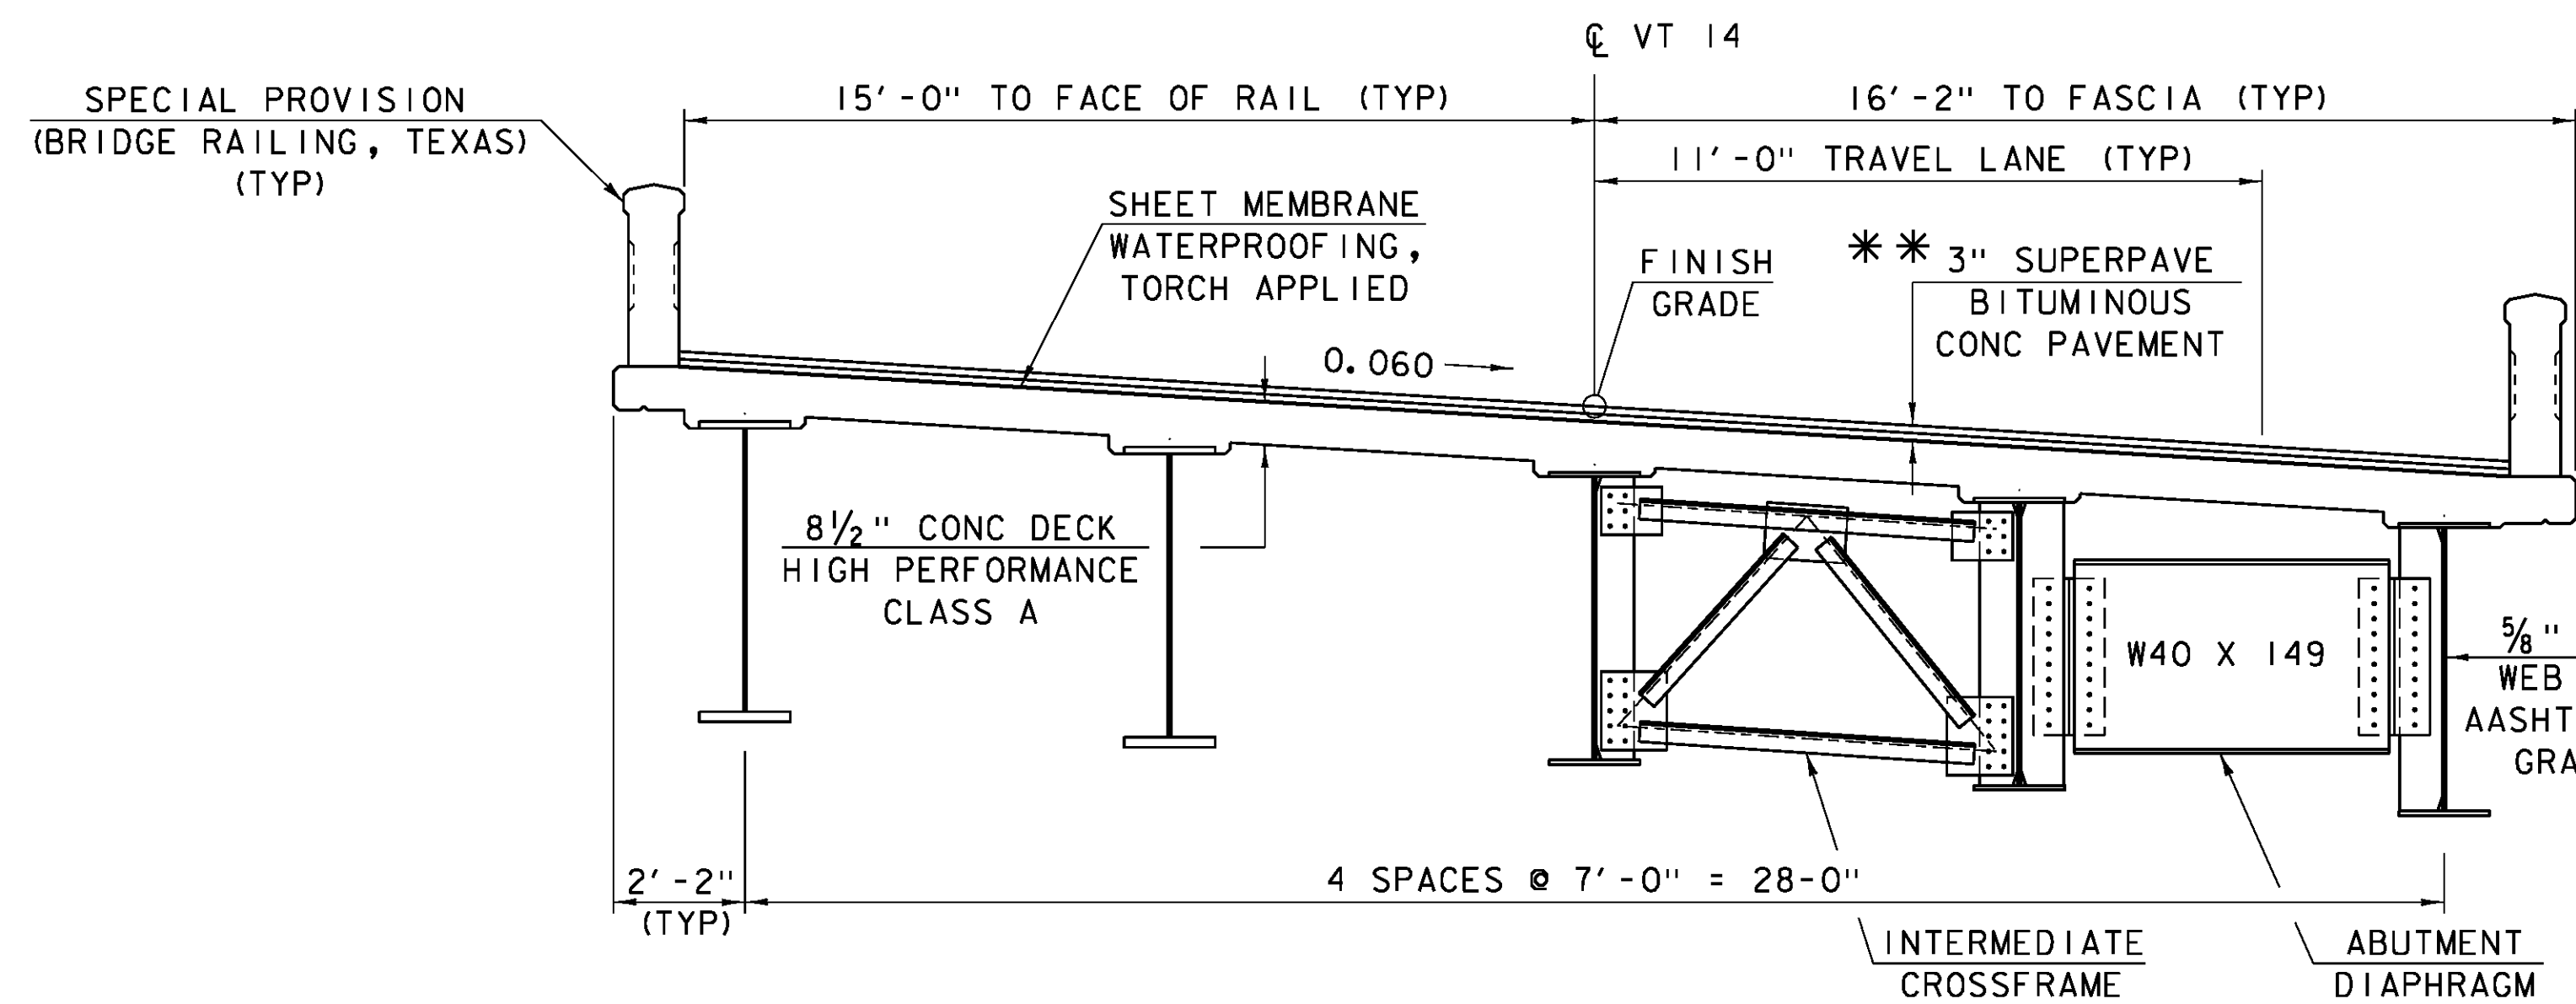

**BRIDGE 28 TYPICAL SECTION**


SCALE: 3/8" = 1'-0"

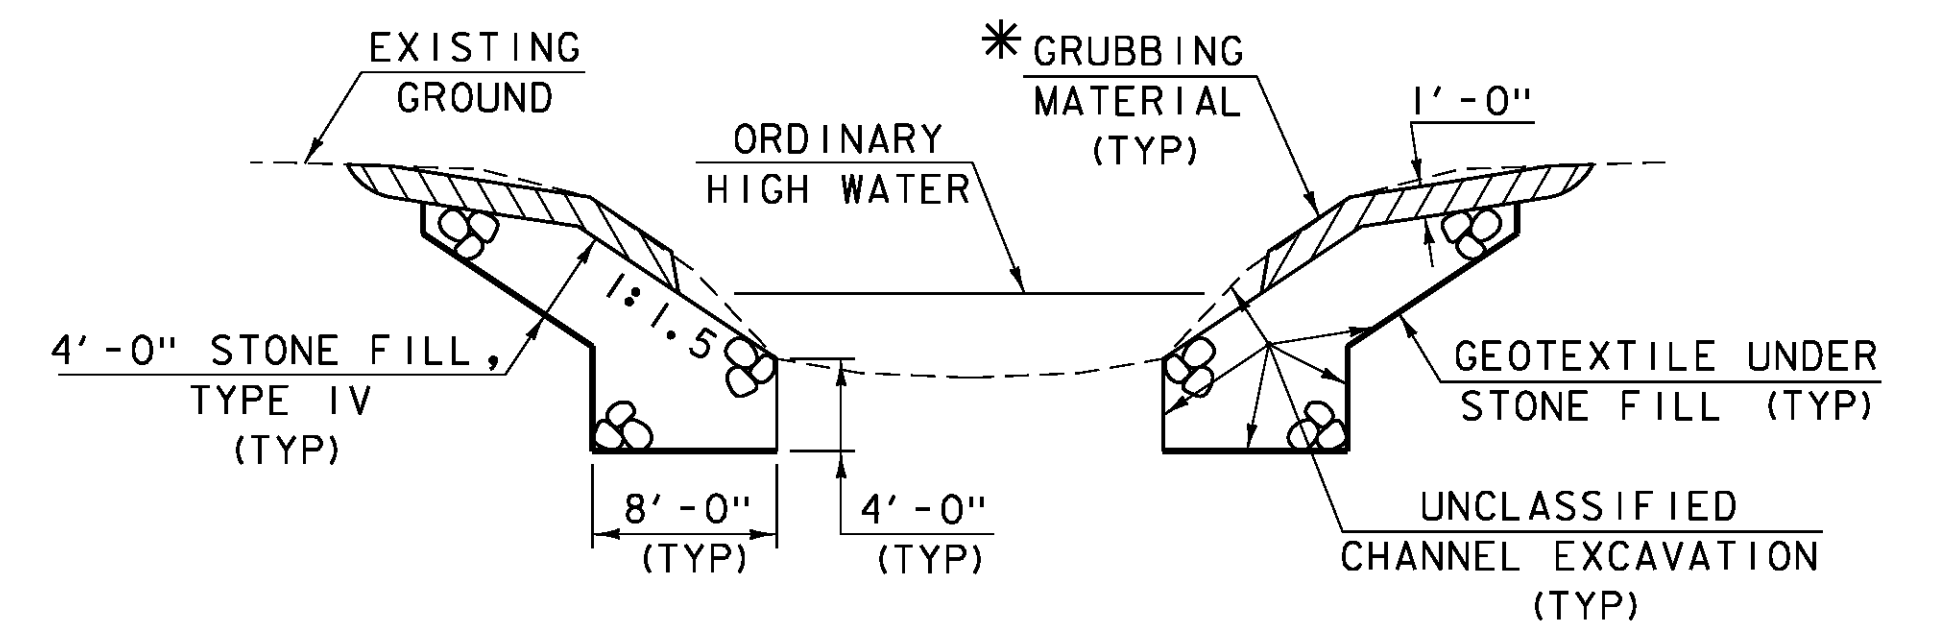

**CHANNEL TYPICAL SECTION**

(NOT TO SCALE)


* GRUBBING MATERIAL SHALL NOT BE PLACED ON THE STONE FILL IN THE AREA UNDER THE BRIDGE. WHENEVER CHANNEL SLOPE INTERSECTS ROADWAY SUBBASE, GRUBBING MATERIAL SHALL BEGIN AT THE BOTTOM OF SUBBASE.

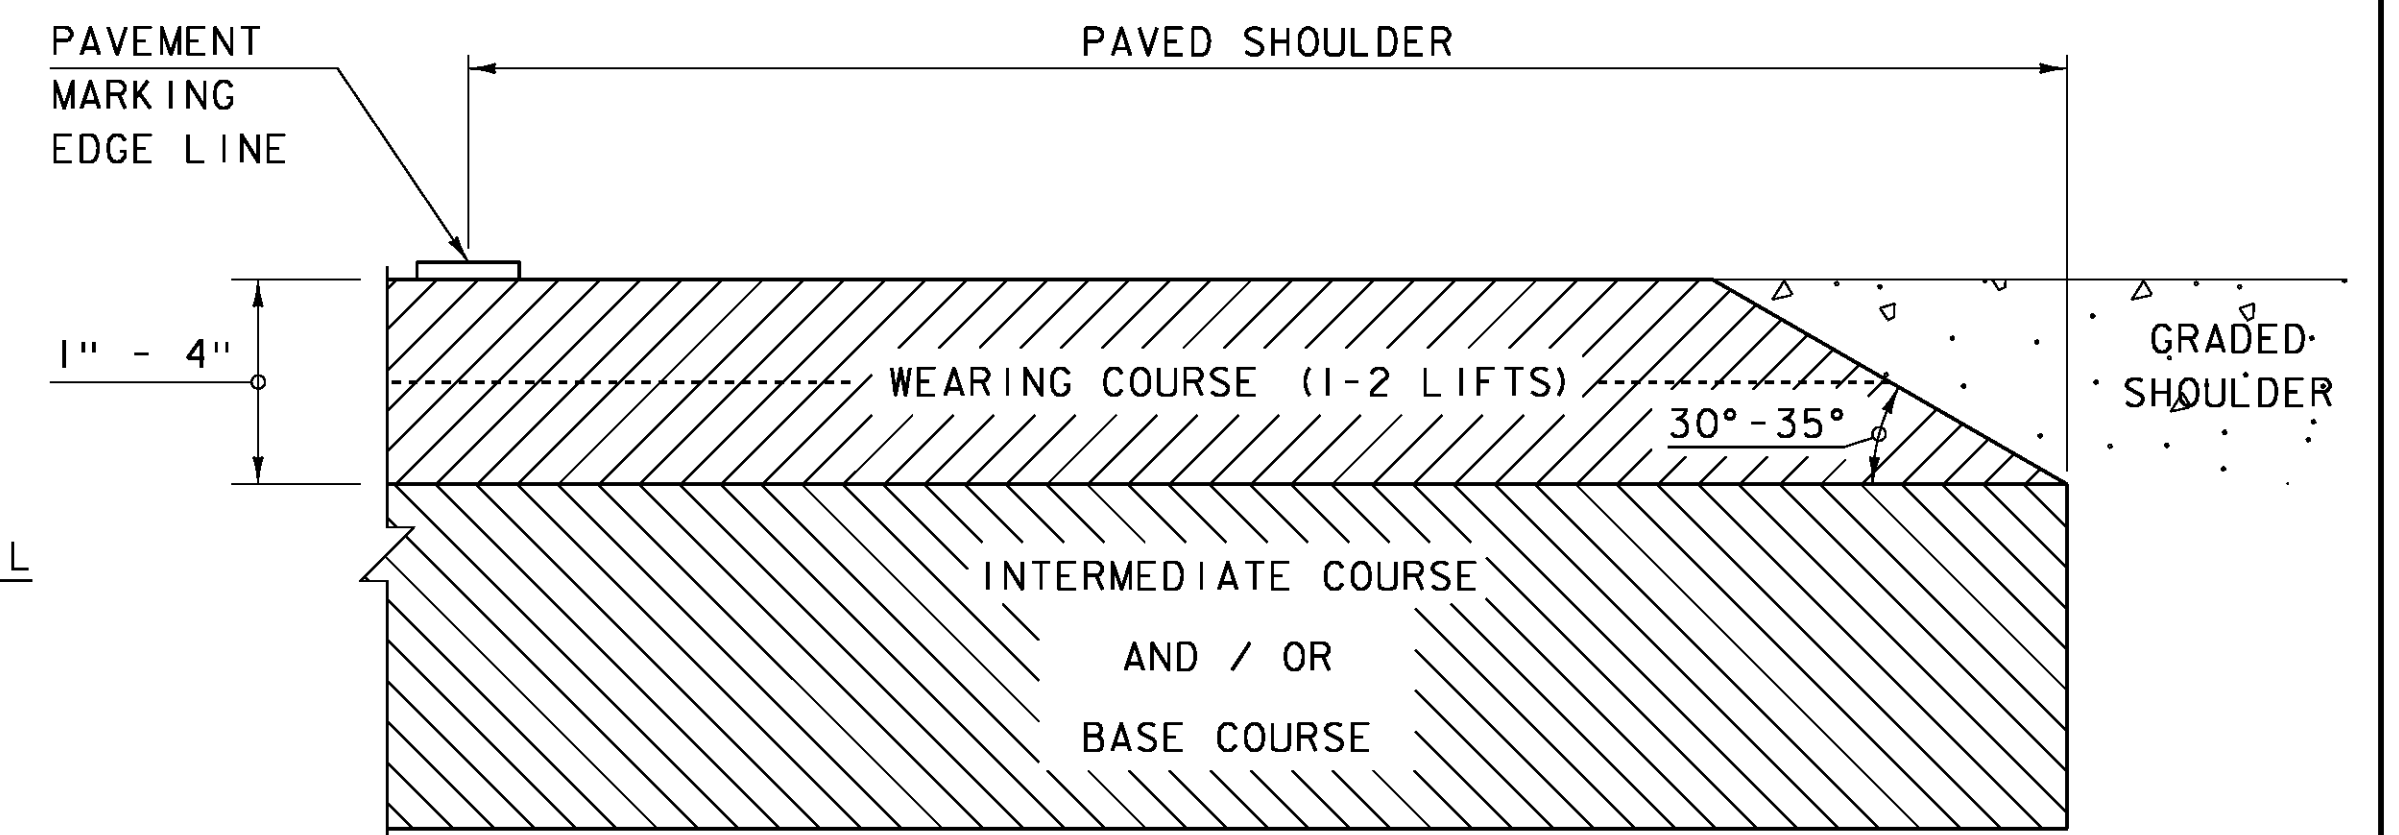

**SAFETY EDGE DETAIL**

NOT TO SCALE

- NOTES:
1. LEVELING COURSE MAY INCLUDE THE "SAFETY EDGE" AT THE CONTRACTOR'S CHOICE.
  2. THE EDGE OF PAVEMENT SHALL BE FORMED IN SUCH A WAY THAT THE BITUMINOUS CONCRETE PAVEMENT IS EXTRUDED OR COMPRESSED TO FORM THE 30 TO 35 DEGREE ANGLE. DEVICES THAT SIMPLY STRIKE-OFF THE MIX WITHOUT PROVIDING ANY COMPACTIVE EFFORT WILL NOT BE ALLOWED.

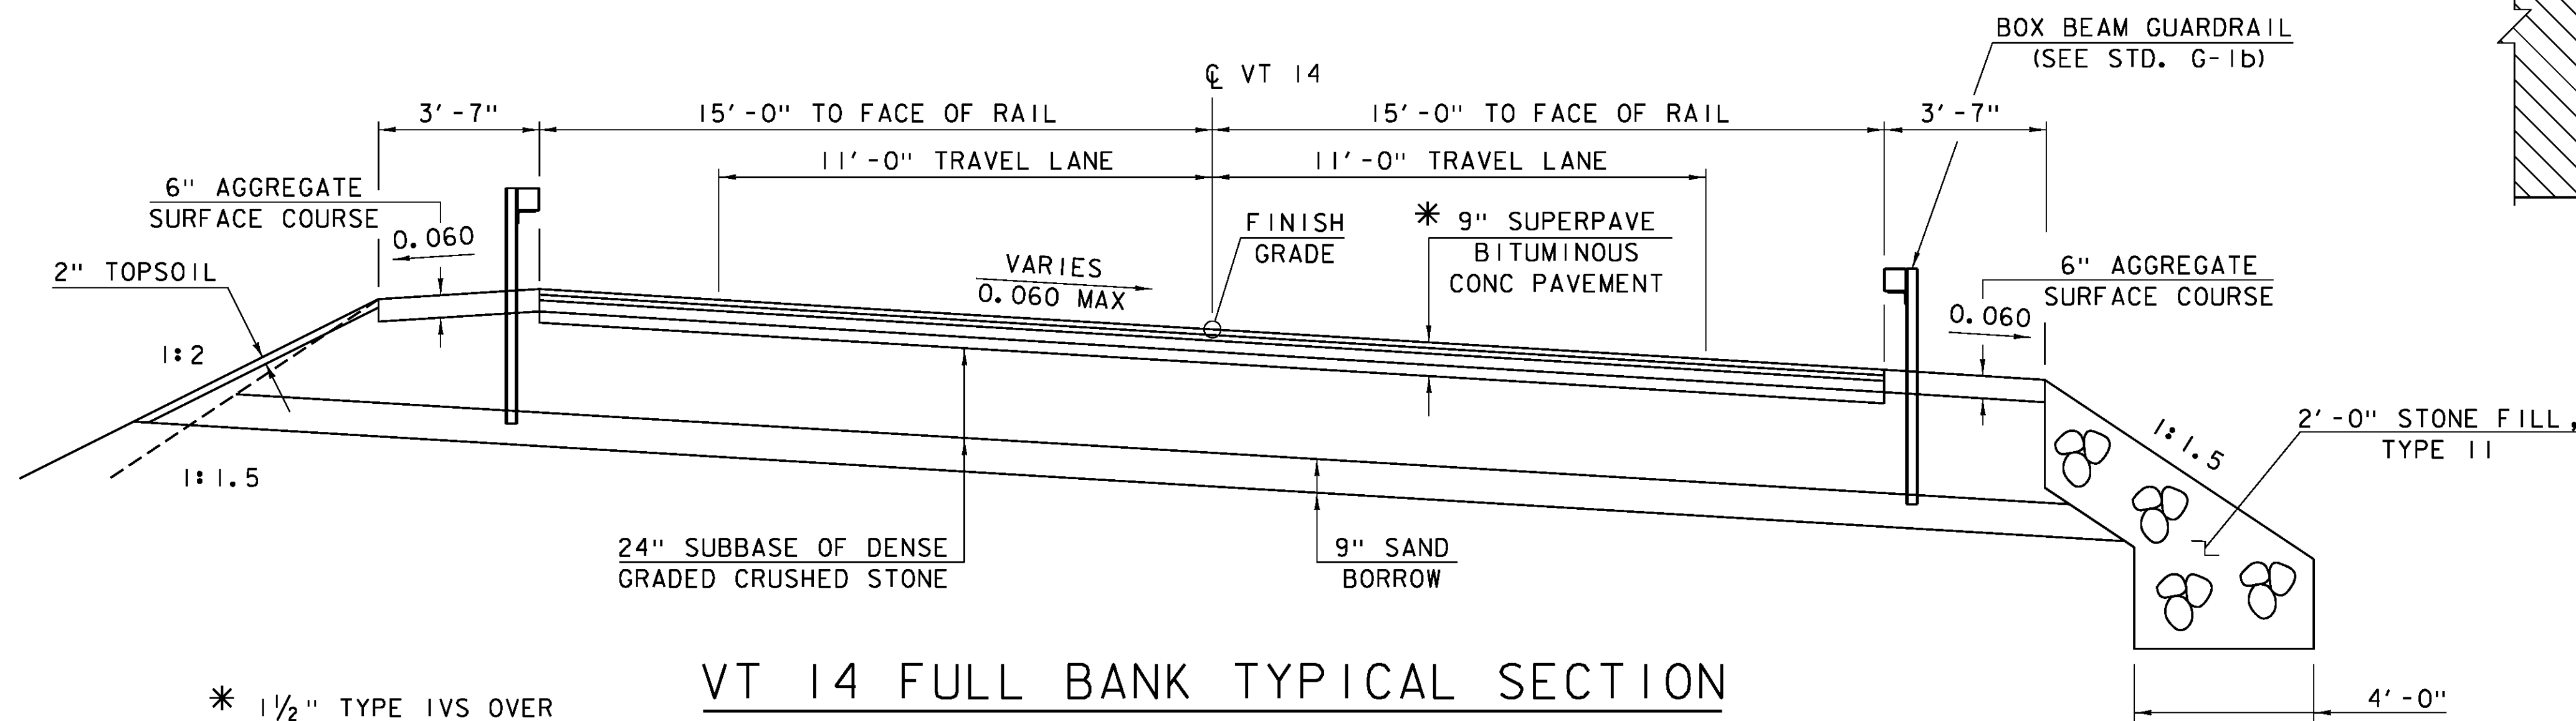

**VT 14 FULL BANK TYPICAL SECTION**


SCALE: 3/8" = 1'-0"

* 1/2" TYPE IVS OVER  
1/2" TYPE IVS OVER  
3" TYPE IIS OVER  
3" TYPE IIS

MATERIAL ITEM	TOLERANCE
PAVEMENT	± 1/4" TOTAL THICKNESS
AGGREGATE SURFACE COURSE	± 1/2"
BASE COURSE	± 1/2"
SUBBASE	± 1"
SAND BORROW	± 1"
GRANULAR BORROW	± 1"

PROJECT NAME: ROYALTON  
 PROJECT NUMBER: BRS 0147 (13)  
 FILE NAME: \BR 28\s86e055+typ.28.dgn PLOT DATE: 08-OCT-2013  
 PROJECT LEADER: C. CARLSON DRAWN BY: G. ROY  
 DESIGNED BY: D. PETERSON CHECKED BY: C. CARLSON  
 BRIDGE 28 PROJECT TYPICAL SECTIONS (1) SHEET 88 OF 186



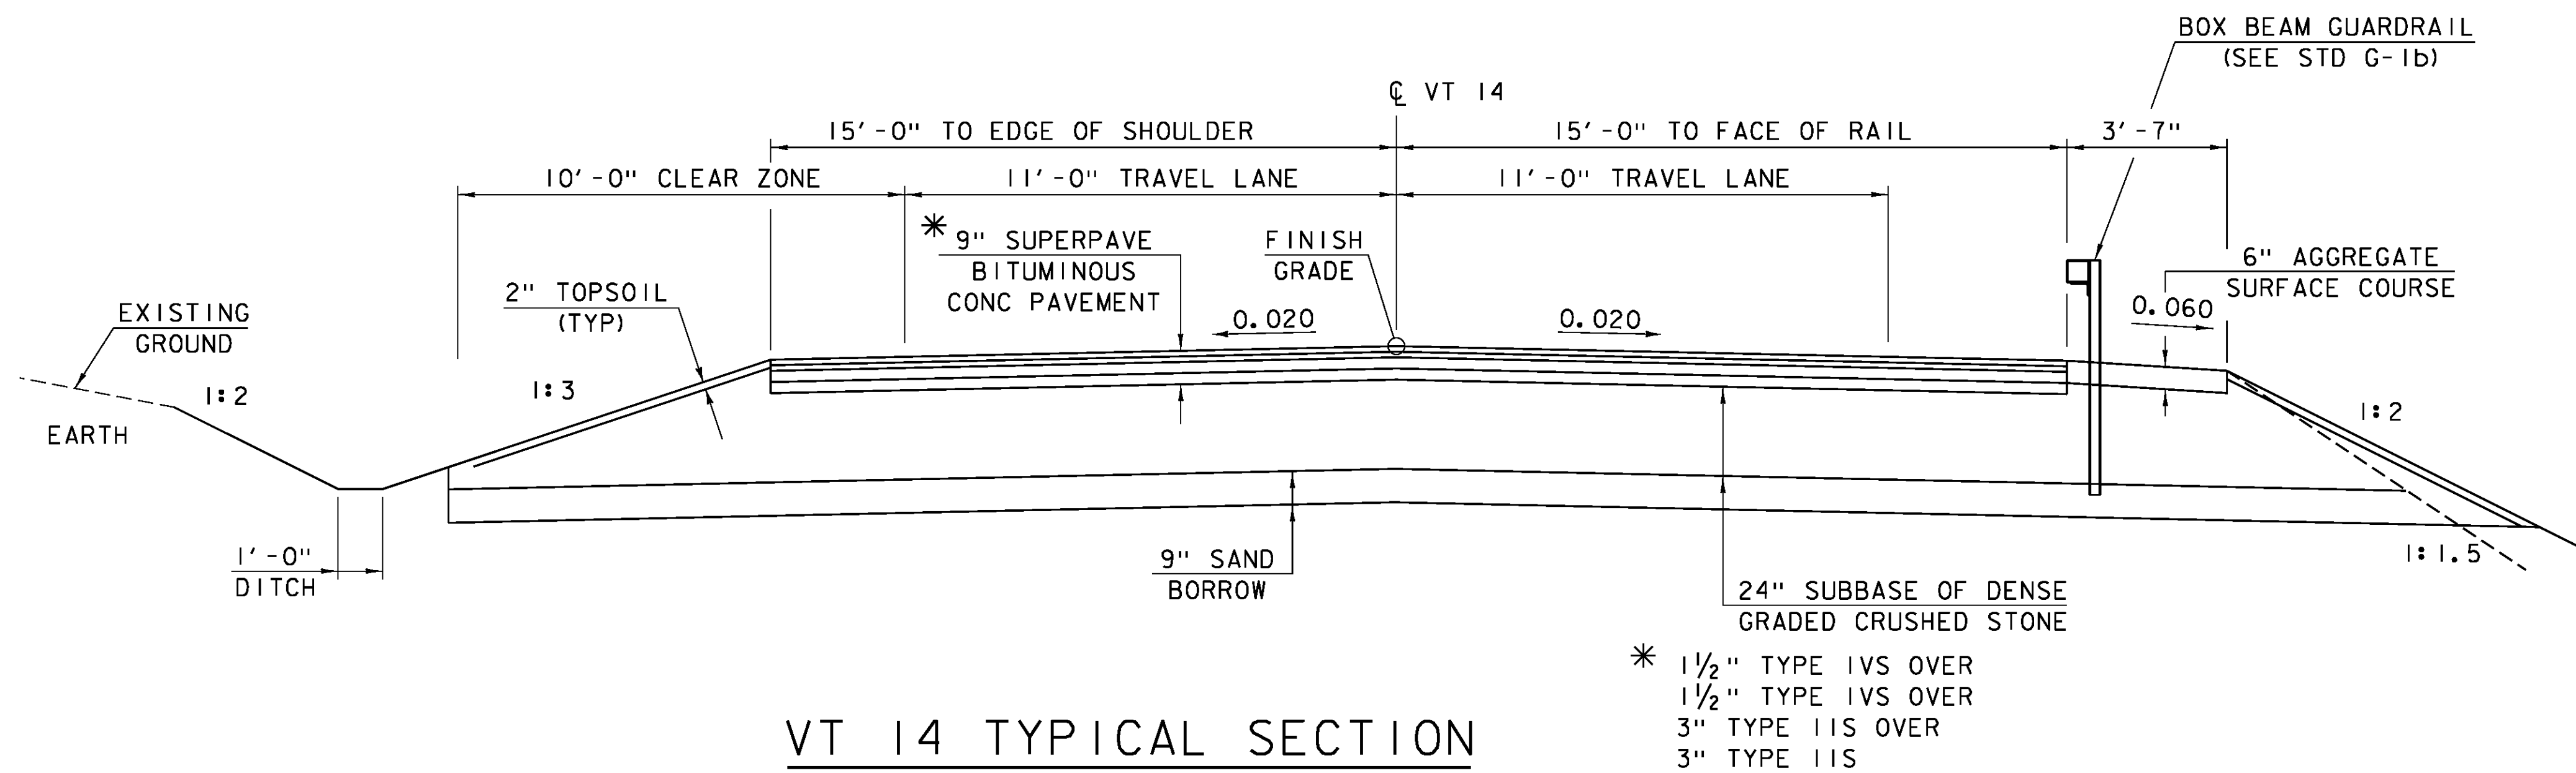


VT 14 TYPICAL SECTION

SCALE: 3/8" = 1'-0"

* 1 1/2" TYPE IVS OVER  
 1 1/2" TYPE IVS OVER  
 3" TYPE IIS OVER  
 3" TYPE IIS

NOTES

1. COFFERDAM LIMITS TO BE DETERMINED BY THE CONTRACTOR.
2. THE PAY LIMITS OF "COFFERDAM EXCAVATION, EARTH" AND "COFFERDAM EXCAVATION, ROCK" SHALL BE 2'-0" OUTSIDE THE PERIMETER OF THE FOOTING, UP TO EXISTING GROUND OR BOTTOM OF SUBBASE, WHICHEVER IS LOWER.
3. IF A COFFERDAM IS CONSTRUCTED WHICH IS LARGER THAN THE INDICATED COFFERDAM EXCAVATION PAY LIMITS, PAYMENT FOR ALL UNCLASSIFIED CHANNEL EXCAVATION, INCLUDING THAT PORTION WHICH IS INSIDE THE COFFERDAM BUT OUTSIDE THE COFFERDAM EXCAVATION PAY LIMITS, WILL BE MADE AT THE CONTRACT UNIT PRICE FOR UNCLASSIFIED CHANNEL EXCAVATION.

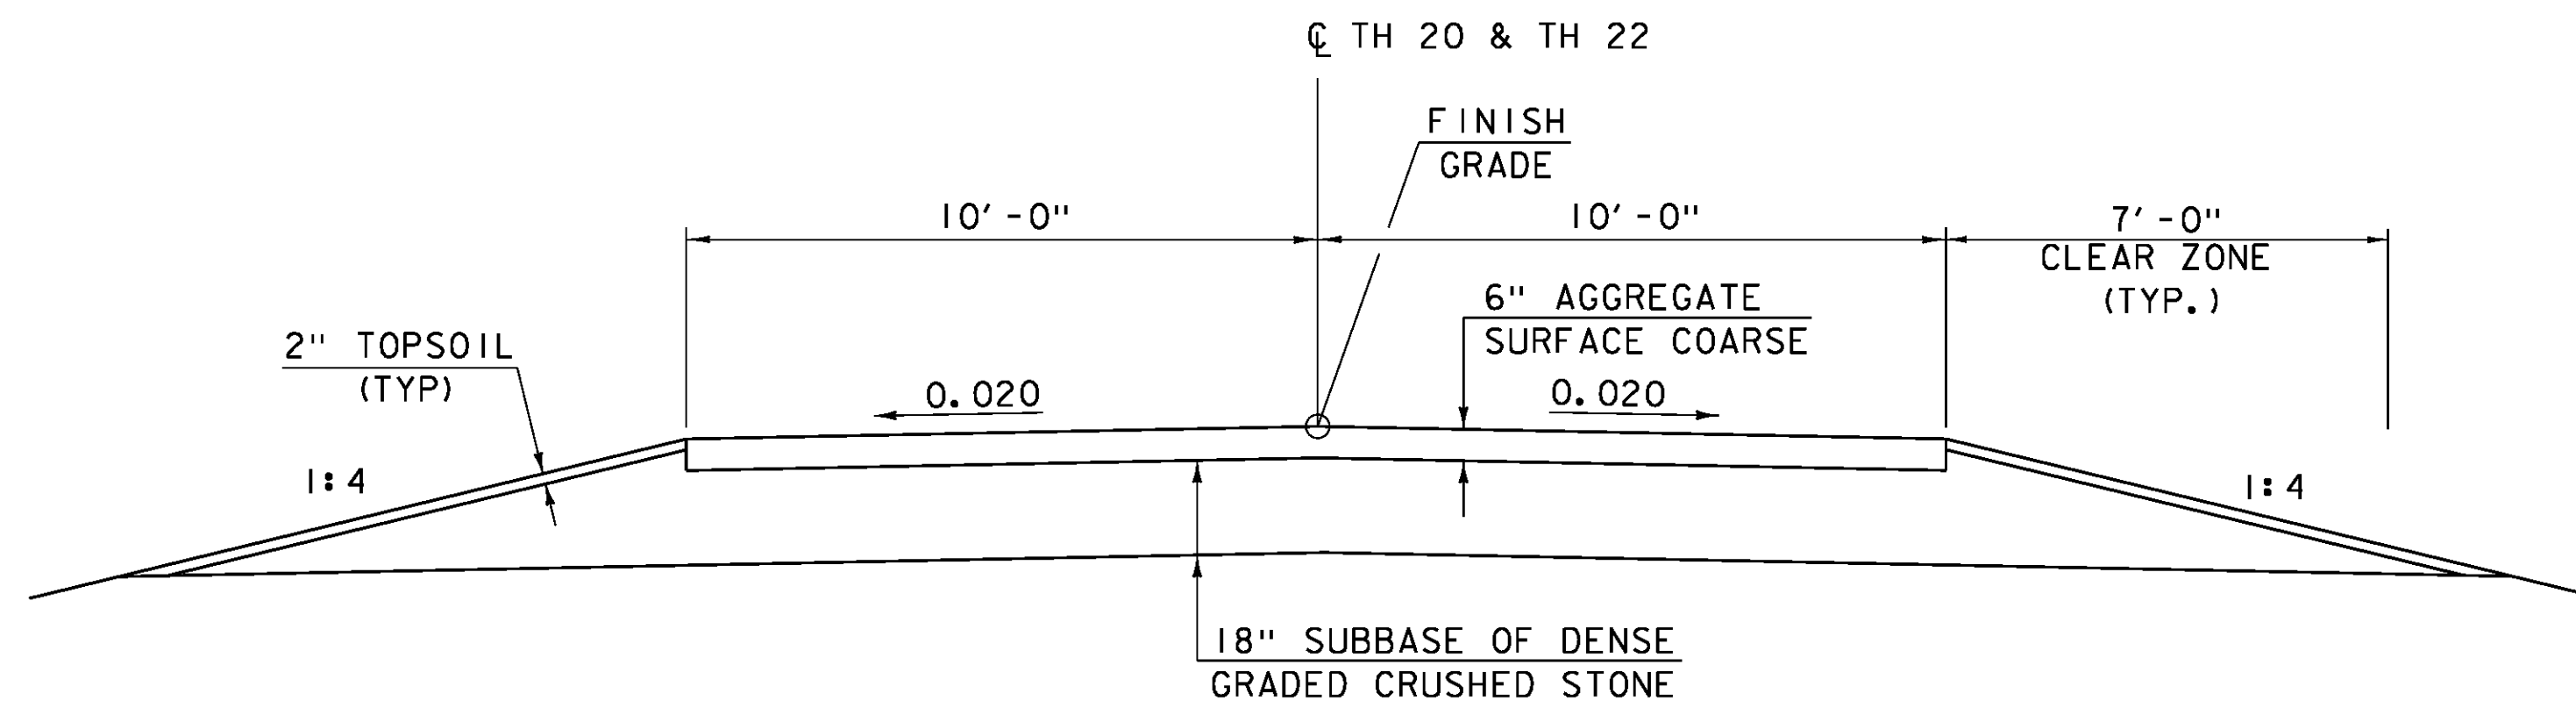


TH 20 TYPICAL SECTION

SCALE: 3/8" = 1'-0"


TH 22 TYPICAL SECTION  
 STA 31+00.00 - STA 31+50.00

SCALE: 3/8" = 1'-0"

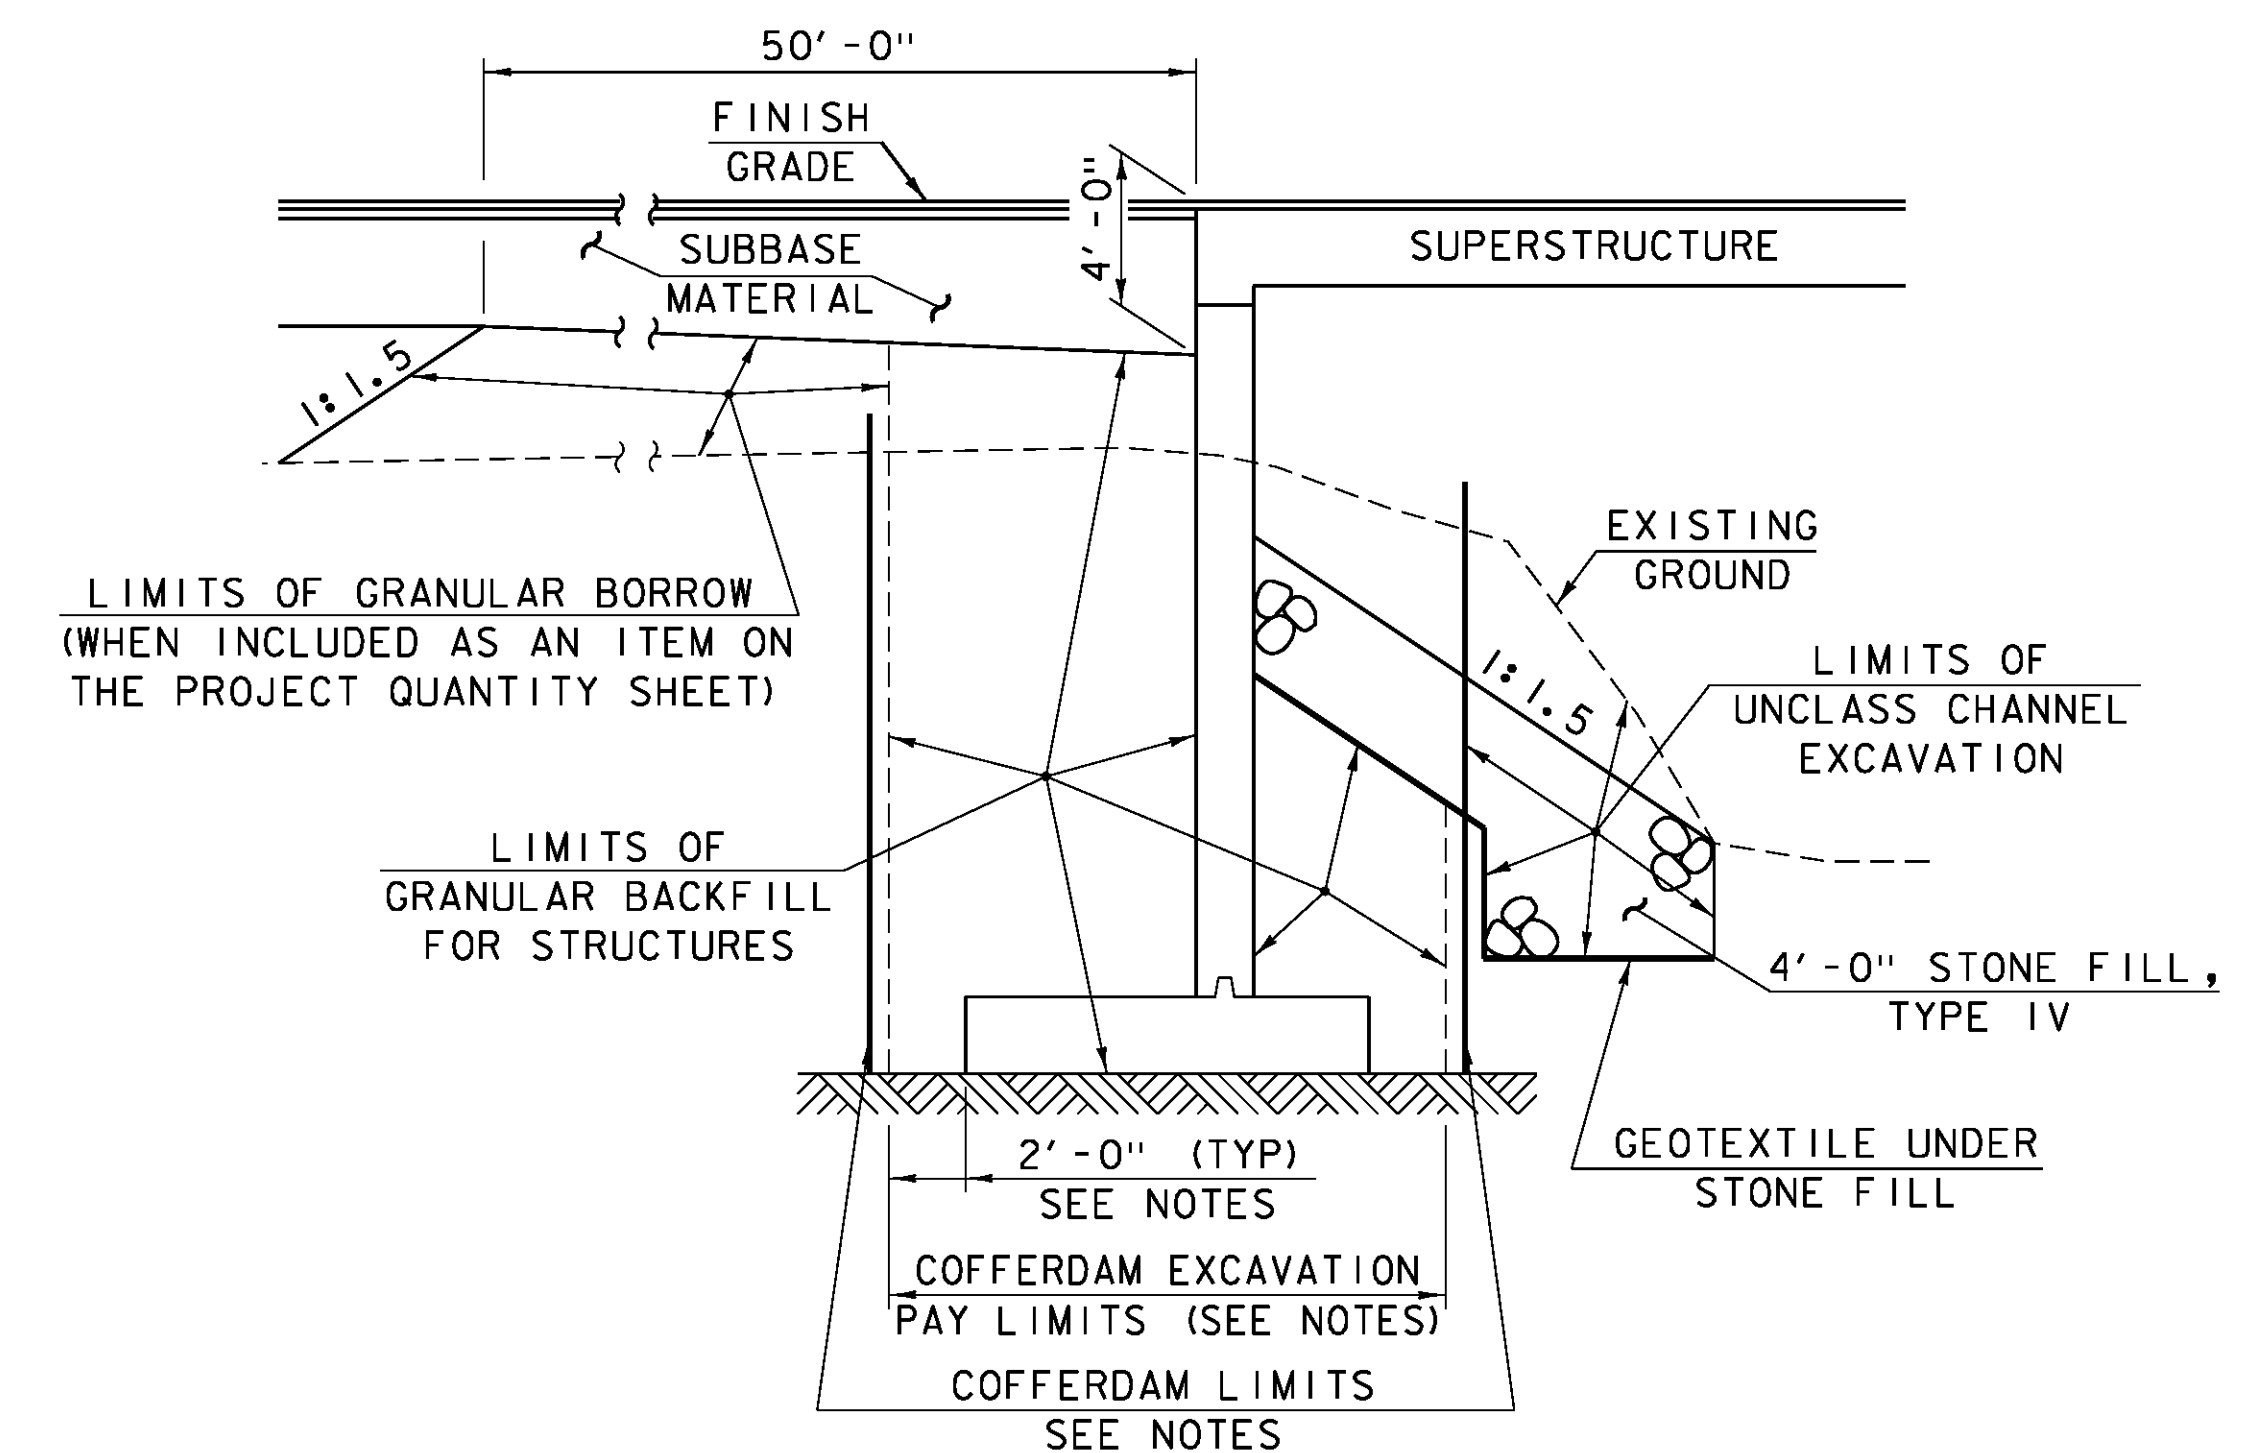

TYPICAL ABUTMENT SECTION

(NOT TO SCALE)

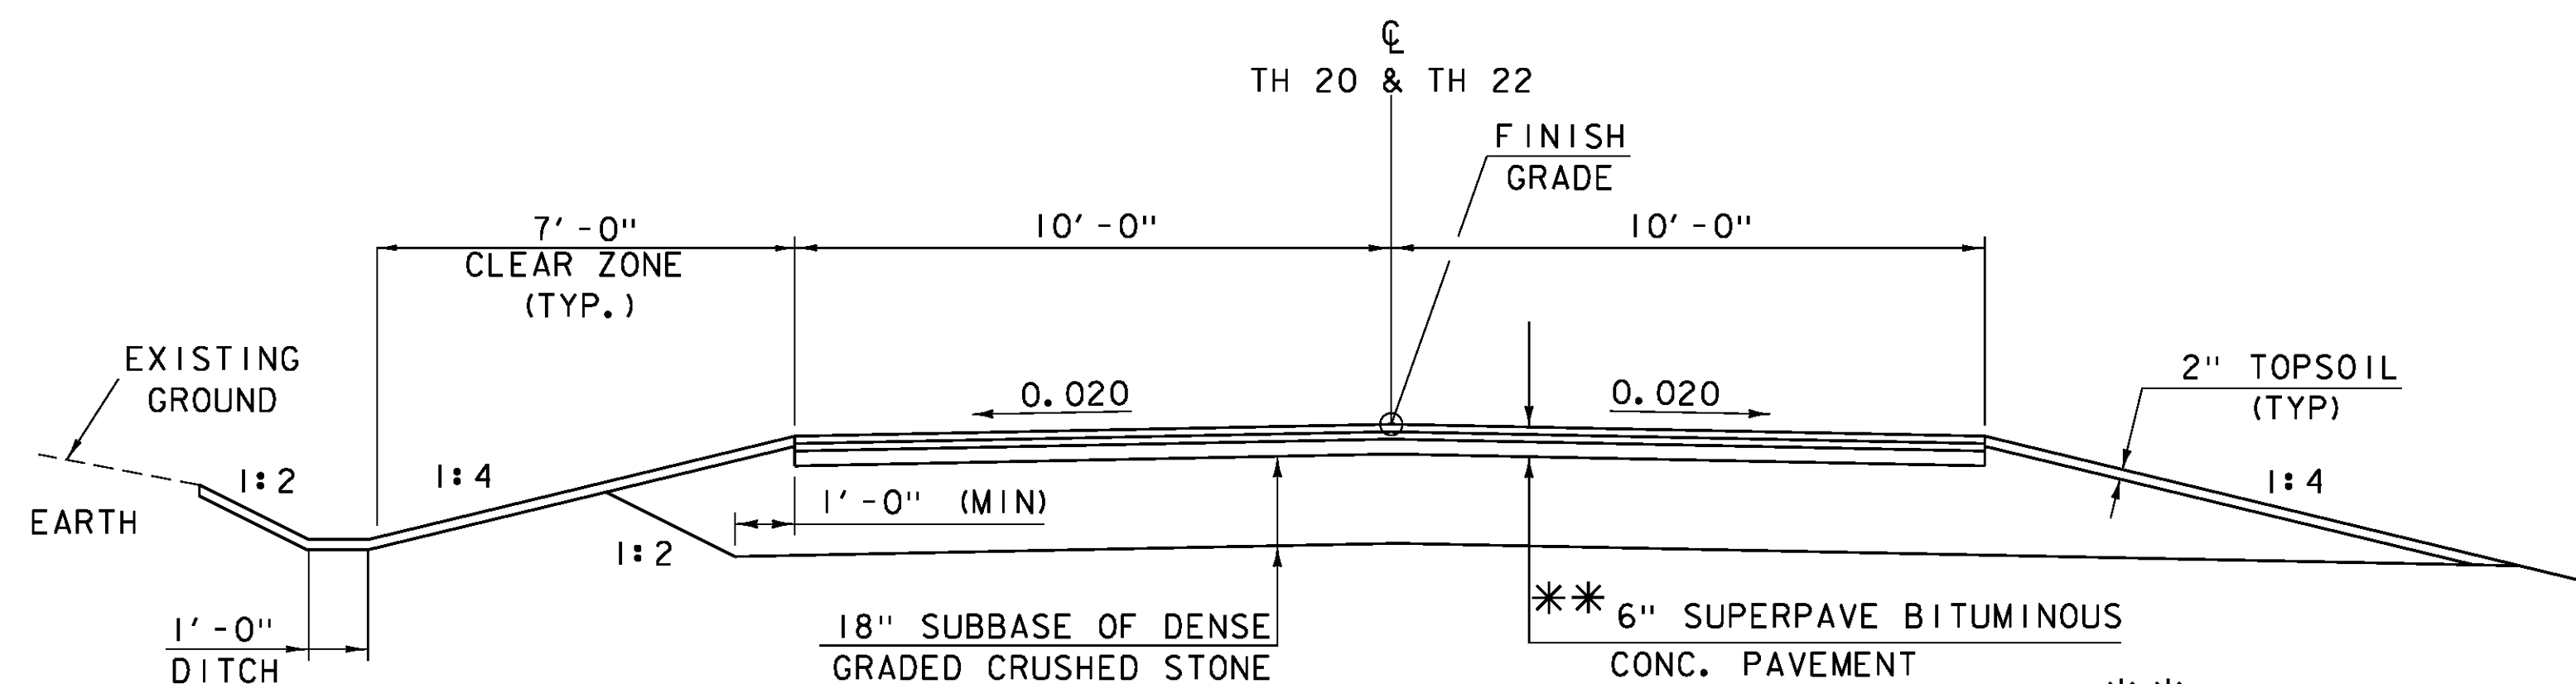

TH 22 TYPICAL SECTION  
 STA 30+15.02 - STA 31+00.00


SCALE: 3/8" = 1'-0"

** 1 1/2" TYPE IVS OVER  
 1 1/2" TYPE IVS OVER  
 3" TYPE IIS


PROJECT NAME: ROYALTON  
 PROJECT NUMBER: BRS 0147 (13)

FILE NAME: \BR 28\86e055typ.28.dgn PLOT DATE: 28-OCT-2013  
 PROJECT LEADER: C. CARLSON DRAWN BY: G. ROY  
 DESIGNED BY: D. PETERSON CHECKED BY: C. CARLSON  
 BRIDGE 28 PROJECT TYPICAL SECTIONS ( 2 ) SHEET 89 OF 186


	SECTIONS 417+00 - 417+75	SECTION 418+00
MINIMUM GEOGRID ULTIMATE TENSILE STRENGTH	3050 lb/ft	3050 lb/ft
NUMBER OF REINFORCEMENT LAYERS	10	7
LENGTHS OF PRIMARY REINFORCEMENT	THREE - 20 FT THREE - 12 FT FOUR - 6 FT	THREE - 12 FT FOUR - 6 FT
VERTICAL SPACING OF PRIMARY REINFORCEMENT	1.5 FT	1.5 FT
LENGTH OF SECONDARY REINFORCEMENT	4 FT	4 FT
VERTICAL SPACING OF SECONDARY REINFORCEMENT	1.5 FT	1.5 FT
TOP REINFORCEMENT ELEVATION (NOT INCLUDING RE-IMBEDMENT HEIGHT)	522.5 FT	522.5 FT

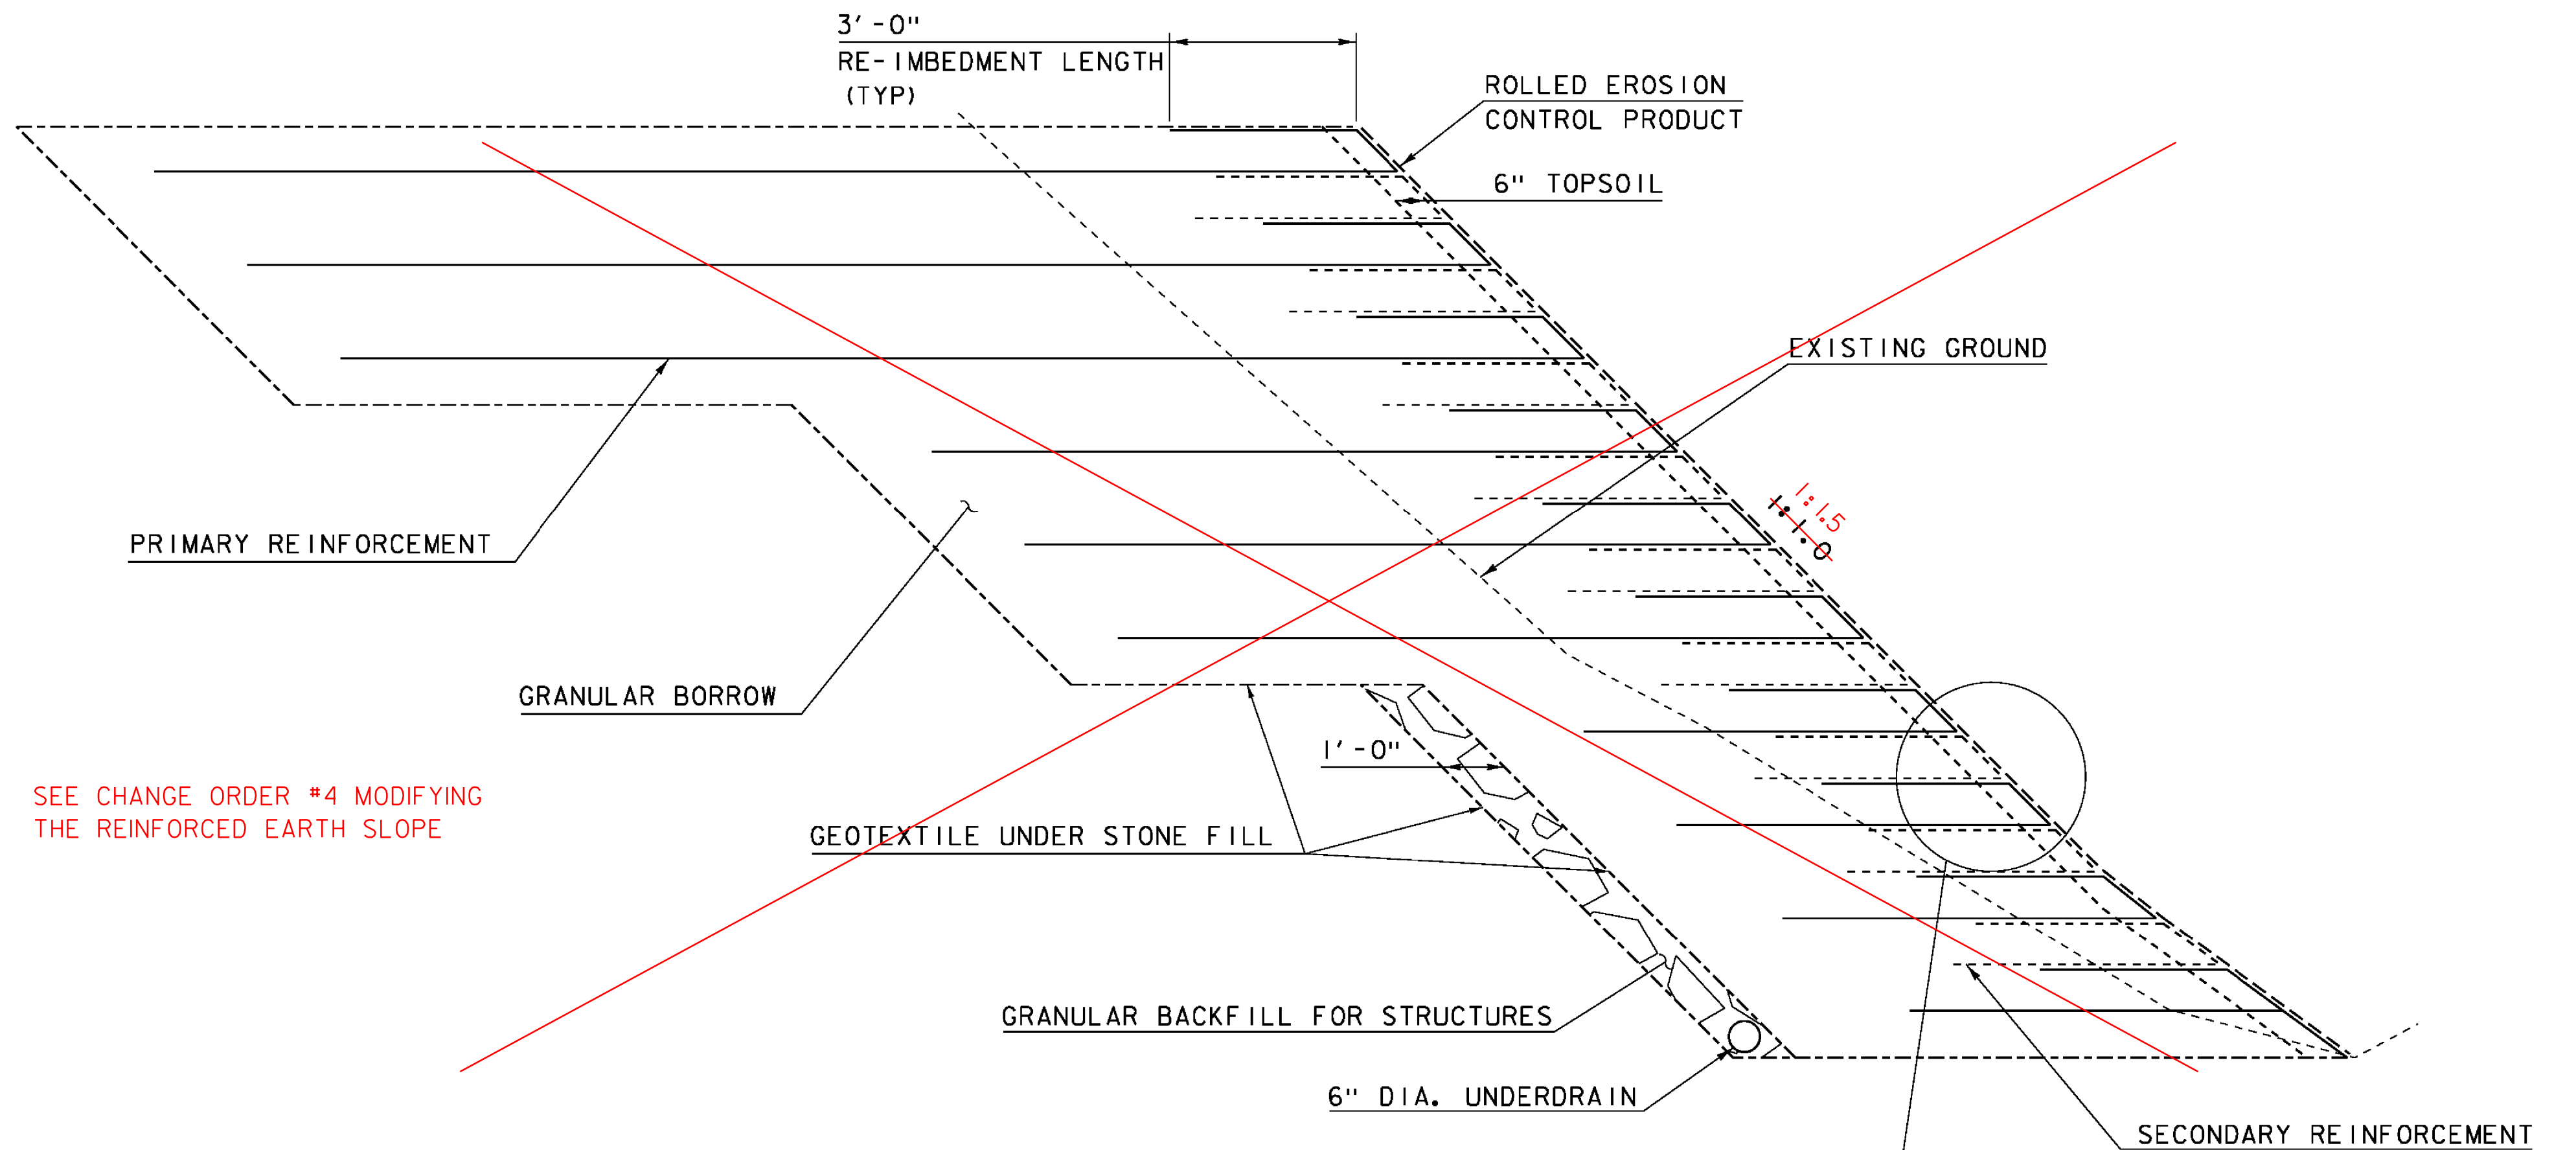

REINFORCED SOIL SLOPE TYPICAL  
SECTIONS 417+00 TO 417+75

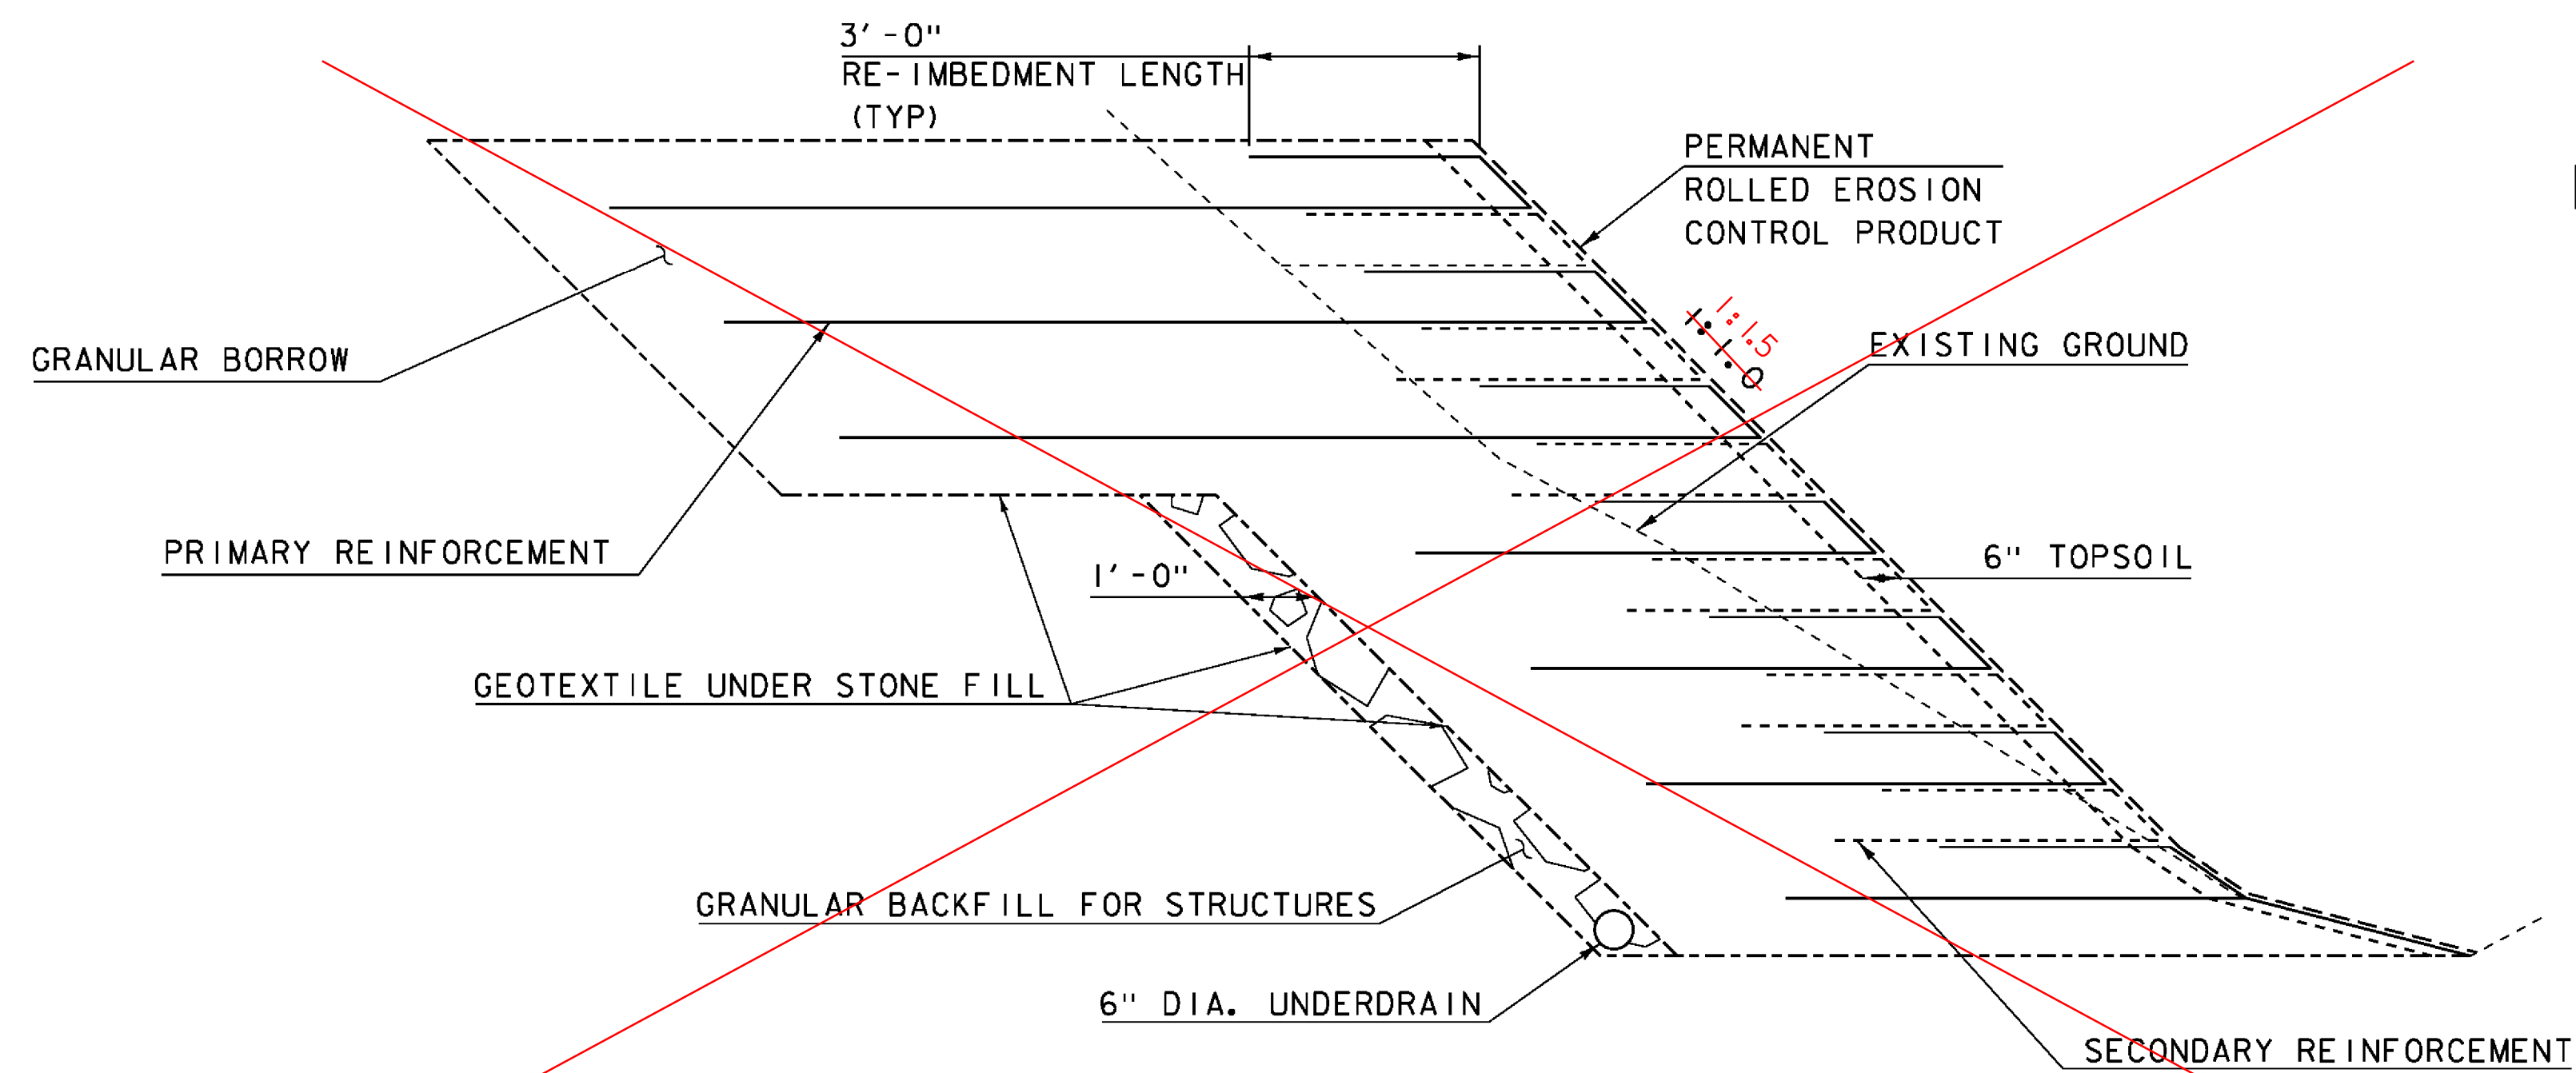

REINFORCED SOIL SLOPE TYPICAL  
SECTION 418+00

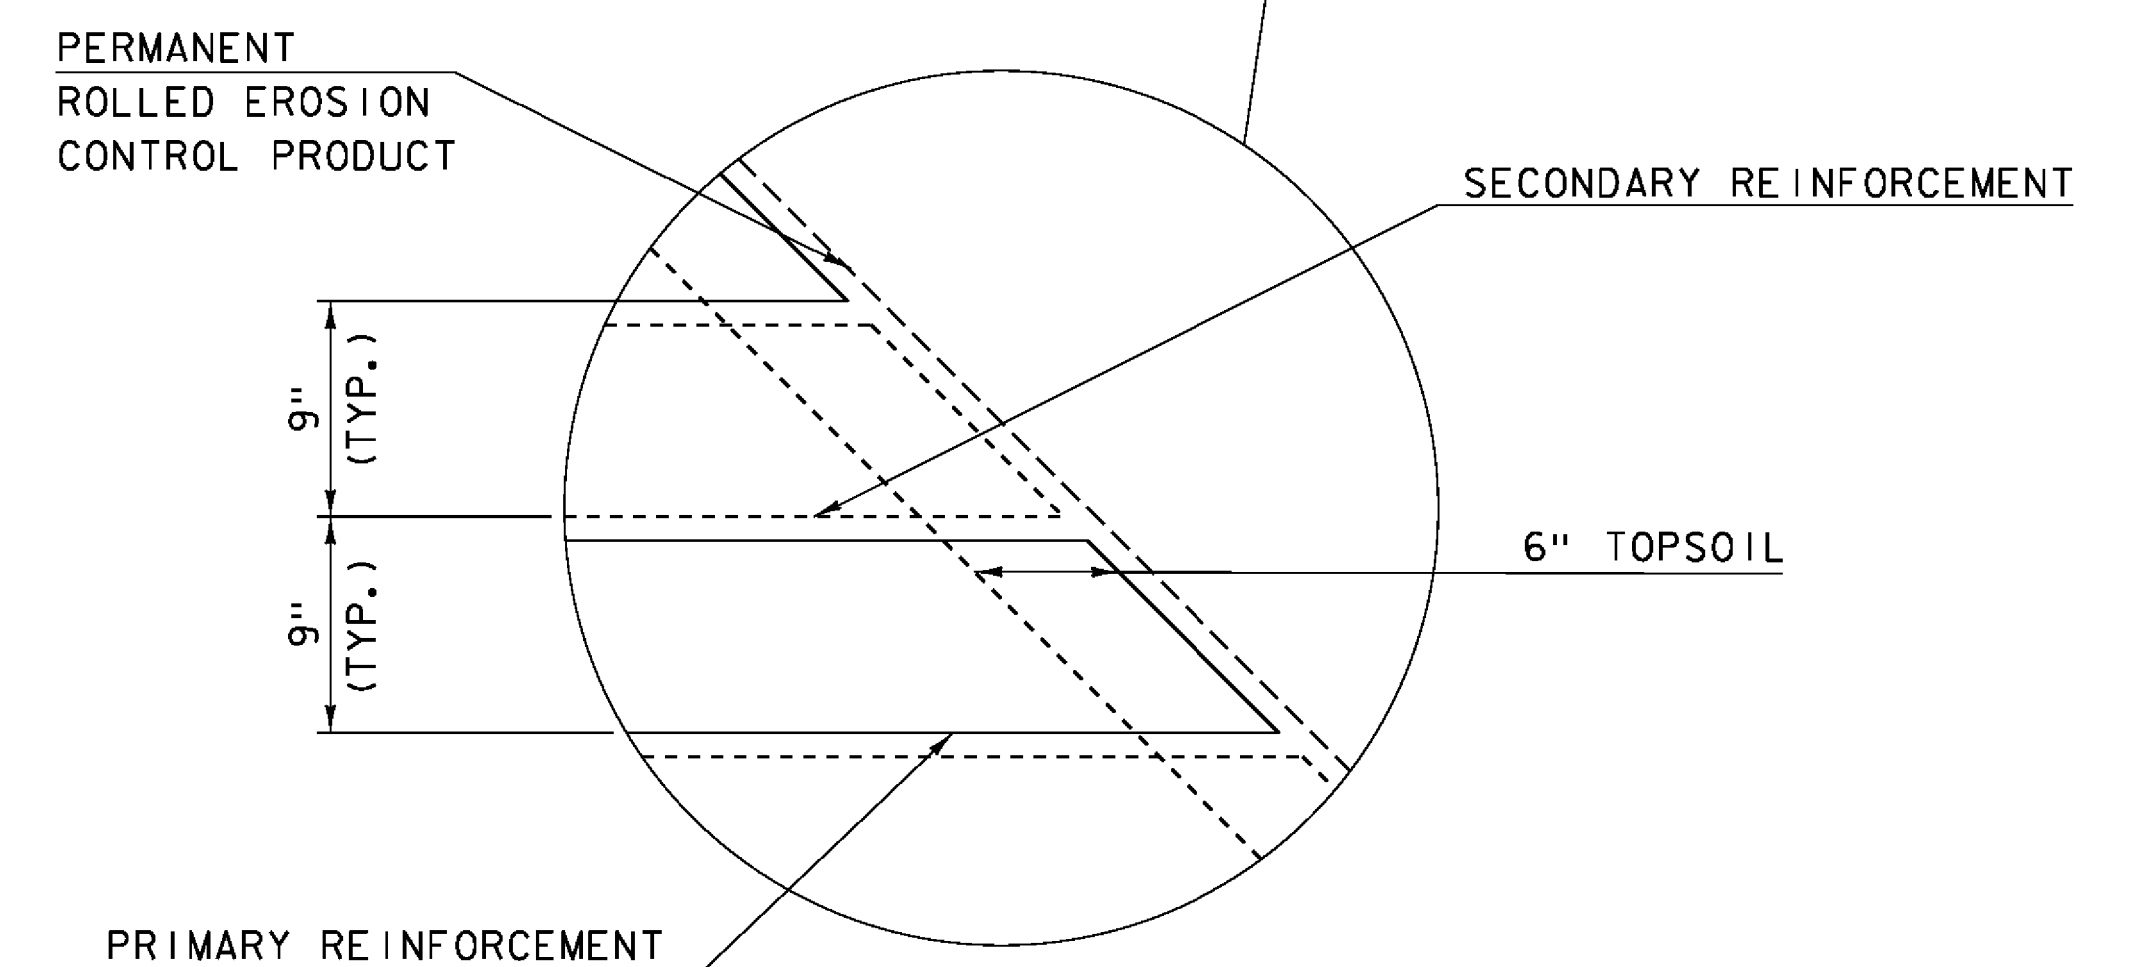

PROJECT NAME: ROYALTON  
PROJECT NUMBER: BRS 0147 (13)

FILE NAME: \BR 28\86e055typ.28.dgn PLOT DATE: 08-OCT-2013  
PROJECT LEADER: C. CARLSON DRAWN BY: D. PETERSON  
DESIGNED BY: D. PETERSON CHECKED BY: C. CARLSON  
BRIDGE 28 PROJECT TYPICAL SECTIONS (3) SHEET 90 OF 186

GPS CONTROL POINTS

**HVCTRL #1**

STANDARD DISK STAMPED  
Spaulding Az Mk  
N = 490047.972  
E = 1616877.024  
ELEV. = 655.248

GENERAL LOCATION, ROYALTON, VT. OWNERSHIP, GEORGE AND AGNES SPAULDING, 7783 VT RTE 14, SOUTH ROYALTON, VT 05068. TO REACH FROM THE INTERSECTION OF VT ROUTE 14 AND VT ROUTE 107 IN NORTH ROYALTON GO NORTH ALONG VT ROUTE 14 FOR 2.0 MI (3.2 KM) TO THE INTERSECTION OF MORSE ROAD (TH 20) STRAIGHT, WATERMAN ROAD (TH 22) LEFT, AND VT ROUTE 14 RIGHT. TURN LEFT AND GO SOUTHWEST AND SOUTH ALONG WATERMAN ROAD FOR 0.3 MI (0.5 KM) TO A GATE IN A WIRE FENCE LINE AND THE SITE OF THE MARK ON THE LEFT IN A FIELD. THE MARK IS SET FLUSH WITH GROUND SURFACE IN THE TOP OF A LOW LYING ROCK OUTCROP. IT IS 9.8 M (32.2 FT) EAST OF AND ABOUT 0.2 M (0.7 FT) LOWER THAN THE CENTERLINE OF WATERMAN ROAD, 25.6 M (84.0 FT) NORTH NORTHEAST OF A 25 CM TRIPLE TRUNK APPLE, 5.5 M (18.0 FT) NORTHEAST OF THE MOST NORTHERLY GATE POST, AND 5.2 M (17.1 FT) EAST OF THE WIRE FENCE AND A FIBERGLASS WITNESS POST.






• DESCRIPTION PROVIDED BY VERMONT AGENCY OF TRANSPORTATION GEODETIC SURVEY UNIT

**HVCTRL #2**

STANDARD DISK STAMPED  
Spaulding  
N = 488849.386  
E = 1617960.788  
ELEV. = 502.952


GENERAL LOCATION, ROYALTON, VT. -OWNERSHIP, GEORGE AND AGNES SPAULDING, 7783 VT RTE 14, SOUTH ROYALTON, VT 05068. TO REACH FROM THE INTERSECTION OF VT ROUTE 14 AND VT ROUTE 107 IN NORTH ROYALTON GO NORTH ALONG VT ROUTE 14 FOR 1.5 MI (2.4 KM) TO THE SITE OF THE MARK ON THE LEFT. IT IS ABOUT 95 M (311.7 FT) SOUTH OF THE SOUTH END OF A CONCRETE BRIDGE OVER THE SECOND BRANCH OF THE WHITE RIVER. THE MARK IS SET ABOUT 0.3 M (1.0 FT) ABOVE GROUND SURFACE IN THE TOP OF A MASSIVE ROCK OUTCROP. IT IS 15.5 M (50.9 FT) WEST NORTHWEST OF AND ABOUT 2.5 M (8.2 FT) LOWER THAN THE CENTERLINE OF VT ROUTE 14, 11.2 M (36.7 FT) NORTH NORTHEAST OF A 10 CM PINE, 3.9 M (12.8 FT) NORTH OF A GUY ANCHOR, AND 4.7 M (15.4 FT) WEST OF POLE NO 42 AND A FIBERGLASS WITNESS POST.

TRAVERSE TIES

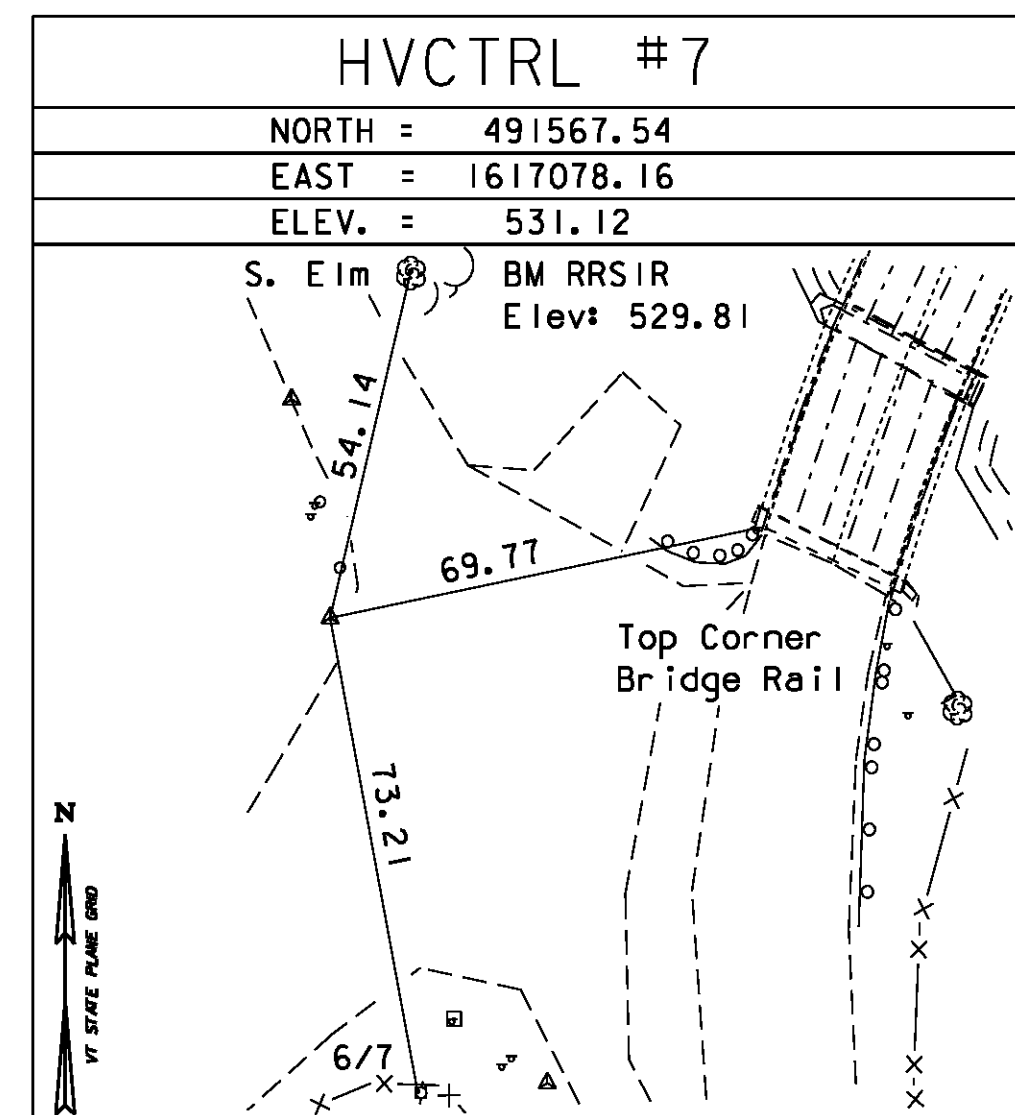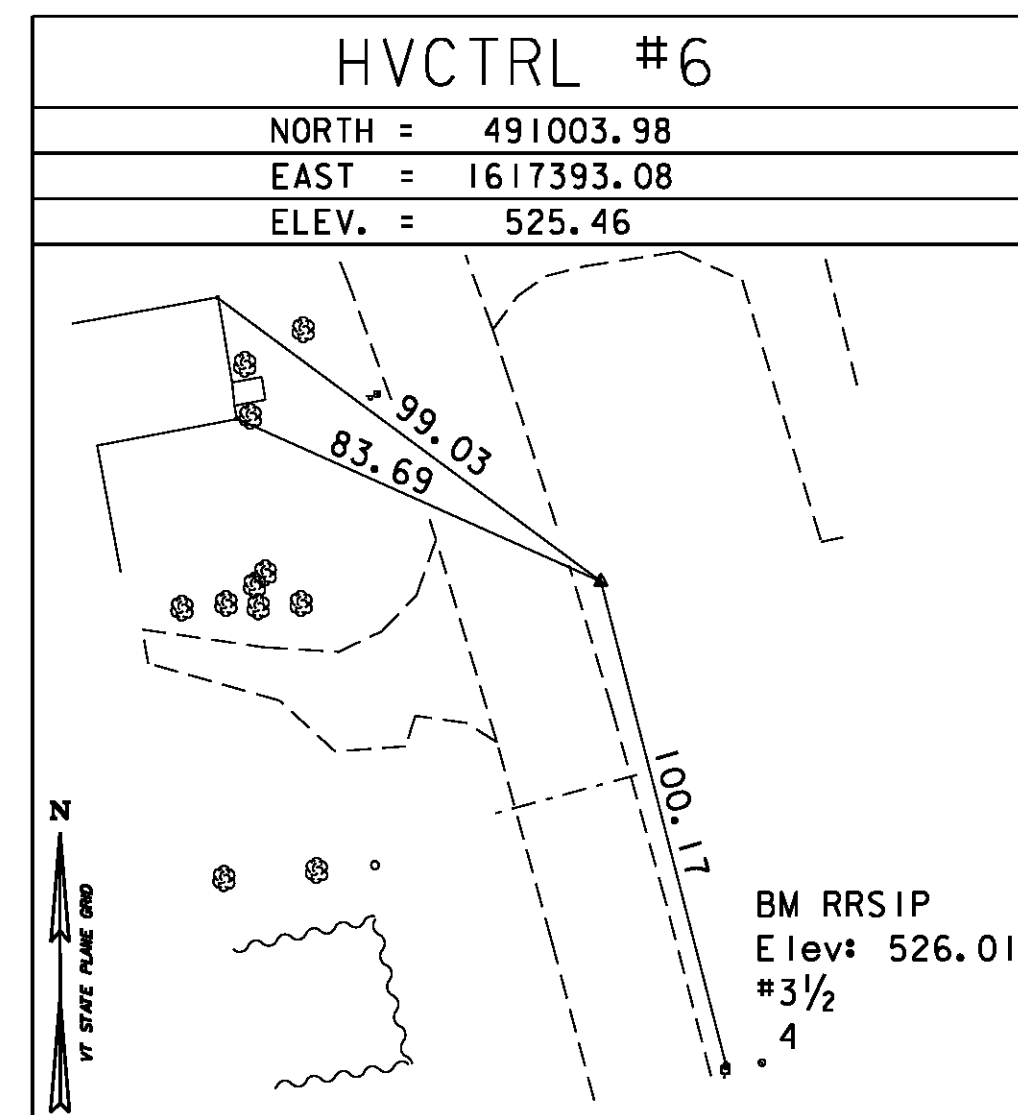
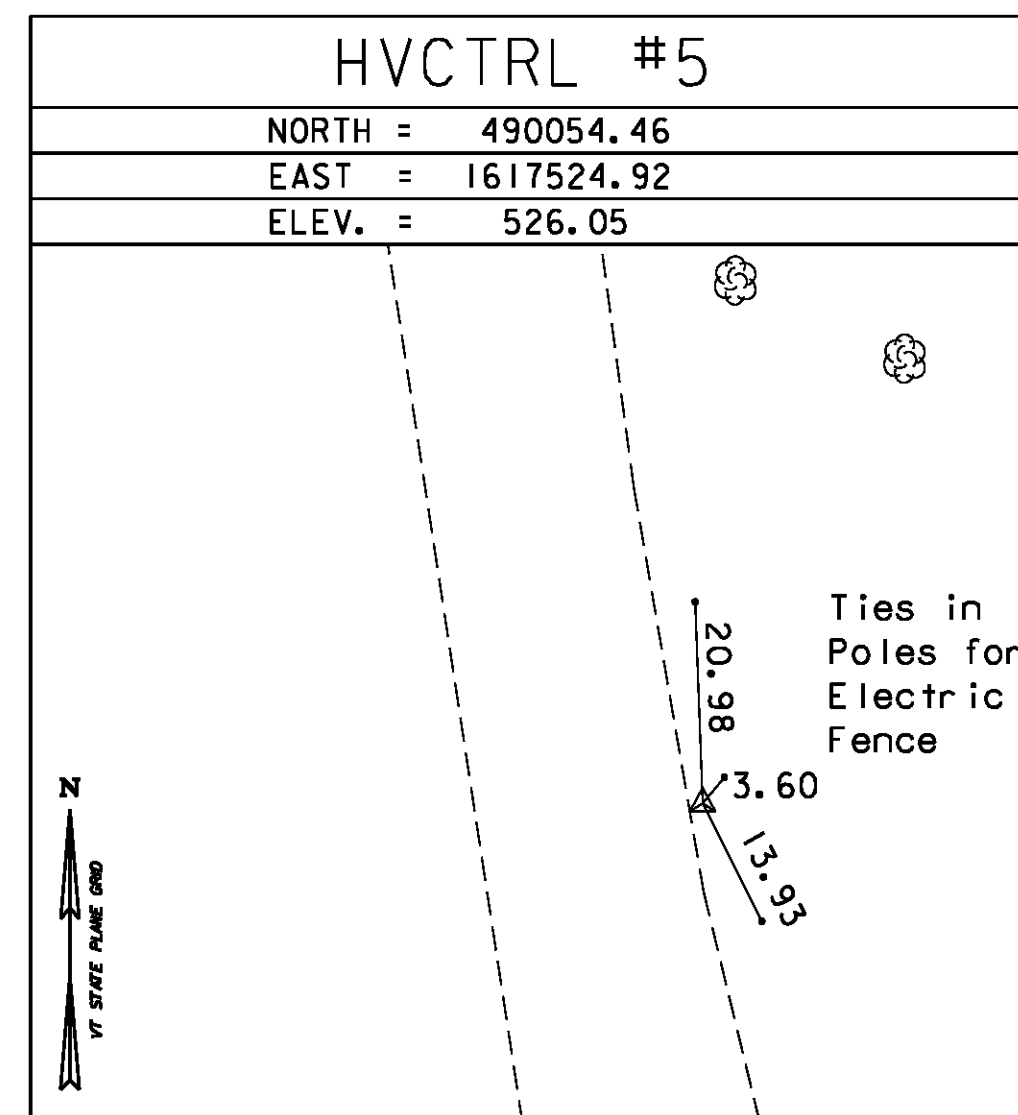
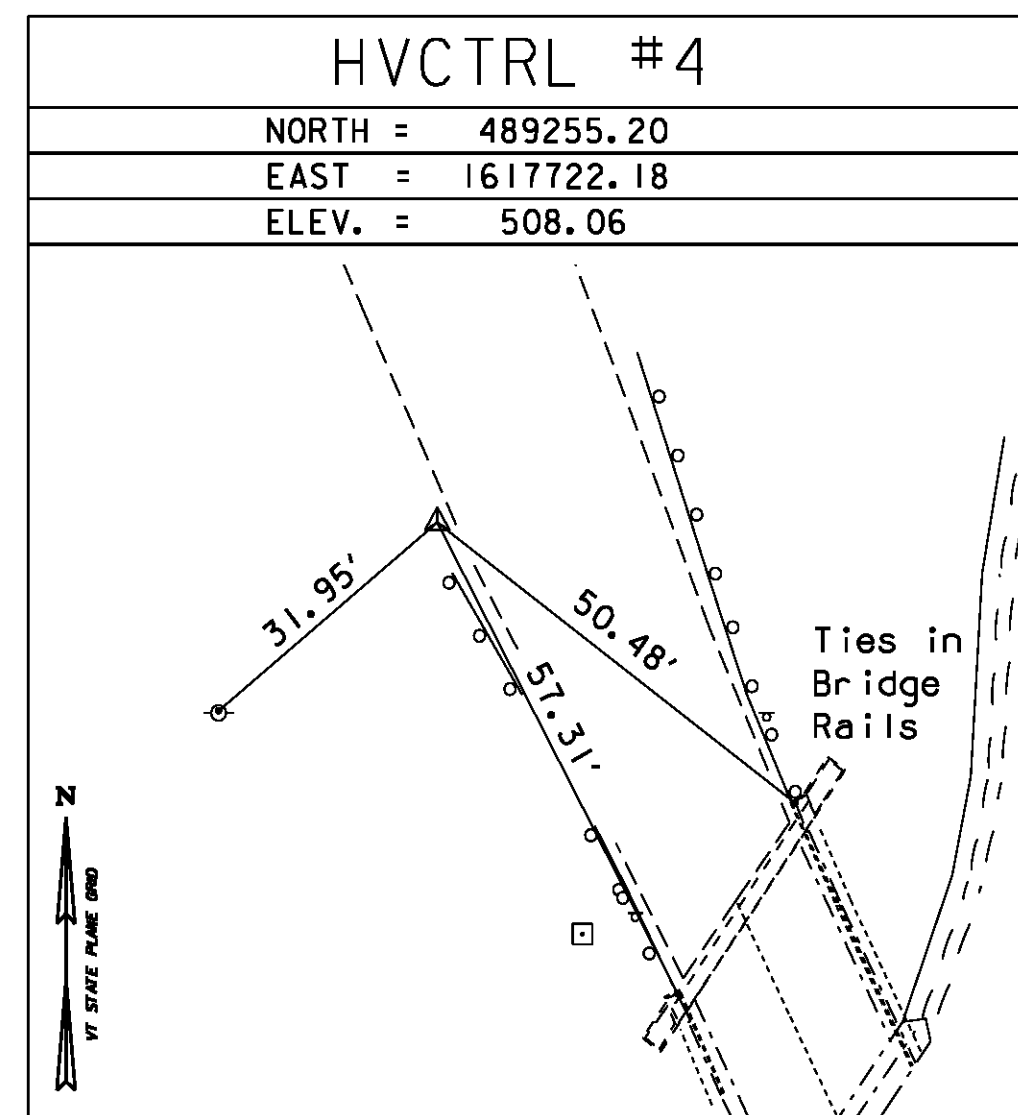
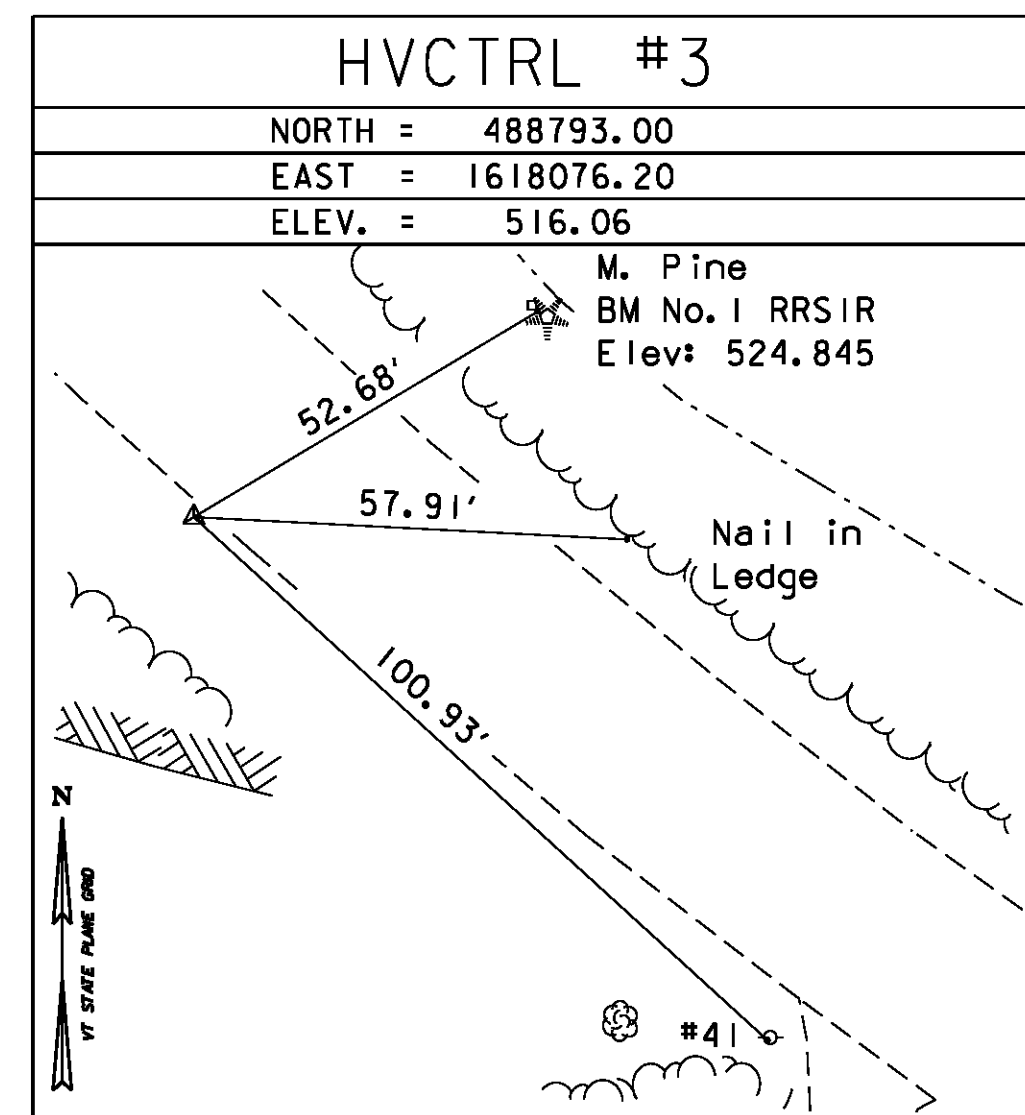


* MAIN TRAVERSE COMPLETED July 16,2001 Richard Gilman P.C. Paul Winters

TRAVERSE TIES

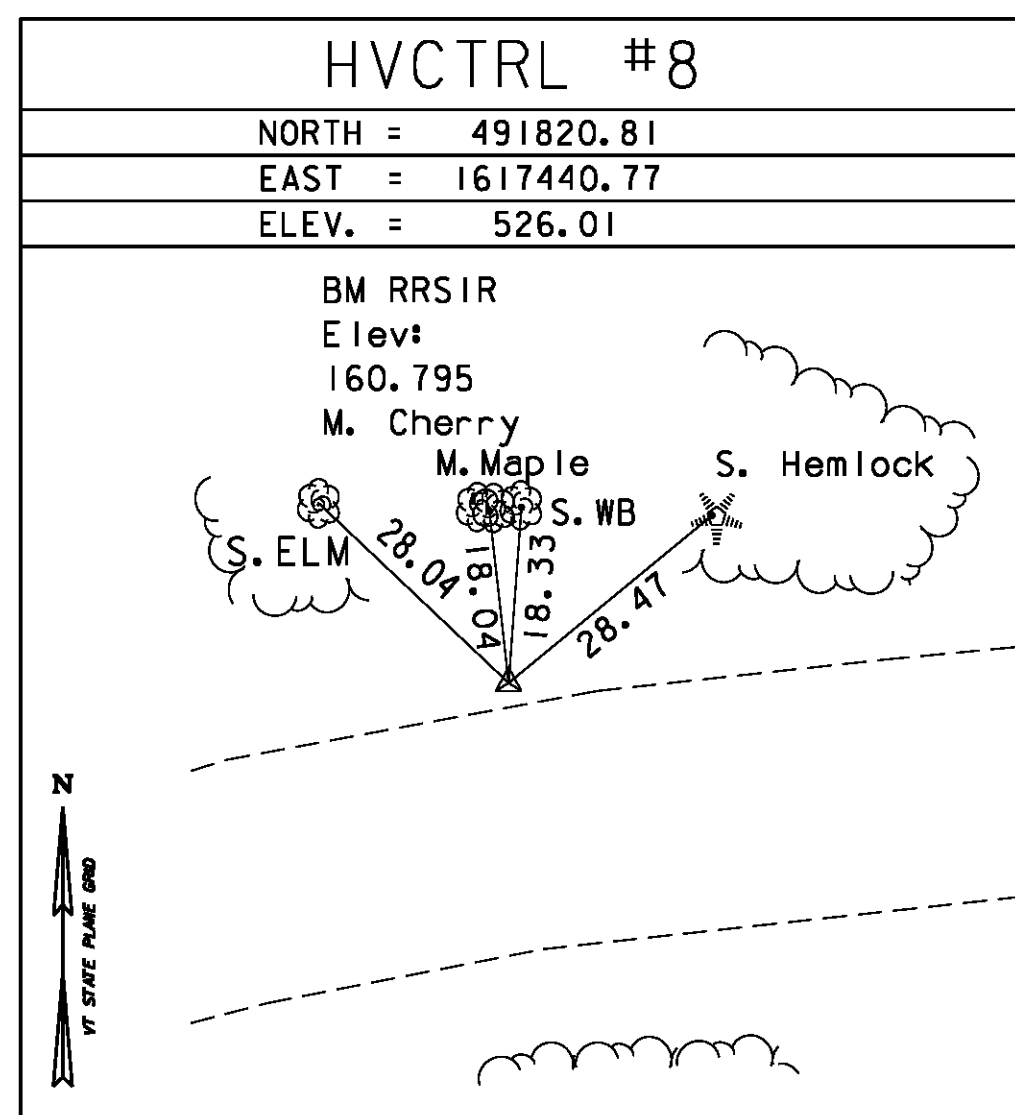



ALIGNMENT TIES

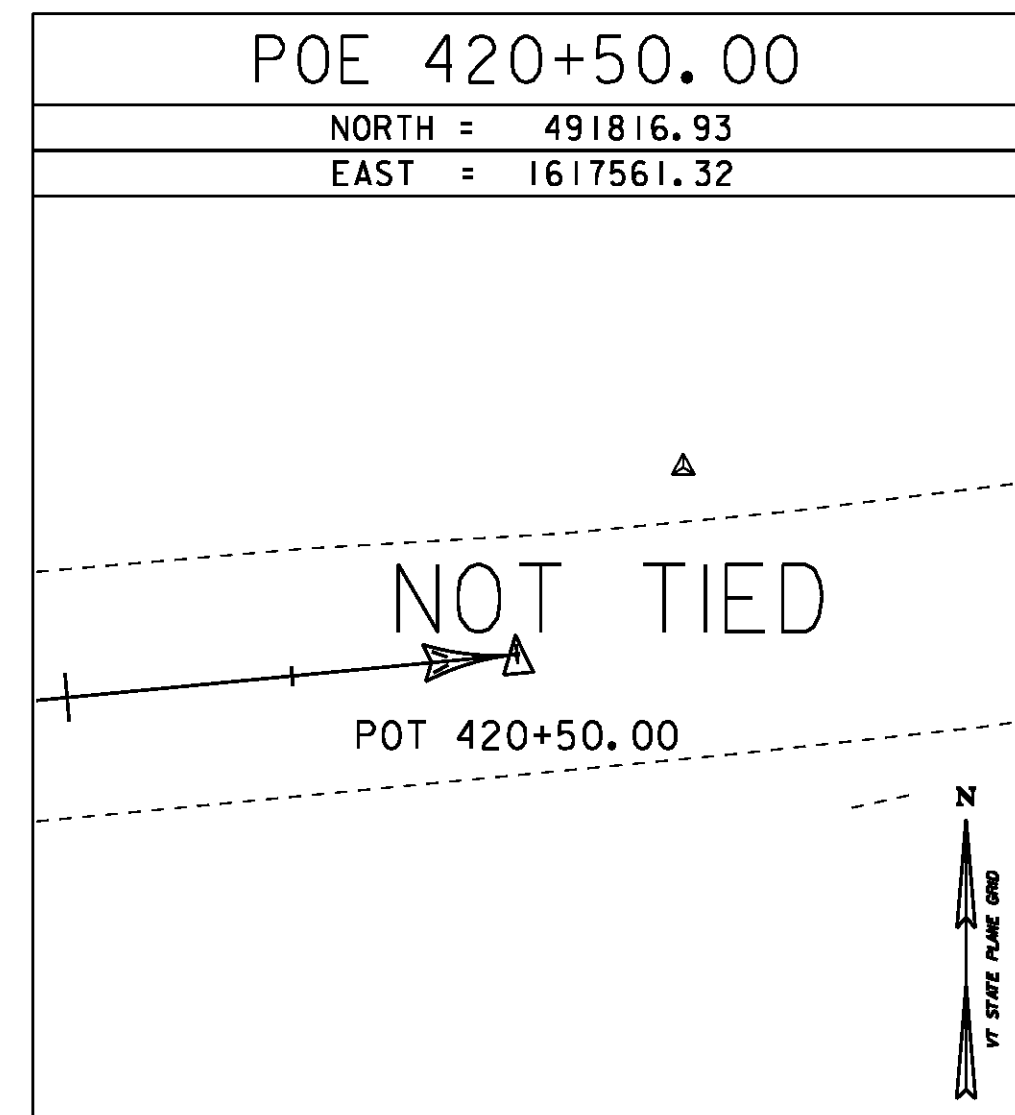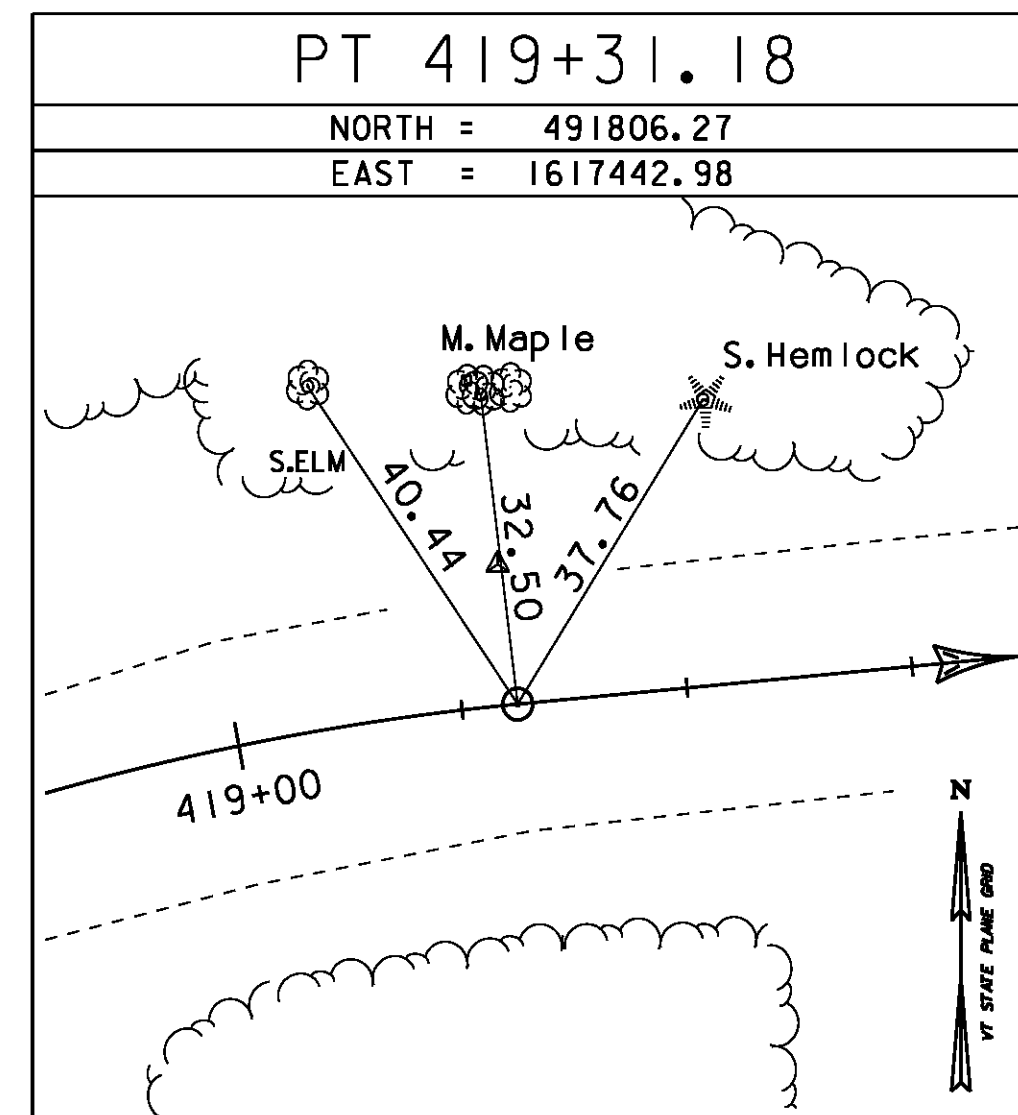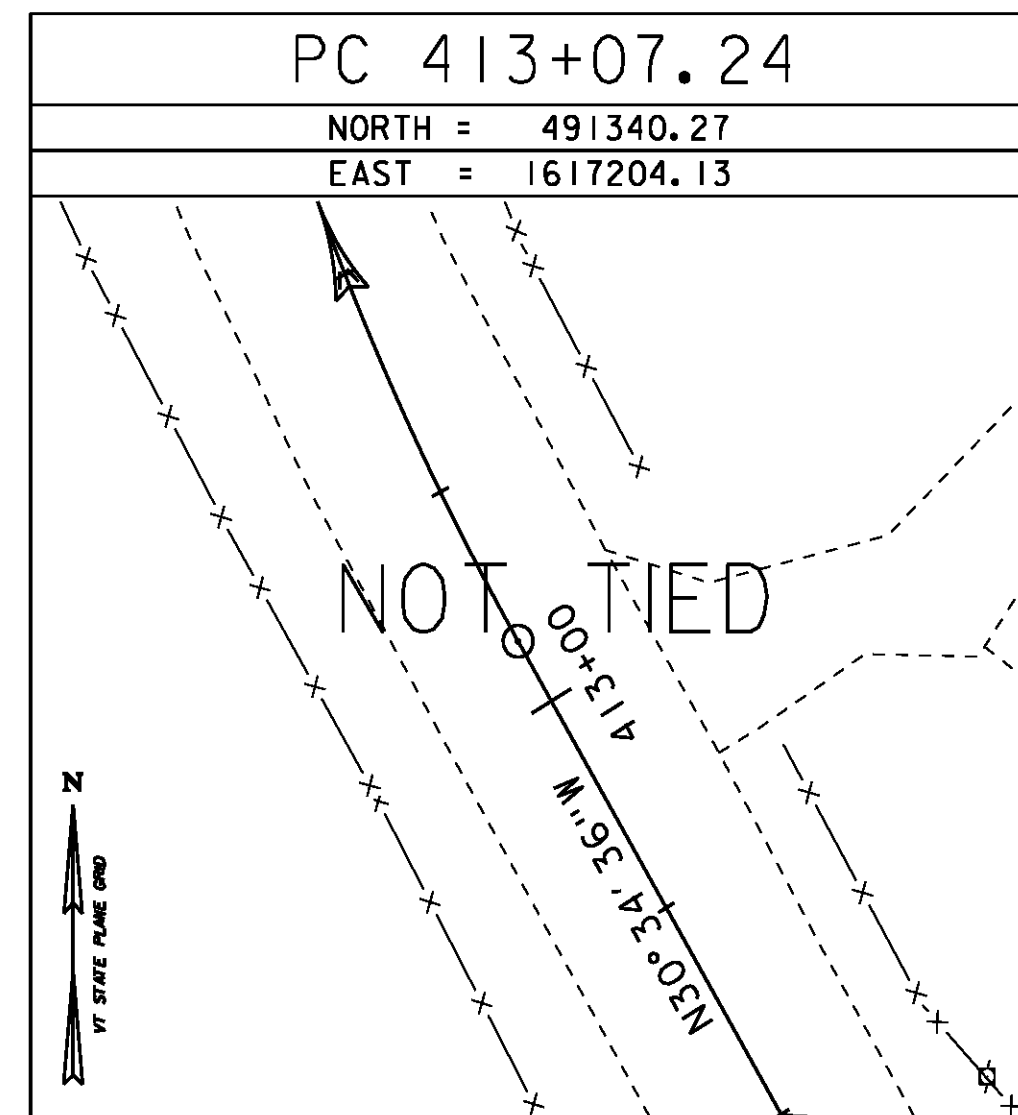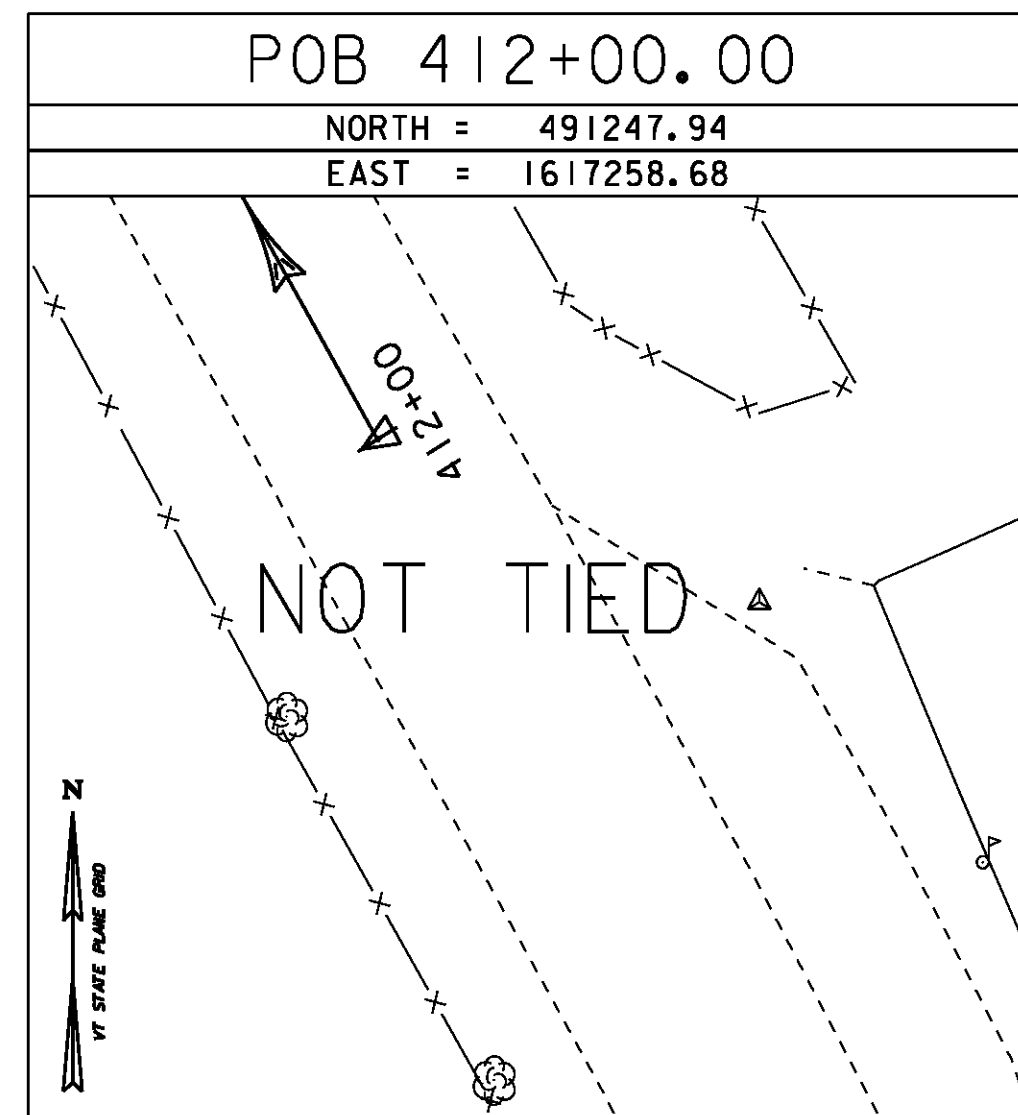

* Alignment Staked 06/05/06 by R.Gilman P.C. & P. Winters

DATUM	
VERTICAL	NAVD 88
HORIZONTAL	NAD 83 (96)
ADJUSTMENT	Compass

PROJECT NAME:	Royalton
PROJECT NUMBER:	BRS 0147 (13)
FILE NAME:	86e055\survey\86e055t1.dgn
PROJECT LEADER:	C. CARLSON
DESIGNED BY:	D. PETERSON
BRIDGE #28	TIE SHEET
PLOT DATE:	08-OCT-2013
DRAWN BY:	R. Bullock
CHECKED BY:	C. CARLSON
	SHEET 91 OF 186

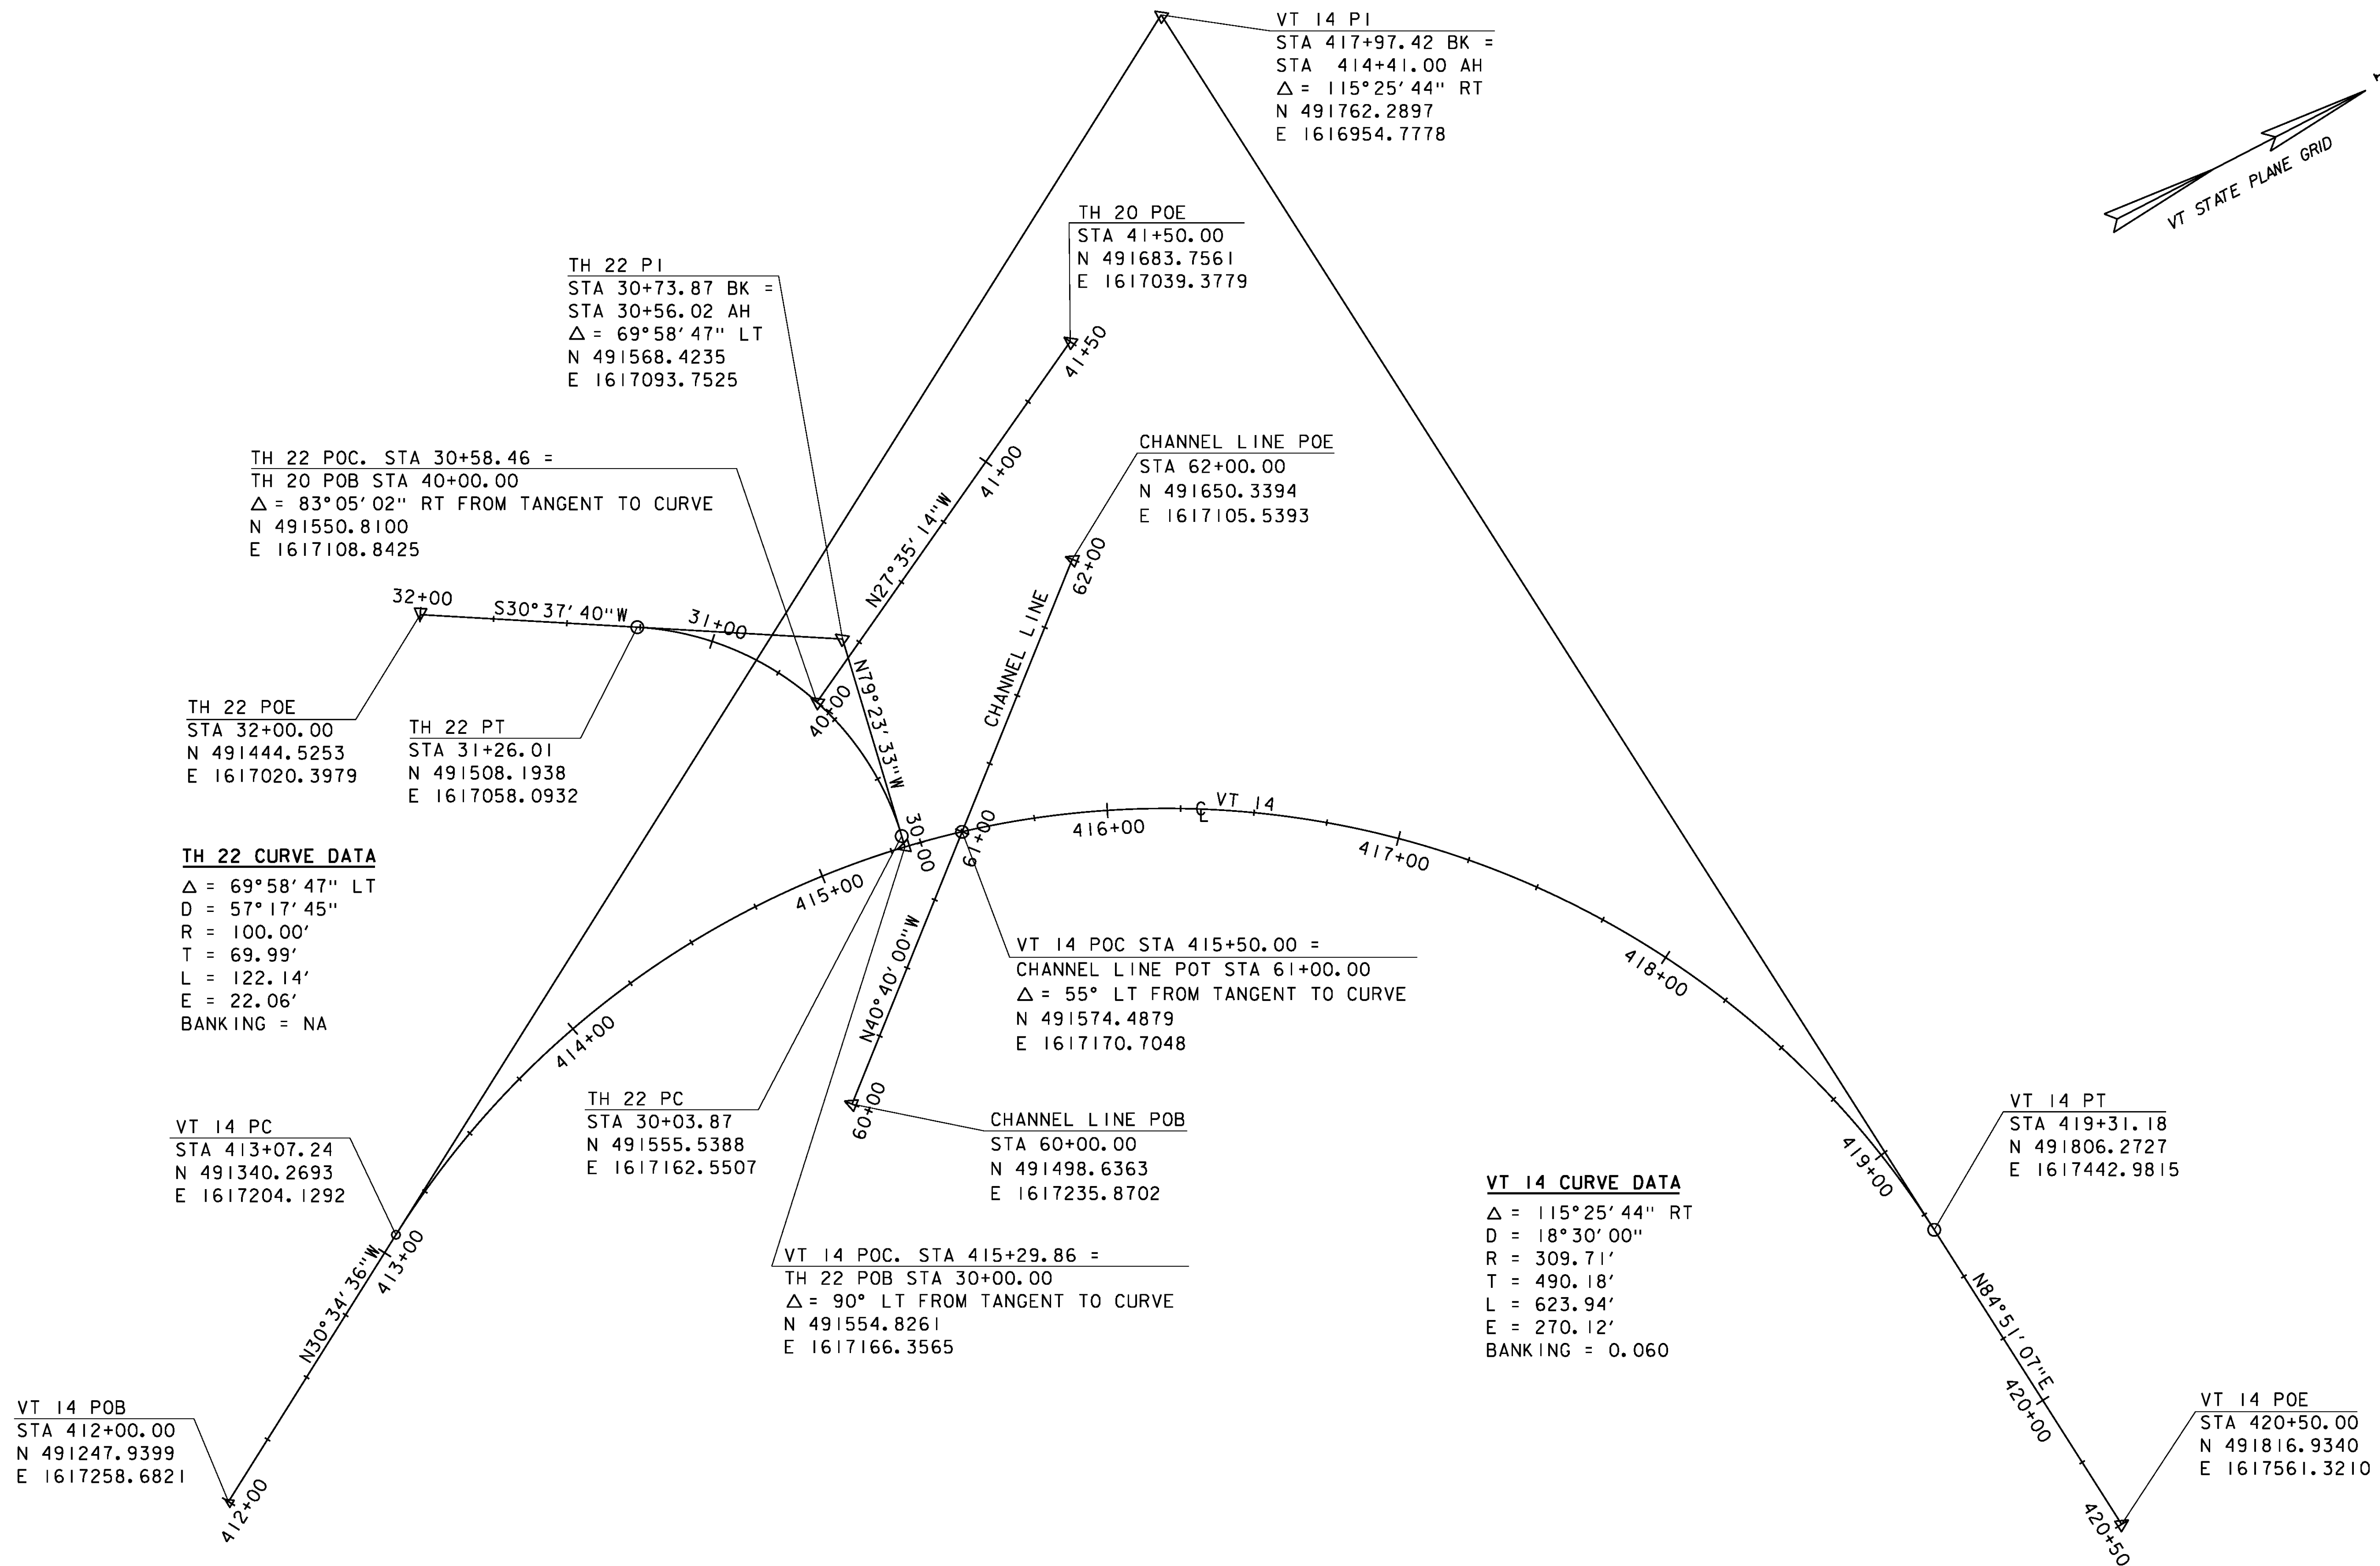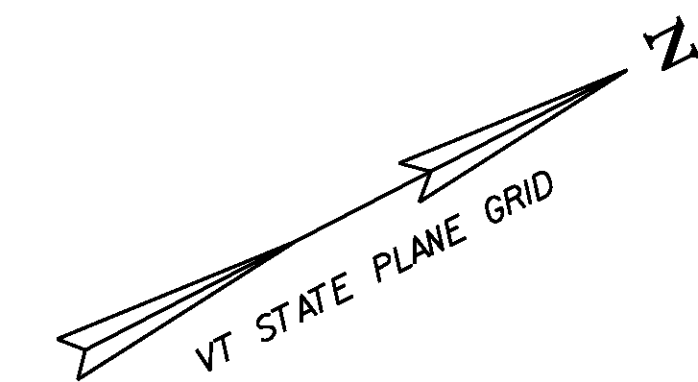

TH 22 PI  
 STA 30+73.87 BK =  
 STA 30+56.02 AH  
 $\Delta = 69^\circ 58' 47''$  LT  
 N 491568.4235  
 E 1617093.7525

VT 14 PI  
 STA 417+97.42 BK =  
 STA 414+41.00 AH  
 $\Delta = 115^\circ 25' 44''$  RT  
 N 491762.2897  
 E 1616954.7778

TH 20 POE  
 STA 41+50.00  
 N 491683.7561  
 E 1617039.3779

TH 22 POC. STA 30+58.46 =  
 TH 20 POB STA 40+00.00  
 $\Delta = 83^\circ 05' 02''$  RT FROM TANGENT TO CURVE  
 N 491550.8100  
 E 1617108.8425

CHANNEL LINE POE  
 STA 62+00.00  
 N 491650.3394  
 E 1617105.5393

TH 22 POE  
 STA 32+00.00  
 N 491444.5253  
 E 1617020.3979

TH 22 PT  
 STA 31+26.01  
 N 491508.1938  
 E 1617058.0932

**TH 22 CURVE DATA**  
 $\Delta = 69^\circ 58' 47''$  LT  
 D = 57' 17.45"  
 R = 100.00'  
 T = 69.99'  
 L = 122.14'  
 E = 22.06'  
 BANKING = NA

VT 14 POC STA 415+50.00 =  
 CHANNEL LINE POT STA 61+00.00  
 $\Delta = 55^\circ$  LT FROM TANGENT TO CURVE  
 N 491574.4879  
 E 1617170.7048

VT 14 PC  
 STA 413+07.24  
 N 491340.2693  
 E 1617204.1292

TH 22 PC  
 STA 30+03.87  
 N 491555.5388  
 E 1617162.5507

CHANNEL LINE POB  
 STA 60+00.00  
 N 491498.6363  
 E 1617235.8702

**VT 14 CURVE DATA**  
 $\Delta = 115^\circ 25' 44''$  RT  
 D = 18' 30.00"  
 R = 309.71'  
 T = 490.18'  
 L = 623.94'  
 E = 270.12'  
 BANKING = 0.060


VT 14 POC. STA 415+29.86 =  
 TH 22 POB STA 30+00.00  
 $\Delta = 90^\circ$  LT FROM TANGENT TO CURVE  
 N 491554.8261  
 E 1617166.3565

VT 14 PT  
 STA 419+31.18  
 N 491806.2727  
 E 1617442.9815


VT 14 POB  
 STA 412+00.00  
 N 491247.9399  
 E 1617258.6821

VT 14 POE  
 STA 420+50.00  
 N 491816.9340  
 E 1617561.3210

DATUM	
VERTICAL	NAVD 88
HORIZONTAL	NAD 83 (96)
ADJUSTMENT	Compass

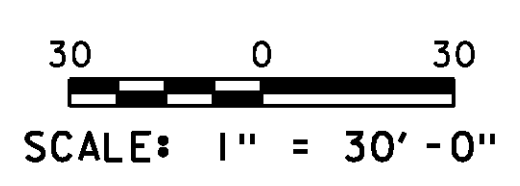

PROJECT NAME:	ROYALTON
PROJECT NUMBER:	BRS 0147 (13)
FILE NAME:	\BR 28\s86e055alg_28.dgn
PROJECT LEADER:	C. CARLSON
DESIGNED BY:	G. ROY
BRIDGE 28 ALIGNMENT LAYOUT	
PLOT DATE:	08-OCT-2013
DRAWN BY:	D. PETERSON
CHECKED BY:	G. ROY
SHEET	92 OF 186

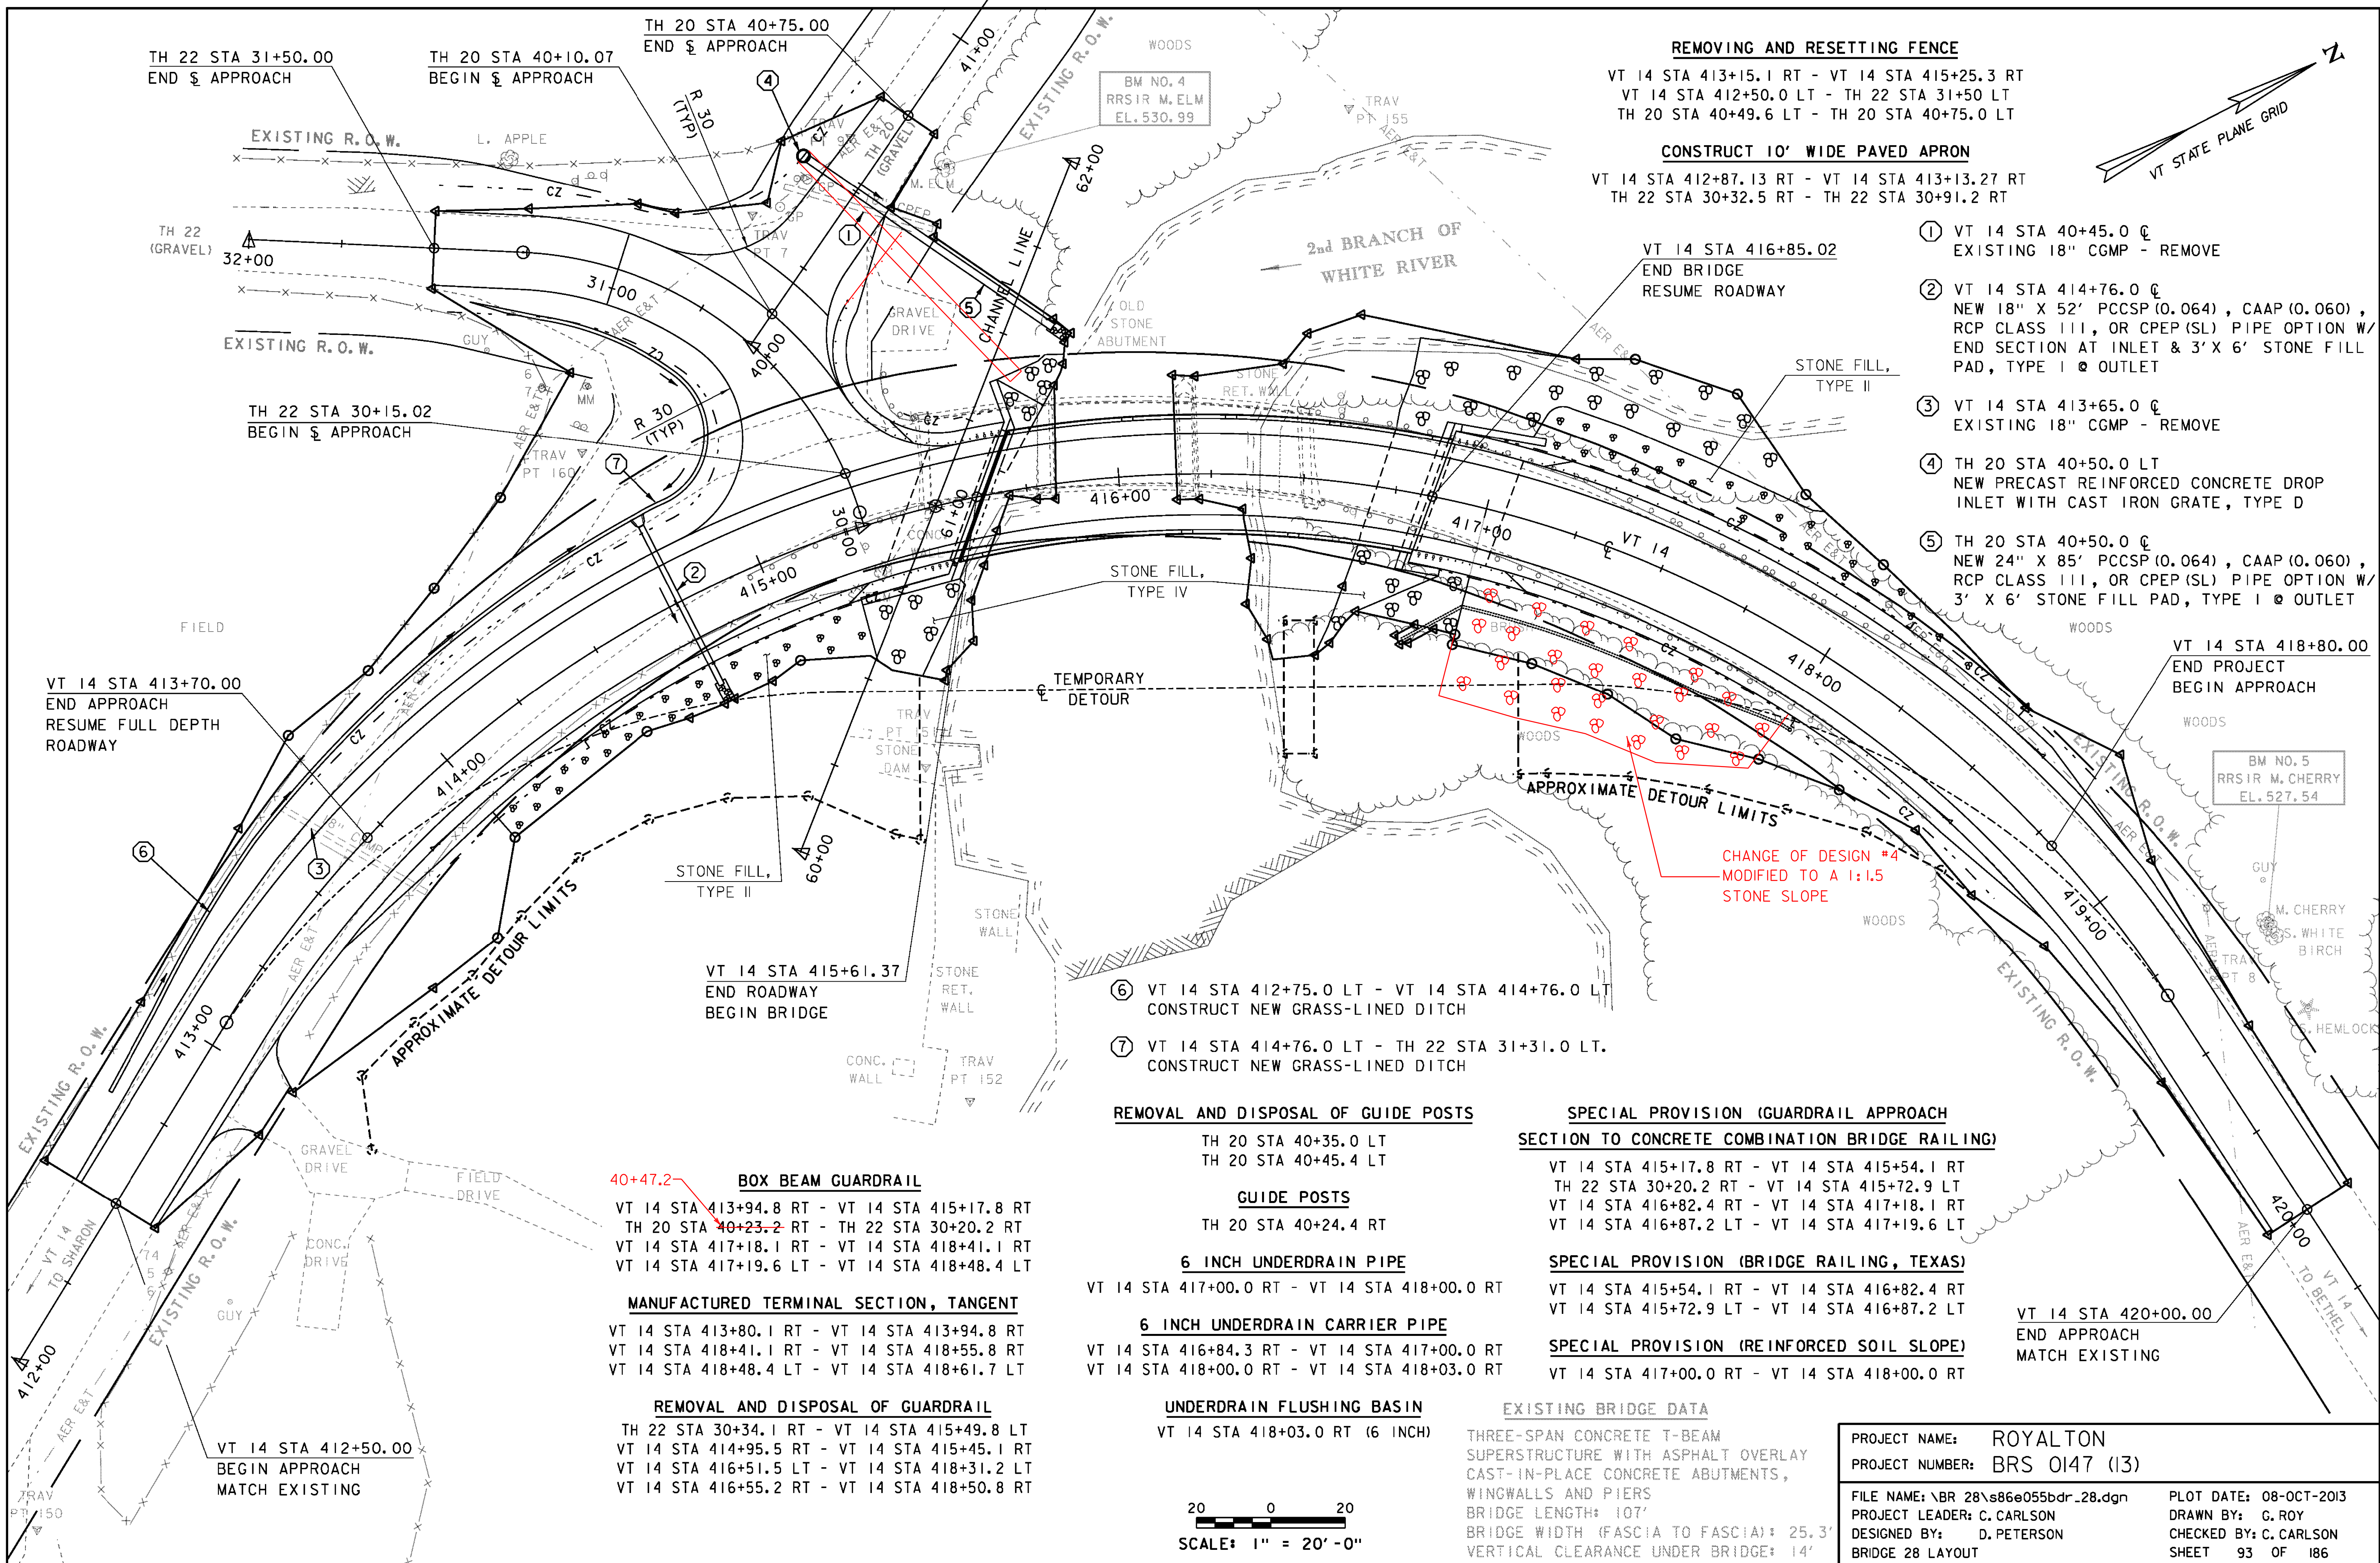

**REMOVING AND RESETTING FENCE**

VT 14 STA 413+15.1 RT - VT 14 STA 415+25.3 RT  
 VT 14 STA 412+50.0 LT - TH 22 STA 31+50 LT  
 TH 20 STA 40+49.6 LT - TH 20 STA 40+75.0 LT

**CONSTRUCT 10' WIDE PAVED APRON**

VT 14 STA 412+87.13 RT - VT 14 STA 413+13.27 RT  
 TH 22 STA 30+32.5 RT - TH 22 STA 30+91.2 RT

- ① VT 14 STA 40+45.0 C  
EXISTING 18" CGMP - REMOVE
- ② VT 14 STA 414+76.0 C  
NEW 18" X 52" PCCSP (0.064), CAAP (0.060),  
RCP CLASS III, OR CPEP (SL) PIPE OPTION W/  
END SECTION AT INLET & 3' X 6' STONE FILL  
PAD, TYPE I @ OUTLET
- ③ VT 14 STA 413+65.0 C  
EXISTING 18" CGMP - REMOVE
- ④ TH 20 STA 40+50.0 LT  
NEW PRECAST REINFORCED CONCRETE DROP  
INLET WITH CAST IRON GRATE, TYPE D
- ⑤ TH 20 STA 40+50.0 C  
NEW 24" X 85" PCCSP (0.064), CAAP (0.060),  
RCP CLASS III, OR CPEP (SL) PIPE OPTION W/  
3' X 6' STONE FILL PAD, TYPE I @ OUTLET

- ⑥ VT 14 STA 412+75.0 LT - VT 14 STA 414+76.0 LT  
CONSTRUCT NEW GRASS-LINED DITCH
- ⑦ VT 14 STA 414+76.0 LT - TH 22 STA 31+31.0 LT.  
CONSTRUCT NEW GRASS-LINED DITCH

**REMOVAL AND DISPOSAL OF GUIDE POSTS**

TH 20 STA 40+35.0 LT  
 TH 20 STA 40+45.4 LT

**GUIDE POSTS**

TH 20 STA 40+24.4 RT

**6 INCH UNDERDRAIN PIPE**

VT 14 STA 417+00.0 RT - VT 14 STA 418+00.0 RT

**6 INCH UNDERDRAIN CARRIER PIPE**

VT 14 STA 416+84.3 RT - VT 14 STA 417+00.0 RT  
 VT 14 STA 418+00.0 RT - VT 14 STA 418+03.0 RT

**UNDERDRAIN FLUSHING BASIN**

VT 14 STA 418+03.0 RT (6 INCH)

**SPECIAL PROVISION (GUARDRAIL APPROACH**

**SECTION TO CONCRETE COMBINATION BRIDGE RAILING)**

VT 14 STA 415+17.8 RT - VT 14 STA 415+54.1 RT  
 TH 22 STA 30+20.2 RT - VT 14 STA 415+72.9 LT  
 VT 14 STA 416+82.4 RT - VT 14 STA 417+18.1 RT  
 VT 14 STA 416+87.2 LT - VT 14 STA 417+19.6 LT

**SPECIAL PROVISION (BRIDGE RAILING, TEXAS)**

VT 14 STA 415+54.1 RT - VT 14 STA 416+82.4 RT  
 VT 14 STA 415+72.9 LT - VT 14 STA 416+87.2 LT

**SPECIAL PROVISION (REINFORCED SOIL SLOPE)**

VT 14 STA 417+00.0 RT - VT 14 STA 418+00.0 RT

**BOX BEAM GUARDRAIL**  
 VT 14 STA 413+94.8 RT - VT 14 STA 415+17.8 RT  
 TH 20 STA 40+23.2 RT - TH 22 STA 30+20.2 RT  
 VT 14 STA 417+18.1 RT - VT 14 STA 418+41.1 RT  
 VT 14 STA 417+19.6 LT - VT 14 STA 418+48.4 LT


**MANUFACTURED TERMINAL SECTION, TANGENT**  
 VT 14 STA 413+80.1 RT - VT 14 STA 413+94.8 RT  
 VT 14 STA 418+41.1 RT - VT 14 STA 418+55.8 RT  
 VT 14 STA 418+48.4 LT - VT 14 STA 418+61.7 LT


**REMOVAL AND DISPOSAL OF GUARDRAIL**  
 TH 22 STA 30+34.1 RT - VT 14 STA 415+49.8 LT  
 VT 14 STA 414+95.5 RT - VT 14 STA 415+45.1 RT  
 VT 14 STA 416+51.5 LT - VT 14 STA 418+31.2 LT  
 VT 14 STA 416+55.2 RT - VT 14 STA 418+50.8 RT

**EXISTING BRIDGE DATA**

THREE-SPAN CONCRETE T-BEAM  
 SUPERSTRUCTURE WITH ASPHALT OVERLAY  
 CAST-IN-PLACE CONCRETE ABUTMENTS,  
 WINGWALLS AND PIERS  
 BRIDGE LENGTH: 107'  
 BRIDGE WIDTH (FASCIA TO FASCIA): 25.3'  
 VERTICAL CLEARANCE UNDER BRIDGE: 14'

PROJECT NAME:	ROYALTON	FILE NAME:	\BR 28\86e055bdr_28.dgn	PLOT DATE:	08-OCT-2013
PROJECT NUMBER:	BRS 0147 (13)	PROJECT LEADER:	C. CARLSON	DRAWN BY:	G. ROY
		DESIGNED BY:	D. PETERSON	CHECKED BY:	C. CARLSON
		BRIDGE 28 LAYOUT		SHEET	93 OF 186

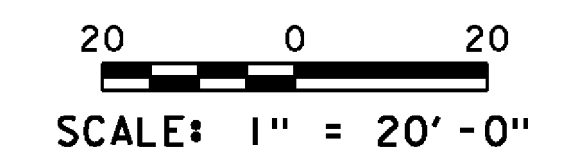

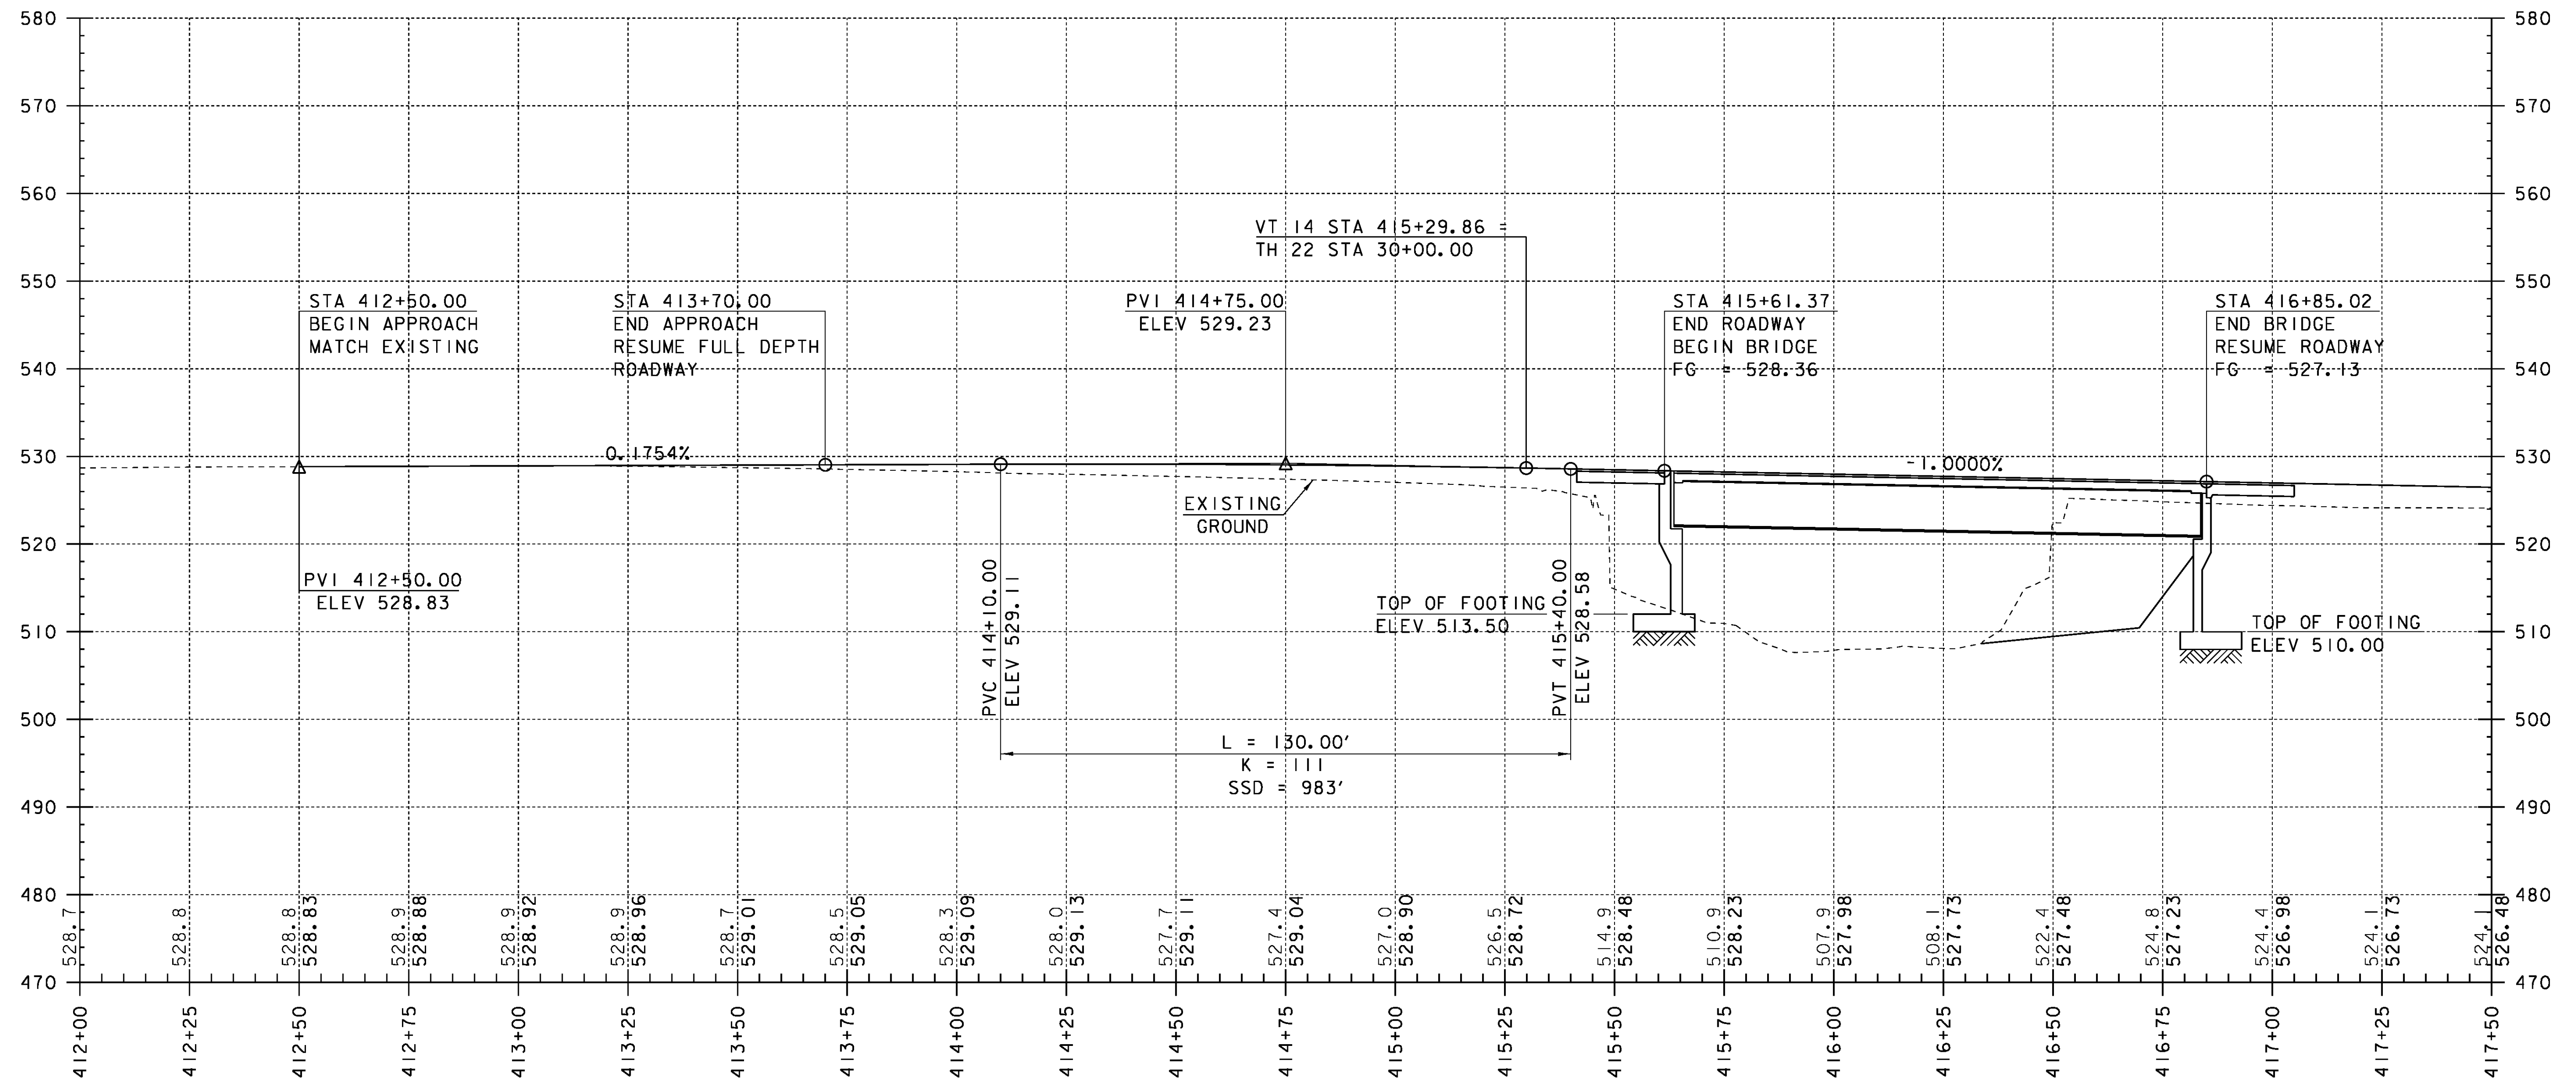

NOTE:

ELEVATIONS SHOWN TO THE NEAREST TENTH ARE  
EXISTING GROUND ALONG PROPOSED CENTERLINE.


ELEVATIONS SHOWN TO THE NEAREST HUNDREDTH ARE  
FINISH GRADES ALONG PROPOSED CENTERLINE.

PROFILE ALONG VT 14

HORIZONTAL SCALE: 1" = 20'-0"  
VERTICAL SCALE: 1" = 10'-0"

PROJECT NAME: ROYALTON  
PROJECT NUMBER: BRS 0147 (13)

FILE NAME: \BR 28\86e055pro_28.dgn PLOT DATE: 08-OCT-2013  
PROJECT LEADER: C. CARLSON DRAWN BY: G. ROY  
DESIGNED BY: D. PETERSON CHECKED BY: C. CARLSON  
BRIDGE 28 VT 14 PROFILE SHEET (1) SHEET 94 OF 186

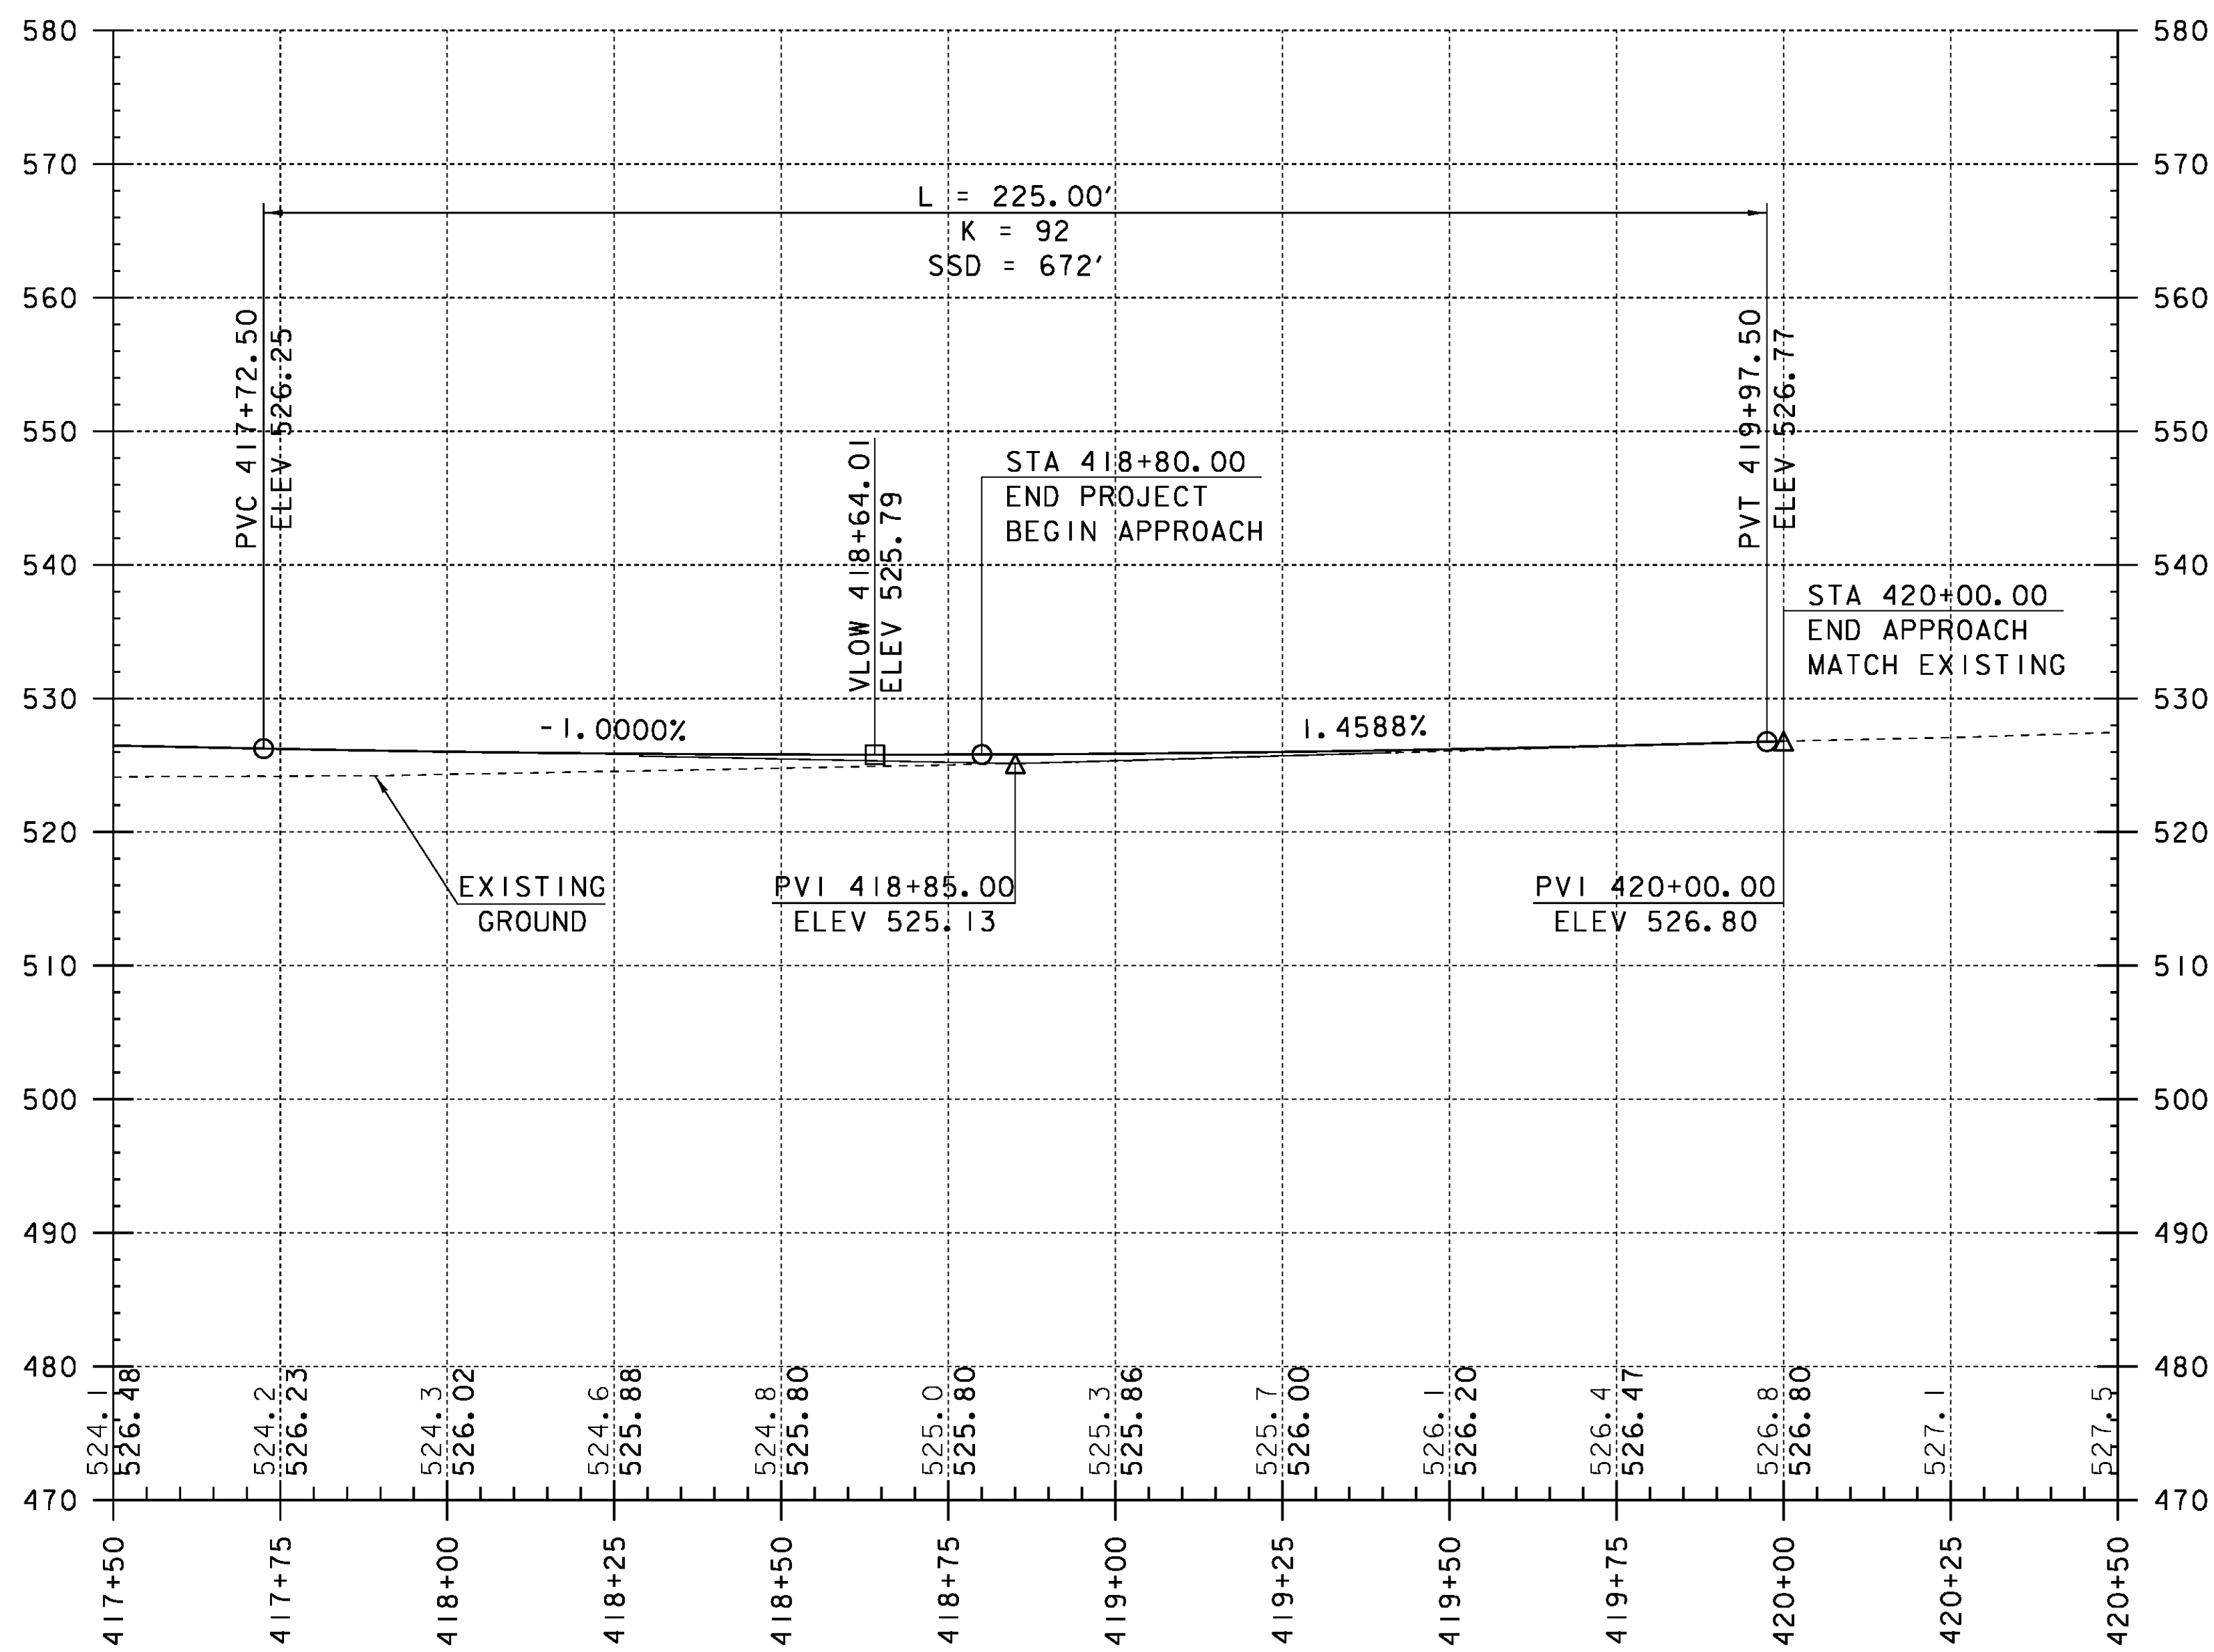

**PROFILE ALONG VT 14**


HORIZONTAL SCALE: 1" = 20' -0"  
 VERTICAL SCALE: 1" = 10' -0"

**NOTE:**

ELEVATIONS SHOWN TO THE NEAREST TENTH ARE  
 EXISTING GROUND ALONG PROPOSED CENTERLINE.

ELEVATIONS SHOWN TO THE NEAREST HUNDREDTH ARE  
 FINISH GRADES ALONG PROPOSED CENTERLINE.


PROJECT NAME: ROYALTON	PLOT DATE: 08-OCT-2013
PROJECT NUMBER: BRS 0147 (13)	DRAWN BY: G. ROY
FILE NAME: \BR 28\s86e055pro_28.dgn	CHECKED BY: C. CARLSON
PROJECT LEADER: C. CARLSON	SHEET 95 OF 186
DESIGNED BY: D. PETERSON	
BRIDGE 28 VT 14 PROFILE SHEET (2)	

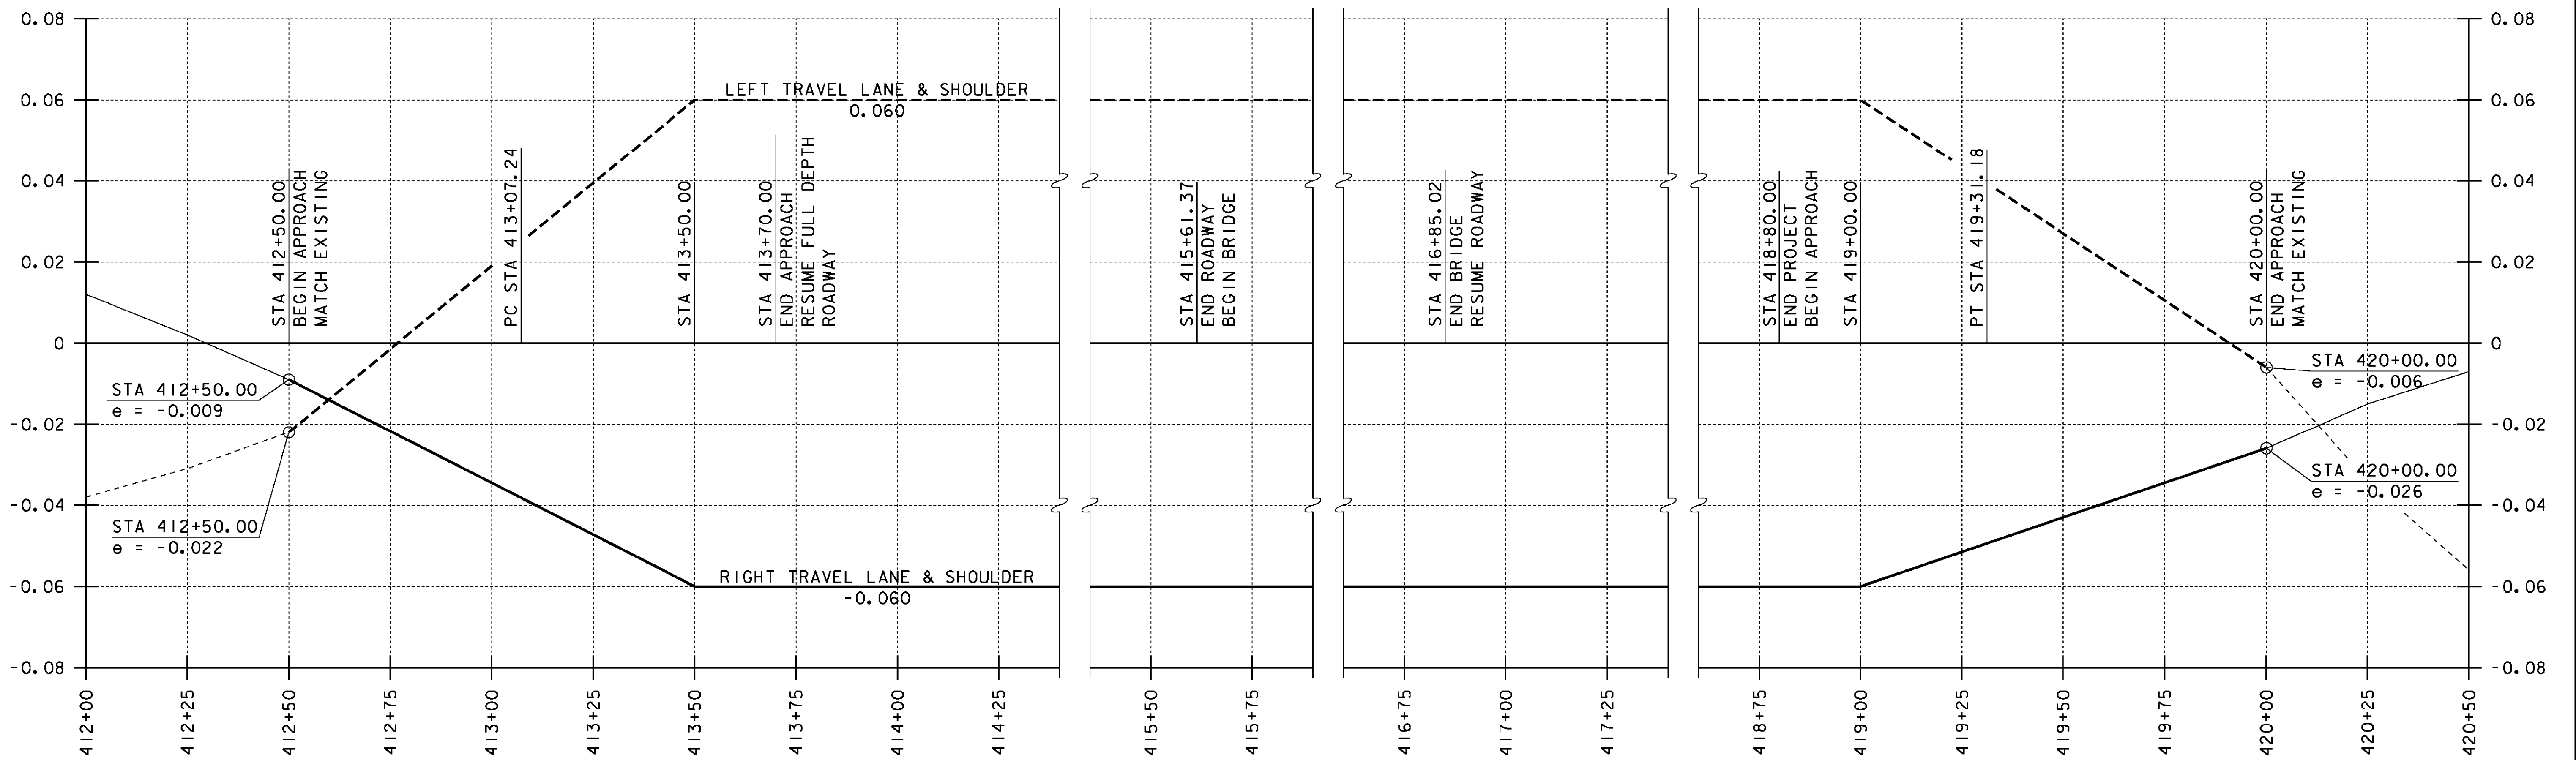

### VT 14 BANKING DIAGRAM

HORIZONTAL SCALE: 1" = 20'-0"  
 VERTICAL SCALE: 1" = 0.02' /'

CHANGE OF DESIGN #7  
 ELIMINATED COLD PLANING  
 ADDED PAVING BETWEEN  
 BR 27 AND BR 28

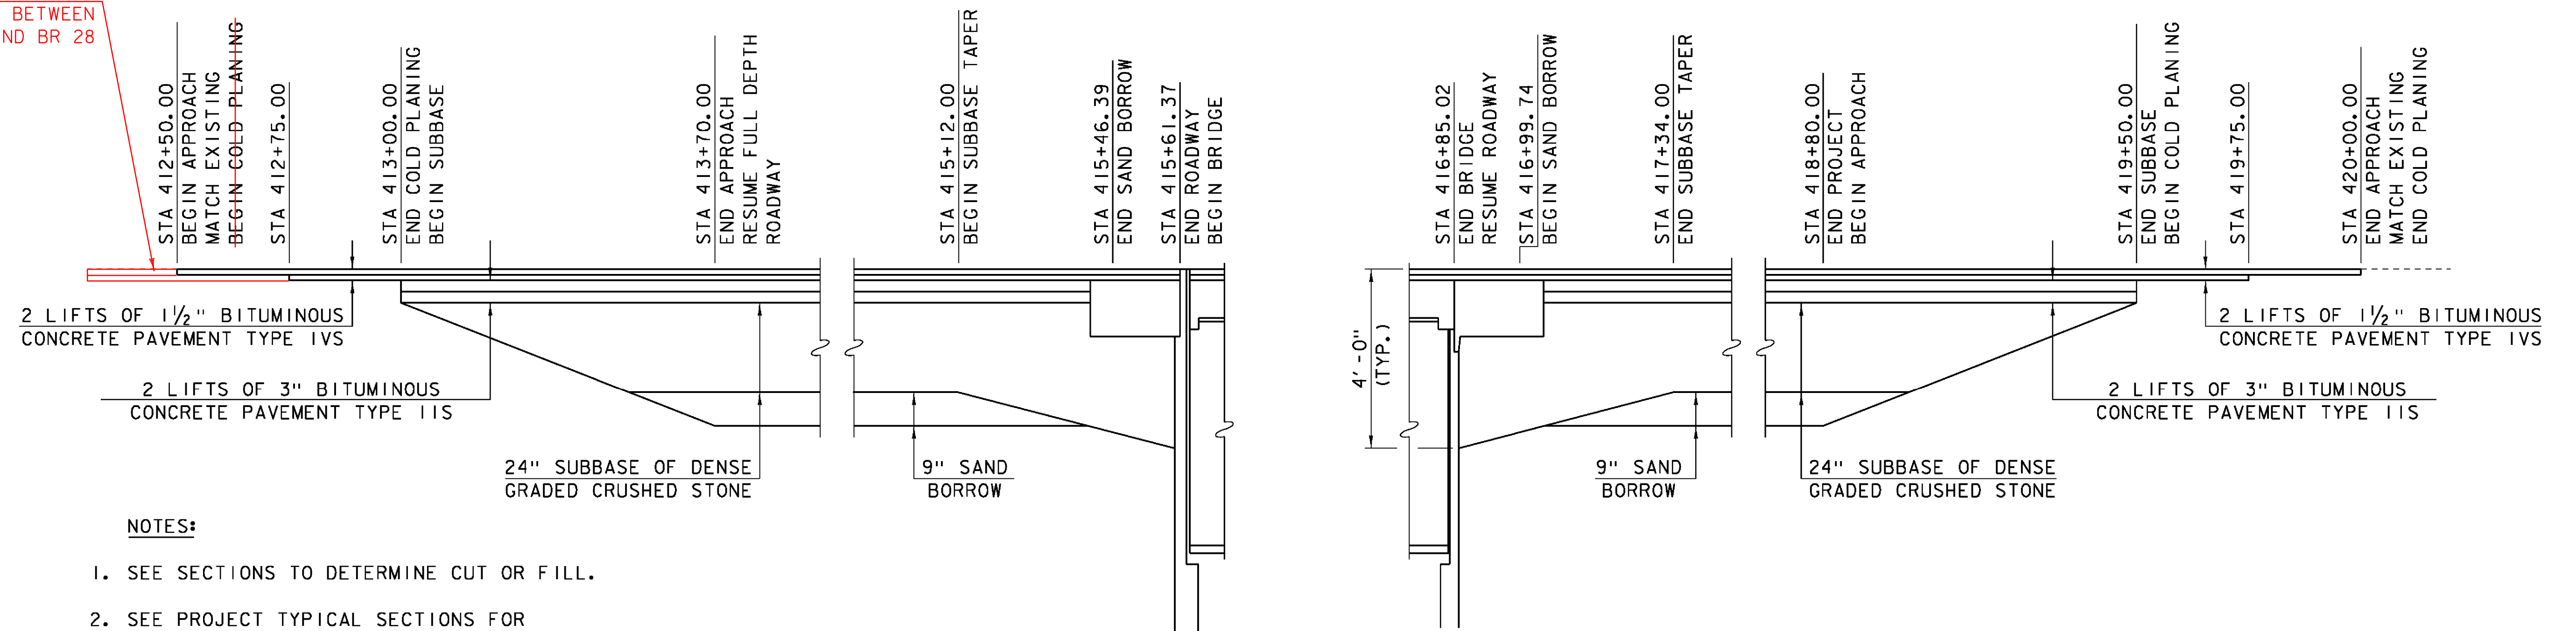

**NOTES:**


1. SEE SECTIONS TO DETERMINE CUT OR FILL.
2. SEE PROJECT TYPICAL SECTIONS FOR ABUTMENT EARTHWORK DETAILS.

### VT 14 MATERIAL TRANSITION DETAIL

HORIZONTAL SCALE: 1" = 20'-0"  
 VERTICAL SCALE: 1" = 2'-0"


PROJECT NAME:	ROYALTON
PROJECT NUMBER:	BRS 0147 (13)
FILE NAME:	BR 28\86e055pro_28.dgn
PROJECT LEADER:	C. CARLSON
DESIGNED BY:	D. PETERSON
PLOT DATE:	08-OCT-2013
DRAWN BY:	G. ROY
CHECKED BY:	C. CARLSON
BRIDGE 28 VT 14 BANKING DIAGRAM AND MATERIAL TRANSITION SHEET 96 OF 186	



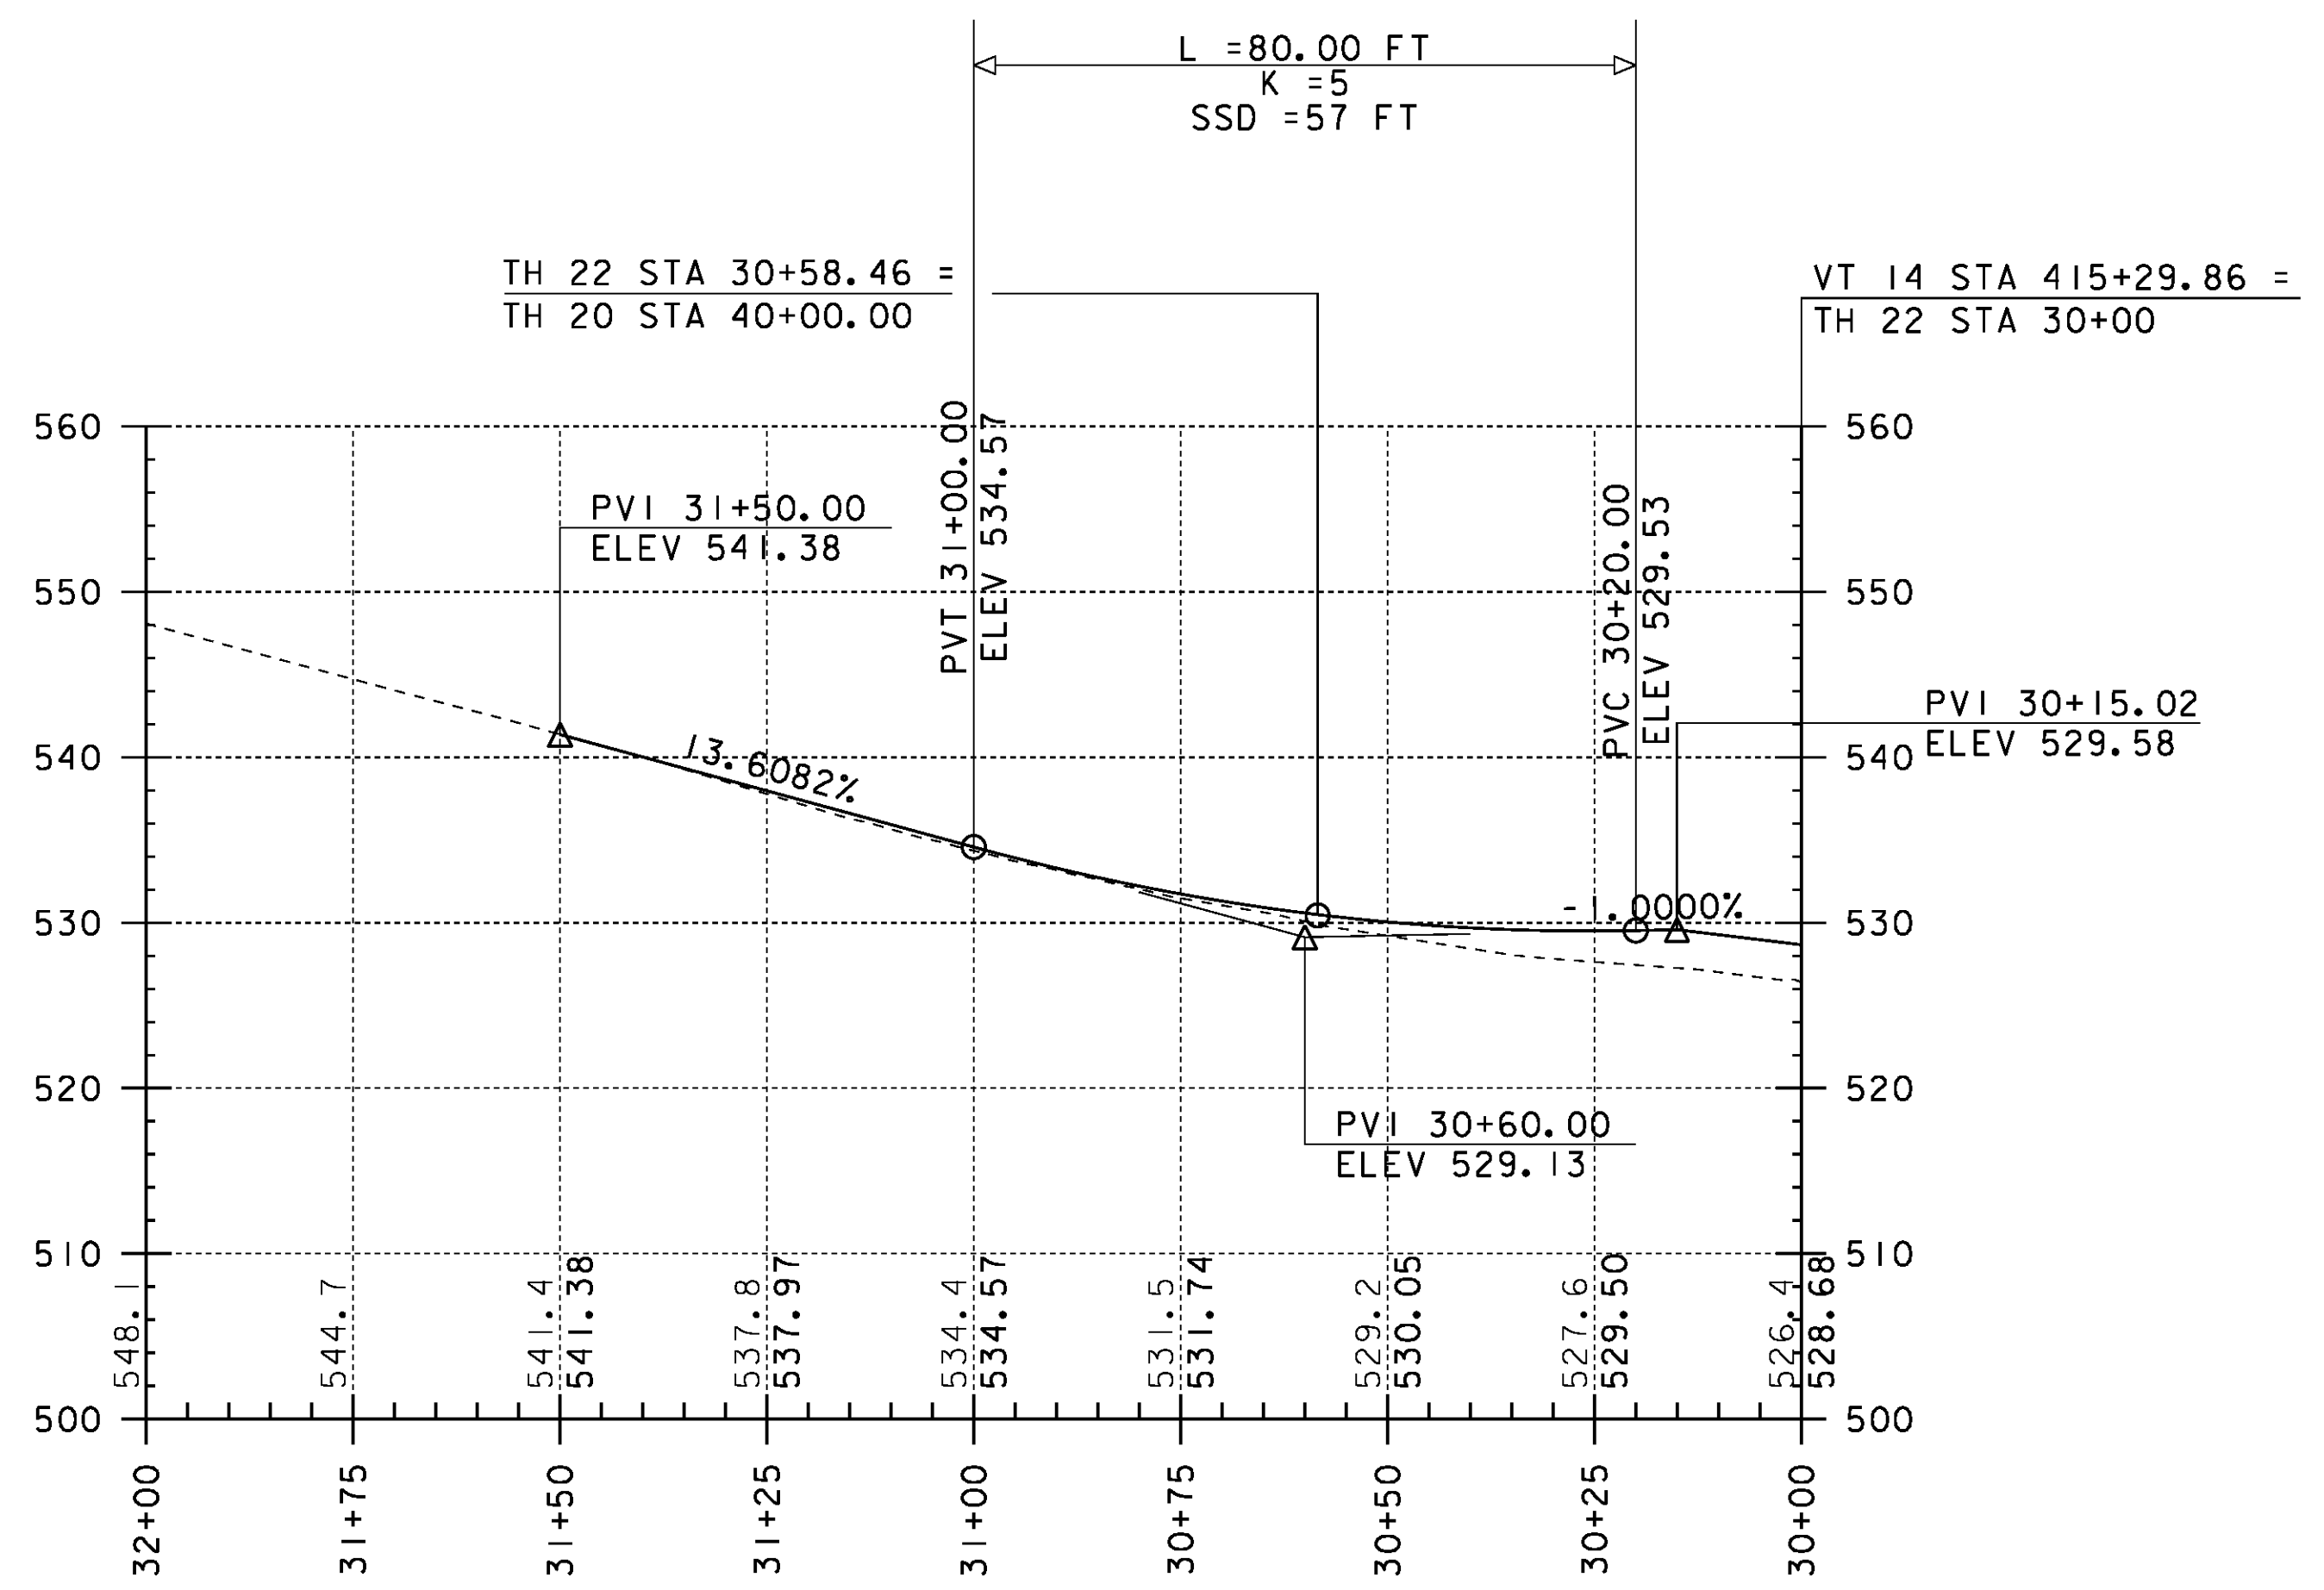

PROFILE ALONG TH 22

HORIZONTAL SCALE: 1" = 20'-0"  
 VERTICAL SCALE: 1" = 10'-0"

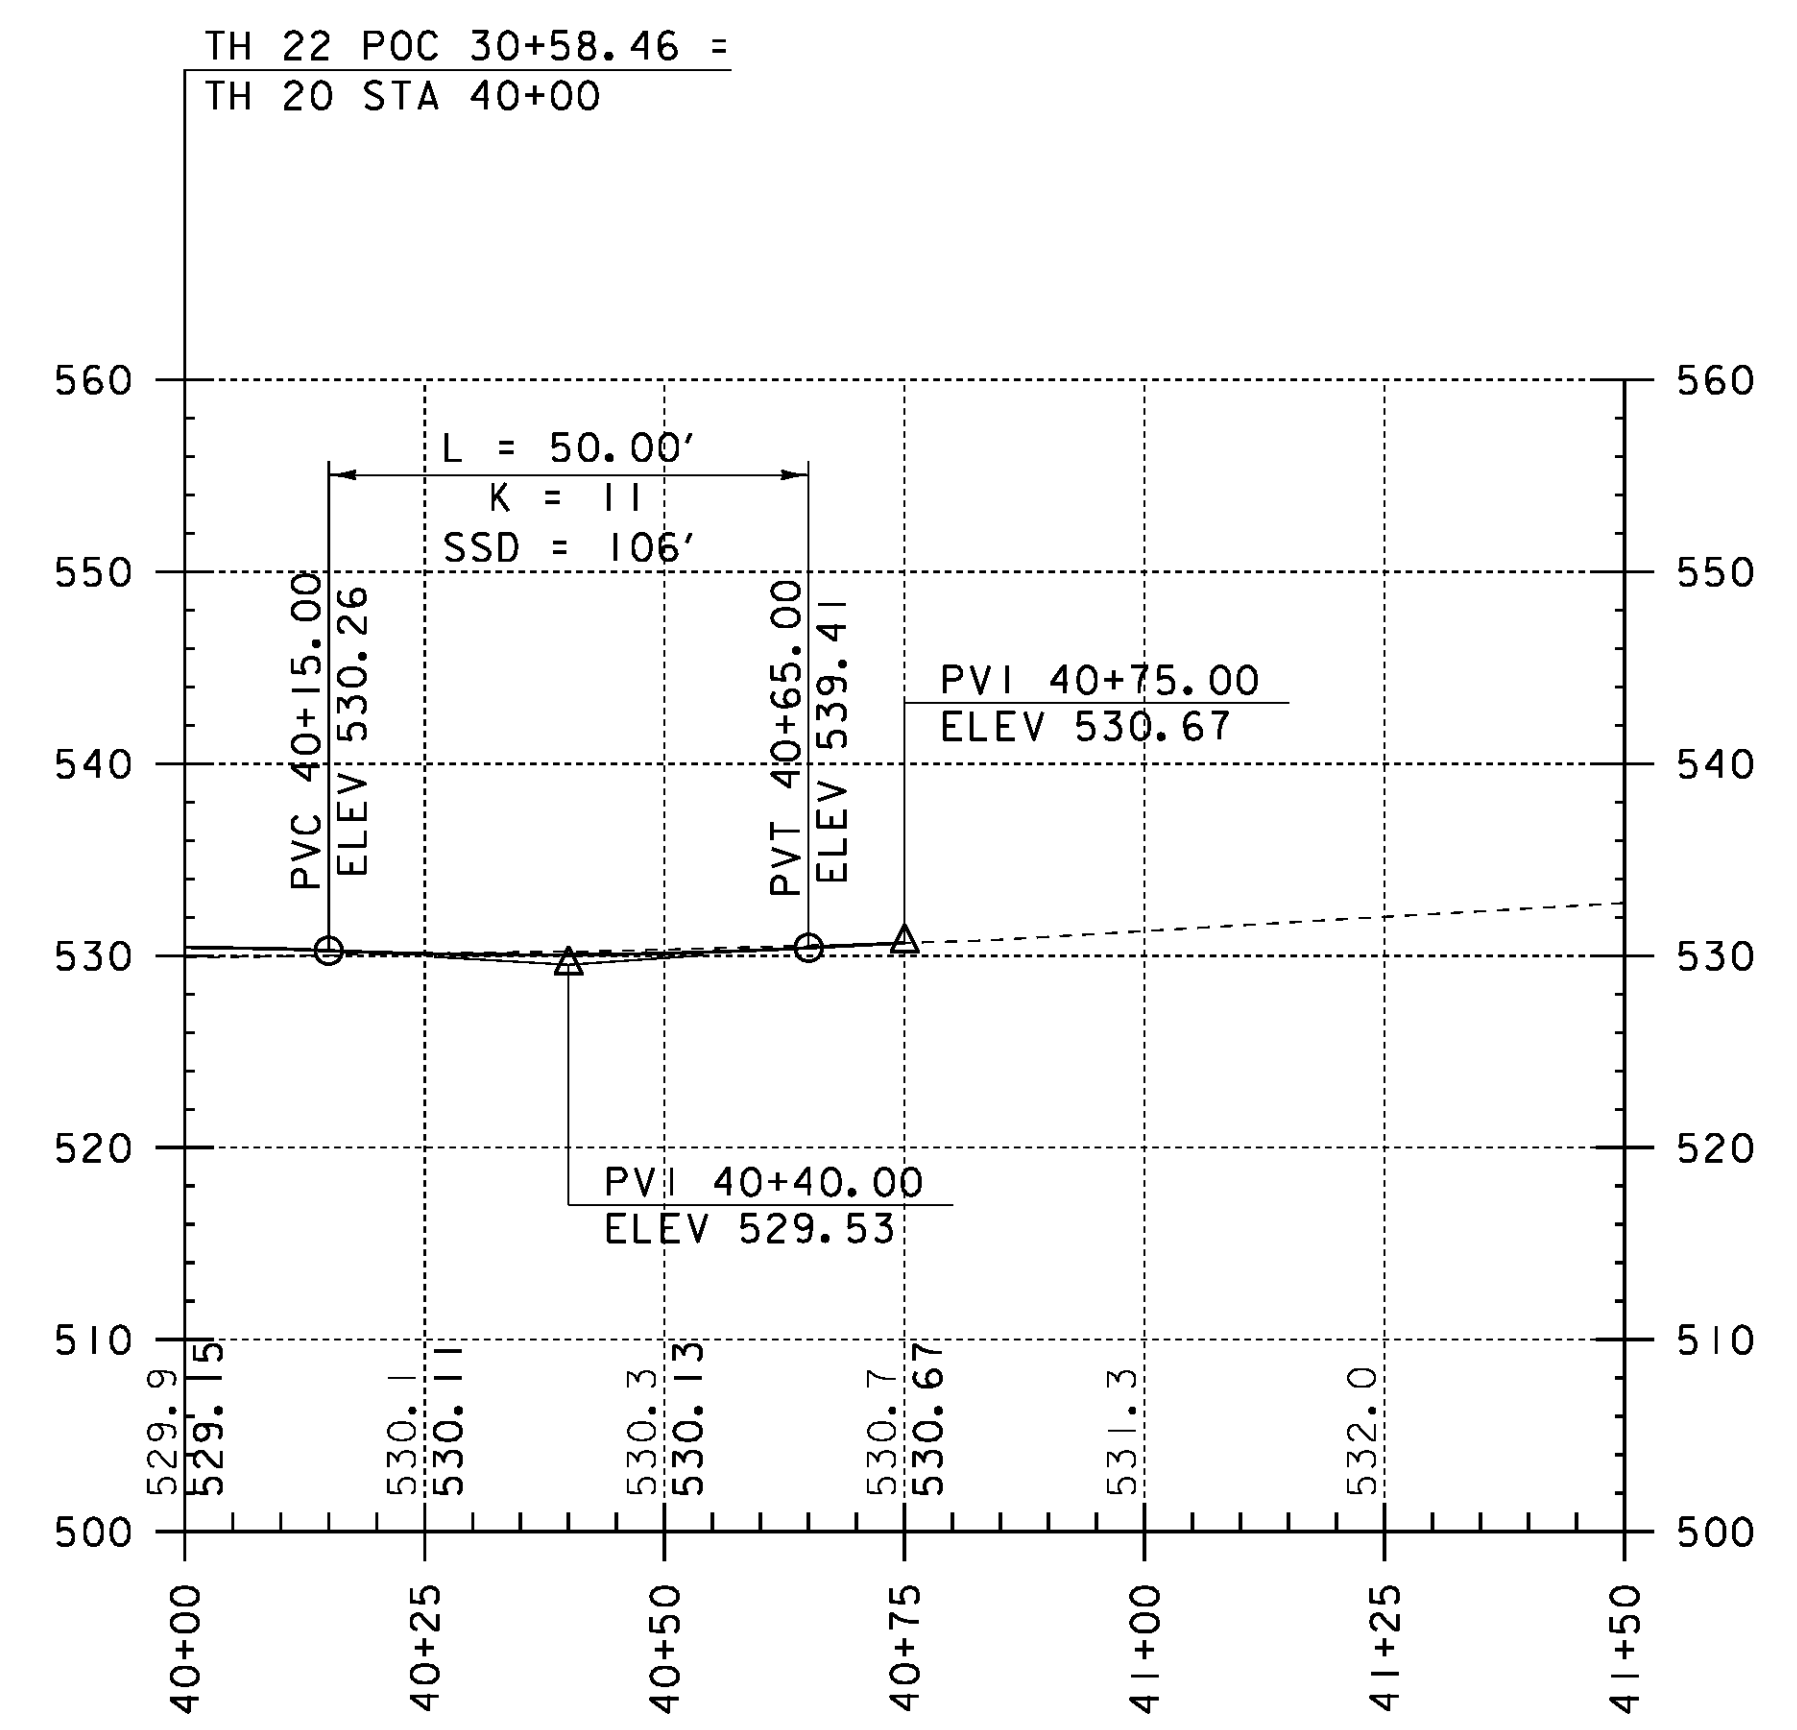

PROFILE ALONG TH 20


HORIZONTAL SCALE: 1" = 20'-0"  
 VERTICAL SCALE: 1" = 10'-0"

NOTE:

ELEVATIONS SHOWN TO THE NEAREST TENTH ARE  
 EXISTING GROUND ALONG PROPOSED CENTERLINE.


ELEVATIONS SHOWN TO THE NEAREST HUNDREDTH ARE  
 FINISH GRADES ALONG PROPOSED CENTERLINE.

PROJECT NAME: ROYALTON	
PROJECT NUMBER: BRS 0147 (13)	
FILE NAME: \BR 28\s86e055pro_28.dgn	PLOT DATE: 08-OCT-2013
PROJECT LEADER: C. CARLSON	DRAWN BY: G. ROY
DESIGNED BY: D. PETERSON	CHECKED BY: C. CARLSON
TH 20 AND TH 22 PROFILES	SHEET 97 OF 186

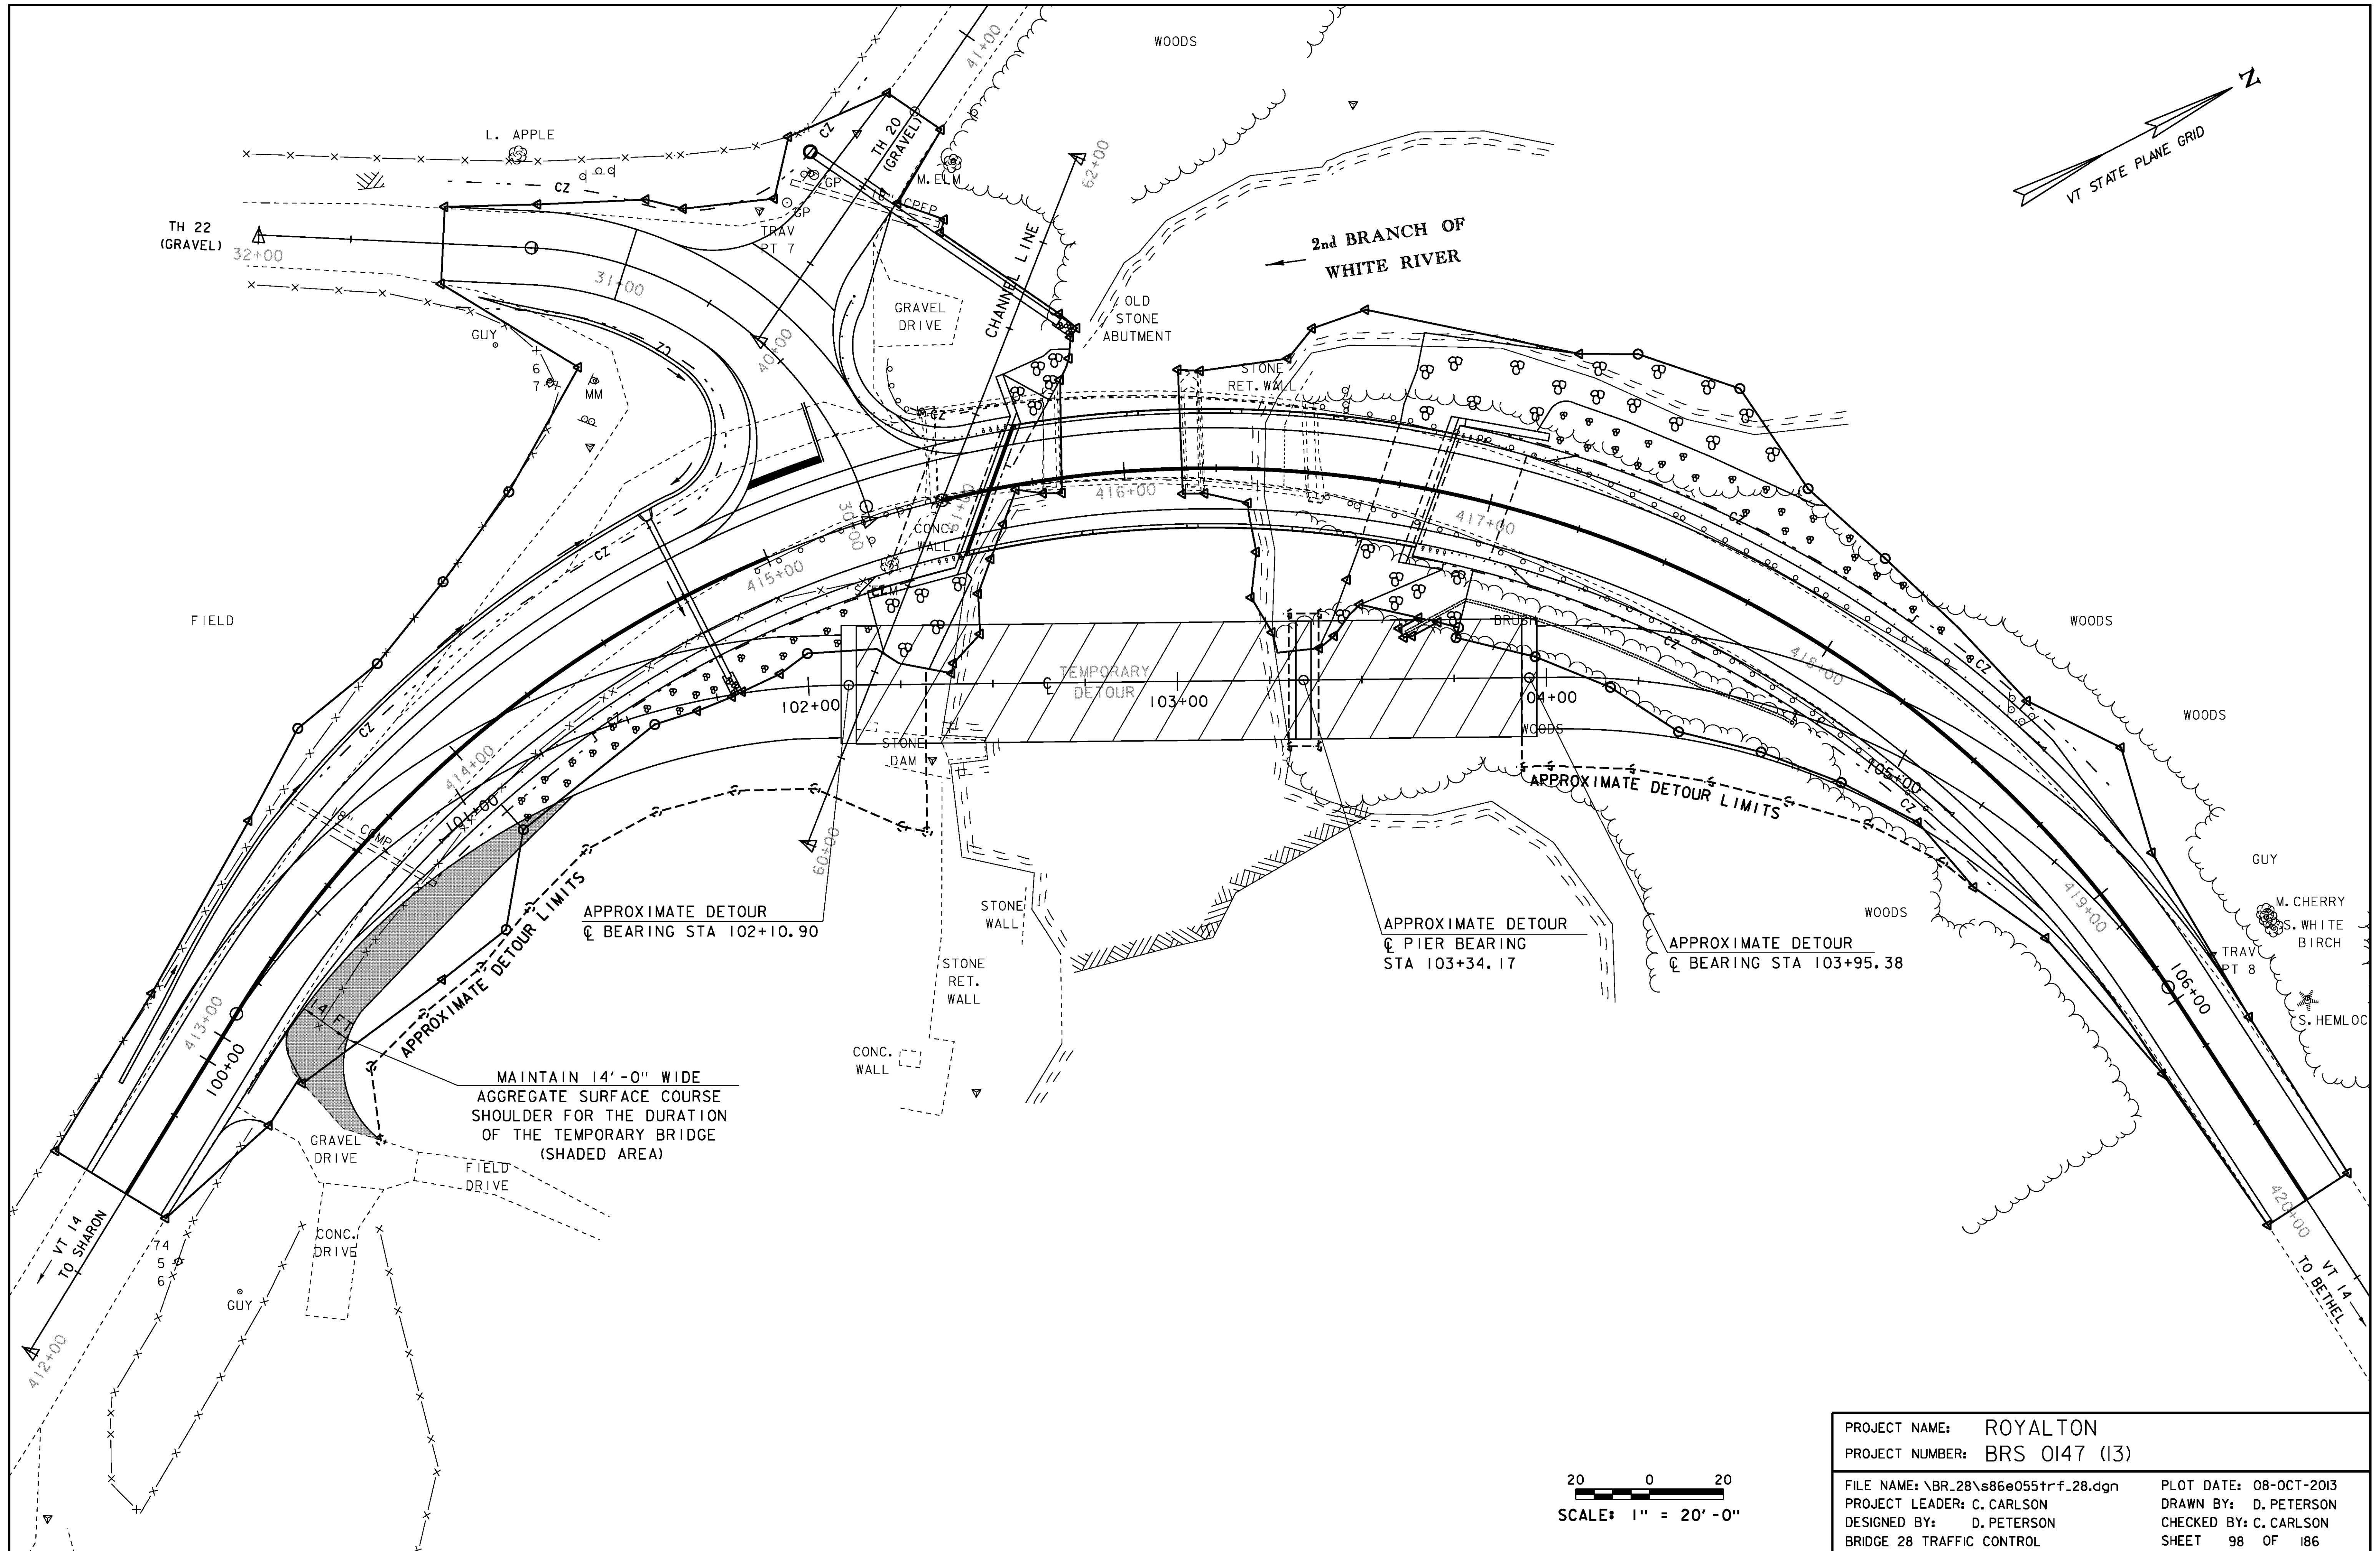

PROJECT NAME:	ROYALTON	FILE NAME:	\BR_28\s86e055trf_28.dgn	PLOT DATE:	08-OCT-2013
PROJECT NUMBER:	BRS 0147 (13)	PROJECT LEADER:	C. CARLSON	DRAWN BY:	D. PETERSON
		DESIGNED BY:	D. PETERSON	CHECKED BY:	C. CARLSON
		BRIDGE 28 TRAFFIC CONTROL		SHEET	98 OF 186

20 0 20  
SCALE: 1" = 20'-0"

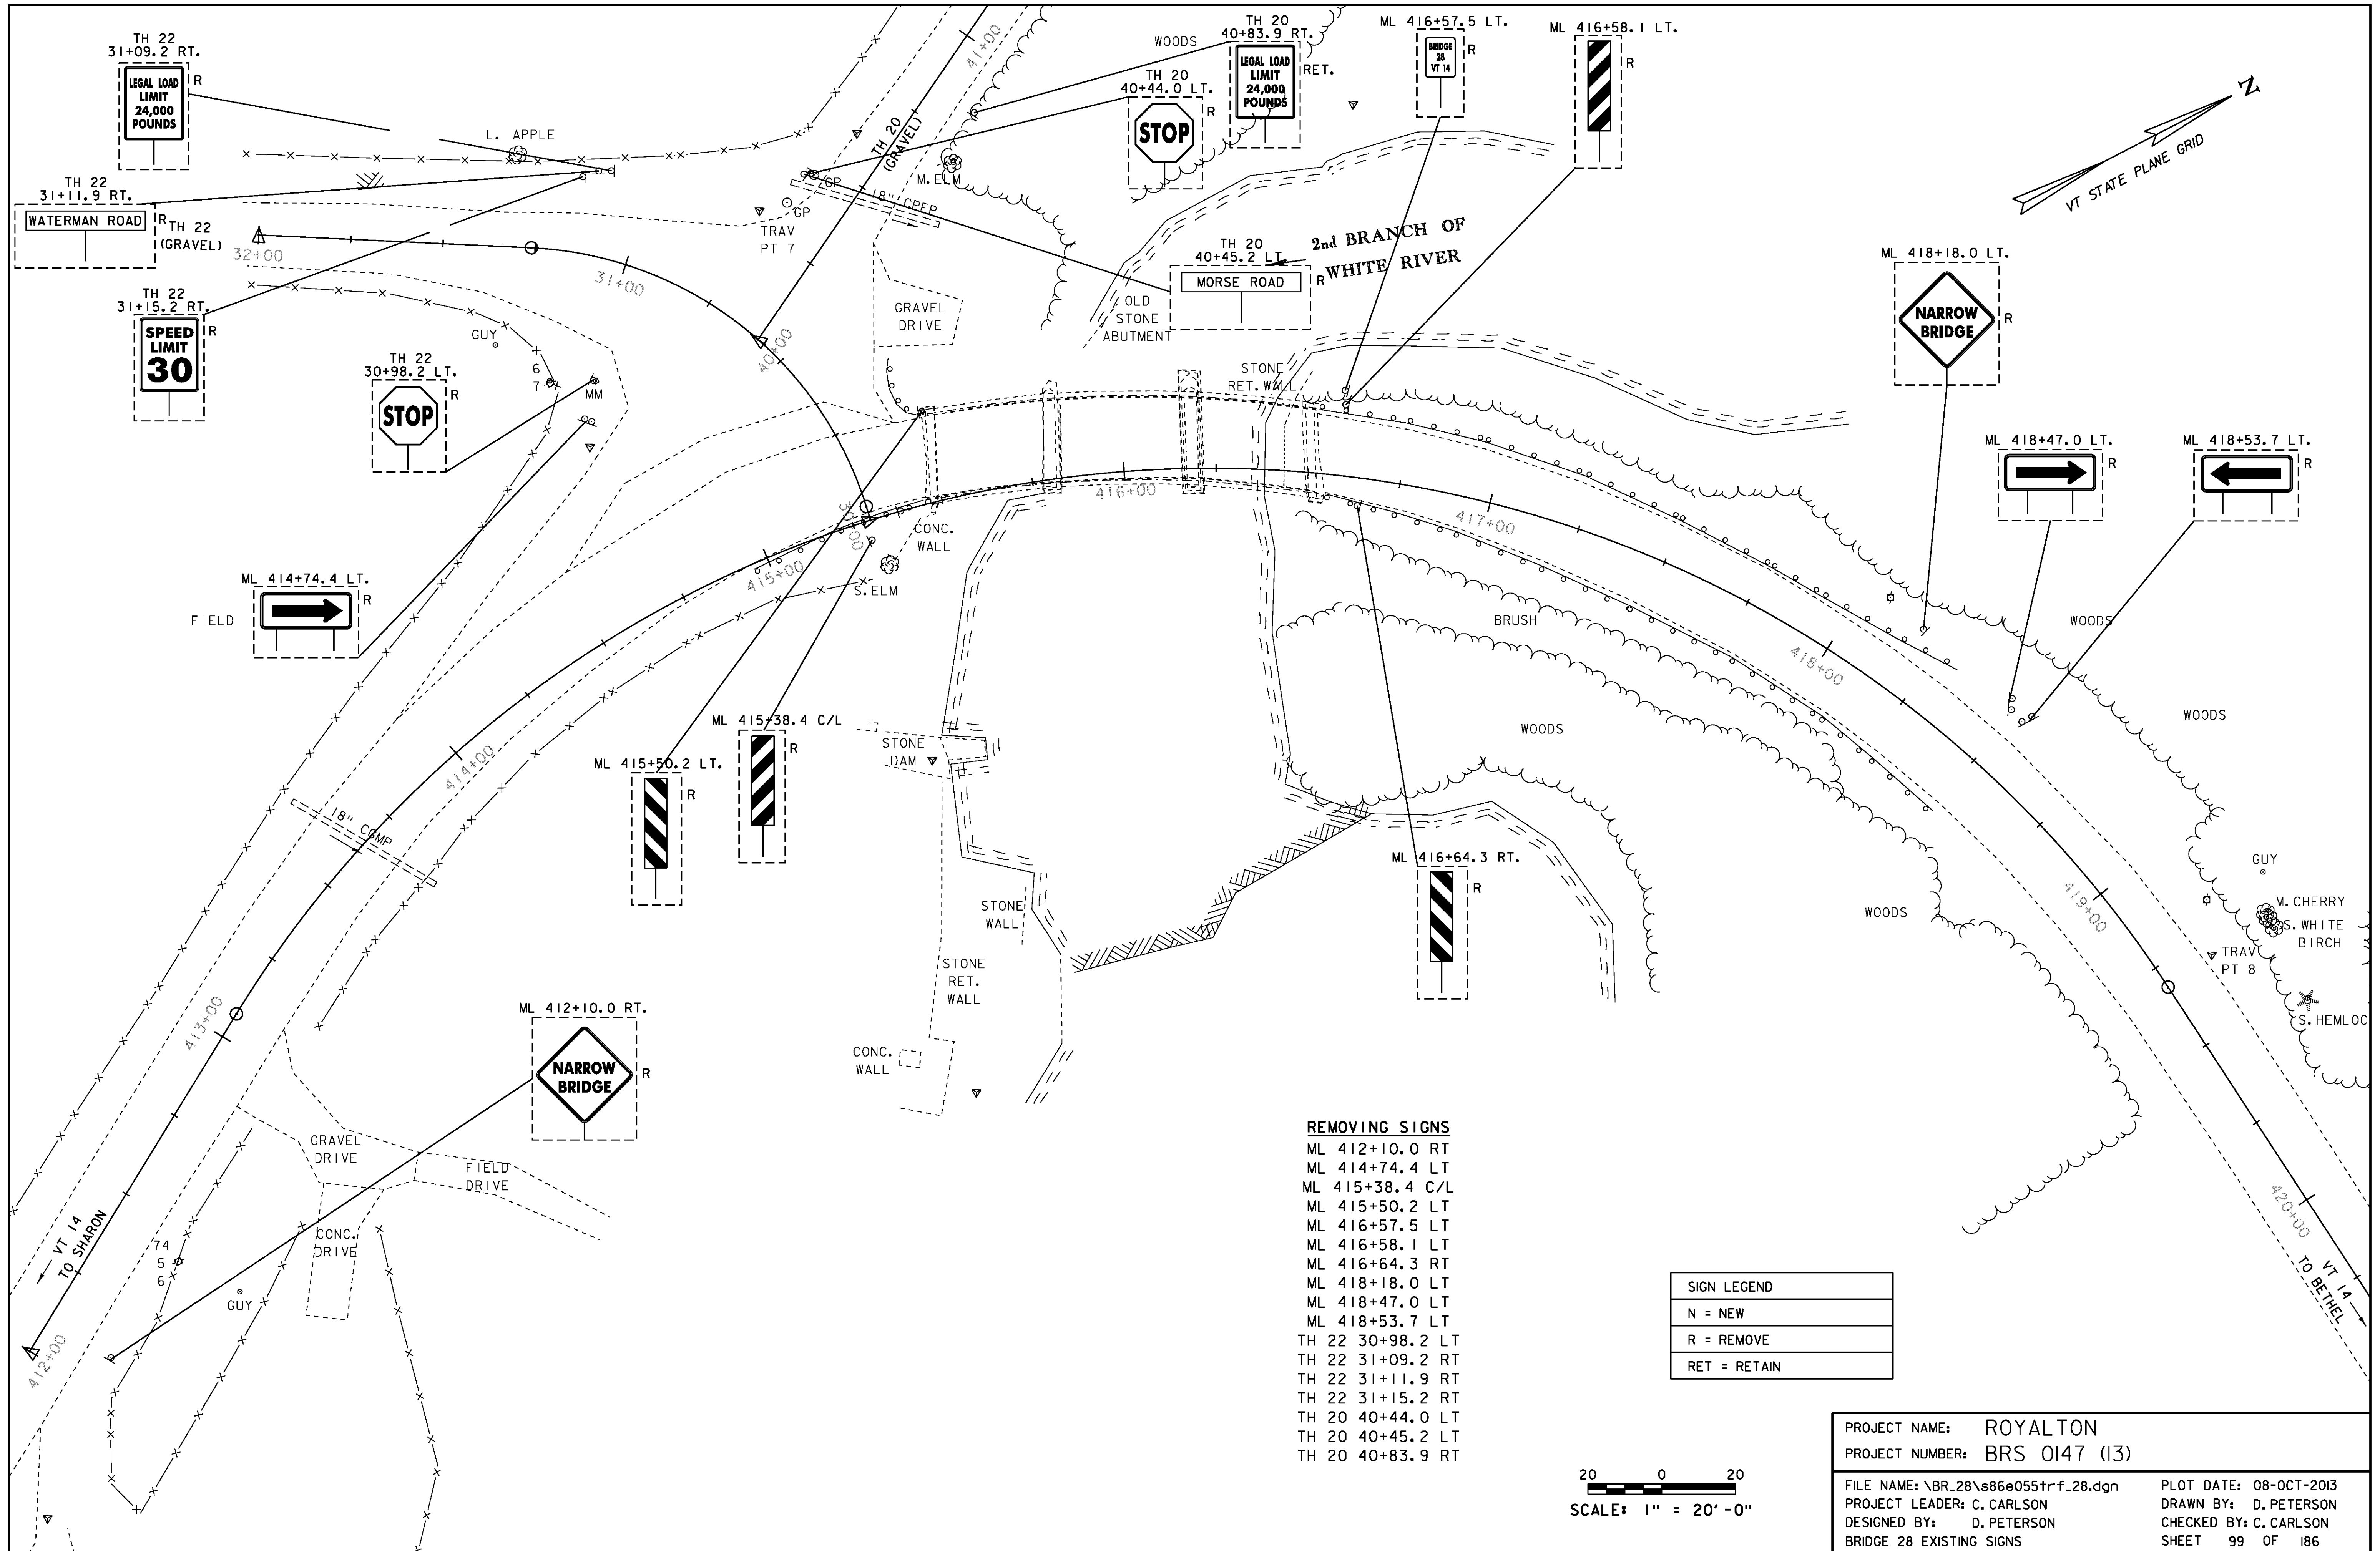


**REMOVING SIGNS**

- ML 412+10.0 RT
- ML 414+74.4 LT
- ML 415+38.4 C/L
- ML 415+50.2 LT
- ML 416+57.5 LT
- ML 416+58.1 LT
- ML 416+64.3 RT
- ML 418+18.0 LT
- ML 418+47.0 LT
- ML 418+53.7 LT
- TH 22 30+98.2 LT
- TH 22 31+09.2 RT
- TH 22 31+11.9 RT
- TH 22 31+15.2 RT
- TH 20 40+44.0 LT
- TH 20 40+45.2 LT
- TH 20 40+83.9 RT

SIGN LEGEND	
N	= NEW
R	= REMOVE
RET	= RETAIN

20 0 20  
 SCALE: 1" = 20'-0"

PROJECT NAME:	ROYALTON	FILE NAME:	\BR_28\86e055trf_28.dgn	PLOT DATE:	08-OCT-2013
PROJECT NUMBER:	BRS 0147 (13)	PROJECT LEADER:	C. CARLSON	DRAWN BY:	D. PETERSON
		DESIGNED BY:	D. PETERSON	CHECKED BY:	C. CARLSON
		BRIDGE 28 EXISTING SIGNS		SHEET	99 OF 186

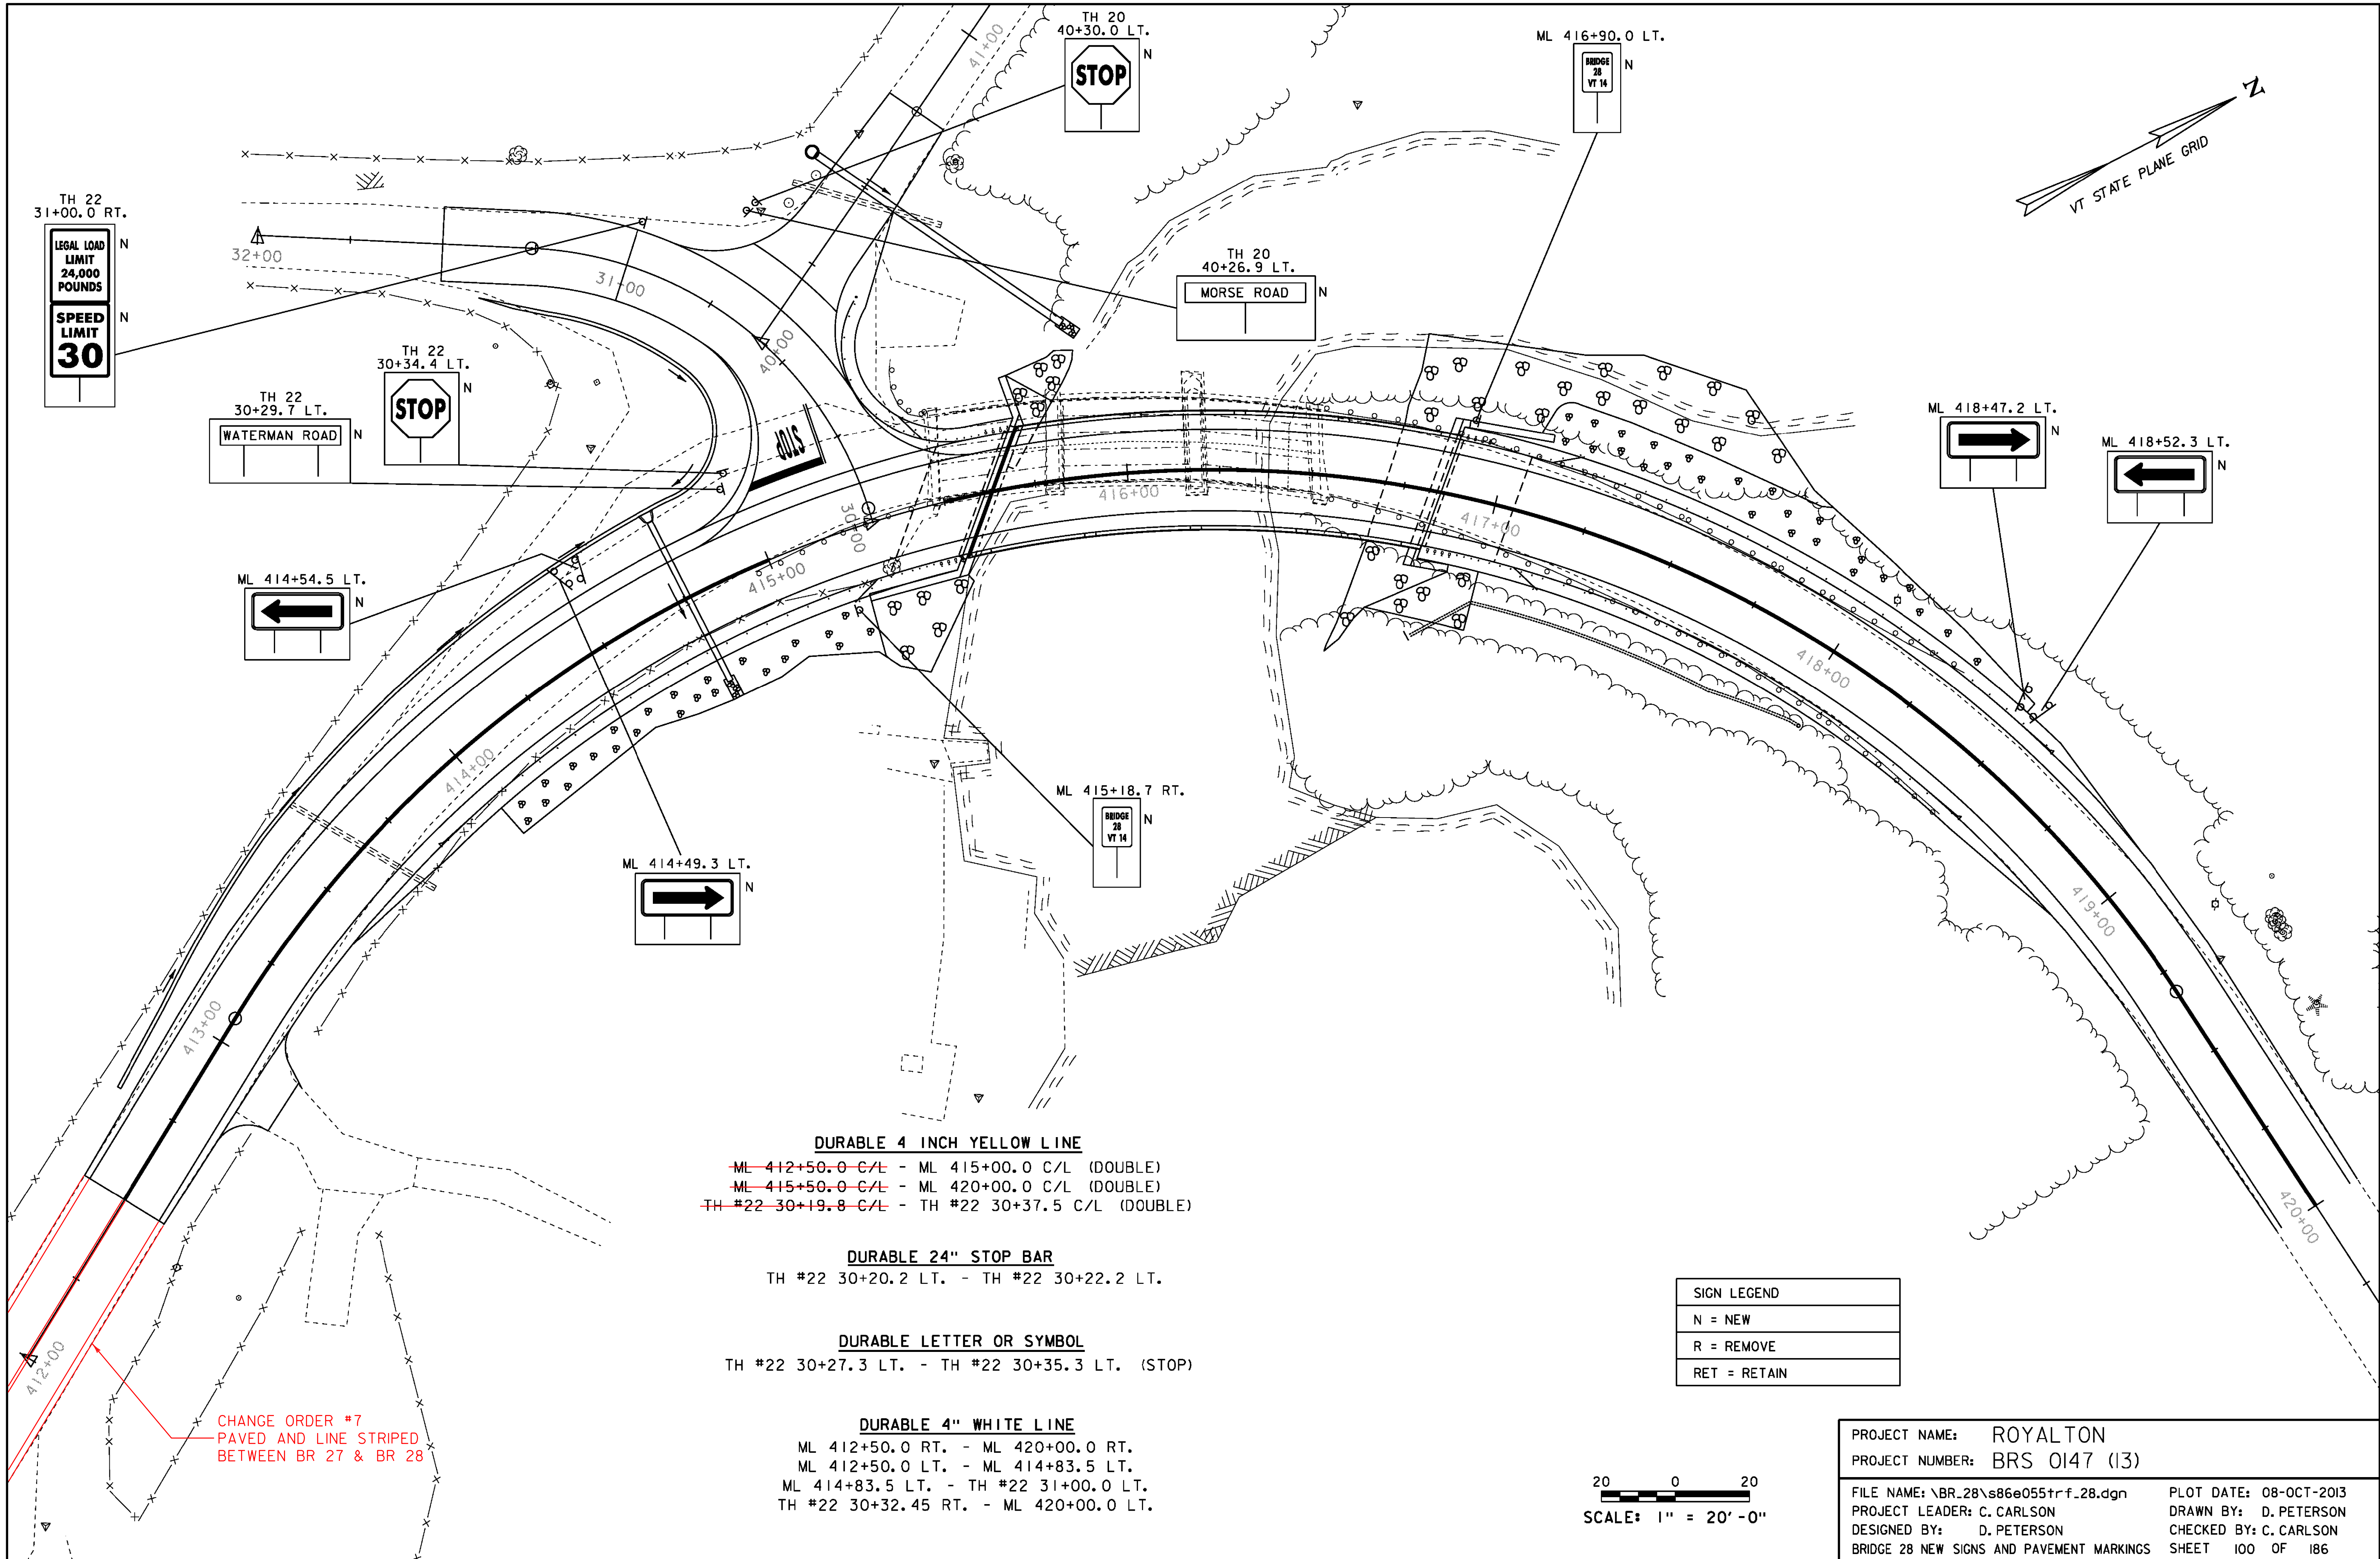

TH 22  
31+00.0 RT.  
LEGAL LOAD  
LIMIT  
24,000  
POUNDS  
SPEED  
LIMIT  
30

TH 22  
30+29.7 LT.  
WATERMAN ROAD

TH 22  
30+34.4 LT.  
STOP

TH 20  
40+30.0 LT.  
STOP

TH 20  
40+26.9 LT.  
MORSE ROAD

ML 416+90.0 LT.  
BRIDGE  
28  
VT 14

ML 414+54.5 LT.  
←

ML 414+49.3 LT.  
→

ML 415+18.7 RT.  
BRIDGE  
28  
VT 14

ML 418+47.2 LT.  
→

ML 418+52.3 LT.  
←

**DURABLE 4 INCH YELLOW LINE**  
~~ML 412+50.0 C/L - ML 415+00.0 C/L (DOUBLE)~~  
~~ML 415+50.0 C/L - ML 420+00.0 C/L (DOUBLE)~~  
~~TH #22 30+19.8 C/L - TH #22 30+37.5 C/L (DOUBLE)~~

**DURABLE 24" STOP BAR**  
 TH #22 30+20.2 LT. - TH #22 30+22.2 LT.

**DURABLE LETTER OR SYMBOL**  
 TH #22 30+27.3 LT. - TH #22 30+35.3 LT. (STOP)


**DURABLE 4" WHITE LINE**  
 ML 412+50.0 RT. - ML 420+00.0 RT.  
 ML 412+50.0 LT. - ML 414+83.5 LT.  
 ML 414+83.5 LT. - TH #22 31+00.0 LT.  
 TH #22 30+32.45 RT. - ML 420+00.0 LT.

CHANGE ORDER #7  
 PAVED AND LINE STRIPED  
 BETWEEN BR 27 & BR 28


SIGN LEGEND	
N	= NEW
R	= REMOVE
RET	= RETAIN

20 0 20  
 SCALE: 1" = 20'-0"

PROJECT NAME: ROYALTON  
 PROJECT NUMBER: BRS 0147 (13)  
 FILE NAME: \BR_28\86e055trf_28.dgn PLOT DATE: 08-OCT-2013  
 PROJECT LEADER: C. CARLSON DRAWN BY: D. PETERSON  
 DESIGNED BY: D. PETERSON CHECKED BY: C. CARLSON  
 BRIDGE 28 NEW SIGNS AND PAVEMENT MARKINGS SHEET 100 OF 186

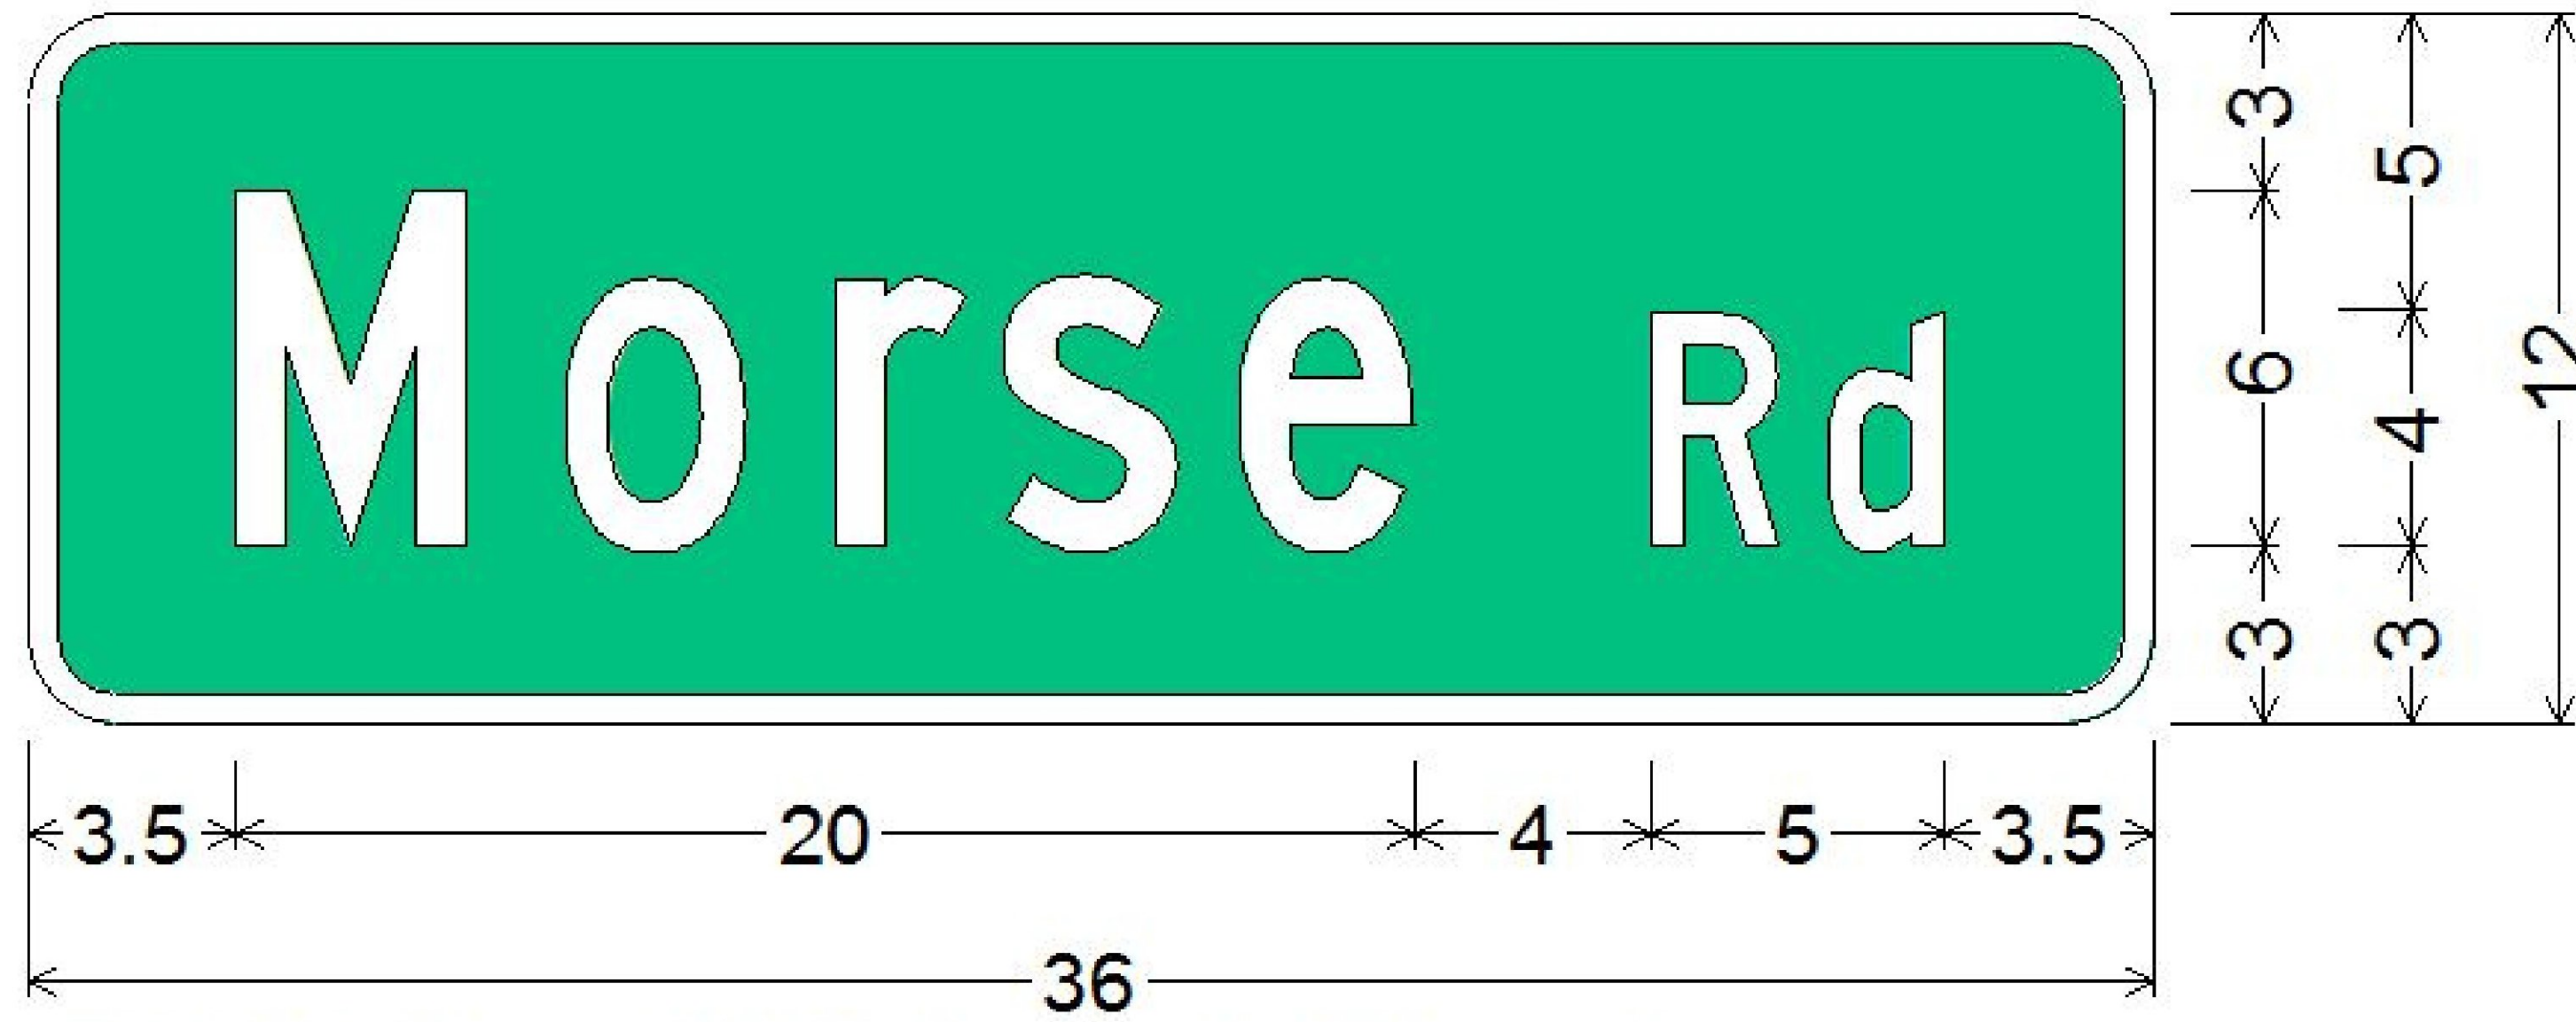

1.500" Radius, 0.500" Border, White on Green;

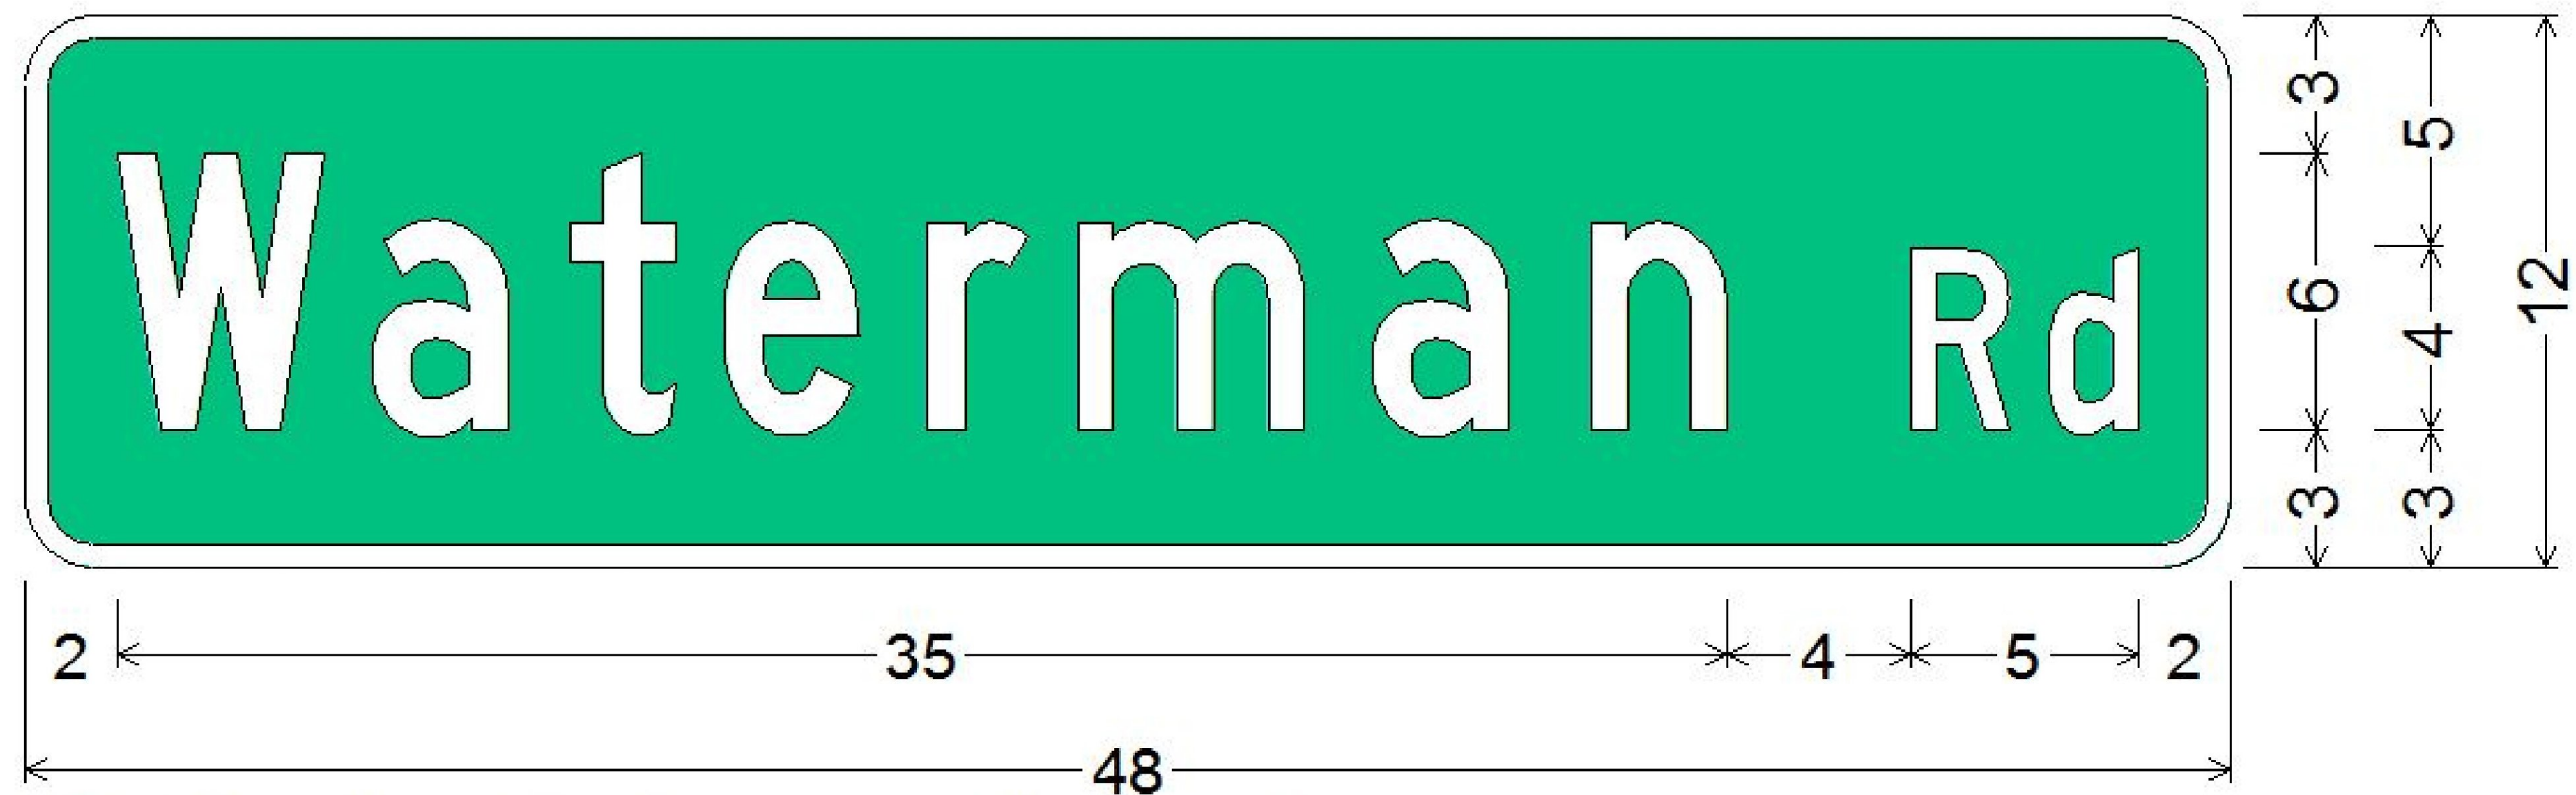

1.500" Radius, 0.500" Border, White on Green;

NOTES:  
ALL DIMENSIONS IN INCHES

PROJECT NAME: ROYALTON	PLOT DATE: 08-OCT-2013
PROJECT NUMBER: BRS 0147 (13)	DRAWN BY: D. PETERSON
FILE NAME: \BR_28\s86e055trf_28.dgn	CHECKED BY: C. CARLSON
DESIGNED BY: D. PETERSON	SHEET 101 OF 186
BRIDGE 28 SIGN DETAILS	

# TRAFFIC SIGN SUMMARY SHEET

MILEMARKER, STATION, OR SIGN NUMBER	SIGN LEGEND	SIGN DIMENSIONS		NEW & SALVAGED SIGNS				EXIST. POST	NO. OF POSTS	NEW SIGN POSTS																REMARKS	SIGN DETAIL			
				"A"	"B"	SALV SIGN	SALV TIS			FLANGED CHANNEL			SQUARE STEEL (in)			TUBULAR ALUMINUM (in)			TUBULAR STEEL (in)			W-SHAPE STEEL			DETAIL ON SHEET NUMBER		STD. SHEET NUMBER			
		1.12	2.0							3.0	1.75	2.0	2.5	3.0	4.0	4.0 MOD	3.0	3.5	4.0	5.0	FTG. SIZE	WEIGHT	POST SIZE							
		lb/ft			lb/ft					lb/ft			lb/ft			24"	30"													
VT 14 414+49.3 LT.		48"	24"	8.0					2																		MUTCD W1-6			
VT 14 414+54.5 LT.		48"	24"	8.0					2																			MUTCD W1-6		
VT 14 415+18.7 RT.	BRIDGE 28 VT 14	6"	8"	0.3					1																			VD-701	E-134	
VT 14 416+90.0 LT.	BRIDGE 28 VT 14	6"	8"	0.3					1																			VD-701	E-134	
VT 14 418+47.2 LT.		48"	24"	8.0					2																			MUTCD W1-6		
VT 14 418+52.3 LT.		48"	24"	8.0					2																			MUTCD W1-6		
TH #22 30+29.7 LT.	WATERMAN ROAD	48"	12"	4.0					2																			MUTCD D3-1, WHITE ON GREEN		
TH #22 30+34.4 LT.		30"	30"	6.3					1																			MUTCD R1-1		
TH #22 31+00.0 RT.	LEGAL LOAD LIMIT 24,000 POUNDS	24"	30"	5.0					1																			VR-017	E-141	
TH #22 31+00.0 RT.	SPEED LIMIT 30	24"	30"	5.0					1																			MUTCD R2-1		
TH #20 40+26.9 LT.	MORSE ROAD	36"	12"	3.0					1																			MUTCD D3-1, WHITE ON GREEN		
TH #20 40+30.0 LT.		30"	30"	6.3					1																			MUTCD R1-1		
VT 14 411+00 RT.	35 MPH	36" 18"	36" 18"	9.0 2.25					1																				ADDED DURING FINAL INSPECTION	
VT 14 422+00 LT.	35 MPH	36" 18"	36" 18"	9.0 2.25					1																				ADDED DURING FINAL INSPECTION	
VT 14 389+95 RT. 390+34 LT.	BRIDGE 27 VT 14	6" 6"	8" 8"	0.3 0.3					1																				ADDED DURING FINAL INSPECTION	
<p>FINAL POST LENGTHS ARE TO BE DETERMINED IN THE FIELD. POST SIZES ARE COMPUTED BASED ON INFORMATION FURNISHED ON THE STANDARD SHEETS AND THE TRAFFIC &amp; SAFETY DIVISION'S "SIGN POST DESIGN GUIDELINE."</p>										<p>FT FT FT FT FT FT FT EA LB LB LB LB LB LB LB LB LB LB LB LB</p>										<p>TOTALS SF 86.3 62.2 SF EA. SF</p>		<p>EA. LB</p>								
										<p>30 243.45 230</p>										<p>EA. EA. LB</p>		<p>EA. EA. LB</p>								
										<p>243.45 260</p>										<p>EA. EA. LB</p>		<p>EA. EA. LB</p>								

PROJECT NAME: ROYALTON  
PROJECT NUMBER: BRS 0147 (13)  
FILE NAME: \BR_28\86e055trf_28.dgn PLOT DATE: 08-OCT-2013  
PROJECT LEADER: C. CARLSON DRAWN BY: L. BULLOCK  
DESIGNED BY: L. BULLOCK CHECKED BY: D. PETERSON  
BRIDGE 28 TRAFFIC SIGN SUMMARY SHEET 102 OF 186

**SOIL CLASSIFICATION**

AASHTO

A1	Gravel and Sand
A3	Fine Sand
A2	Silty or Clayey Gravel and Sand
A4	Silty Soil - Low Compressibility
A5	Silty Soil - Highly Compressible
A6	Clayey Soil - Low Compressibility
A7	Clayey Soil - Highly Compressible

**ROCK QUALITY DESIGNATION**

R.Q.D. (%)	ROCK DESCRIPTION
<25	Very Poor
25 to 50	Poor
51 to 75	Fair
76 to 90	Good
>90	Excellent

**SHEAR STRENGTH**

UNDRAINED SHEAR STRENGTH IN P.S.F.	CONSISTENCY
<250	Very Soft
250-500	Soft
500-1000	Med. Stiff
1000-2000	Stiff
2000-4000	Very Stiff
>4000	Hard

**CORRELATION GUIDE OF "N" TO DENSITY/CONSISTENCY**


DENSITY (GRANULAR SOILS)		CONSISTENCY (COHESIVE SOILS)	
N	DESCRIPTIVE TERM	N	DESCRIPTIVE TERM
<5	Very Loose	<2	Very Soft
5-10	Loose	2-4	Soft
11-24	Med. Dense	5-8	Med. Stiff
25-50	Dense	9-15	Stiff
>50	Very Dense	16-30	Very Stiff
		31-60	Hard
		>60	Very Hard

**COMMONLY USED SYMBOLS**

- ▼ Water Elevation
- ⊕ Standard Penetration Boring
- ⊙ Auger Boring
- Rod Sounding
- S Sample
- N Standard Penetration Test
- Blow Count Per Foot For:
  - 2" O.D. Sampler
  - 1 3/8" I.D. Sampler
  - Hammer Weight Of 140 Lbs.
  - Hammer Fall Of 30"
- VS Field Vane Shear Test
- US Undisturbed Soil Sample
- B Blast
- DC Diamond Core
- MD Mud Drill
- WA Wash Ahead
- HSA Hollow Stem Auger
- AX Core Size 1 1/8"
- BX Core Size 1 5/8"
- NX Core Size 2 1/8"
- M Double Tube Core Barrel Used
- LL Liquid Limit
- PL Plastic Limit
- PI Plasticity Index
- NP Non Plastic
- w Moisture Content (Dry Wgt. Basis)
- D Dry
- M Moist
- MTW Moist To Wet
- W Wet
- Sat Saturated
- Bo Boulder
- Gr Gravel
- Sa Sand
- SI Silt
- Cl Clay
- HP Hardpan
- Le Ledge
- NLTD No Ledge To Depth
- CNPF Can Not Penetrate Further
- TLOB To Ledge Or Boulder
- NR No Recovery
- Rec. Recovery
- %Rec. Percent Recovery
- RQD Rock Quality Designation
- CBR California Bearing Ratio
- < Less Than
- > Greater Than
- R Refusal (N > 100)

**COLOR**

blk	Black	pnk	Pink
bl	Blue	pu	Purple
brn	Brown	rd	Red
dk	Dark	tn	Tan
gry	Gray	wh	White
gn	Green	yel	Yellow
lt	Light	mltc	Multicolored
or	Orange		

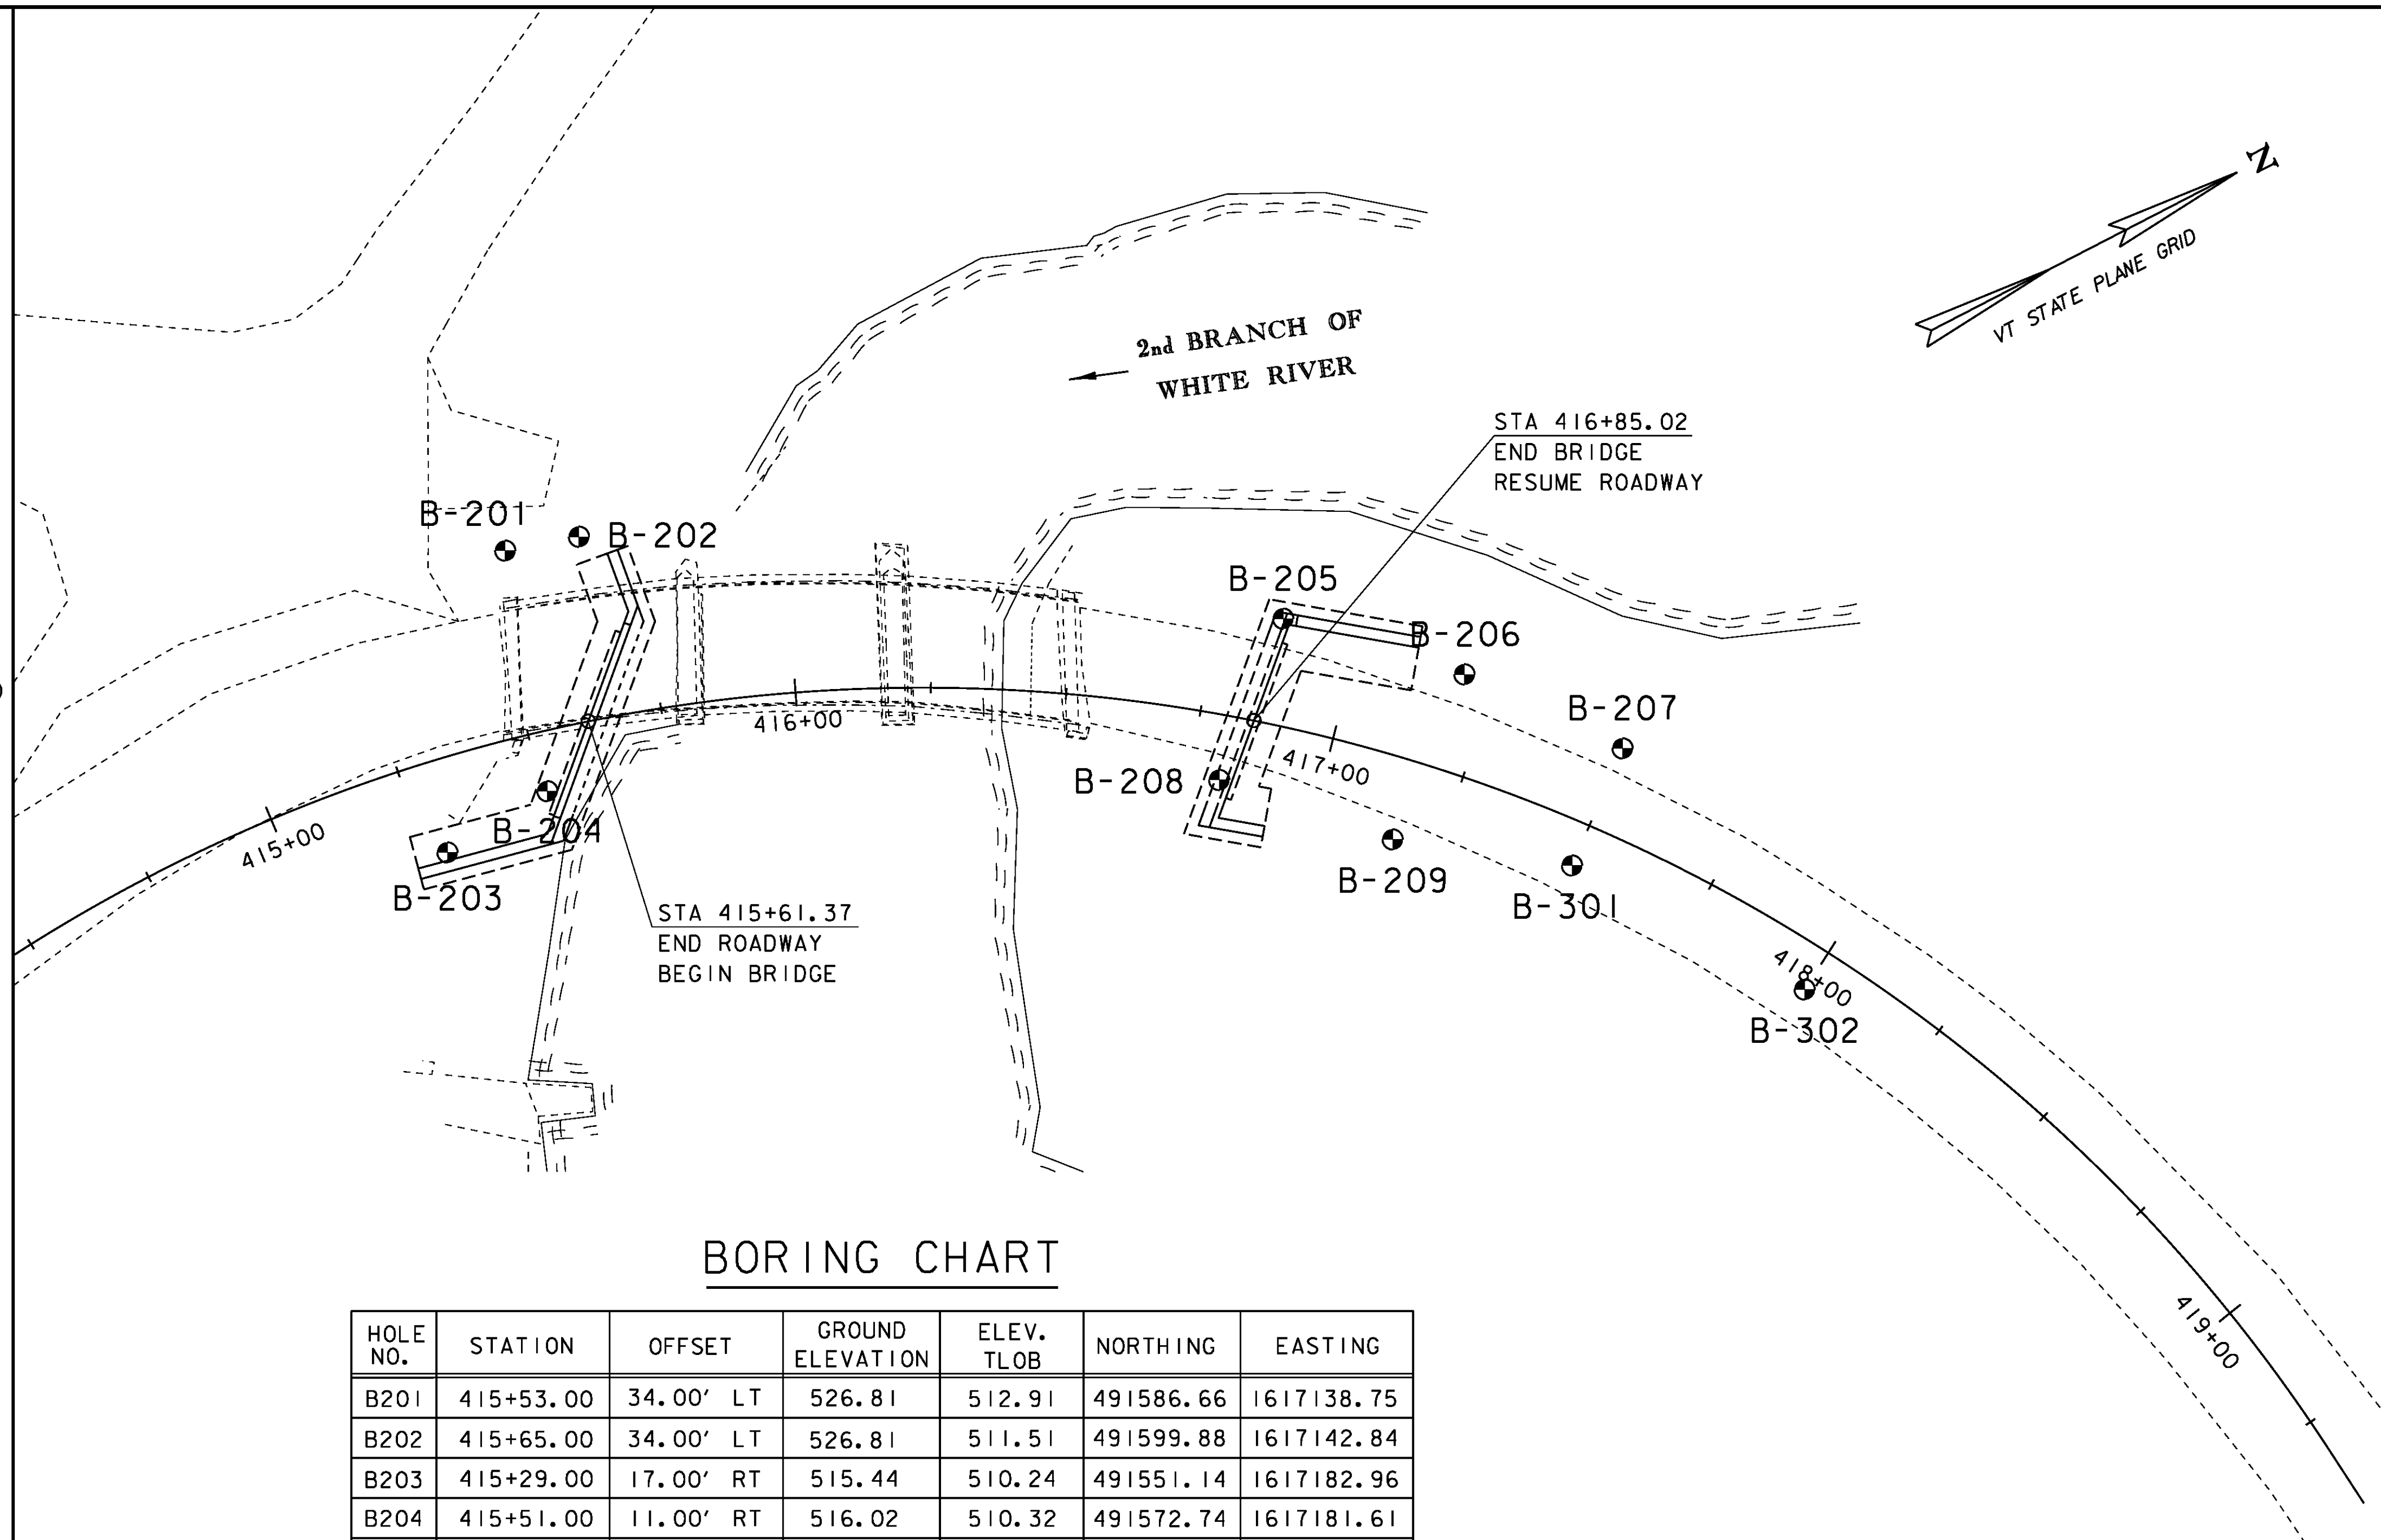

**BORING CHART**


HOLE NO.	STATION	OFFSET	GROUND ELEVATION	ELEV. TLOB	NORTHING	EASTING
B201	415+53.00	34.00' LT	526.81	512.91	491586.66	1617138.75
B202	415+65.00	34.00' LT	526.81	511.51	491599.88	1617142.84
B203	415+29.00	17.00' RT	515.44	510.24	491551.14	1617182.96
B204	415+51.00	11.00' RT	516.02	510.32	491572.74	1617181.61
B205	416+86.00	19.50' LT	524.51	507.31	491707.61	1617217.07
B206	417+19.51	18.00' LT	524.42	500.92	491732.35	1617241.83
B207	417+50.00	15.50' LT	524.55	502.35	491751.73	1617267.58
B208	416+81.00	12.00' RT	523.03	508.03	491683.23	1617237.85
B209	417+16.00	15.00' RT	521.52	503.52	491706.37	1617262.54
B301	417+50.00	8.00' RT	523.30	494.70	491733.36	1617282.29
B302	418+00.00	8.00' RT	523.50	482.70	491760.57	1617322.62

**DEFINITIONS (AASHTO)**

- BEDROCK (LEDGE)** - Rock in its native location of indefinite thickness.
- BOULDER** - A rock fragment with an average dimension > 12 inches.
- COBBLE** - Rock fragments with an average dimension between 3 and 12 inches.
- GRAVEL** - Rounded particles of rock < 3" and > 0.075" (#10 sieve).
- SAND** - Particles of rock < 0.075" (#10 sieve) and > 0.0025" (#200 sieve).
- SILT** - Soil < 0.0025" (#200 sieve), non or slightly plastic and exhibits no strength when air-dried.
- CLAY** - Fine grained soil, exhibits plasticity when moist and considerable strength when air-dried.
- VARVED** - Alternate layers of silt and clay.
- HARDPAN** - Extremely dense soil, cemented layer, not softened when wet.
- MUCK** - Soft organic soil (containing > 10% organic material).
- MOISTURE CONTENT** - Weight of water divided by dry weight of soil.
- FLOWING SAND** - Granular soil so saturated (loose) that it flows into drill casing during extraction of wash rod.
- STRIKE** - Angle from magnetic north to line of intersection of bed with a horizontal plane.
- DIP** - Inclination of bed with a horizontal plane.

**GENERAL NOTES**




- The subsurface explorations shown herein were made between 06/14/2006 and 08/26/2006 by the Agency.
- Soil and rock classifications, properties and descriptions are based on engineering interpretation from available subsurface information by the Agency and may not necessarily reflect actual variations in subsurface conditions that may be encountered between individual boring or sample locations.
- Observed water levels and/or conditions indicated are as recorded at the time of exploration and may vary according to the prevailing rainfall, methods of exploration and other factors.
- Engineering judgement was exercised in preparing the subsurface information presented herein. Analysis and interpretation of subsurface data was performed and interpreted for Agency design and estimating purposes. Presentation of the information in the Contract is intended to provide the Contractor access to the same data available to the Agency. The subsurface information is presented in good faith and is not intended as a substitute for personal investigation, independent interpretation, independent analysis or judgement by the Contractor.
- Pictorial structure details shown on the boring plan layout or soils profile are for illustrative purposes only and may not accurately portray final contract details.
- Terminology used on boring logs to describe the hardness, degree of weathering, and spacing of fractures, joints and other discontinuities in the bedrock is defined in the AASHTO Manual on Subsurface Investigations, 1988.

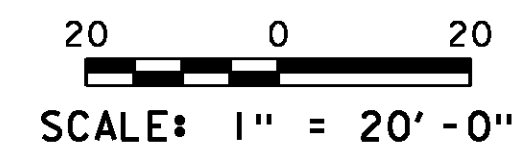

PROJECT NAME: ROYALTON  
PROJECT NUMBER: BRS 0147 (13)

FILE NAME: \BR 28\86e055bor_28.dgn  
PROJECT LEADER: C. CARLSON  
DESIGNED BY: D. PETERSON  
BRIDGE 28 BORING LAYOUT

PLOT DATE: 08-OCT-2013  
DRAWN BY: G. ROY  
CHECKED BY: D. PETERSON  
SHEET 103 OF 186

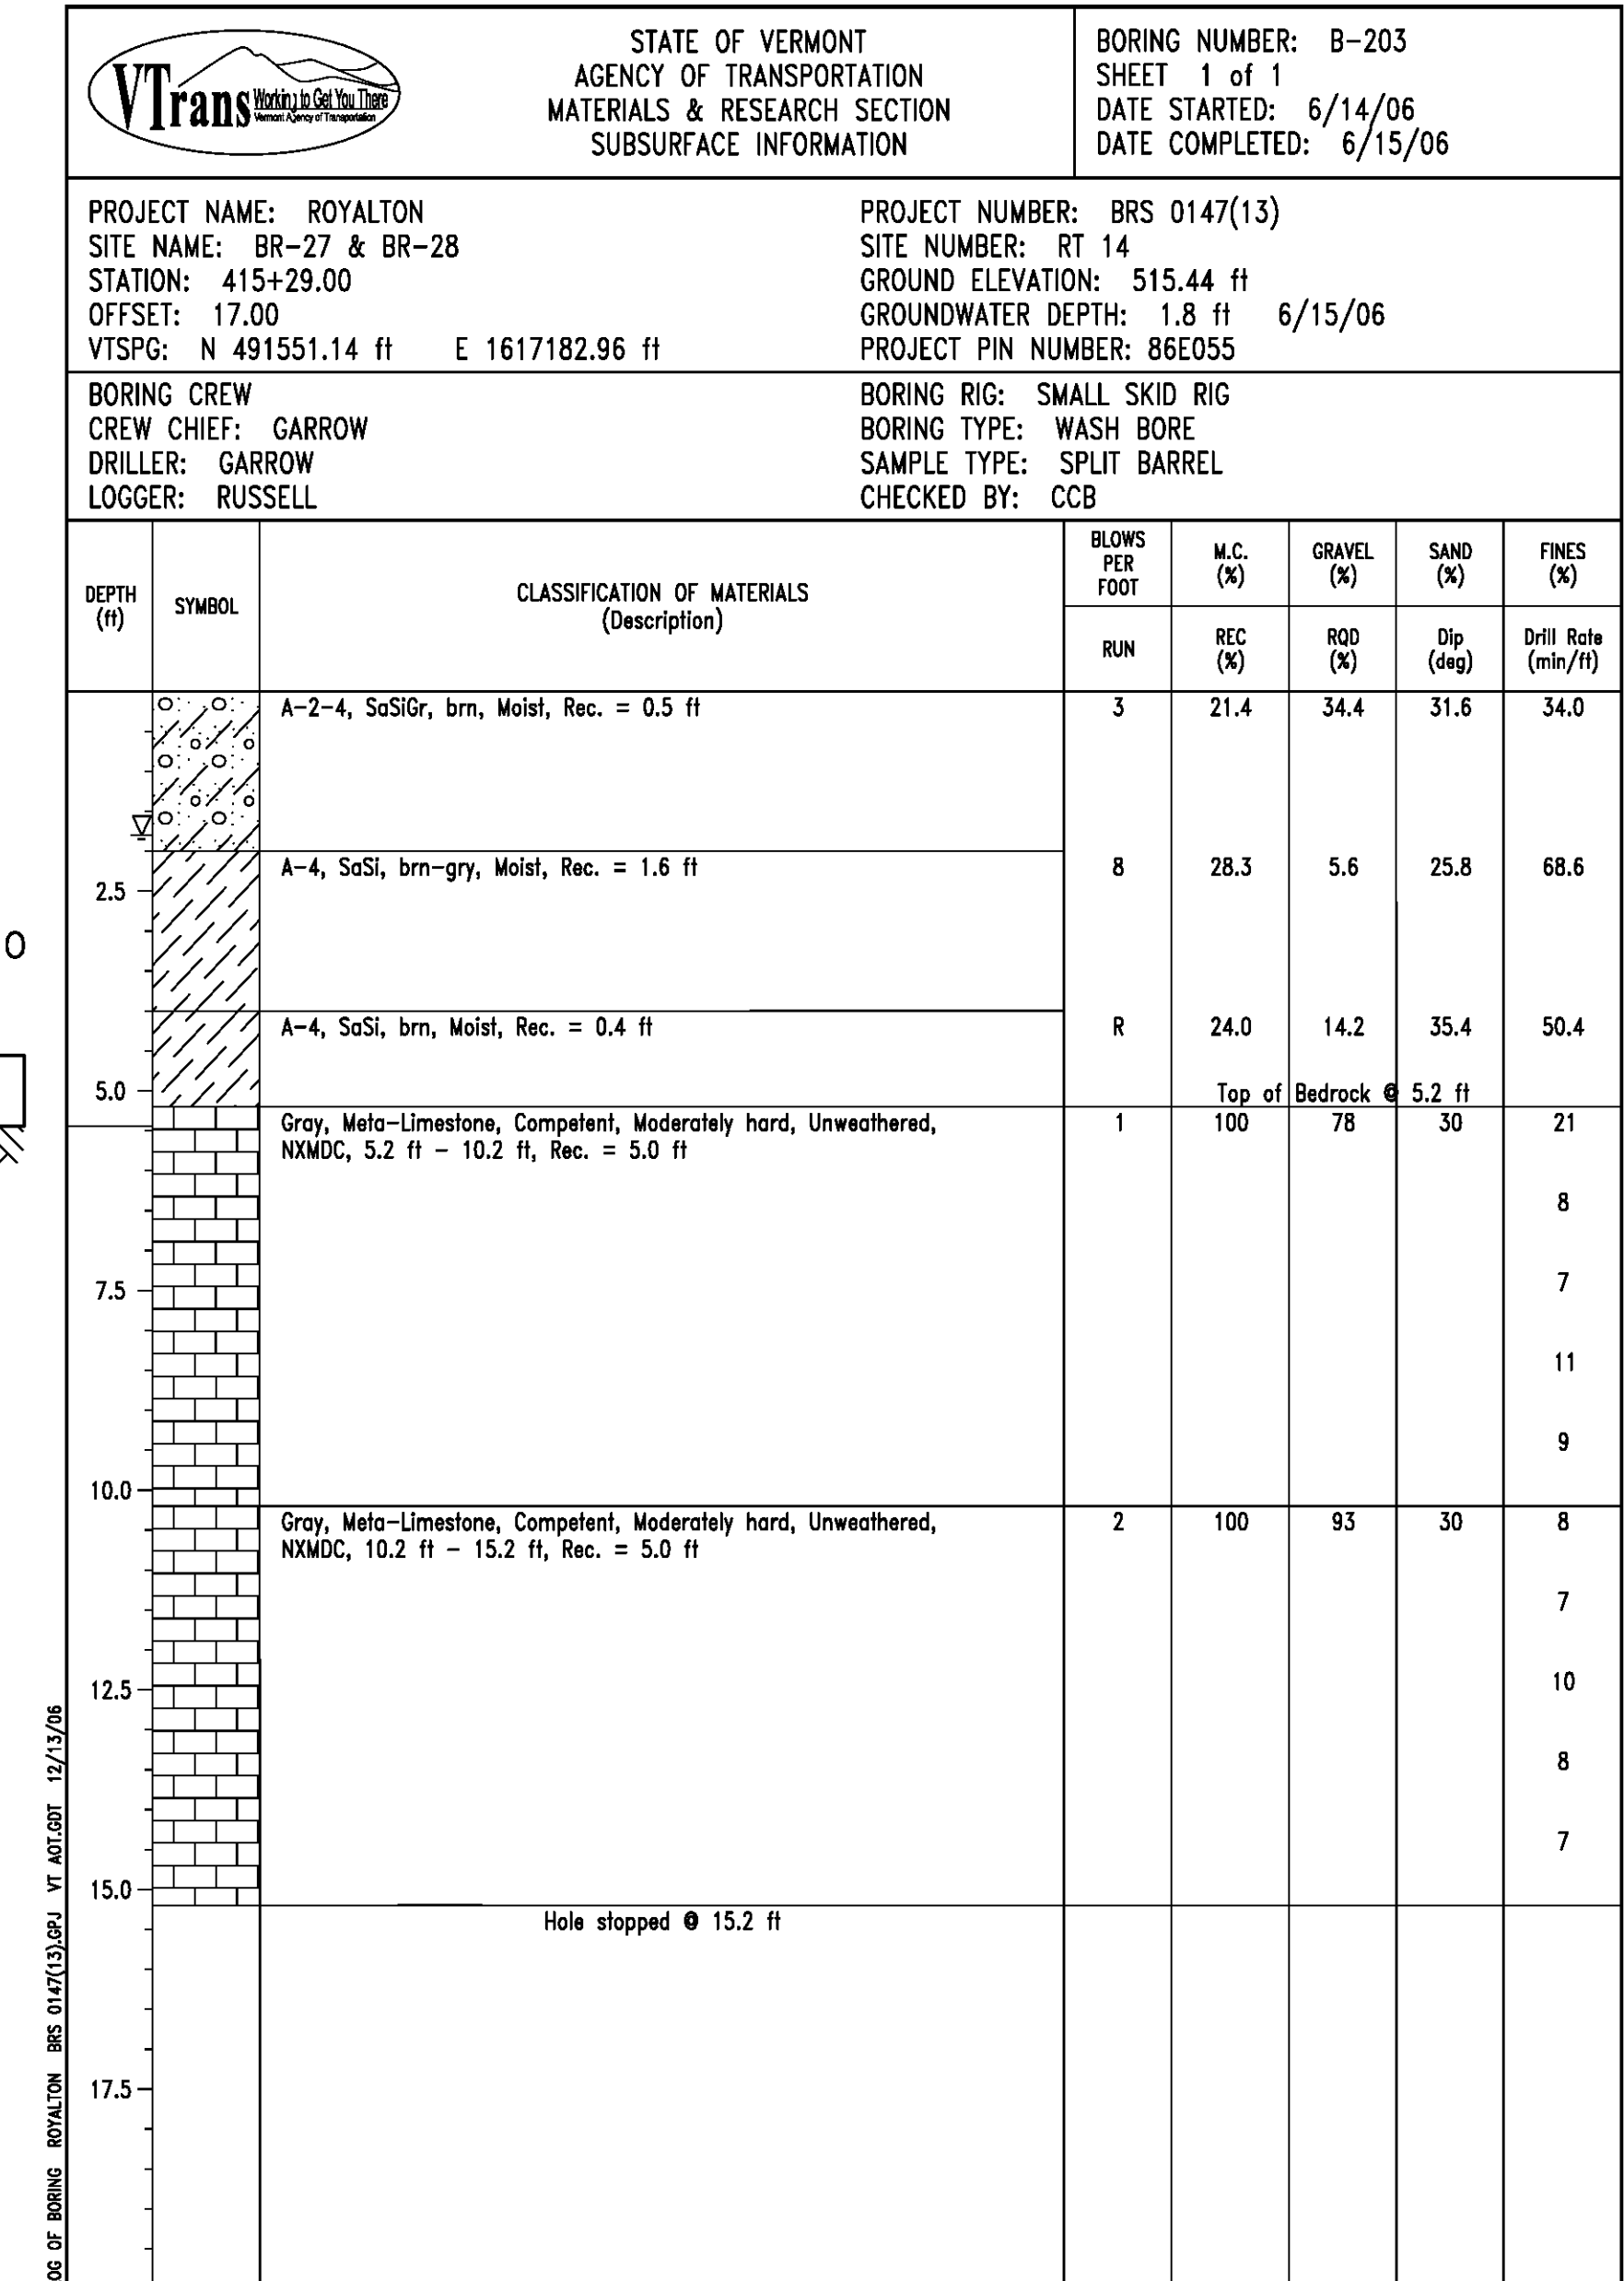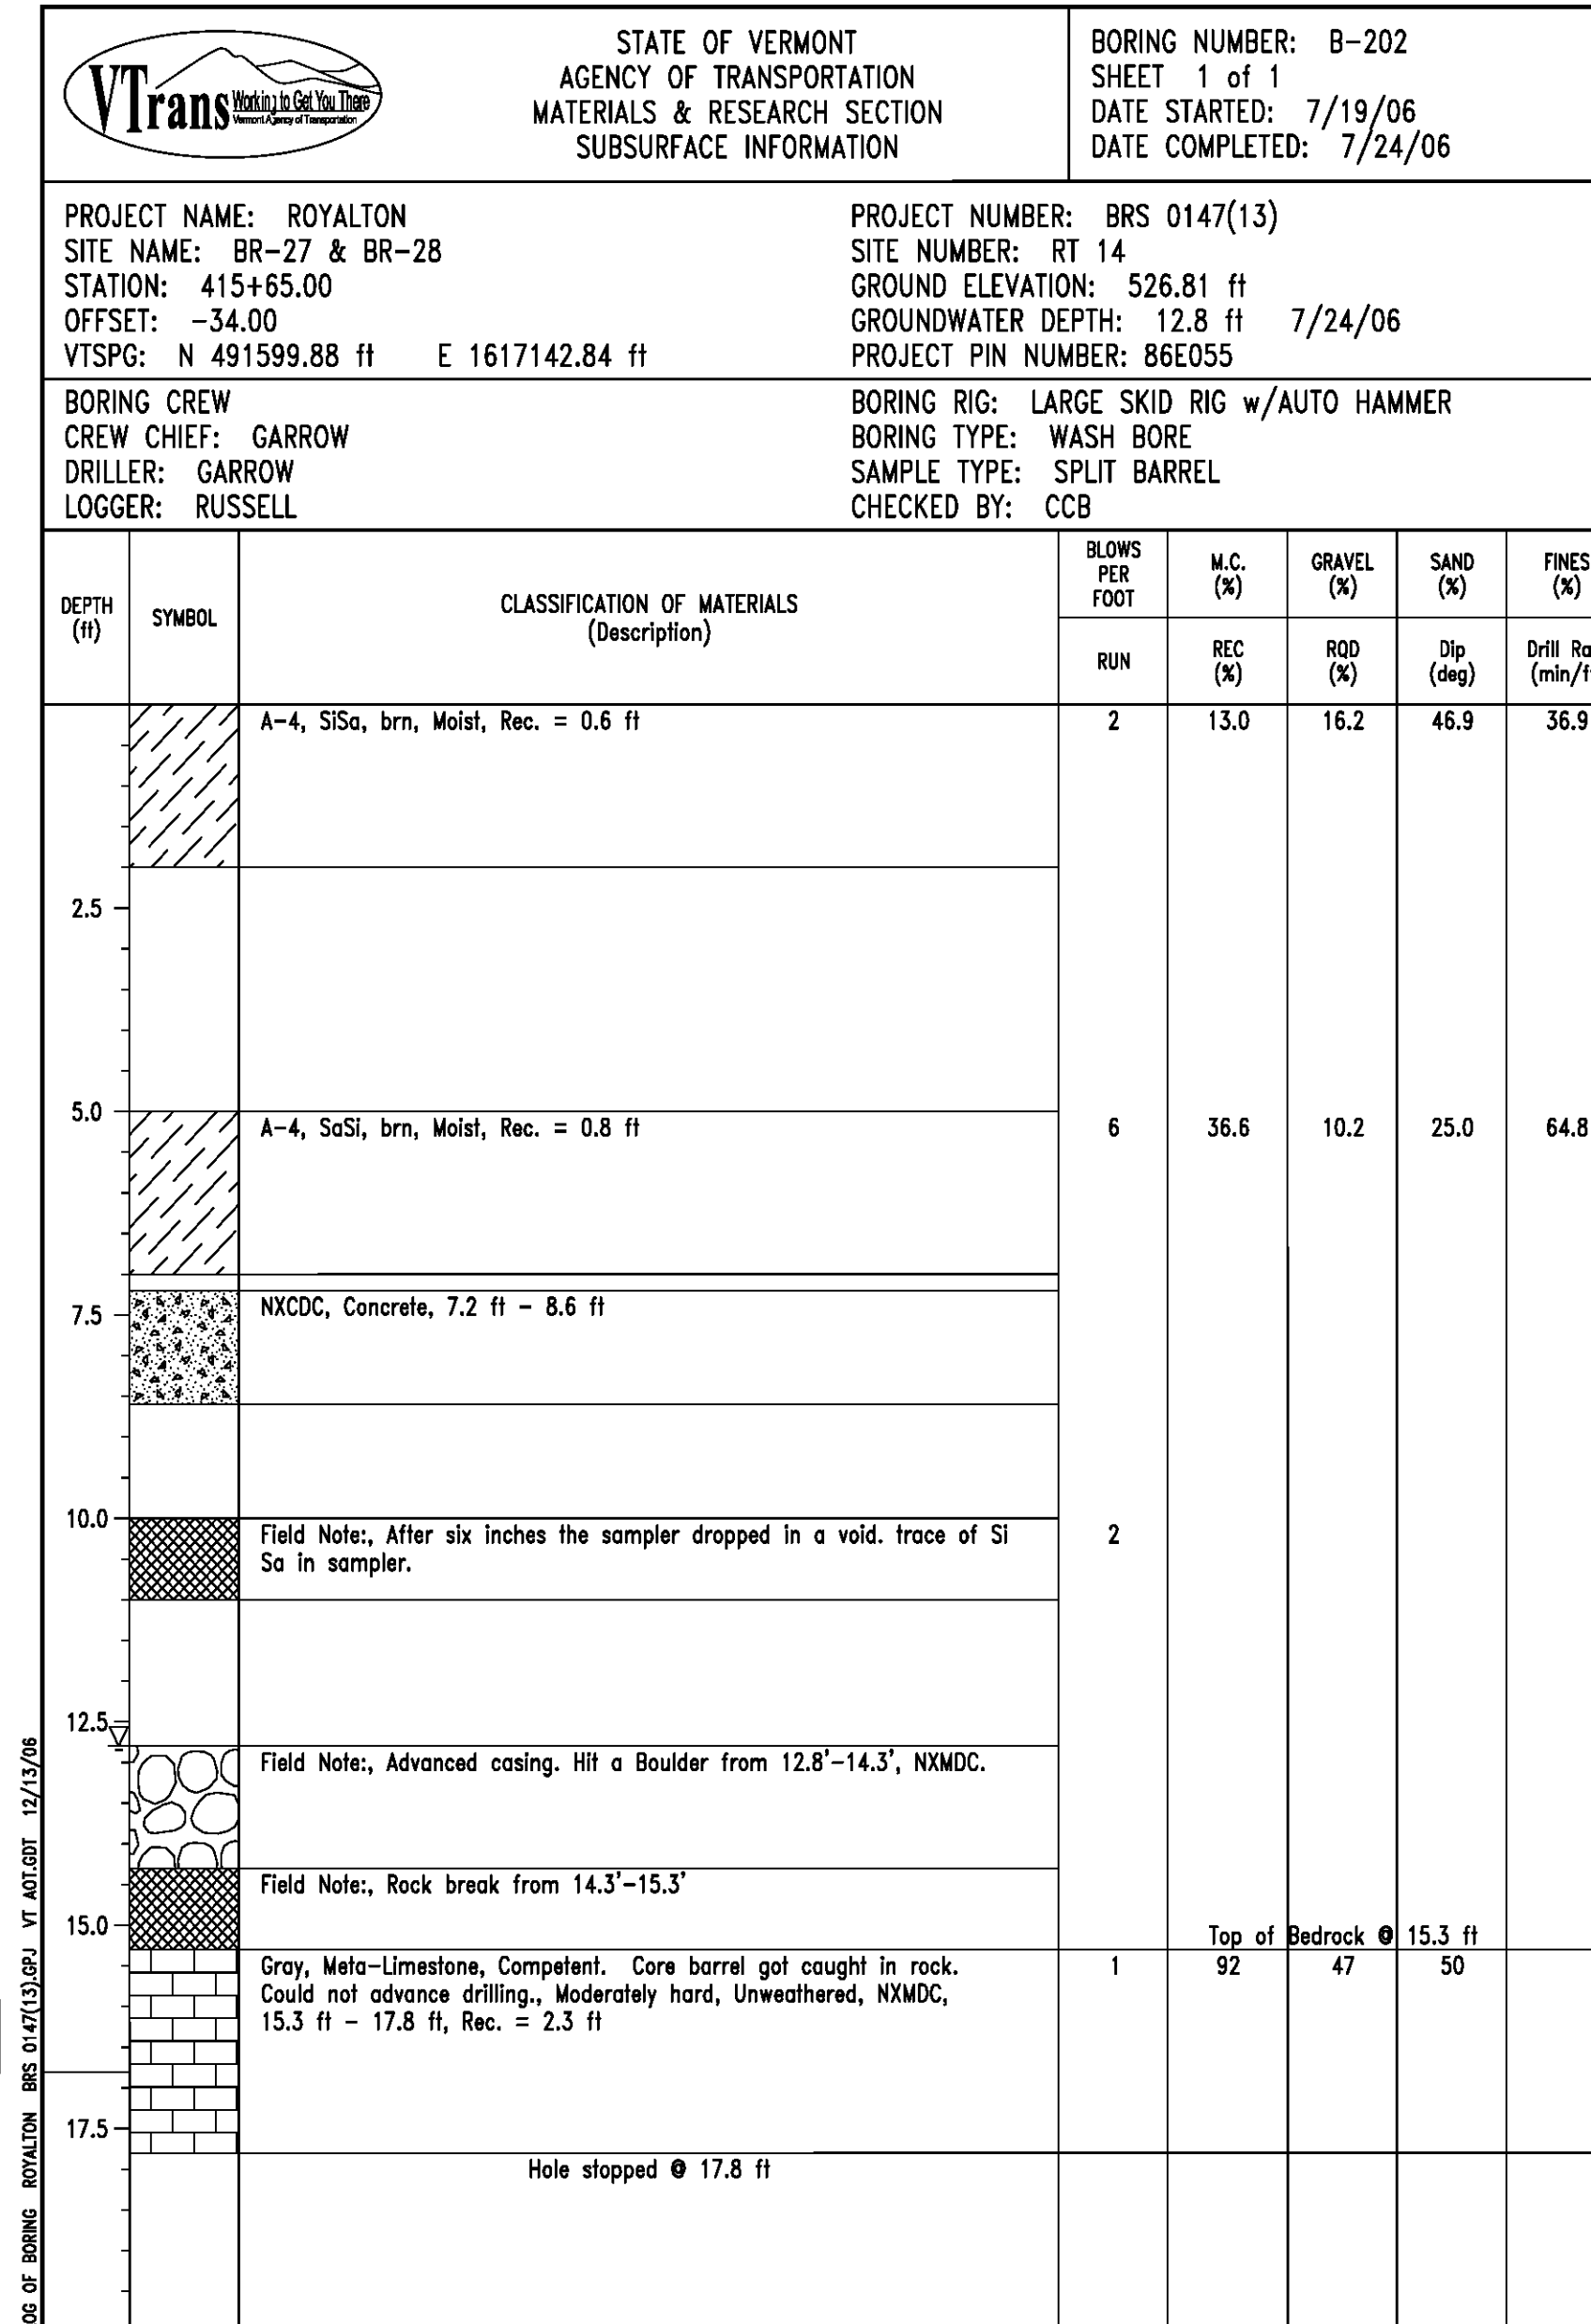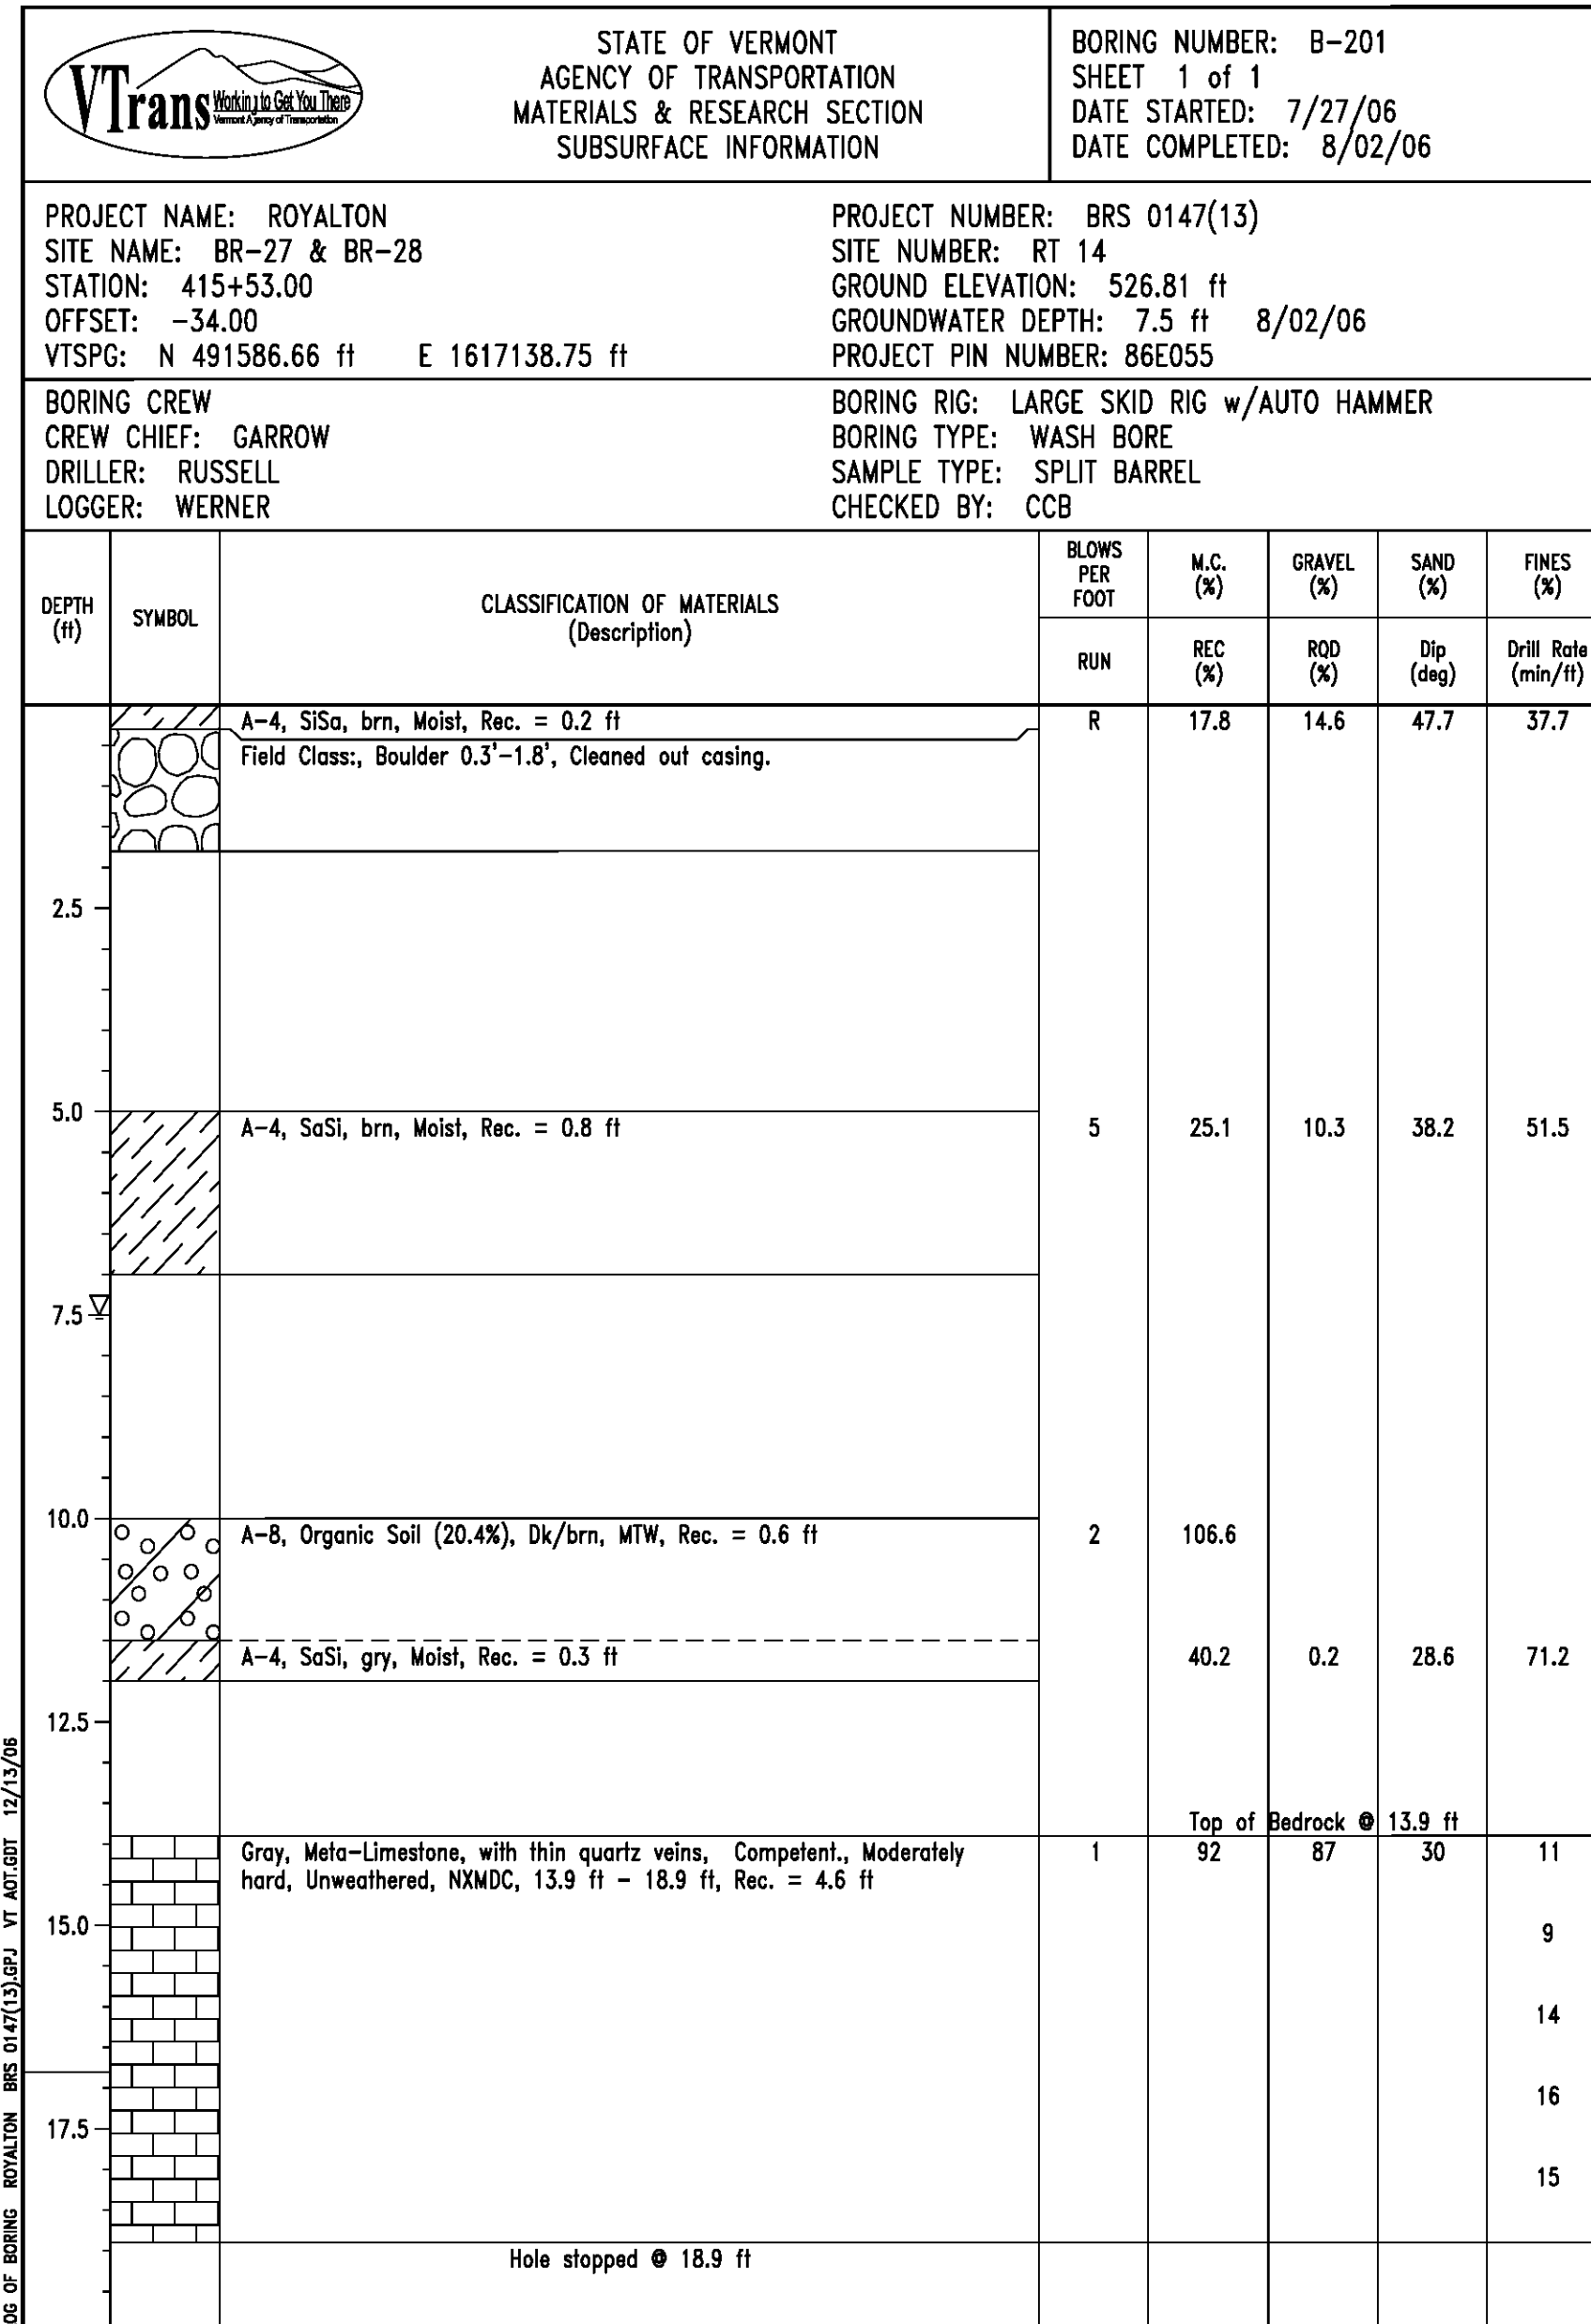


PROJECT NAME: ROYALTON  
 PROJECT NUMBER: BRS 0147 (13)

FILE NAME: \BR 28\86e055bor_28.dgn PLOT DATE: 08-OCT-2013  
 PROJECT LEADER: C. CARLSON DRAWN BY: C. MOONEY  
 DESIGNED BY: D. PETERSON CHECKED BY: G. ROY  
 BRIDGE 28 BORING LOGS (1) SHEET 104 OF 186



STATE OF VERMONT AGENCY OF TRANSPORTATION MATERIALS & RESEARCH SECTION SUBSURFACE INFORMATION		BORING NUMBER: B-204 SHEET 1 of 1 DATE STARTED: 6/19/06 DATE COMPLETED: 6/20/06						
PROJECT NAME: ROYALTON SITE NAME: BR-27 & BR-28 STATION: 415+51.00 OFFSET: 11.00 VTSPG: N 491572.74 ft E 1617181.61 ft		PROJECT NUMBER: BRS 0147(13) SITE NUMBER: RT 14 GROUND ELEVATION: 516.02 ft GROUNDWATER DEPTH: No Water Found 6/22/06 PROJECT PIN NUMBER: 86E055						
BORING CREW CREW CHIEF: GARROW DRILLER: GARROW LOGGER: RUSSELL		BORING RIG: SMALL SKID RIG BORING TYPE: WASH BORE SAMPLE TYPE: SPLIT BARREL CHECKED BY: CCB						
DEPTH (ft)	SYMBOL	CLASSIFICATION OF MATERIALS (Description)	BLOWS PER FOOT		M.C. (%)	GRAVEL (%)	SAND (%)	FINES (%)
			RUN	REC (%)				
		A-4, SiSa, brn, Moist, Rec. = 1.0 ft	6	16.0	17.0	43.4	39.6	
2.5		A-4, SiSa, brn, Moist, Rec. = 0.3 ft, Sample had Concrete material that was removed before testing.	3	16.6	18.5	40.8	40.7	
5.0		Visual Class., SiSa with broken rock (possible bedrock) material, brn, Moist, Rec. = 1.3 ft	13	22.5				
		Gray, Meta-Limestone, Upper portion of core run contains zones of punky weathered limestone, Competent below 7.0', Moderately hard, NXMDC, 5.7 ft - 10.7 ft, Rec. = 4.2 ft	1	84	44	50	8	
7.5							7	
							9	
							10	
10.0							9	
		Gray, Phyllite, Competent, Moderately hard, Unweathered, NXMDC, 10.7 ft - 13.2 ft, Rec. = 4.4 ft	2	88	88	50	6	
12.5							7	
							9	
		Gray, Meta-Limestone, Competent, Moderately hard, Unweathered, 13.2 ft - 15.7 ft					10	
15.0							8	
17.5		Hole stopped @ 15.7 ft						


TOP OF FOOTING ABUT. #1  
EL. 513.50

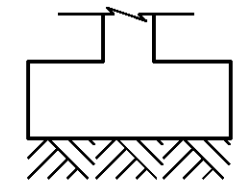

LOG OF BORING ROYALTON BRS 0147(13) BOR. VT. 6/20/06 12/15/06

STATE OF VERMONT AGENCY OF TRANSPORTATION MATERIALS & RESEARCH SECTION SUBSURFACE INFORMATION		BORING NUMBER: B-205 SHEET 1 of 1 DATE STARTED: 8/04/06 DATE COMPLETED: 8/07/06						
PROJECT NAME: ROYALTON SITE NAME: BR-27 & BR-28 STATION: 416+86.00 OFFSET: -19.50 VTSPG: N 491707.61 ft E 1617217.07 ft		PROJECT NUMBER: BRS 0147(13) SITE NUMBER: RT 14 GROUND ELEVATION: 524.51 ft GROUNDWATER DEPTH: 14.8 ft 8/07/06 PROJECT PIN NUMBER: 86E055						
BORING CREW CREW CHIEF: GARROW DRILLER: RUSSELL LOGGER: WERNER		BORING RIG: SMALL SKID RIG BORING TYPE: WASH BORE SAMPLE TYPE: SPLIT BARREL CHECKED BY: CCB						
DEPTH (ft)	SYMBOL	CLASSIFICATION OF MATERIALS (Description)	BLOWS PER FOOT		M.C. (%)	GRAVEL (%)	SAND (%)	FINES (%)
			RUN	REC (%)				
		A-1-b, GrSa, brn, Moist, Rec. = 0.8 ft	2	10.8	28.5	56.2	15.3	
5		Field Class., Wood 4.0'-5.0', NXGDC No recovery, Wood in end of sampler, 5.0 ft - 7.0 ft	5					
10		A-4, Si, brn, Moist, Rec. = 0.8 ft	4	33.8	1.1	14.6	84.3	
15		A-4, SoSi, brn, Moist, Rec. = 0.3 ft A-4, SoSi with a trace of organics (2.4%), Dk/brn-gry, Moist, Rec. = 1.0 ft	5	35.4 42.8	0.5 0.0	44.0 48.4	55.5 51.6	
		Gray, Meta-Limestone, Competent, Moderately hard, Unweathered, NXMDC, 17.2 ft - 18.9 ft, Rec. = 4.7 ft	1	94	90	15	13	
20		Gray, Phyllite, Competent, Moderately hard, Unweathered, 18.9 ft - 22.2 ft					12 13 16 18	
25		Hole stopped @ 22.2 ft						


TOP OF FOOTING ABUT. #2  
EL. 510.00

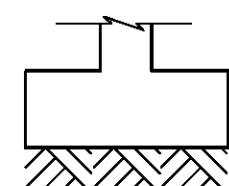

LOG OF BORING ROYALTON BRS 0147(13) BOR. VT. 8/07/06 12/15/06

STATE OF VERMONT AGENCY OF TRANSPORTATION MATERIALS & RESEARCH SECTION SUBSURFACE INFORMATION		BORING NUMBER: B-206 SHEET 1 of 1 DATE STARTED: 8/06/06 DATE COMPLETED: 8/11/06						
PROJECT NAME: ROYALTON SITE NAME: BR-27 & BR-28 STATION: 417+19.51 OFFSET: -18.00 VTSPG: N 491732.35 ft E 1617241.83 ft		PROJECT NUMBER: BRS 0147(13) SITE NUMBER: RT 14 GROUND ELEVATION: 524.42 ft GROUNDWATER DEPTH: 15.0 ft 8/11/06 PROJECT PIN NUMBER: 86E055						
BORING CREW CREW CHIEF: GARROW DRILLER: RUSSELL LOGGER: WERNER		BORING RIG: SMALL SKID RIG BORING TYPE: WASH BORE SAMPLE TYPE: SPLIT BARREL CHECKED BY: CCB						
DEPTH (ft)	SYMBOL	CLASSIFICATION OF MATERIALS (Description)	BLOWS PER FOOT		M.C. (%)	GRAVEL (%)	SAND (%)	FINES (%)
			RUN	REC (%)				
		A-1-b, GrSa, brn, Moist, Rec. = 0.6 ft	4	18.9	31.9	51.5	16.6	
5		Field Note: Cleaned out casing 4.2'-5.0' with NXDC. No recovery, 5.0 ft - 7.0 ft	6					
10		A-4, SoSi, brn, Moist, Rec. = 1.3 ft	7	37.1	2.3	22.0	75.7	
15		A-2-4, SiSa, brn, Moist, Rec. = 1.0 ft	2	37.5	1.8	63.3	34.9	
20		A-4, Si, gry, Moist, Rec. = 1.6 ft	5	33.2	0.8	17.1	82.1	
25		Gray, Meta-Limestone, grading to phyllite, Competent, Moderately hard, Unweathered, NXMDC, 23.5 ft - 26.5 ft, Rec. = 3.0 ft	1	100	83	30	22	
		Alternating gray, Meta-Limestone and Phyllite, Competent, Moderately hard, Unweathered, NXMDC, 26.5 ft - 28.5 ft, Rec. = 2.0 ft	2	100	95	30	14	
		Hole stopped @ 28.5 ft					18	




TOP OF FOOTING ABUT. #2  
EL. 510.00

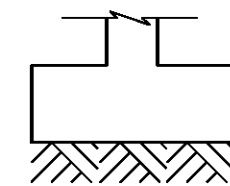

LOG OF BORING ROYALTON BRS 0147(13) BOR. VT. 8/11/06 12/15/06

PROJECT NAME: ROYALTON  
PROJECT NUMBER: BRS 0147 (13)

FILE NAME: \BR 28\86e055bor_28.dgn PLOT DATE: 08-OCT-2013  
PROJECT LEADER: C. CARLSON DRAWN BY: C. MOONEY  
DESIGNED BY: D. PETERSON CHECKED BY: G. ROY  
BRIDGE 28 BORING LOGS (2) SHEET 105 OF 186

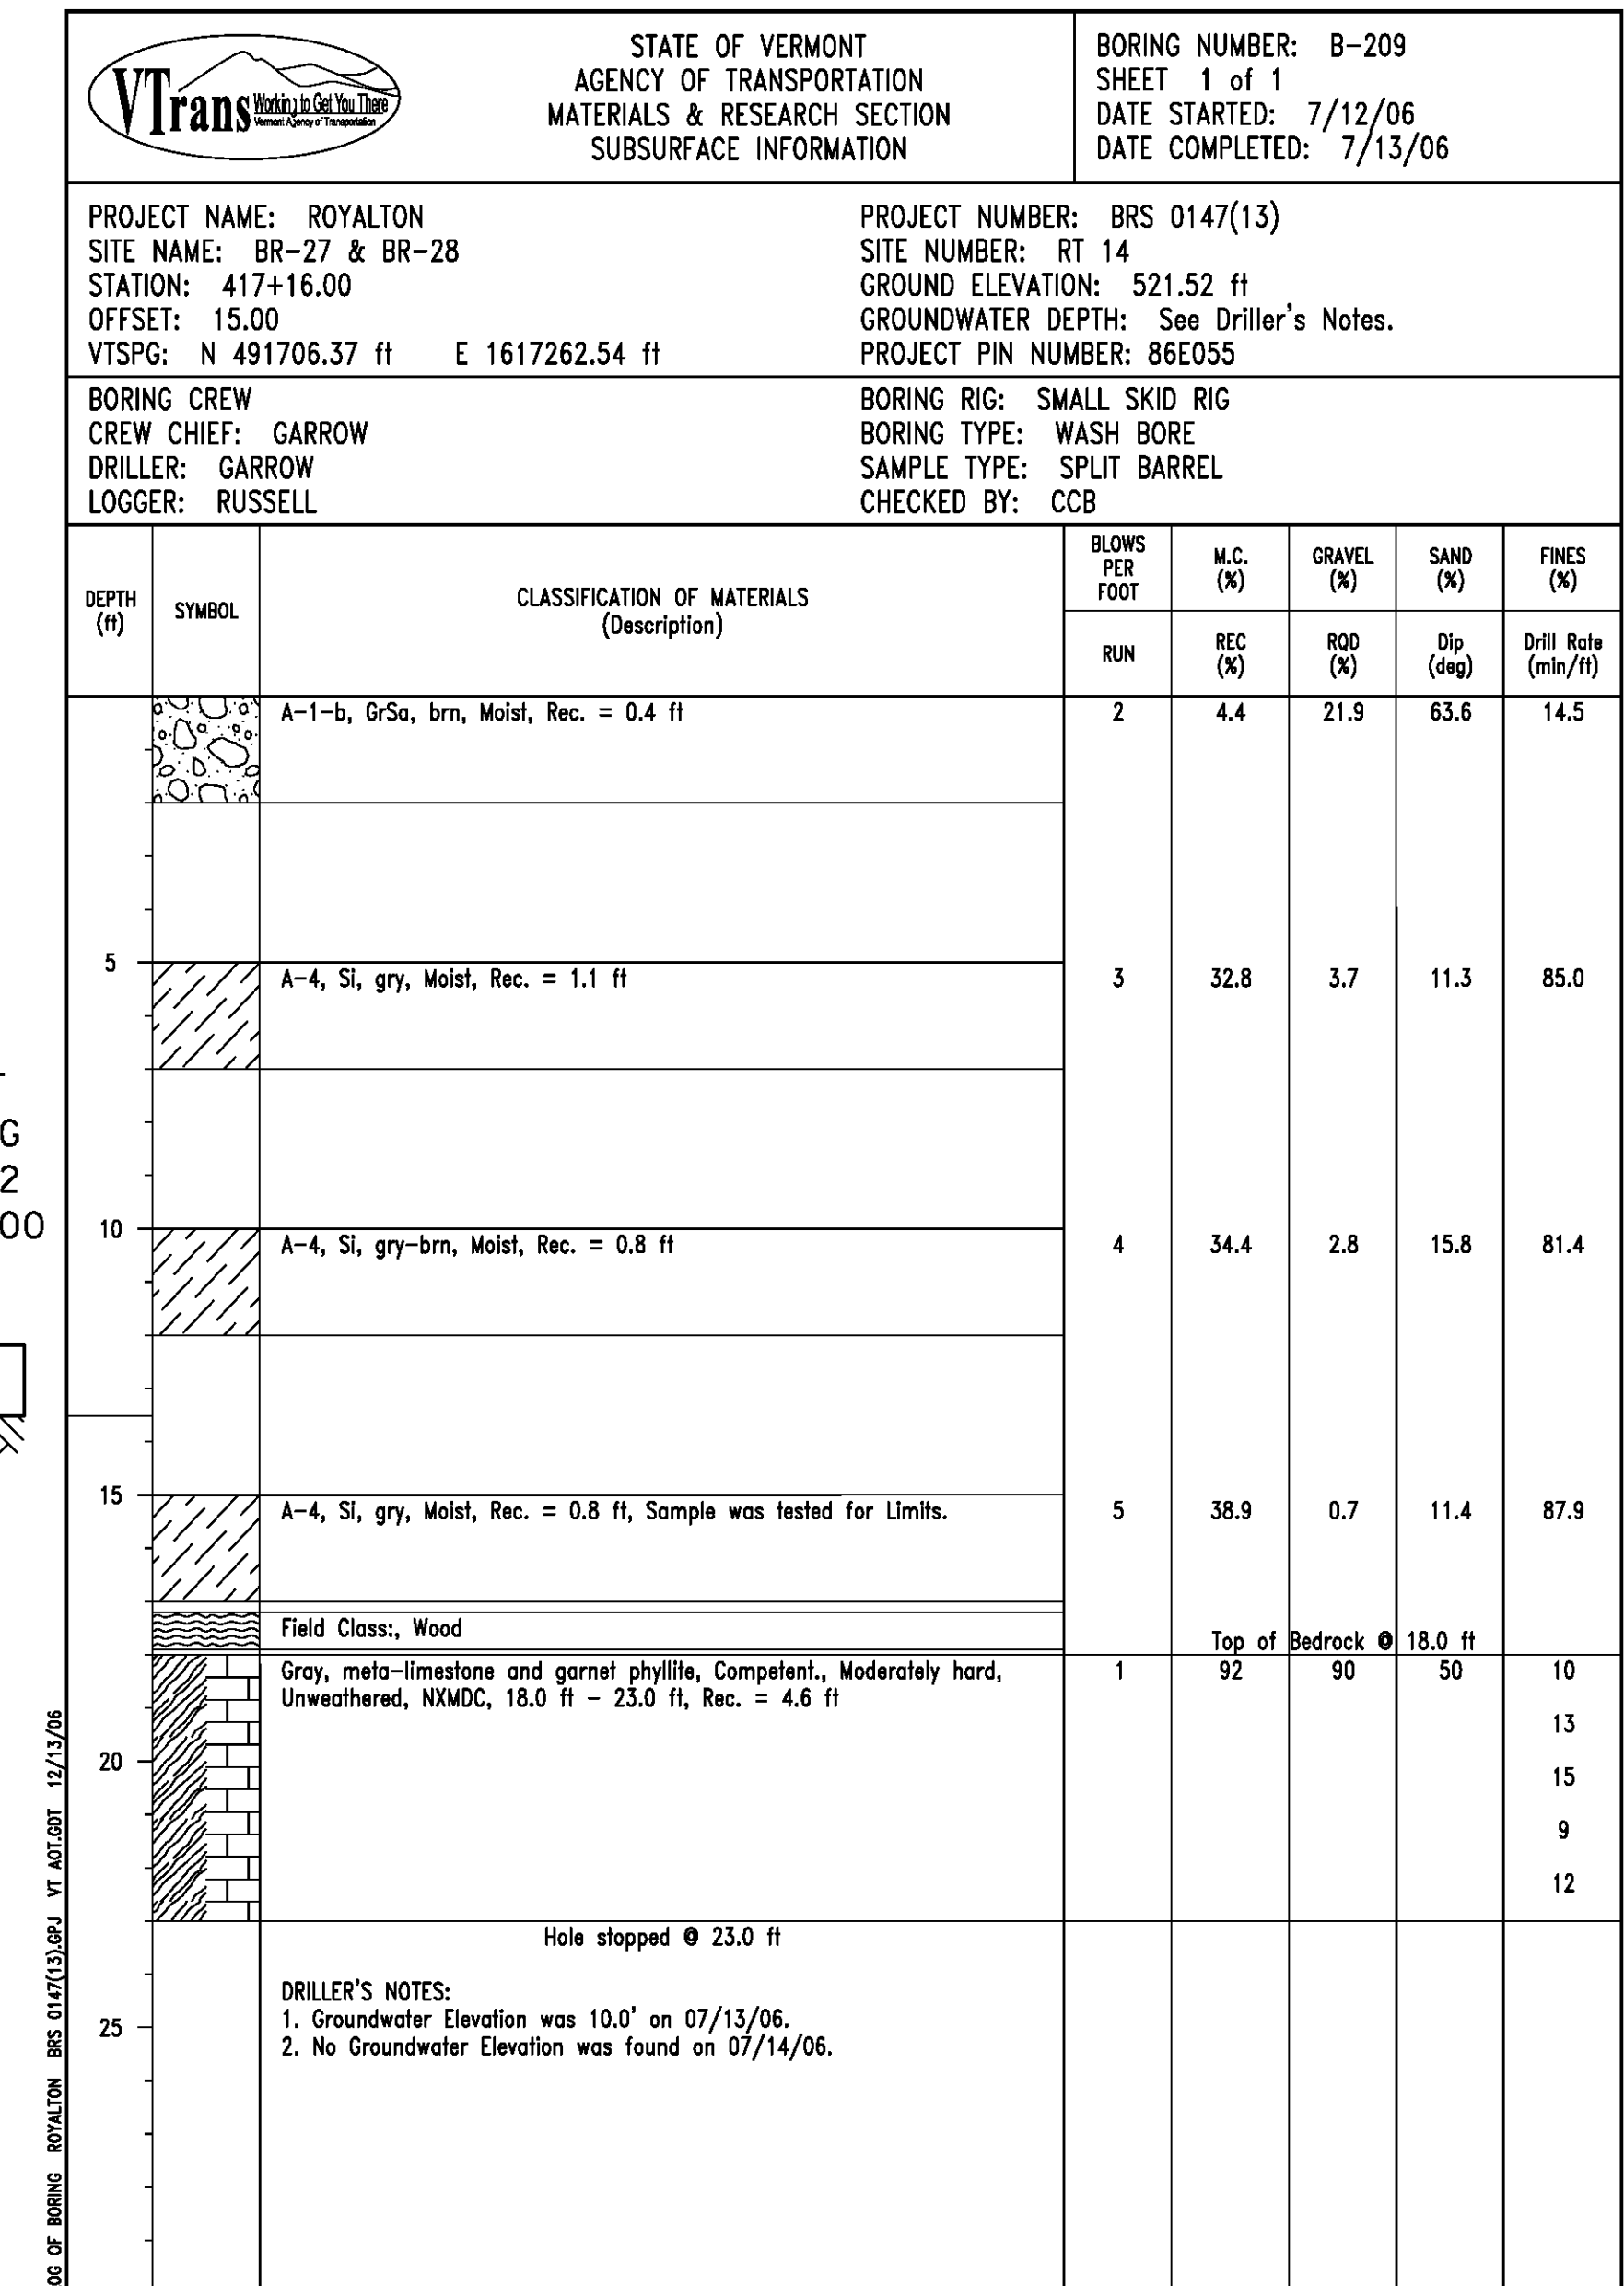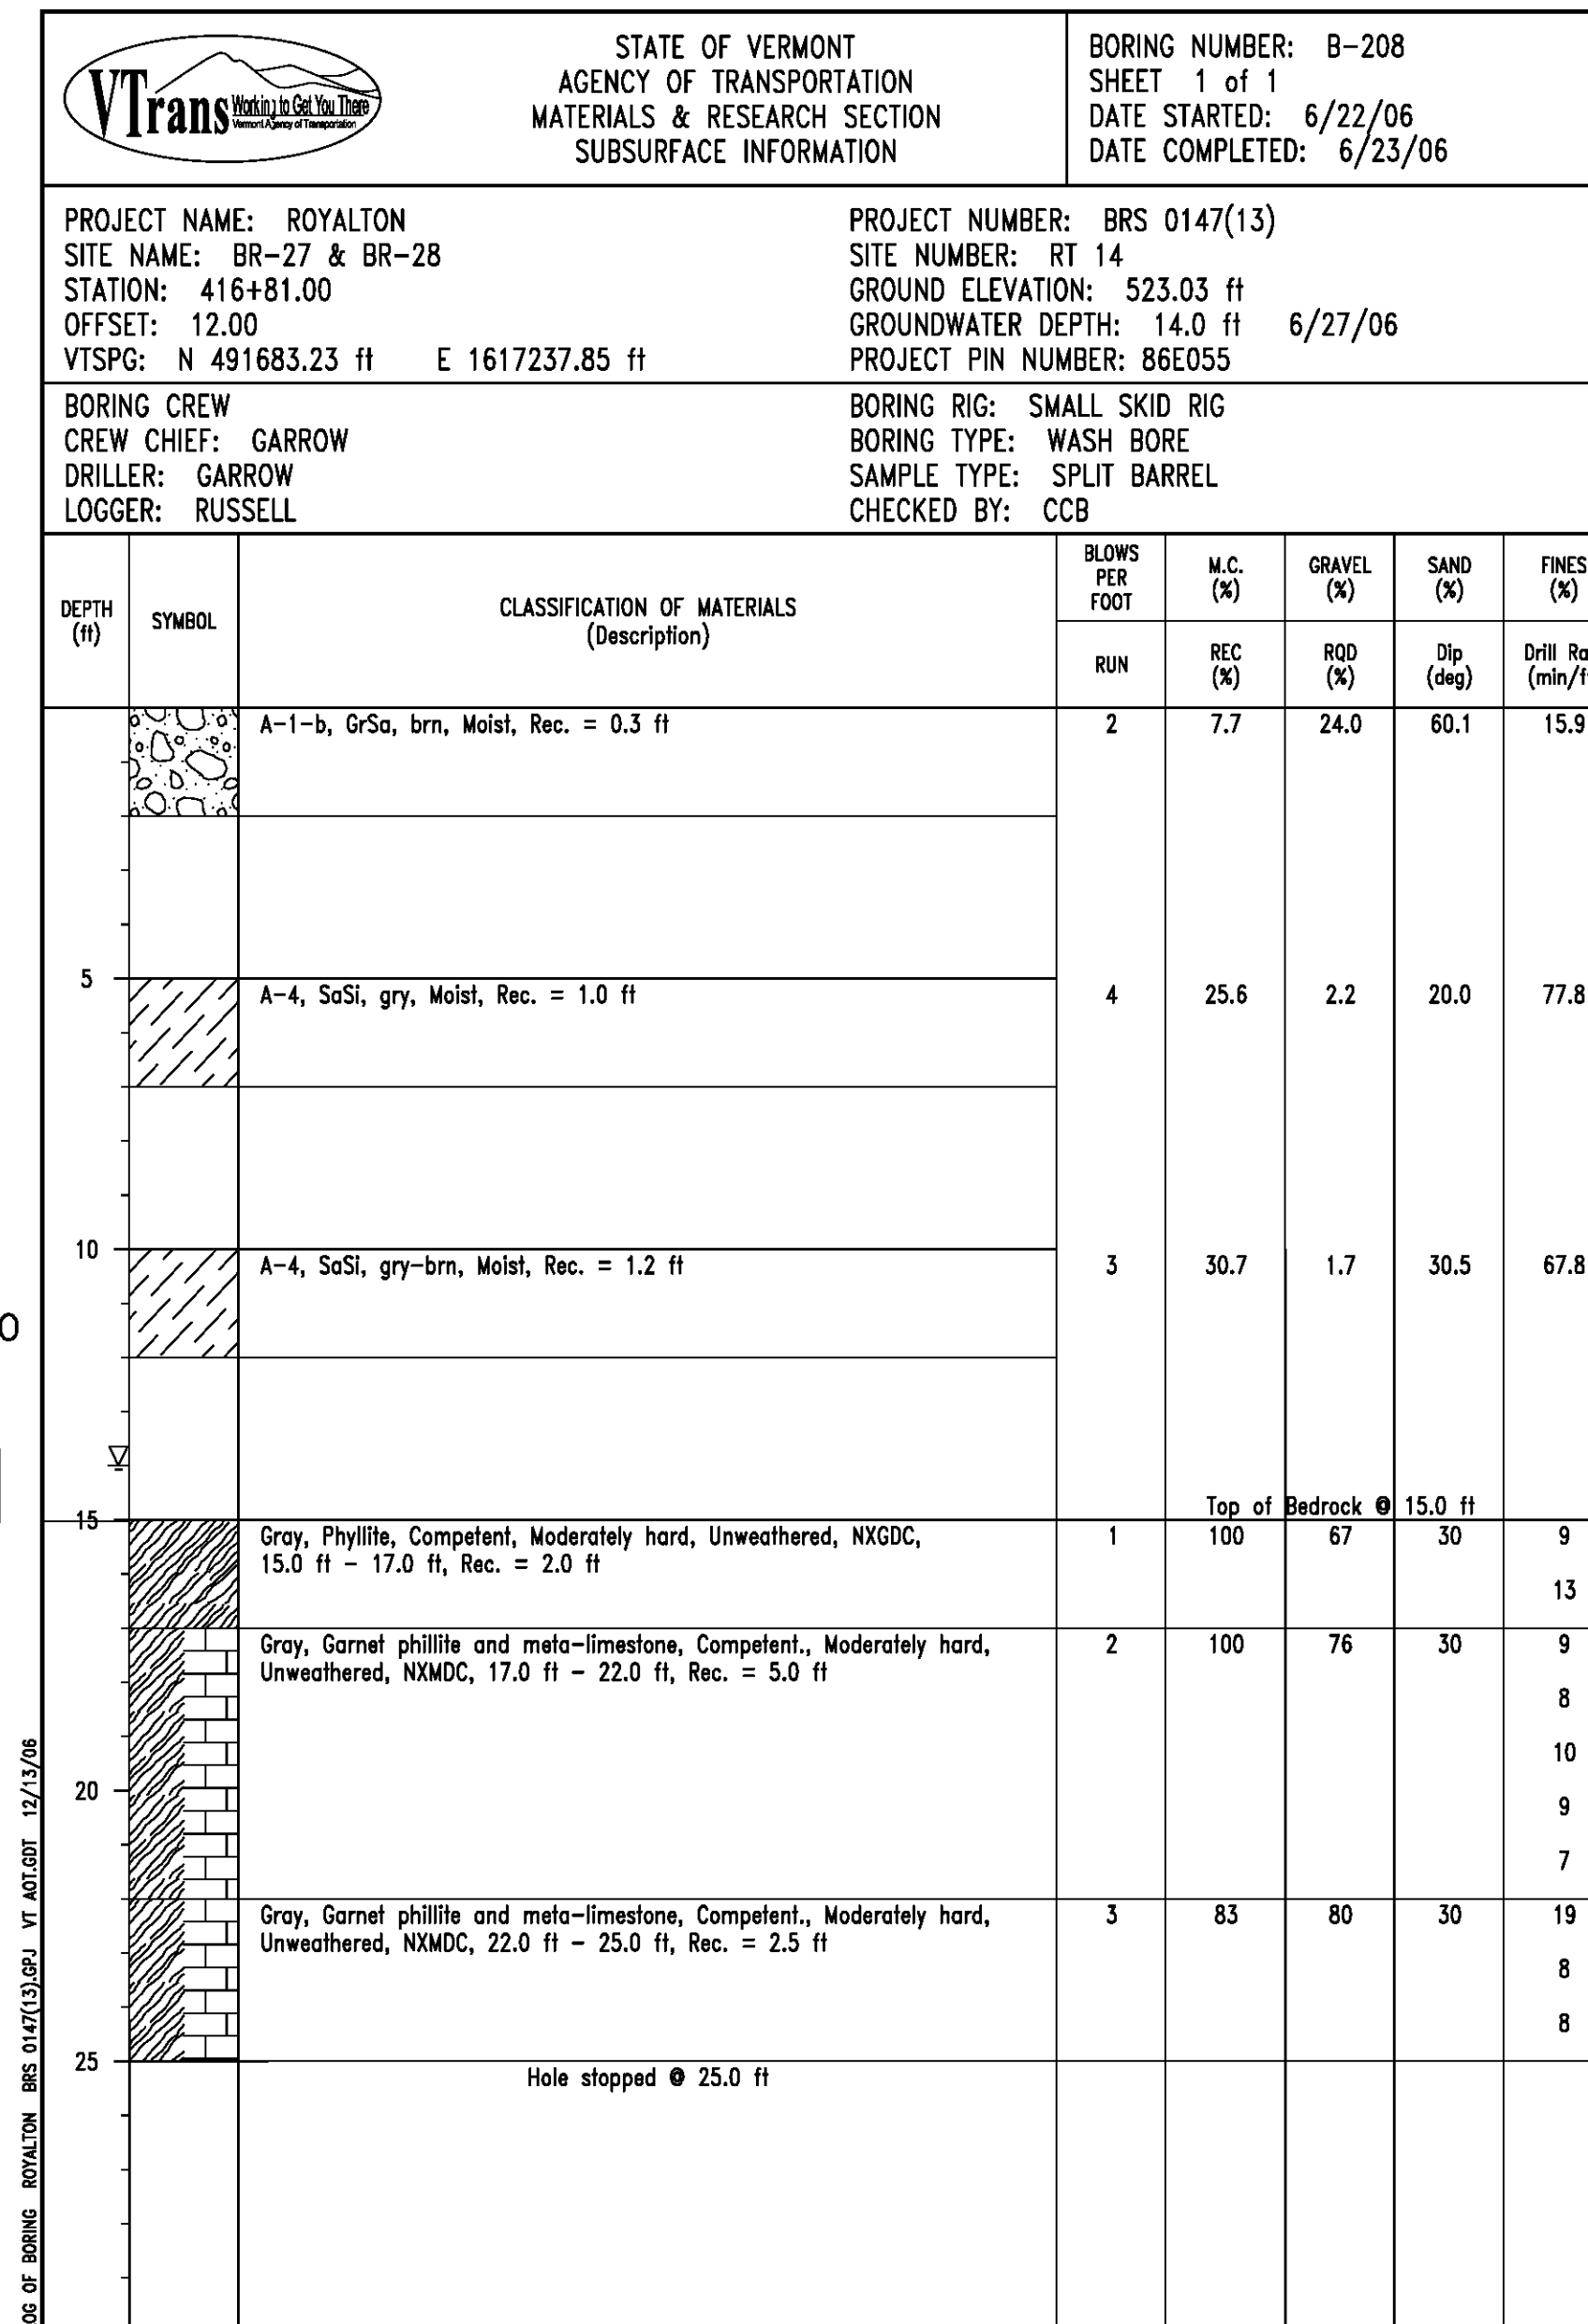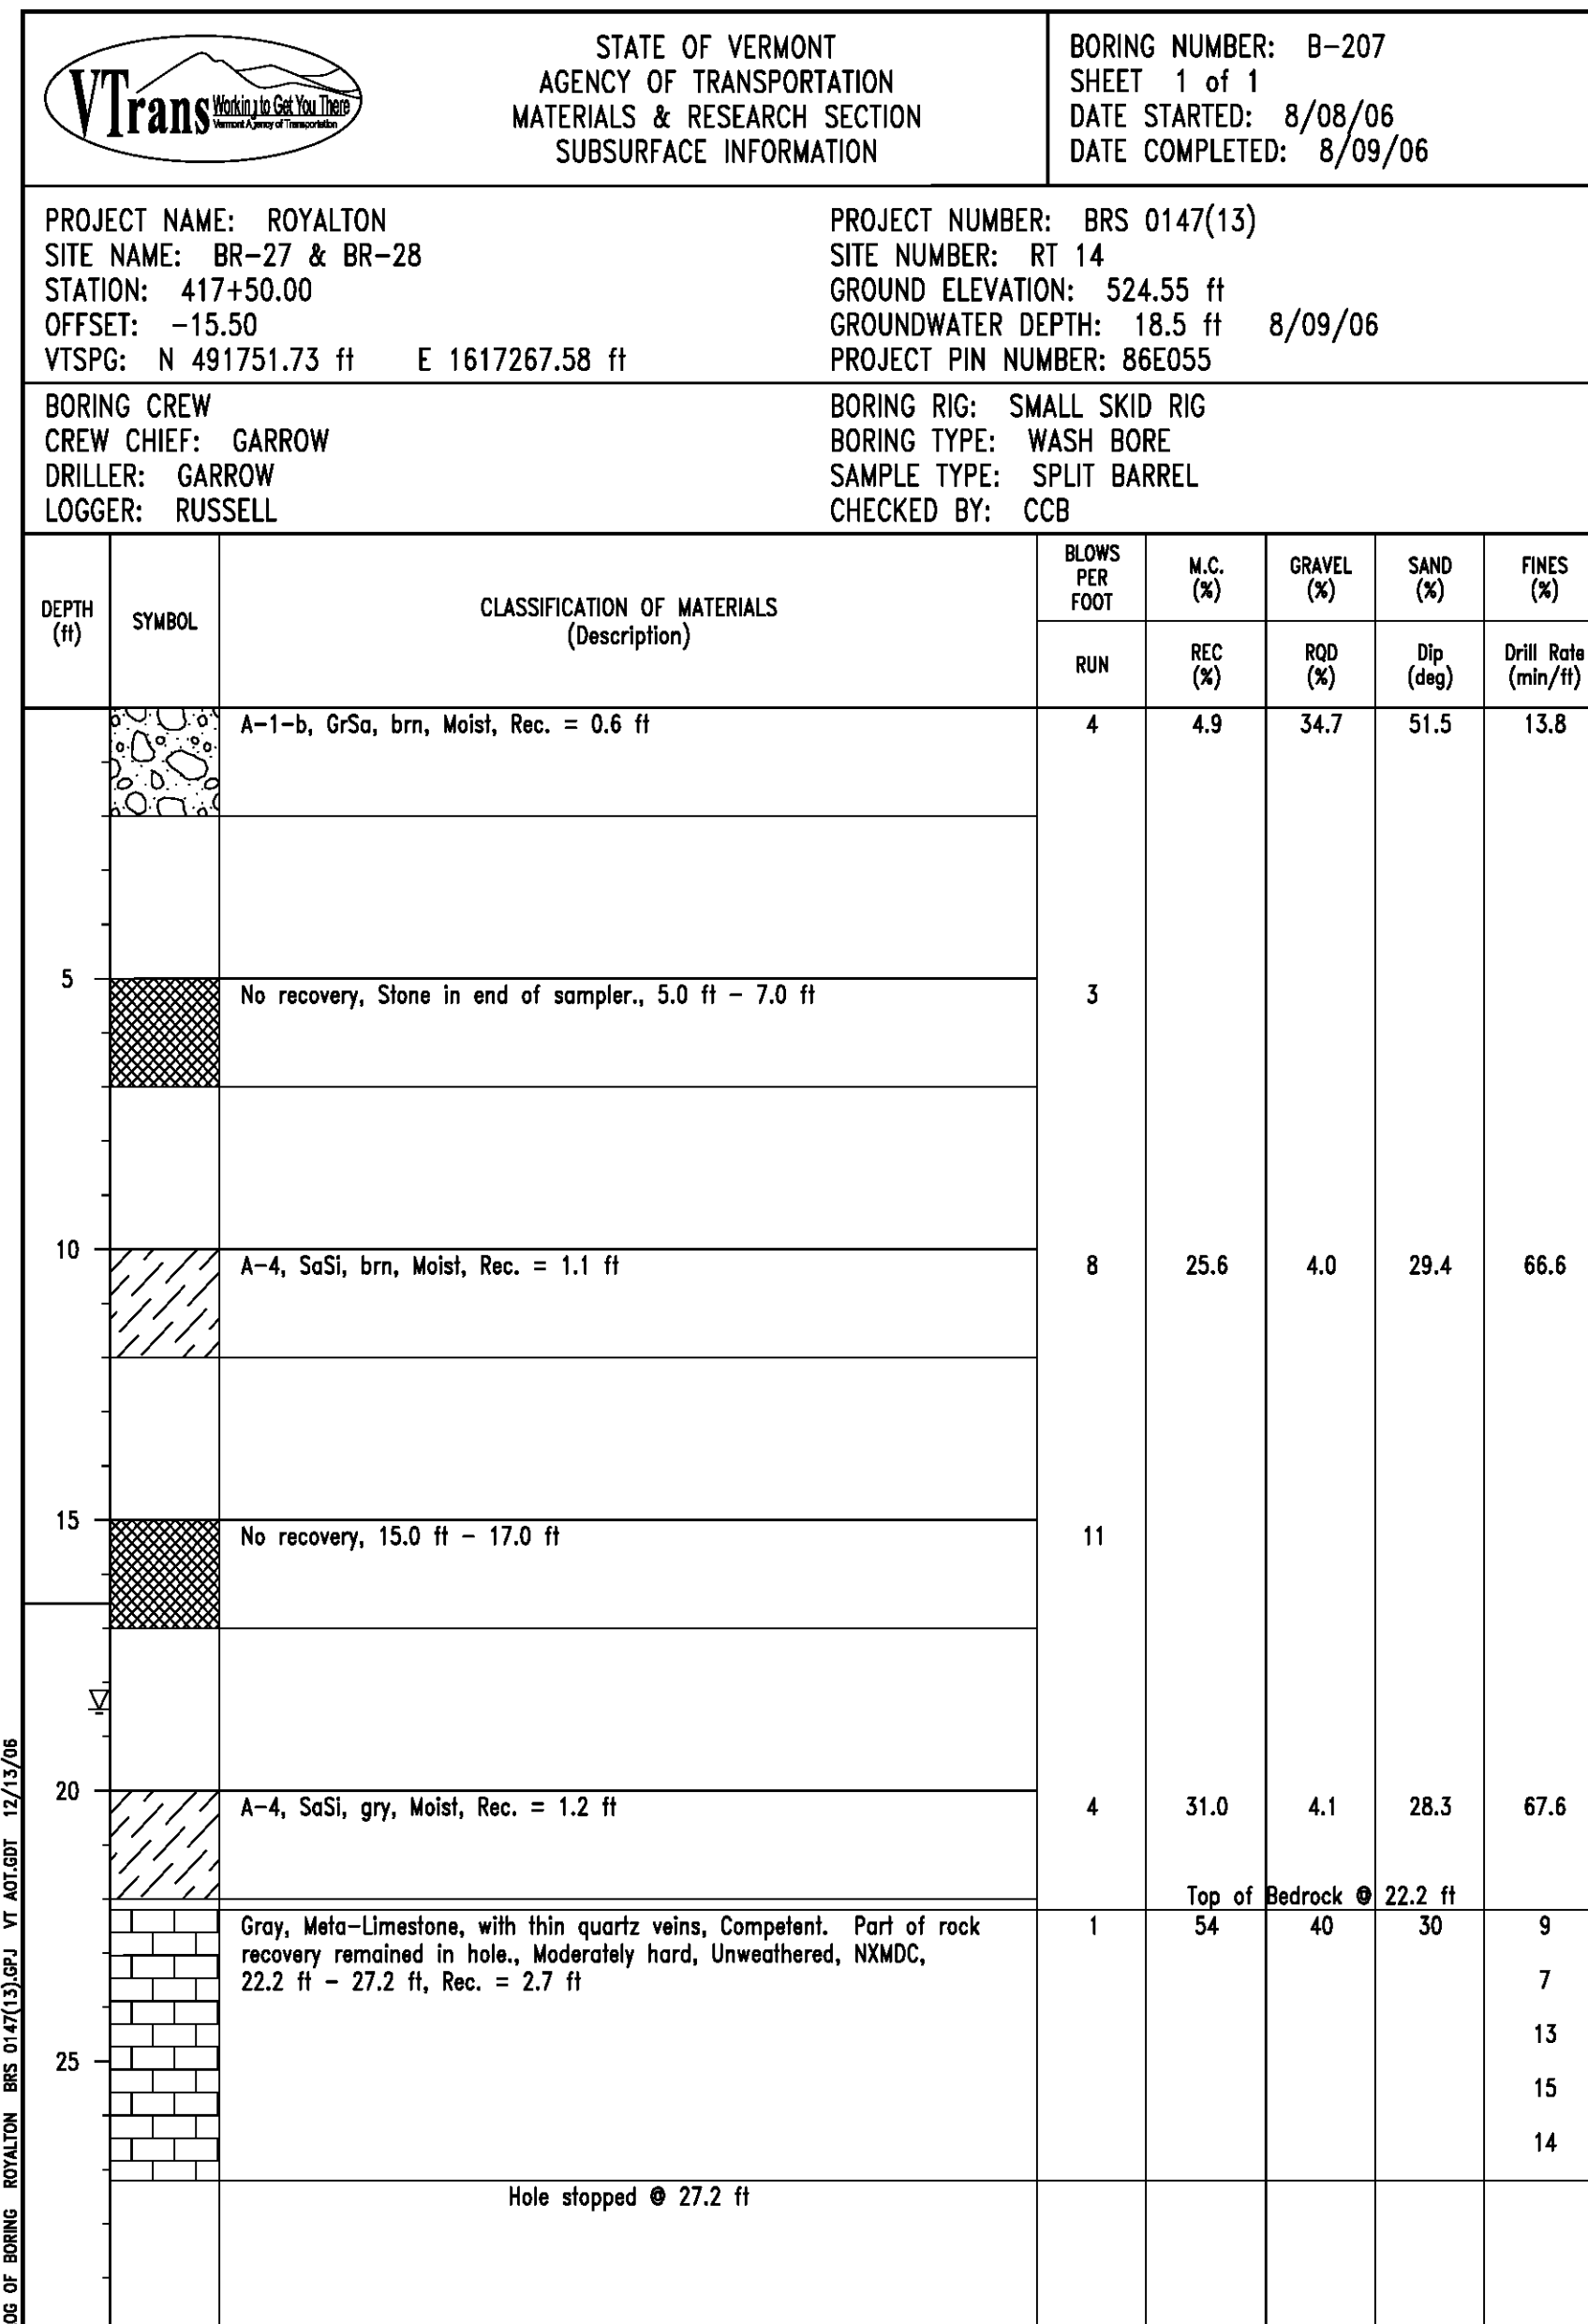

PROJECT NAME: ROYALTON  
PROJECT NUMBER: BRS 0147 (13)

FILE NAME: \BR 28\86e055bor_28.dgn PLOT DATE: 08-OCT-2013  
PROJECT LEADER: C. CARLSON DRAWN BY: C. MOONEY  
DESIGNED BY: D. PETERSON CHECKED BY: G. ROY  
BRIDGE 28 BORING LOGS (3) SHEET 106 OF 186



VT Trans		STATE OF VERMONT AGENCY OF TRANSPORTATION MATERIALS & RESEARCH SECTION SUBSURFACE INFORMATION		BORING LOG		Boring No.: B-301				
				ROYALTON BRS 0147(13) VT-14 BR-28		Page No.: 1 of 1 Pin No.: 86E055 Checked By: CEE				
Boring Crew: GARROW, WERNER, PORTER		Type: WB	SS	Groundwater Observations						
Date Started: 8/24/10	Date Finished: 8/24/10	L.D.: 2.5 in	1.25 in	Date	Depth (ft)	Notes				
VTSPG NAD83: N 491733.36 ft E 1617282.29 ft	Station: 417+50.00	Offset: 8.00	Ground Elevation: 523.3 ft	08/24/10	None taken. (Road)					
		Hammer Wt: N.A.	140 lb.							
		Hammer Fall: N.A.	30 in.							
		Hammer/Rod Type: Auto/AWJ								
		Rig: CME 45C SKID	CE = 1.33							
Depth (ft)	Strata (1)	CLASSIFICATION OF MATERIALS (Description)	Run (Dip deg.)	Core Rec. (ft)	Drill Rate (min/ft)	Blows/ft (N Value)	Moisture Content %	Gravel %	Sand %	Fines %
0		Asphalt pavement, Rec. = 1.5 ft, 0.0 ft - 1.5 ft								
5		A-4, SaSi, brn, Wet, Rec. = 0.5 ft				14-9-6-8 (15)	22.5	19.4	29.7	50.9
		Field Note: No Recovery, Advanced with rollercone to 6 feet.				13-8-4-5 (12)				
		A-4, SaSi, brn, Wet, Rec. = 1.4 ft				2-1-1-1 (2)	29.6	5.7	38.7	55.6
		A-2-4, SiSa, brn, Wet, Rec. = 0.6 ft				WH-WH (3)	22.4	15.8	51.3	32.9
10		A-4, SiSa, brn, Wet, Rec. = 1.0 ft				9-12-6-6 (18)	23.3	8.5	47.6	43.9
		A-4, SaSi, brn, Wet, Rec. = 0.8 ft				7-4-5-2 (9)	28.5	8.7	20.0	71.3
15		A-4, Si, brn, Wet, Rec. = 1.2 ft, A small amount of wood was within sample.				WH-WH (2)	40.1	1.6	17.2	81.2
		A-4, Si, brn, Wet, Rec. = 1.4 ft				WH-WH (2)	38.5	0.4	11.1	88.5
		A-4, SaSi, brn, Wet, Rec. = 1.4 ft				1-1-1-1 (2)	33.0	1.9	36.3	61.8
20		Visual Classification, Wood with some sand, brn, Wet, Rec. = 0.9 ft, Rollerconed ahead and advanced casing to 24 feet.				4-13-3-18 (16)				
25		Field Note: No Recovery, Wood pieces in sampler. Rollerconed to 26 feet.				5-4-3-3 (7)				
		A-4, SaSi, gry, Wet, Rec. = 1.3 ft				5-3-5-5 (8)	27.6	1.3	33.0	65.7
		A-4, Si, gry, Wet, Rec. = 0.3 ft				2-16-R (8)	31.5	2.1	11.6	86.3
30		28.6 ft - 29.0 ft, Gray, Meta-Limestone, with quartz veins. Hard, Unweathered, Fair rock, BXMD	1 (20)	40 (10)	18 (14)					
		29.0 ft - 34.0 ft, Gray, Meta-Limestone, with quartz veins. Hard, Unweathered, Fair rock, BXMD	2 (20)	100 (35)	8 (7)					
35		Hole stopped @ 34.0 ft								

Notes:  
1. Stratification lines represent approximate boundary between material types. Transition may be gradual.  
2. N Values have not been corrected for hammer energy. CE is the hammer energy correction factor.  
3. Water level readings have been made at times and under conditions stated. Fluctuations of groundwater may occur due to other factors than those present at the time measurements were made.


VT Trans		STATE OF VERMONT AGENCY OF TRANSPORTATION MATERIALS & RESEARCH SECTION SUBSURFACE INFORMATION		BORING LOG		Boring No.: B-302				
				ROYALTON BRS 0147(13) VT-14 BR-28		Page No.: 1 of 1 Pin No.: 86E055 Checked By: CEE				
Boring Crew: GARROW, WERNER, PORTER		Type: WB	SS	Groundwater Observations						
Date Started: 8/26/10	Date Finished: 8/26/10	L.D.: 3.5 in	1.5 in	Date	Depth (ft)	Notes				
VTSPG NAD83: N 491760.57 ft E 1617322.62 ft	Station: 418+00.00	Offset: 8.00	Ground Elevation: 523.5 ft	08/26/10	None taken					
		Hammer Wt: N.A.	140 lb.							
		Hammer Fall: N.A.	30 in.							
		Hammer/Rod Type: Auto/AWJ								
		Rig: CME 45C SKID	CE = 1.33							
Depth (ft)	Strata (1)	CLASSIFICATION OF MATERIALS (Description)	Run (Dip deg.)	Core Rec. (ft)	Drill Rate (min/ft)	Blows/ft (N Value)	Moisture Content %	Gravel %	Sand %	Fines %
0		Asphalt Pavement, 0.0 ft - 1.5 ft								
5		A-1-b, GrSa, brn, Moist, Rec. = 0.6 ft				8-6-5-5 (11)	10.1	38.5	47.0	14.5
		A-4, Si, brn, Moist, Rec. = 0.6 ft				2-2-4-2 (6)	26.8	1.7	17.6	80.7
		A-4, Si, brn, Moist, Rec. = 1.2 ft				2-2-2-3 (4)	30.2	6.0	5.2	88.8
		A-4, Si, brn, Wet, Rec. = 1.4 ft				WH-1-2-1 (1)	35.2	7.9	2.8	89.3
		A-4, Si, brn, Wet, Rec. = 1.0 ft				WH-WH (3)	33.9	2.0	7.5	90.5
10		A-4, SaSi, brn, Wet, Rec. = 0.8 ft				WH-WH (2)	26.2	2.0	31.8	66.2
		A-4, Si, brn, MTW, Rec. = 1.1 ft				5-5-5-5 (10)	28.6	13.8	14.7	71.5
15		A-4, Si, brn, Wet, Rec. = 1.5 ft, Small concretions were within sample.				4-4-4-3 (8)	30.1	11.4	10.7	77.9
		A-4, SaSi, brn, Wet, Rec. = 1.5 ft, Small concretions were within sample.				3-3-4-2 (7)	24.6	7.5	38.8	53.7
		A-4, SaSi, brn, Wet, Rec. = 1.0 ft, Small concretions were within sample.				5-7-7-10 (14)	22.6	10.1	42.5	47.4
20		A-2-4, SiSa, brn, Wet, Rec. = 1.0 ft				1-2-1-2 (5)	29.7	0.1	78.2	21.7
		A-2-4, Sa, gry, Wet, Rec. = 1.3 ft				4-3-5-6 (8)	27.1	0.2	82.7	17.1
25		A-2-4, Sa, gry, Wet, Rec. = 1.2 ft				4-5-5-7 (10)	25.1		83.2	16.8
		A-3, Sa, gry, Wet, Rec. = 1.6 ft				8-8-7-7 (15)	23.8		90.1	9.9
		A-3, Sa, gry, Wet, Rec. = 2.0 ft				5-7-R-7 (15)	25.0		93.1	6.9
30		A-3, Sa, gry, Wet, Rec. = 2.0 ft				1-2-1-2 (3)	22.8		90.0	10.0
		A-3, Sa, gry, Wet, Rec. = 2.0 ft				3-3-6-9 (9)	22.8	0.1	89.9	10.0
35		A-2-4, SiSa, gry, Wet, Rec. = 1.0 ft				3-4-4-4 (8)	24.2	0.5	75.5	24.0
		A-4, Si, gry, Wet, Rec. = 2.0 ft				5-5-5-5 (10)	31.3	0.2	17.5	82.3
		A-4, Si, gry, Wet, Rec. = 1.6 ft				2-2-1-2 (3)	33.3	0.4	3.2	96.4
40		A-4, Si, gry, Wet, Rec. = 0.3 ft, Advanced casing to 40.8 ft.				39-R (1)	30.1		2.7	97.3
		40.8 ft - 45.8 ft, Gray, Meta-Limestone, with 0.85 ft thick phyllite zone at 42.11 feet. Hard, Unweathered, Fair rock, BXMD								
45		Hole stopped @ 45.8 ft								

Notes:  
1. Stratification lines represent approximate boundary between material types. Transition may be gradual.  
2. N Values have not been corrected for hammer energy. CE is the hammer energy correction factor.  
3. Water level readings have been made at times and under conditions stated. Fluctuations of groundwater may occur due to other factors than those present at the time measurements were made.


PROJECT NAME: ROYALTON  
PROJECT NUMBER: BRS 0147 (13)  
FILE NAME: \BR 28\86e055bor_28.dgn PLOT DATE: 08-OCT-2013  
PROJECT LEADER: C. CARLSON DRAWN BY: C. MOONEY  
DESIGNED BY: D. PETERSON CHECKED BY: G. ROY  
BRIDGE 28 BORING LOGS (4) SHEET 107 OF 186

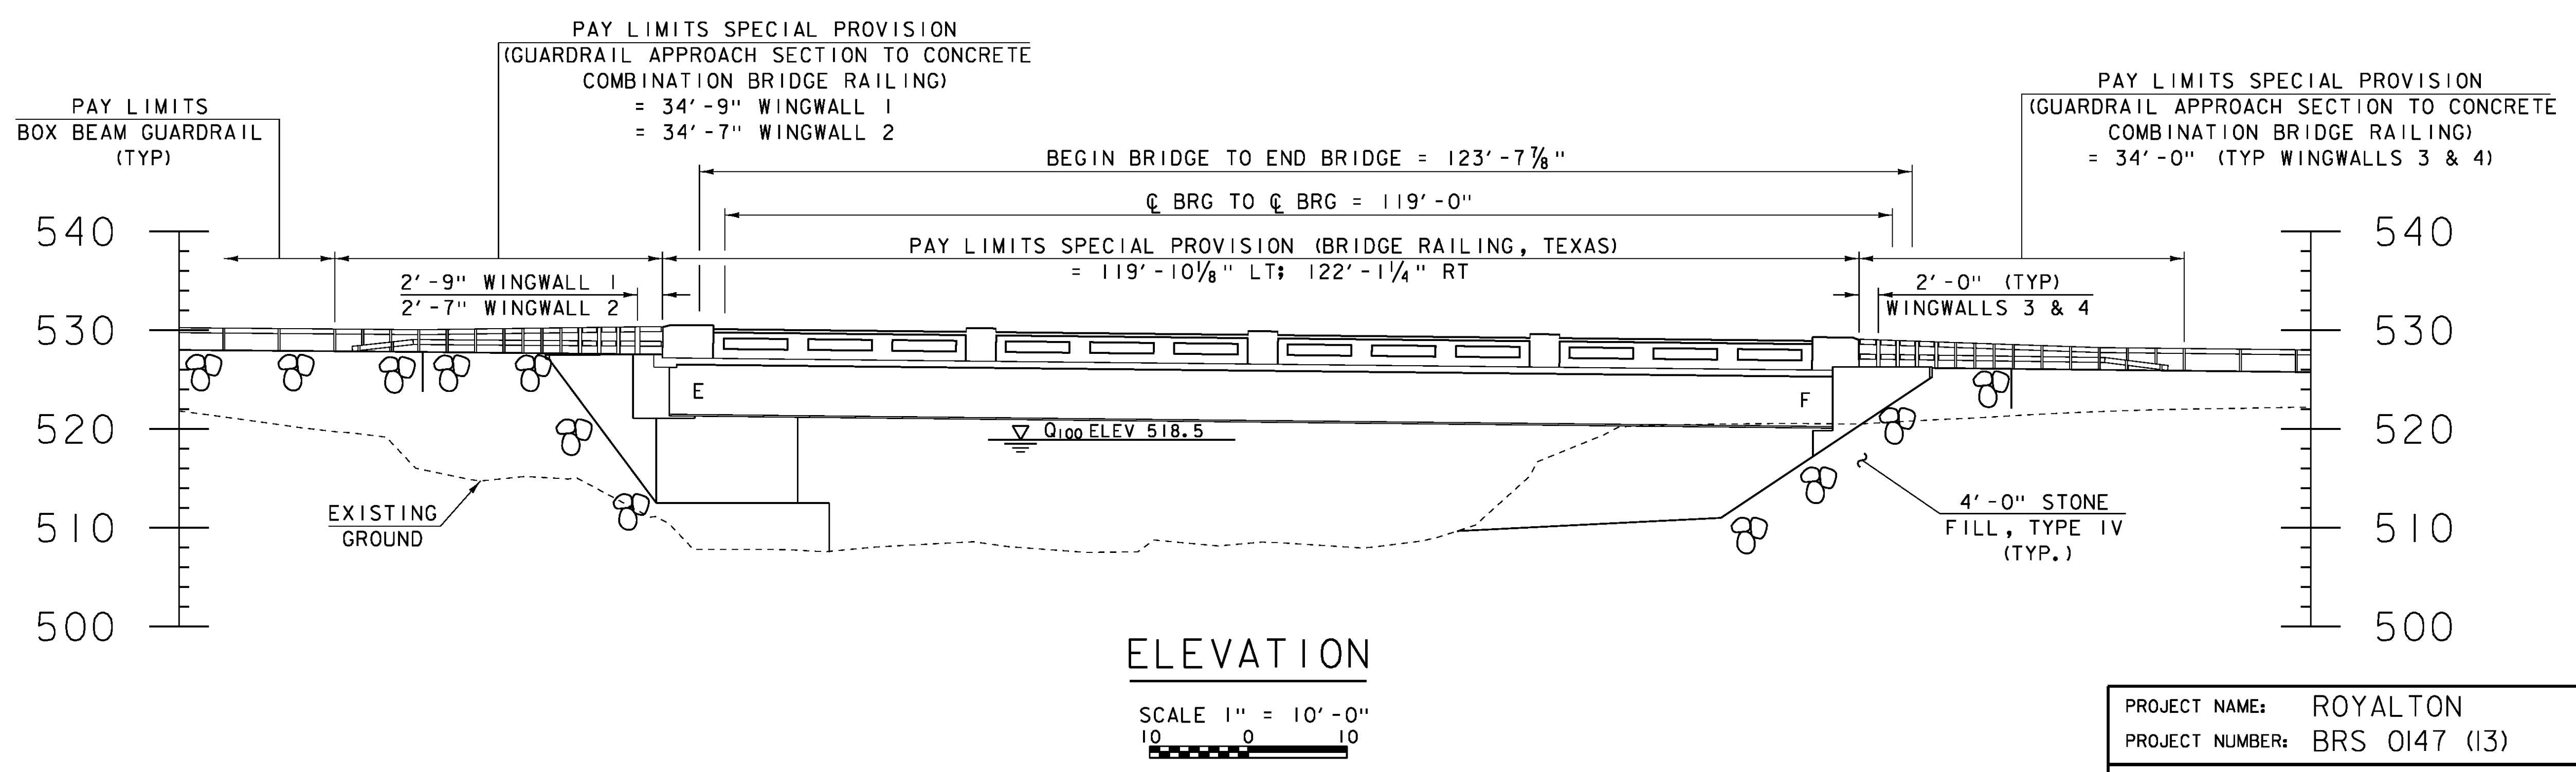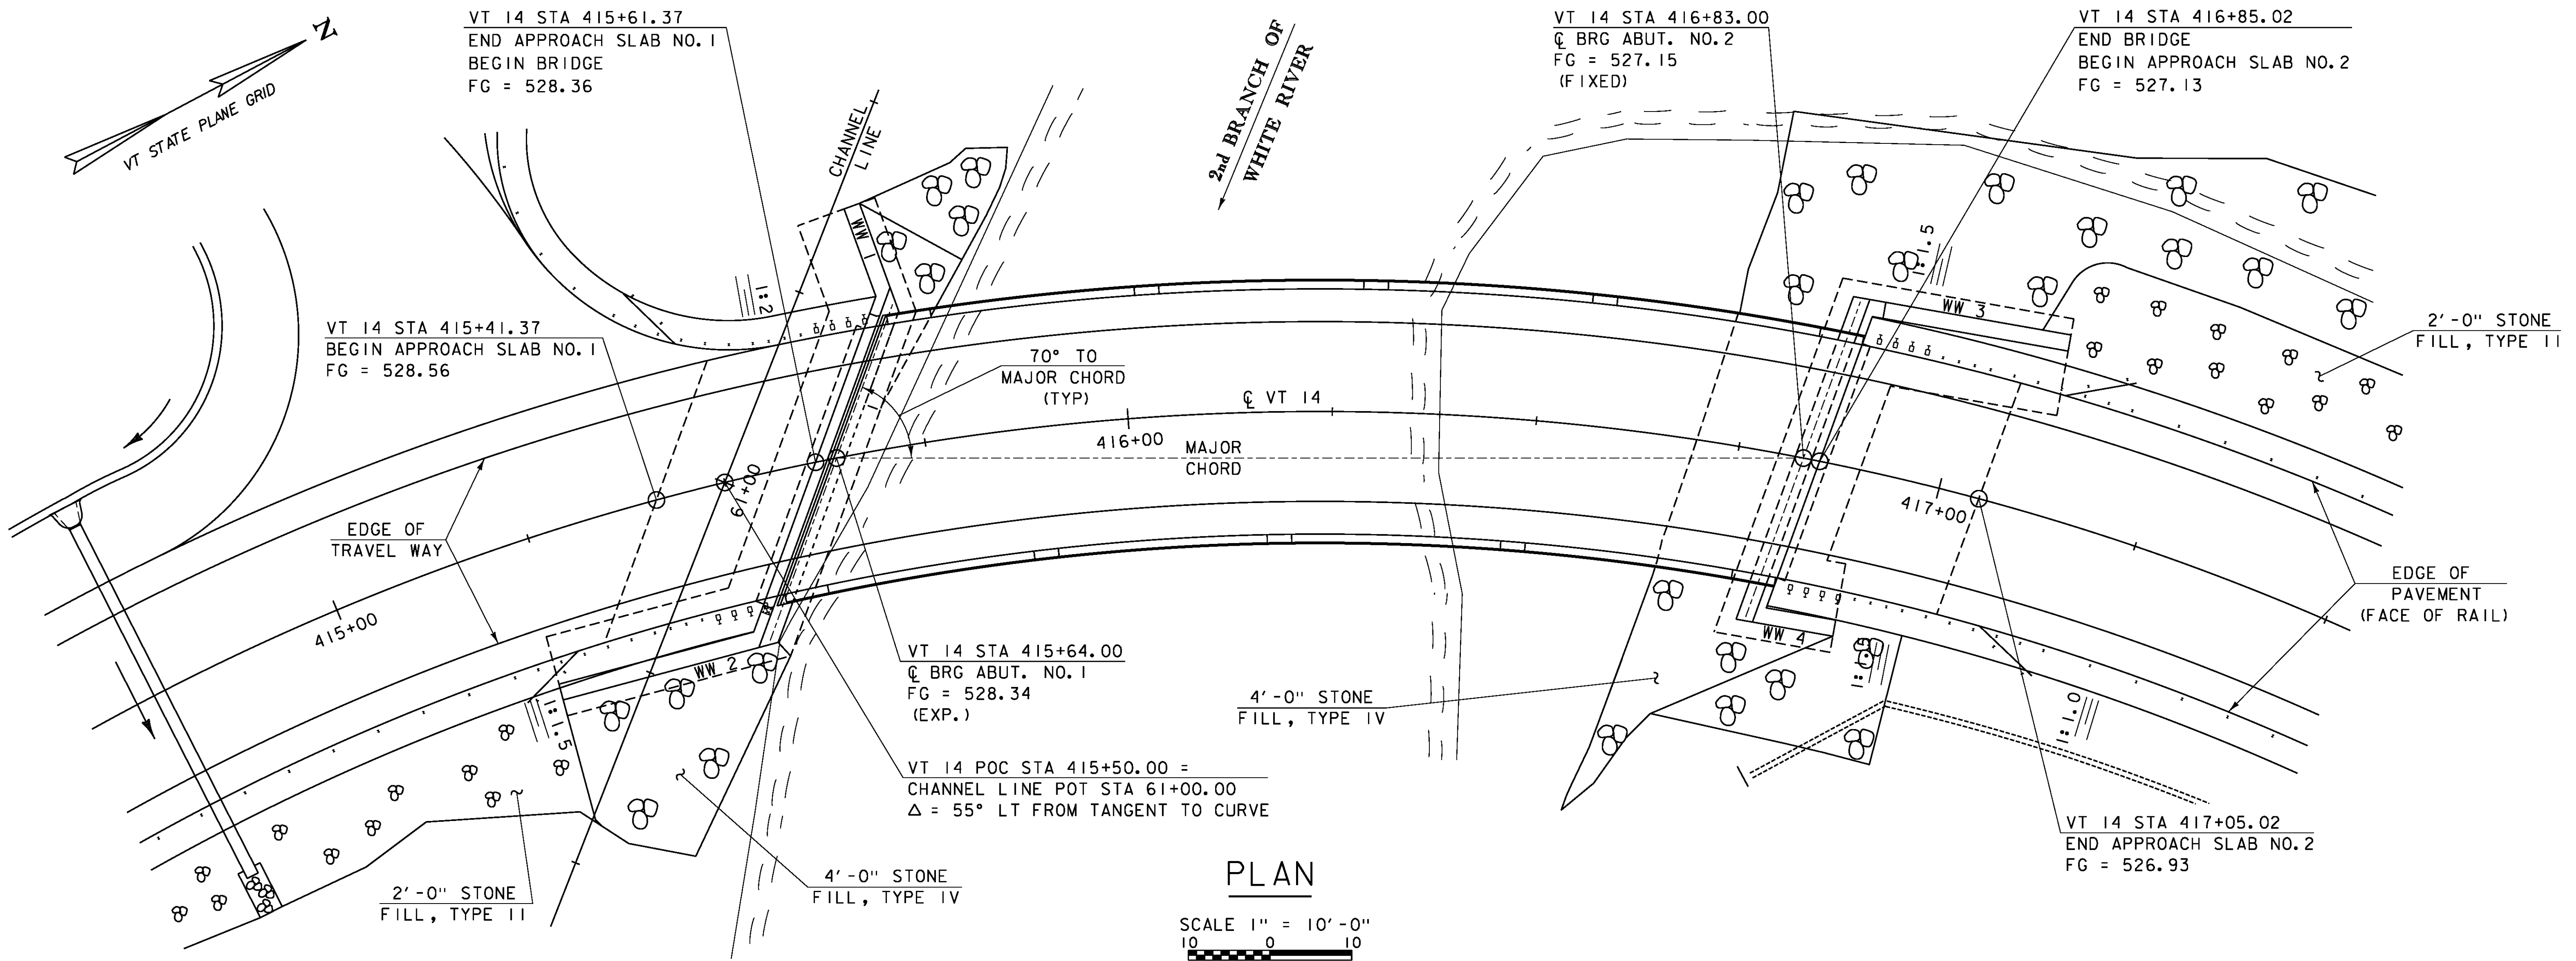

PROJECT NAME:	ROYALTON	PLOT DATE:	08-OCT-2013
PROJECT NUMBER:	BRS 0147 (13)	DRAWN BY:	STR3
FILE NAME:	\BR 28\86e055pe_28.dgn	CHECKED BY:	C. CARLSON
PROJECT LEADER:	C. CARLSON	SHEET	108 OF 186
DESIGNED BY:	D. PETERSON	BRIDGE 28 PLAN AND ELEVATION	

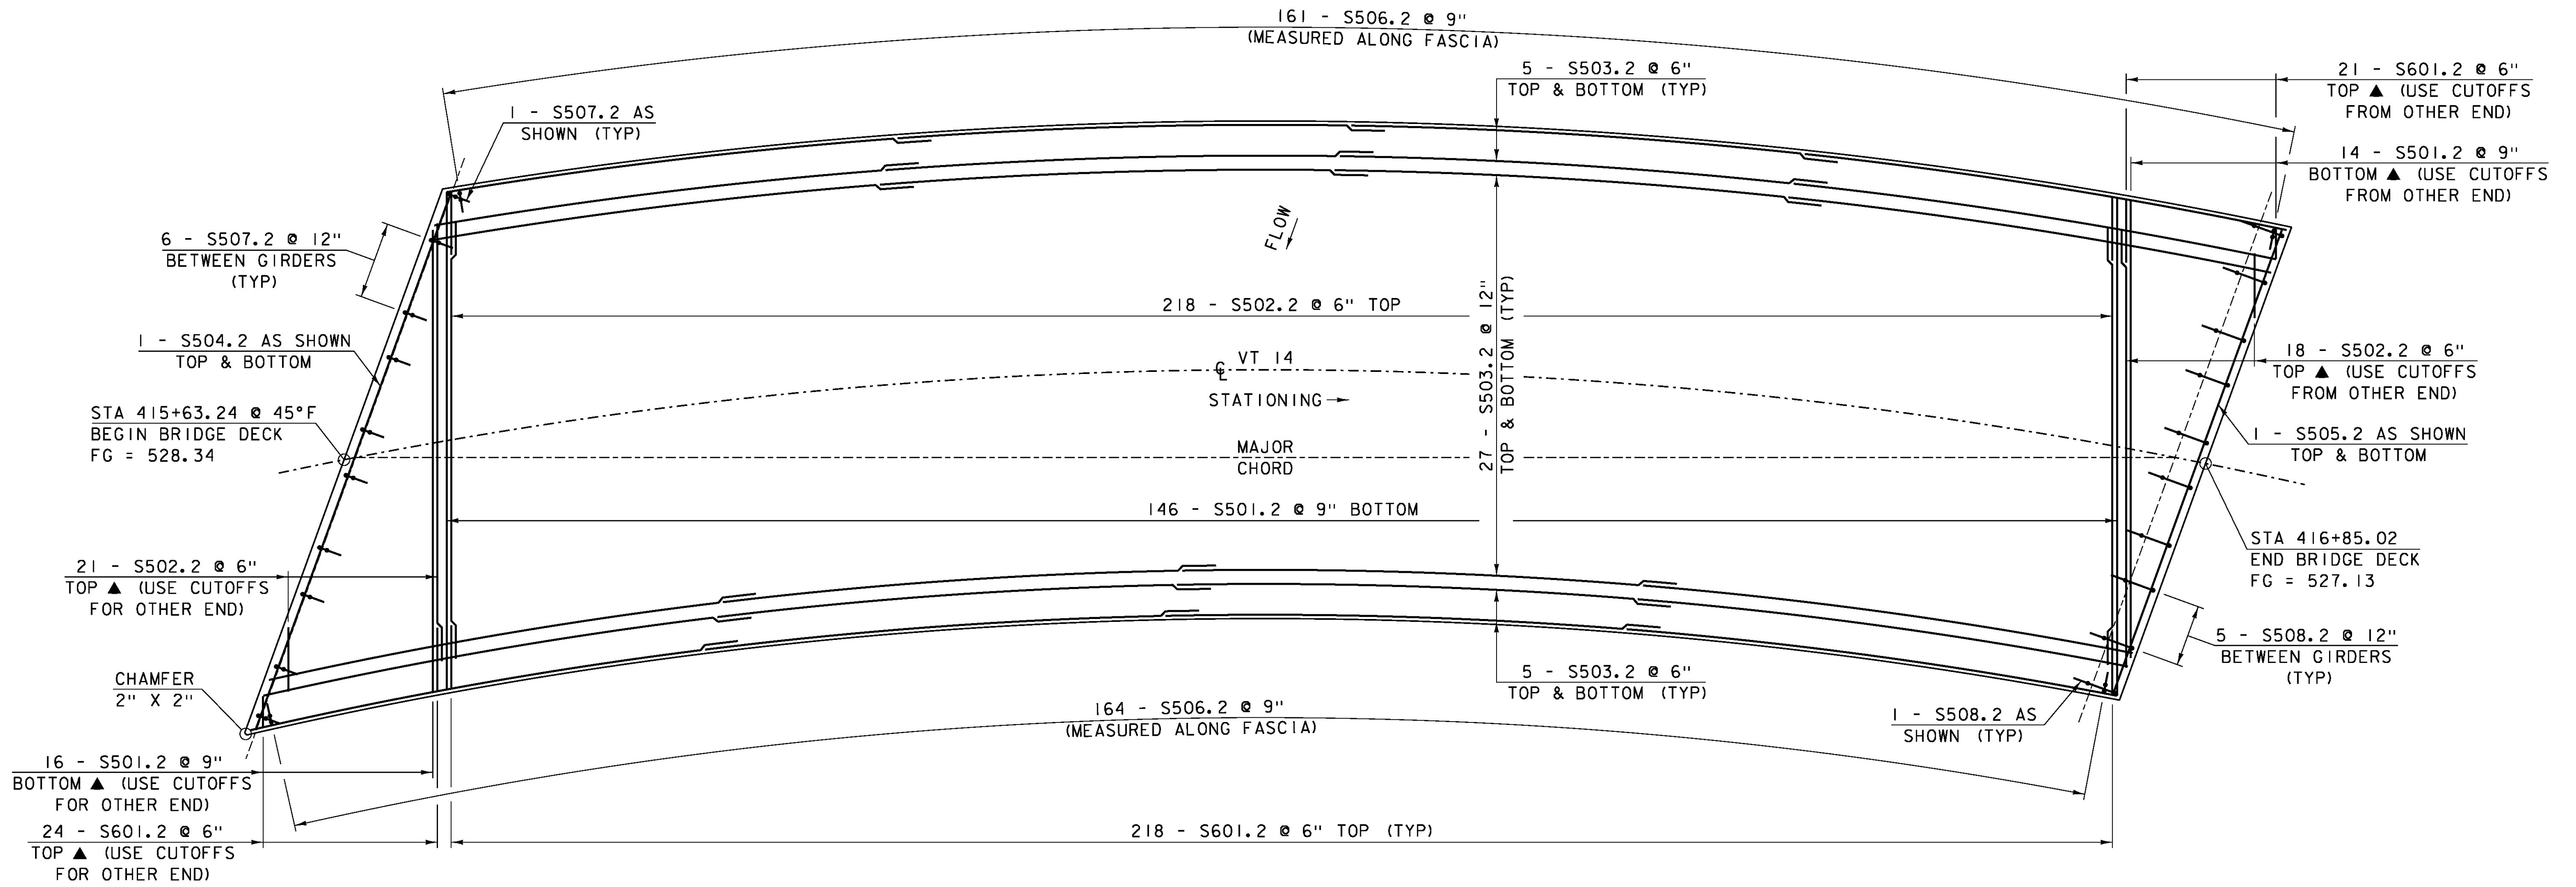


**DECK REINFORCING PLAN**  
SCALE: 3/8" = 1'-0"

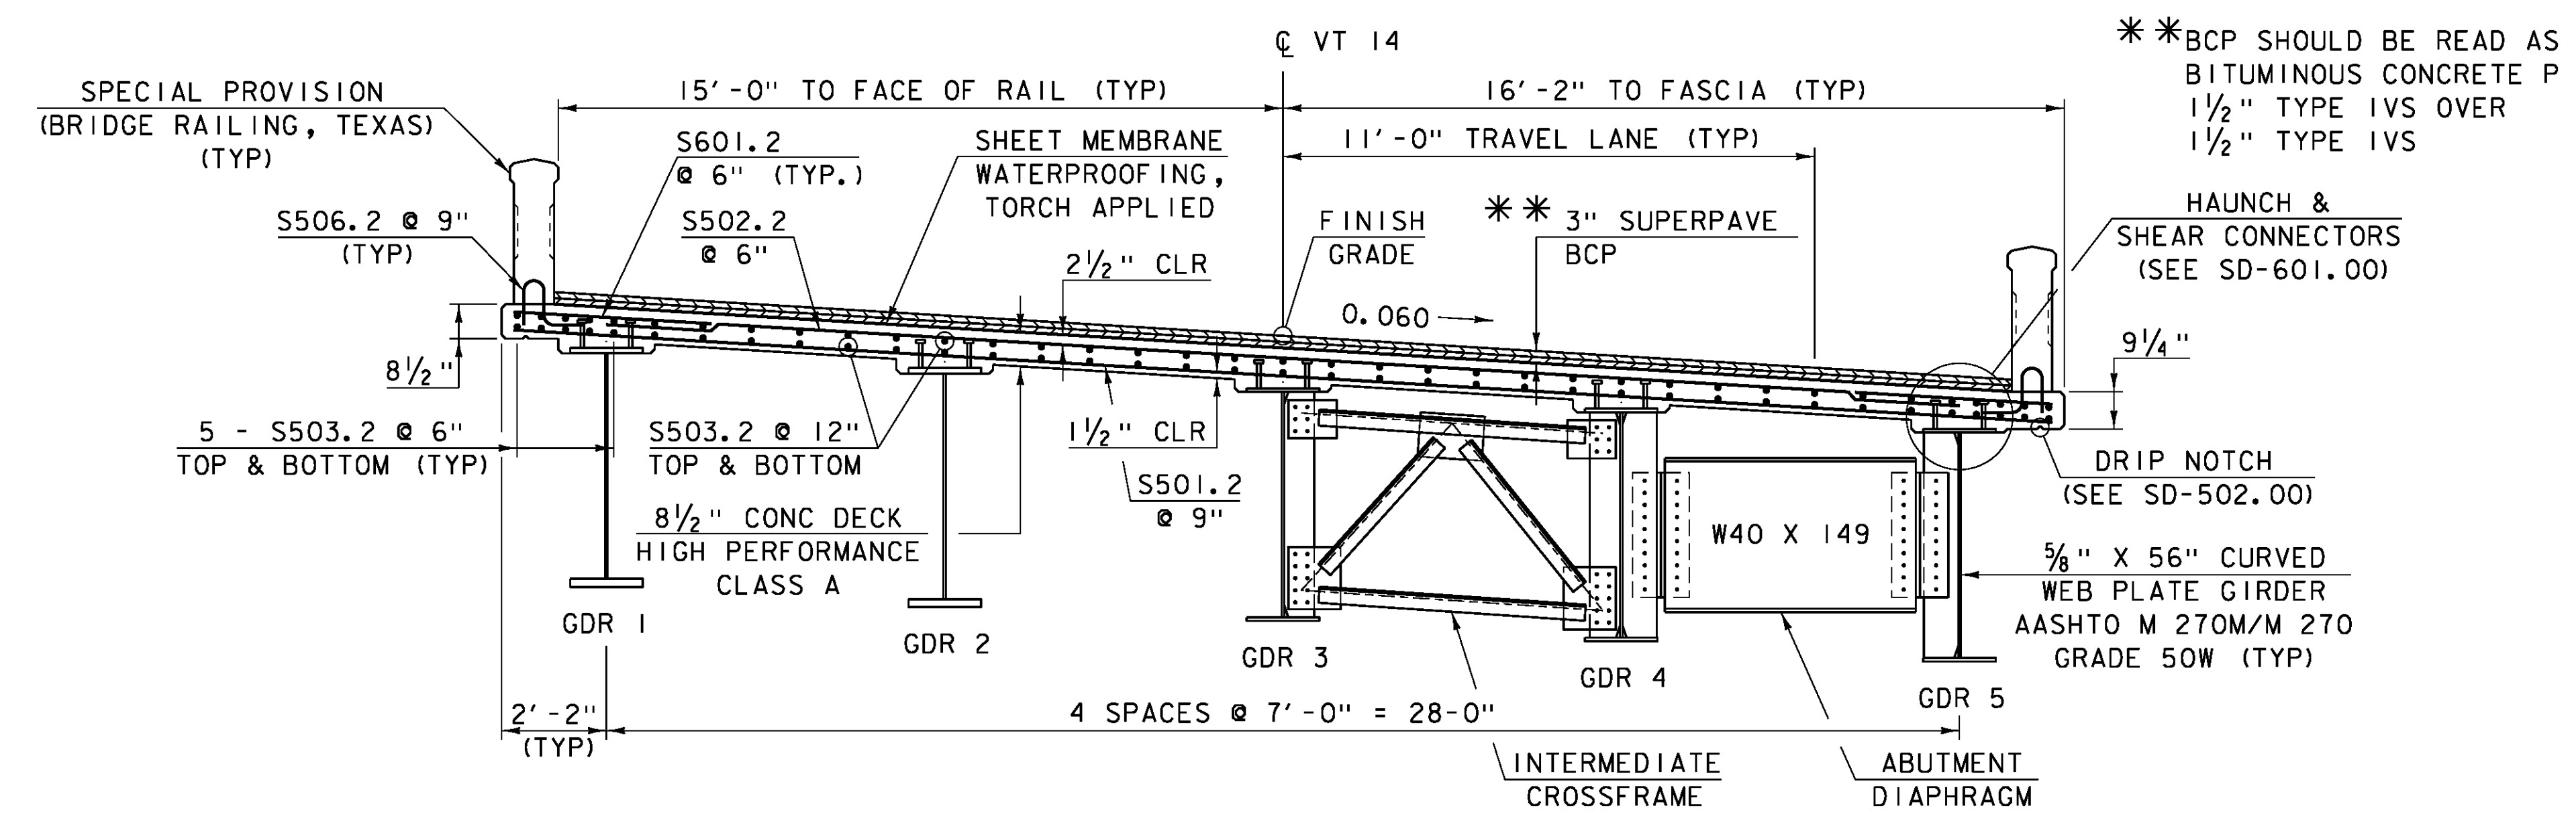


**BRIDGE 28 TYPICAL SECTION**  
SCALE: 3/8" = 1'-0"

- NOTES:**
- ▲ = CUT TO FIT IN FIELD
  - 3" CLEAR, UNLESS OTHERWISE SPECIFIED ON THE PLANS.
  - 2'-2" BAR LAP UNLESS OTHERWISE SPECIFIED ON THE PLANS.

PROJECT NAME:	ROYALTON
PROJECT NUMBER:	BRS 0147 (13)
FILE NAME:	\BR 28\86e055sup_28.dgn
PROJECT LEADER:	C. CARLSON
DESIGNED BY:	D. PETERSON
BRIDGE 28 DECK REINFORCING DETAILS	
PLOT DATE:	08-OCT-2013
DRAWN BY:	G. ROY
CHECKED BY:	D. PETERSON
SHEET	109 OF 186

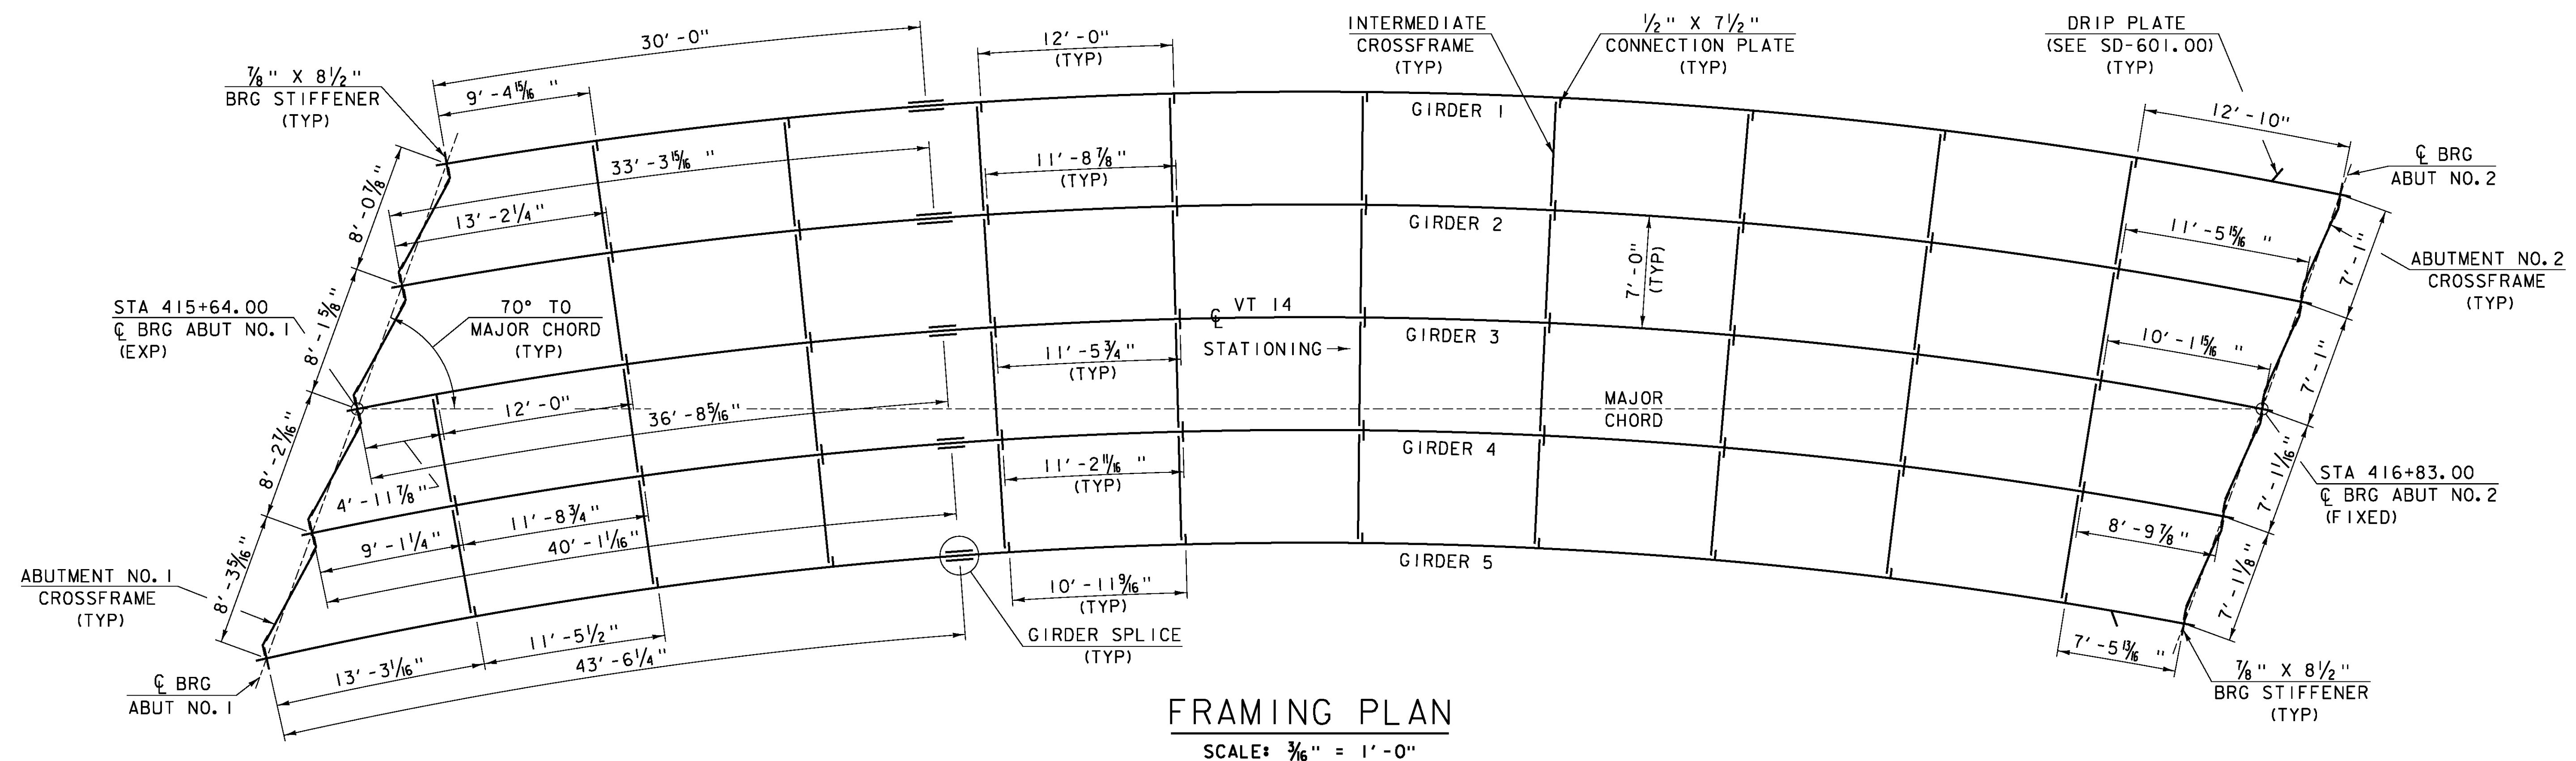

**FRAMING PLAN**  
SCALE: 3/16" = 1'-0"

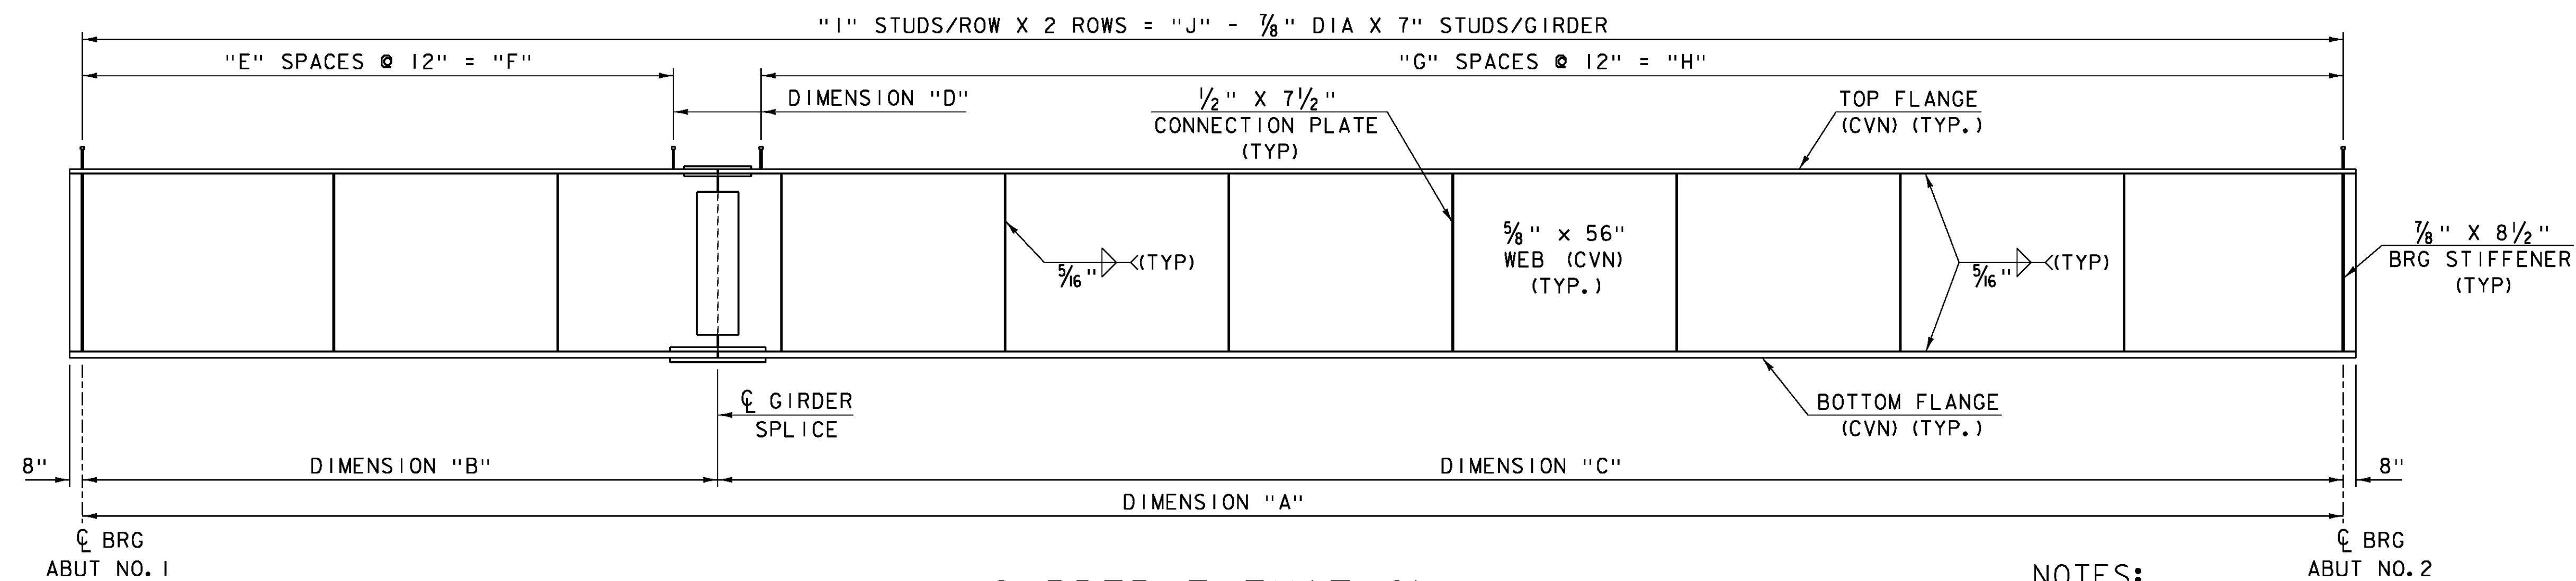

**GIRDER ELEVATION**

HORIZONTAL SCALE: 3/16" = 1'-0"  
VERTICAL SCALE: 3/8" = 1'-0"

**GIRDER DIMENSIONS TABLE**


GIRDER	TOP FLANGE	BOTTOM FLANGE	RADIUS	"A"	"B"	"C"	"D"	"E"	"F"	"G"	"H"	"I"	"J"
1	1 3/8" X 18"	2" X 18"	323.71'	118'-2 1/16"	30'-0"	88'-2 1/16"	4'-2 1/16"	28	28'-0"	86	86'-0"	116	232
2	1 3/8" X 18"	2" X 18"	316.71'	118'-7 1/4"	33'-3 1/16"	85'-3 3/16"	4'-7 1/4"	31	31'-0"	83	83'-0"	116	232
3	7/8" X 18"	7/8" X 18"	309.71'	119'-0"	36'-8 5/16"	82'-3 3/16"	3'-0"	35	35'-0"	81	81'-0"	118	236
4	7/8" X 18"	7/8" X 18"	302.71'	119'-5 1/8"	40'-1 1/16"	79'-4 1/16"	2'-5 1/8"	39	39'-0"	78	78'-0"	119	238
5	7/8" X 18"	7/8" X 18"	295.71'	119'-10 1/16"	43'-6 1/4"	76'-4 7/16"	2'-10 1/16"	42	42'-0"	75	75'-0"	119	238

**NOTES:**

- DIMENSIONS SHOWN ARE ALONG THE ARC  $\phi$  OF THE GIRDER.
- ENDS OF GIRDERS SHALL BE FABRICATED SO THAT THEY WILL BE PLUMB UNDER FULL DEAD LOAD.
- BEARING STIFFENERS SHALL BE PLUMB TO THE WEB IN THEIR FINAL POSITION.
- CVN - SHALL MEET CHARPY V-NOTCH REQUIREMENTS FOR MAIN MEMBERS AS INDICATED IN SECTION 714.
- ALL STEEL SHALL BE AASHTO M 270M/M 270, GRADE 50W.


PROJECT NAME: ROYALTON  
PROJECT NUMBER: BRS 0147 (13)

FILE NAME: \BR 28\86e055sup_28.dgn PLOT DATE: 08-OCT-2013  
PROJECT LEADER: C. CARLSON DRAWN BY: G. ROY  
DESIGNED BY: D. PETERSON CHECKED BY: D. PETERSON  
BRIDGE 28 FRAMING PLAN AND GIRDER ELEVATION SHEET 110 OF 186

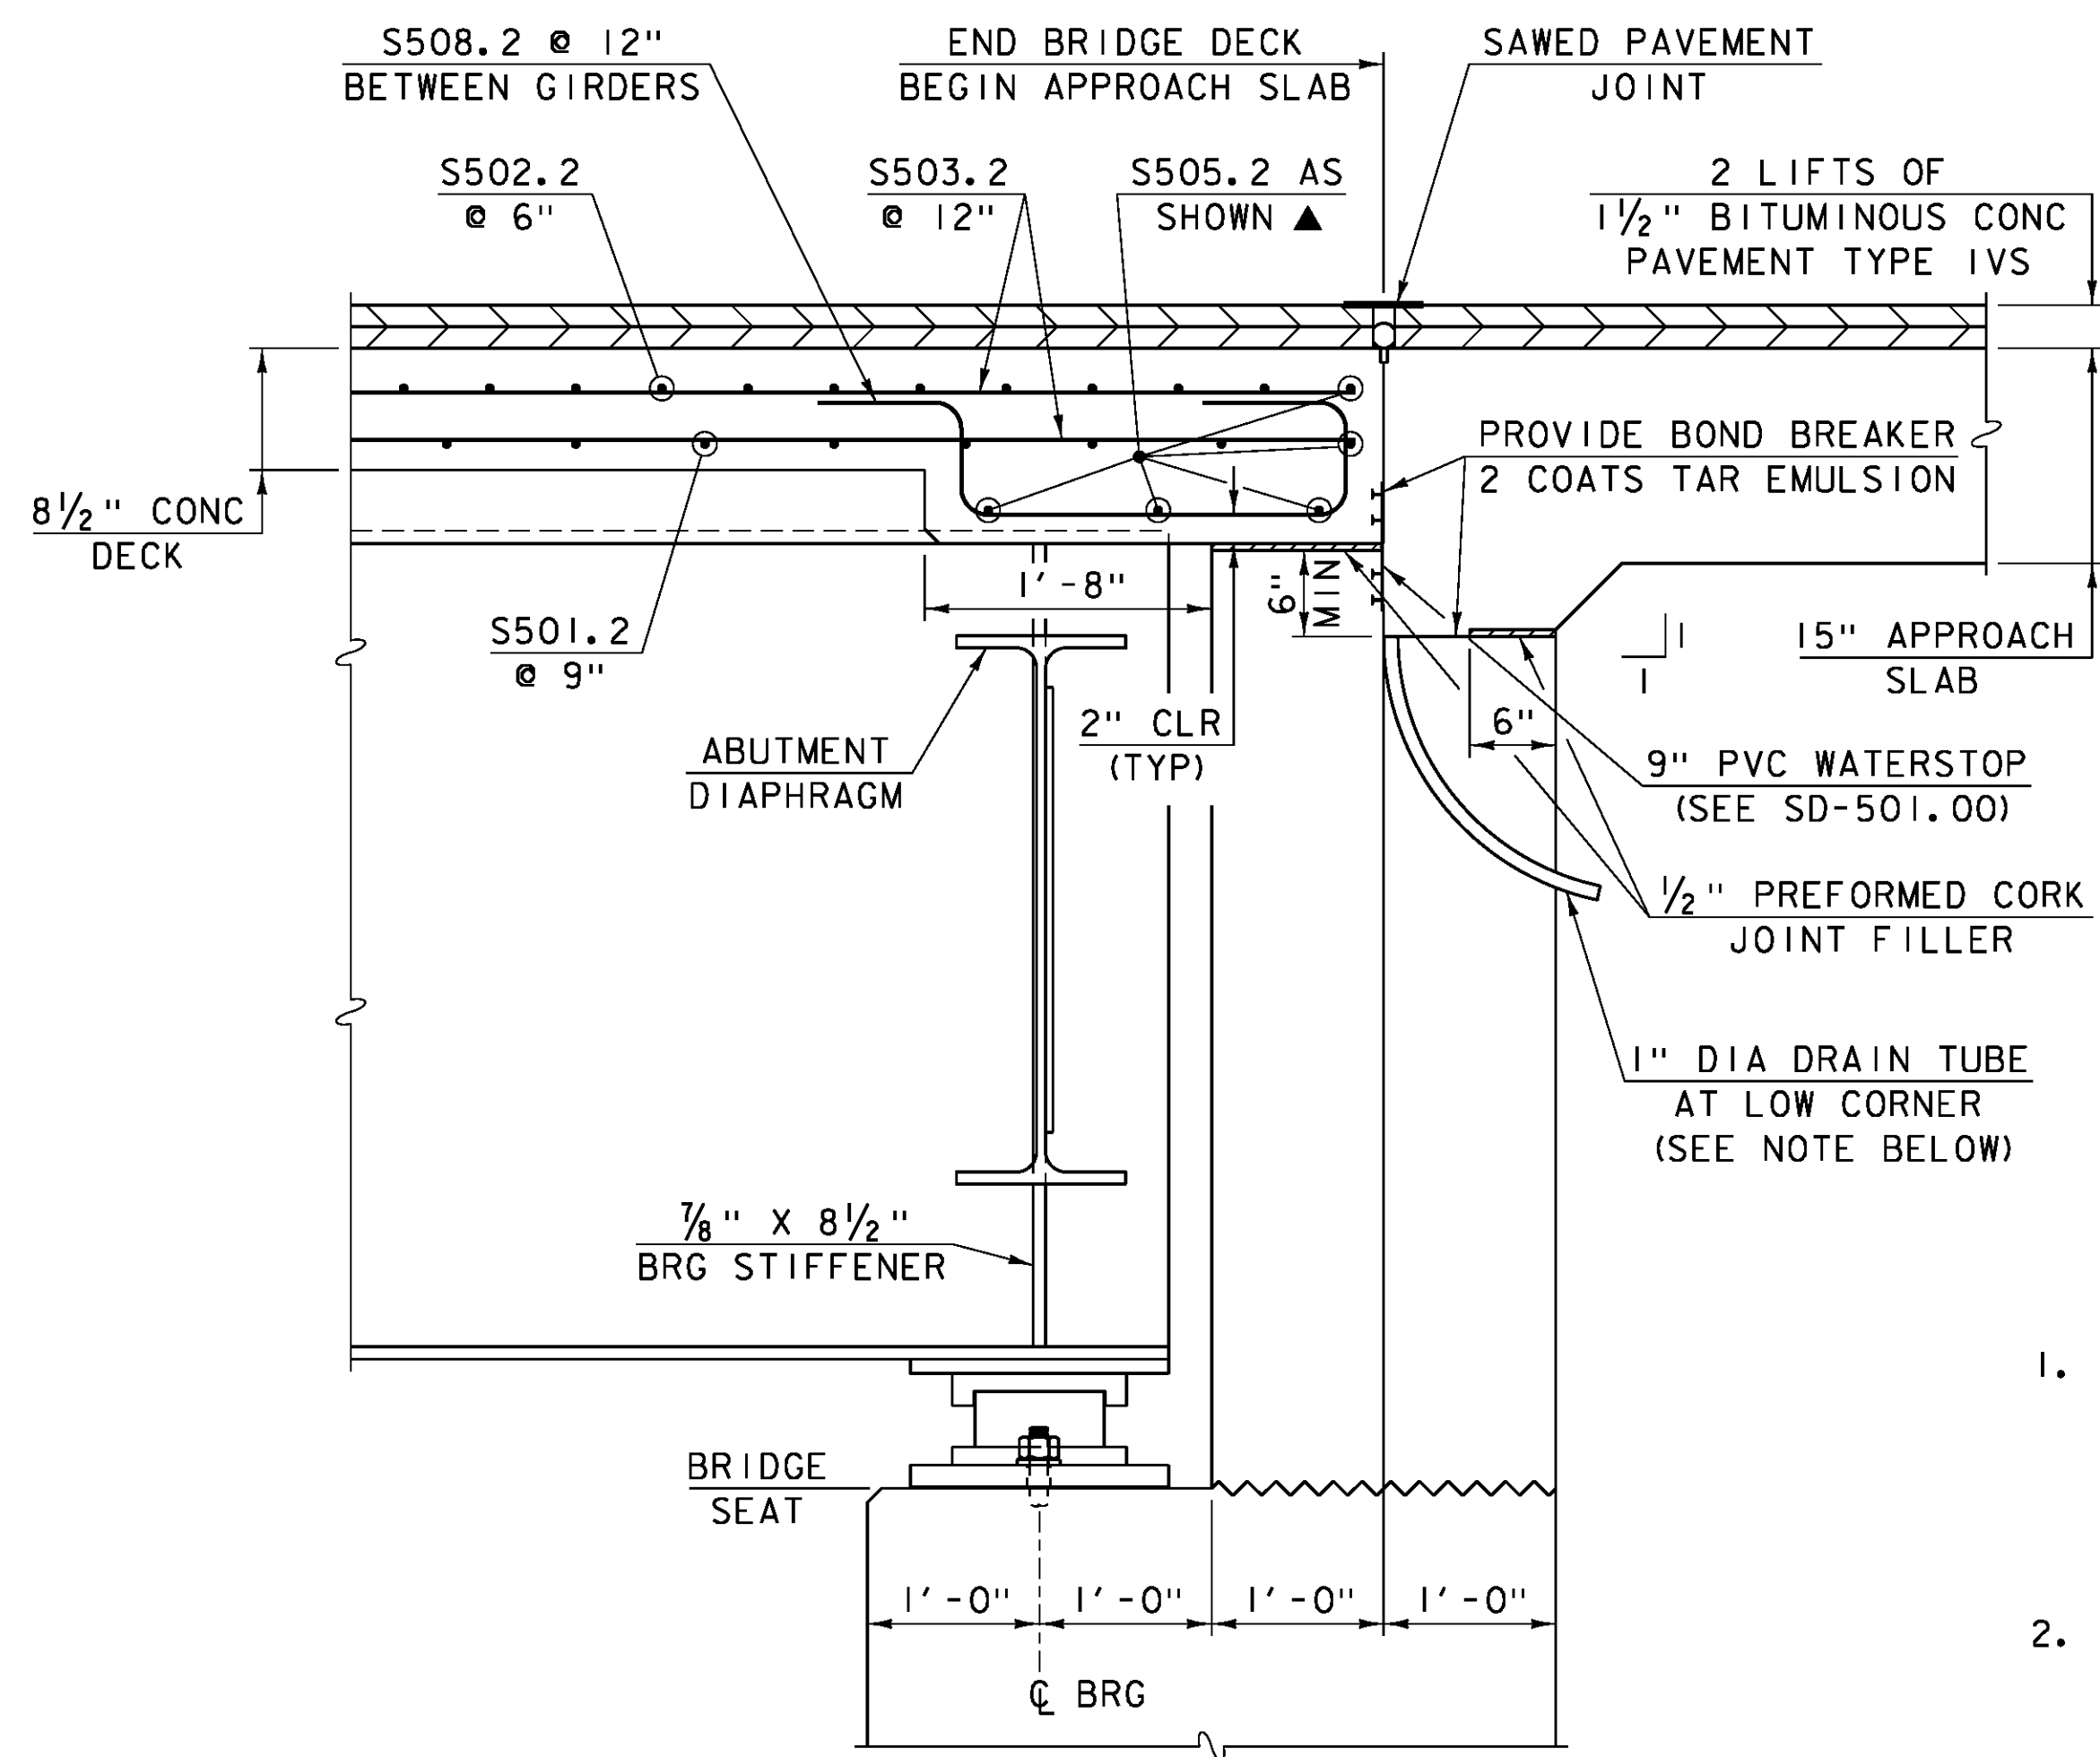

**ABUTMENT NO. 2 END DETAIL**

(NORMAL TO CL BEARING)  
SCALE: 1" = 1'-0"

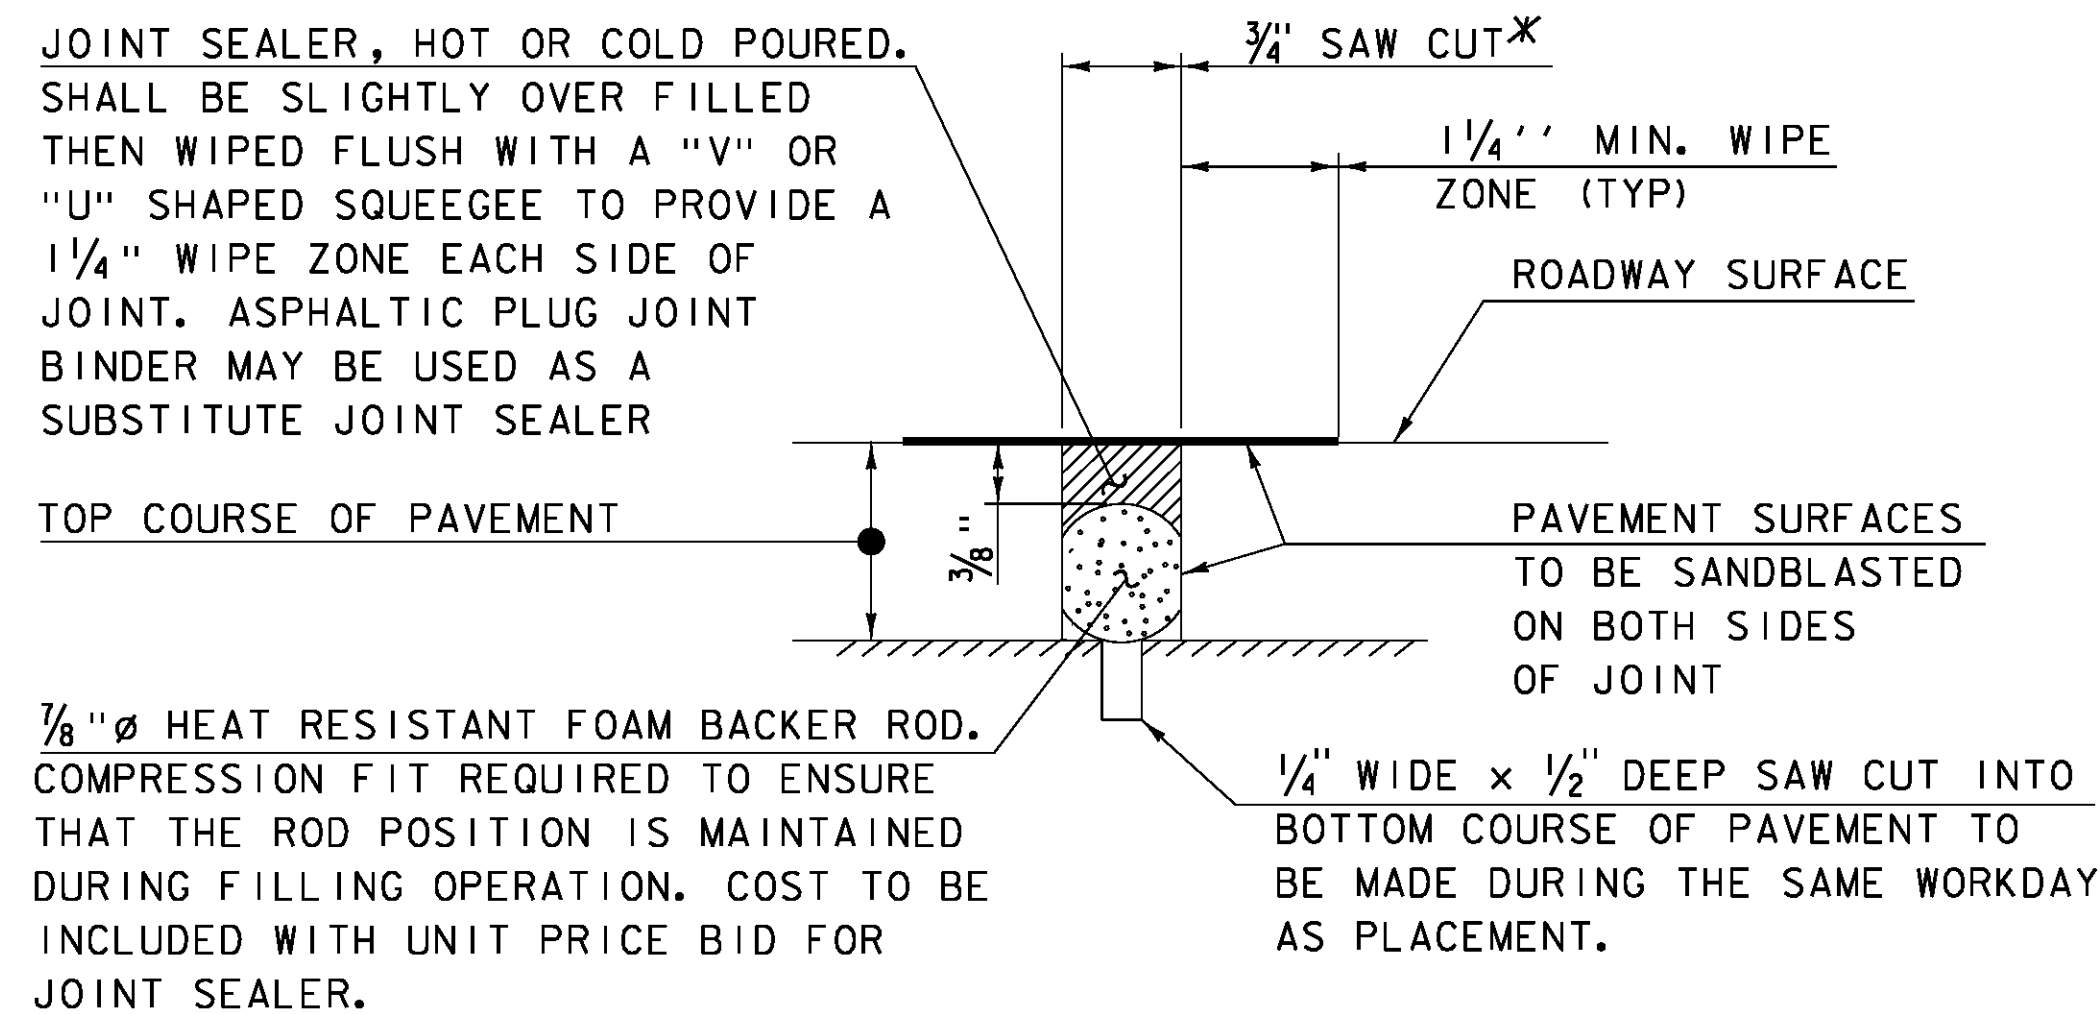


**SAWED PAVEMENT JOINT DETAIL**  
(NOT TO SCALE)

* JOINT IS TO BE LOCATED ACCURATELY BY STRING LINING, OR OTHER MEANS, PRIOR TO PAVING, SO THAT THE SAW CUTS WILL BE MADE DIRECTLY OVER THE END OF CONCRETE DECK. JOINT SHALL BE CUT DRY IN A SINGLE PASS AND BE SEALED WITHIN 24 HOURS OR PRIOR TO EXPOSURE TO TRAFFIC. JOINT SHALL BE CLEANED PRIOR TO APPLYING THE JOINT SEALER.

**NOTES:**

- MATERIAL FOR TUBE SHALL MEET THE REQUIREMENTS OF SUBSECTION 740.01. PAYMENT FOR TUBE AND ITS INSTALLATION SHALL BE INCLUDED IN THE UNIT PRICE BID FOR ITEM 501.34, "CONCRETE, HIGH PERFORMANCE CLASS B".
- SEE SD-516.11a AND SD-516.11b FOR ABUTMENT NO. 1 END DETAILS WITH EXPANSION JOINT.

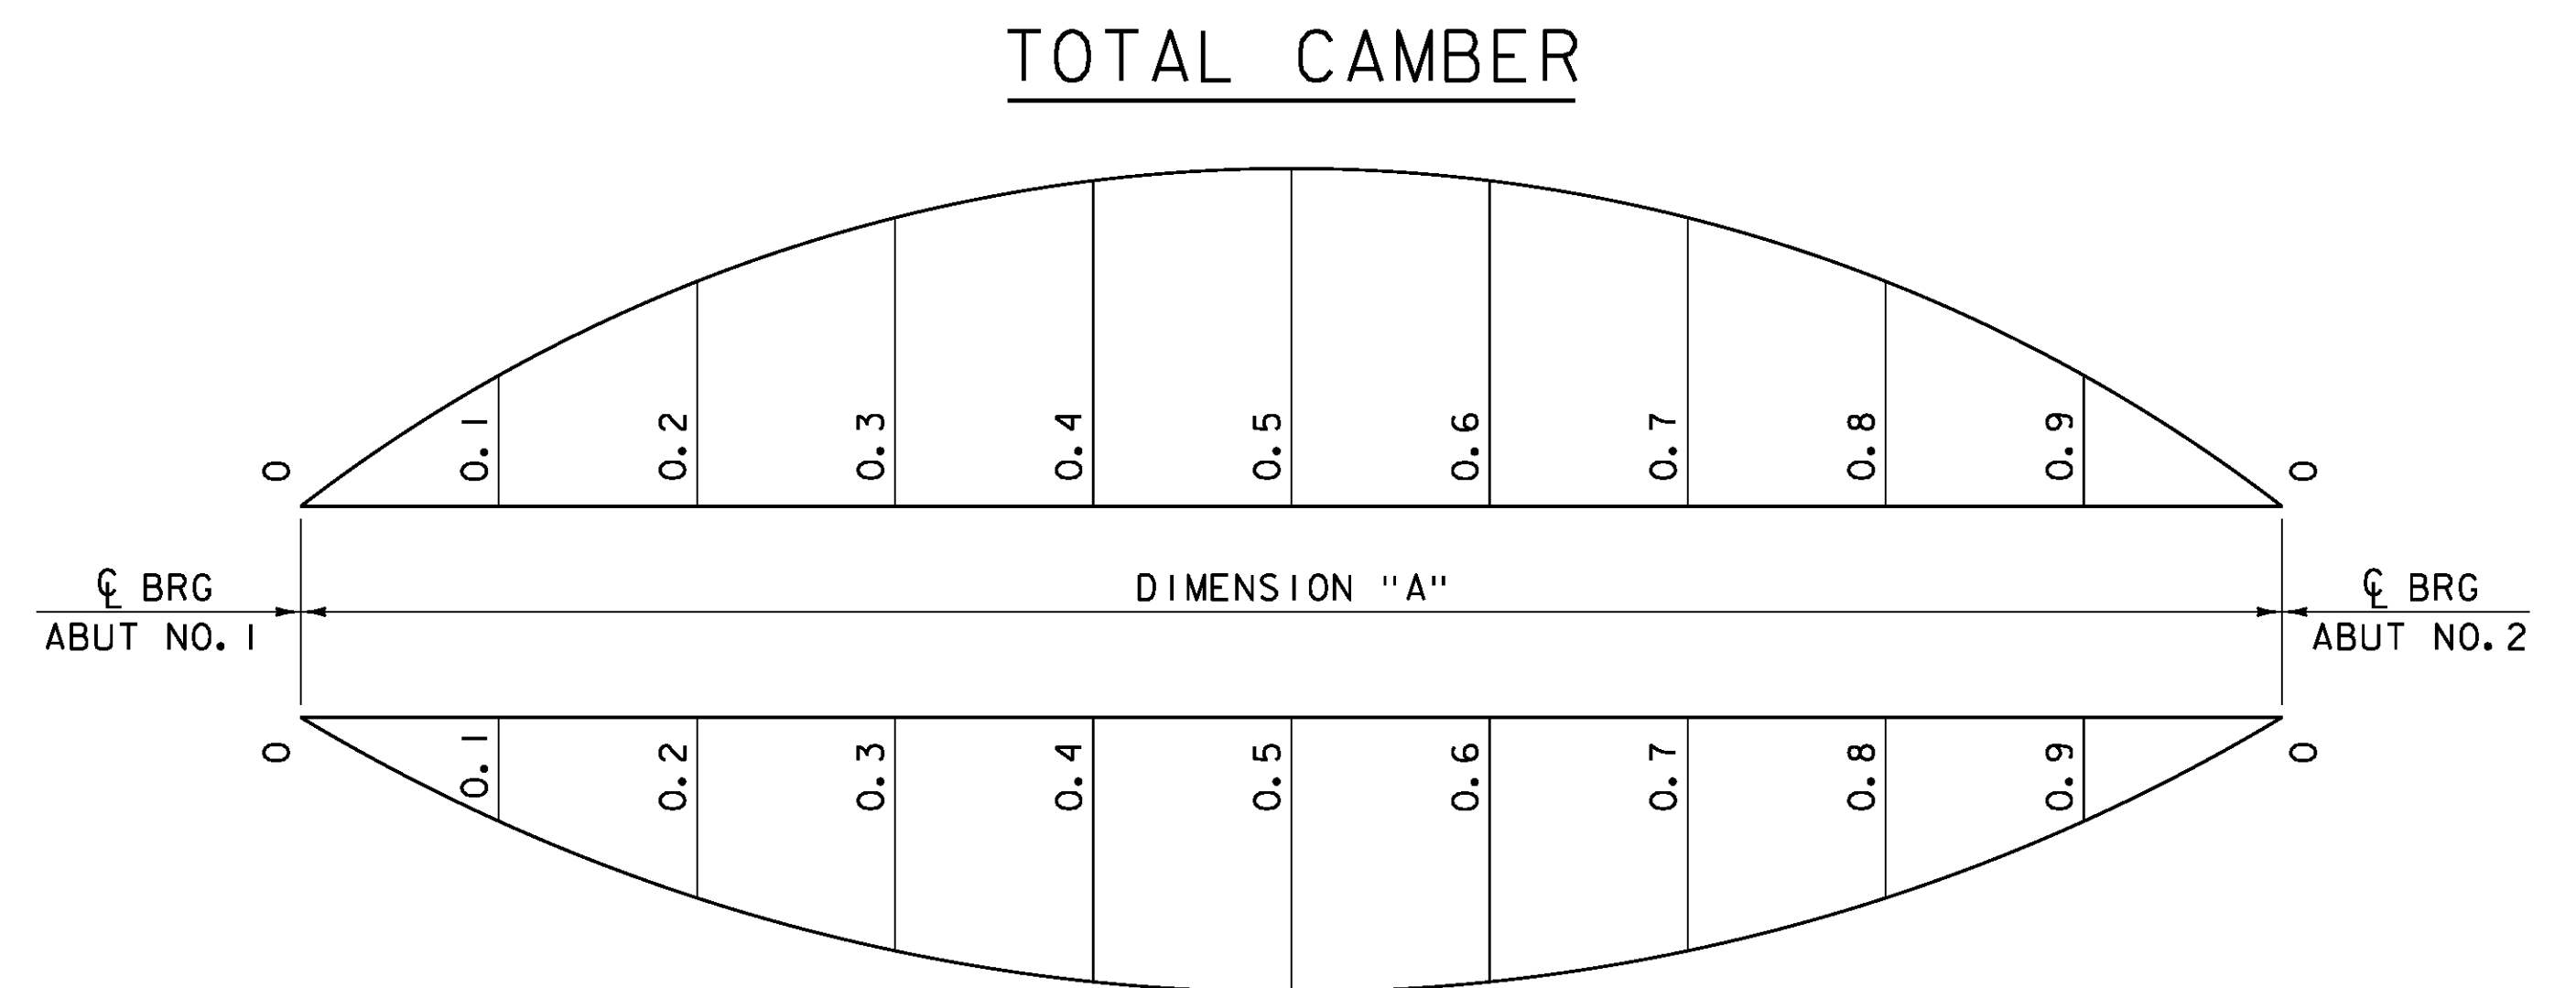

**DEAD LOAD DEFLECTION**

CAMBER AND DEFLECTION MEASUREMENTS ARE GIVEN IN INCHES AT TENTH POINTS. MEASUREMENTS INCLUDE GIRDER SELF-WEIGHT.

**TOTAL CAMBER**


GIRDER	"A"	0.1	0.2	0.3	0.4	0.5	0.6	0.7	0.8	0.9
1	118' - 2 5/8"	2 1/2"	4 1/8"	6 5/16"	7 3/8"	7 3/4"	7 3/8"	6 5/16"	4 5/8"	2 1/2"
2	118' - 7 1/4"	2 3/16"	4 1/8"	5 5/8"	6 5/8"	6 5/8"	6 1/8"	5 3/4"	4 1/4"	2 1/4"
3	119' - 0"	2"	3 1/16"	5 1/16"	5 5/8"	6 1/4"	6"	5 1/4"	3 7/8"	2 1/16"
4	119' - 5 1/8"	1 5/8"	3 3/8"	4 9/16"	5 3/8"	5 5/8"	5 7/16"	4 1/16"	3 1/2"	1 7/8"
5	119' - 10 1/16"	1 1/16"	3 1/16"	4 3/16"	4 1/8"	5"	4 1/16"	4 1/8"	3 1/16"	1 5/8"

**DEAD LOAD DEFLECTION**

GIRDER	"A"	0.1	0.2	0.3	0.4	0.5	0.6	0.7	0.8	0.9
1	118' - 2 5/8"	1 5/8"	3 1/8"	5 1/16"	5 5/8"	6 1/4"	5 5/8"	5 1/16"	3 1/16"	1 5/8"
2	118' - 7 1/4"	1 5/8"	3 3/8"	4 3/8"	5 3/16"	5 1/16"	5 1/4"	4 1/2"	3 5/16"	1 3/4"
3	119' - 0"	1 7/16"	2 3/4"	3 1/16"	4 1/2"	4 3/4"	4 9/16"	3 5/8"	2 5/16"	1 9/16"
4	119' - 5 1/8"	1 1/4"	2 3/8"	3 5/16"	3 5/8"	4 1/8"	4"	3 7/16"	2 1/2"	1 3/8"
5	119' - 10 1/16"	1 1/8"	2 1/8"	2 7/8"	3 3/8"	3 1/2"	3 3/8"	2 7/8"	2 1/16"	1 1/8"


PROJECT NAME: ROYALTON  
PROJECT NUMBER: BRS 0147 (13)

FILE NAME: \BR 28\86e055sup_28.dgn PLOT DATE: 08-OCT-2013  
PROJECT LEADER: C. CARLSON DRAWN BY: G. ROY  
DESIGNED BY: D. PETERSON CHECKED BY: D. PETERSON  
BRIDGE 28 ABUT. NO. 2 END DETAIL AND CAMBER TABLES SHEET III OF 186

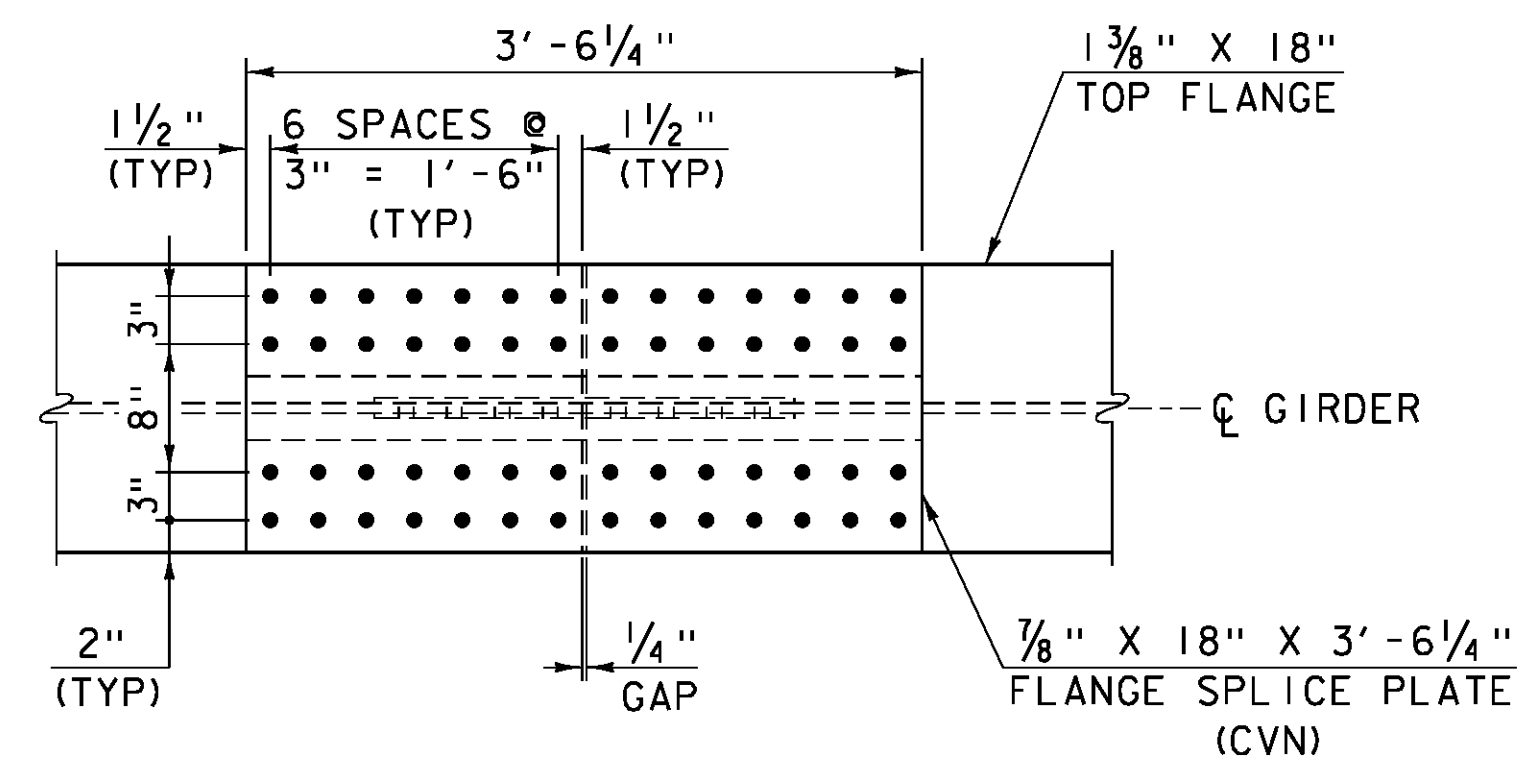


GIRDERS 1 & 2 TOP FLANGE PLAN

SCALE: 1" = 1'-0"

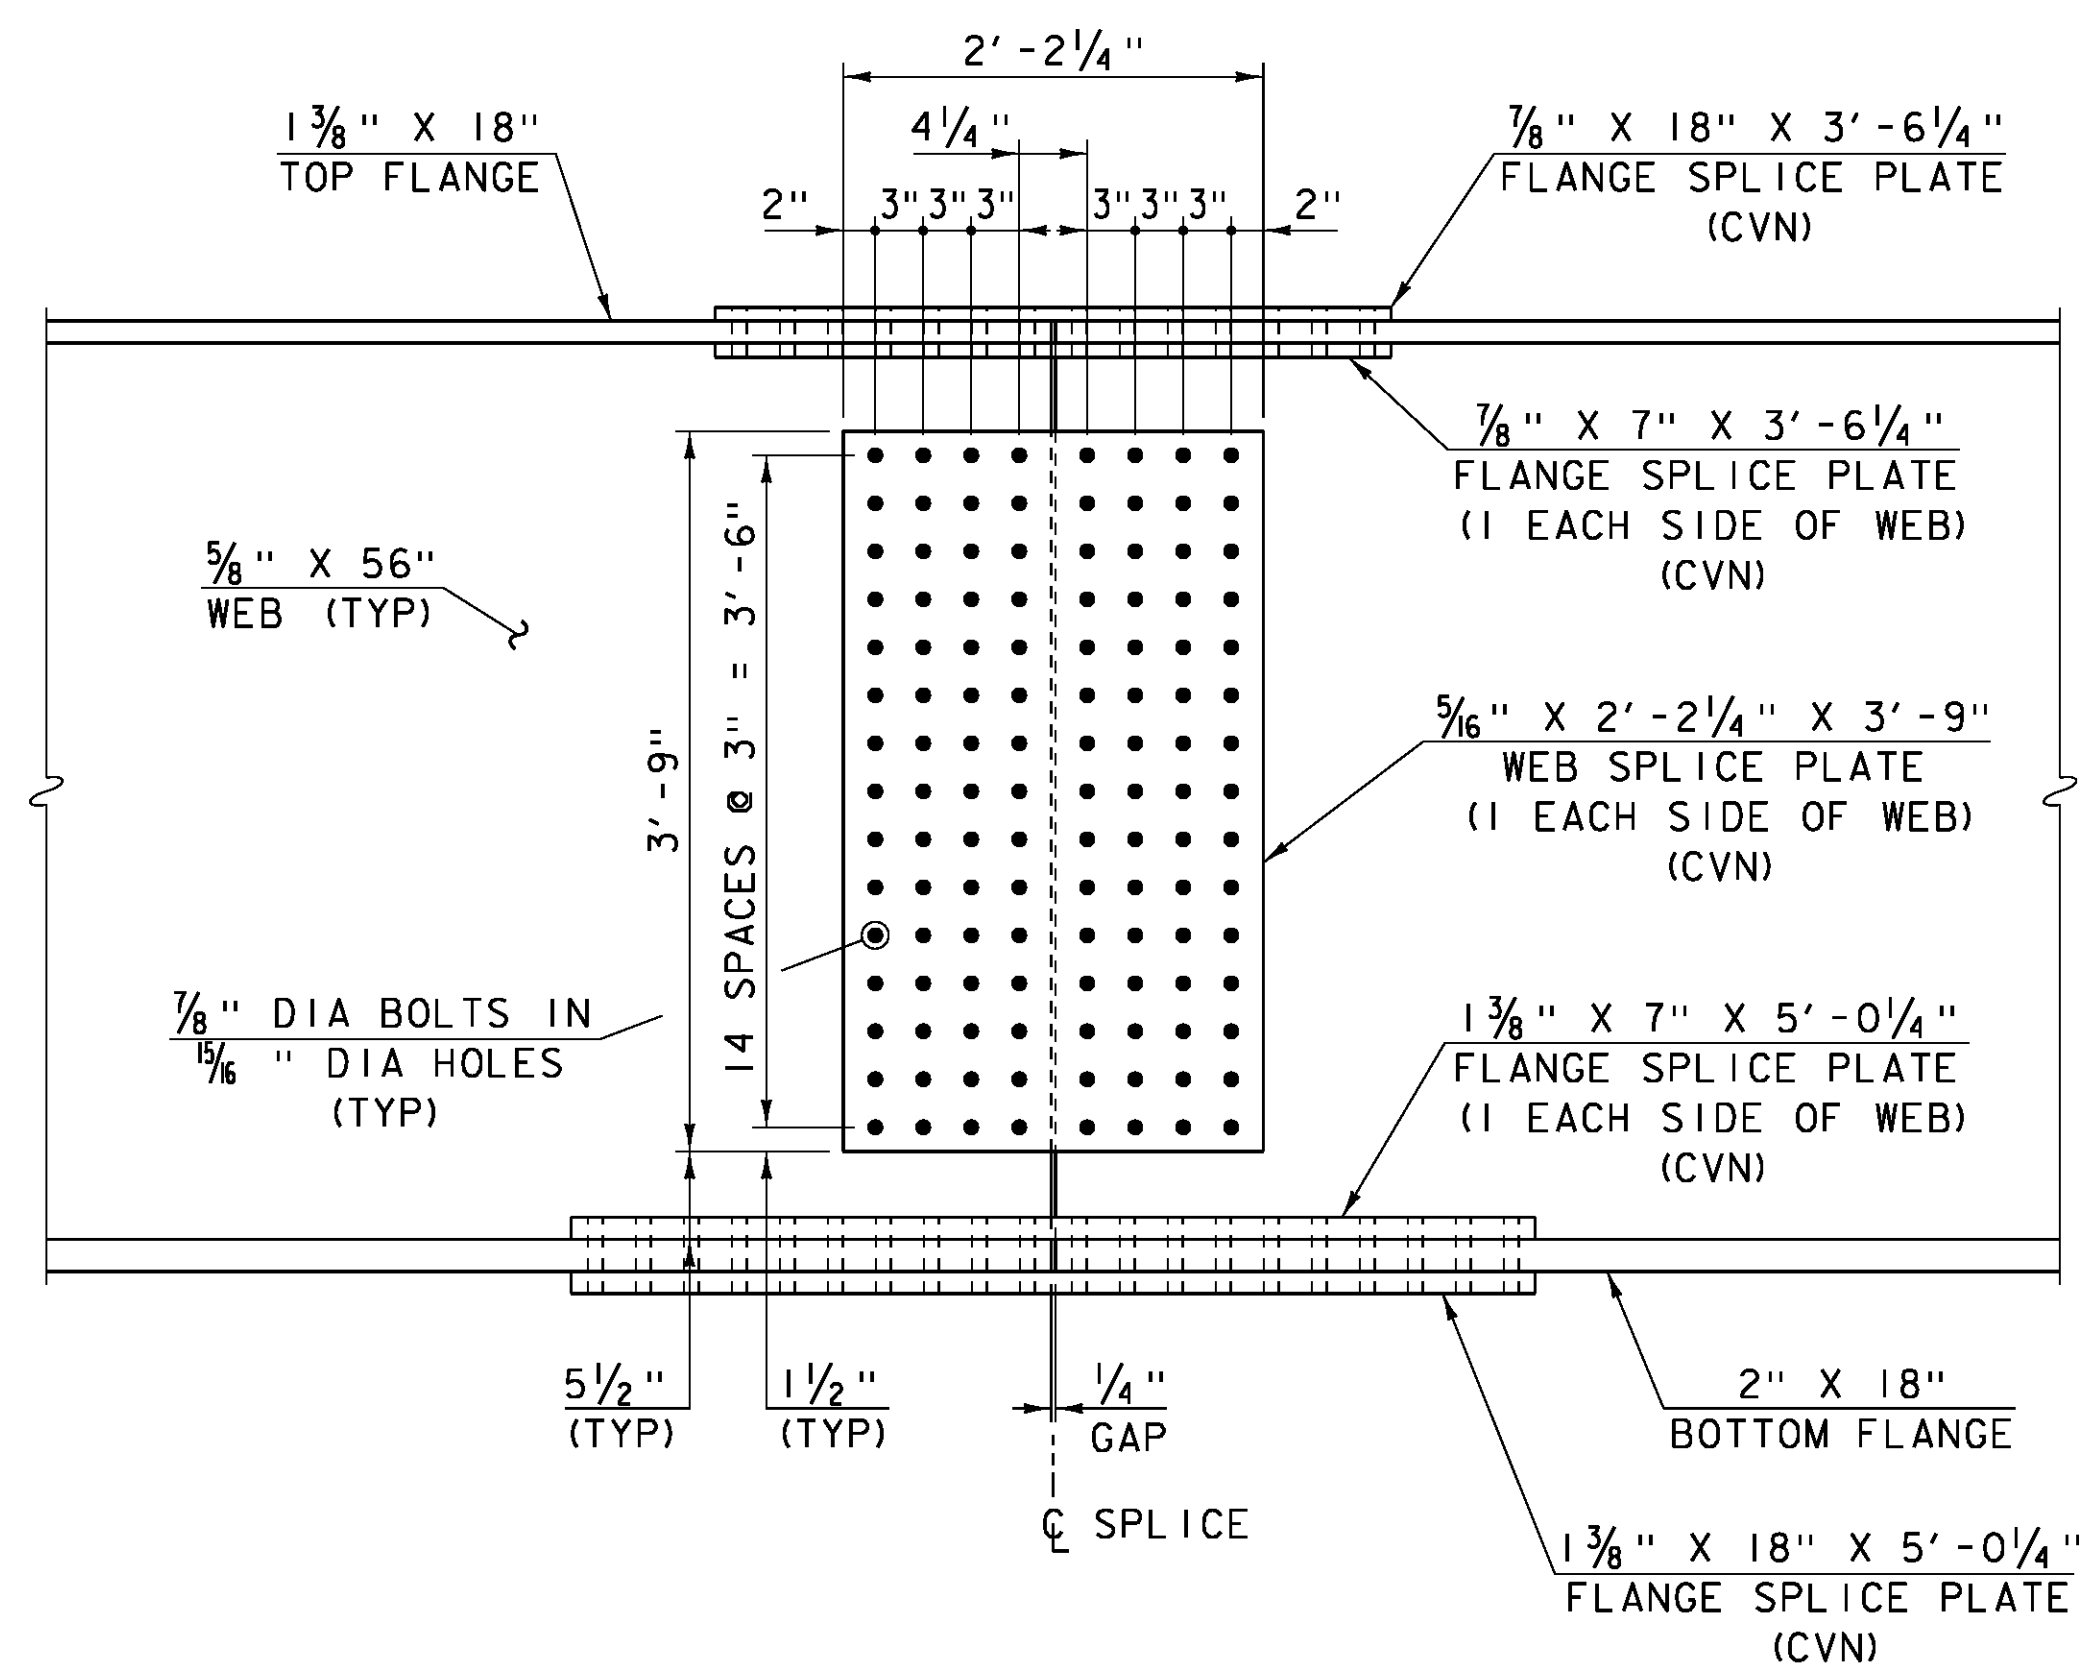


GIRDERS 1 & 2 WEB ELEVATION

SCALE: 1" = 1'-0"

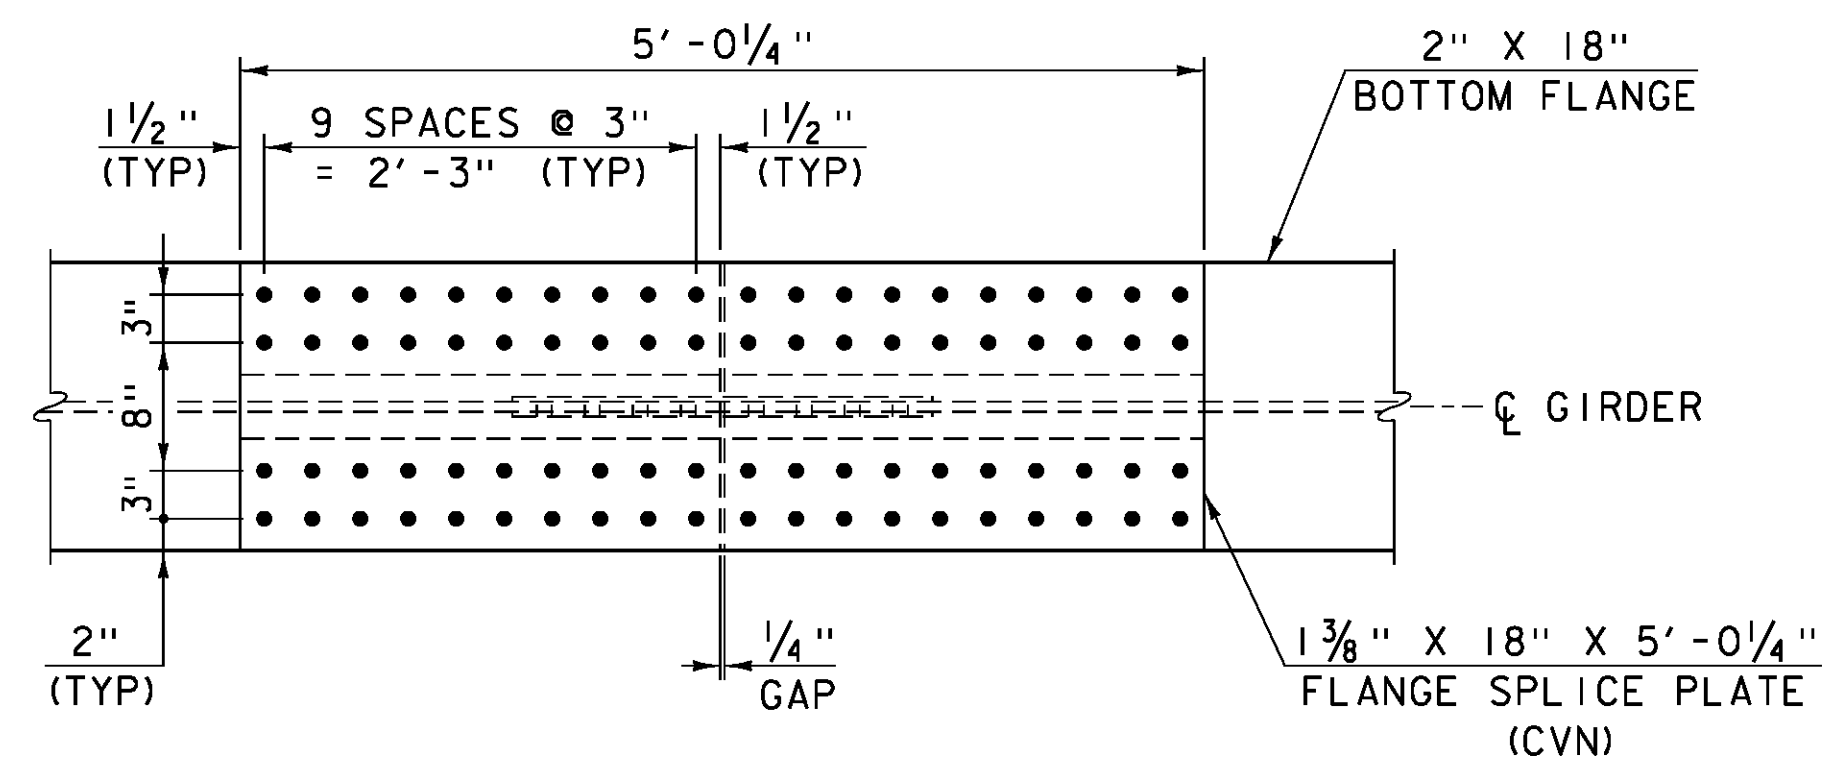


GIRDERS 1 & 2 BOTTOM FLANGE PLAN

SCALE: 1" = 1'-0"

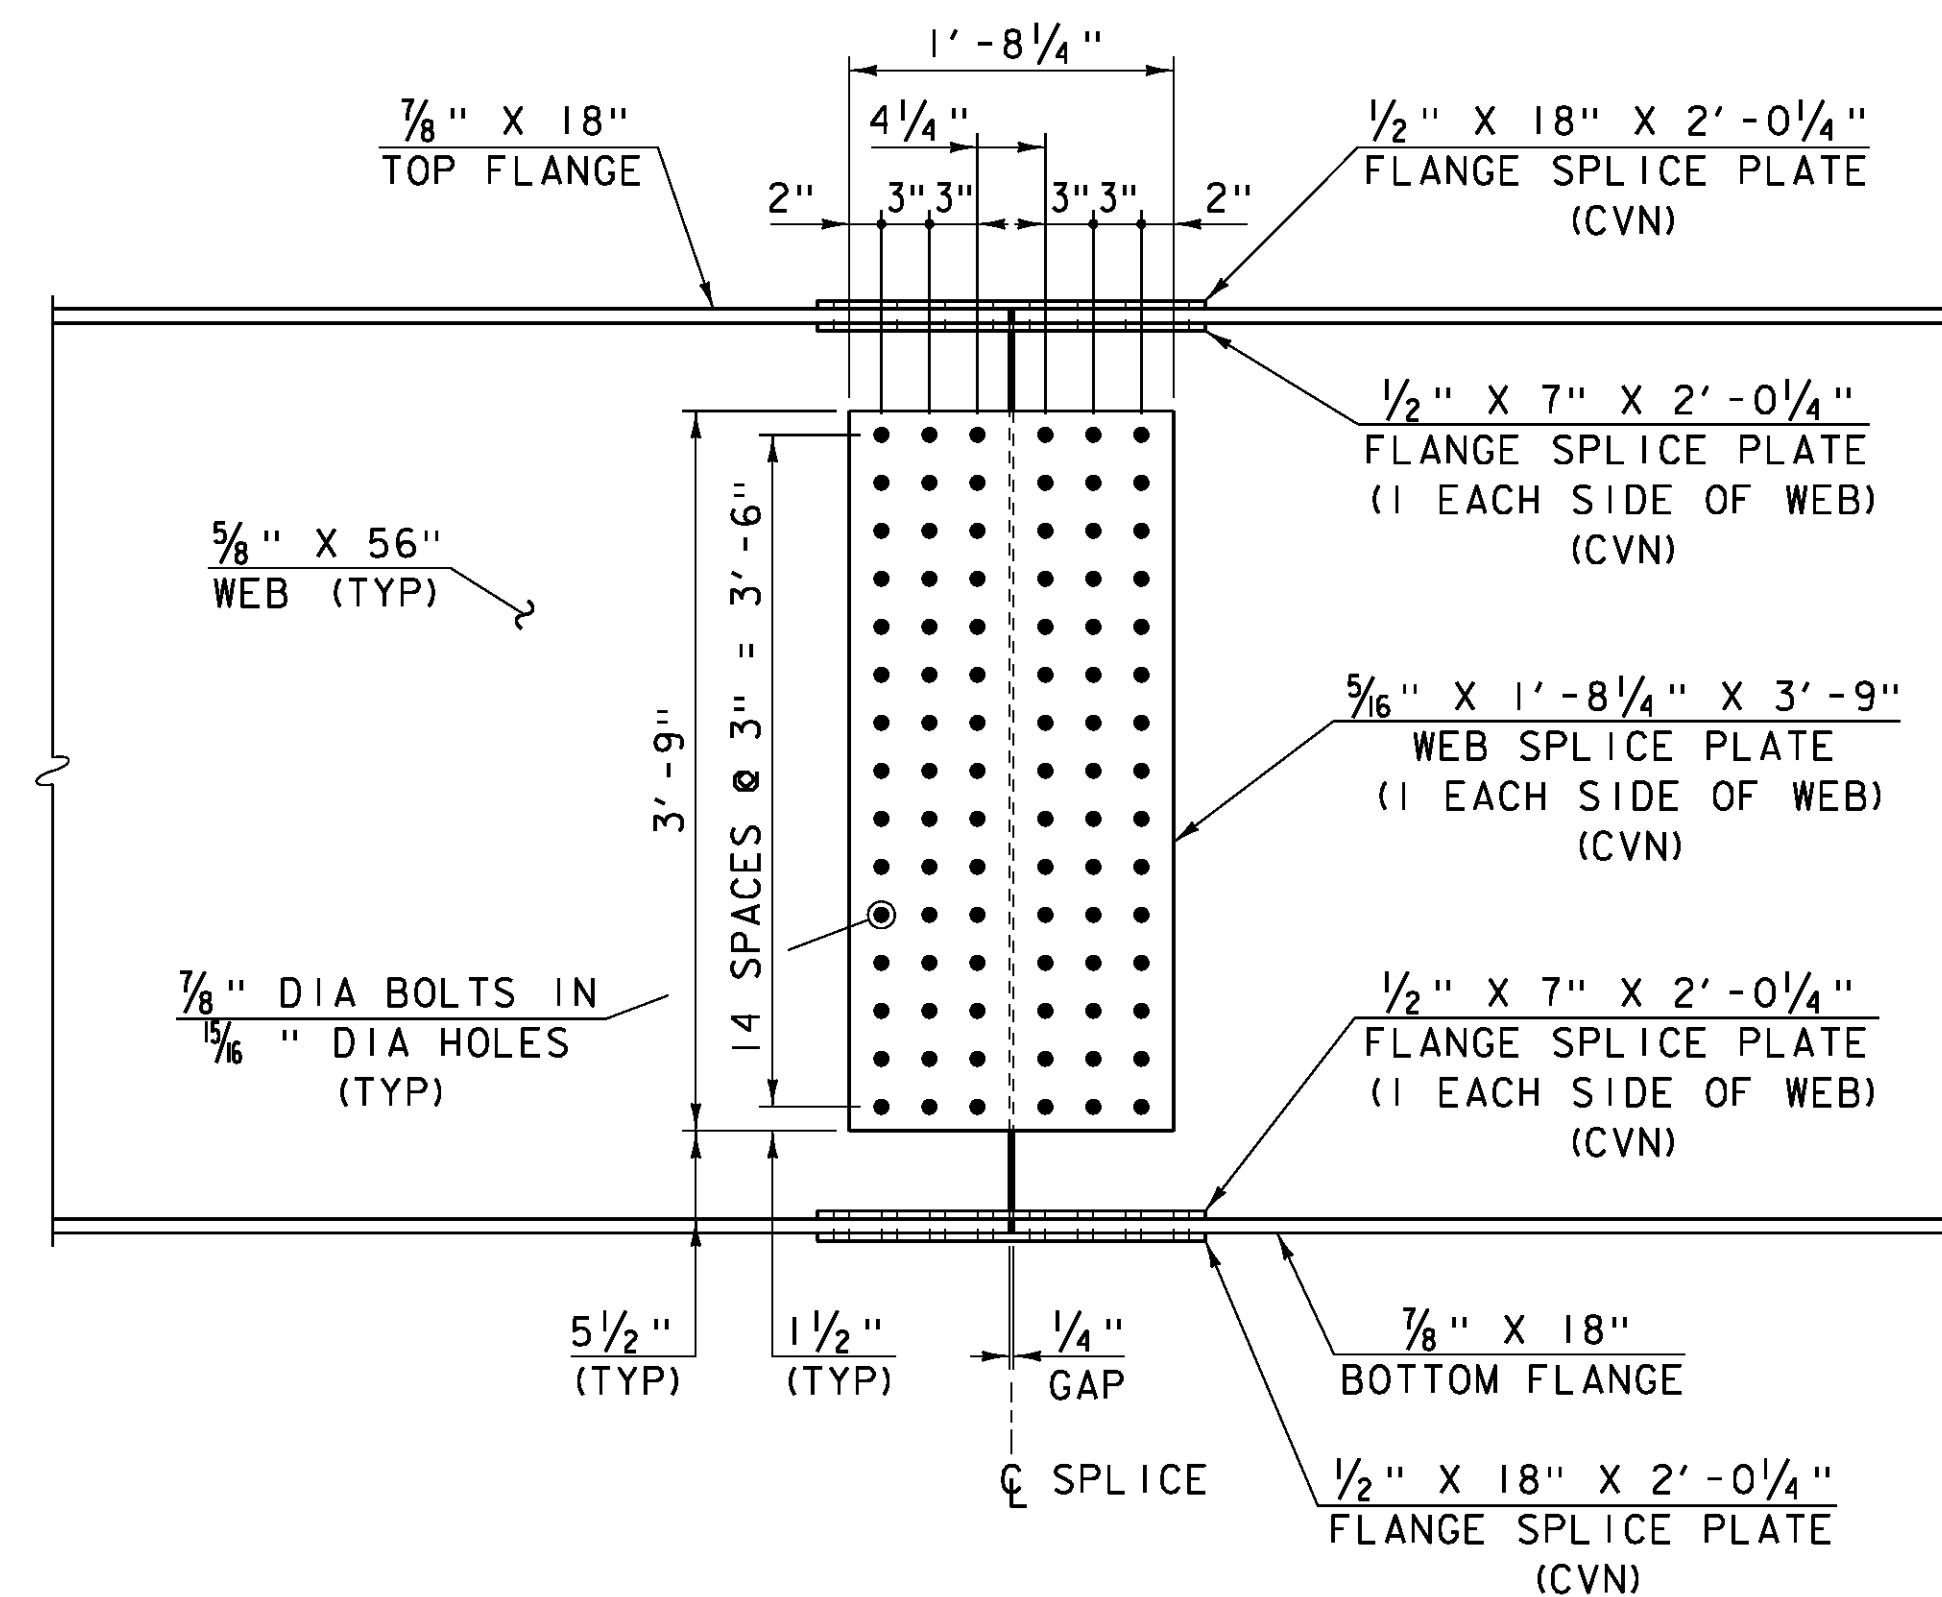

GIRDERS 3-5 WEB ELEVATION

SCALE: 1" = 1'-0"

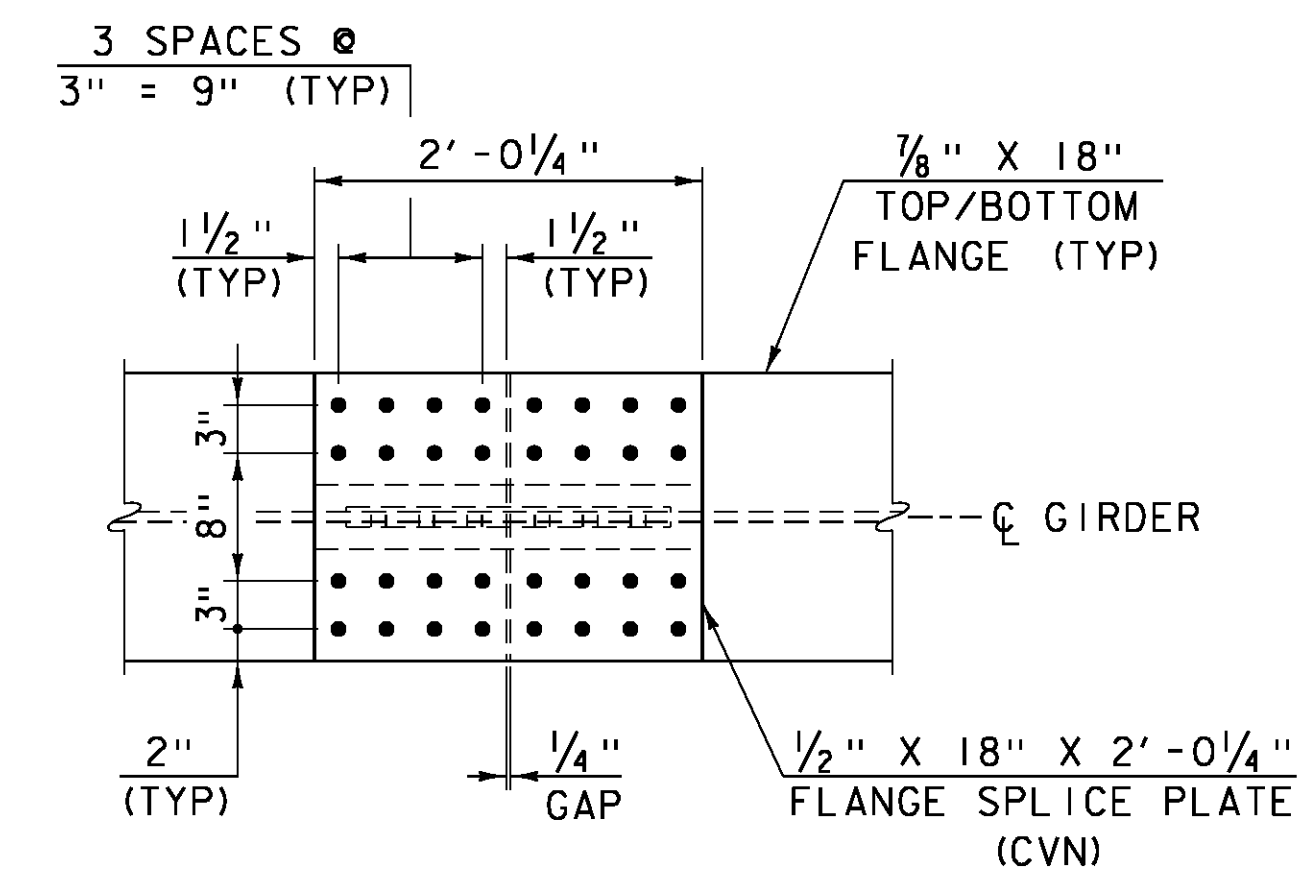

GIRDERS 3-5 TOP/BOTTOM FLANGE PLAN

SCALE: 1" = 1'-0"

NOTES:

CVN - SHALL MEET CHARPY V-NOTCH REQUIREMENTS FOR MAIN MEMBERS AS INDICATED IN SECTION 714.


ALL STEEL SHALL BE AASHTO M 270M/M 270, GRADE 50W.

PROJECT NAME: ROYALTON  
PROJECT NUMBER: BRS 0147 (13)

FILE NAME: \BR 28\86e055sup_28.dgn  
PROJECT LEADER: C. CARLSON  
DESIGNED BY: D. PETERSON  
BRIDGE 28 GIRDER SPLICE DETAILS


PLOT DATE: 08-OCT-2013  
DRAWN BY: G. ROY  
CHECKED BY: D. PETERSON  
SHEET 112 OF 186



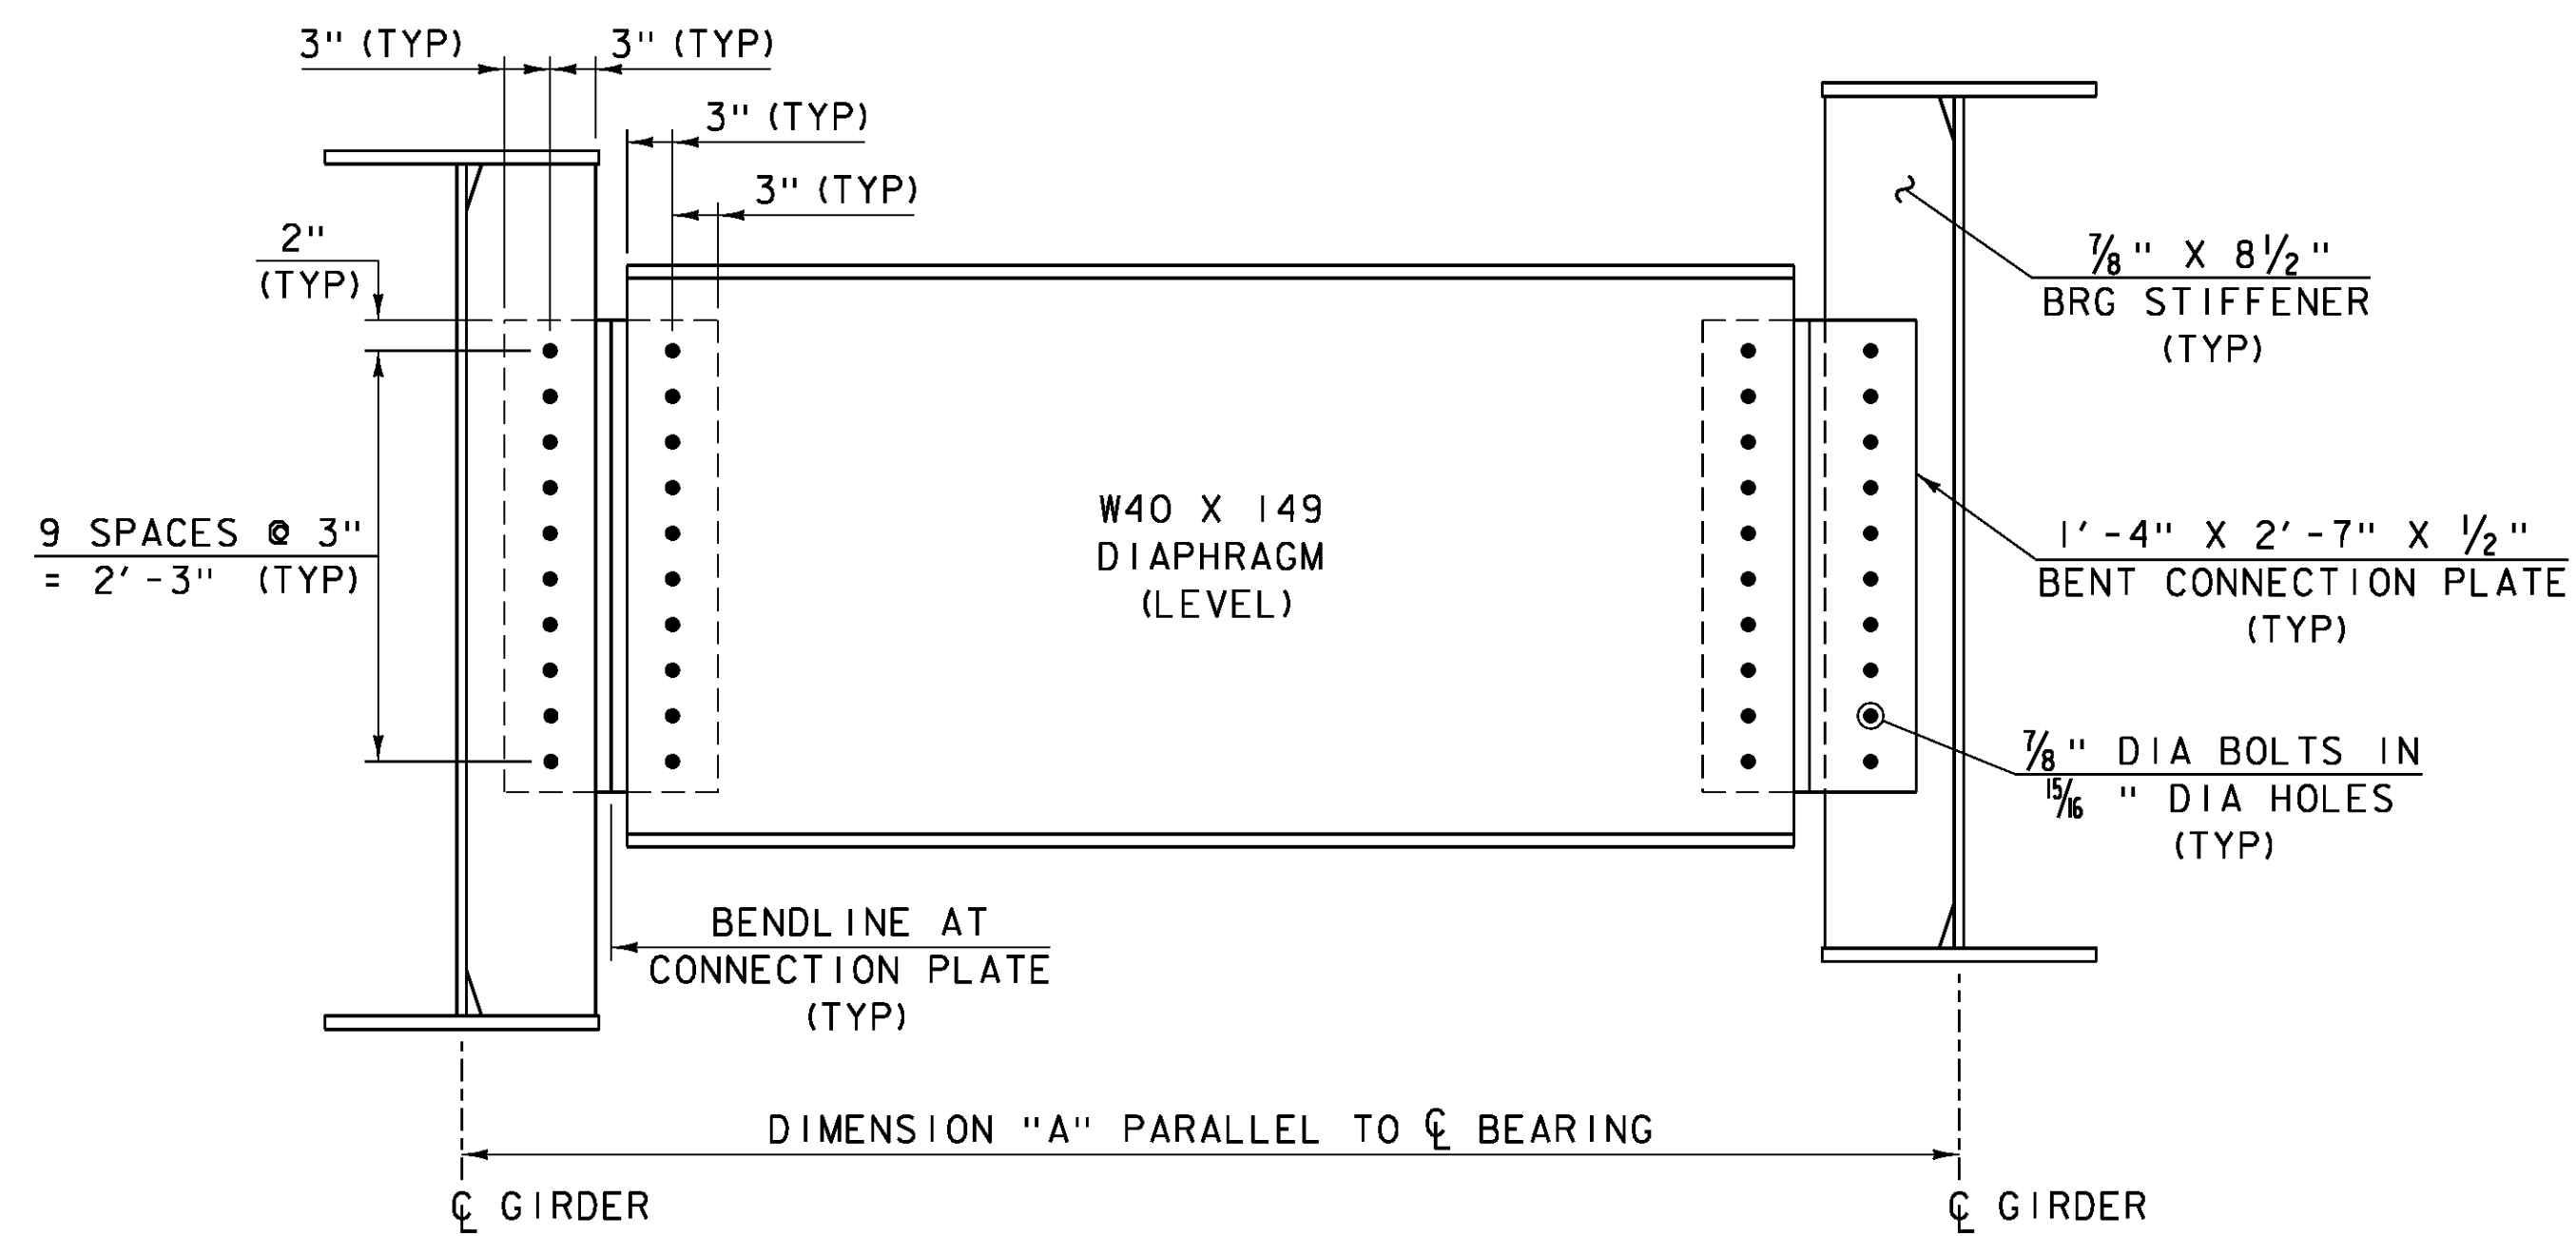


**ABUTMENT NO. 1 CROSSFRAME**

(LOOKING DOWNSTATION)  
SCALE: 1" = 1'-0"

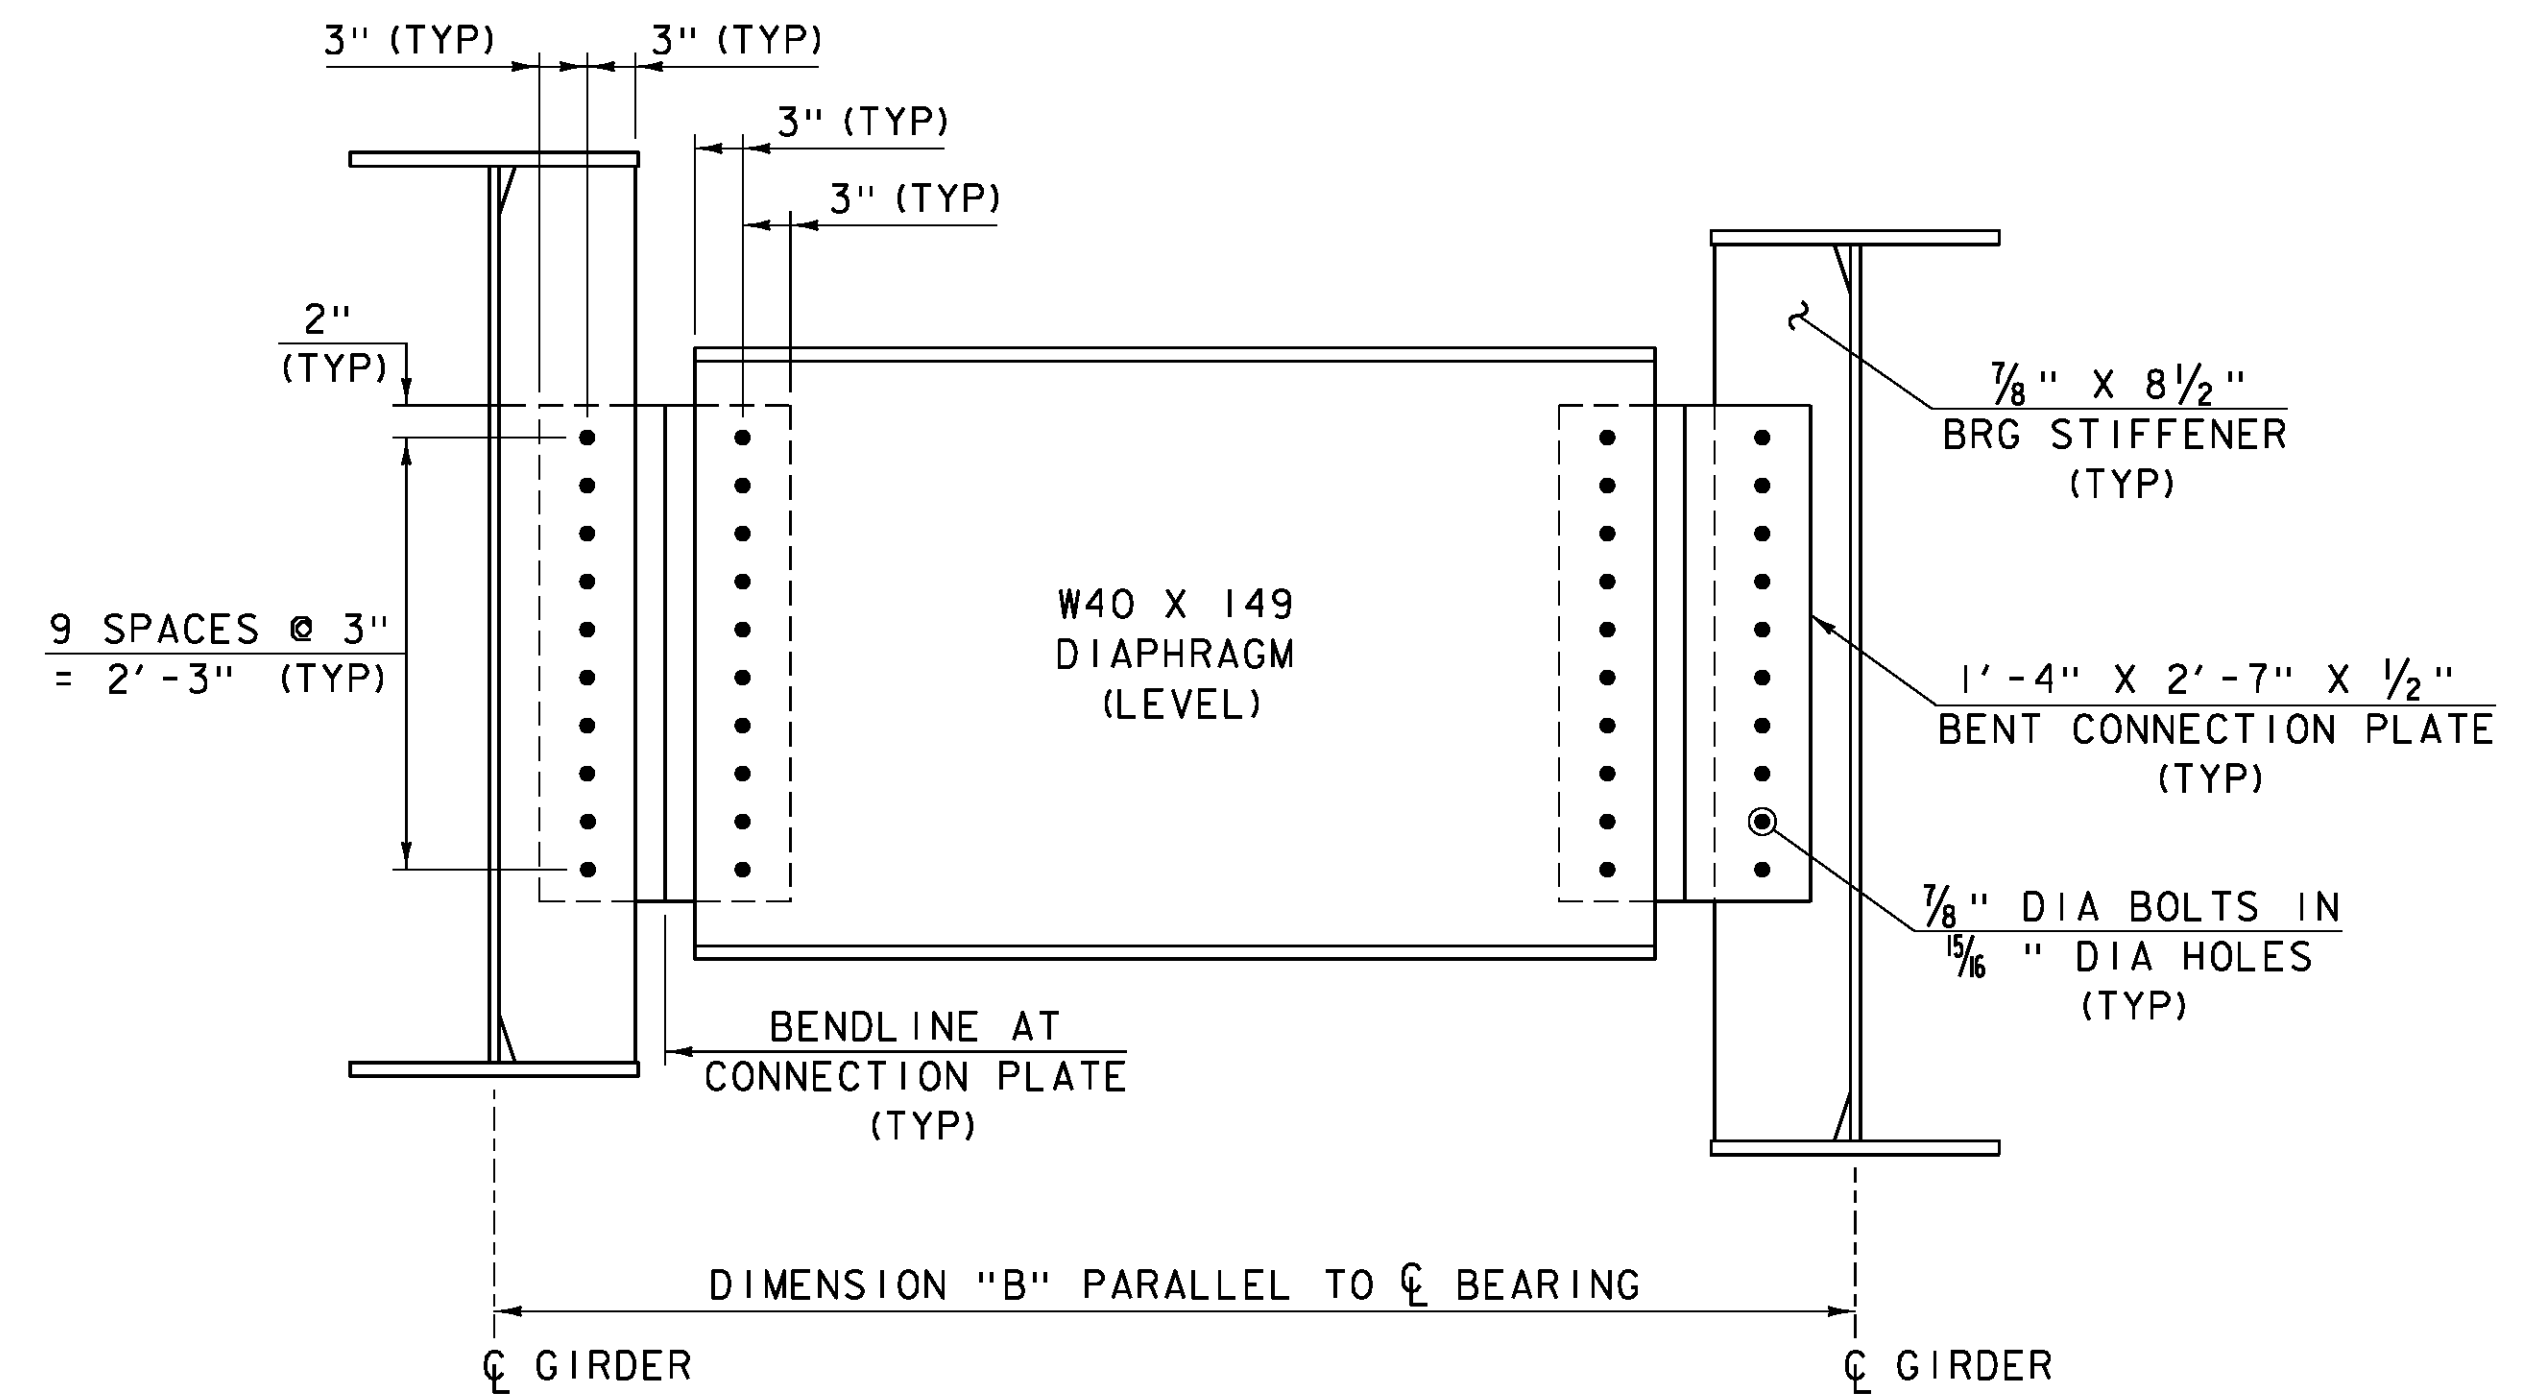


**ABUTMENT NO. 2 CROSSFRAME**

(LOOKING UPSTATION)  
SCALE: 1" = 1'-0"

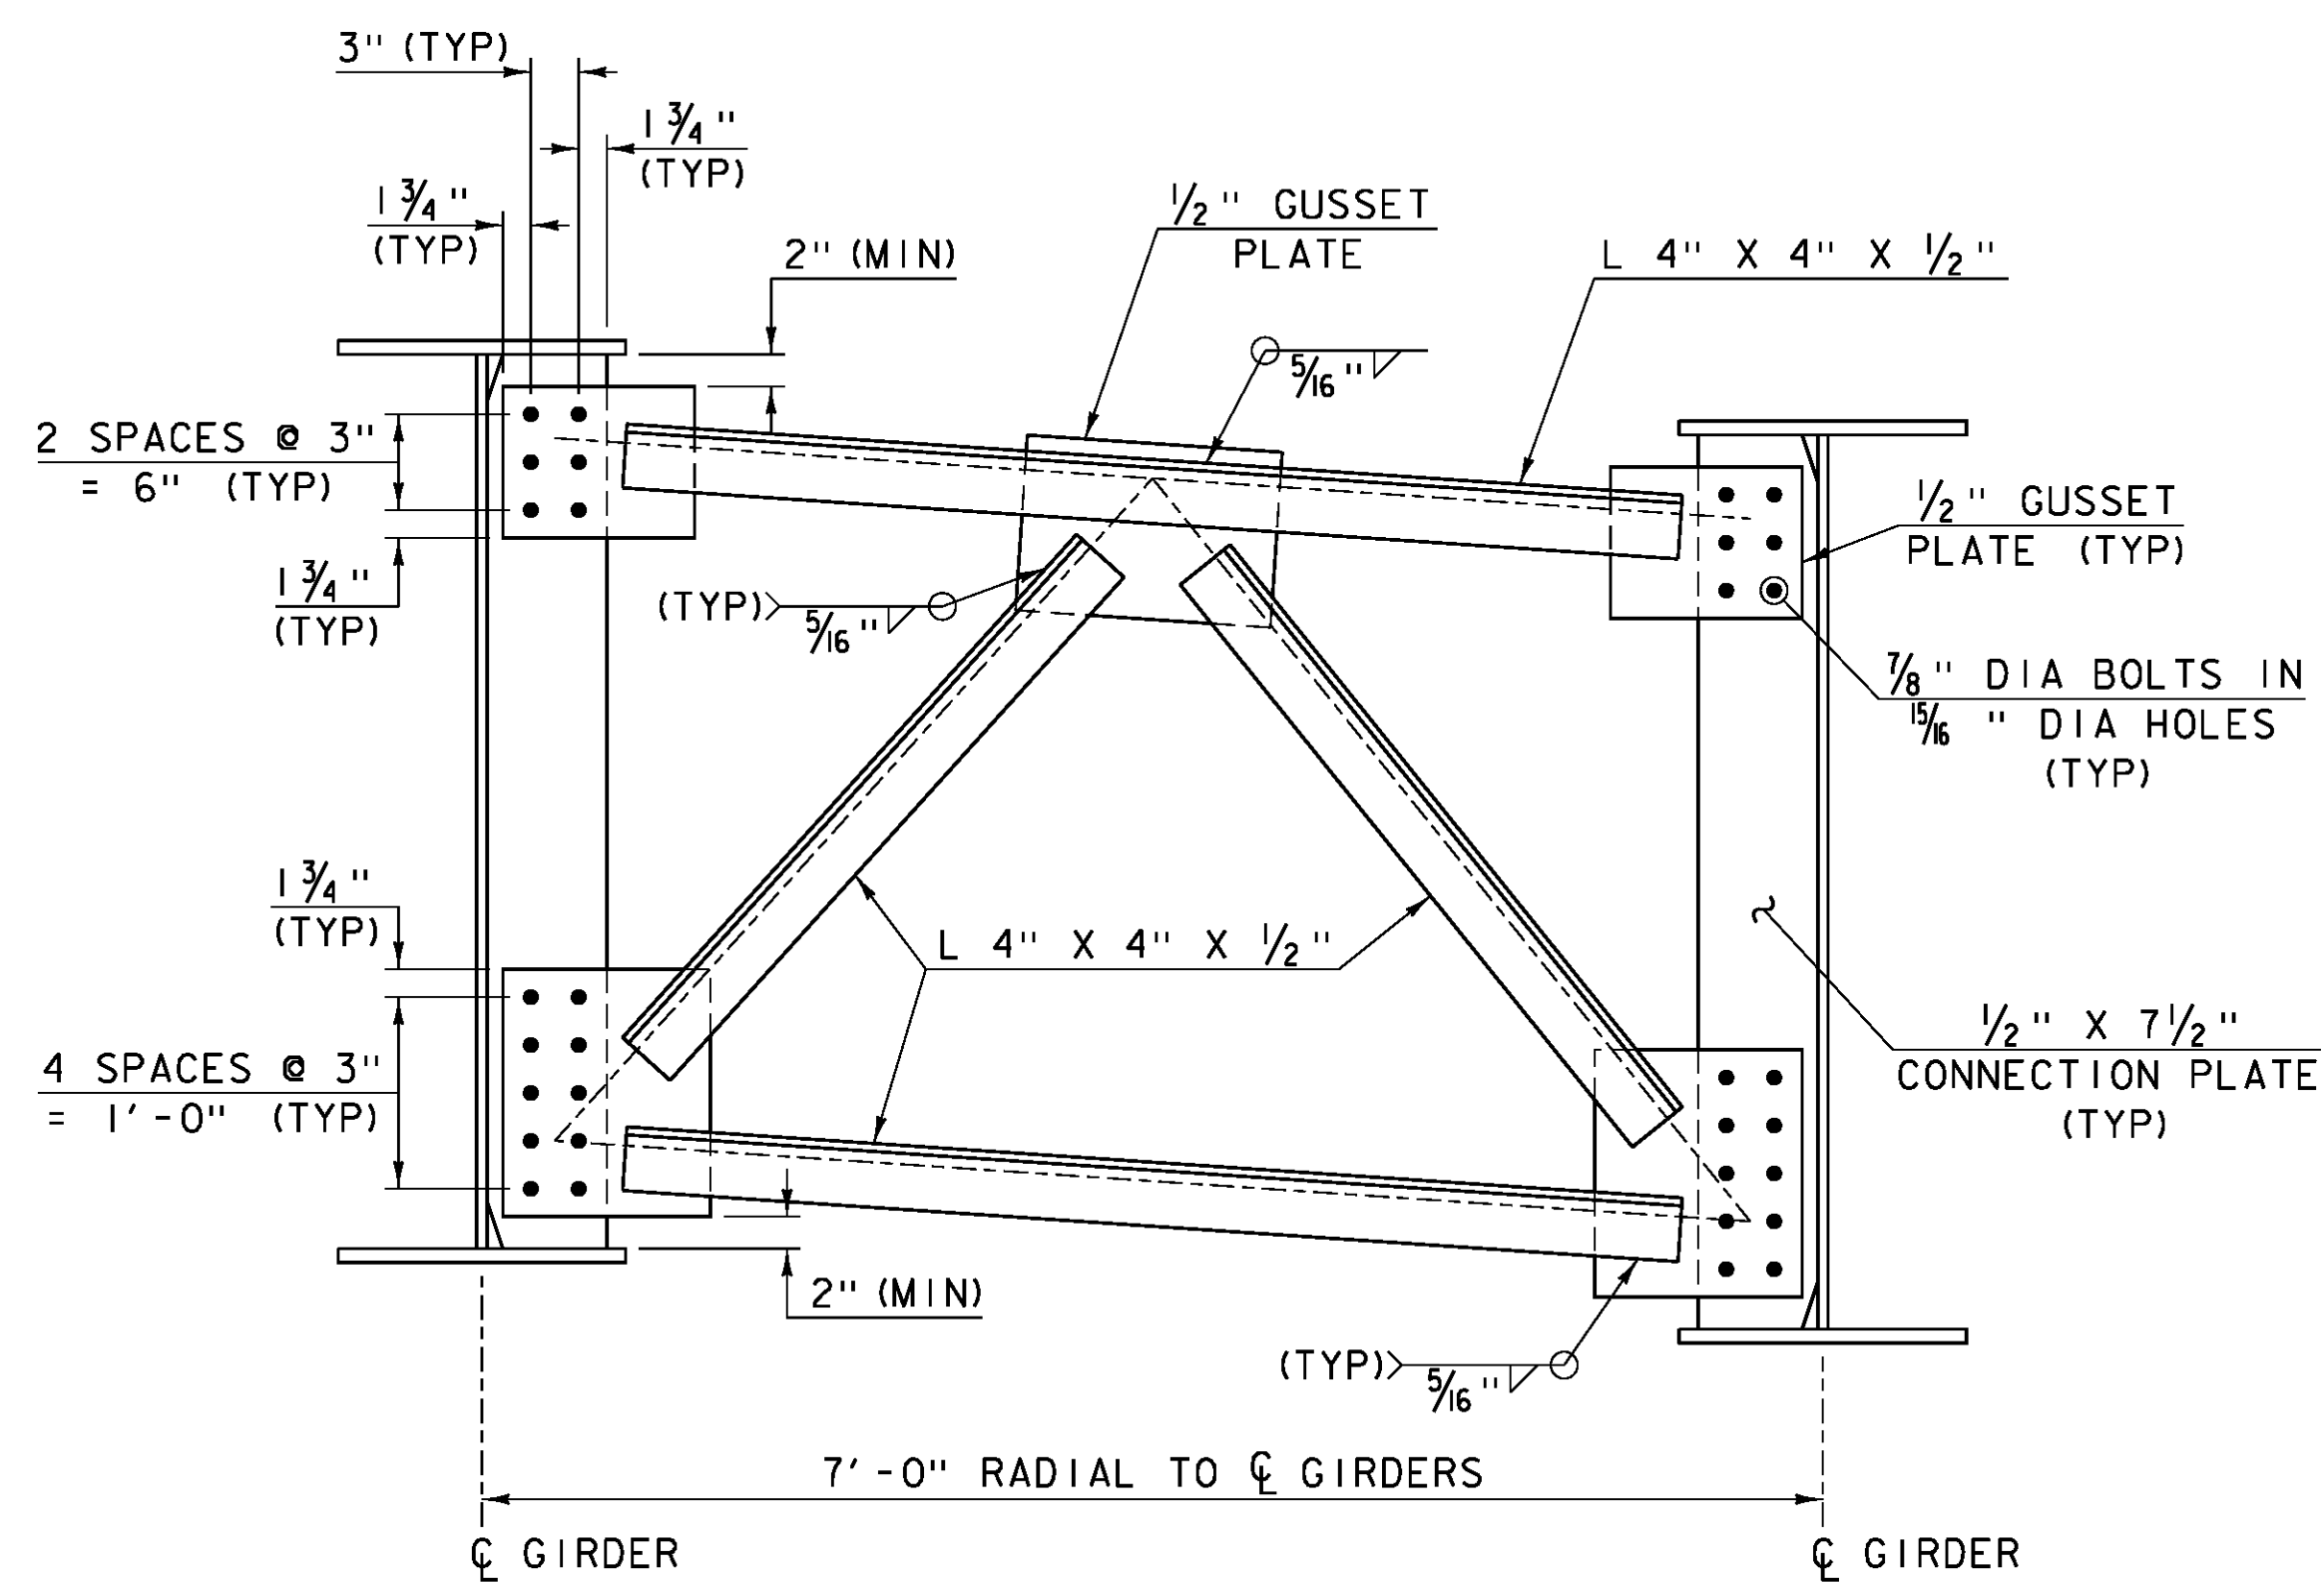

**INTERMEDIATE CROSSFRAME**

(LOOKING UPSTATION)  
SCALE: 1" = 1'-0"

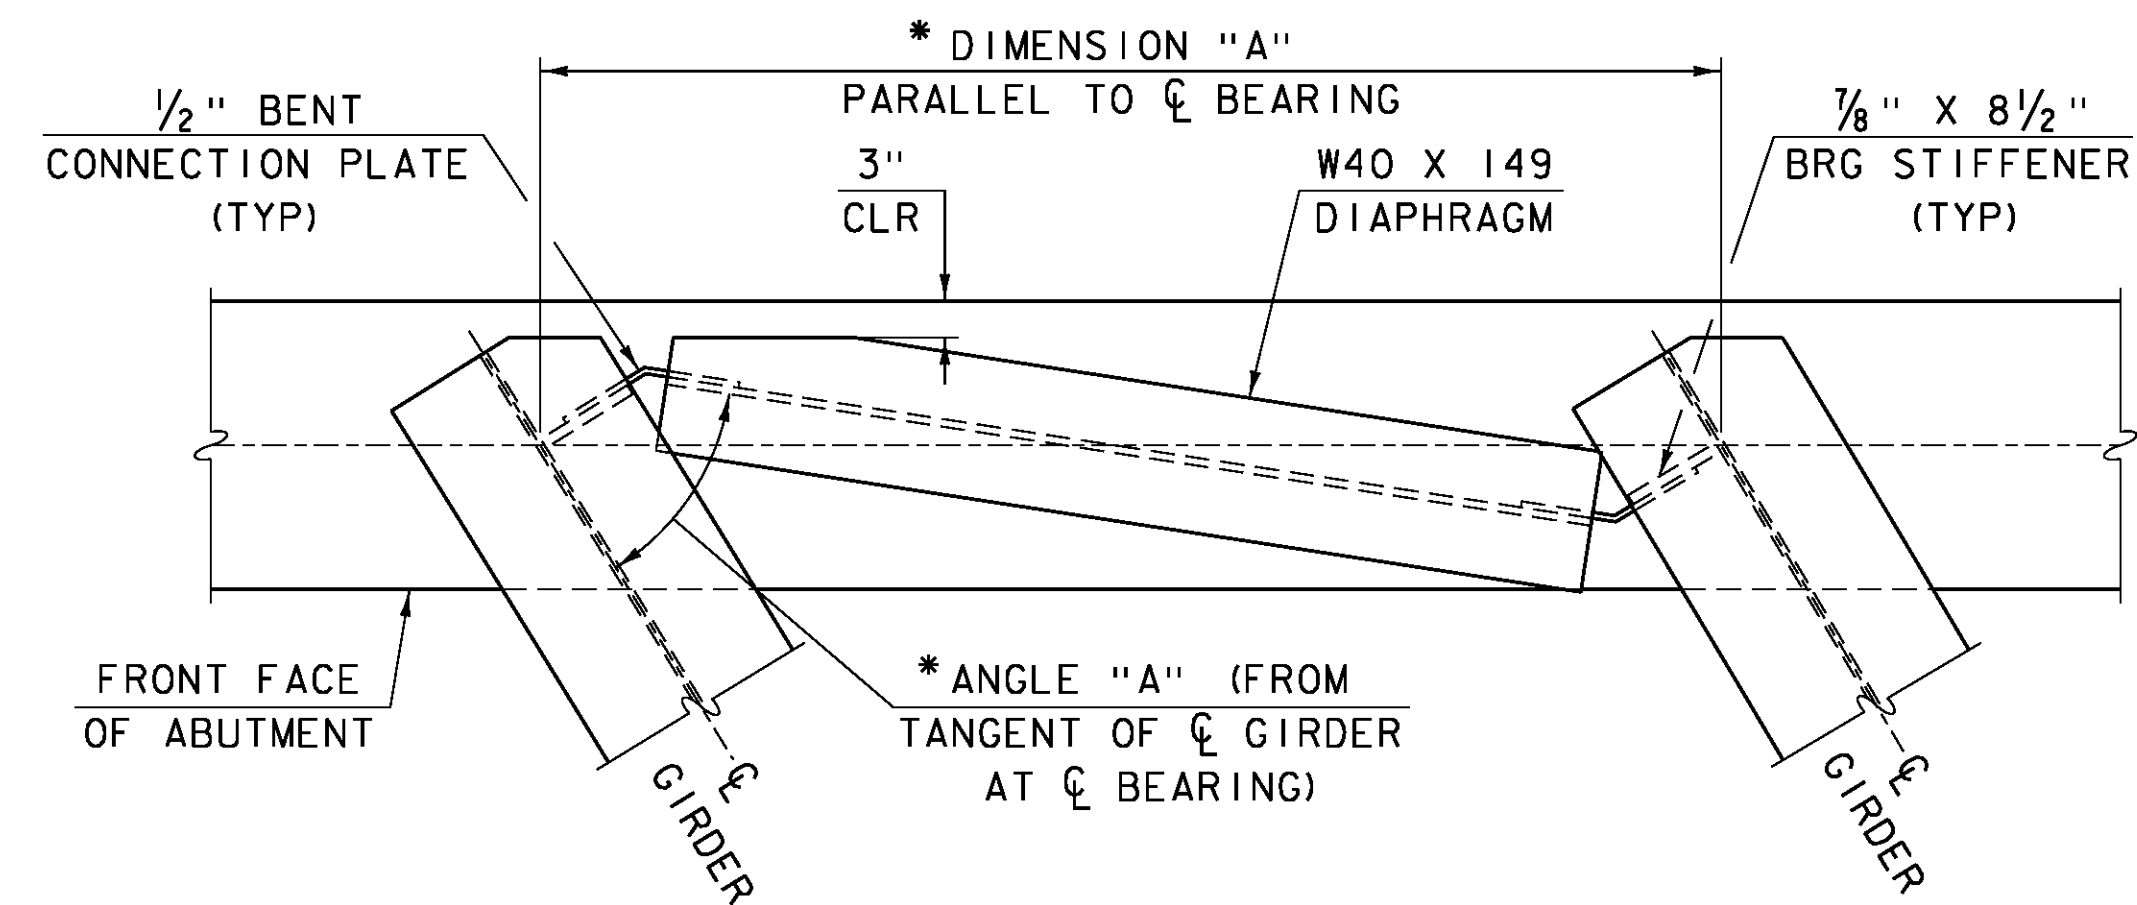

**PLAN VIEW ABUTMENT NO. 1 CROSSFRAME**

SCALE: 3/4" = 1'-0"  
(ABUTMENT NO. 2 SIMILAR)

* DIMENSION "B" & ANGLE "B" FOR ABUTMENT NO. 2

**CROSSFRAME TABLE**

GIRDERS	DIMENSION "A"	ANGLE "A"	DIMENSION "B"	ANGLE "B"
1 - 2	8' - 0 7/8"	51° 11' 42"	7' - 1"	77° 15' 45"
2 - 3	8' - 1 5/8"	50° 22' 15"	7' - 1"	77° 00' 41"
3 - 4	8' - 2 7/16"	49° 30' 30"	7' - 1 1/16"	76° 44' 44"
4 - 5	8' - 3 5/16"	48° 49' 52"	7' - 1 1/8"	76° 28' 19"


**NOTES:**

SEE SD-602.00 FOR WELD TERMINATION AND COPING DETAILS.

SEE SD-602.00 FOR WELD LOCATION DETAIL AT CROSSFRAMES.

PROJECT NAME: ROYALTON  
PROJECT NUMBER: BRS 0147 (13)

FILE NAME: \BR 28\86e055sup_28.dgn PLOT DATE: 08-OCT-2013  
PROJECT LEADER: C. CARLSON DRAWN BY: G. ROY  
DESIGNED BY: D. PETERSON CHECKED BY: D. PETERSON  
BRIDGE 28 CROSSFRAME DETAILS SHEET 113 OF 186

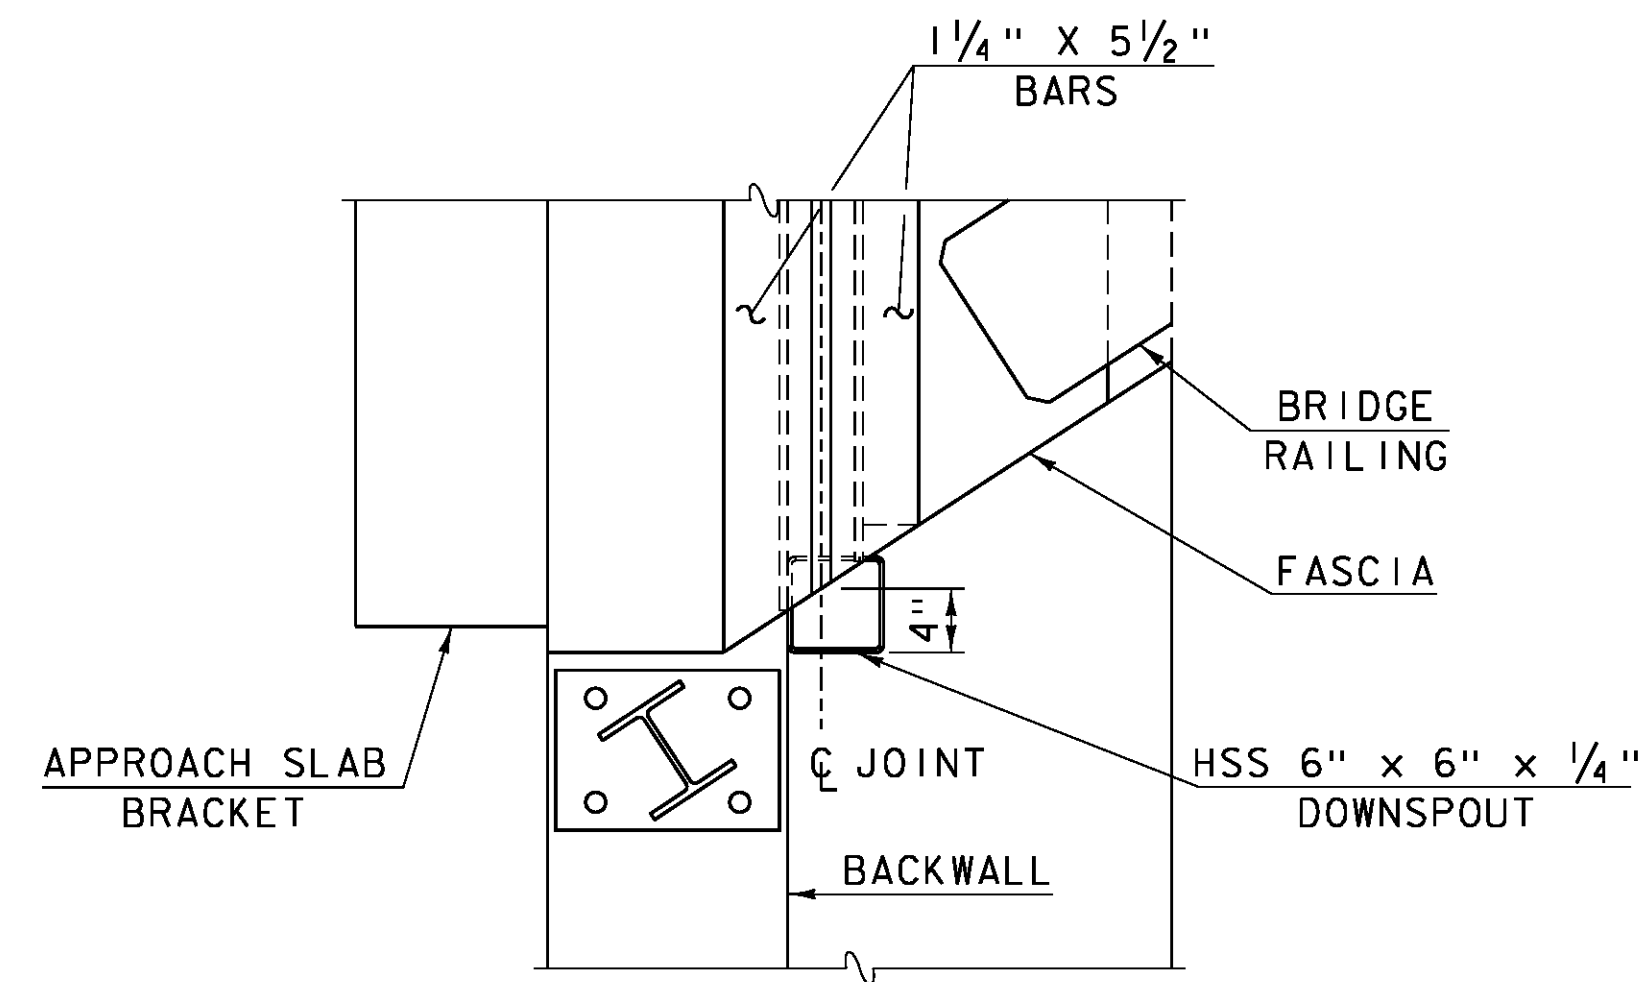


**DOWNSPOUT PLAN**

SCALE: 1" = 1'-0"


**DOWNSPOUT NOTES**

1. HOLLOW STRUCTURAL STEEL TUBING SHALL CONFORM TO SECTION 506.02 OF THE STANDARD SPECIFICATIONS.
2. ALL PLATES, BARS, AND ANGLES SHALL CONFORM TO SECTION 714.02 OF THE STANDARD SPECIFICATIONS.
3. DOWNSPOUT SHALL BE GALVANIZED IN ACCORDANCE WITH 726.08 OF THE STANDARD SPECIFICATIONS AFTER FABRICATION.
4. ALL BOLTS AND RELATED HARDWARE SHALL BE ASTM A307 AND SHALL BE GALVANIZED IN ACCORDANCE WITH ASTM A153 (AASHTO M232).
5. AREAS WHERE THE GALVANIZING HAS BEEN REMOVED FROM THE DOWNSPOUTS EITHER BY CUTTING, BURNING, WELDING, PLACING, OR ANY OTHER MEANS SHALL BE REPAIRED IN CONFORMANCE WITH SECTION 726.08 OF THE STANDARD SPECIFICATIONS.
6. ALL MATERIALS AND INSTALLATION COSTS FOR THE DOWNSPOUTS, INCLUDING STEEL TUBING, RELATED HARDWARE, AND ANCHOR BOLTS SHALL BE PAID FOR UNDER ITEM 506.75 "STRUCTURAL STEEL".

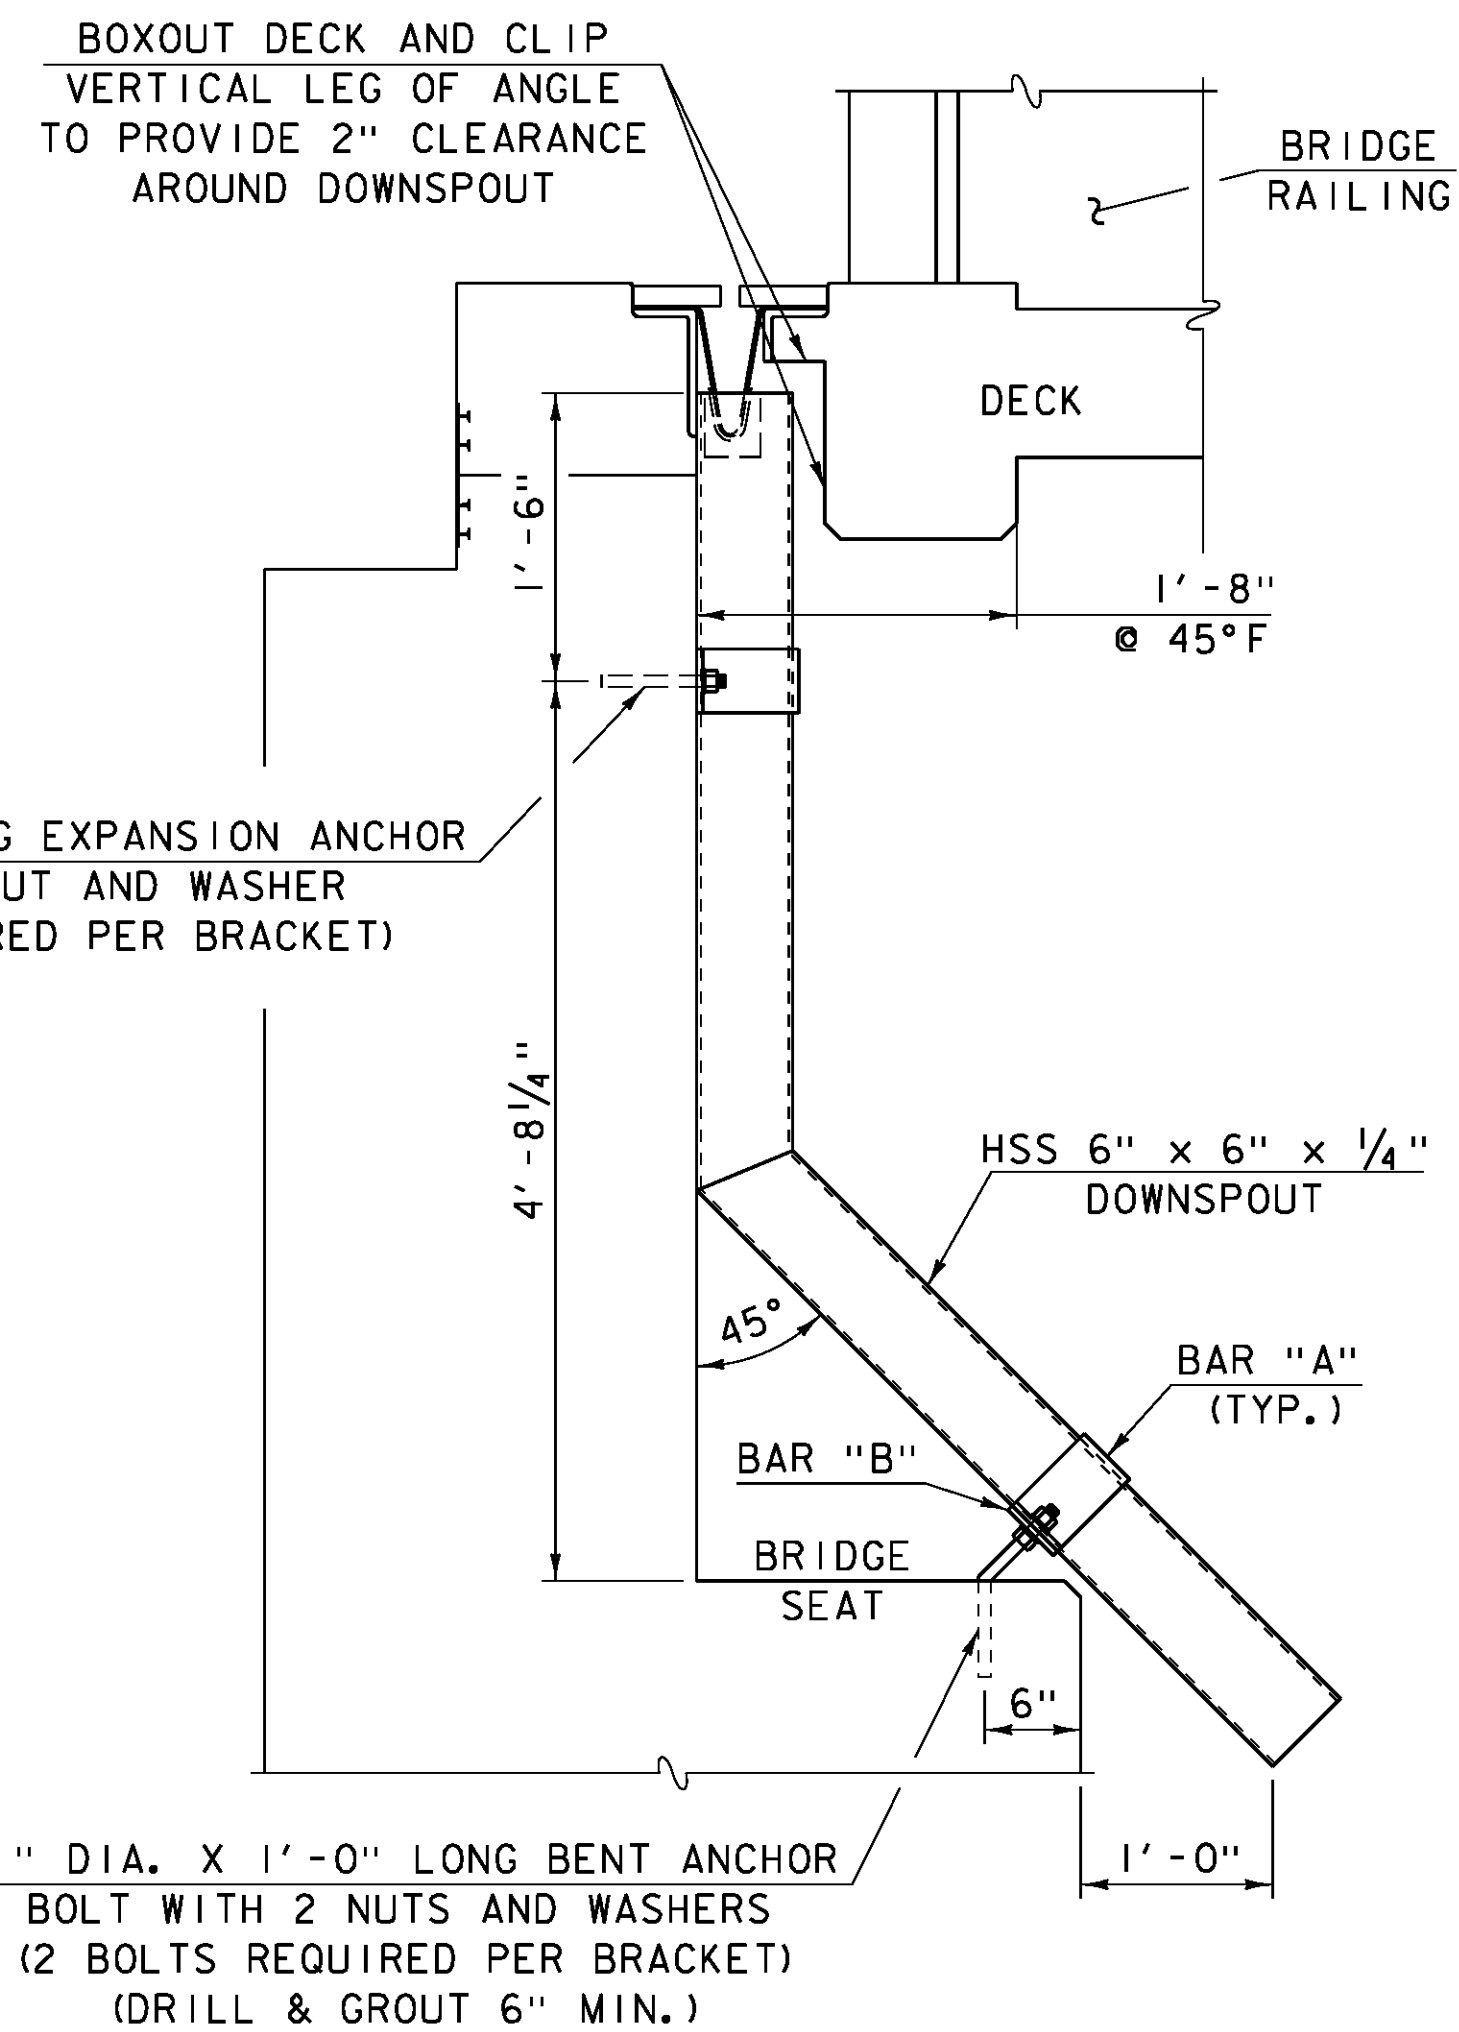


**DOWNSPOUT ELEVATION**

SCALE: 1" = 1'-0"

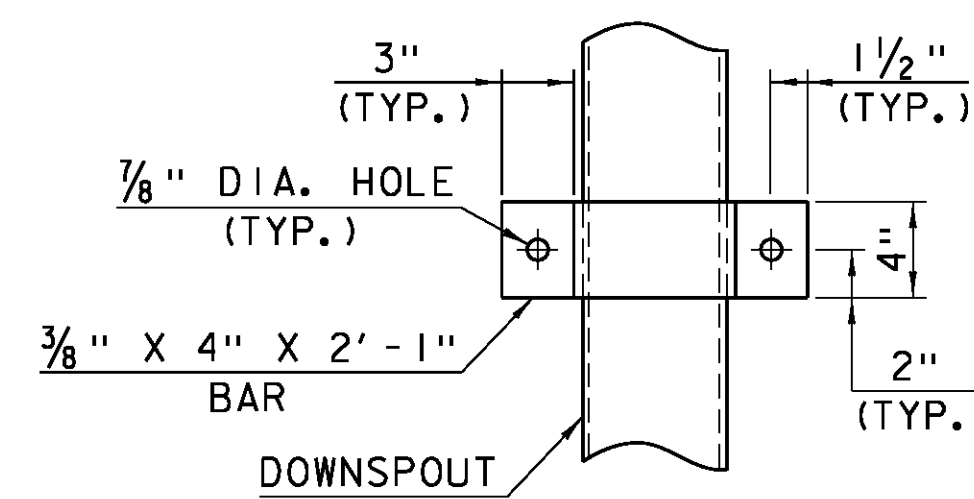


**ELEVATION VIEW BAR "A"**

SCALE: 1 1/2" = 1'-0"

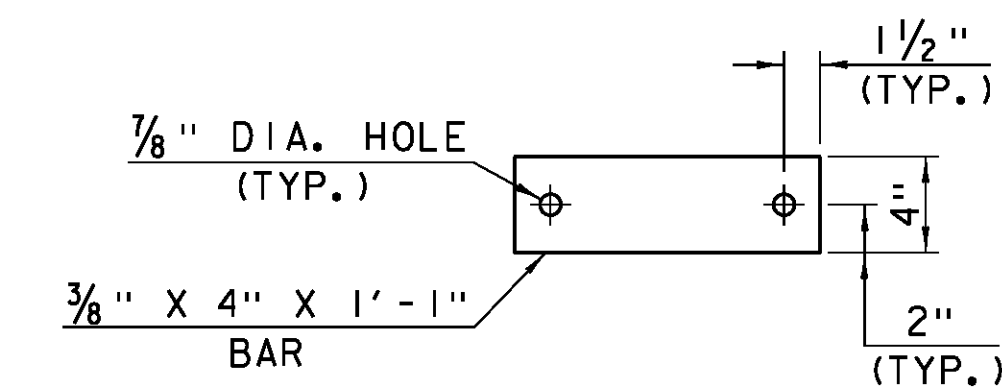

**ELEVATION VIEW BAR "B"**


SCALE: 1 1/2" = 1'-0"

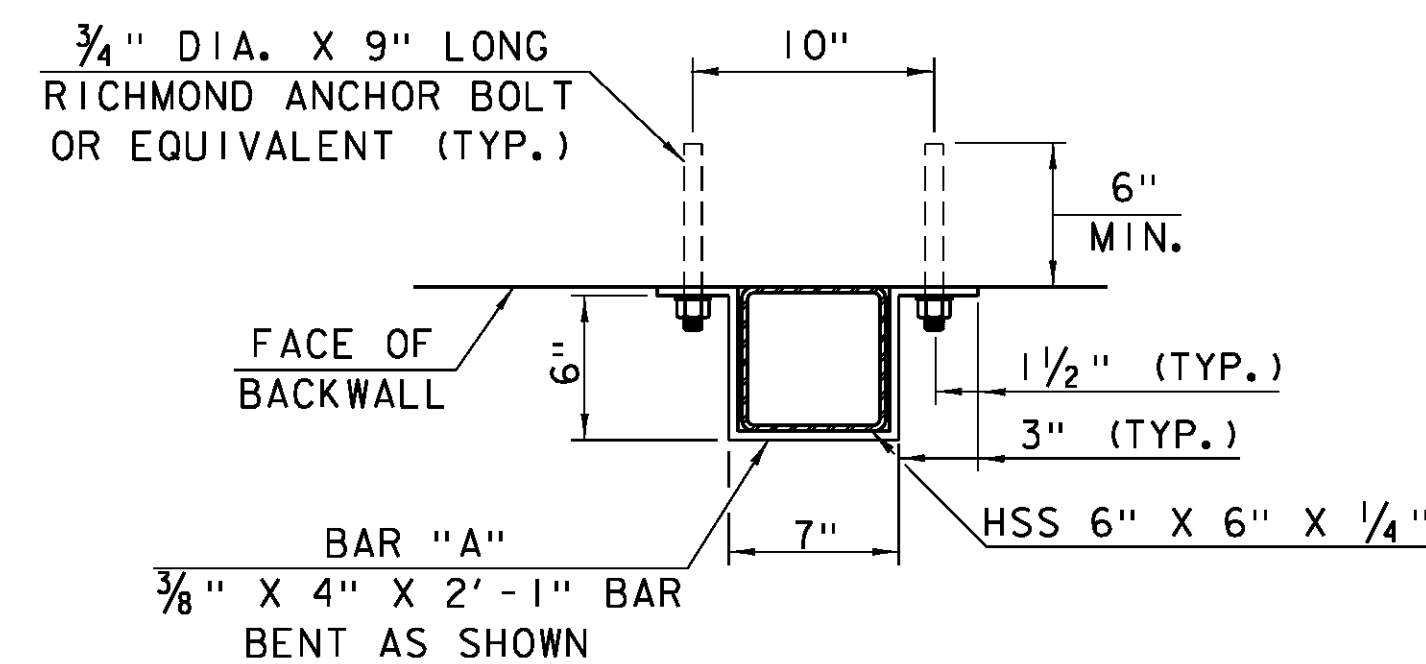

**DOWNSPOUT ATTACHMENT TO BACKWALL**

**PLAN VIEW**

SCALE: 1 1/2" = 1'-0"

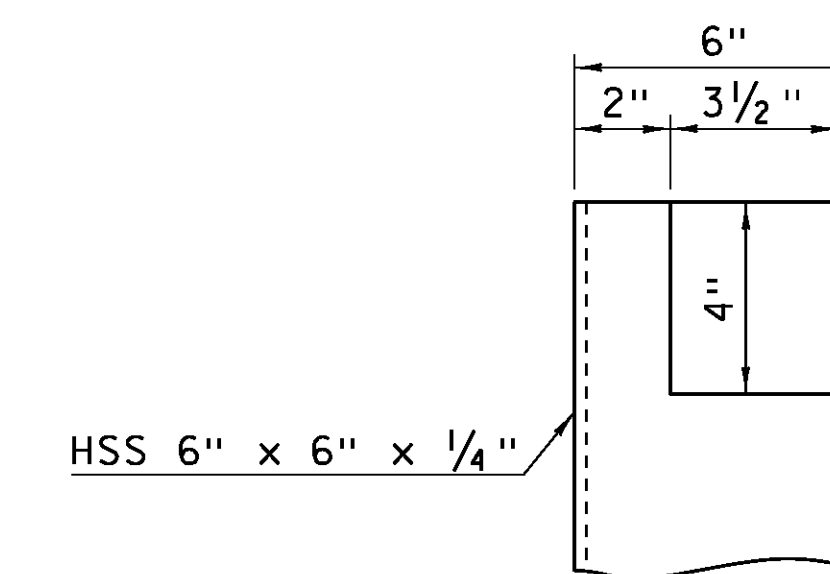


**DOWNSPOUT CUTOUT DETAIL**

SCALE: 3" = 1'-0"


PROJECT NAME: ROYALTON  
PROJECT NUMBER: BRS 0147 (13)

FILE NAME: \BR 28\s86e055sup_28.dgn PLOT DATE: 08-OCT-2013  
PROJECT LEADER: C. CARLSON DRAWN BY: G. ROY  
DESIGNED BY: D. PETERSON CHECKED BY: D. PETERSON  
BRIDGE 28 DOWNSPOUT DETAILS SHEET 114 OF 186

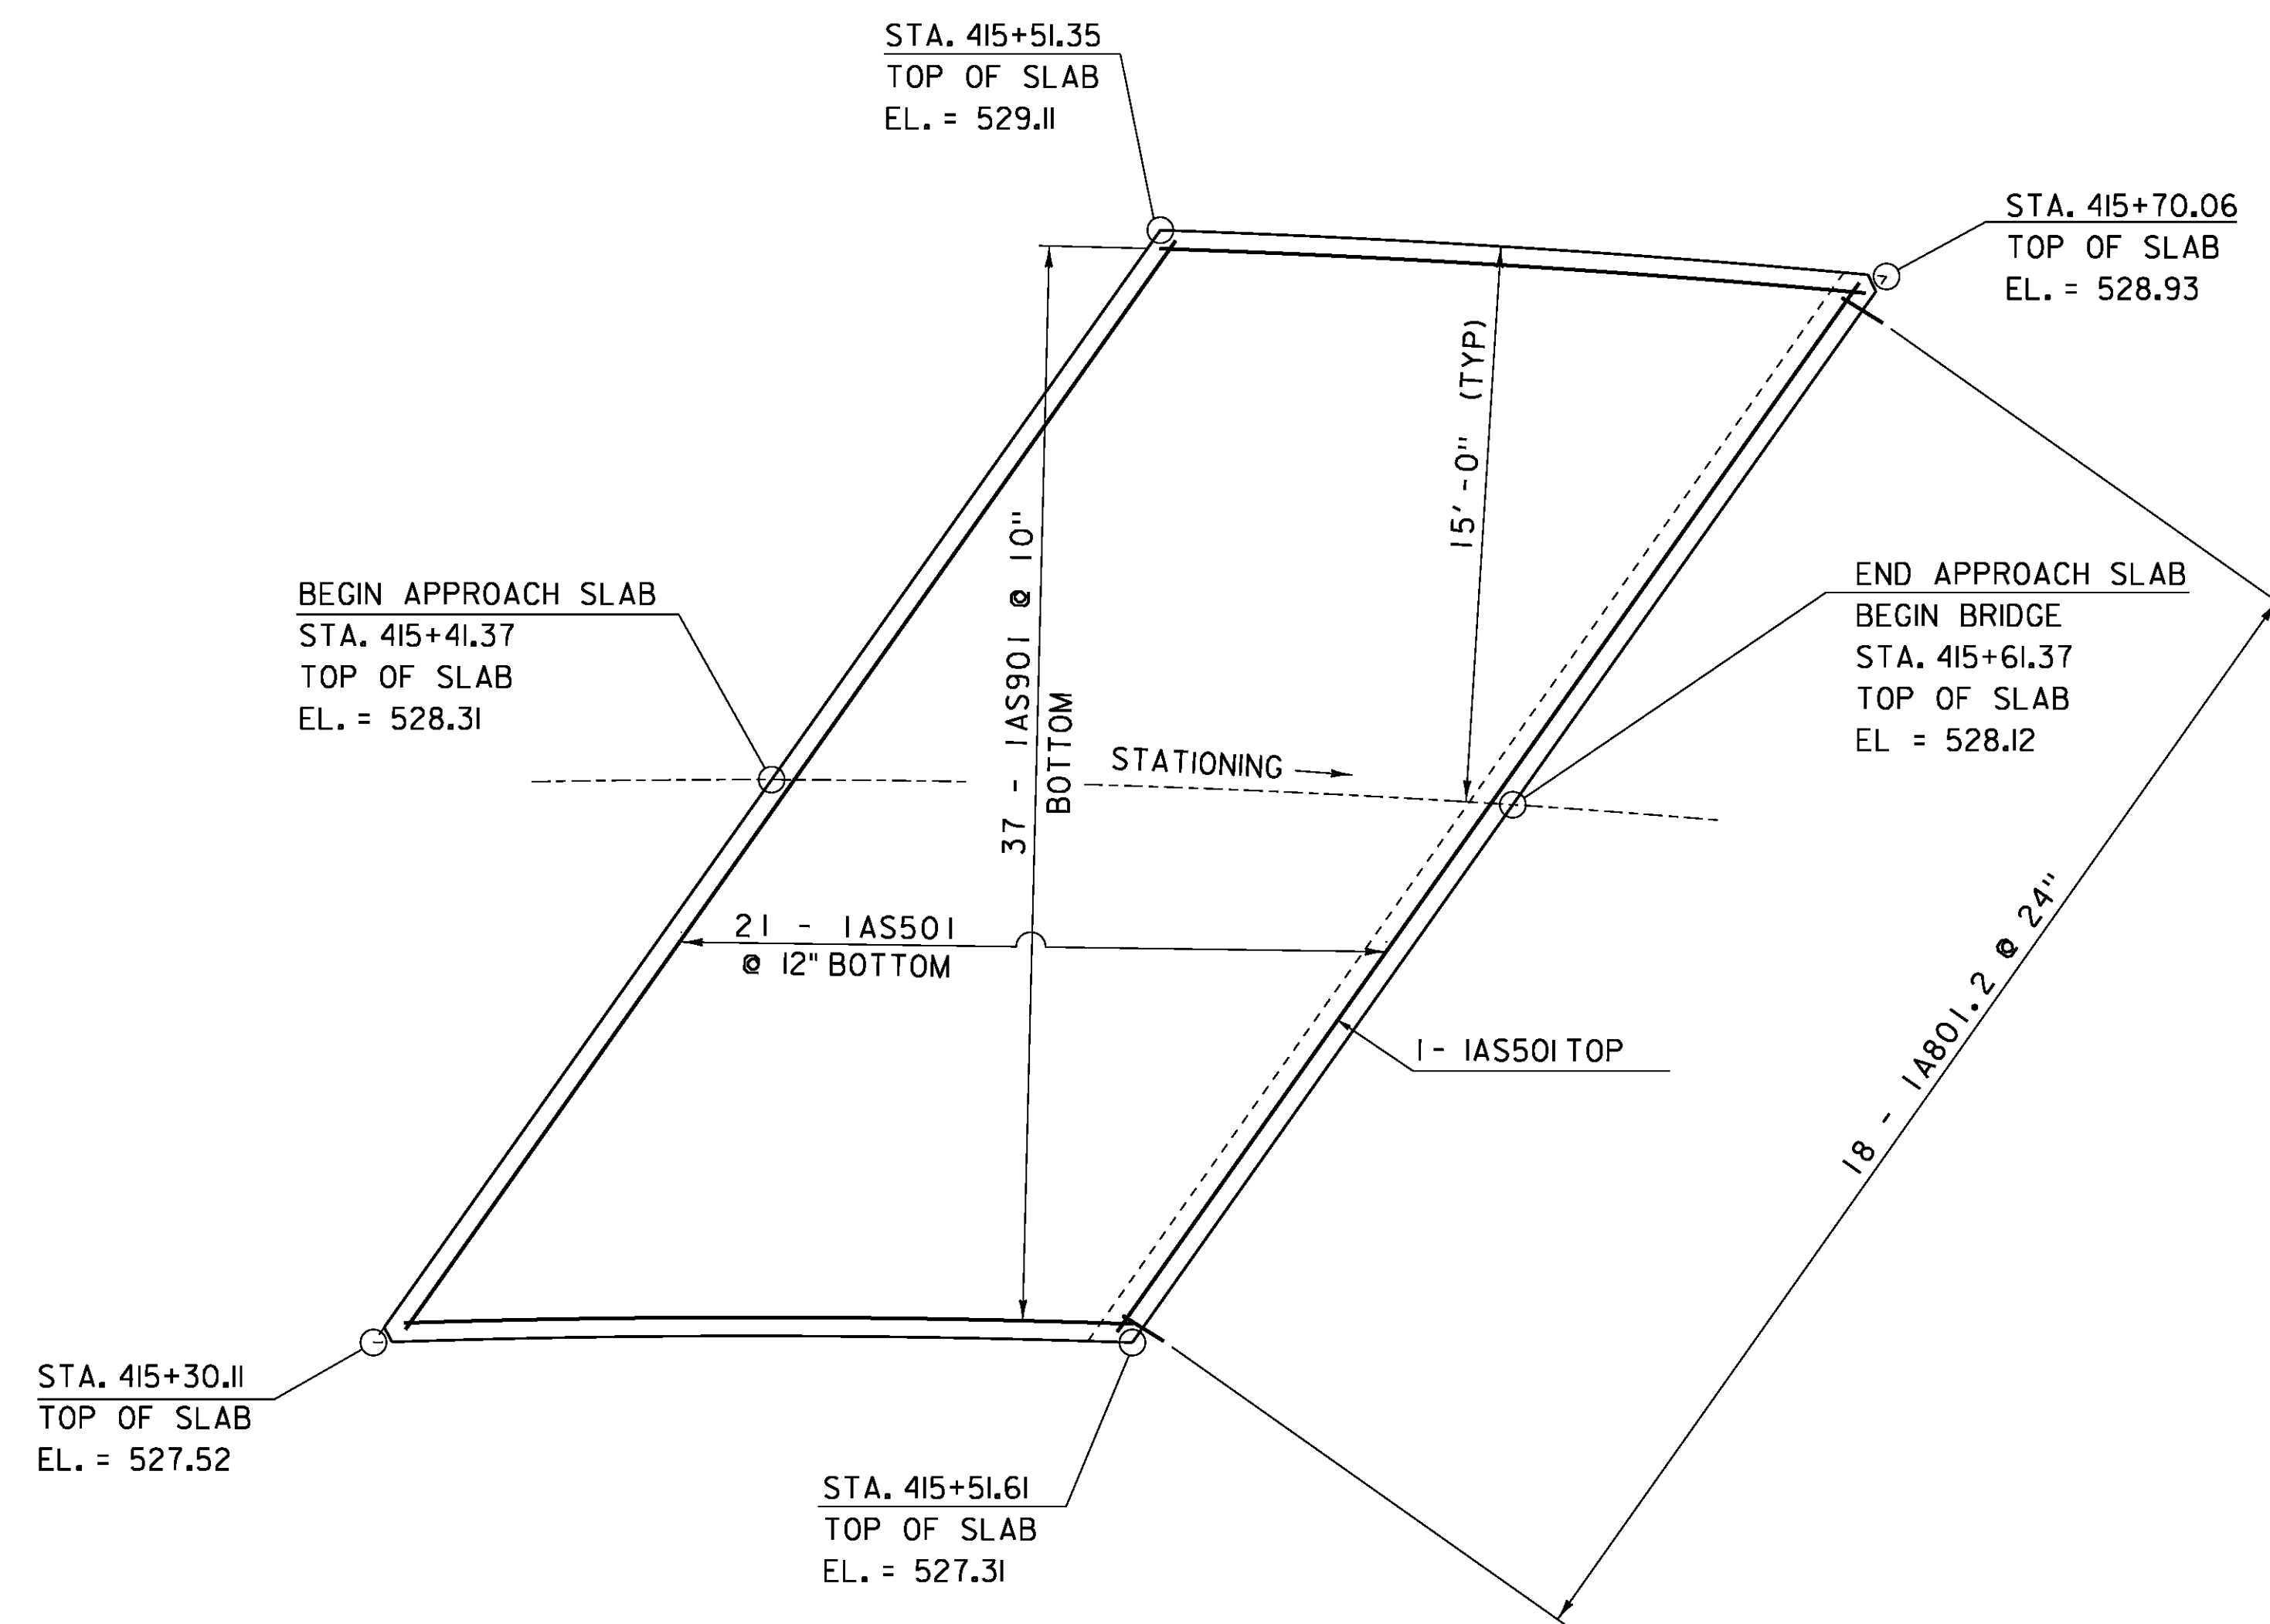


APPROACH SLAB PLAN NO. 1 TYPICAL

SCALE 1/4" = 1'-0"

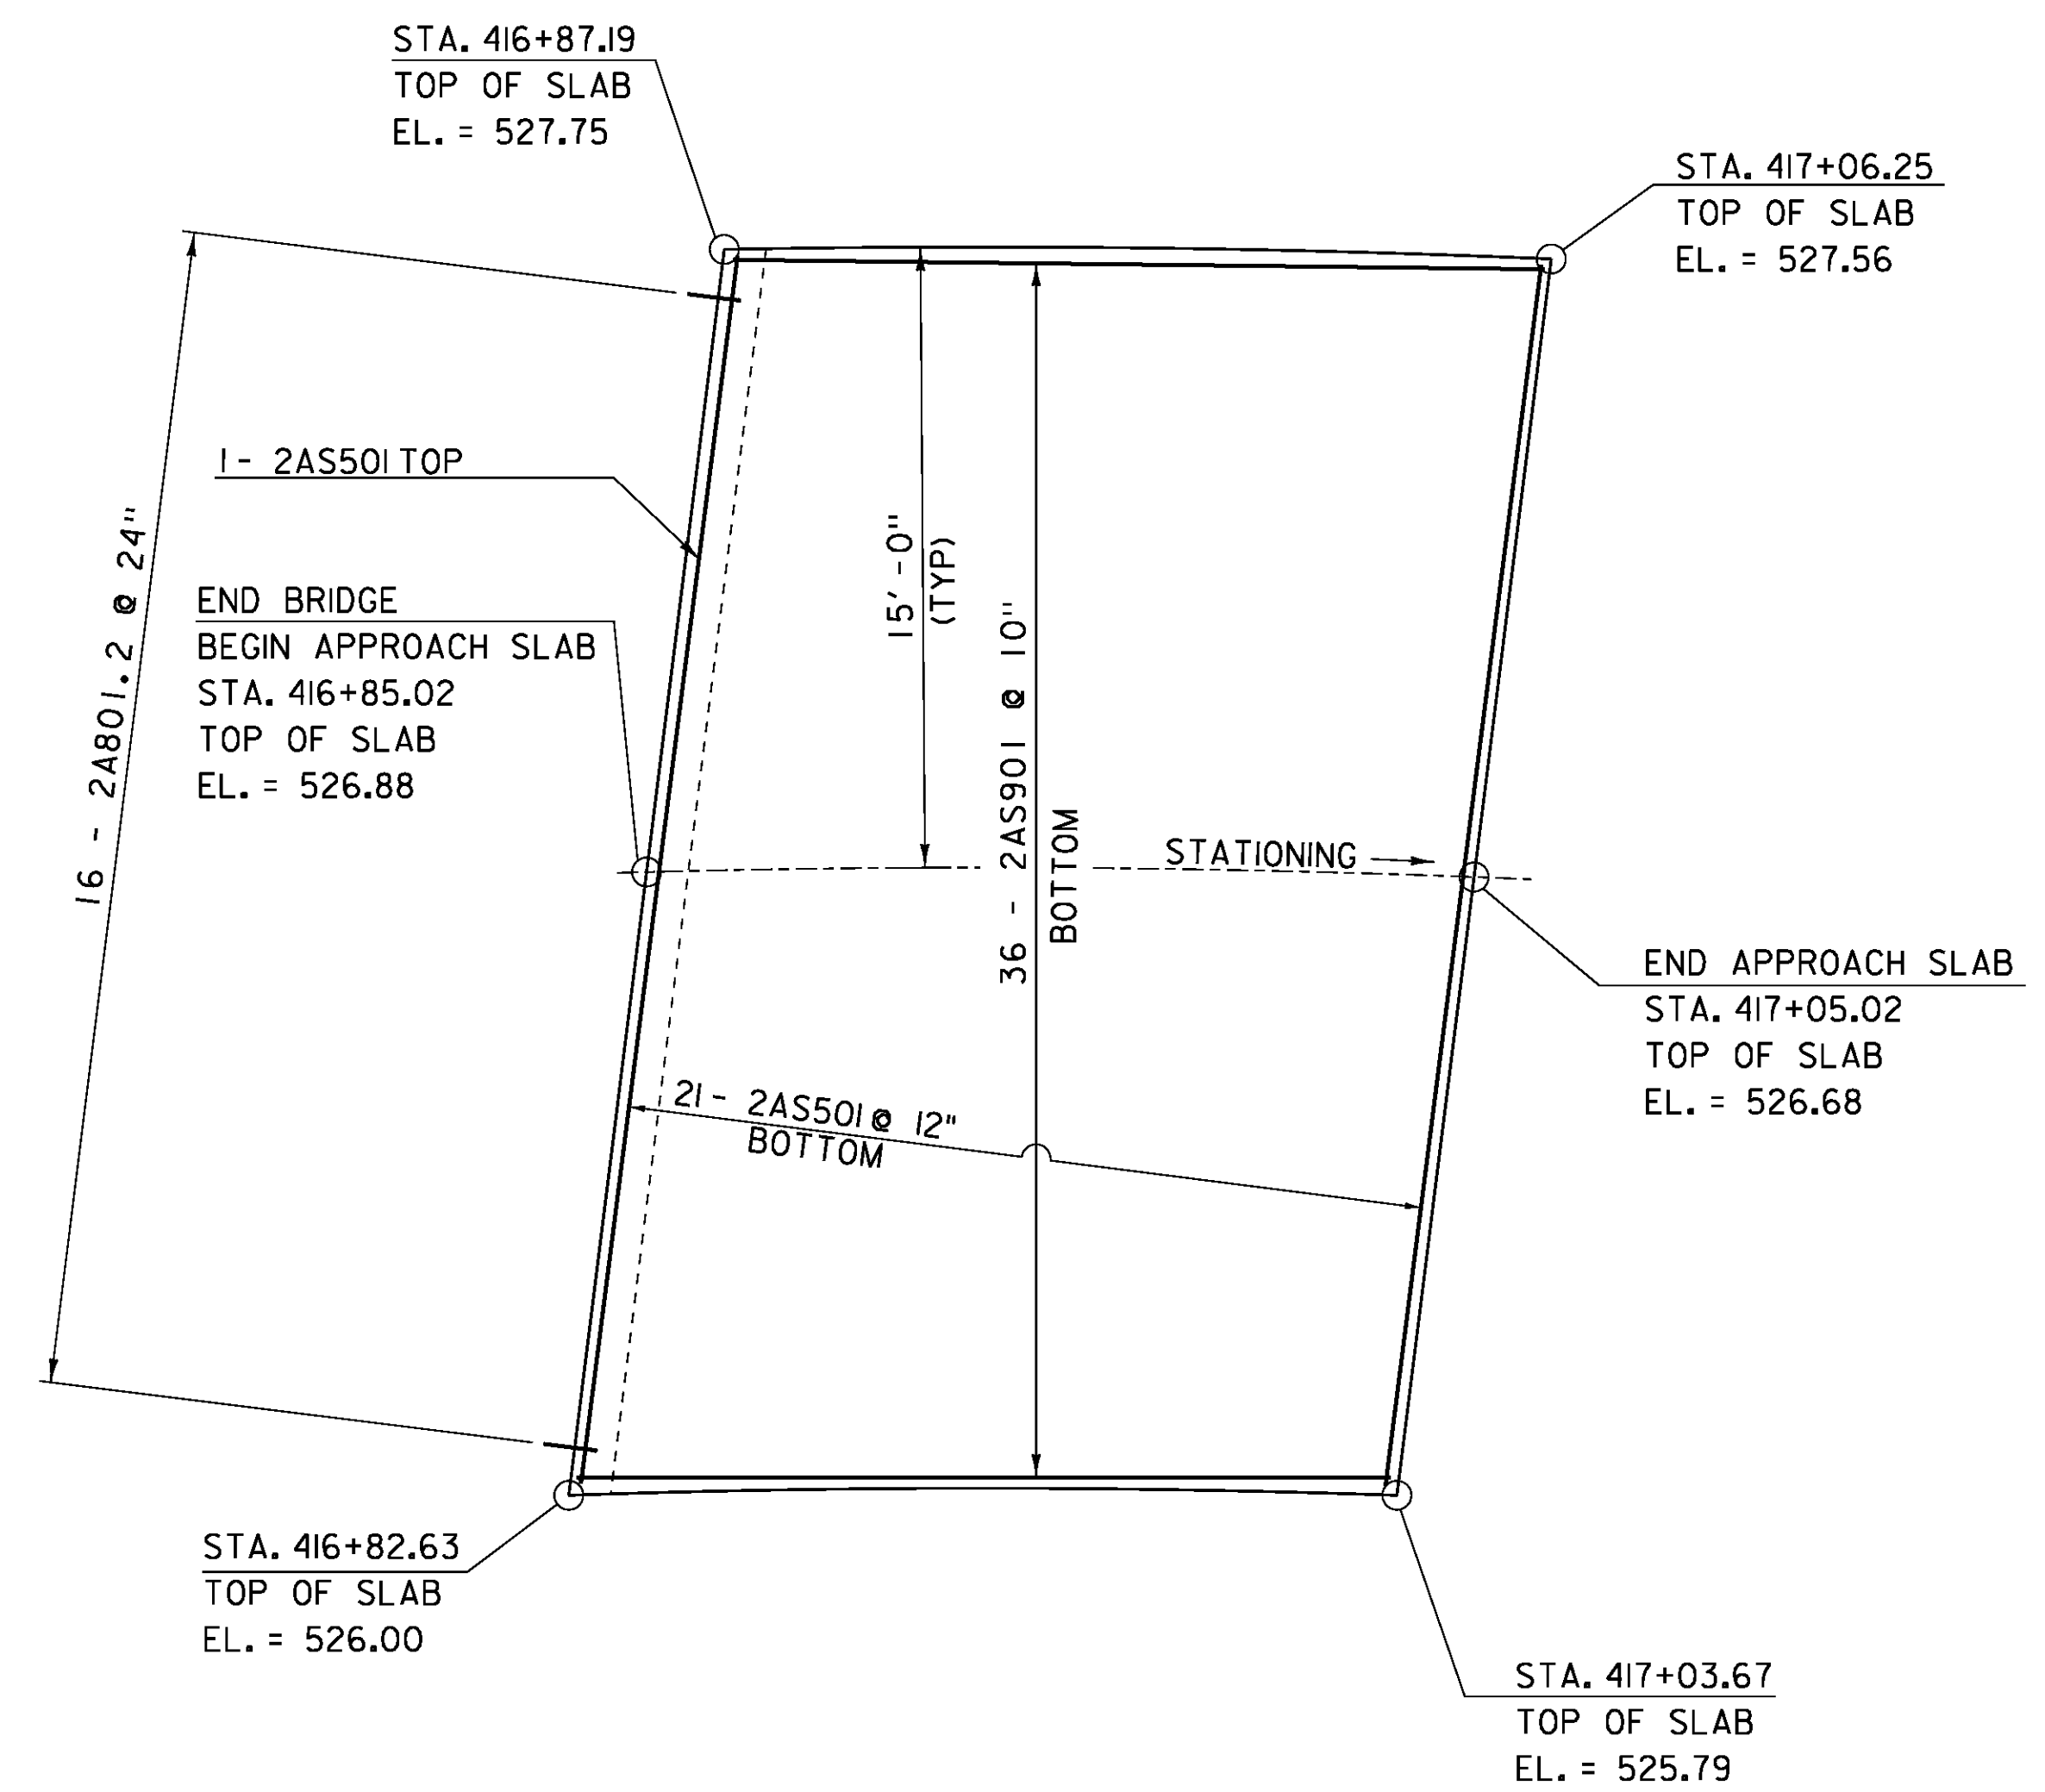


APPROACH SLAB PLAN NO. 2 TYPICAL

SCALE 1/4" = 1'-0"

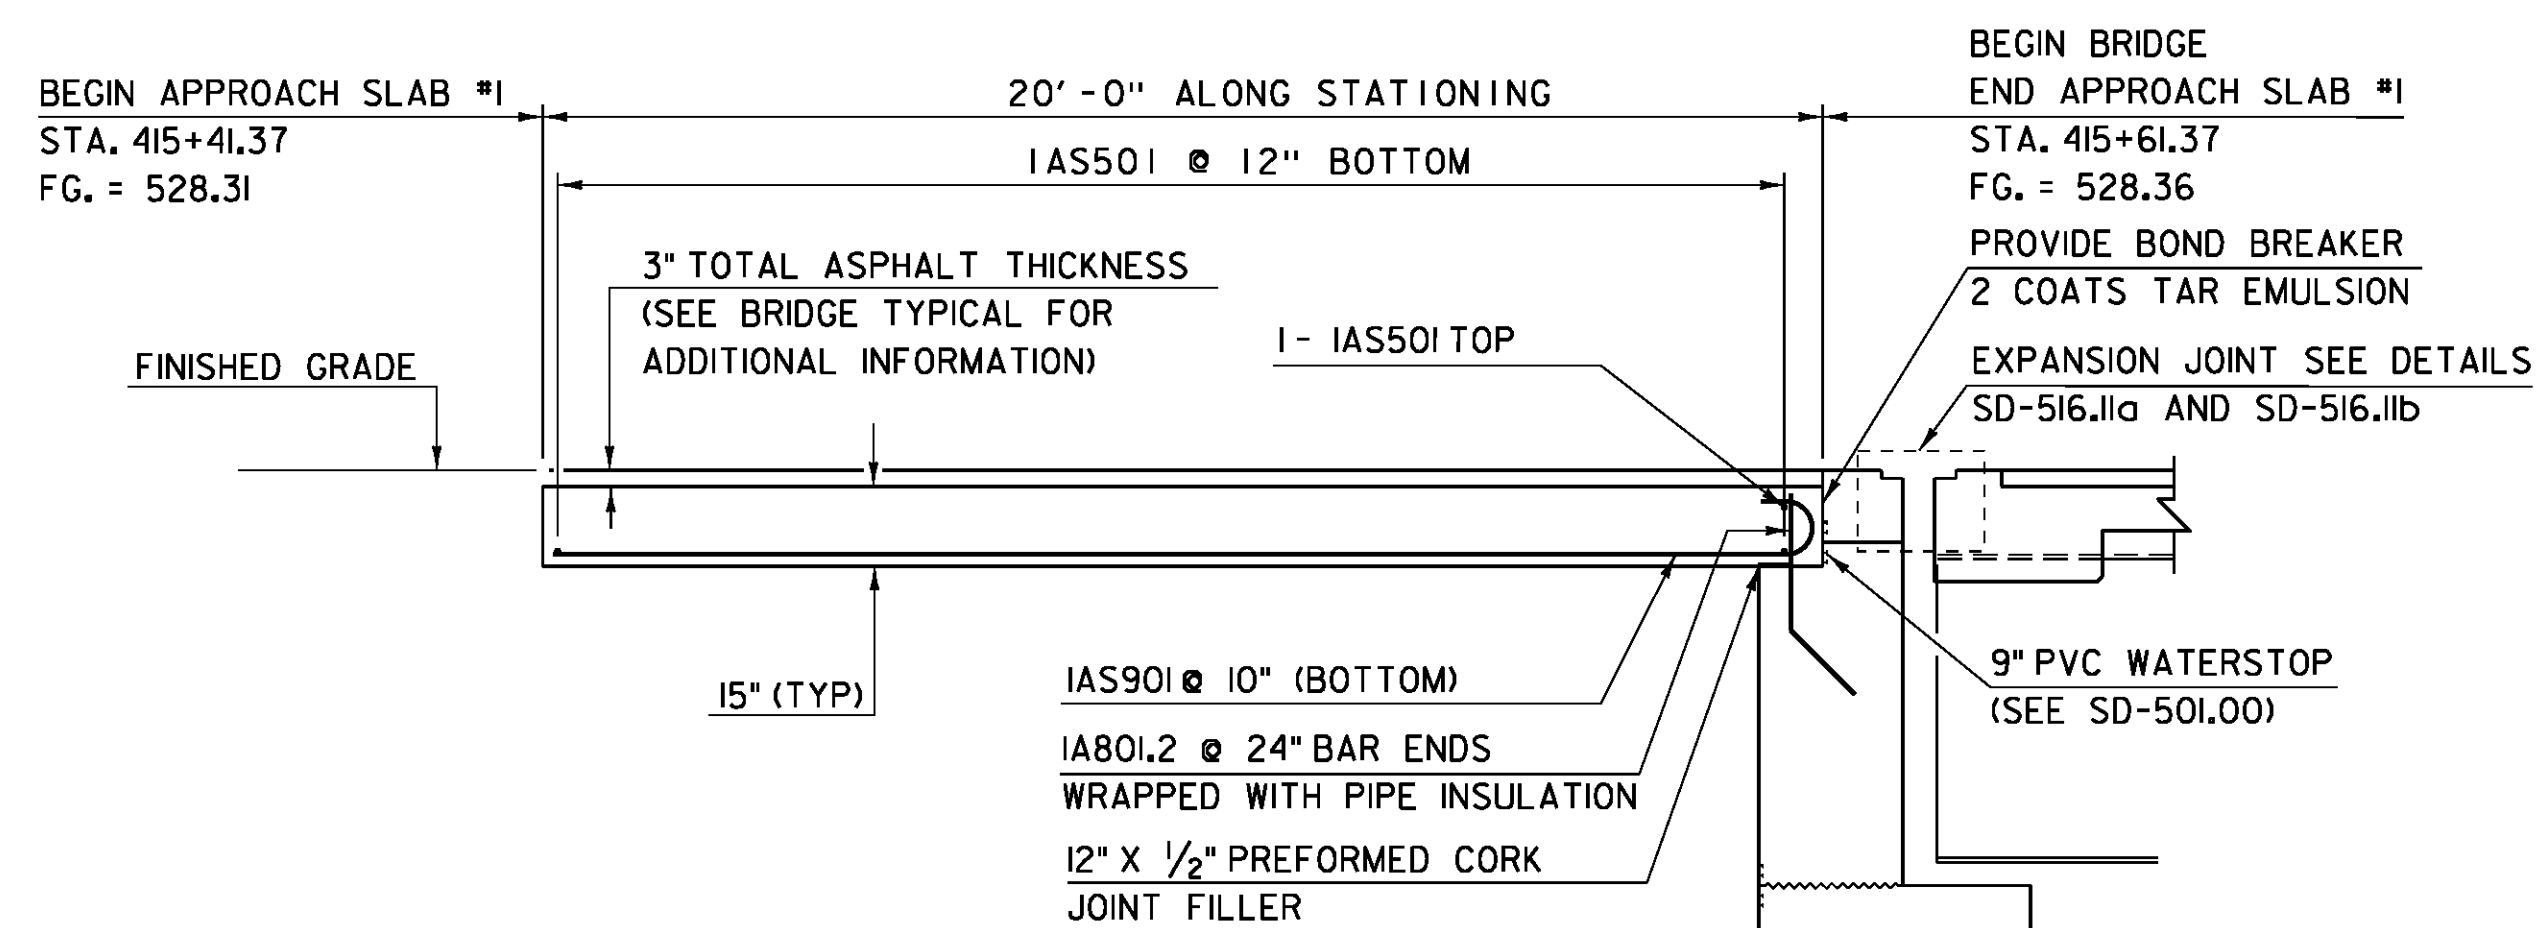

APPROACH SLAB NO. 1 TYPICAL

SCALE 1/4" = 1'-0"

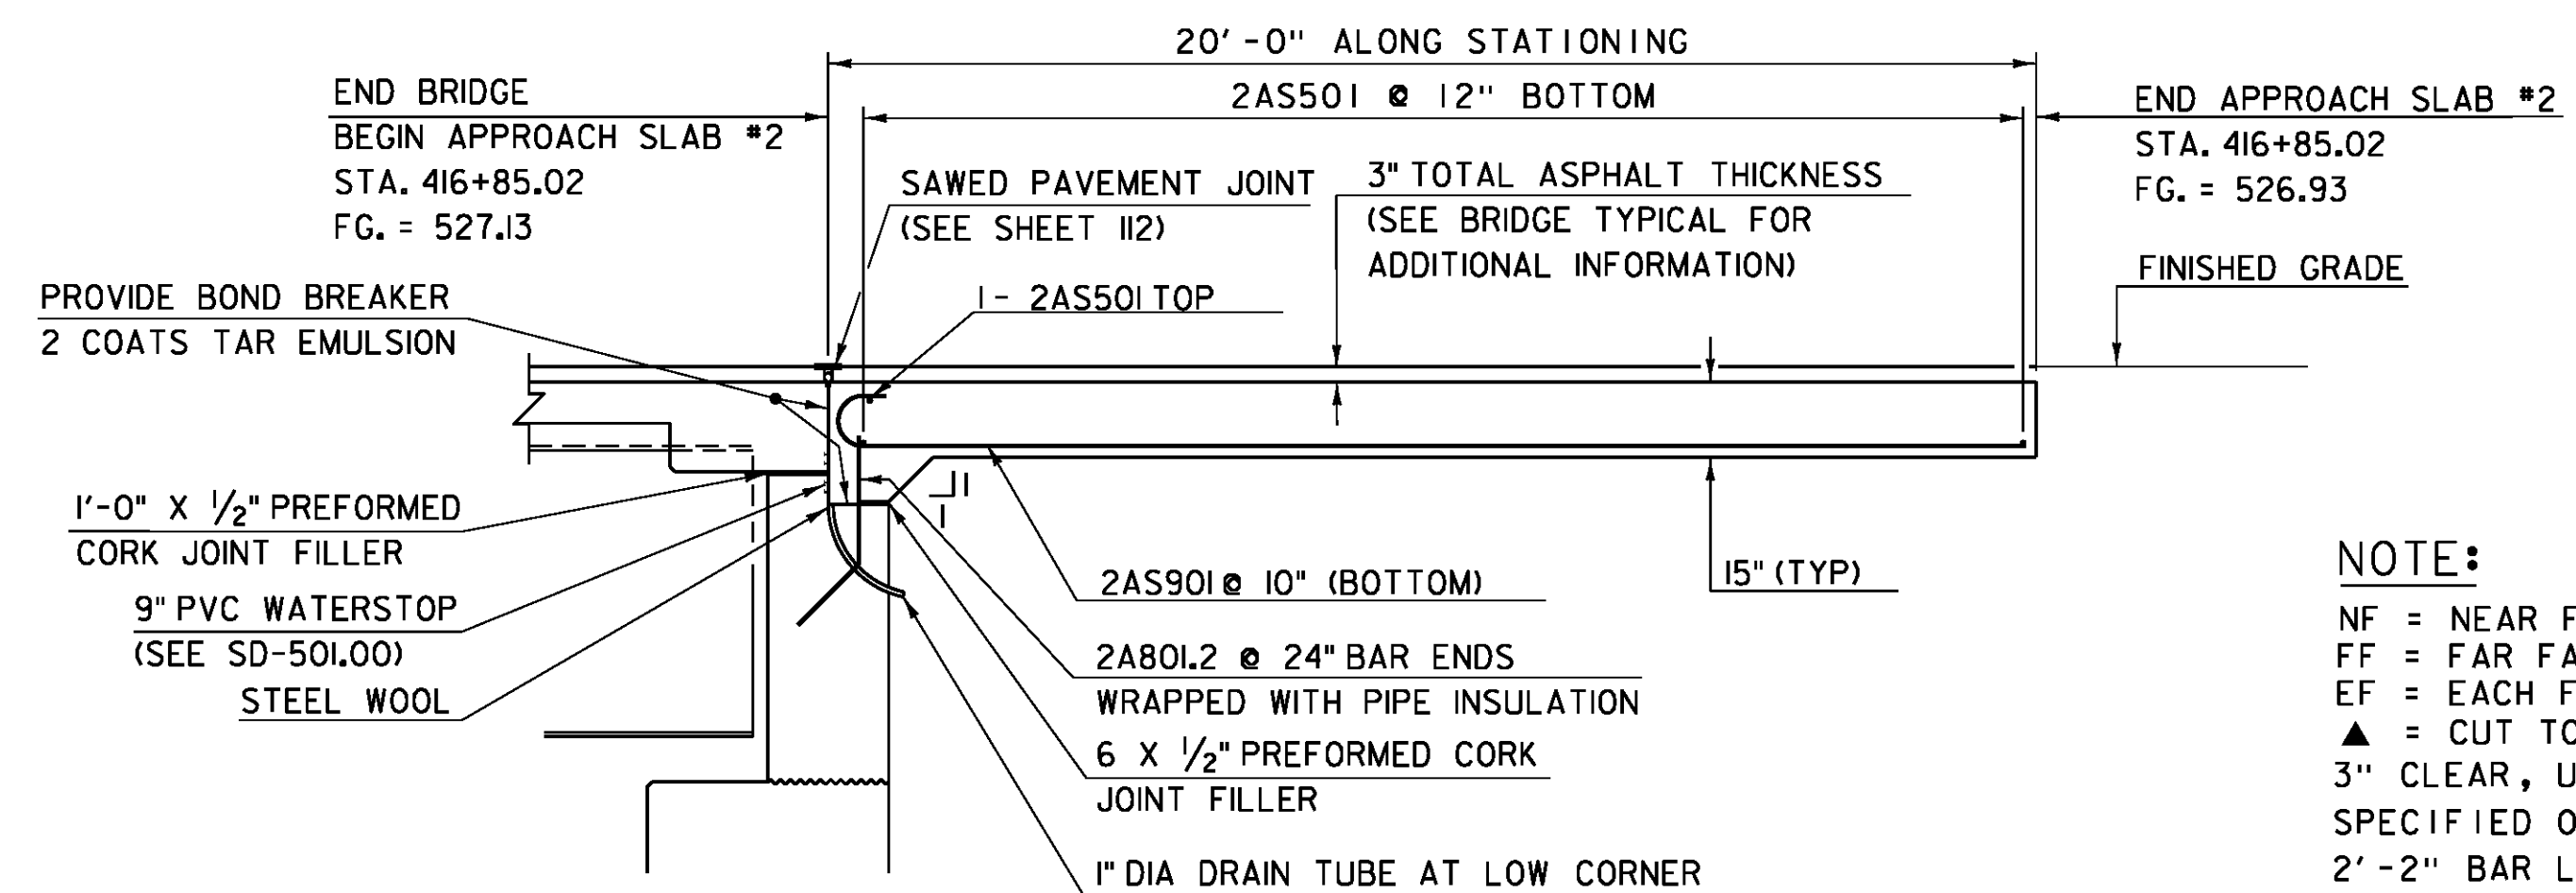


APPROACH SLAB NO. 2 TYPICAL

SCALE 1/4" = 1'-0"

**NOTE:**  
 NF = NEAR FACE  
 FF = FAR FACE  
 EF = EACH FACE  
 ▲ = CUT TO FIT IN FIELD  
 3" CLEAR, UNLESS OTHERWISE SPECIFIED ON THE PLANS.  
 2' - 2" BAR LAP UNLESS OTHERWISE SPECIFIED ON THE PLANS.

PROJECT NAME:	ROYALTON
PROJECT NUMBER:	BRS 0147 (13)
FILE NAME:	86e055/STR/86e055sub.dgn
PROJECT LEADER:	C.CARLSON
DESIGNED BY:	D.PETERSON
PLOT DATE:	08-OCT-2013
DRAWN BY:	G.ROKES
CHECKED BY:	D.PETERSON
BRIDGE 28 APPROACH SLAB 1 AND 2 TYPICALS SHEET 115 OF 186	

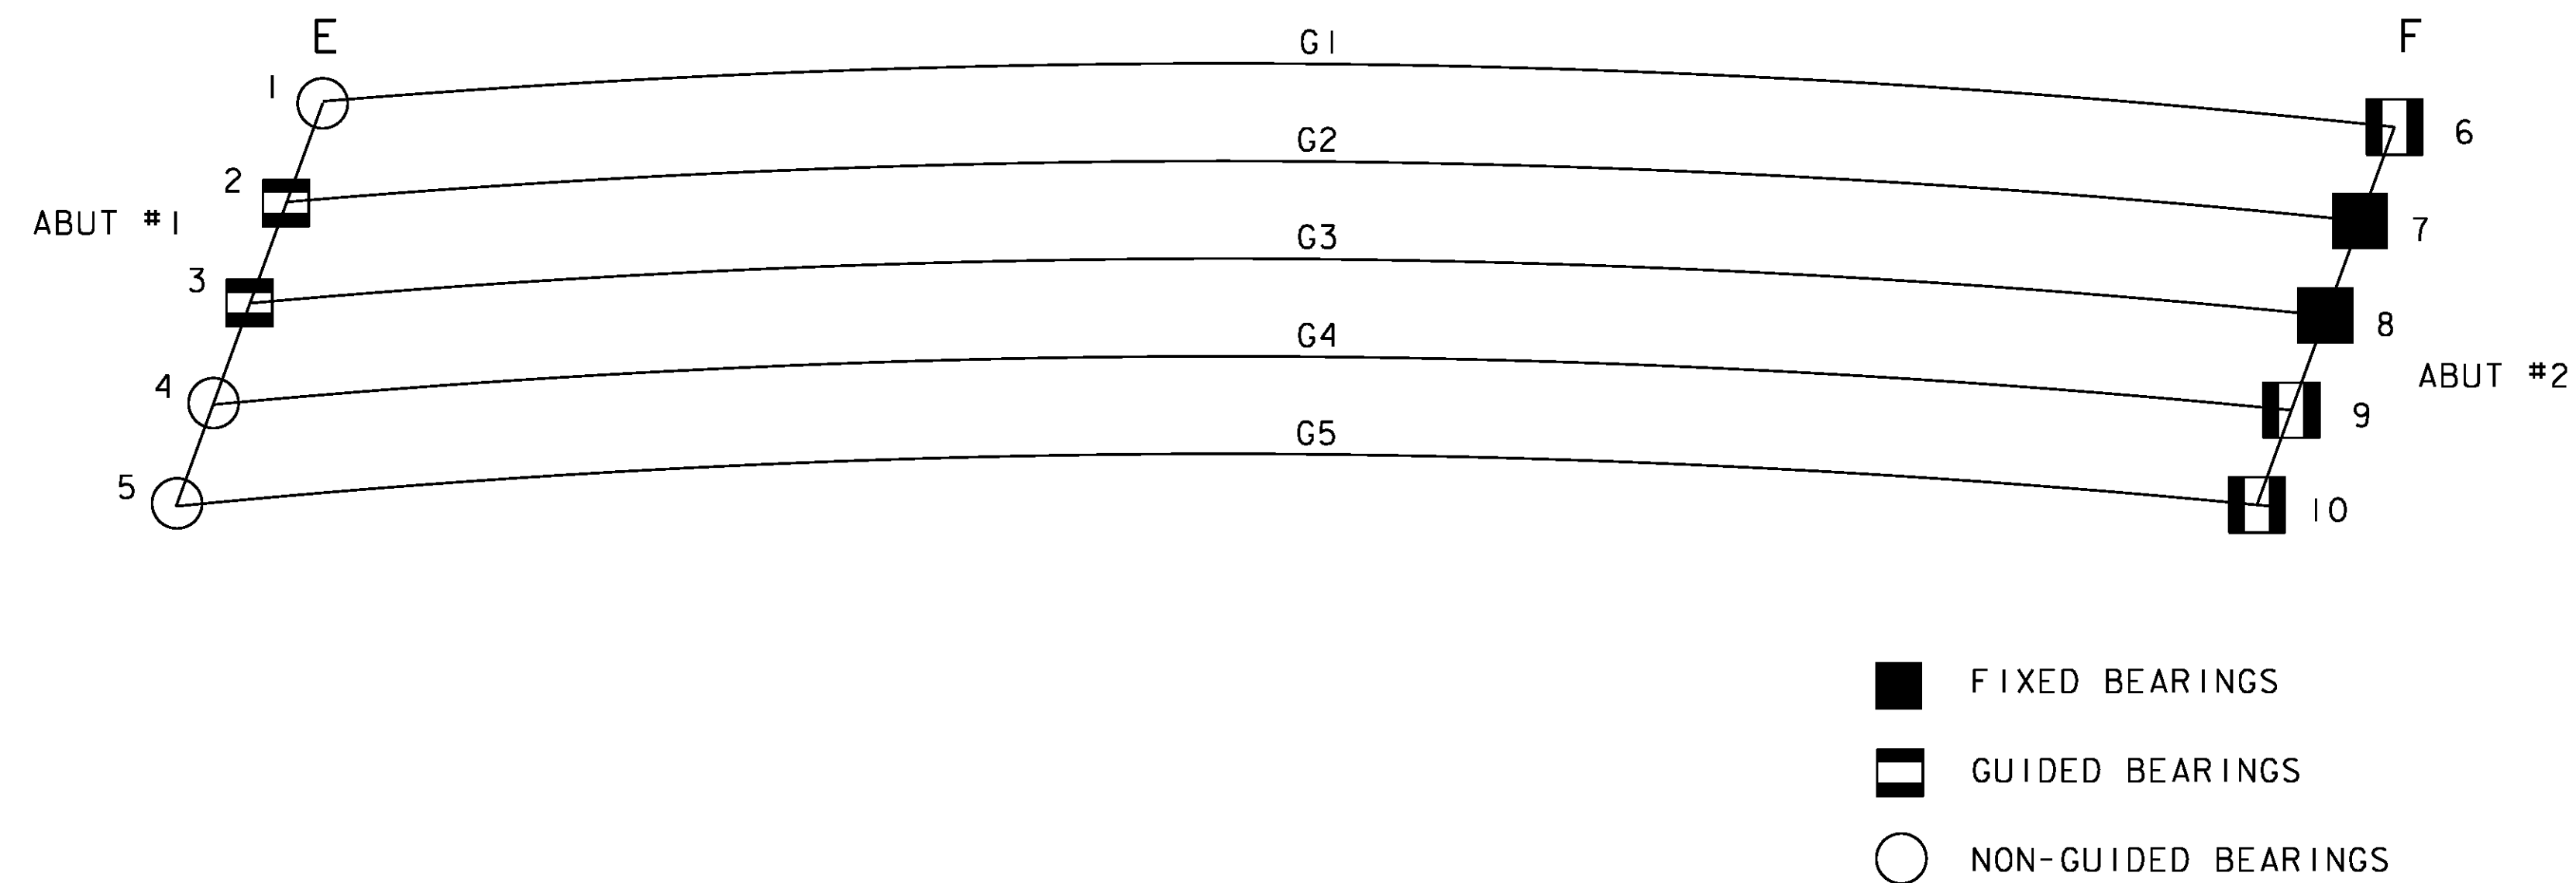

**BEARING LAYOUT**  
NOT TO SCALE

ABUTMENT #1 (VERTICAL LOADS)		
BEARING NO.	*UNFACTORED DEAD LOAD	*UNFACTORED LIVE LOAD
1	168 KIPS	224 KIPS
2	104 KIPS	156 KIPS
3	70 KIPS	129 KIPS
4	53 KIPS	118 KIPS
5	63 KIPS	93 KIPS

ABUTMENT #2 (VERTICAL LOADS)		
BEARING NO.	*UNFACTORED DEAD LOAD	*UNFACTORED LIVE LOAD
6	130 KIPS	186 KIPS
7	123 KIPS	175 KIPS
8	75 KIPS	130 KIPS
9	70 KIPS	127 KIPS
10	38 KIPS	78 KIPS


**BEARING NOTES**

1. BEARINGS SHALL CONFORM TO APPLICABLE SUBSECTIONS OF SECTIONS 531 & 731.
2. BEARINGS SHALL BE PAID FOR UNDER ITEM 531.15 "BEARING DEVICE ASSEMBLY, HIGH LOAD MULTI-ROTATIONAL".
3. FABRICATION DRAWINGS CONFORMING TO SUBSECTION 531.03 SHALL BE SUBMITTED.
4. THE CONCRETE SURFACE UNDER THE BEARING DEVICES SHALL BE LEVEL.
5. DESIGN CRITERIA:
  - A. BASE PLATE TO CONCRETE DESIGN PRESSURE = 1.20 ksi MAXIMUM.
  - B. MINIMUM DESIGN ROTATION = 0.030 radians
  - C. MINIMUM DESIGN TRANSLATION: TRANSVERSE = 1"  
LONGITUDINAL = 2"
  - D. HORIZONTAL CAPACITY SHALL BE A MINIMUM OF 25% OF THE VERTICAL LOAD.
  - E. VERTICAL DESIGN LOAD PER TABLE ON THIS SHEET.
6. ALL POTS, PLATES, NUTS, WASHERS AND ANCHOR BOLTS, UNLESS OTHERWISE NOTED, SHALL BE GALVANIZED OR METALIZED AS PER SUBSECTIONS 531.04 (B) AND 506.14 OF THE STANDARD SPECIFICATIONS. IF THE BEARINGS ARE METALIZED, THEY SHALL BE SEALED WITH AN APPROVED SEALER AS SPECIFIED IN SUBSECTION 531.04 (B) OF THE STANDARD SPECIFICATIONS. AREAS OF GALVANIZING OR METALIZING DAMAGED BY FIELD WELDING OR HANDLING SHALL BE REPAIRED IN CONFORMANCE WITH SUBSECTION 726.08. THE INSIDE OF THE POTS SHALL NOT BE GALVANIZED OR METALIZED.
7. ALL STEEL IN BEARING DEVICES SHALL BE AASHTO M270M/M270 GRADE 345, UNLESS NOTED OTHERWISE.
8. ANCHOR BOLTS SHALL HAVE A MINIMUM OF 15" EMBEDMENT INTO THE CONCRETE AND SHALL CONFORM TO SUBSECTION 714.08.
9. THE CONNECTION BETWEEN THE POT BEARING AND SOLE PLATE AND POT BEARING AND THE MASONRY PLATE SHALL BE DESIGNED AND DETAILED BY THE SUPPLIER.
10. ALL DESIGNS DONE FOR THE BEARINGS SHALL BE PER THE AASHTO LRFD BRIDGE DESIGN SPECIFICATIONS 5TH EDITION AND ITS LATEST REVISIONS.
11. ALTERNATE CONFIGURATIONS FOR BEARINGS MAY BE SUBMITTED FOR APPROVAL. ANY ALTERNATE SUBMITTED SHALL BE DESIGNED AND CERTIFIED TO MEET THE DESIGN LOADS AND CRITERIA SHOWN ON THE PLANS.
12. ALL BEARINGS SHALL BE MARKED PRIOR TO SHIPPING. THE MARKS SHALL INCLUDE THE BEARING LOCATION ON THE BRIDGE AND A DIRECTION ARROW THAT POINTS UP-STATION. ALL MARKS SHALL BE PERMANENT AND BE VISIBLE AFTER THE BEARING IS INSTALLED.


PROJECT NAME:	ROYALTON
PROJECT NUMBER:	BRS 0147 (13)
FILE NAME:	BR 28\86e055brg_28.dgn
PROJECT LEADER:	C. CARLSON
DESIGNED BY:	D. PETERSON
BRIDGE 28 BEARING NOTES	
PLOT DATE:	08-OCT-2013
DRAWN BY:	DZENAN K.
CHECKED BY:	D.PETERSON
SHEET	116 OF 186

### ABUTMENT 1 BEARINGS


BEARING	GUIDE ANGLE
1	NONE
2	100° - 43'
3	101° - 0'
4	NONE
5	NONE

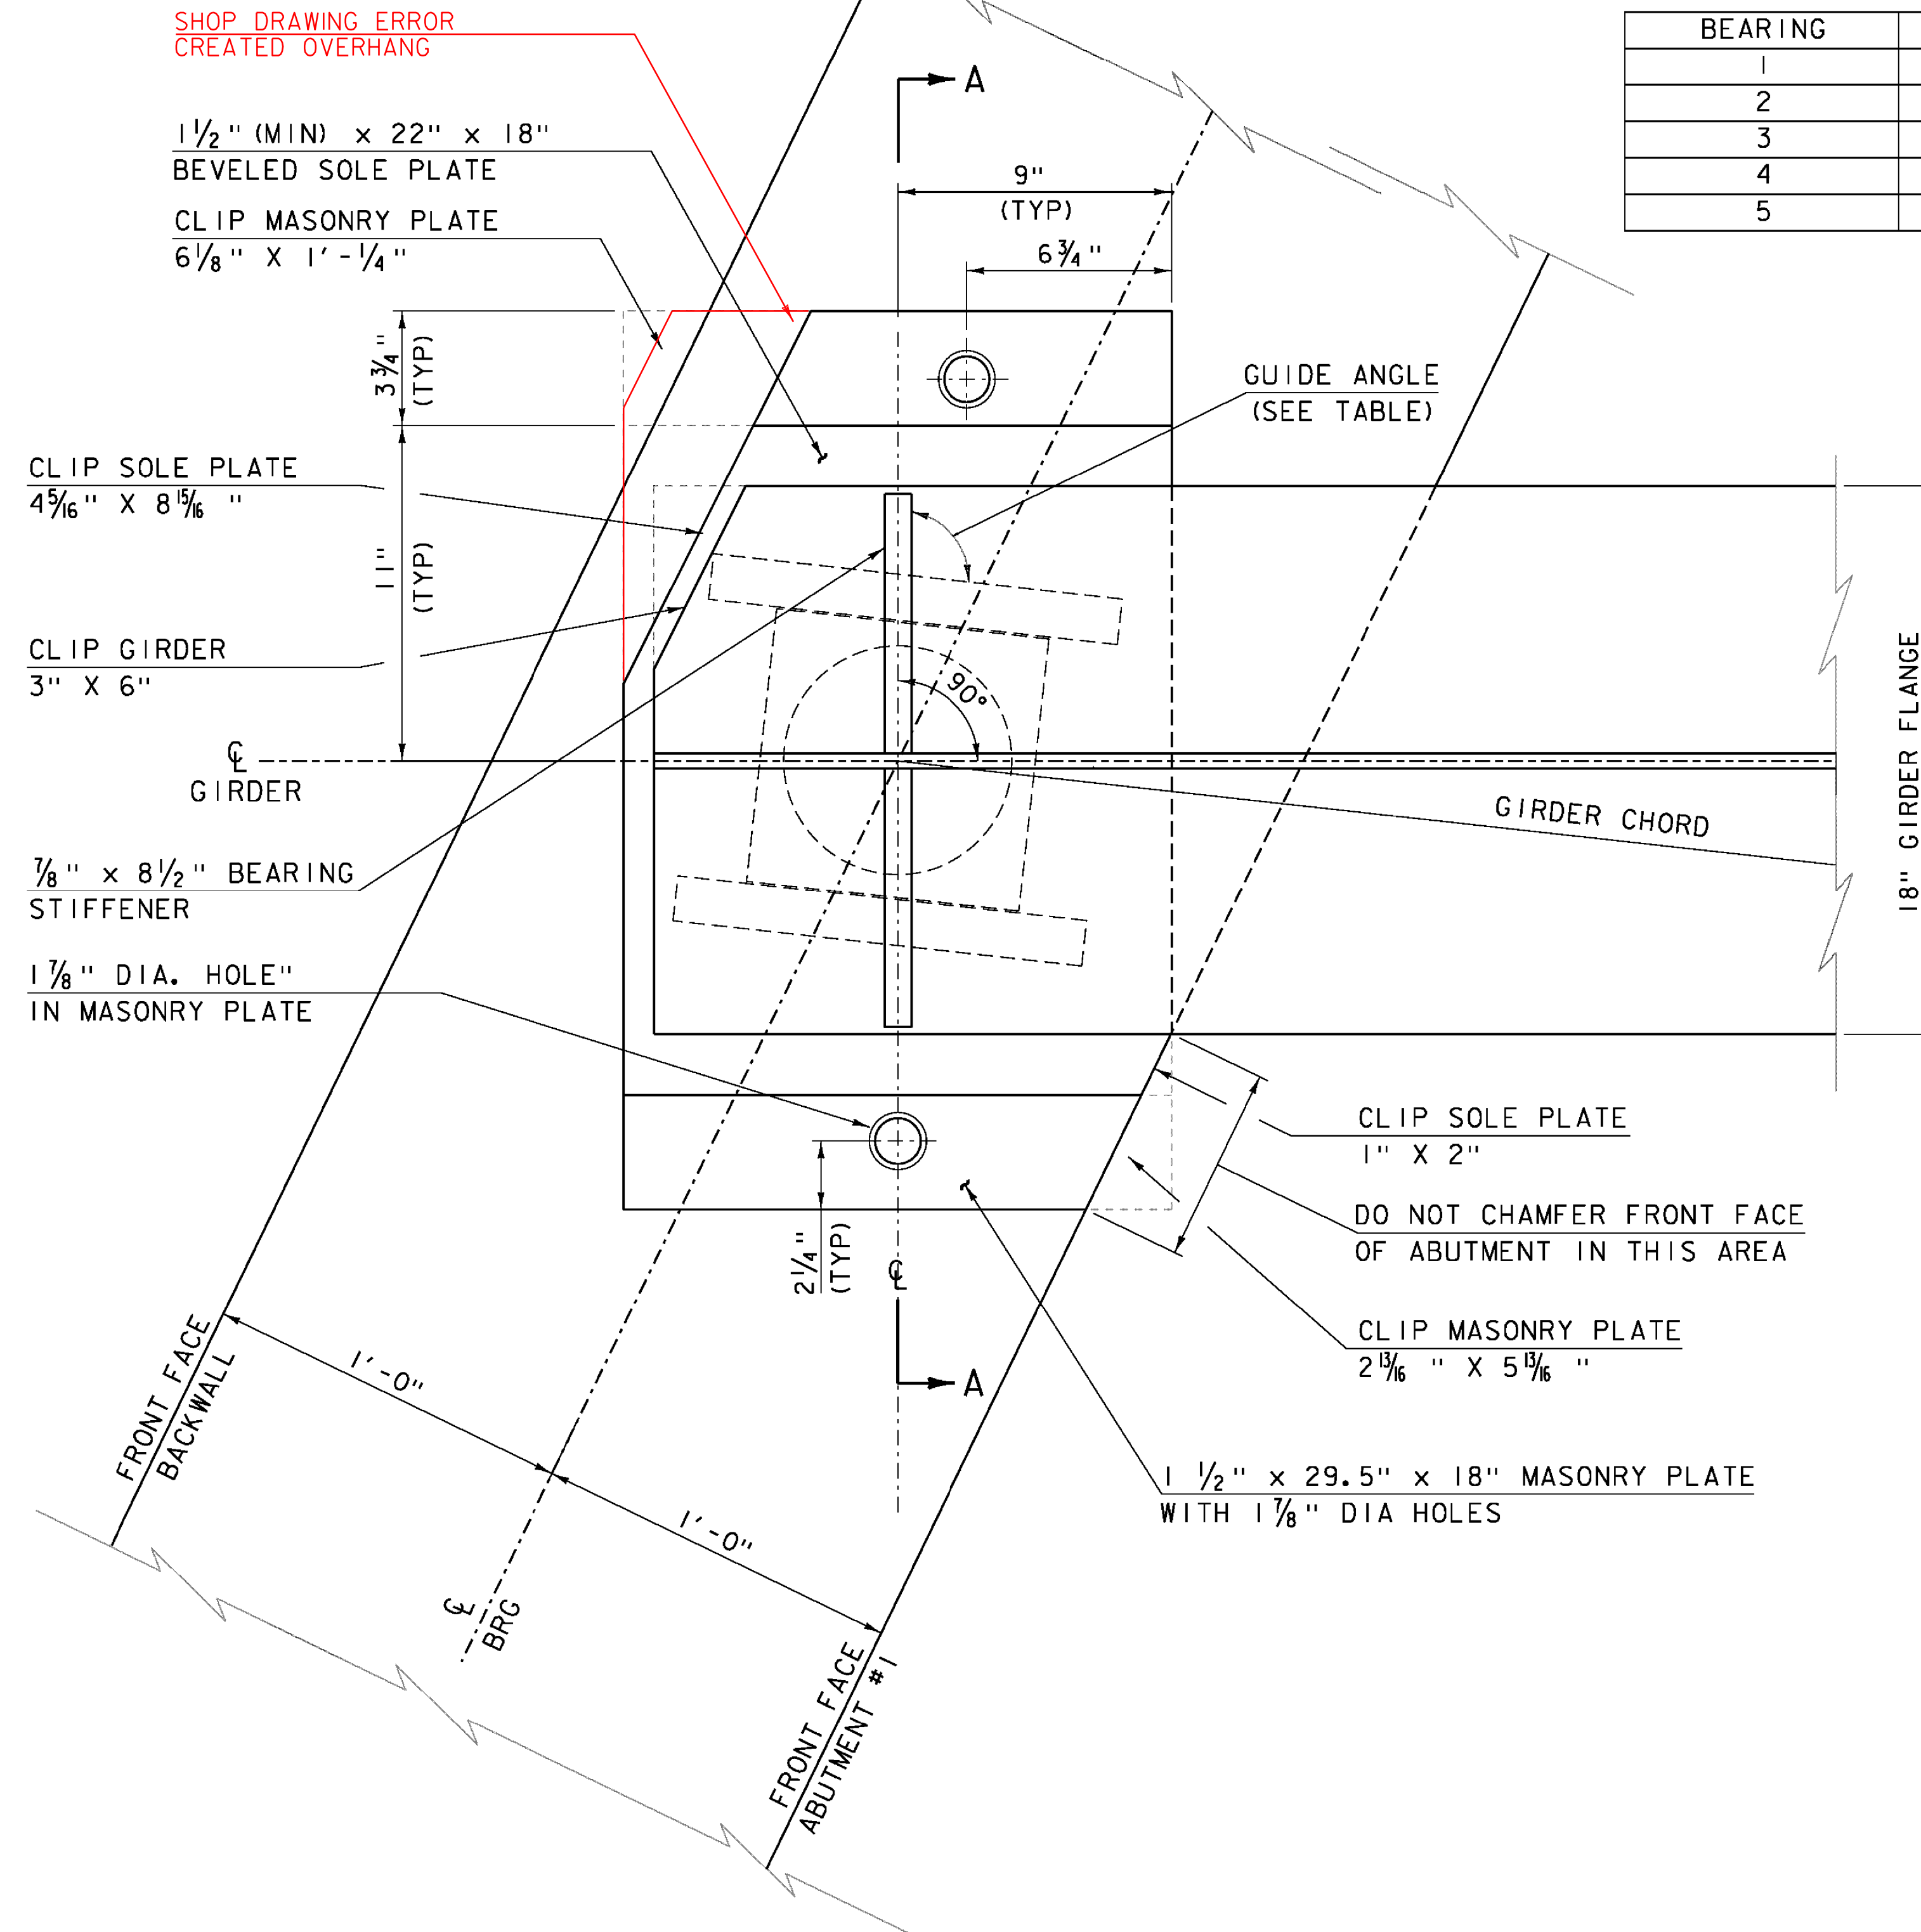

**PLAN VIEW**  
SCALE 3" = 1' - 0"

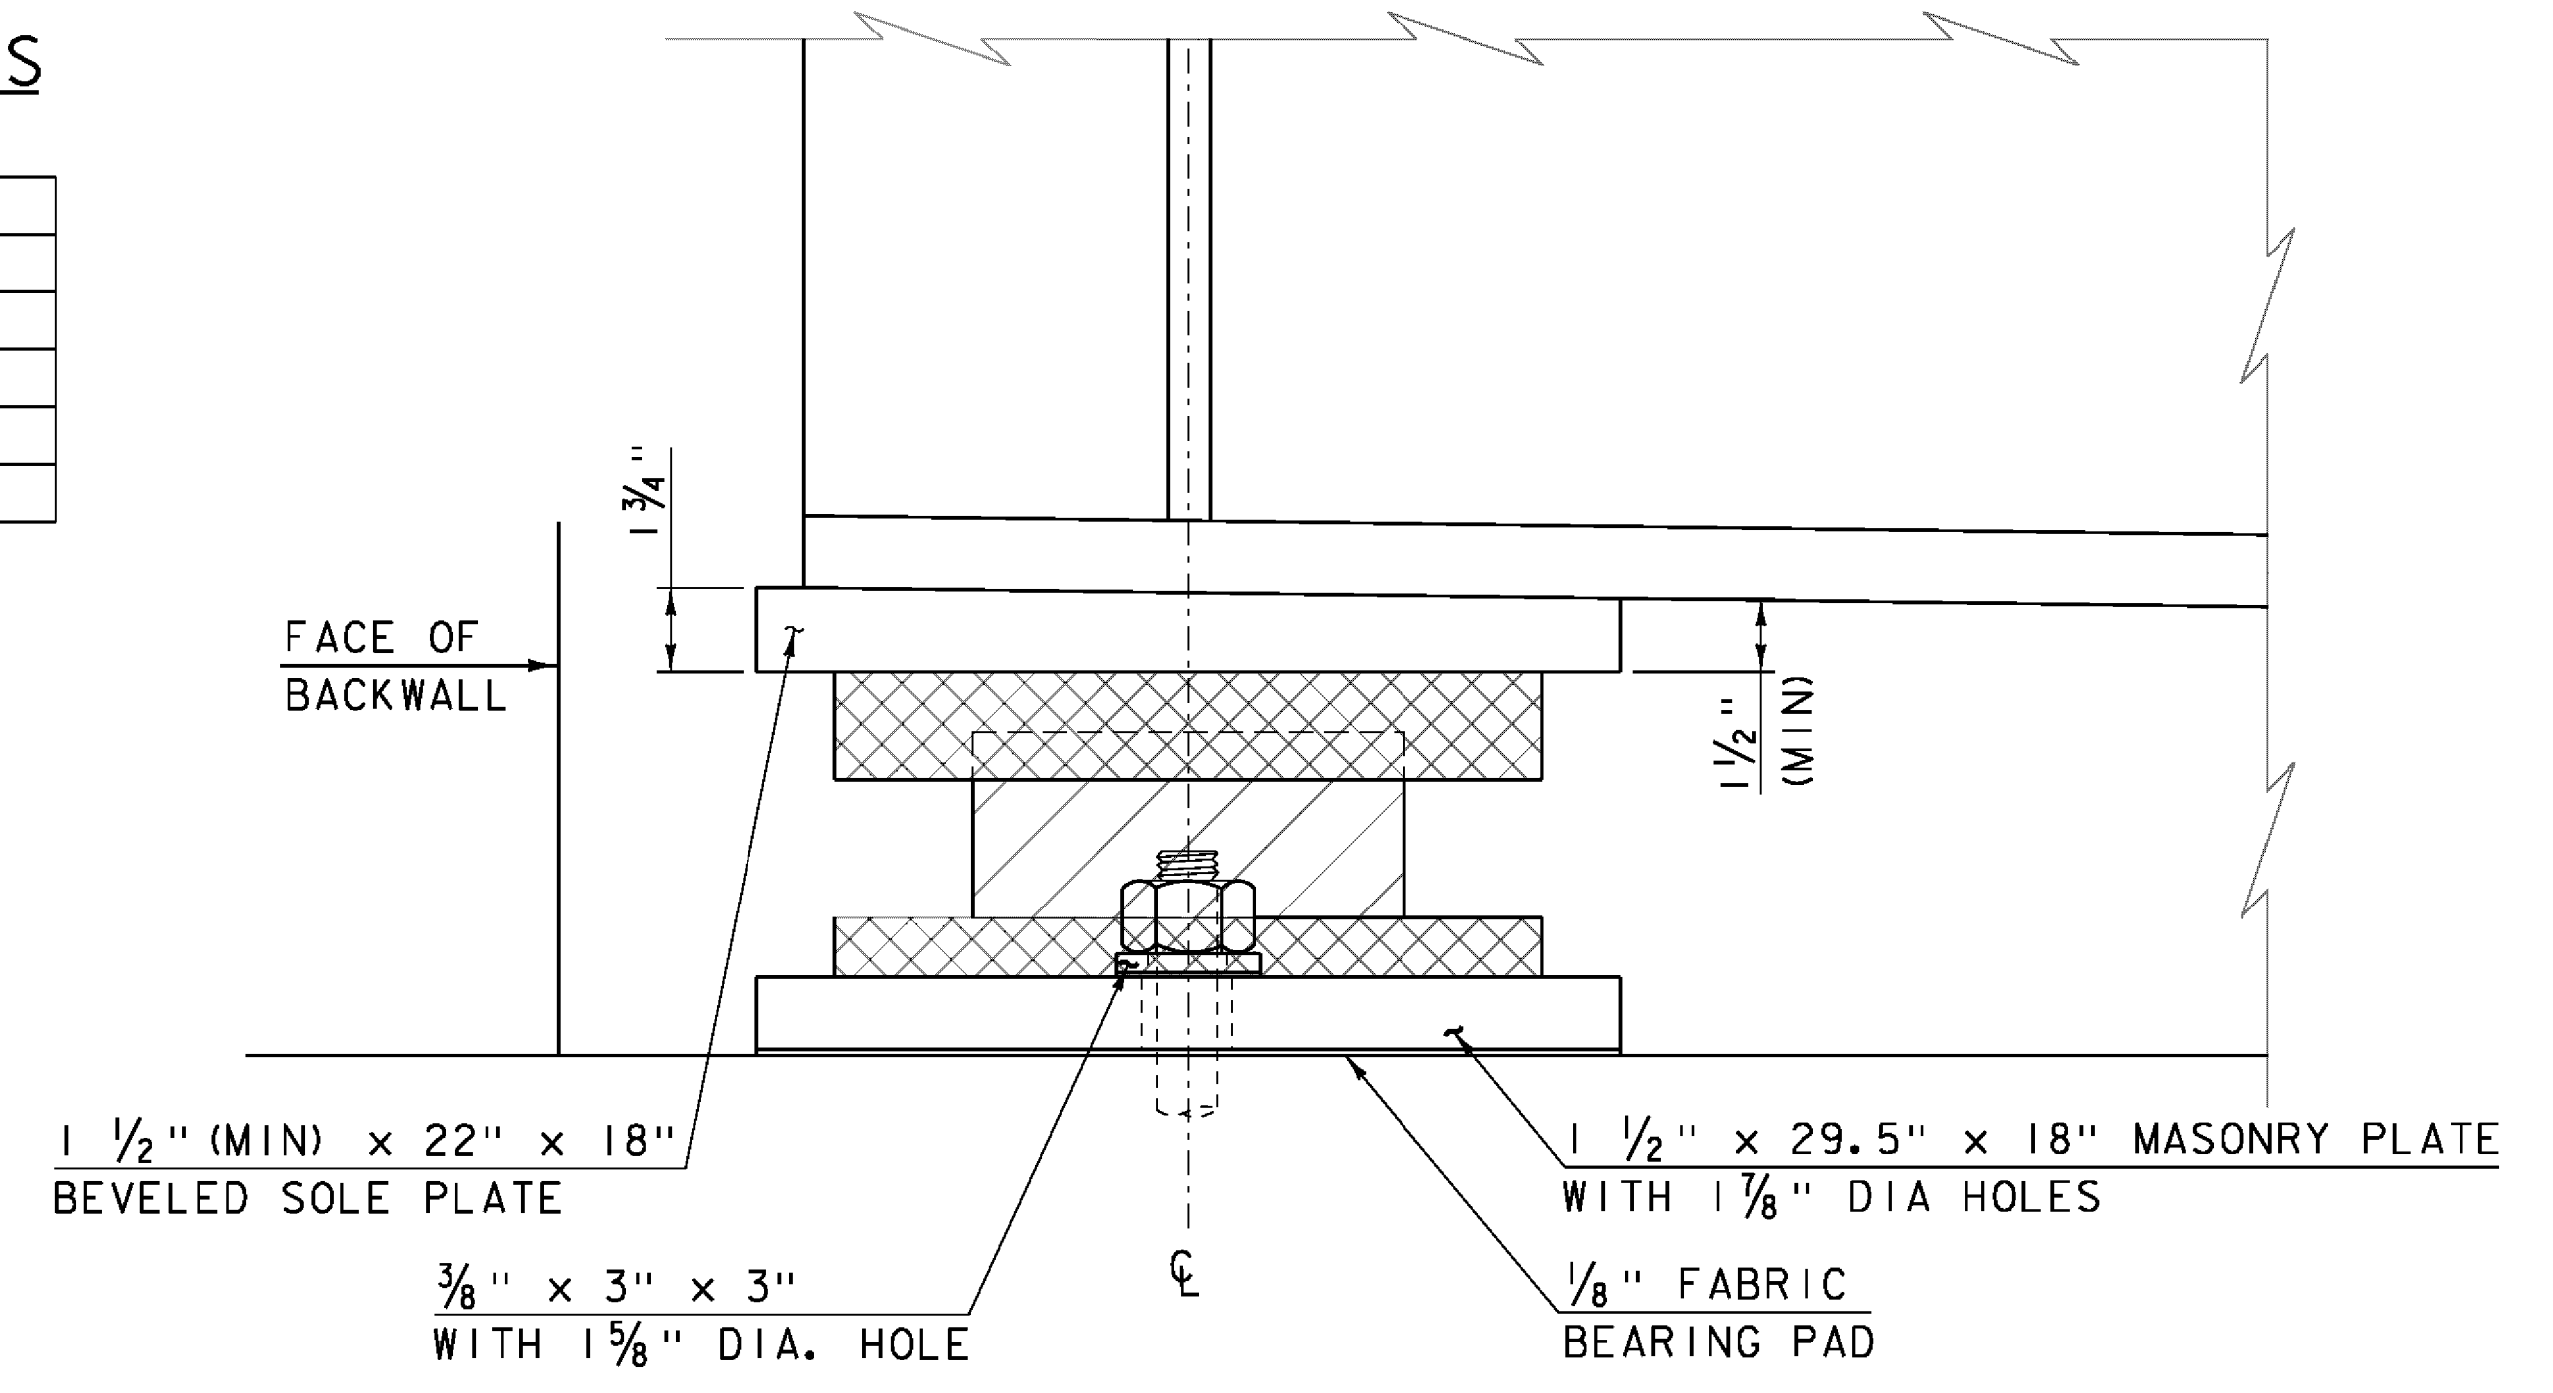

**SIDE ELEVATION**  
SCALE 3" = 1' - 0"

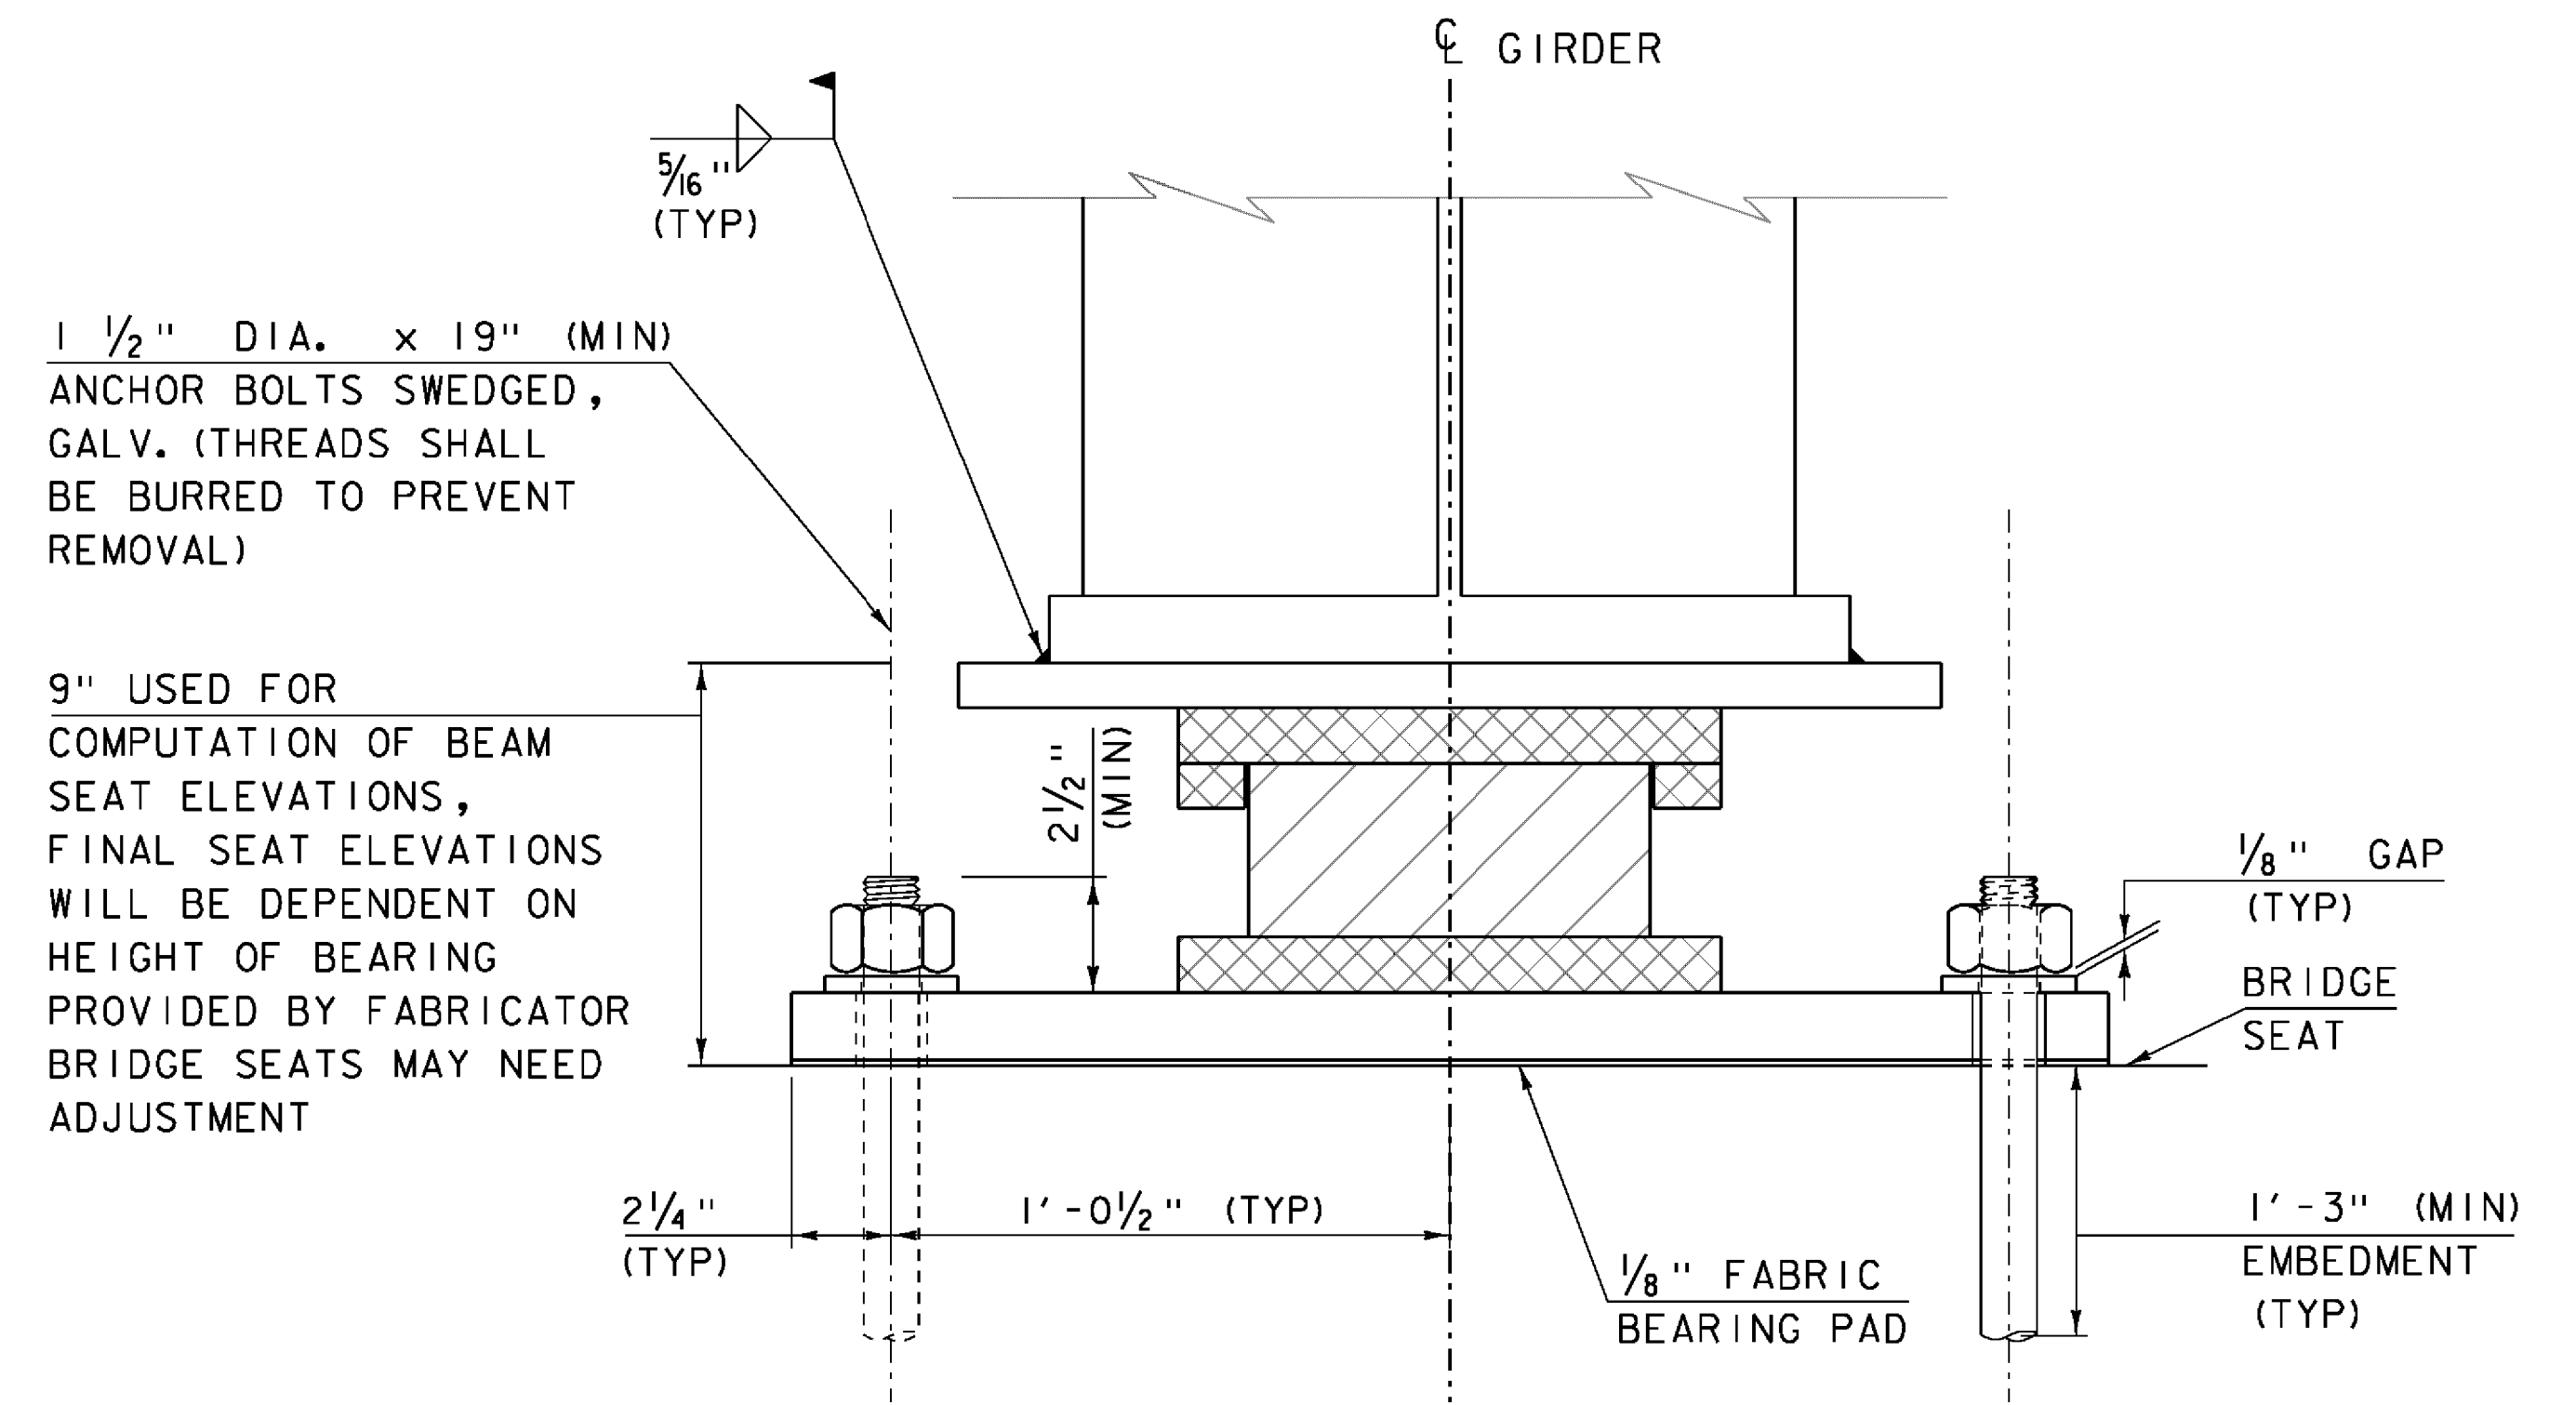

**SECTION A-A**  
SCALE 3" = 1' - 0"


**NOTES:**

- THE HATCHED COMPONENTS OF THE POT BEARINGS ARE SHOWN FOR REPRESENTATIVE PURPOSES ONLY. THE ACTUAL CONFIGURATION OF THE COMPONENTS WILL BE DEPENDENT UPON THE BEARING FABRICATOR.
- SEE BRIDGE 28 BEARING NOTES, SHEET 116 FOR ADDITIONAL BEARING NOTES.

PROJECT NAME: ROYALTON	PLOT DATE: 08-OCT-2013
PROJECT NUMBER: BRS 0147 (13)	DRAWN BY: DZENAN K.
FILE NAME: \BR 28\86e055brg.28.dgn	CHECKED BY: D. PETERSON
PROJECT LEADER: C. CARLSON	SHEET 117 OF 186
DESIGNED BY: D. PETERSON	
BRIDGE 28 EXPANSION BEARING DETAILS	

**ABUTMENT 2 BEARINGS**


BEARING	GUIDE ANGLE
6	79°-32'
7	NONE
8	NONE
9	78°-42'
10	78°-23'

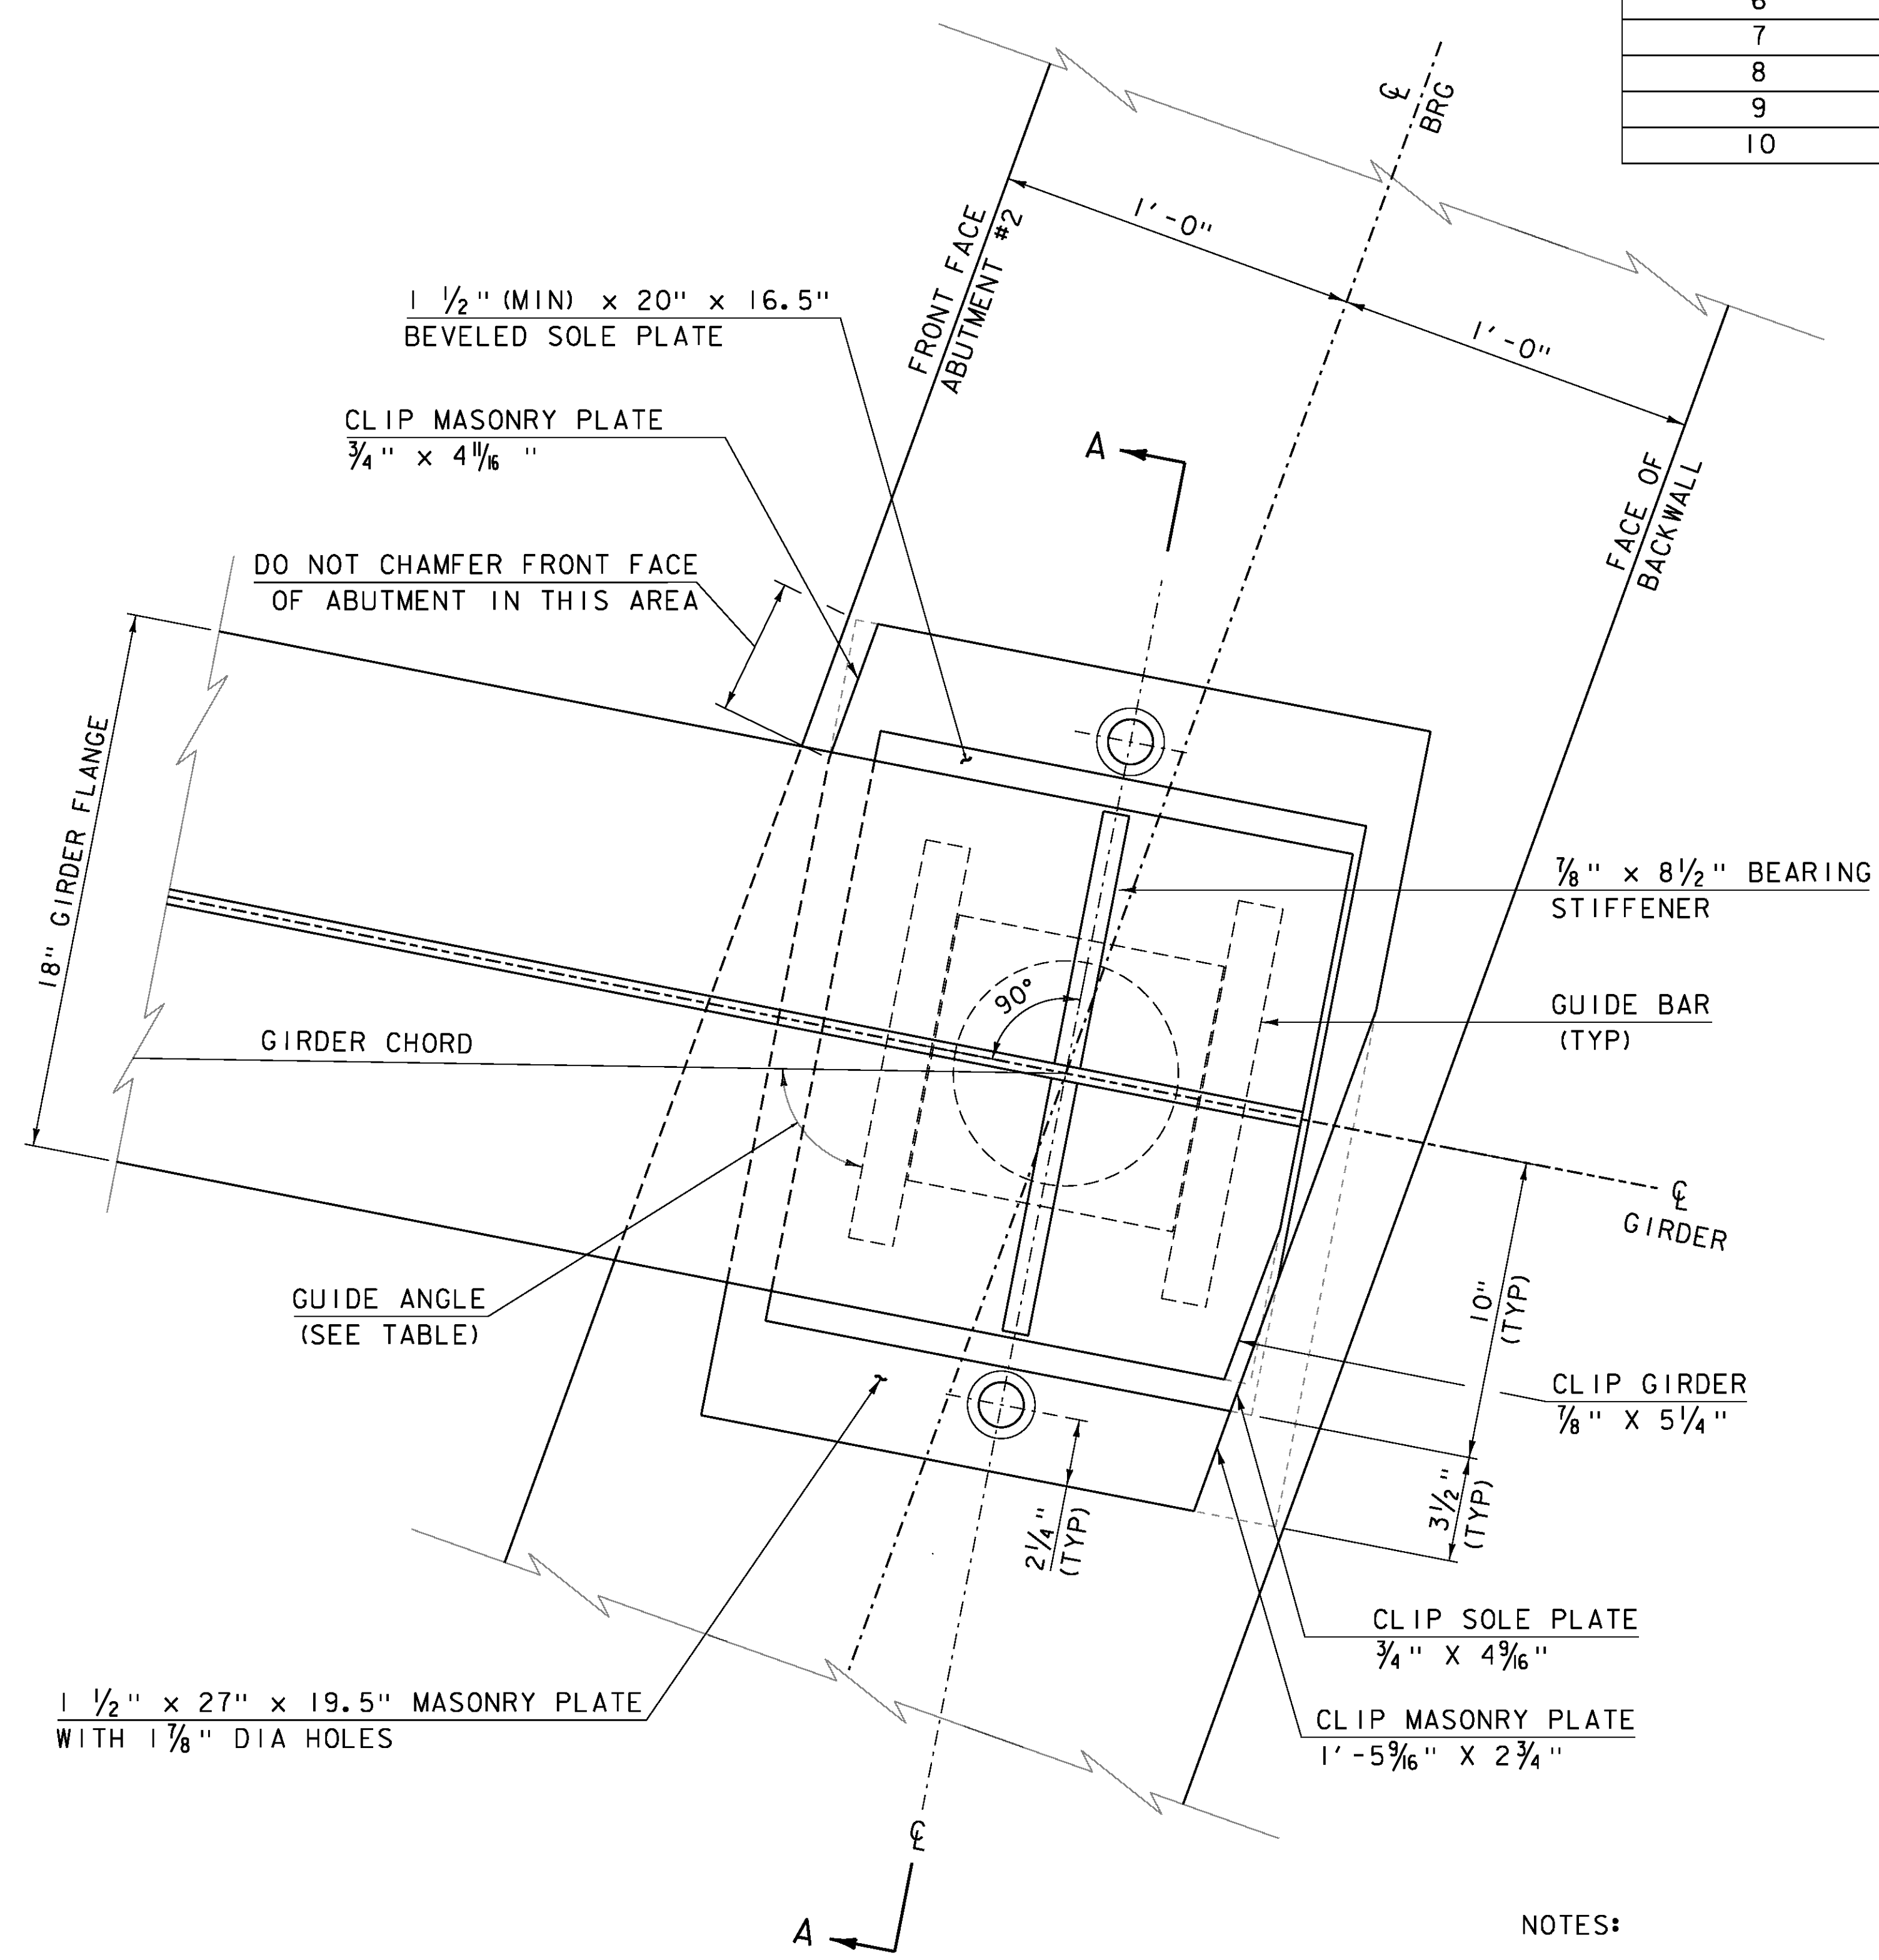


**PLAN VIEW**  
SCALE 3"=1'-0"

**NOTES:**

1. THE HATCHED COMPONENTS OF THE POT BEARINGS ARE SHOWN FOR REPRESENTATIVE PURPOSES ONLY. THE ACTUAL CONFIGURATION OF THE COMPONENTS WILL BE DEPENDENT UPON THE BEARING FABRICATOR.
2. SEE BRIDGE 28 BEARING NOTES, SHEET 116 FOR ADDITIONAL BEARING NOTES.

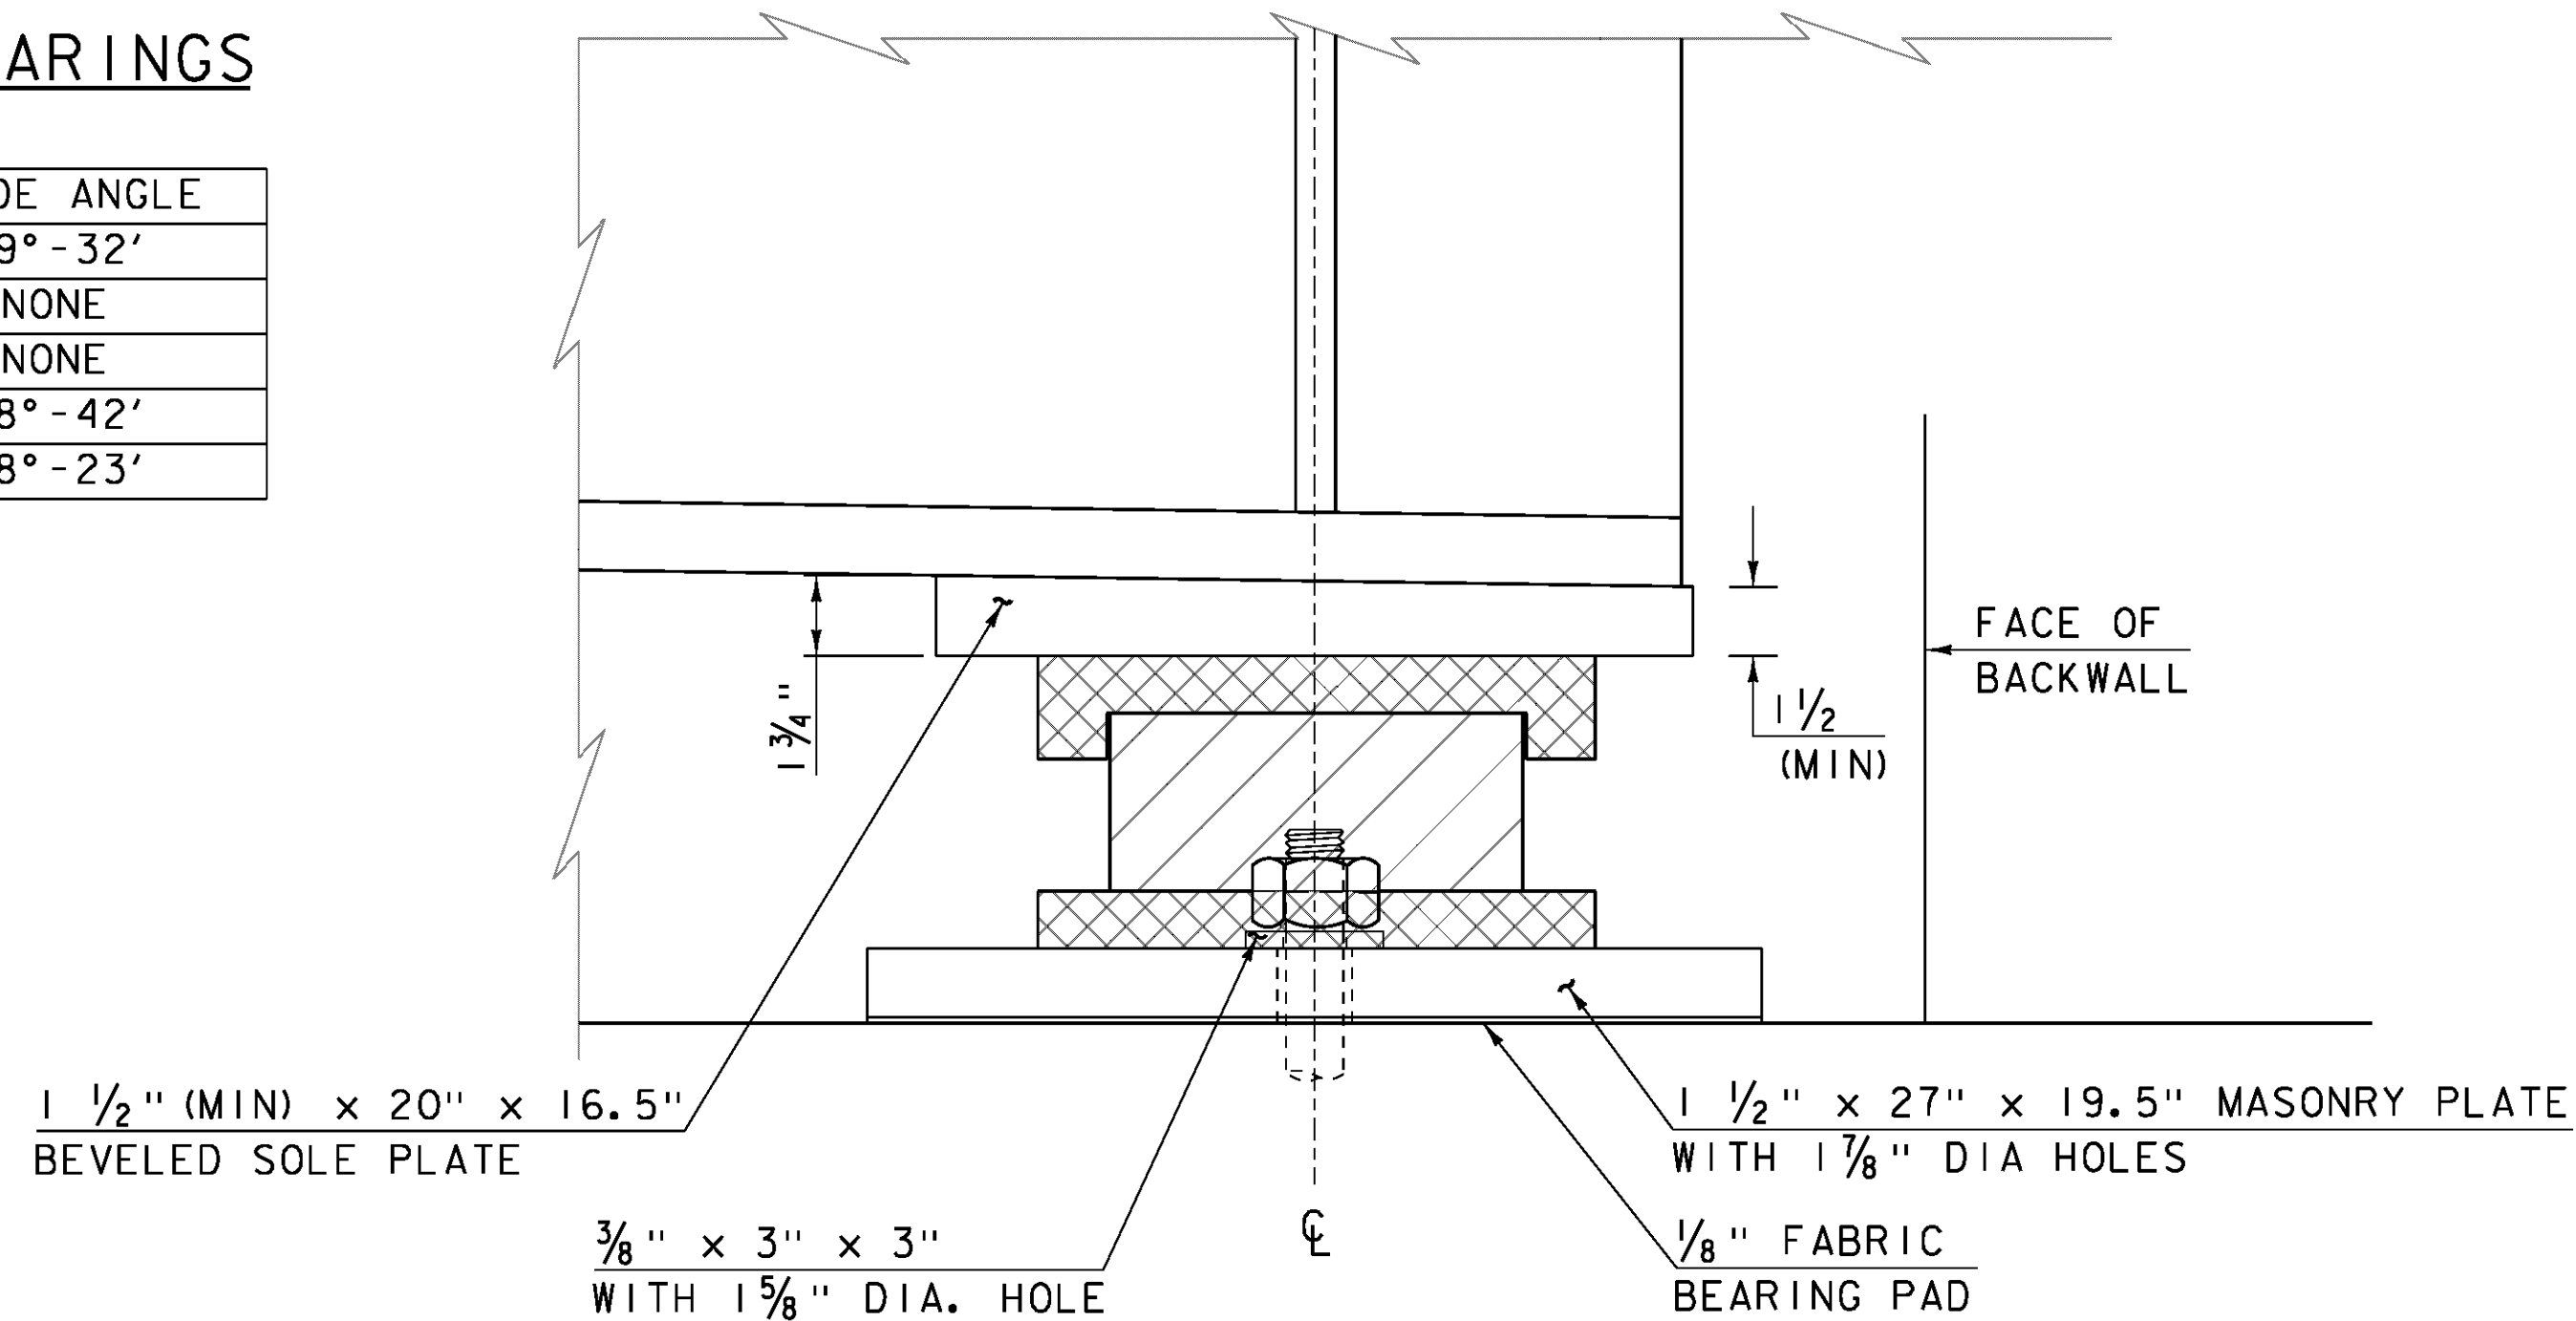

**SIDE ELEVATION**  
SCALE 3"=1'-0"

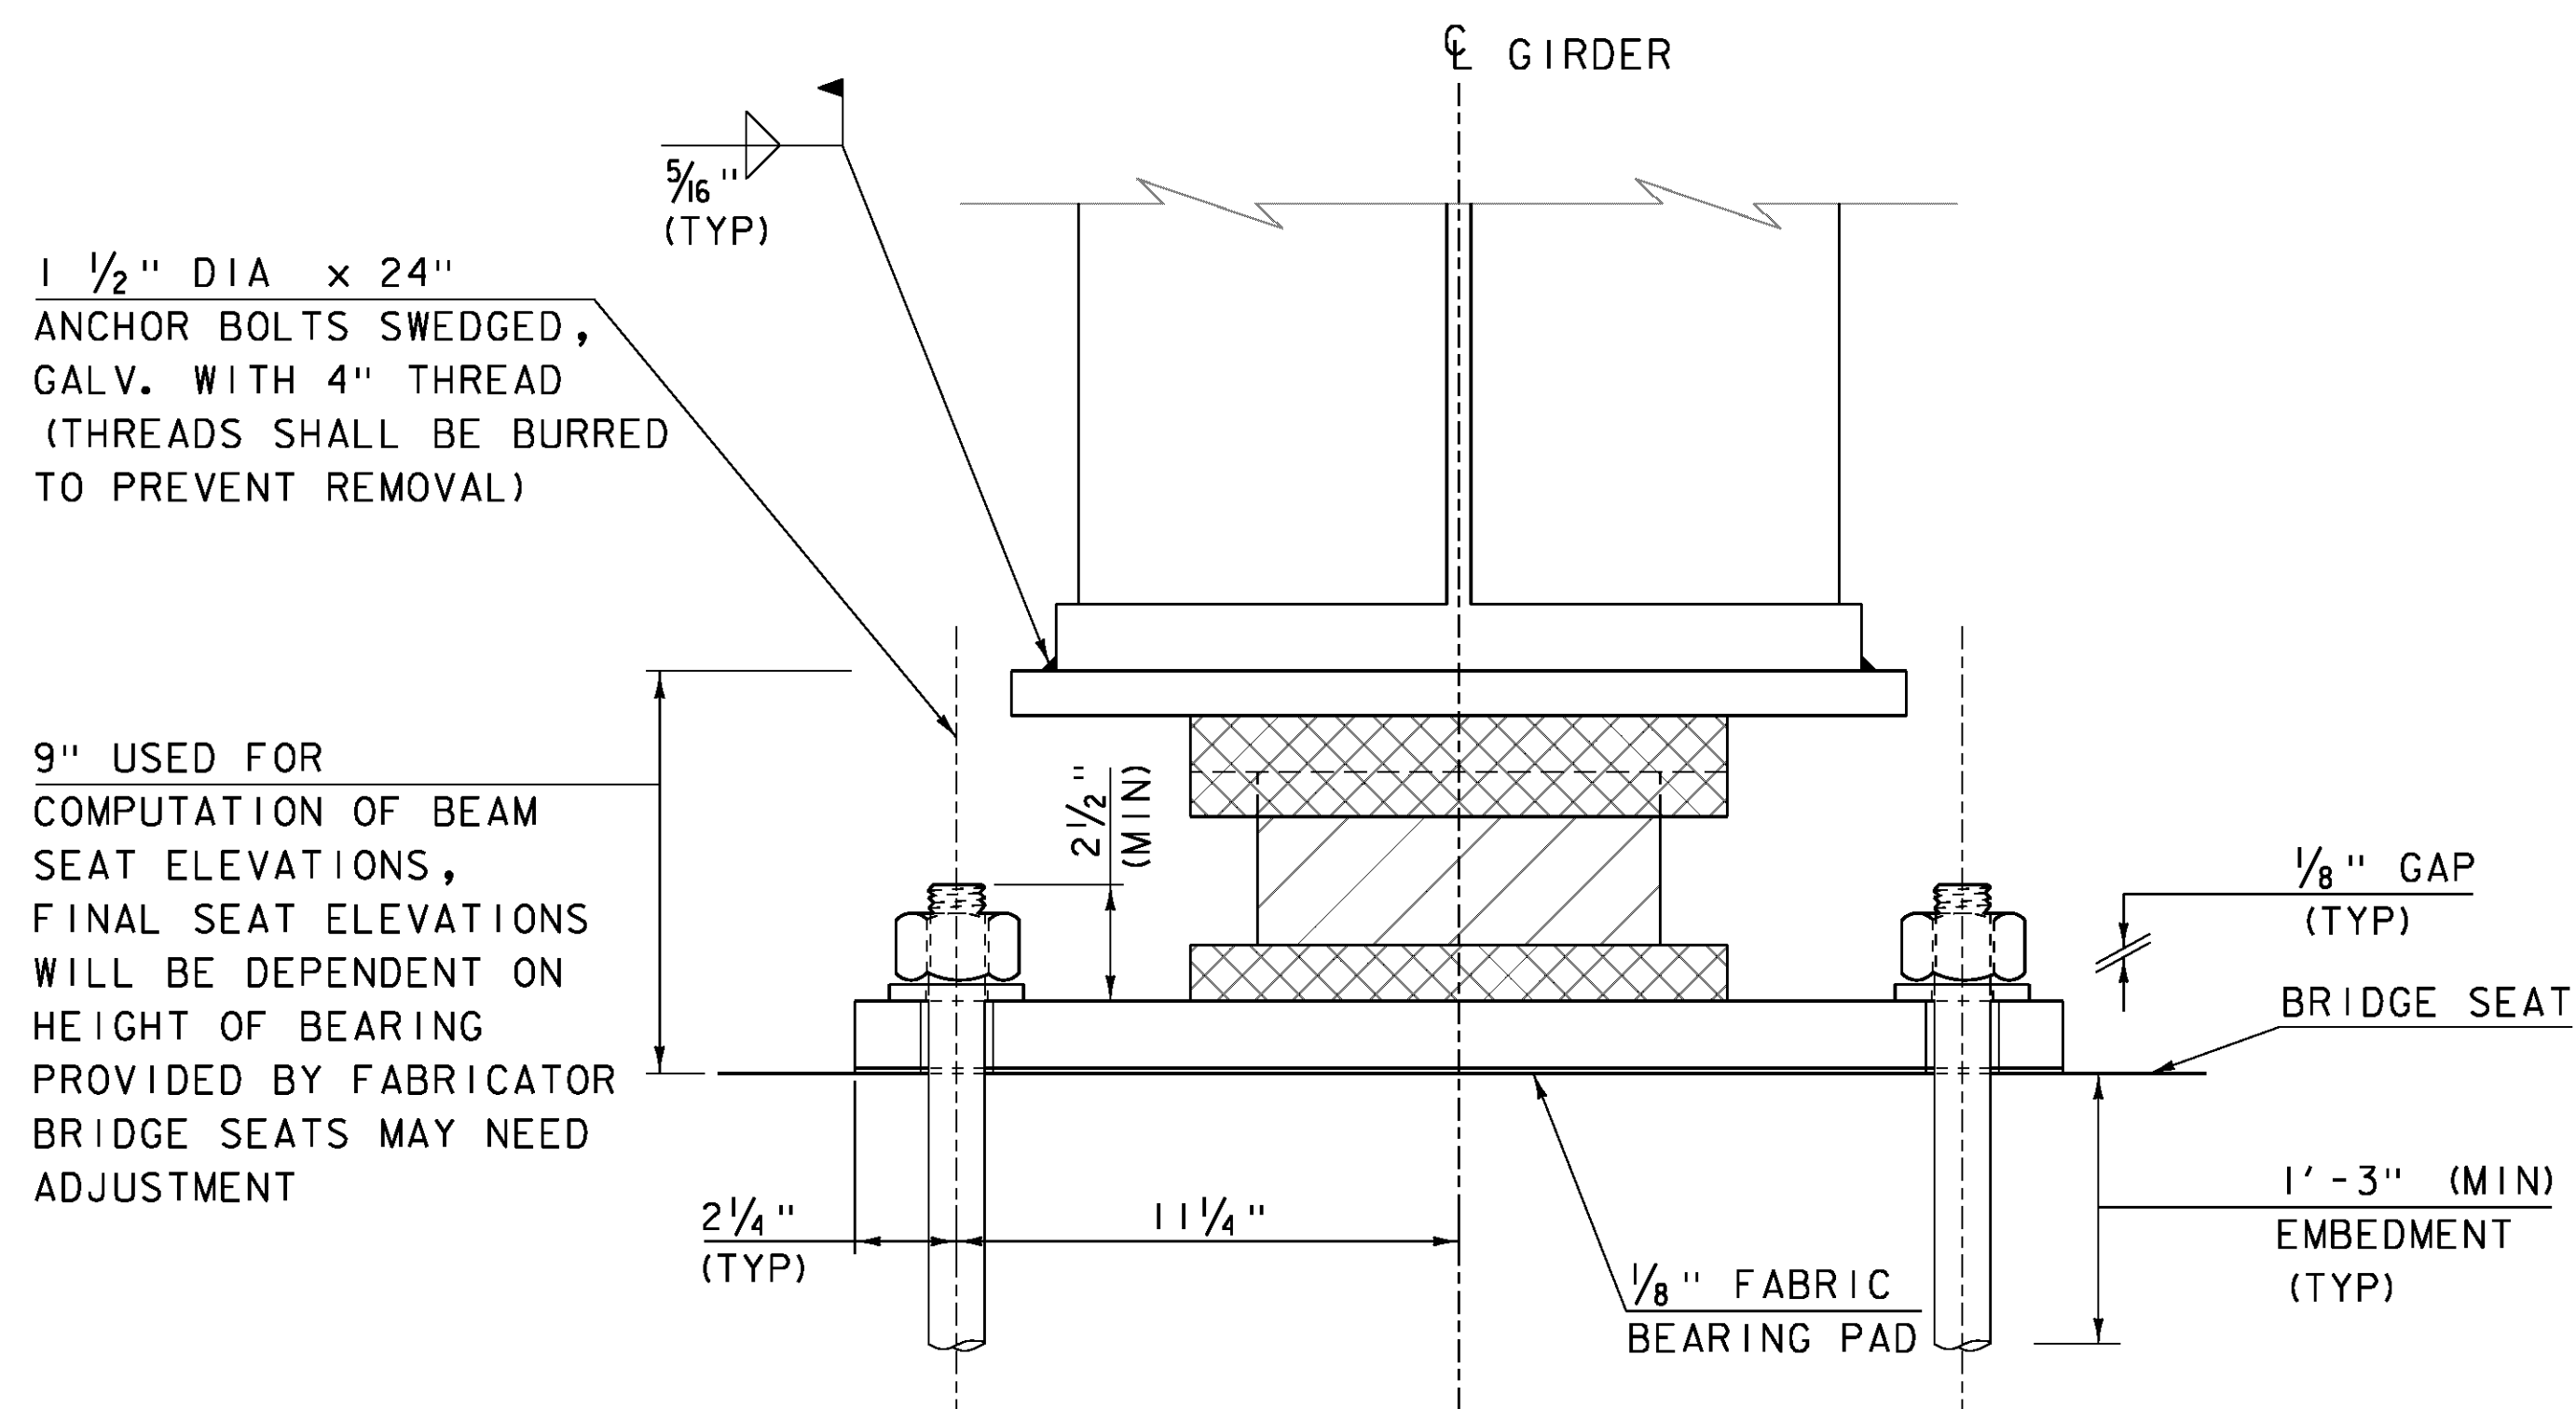


**SECTION A-A**  
SCALE 3"=1'-0"

PROJECT NAME: ROYALTON  
PROJECT NUMBER: BRS 0147 (13)


FILE NAME: \BR 28\86e055brg_28.dgn  
PROJECT LEADER: C. CARLSON  
DESIGNED BY: D. PETERSON  
BRIDGE 28 GUIDED BEARING DETAILS

PLOT DATE: 08-OCT-2013  
DRAWN BY: DZENAN K.  
CHECKED BY: D. PETERSON  
SHEET 118 OF 186

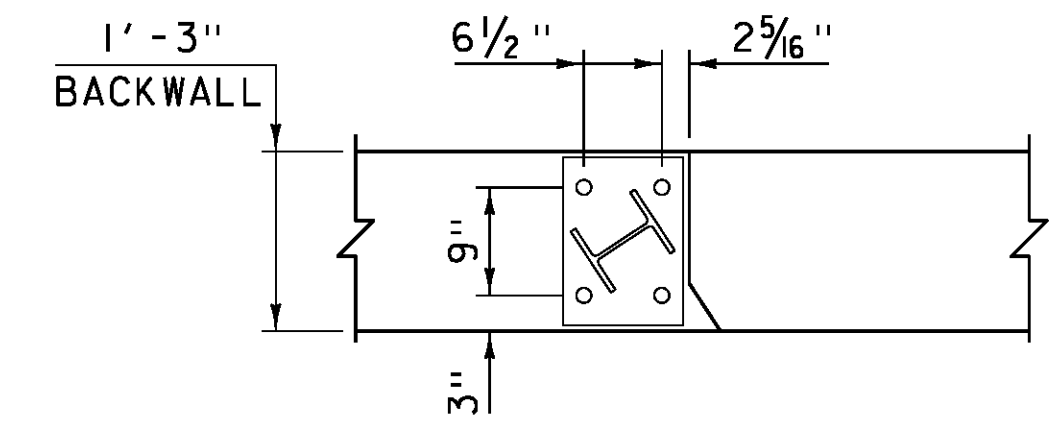

ANCHOR PLATE LOCATION DETAIL


SCALE  $\frac{3}{4}'' = 1'-0''$

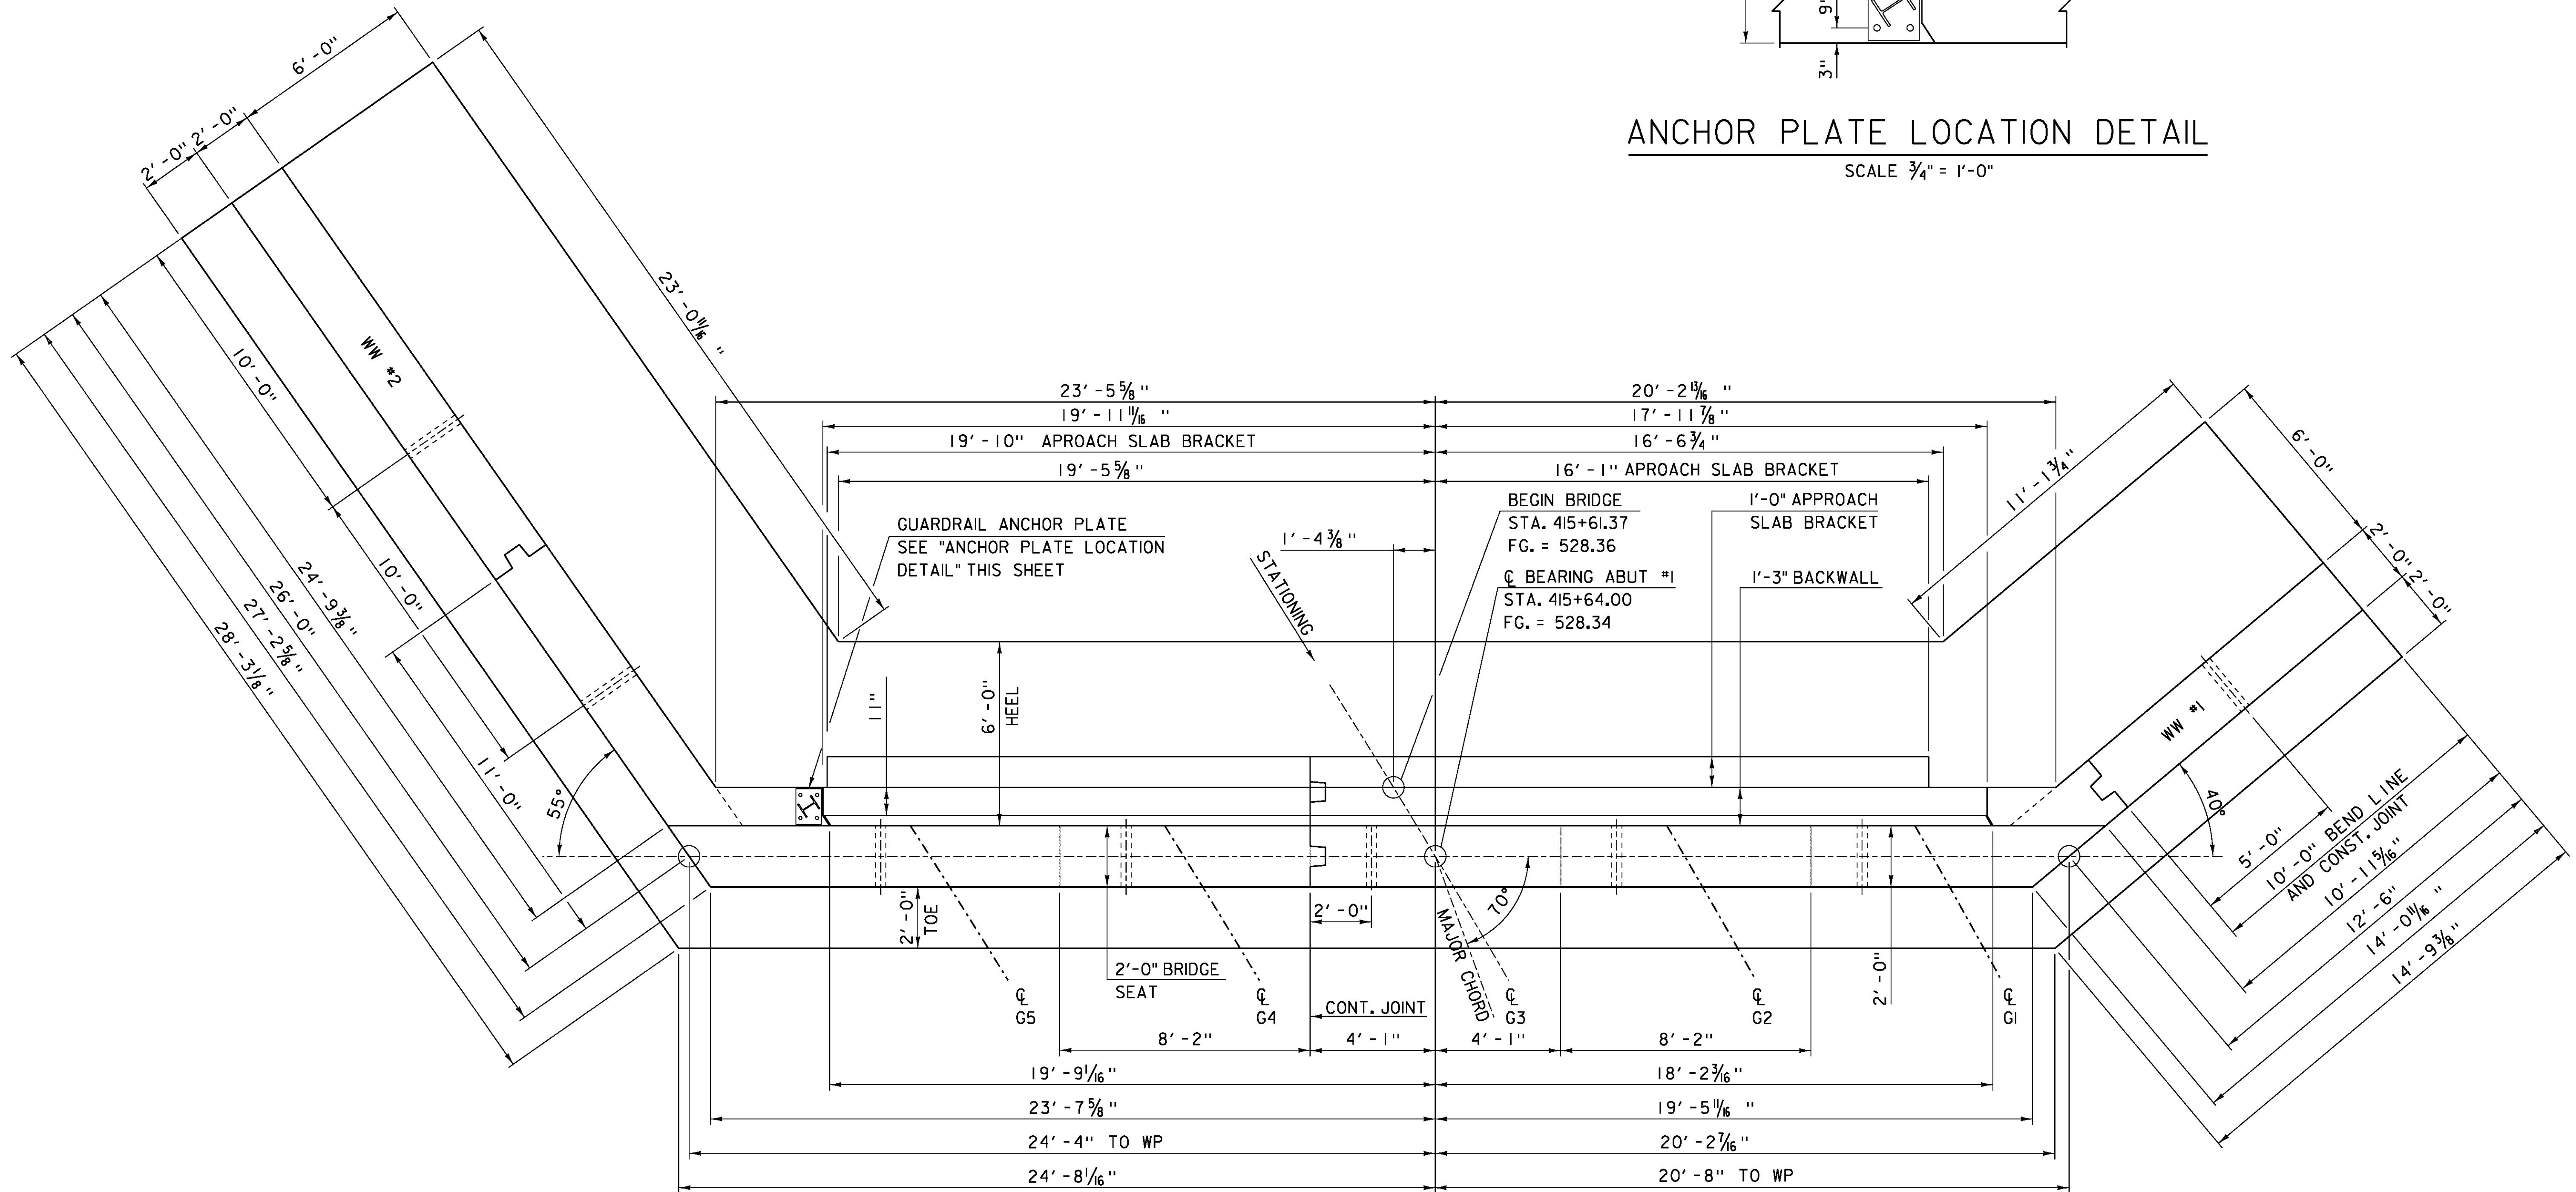

ABUTMENT #1 PLAN


SCALE  $\frac{3}{8}'' = 1'-0''$

PROJECT NAME:	ROYALTON
PROJECT NUMBER:	BRS 0147 (13)
FILE NAME:	86e055/STR/86e055sub.dgn
PROJECT LEADER:	C.CARLSON
DESIGNED BY:	D.PETERSON
BRIDGE 28 ABUTMENT 1 PLAN	
PLOT DATE:	08-OCT-2013
DRAWN BY:	G.ROKES
CHECKED BY:	D.PETERSON
SHEET	119 OF 186

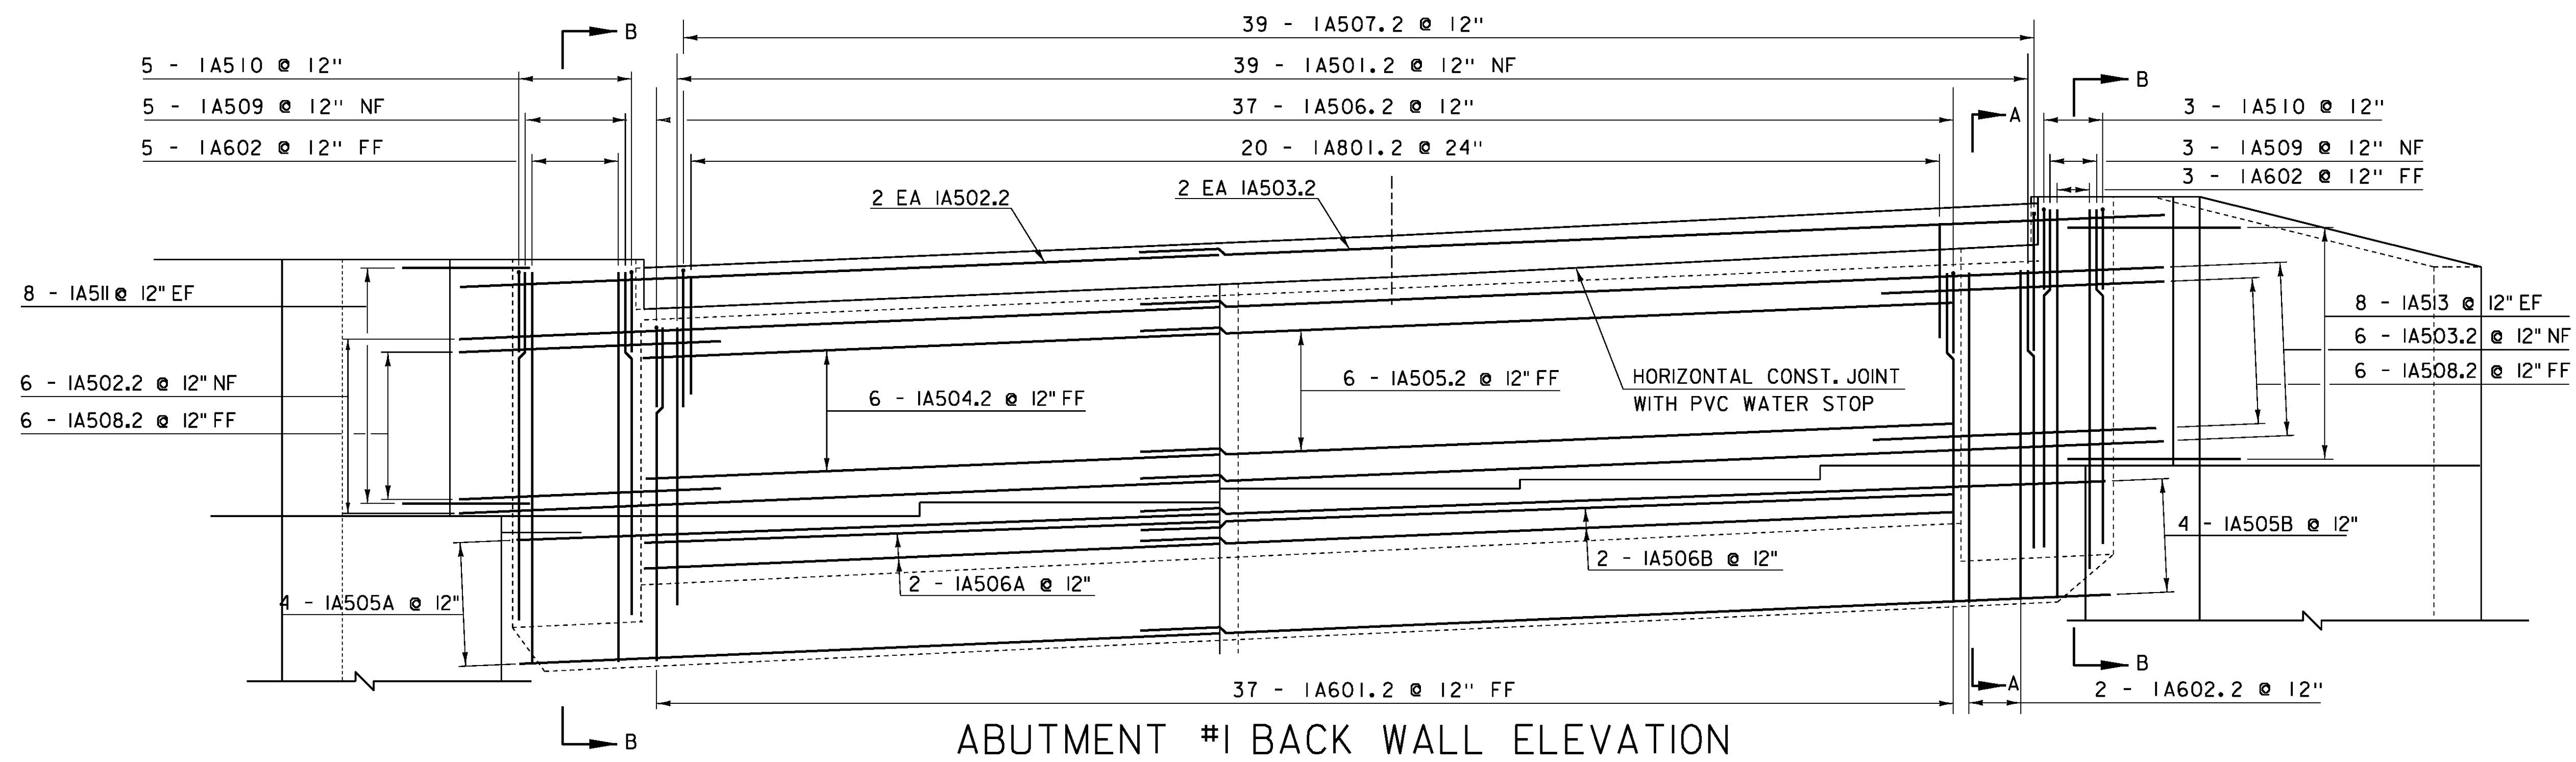

**ABUTMENT #1 BACK WALL ELEVATION**

SCALE  $\frac{3}{8}$ " = 1'-0"

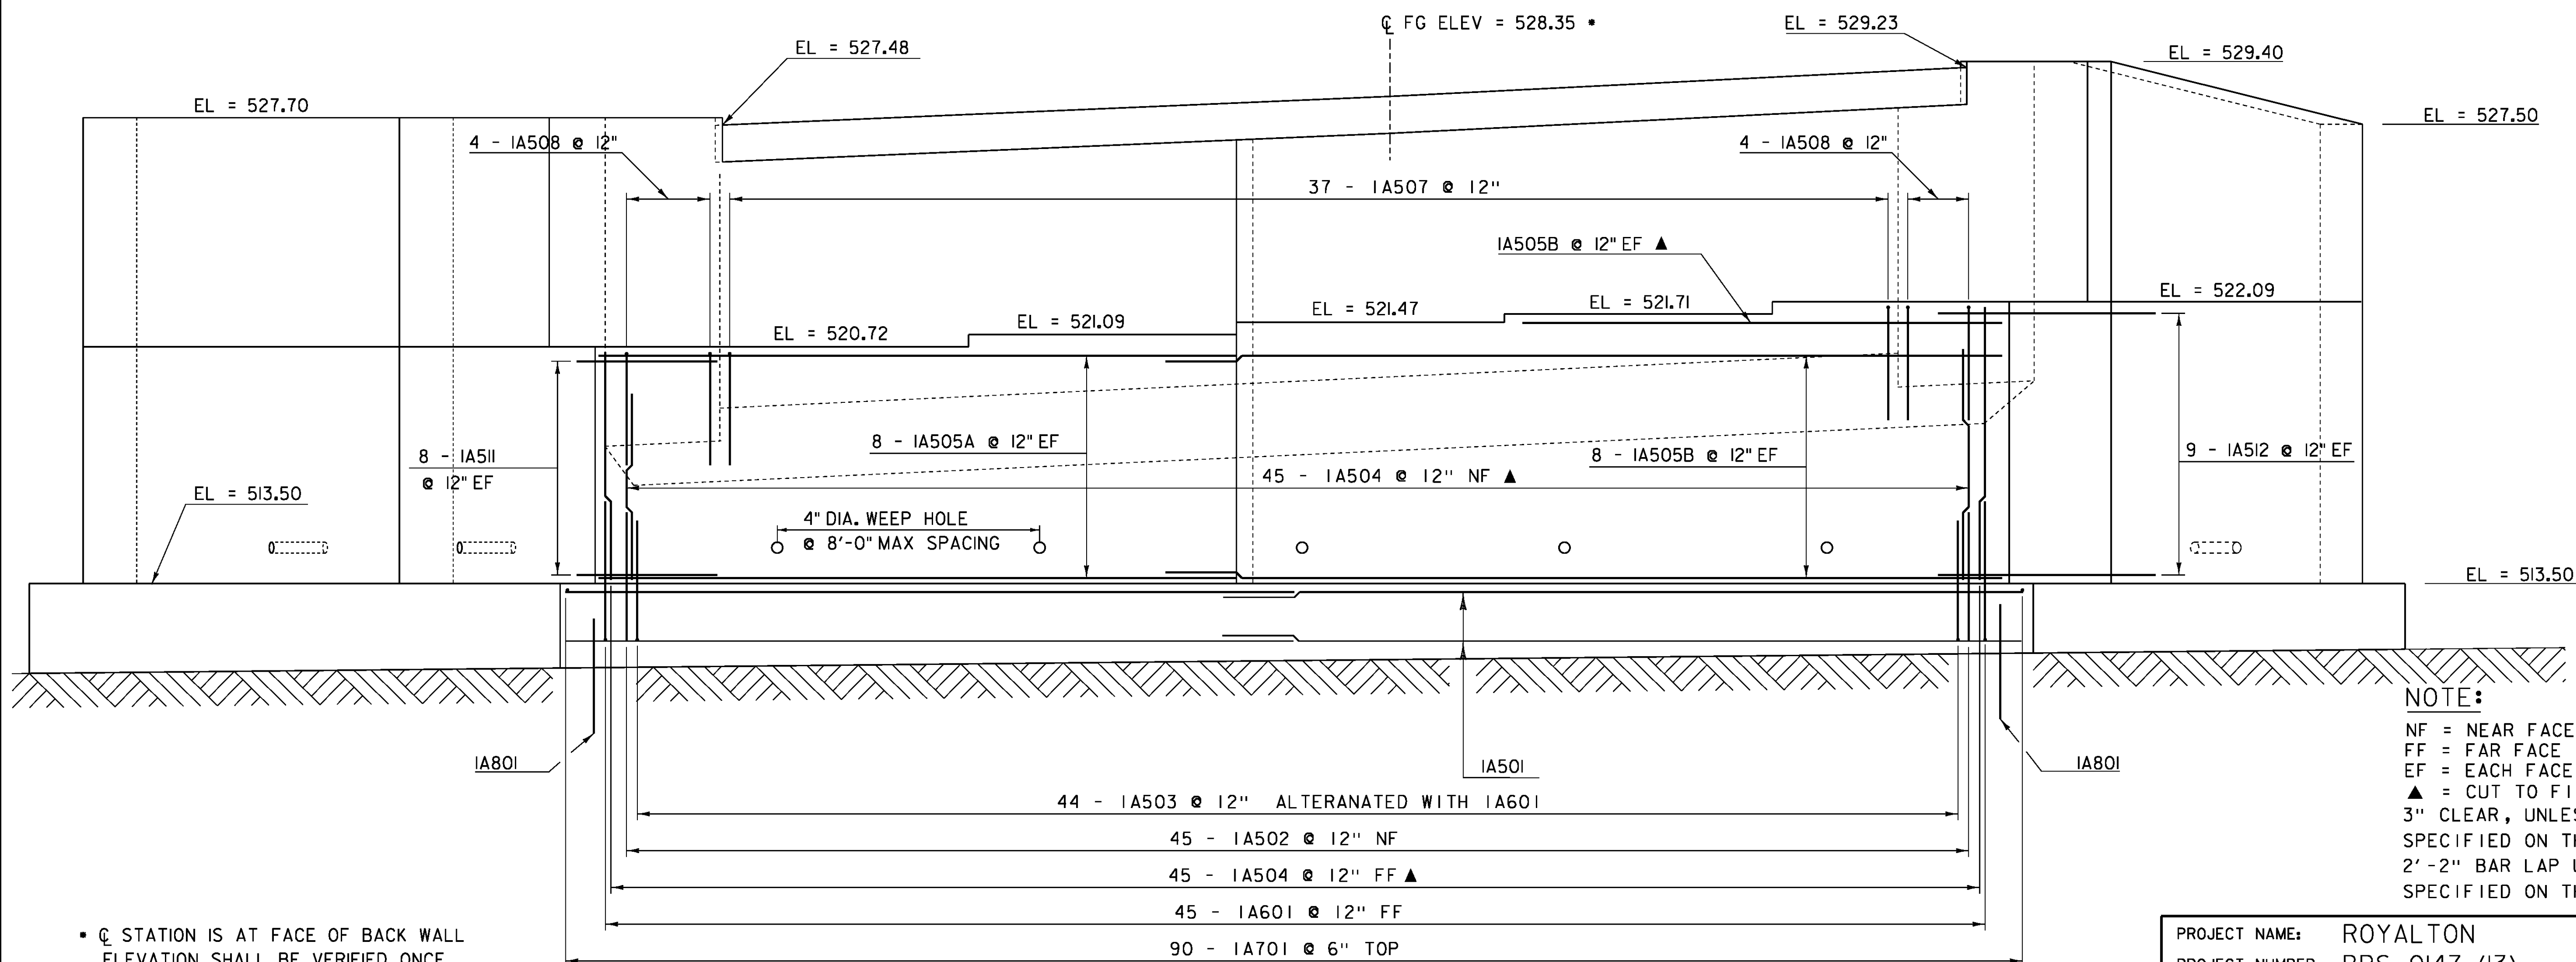

**ABUTMENT #1 ELEVATION**

SCALE  $\frac{3}{8}$ " = 1'-0"

• C STATION IS AT FACE OF BACK WALL  
ELEVATION SHALL BE VERIFIED ONCE  
EXPANSION JOINT AND BRIDGE DECK ARE  
PLACED.


**NOTE:**

NF = NEAR FACE  
FF = FAR FACE  
EF = EACH FACE  
▲ = CUT TO FIT IN FIELD  
3" CLEAR, UNLESS OTHERWISE  
SPECIFIED ON THE PLANS.  
2'-2" BAR LAP UNLESS OTHERWISE  
SPECIFIED ON THE PLANS.

PROJECT NAME: ROYALTON  
PROJECT NUMBER: BRS 0147 (13)


FILE NAME: 86e055/STR/86e055sub.dgn PLOT DATE: 08-OCT-2013  
PROJECT LEADER: C.CARLSON DRAWN BY: G.ROKES  
DESIGNED BY: D.PETERSON CHECKED BY: D.PETERSON  
BRIDGE 28 ABUTMENT 1 ELEVATION SHEET 120 OF 186



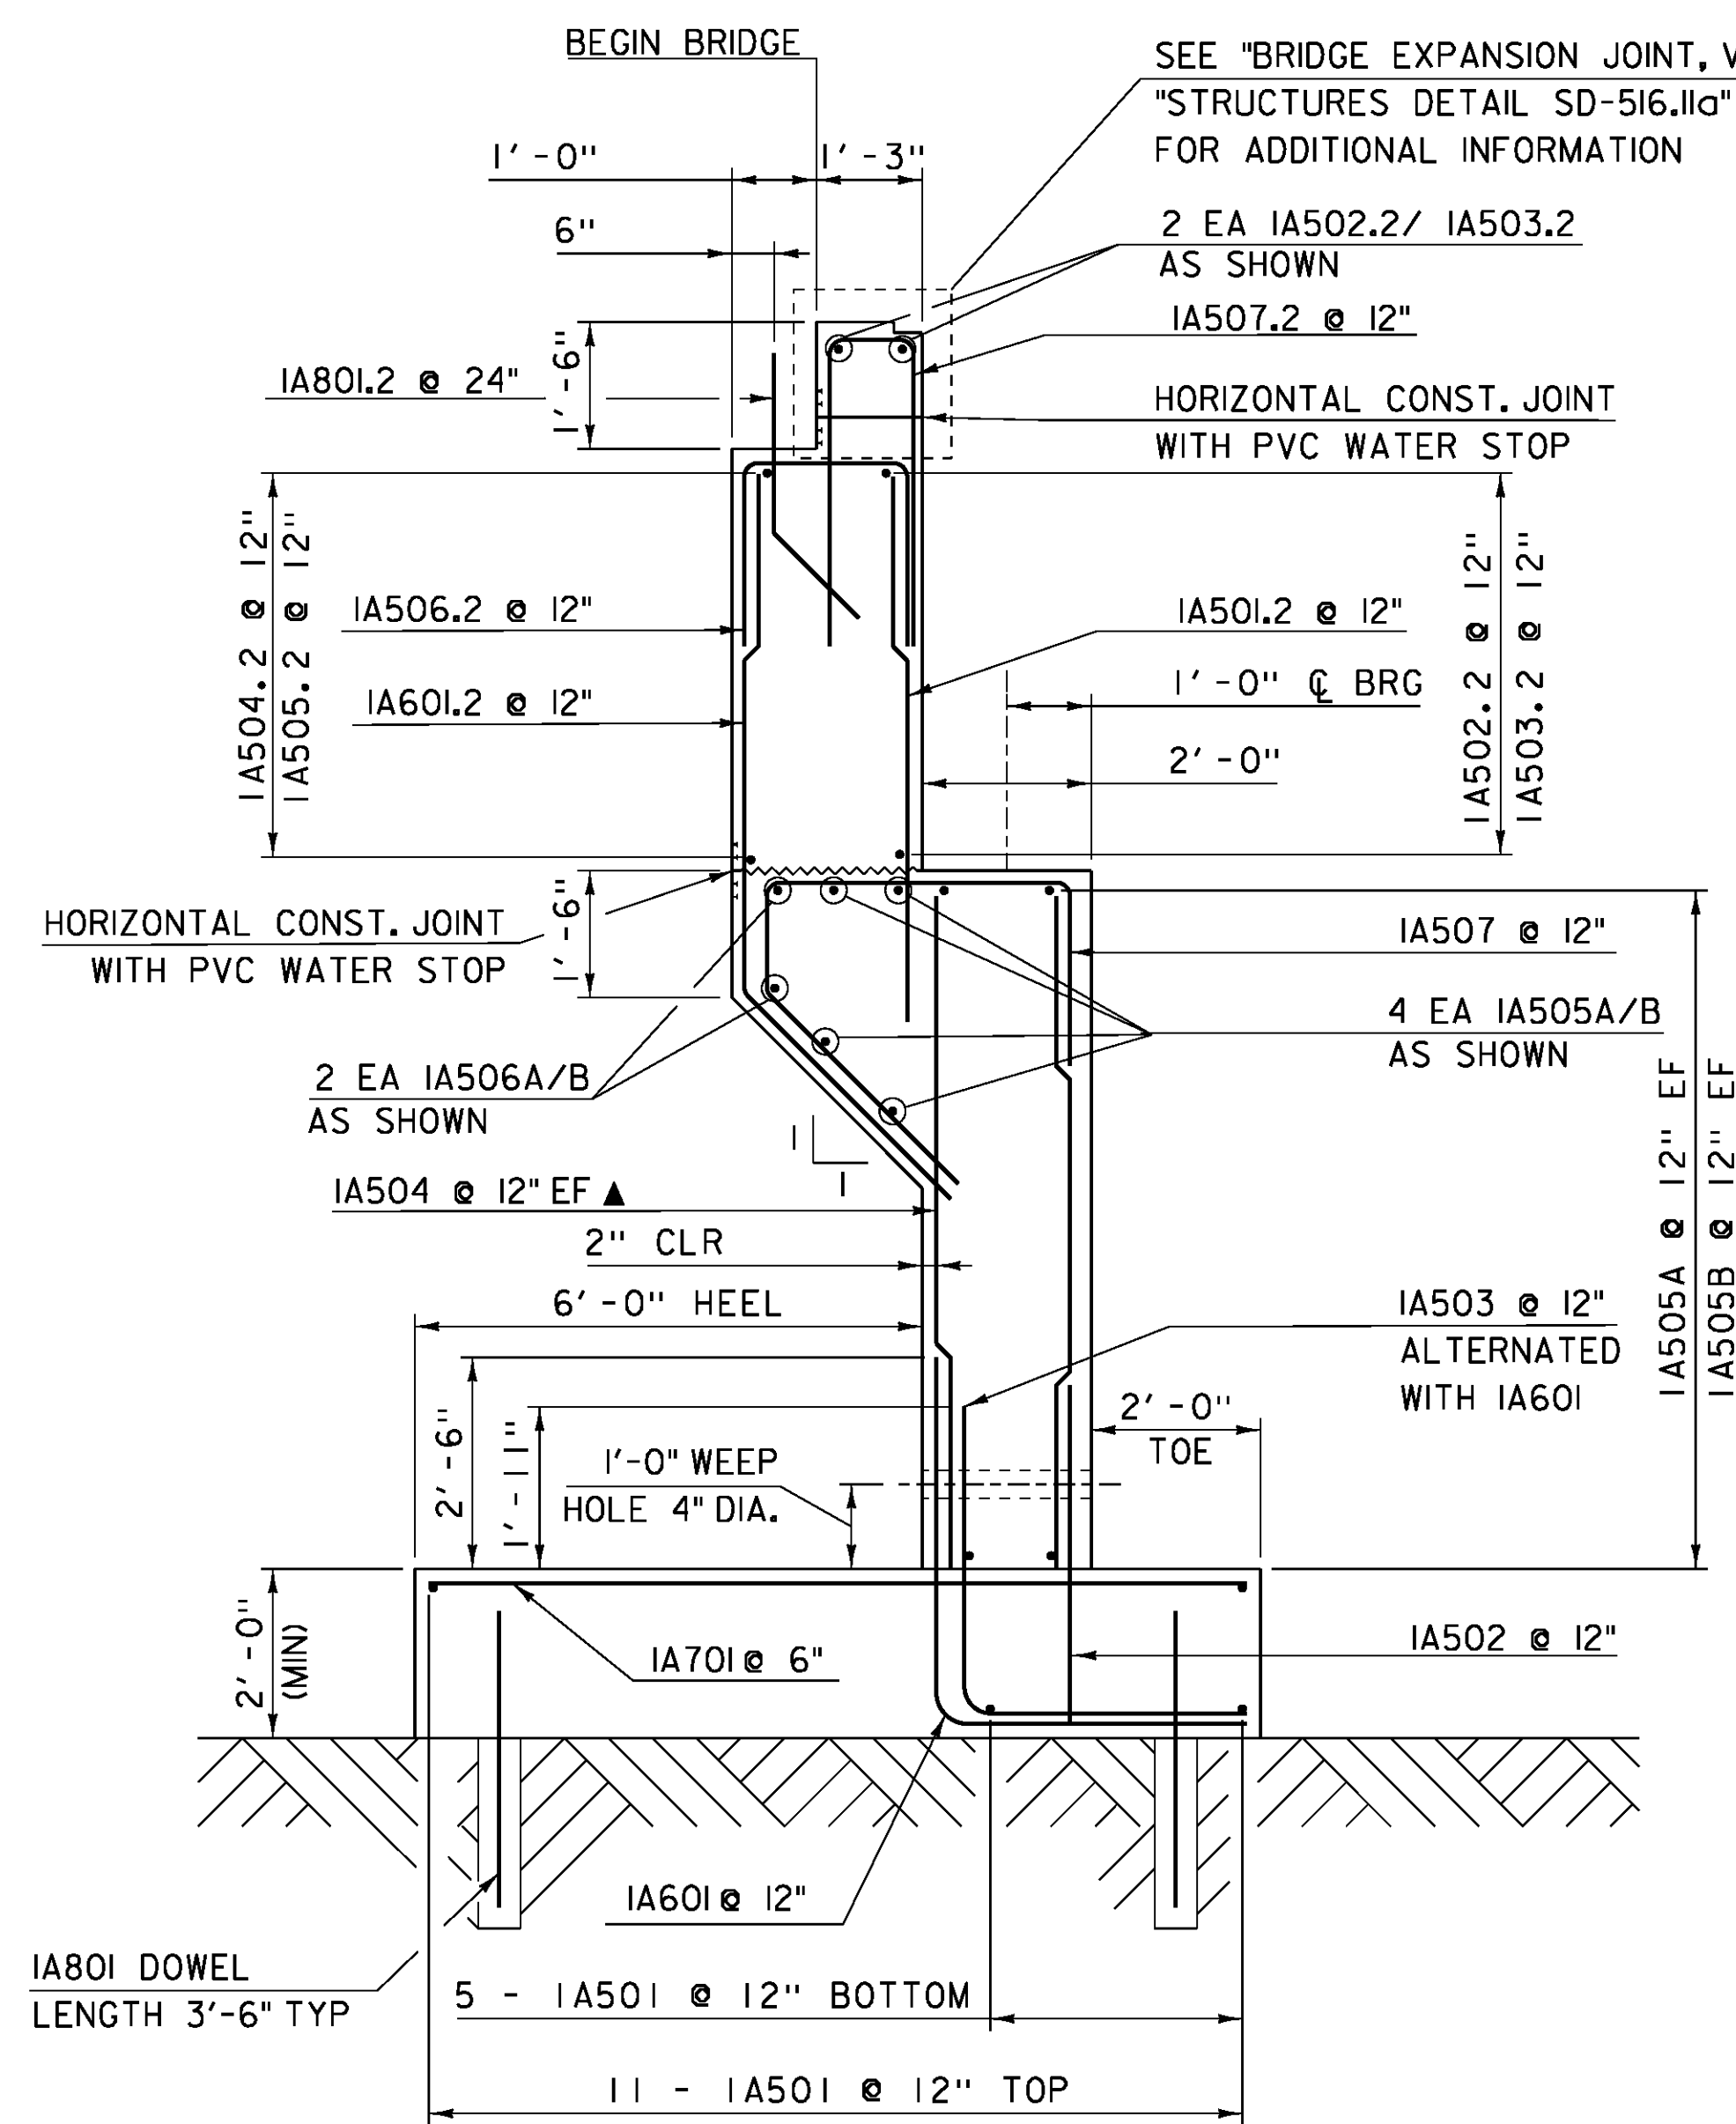


ABUTMENT #1 TYPICAL

SCALE 1/2" = 1'-0"

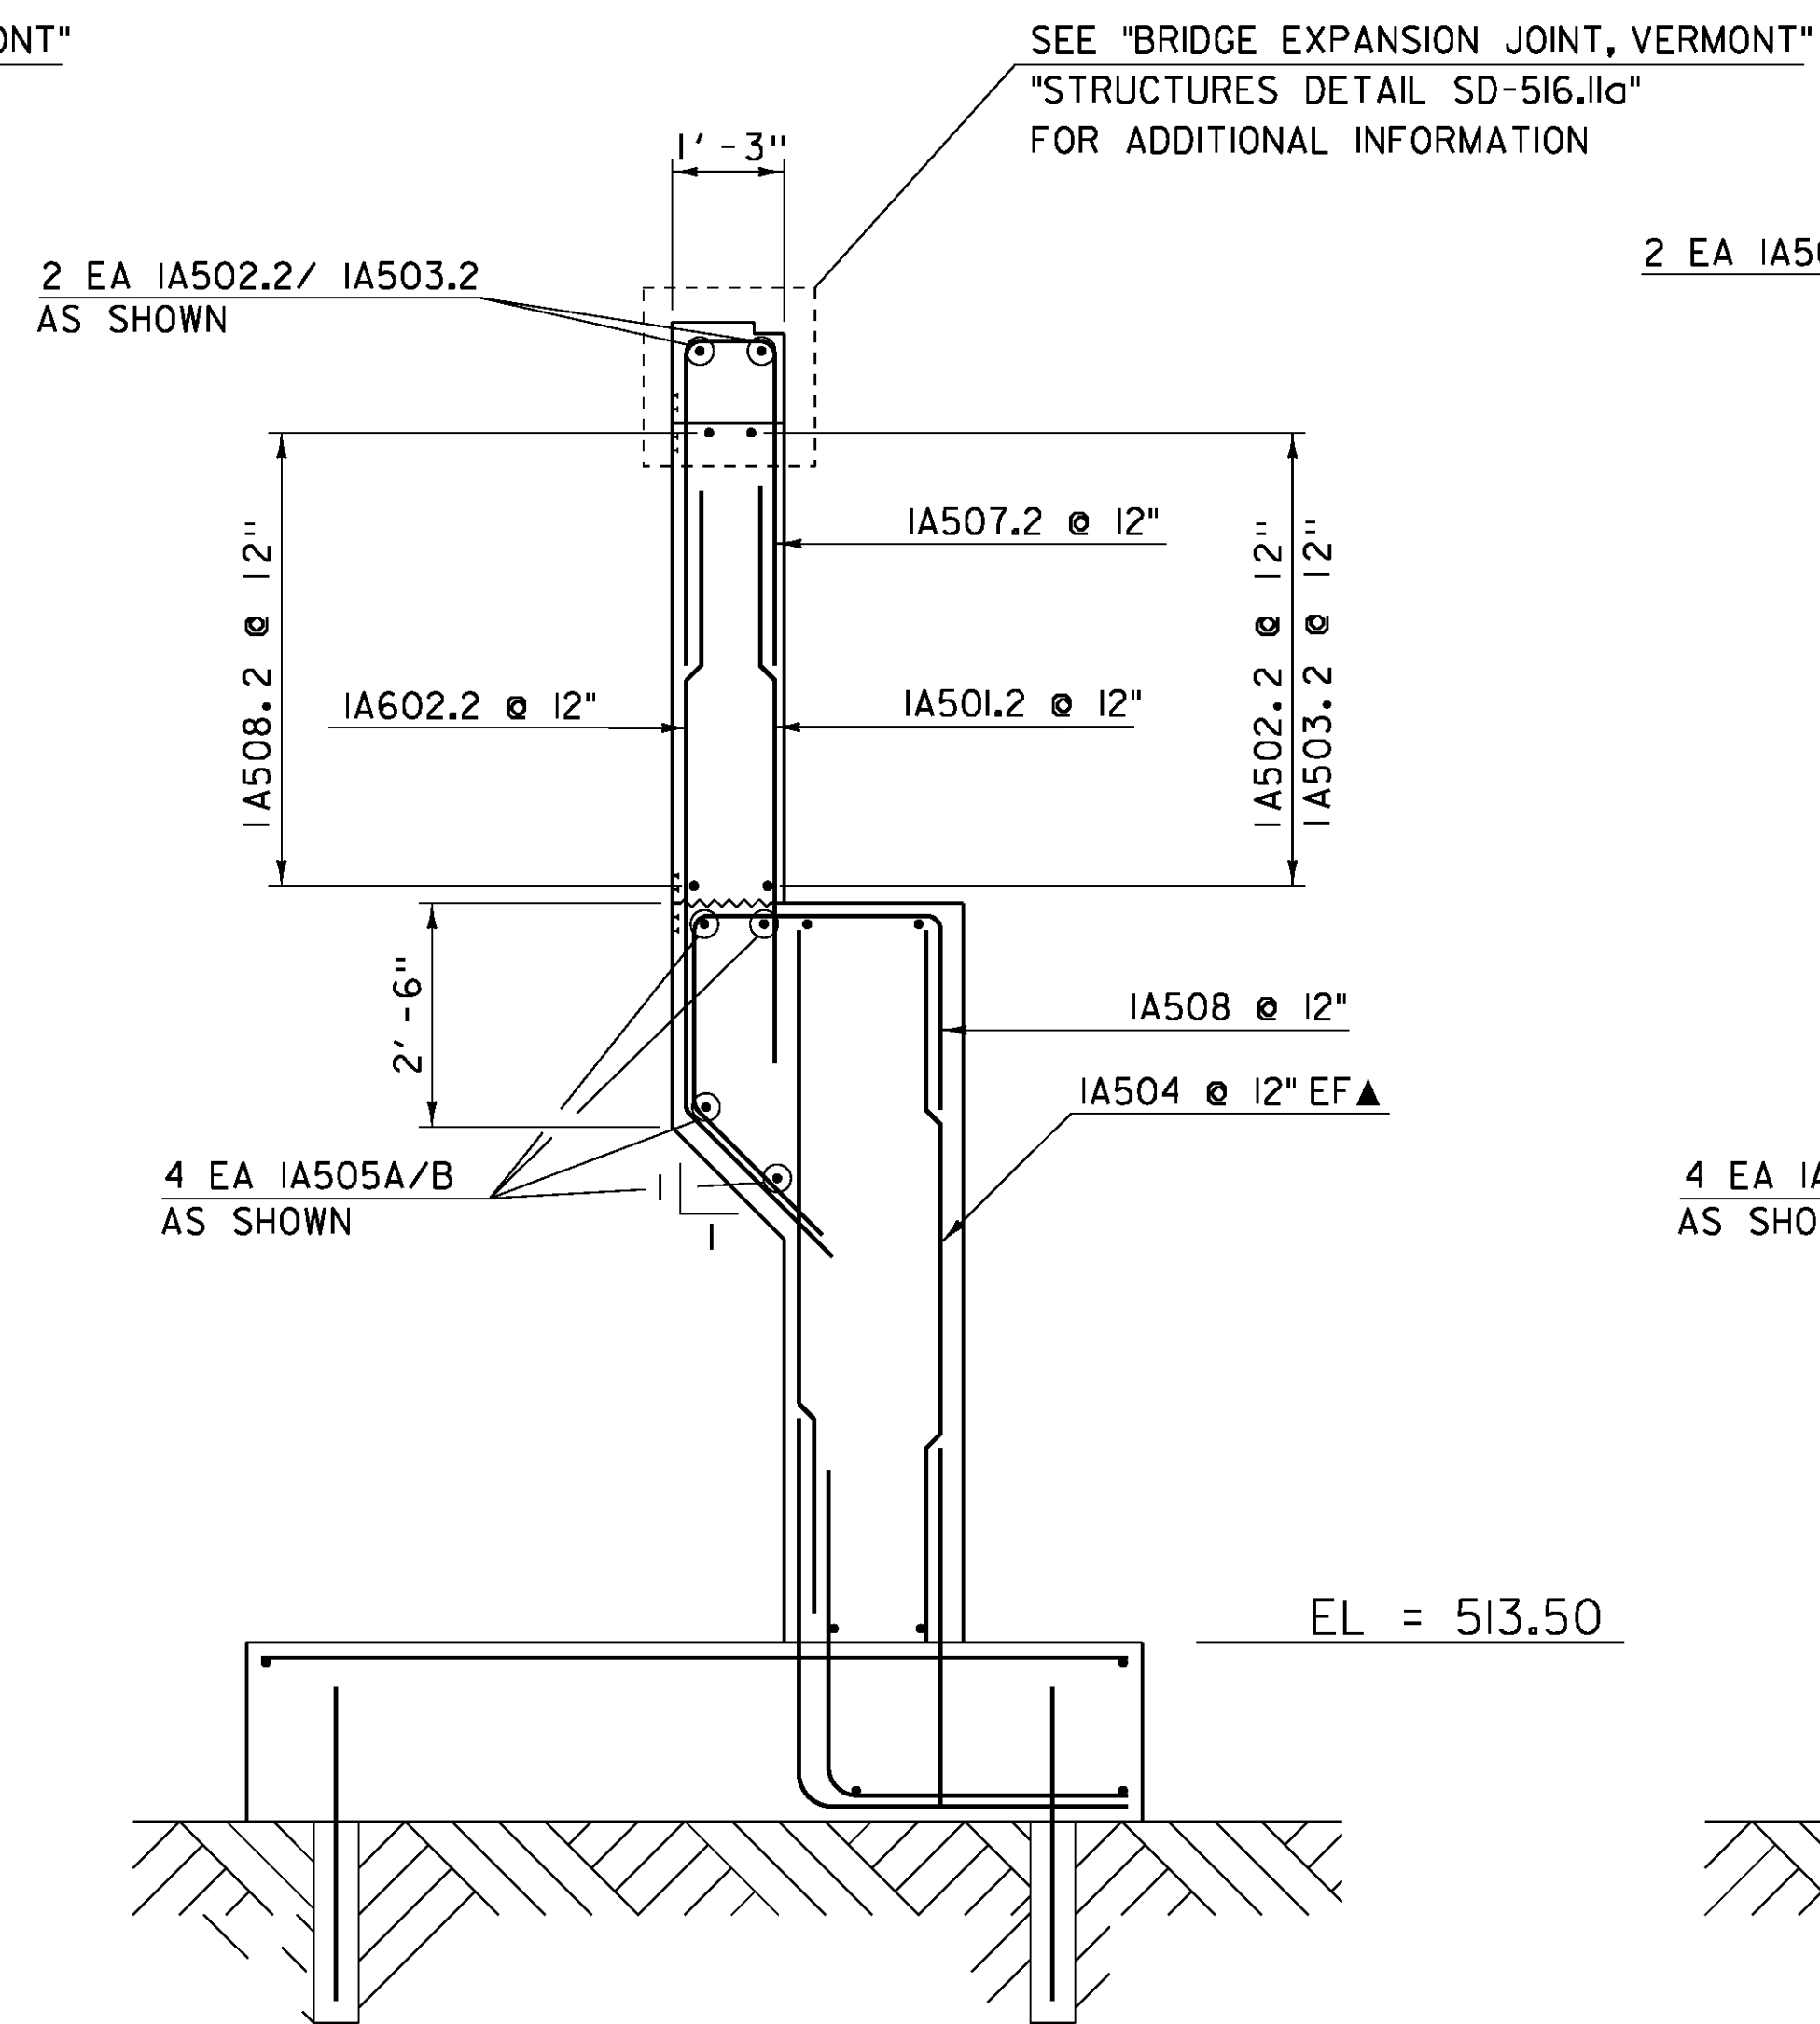

A-A SECTION ABUTMENT #1

SCALE 1/2" = 1'-0"

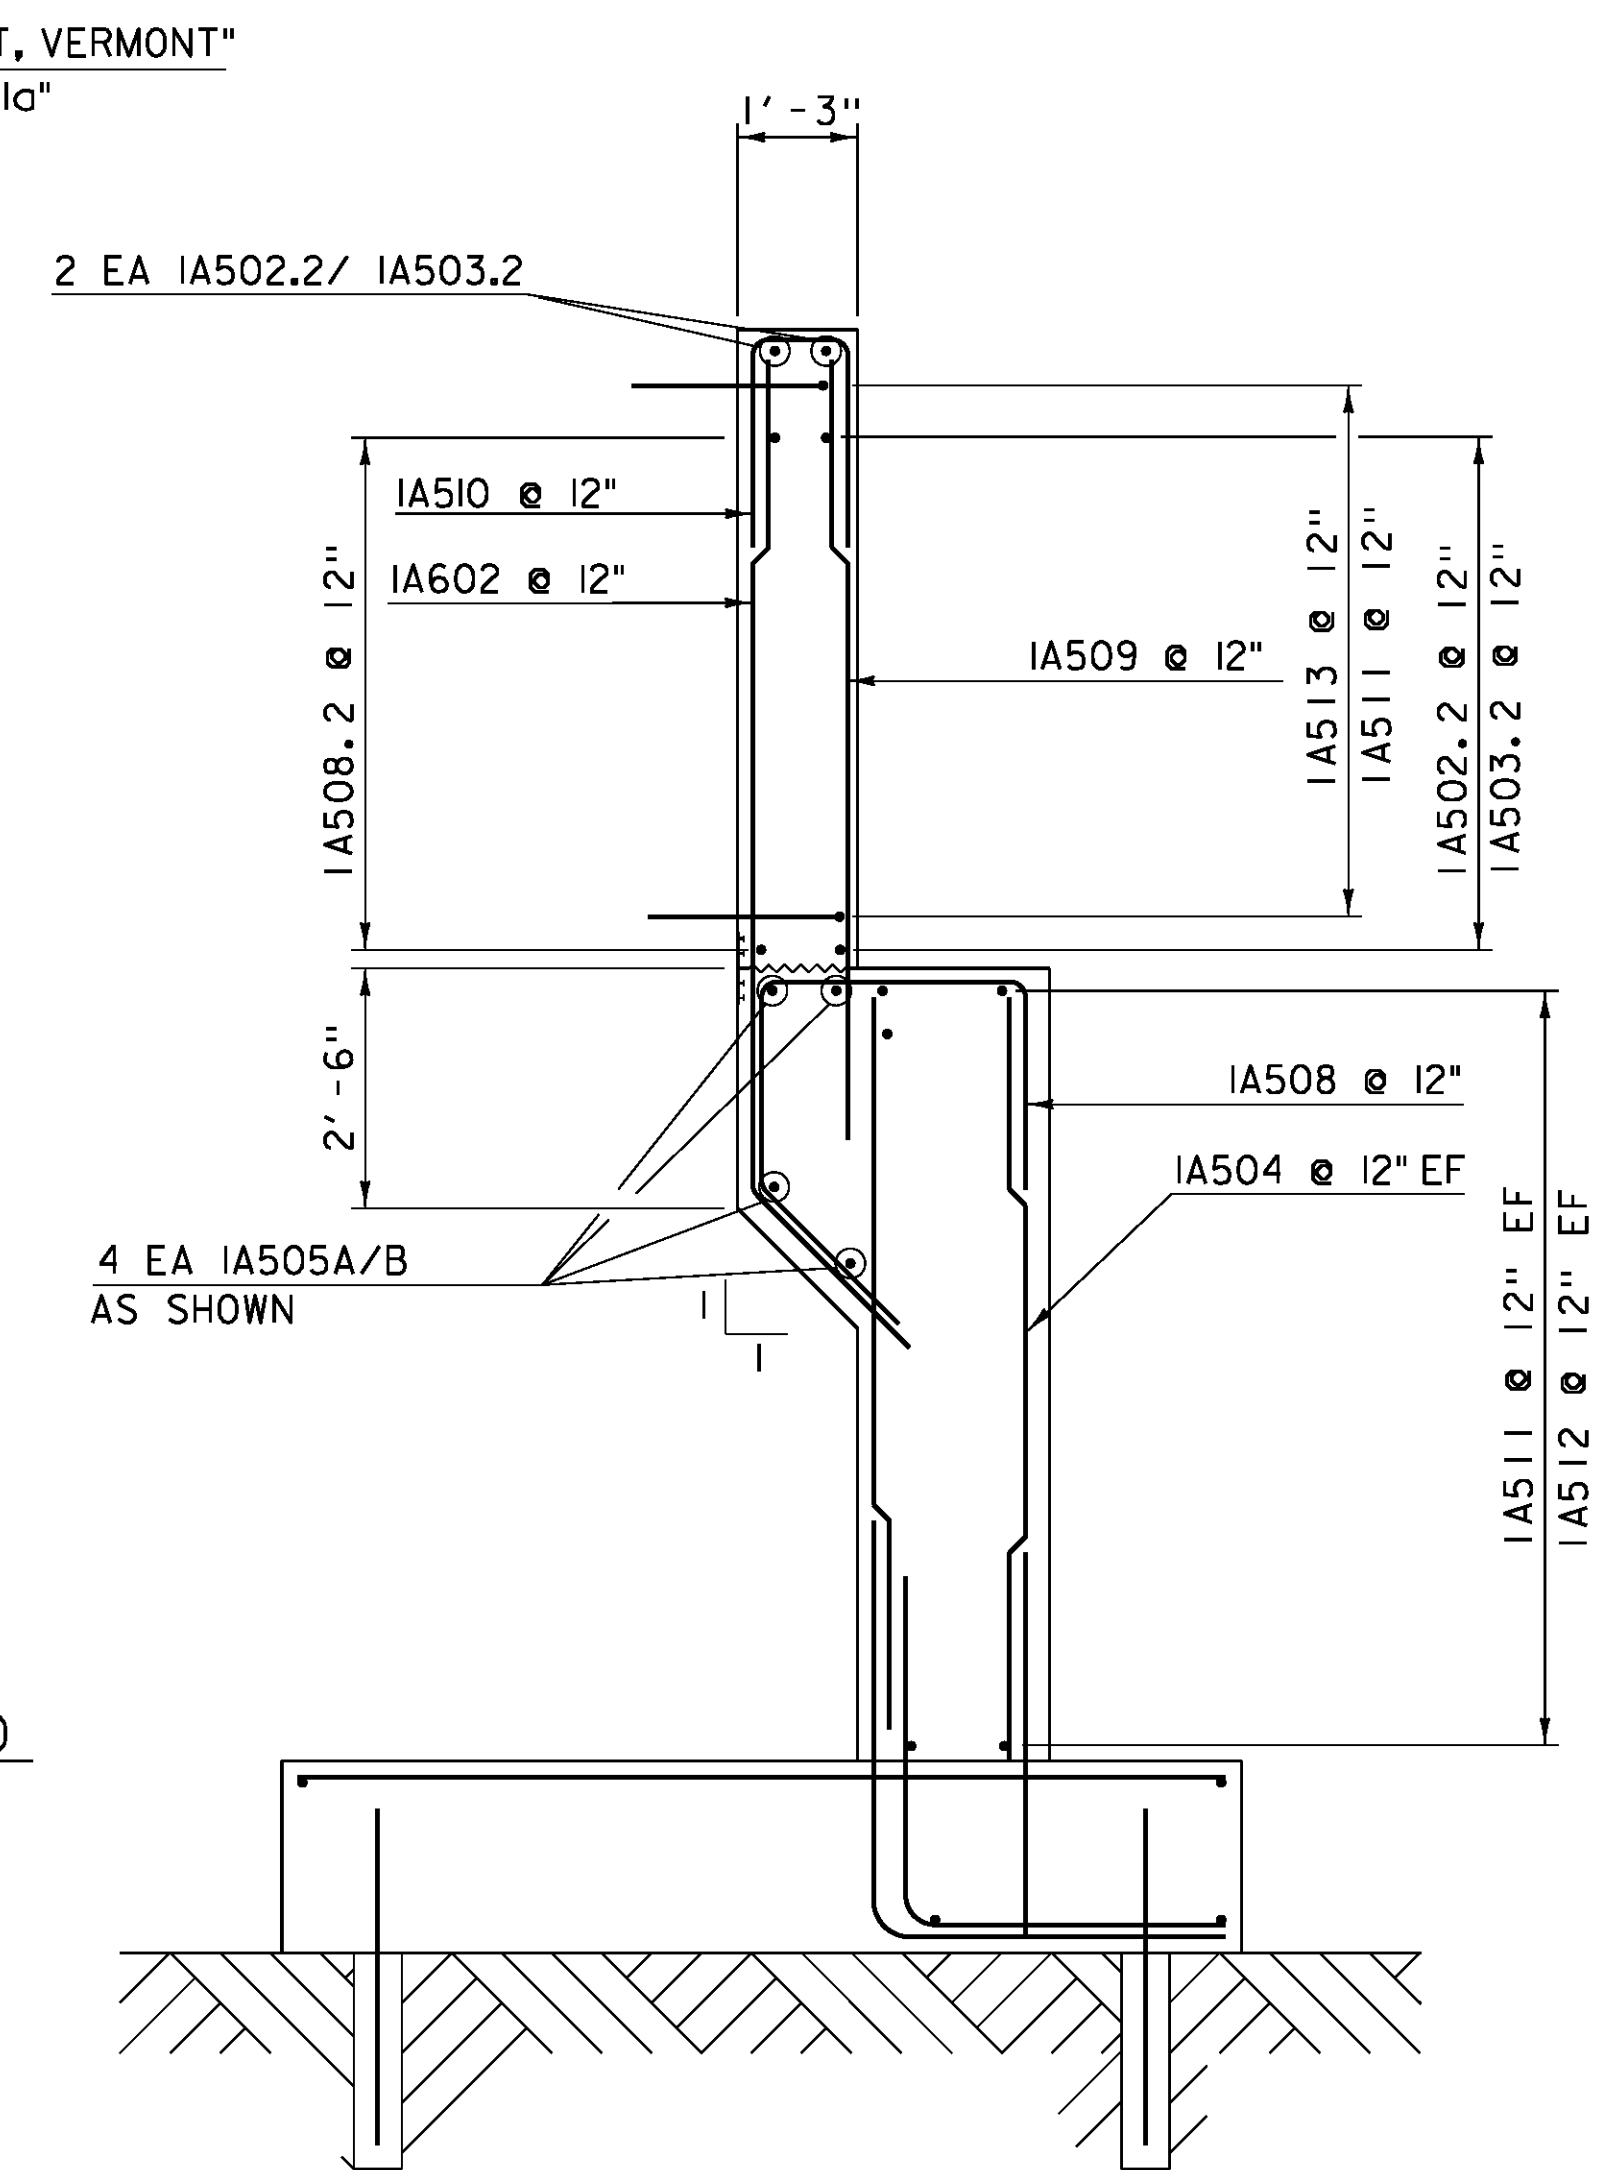

B-B SECTION ABUTMENT #1

SCALE 1/2" = 1'-0"


NOTE:

- NF = NEAR FACE
- FF = FAR FACE
- EF = EACH FACE
- ▲ = CUT TO FIT IN FIELD
- 3" CLEAR, UNLESS OTHERWISE SPECIFIED ON THE PLANS.
- 2' - 2" BAR LAP UNLESS OTHERWISE SPECIFIED ON THE PLANS.

PROJECT NAME: ROYALTON  
PROJECT NUMBER: BRS 0147 (13)


FILE NAME: 86e055/STR/86e055sub.dgn  
PROJECT LEADER: C.CARLSON  
DESIGNED BY: D.PETERSON  
BRIDGE 28 ABUTMENT 1 TYPICAL

PLOT DATE: 08-OCT-2013  
DRAWN BY: G.ROKES  
CHECKED BY: D.PETERSON  
SHEET 121 OF 186

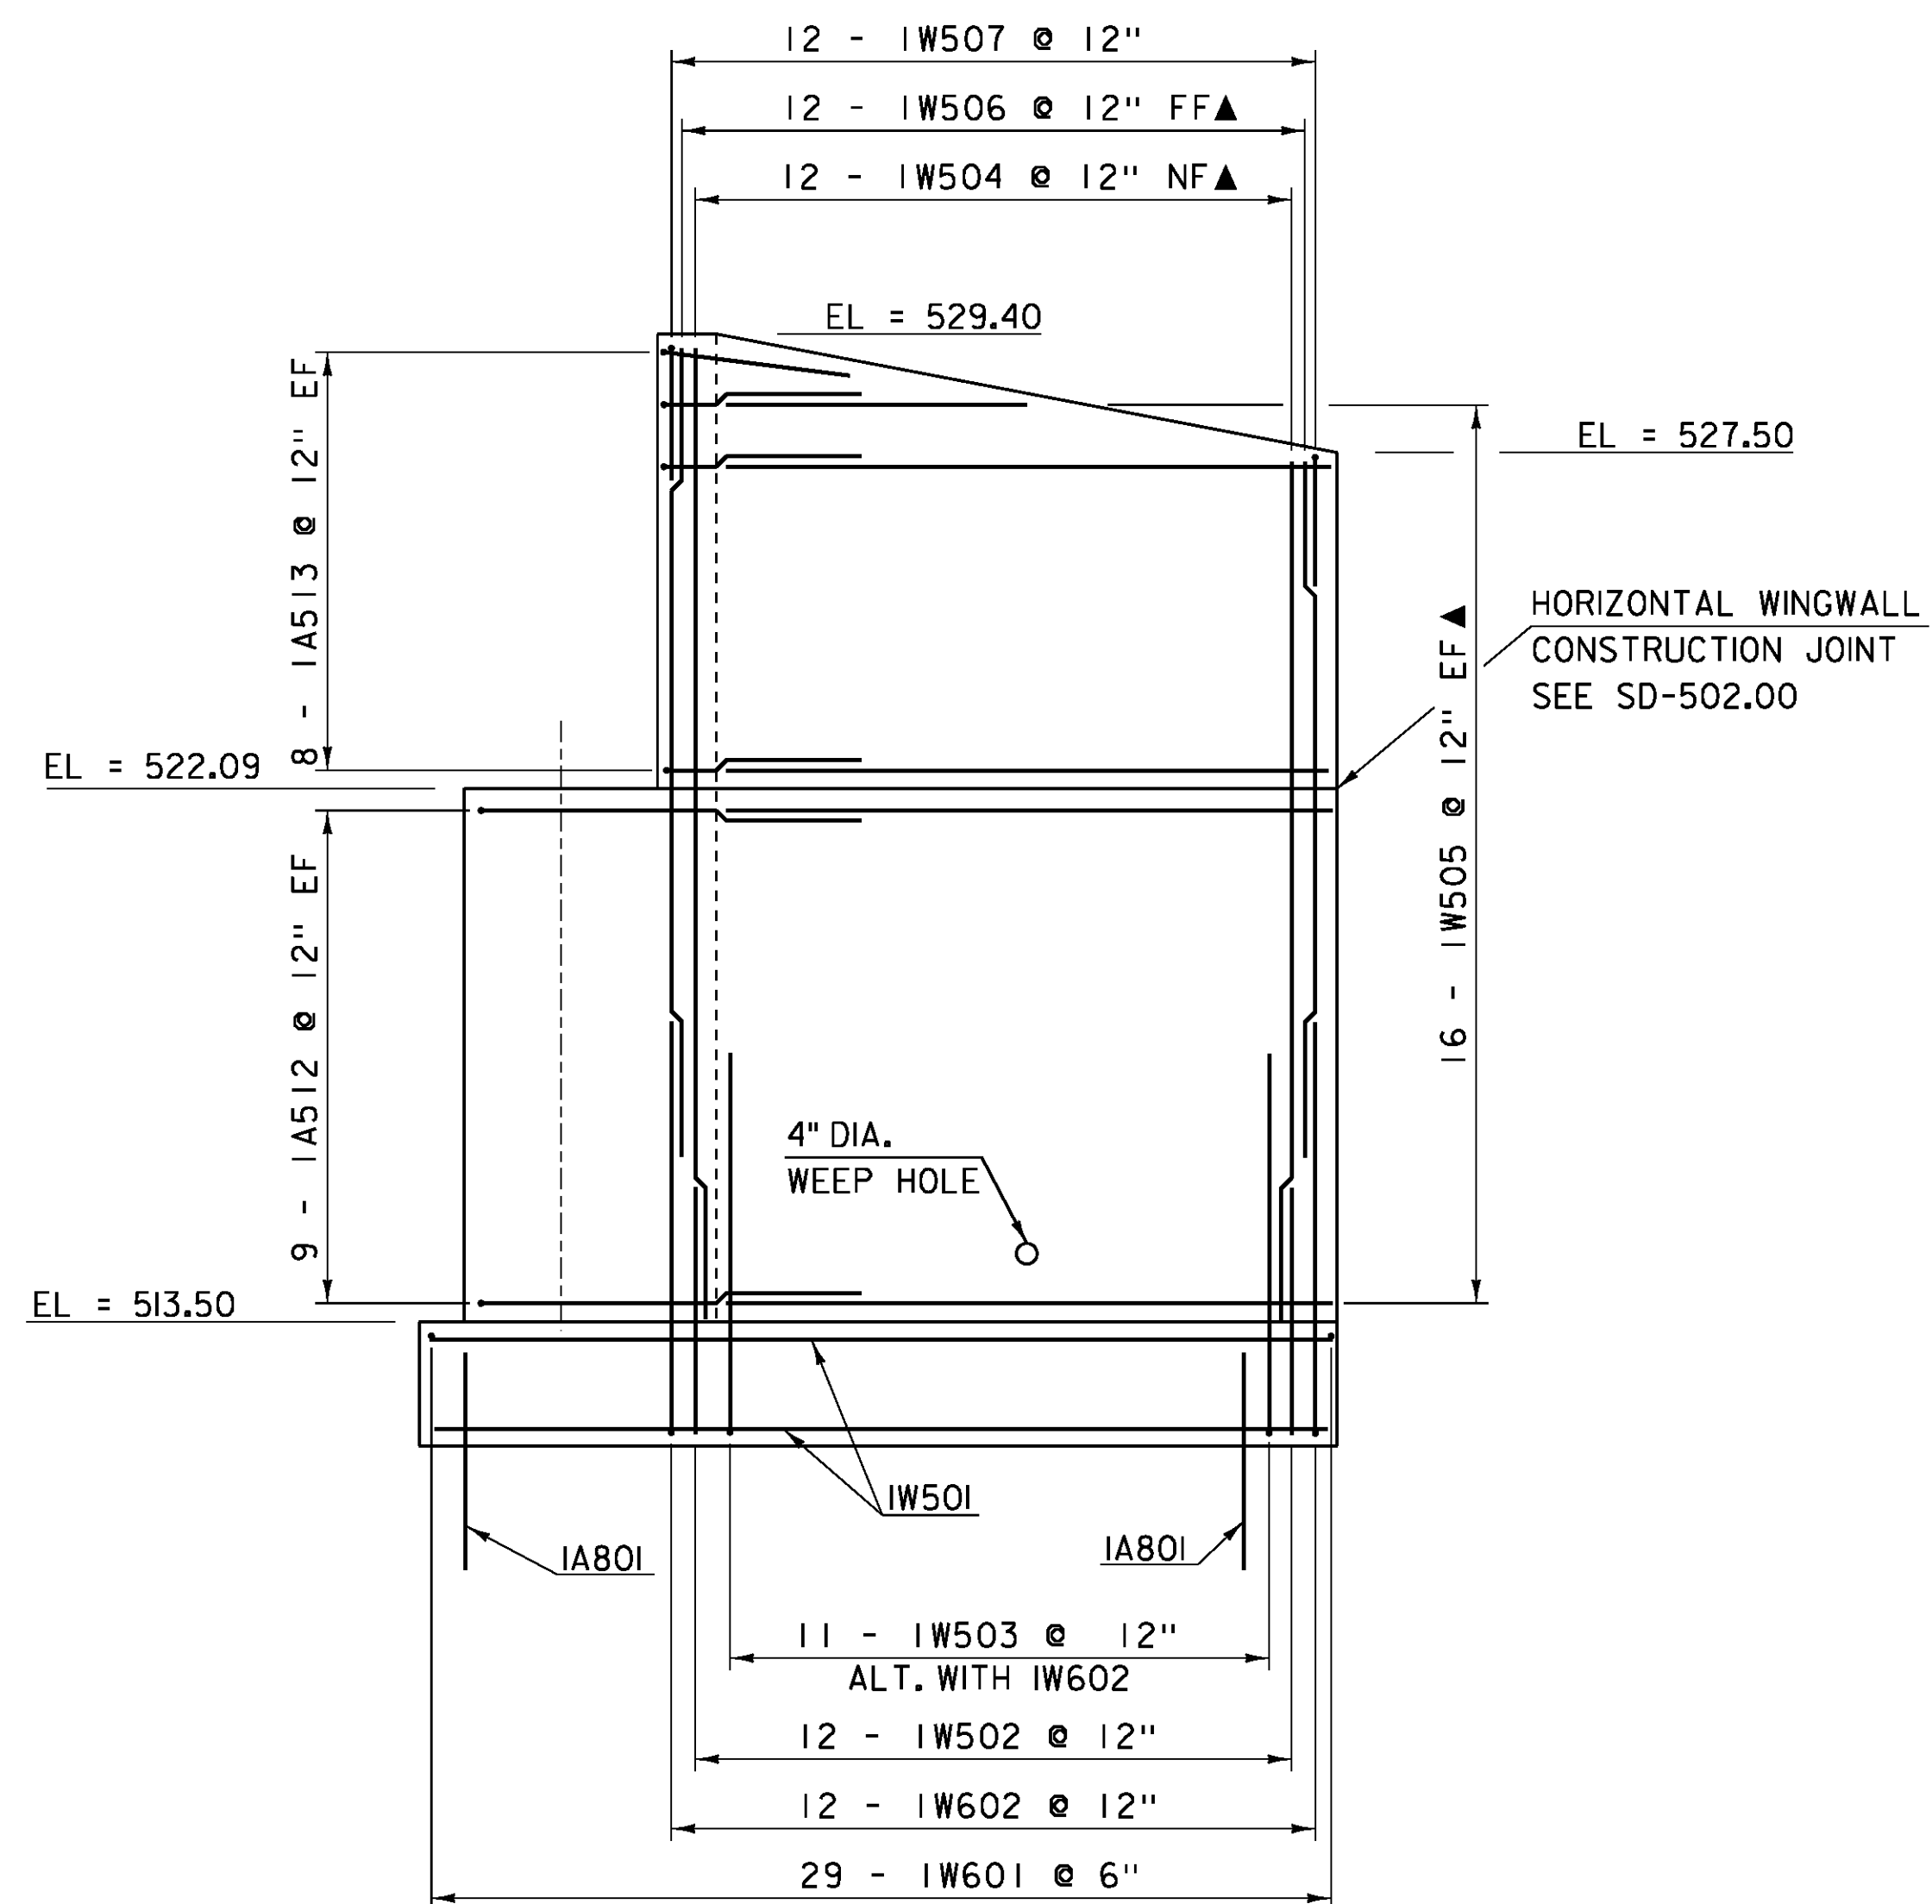

WINGWALL #1 ELEVATION

SCALE 3/8" = 1'-0"

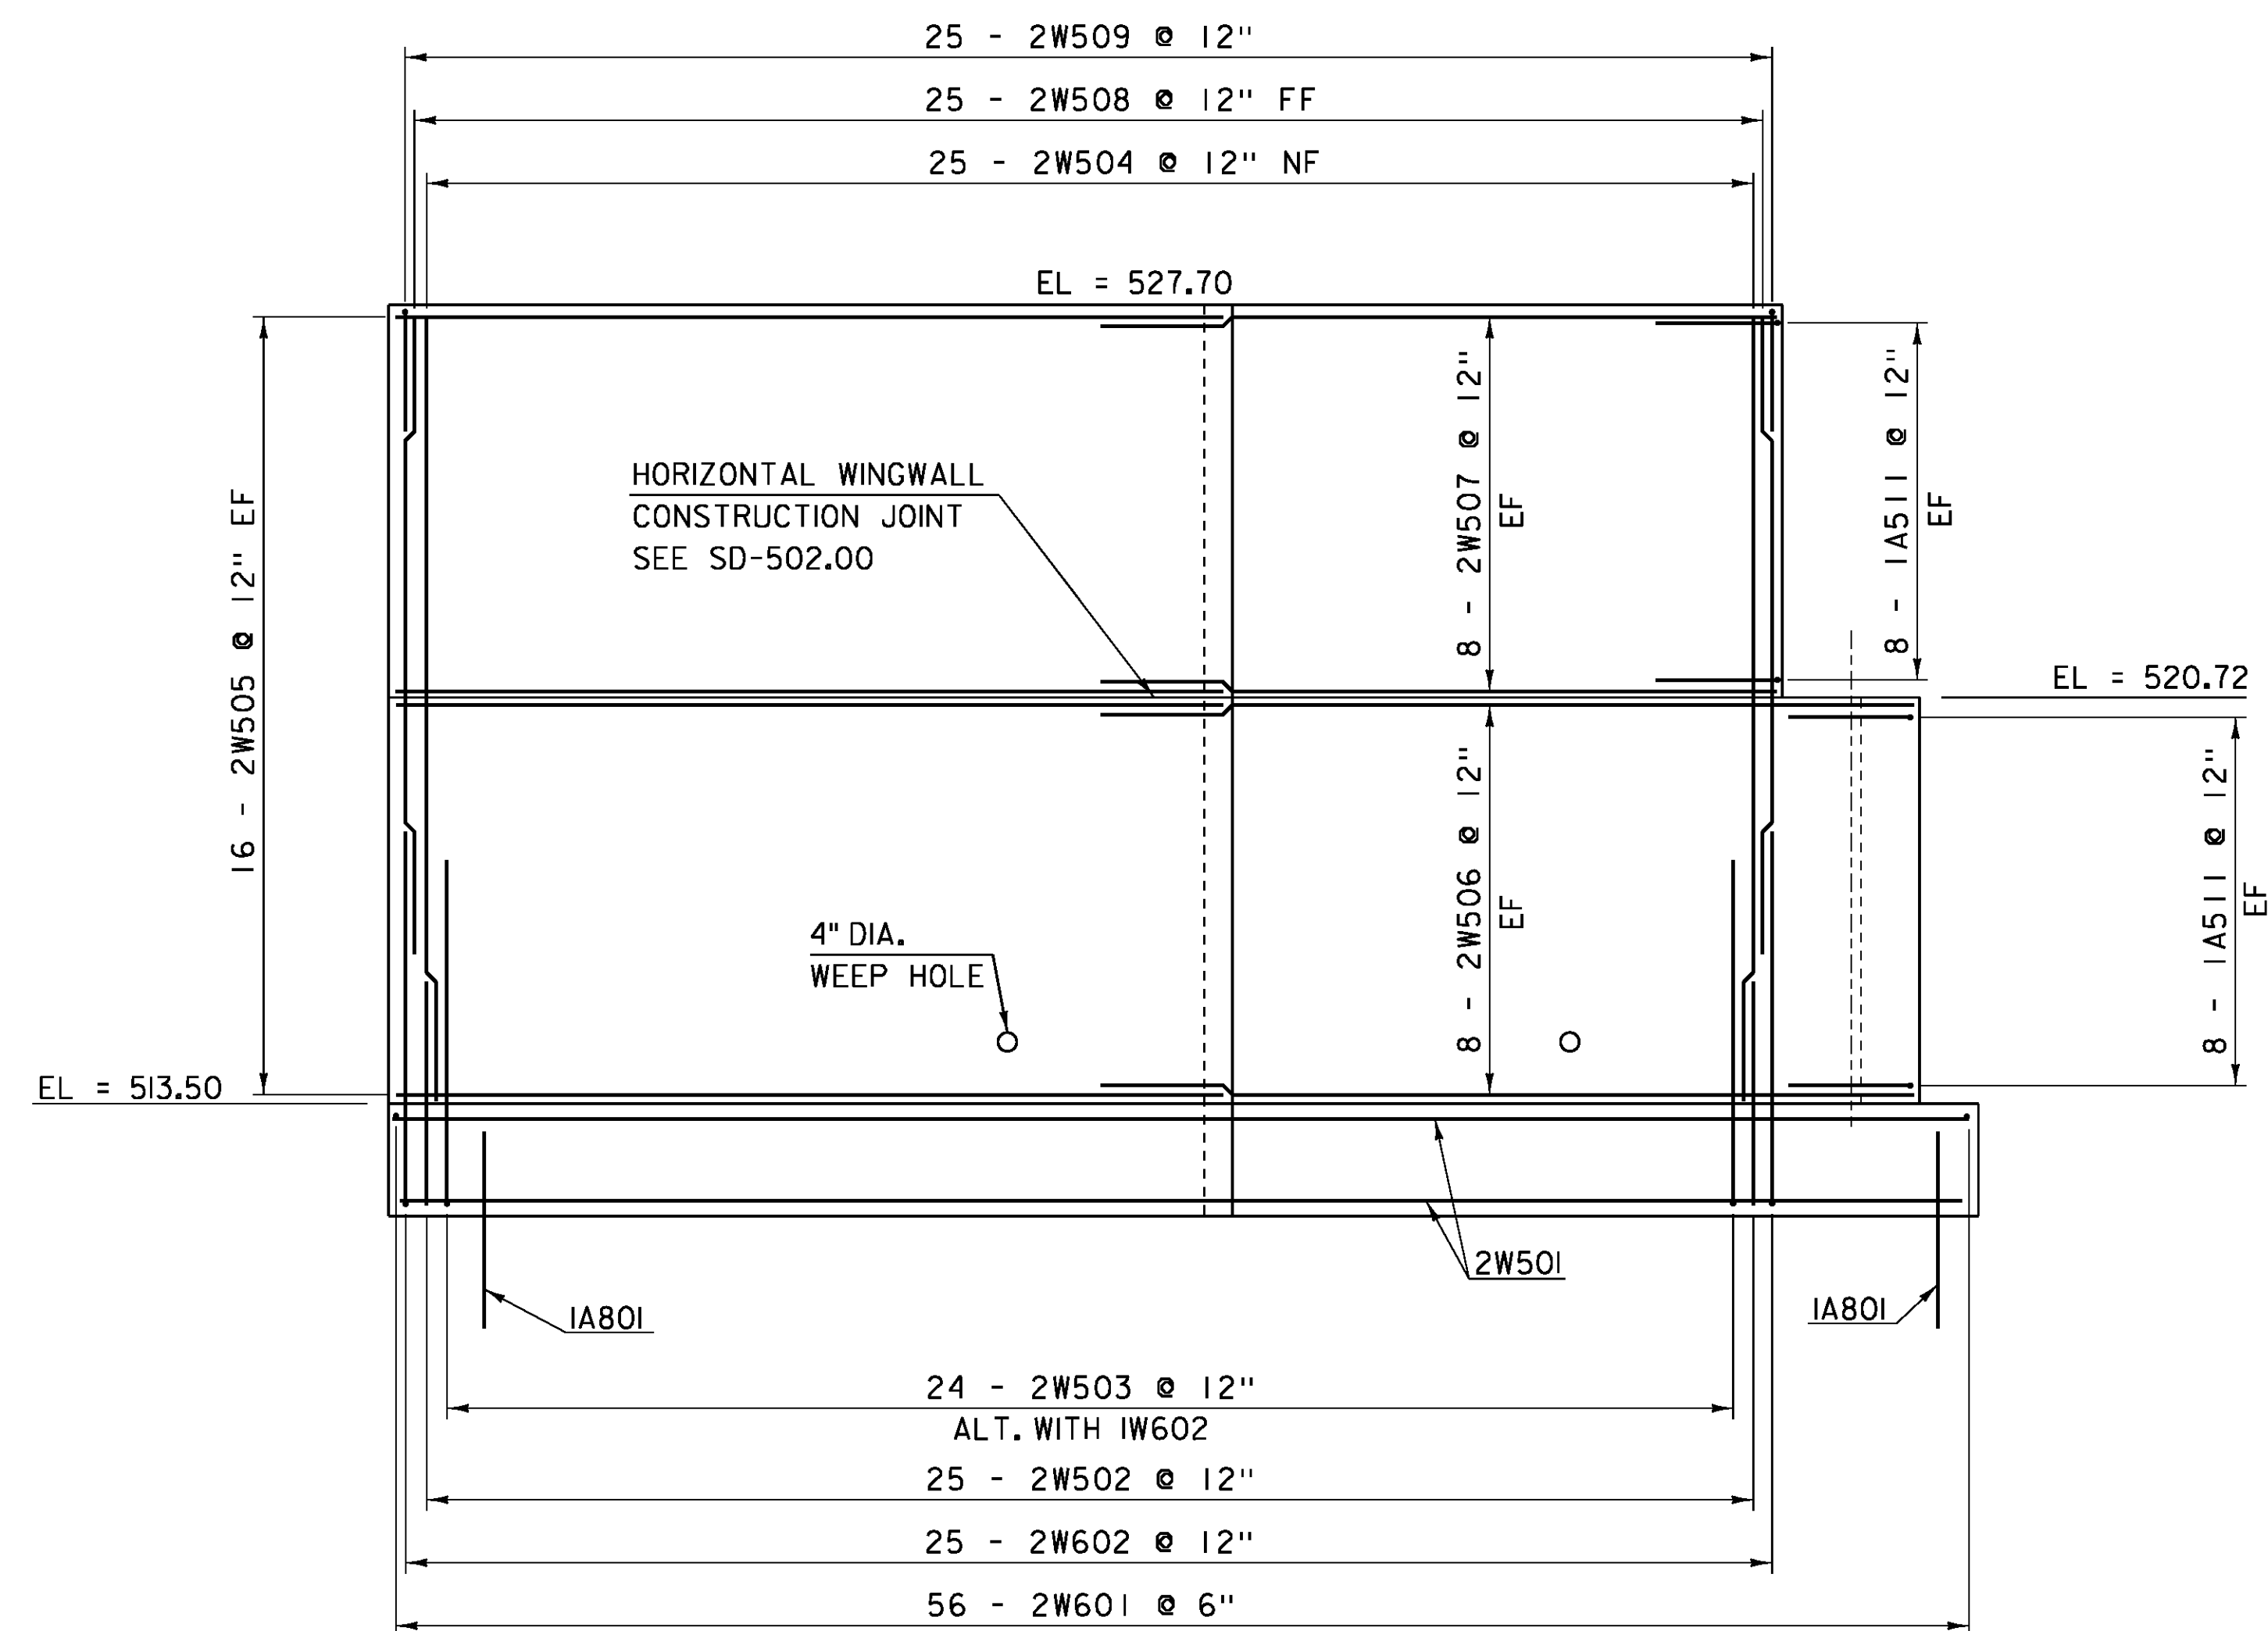


WINGWALL #2 ELEVATION

SCALE 3/8" = 1'-0"

NOTE:


- NF = NEAR FACE
- FF = FAR FACE
- EF = EACH FACE
- ▲ = CUT TO FIT IN FIELD
- 3" CLEAR, UNLESS OTHERWISE SPECIFIED ON THE PLANS.
- 2'-2" BAR LAP UNLESS OTHERWISE SPECIFIED ON THE PLANS.

PROJECT NAME:	ROYALTON
PROJECT NUMBER:	BRS 0147 (13)
FILE NAME:	86e055/STR/86e055sub.dgn
PROJECT LEADER:	C.CARLSON
DESIGNED BY:	D.PETERSON
BRIDGE 28 WINGWALL 1 AND 2 ELEVATIONS	
PLOT DATE:	08-OCT-2013
DRAWN BY:	G.ROKES
CHECKED BY:	D.PETERSON
SHEET	122 OF 186

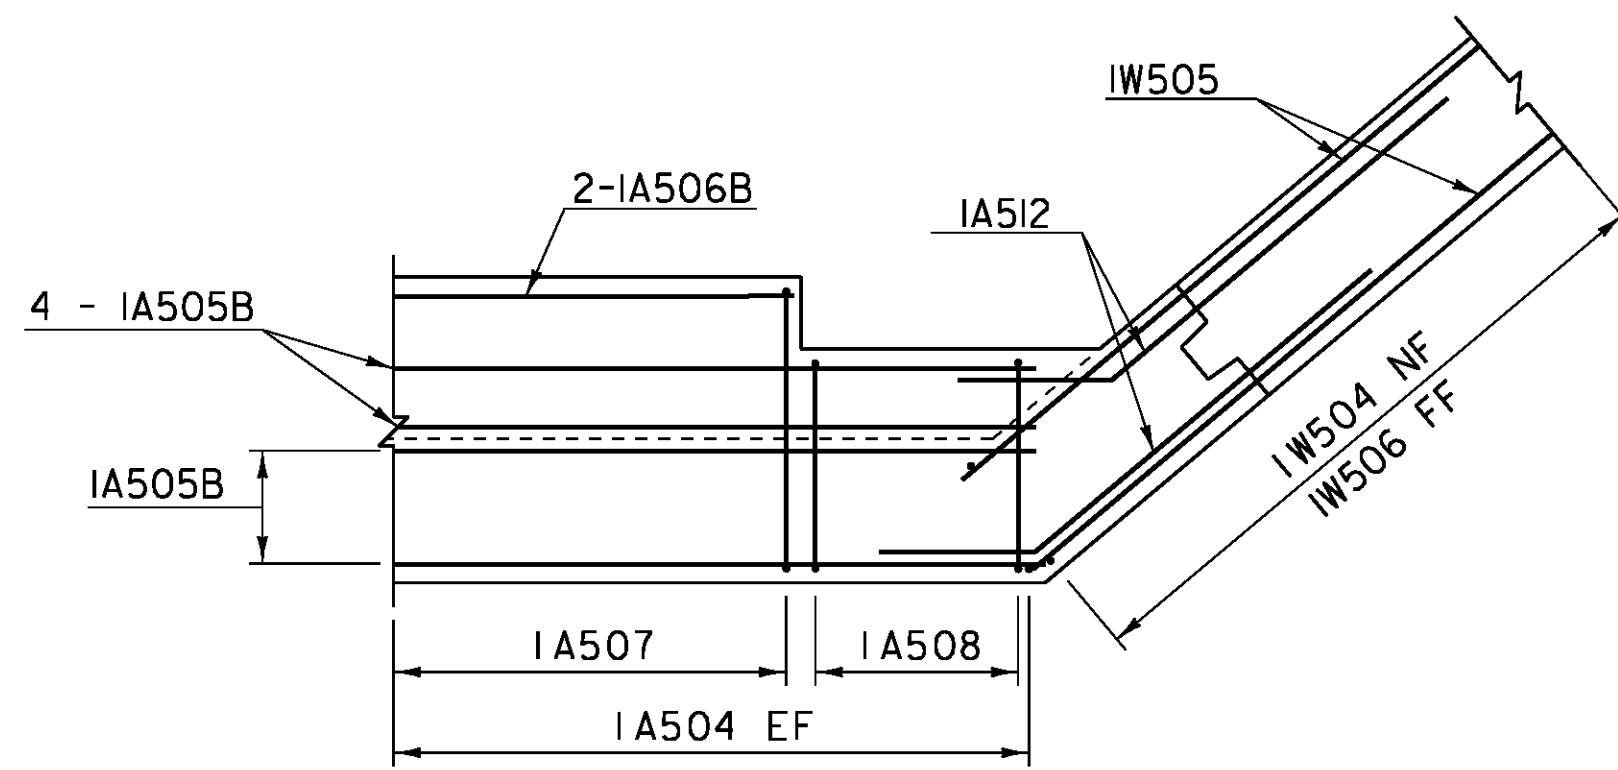


WINGWALL #1 CORNER  
BELOW BRIDGE SEAT

SCALE 3/8" = 1'-0"

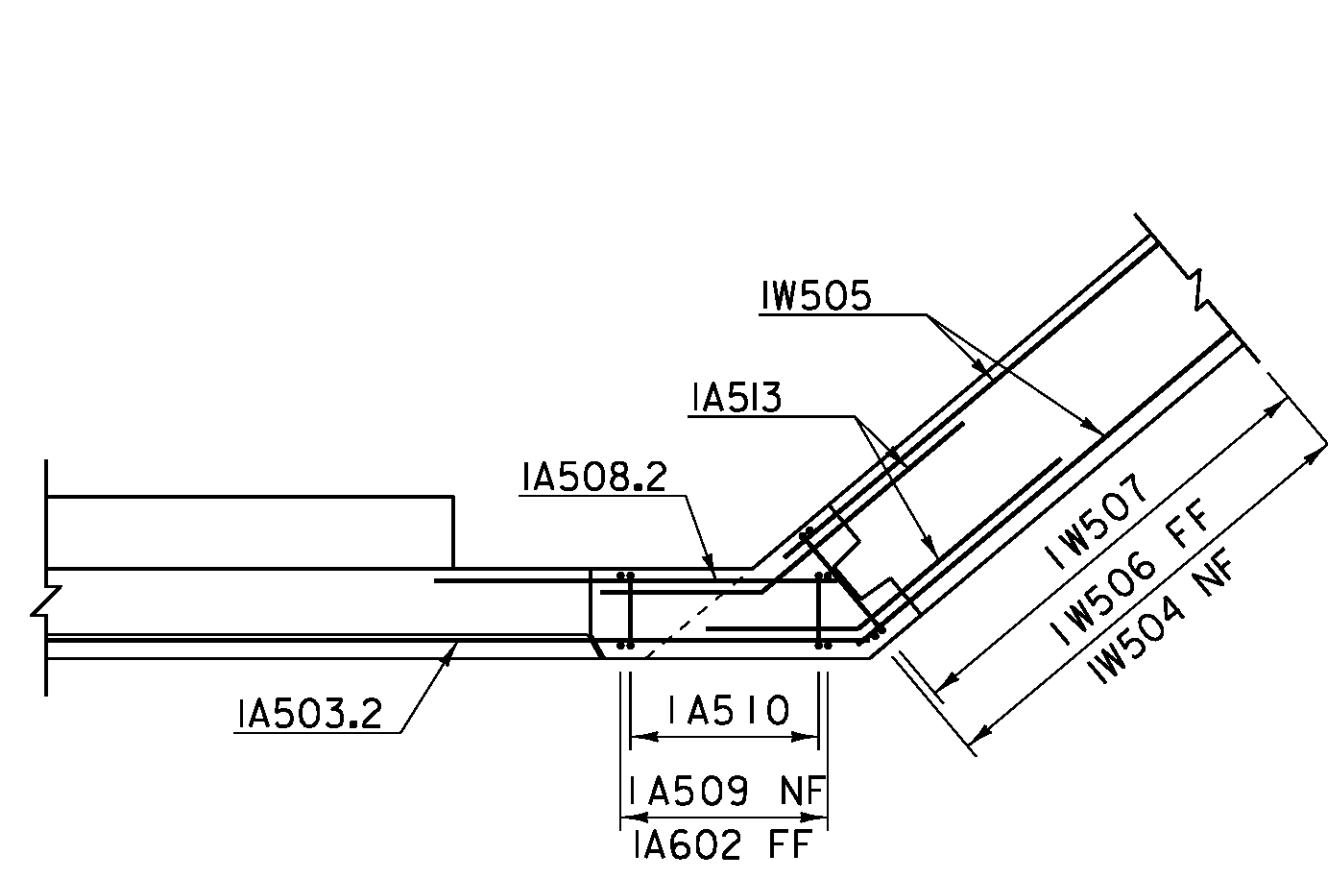


WINGWALL #1 CORNER  
ABOVE BRIDGE SEAT

SCALE 3/8" = 1'-0"

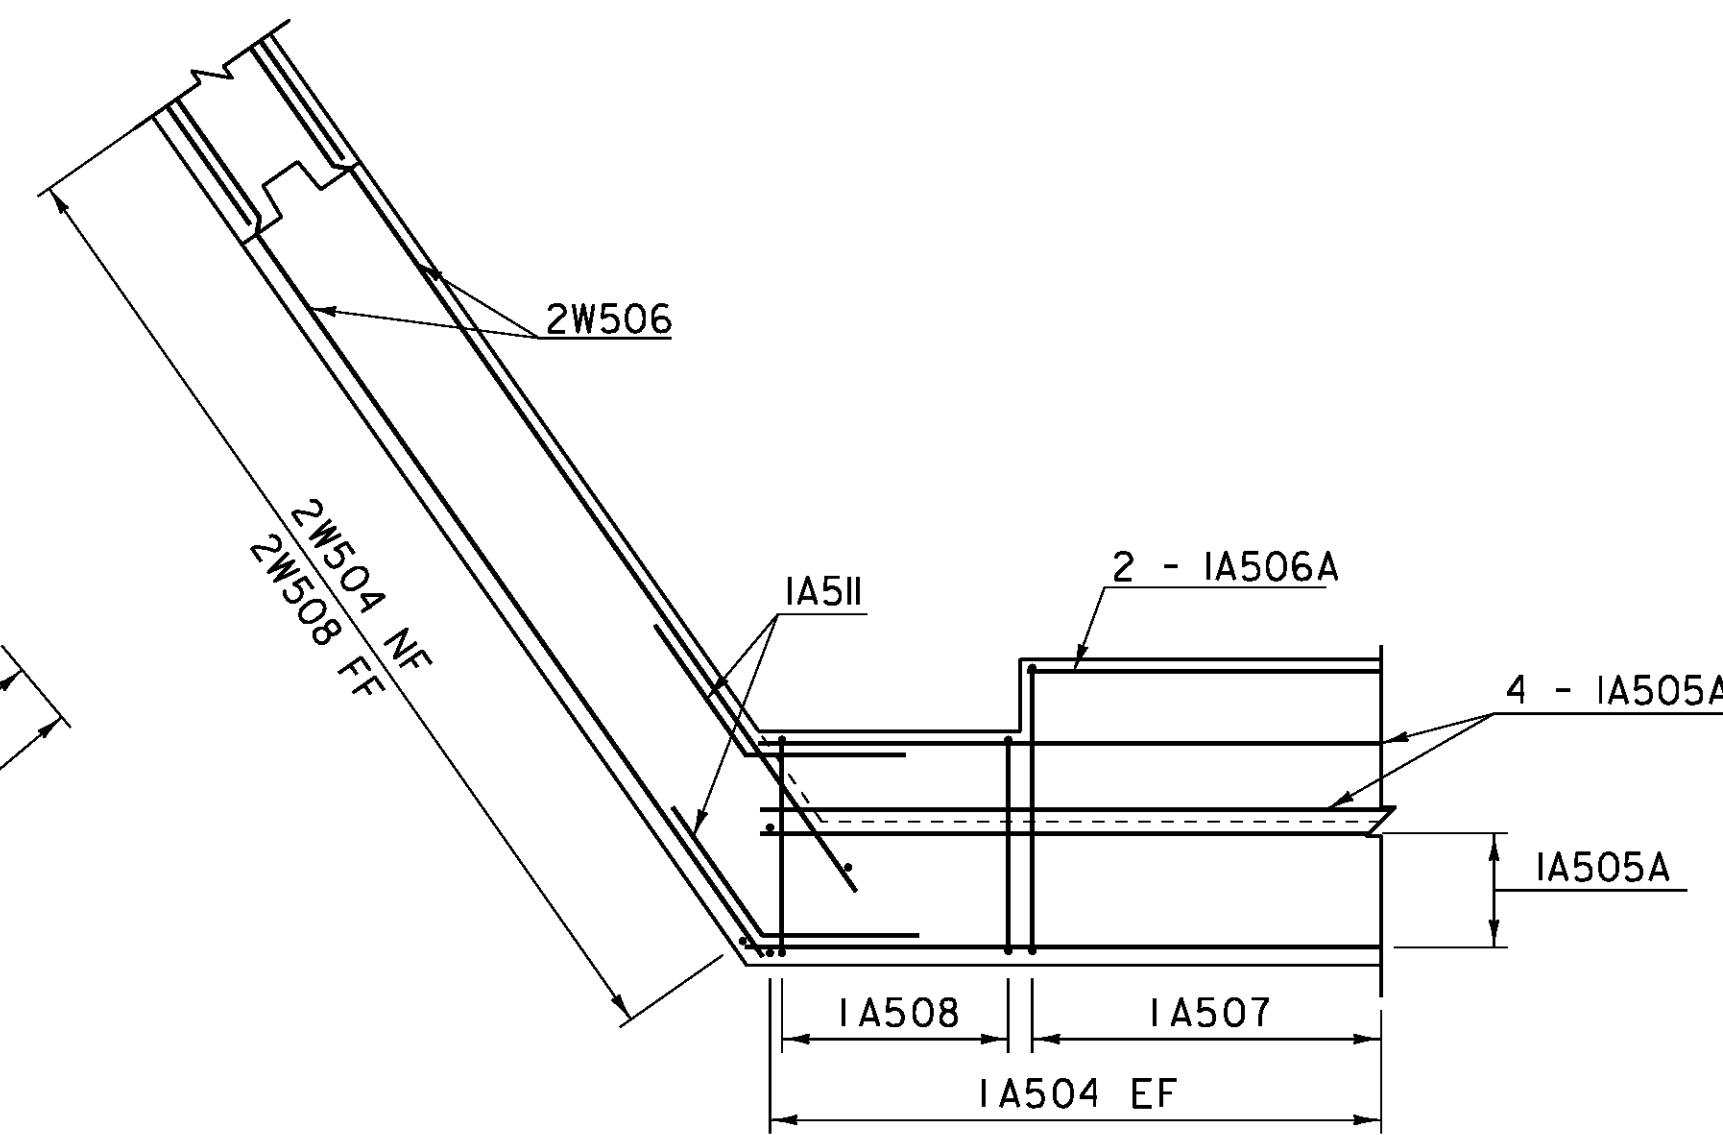


WINGWALL #2 CORNER  
BELOW BRIDGE SEAT

SCALE 3/8" = 1'-0"

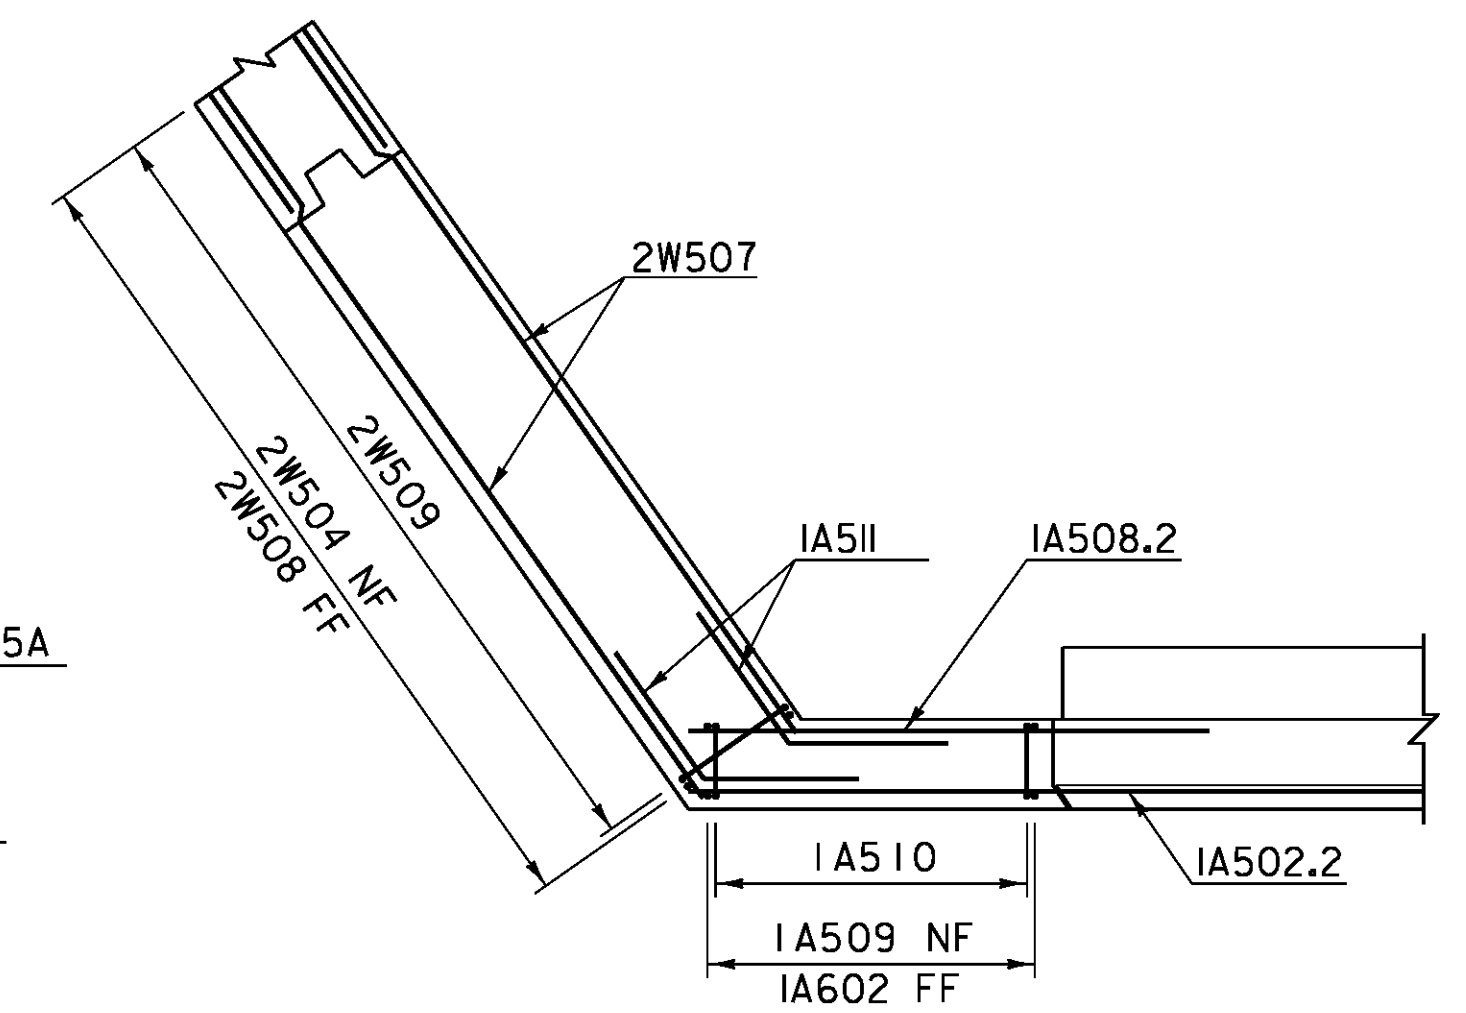


WINGWALL #2 CORNER  
ABOVE BRIDGE SEAT

SCALE 3/8" = 1'-0"

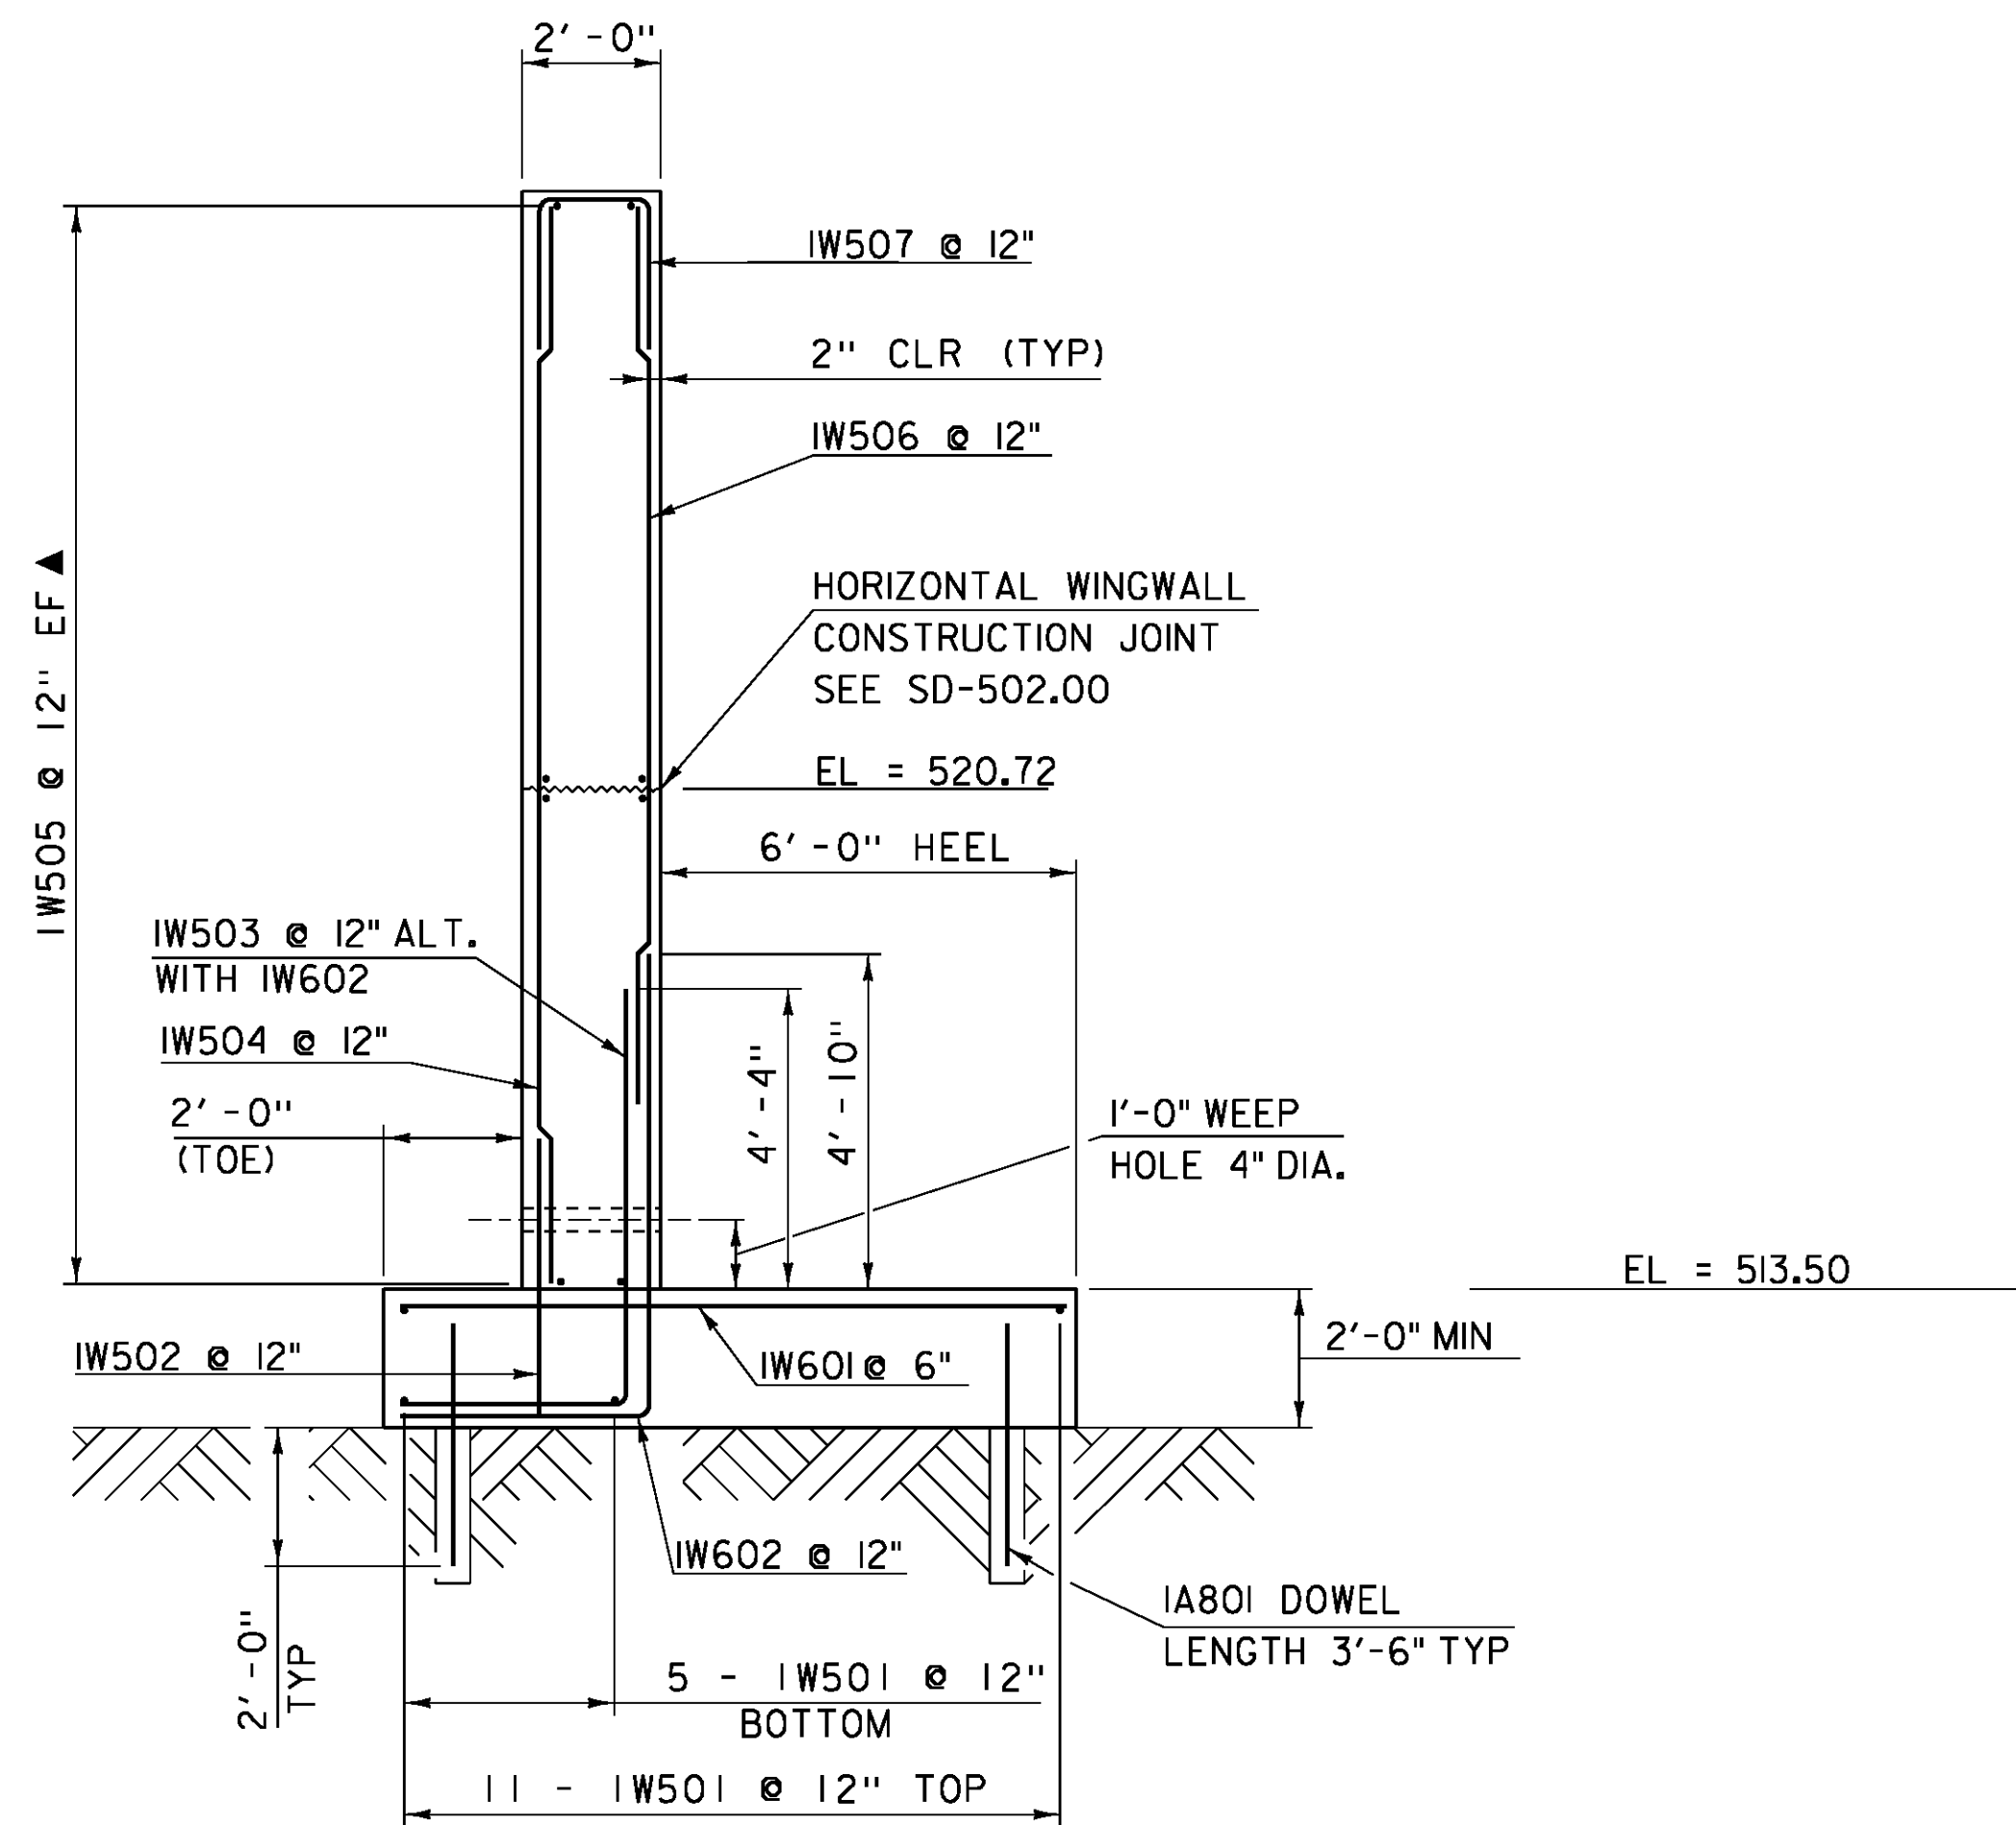

WINGWALL #1 TYPICAL

SCALE 3/8" = 1'-0"

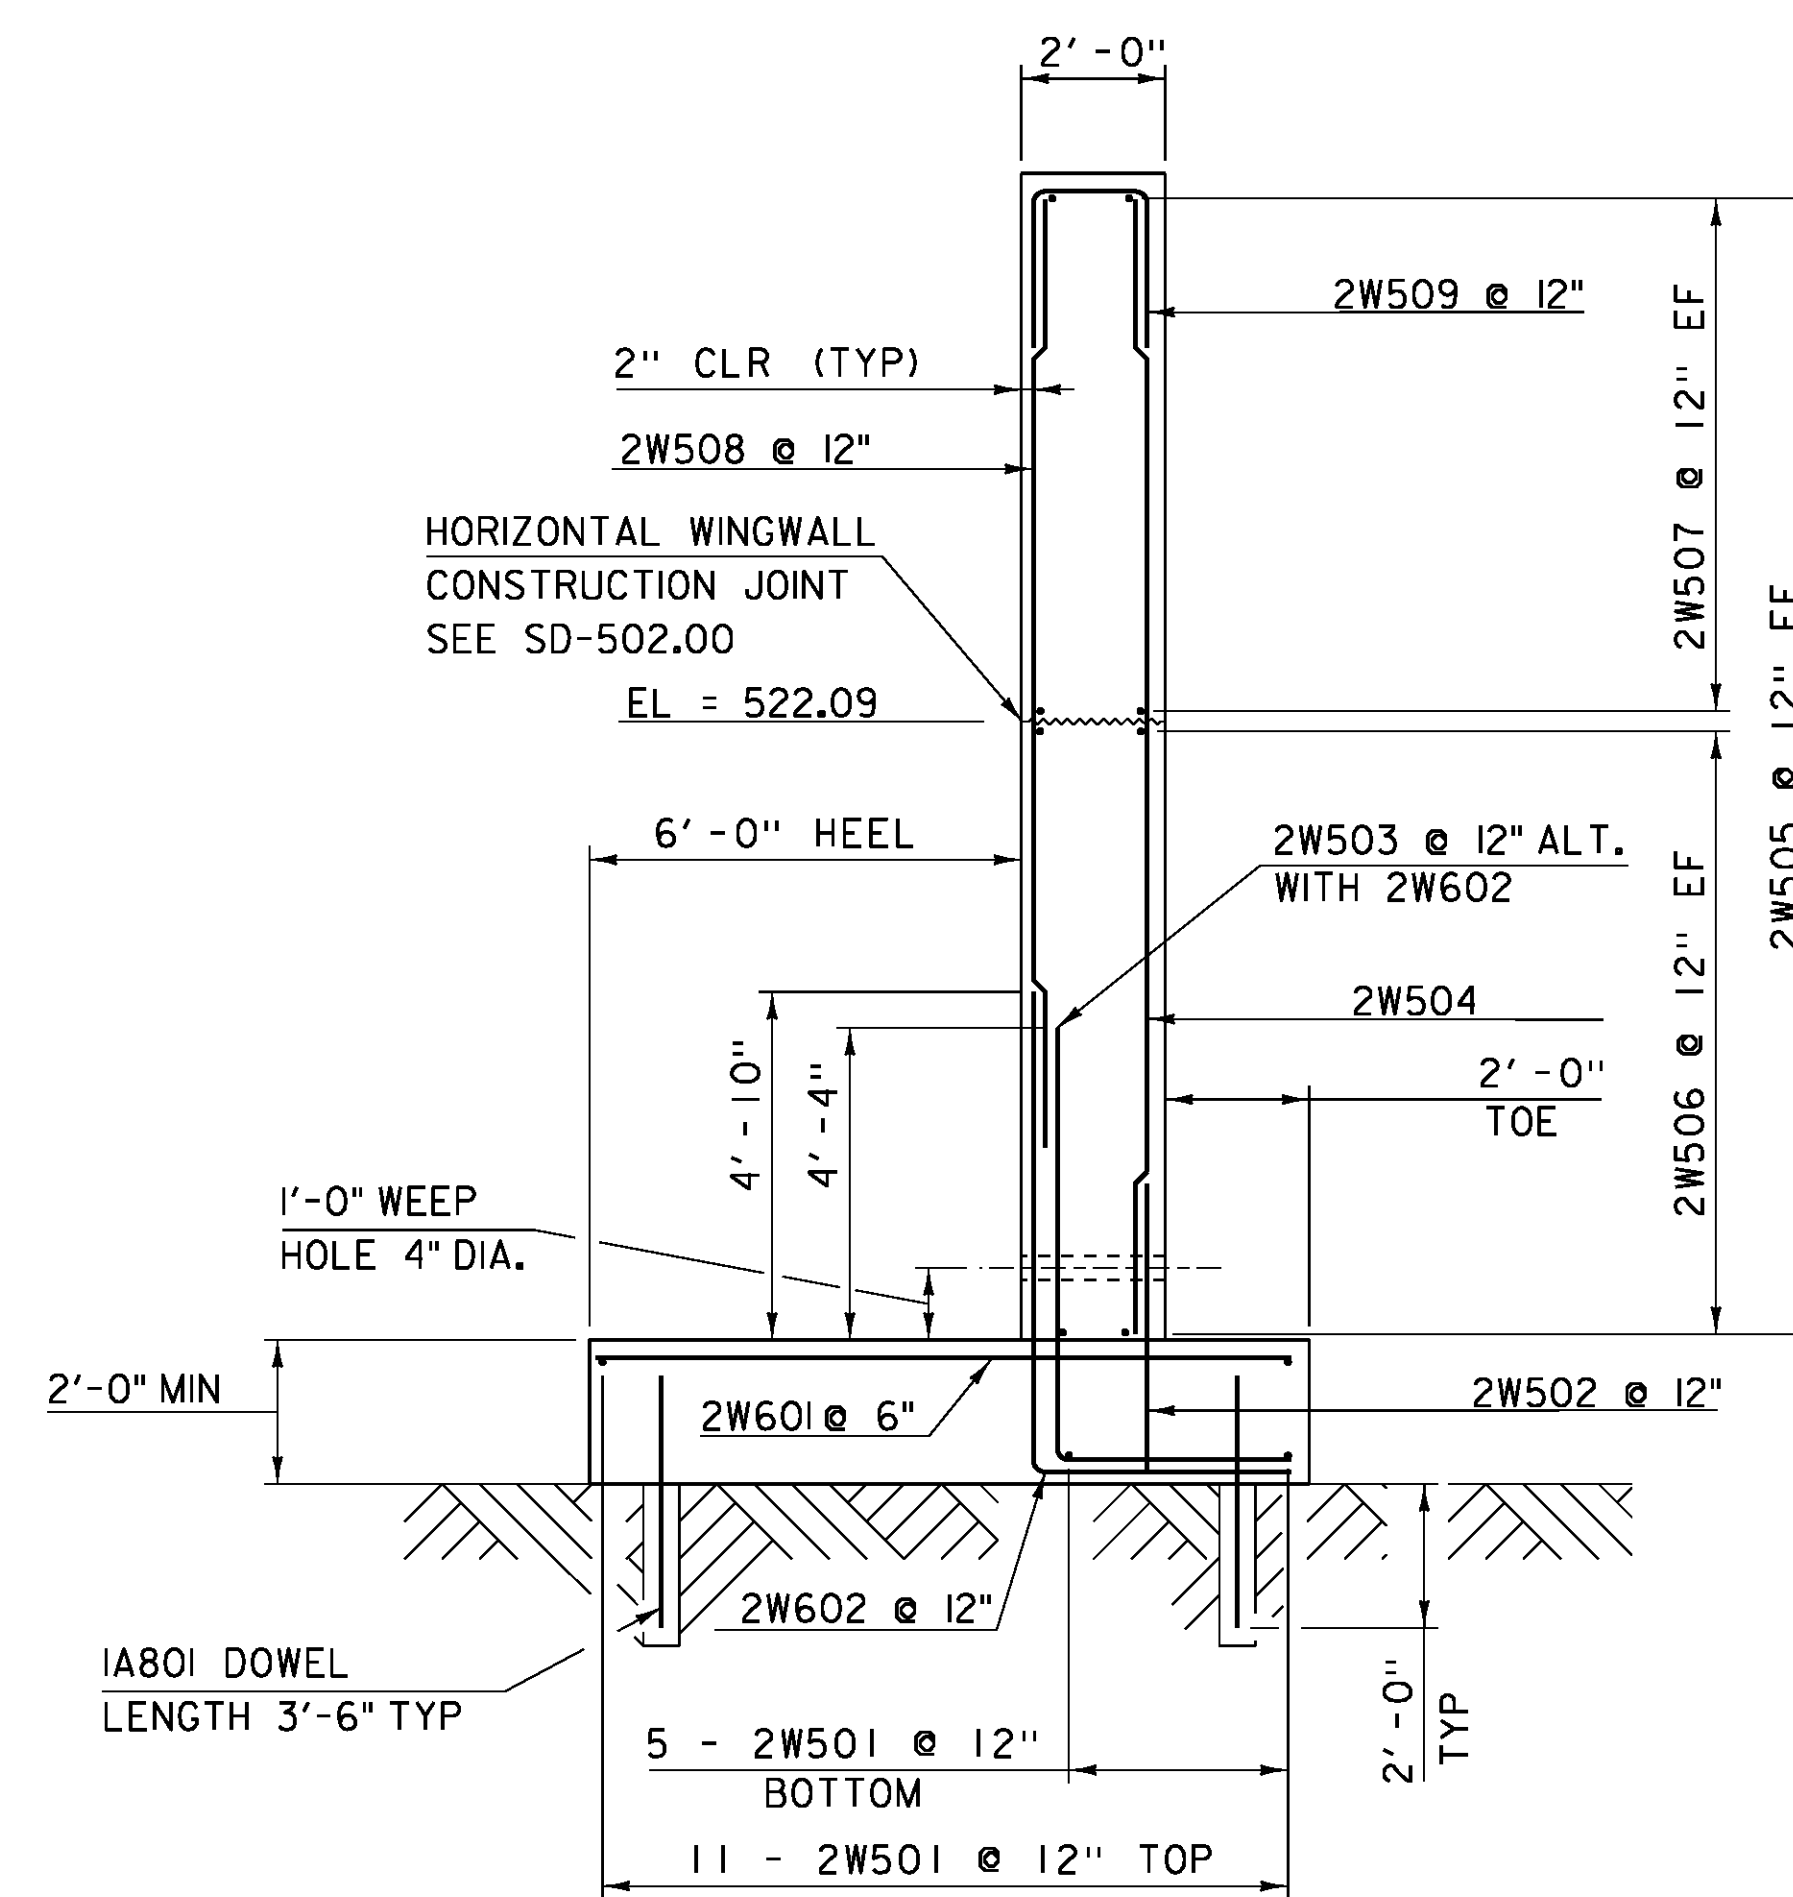

WINGWALL #2 TYPICAL

SCALE 3/8" = 1'-0"


**NOTE:**

- NF = NEAR FACE
- FF = FAR FACE
- EF = EACH FACE
- ▲ = CUT TO FIT IN FIELD
- 3" CLEAR, UNLESS OTHERWISE SPECIFIED ON THE PLANS.
- 2'-2" BAR LAP UNLESS OTHERWISE SPECIFIED ON THE PLANS.

PROJECT NAME: ROYALTON  
PROJECT NUMBER: BRS 0147 (13)

FILE NAME: 86e055/STR/86e055sub.dgn  
PROJECT LEADER: C.CARLSON  
DESIGNED BY: D.PETERSON  
BRIDGE 28 WINGWALL 1 AND 2 TYPICALS

PLOT DATE: 08-OCT-2013  
DRAWN BY: G.ROKES  
CHECKED BY: D.PETERSON  
SHEET 123 OF 186

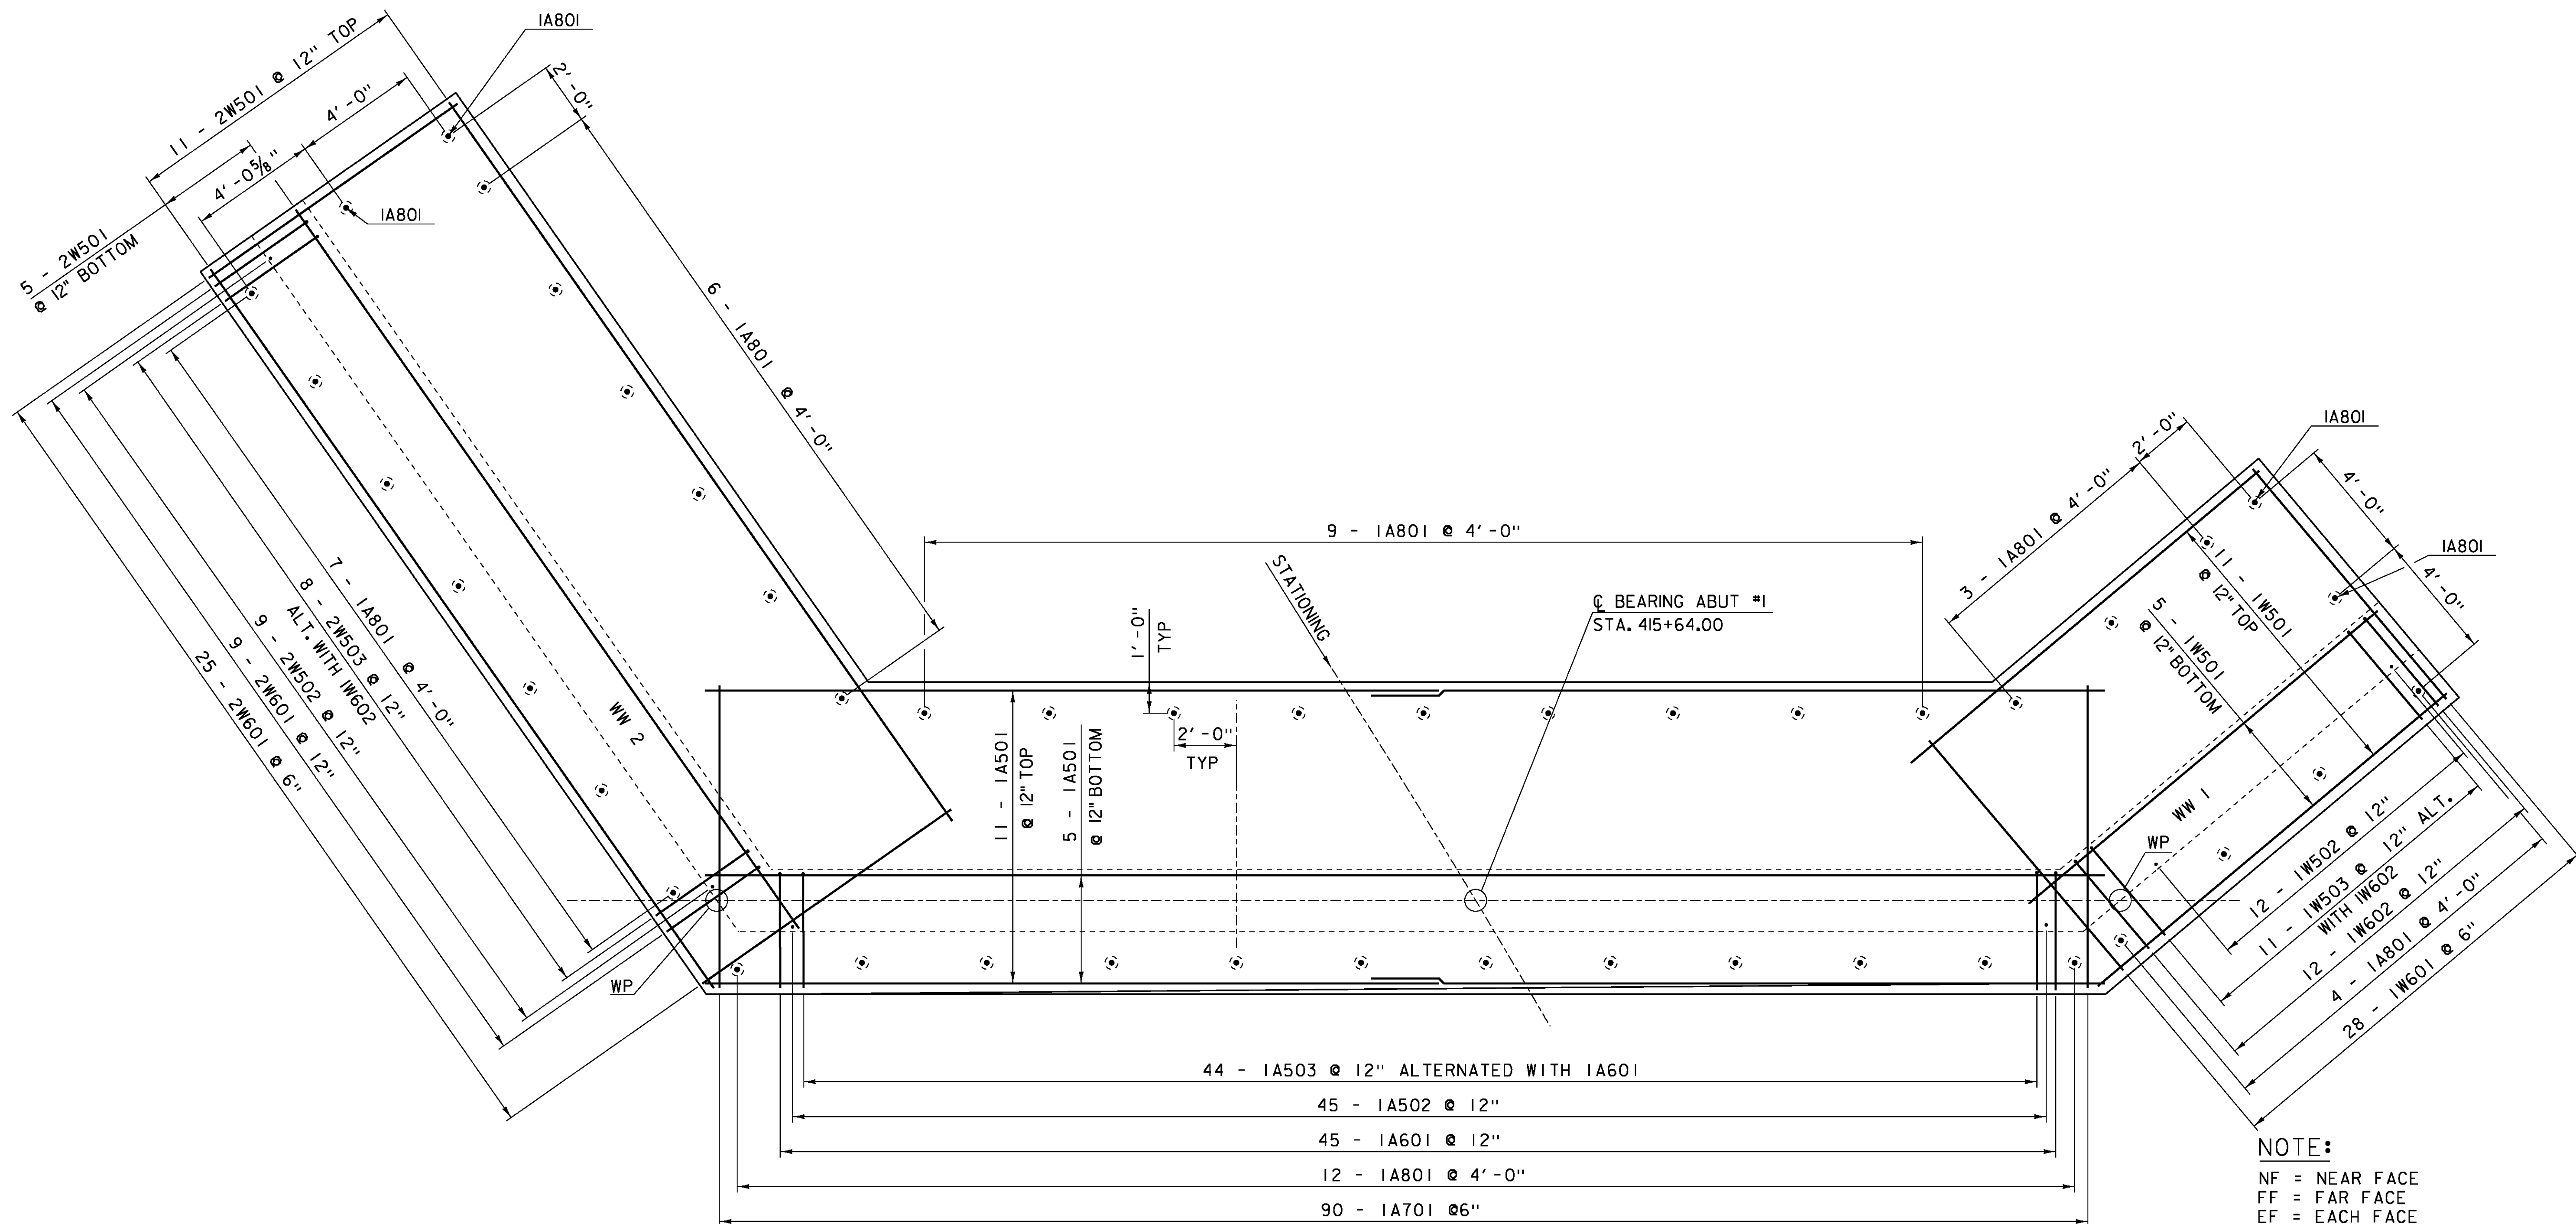


ABUTMENT #1 FOOTING REINFORCING PLAN

SCALE 3/8" = 1'-0"

**NOTE:**  
 NF = NEAR FACE  
 FF = FAR FACE  
 EF = EACH FACE  
 ▲ = CUT TO FIT IN FIELD  
 3" CLEAR, UNLESS OTHERWISE SPECIFIED ON THE PLANS.  
 2'-2" BAR LAP UNLESS OTHERWISE SPECIFIED ON THE PLANS.

PROJECT NAME:	ROYALTON	PLOT DATE:	08-OCT-2013
PROJECT NUMBER:	BRS 0147 (13)	DRAWN BY:	G.ROKES
FILE NAME:	86e055/STR/86e055sub.dgn	CHECKED BY:	D.PETERSON
PROJECT LEADER:	C.CARLSON	SHEET	124 OF 186
DESIGNED BY:	D.PETERSON	BRIDGE 28 ABUTMENT 1 FOOTING PLAN	

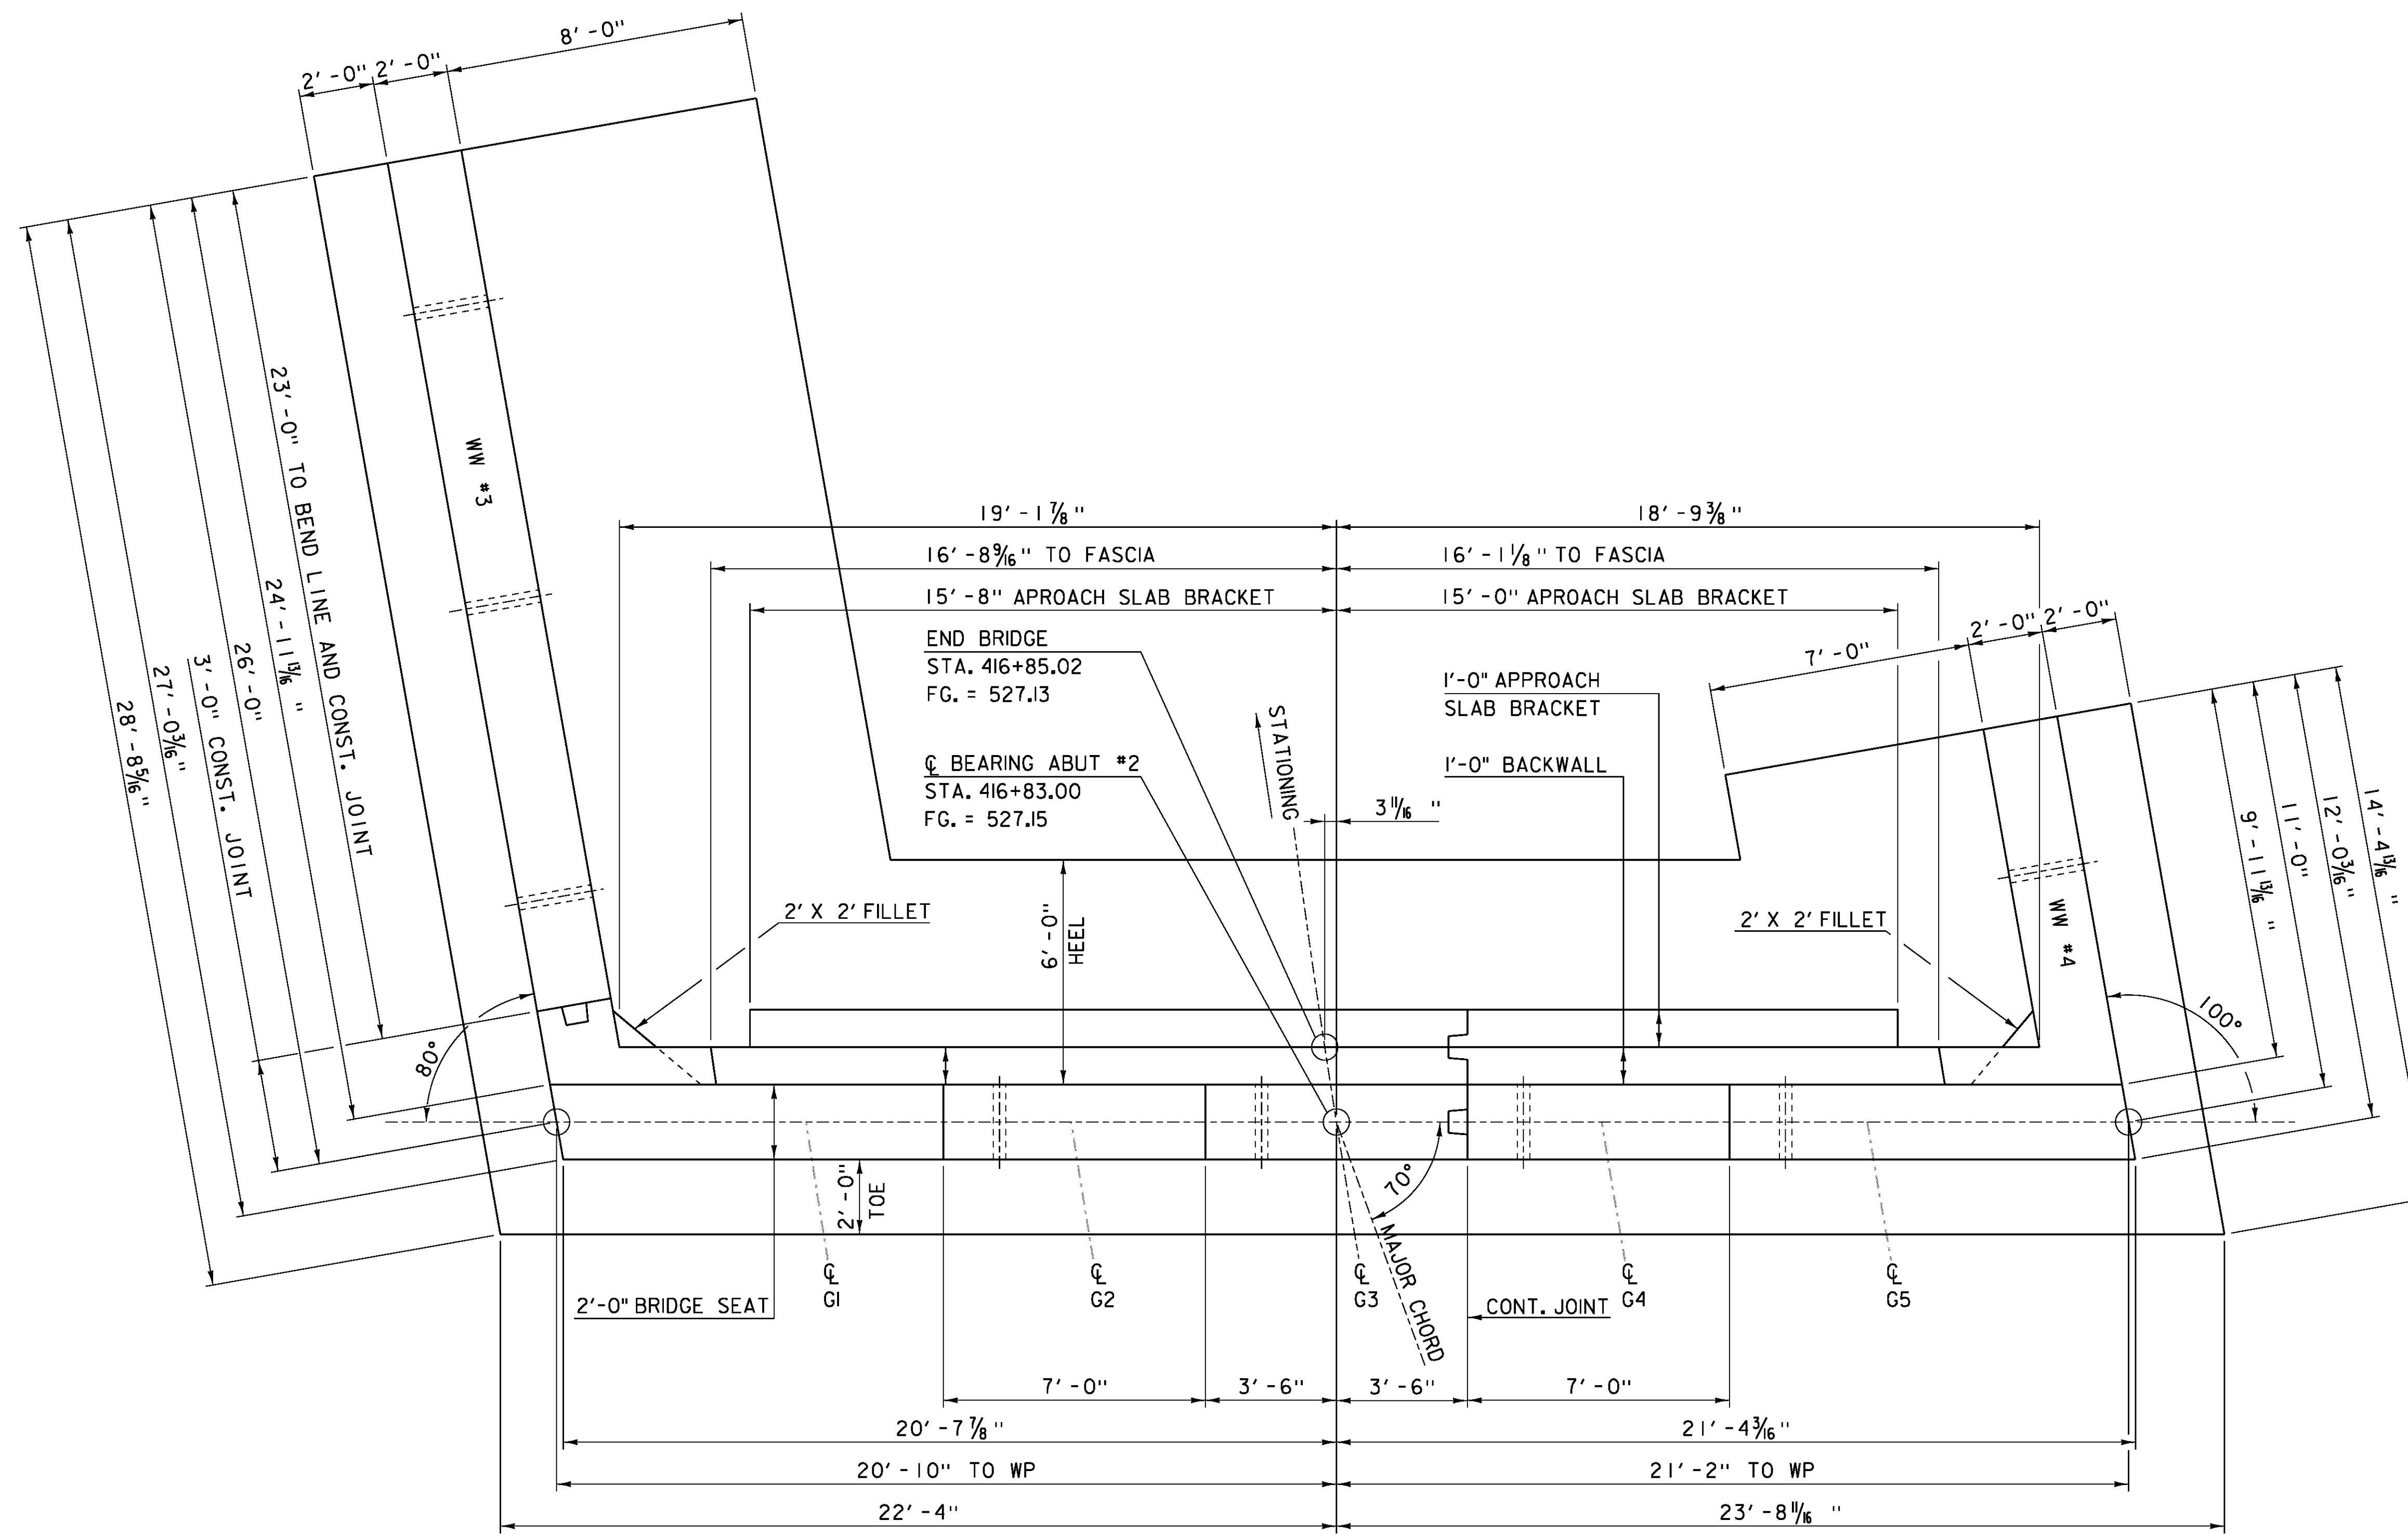


**ABUTMENT #2 PLAN**

SCALE 3/8" = 1'-0"

**NOTE:**


- NF = NEAR FACE
- FF = FAR FACE
- EF = EACH FACE
- ▲ = CUT TO FIT IN FIELD
- 3" CLEAR, UNLESS OTHERWISE SPECIFIED ON THE PLANS.
- 2'-2" BAR LAP UNLESS OTHERWISE SPECIFIED ON THE PLANS.

PROJECT NAME:	ROYALTON
PROJECT NUMBER:	BRS 0147 (13)
FILE NAME:	86e055/STR/86e055sub.dgn
PROJECT LEADER:	C.CARLSON
DESIGNED BY:	D.PETERSON
BRIDGE 28 ABUTMENT 2 PLAN	
PLOT DATE:	08-OCT-2013
DRAWN BY:	G.ROKES
CHECKED BY:	D.PETERSON
SHEET	125 OF 186

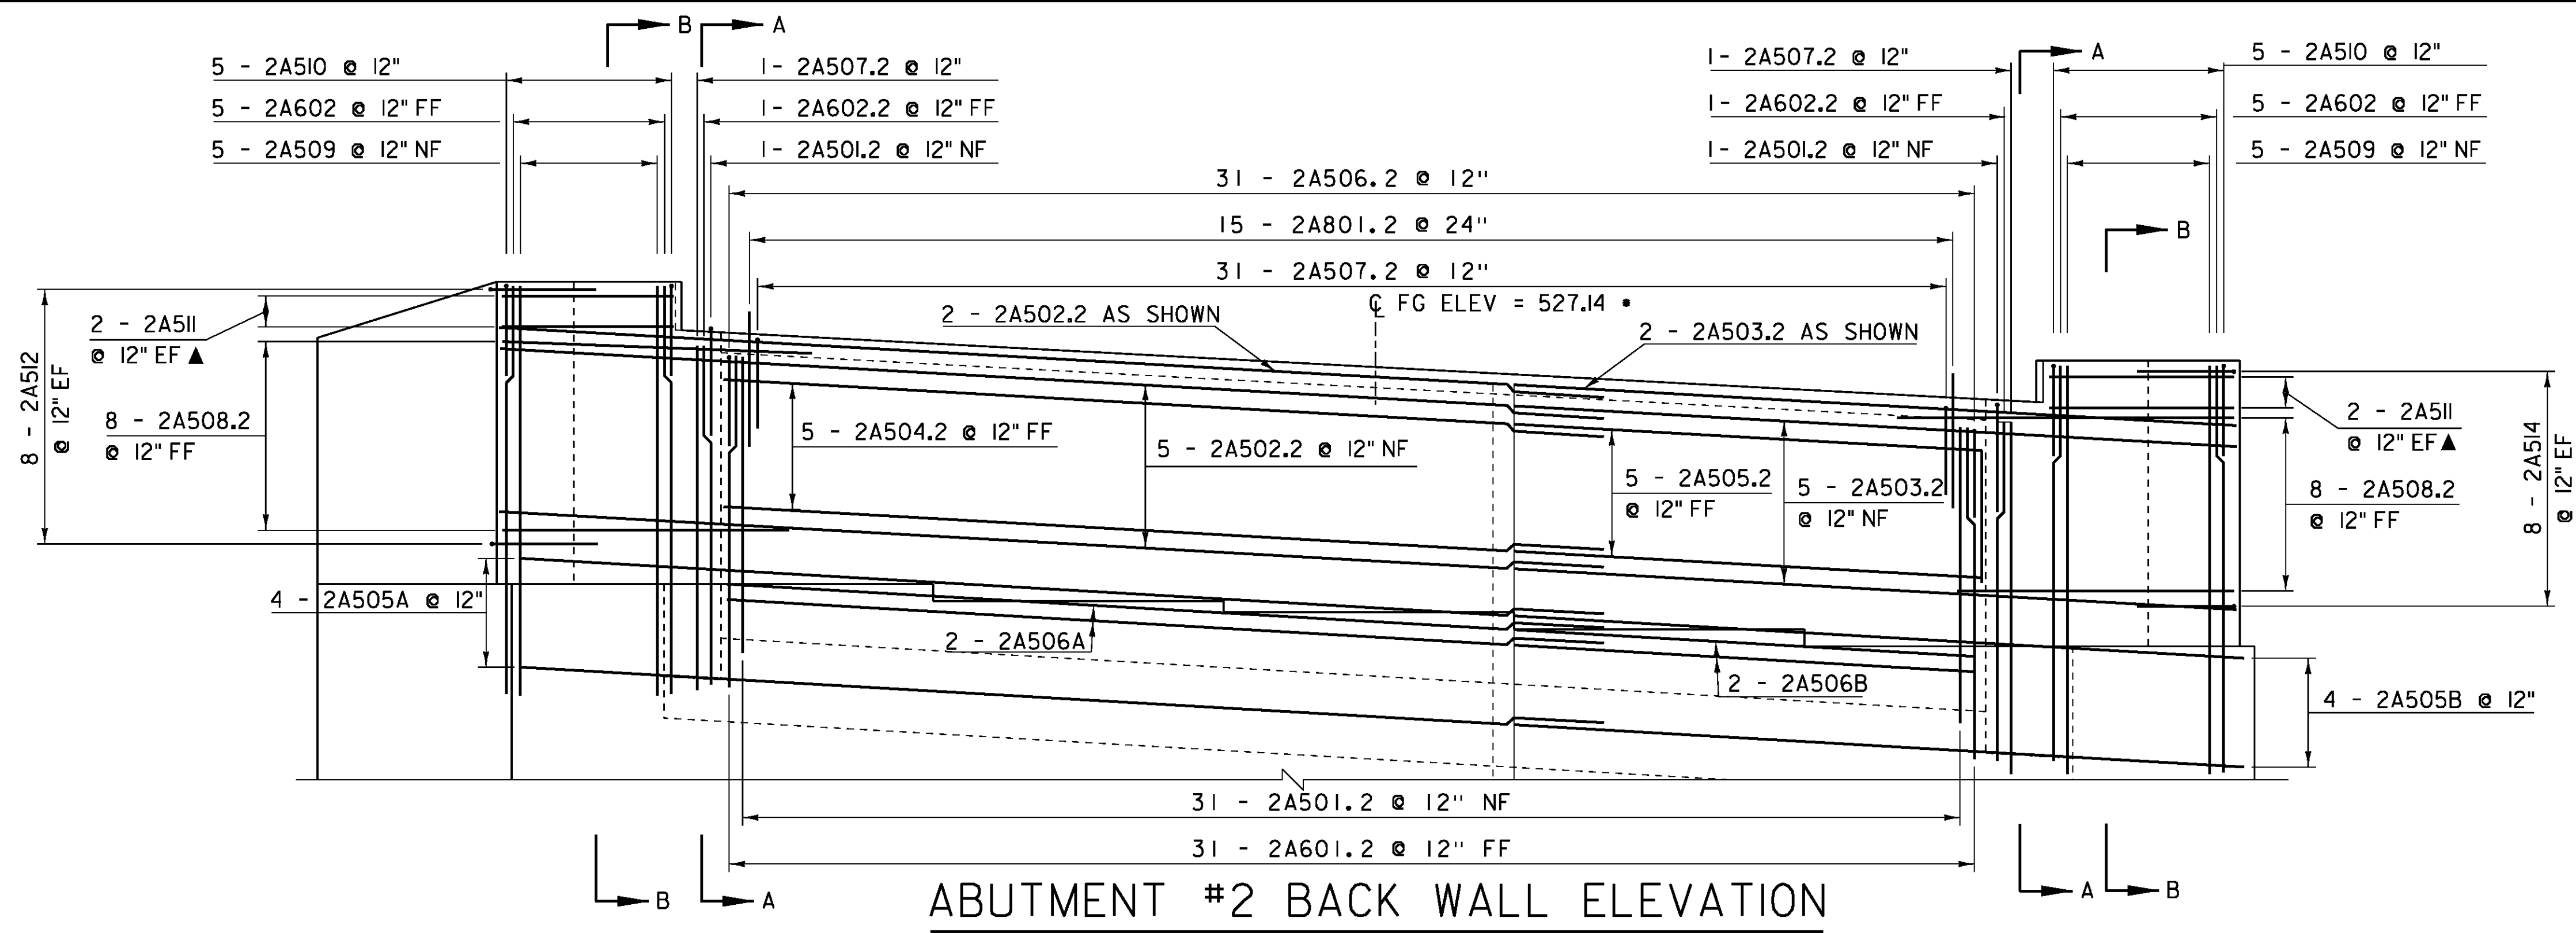

ABUTMENT #2 BACK WALL ELEVATION

SCALE 3/8" = 1'-0"

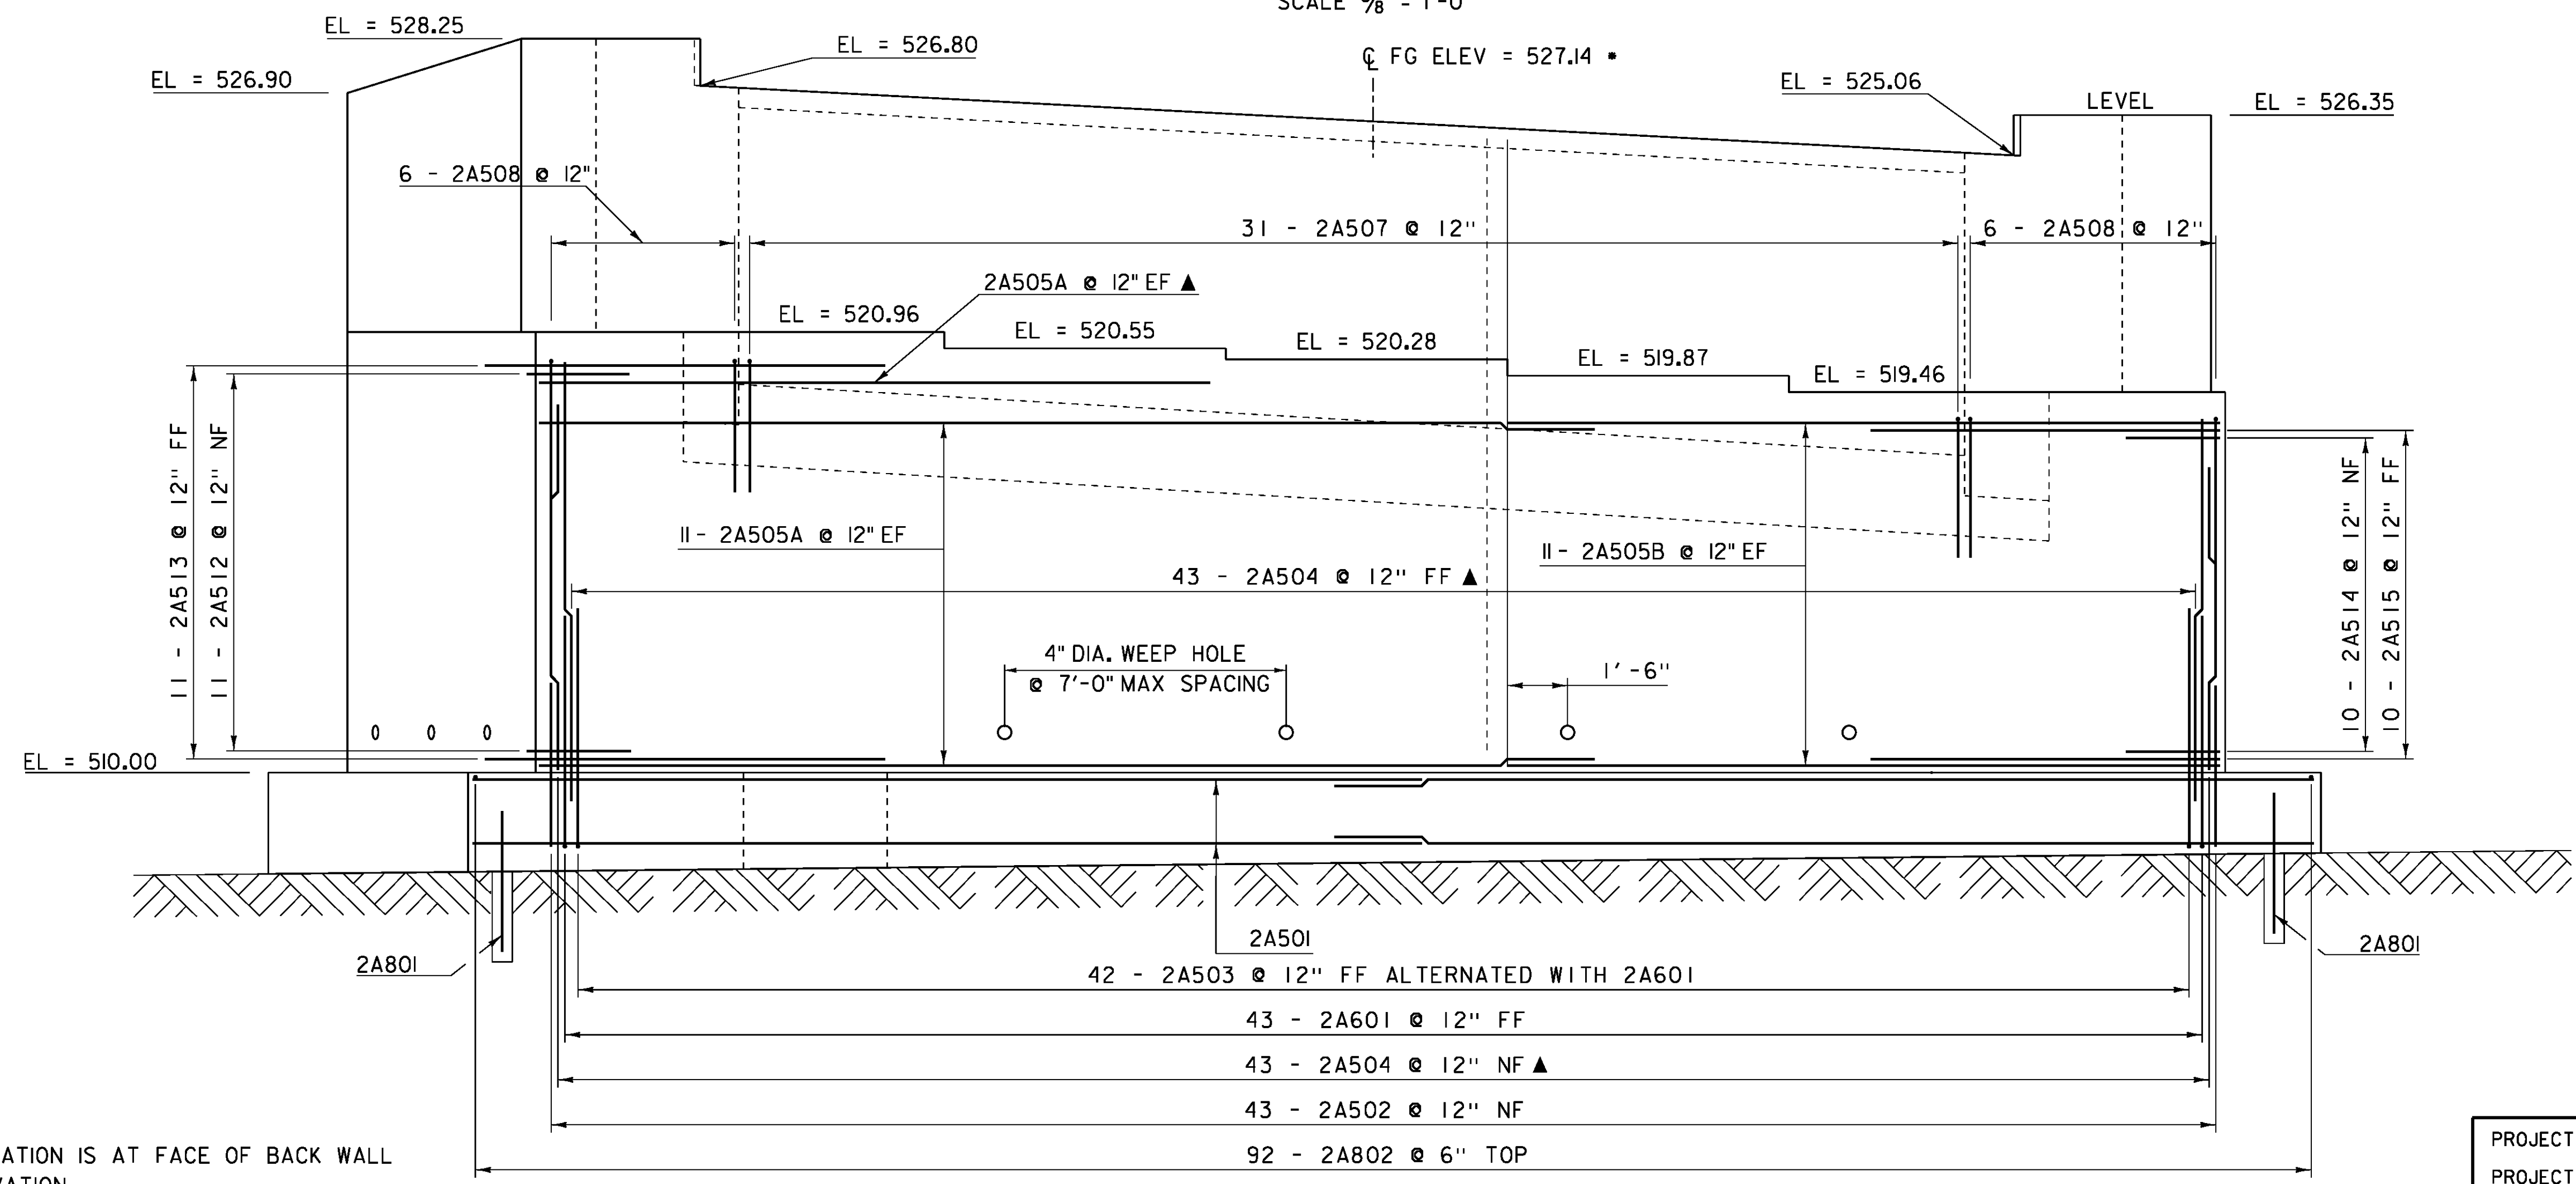


ABUTMENT #2 ELEVATION

SCALE 3/8" = 1'-0"

• STATION IS AT FACE OF BACK WALL ELEVATION


**NOTE:**  
 NF = NEAR FACE  
 FF = FAR FACE  
 EF = EACH FACE  
 ▲ = CUT TO FIT IN FIELD  
 3" CLEAR, UNLESS OTHERWISE SPECIFIED ON THE PLANS.  
 2'-2" BAR LAP UNLESS OTHERWISE SPECIFIED ON THE PLANS.

PROJECT NAME:	ROYALTON	PLOT DATE:	08-OCT-2013
PROJECT NUMBER:	BRS 0147 (13)	DRAWN BY:	G.ROKES
FILE NAME:	86e055/STR/86e055sub.dgn	CHECKED BY:	D.PETERSON
PROJECT LEADER:	C.CARLSON	SHEET	126 OF 186
DESIGNED BY:	D.PETERSON	BRIDGE 28 ABUTMENT 2 ELEVATION	

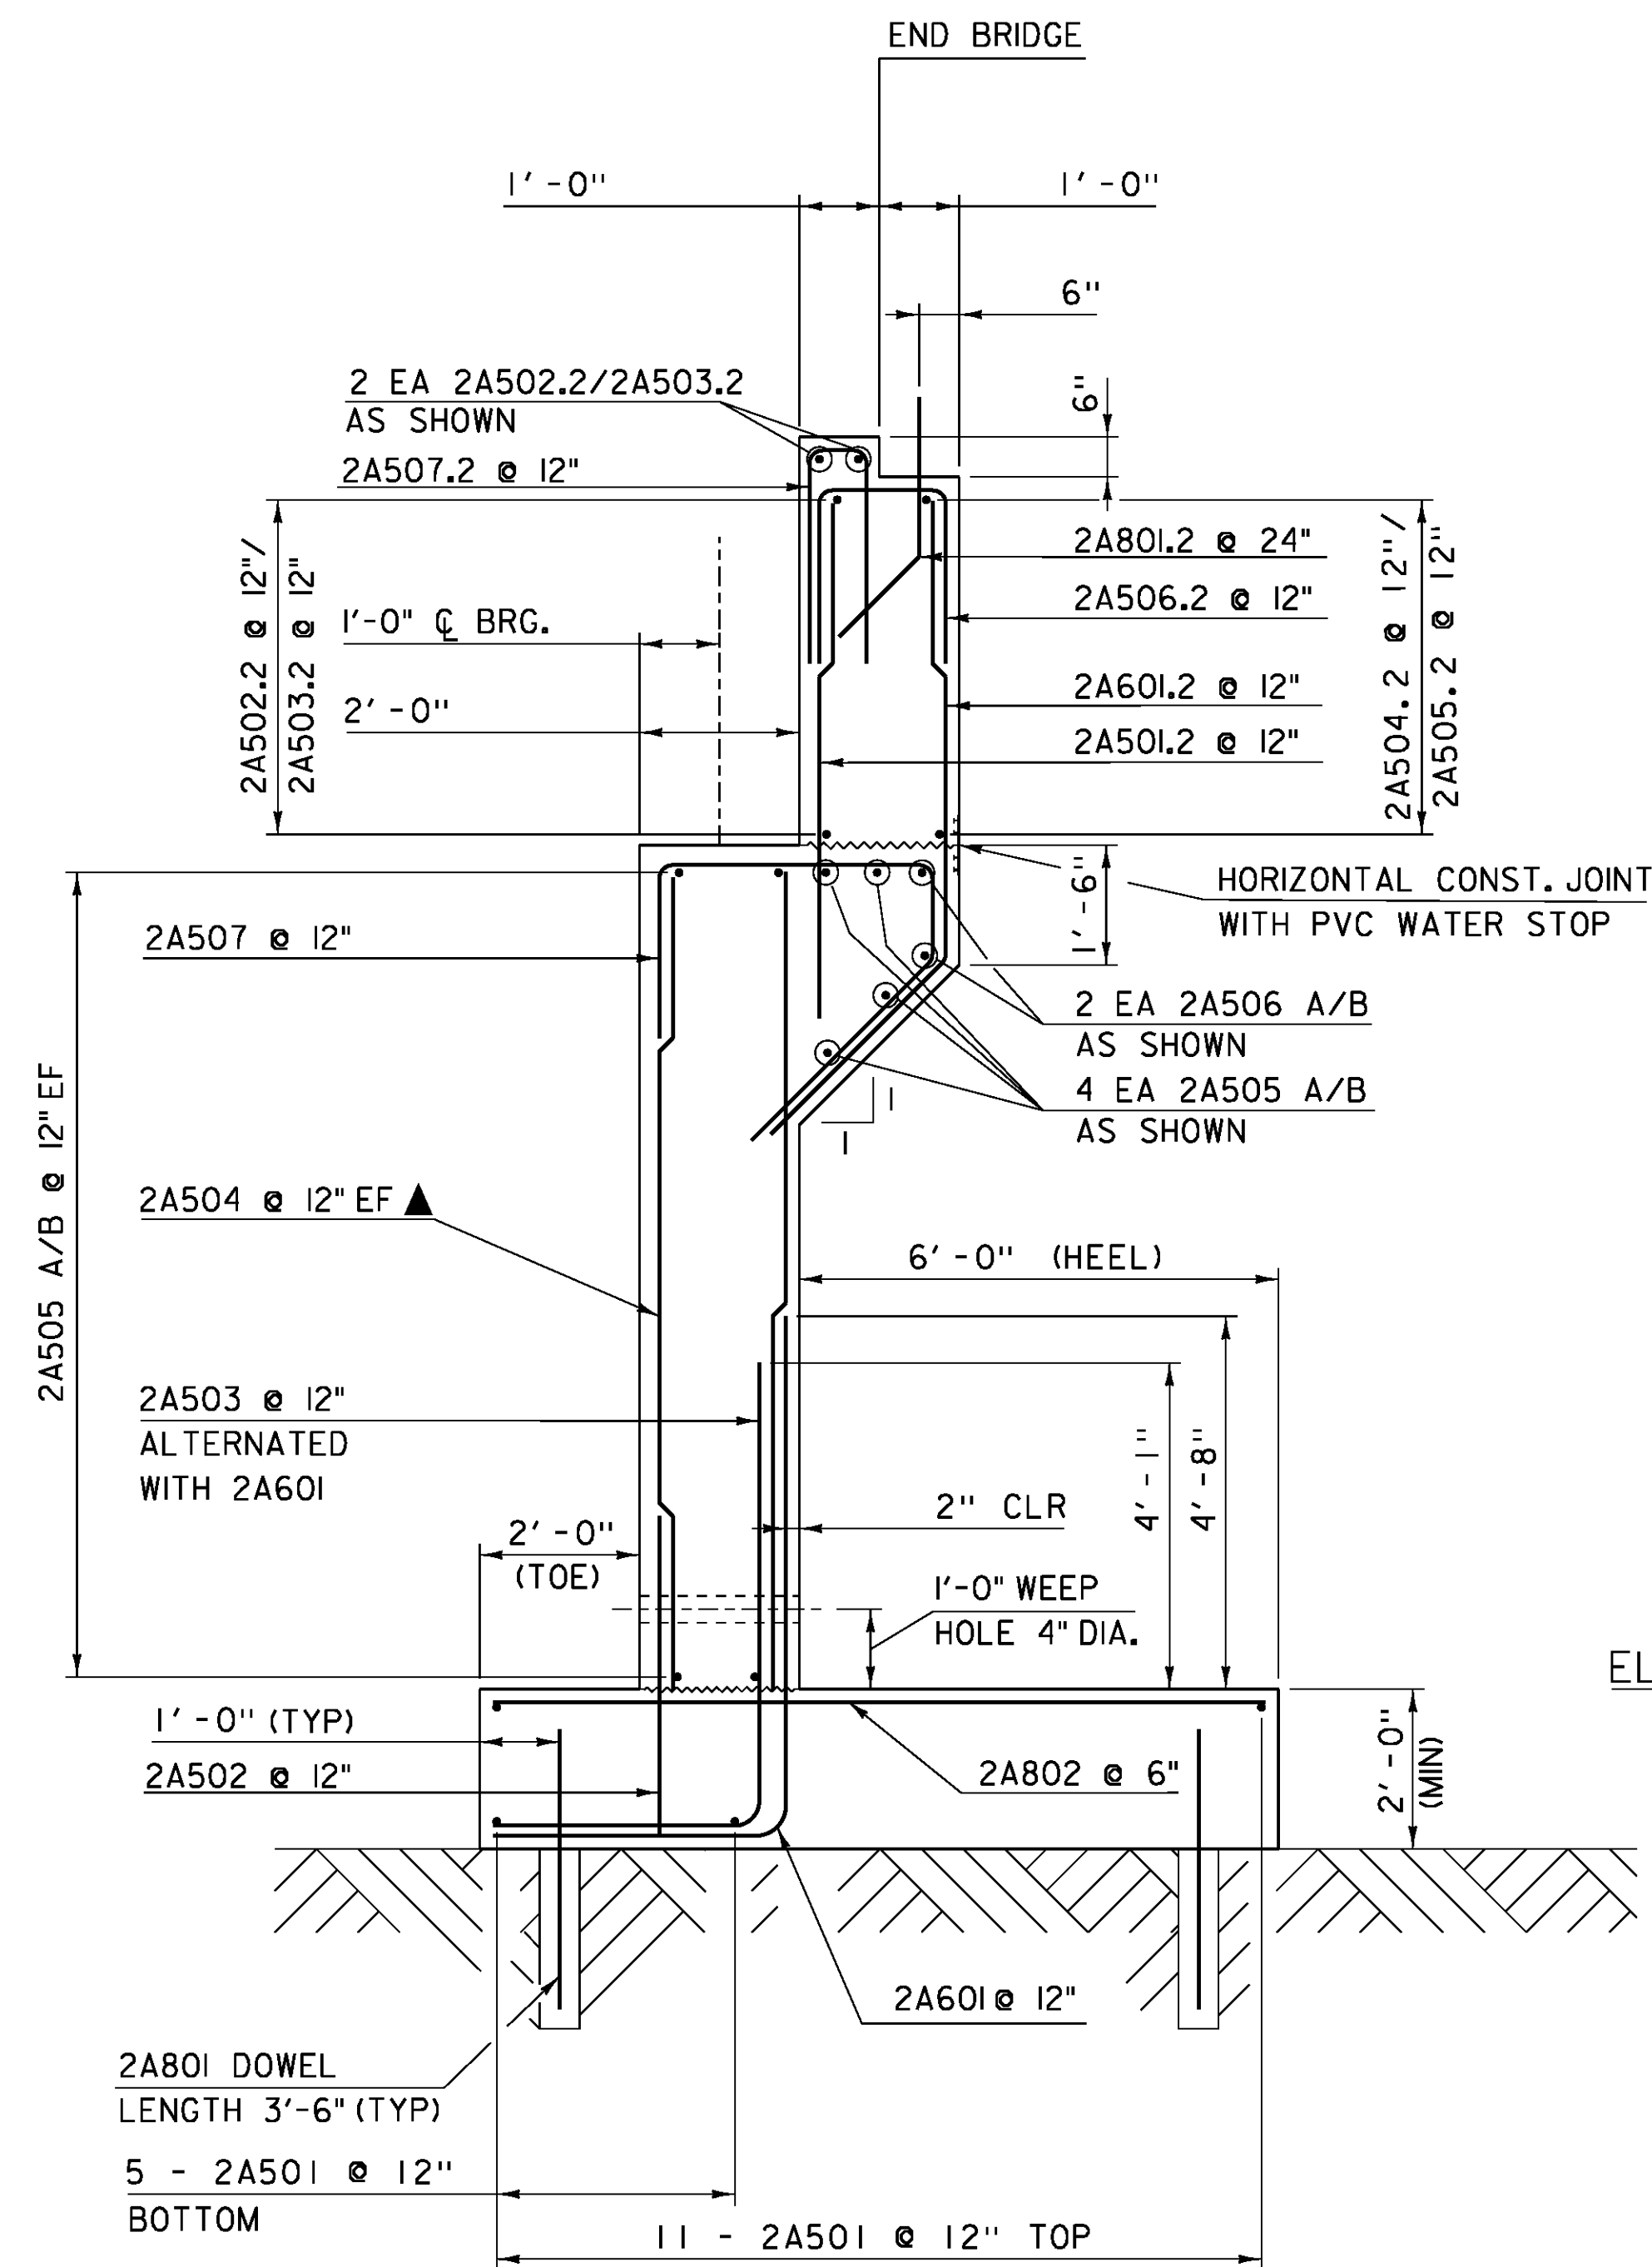


ABUTMENT #2 TYPICAL

SCALE 1/2" = 1'-0"

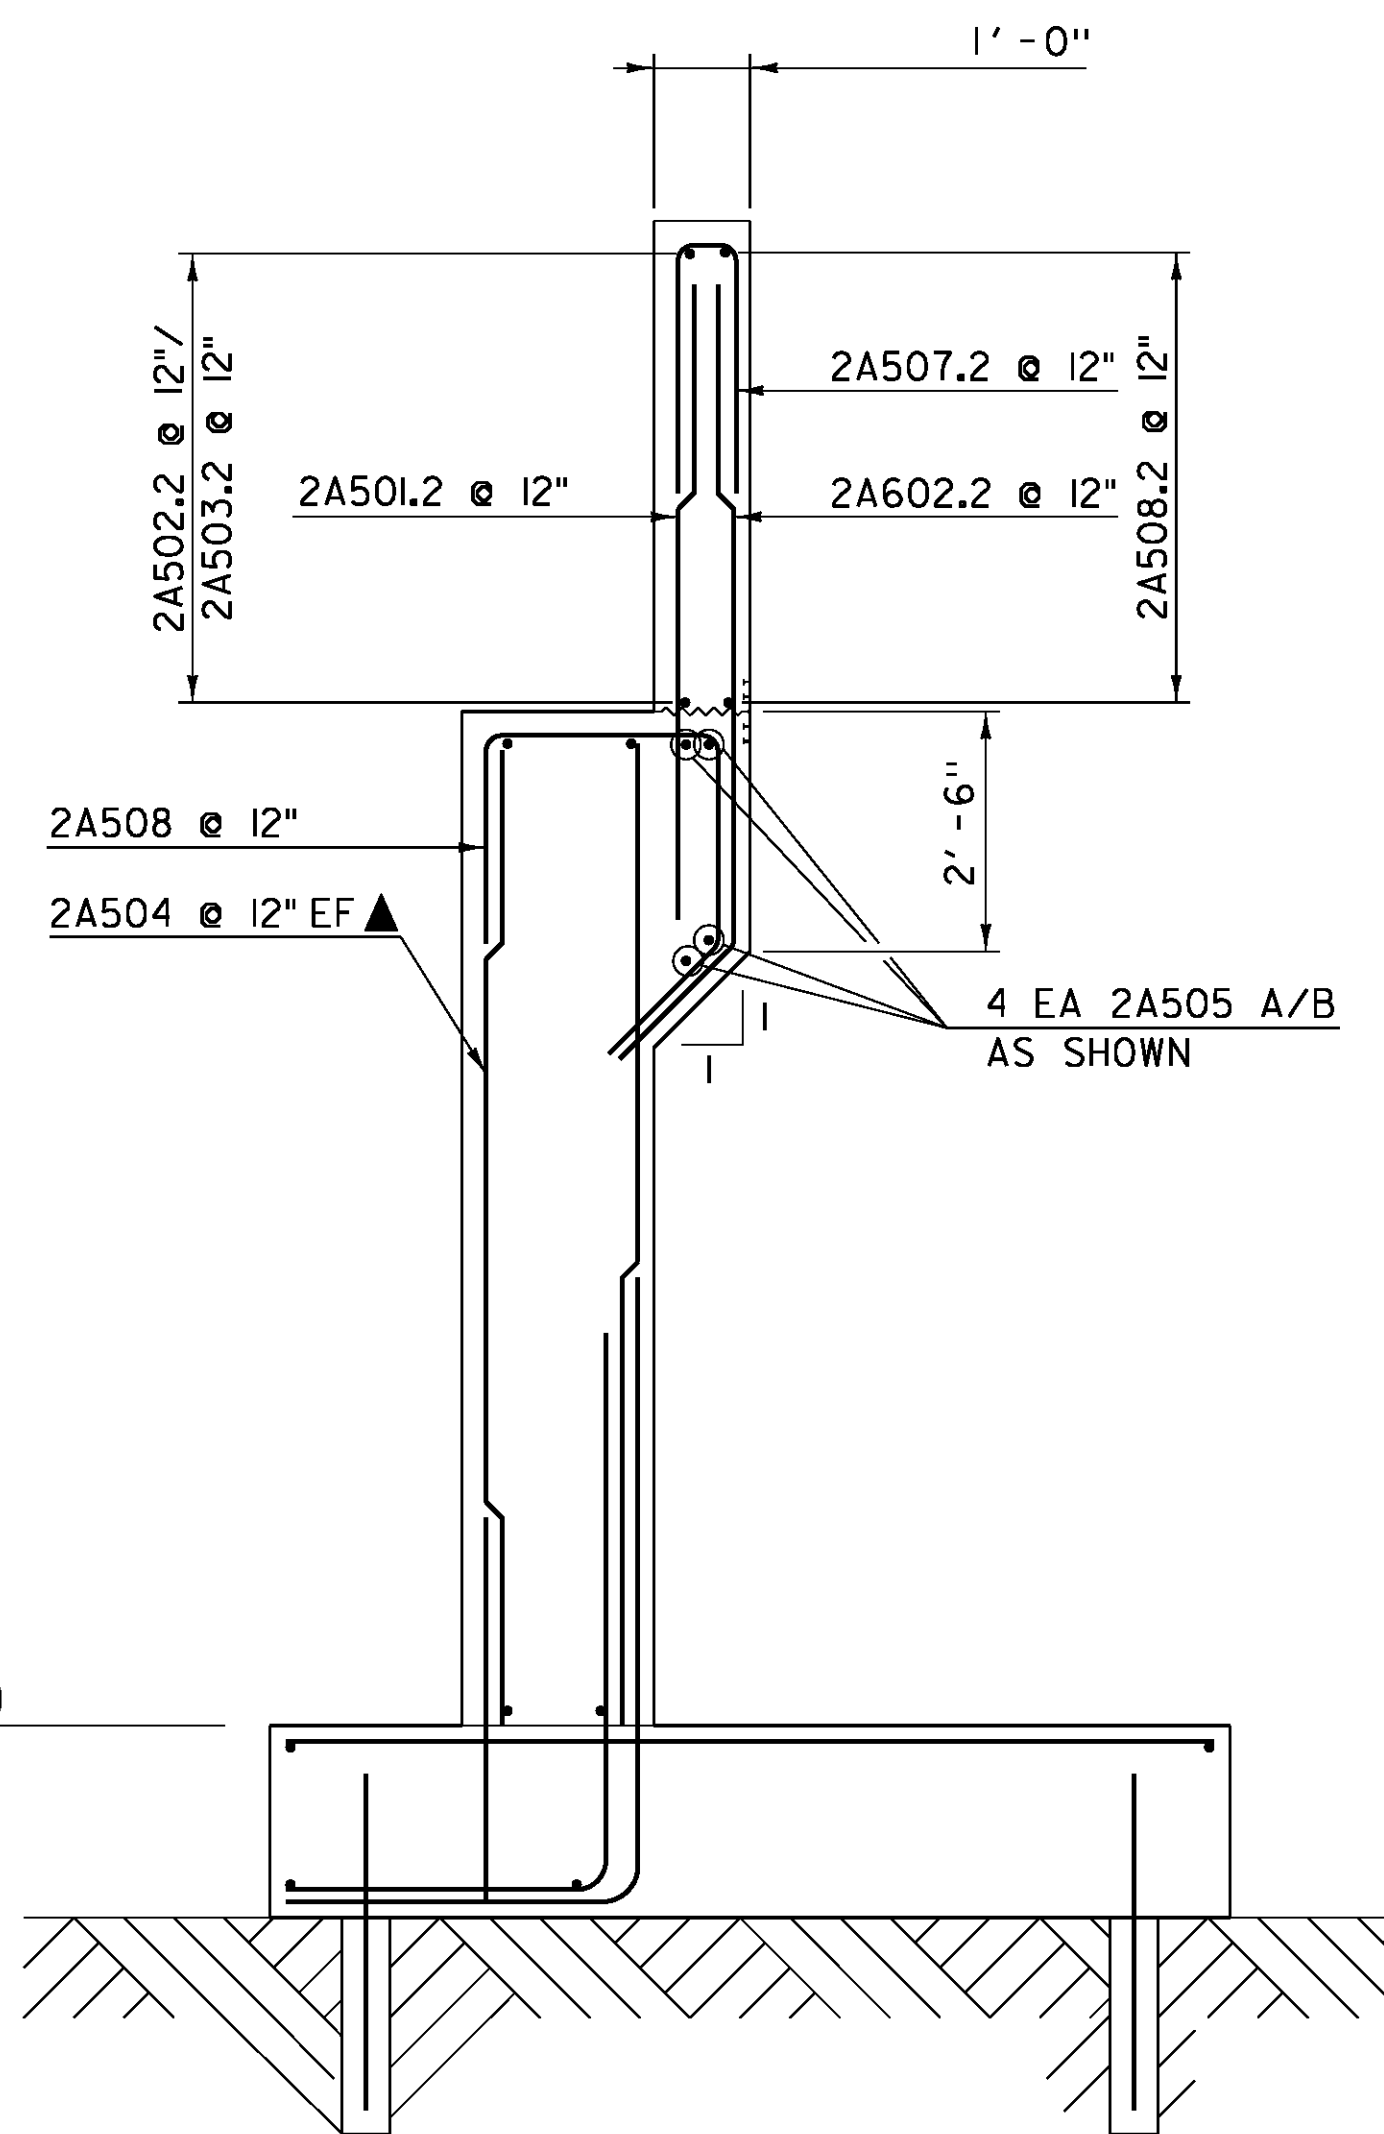

A-A SECTION ABUTMENT #2

SCALE 1/2" = 1'-0"

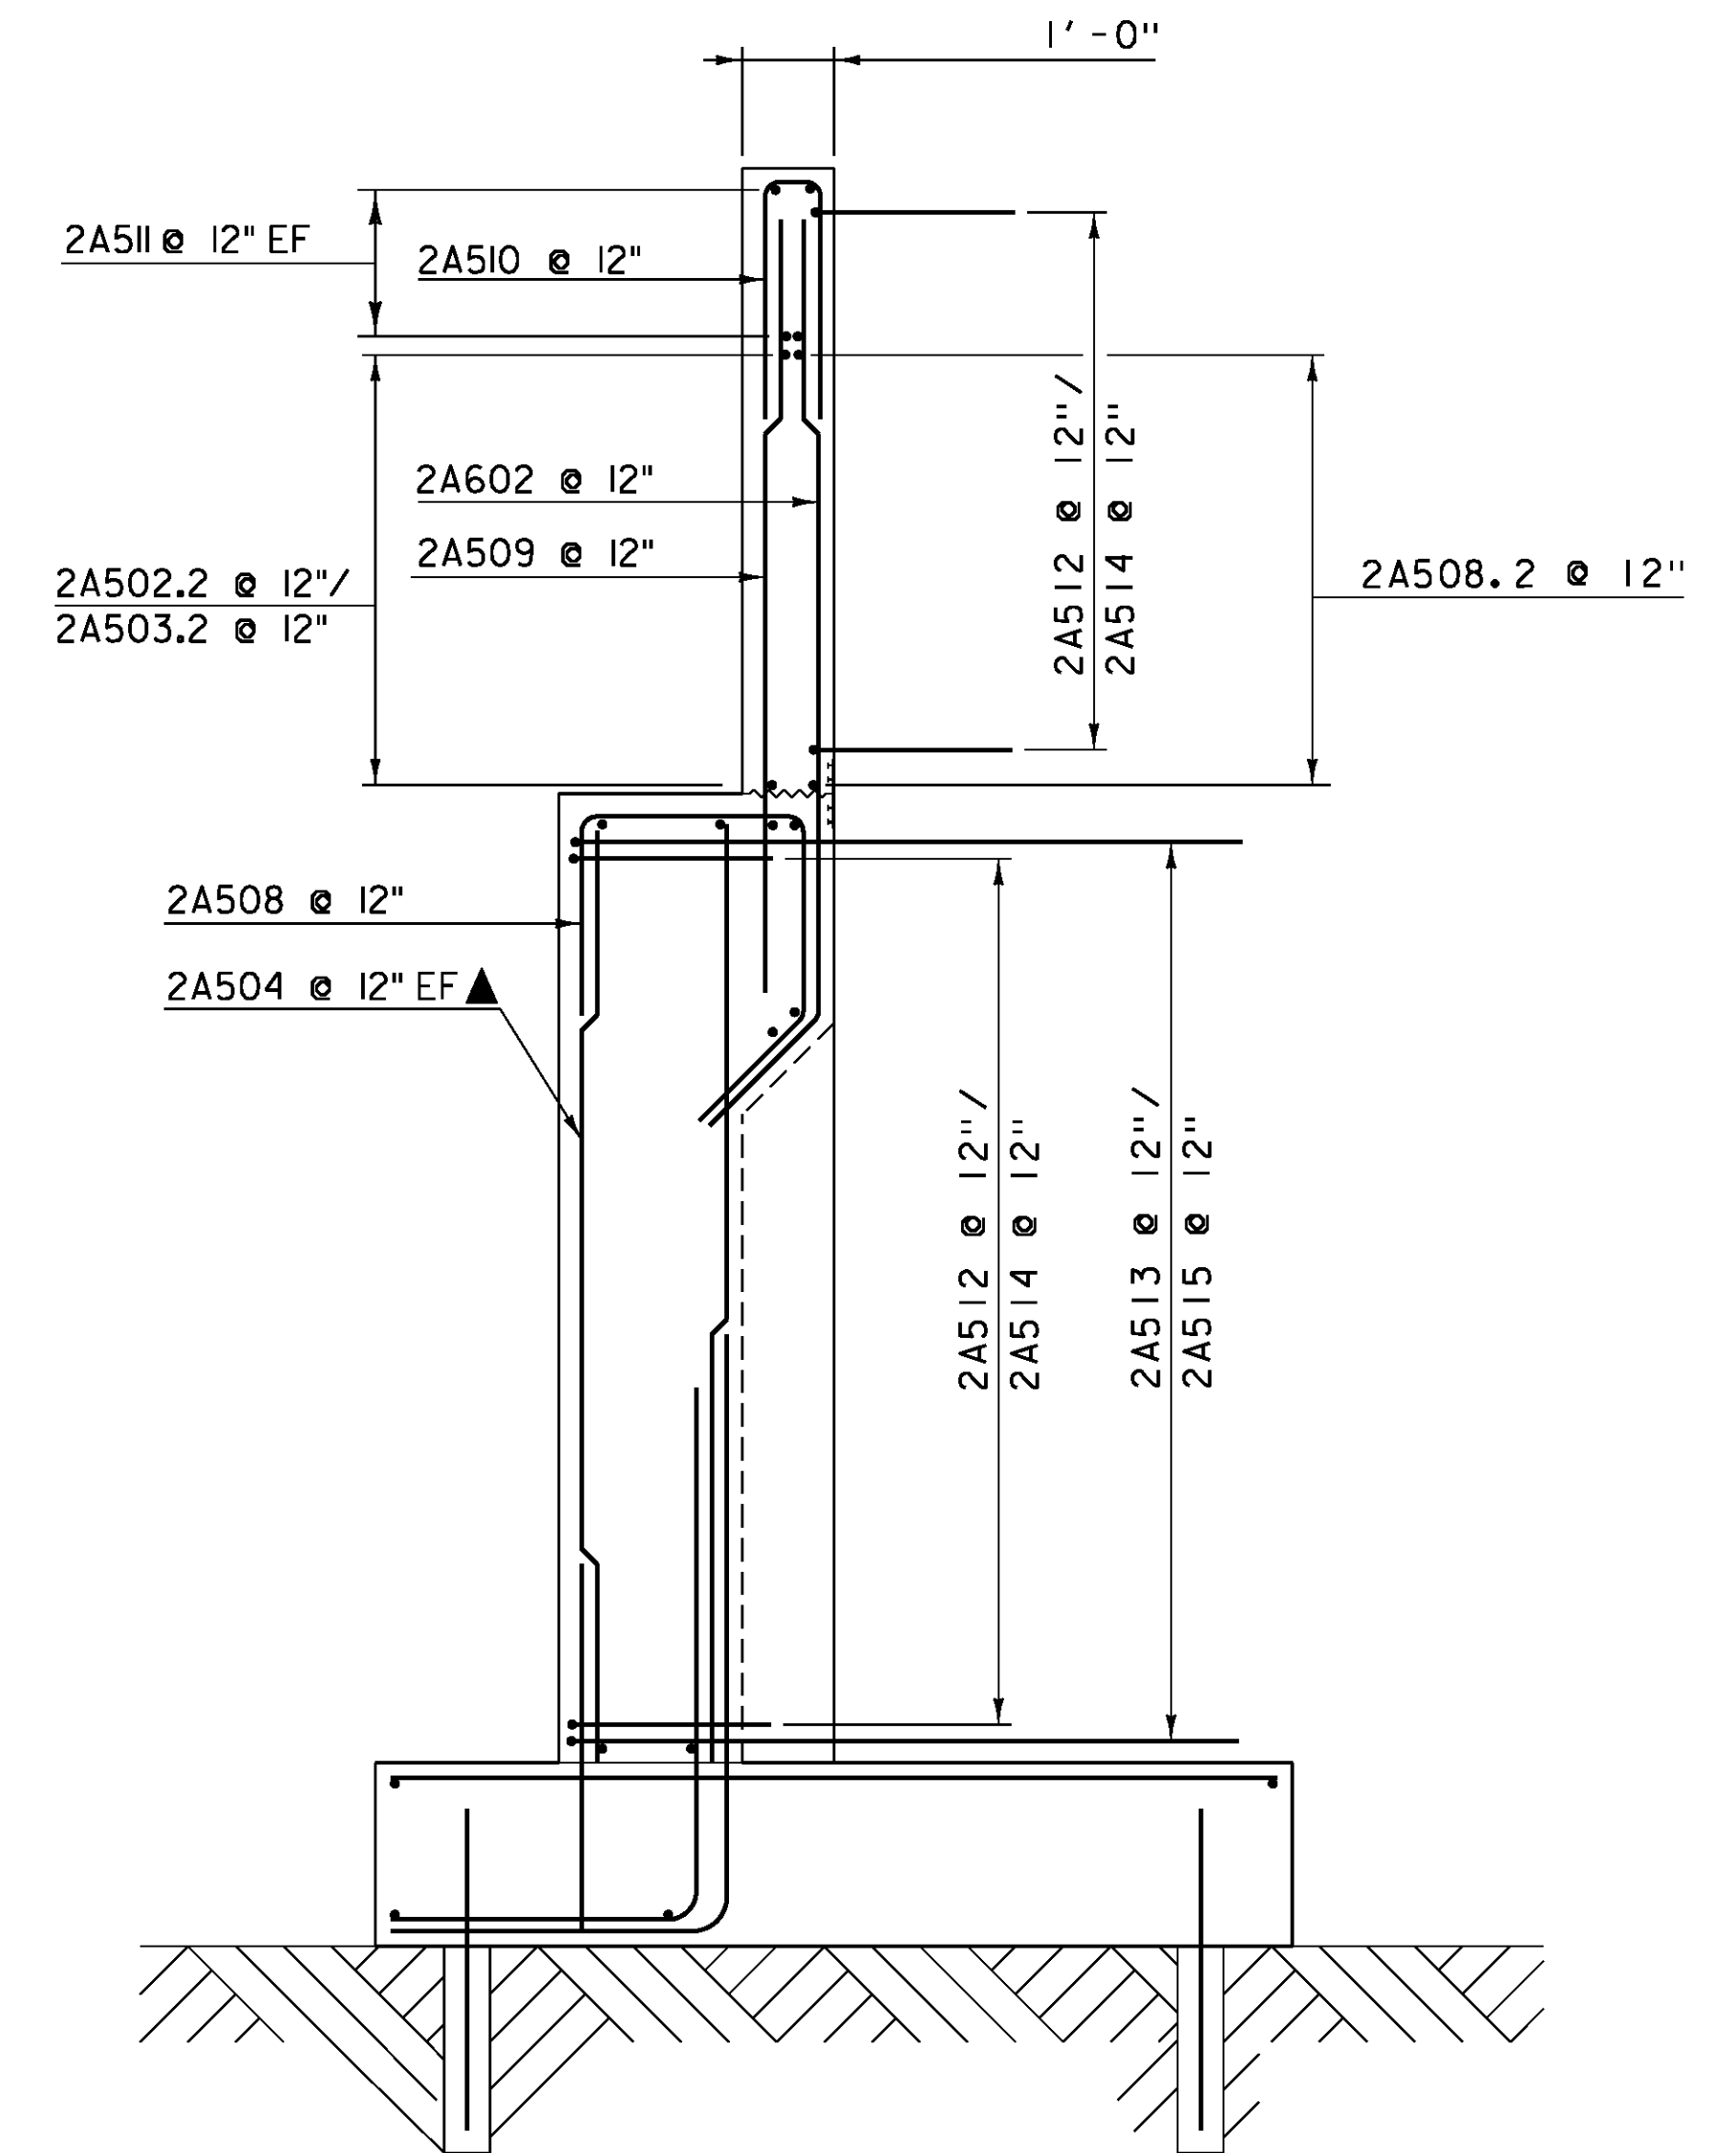


B-B SECTION ABUTMENT #2

SCALE 1/2" = 1'-0"

NOTE:


- NF = NEAR FACE
- FF = FAR FACE
- EF = EACH FACE
- ▲ = CUT TO FIT IN FIELD
- 3" CLEAR, UNLESS OTHERWISE SPECIFIED ON THE PLANS.
- 2'-2" BAR LAP UNLESS OTHERWISE SPECIFIED ON THE PLANS.

PROJECT NAME:	ROYALTON	FILE NAME:	86e055/STR/86e055sub.dgn	PLOT DATE:	08-OCT-2013
PROJECT NUMBER:	BRS 0147 (13)	PROJECT LEADER:	C.CARLSON	DRAWN BY:	G.ROKES
		DESIGNED BY:	D.PETERSON	CHECKED BY:	D.PETERSON
			BRIDGE 28 ABUTMENT 2 TYPICAL		SHEET 127 OF 186

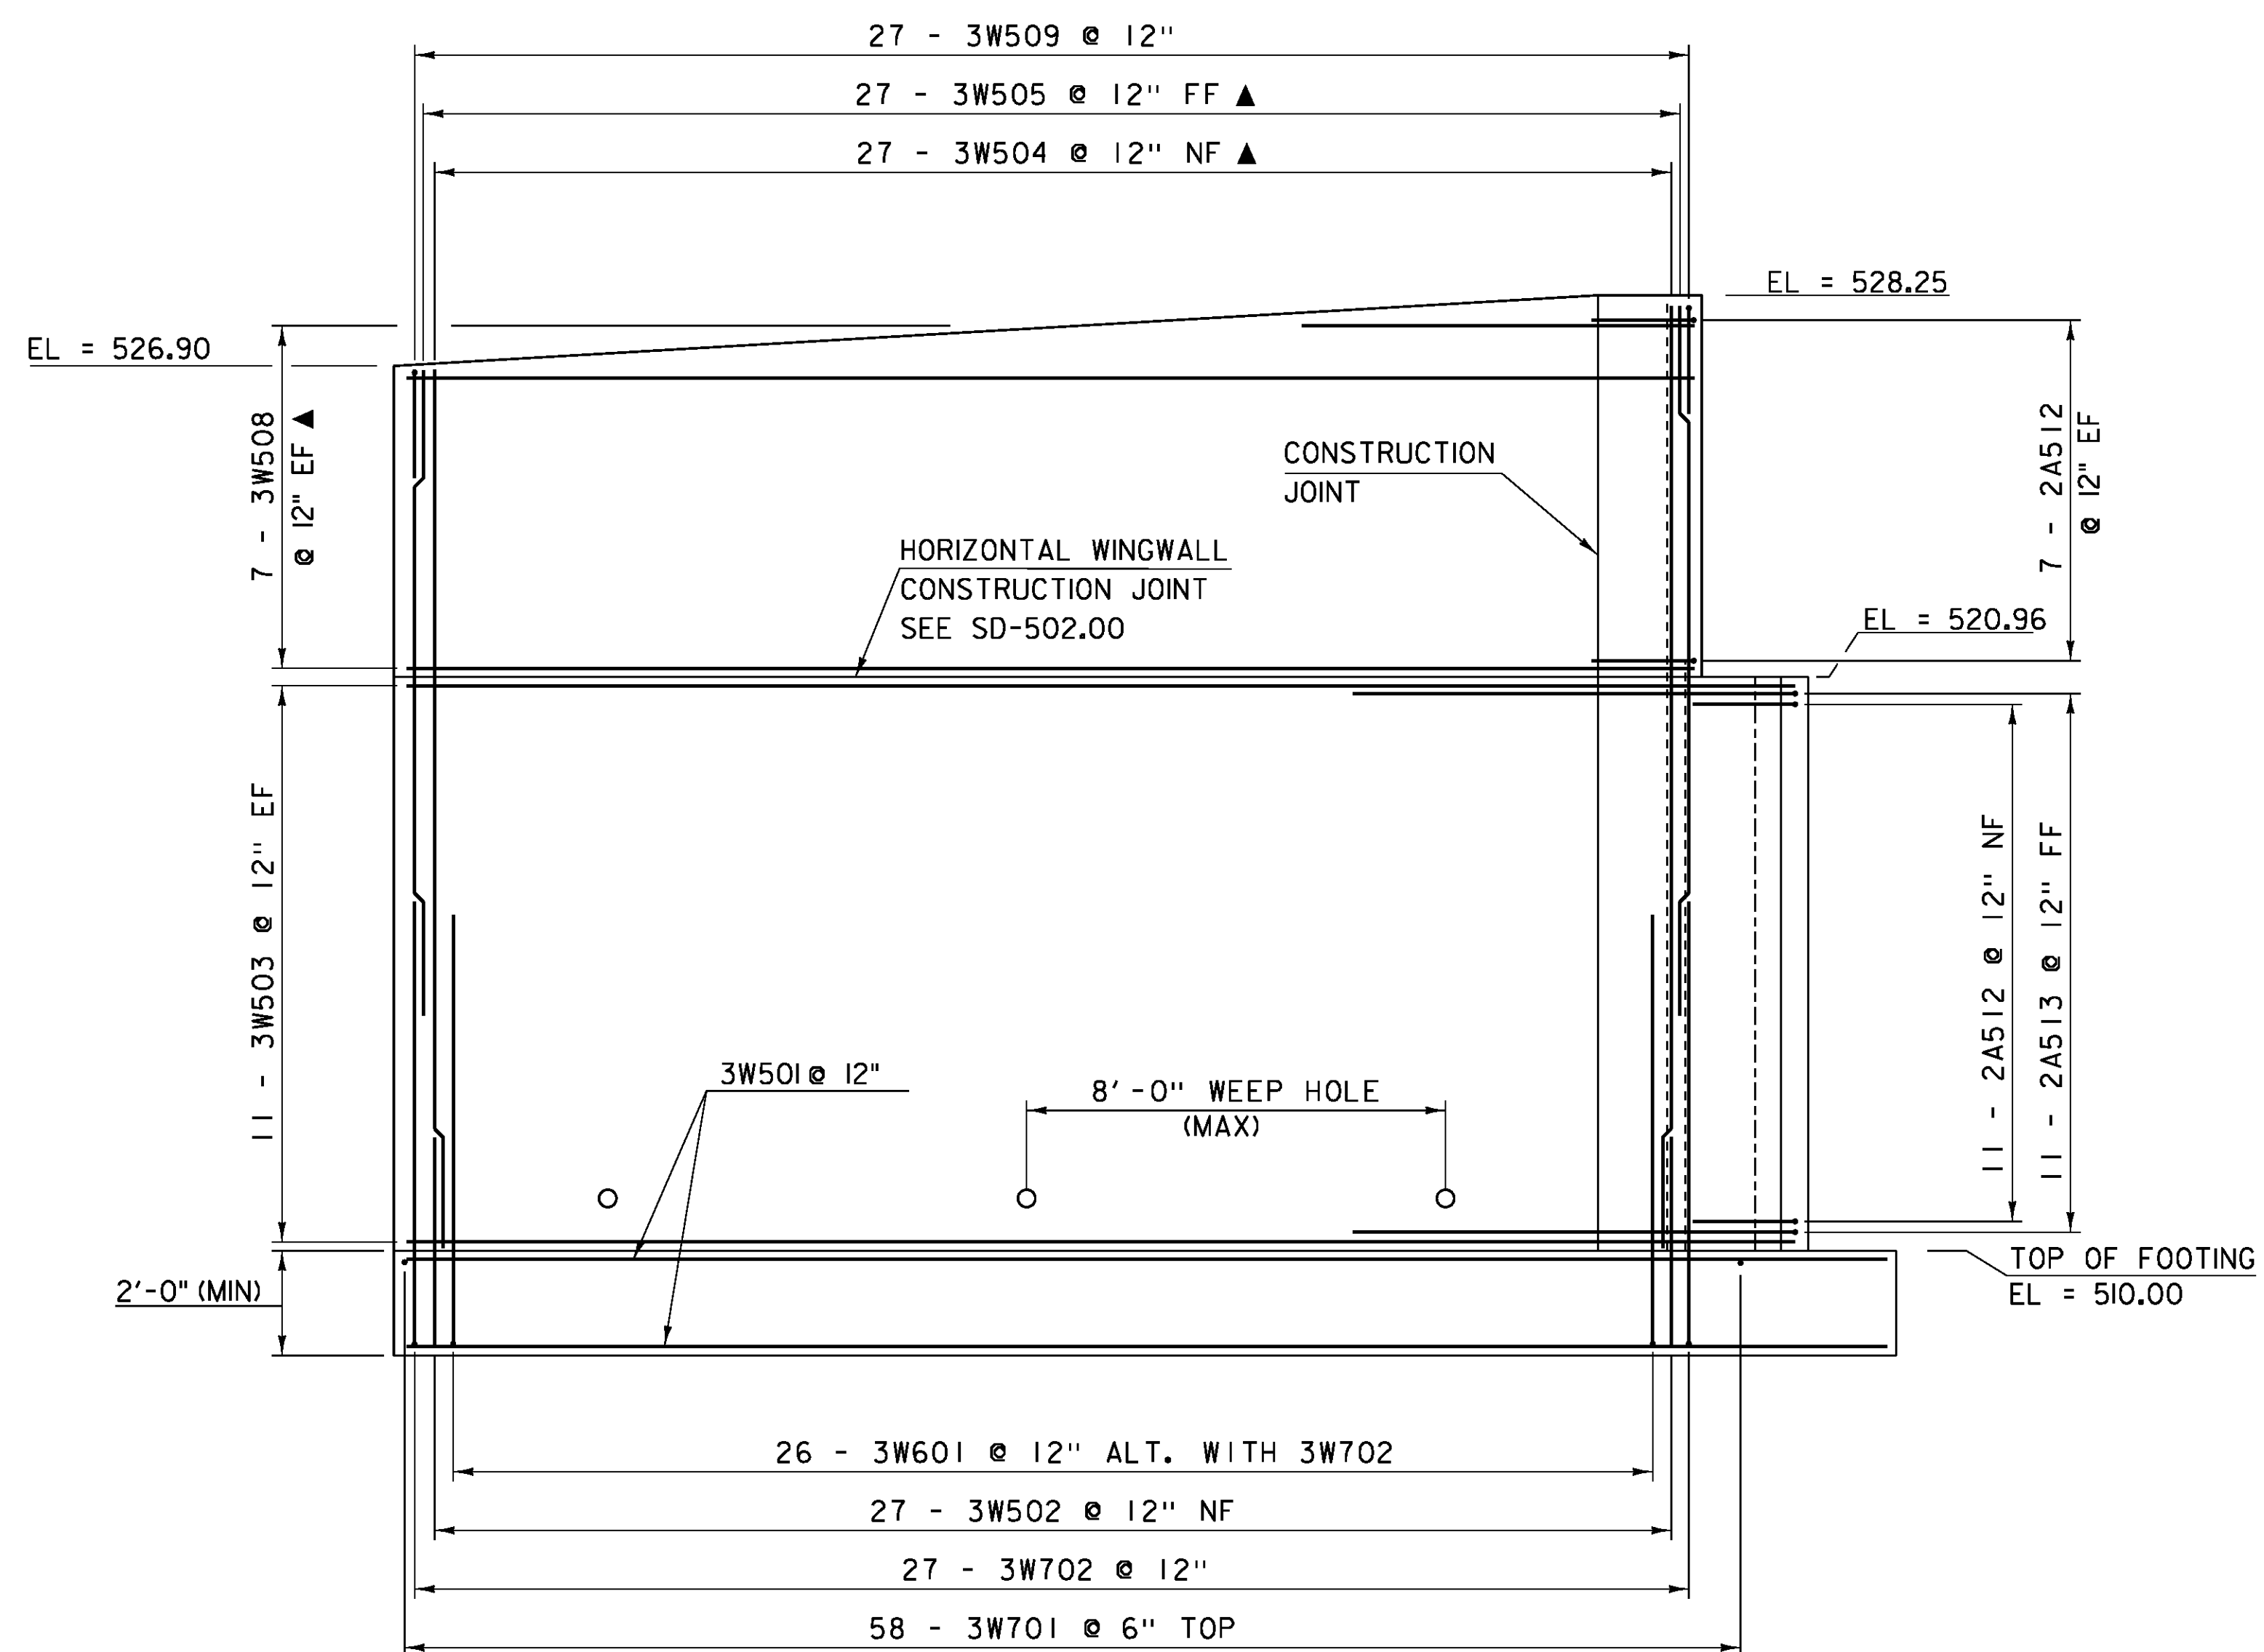

WINGWALL #3 ELEVATION

SCALE 3/8" = 1'-0"

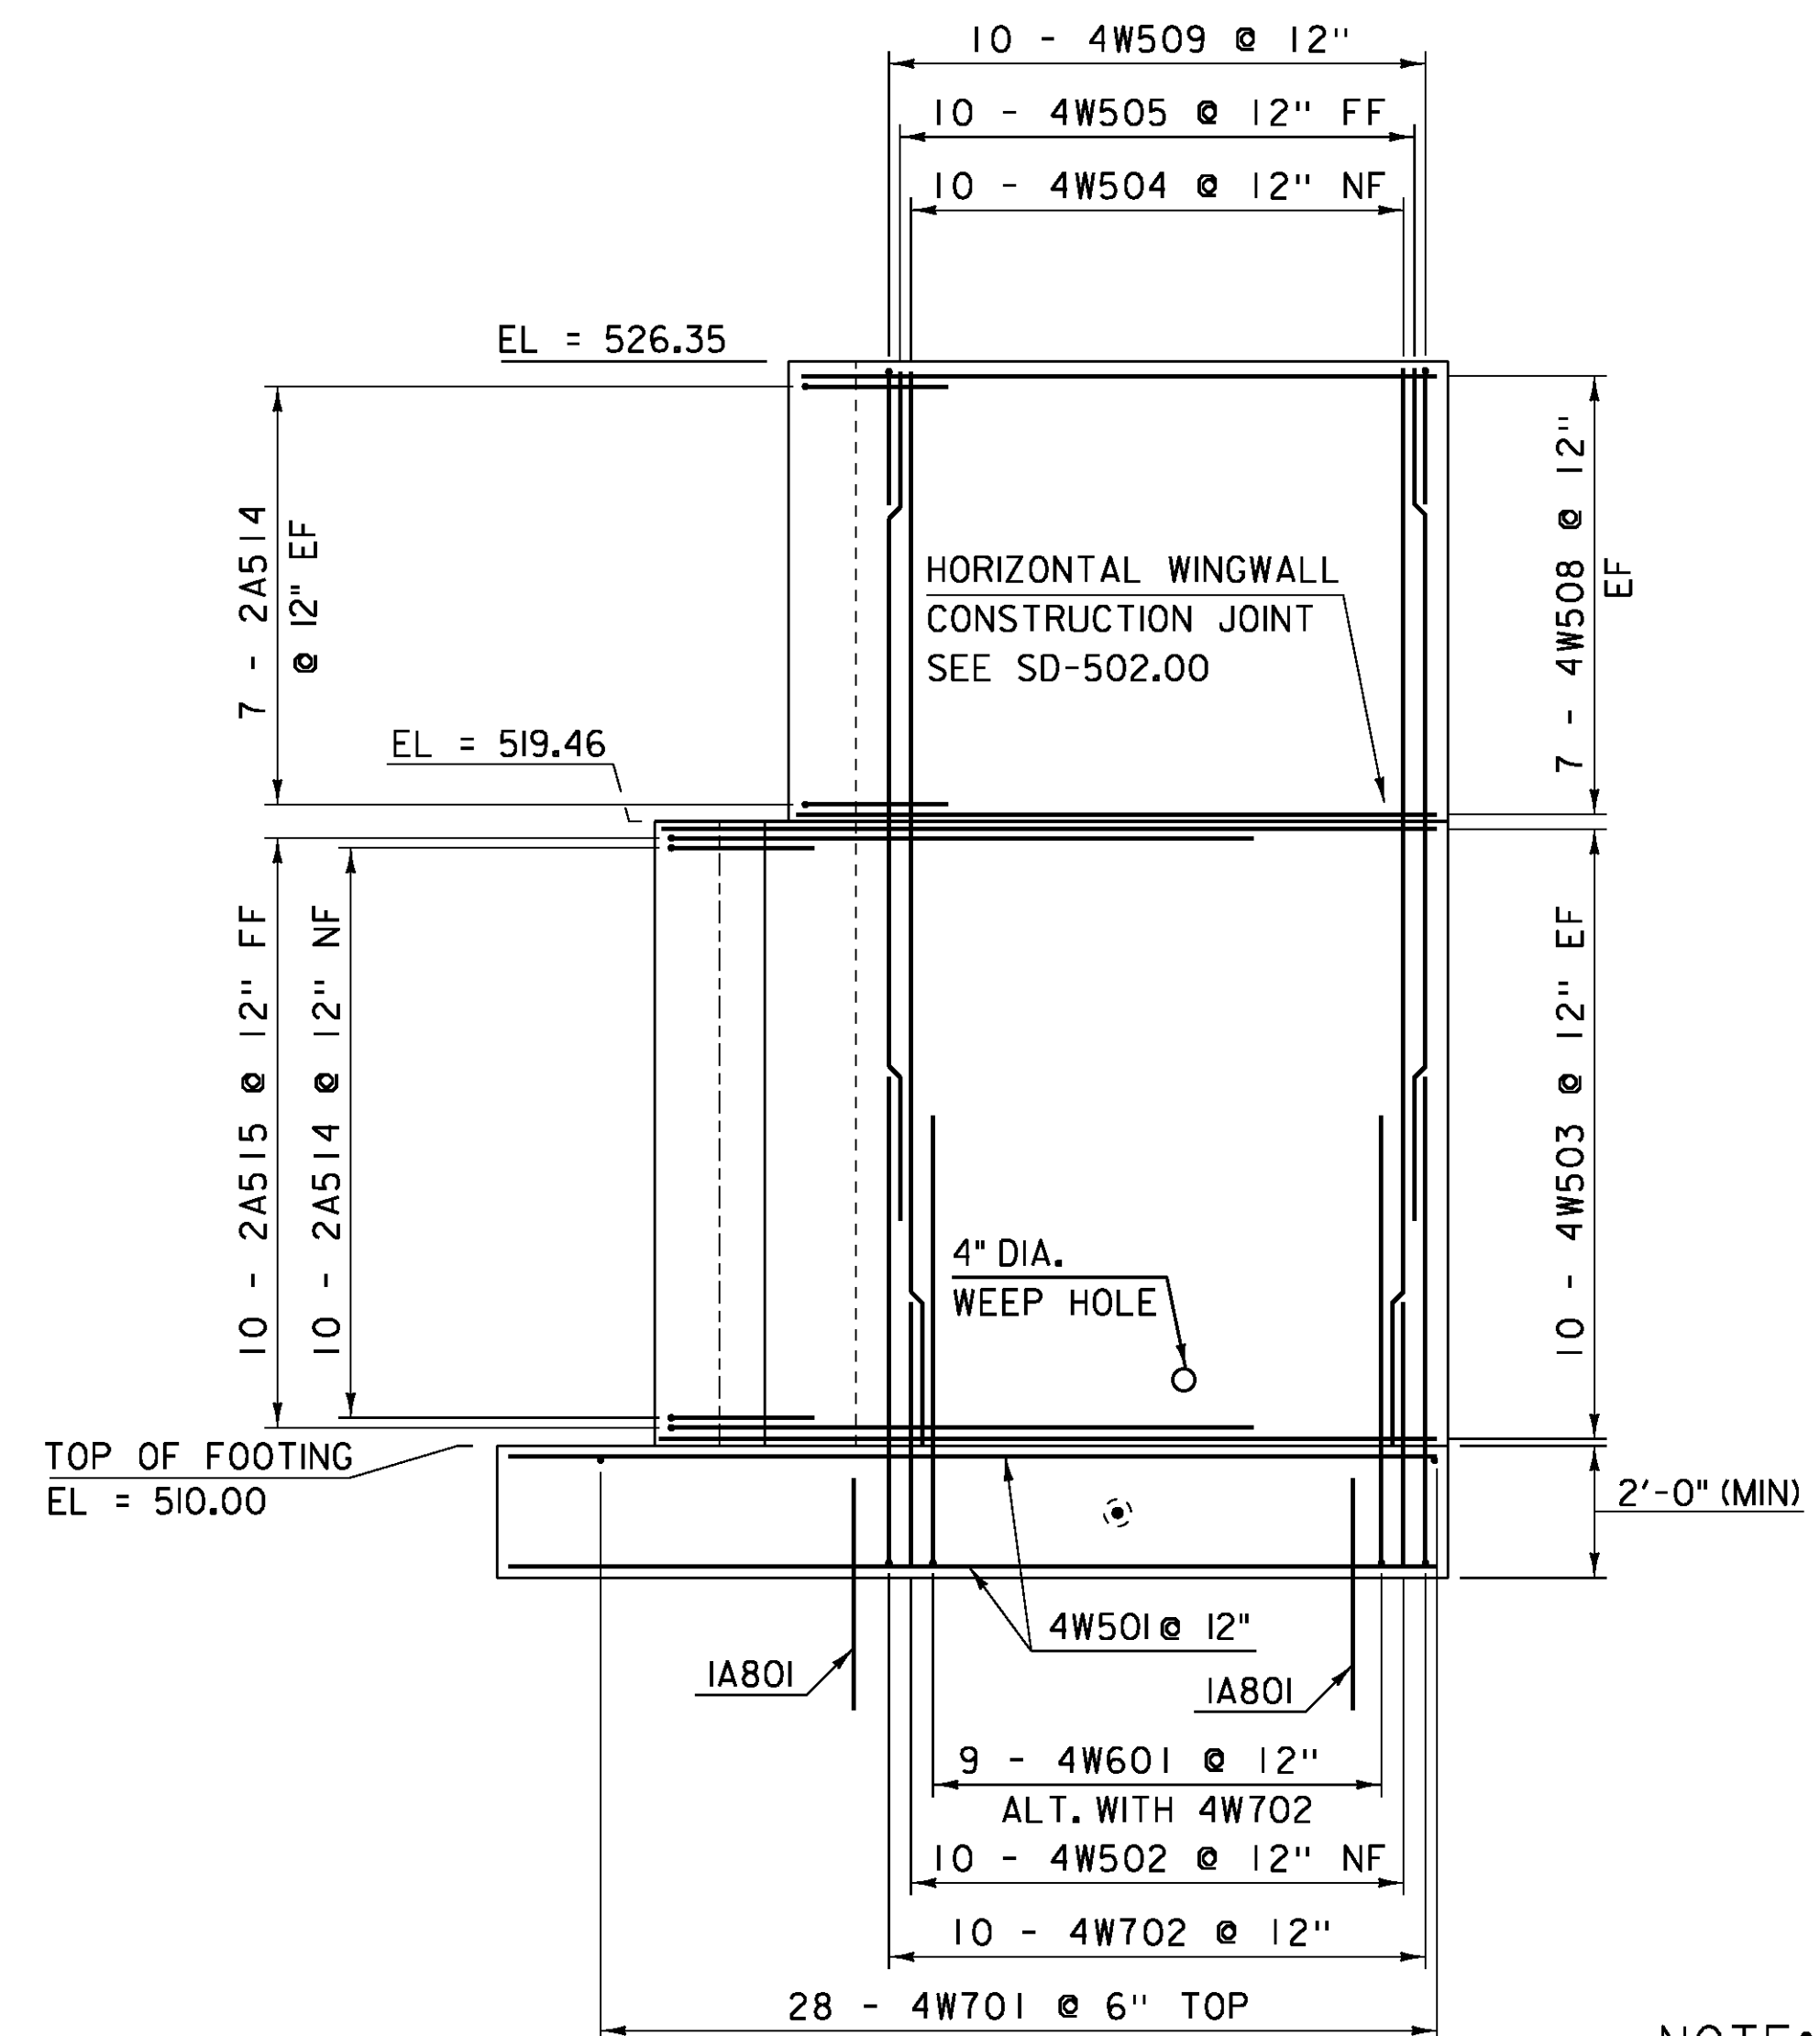

WINGWALL #4 ELEVATION


SCALE 3/8" = 1'-0"

NOTE:

- NF = NEAR FACE
- FF = FAR FACE
- EF = EACH FACE
- ▲ = CUT TO FIT IN FIELD
- 3" CLEAR, UNLESS OTHERWISE SPECIFIED ON THE PLANS.
- 2'-2" BAR LAP UNLESS OTHERWISE SPECIFIED ON THE PLANS.


PROJECT NAME:	ROYALTON
PROJECT NUMBER:	BRS 0147 (13)
FILE NAME:	86e055/STR/86e055sub.dgn
PROJECT LEADER:	C.CARLSON
DESIGNED BY:	D.PETERSON
BRIDGE 28 WINGWALL 3 AND 4 ELEVATIONS	
PLOT DATE:	08-OCT-2013
DRAWN BY:	G.ROKES
CHECKED BY:	D.PETERSON
SHEET	128 OF 186



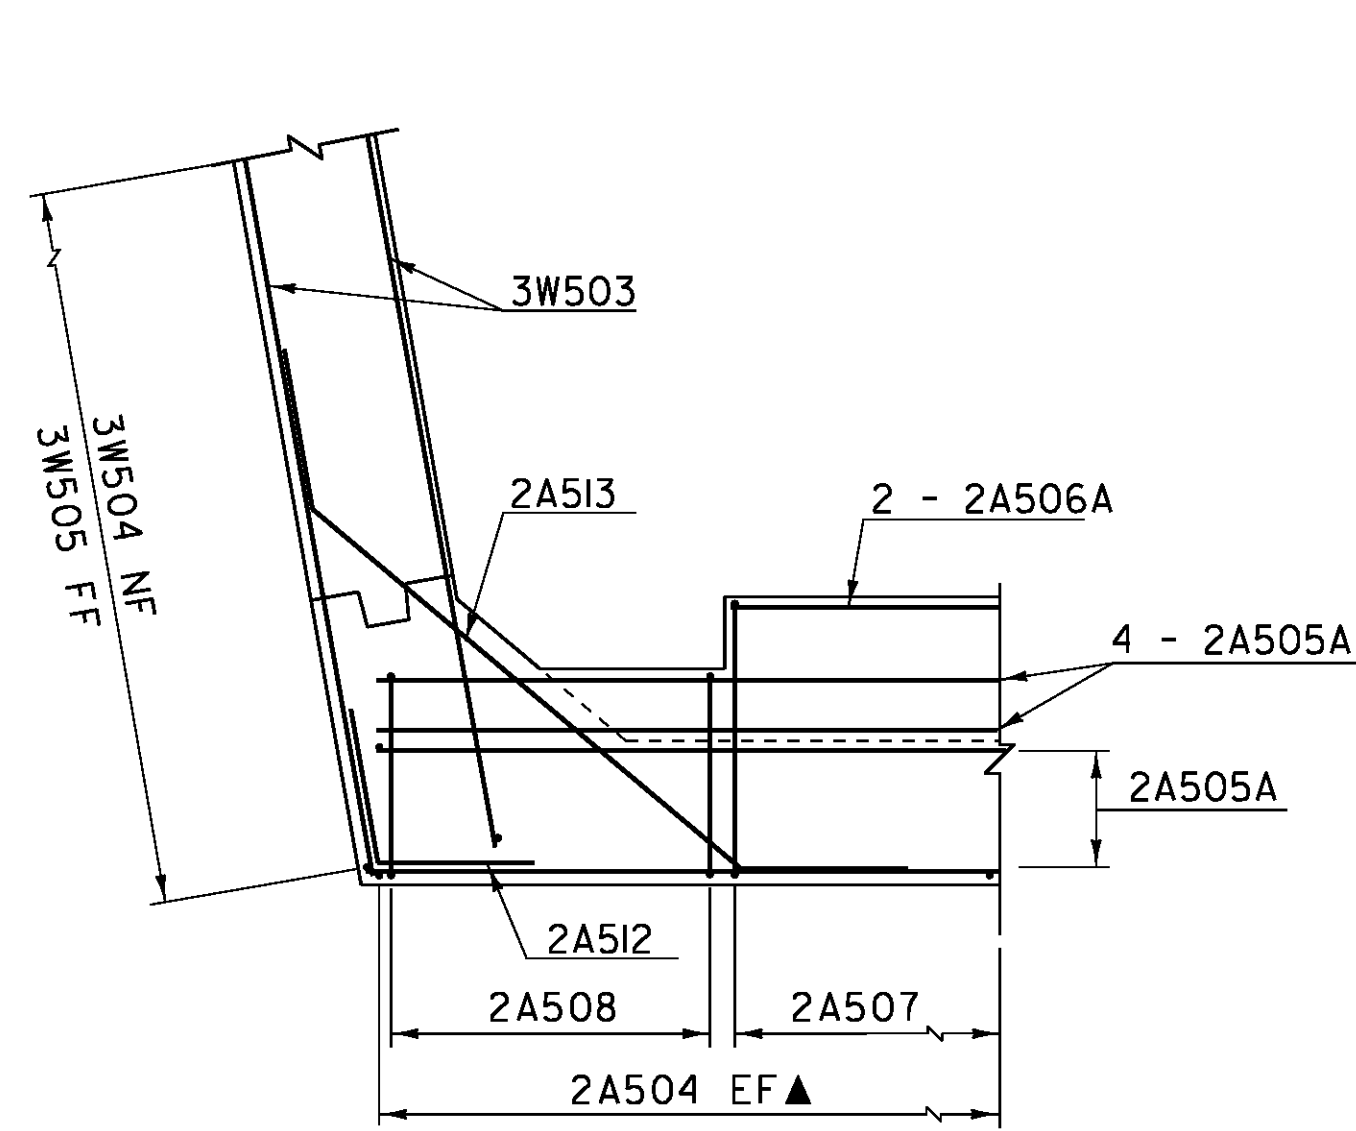


WINGWALL #3 CORNER  
BELOW BRIDGE SEAT

SCALE 3/8" = 1'-0"

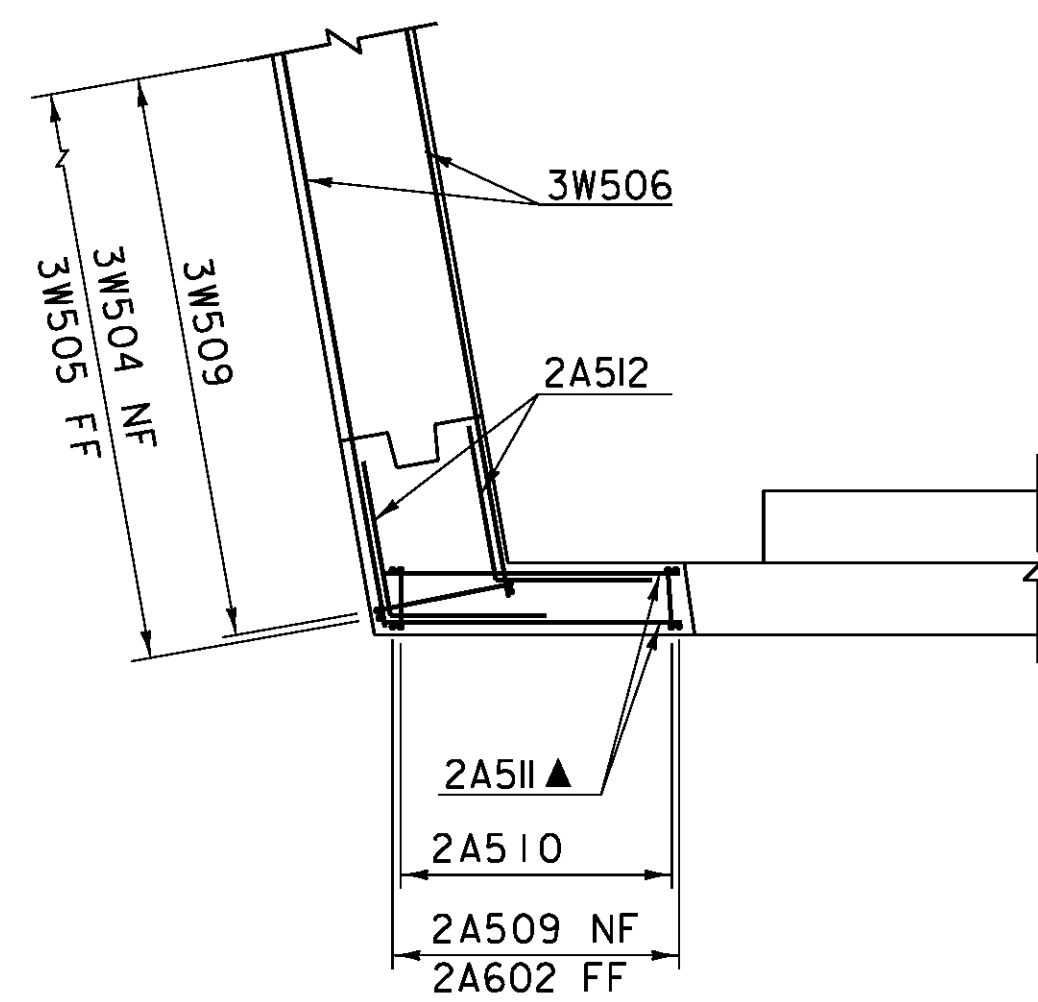


WINGWALL #3 CORNER  
ABOVE BRIDGE SEAT

SCALE 3/8" = 1'-0"

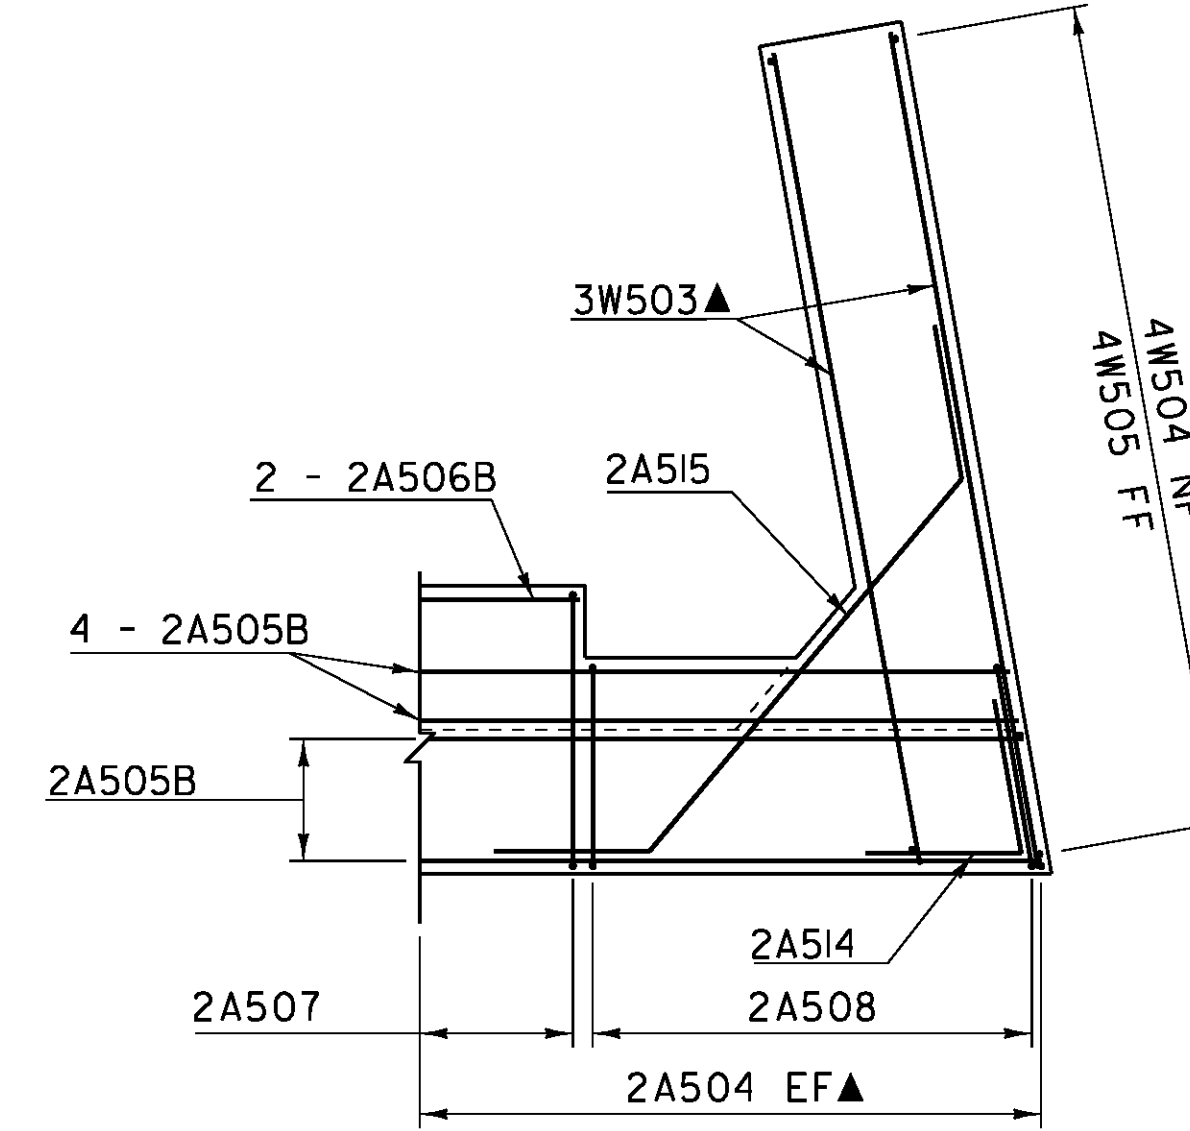


WINGWALL #4 CORNER  
BELOW BRIDGE SEAT

SCALE 3/8" = 1'-0"

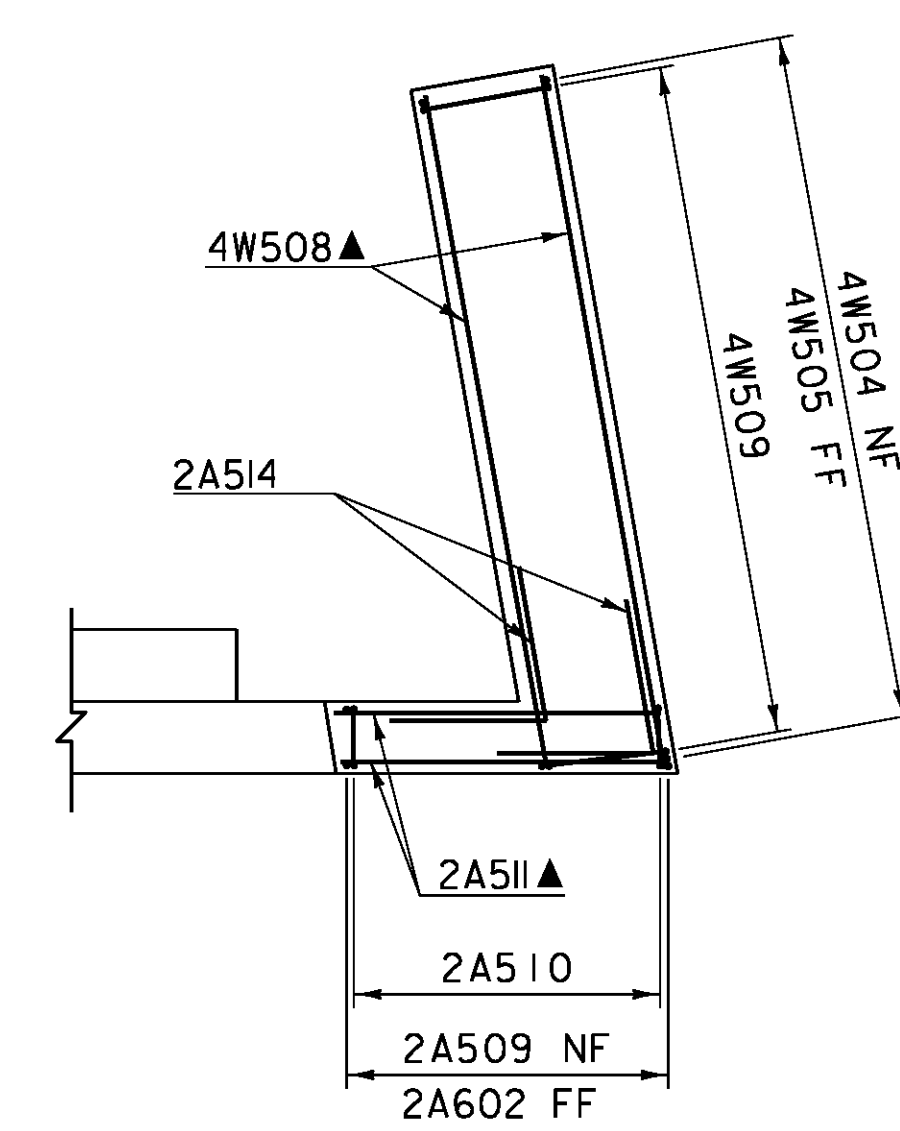


WINGWALL #4 CORNER  
ABOVE BRIDGE SEAT

SCALE 3/8" = 1'-0"

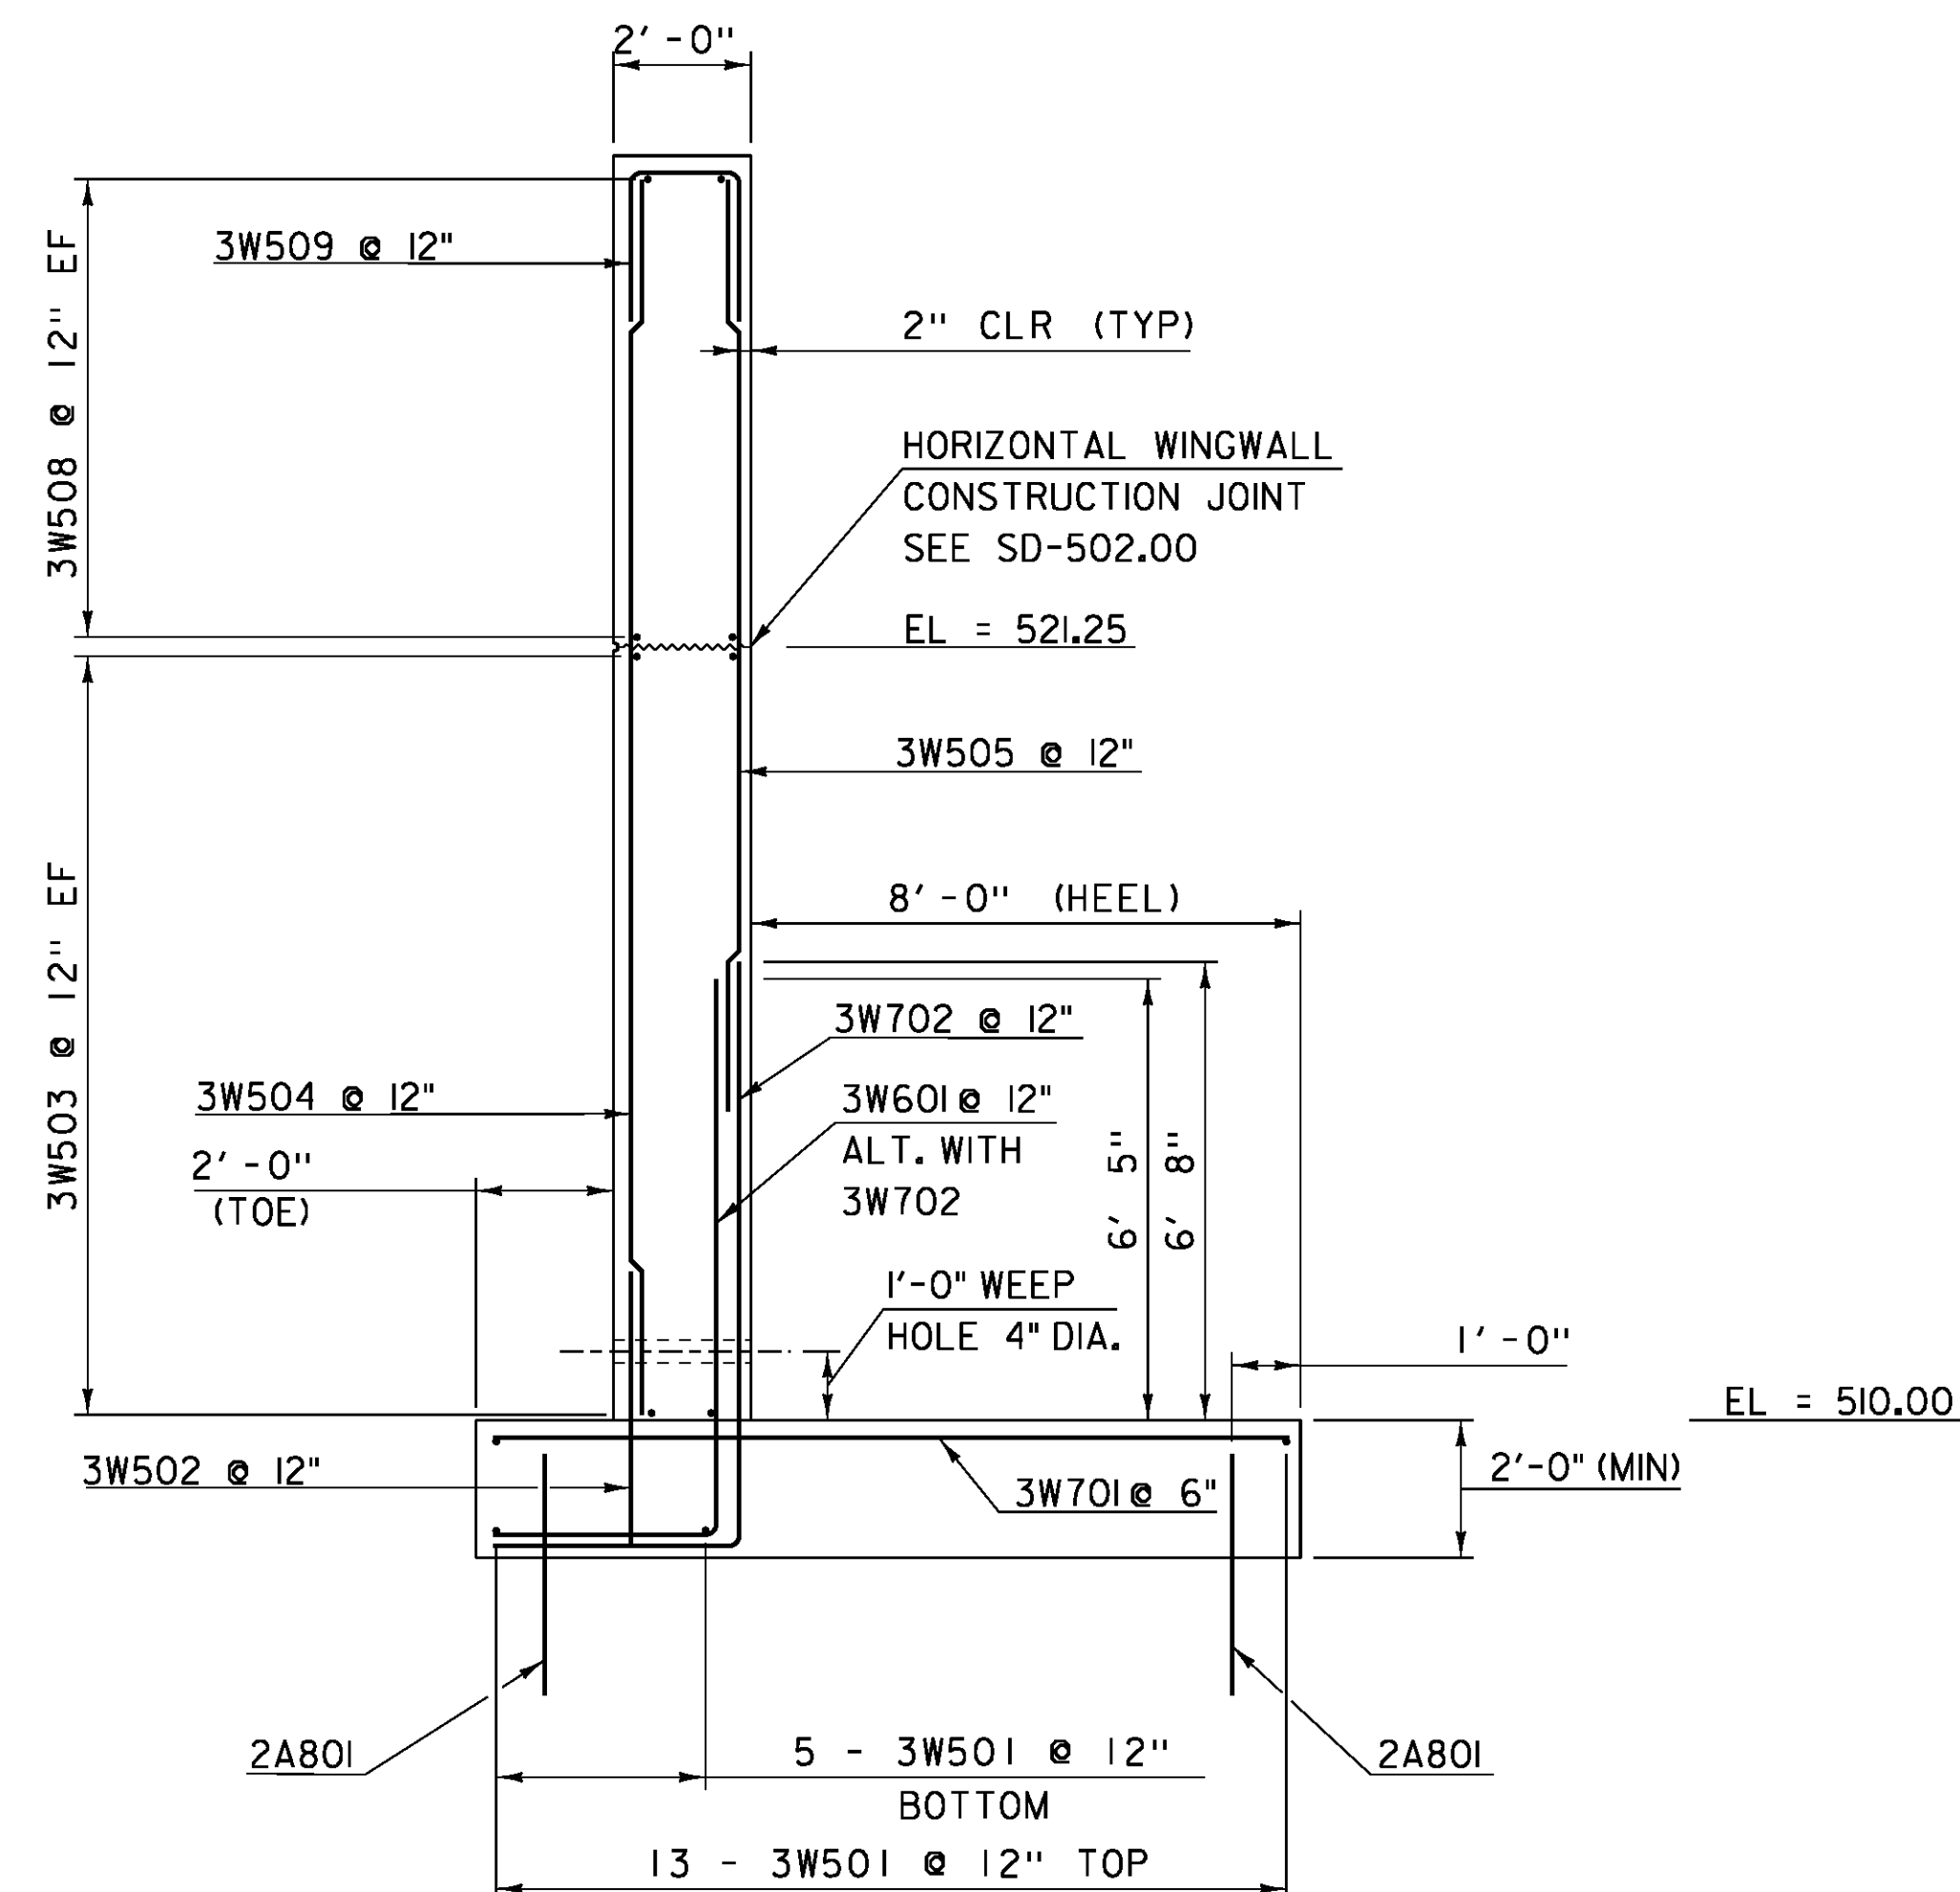

WINGWALL #3 TYPICAL

SCALE 3/8" = 1'-0"

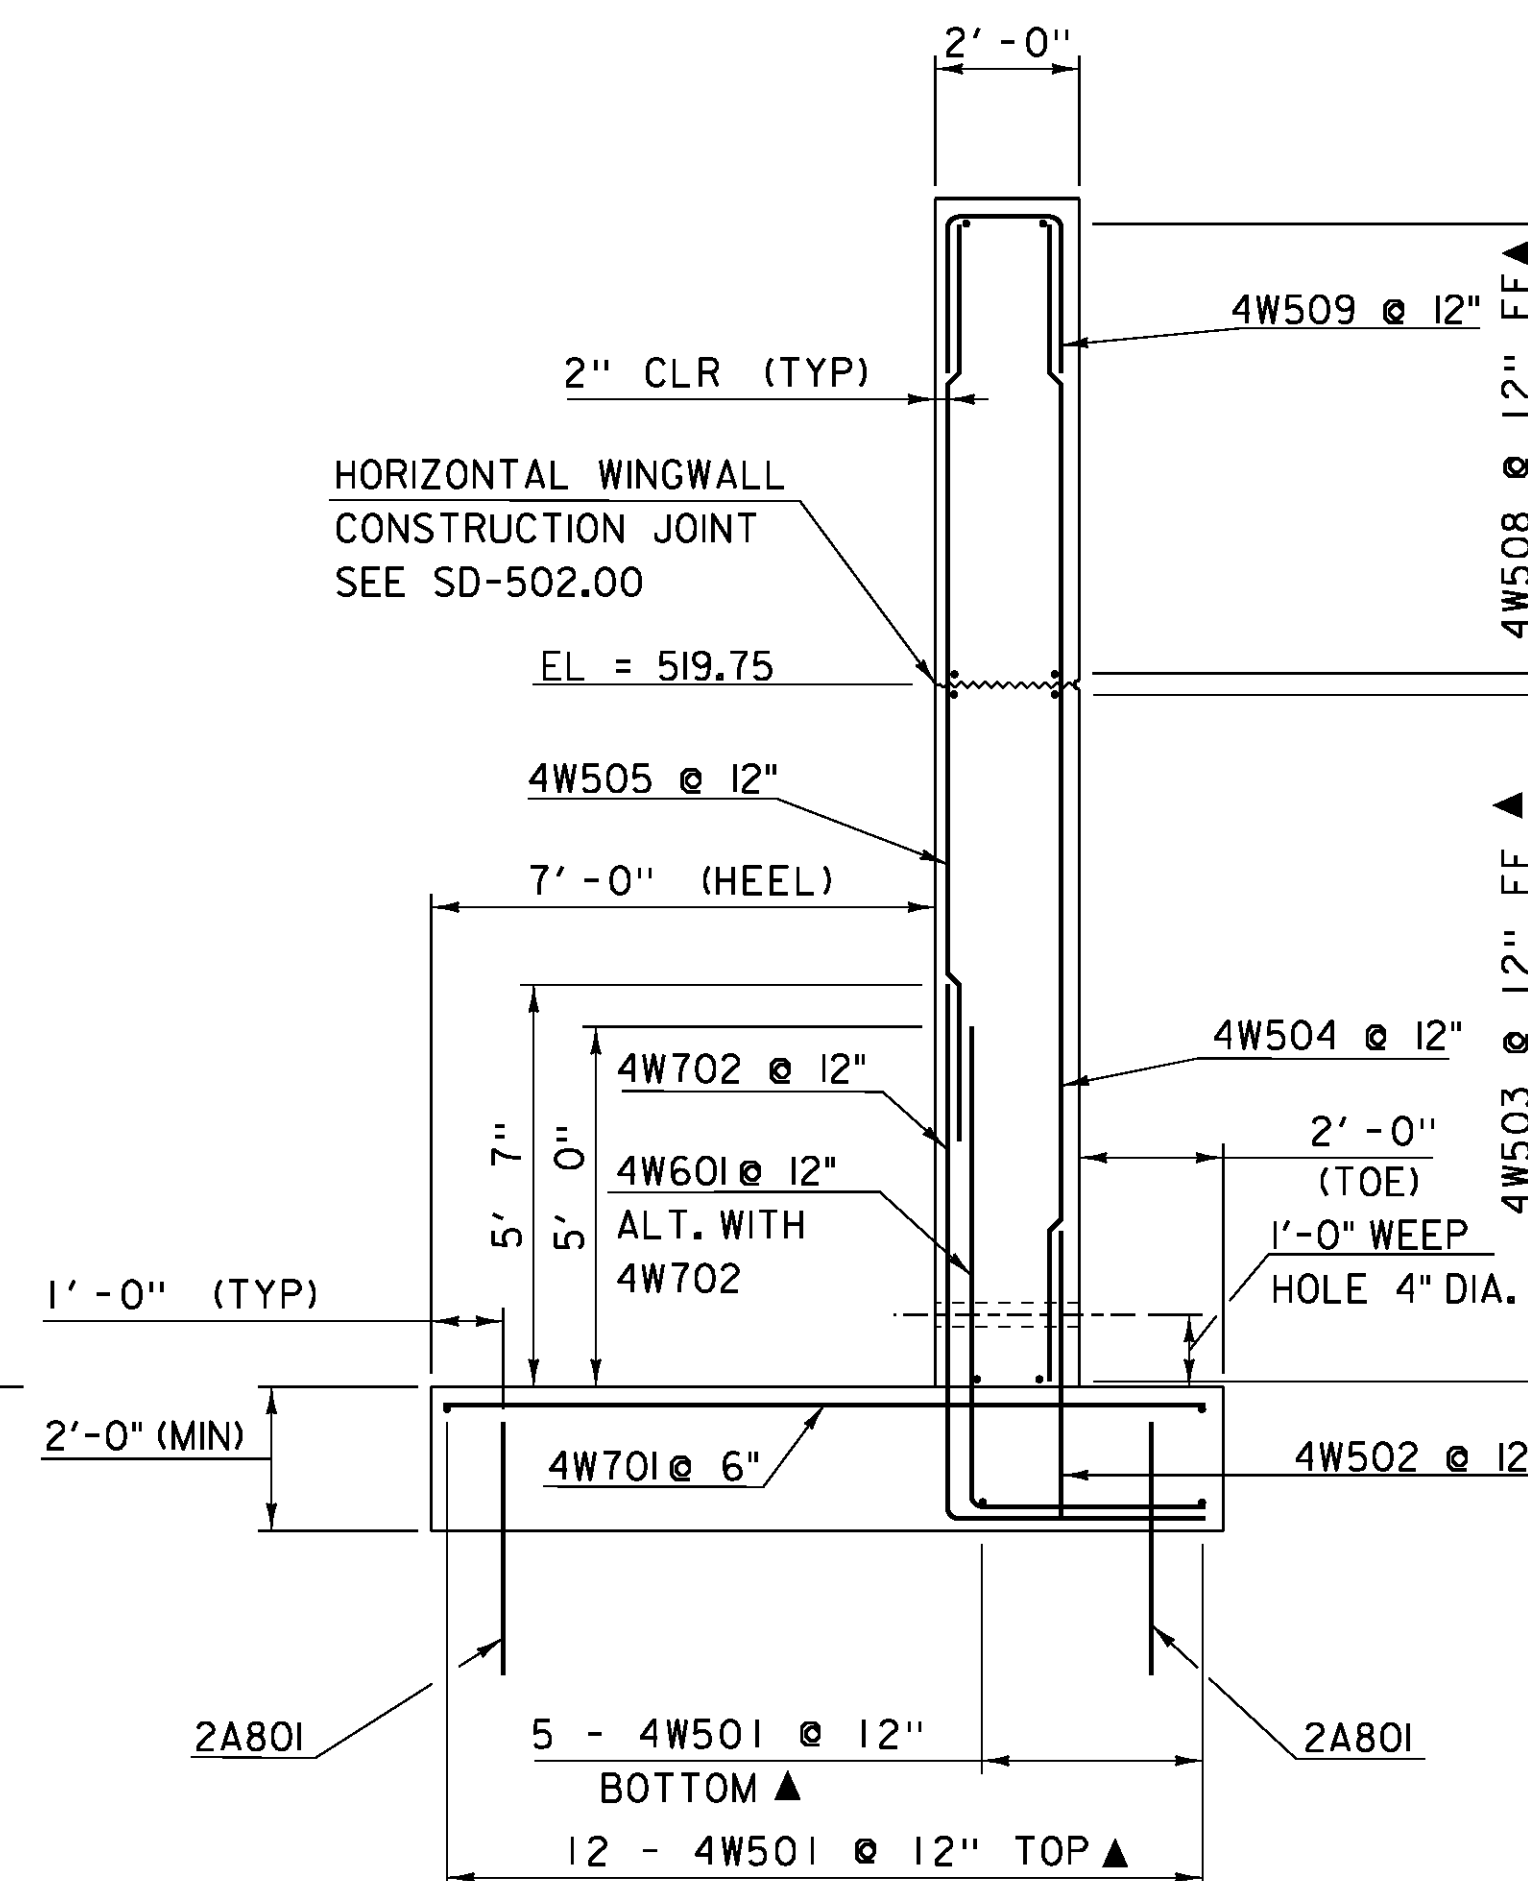

WINGWALL #4 TYPICAL

SCALE 3/8" = 1'-0"

NOTE:


- NF = NEAR FACE
- FF = FAR FACE
- EF = EACH FACE
- ▲ = CUT TO FIT IN FIELD
- 3" CLEAR, UNLESS OTHERWISE SPECIFIED ON THE PLANS.
- 2'-2" BAR LAP UNLESS OTHERWISE SPECIFIED ON THE PLANS.

PROJECT NAME: ROYALTON  
PROJECT NUMBER: BRS 0147 (13)

FILE NAME: 86e055/STR/86e055sub.dgn  
PROJECT LEADER: C.CARLSON  
DESIGNED BY: D.PETERSON  
BRIDGE 28 WINGWALL 3 AND 4 TYPICALS


PLOT DATE: 08-OCT-2013  
DRAWN BY: G.ROKES  
CHECKED BY: D.PETERSON  
SHEET 129 OF 186



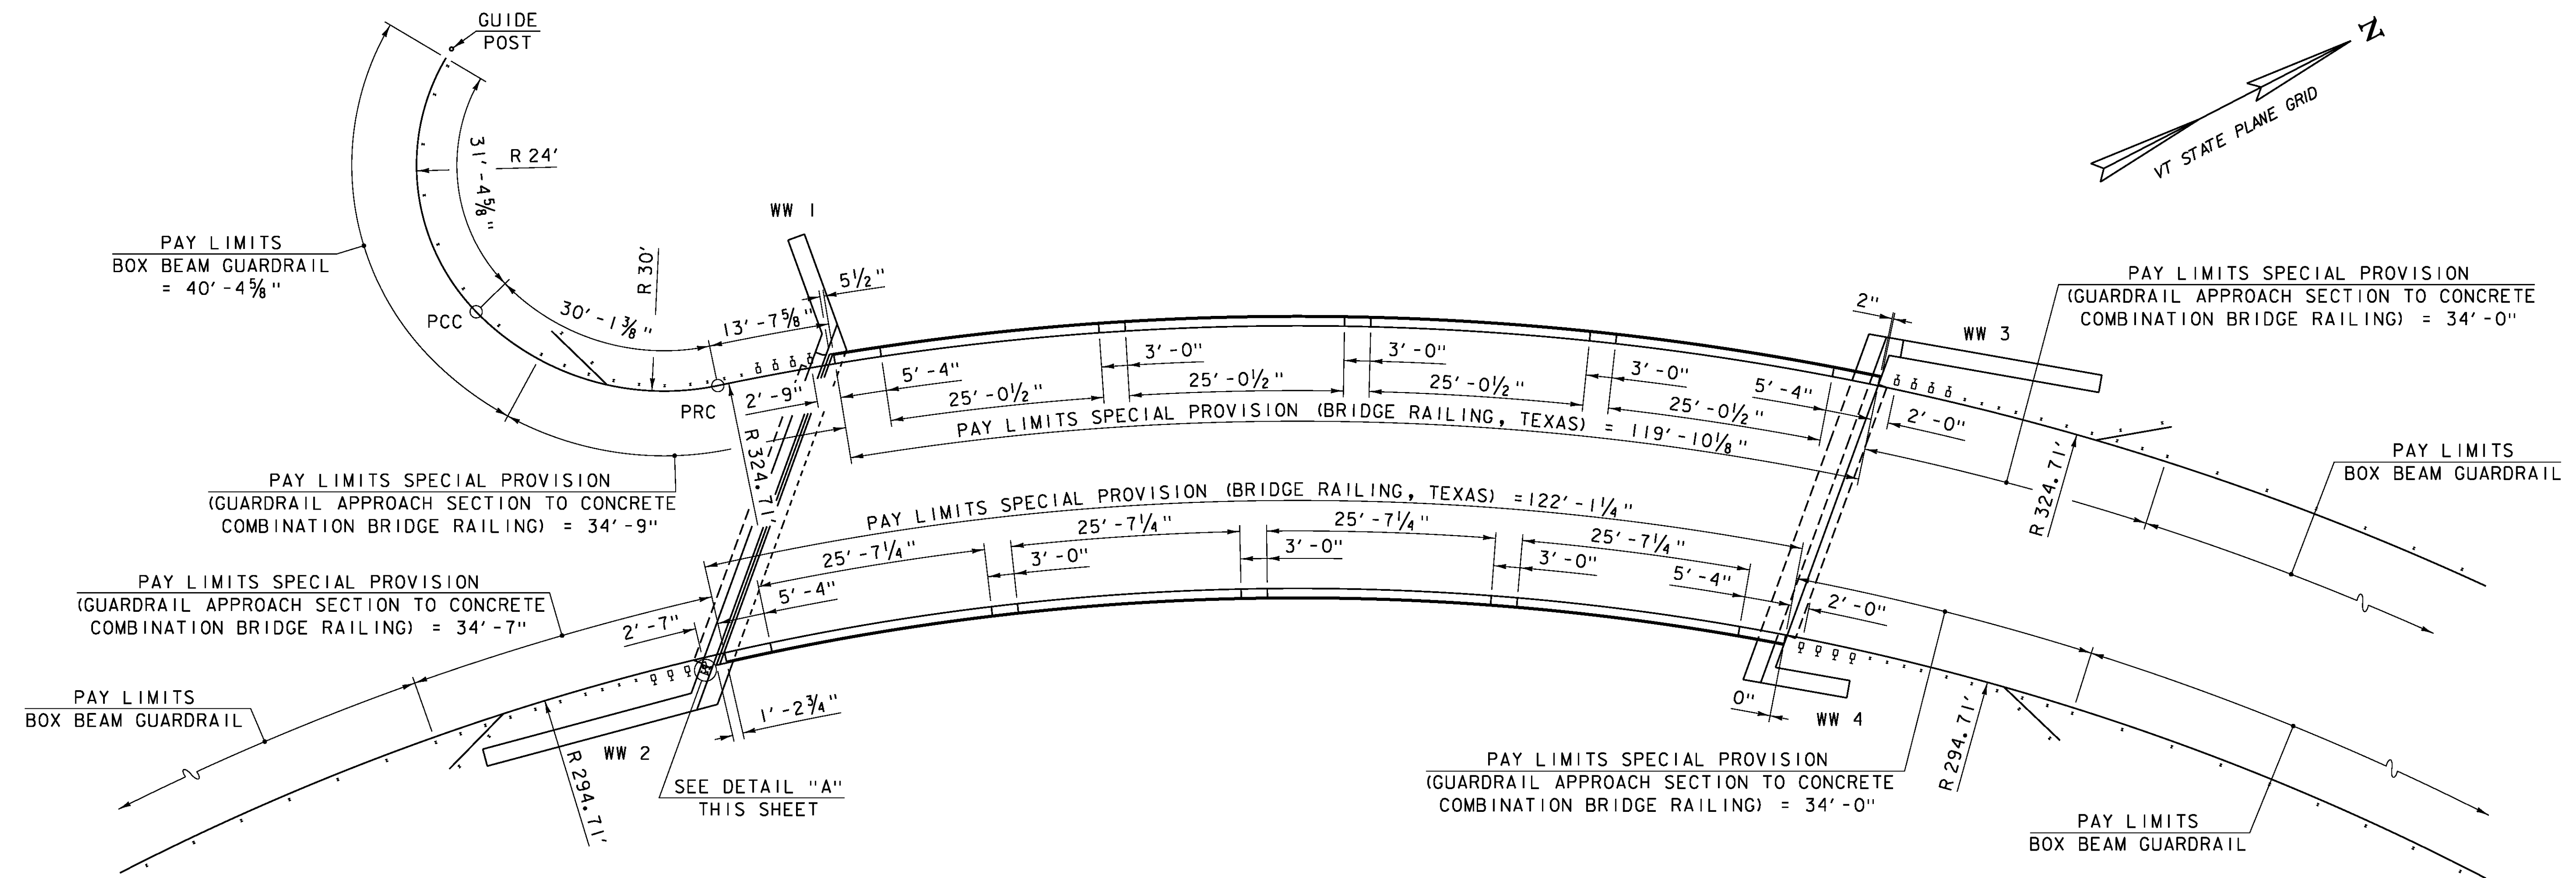


**RAIL LAYOUT**

SCALE: 1" = 10'-0"

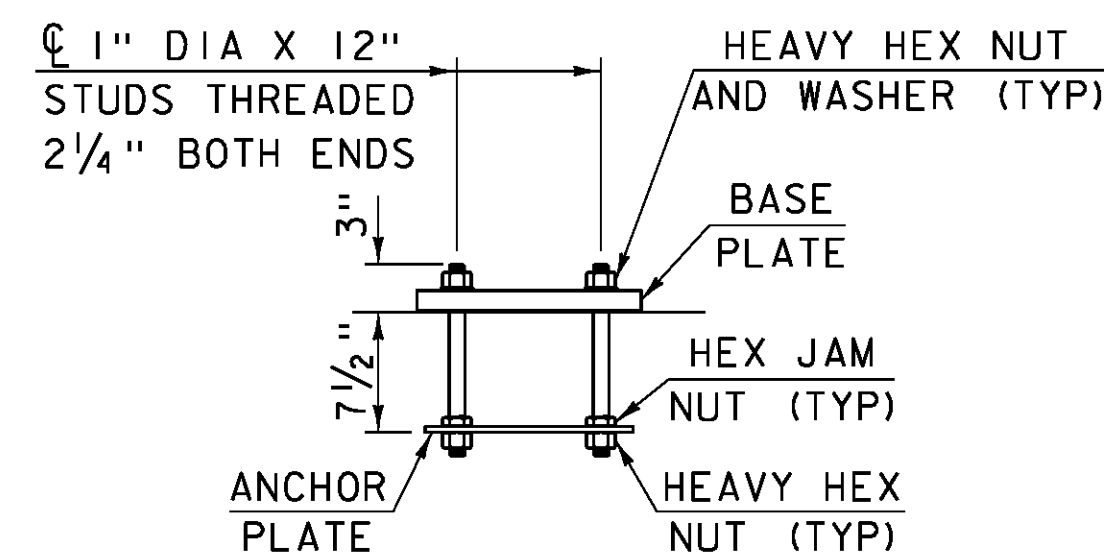


**POST ANCHORAGE**

SCALE: 1" = 1'-0"

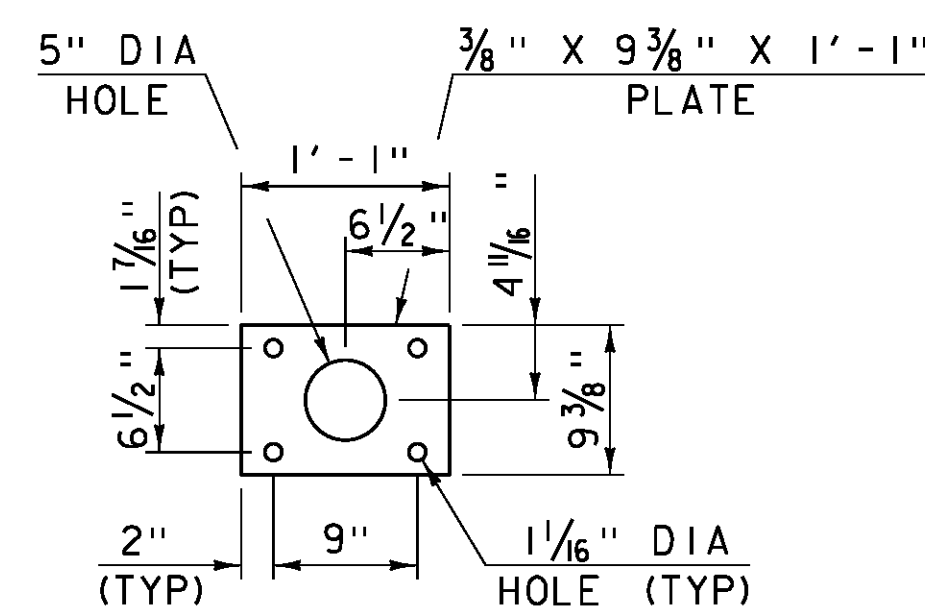


**ANCHOR PLATE DETAIL**

SCALE: 1" = 1'-0"

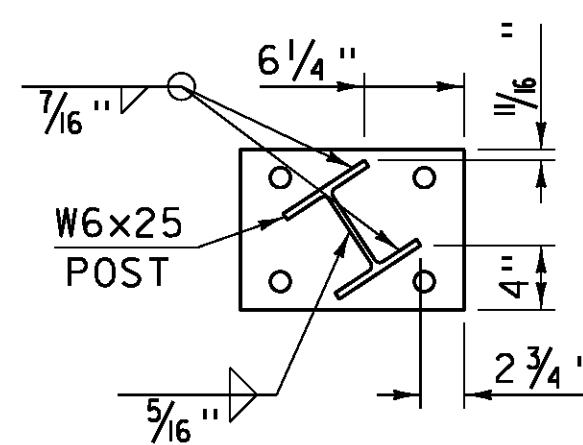


**POST LOCATION DETAIL**

SCALE: 1" = 1'-0"

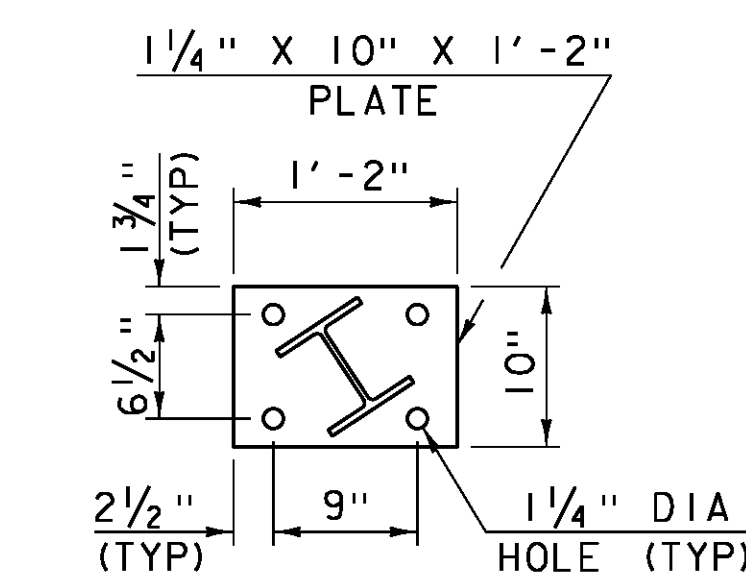


**BASE PLATE DETAIL**

SCALE: 1" = 1'-0"

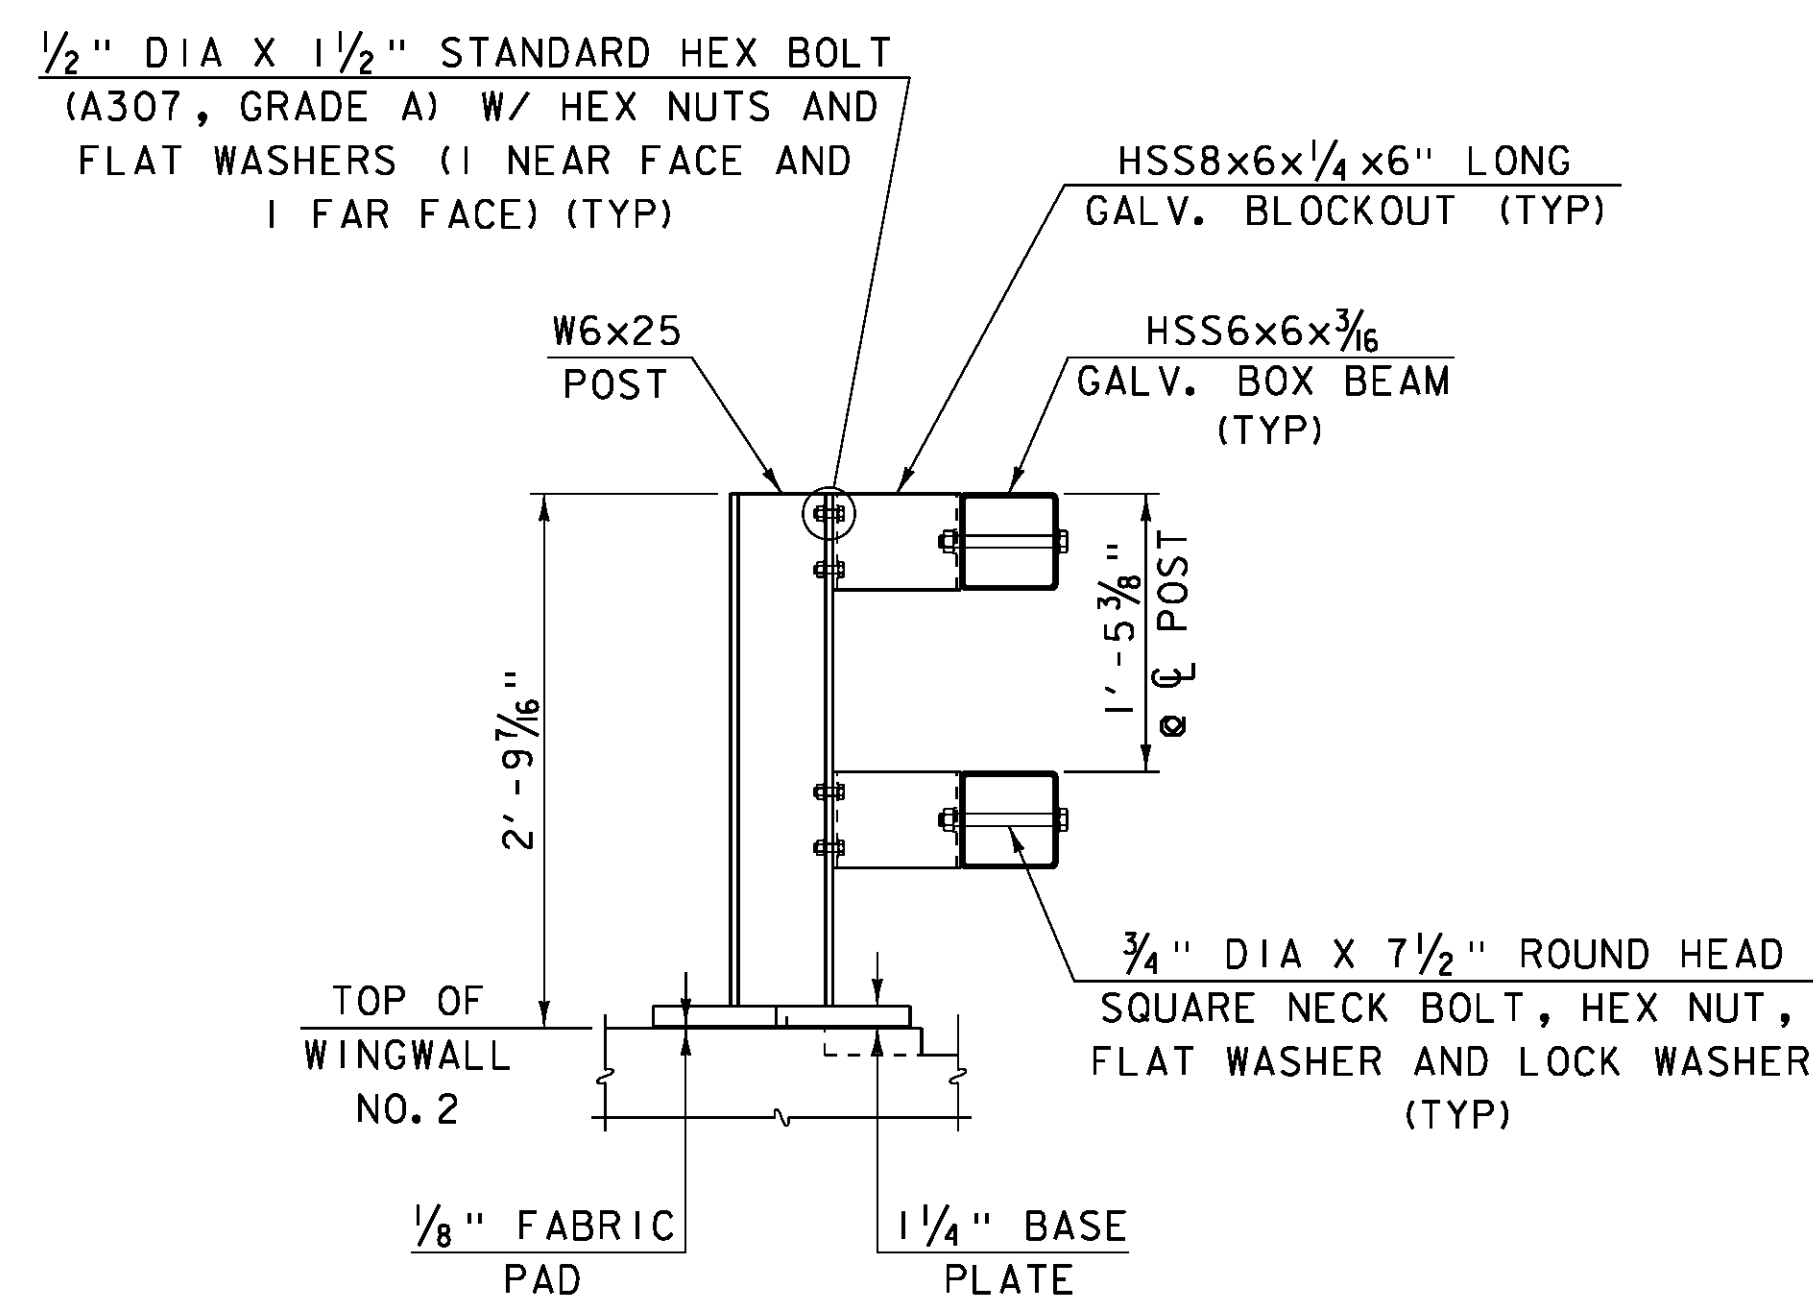


**RAIL SECTION**

SCALE: 1" = 1'-0"

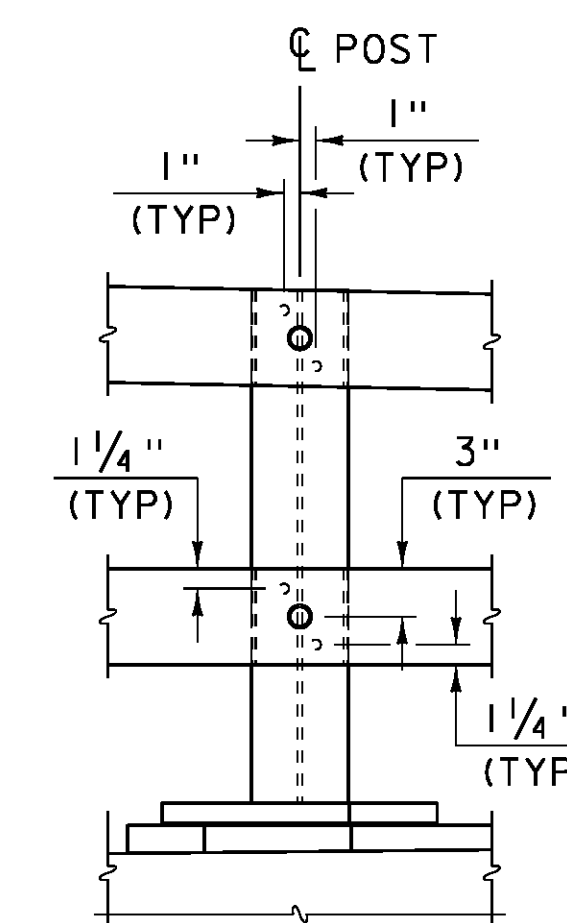

**VIEW "A-A"**

SCALE: 1" = 1'-0"

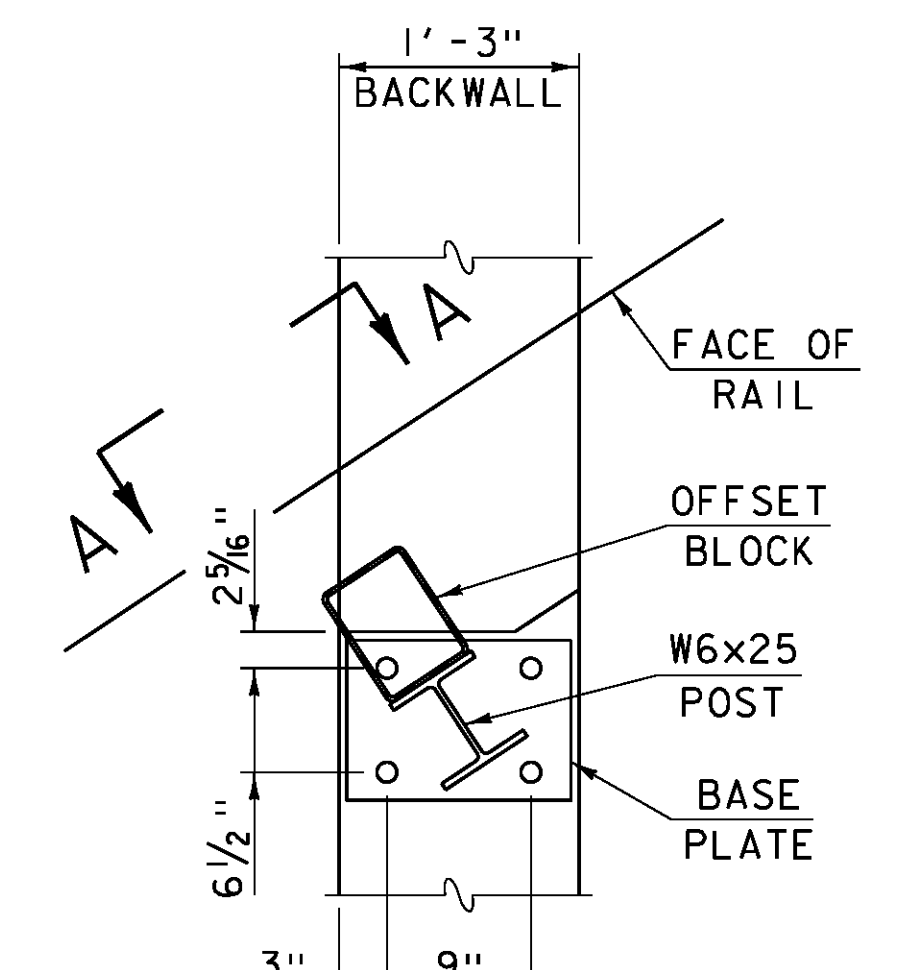

**DETAIL "A"**


SCALE: 1" = 1'-0"

NOTE:  
HOLES FOR BLOCKOUT AND RAIL ATTACHMENT SHALL BE 1/16" LARGER THAN BOLT SIZE.

PROJECT NAME: ROYALTON  
PROJECT NUMBER: BRS 0147 (13)


FILE NAME: \BR 28\86e055rail.28.dgn  
PROJECT LEADER: C. CARLSON  
DESIGNED BY: G. ROY  
BRIDGE 28 RAIL LAYOUT

PLOT DATE: 08-OCT-2013  
DRAWN BY: G. ROY  
CHECKED BY: D. PETERSON  
SHEET 131 OF 186

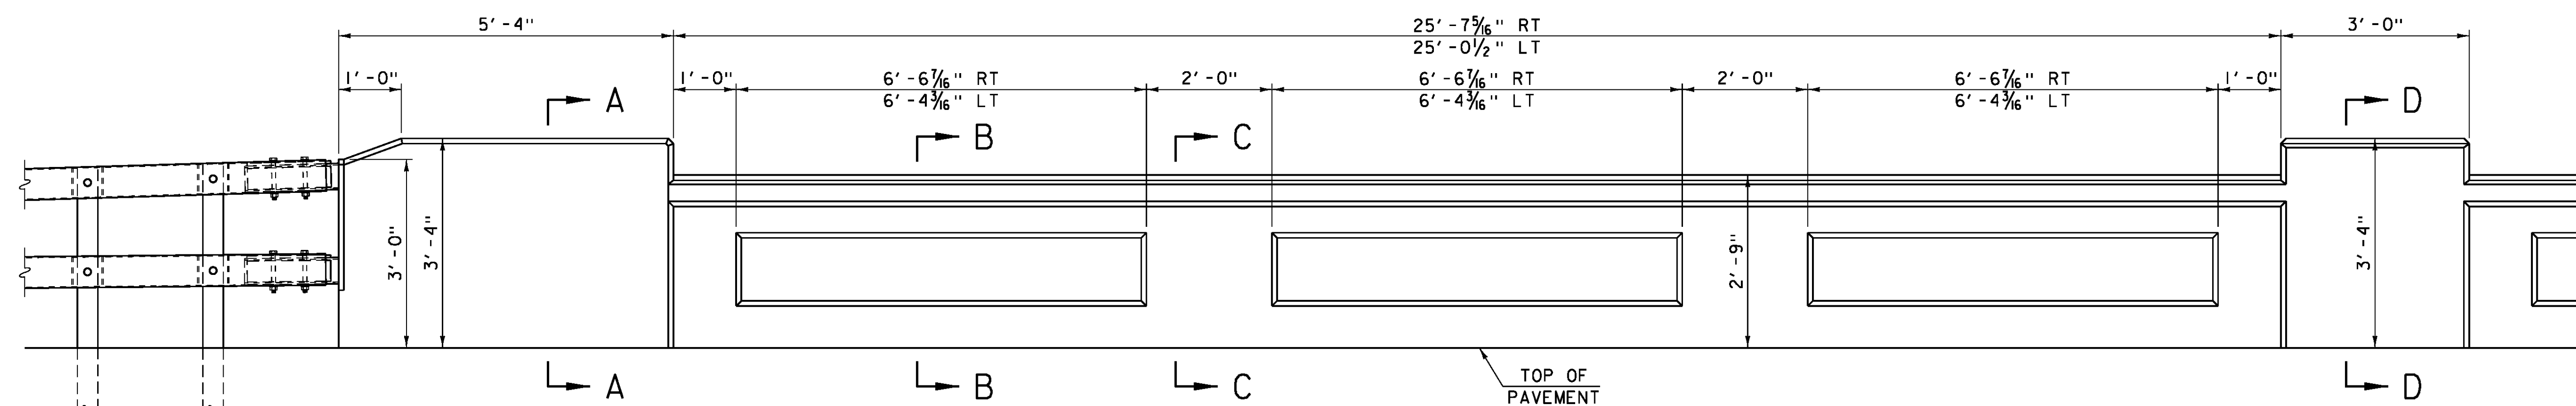


**PARTIAL BRIDGE RAIL ELEVATION  
(VIEWED FROM CENTERLINE OF ROADWAY)**


SCALE: 3/4" = 1'-0"

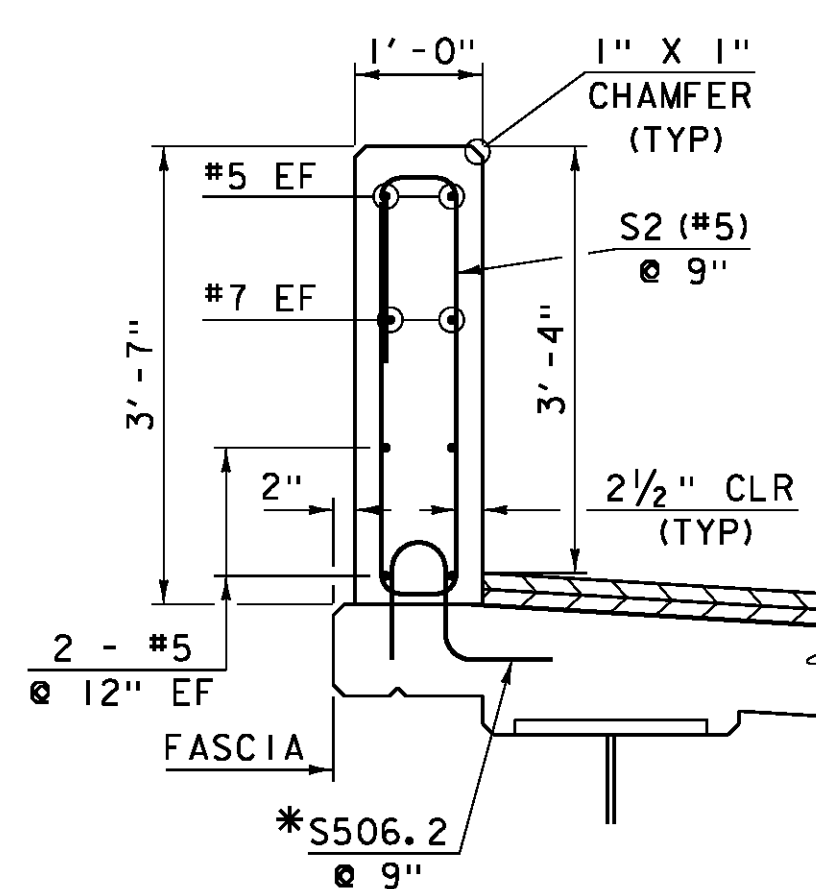


**SECTION "A-A"**  
SCALE: 3/4" = 1'-0"

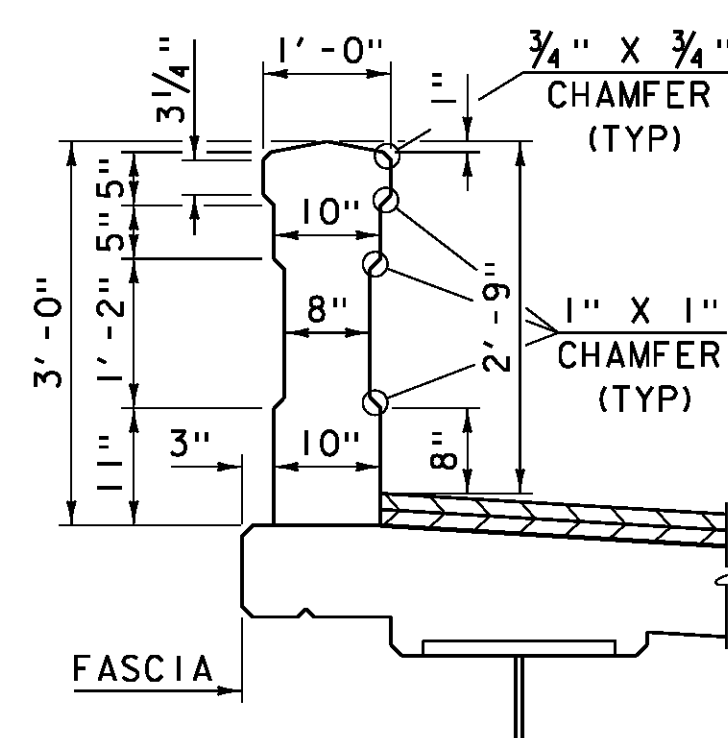


**SECTION "B-B"  
WITHOUT REINFORCING**  
SCALE: 3/4" = 1'-0"

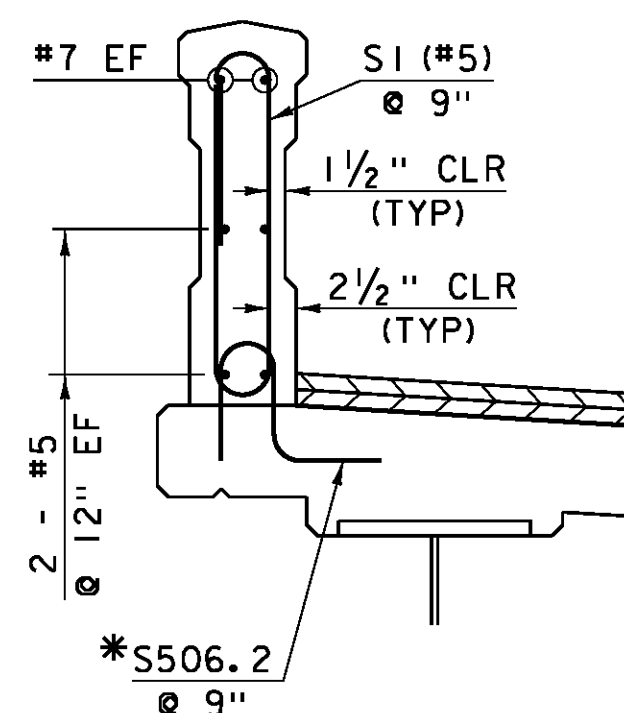

**SECTION "B-B"**  
SCALE: 3/4" = 1'-0"


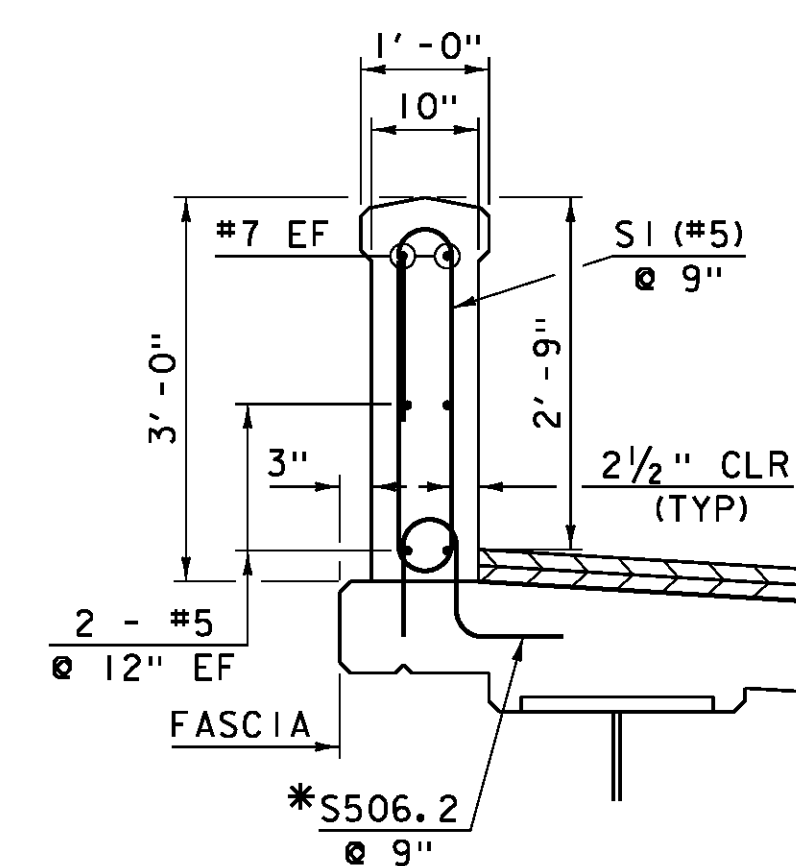


**SECTION "C-C"**  
SCALE: 3/4" = 1'-0"

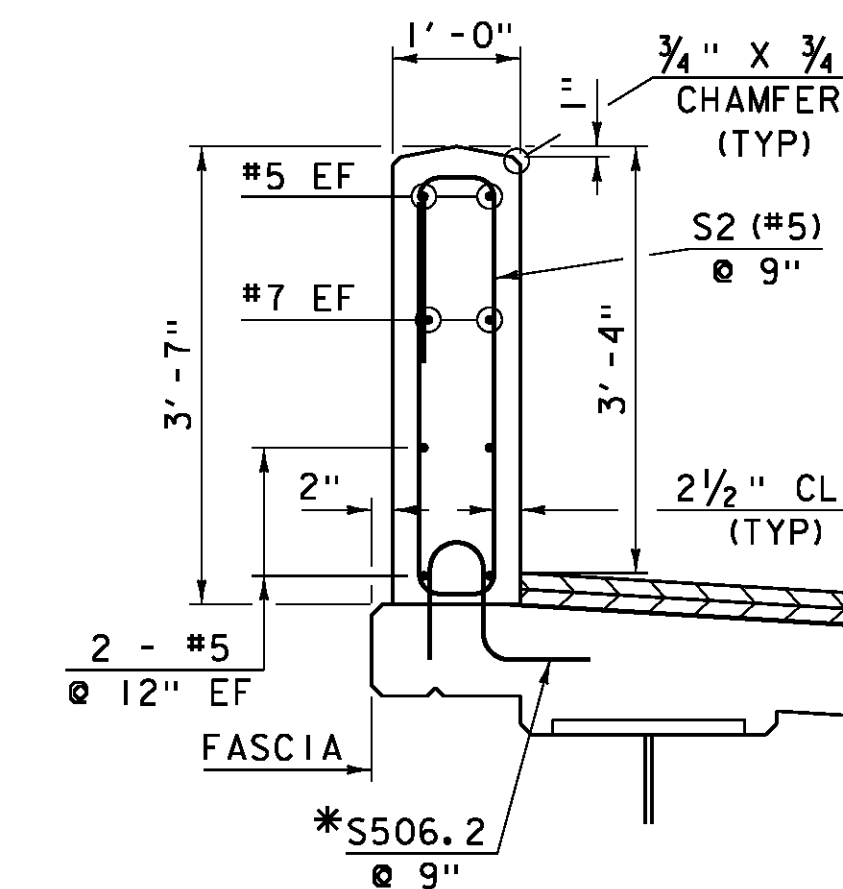

**SECTION "D-D"**  
SCALE: 3/4" = 1'-0"

*PAID FOR UNDER PAY ITEM 507.12,  
"REINFORCING STEEL, LEVEL 11".

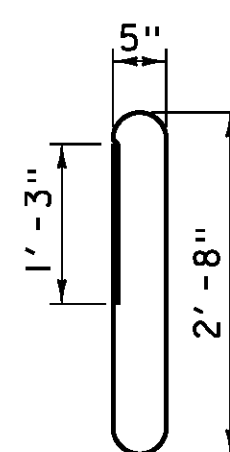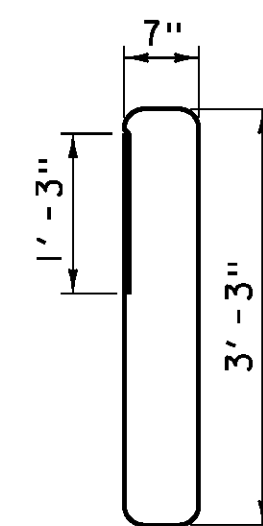

**S2 (#5)      S1 (#5)**  
**BRIDGE RAIL REINFORCING DETAILS**  
SCALE: 3/4" = 1'-0"

**NOTE:**


NF = NEAR FACE  
FF = FAR FACE  
EF = EACH FACE  
▲ = CUT TO FIT IN FIELD  
3" CLEAR, UNLESS OTHERWISE SPECIFIED ON THE PLANS.  
2'-2" BAR LAP UNLESS OTHERWISE SPECIFIED ON THE PLANS.

**NOTES:**

- ALL REINFORCING STEEL IN THE BRIDGE RAIL SHALL BE LEVEL 11.
- LAP SPLICES FOR #7 BARS SHALL BE 3'-0".

PROJECT NAME: ROYALTON  
PROJECT NUMBER: BRS 0147 (13)


FILE NAME: \BR 28\86e055rail.28.dgn      PLOT DATE: 08-OCT-2013  
PROJECT LEADER: C. CARLSON      DRAWN BY: R. PELLETT  
DESIGNED BY: D. PETERSON      CHECKED BY: D. PETERSON  
BRIDGE 28 BRIDGE RAIL DETAILS      SHEET 132 OF 186

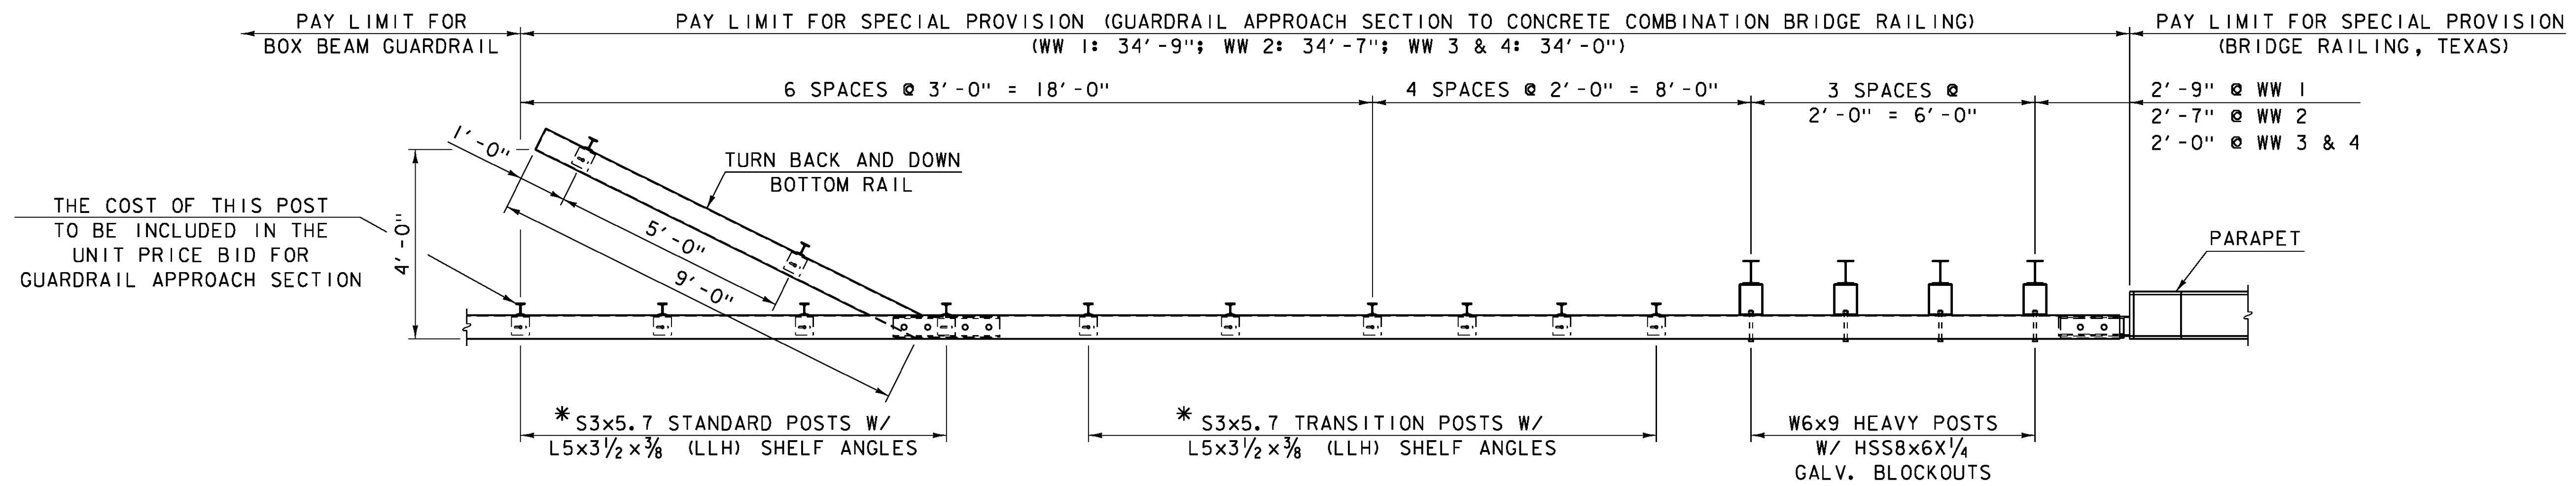

* SEE STD. G1-B FOR POST CONNECTION DETAILS

**APPROACH RAIL PLAN**

NOT TO SCALE

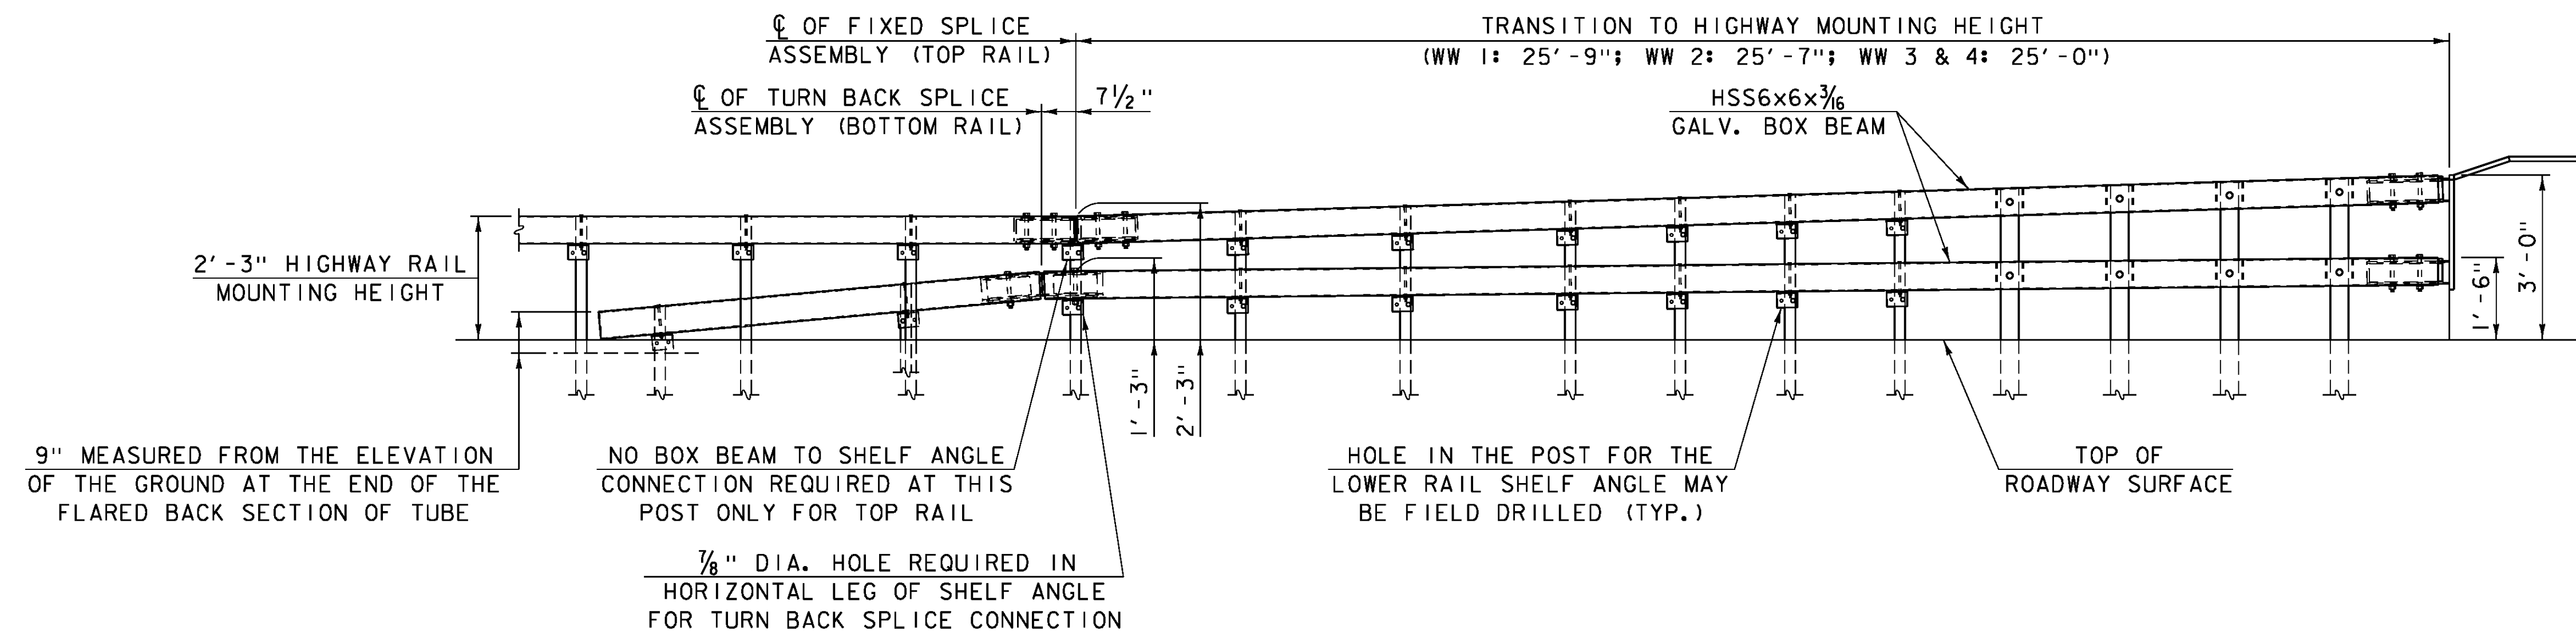


**APPROACH RAIL ELEVATION**


NOT TO SCALE

PROJECT NAME: ROYALTON  
PROJECT NUMBER: BRS 0147 (13)

FILE NAME: \BR 28\86e055rail.28.dgn PLOT DATE: 08-OCT-2013  
PROJECT LEADER: C. CARLSON DRAWN BY: G. ROY  
DESIGNED BY: D. PETERSON CHECKED BY: D. PETERSON  
BRIDGE 28 APPROACH RAIL PLAN AND ELEVATION SHEET 133 OF 186

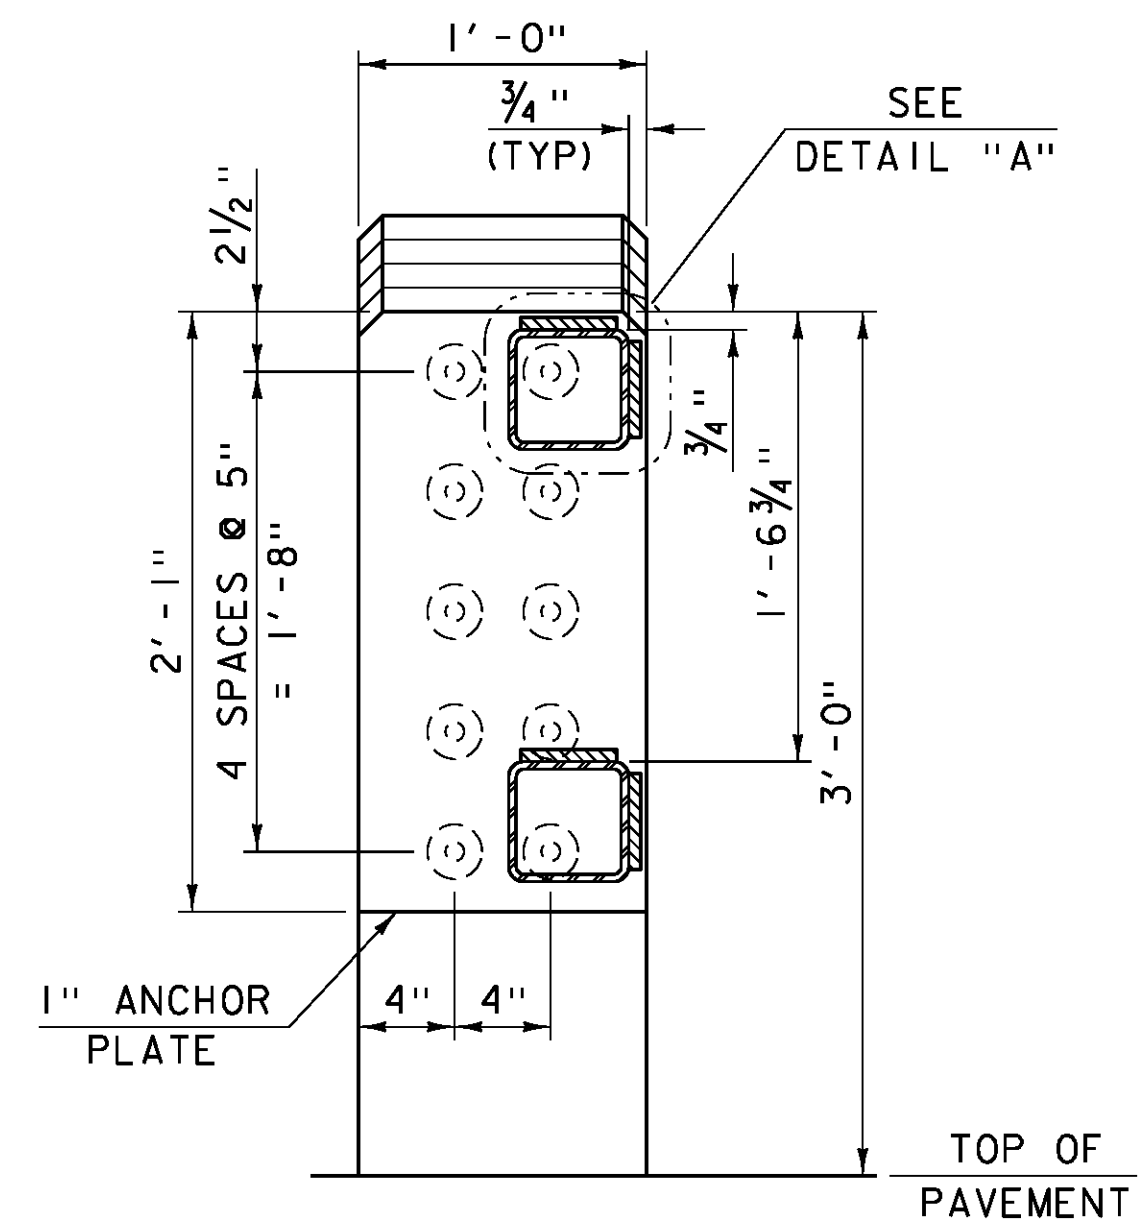


SECTION A-A  
NOT TO SCALE

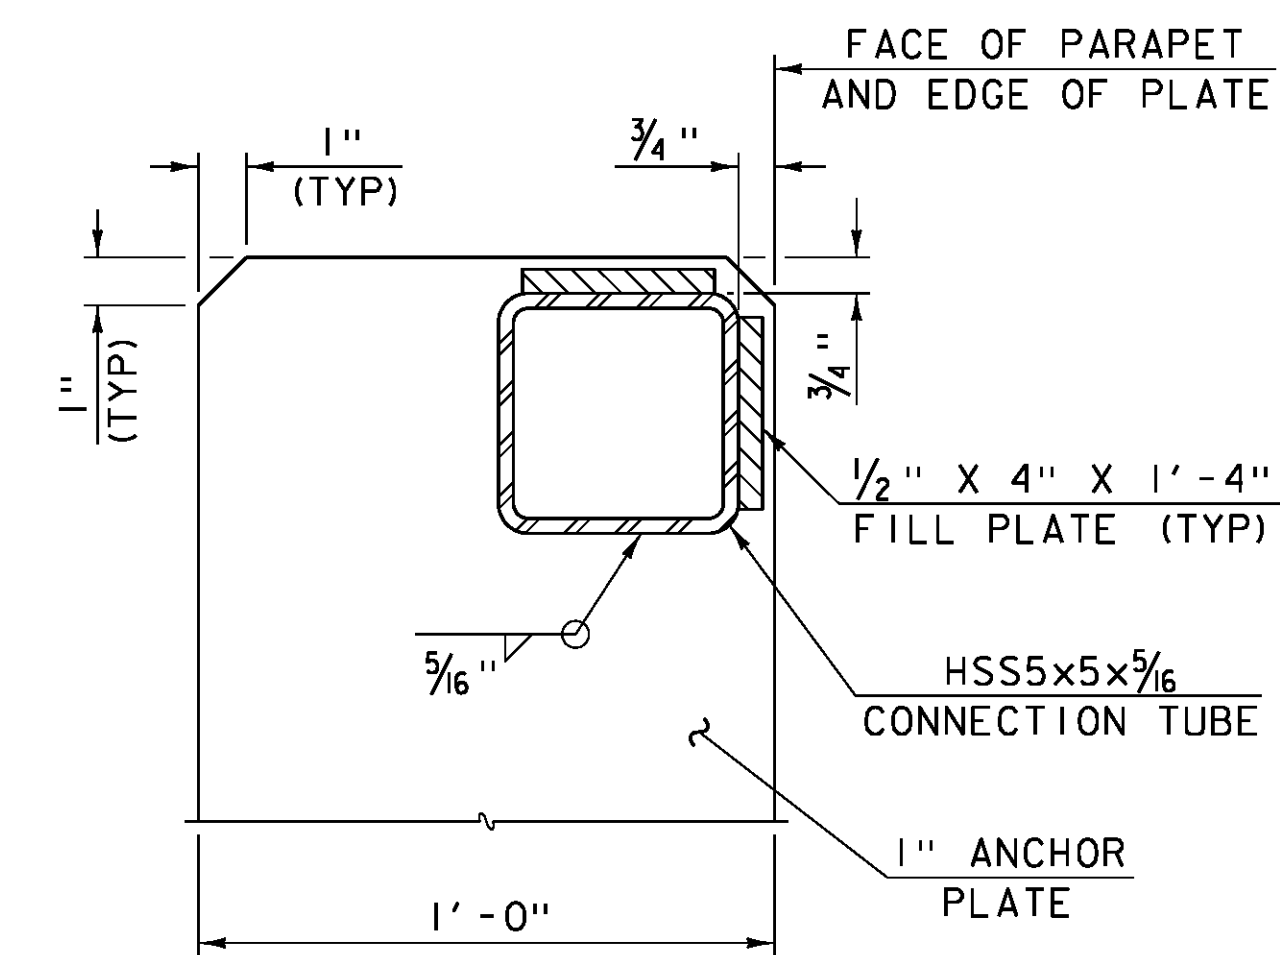


DETAIL "A"  
NOT TO SCALE

3/4" DIA X 7/2" BOLT (A325, TYPE 1)  
W/ STANDARD WASHERS AND SPRING LOCK WASHERS  
NUT TO BE FINGER TIGHT AND THE FIRST THREAD  
BELOW THE NUT TO BE DAMAGED TO PREVENT REMOVAL  
(TYP)

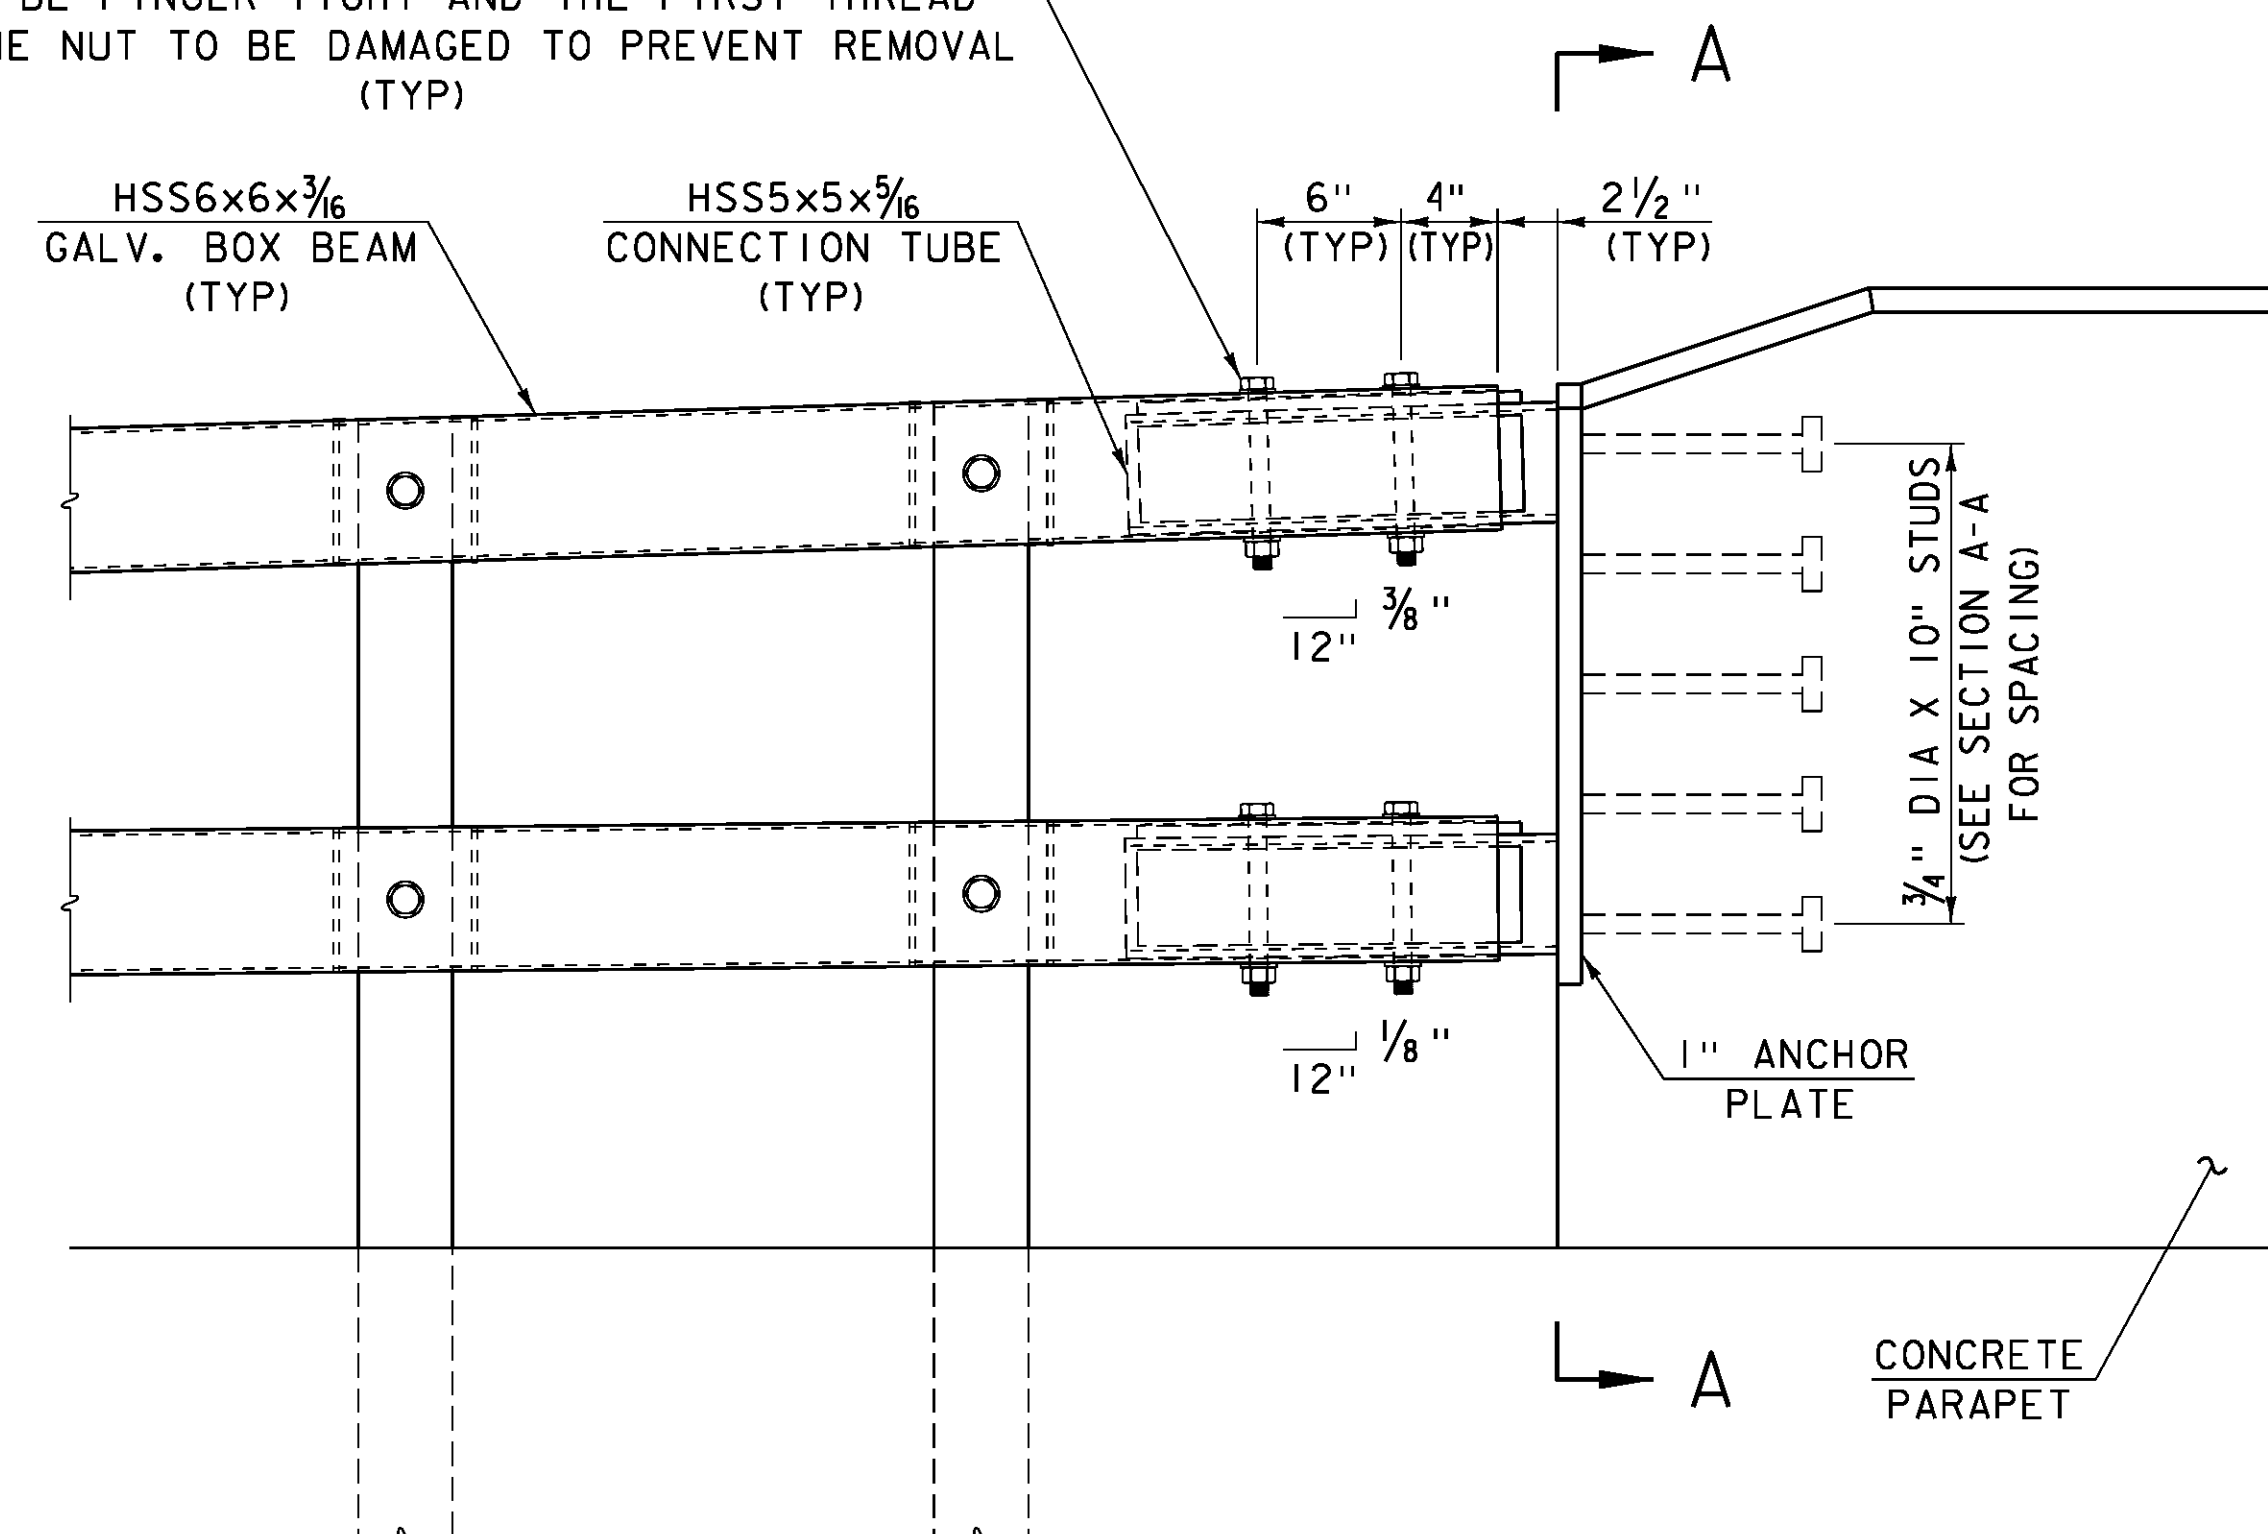

APPROACH RAIL CONNECTION DETAIL  
NOT TO SCALE

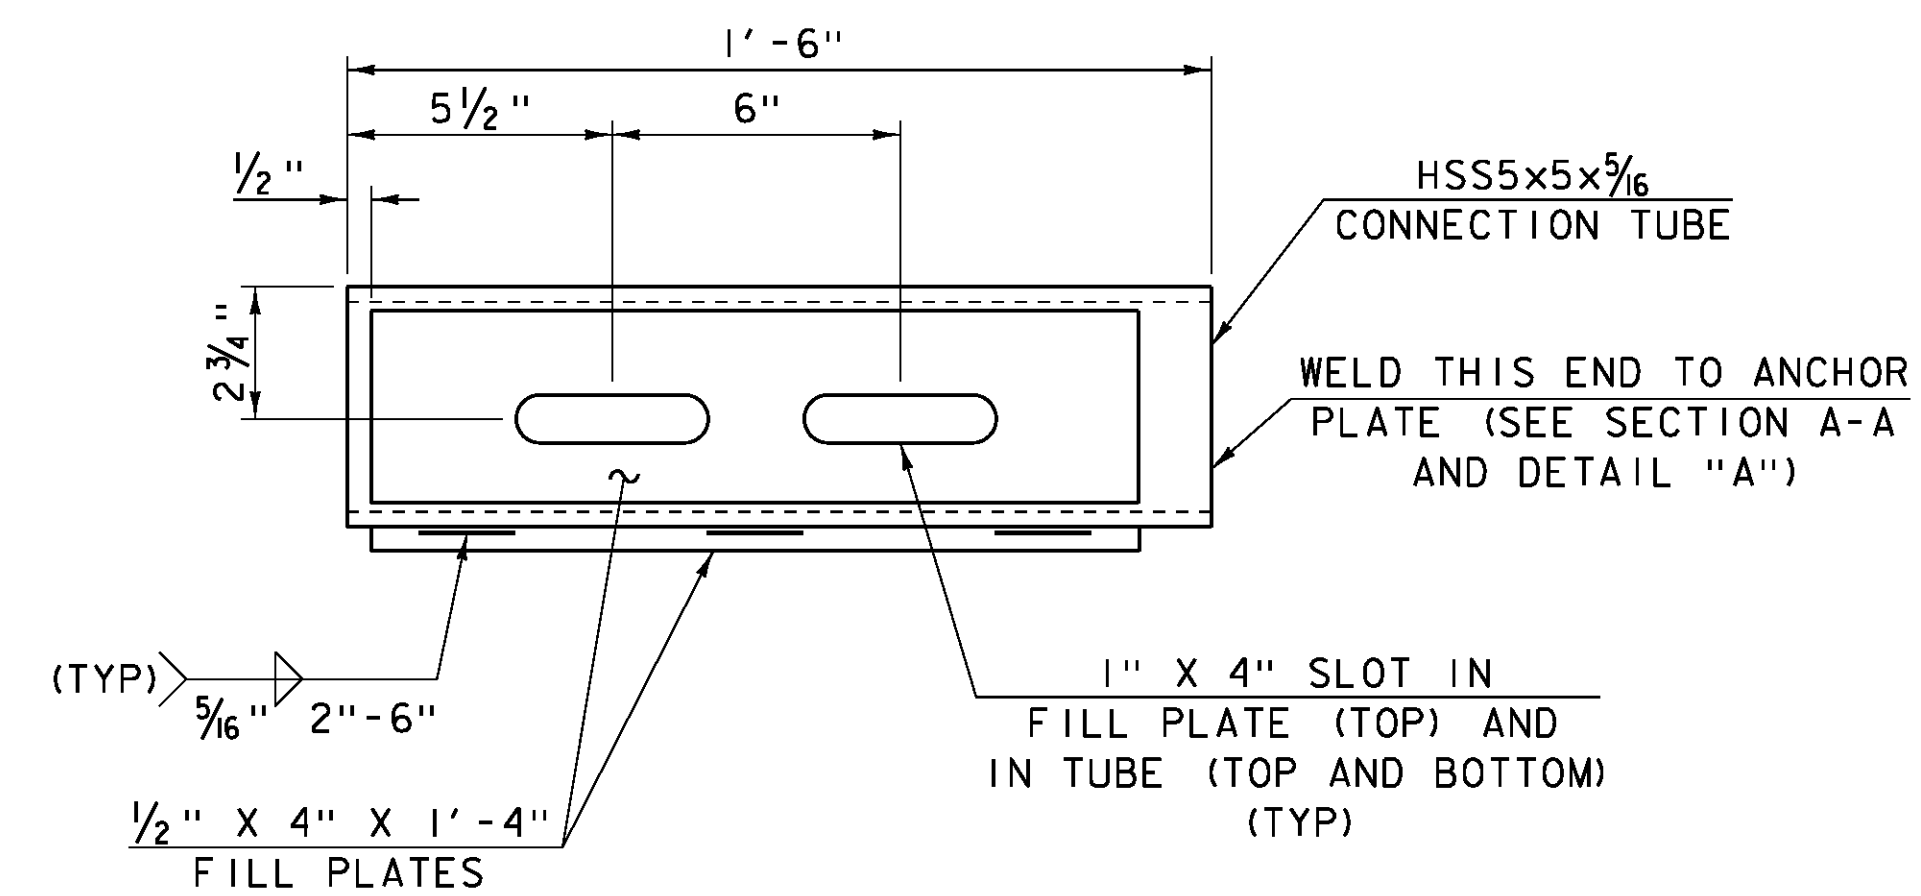


CONNECTION TUBE DETAIL PLAN  
NOT TO SCALE


PROJECT NAME: ROYALTON  
PROJECT NUMBER: BRS 0147 (13)

FILE NAME: \BR 28\86e055rail.28.dgn  
PROJECT LEADER: C. CARLSON  
DESIGNED BY: G. ROY  
BRIDGE 28 APPROACH RAIL DETAILS (1)

PLOT DATE: 08-OCT-2013  
DRAWN BY: G. ROY  
CHECKED BY: D. PETERSON  
SHEET 134 OF 186

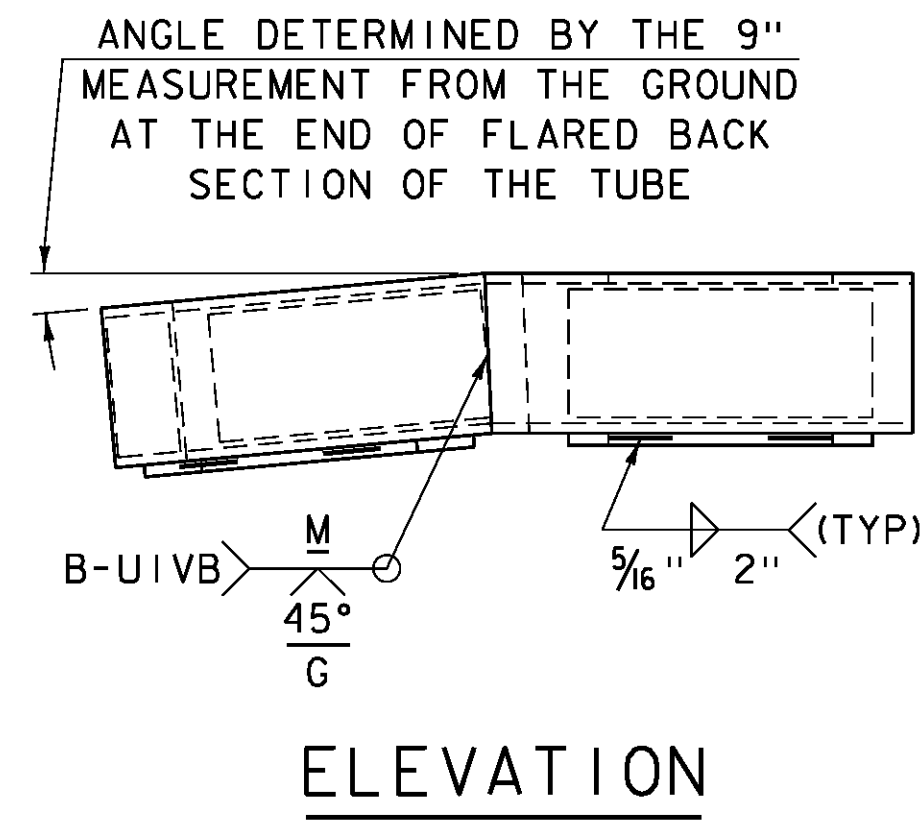


**ELEVATION**

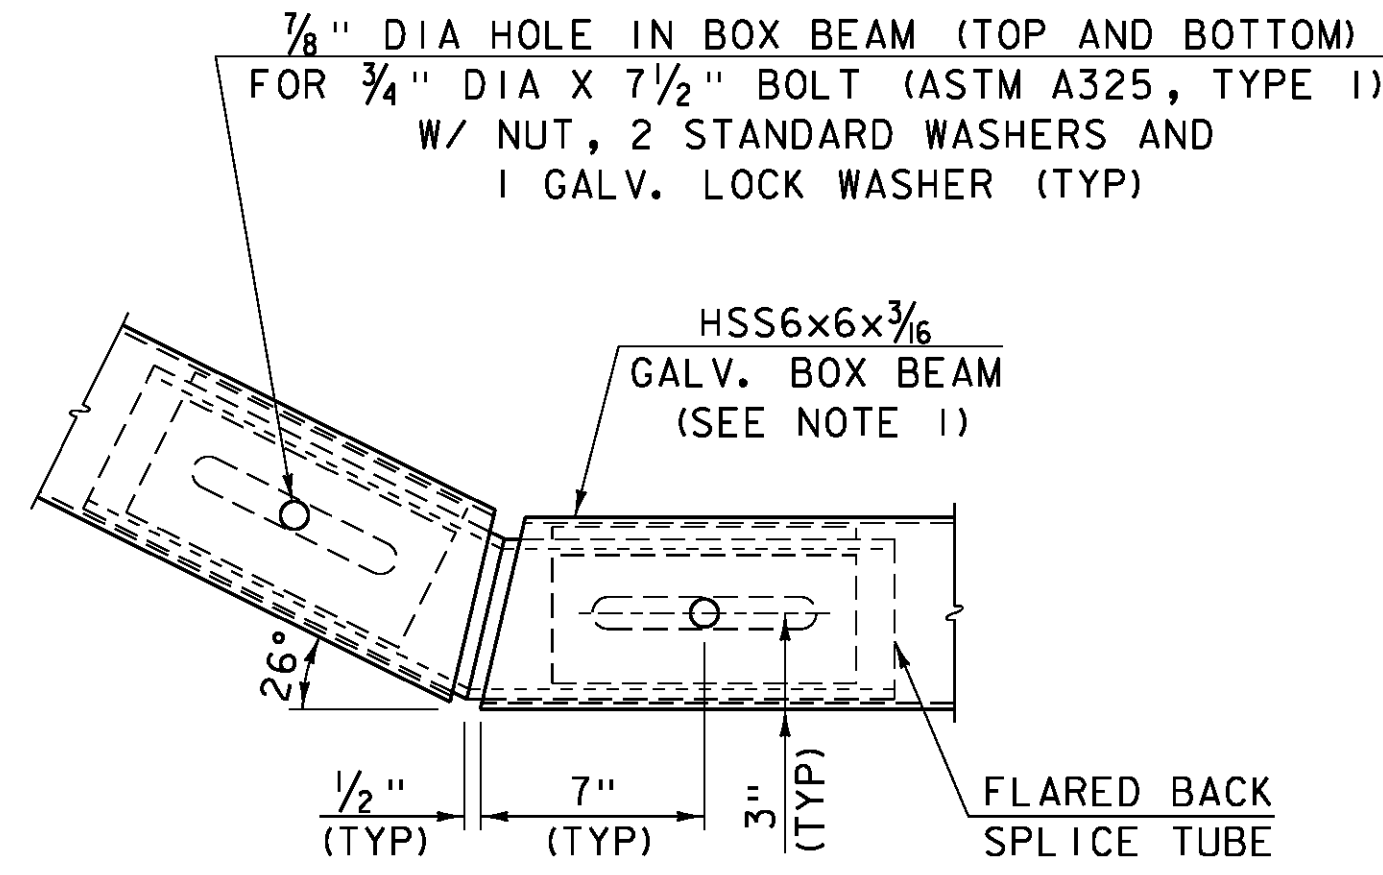


**PLAN BOTTOM RAIL FLARE BACK DETAIL**

NOT TO SCALE

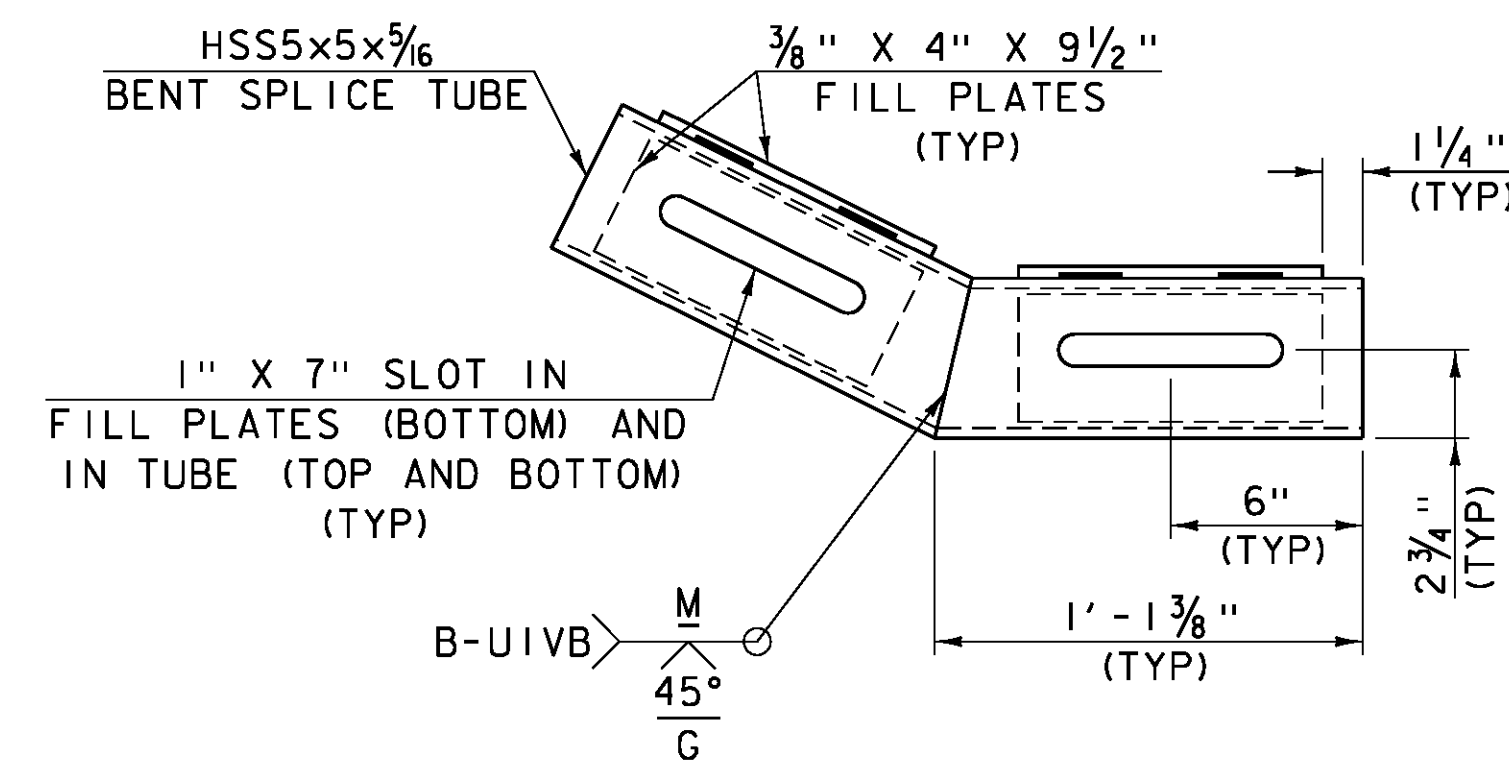


**PLAN FLARED BACK SPLICE TUBE DETAIL**

NOT TO SCALE

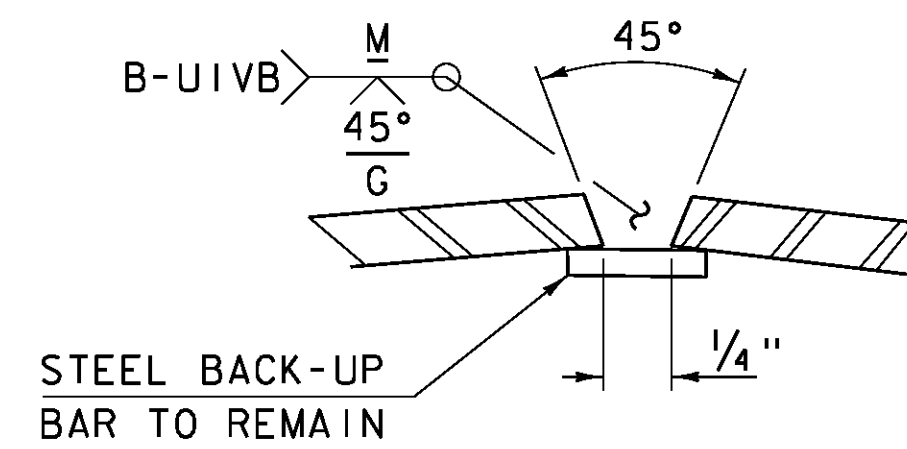



**WELD DETAIL FOR SPLICE TUBE**

NOT TO SCALE

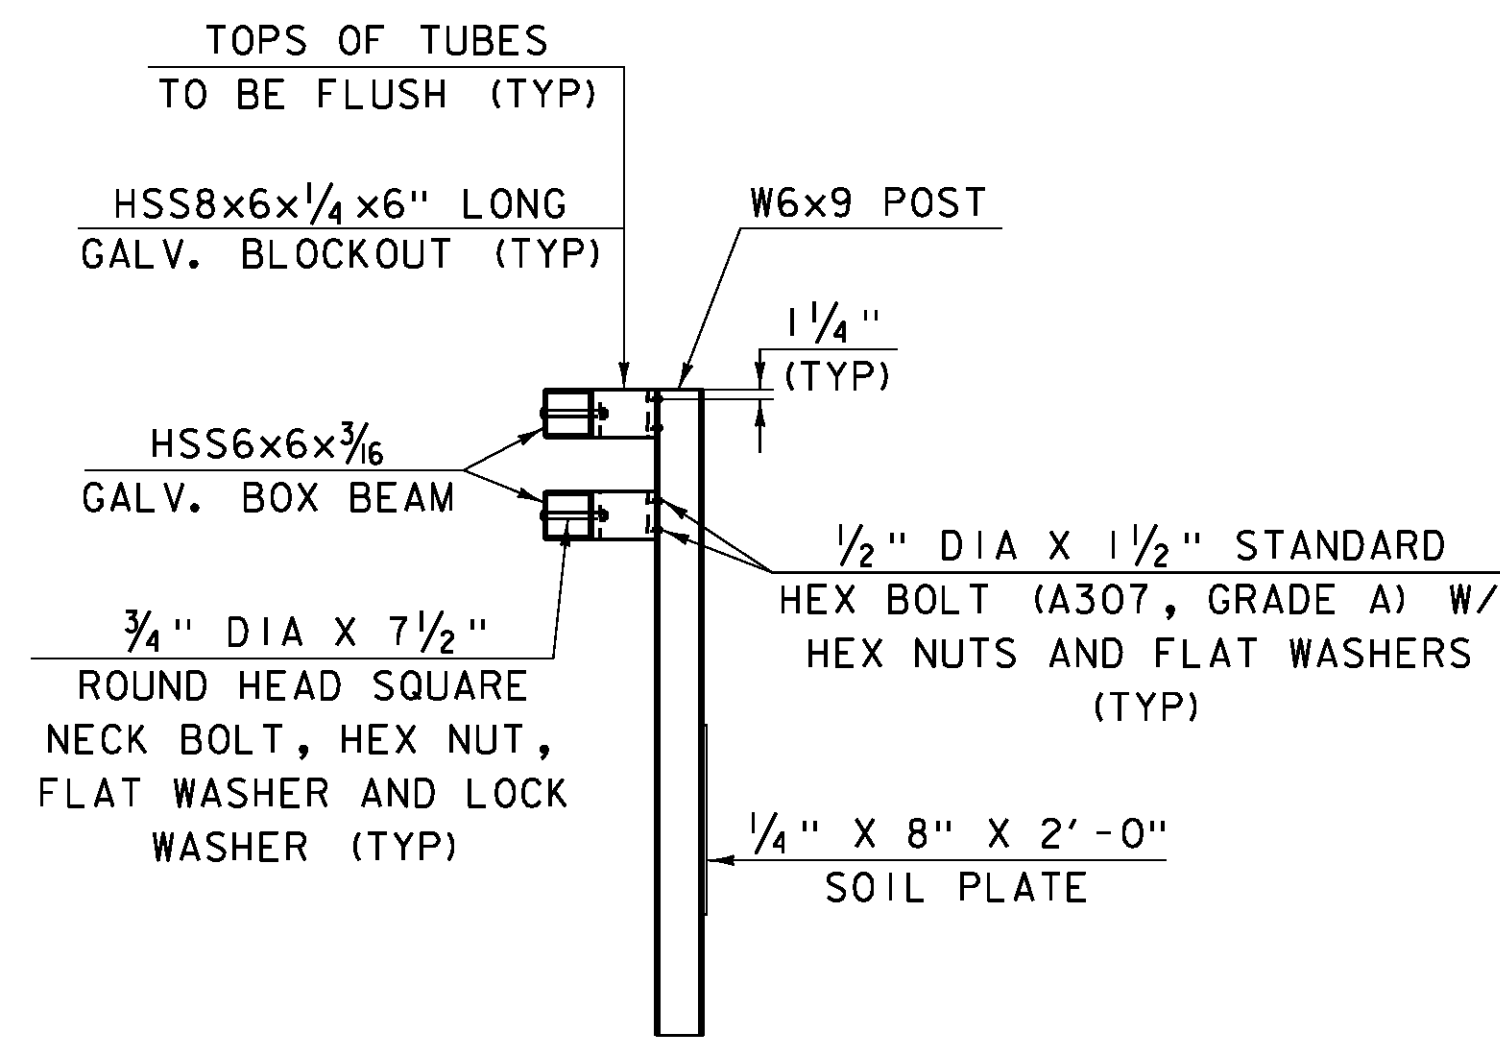



**HEAVY POST ELEVATION**

NOT TO SCALE

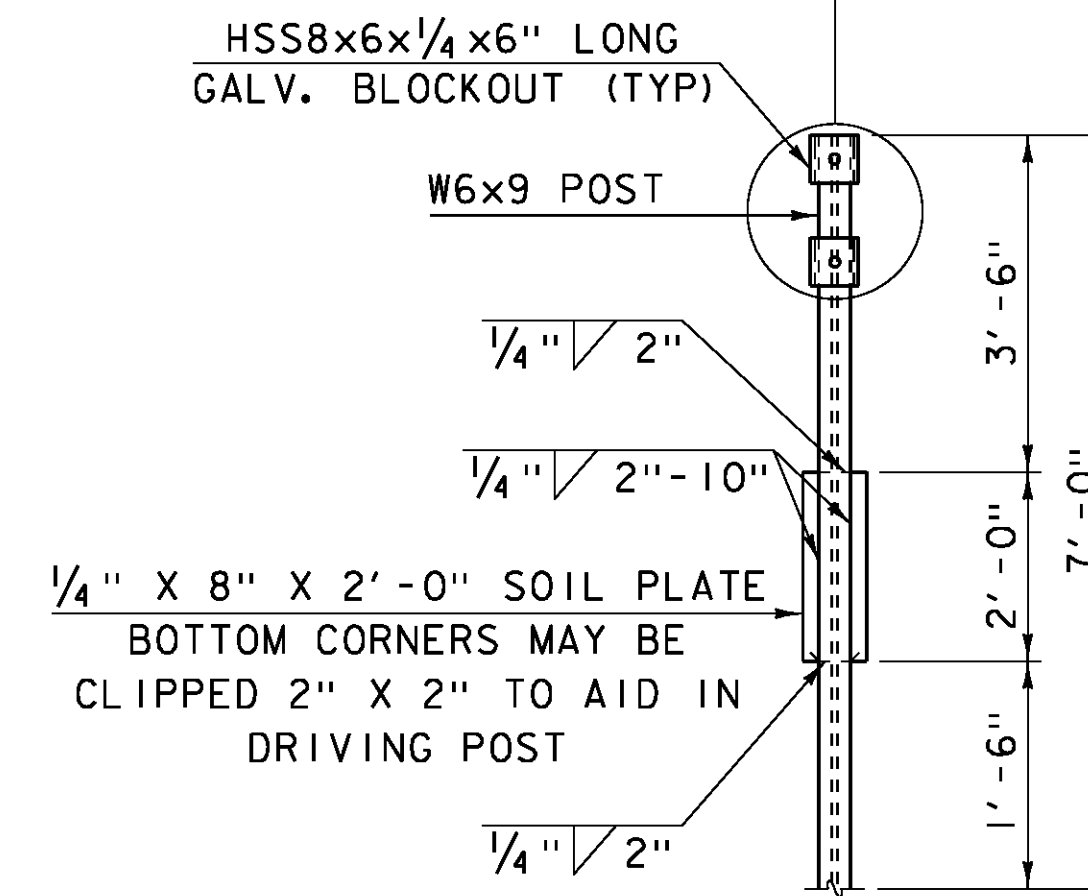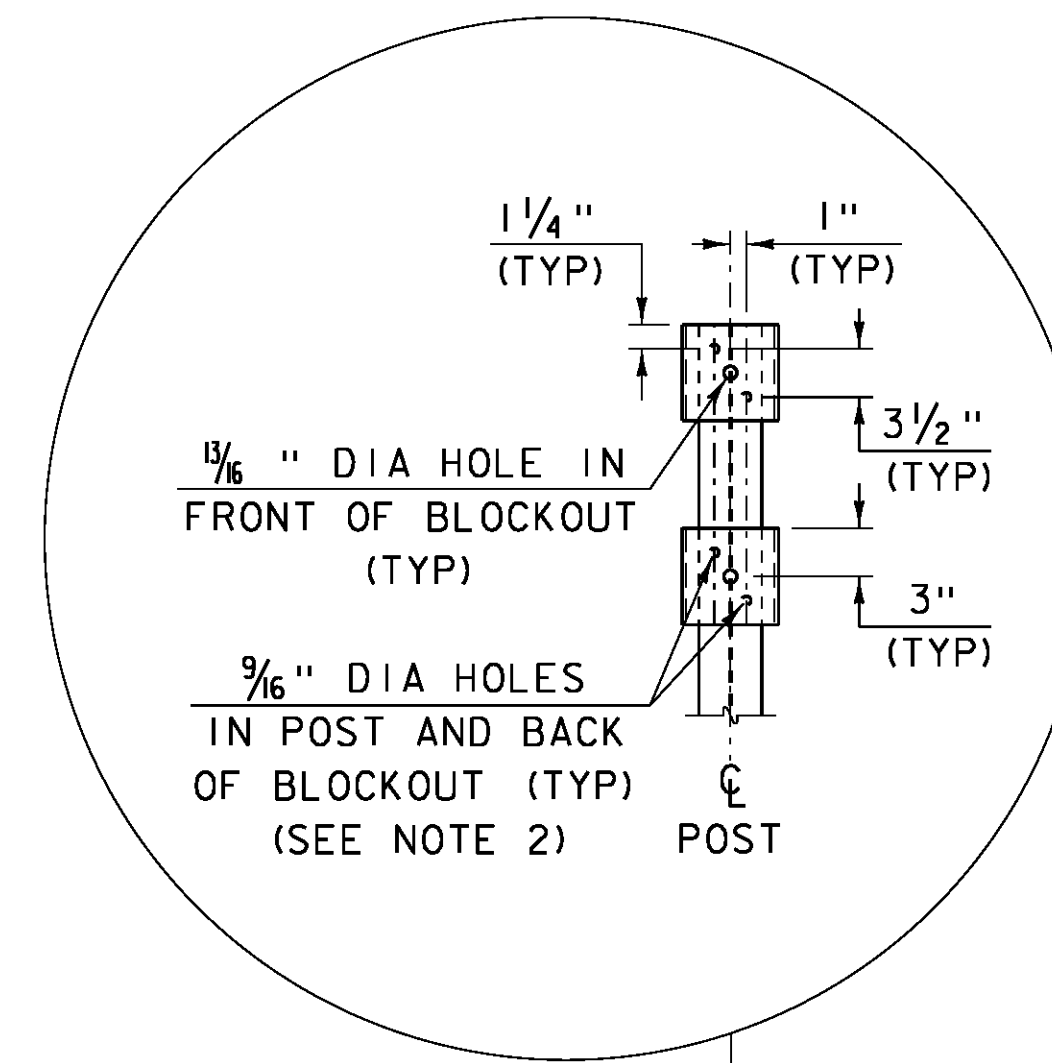

**HEAVY POST DETAIL**

NOT TO SCALE

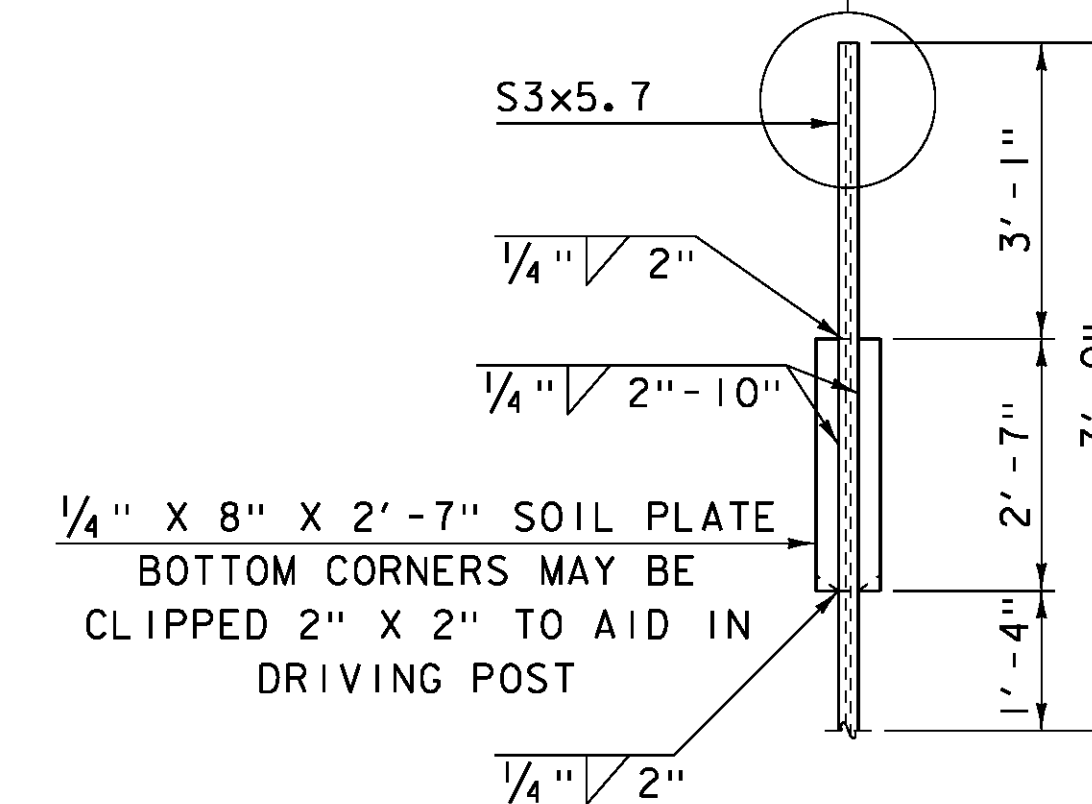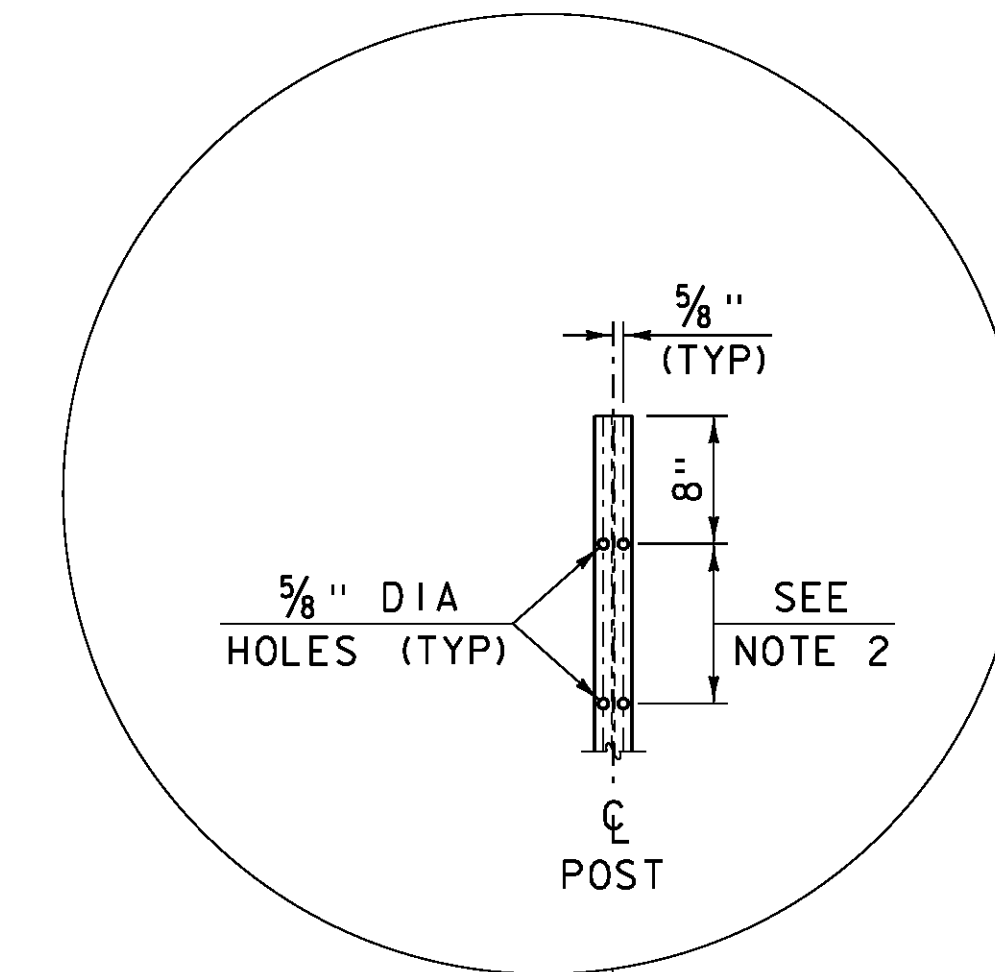

**TRANSITION POST DETAIL**


NOT TO SCALE

**NOTES:**


1. PROTRUSIONS CAUSED BY WELDING OR GALVANIZING ARE NOT PERMITTED ON THE ADJOINING SURFACES OF THE BOX BEAM RAILS, SPLICE TUBES AND FILL PLATES.
2. HOLES IN POST FOR LOWER RAIL MAY BE LOCATED AND DRILLED IN THE FIELD. IF SO, GALVANIZING SHALL BE REPAIRED.

PROJECT NAME: ROYALTON  
PROJECT NUMBER: BRS 0147 (13)


FILE NAME: \BR 28\86e055rail.28.dgn PLOT DATE: 08-OCT-2013  
PROJECT LEADER: C. CARLSON DRAWN BY: G. ROY  
DESIGNED BY: G. ROY CHECKED BY: D. PETERSON  
BRIDGE 28 APPROACH RAIL DETAILS (2) SHEET 135 OF 186

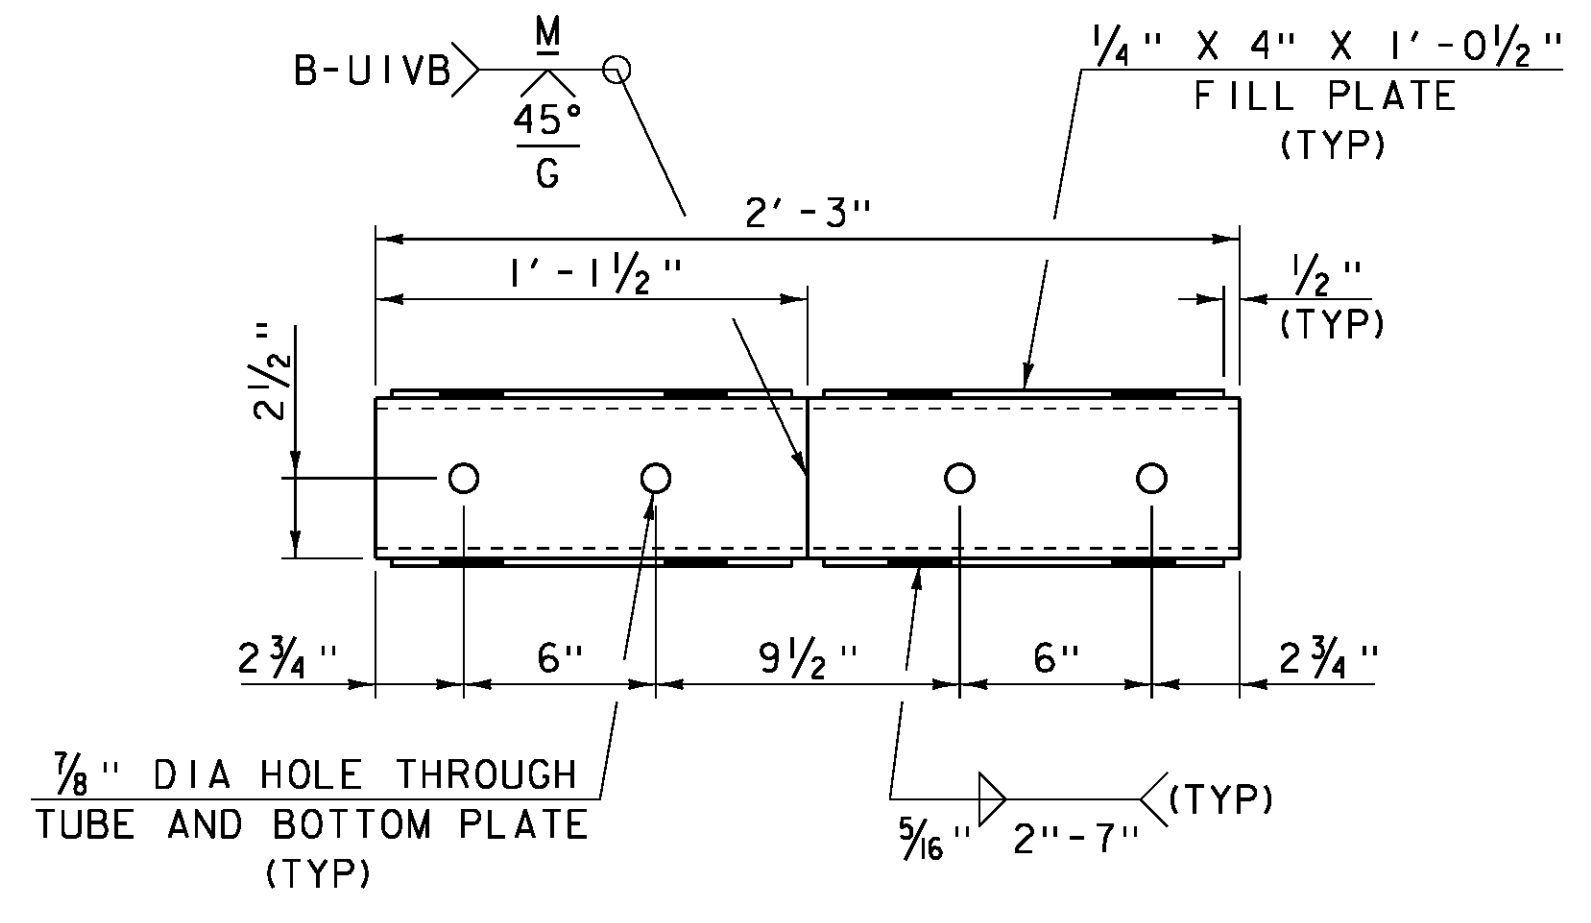


**FIXED SPLICE TUBE PLAN**  
NOT TO SCALE

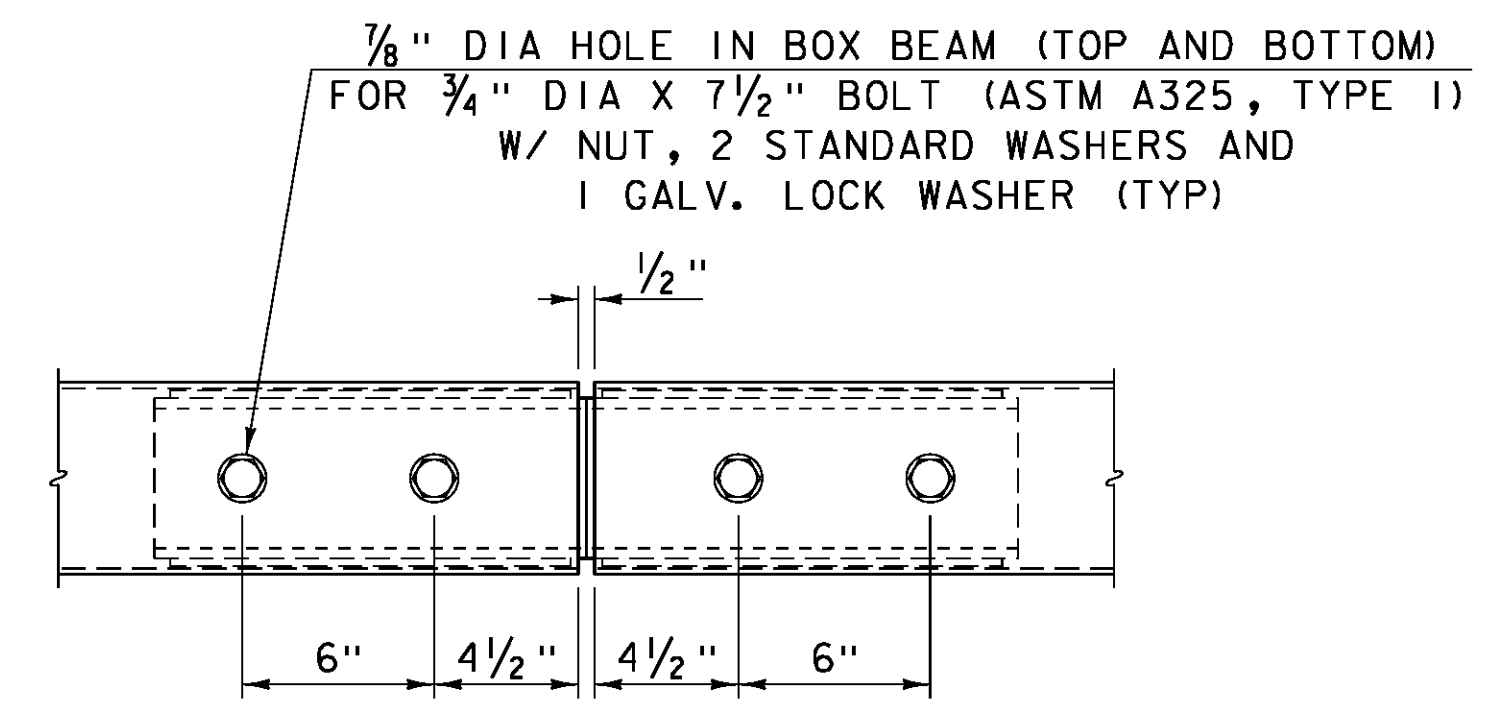


**FIXED SPLICE ASSEMBLY PLAN**  
NOT TO SCALE

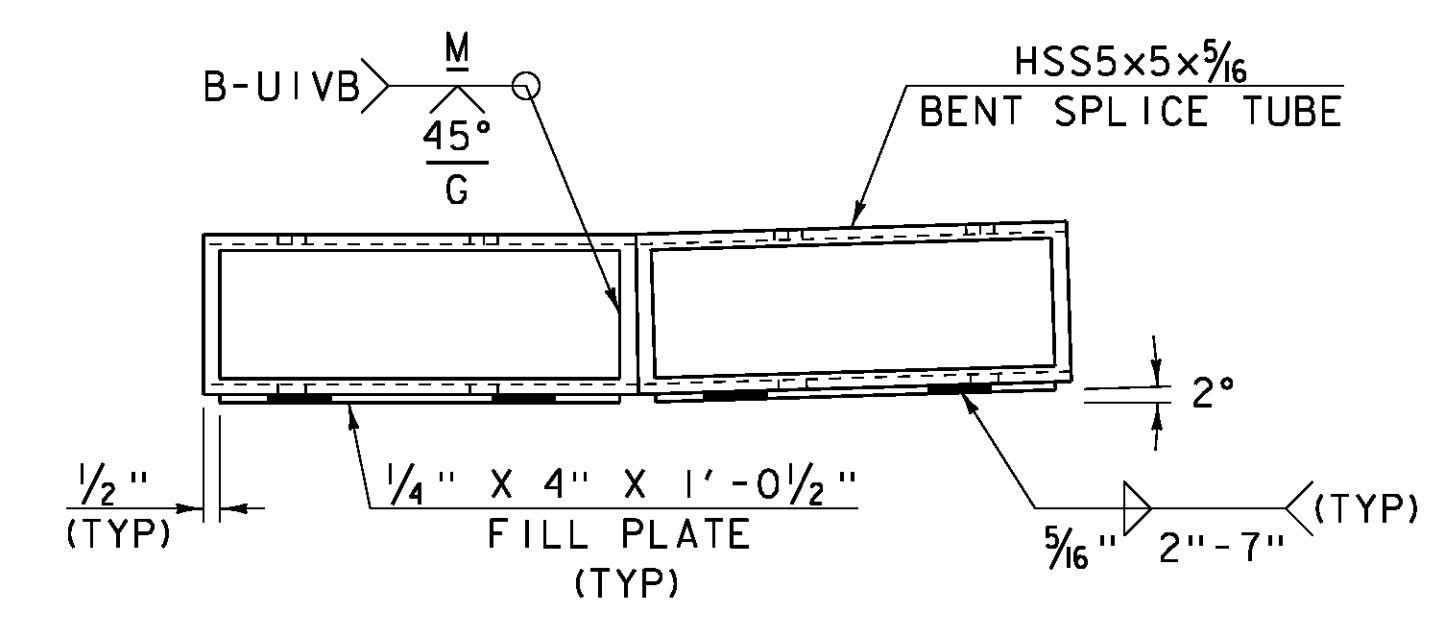

**FIXED SPLICE TUBE ELEVATION**  
NOT TO SCALE

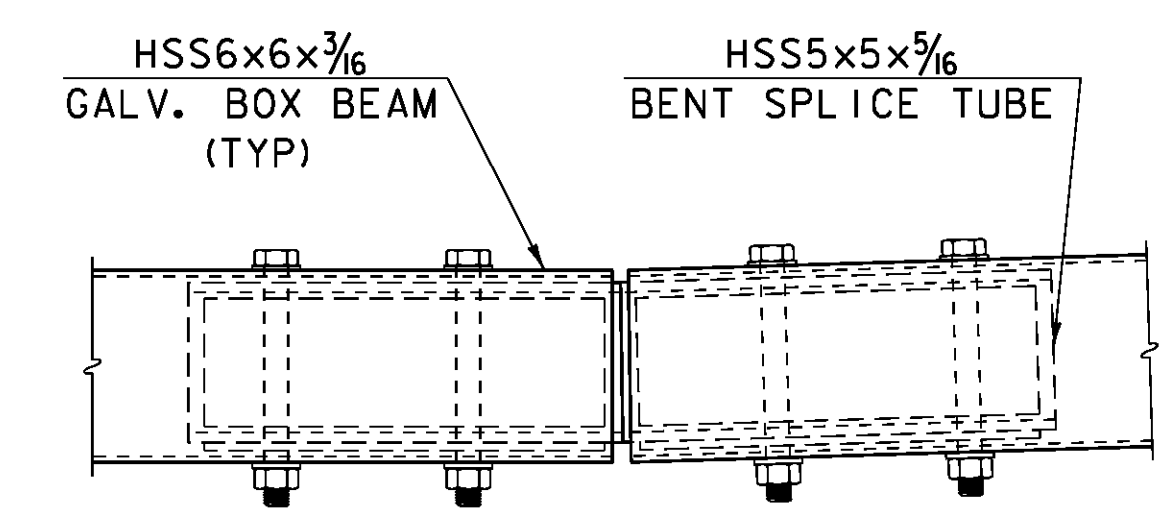


**FIXED SPLICE ASSEMBLY ELEVATION**  
NOT TO SCALE

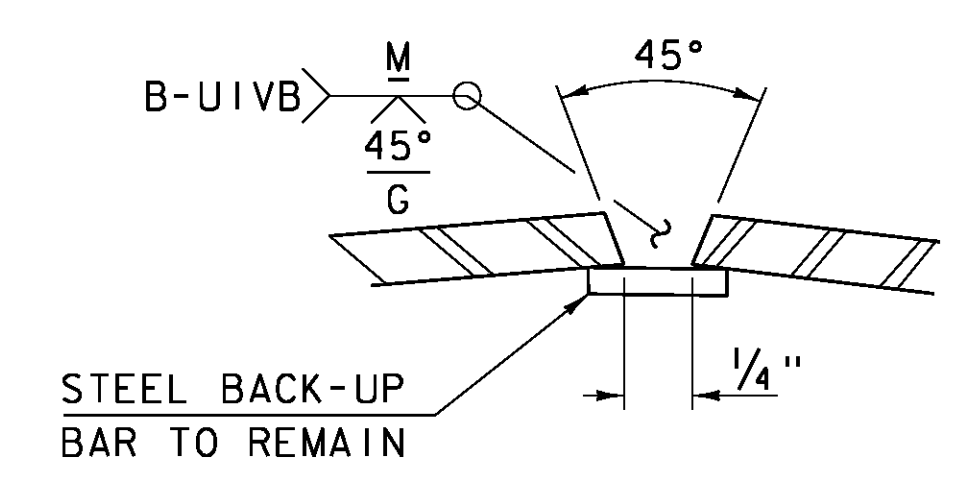


**WELD DETAIL FOR SPLICE TUBE**  
NOT TO SCALE

PROJECT NAME: ROYALTON	PLOT DATE: 08-OCT-2013
PROJECT NUMBER: BRS 0147 (13)	DRAWN BY: G. ROY
FILE NAME: \BR 28\86e055rail.28.dgn	CHECKED BY: D. PETERSON
PROJECT LEADER: C. CARLSON	SHEET 136 OF 186
DESIGNED BY: G. ROY	
BRIDGE 28 APPROACH RAIL DETAILS (3)	



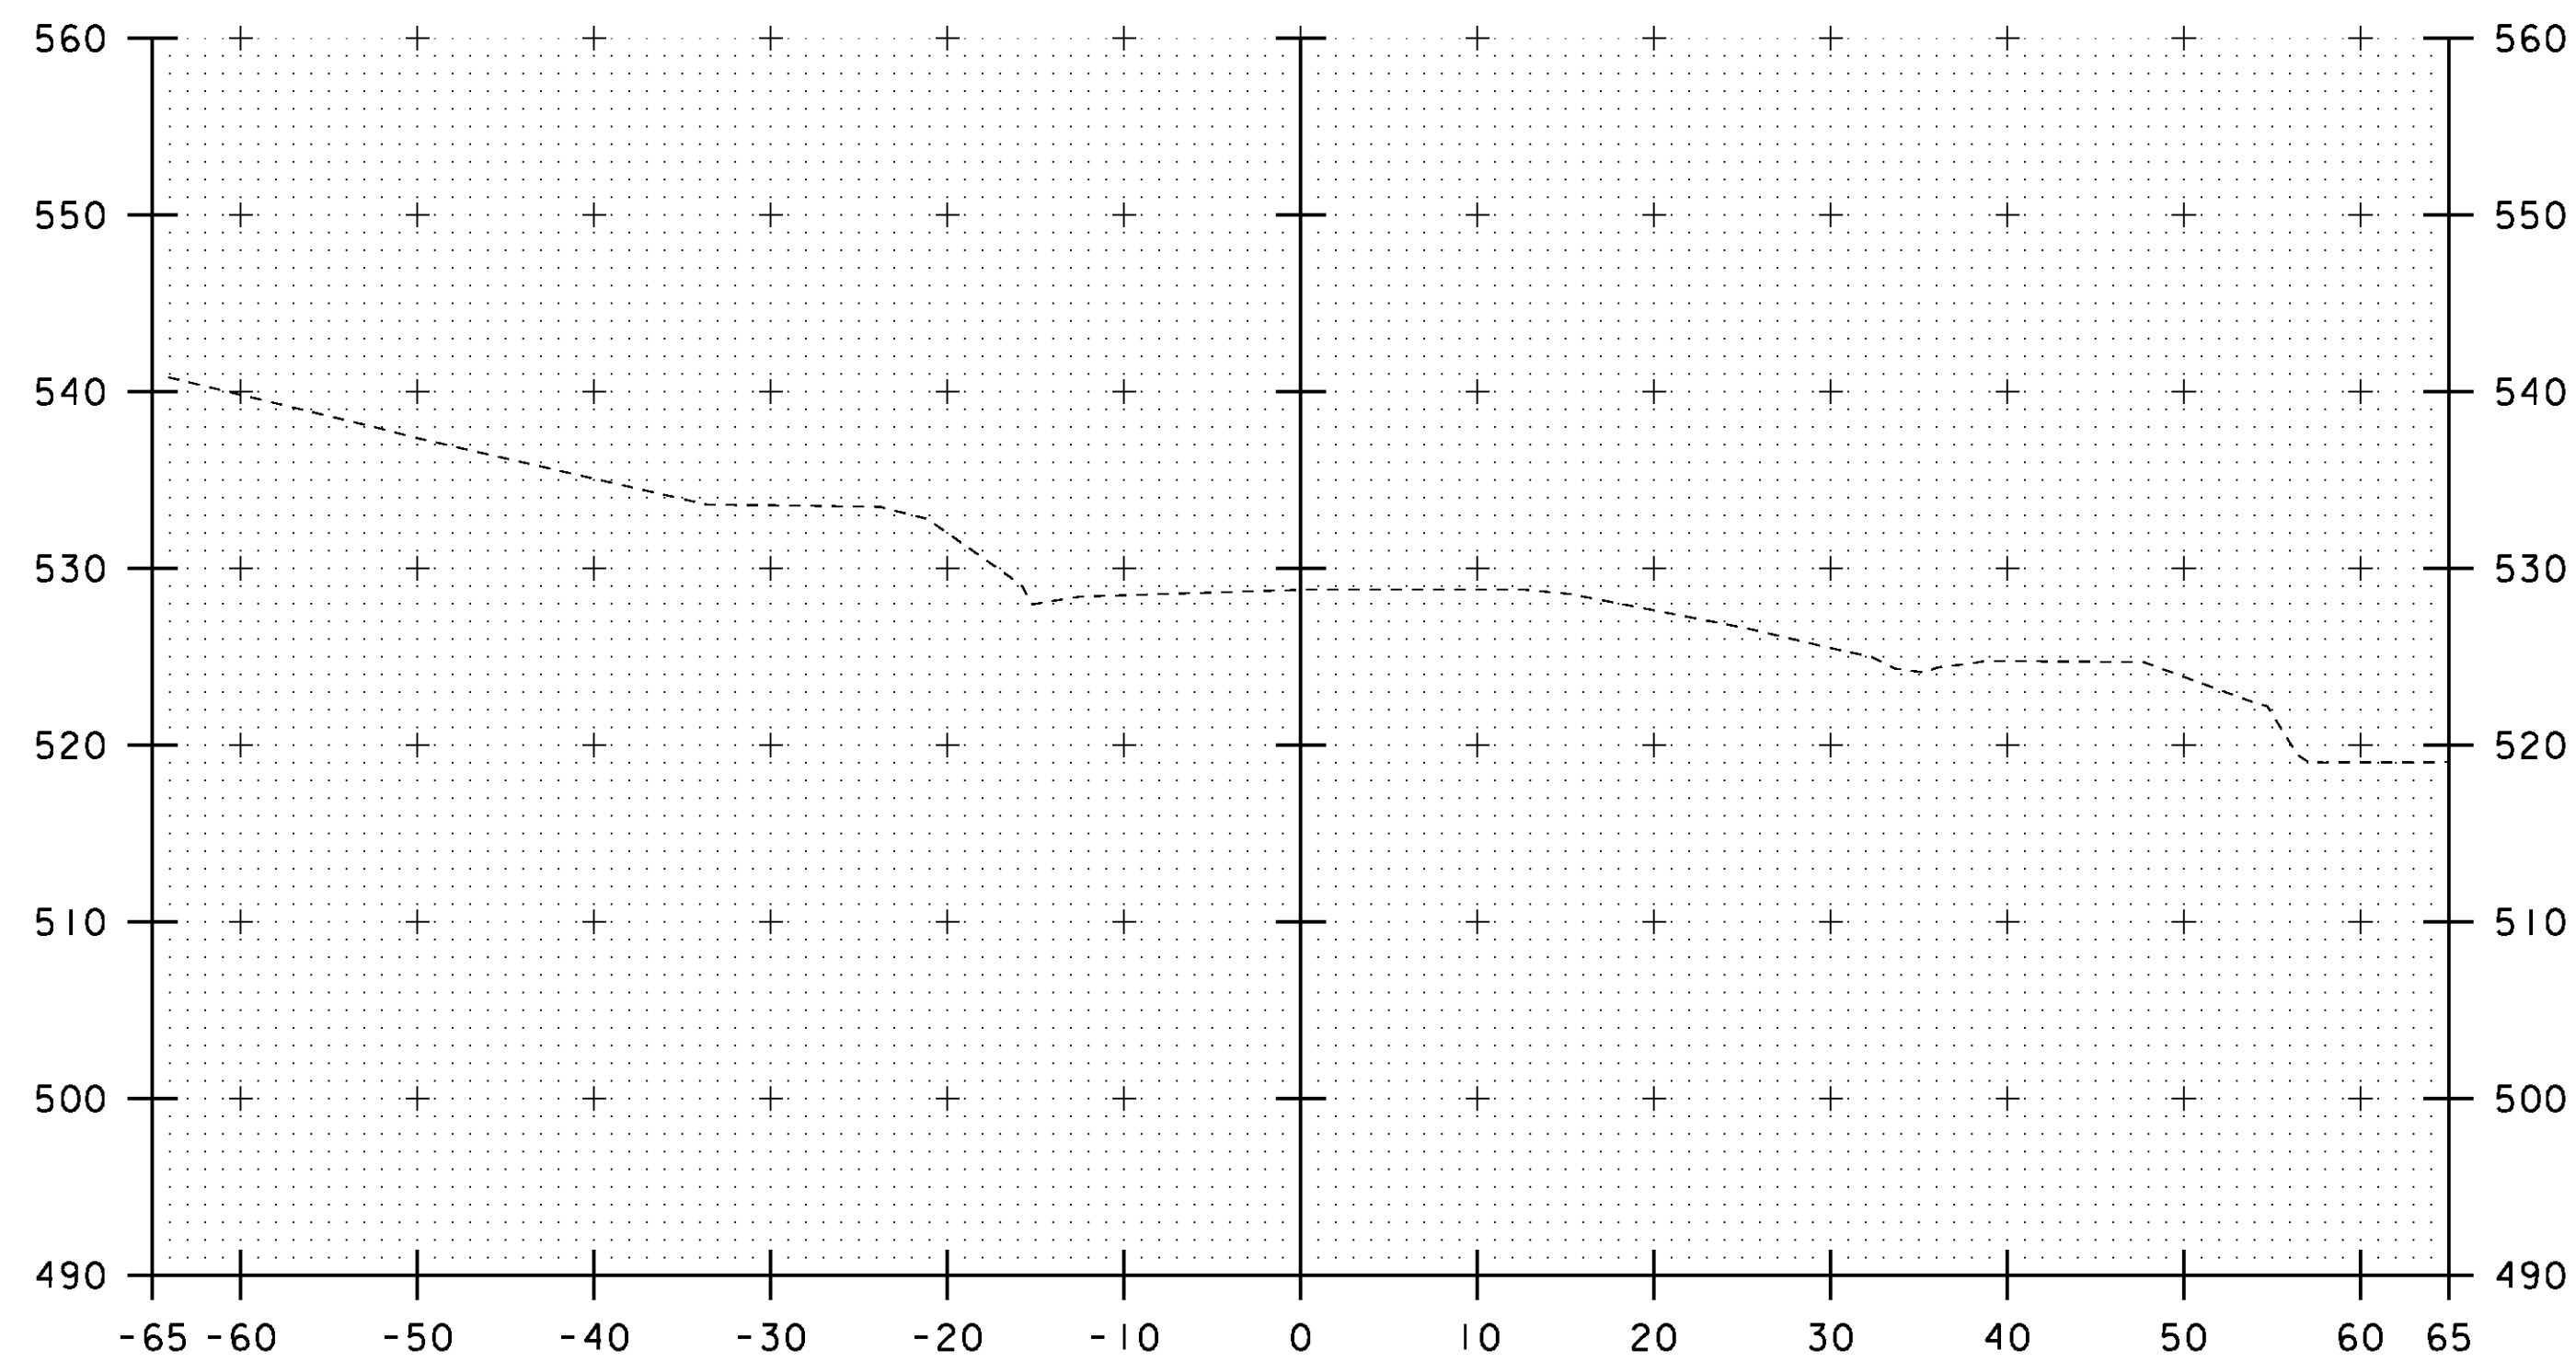


412+25

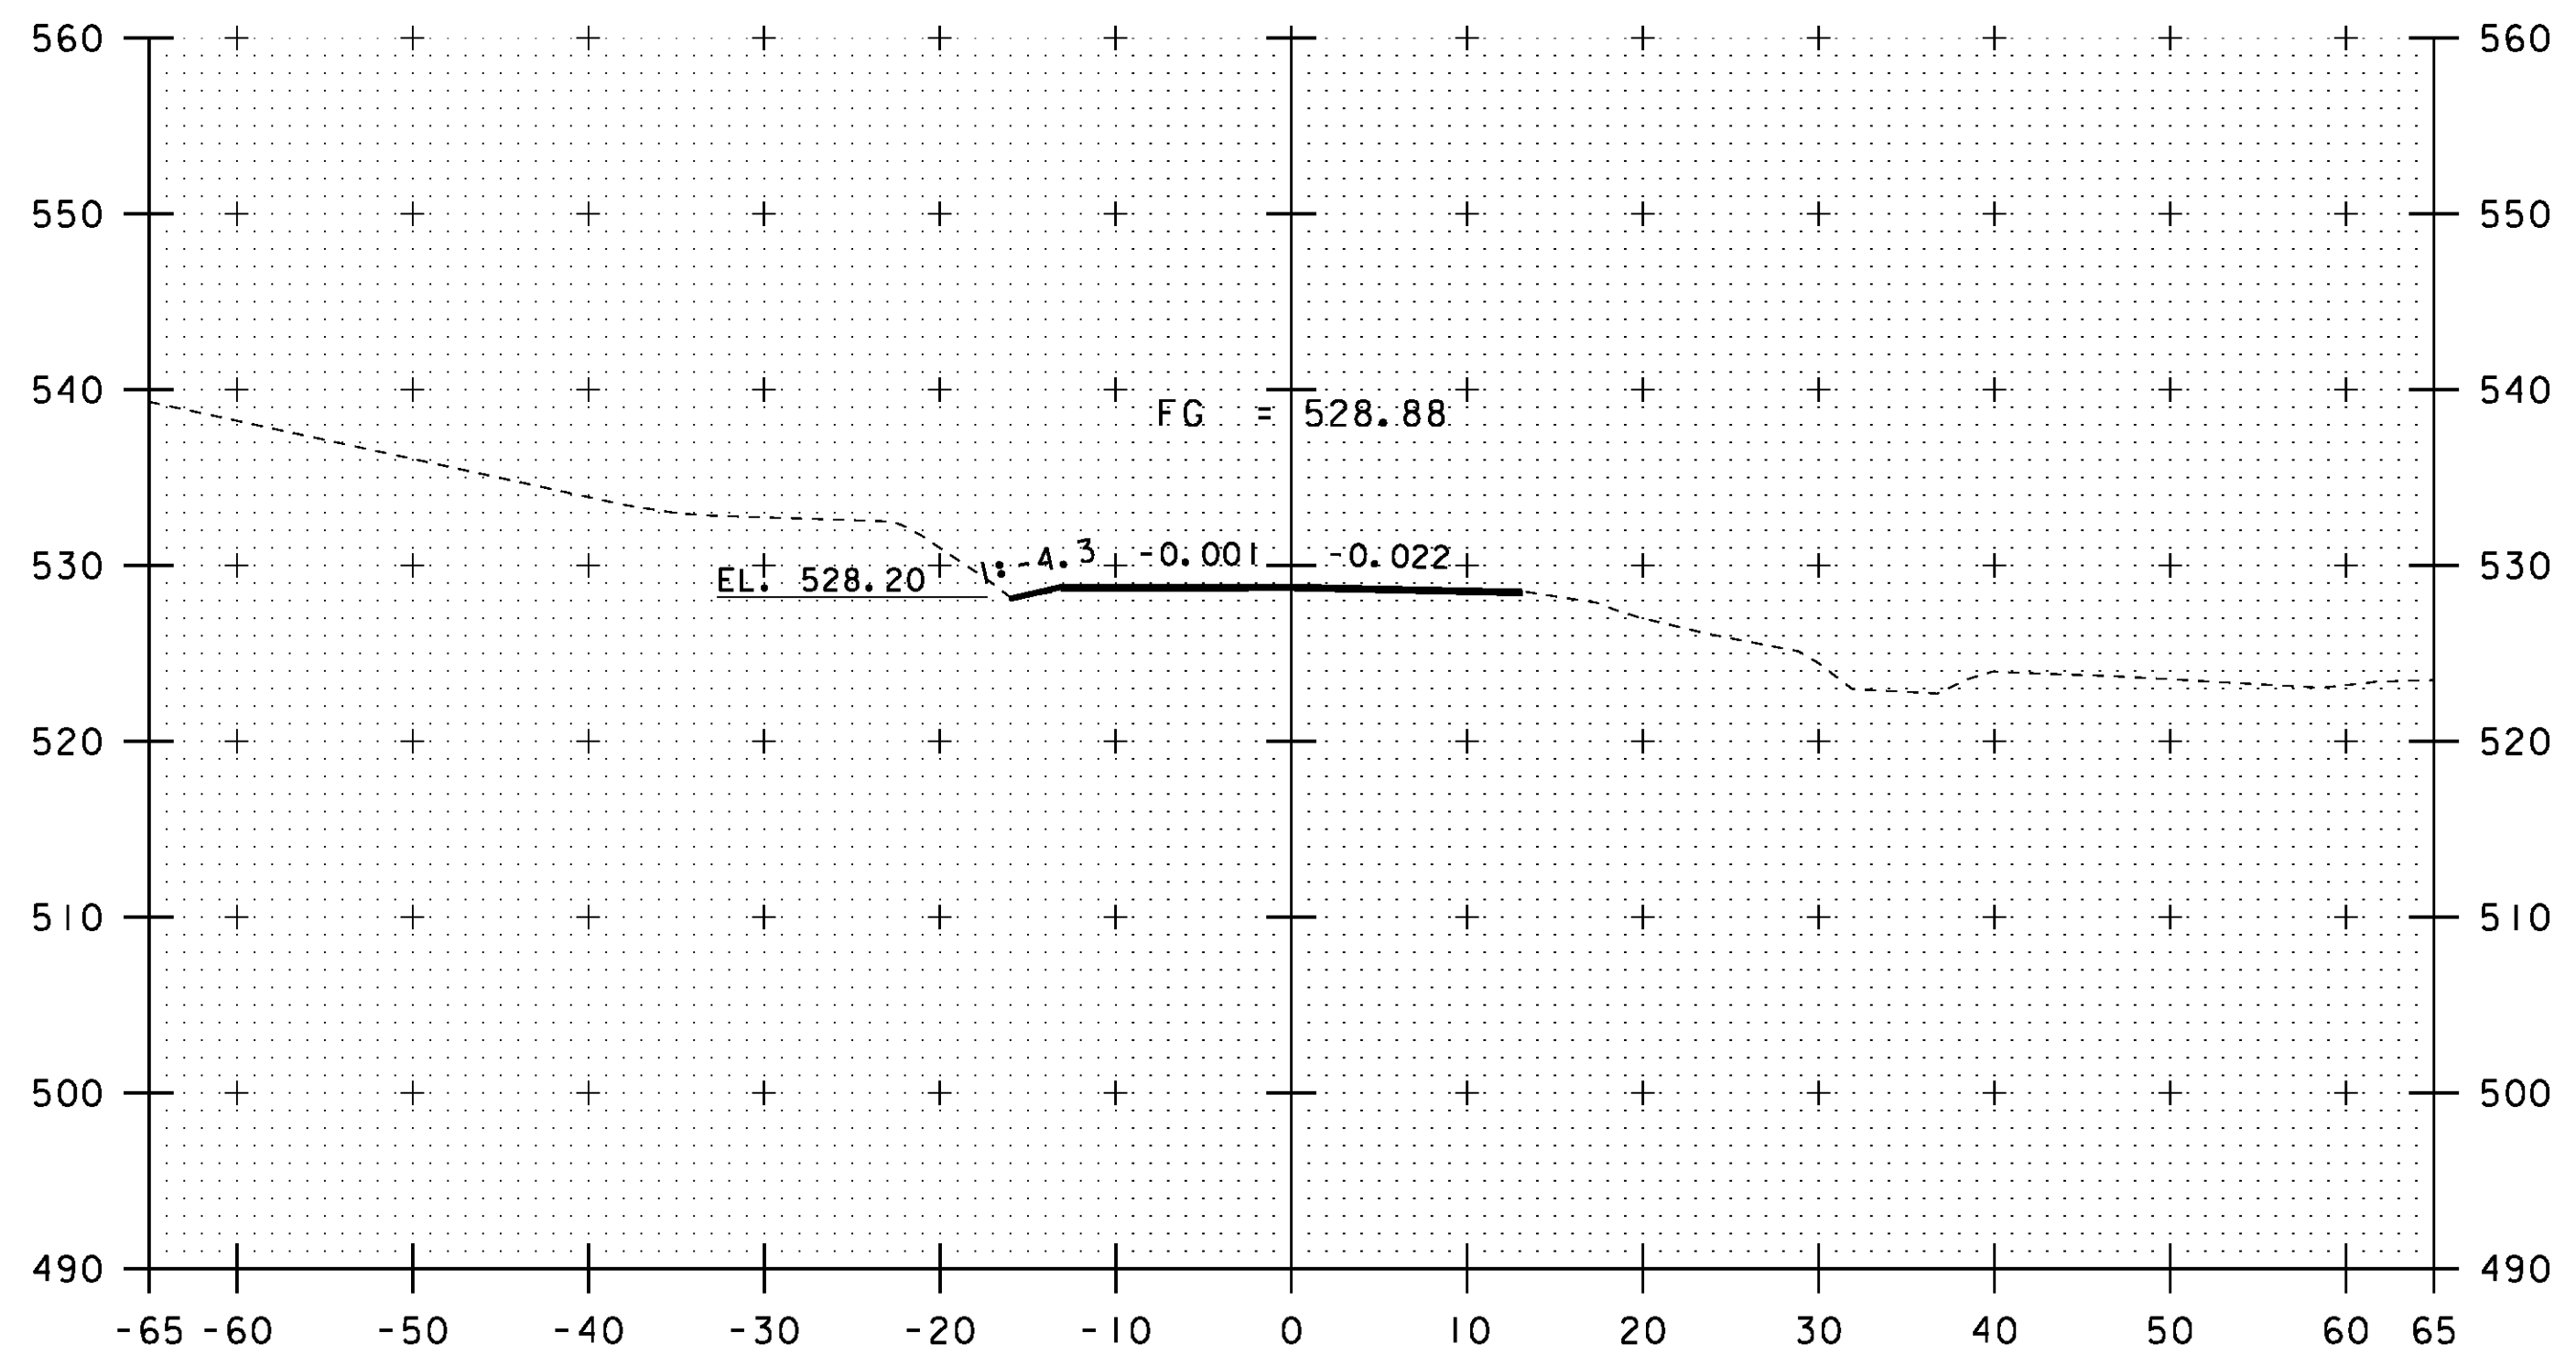


STA 412+75.00 LT. - TH #22 STA 31+40 LT  
CONSTRUCT GRASS-LINED DITCH


412+75

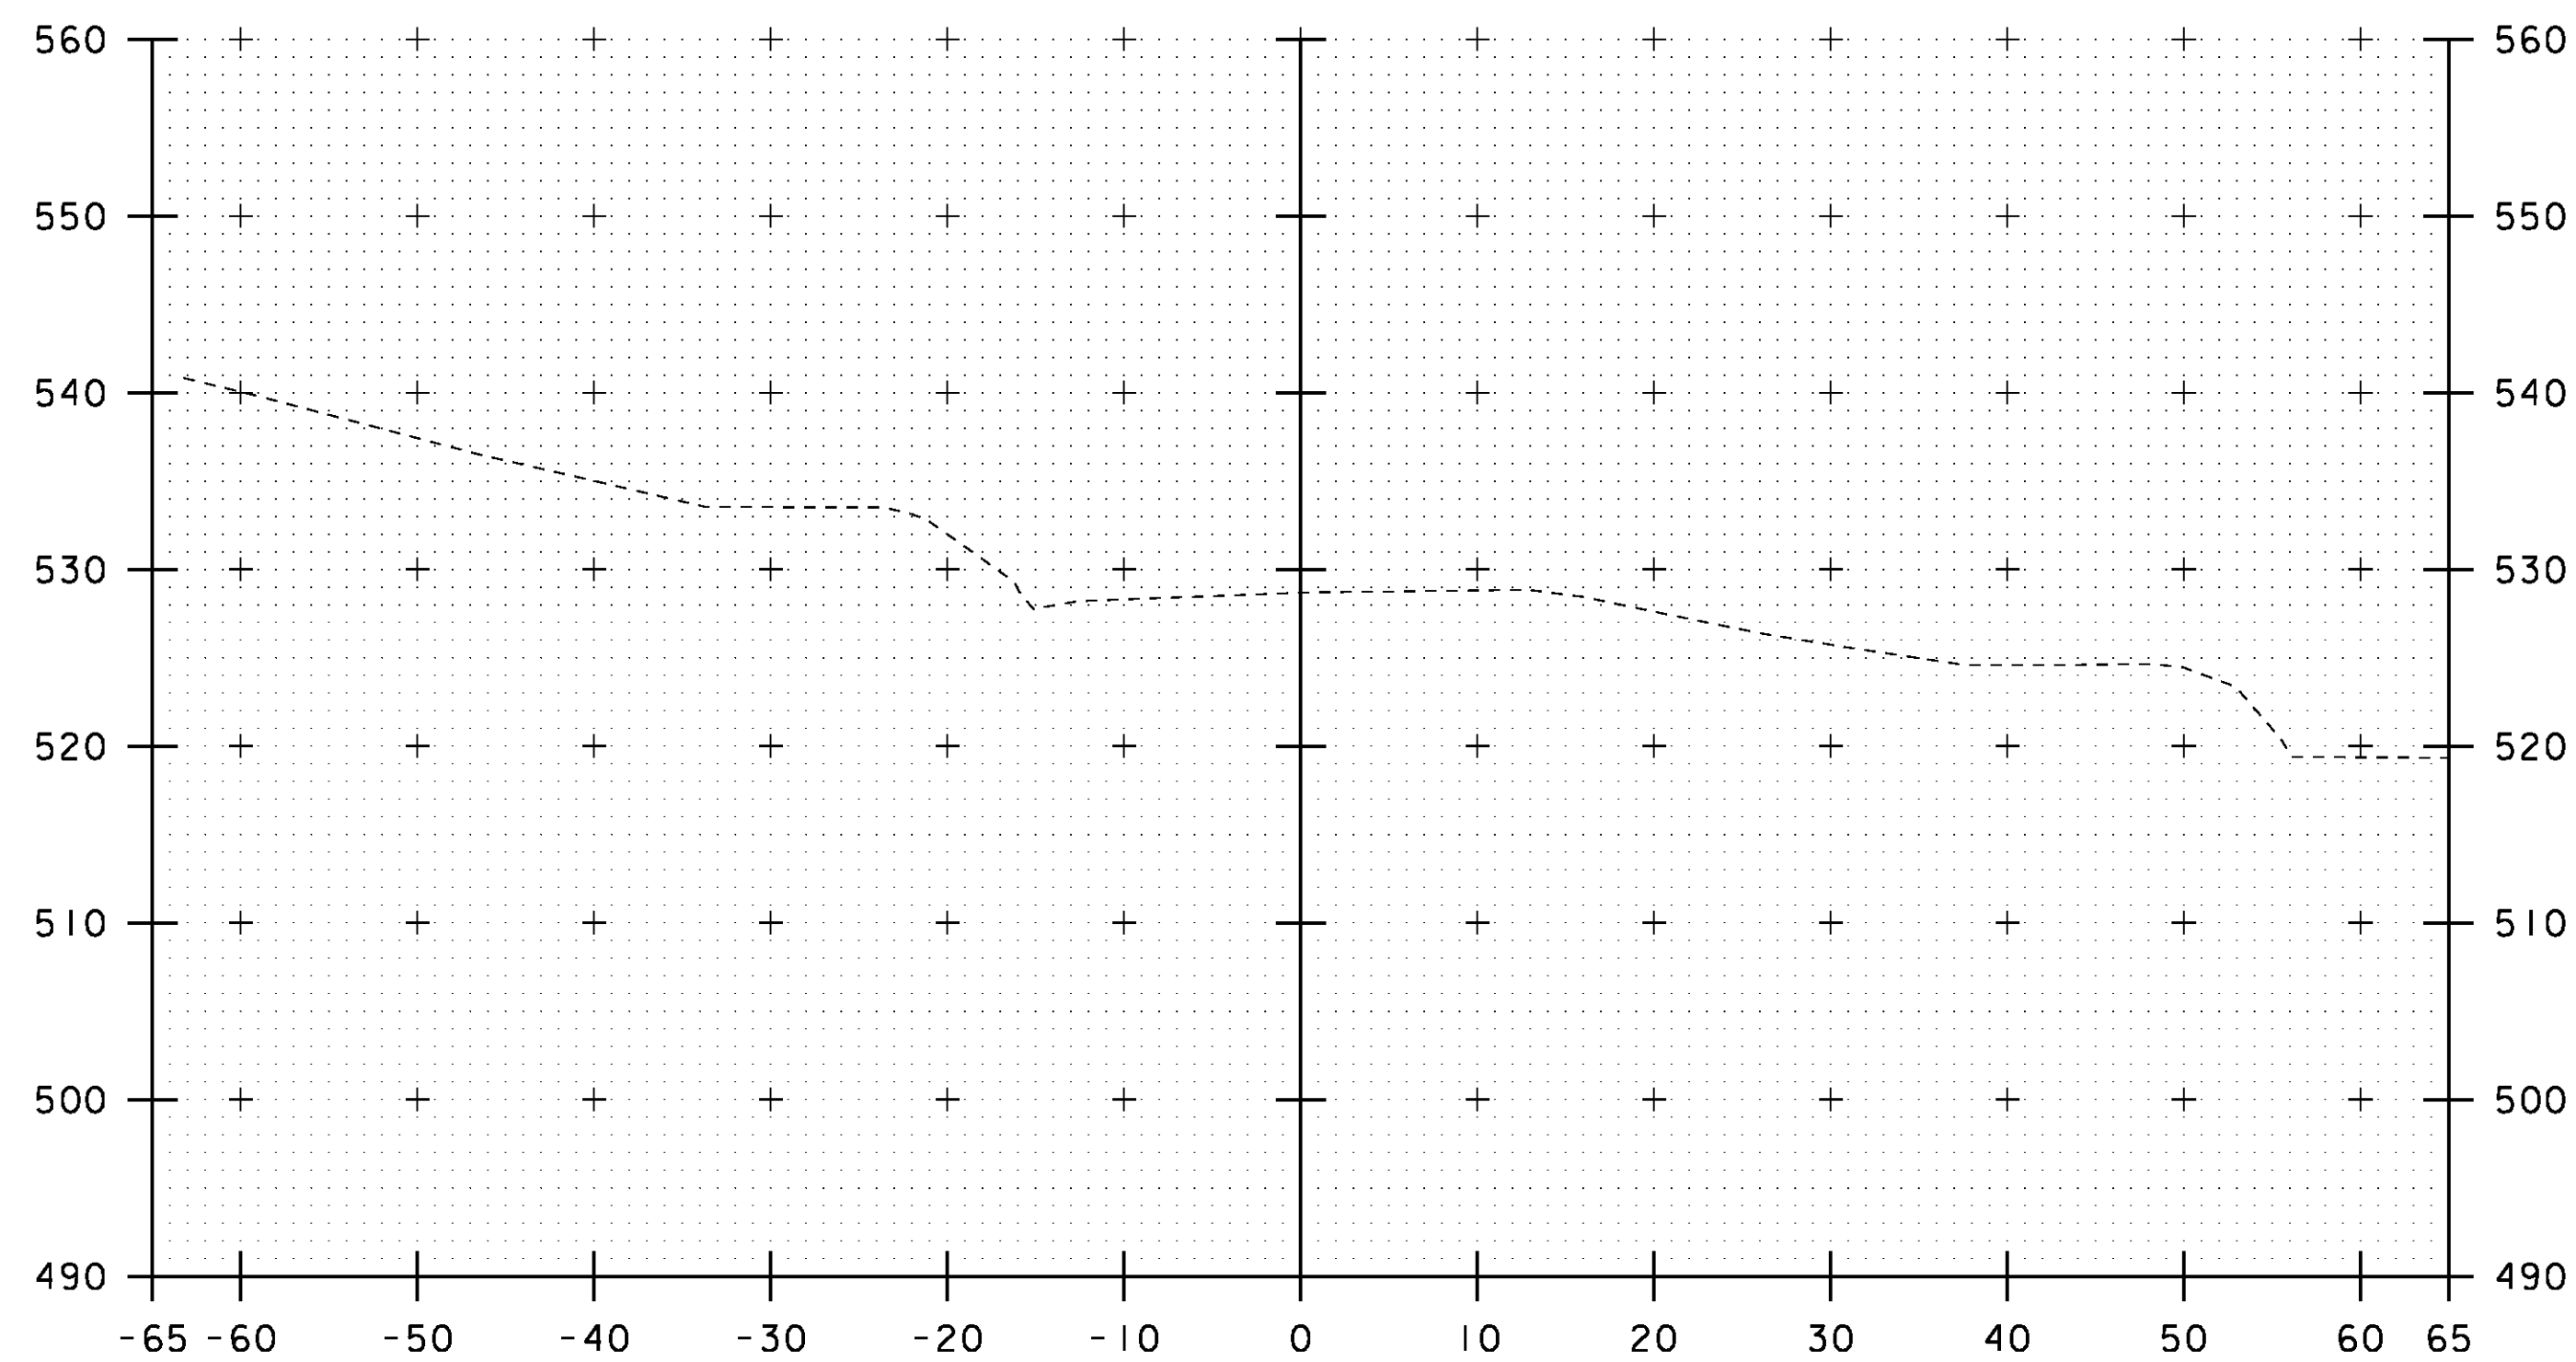

412+00

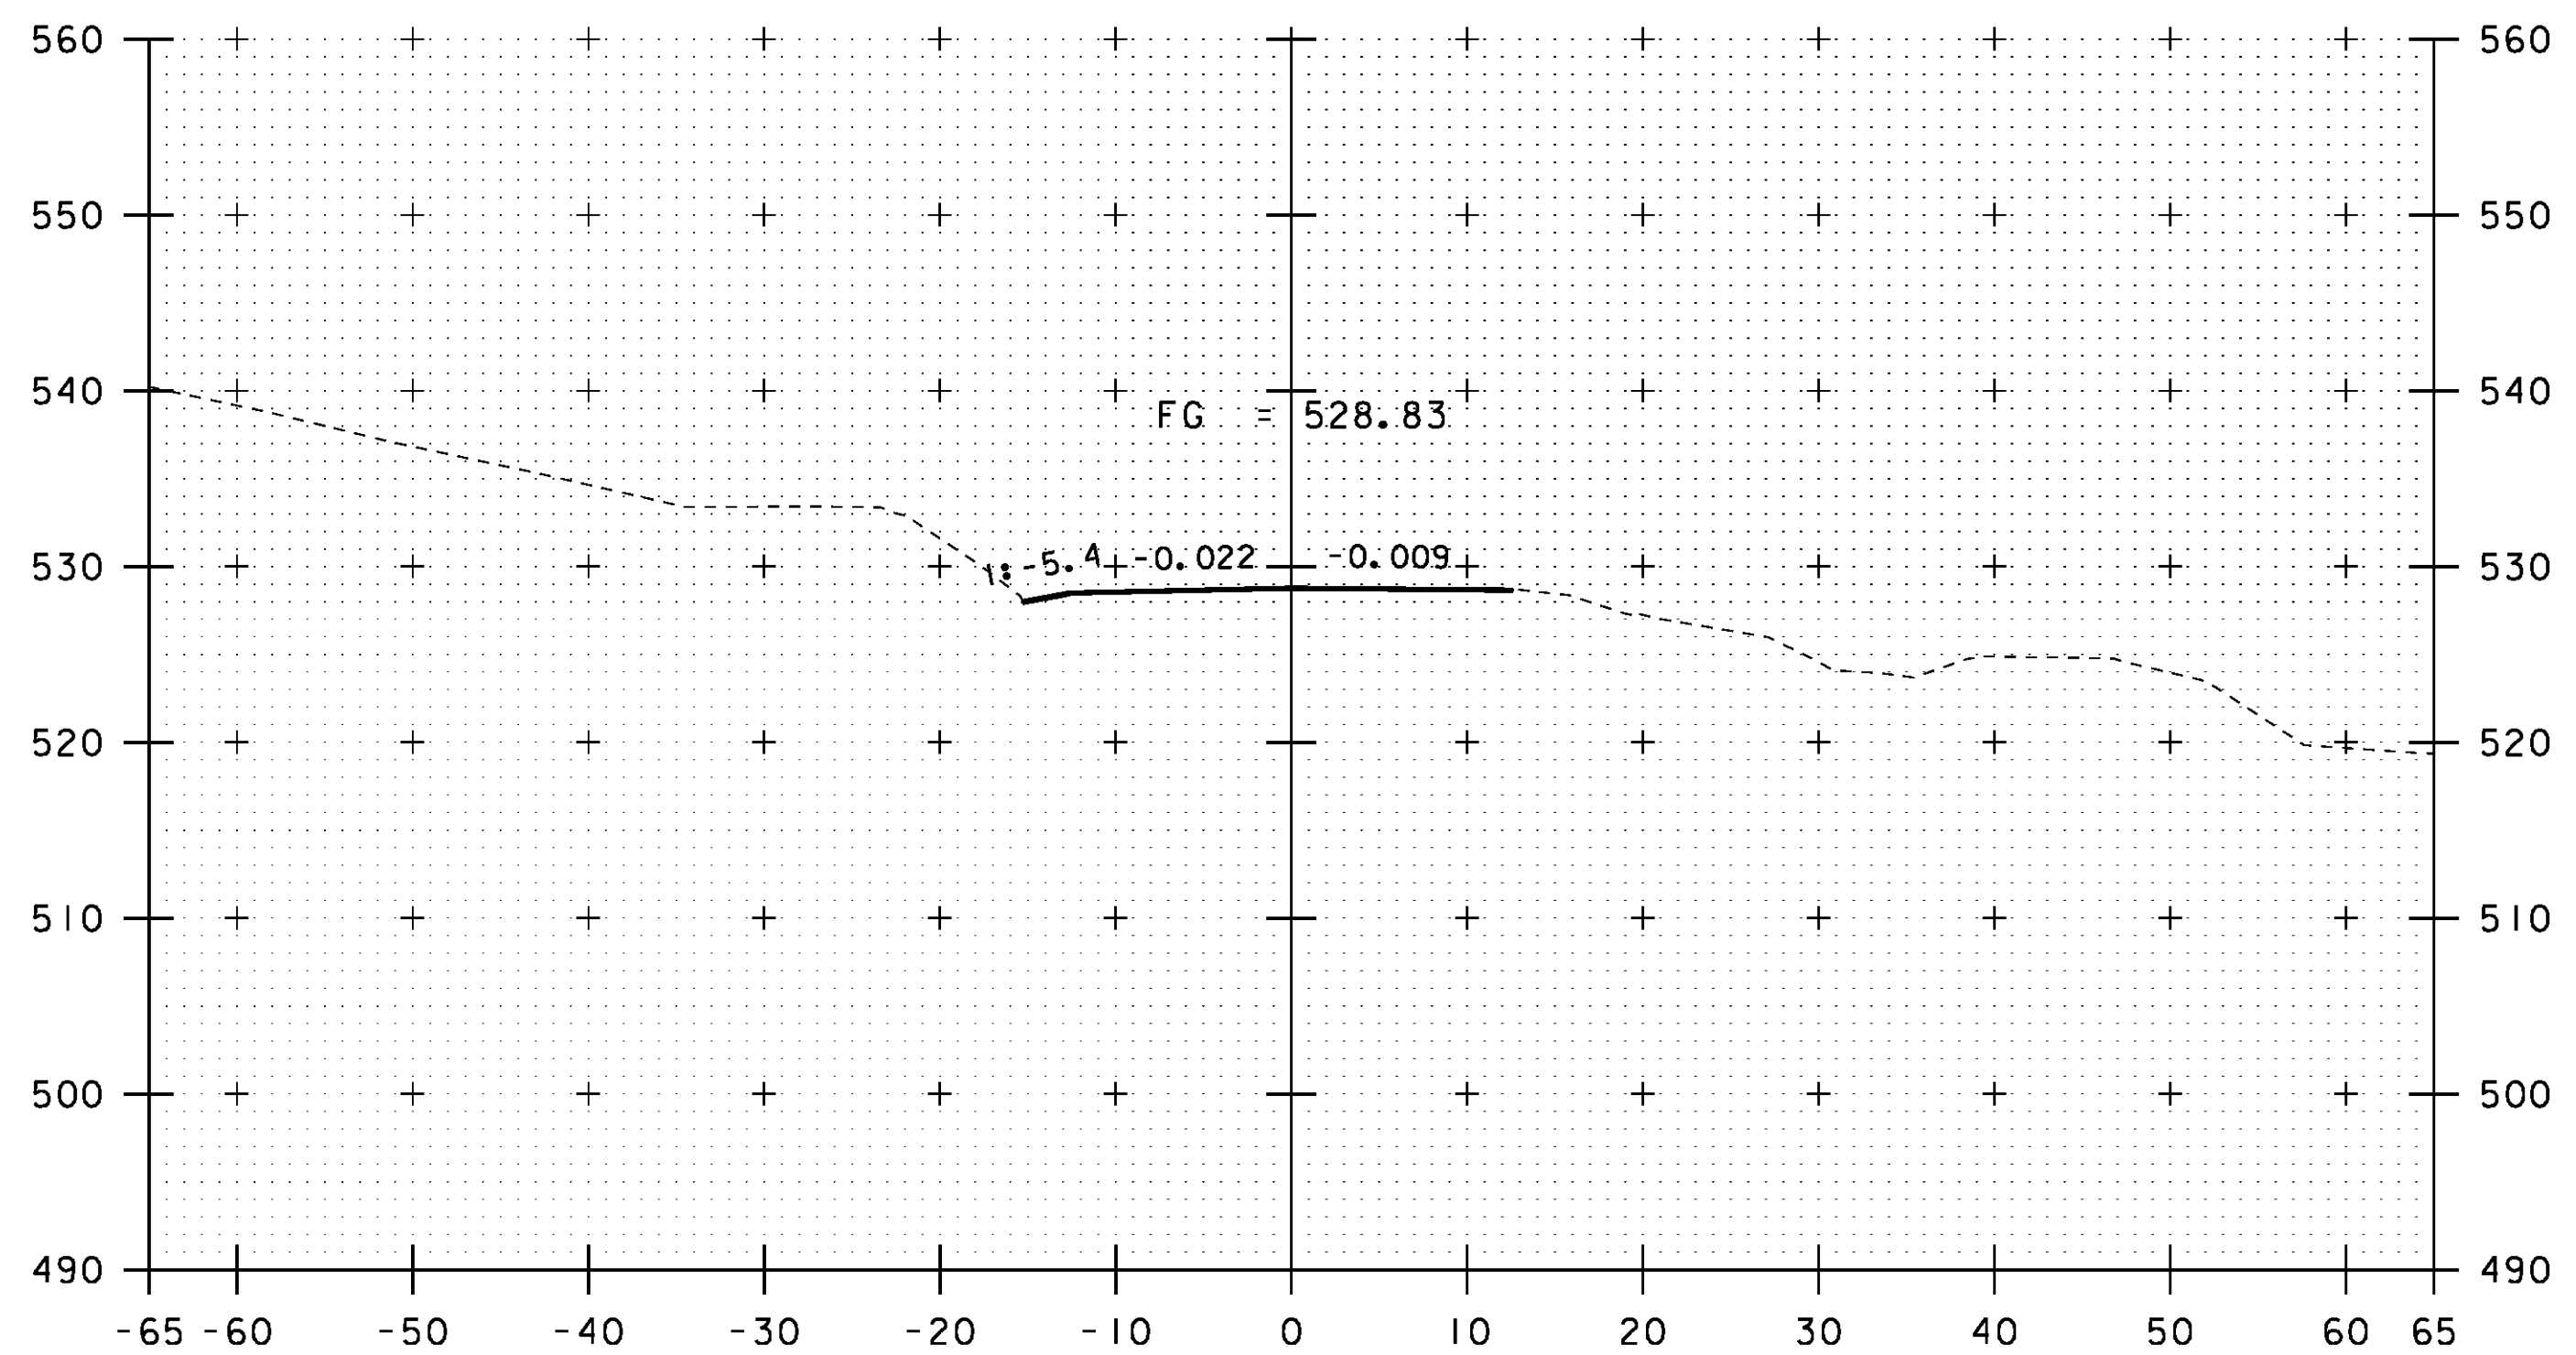

412+50  
BEGIN APPROACH  
MATCH EXISTING

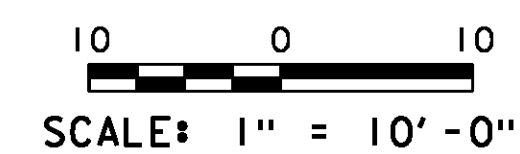


STA. 412+00 TO STA. 412+75


PROJECT NAME: ROYALTON  
PROJECT NUMBER: BRS 0147 (13)

FILE NAME: \BR_28\s86e055xsl_28.dgn  
PROJECT LEADER: C. CARLSON  
DESIGNED BY: D. PETERSON  
BRIDGE 28 VT 14 CROSS SECTIONS (1)

PLOT DATE: 08-OCT-2013  
DRAWN BY: STR3  
CHECKED BY: C. CARLSON  
SHEET 137 OF 186

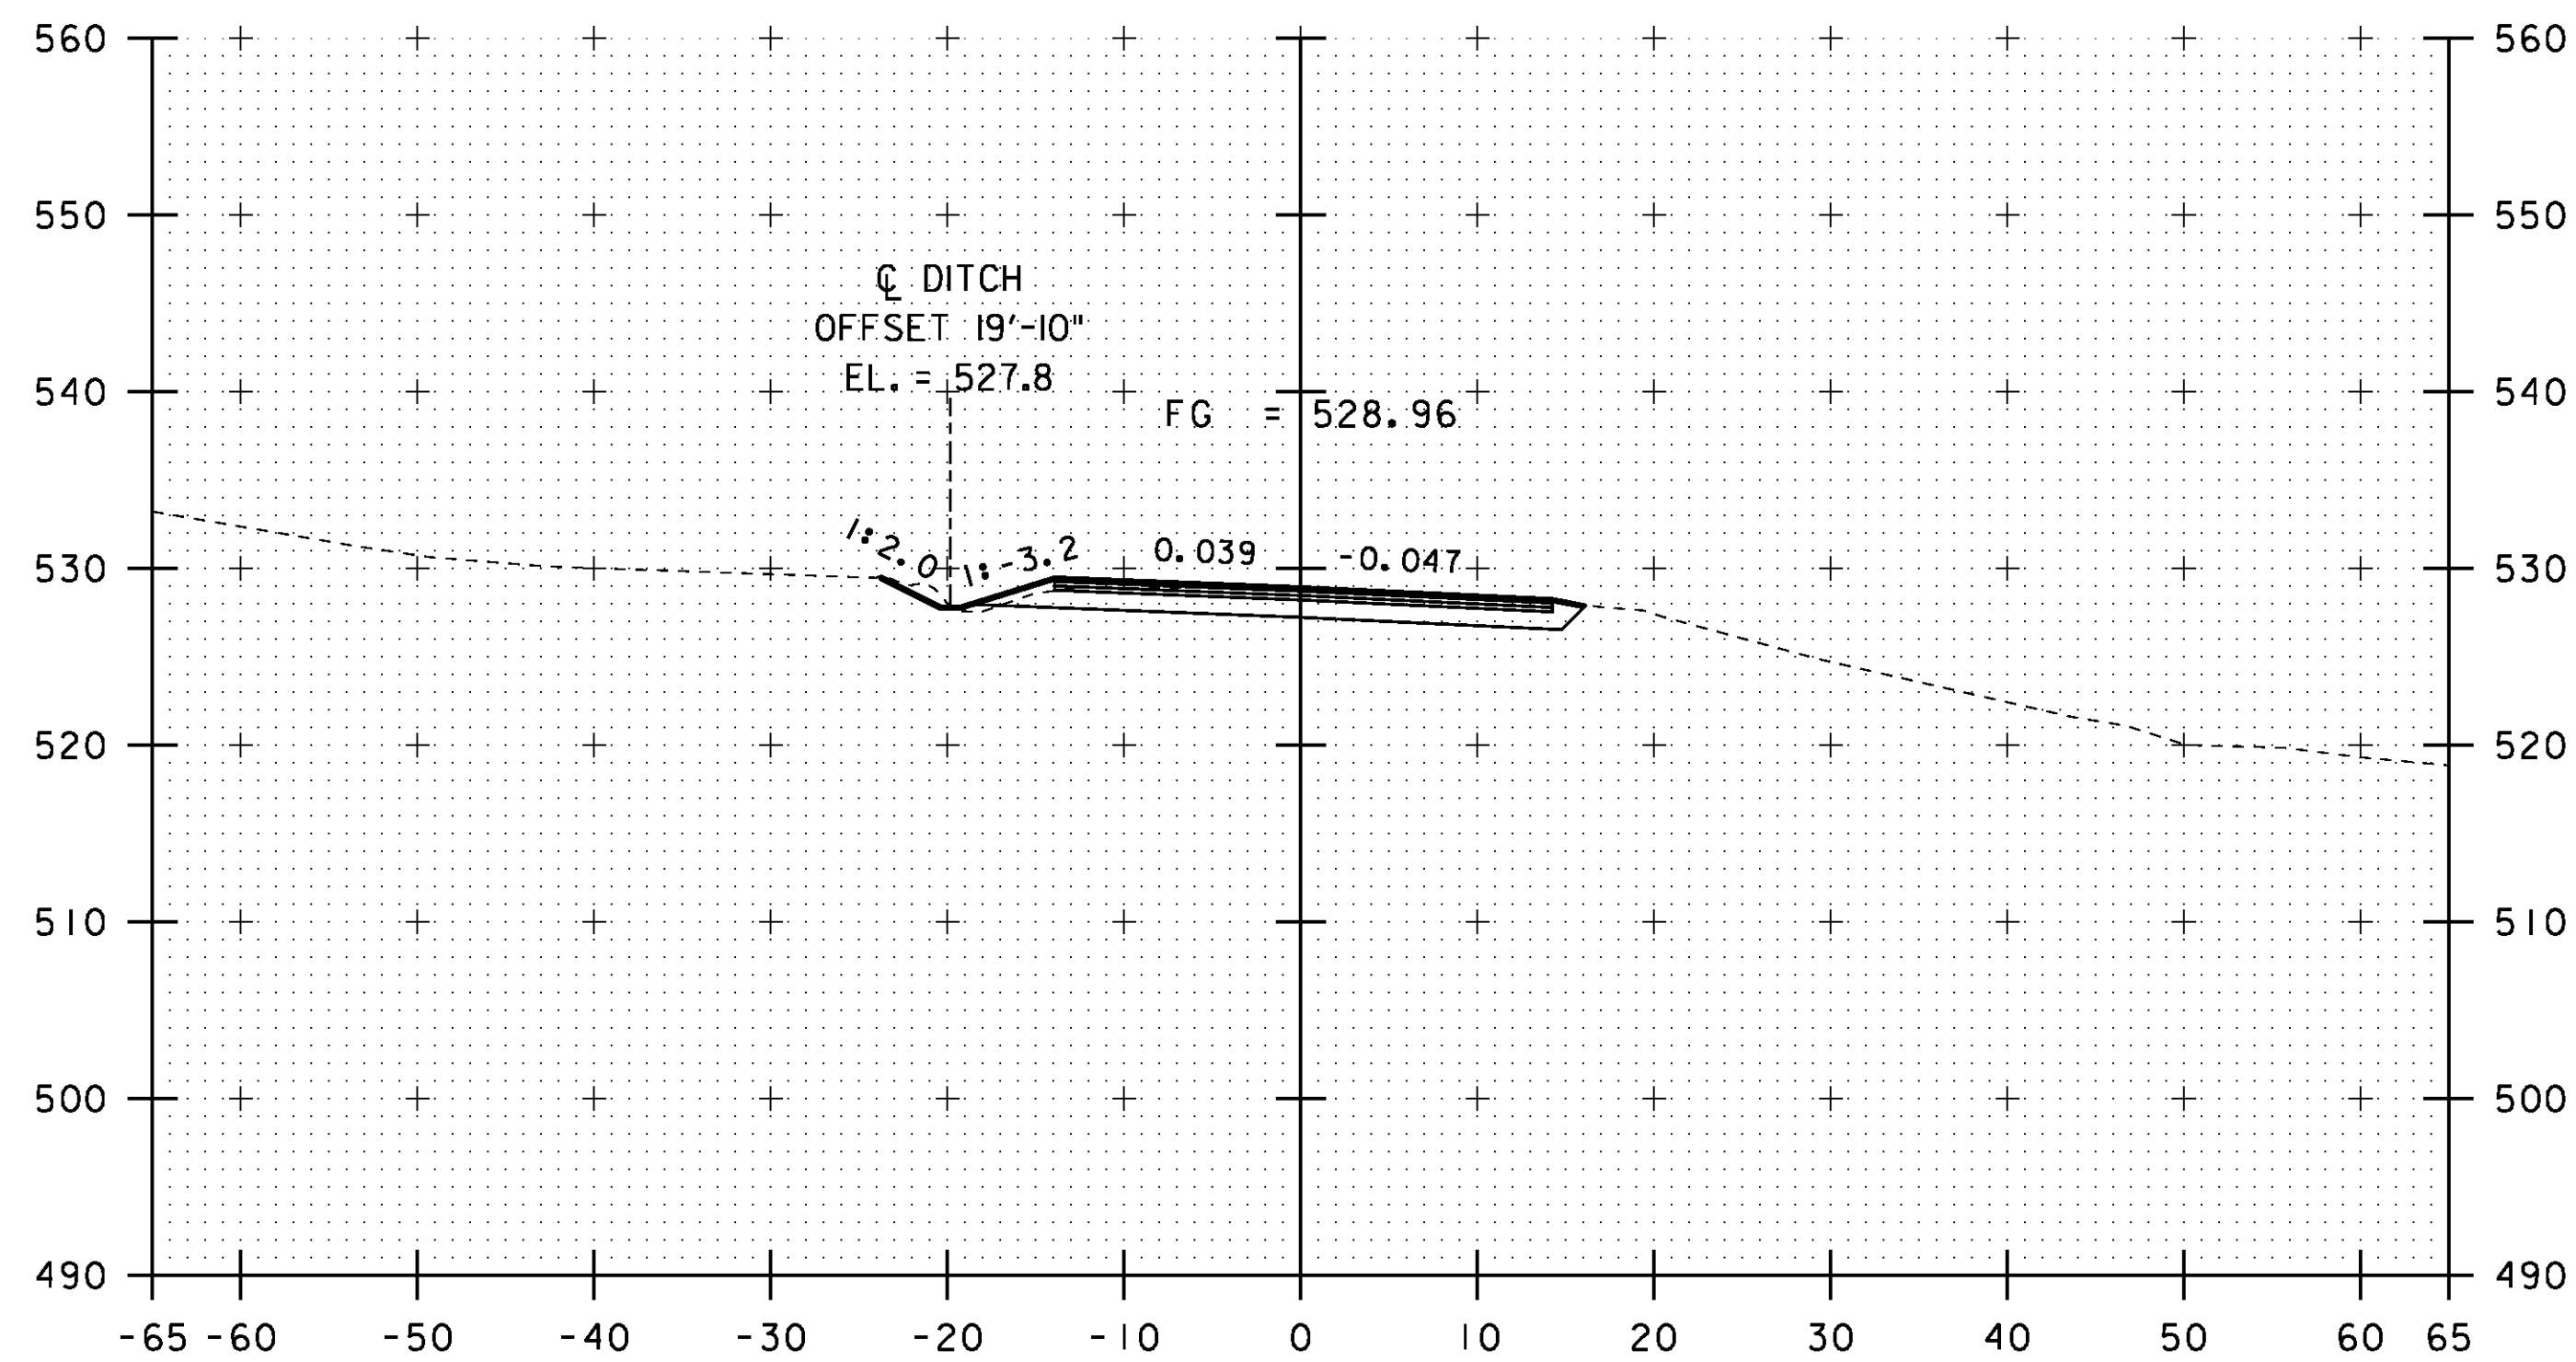

413+25

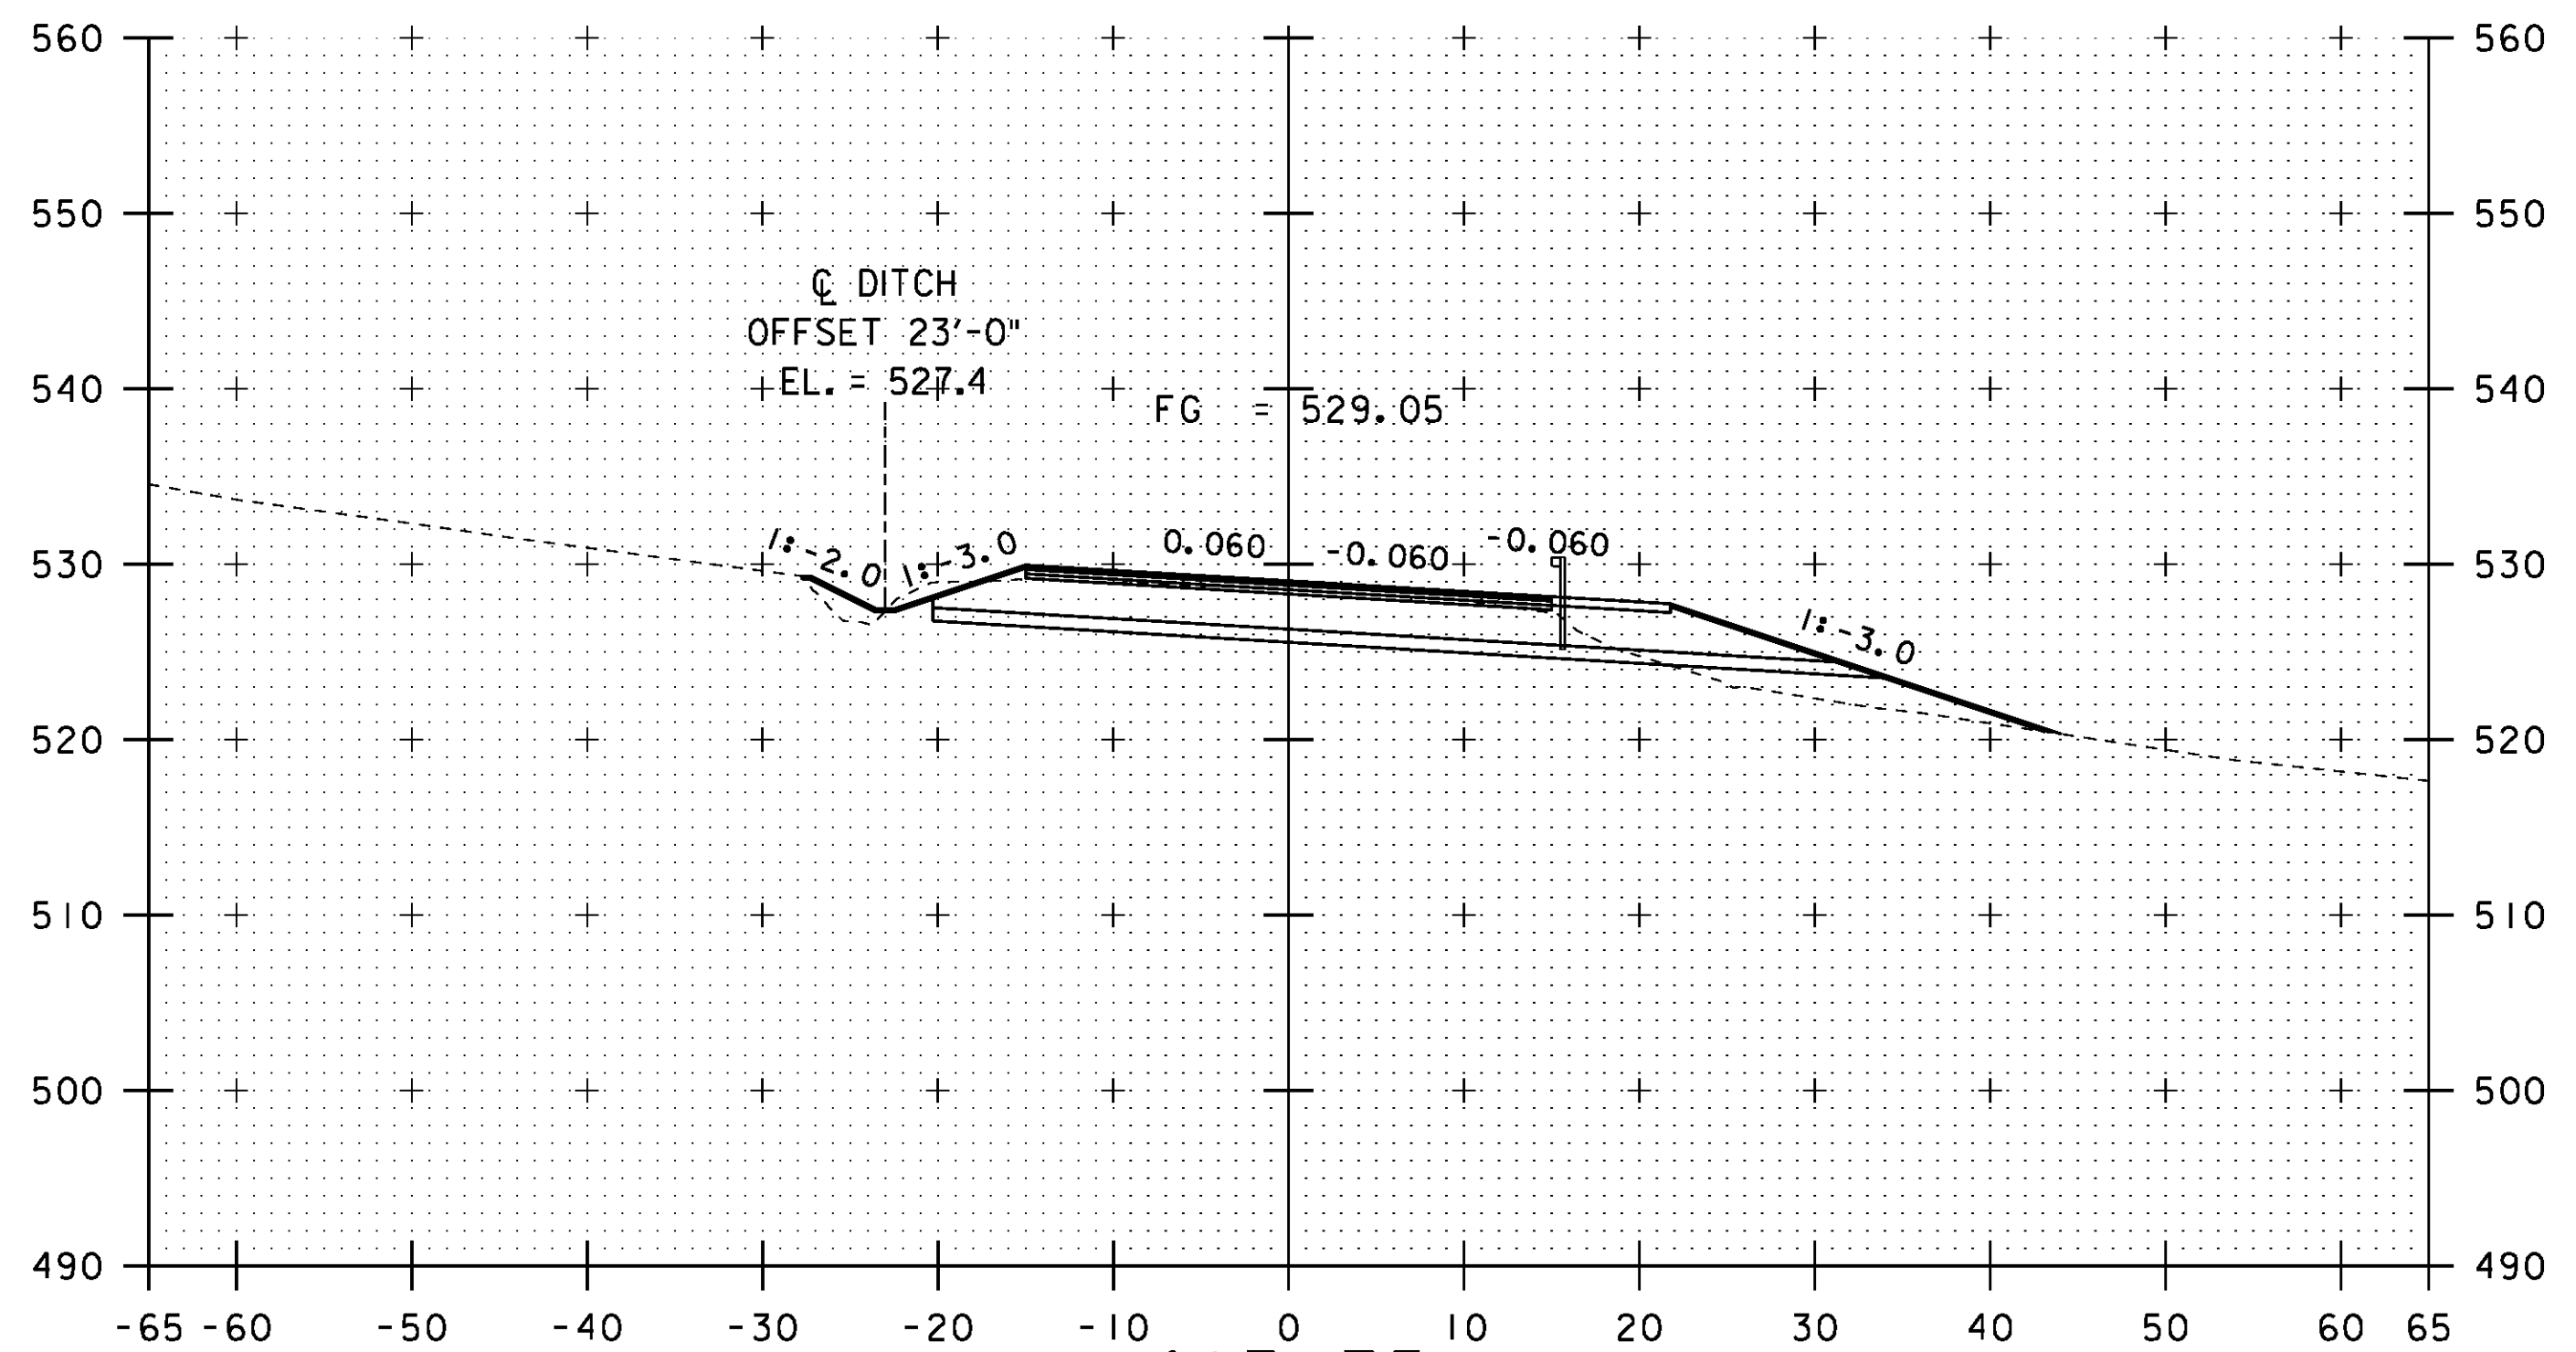


413+75


413+70.00  
END APPROACH

RESUME FULL DEPTH ROADWAY


STA 413+65.00 C/L  
REMOVE EXISTING 18" CGMP

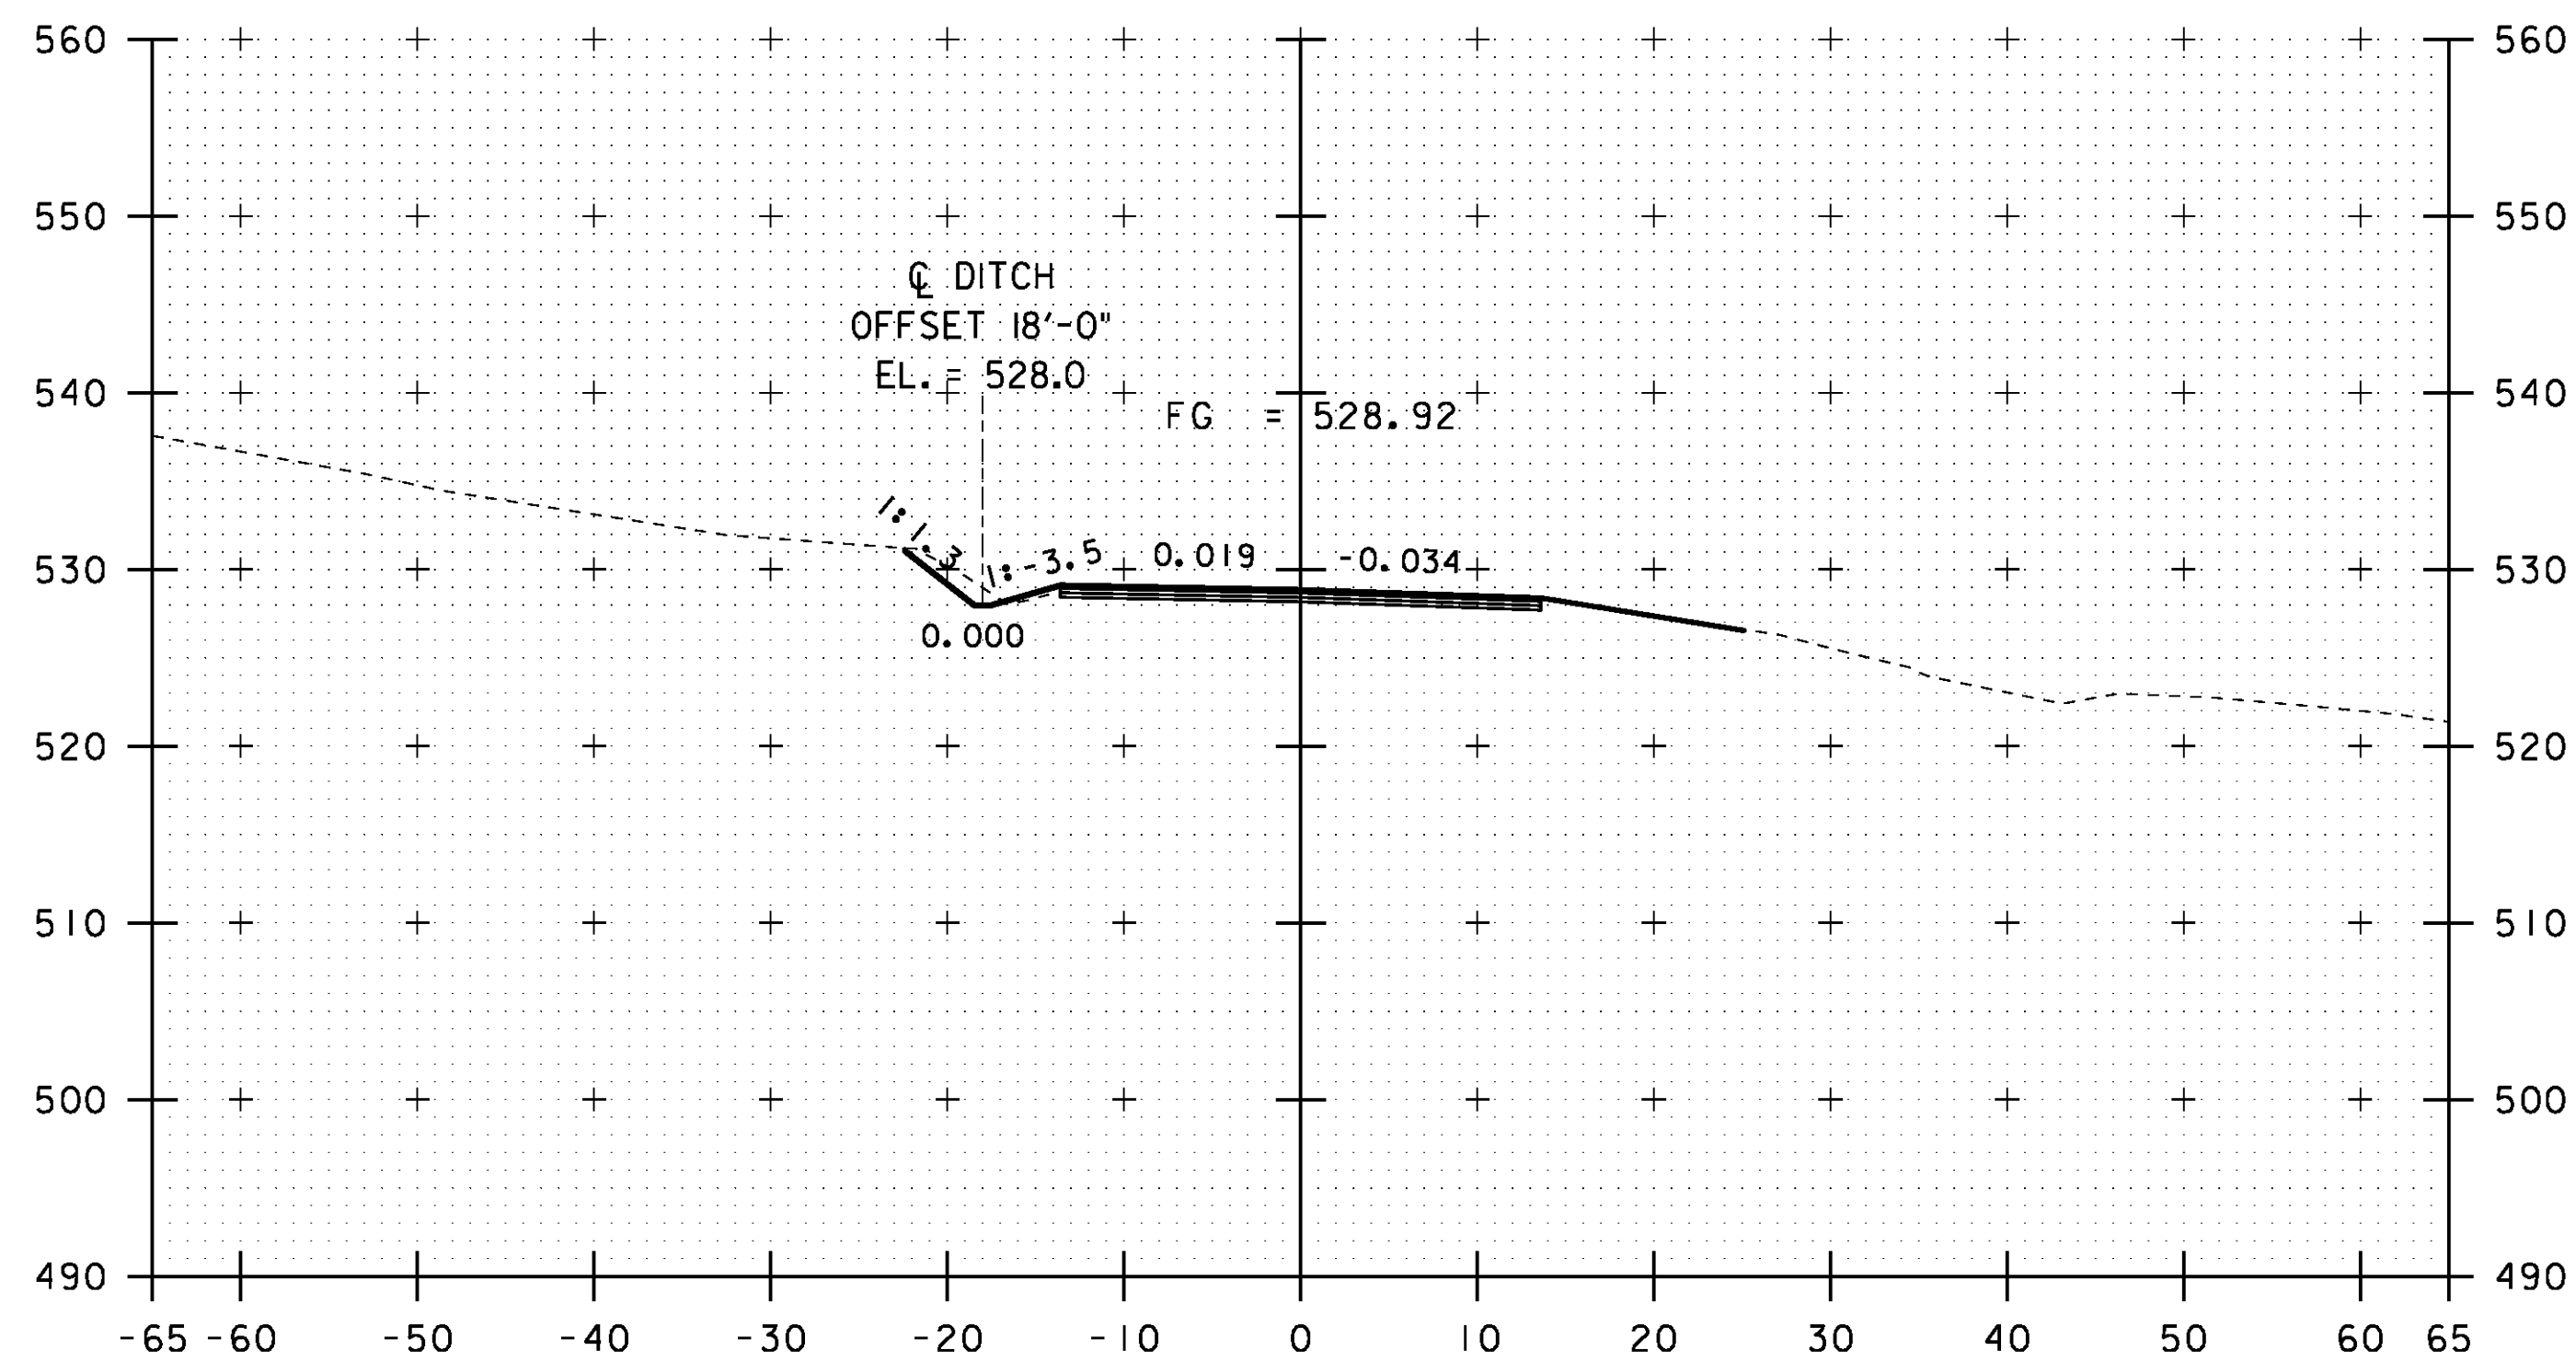


413+00

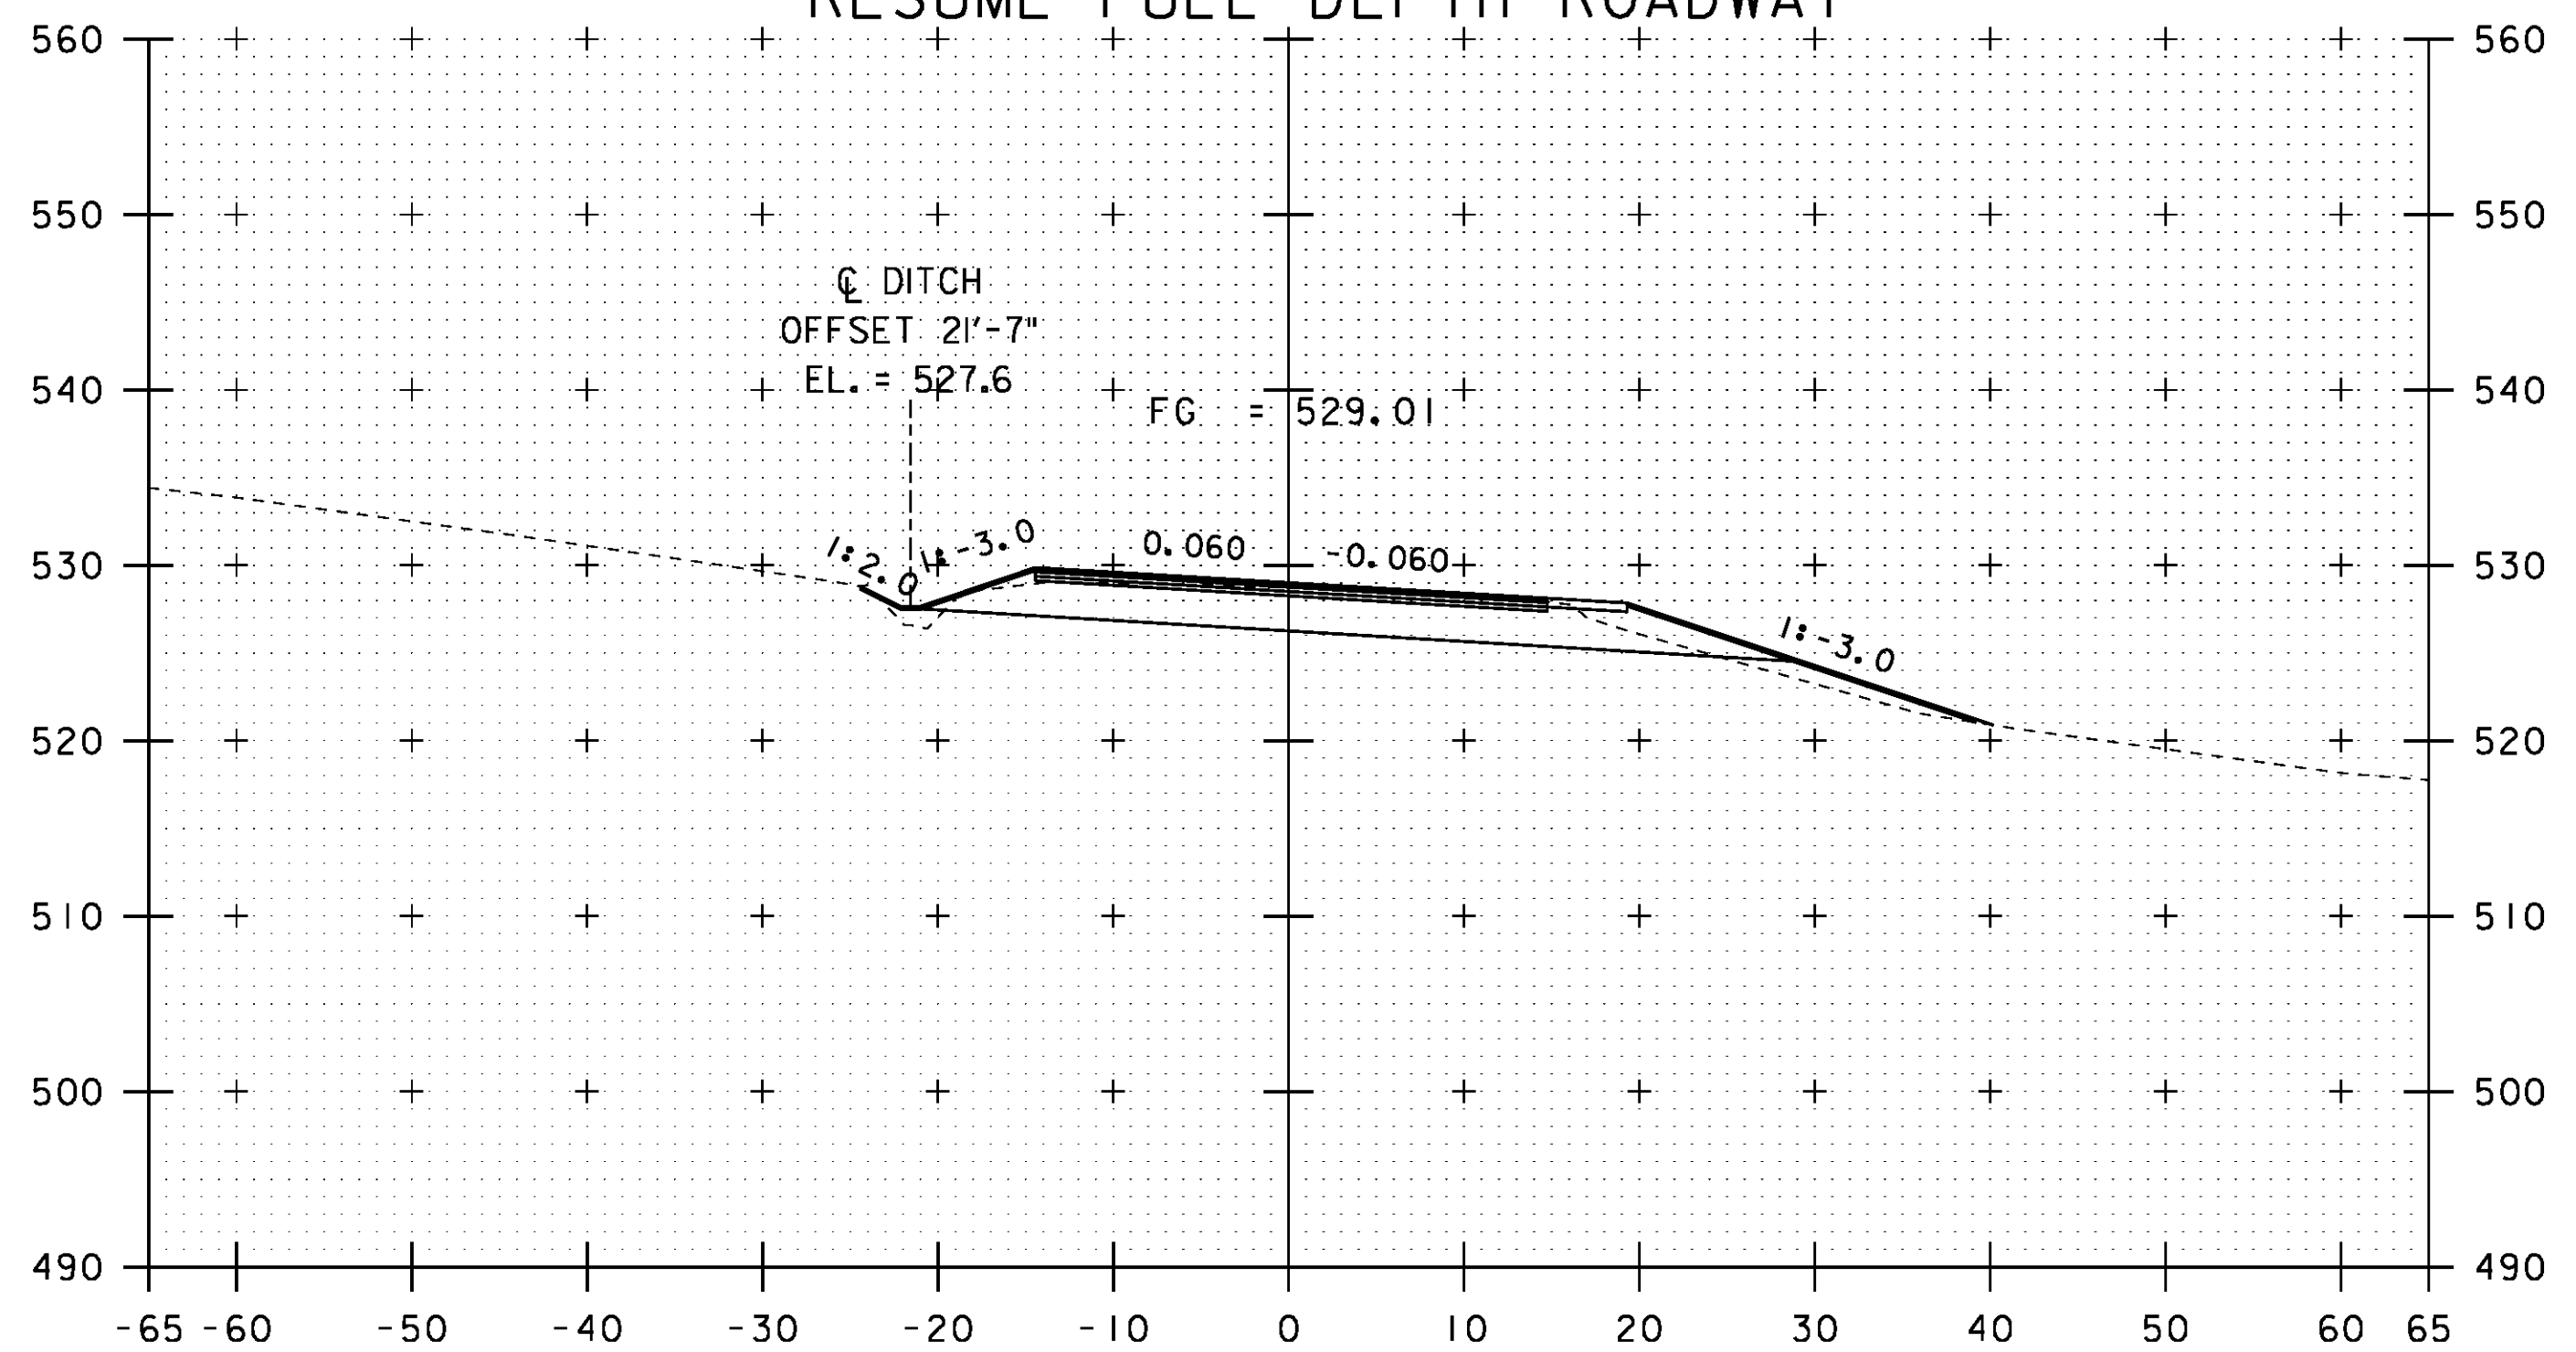


413+50

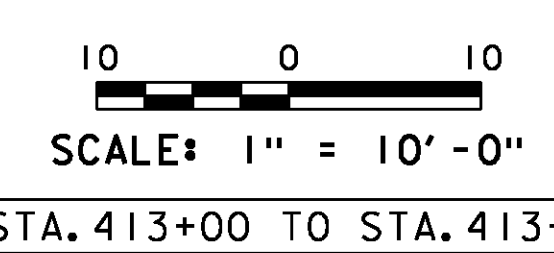


PROJECT NAME:	ROYALTON	FILE NAME:	\BR_28\86e055xsl_28.dgn	PLOT DATE:	08-OCT-2013
PROJECT NUMBER:	BRS 0147 (13)	PROJECT LEADER:	C. CARLSON	DRAWN BY:	STR3
		DESIGNED BY:	D. PETERSON	CHECKED BY:	C. CARLSON
		BRIDGE 28 VT 14 CROSS SECTIONS (2)		SHEET	138 OF 186

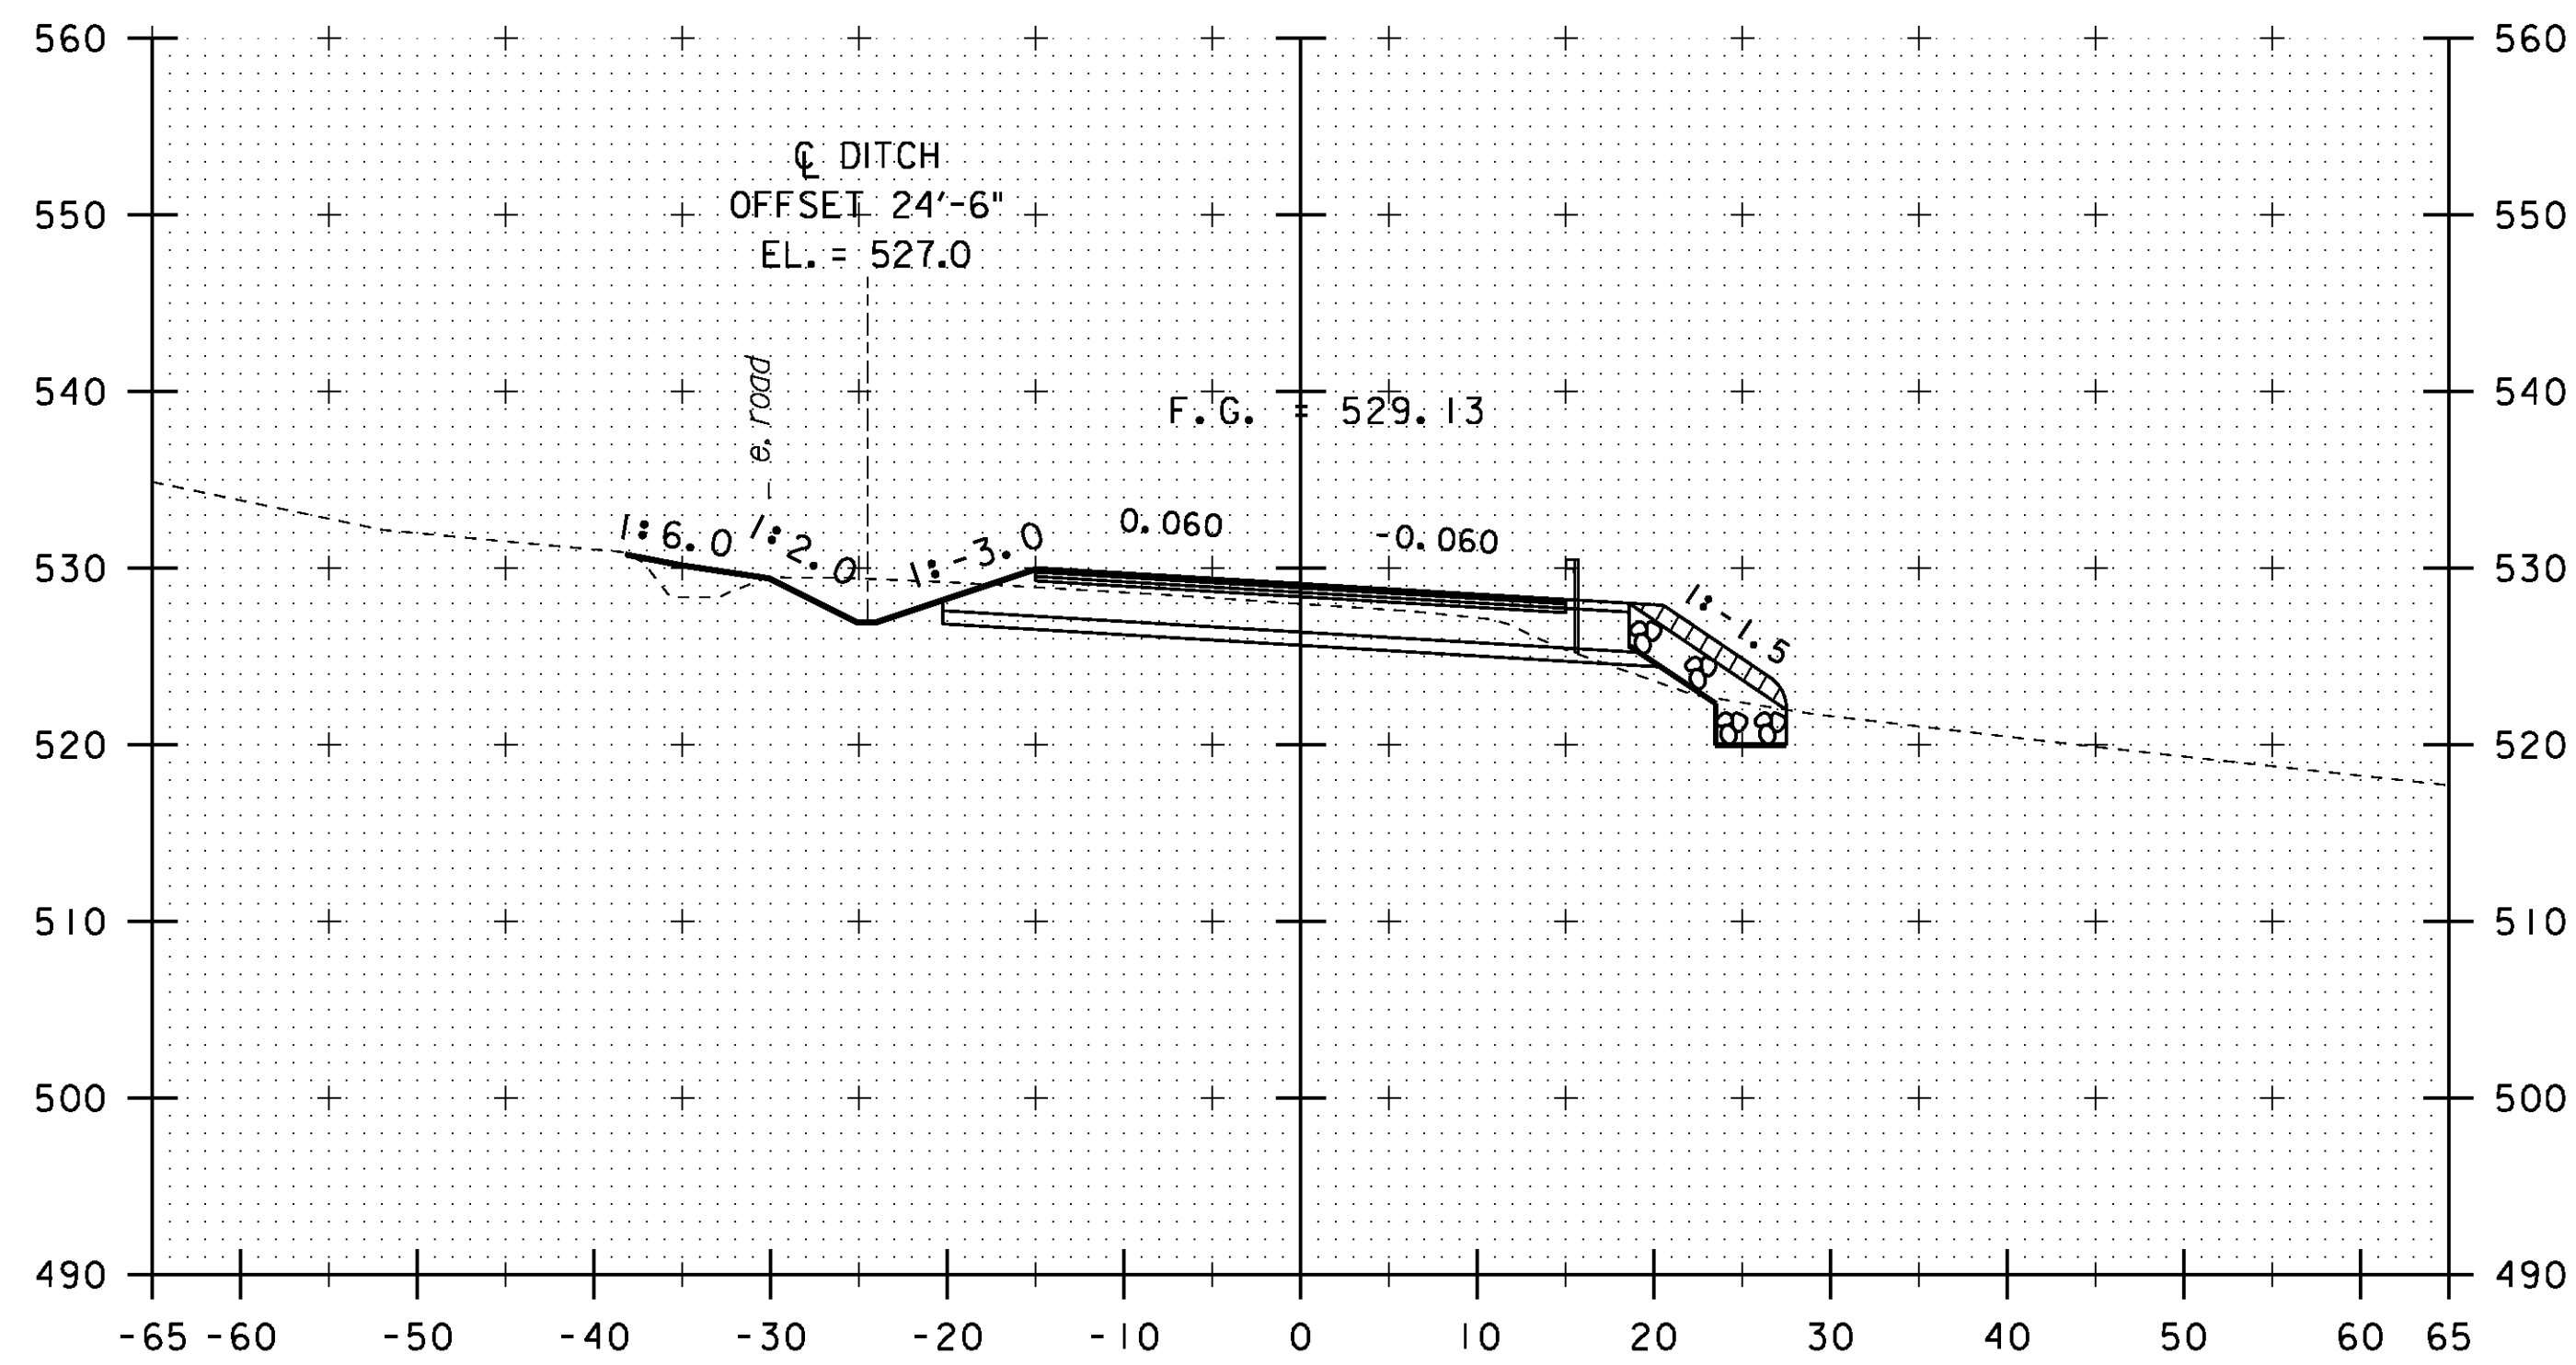


414+25

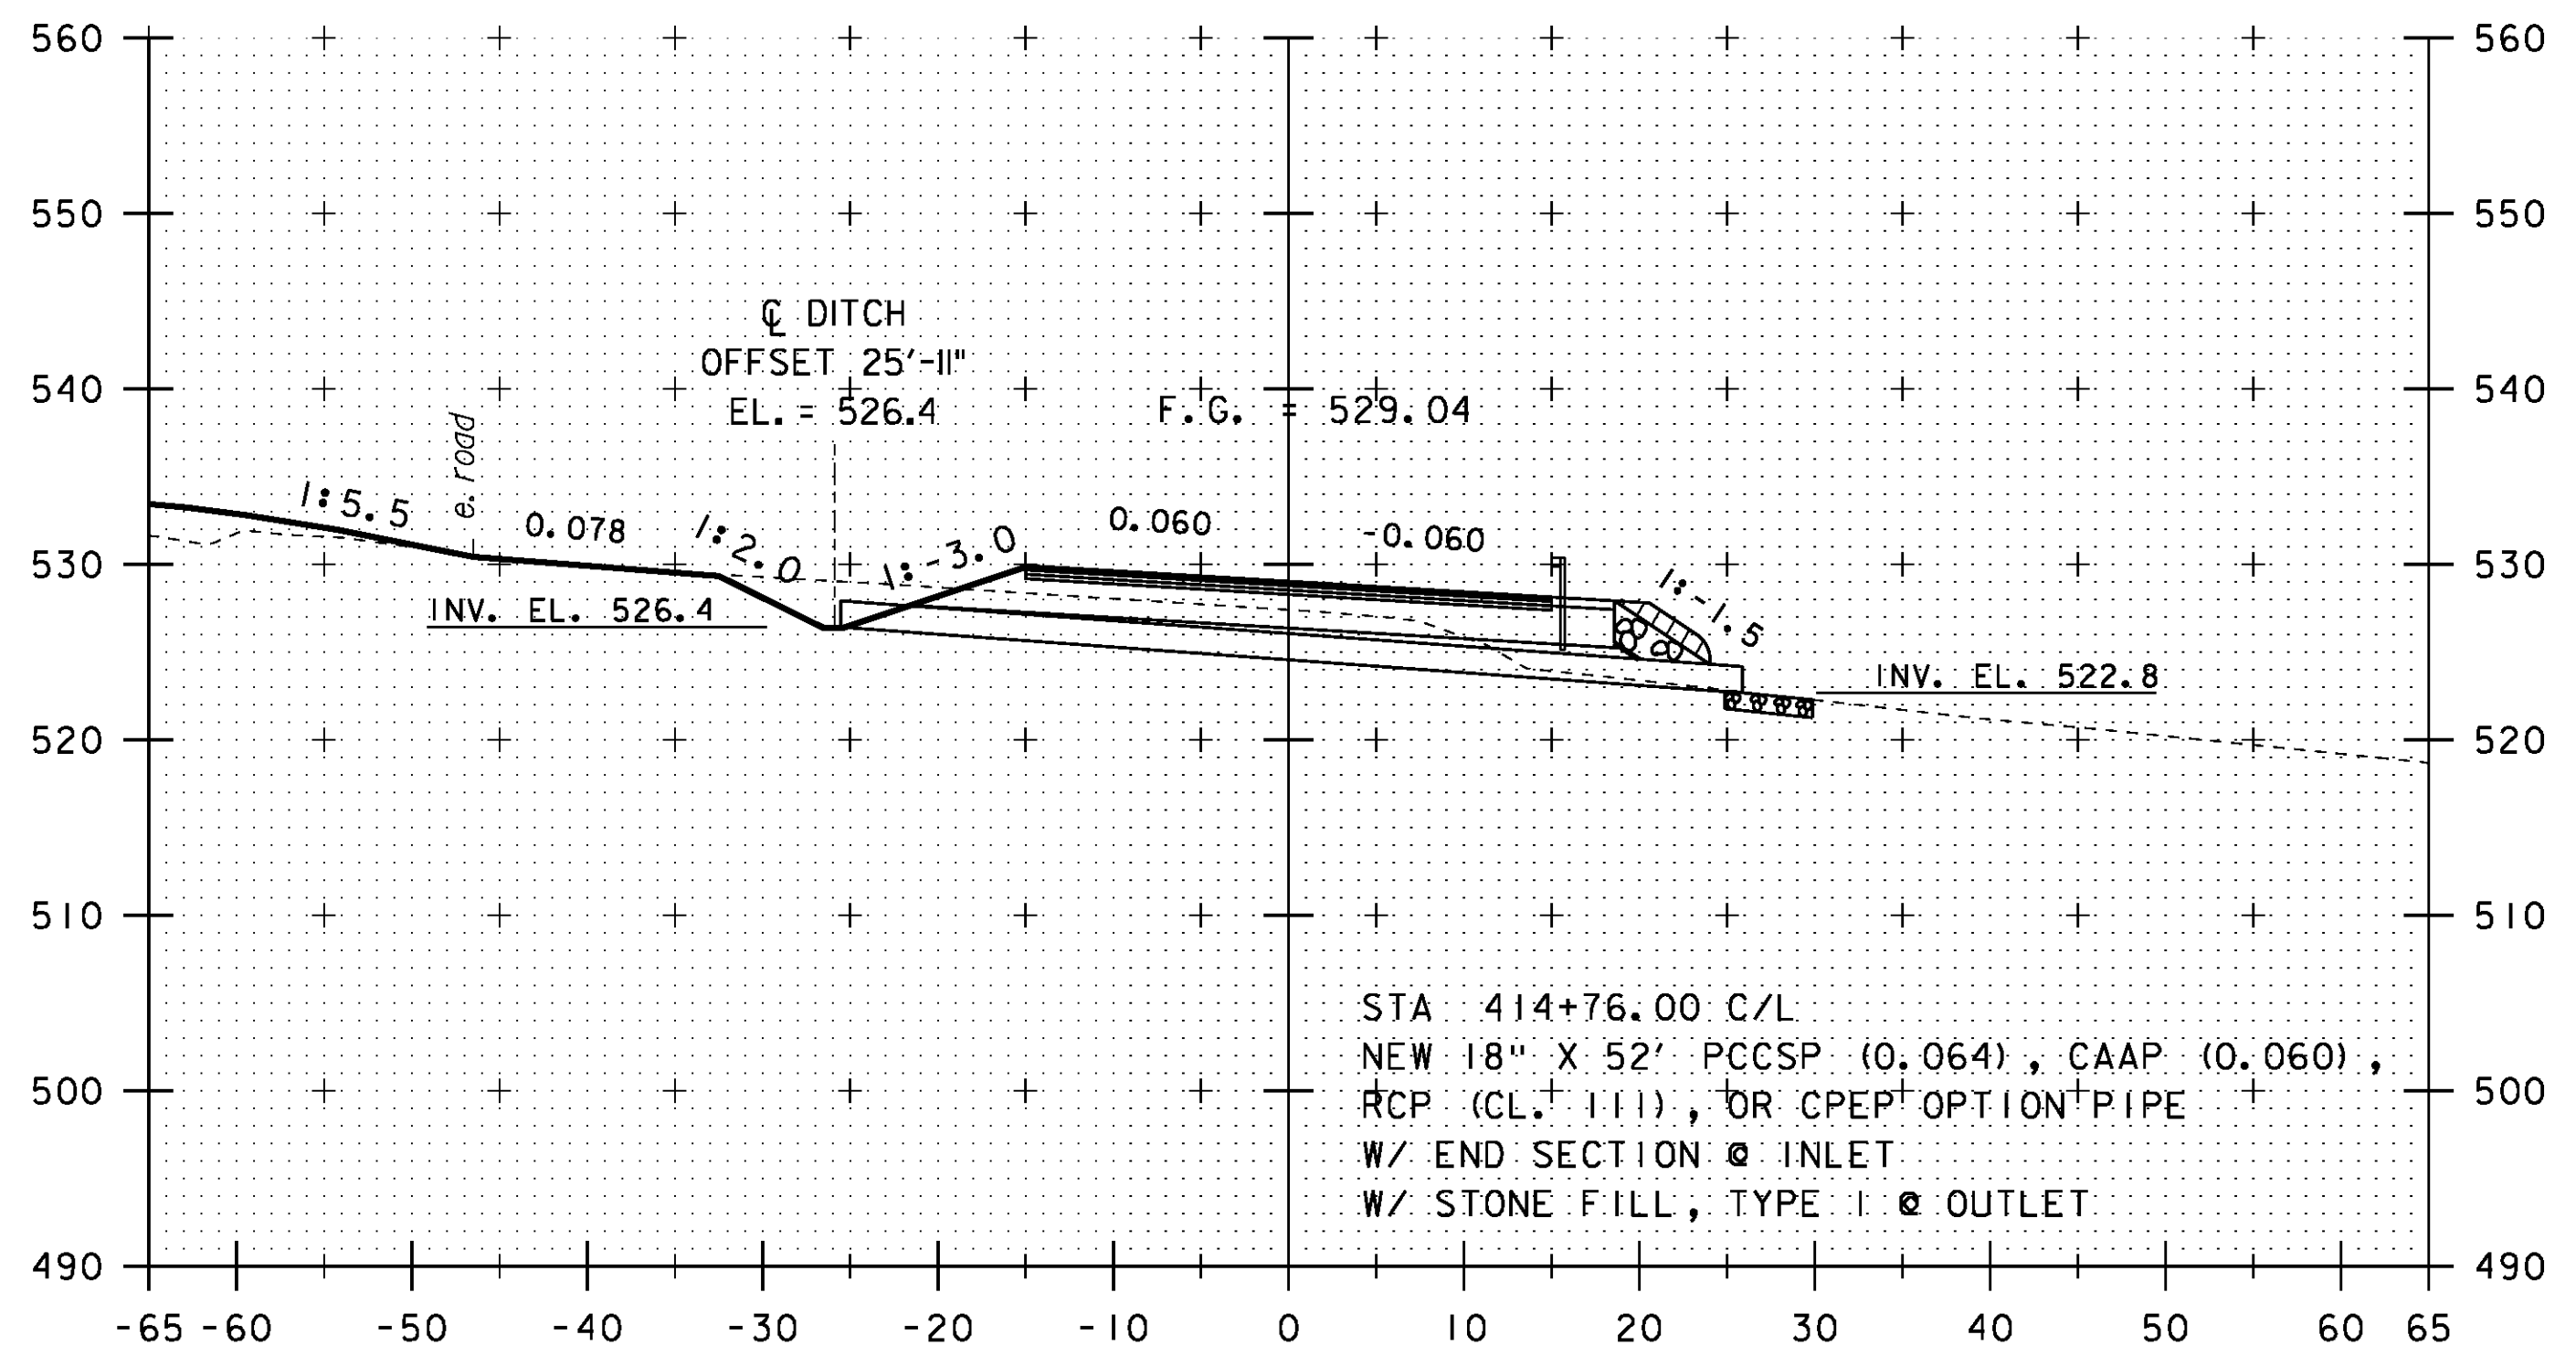


414+75

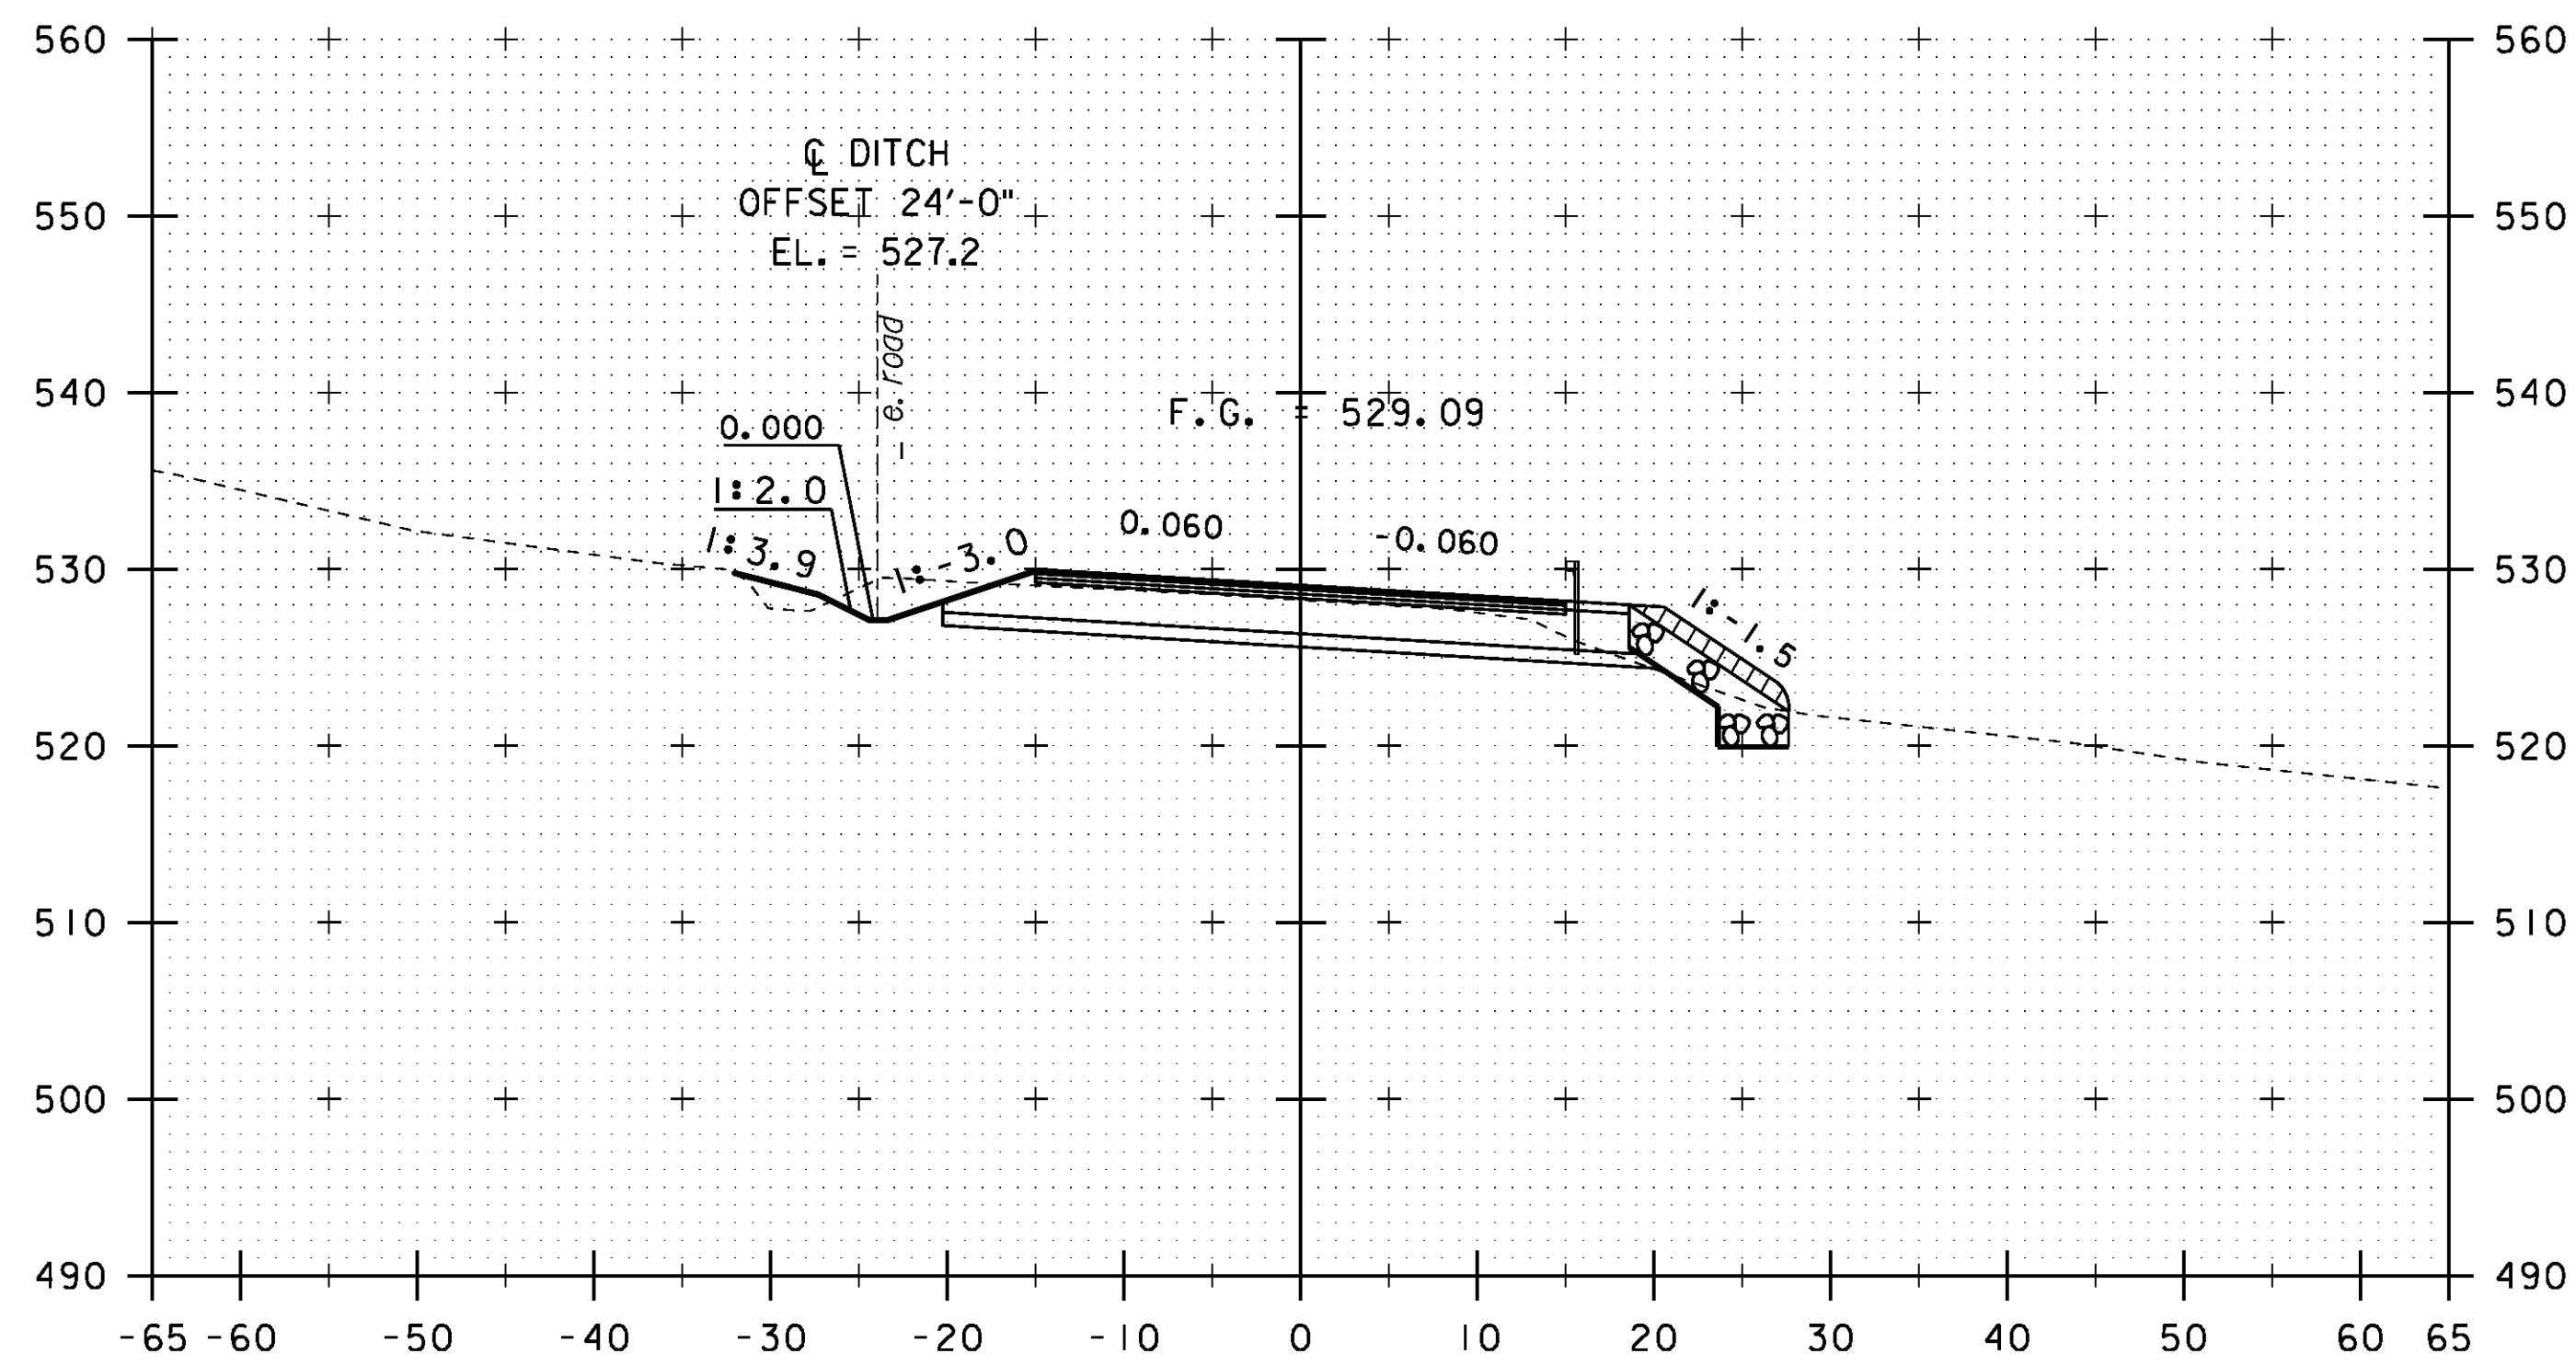


414+00

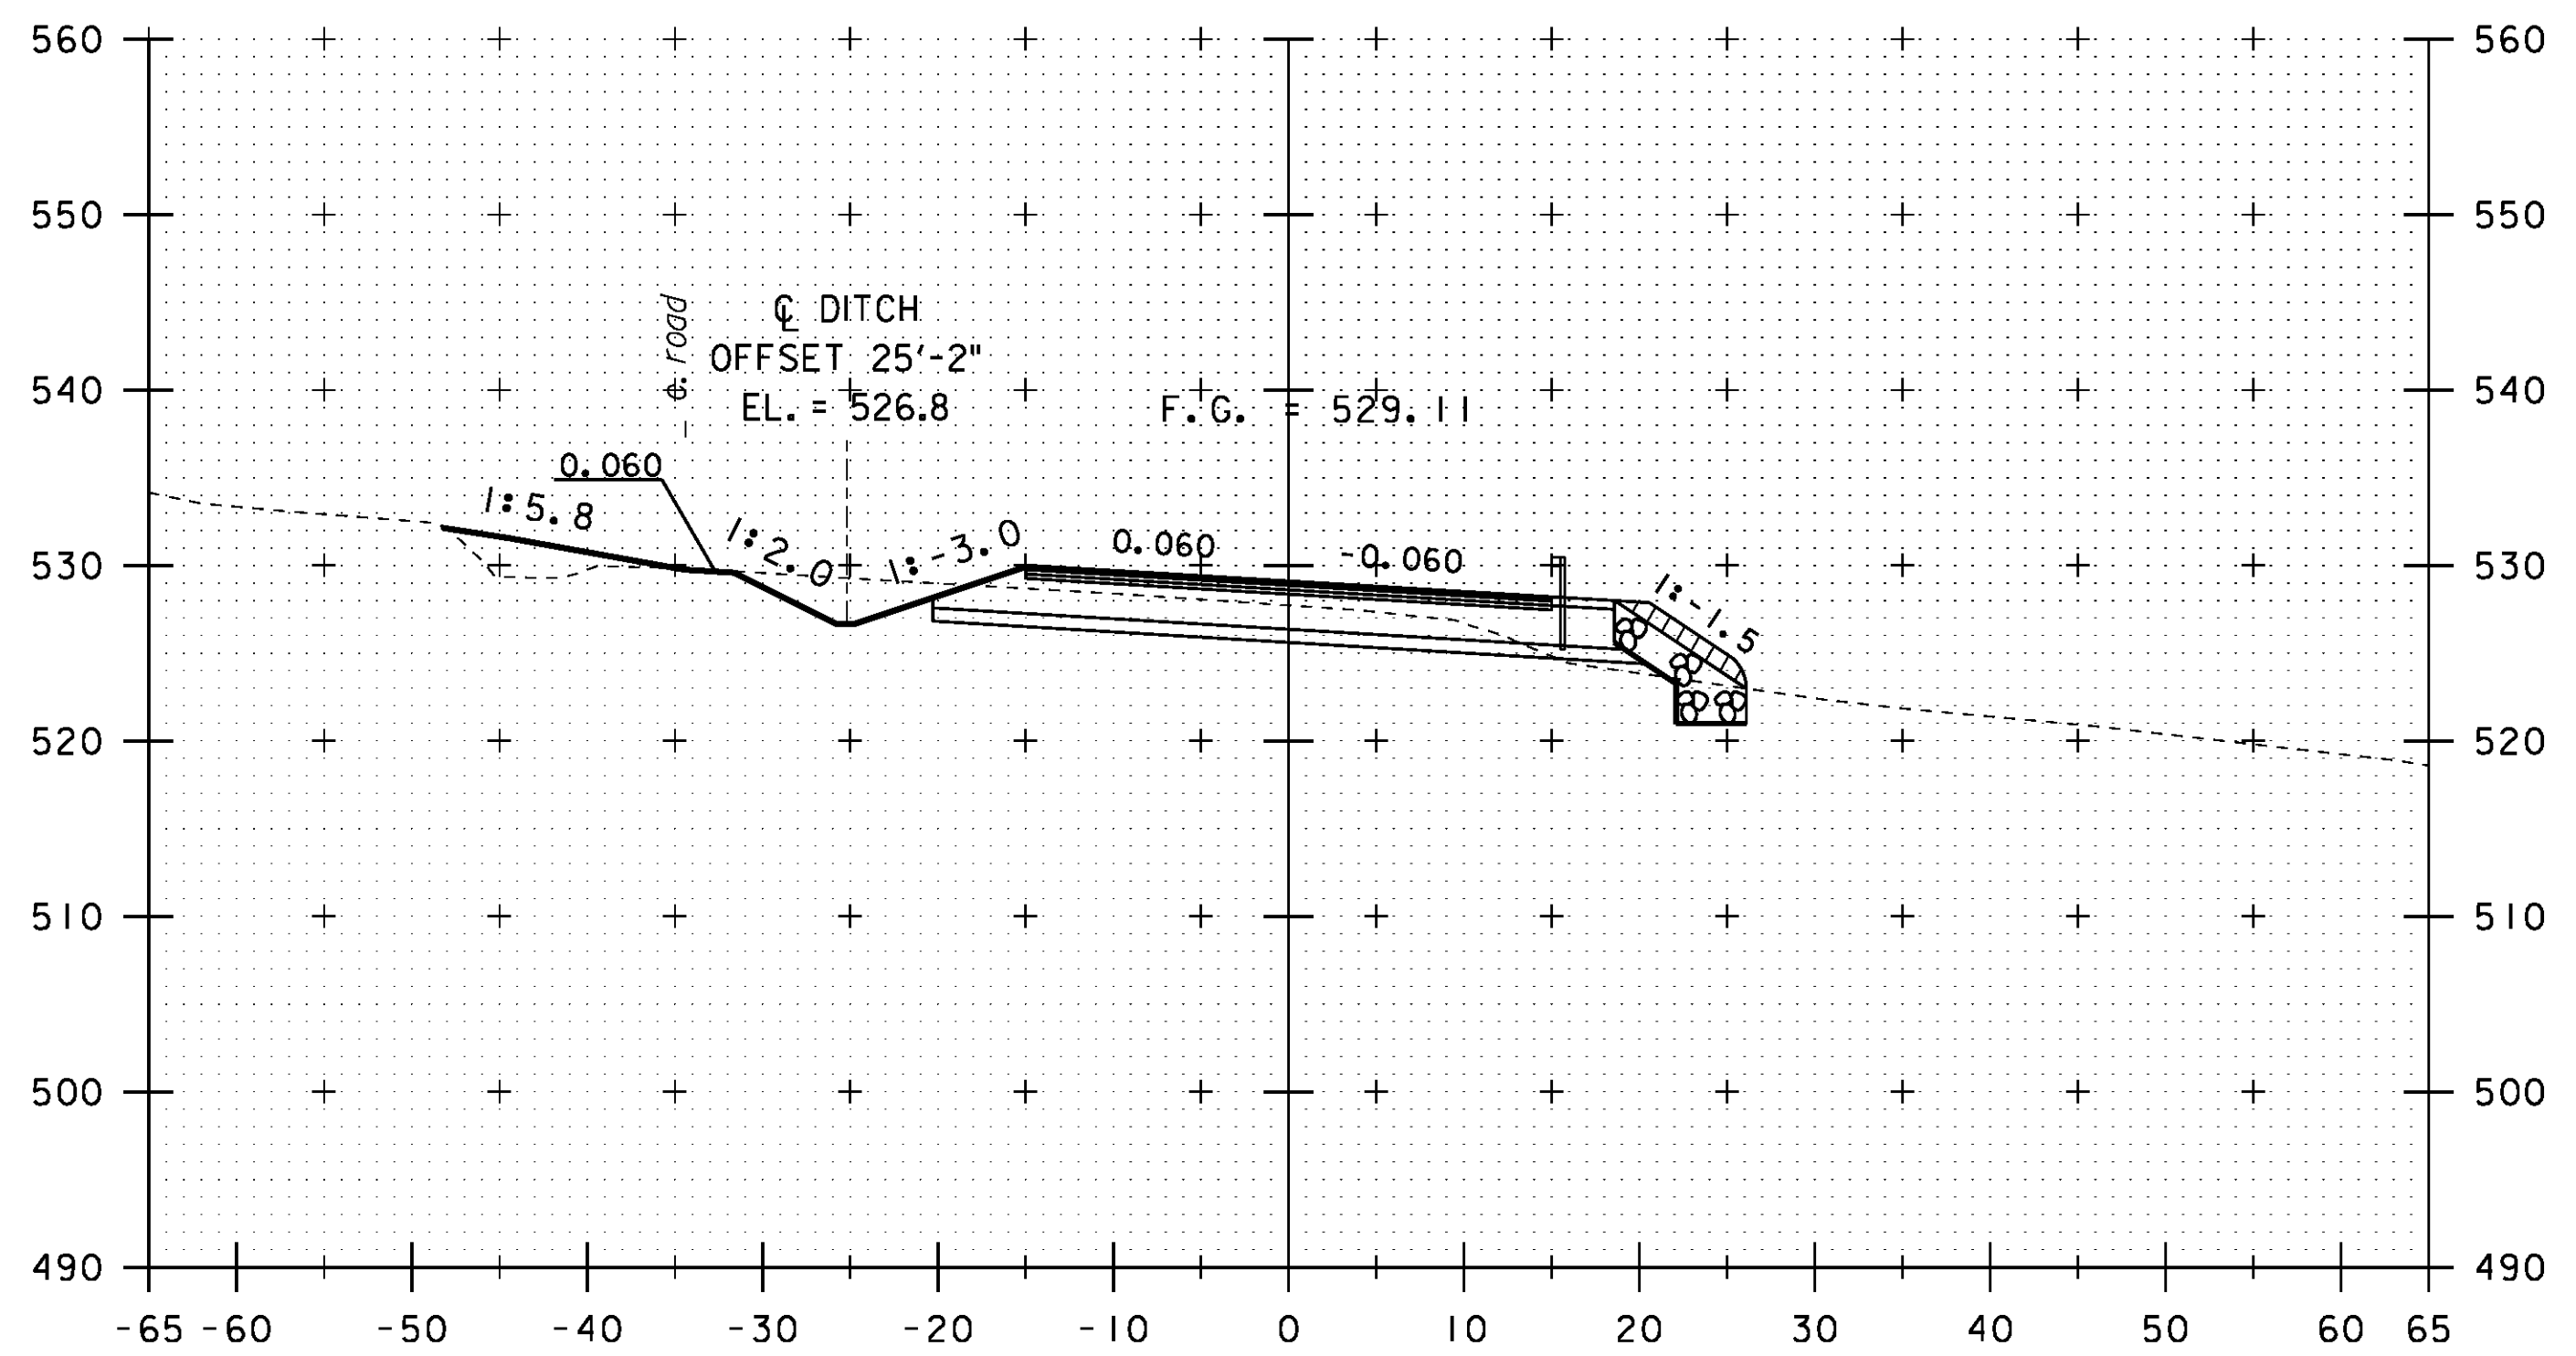


414+50

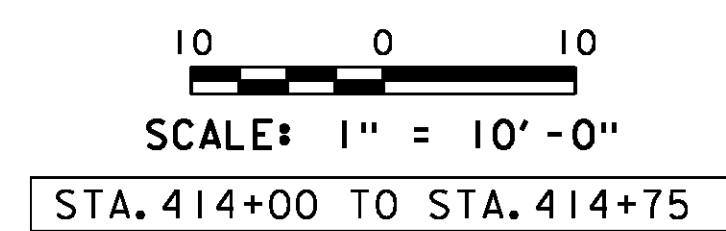


PROJECT NAME: ROYALTON	PROJECT NUMBER: BRS 0147 (13)
FILE NAME: \BR_28\86e055xsl_28.dgn	PLOT DATE: 08-OCT-2013
PROJECT LEADER: C. CARLSON	DRAWN BY: STR3
DESIGNED BY: D. PETERSON	CHECKED BY: C. CARLSON
BRIDGE 28 VT 14 CROSS SECTIONS (3)	SHEET 139 OF 186

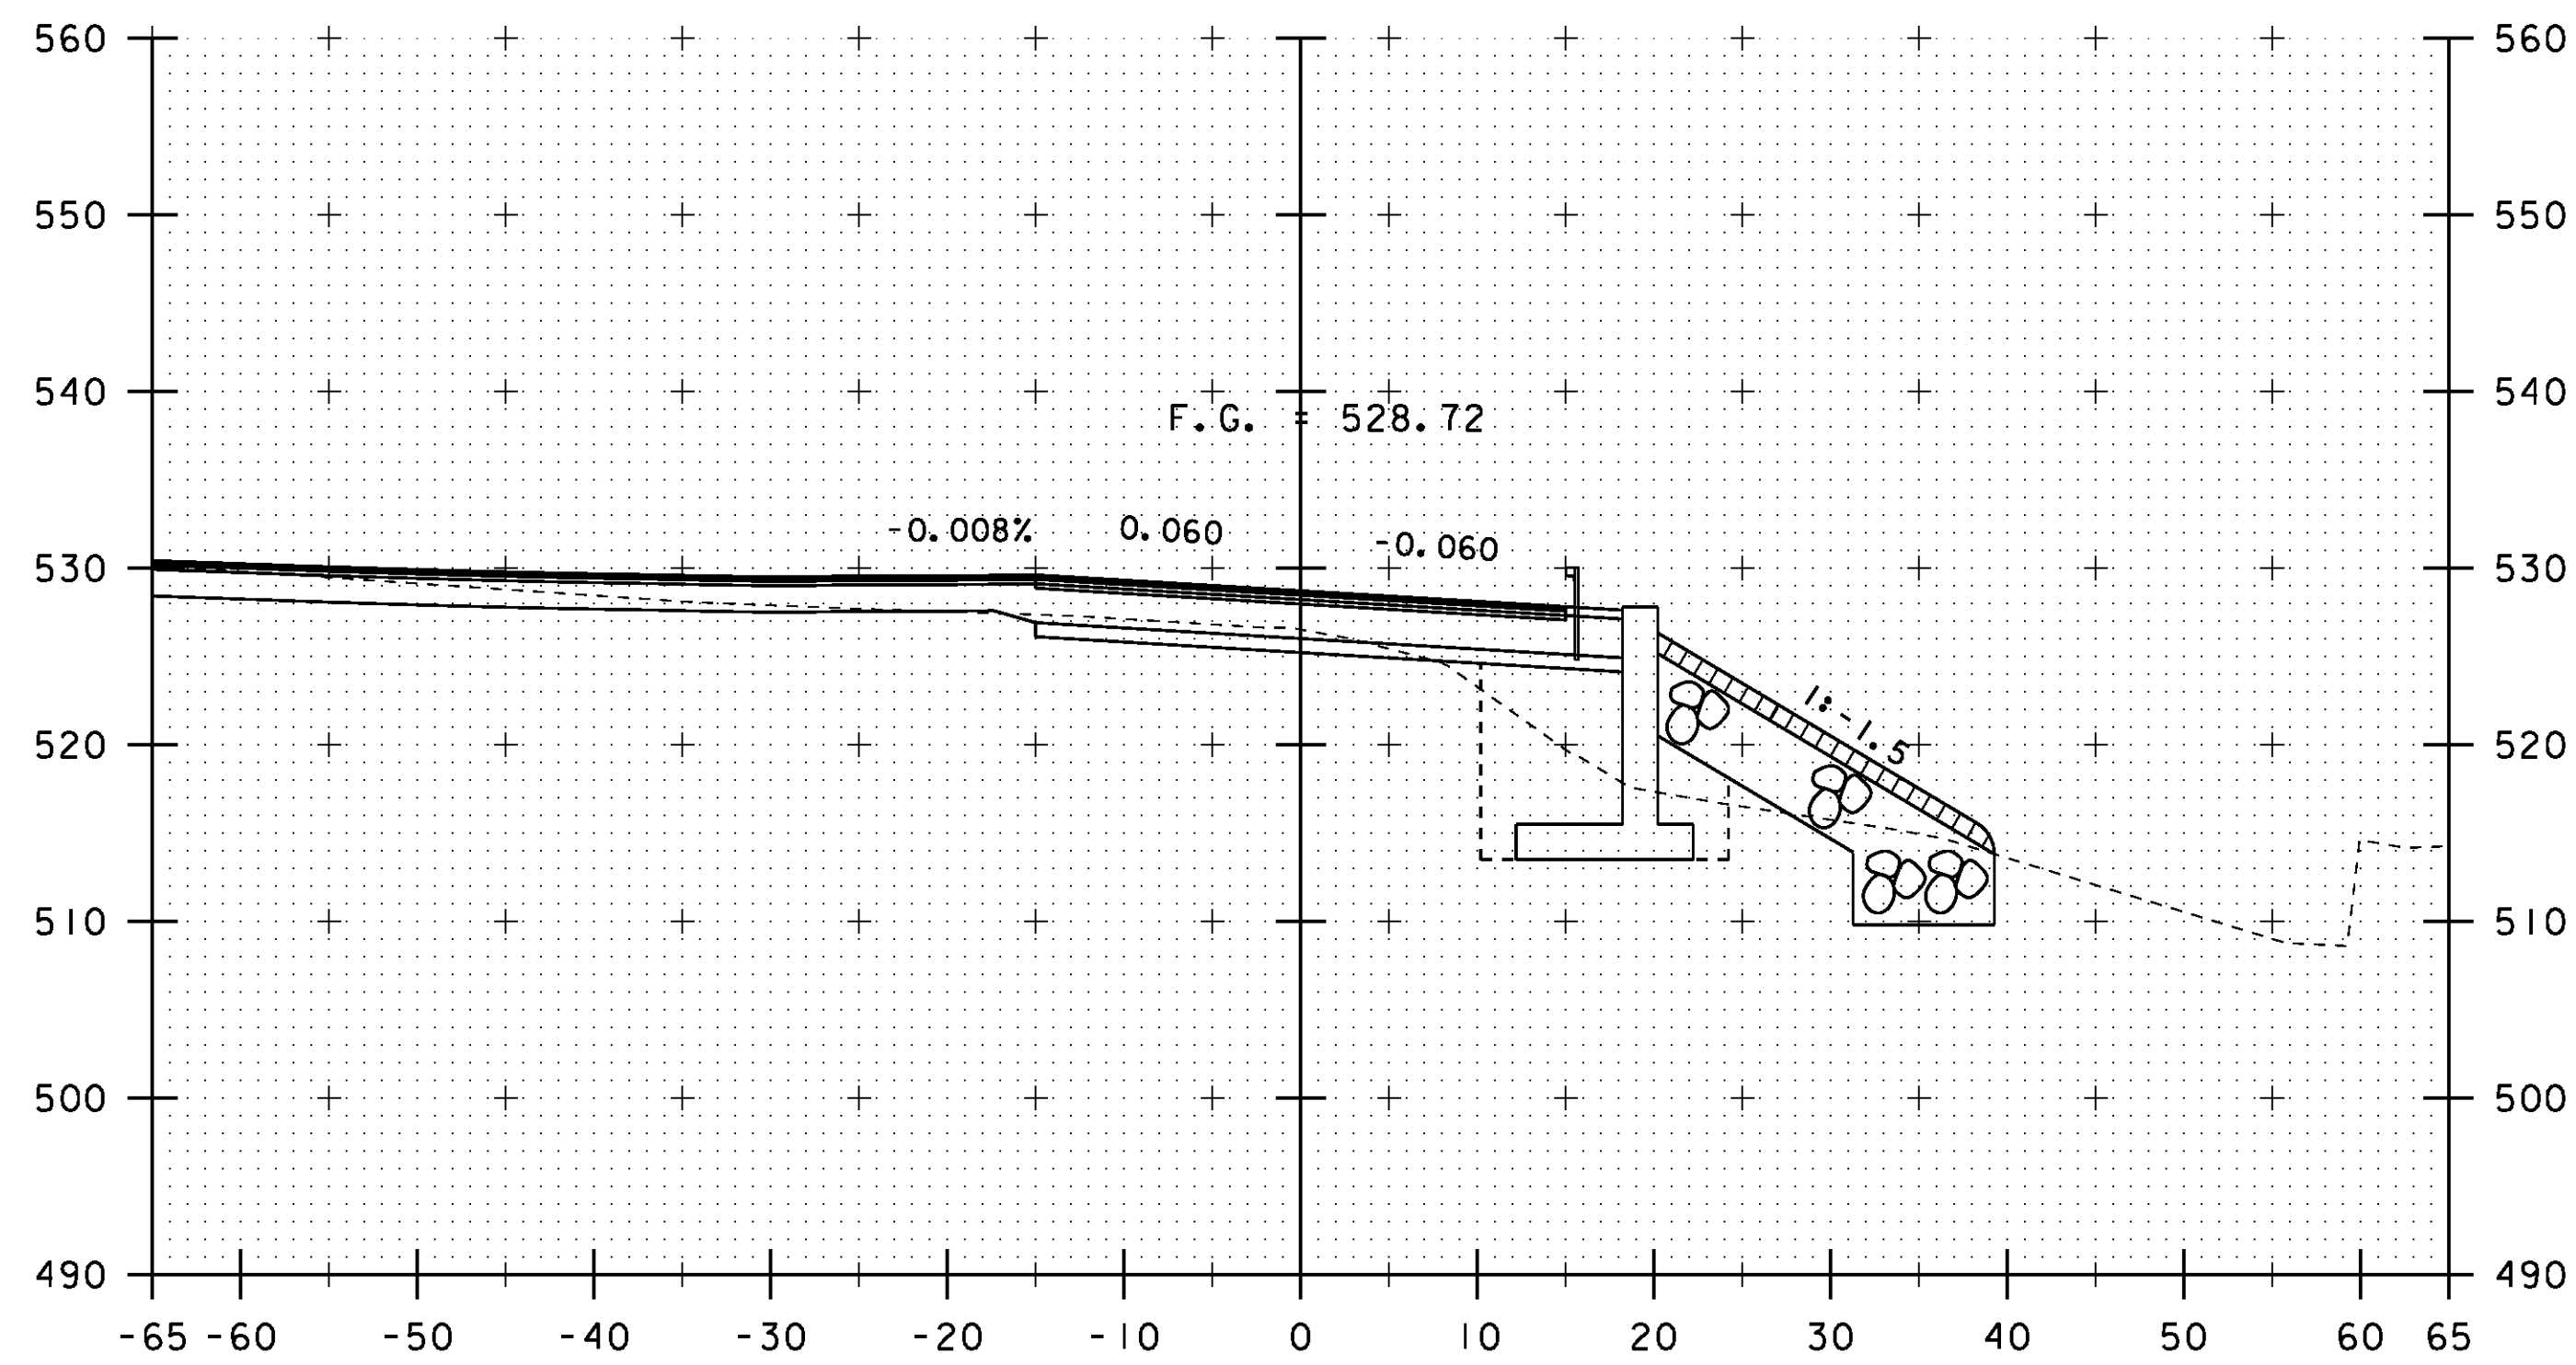


415+25

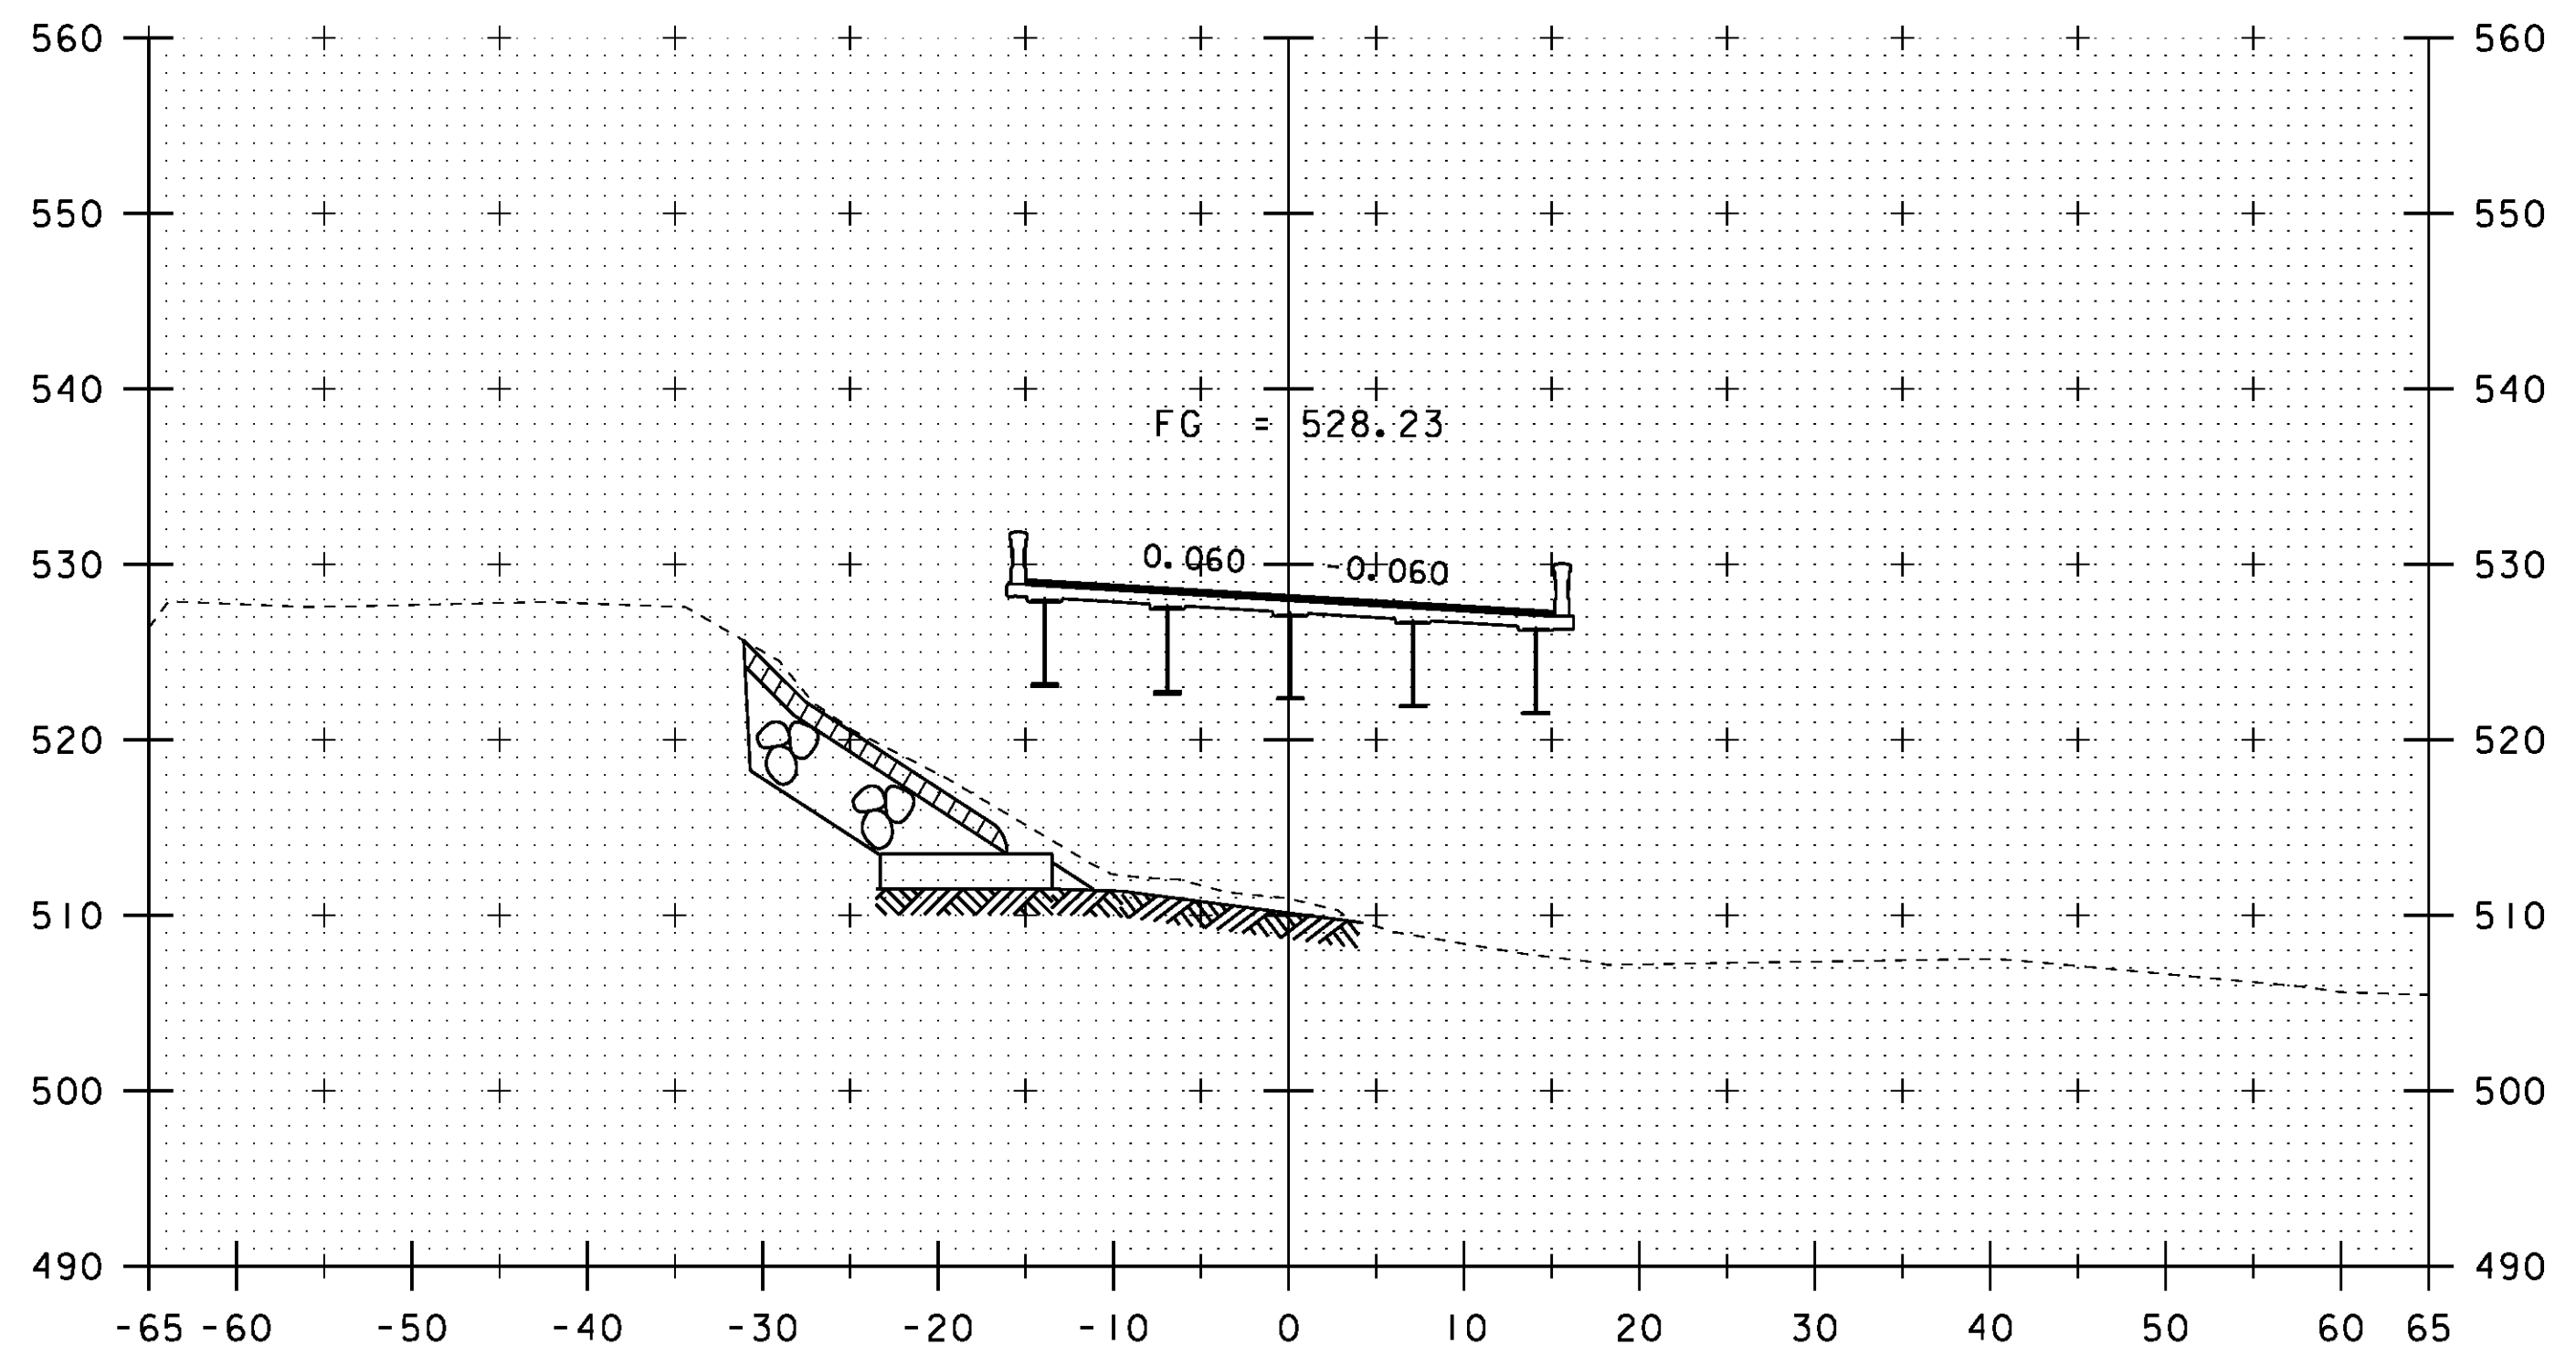

415+75  
 STA 415+61.37  
 END ROADWAY  
 BEGIN BRIDGE

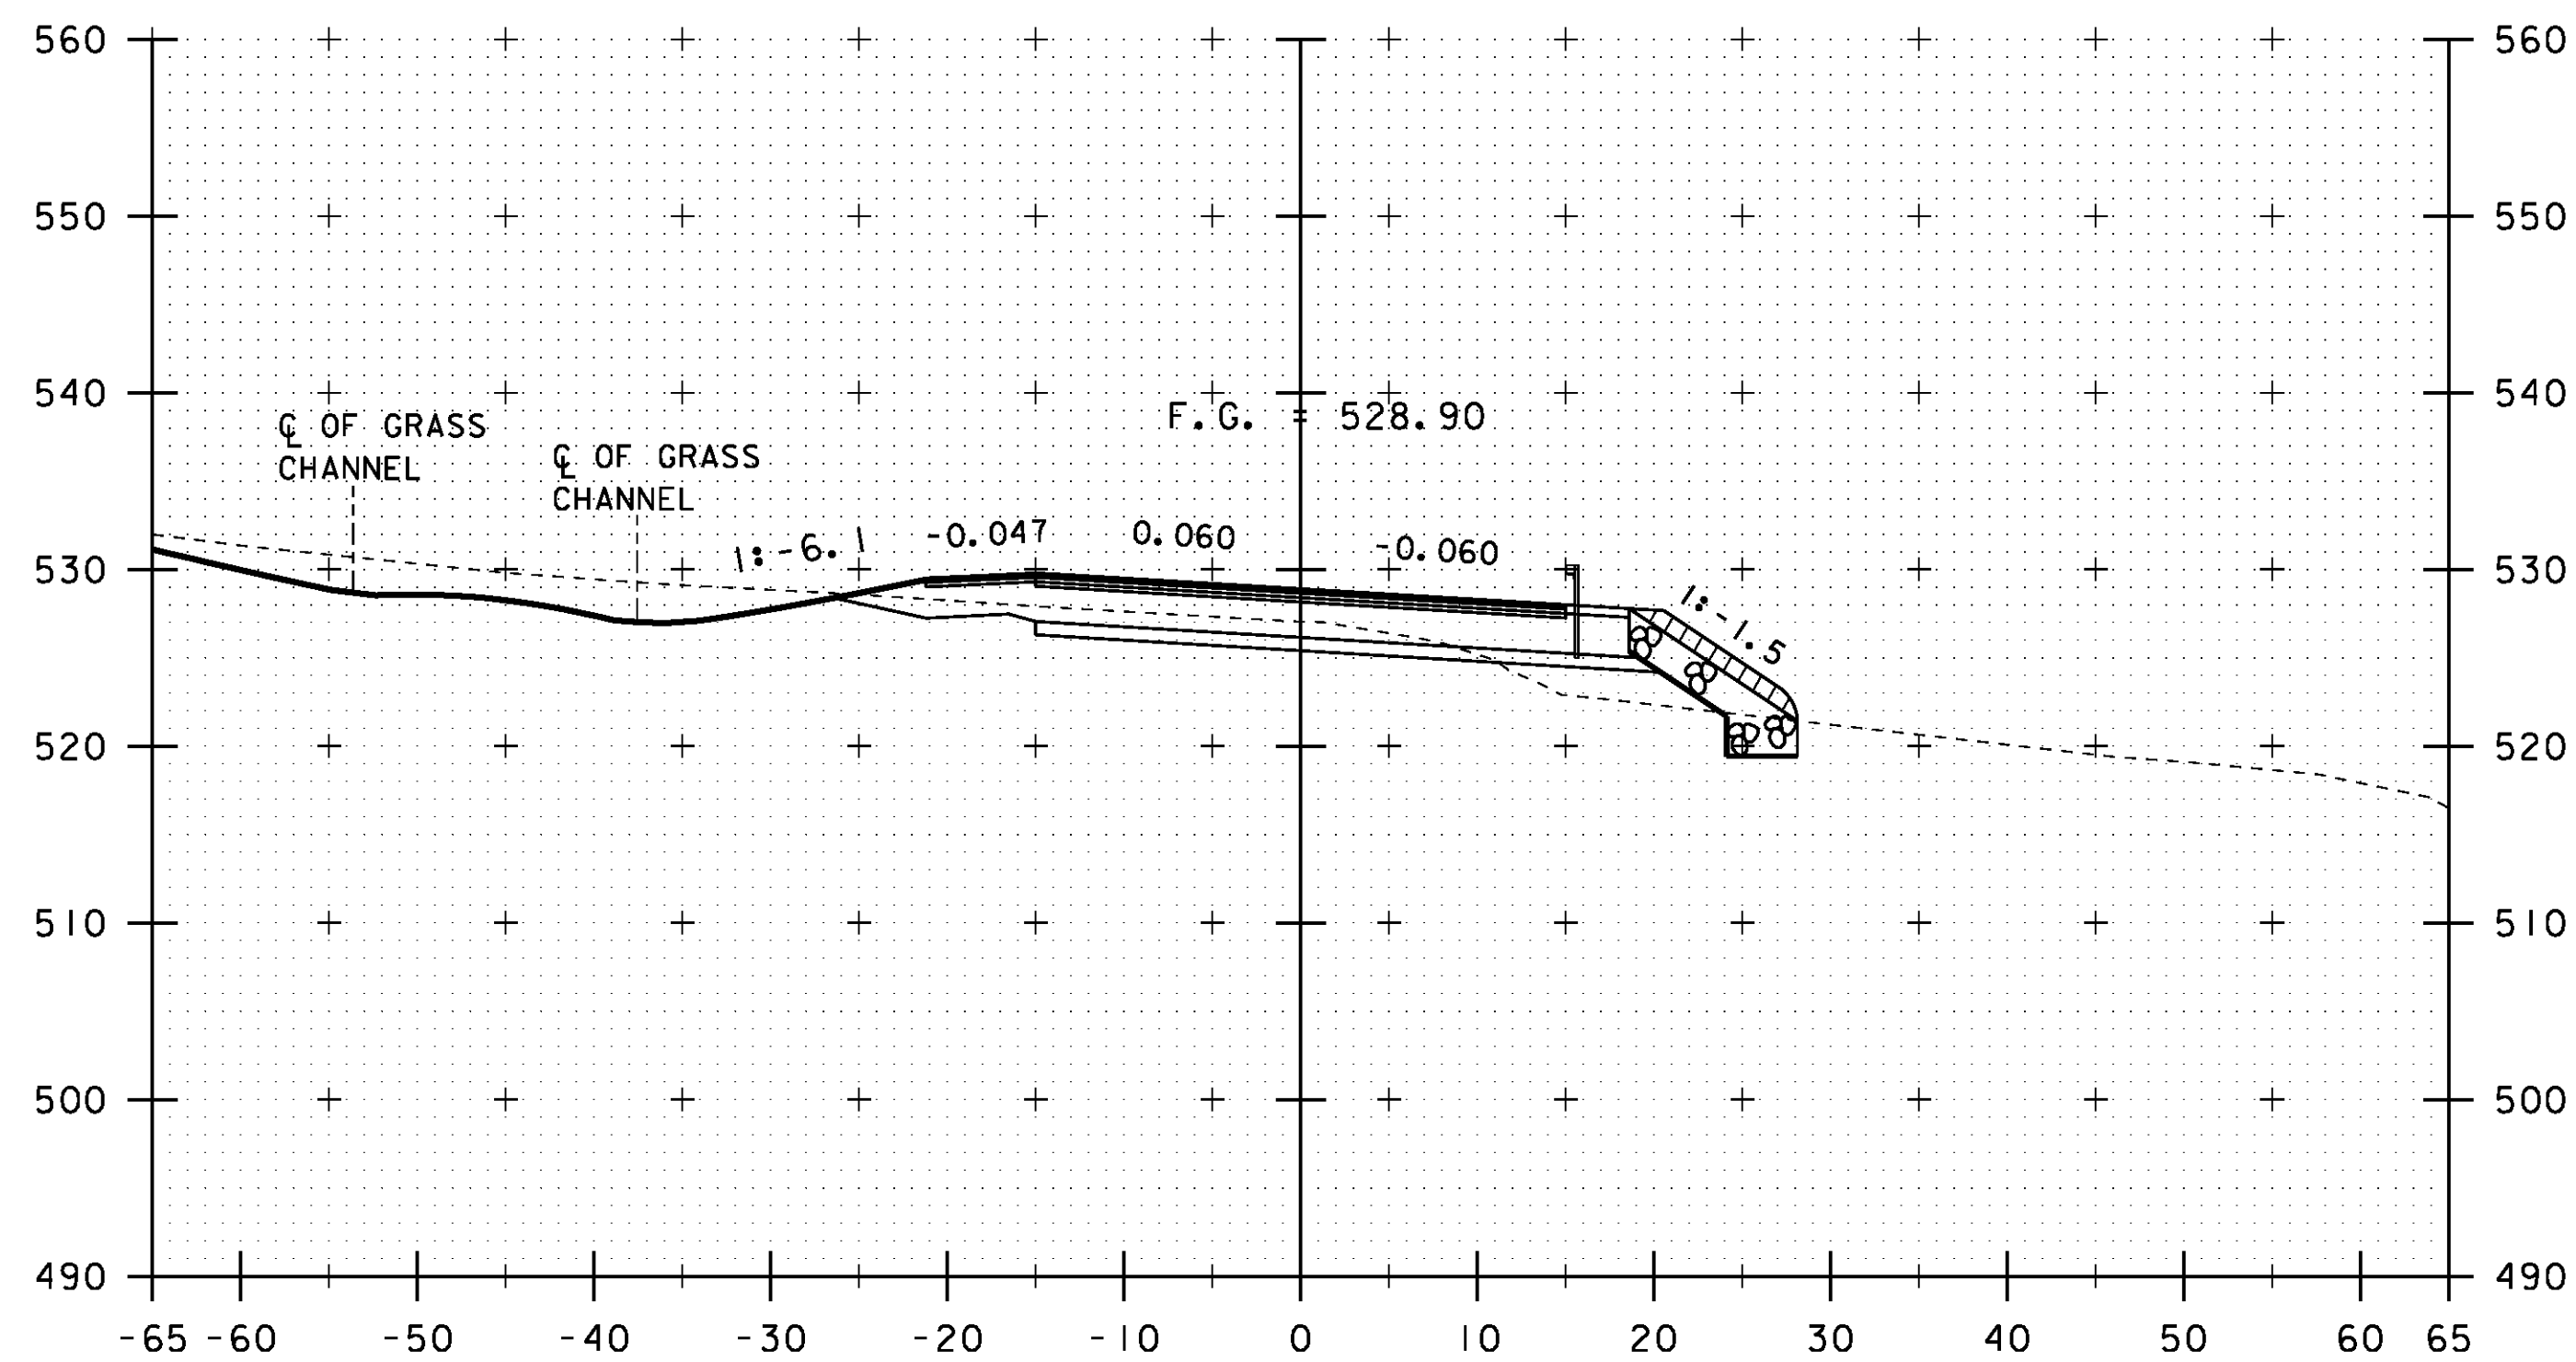

415+00

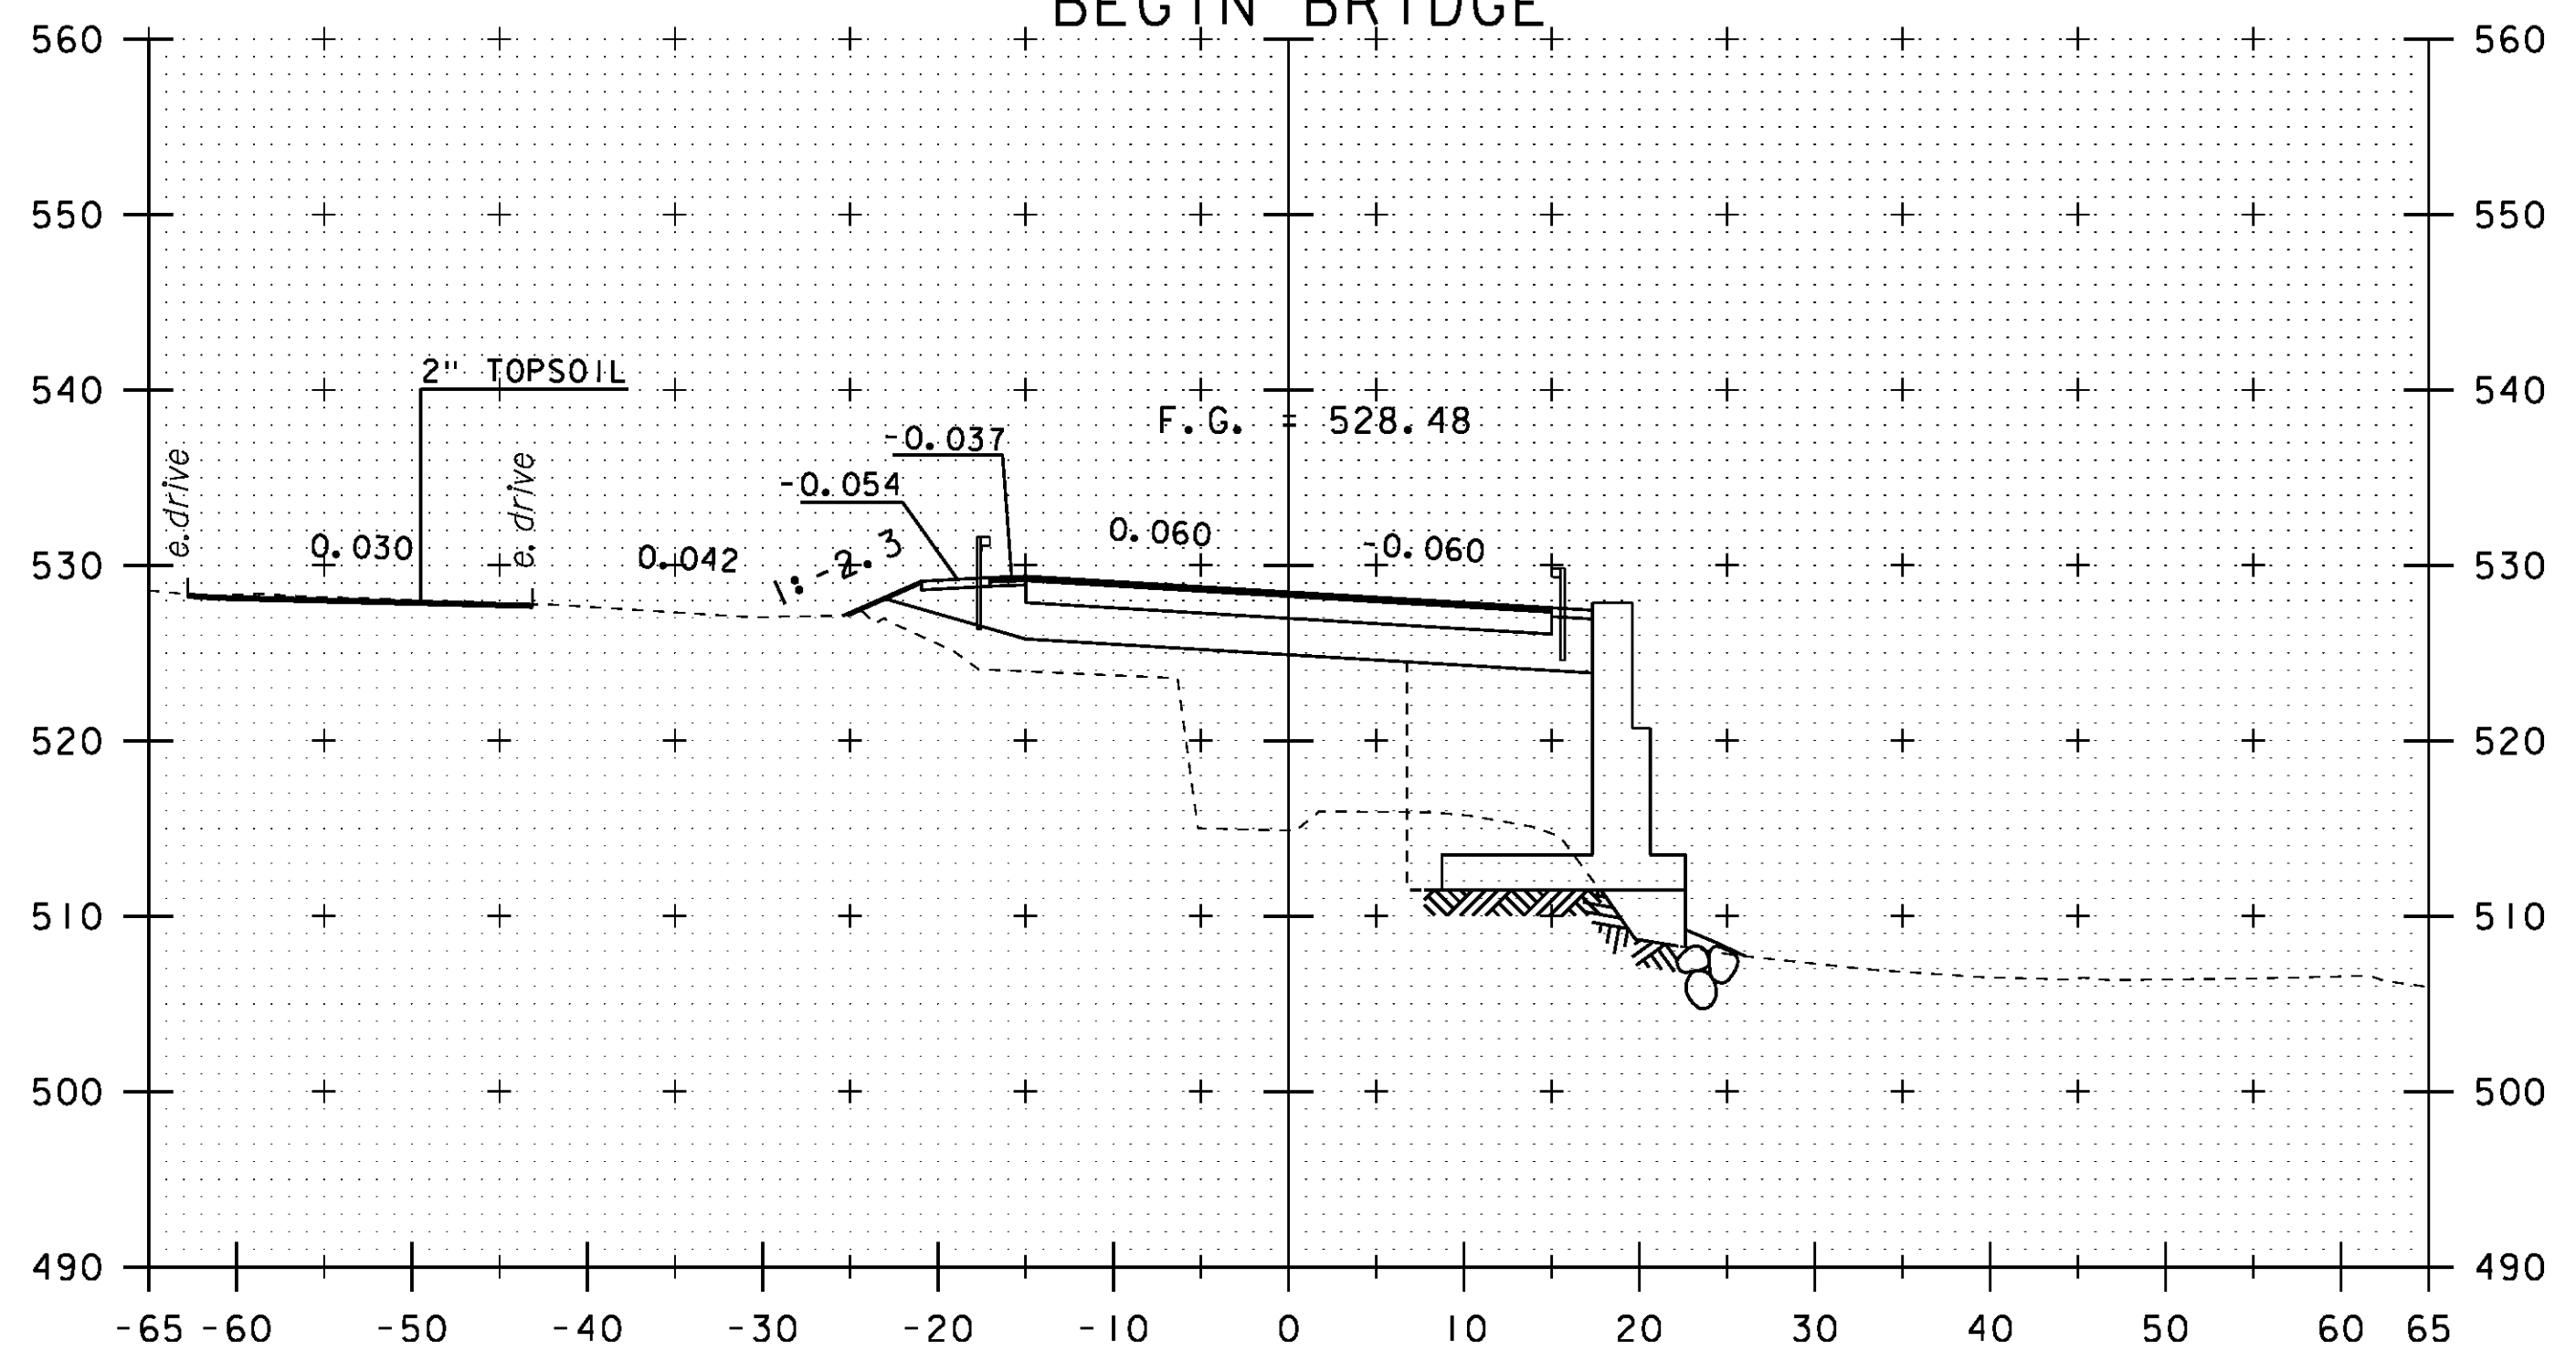

415+50




SCALE: 1" = 10'-0"

STA. 415+00 TO STA. 415+75


PROJECT NAME: ROYALTON  
 PROJECT NUMBER: BRS 0147 (13)

FILE NAME: \BR_28\86e055xsl_28.dgn  
 PROJECT LEADER: C. CARLSON  
 DESIGNED BY: D. PETERSON  
 BRIDGE 28 VT 14 CROSS SECTIONS (4)


PLOT DATE: 08-OCT-2013  
 DRAWN BY: STR3  
 CHECKED BY: C. CARLSON  
 SHEET 140 OF 186

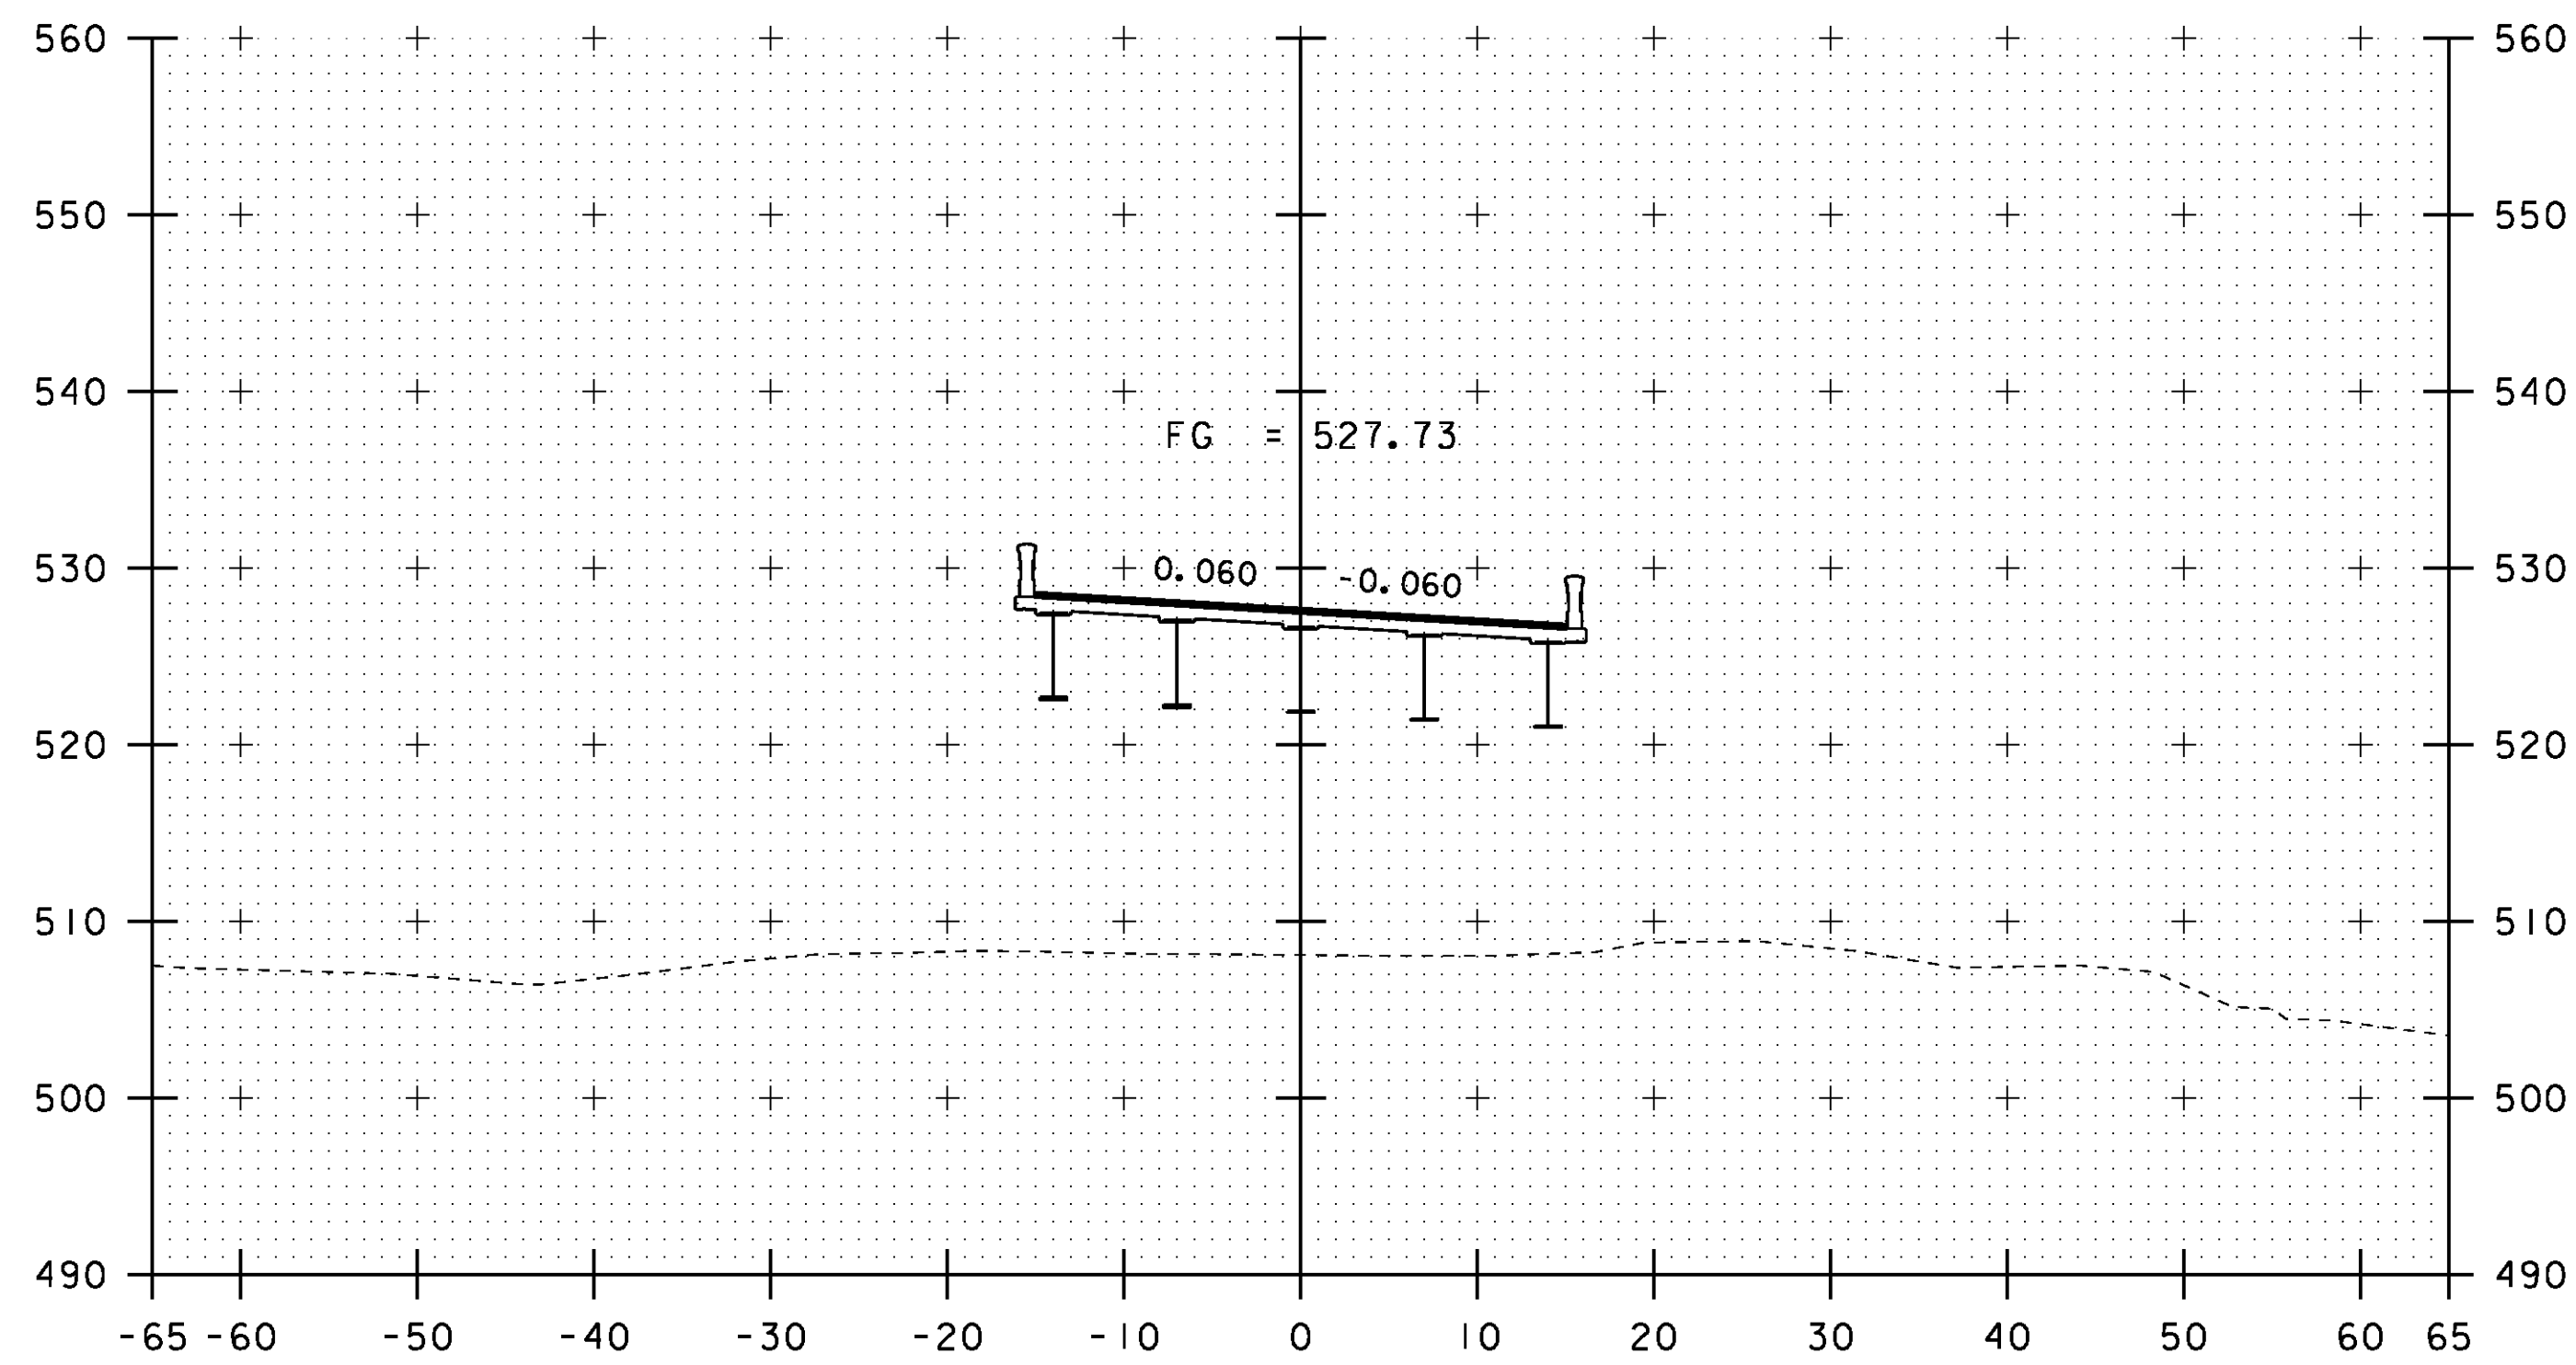


416+25

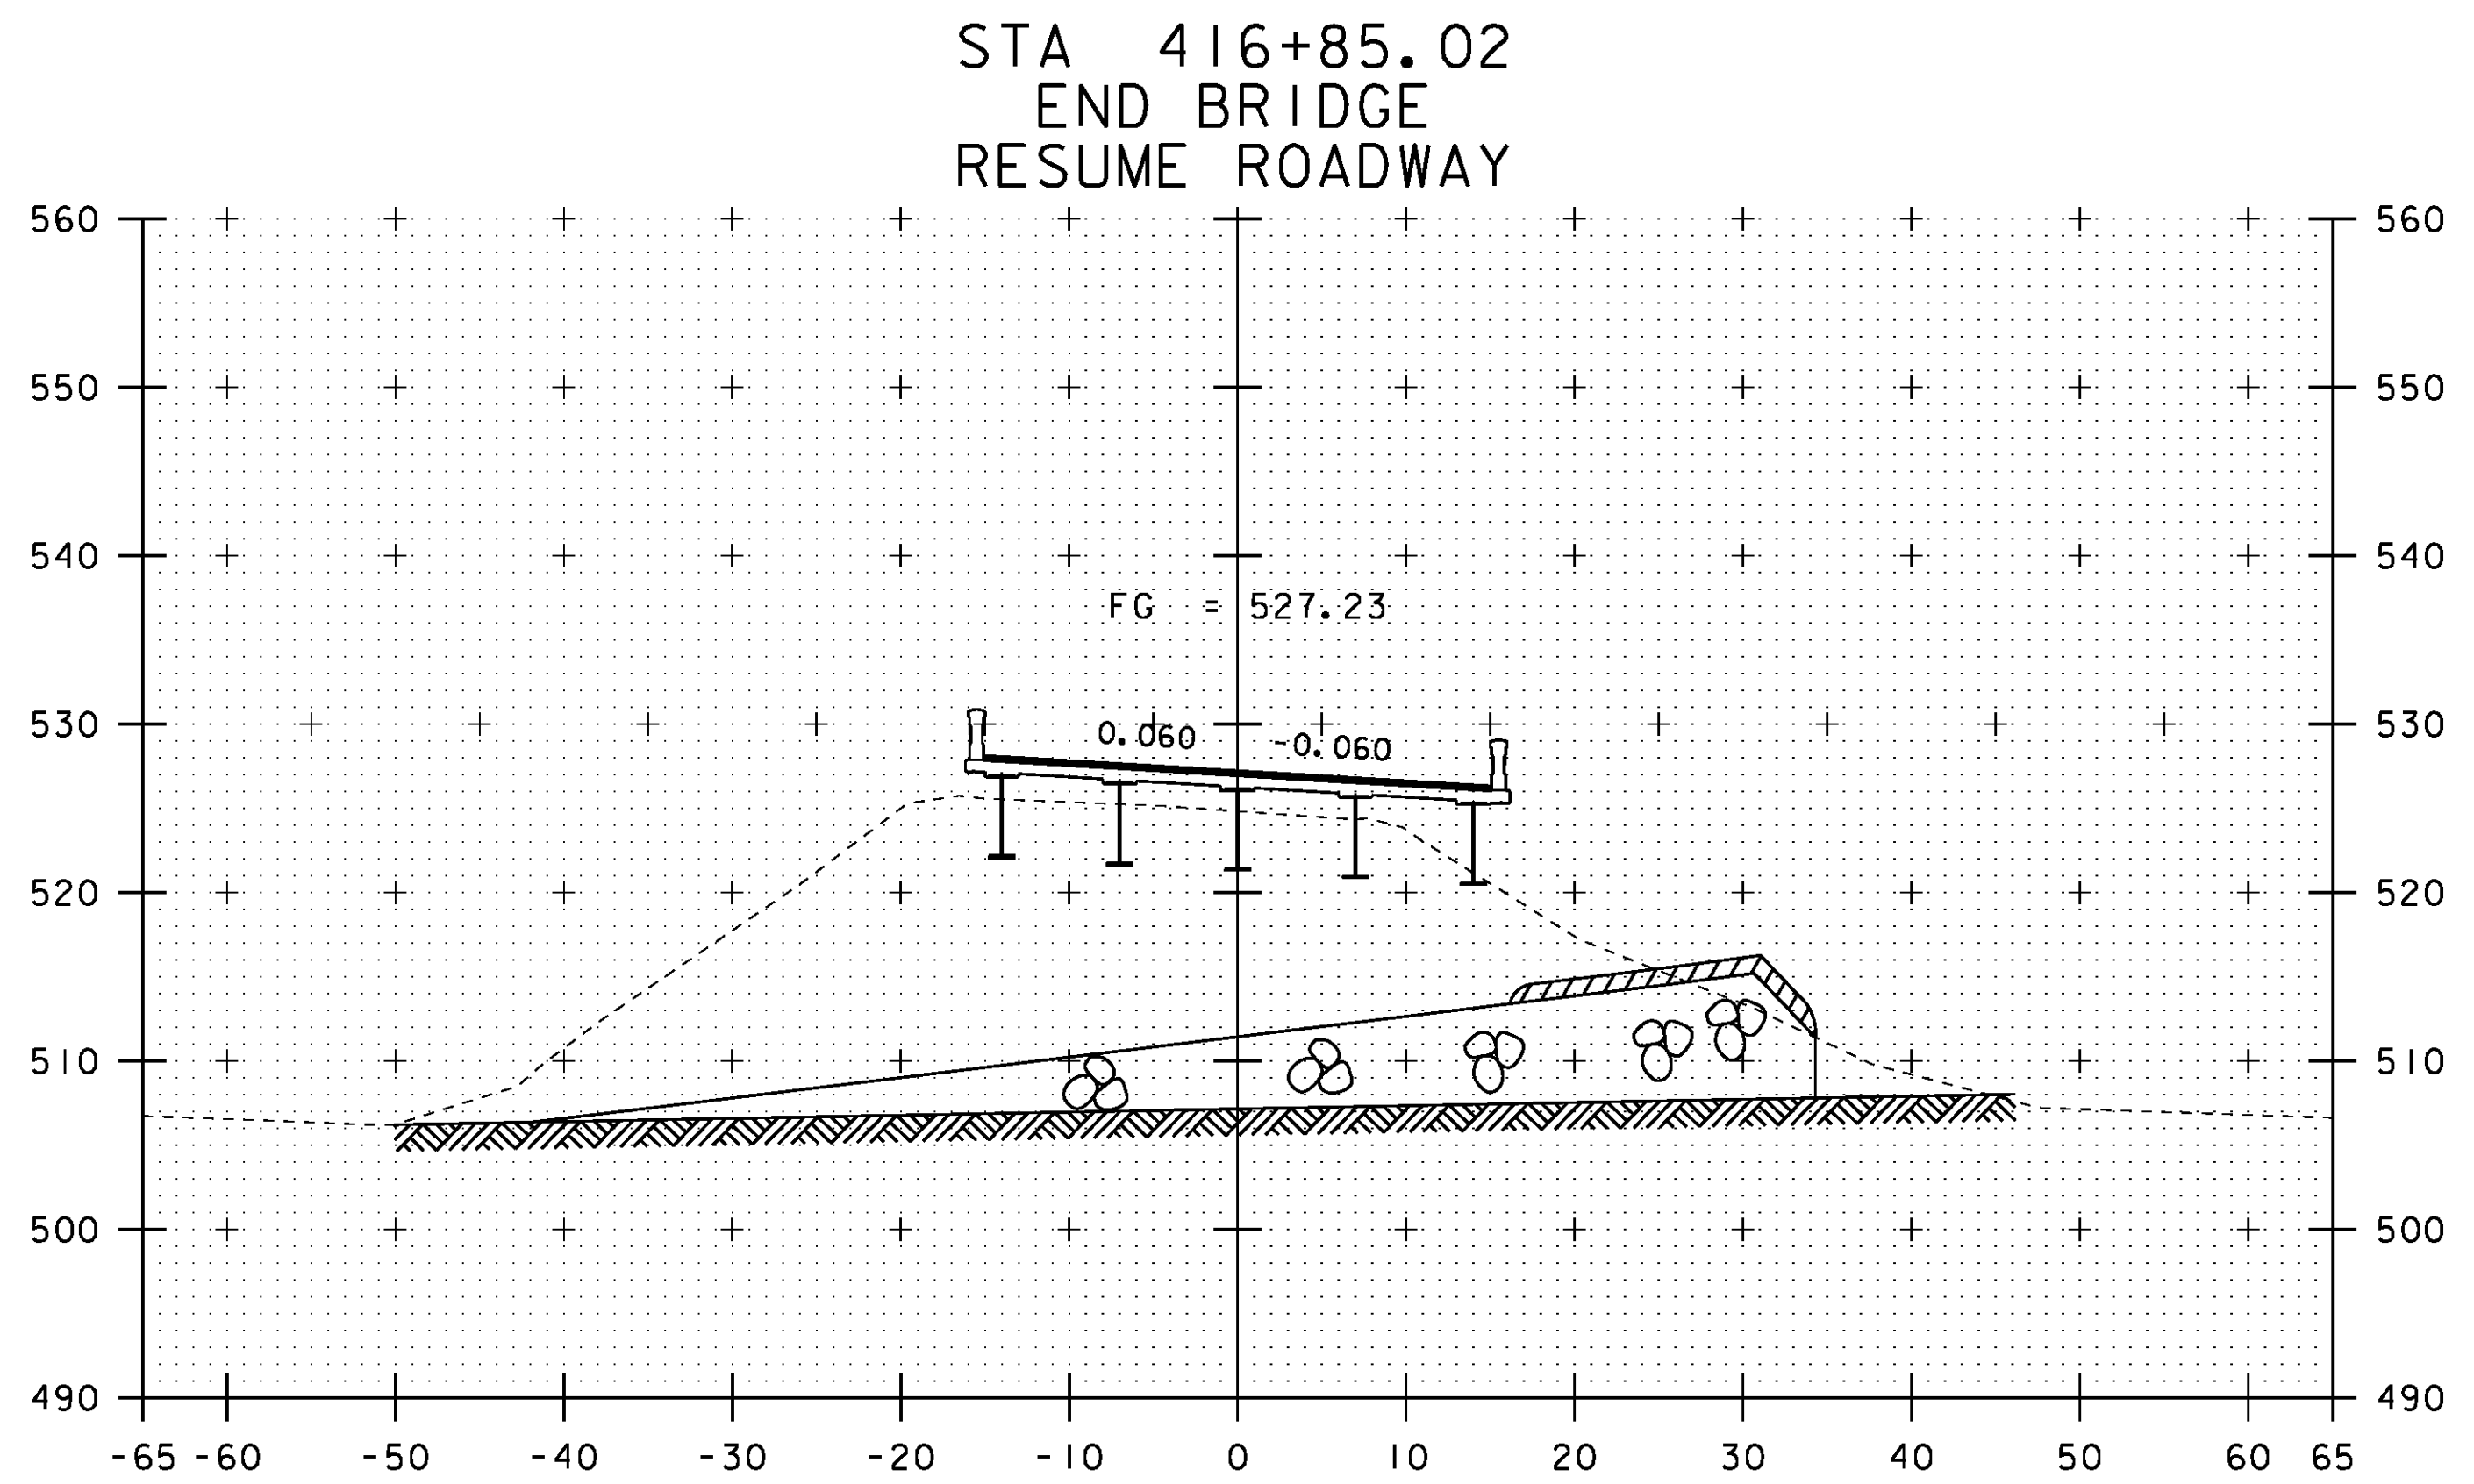

416+75

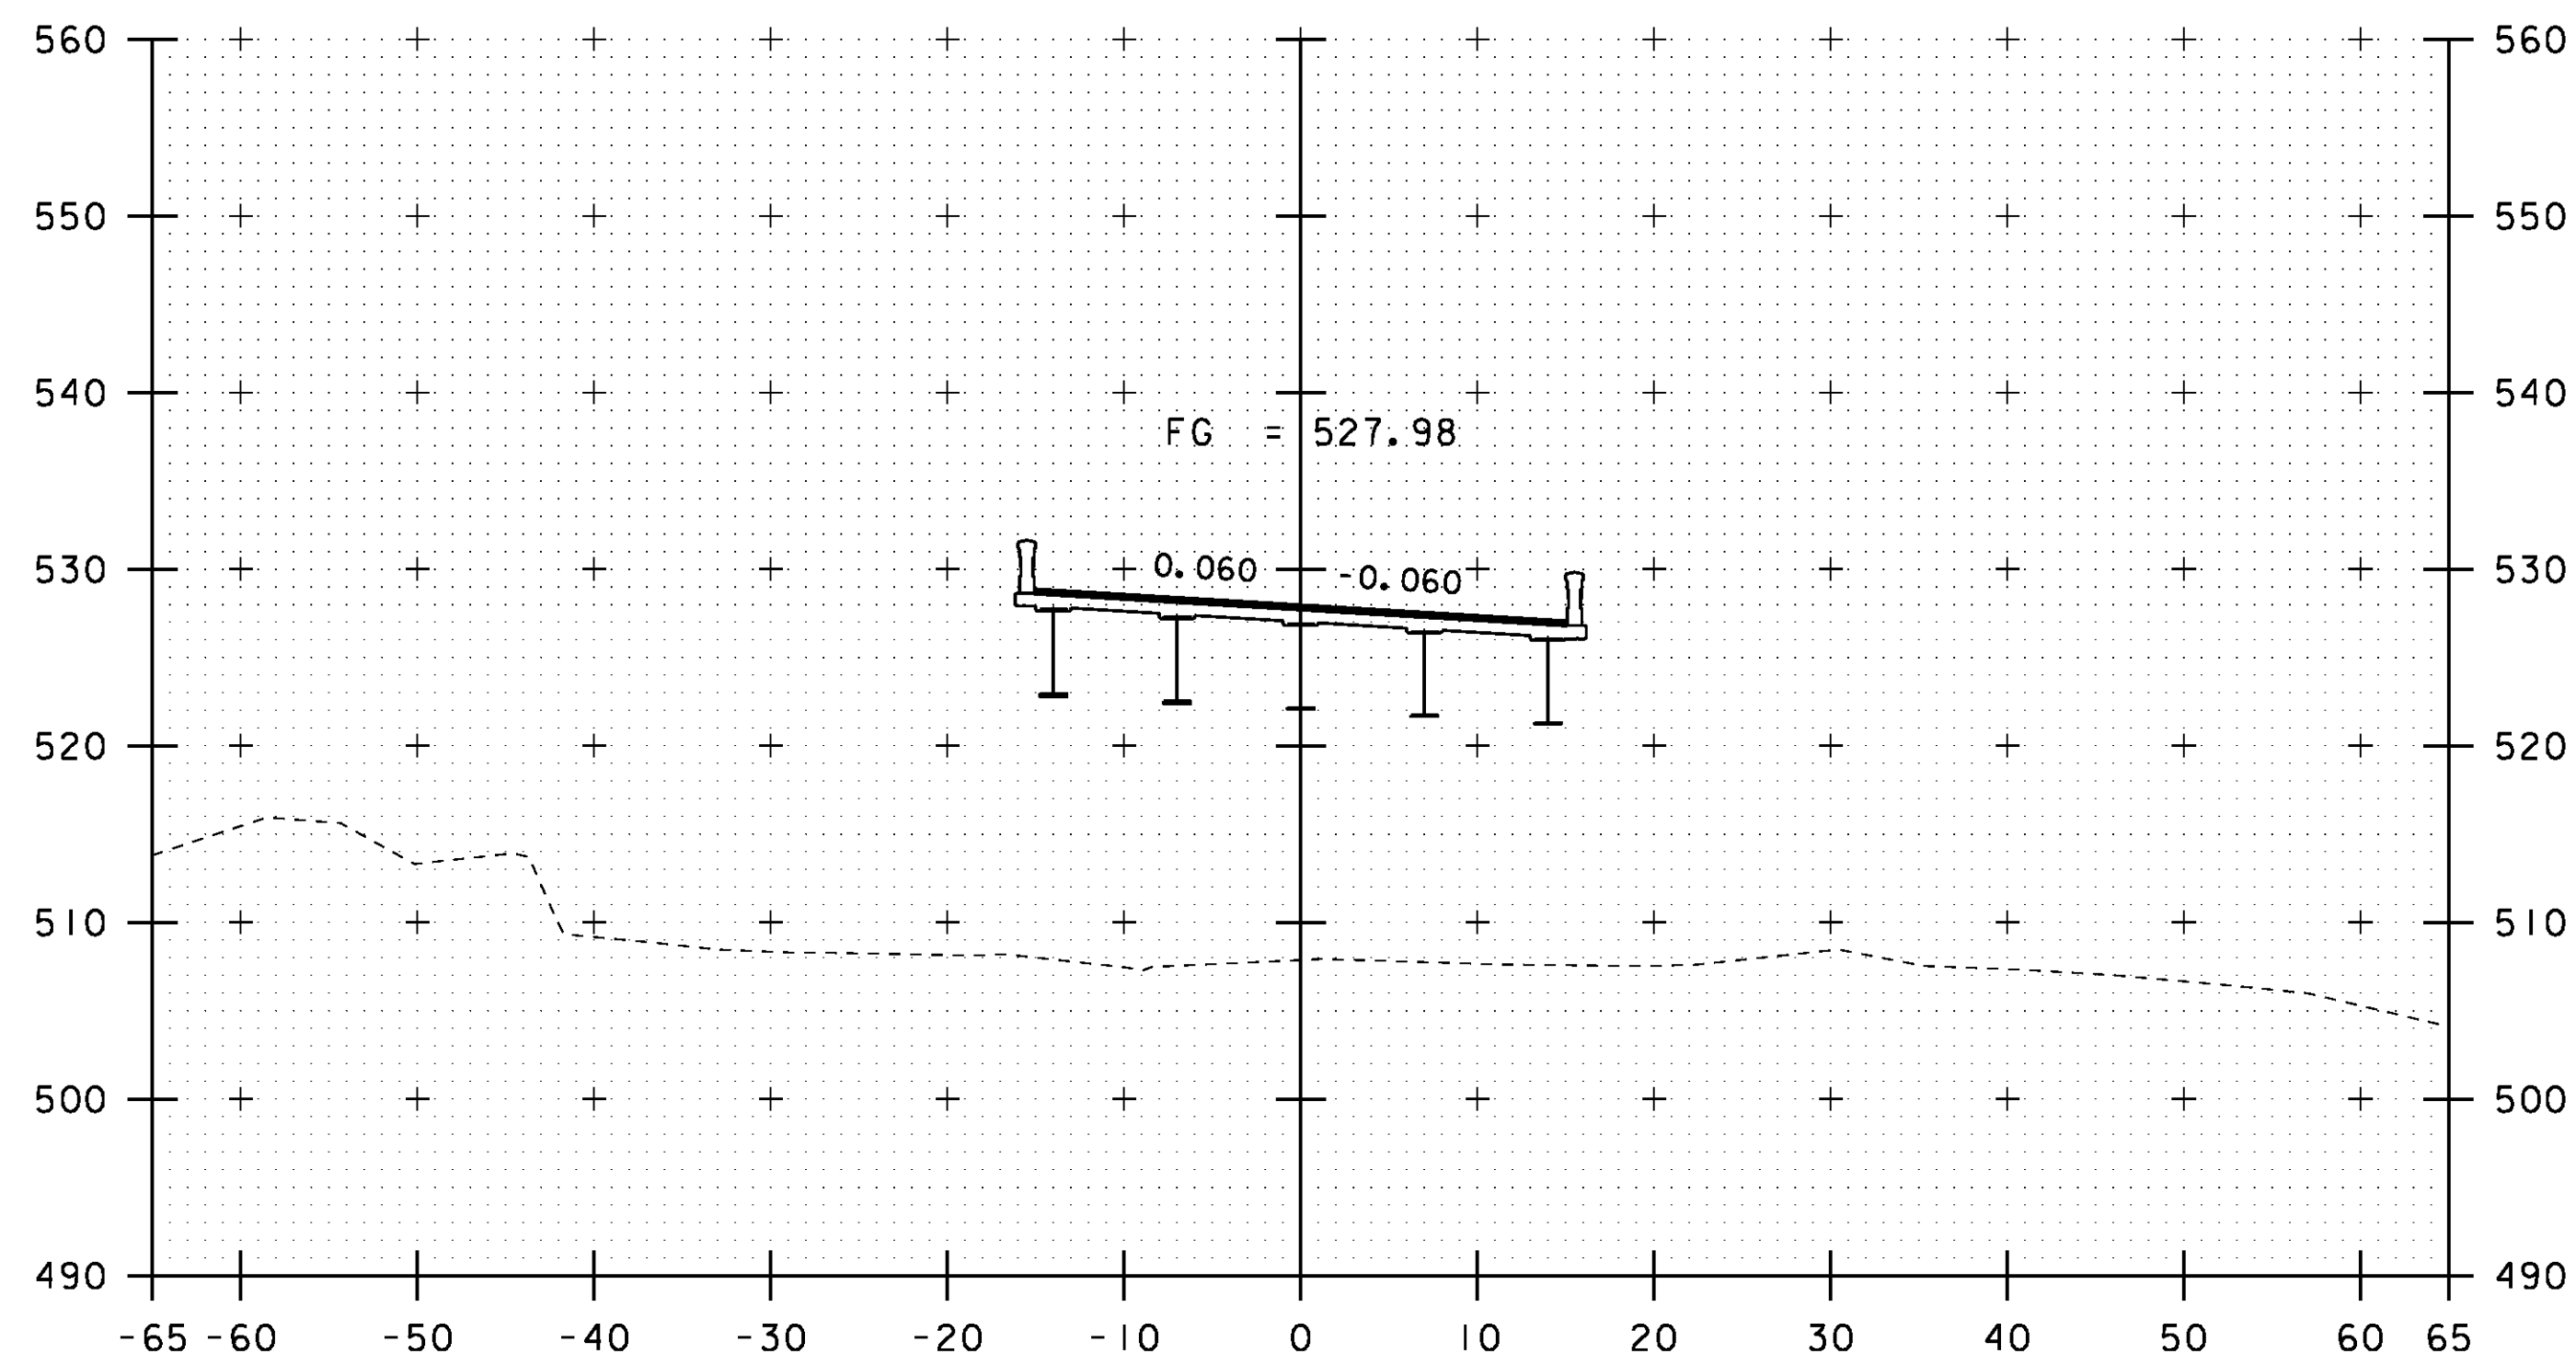

416+00

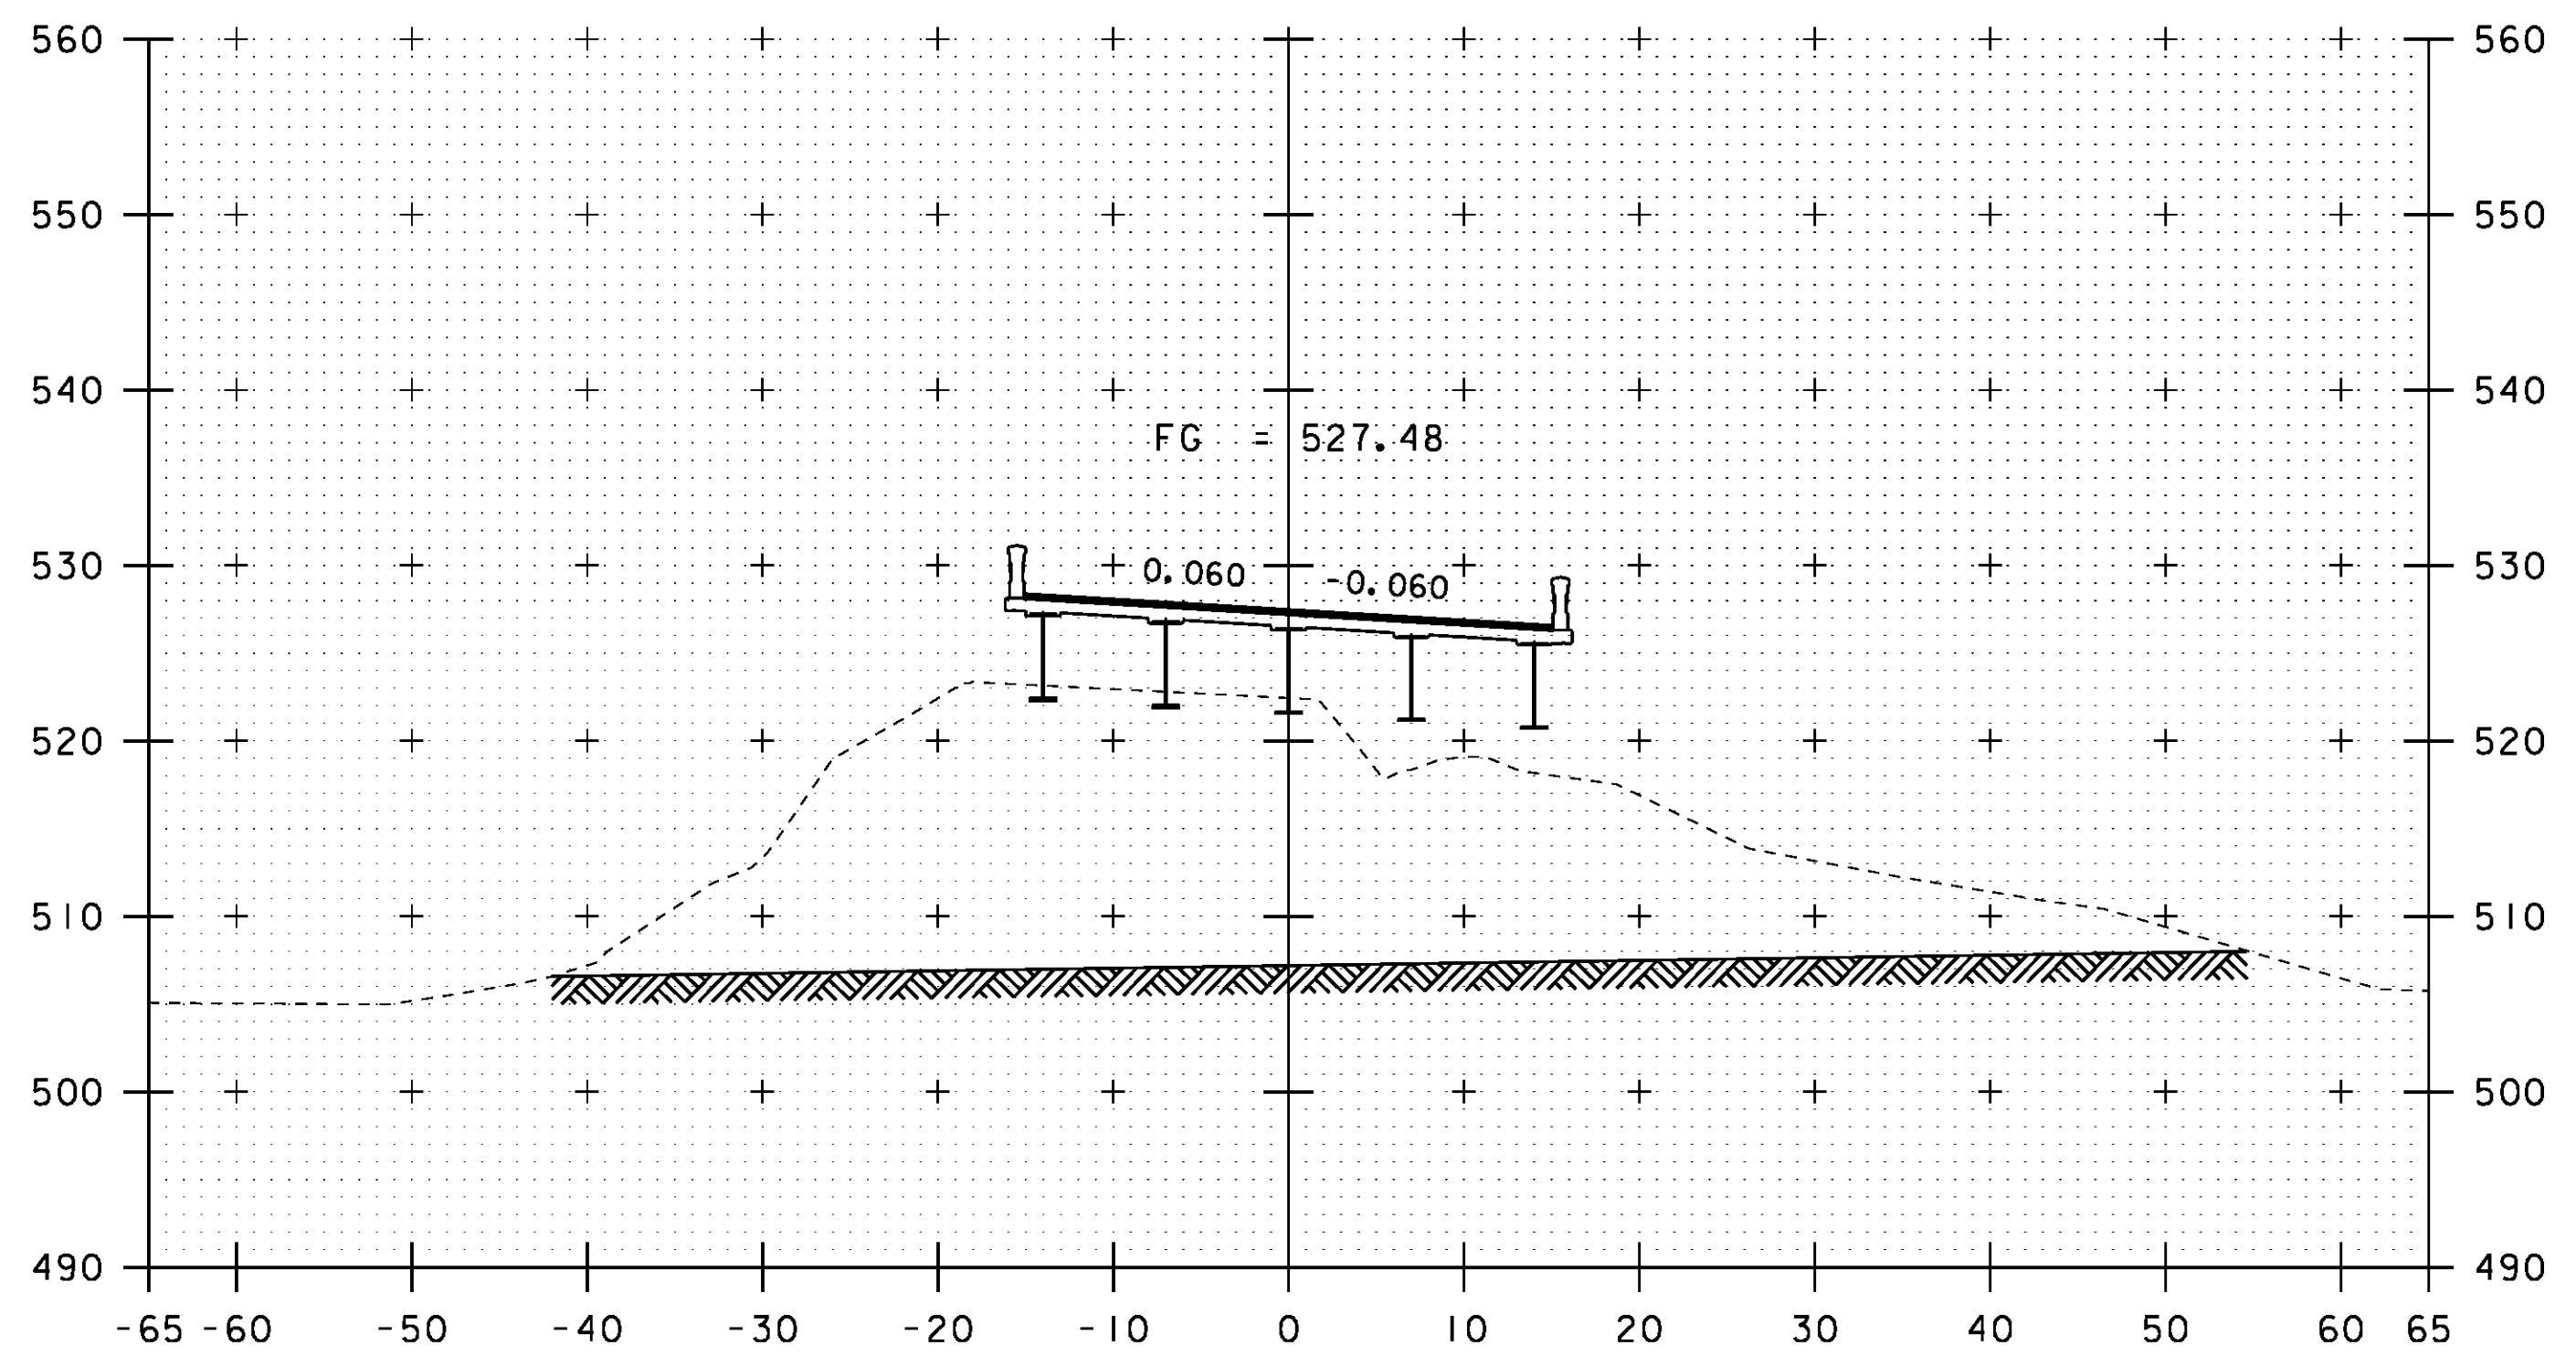


416+50




SCALE: 1" = 10' - 0"

STA. 416+00 TO STA. 416+75


PROJECT NAME: ROYALTON	PLLOT DATE: 08-OCT-2013
PROJECT NUMBER: BRS 0147 (13)	DRAWN BY: STR3
FILE NAME: \BR_28\s86e055xsl_28.dgn	CHECKED BY: C. CARLSON
PROJECT LEADER: C. CARLSON	SHEET 141 OF 186
DESIGNED BY: D. PETERSON	
BRIDGE 28 VT 14 CROSS SECTIONS (5)	

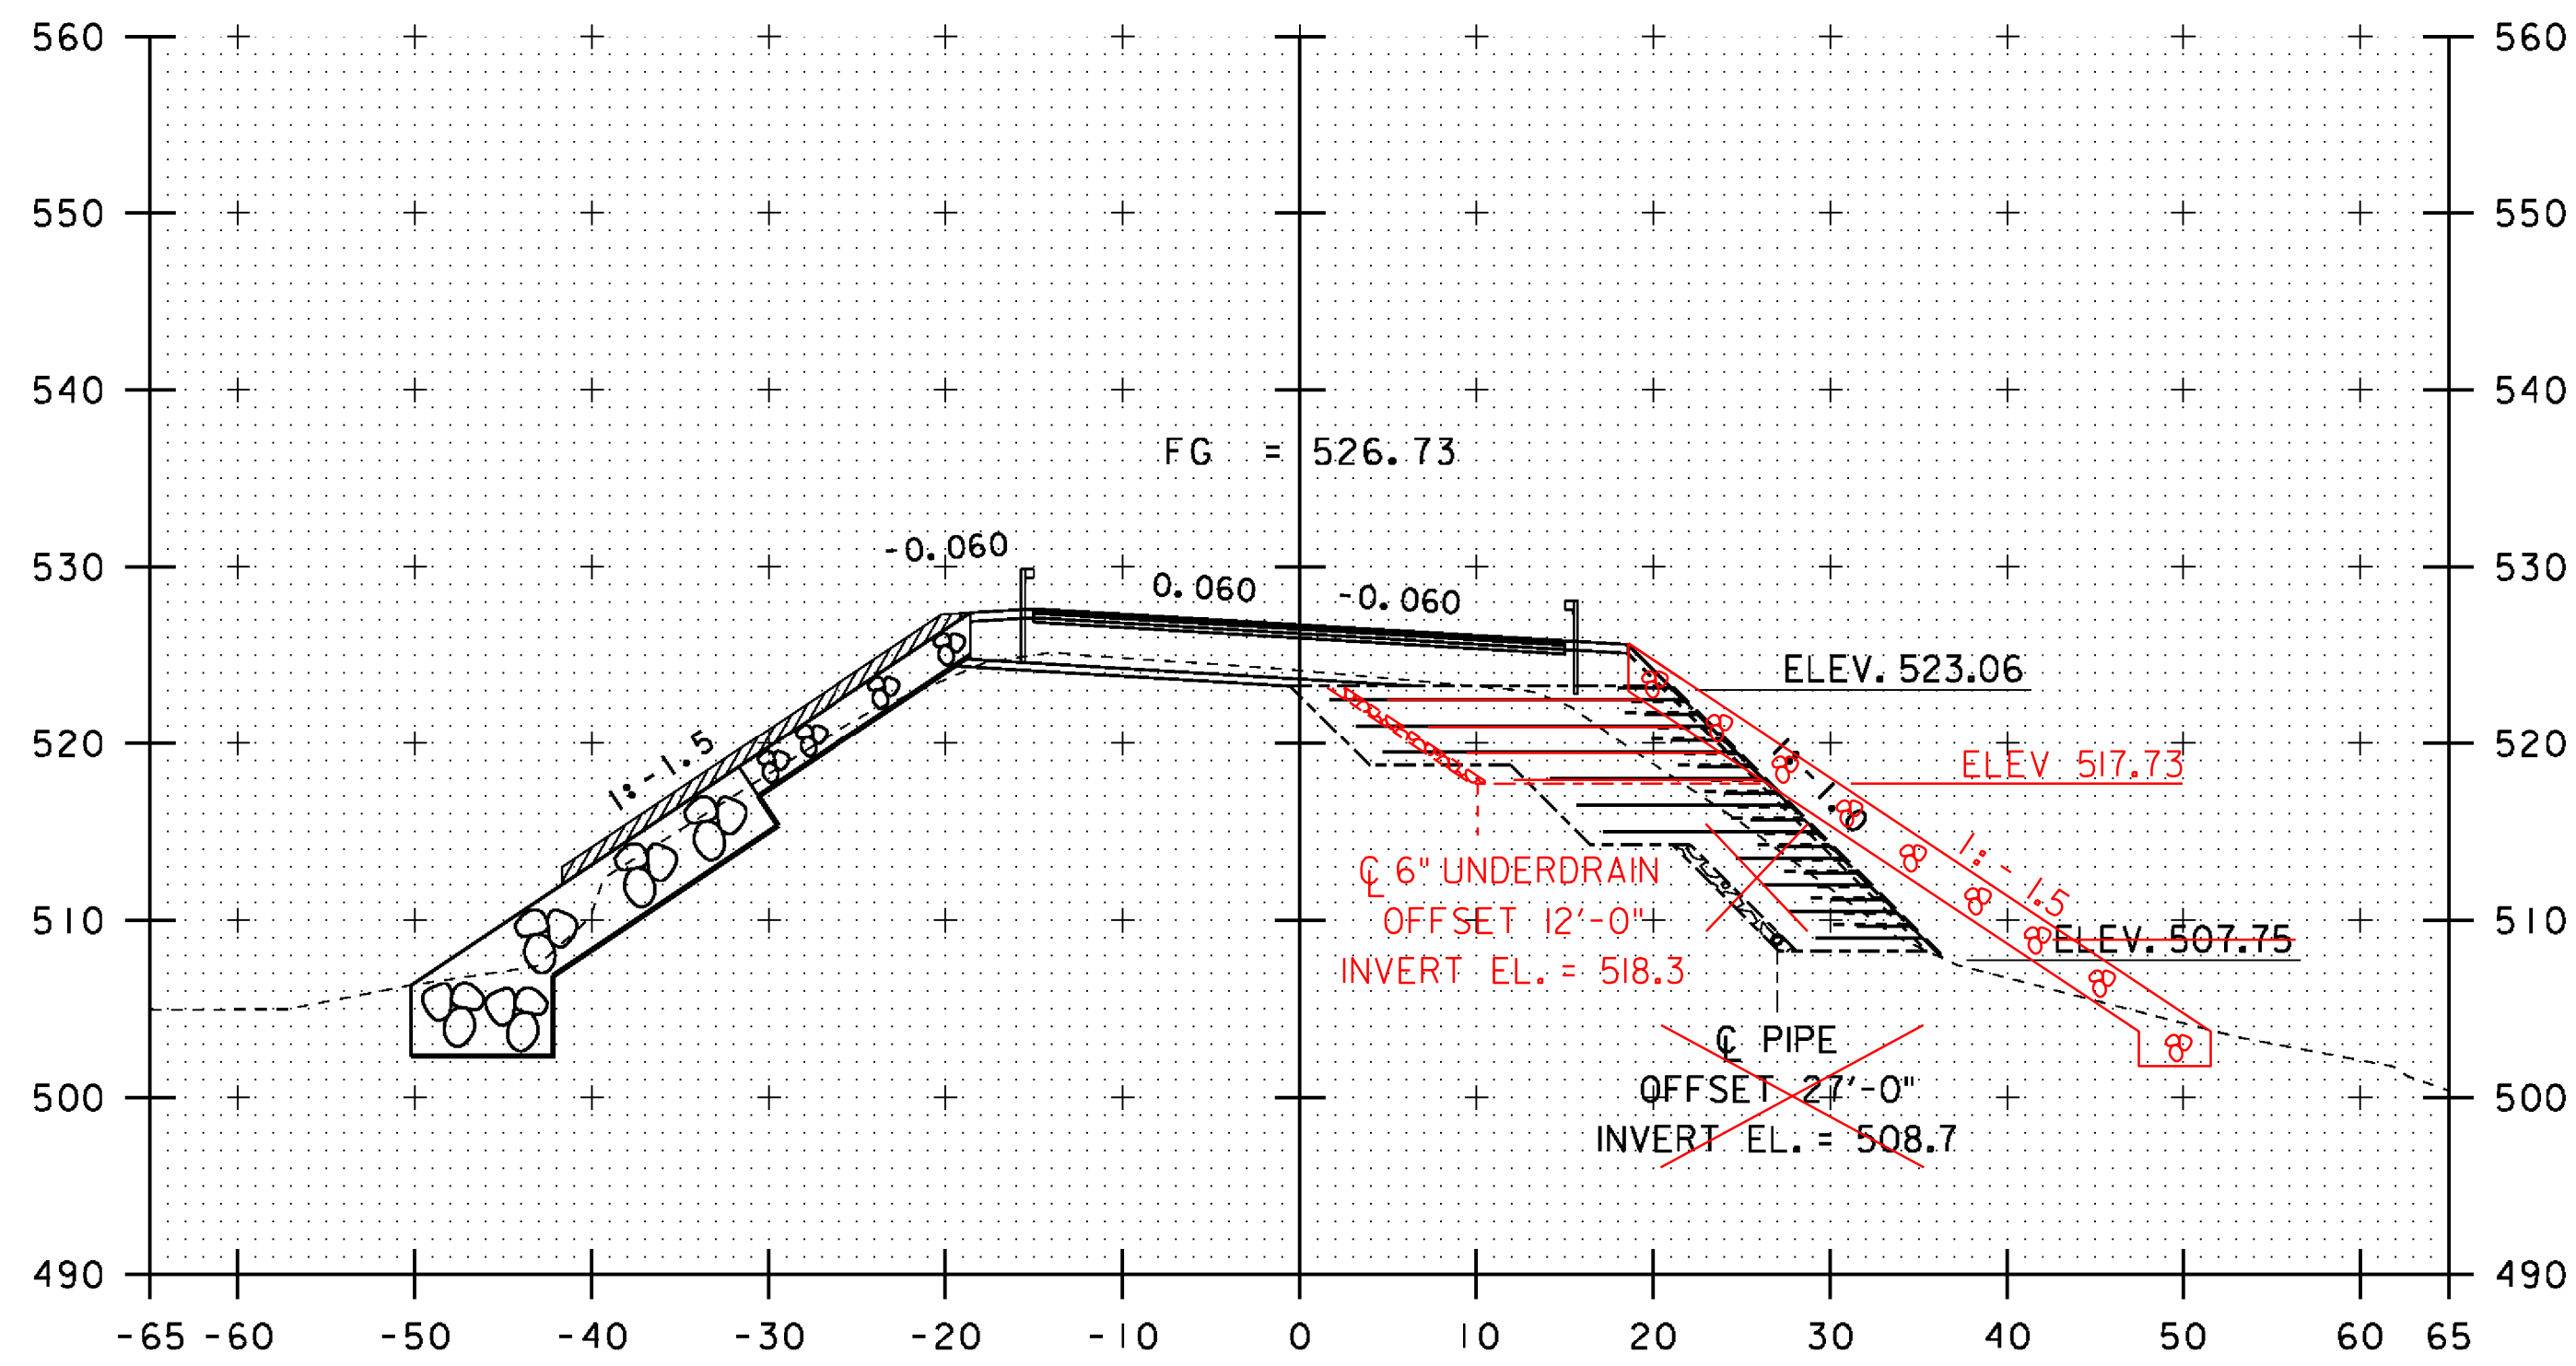


417+25

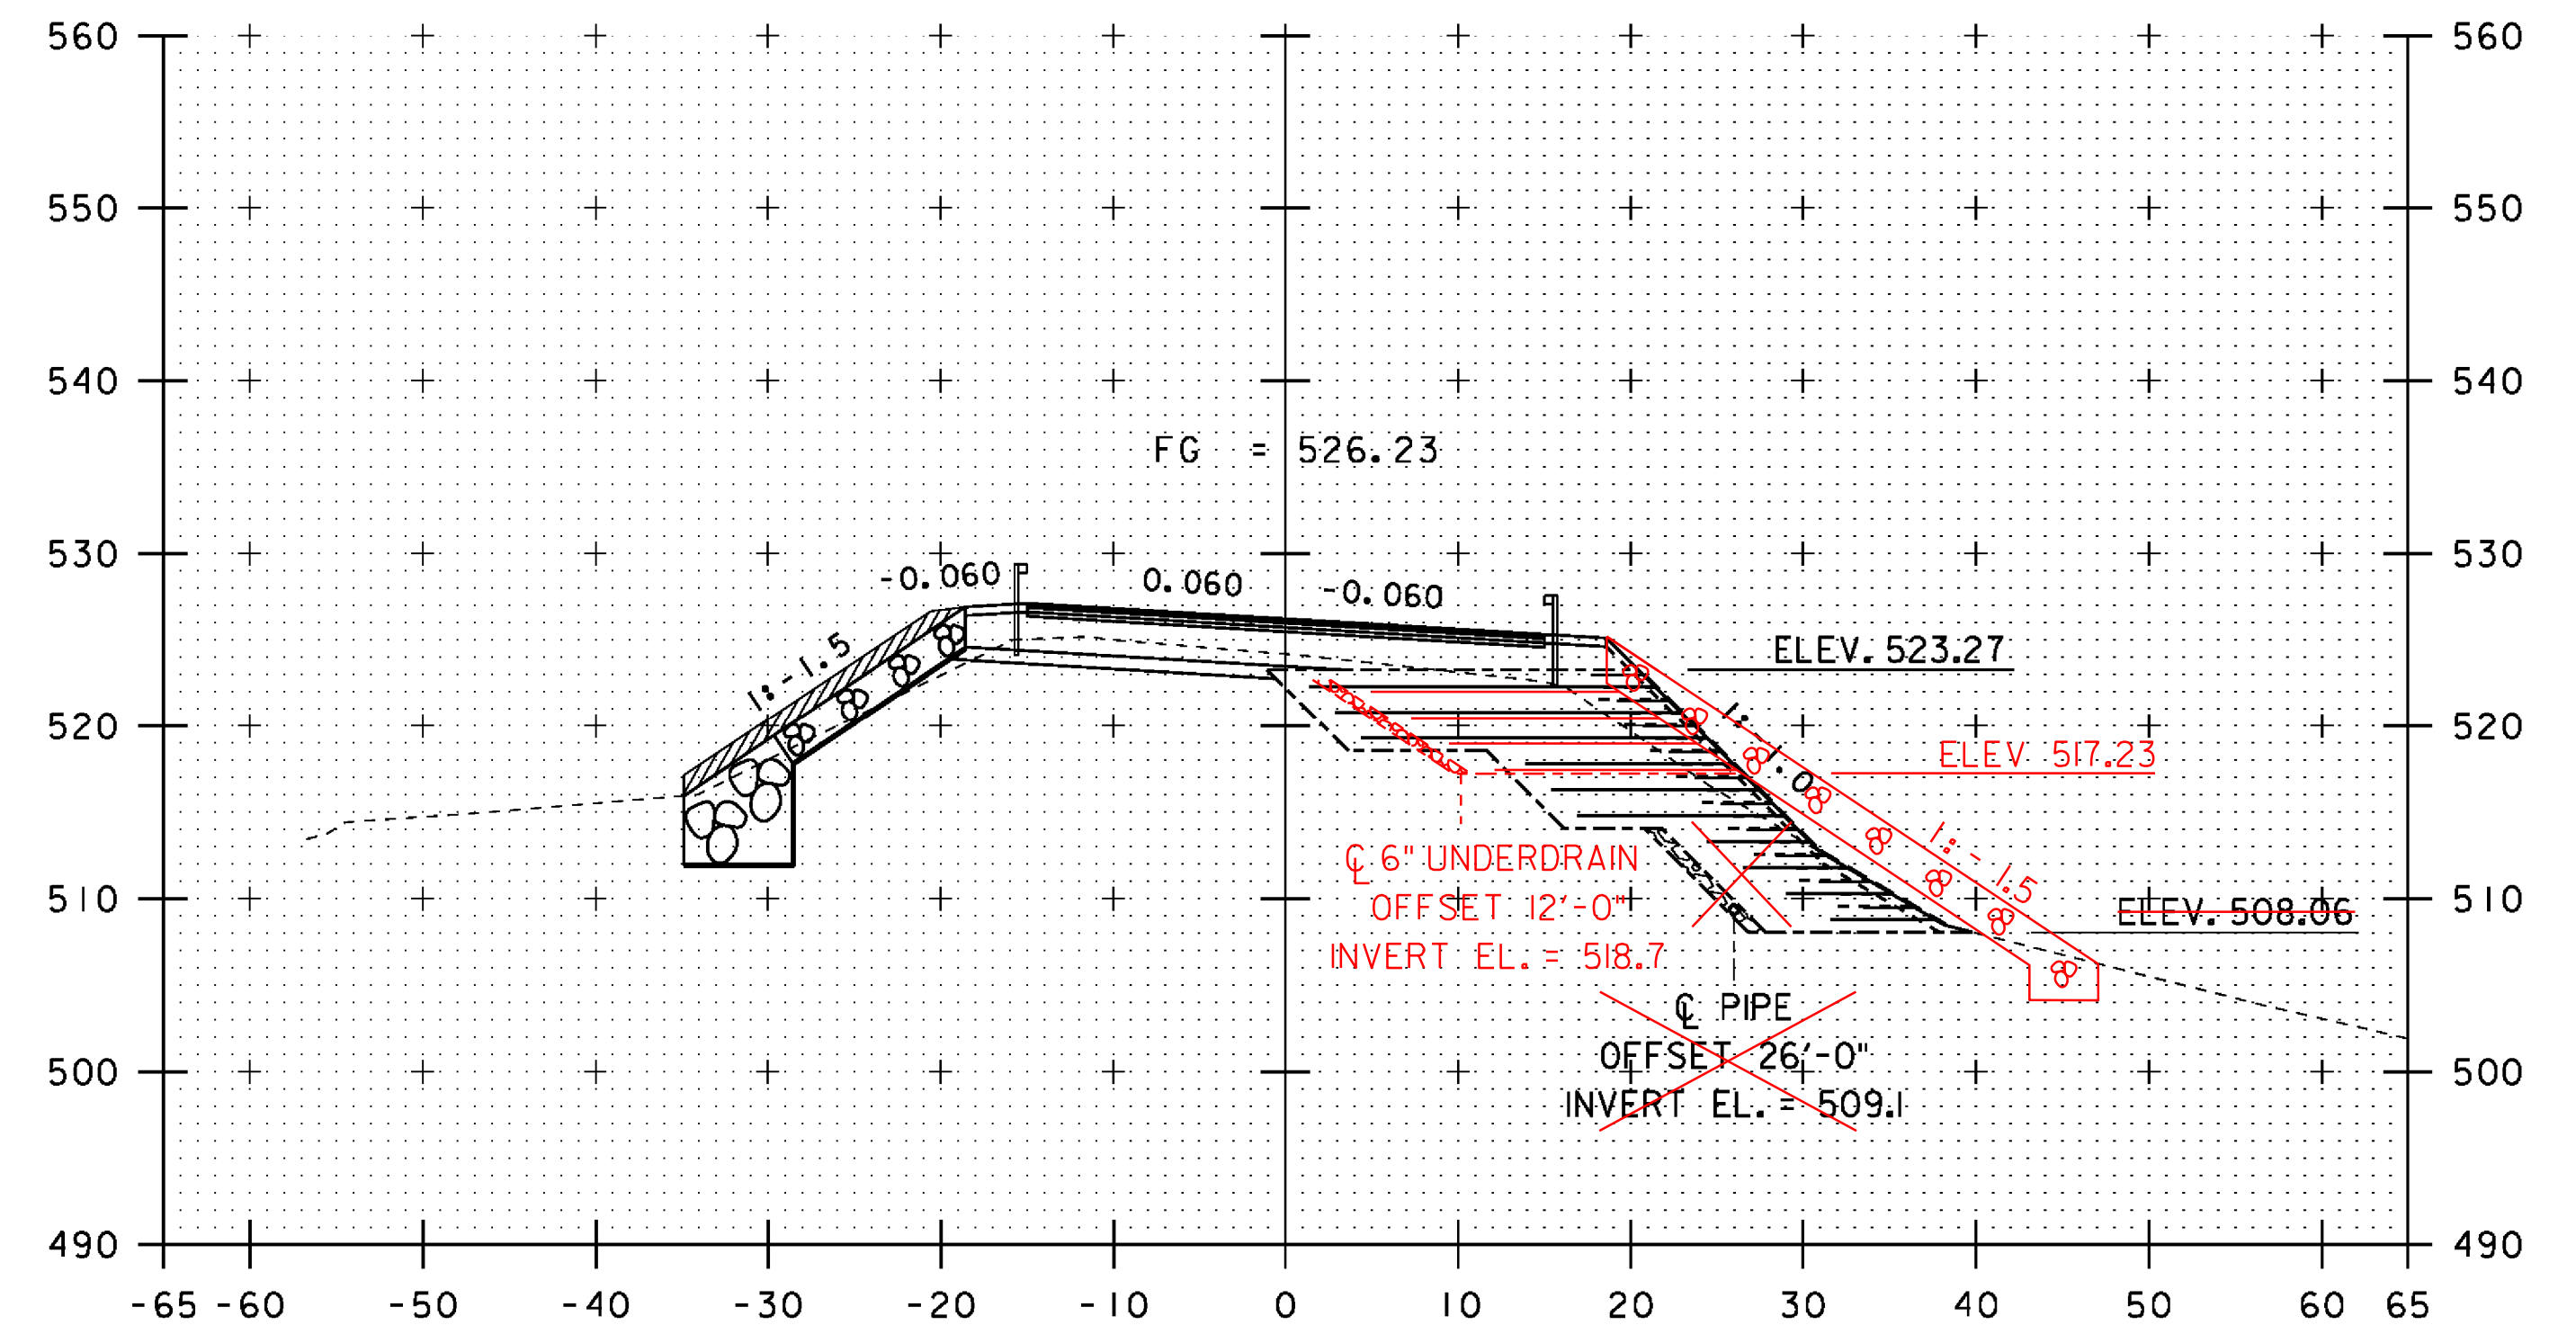

417+75

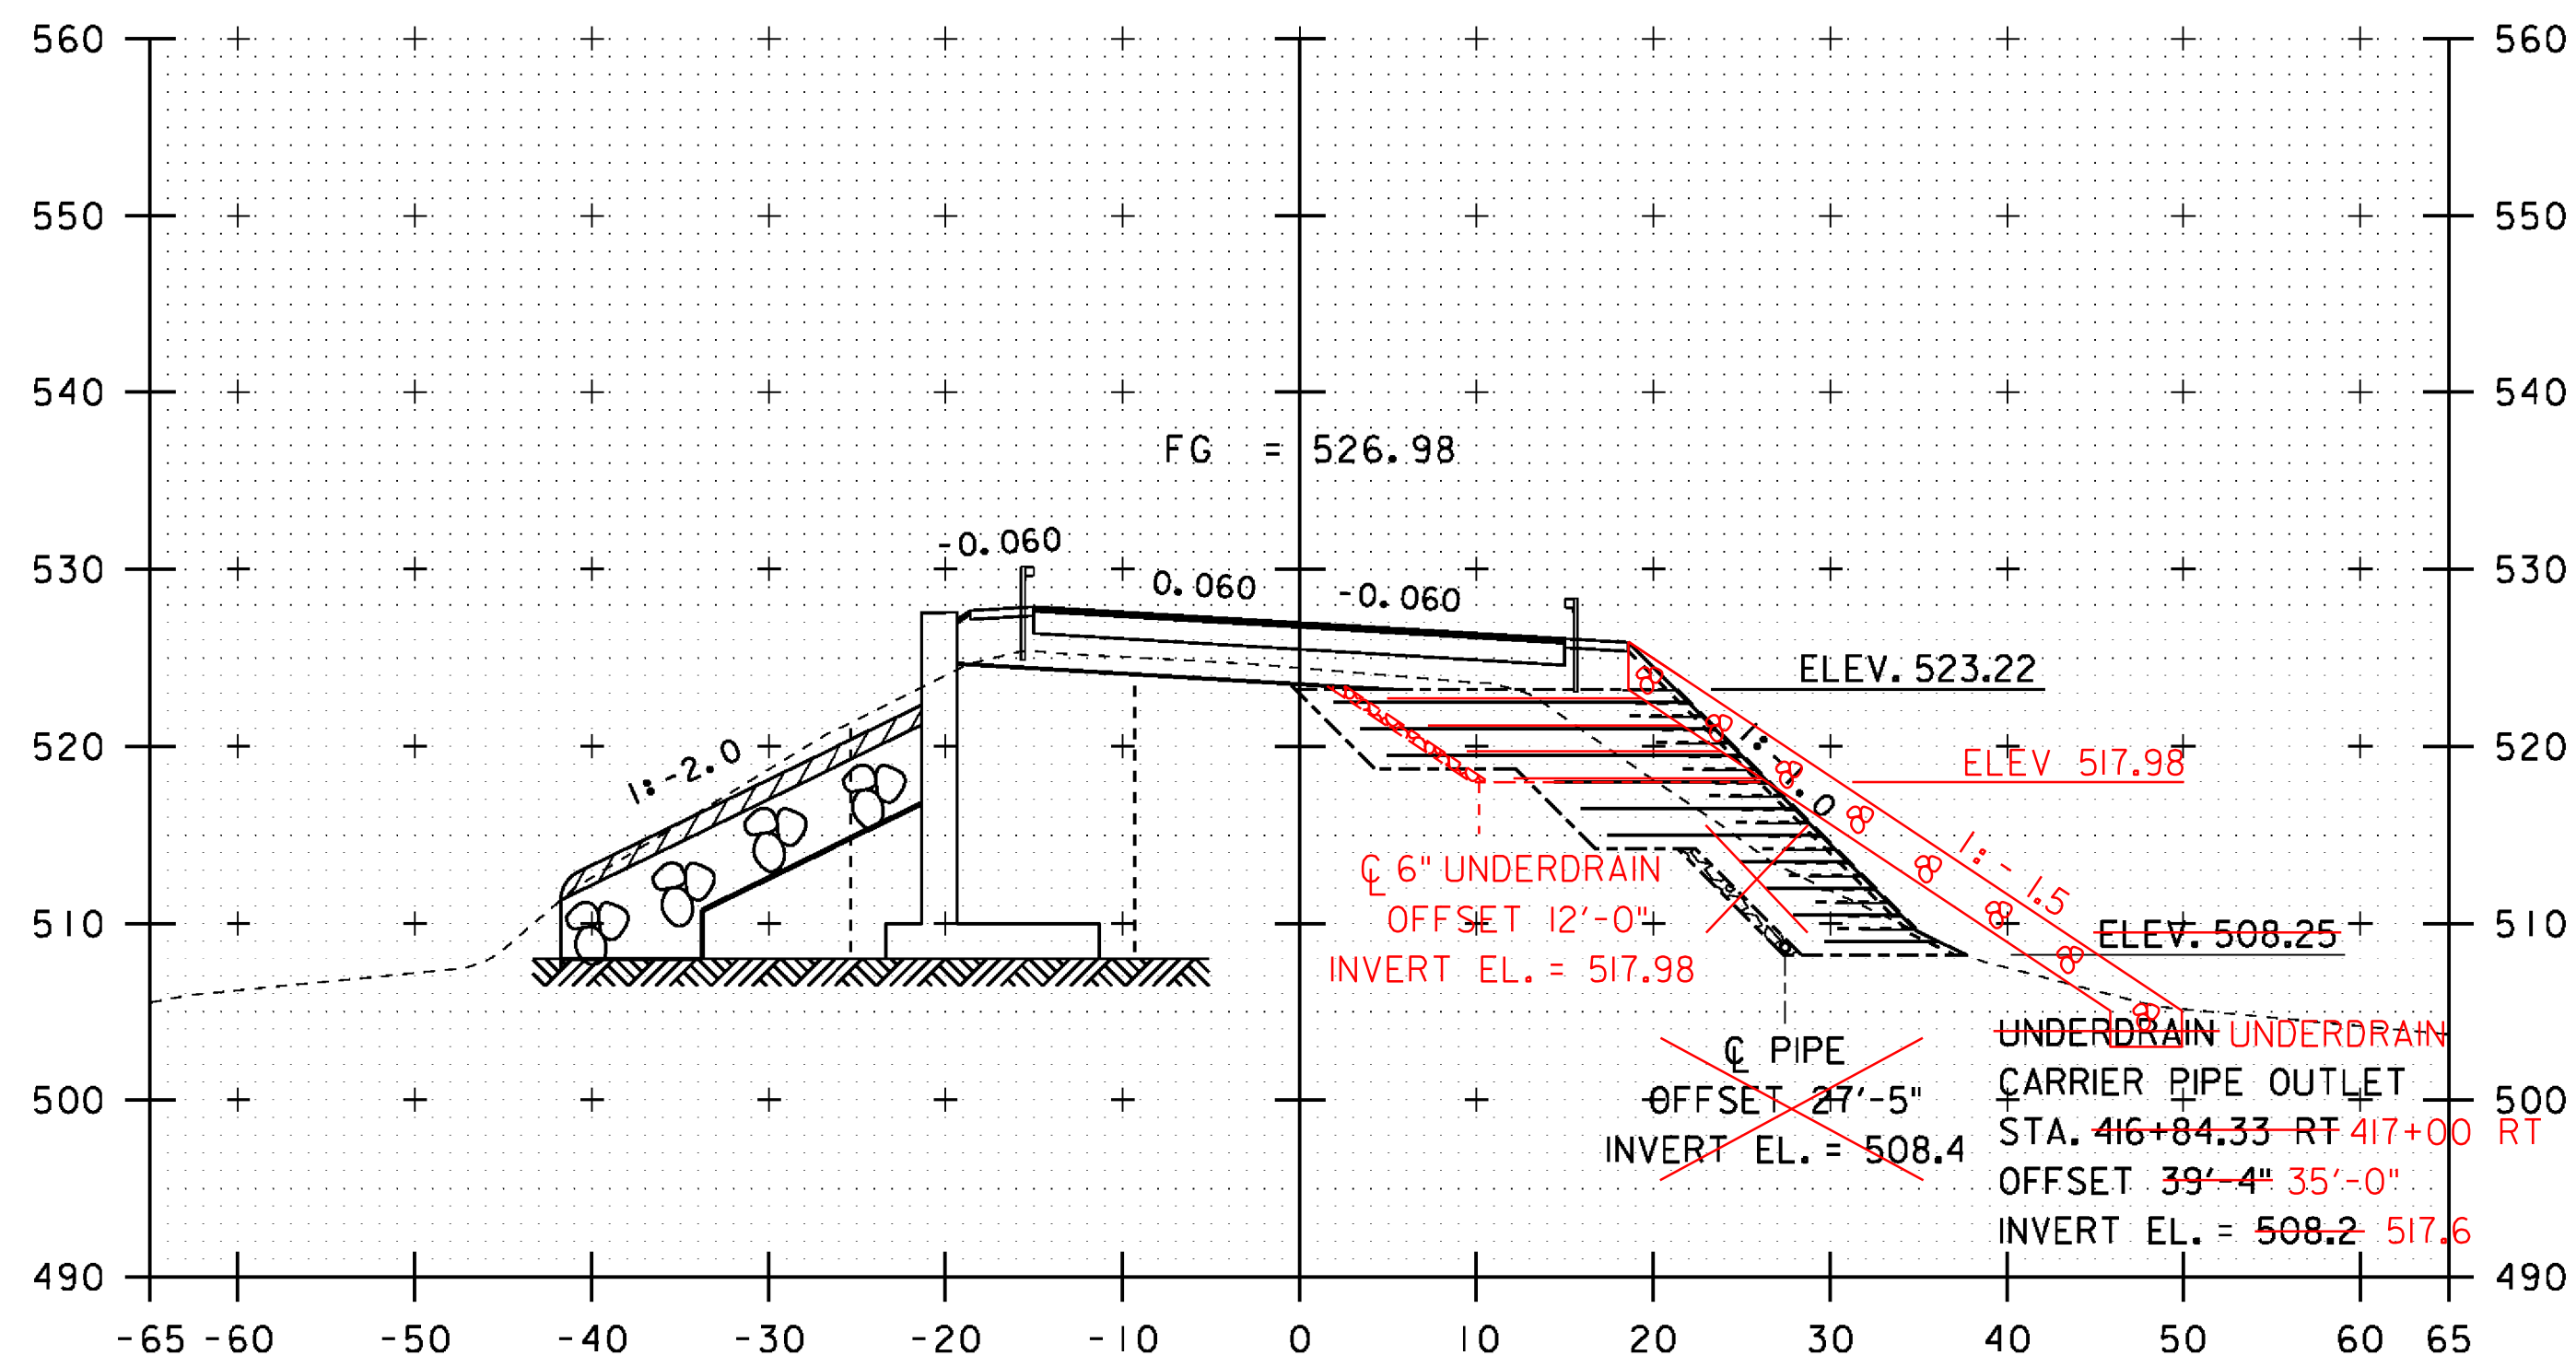

417+00

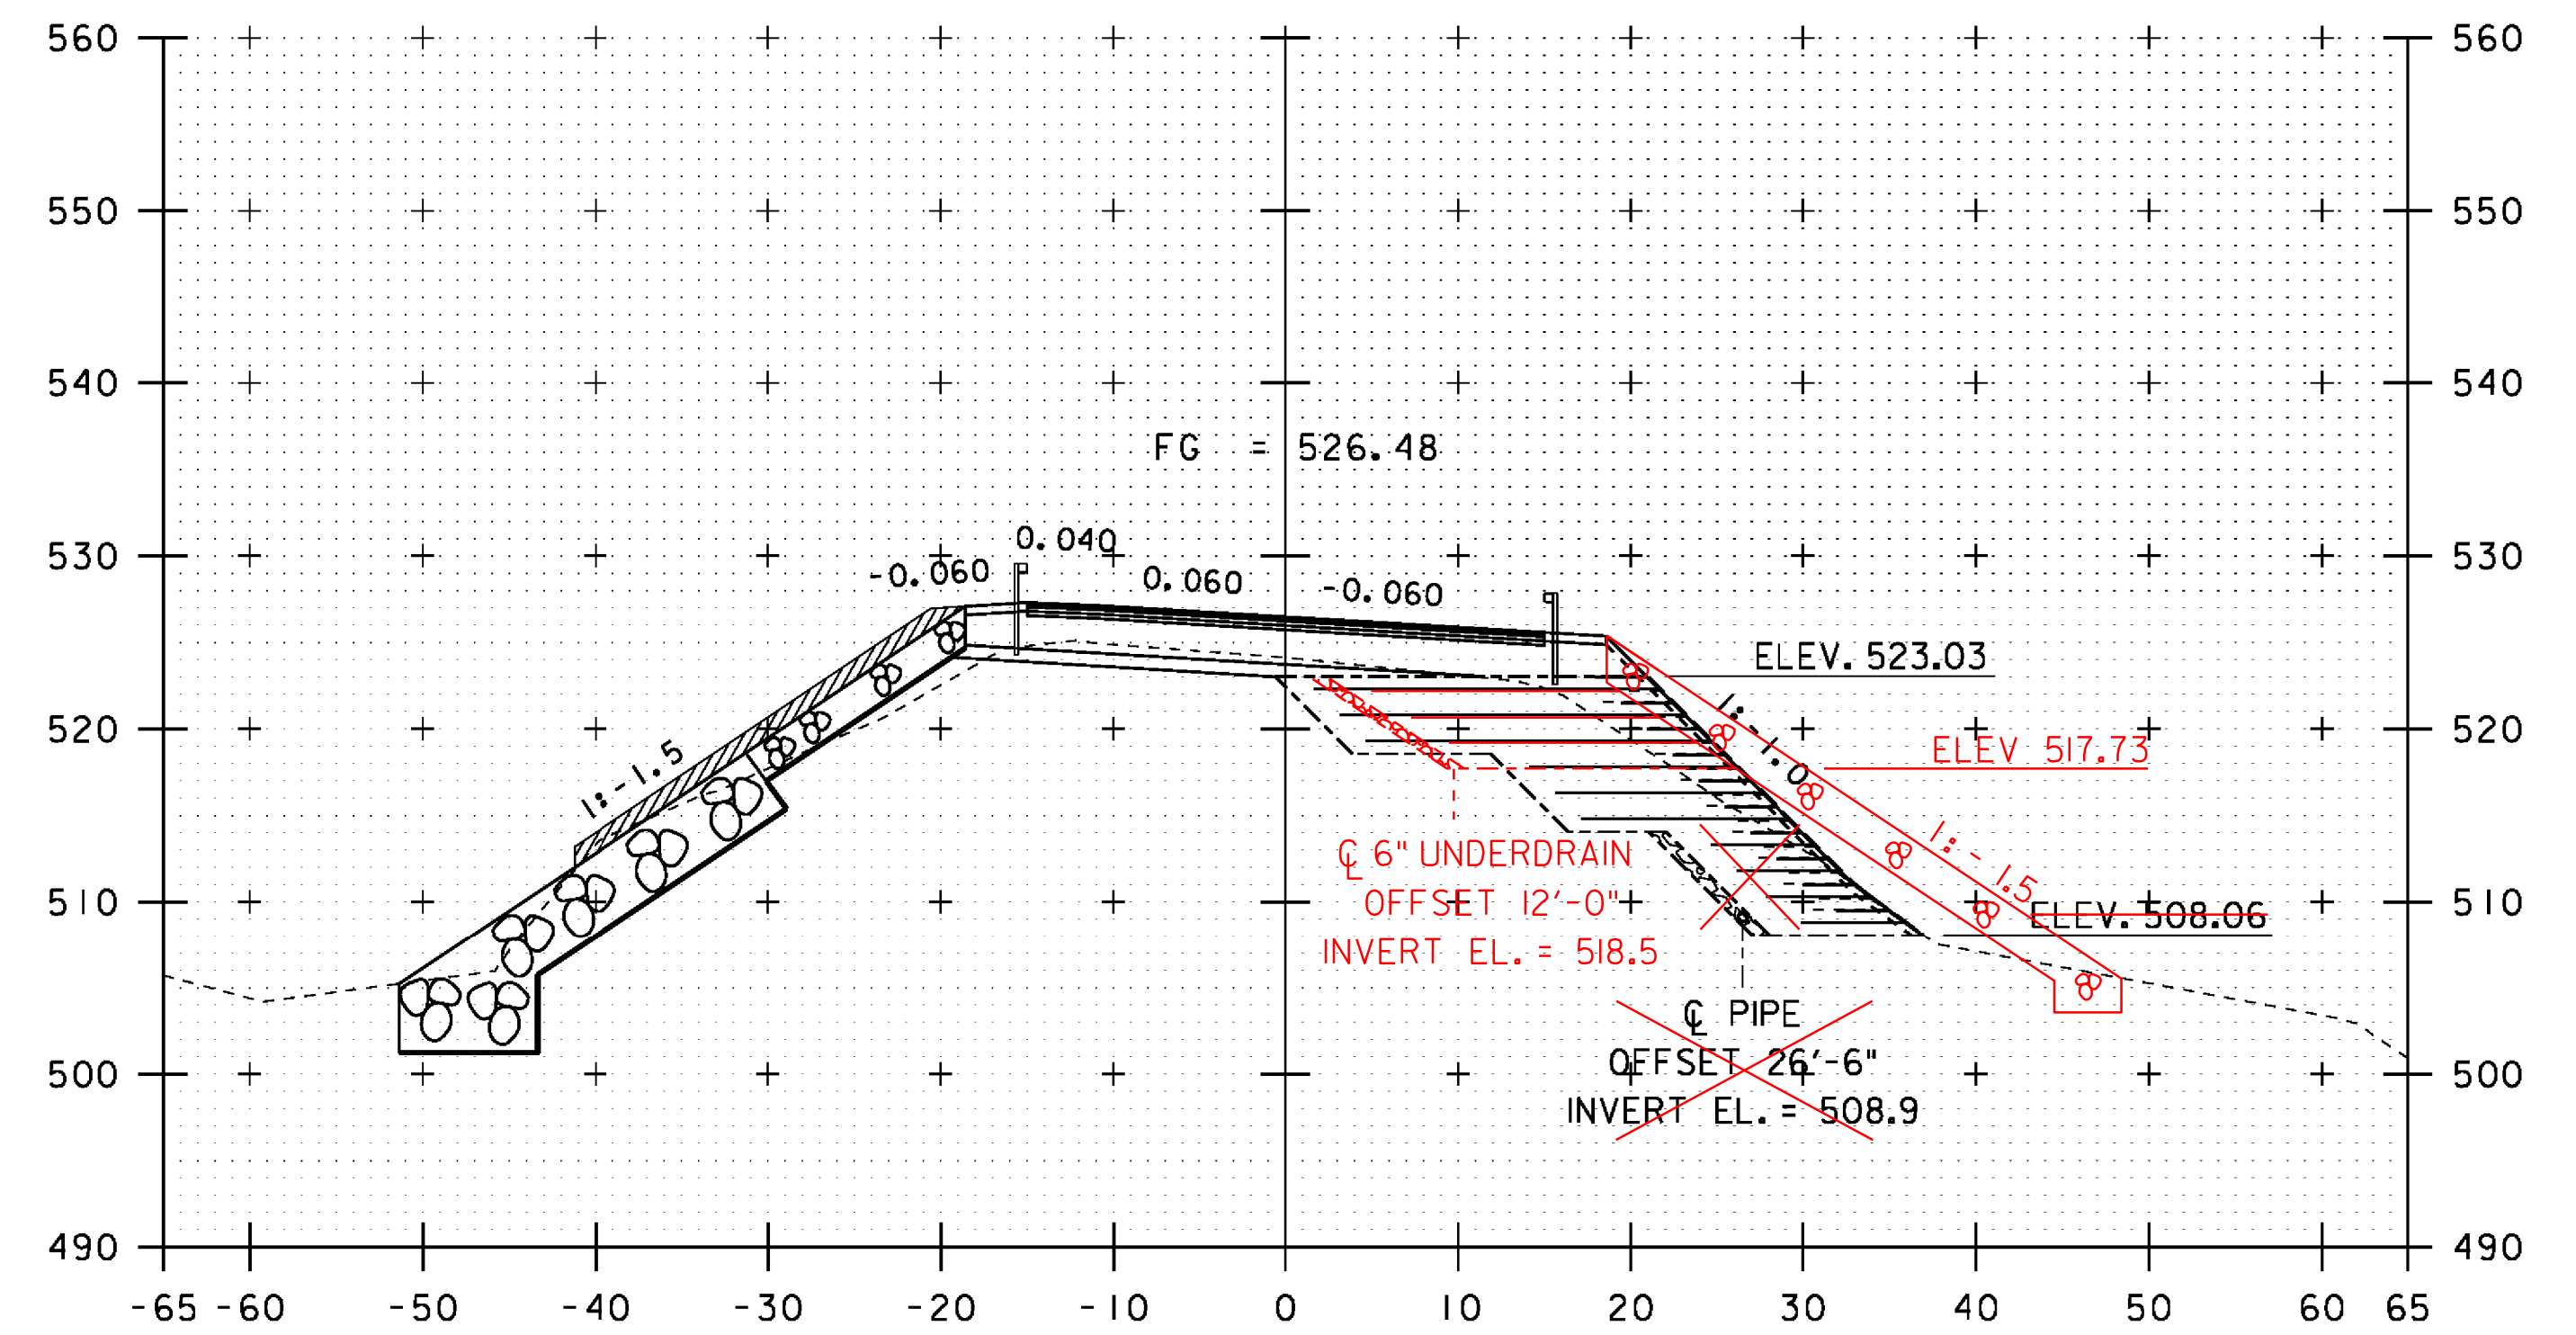

417+50

STA 417+06.90 LT.  
 BEGIN STONE FILL, TYPE II  
 GEOTEXTILE UNDER STONE FILL  
 GRUBBING MATERIAL

STA 417+00.00 RT.  
 BEGIN REINFORCED SOIL SLOPE  
 BEGIN STONE FILL, TYPE II  
 GEOTEXTILE UNDER STONE FILL  
 GRUBBING MATERIAL


10 0 10  
 SCALE: 1" = 10'-0"

STA. 417+00 TO STA. 417+75


PROJECT NAME: ROYALTON  
 PROJECT NUMBER: BRS 0147 (13)

FILE NAME: \BR_28\86e055\sl_28.dgn  
 PROJECT LEADER: C. CARLSON  
 DESIGNED BY: D. PETERSON  
 BRIDGE 28 VT 14 CROSS SECTIONS (6)


PLOT DATE: 08-OCT-2013  
 DRAWN BY: STR3  
 CHECKED BY: C. CARLSON  
 SHEET 142 OF 186

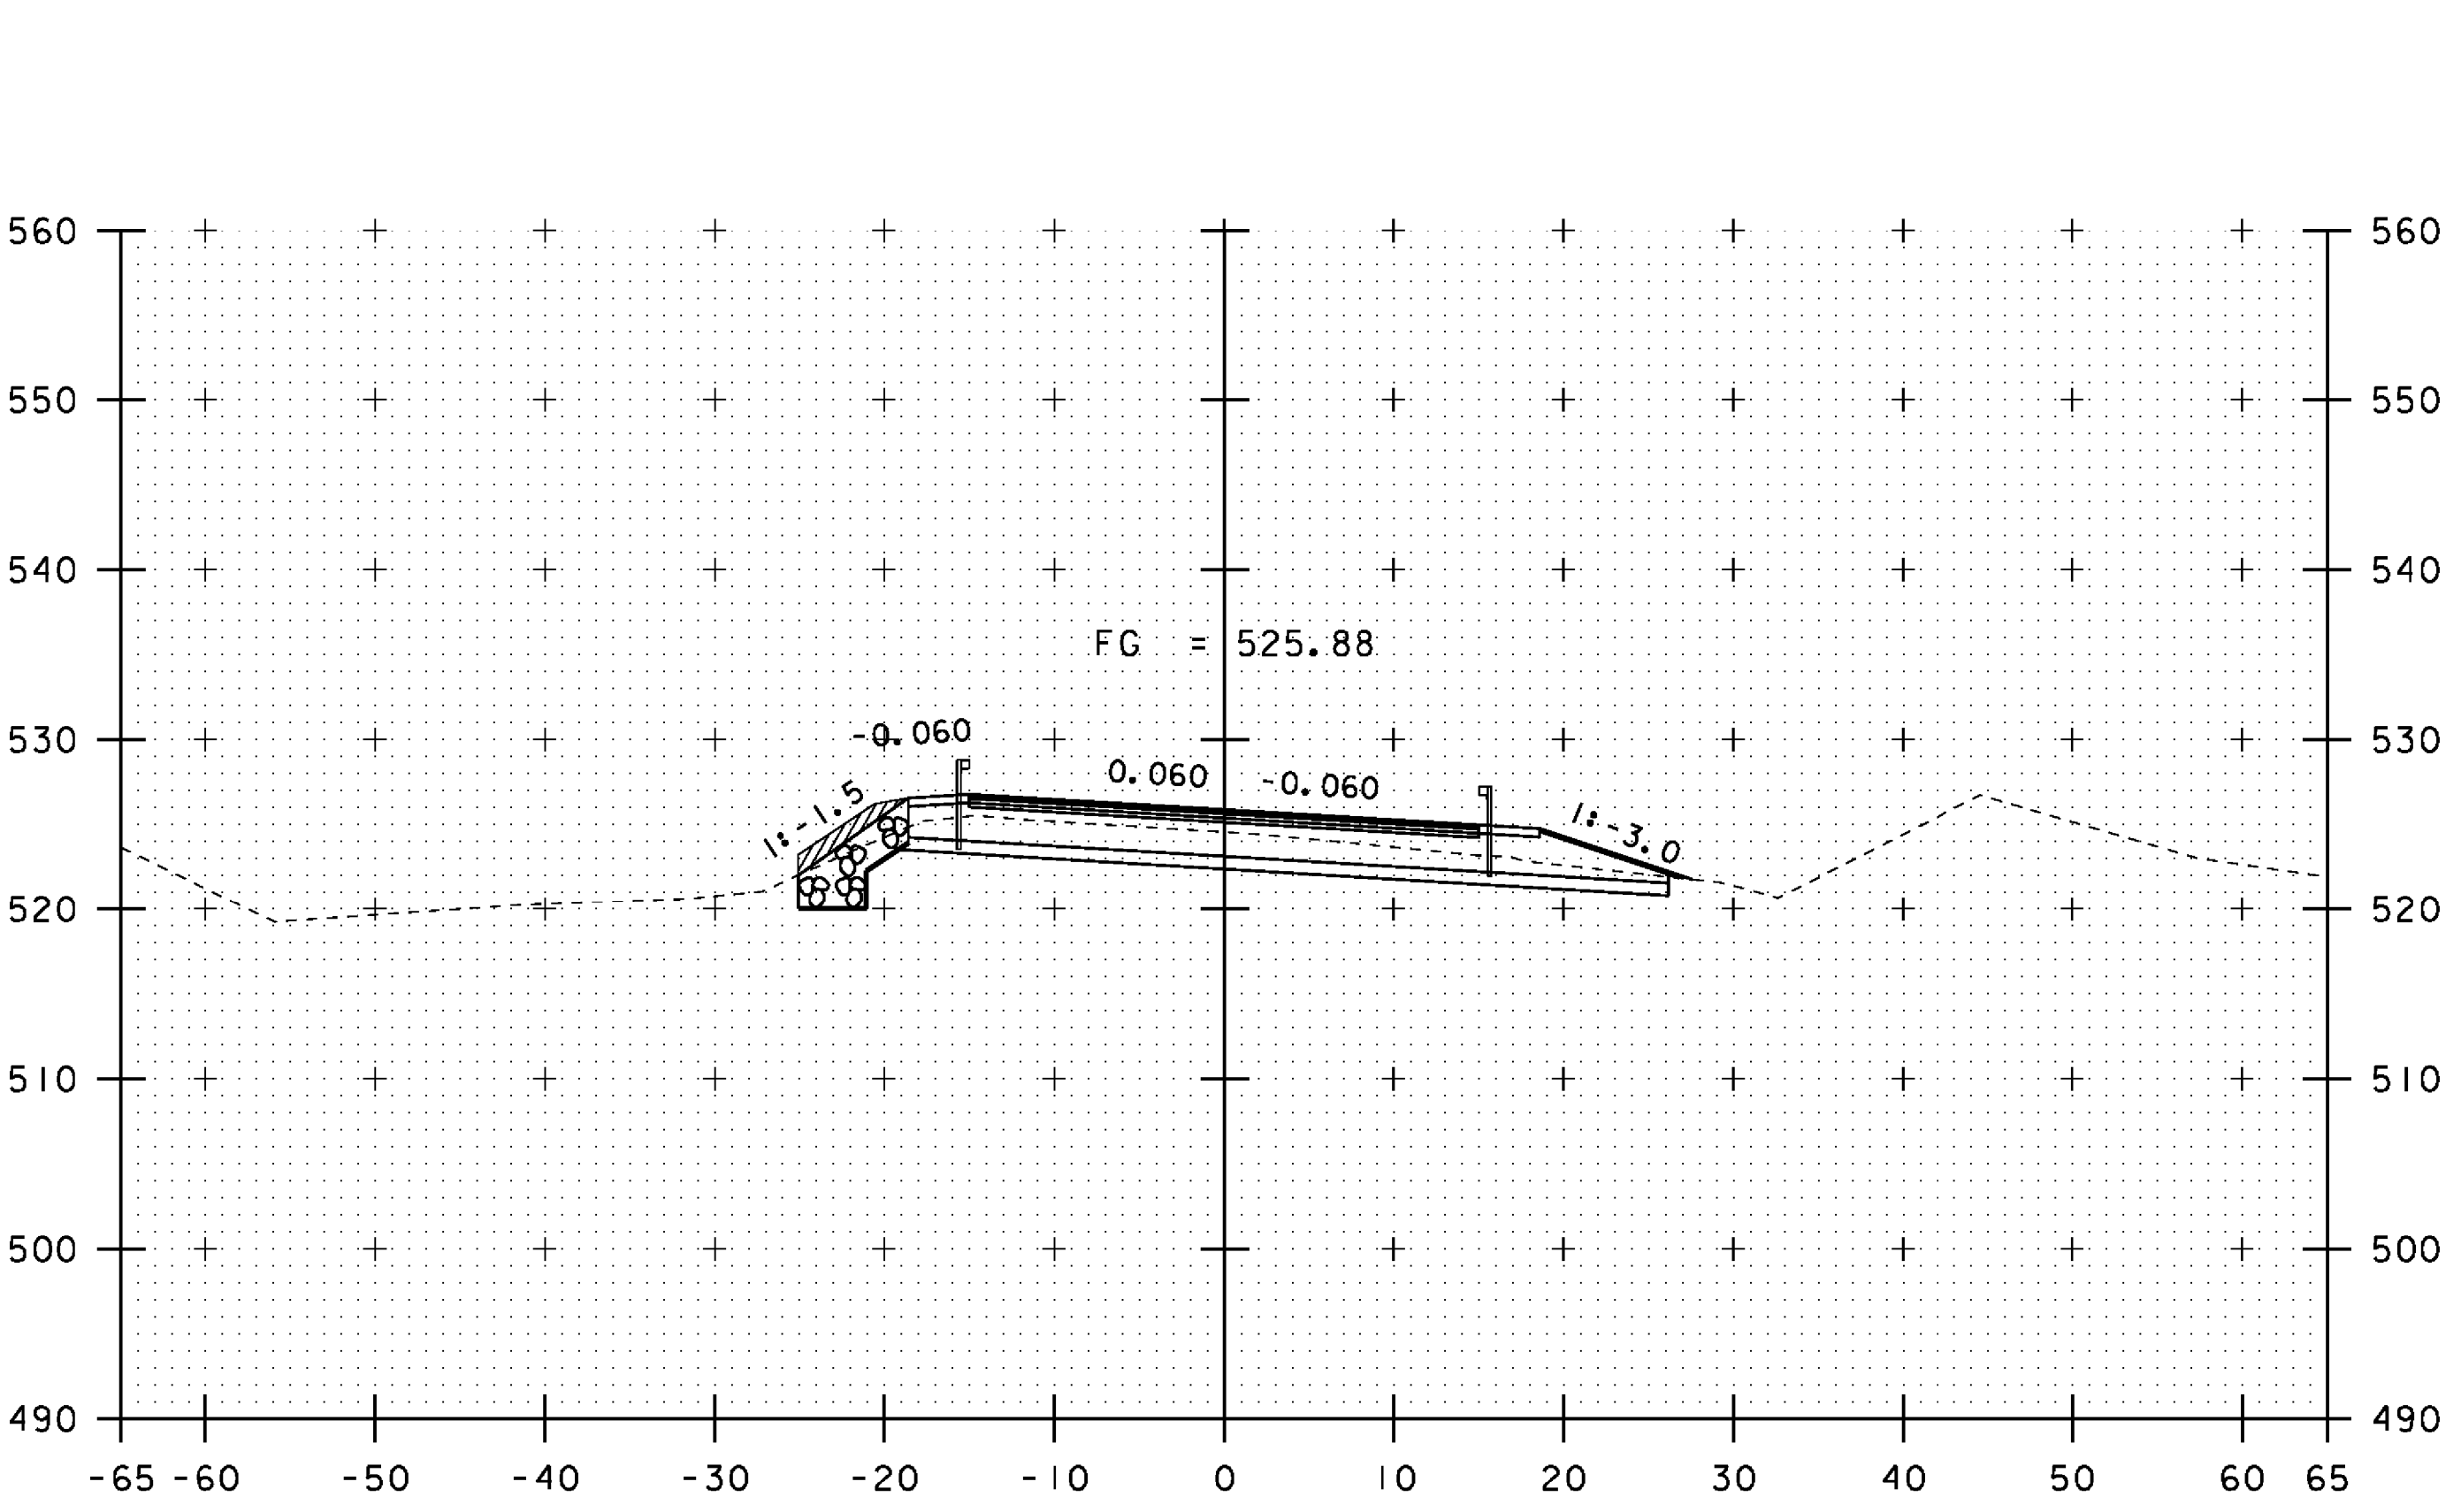

418+25

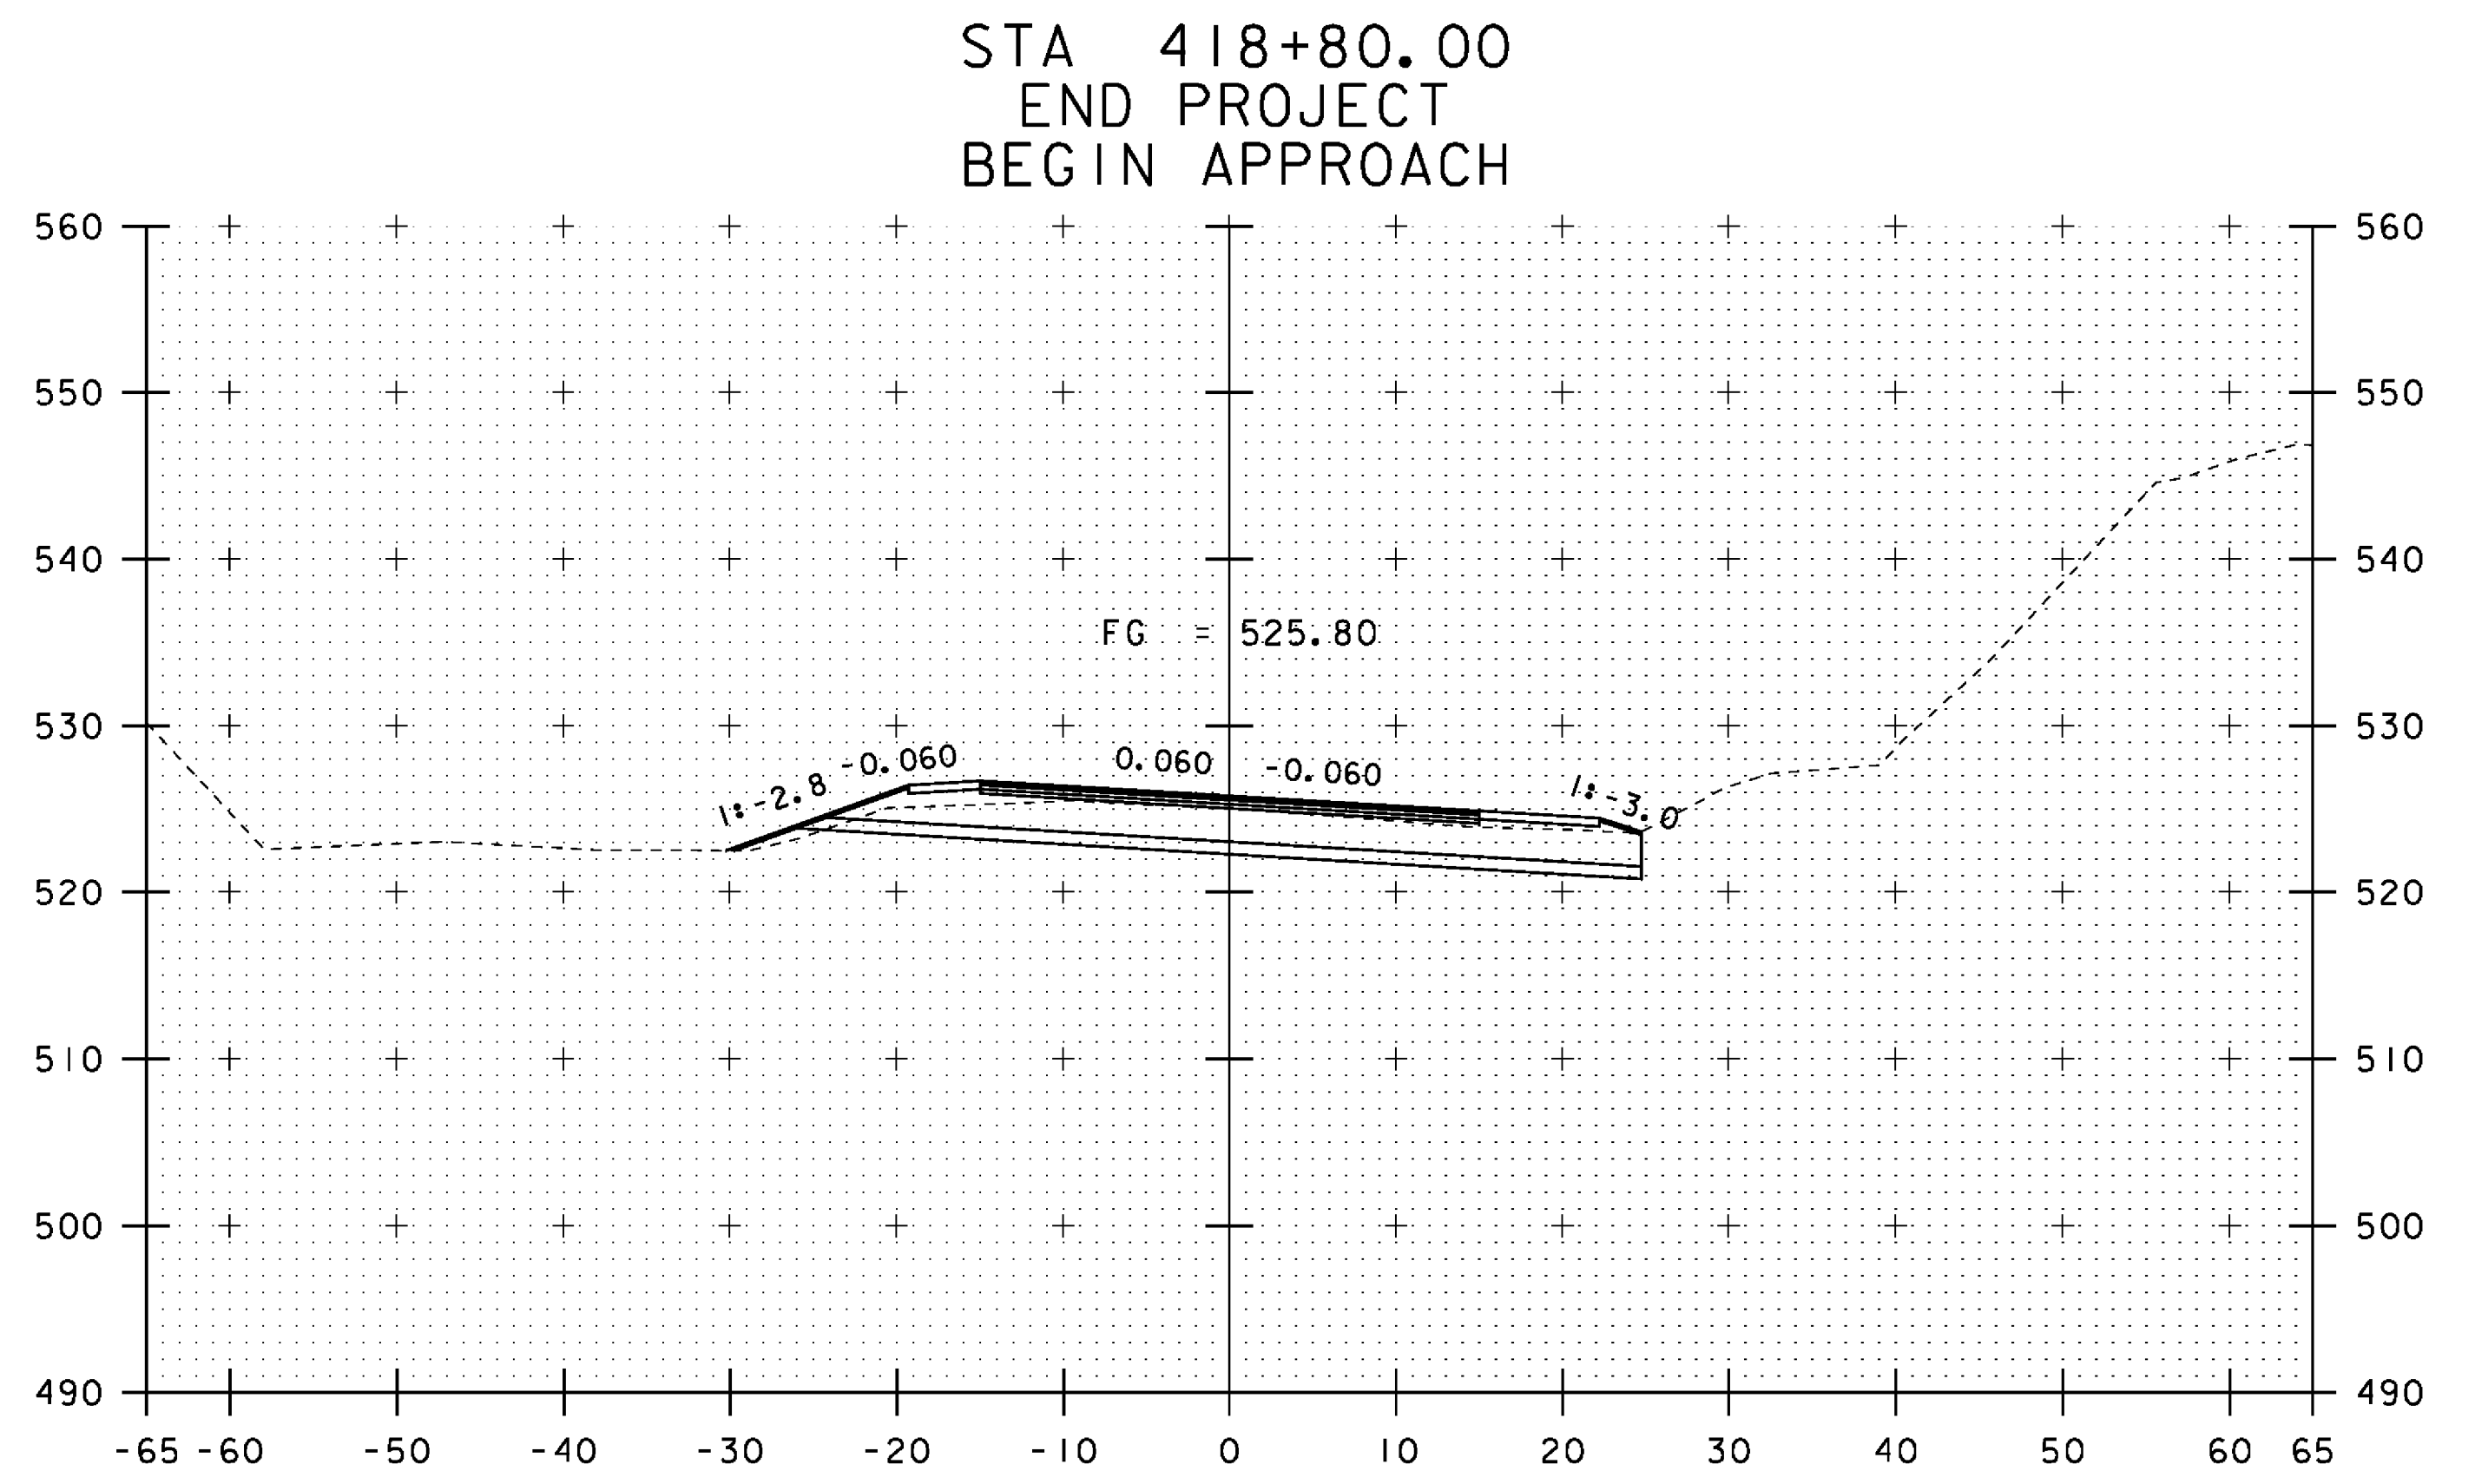


418+75

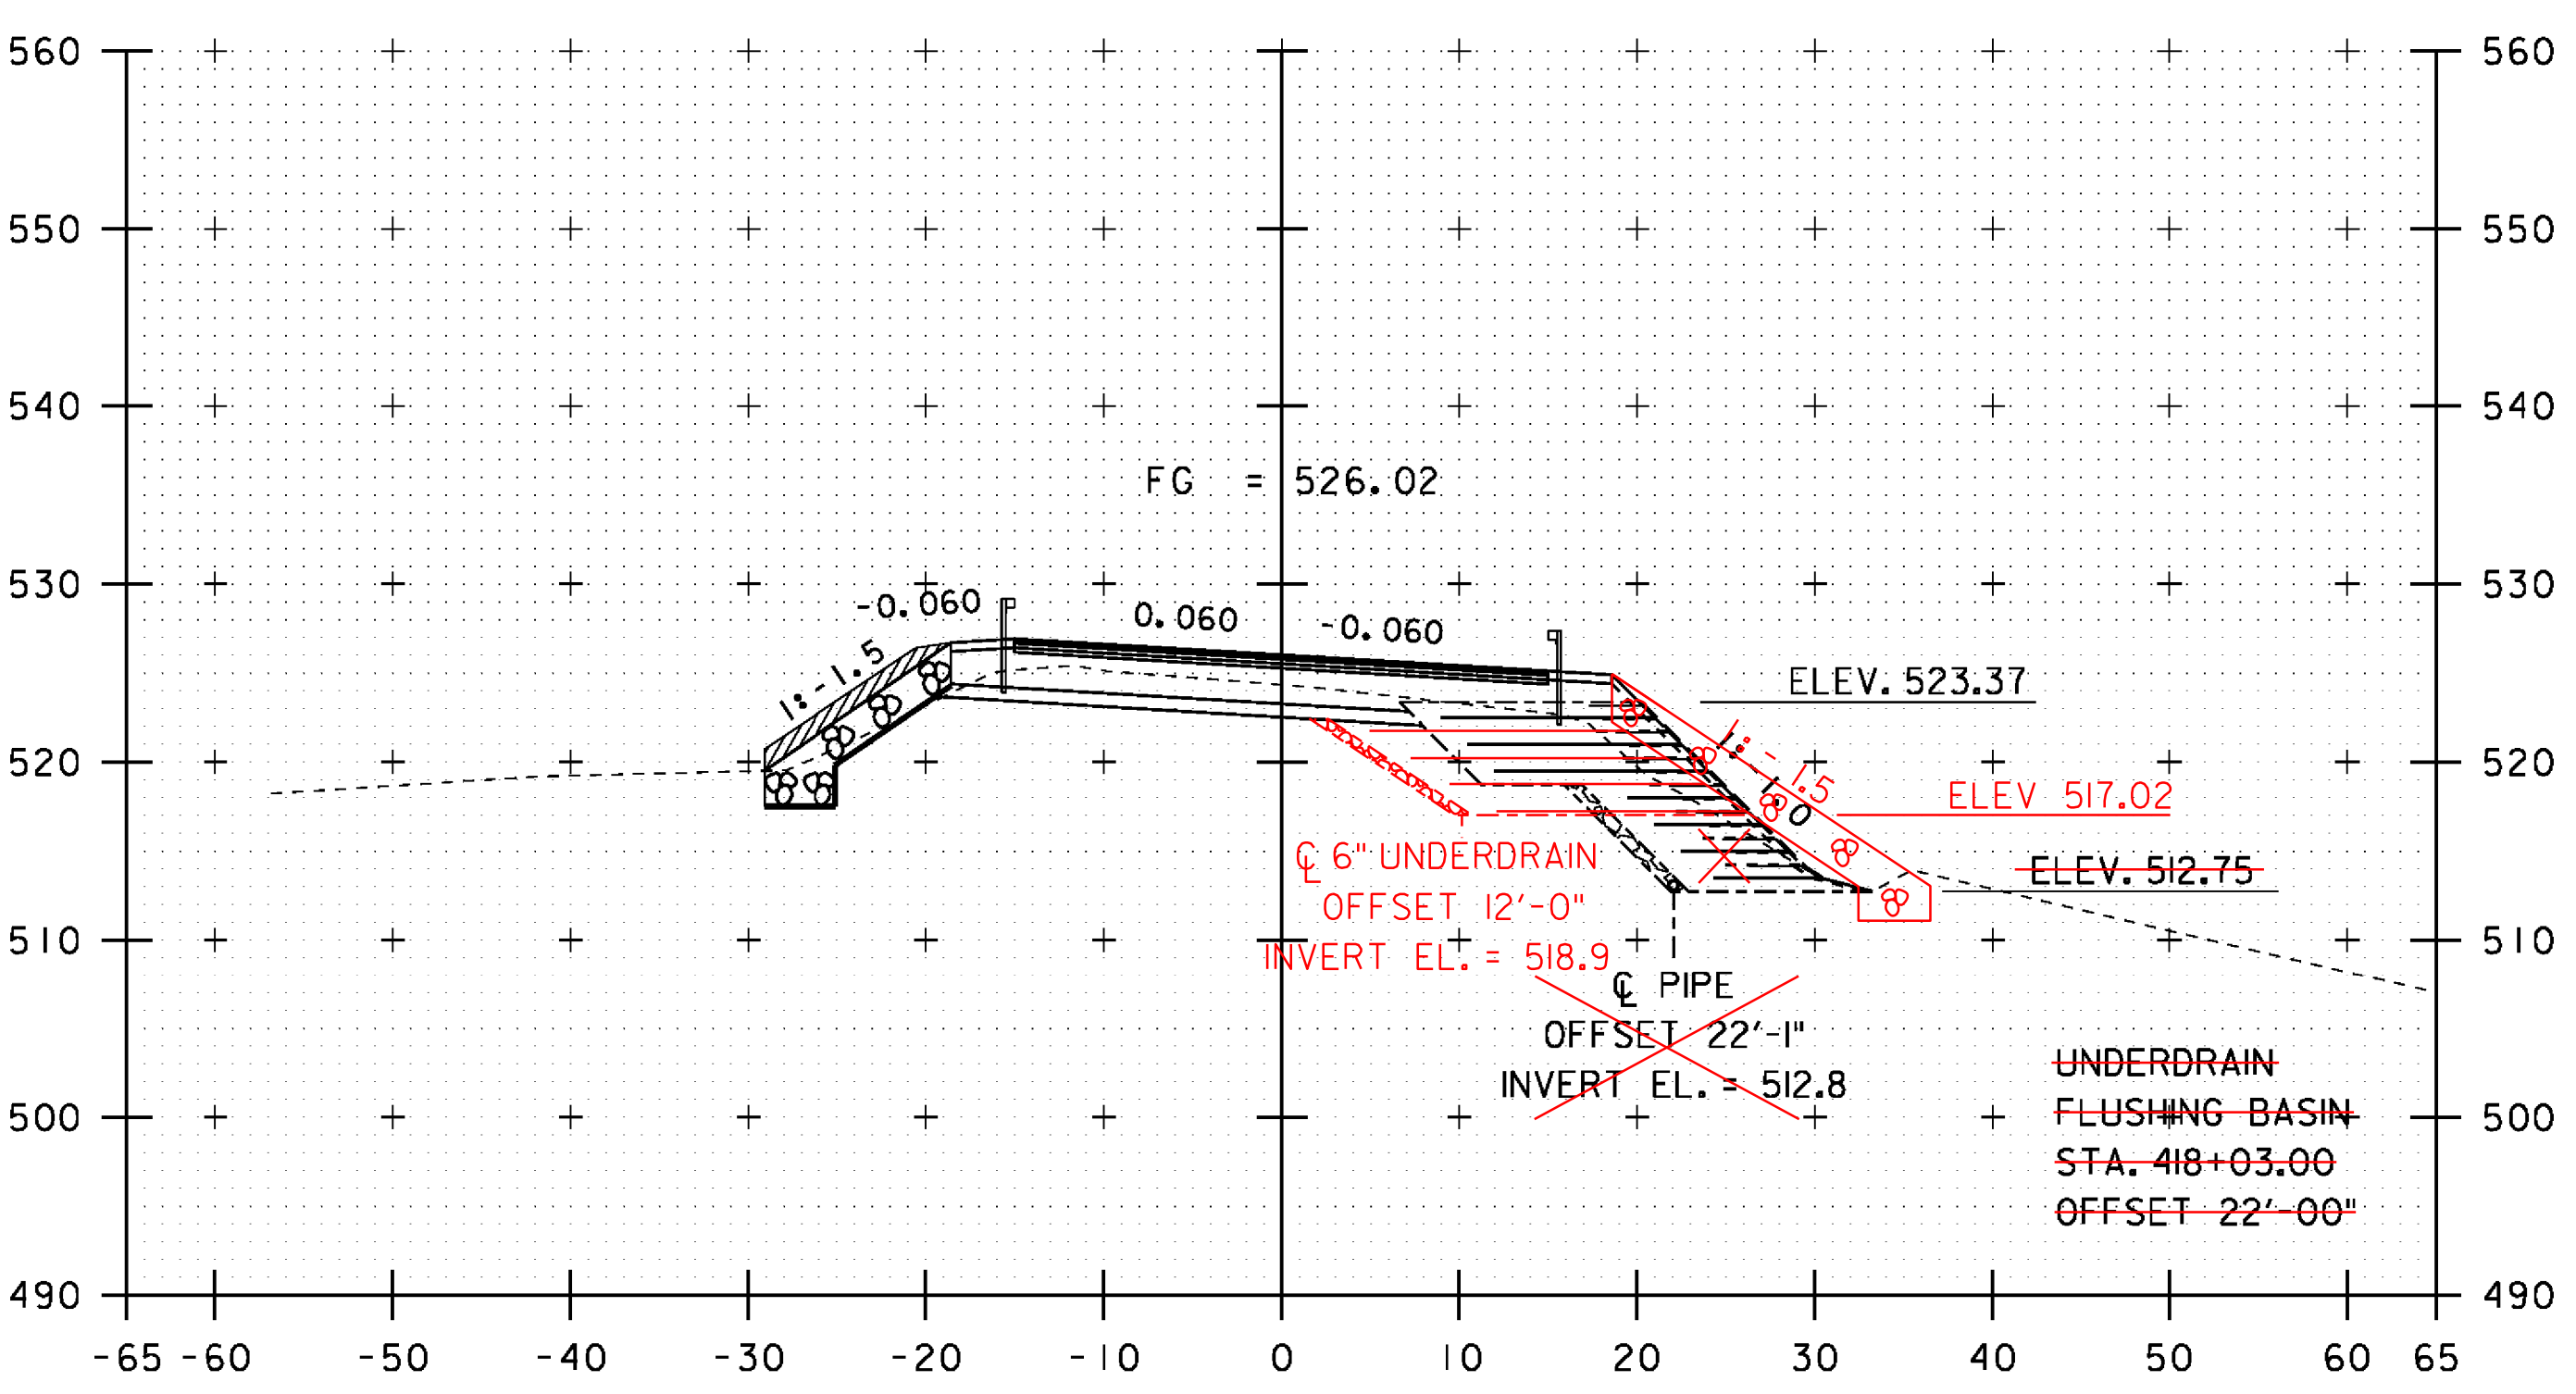


418+00

STA 418+00.00 RT.  
 END REINFORCED SOIL SLOPE  
 STONE FILL, TYPE II  
 GEOTEXTILE UNDER STONE FILL  
 GRUBBING MATERIAL

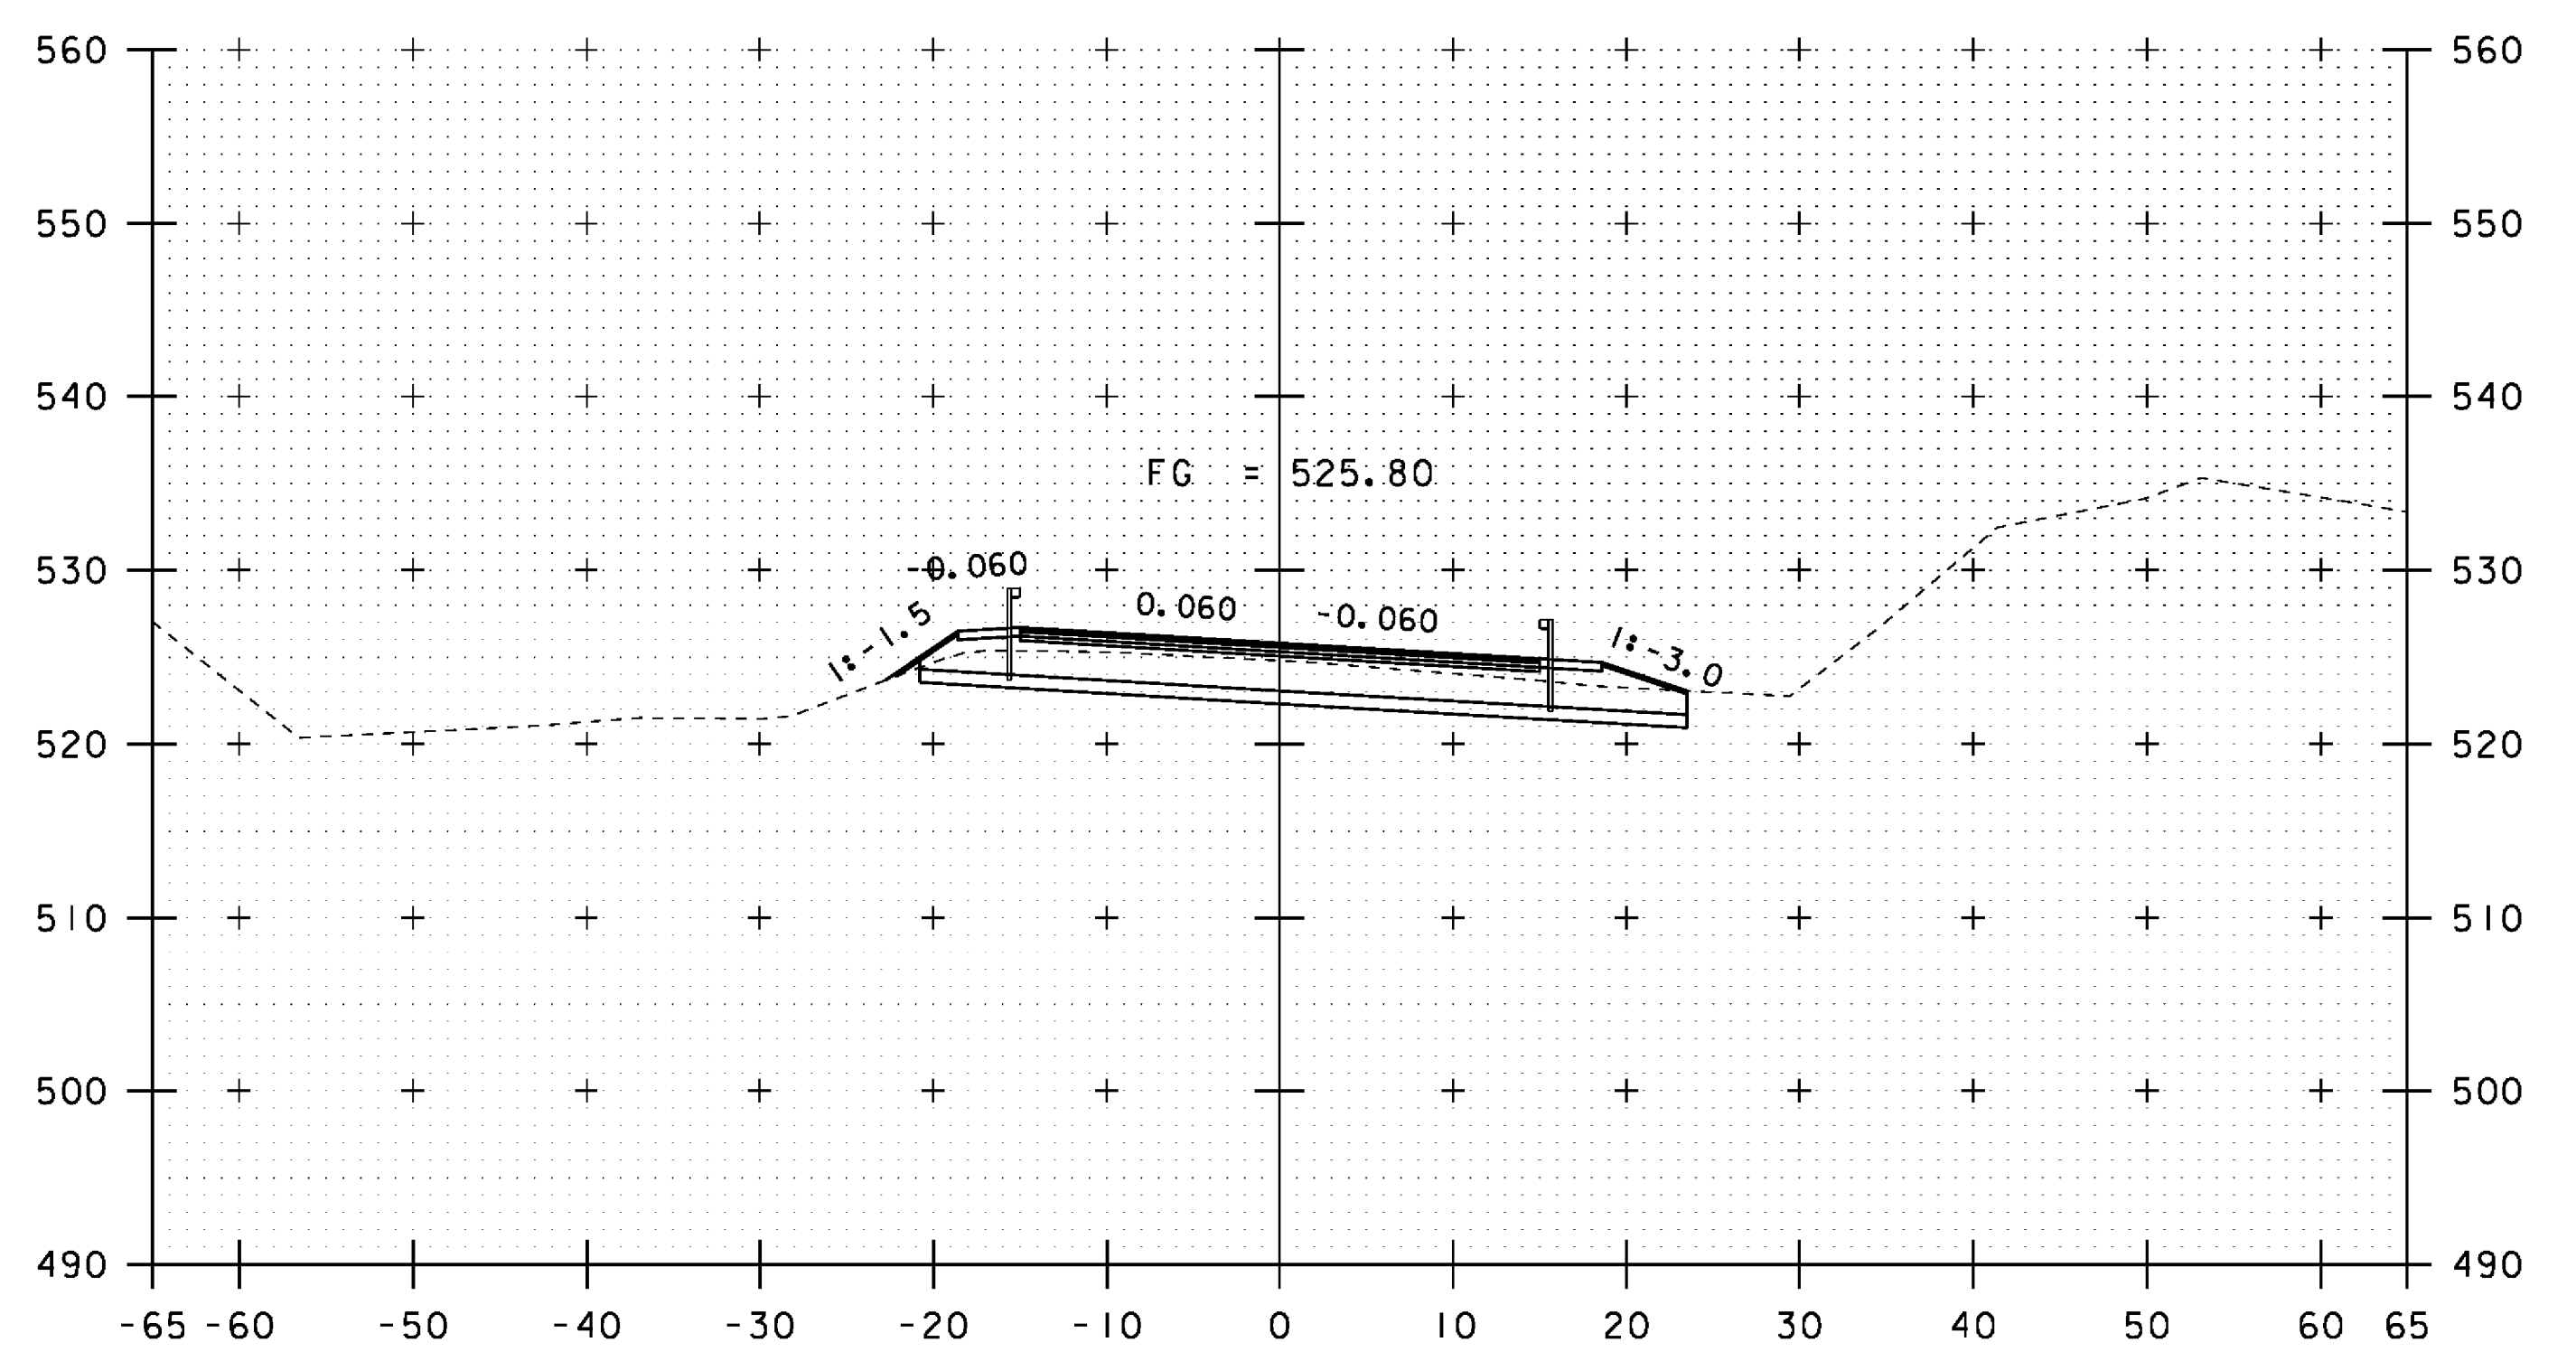


418+50


STA 418+50.00 LT.  
 END STONE FILL, TYPE II  
 GEOTEXTILE UNDER STONE FILL  
 GRUBBING MATERIAL

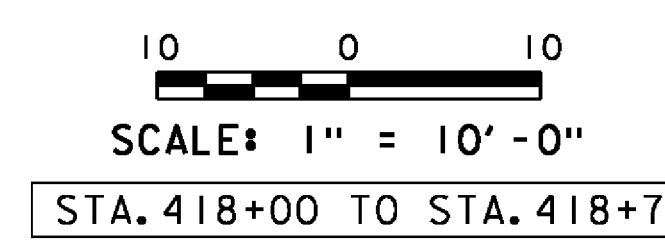


PROJECT NAME:	ROYALTON	PLOT DATE:	08-OCT-2013
PROJECT NUMBER:	BRS 0147 (13)	DRAWN BY:	STR3
FILE NAME:	\\BR.28\86e055\sl.28.dgn	CHECKED BY:	C. CARLSON
PROJECT LEADER:	C. CARLSON	SHEET	143 OF 186
DESIGNED BY:	D. PETERSON		
BRIDGE 28 VT 14 CROSS SECTIONS (7)			

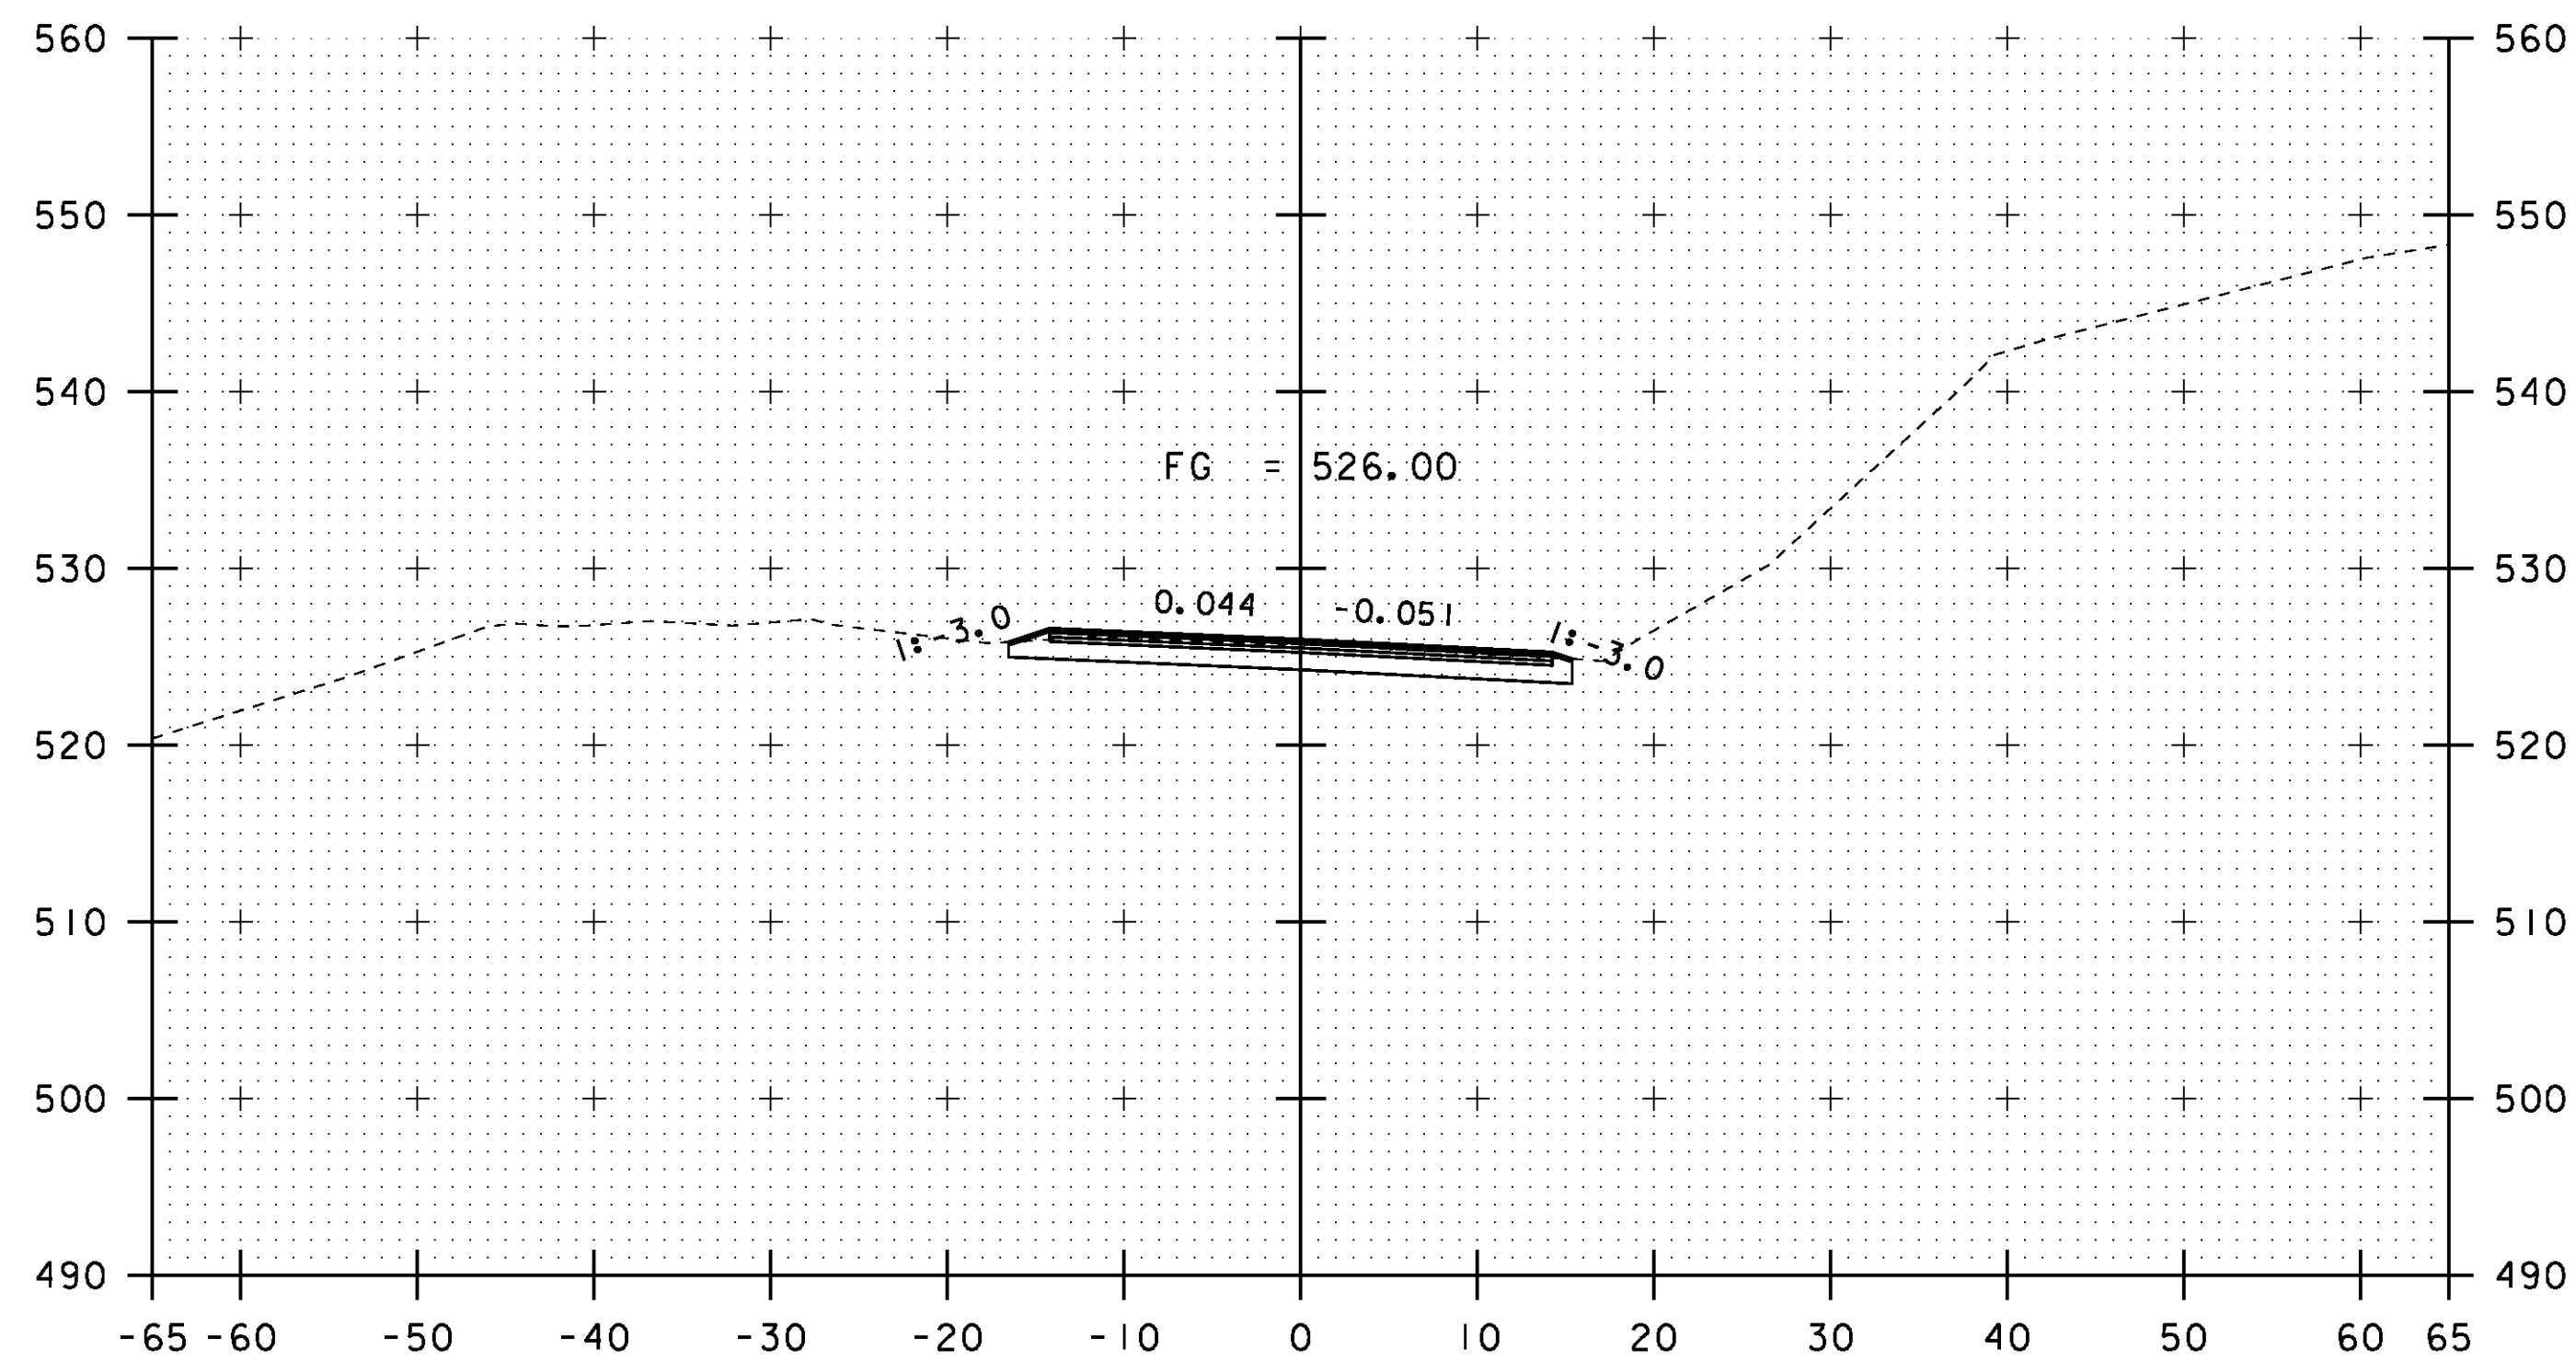


419+25

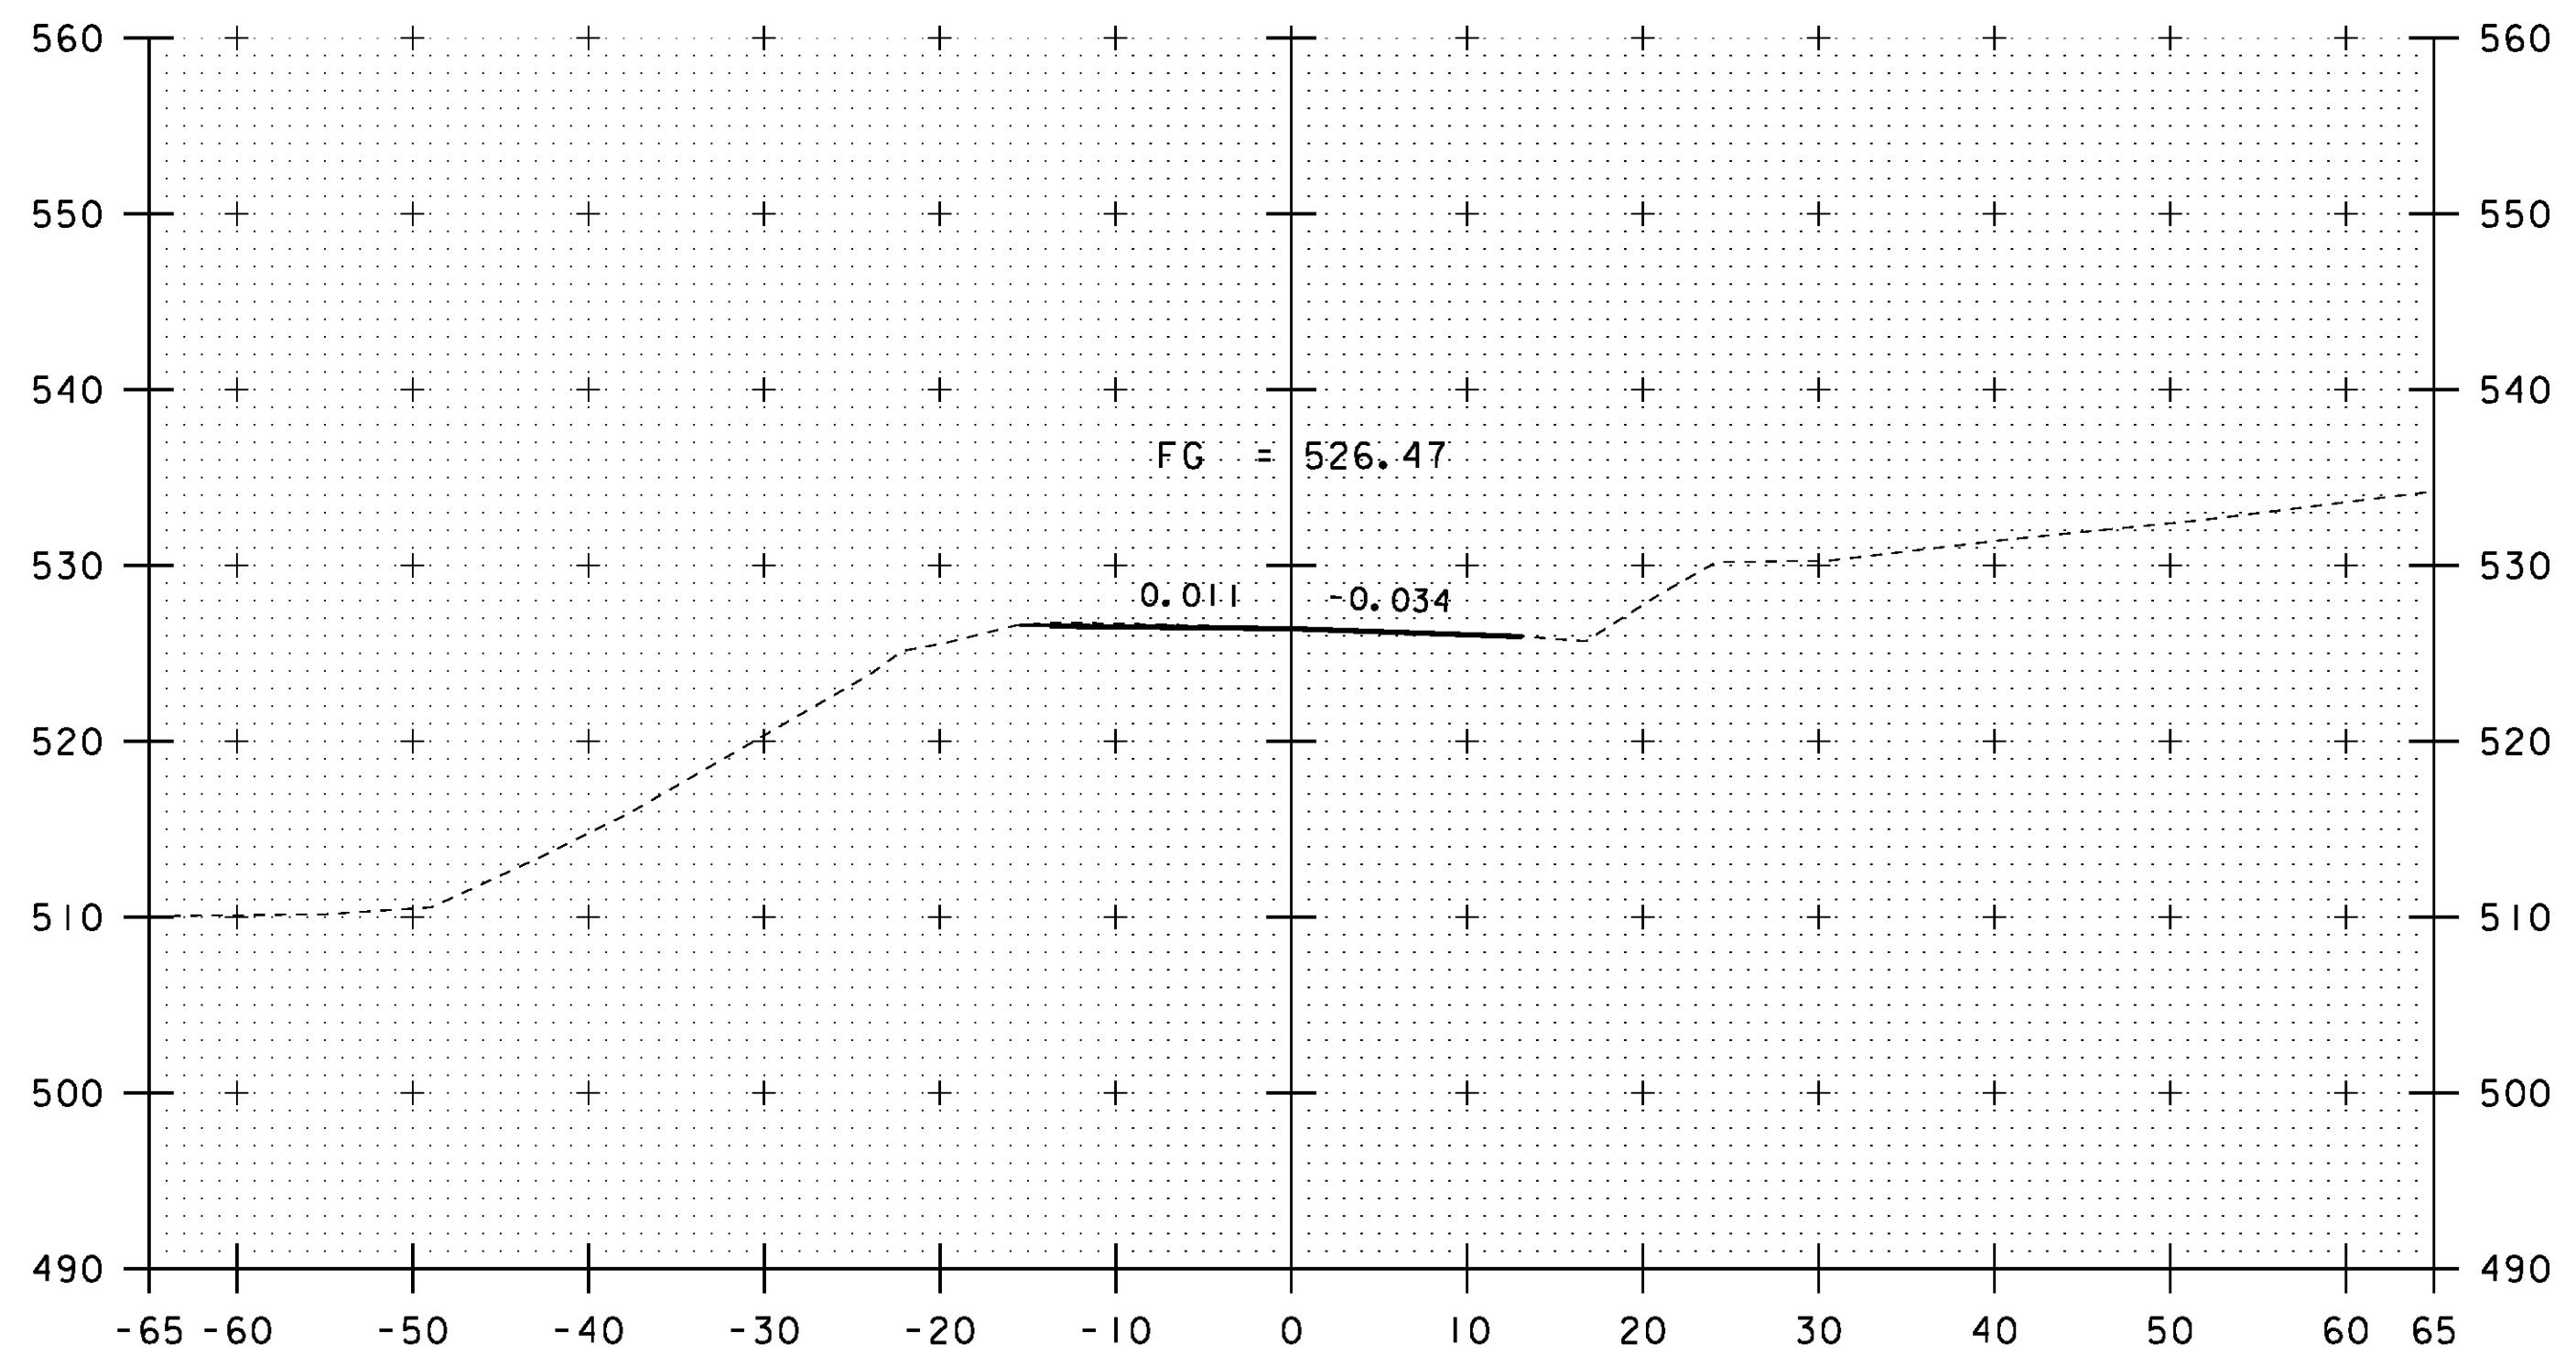


419+75

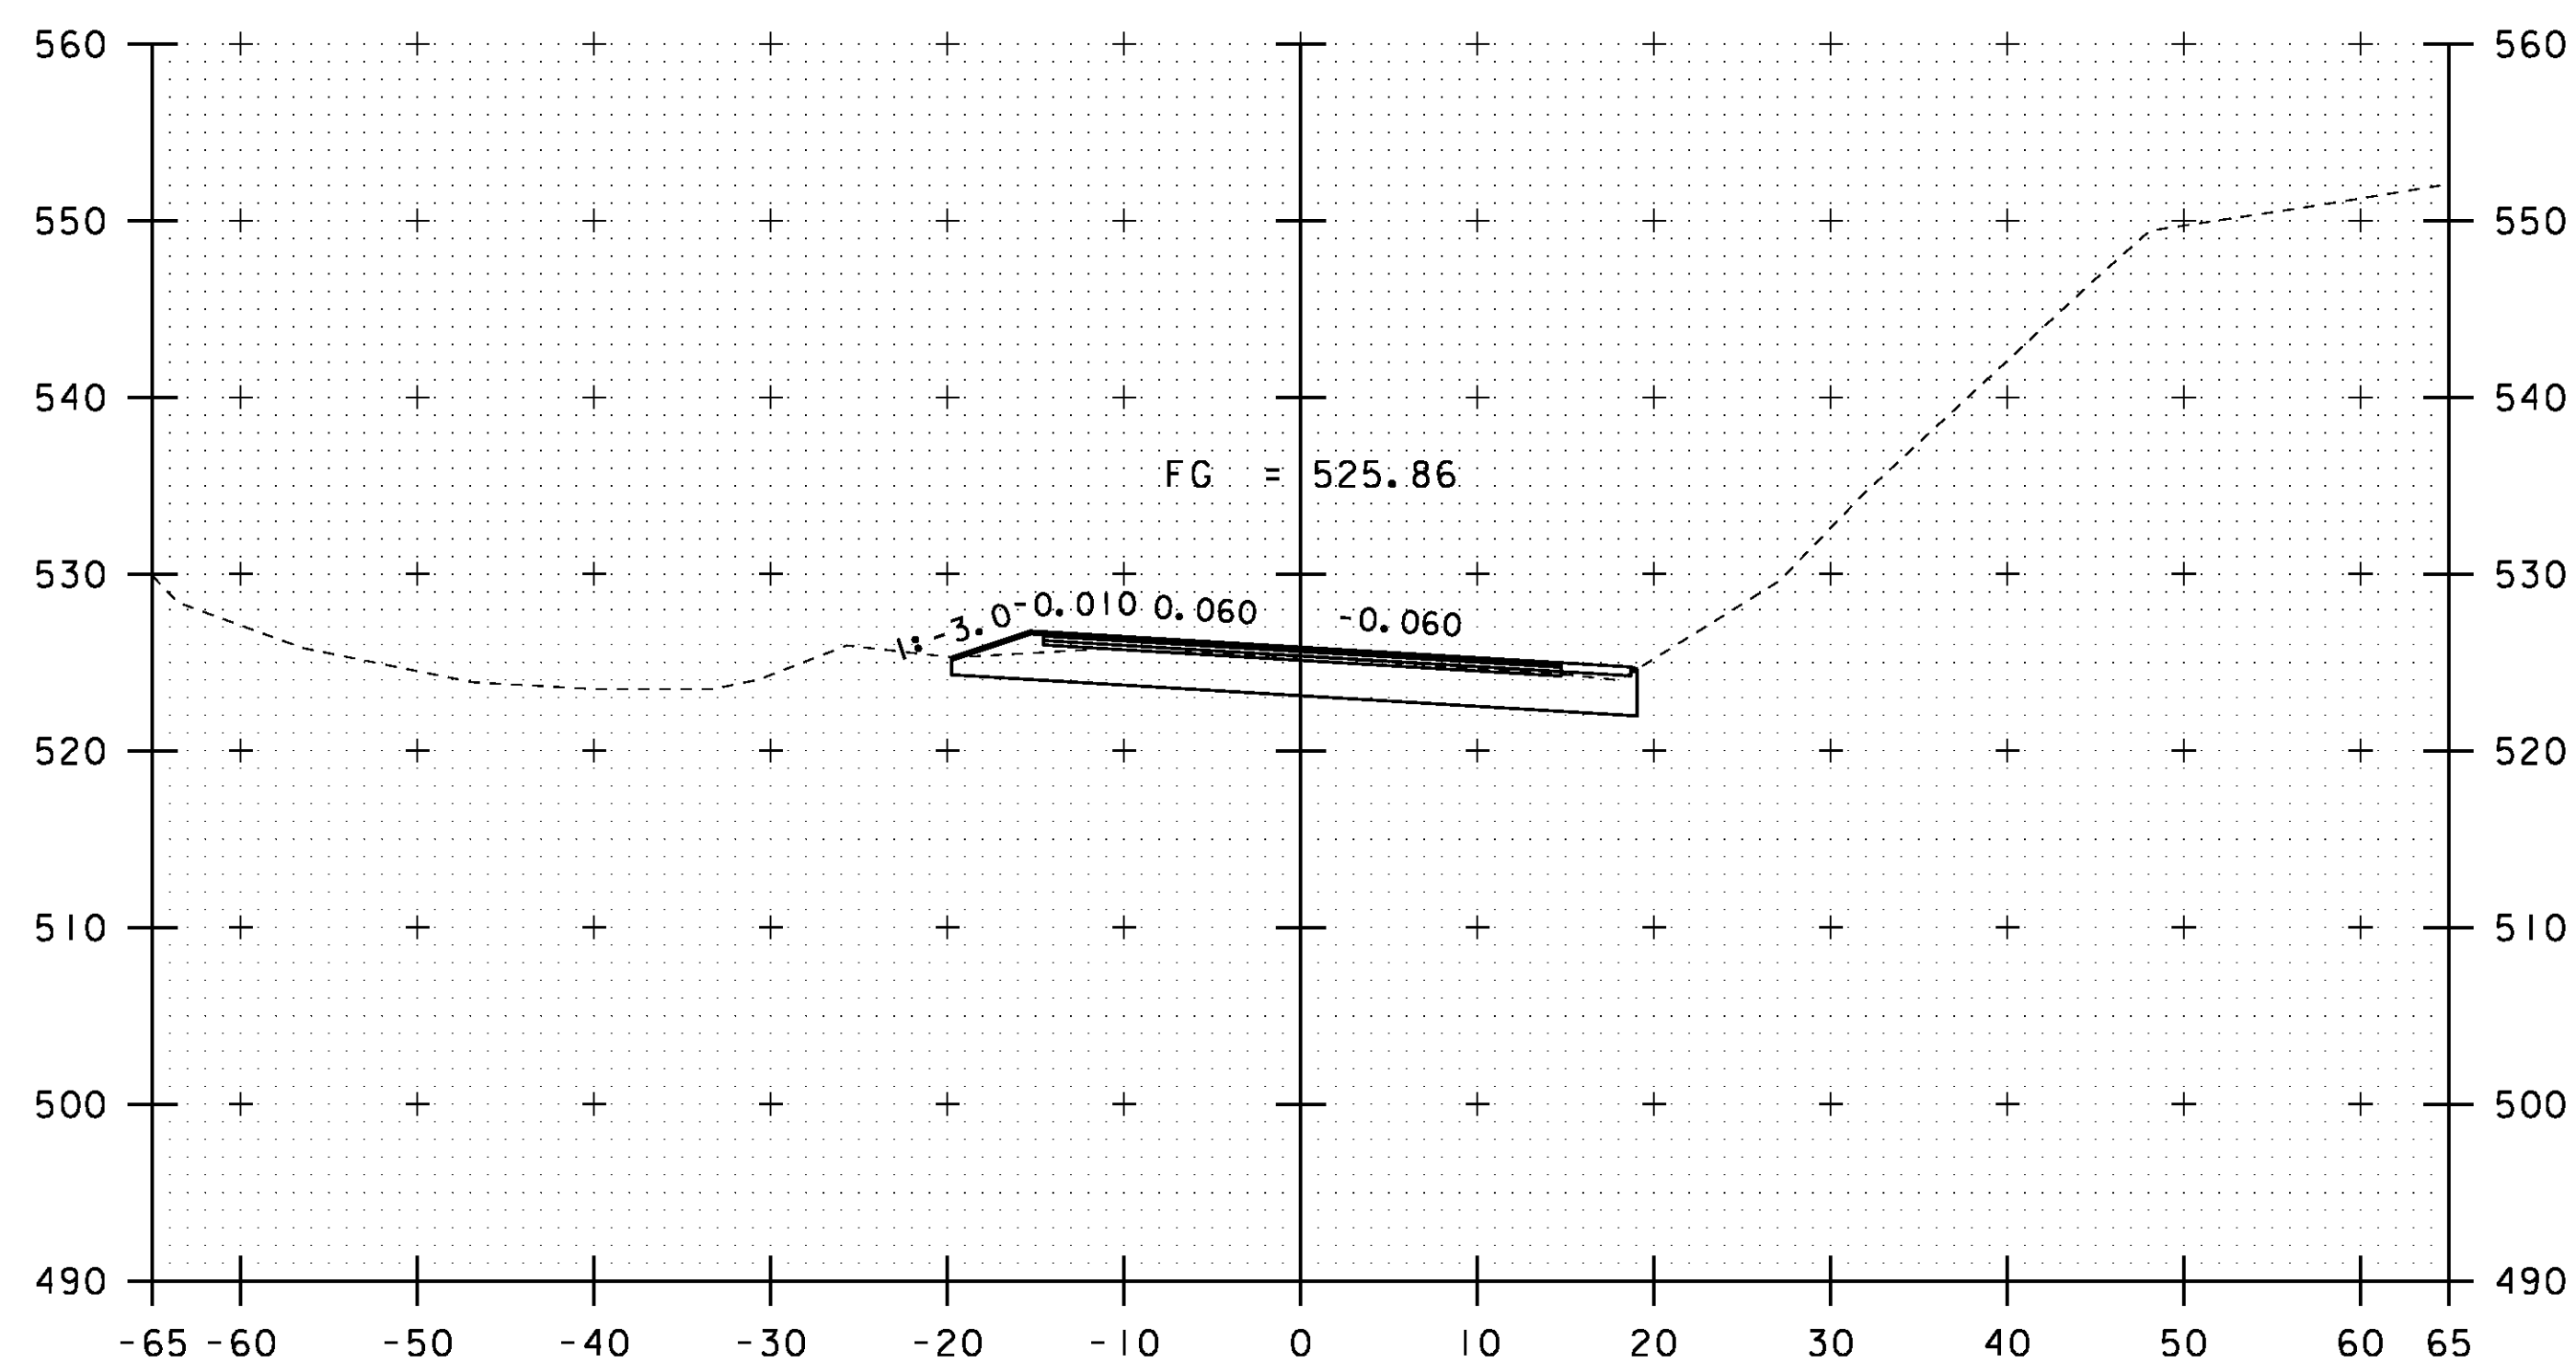

419+00

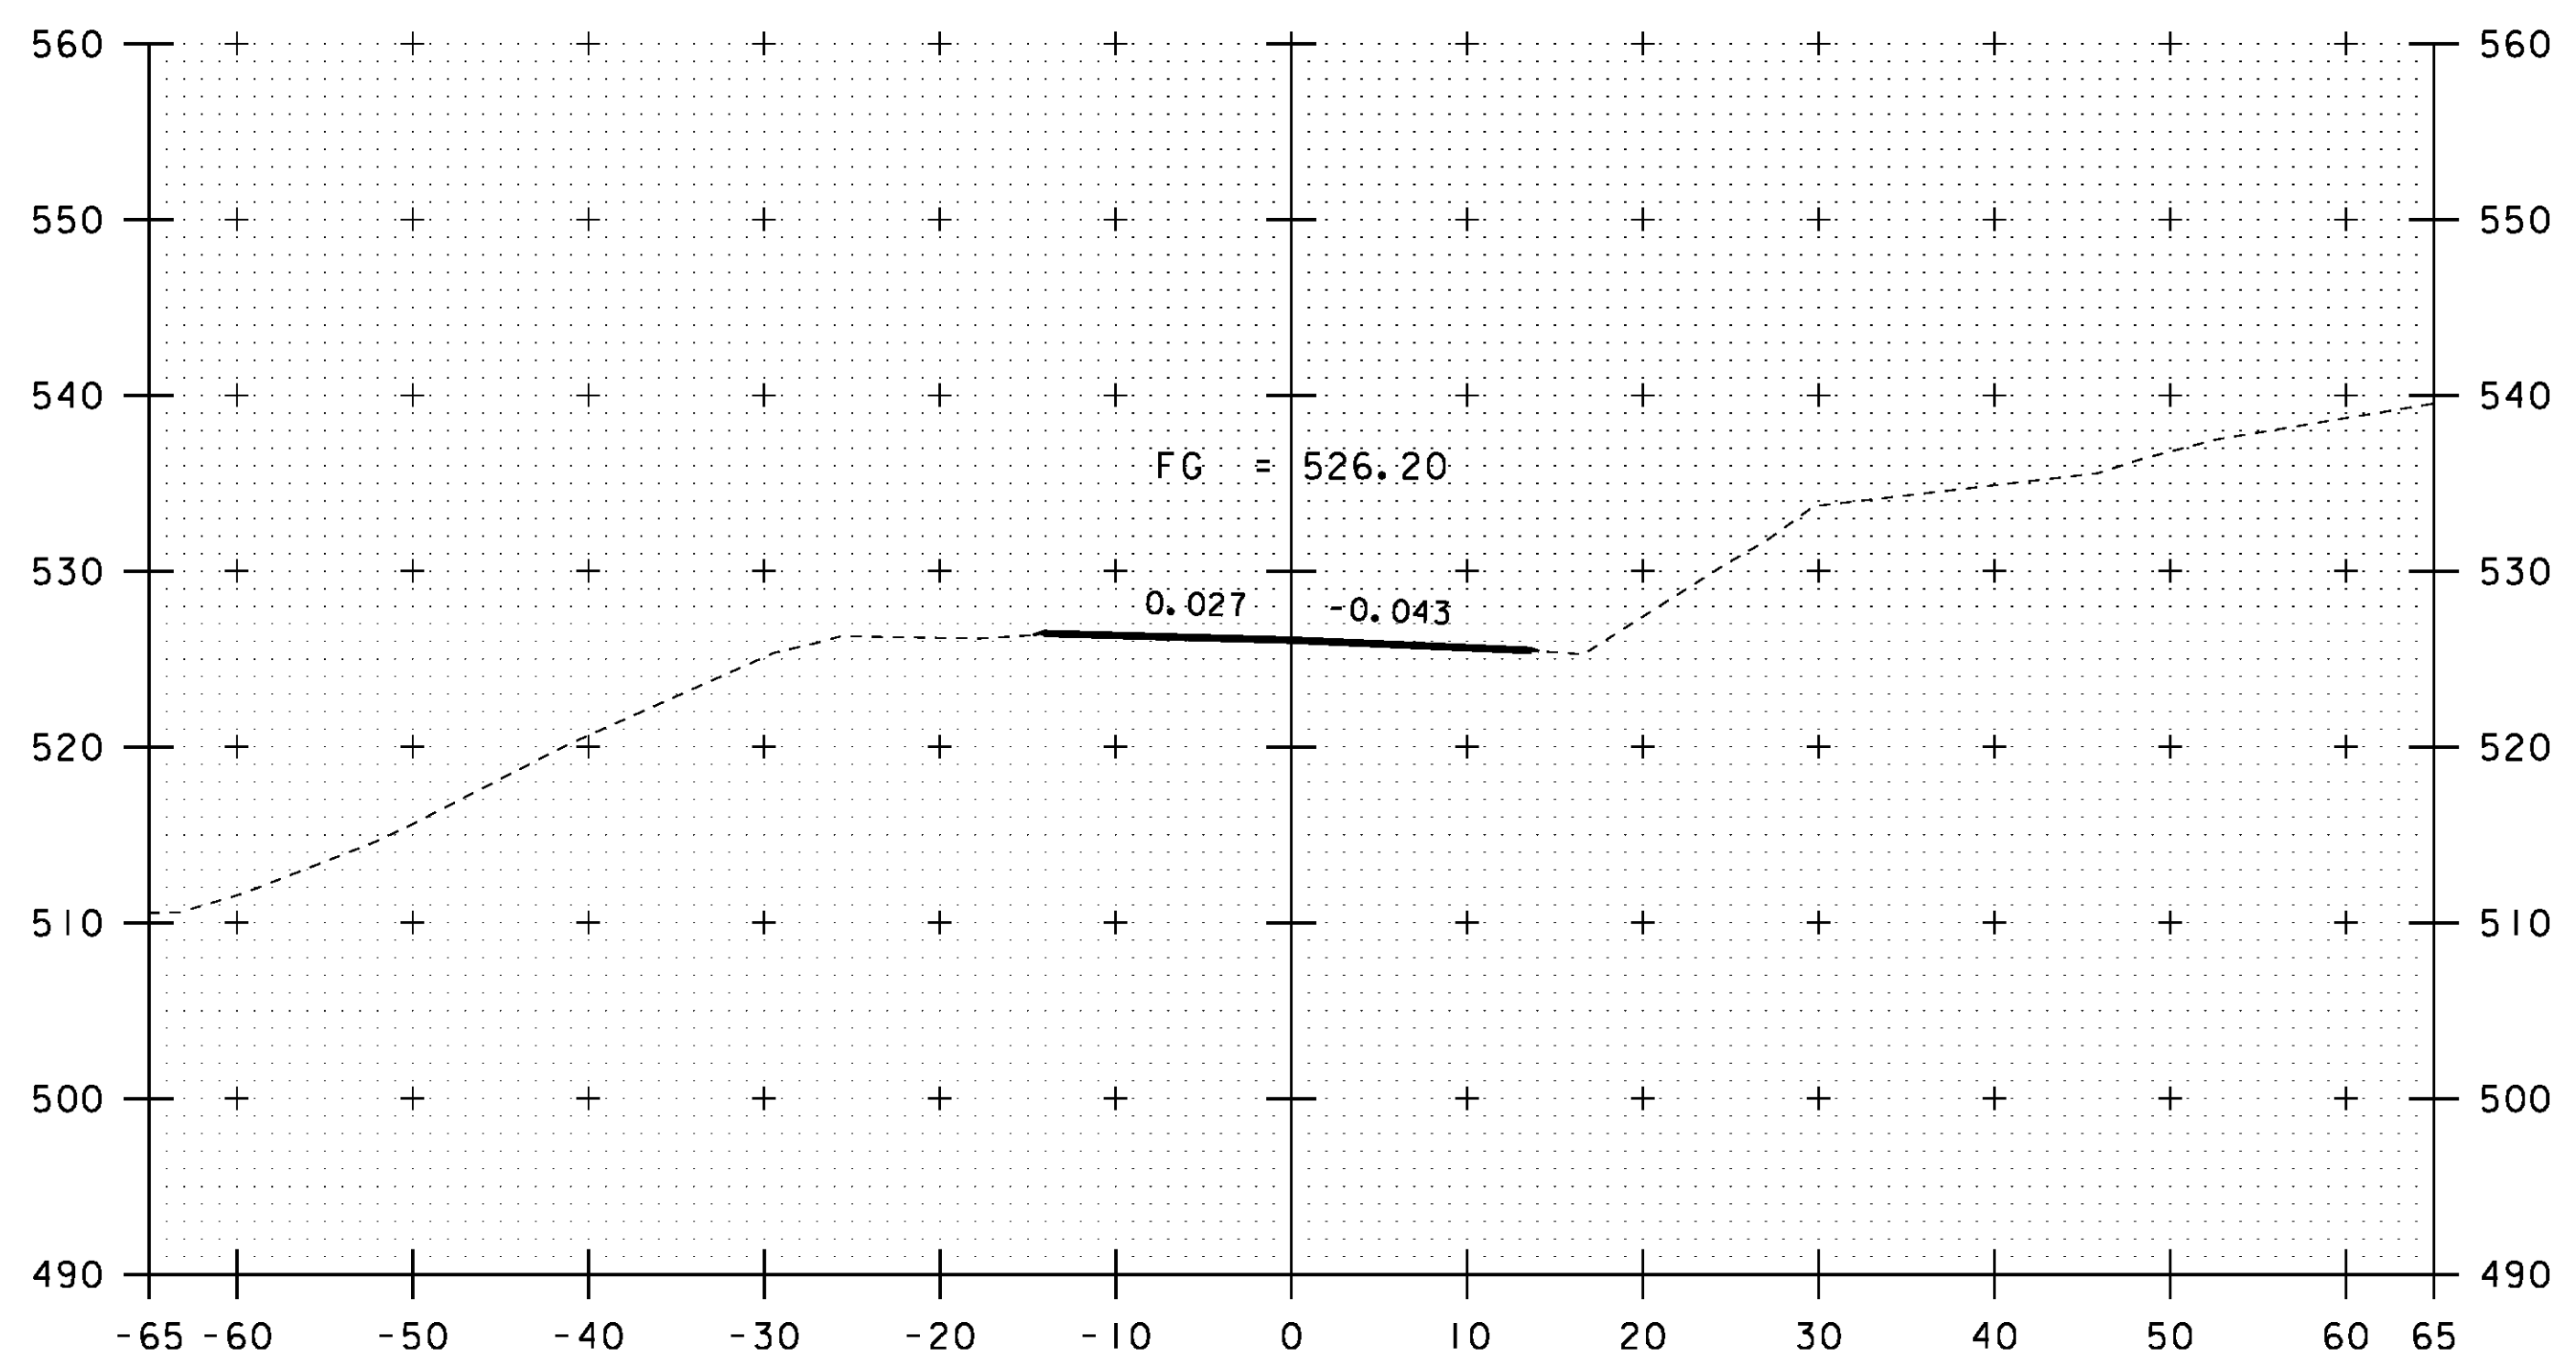


419+50

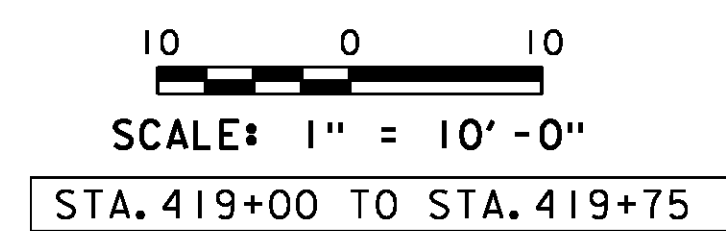


PROJECT NAME:	ROYALTON	FILE NAME:	\BR_28\s86e055xsl_28.dgn	PLOT DATE:	08-OCT-2013
PROJECT NUMBER:	BRS 0147 (13)	PROJECT LEADER:	C. CARLSON	DRAWN BY:	STR3
		DESIGNED BY:	D. PETERSON	CHECKED BY:	C. CARLSON
		BRIDGE 28 VT 14 CROSS SECTIONS (8)		SHEET	144 OF 186




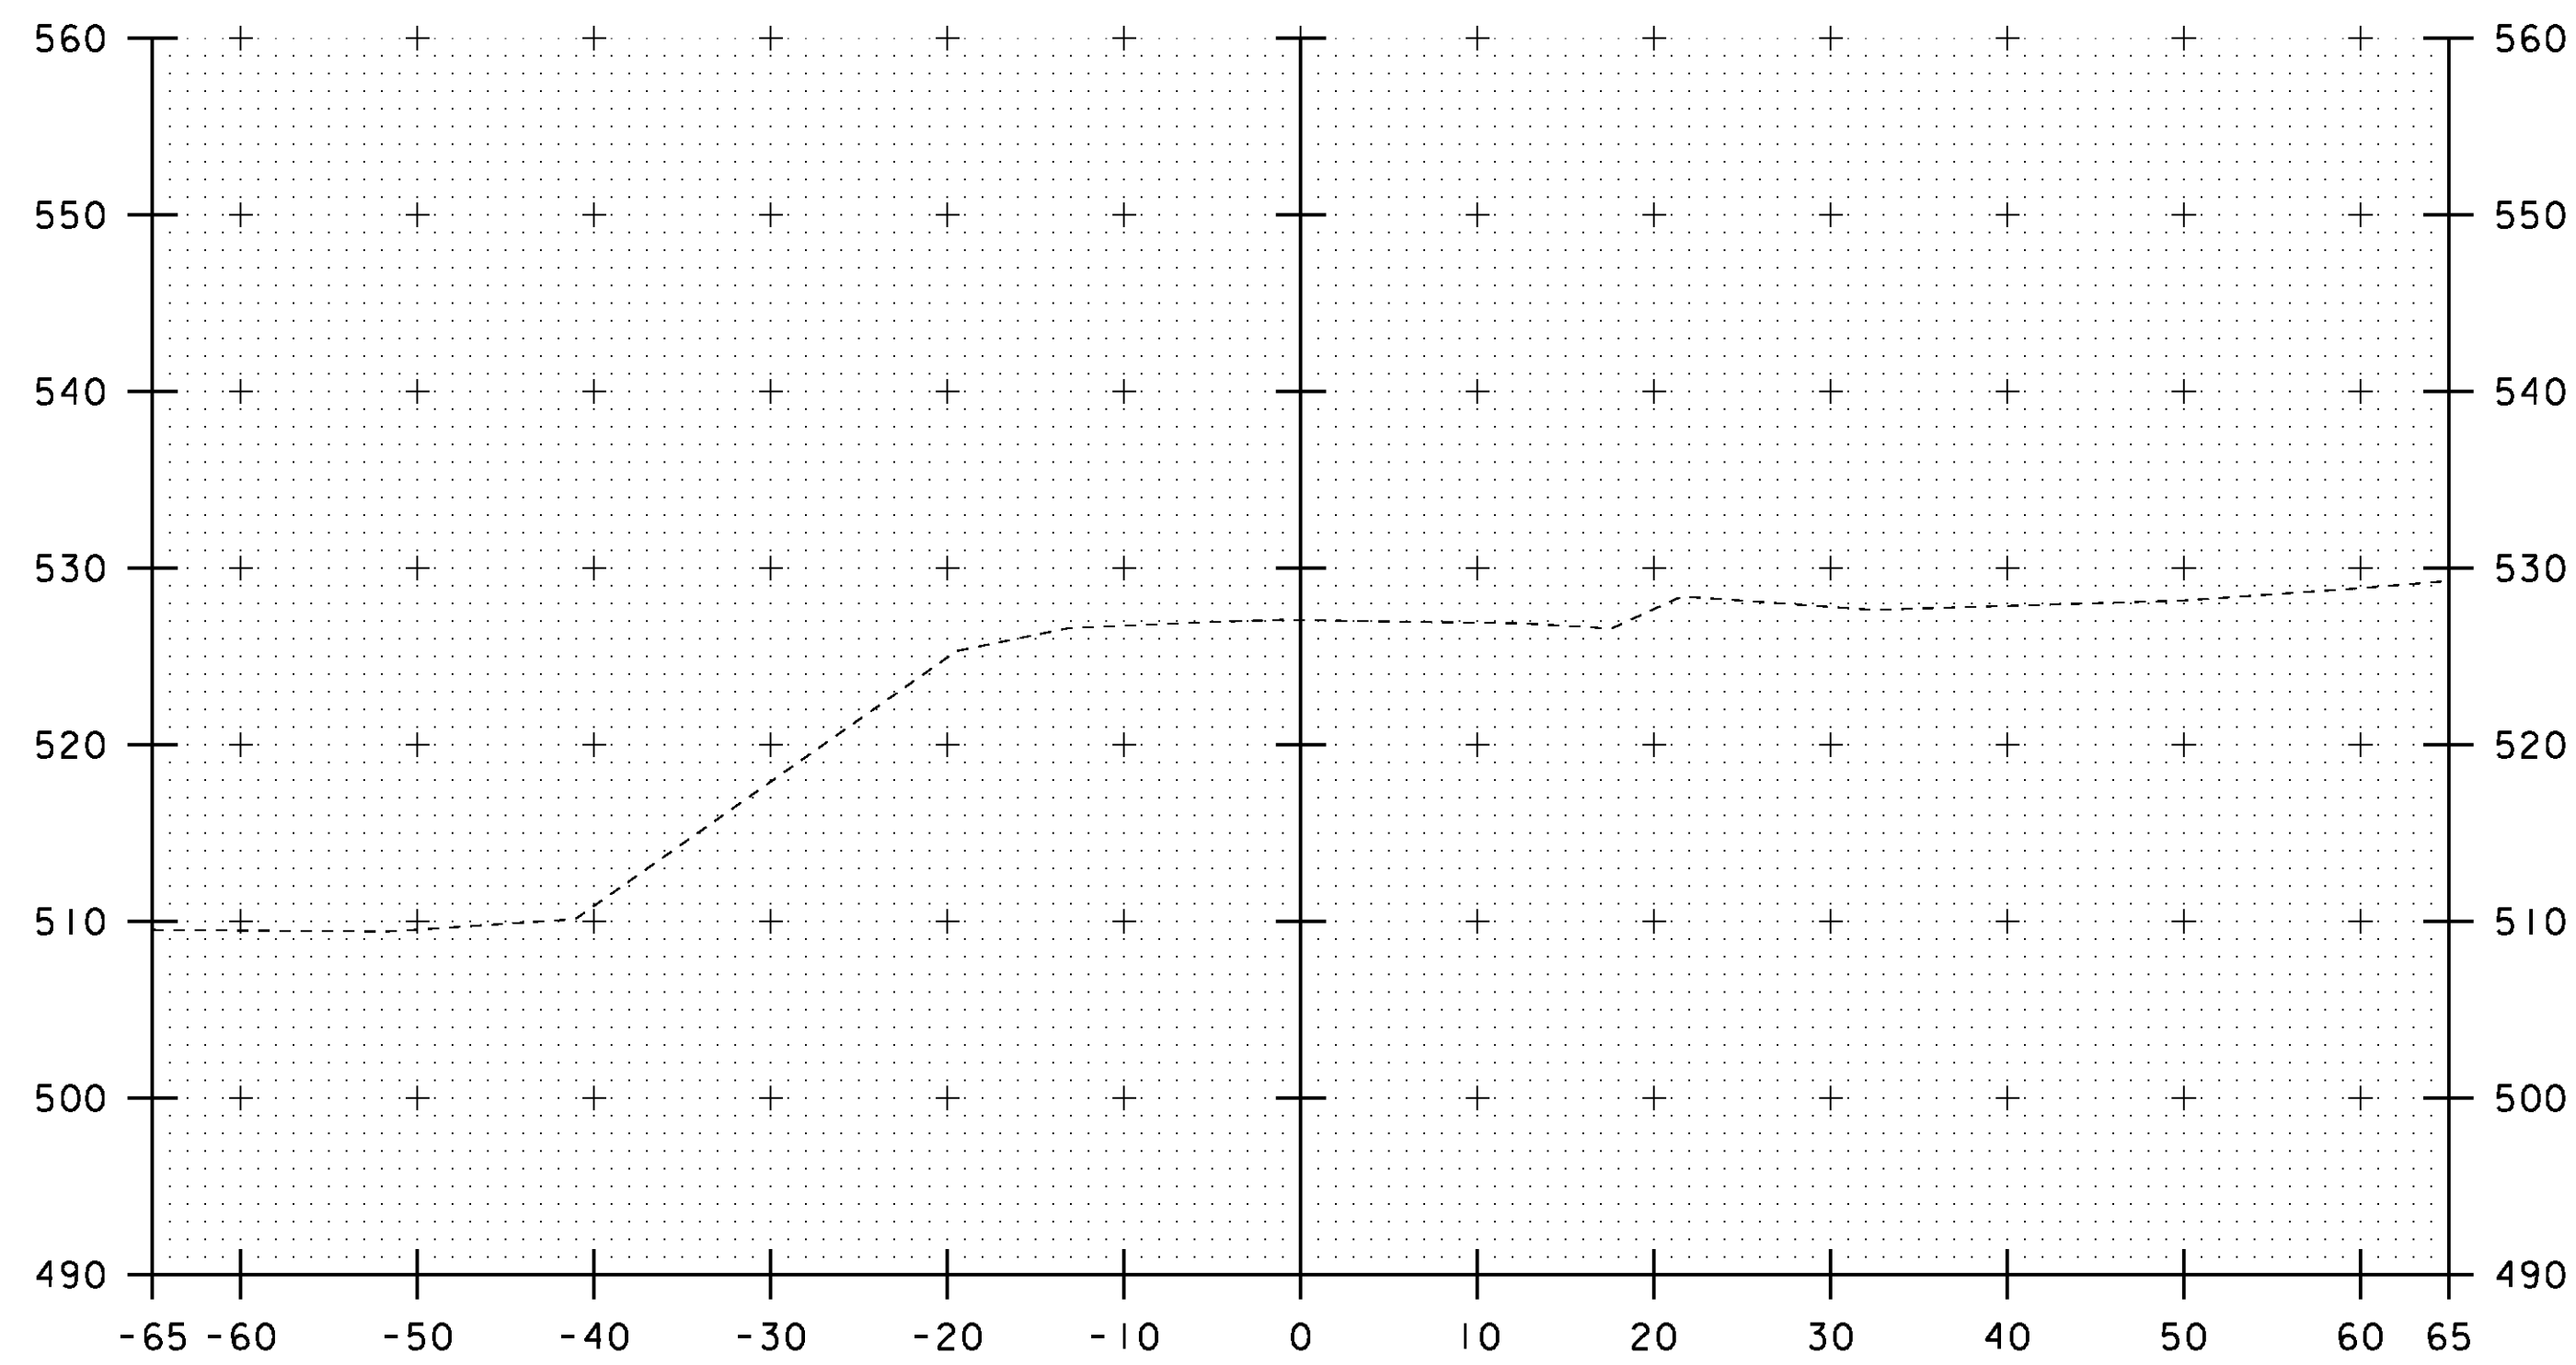


420+25

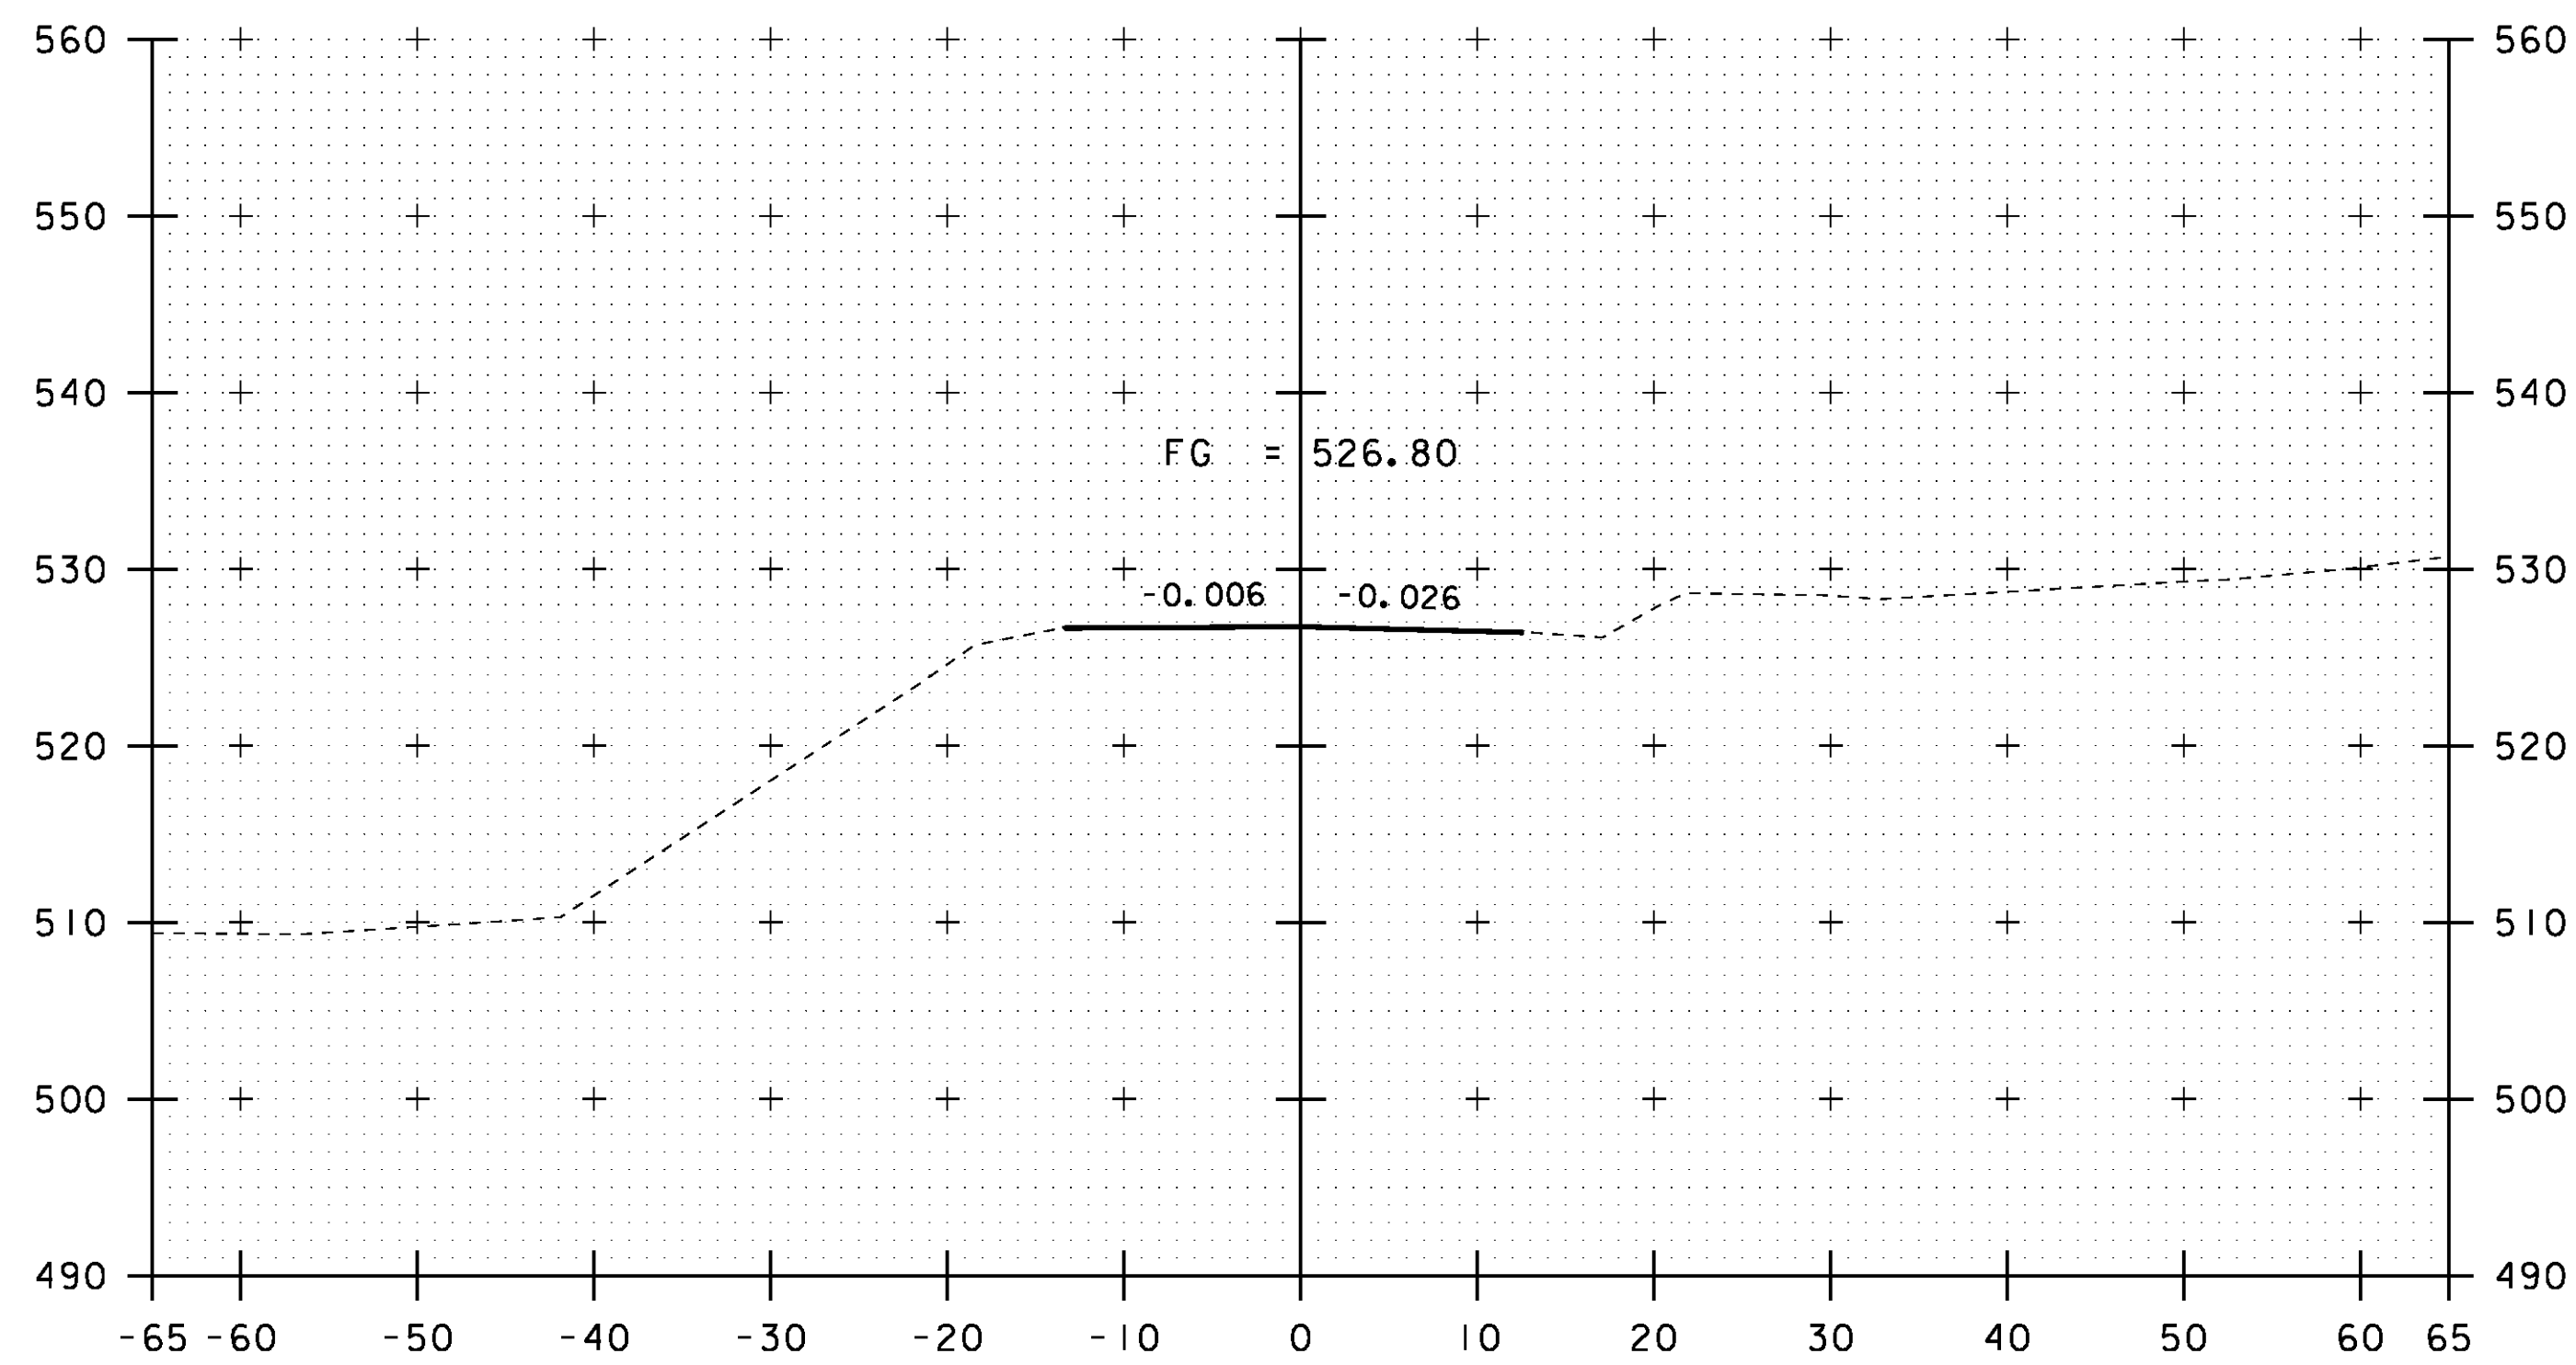


420+00  
END APPROACH  
MATCH EXISTING

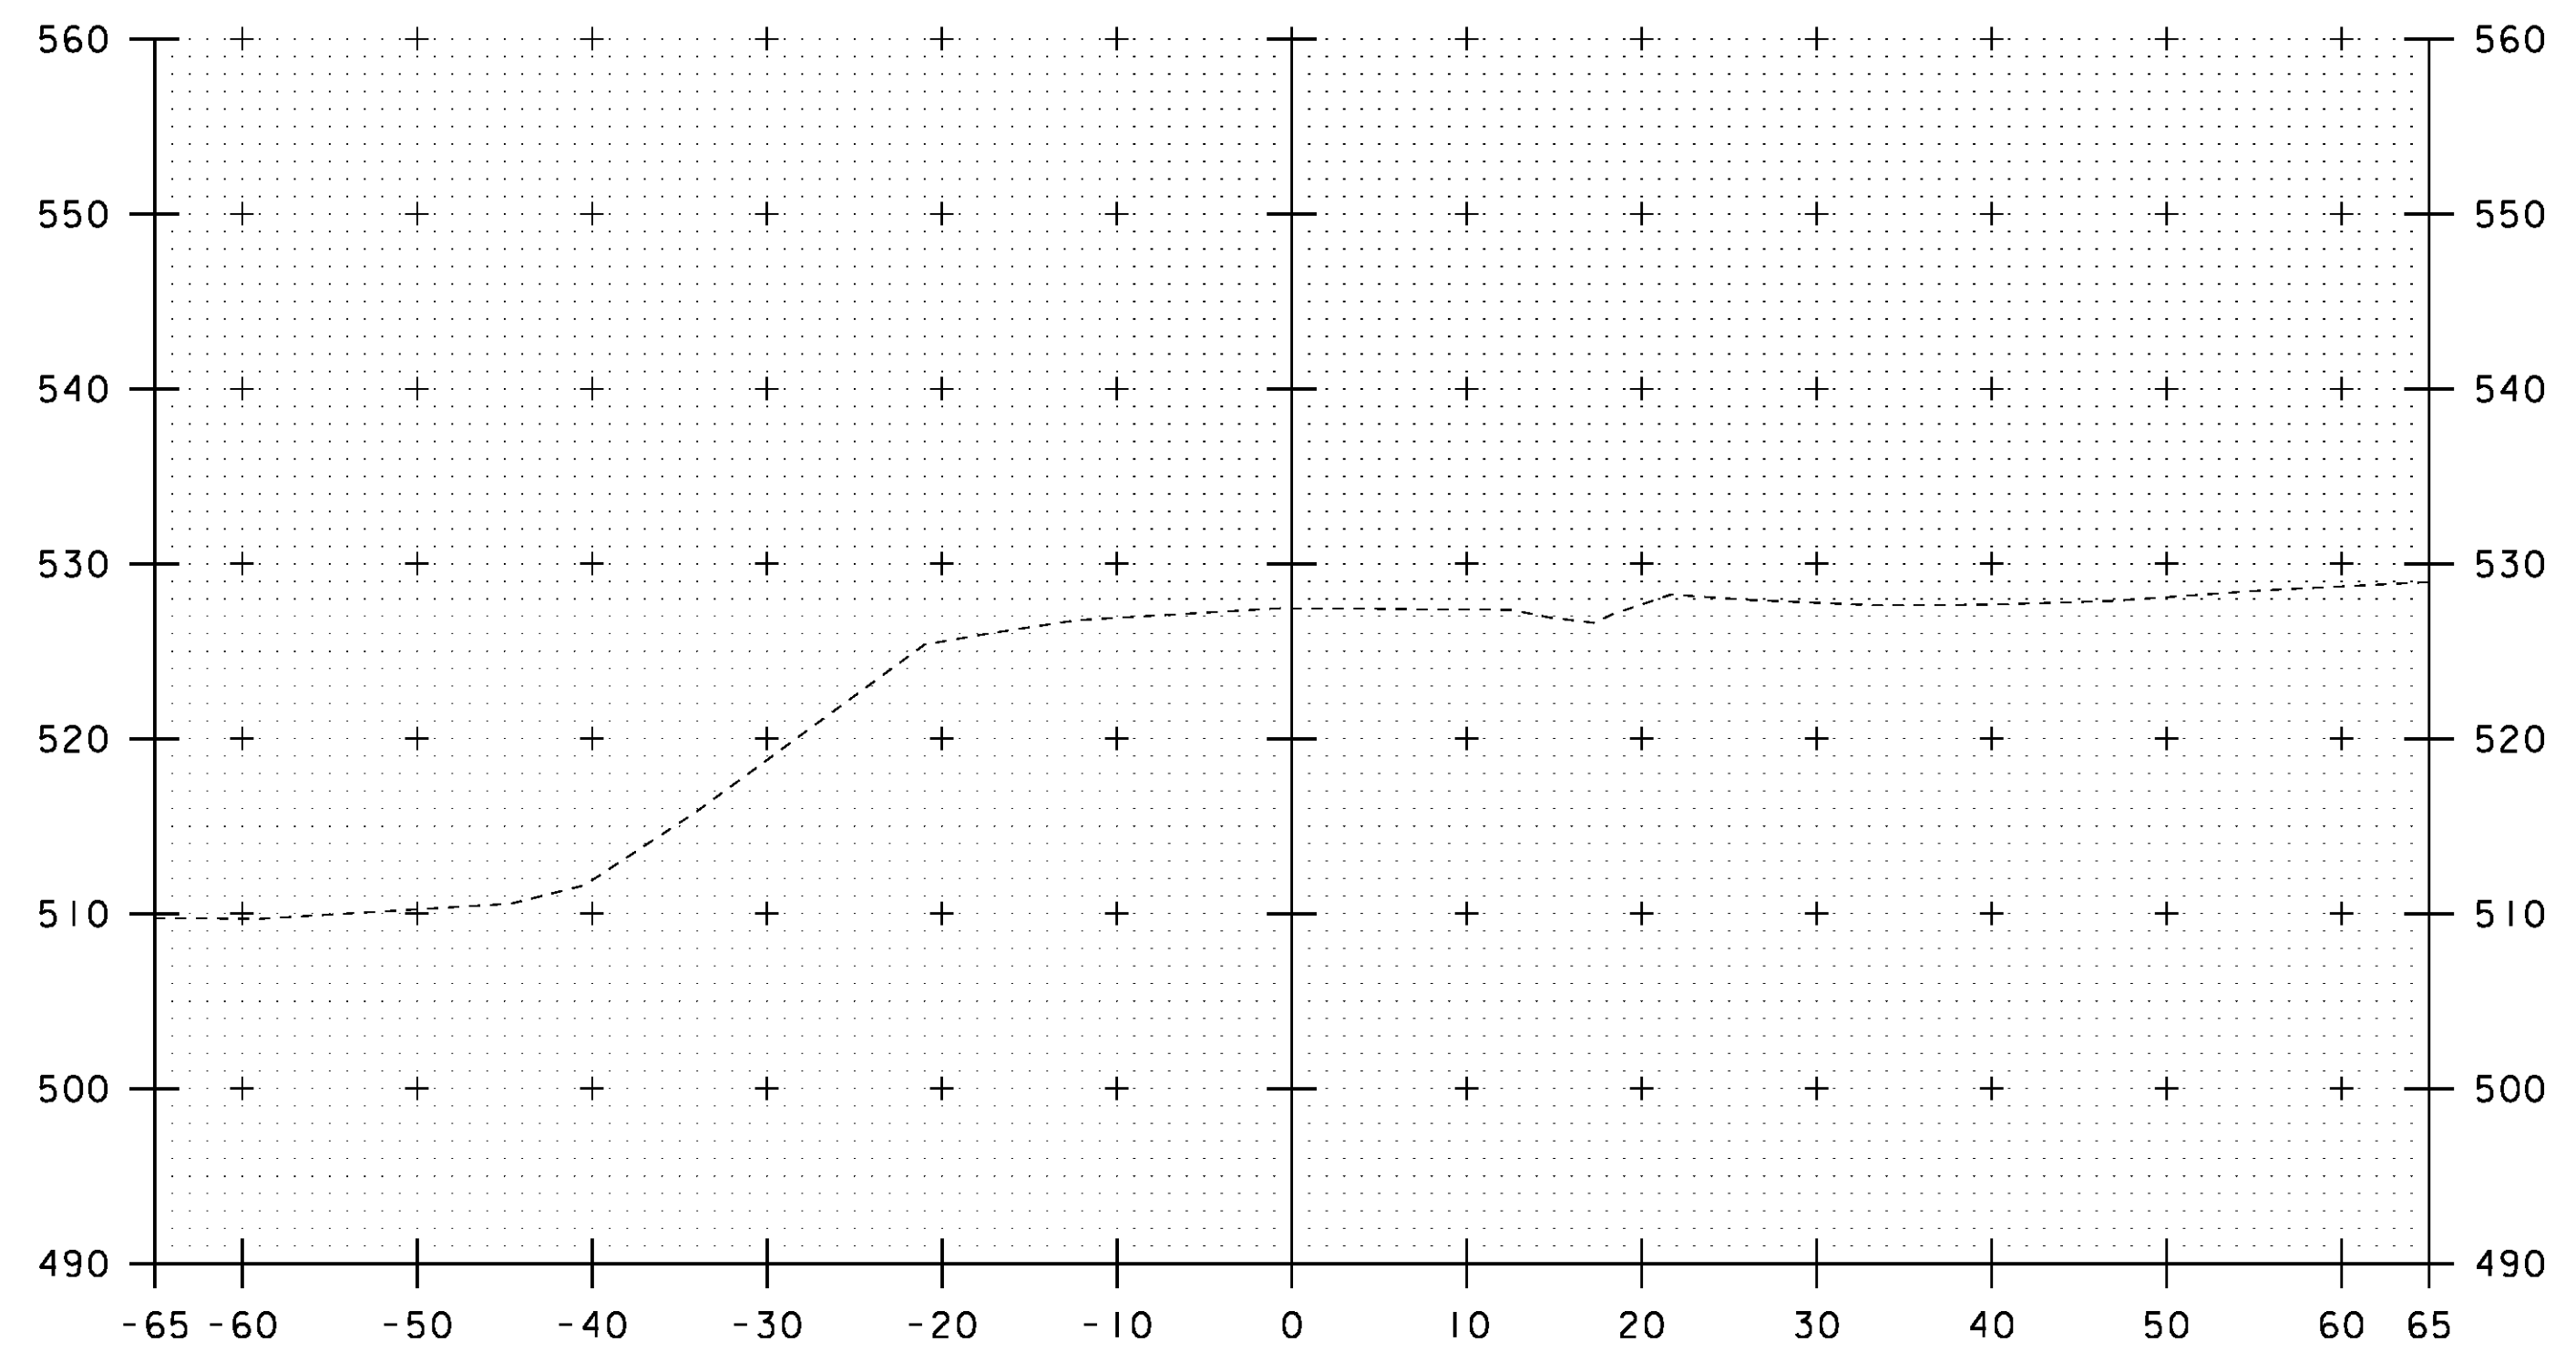


420+50

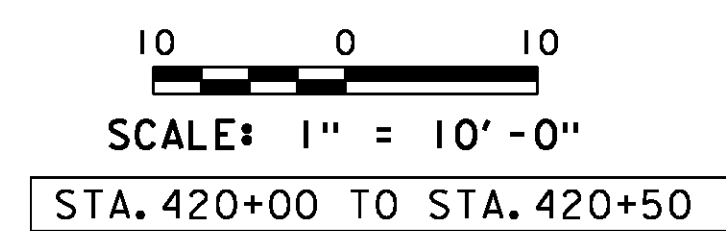

PROJECT NAME: ROYALTON	PLLOT DATE: 08-OCT-2013
PROJECT NUMBER: BRS 0147 (13)	DRAWN BY: STR3
FILE NAME: \BR_28\86e055xsl_28.dgn	CHECKED BY: C. CARLSON
PROJECT LEADER: C. CARLSON	SHEET 145 OF 186
DESIGNED BY: D. PETERSON	
BRIDGE 28 VT 14 CROSS SECTIONS (9)	

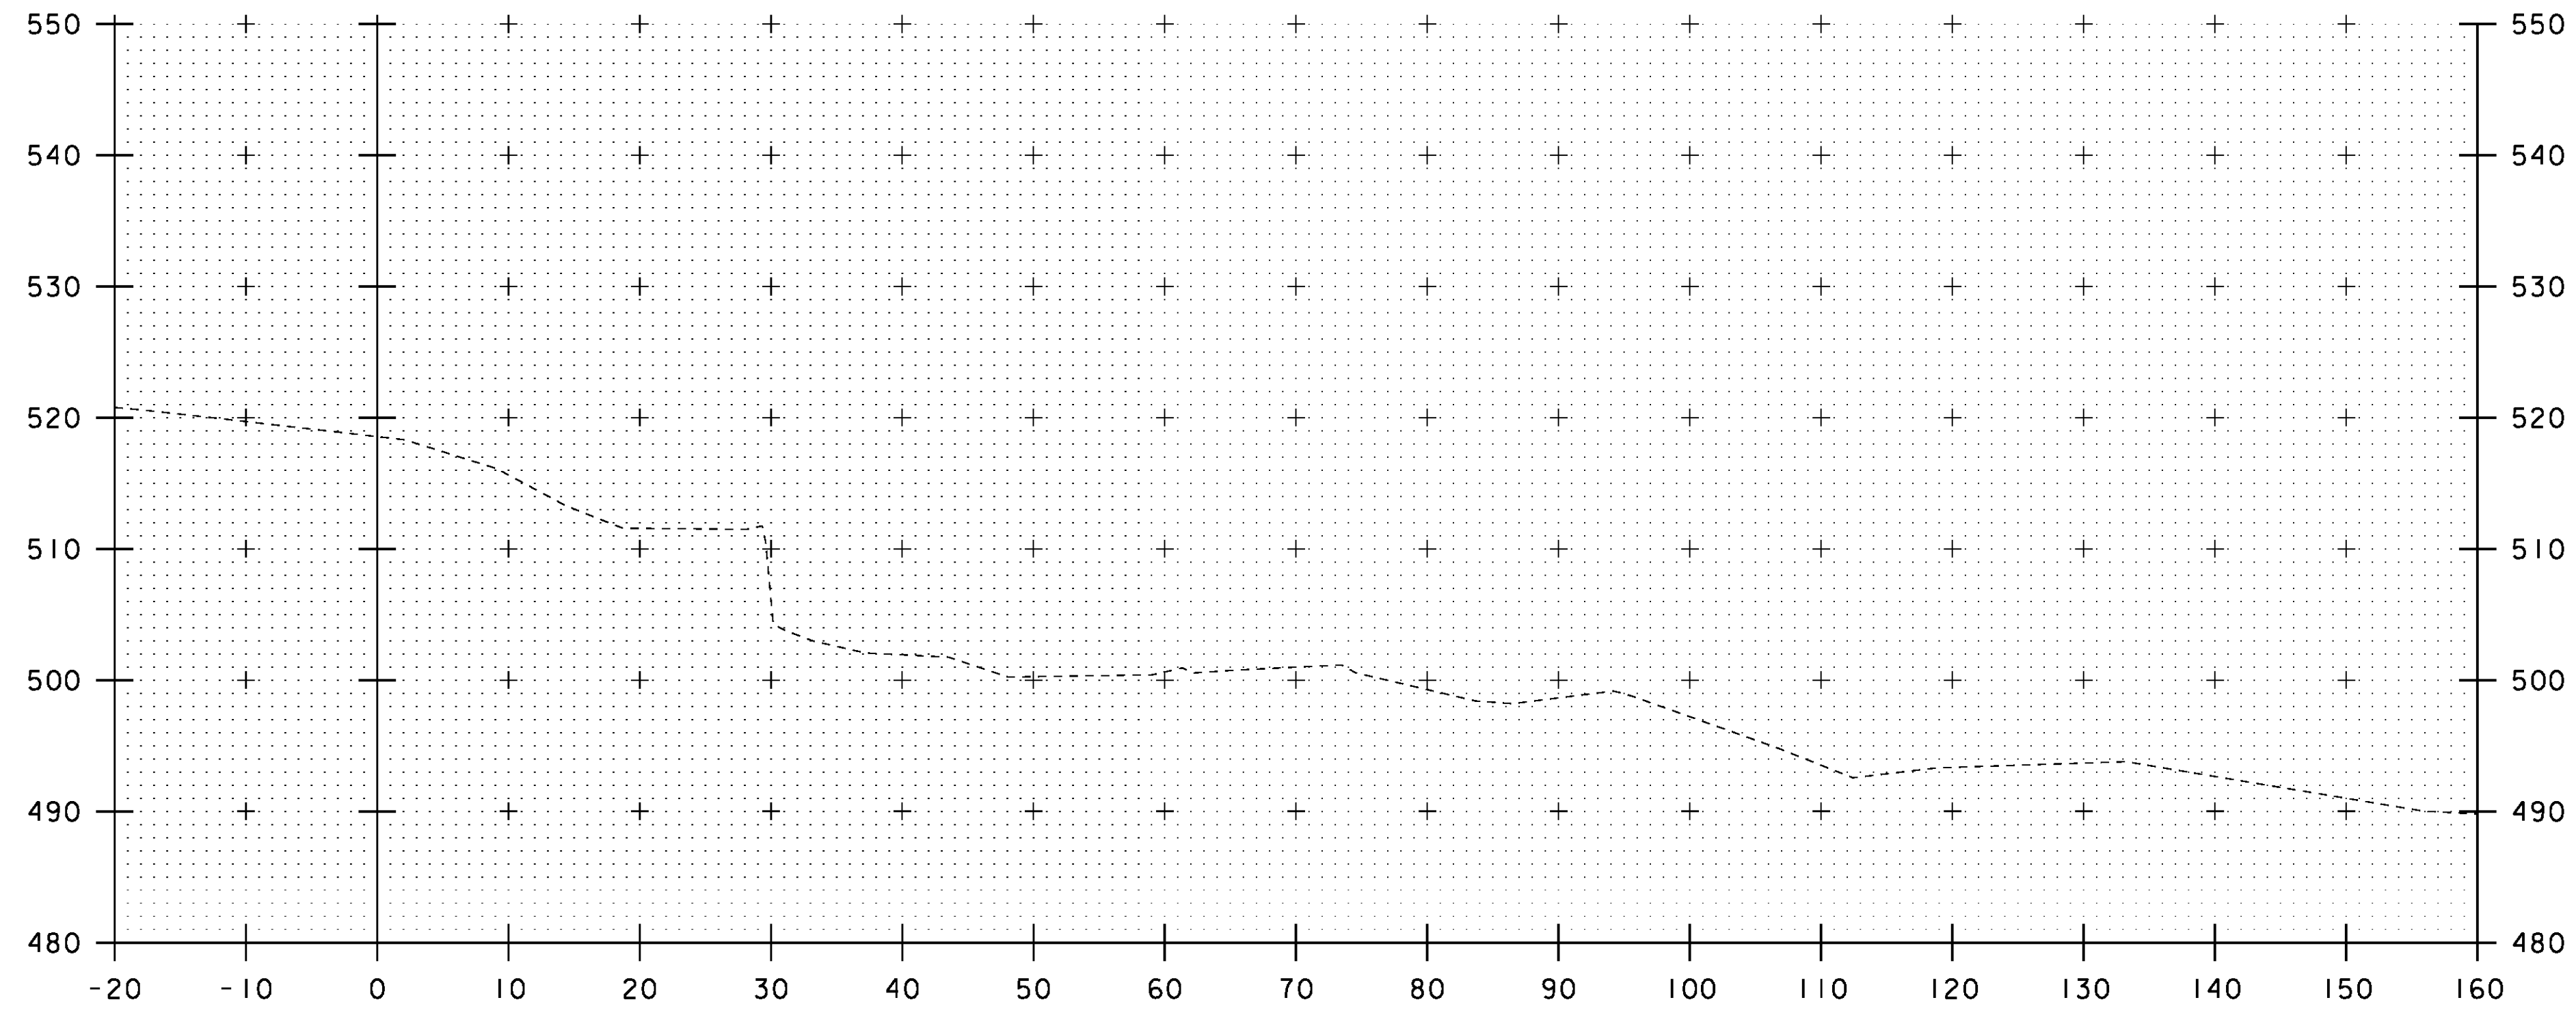

60+25

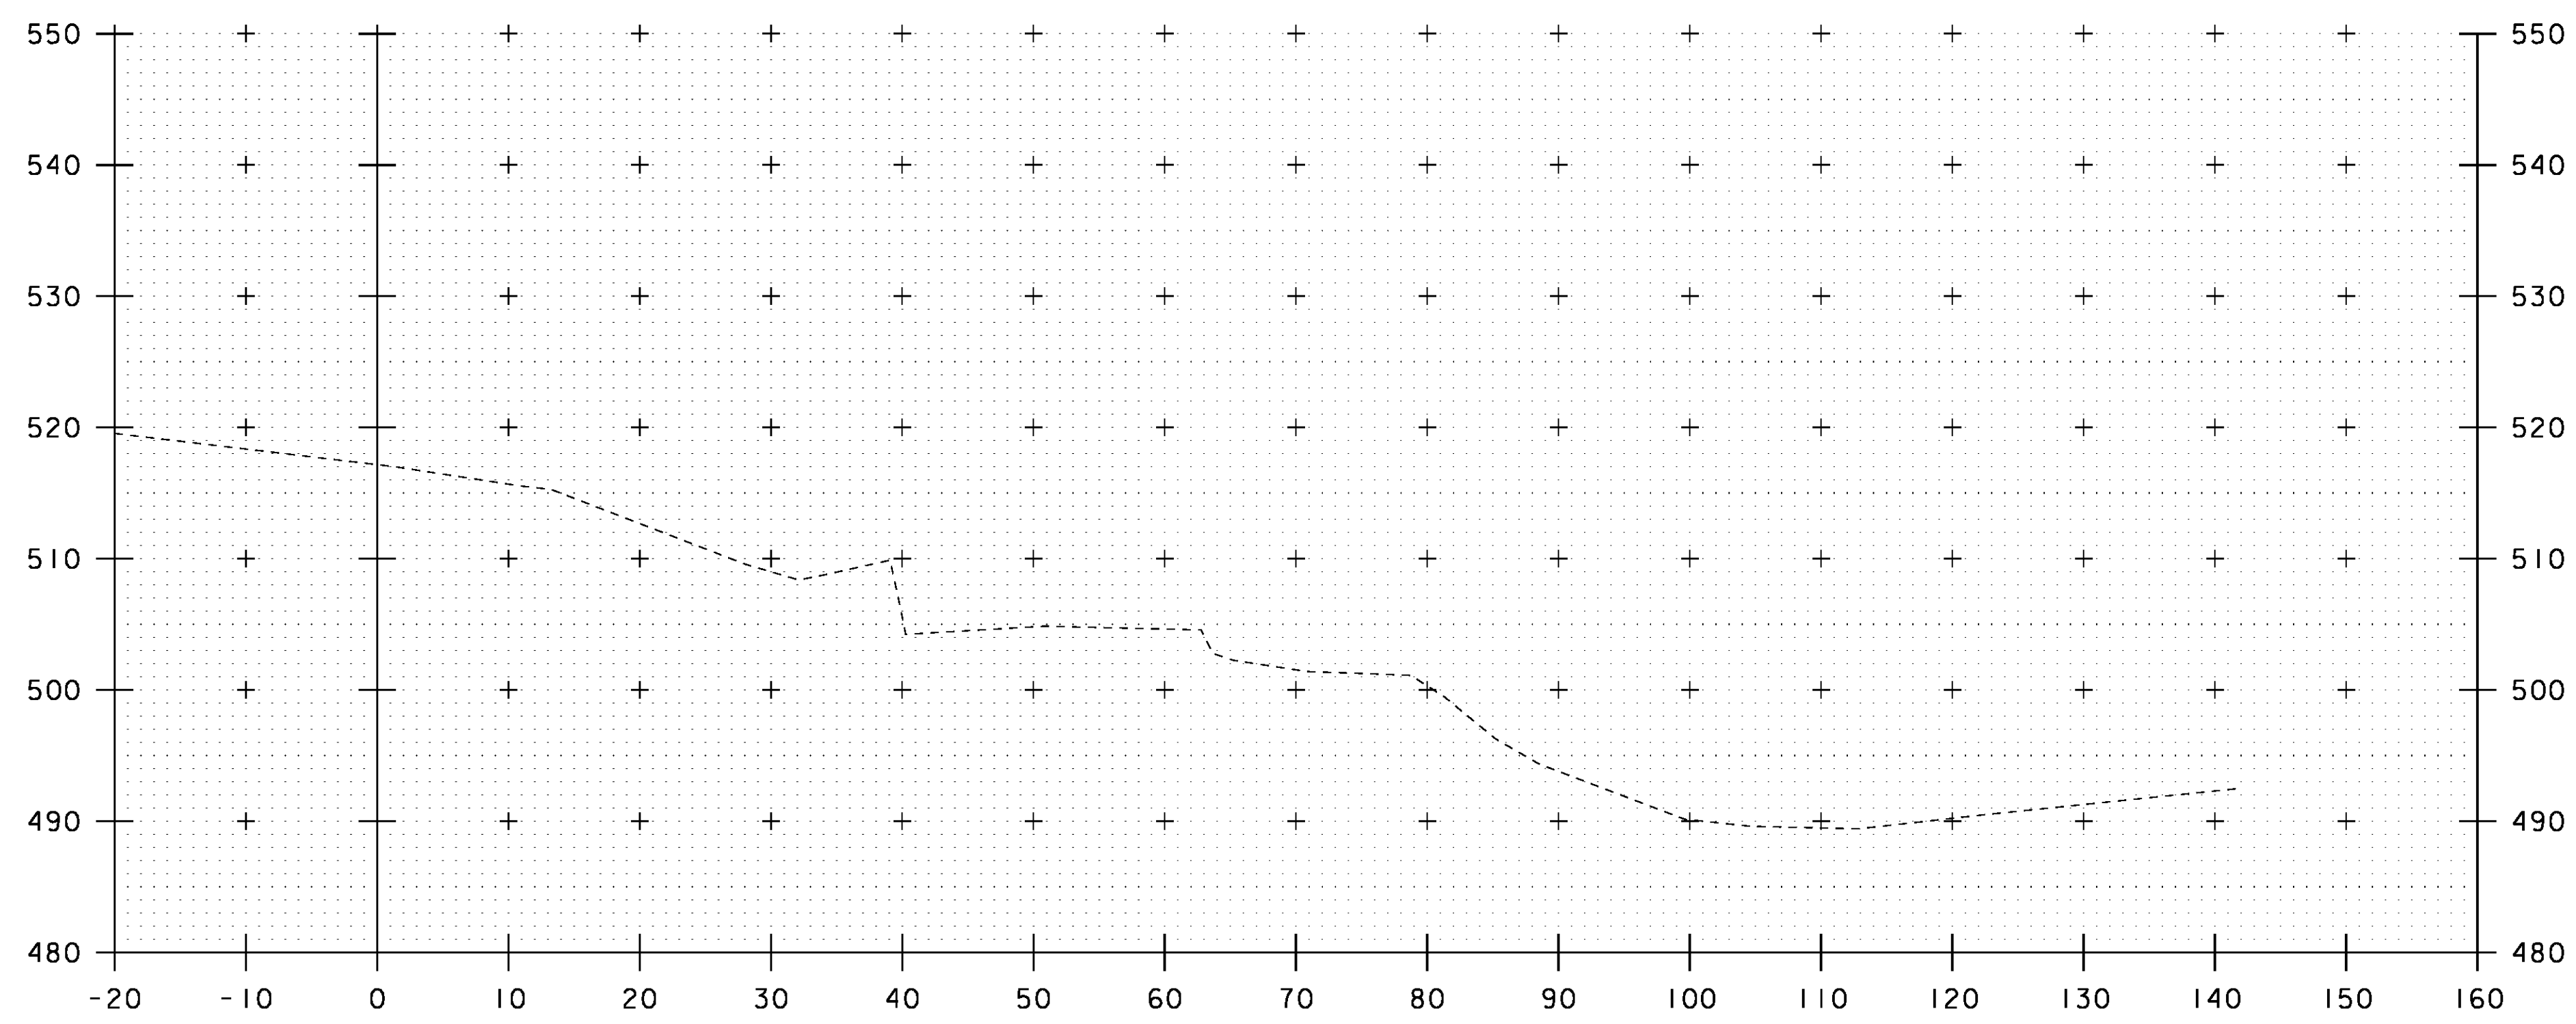


60+00



SCALE: 1" = 10'-0"


STA. 60+00 TO STA. 60+25

PROJECT NAME:	ROYALTON
PROJECT NUMBER:	BRS 0147 (13)
FILE NAME:	\BR_28\s86e055xsl_28.dgn
PROJECT LEADER:	C. CARLSON
DESIGNED BY:	D. PETERSON
BRIDGE 28 CHANNEL LINE CROSS SECTIONS(1)	SHEET 146 OF 186
PLOT DATE:	08-OCT-2013
DRAWN BY:	STR3
CHECKED BY:	C. CARLSON

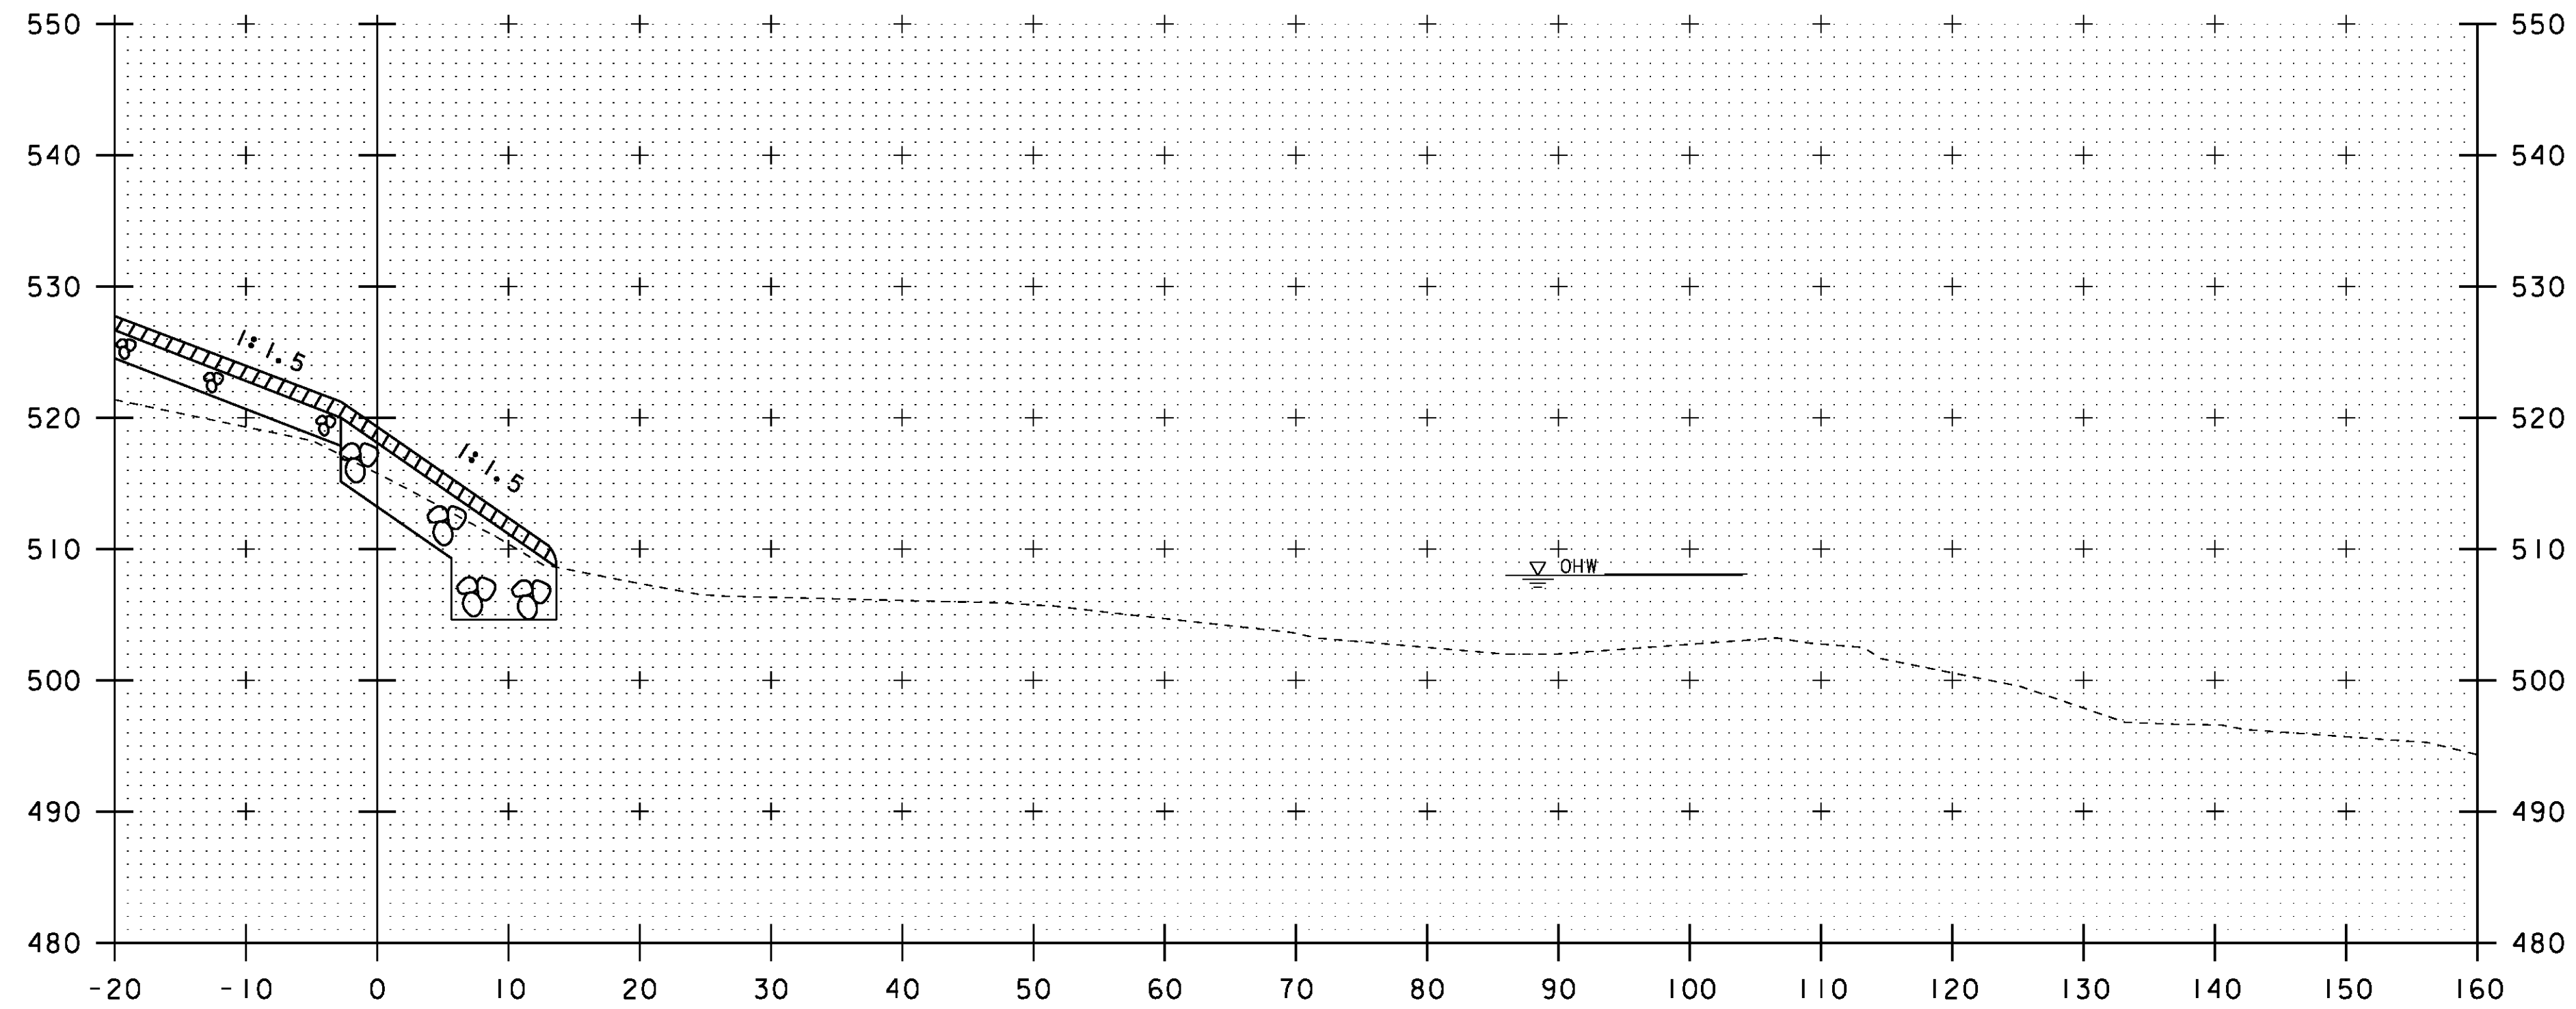


STA 60+54.58 LT  
 BEGIN UNCLASSIFIED CHANNEL EXCAVATION  
 GEOTEXTILE UNDER STONE FILL  
 STONE FILL, TYPE IV  
 GRUBBING MATERIAL

60+60

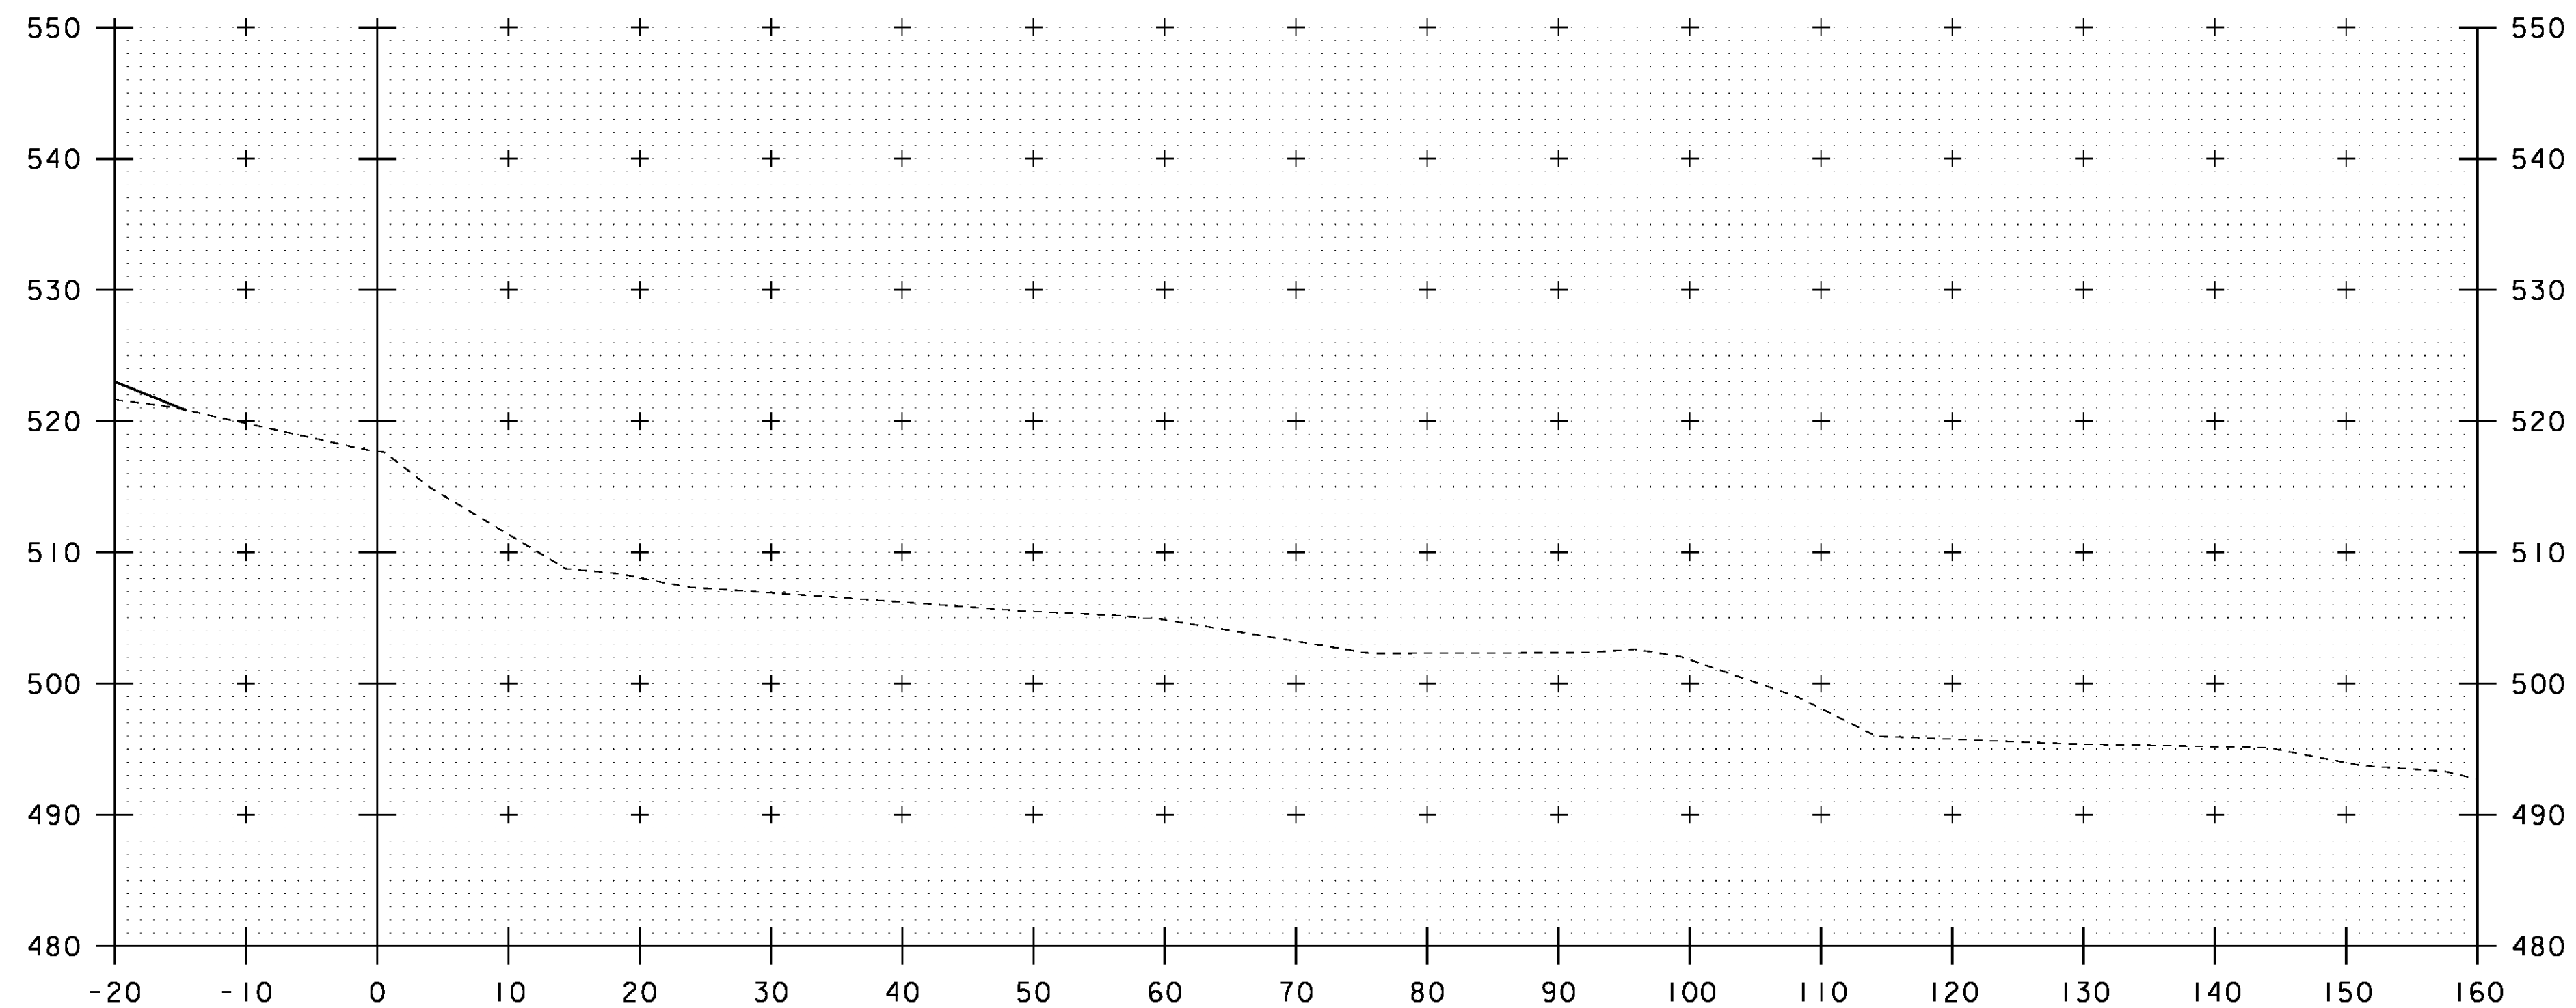


60+50

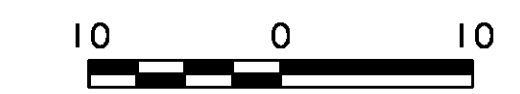


SCALE: 1" = 10'-0"

STA. 60+50 TO STA. 60+60

PROJECT NAME:	ROYALTON
PROJECT NUMBER:	BRS 0147 (13)
FILE NAME:	\BR_28\86e055xsl_28.dgn
PROJECT LEADER:	C. CARLSON
DESIGNED BY:	D. PETERSON
BRIDGE 28 CHANNEL LINE CROSS SECTIONS (2) SHEET	147 OF 186
PLOT DATE:	08-OCT-2013
DRAWN BY:	STR3
CHECKED BY:	C. CARLSON

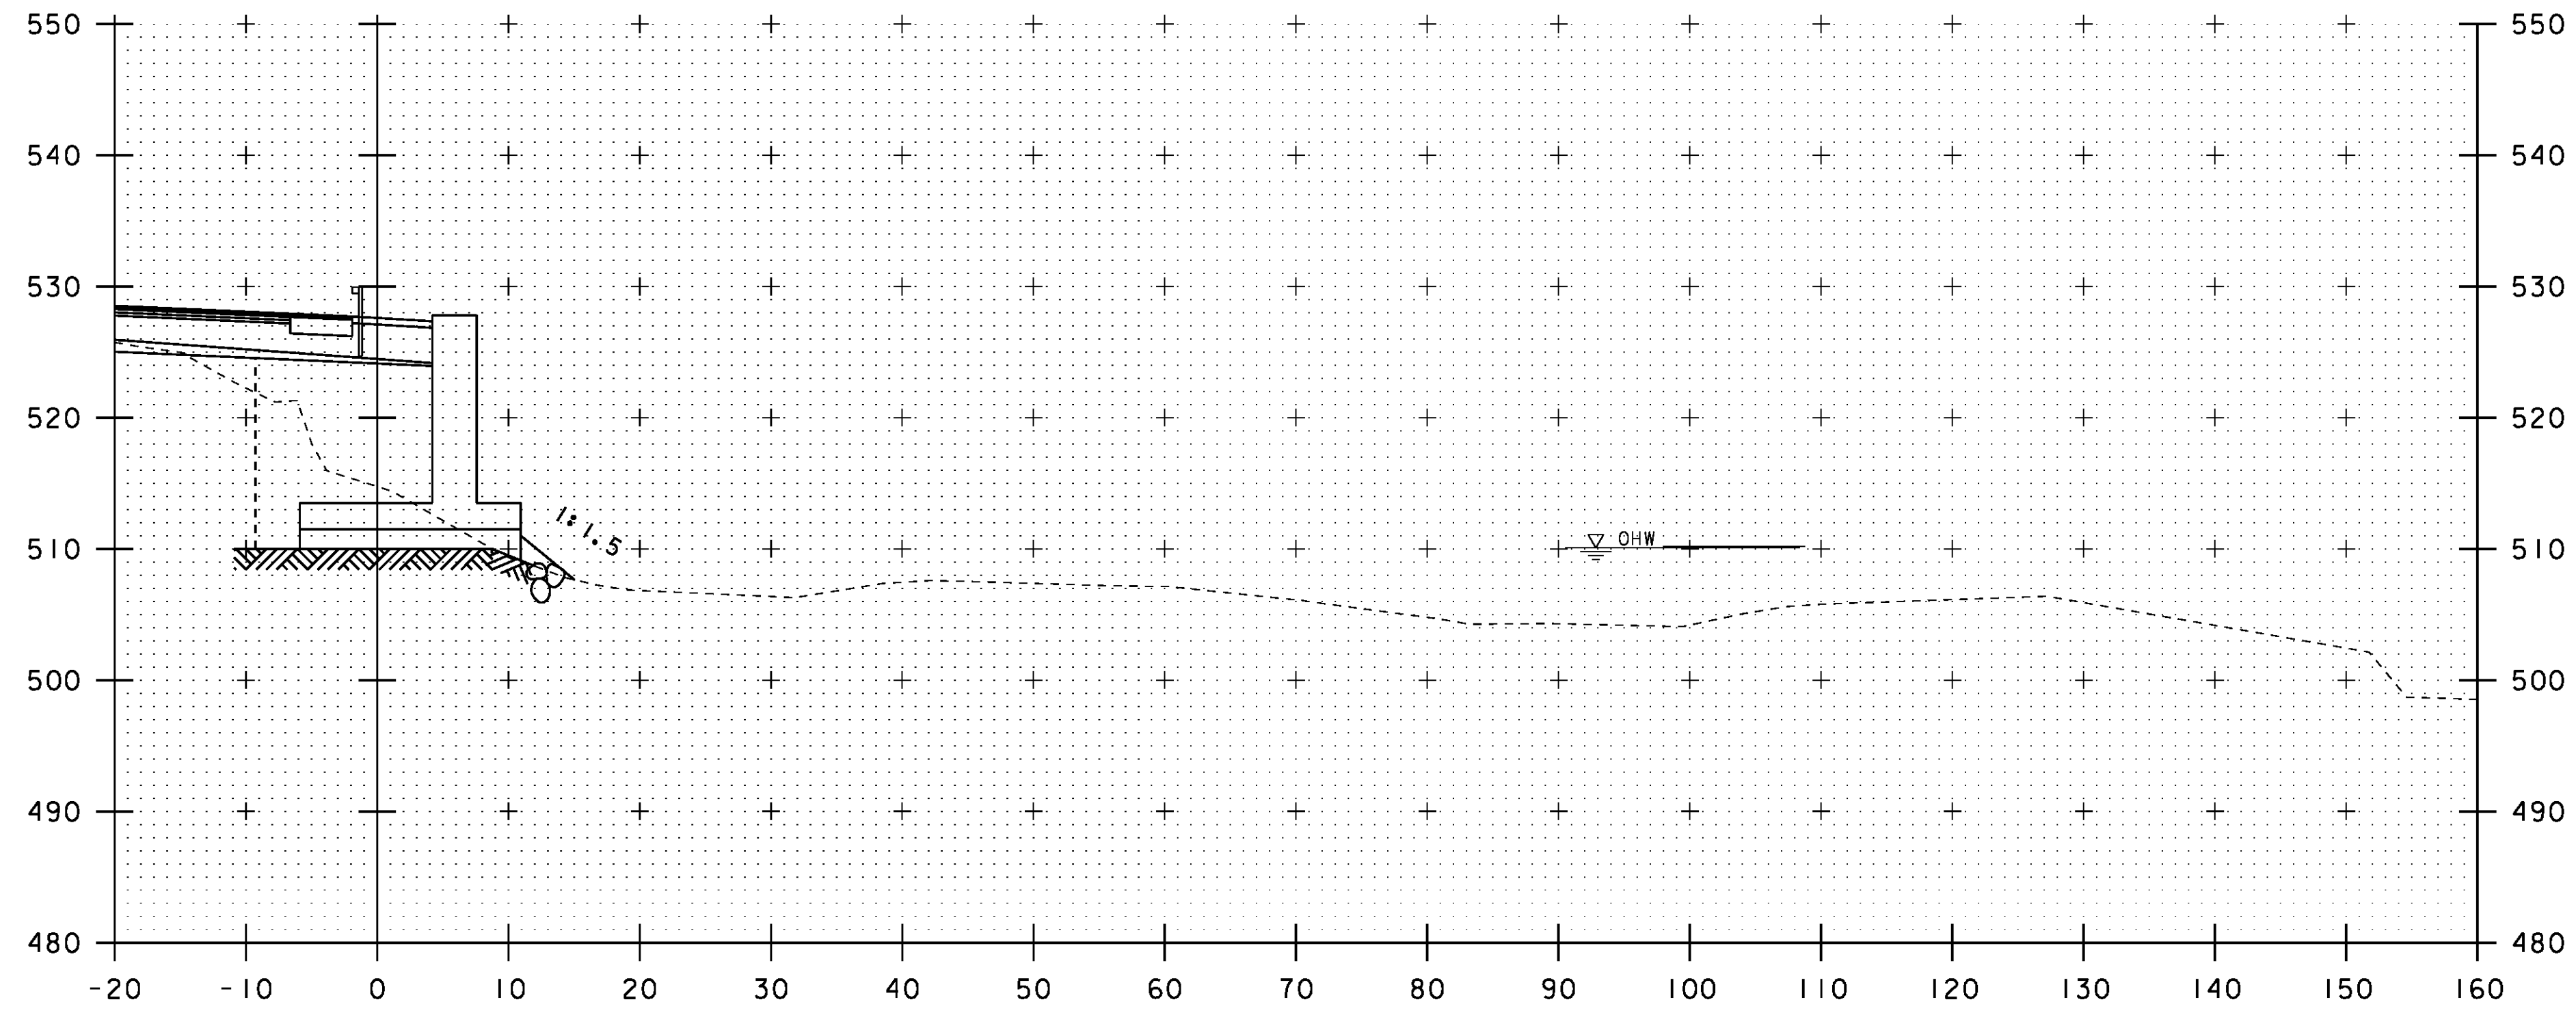

60+80


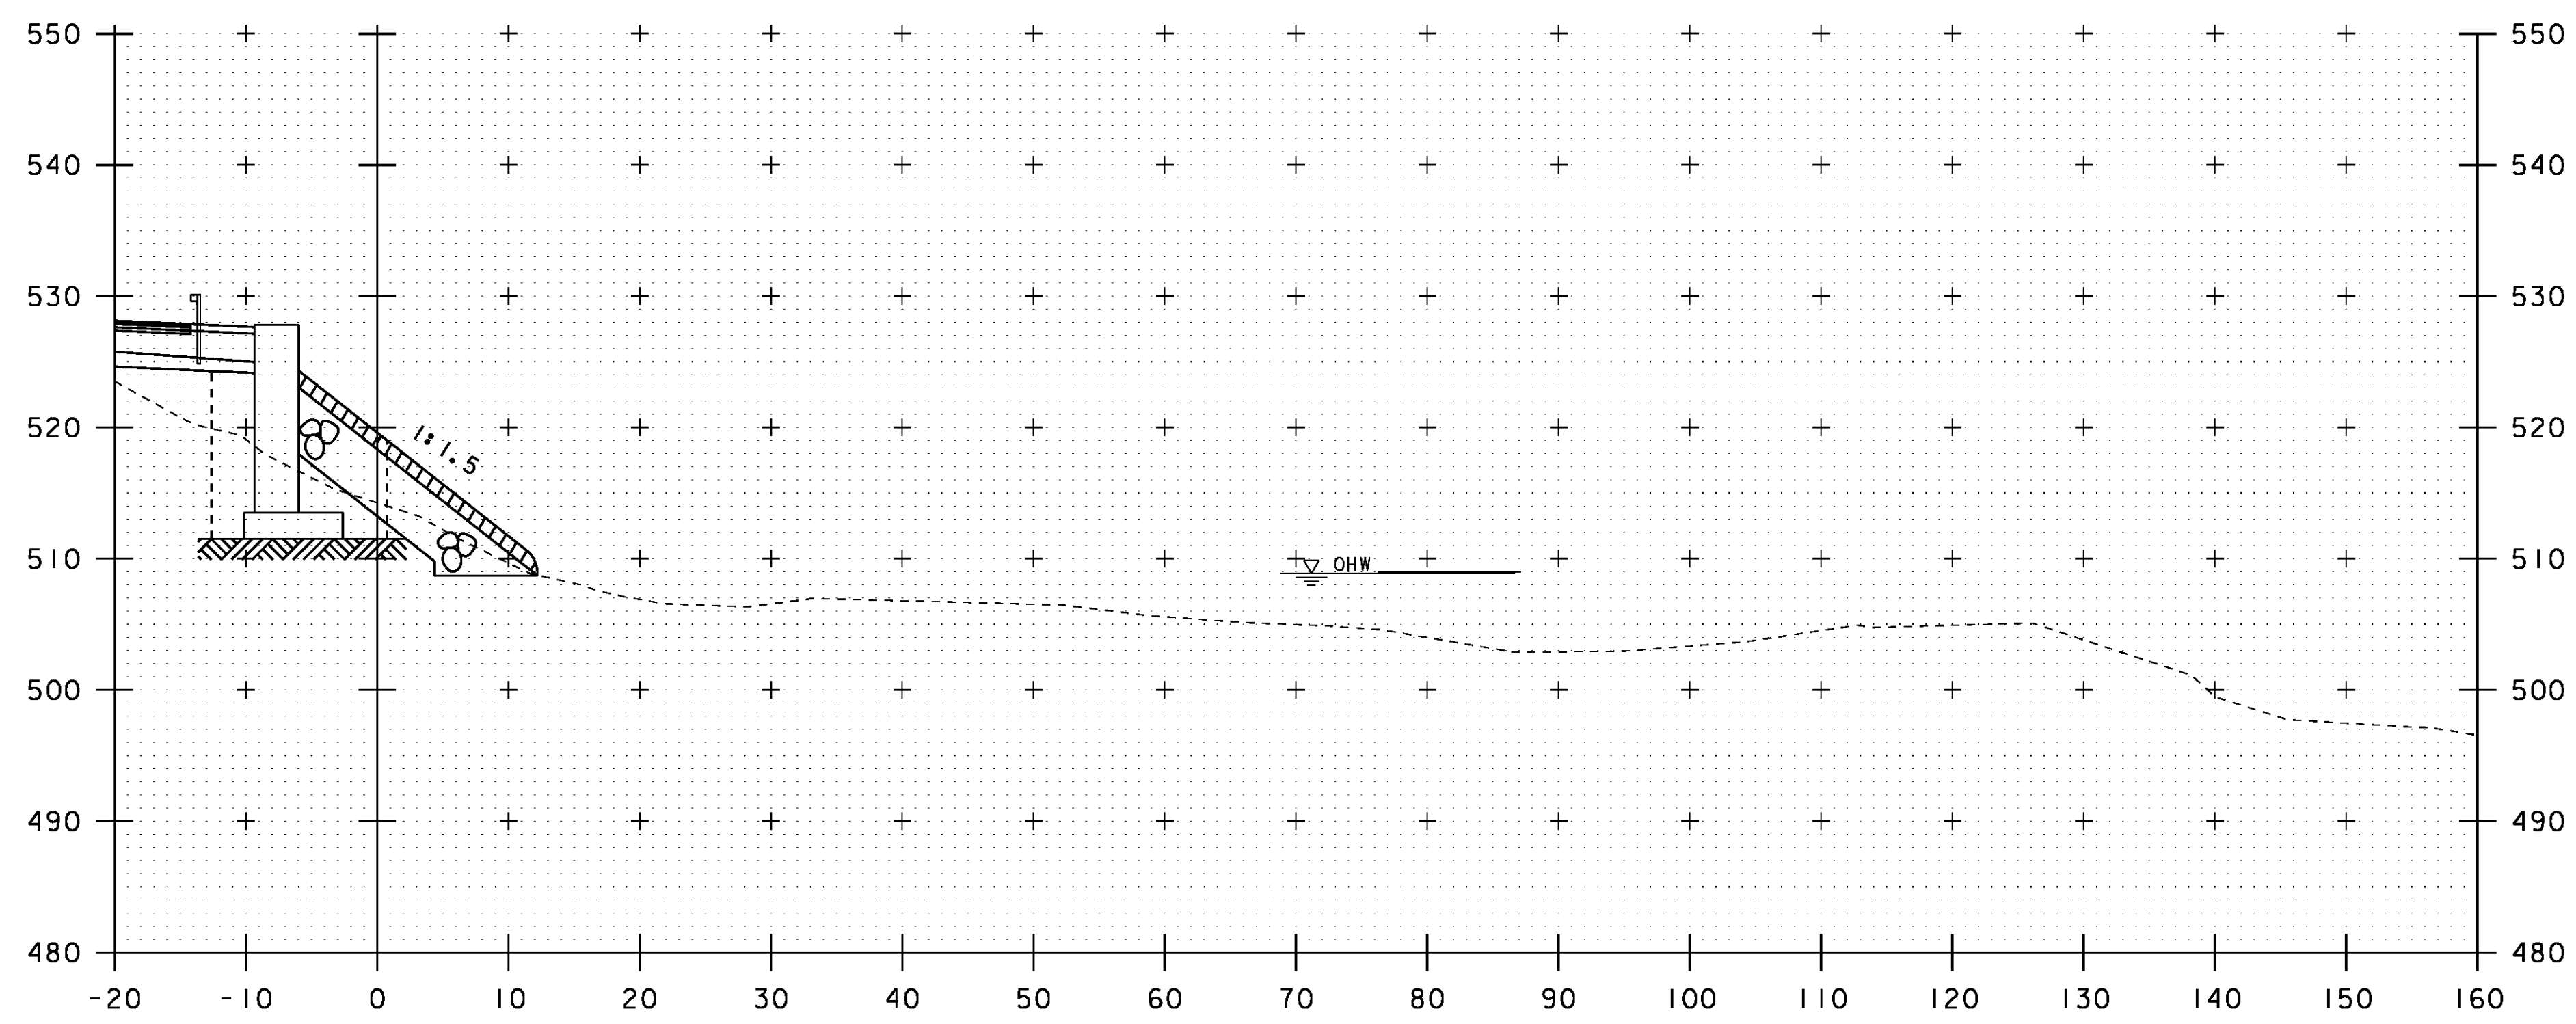


60+70




STA. 60+70 TO STA. 60+80

PROJECT NAME:	ROYALTON
PROJECT NUMBER:	BRS 0147 (13)
FILE NAME:	\BR_28\86e055xsl_28.dgn
PROJECT LEADER:	C. CARLSON
DESIGNED BY:	D. PETERSON
BRIDGE 28 CHANNEL LINE CROSS SECTIONS (3) SHEET	148 OF 186
PLOT DATE:	08-OCT-2013
DRAWN BY:	STR3
CHECKED BY:	C. CARLSON

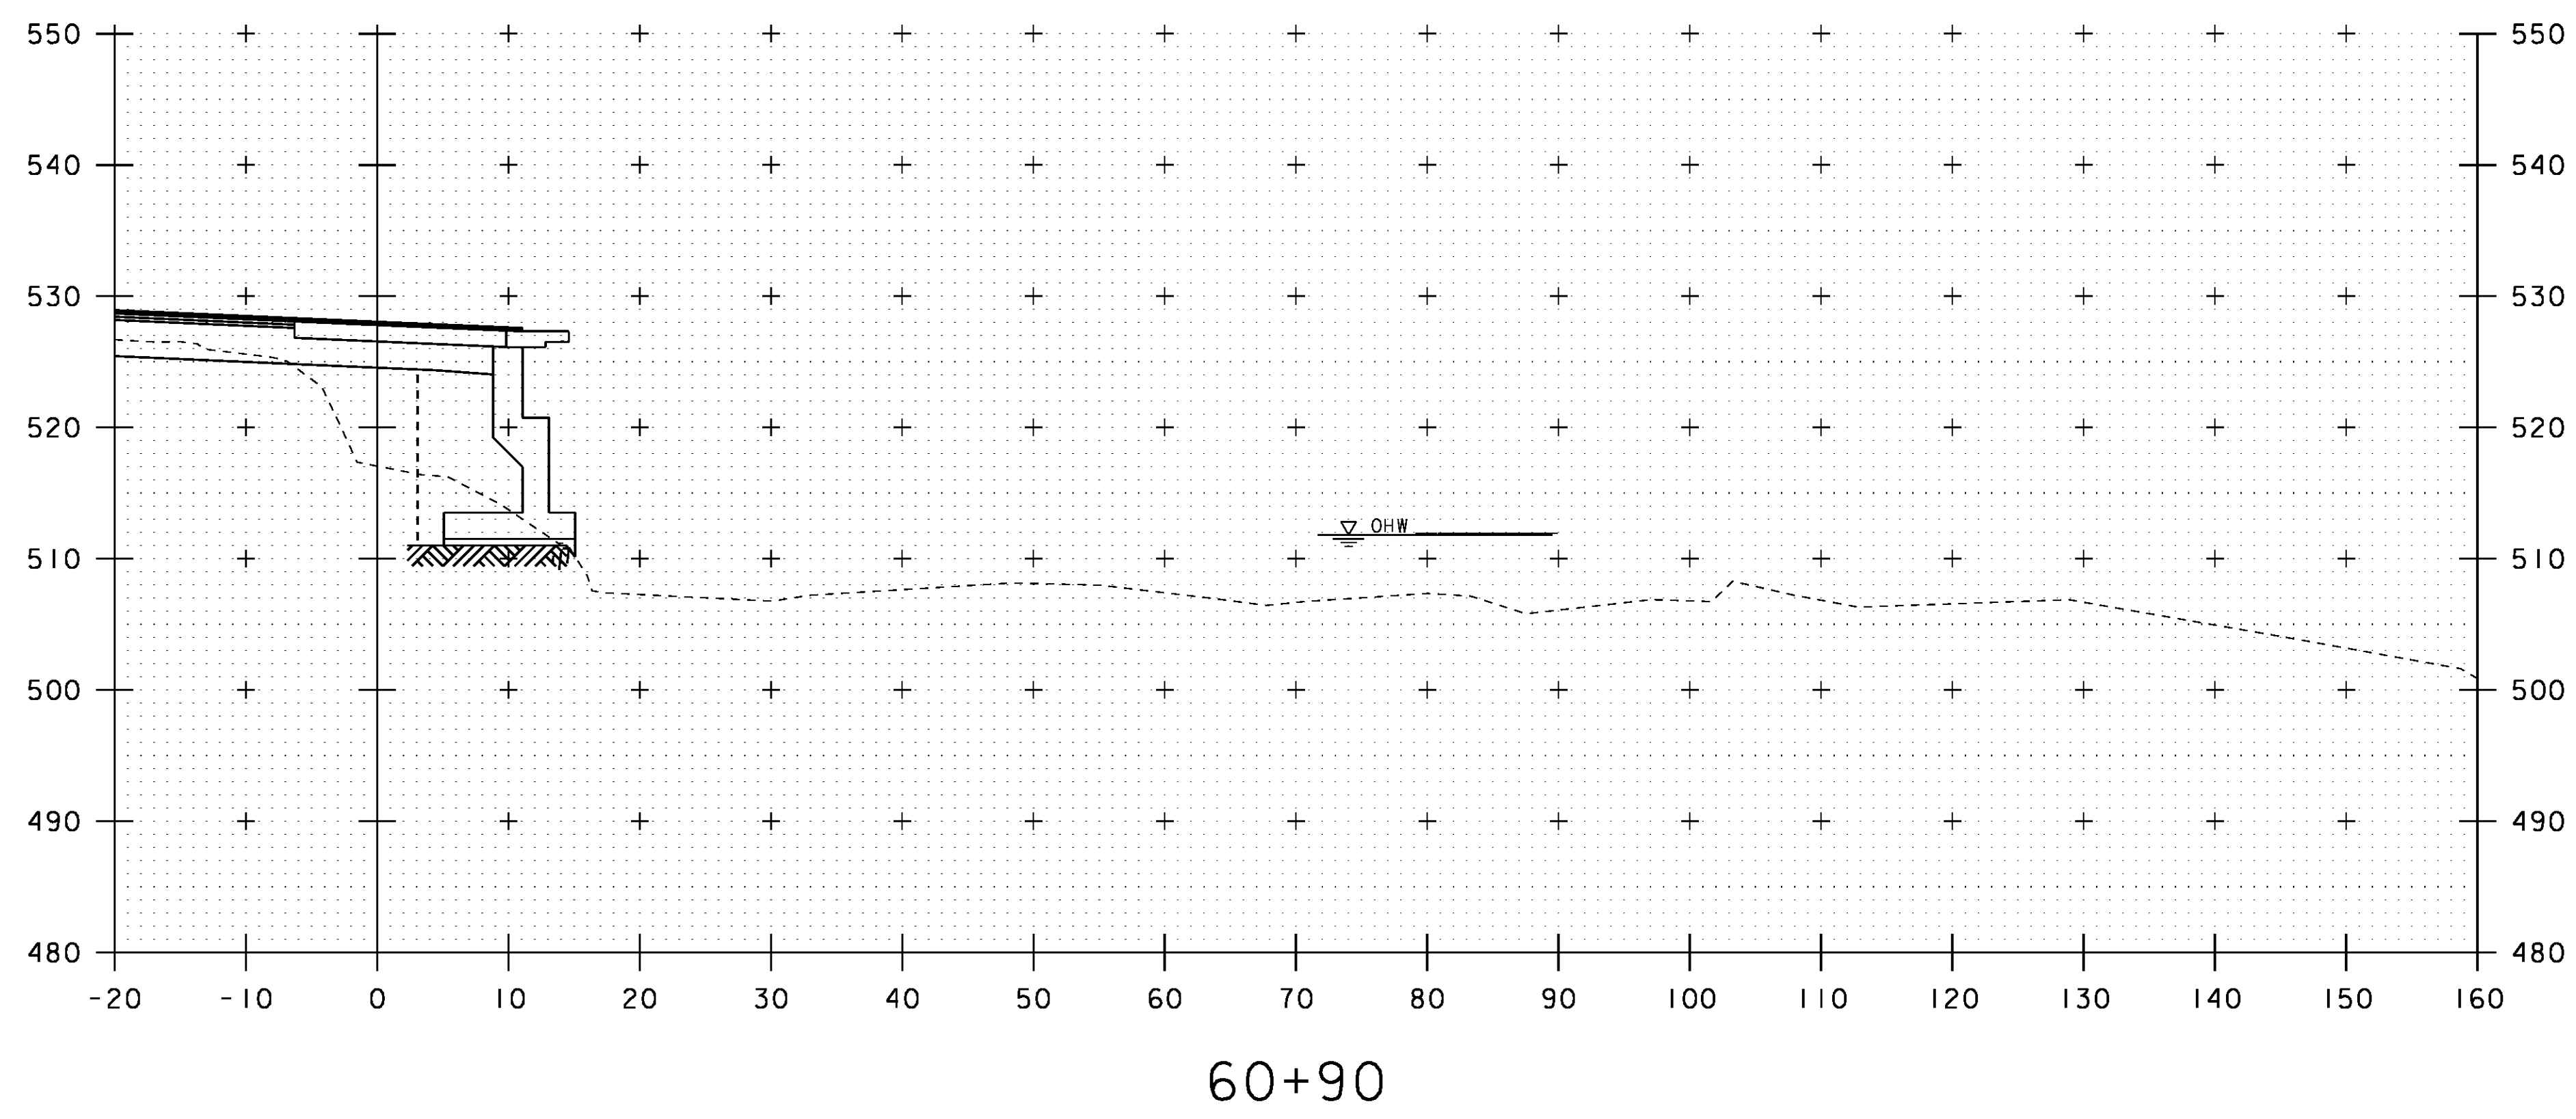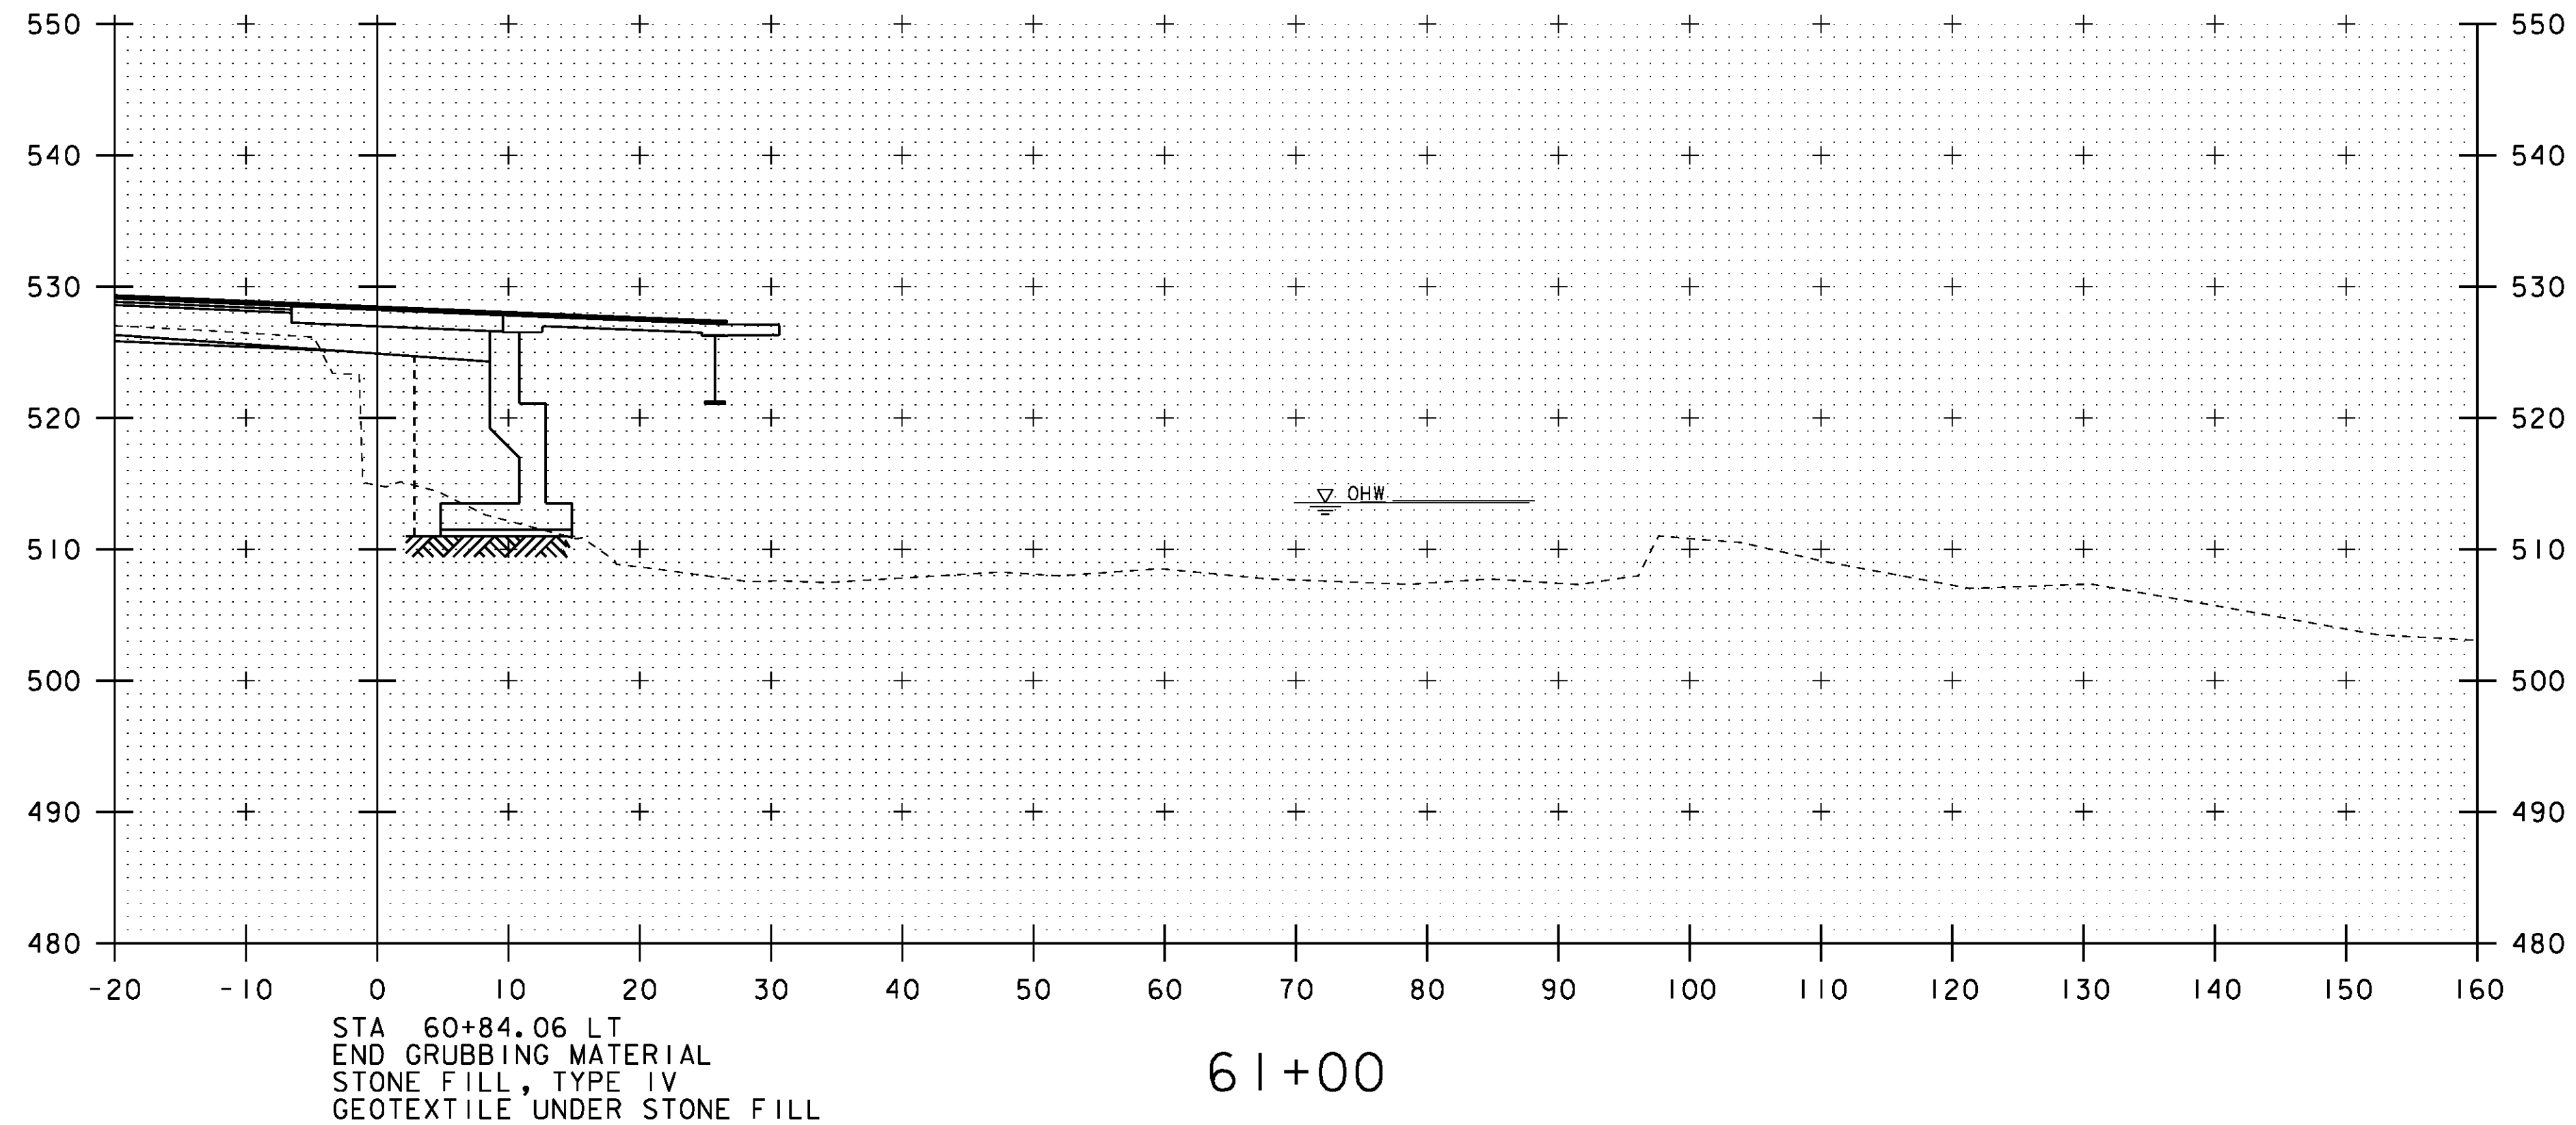


STA. 60+90 TO STA. 61+00

PROJECT NAME:	ROYALTON
PROJECT NUMBER:	BRS 0147 (13)
FILE NAME:	\BR_28\86e055xsl_28.dgn
PROJECT LEADER:	C. CARLSON
DESIGNED BY:	D. PETERSON
BRIDGE 28 CHANNEL LINE CROSS SECTIONS (4)	SHEET 149 OF 186
PLOT DATE:	08-OCT-2013
DRAWN BY:	STR3
CHECKED BY:	C. CARLSON

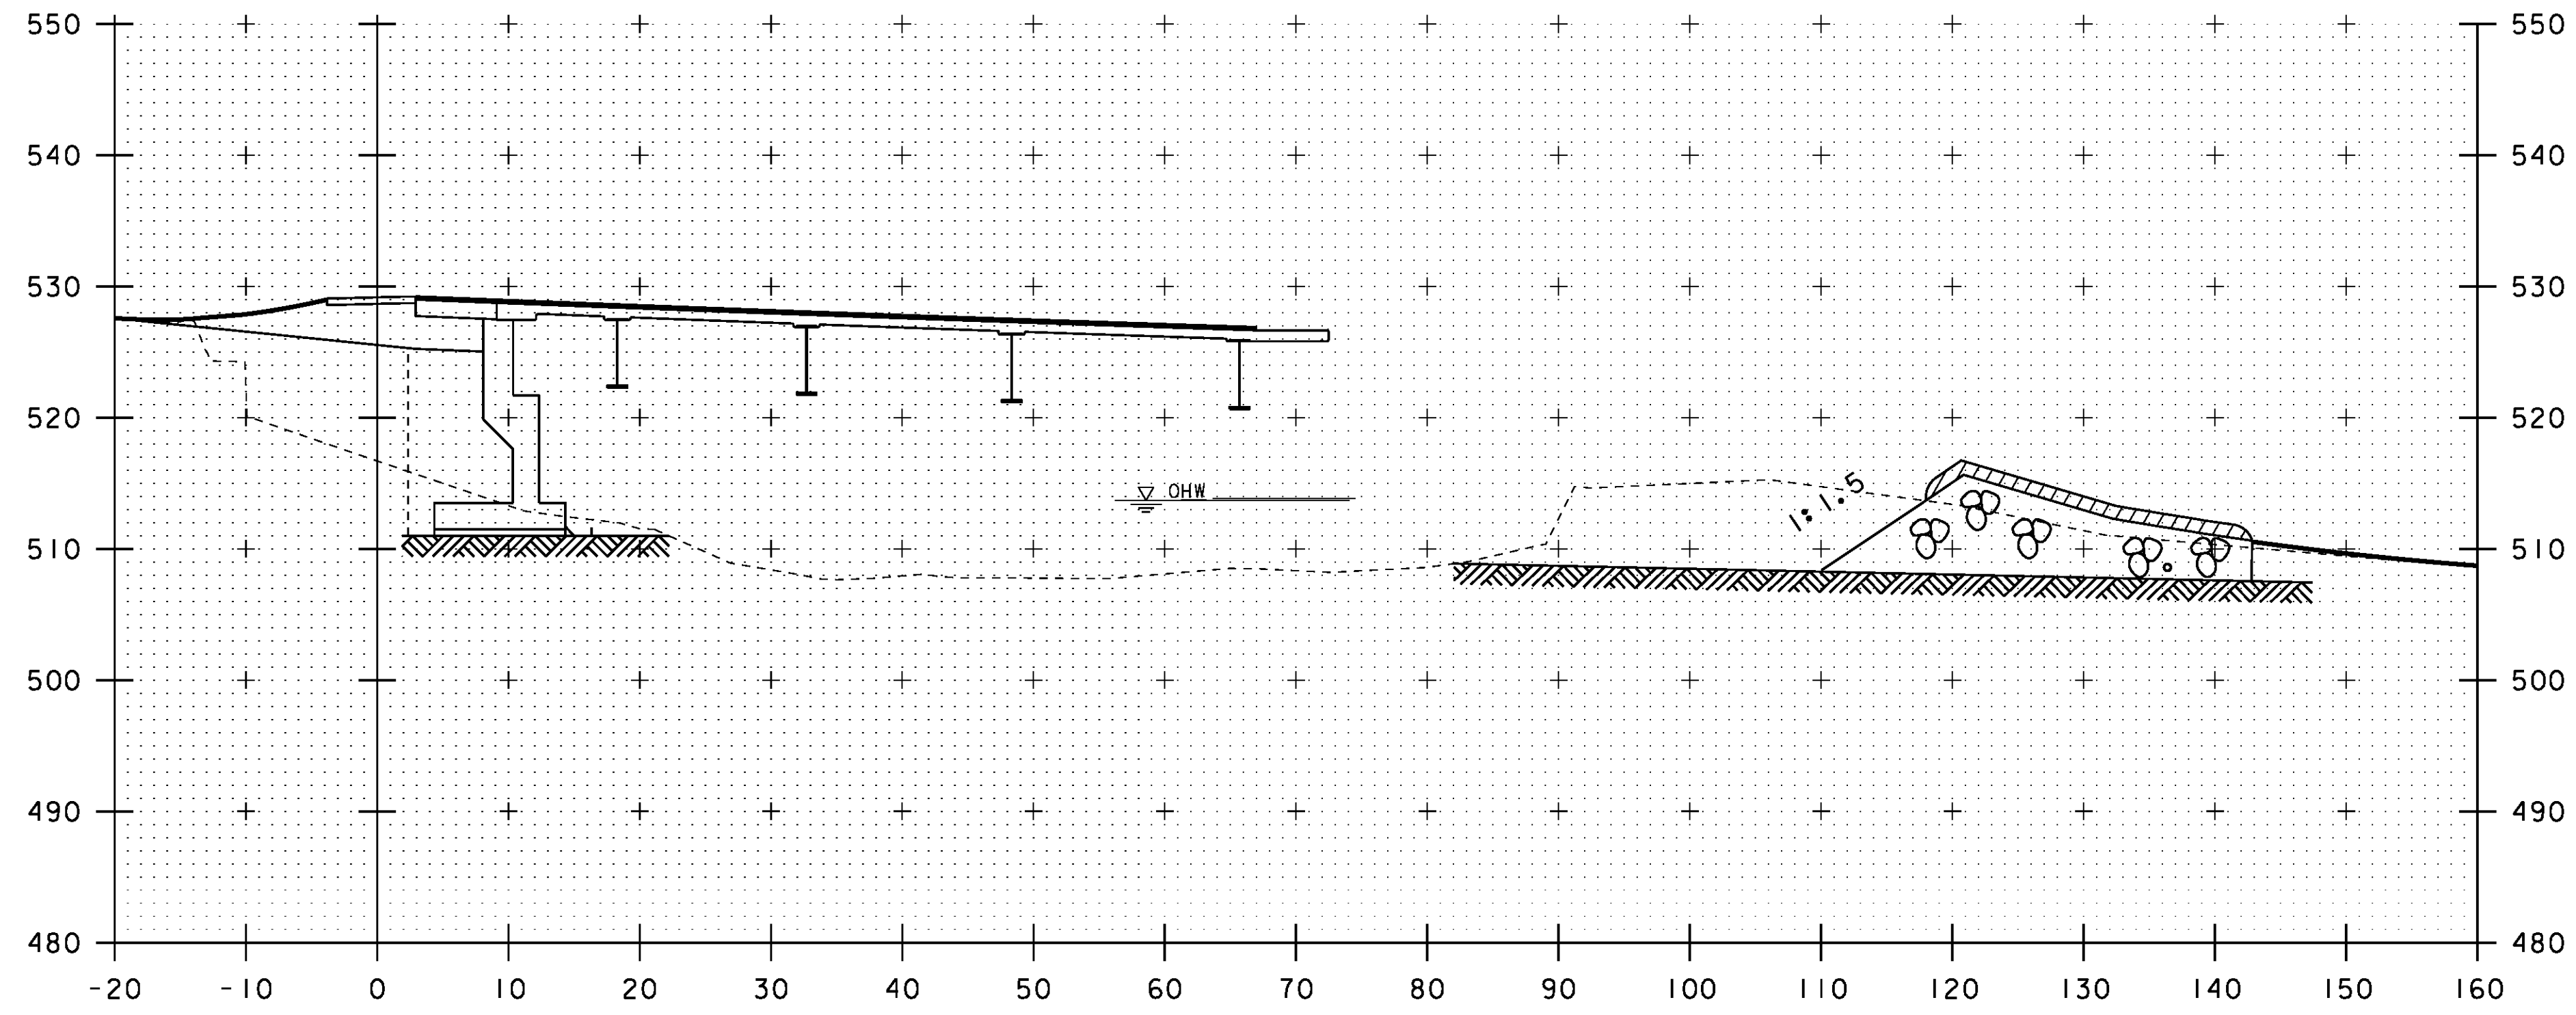


STA 61+15.00 LT  
RESUME STONE FILL, TYPE IV  
GEOTEXTILE UNDER STONE FILL

61+20

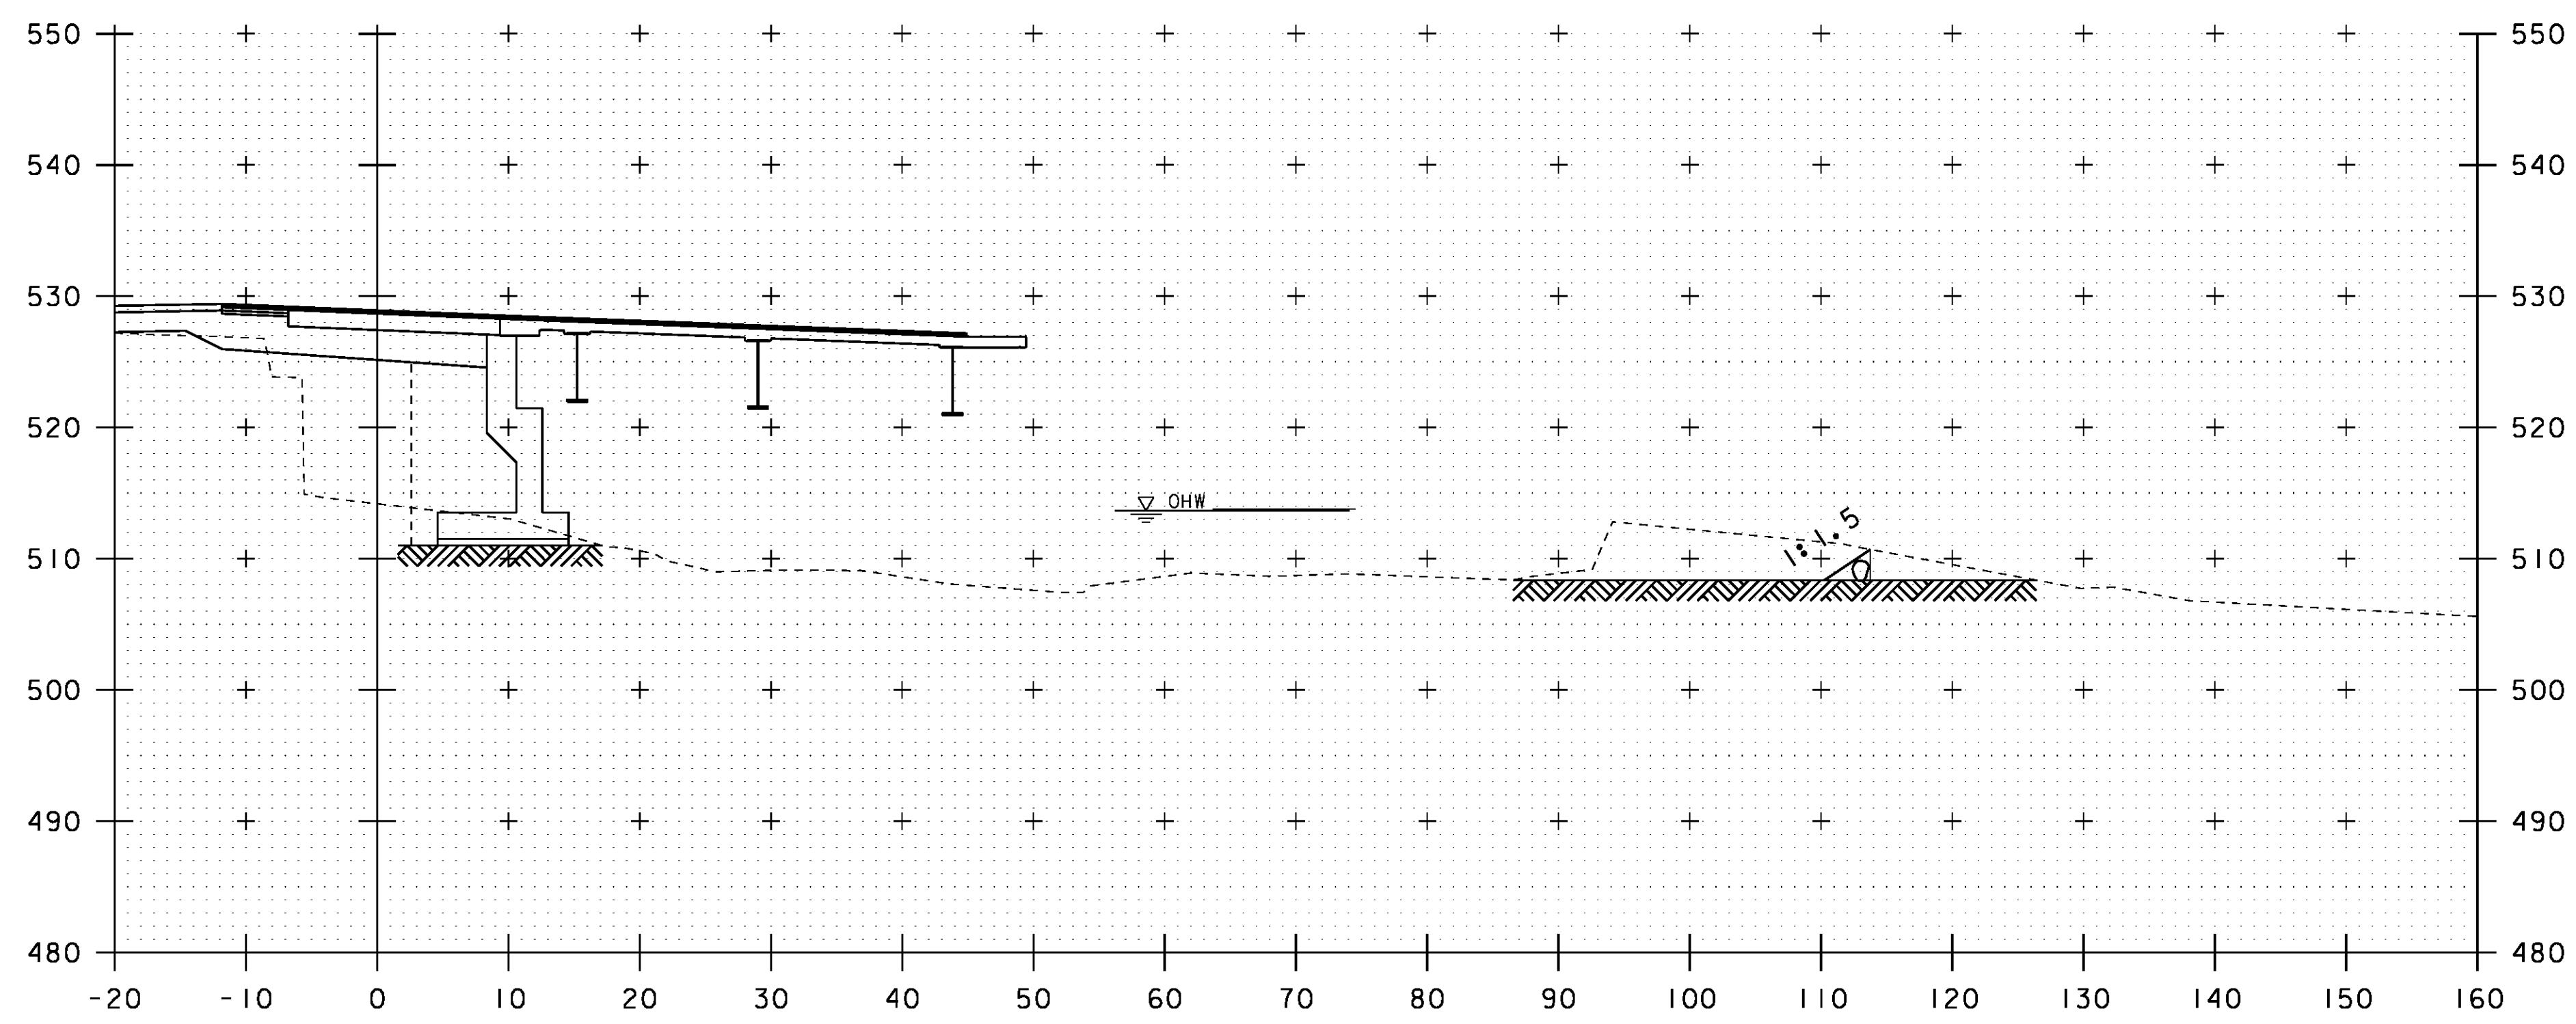

STA 61+00.03 RT  
BEGIN UNCLASSIFIED CHANNEL EXCAVATION  
GEOTEXTILE UNDER STONE FILL  
STONE FILL, TYPE IV  
GRUBBING MATERIAL




61+10

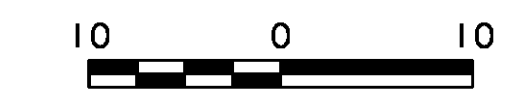

SCALE: 1" = 10'-0"

STA. 61+10 TO STA. 61+20


PROJECT NAME:	ROYALTON
PROJECT NUMBER:	BRS 0147 (13)
FILE NAME:	\BR_28\86e055xsl-28.dgn
PROJECT LEADER:	C. CARLSON
DESIGNED BY:	D. PETERSON
BRIDGE 28 CHANNEL LINE CROSS SECTIONS (5) SHEET	150 OF 186
PLOT DATE:	08-OCT-2013
DRAWN BY:	STR3
CHECKED BY:	C. CARLSON

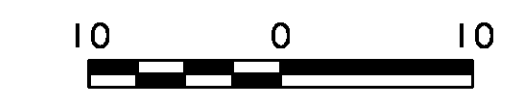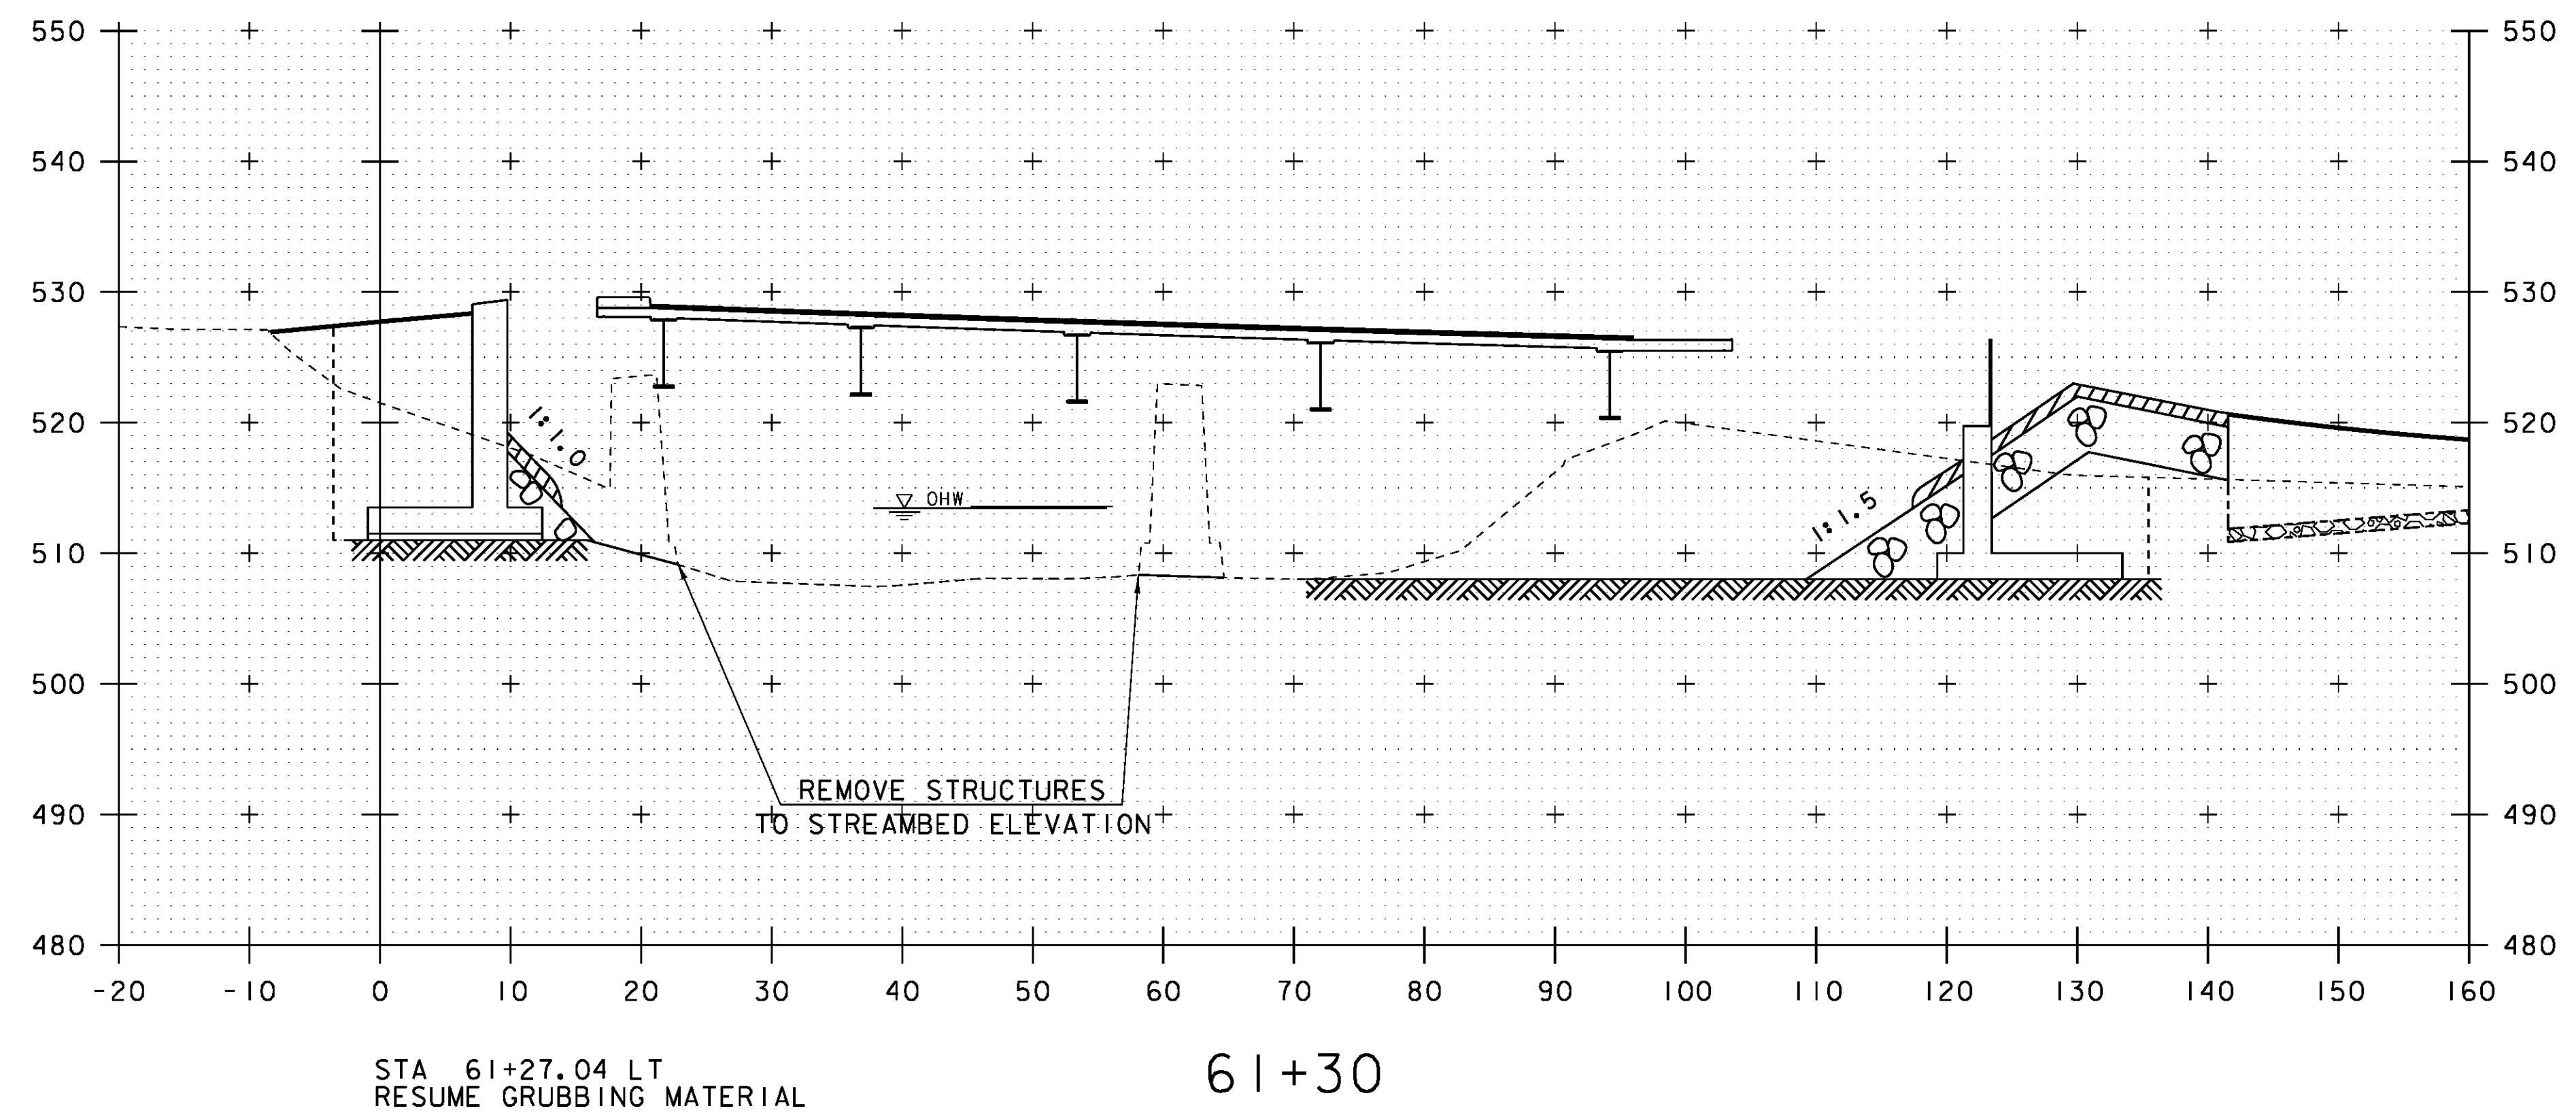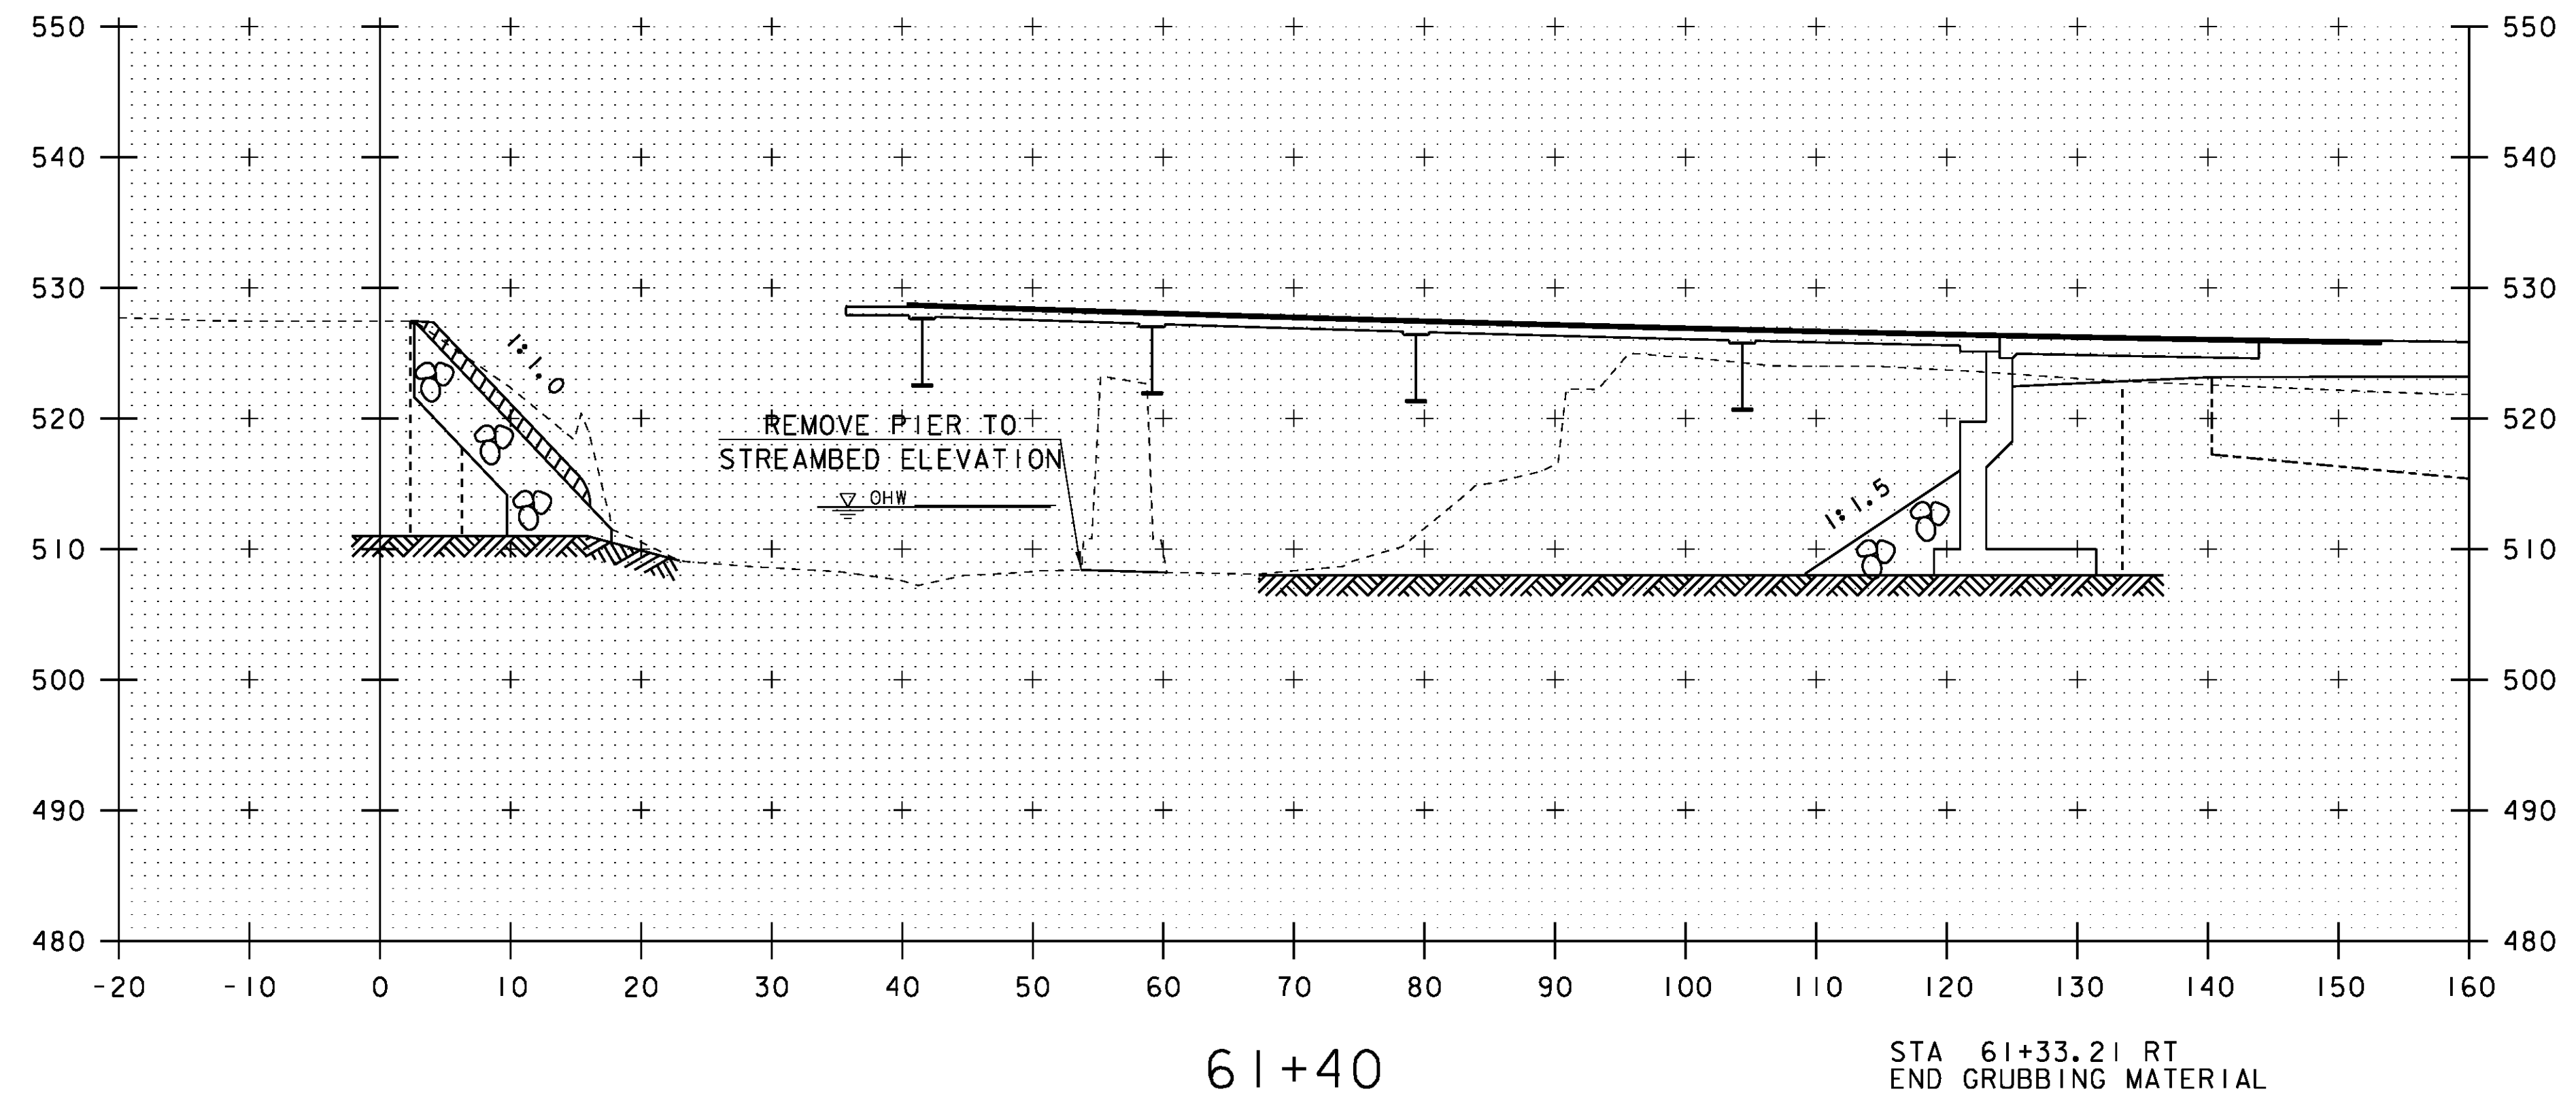


SCALE: 1" = 10'-0"

STA. 61+30 TO STA. 61+40

PROJECT NAME:	ROYALTON
PROJECT NUMBER:	BRS 0147 (13)
FILE NAME:	\BR_28\86e055xsl_28.dgn
PROJECT LEADER:	C. CARLSON
DESIGNED BY:	D. PETERSON
BRIDGE 28 CHANNEL LINE CROSS SECTIONS (6) SHEET	151 OF 186
PLOT DATE:	08-OCT-2013
DRAWN BY:	STR3
CHECKED BY:	C. CARLSON

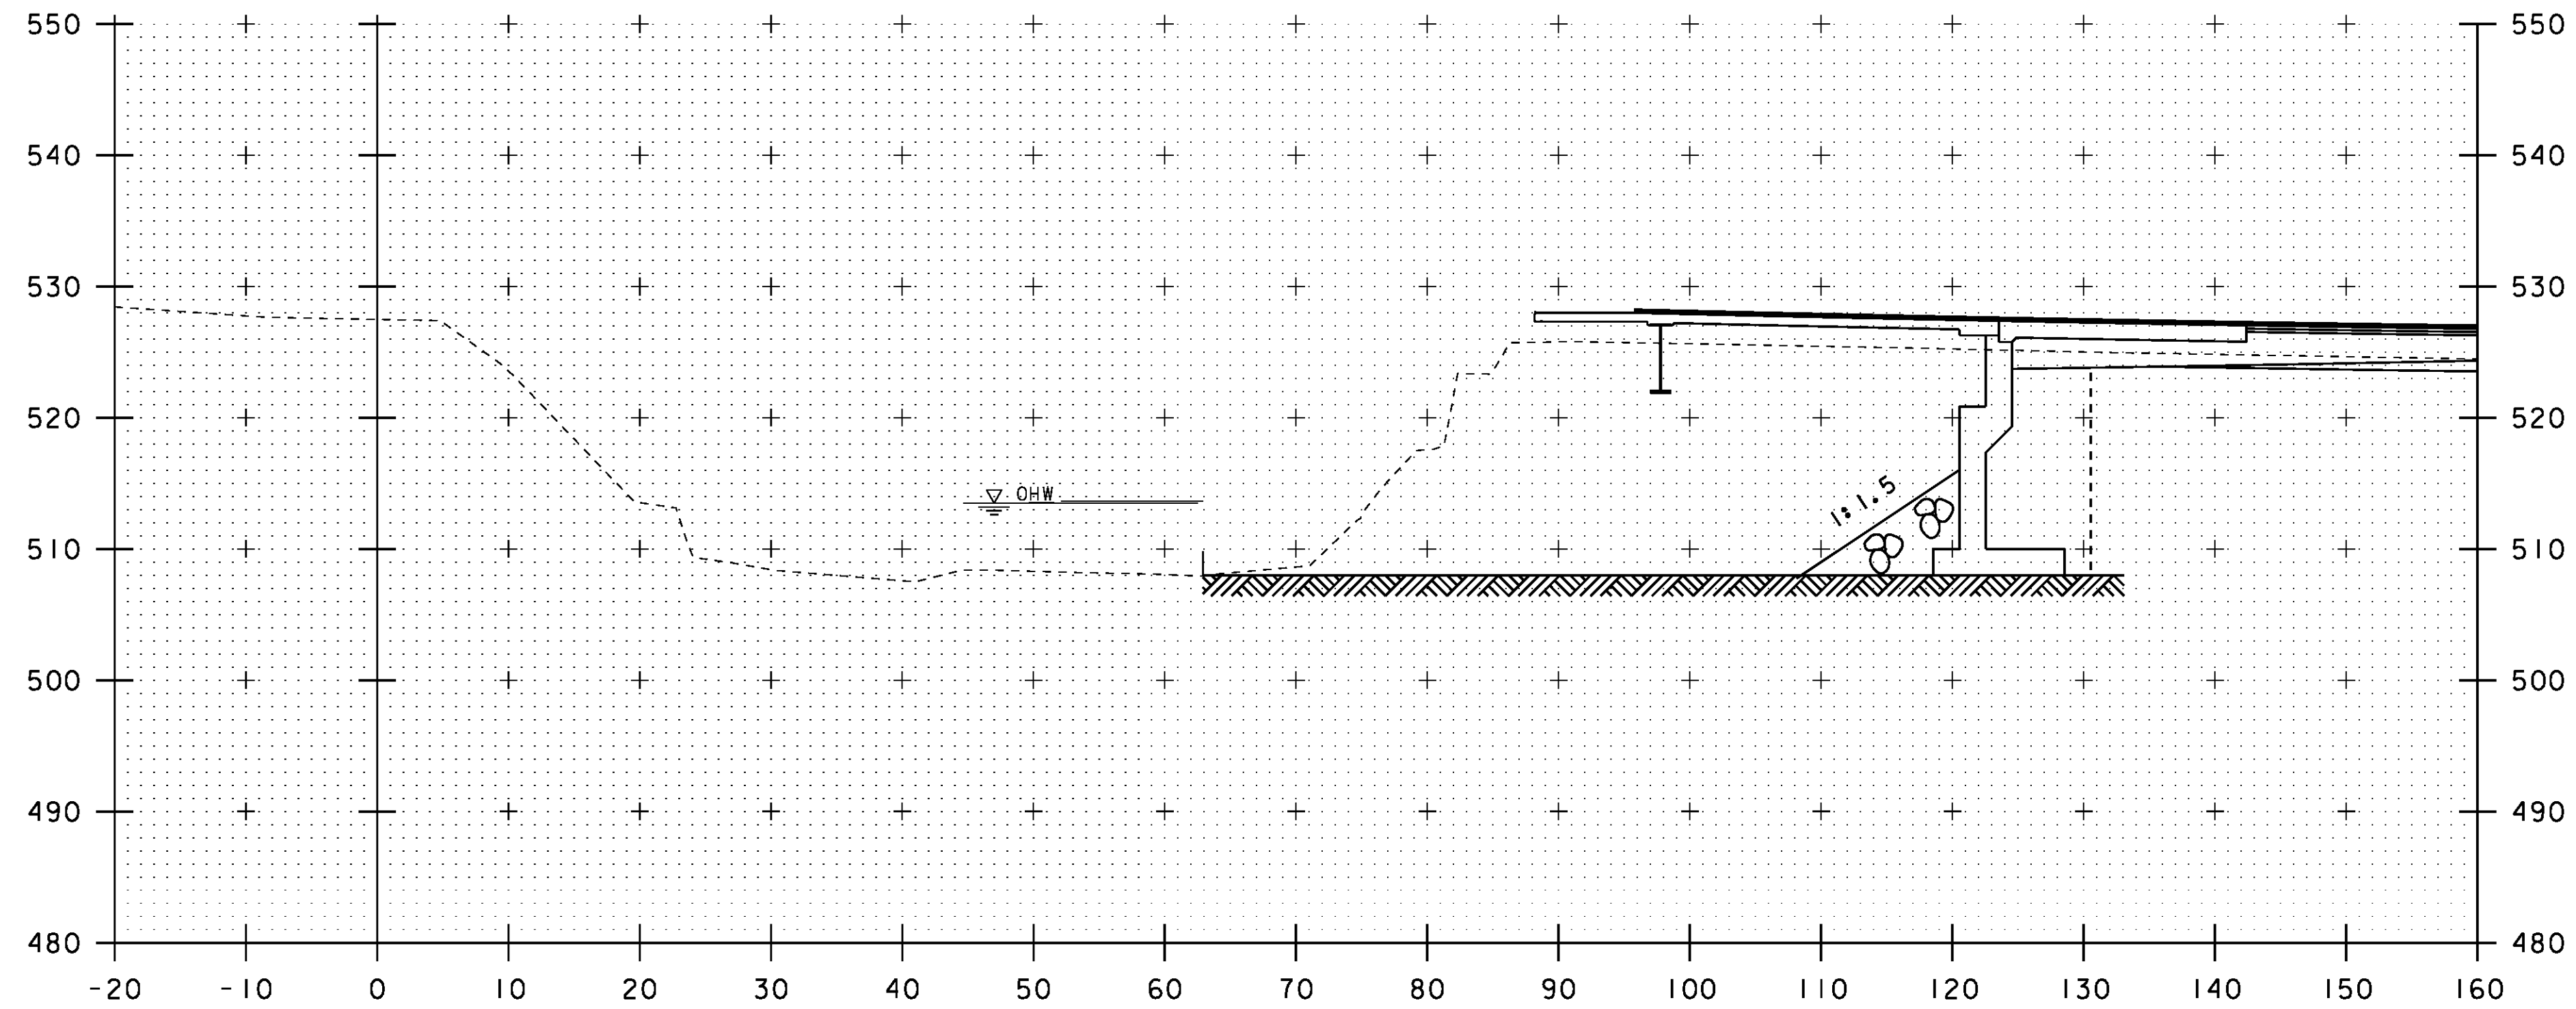


61+60

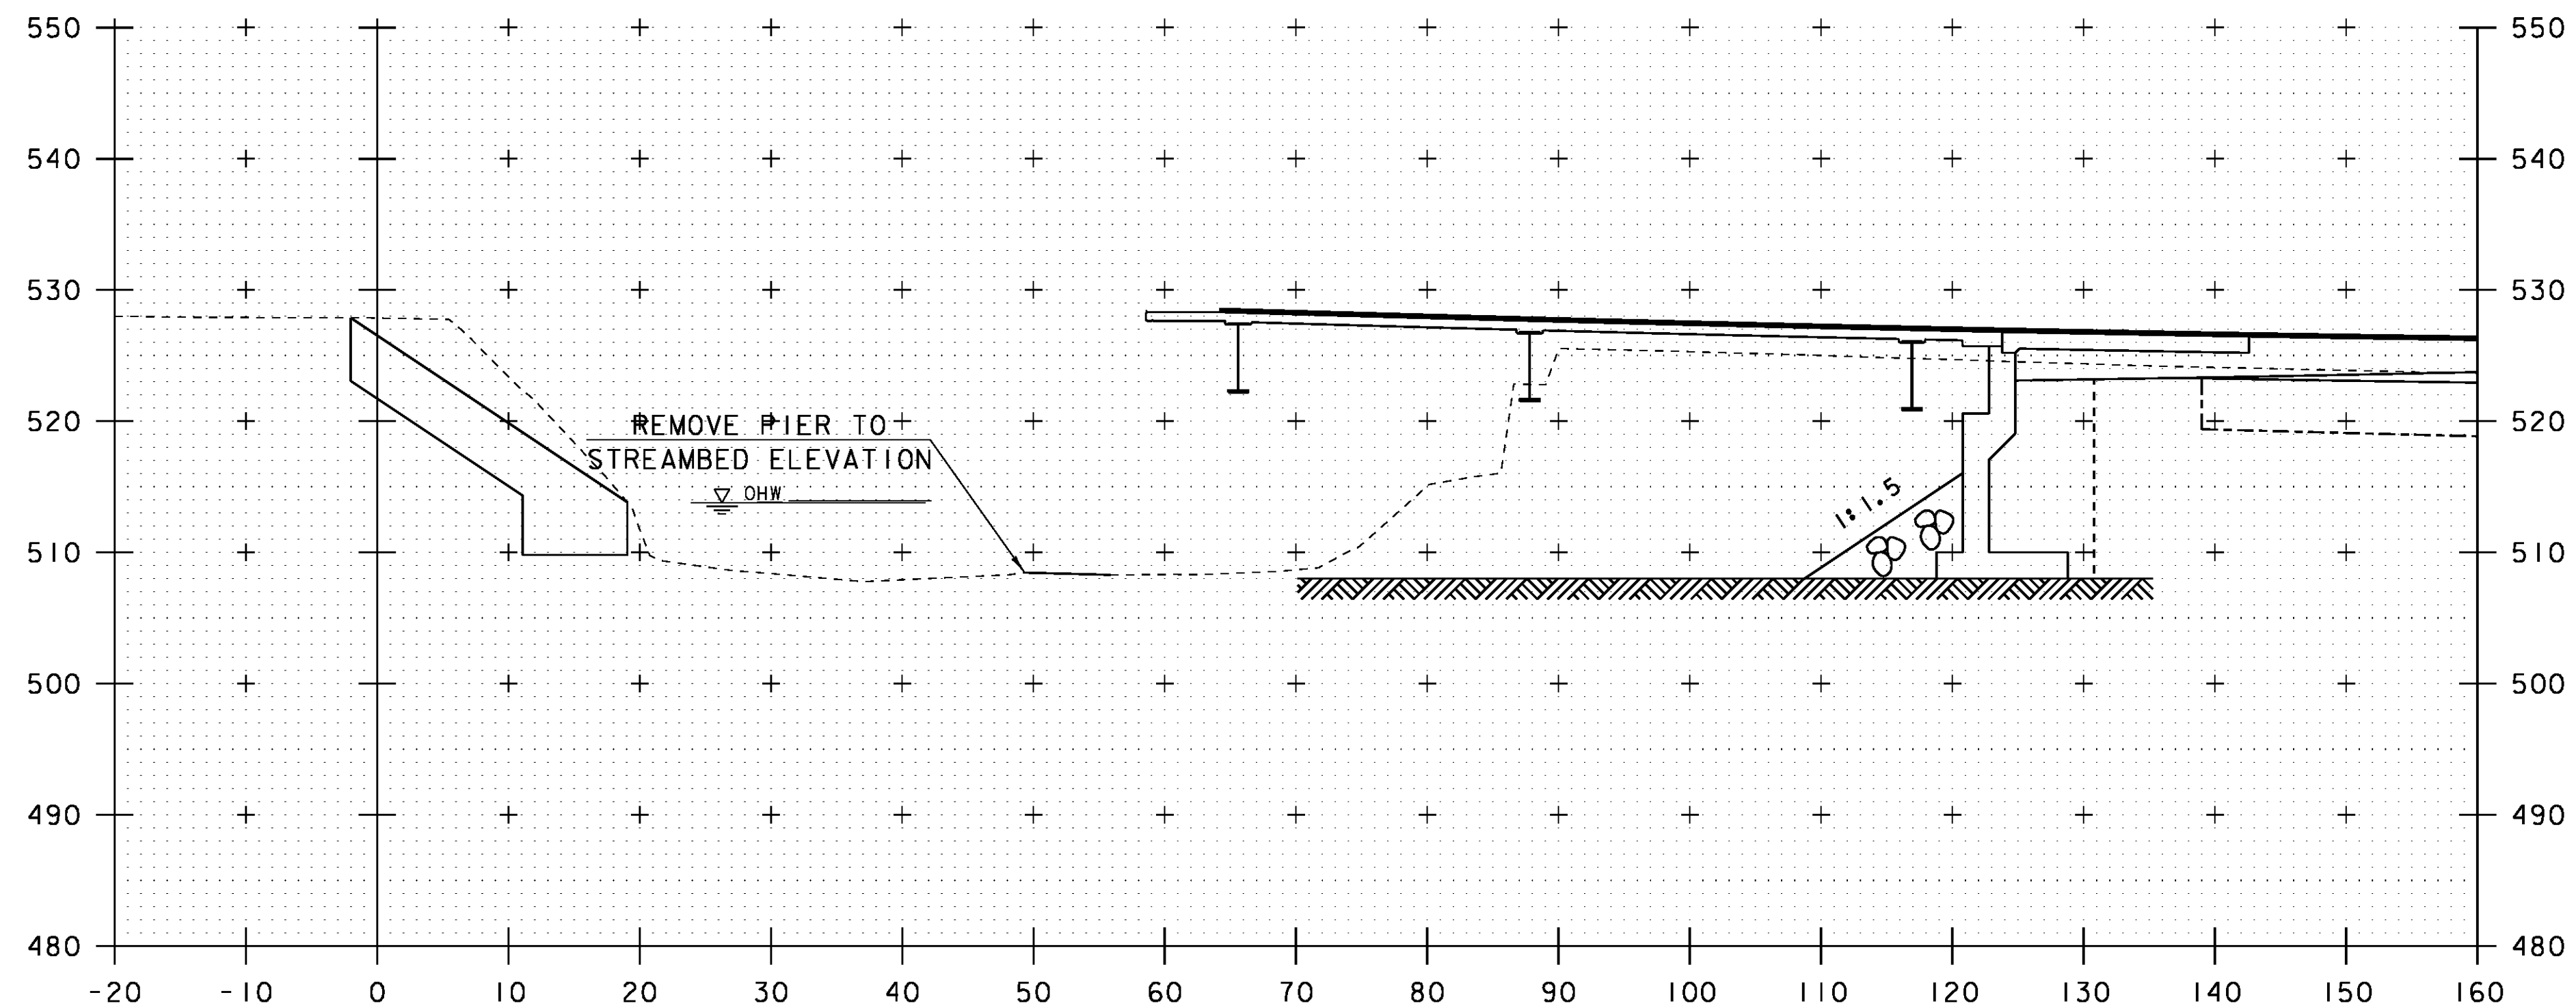

61+50


STA 61+46.13 LT  
 END UNCLASSIFIED CHANNEL EXCAVATION  
 GEOTEXTILE UNDER STONE FILL  
 STONE FILL, TYPE IV  
 GRUBBING MATERIAL

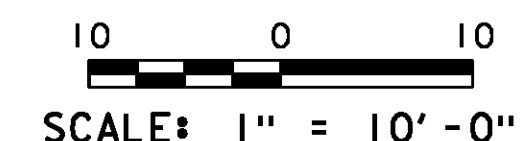


STA. 61+50 TO STA. 61+60

PROJECT NAME:	ROYALTON
PROJECT NUMBER:	BRS 0147 (13)
FILE NAME:	\BR_28\86e055xsl-28.dgn
PROJECT LEADER:	C. CARLSON
DESIGNED BY:	D. PETERSON
BRIDGE 28 CHANNEL LINE CROSS SECTIONS (7) SHEET	152 OF 186
PLOT DATE:	08-OCT-2013
DRAWN BY:	STR3
CHECKED BY:	C. CARLSON



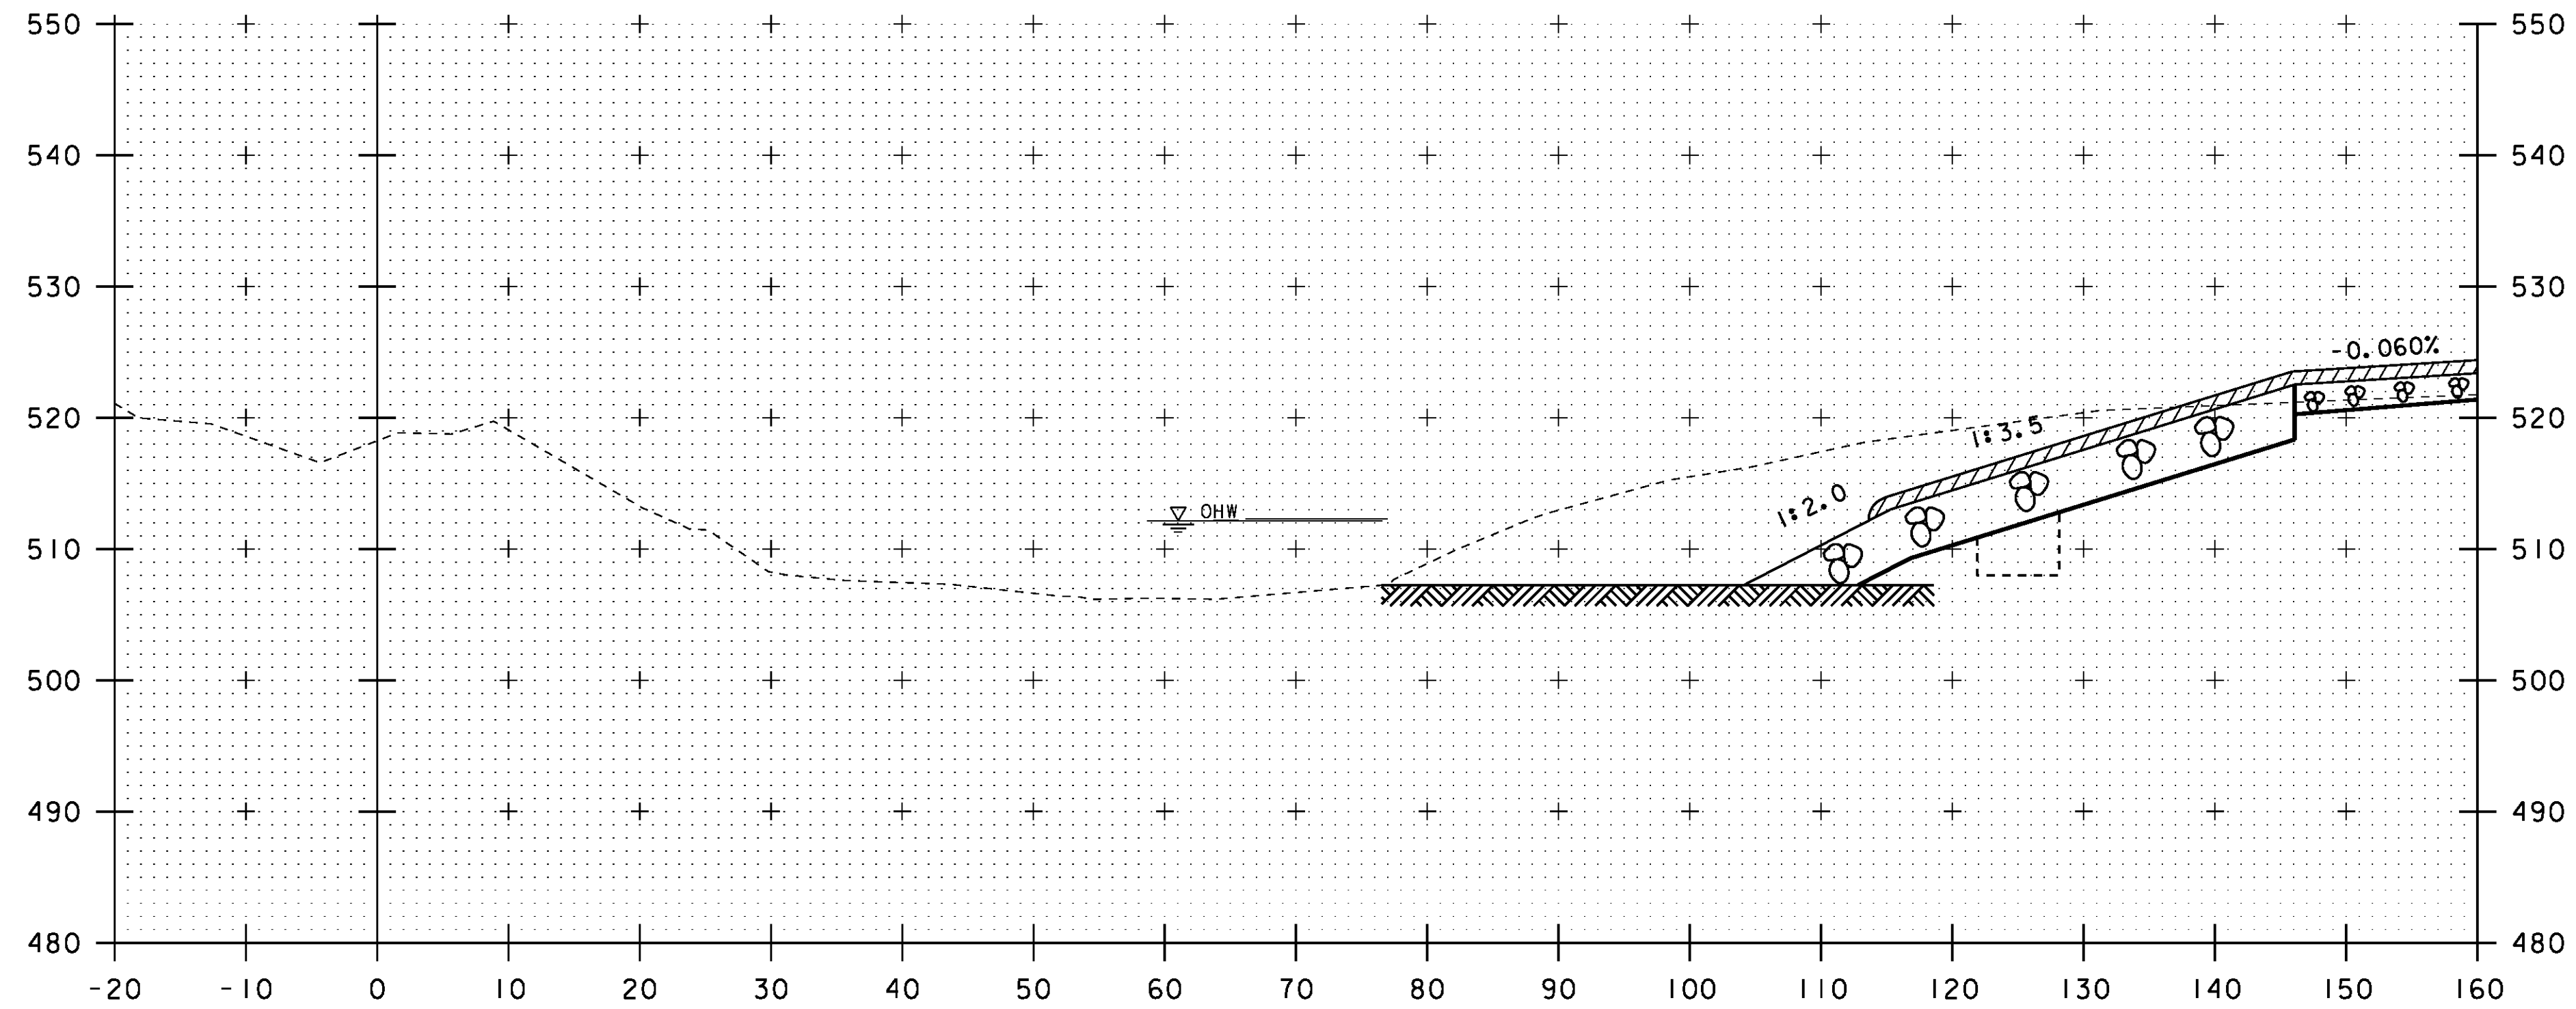


61+80

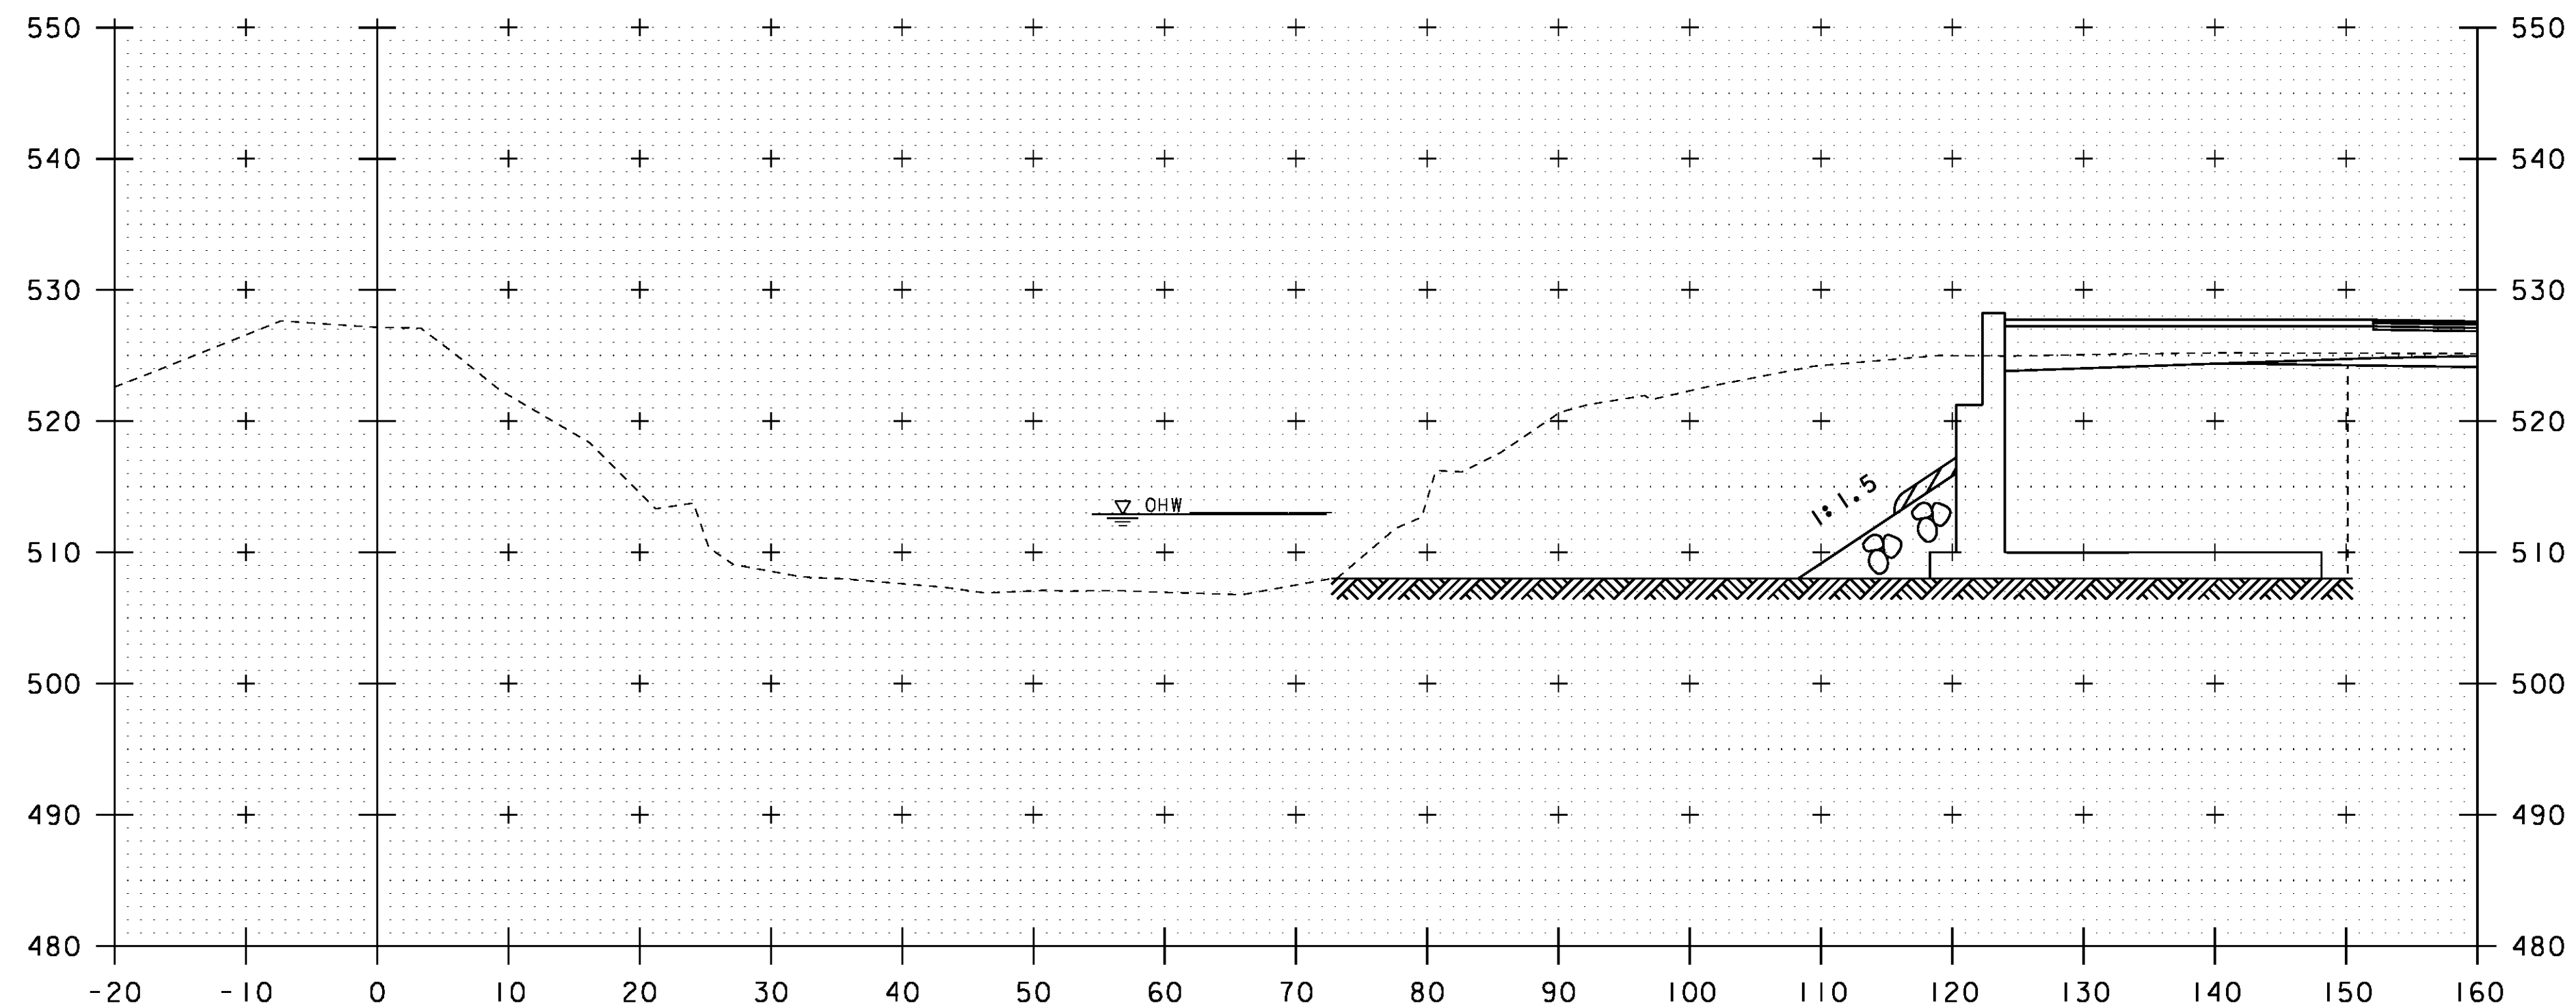

61+70


STA. 61+65.00 RT  
BEGIN GRUBBING MATERIAL

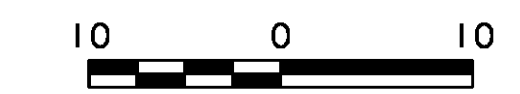

SCALE: 1" = 10'-0"


STA. 61+70 TO STA. 61+80

PROJECT NAME:	ROYALTON
PROJECT NUMBER:	BRS 0147 (13)
FILE NAME:	\BR_28\s86e055xsl_28.dgn
PROJECT LEADER:	C. CARLSON
DESIGNED BY:	D. PETERSON
BRIDGE 28 CHANNEL LINE CROSS SECTIONS (8) SHEET	153 OF 186
PLOT DATE:	08-OCT-2013
DRAWN BY:	STR3
CHECKED BY:	C. CARLSON

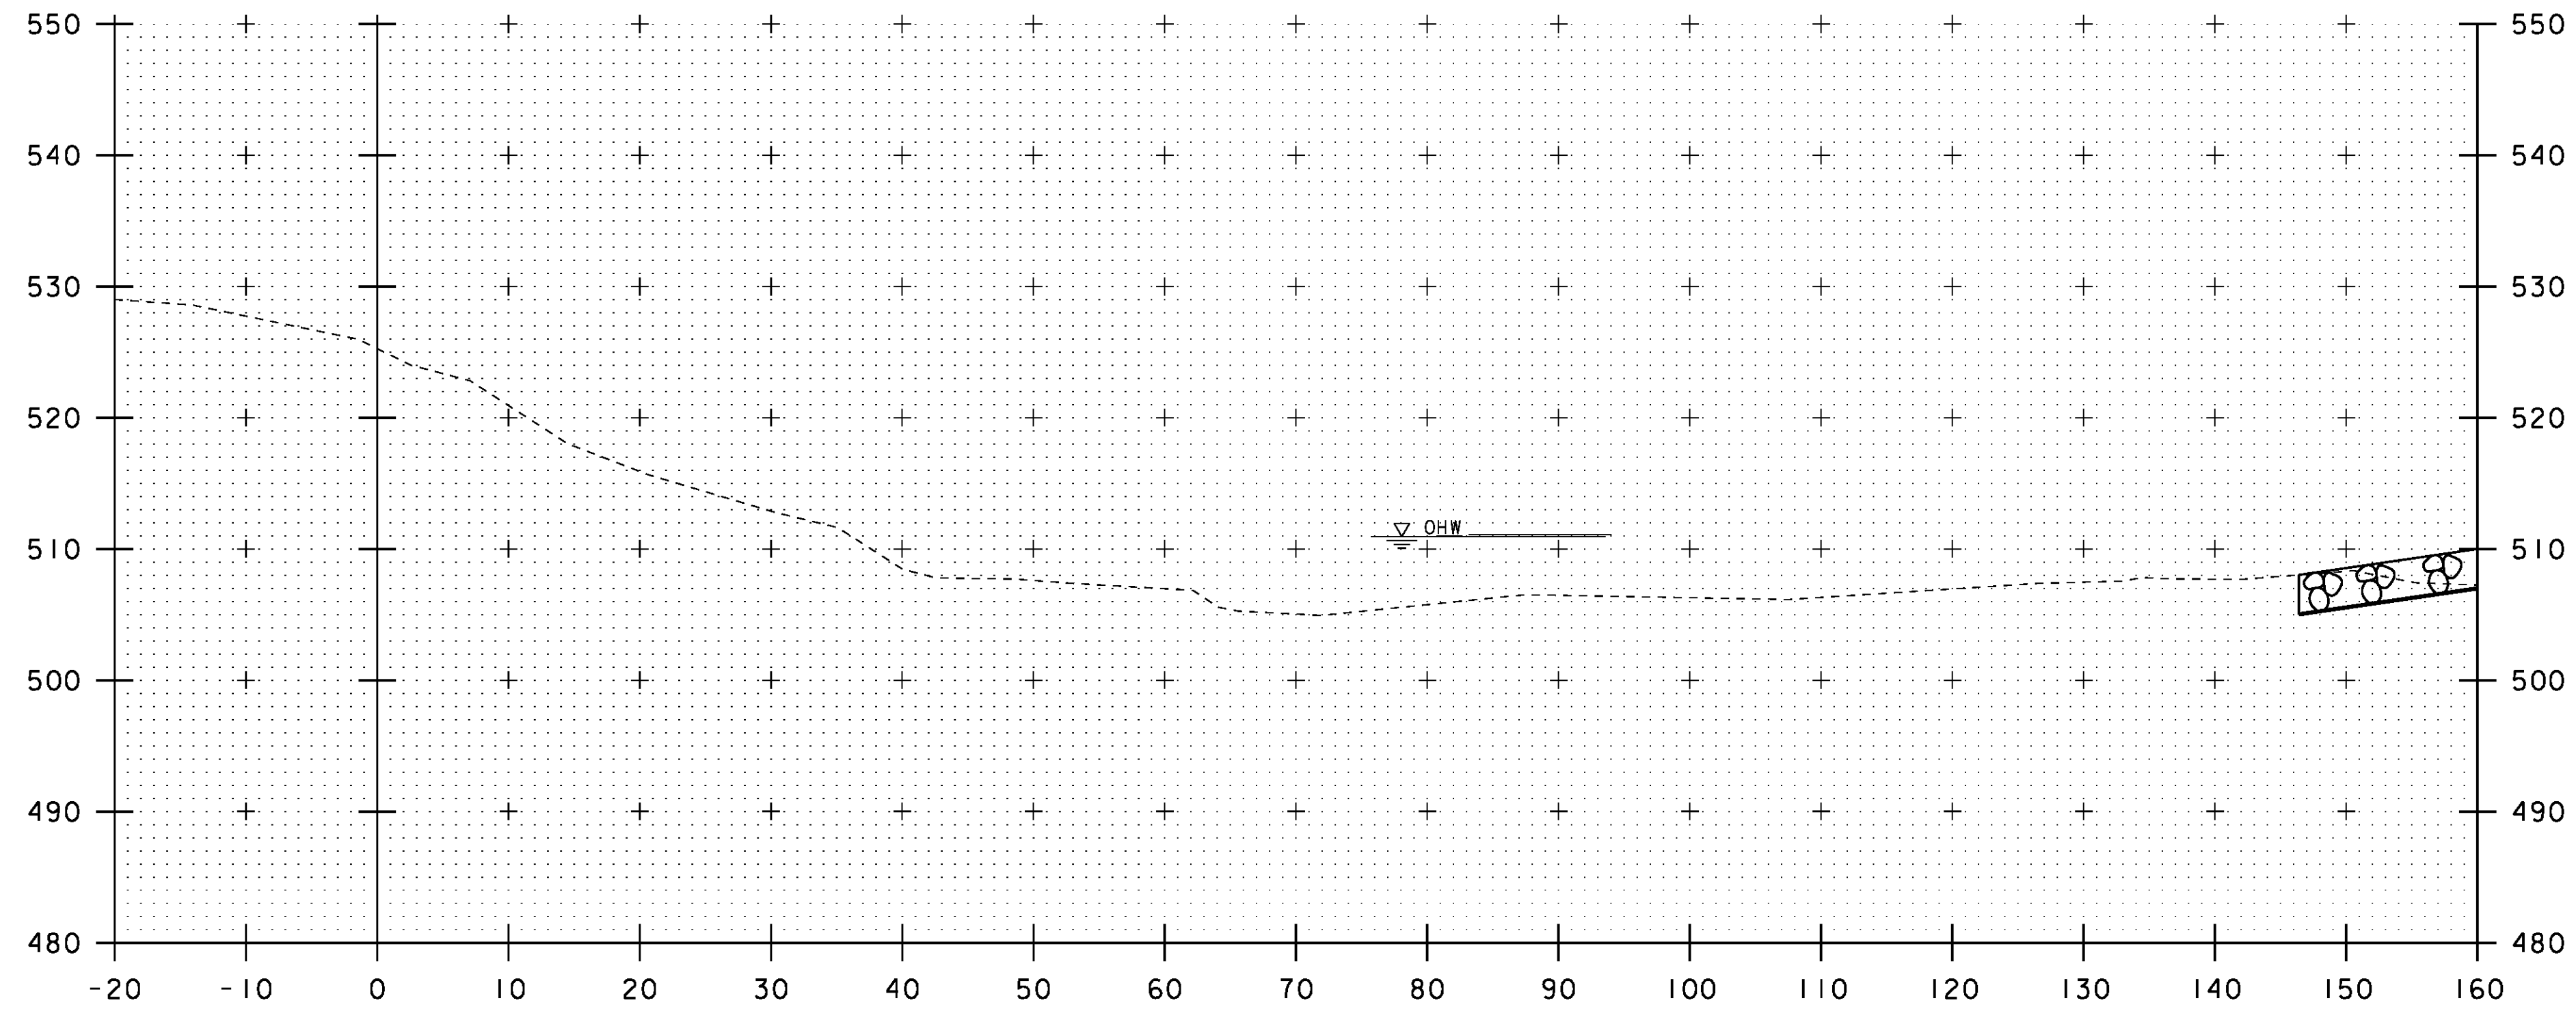


62+00

STA 62+00  
 END UNCLASSIFIED CHANNEL EXCAVATION  
 GEOTEXTILE UNDER STONE FILL  
 STONE FILL, TYPE IV  
 GRUBBING MATERIAL

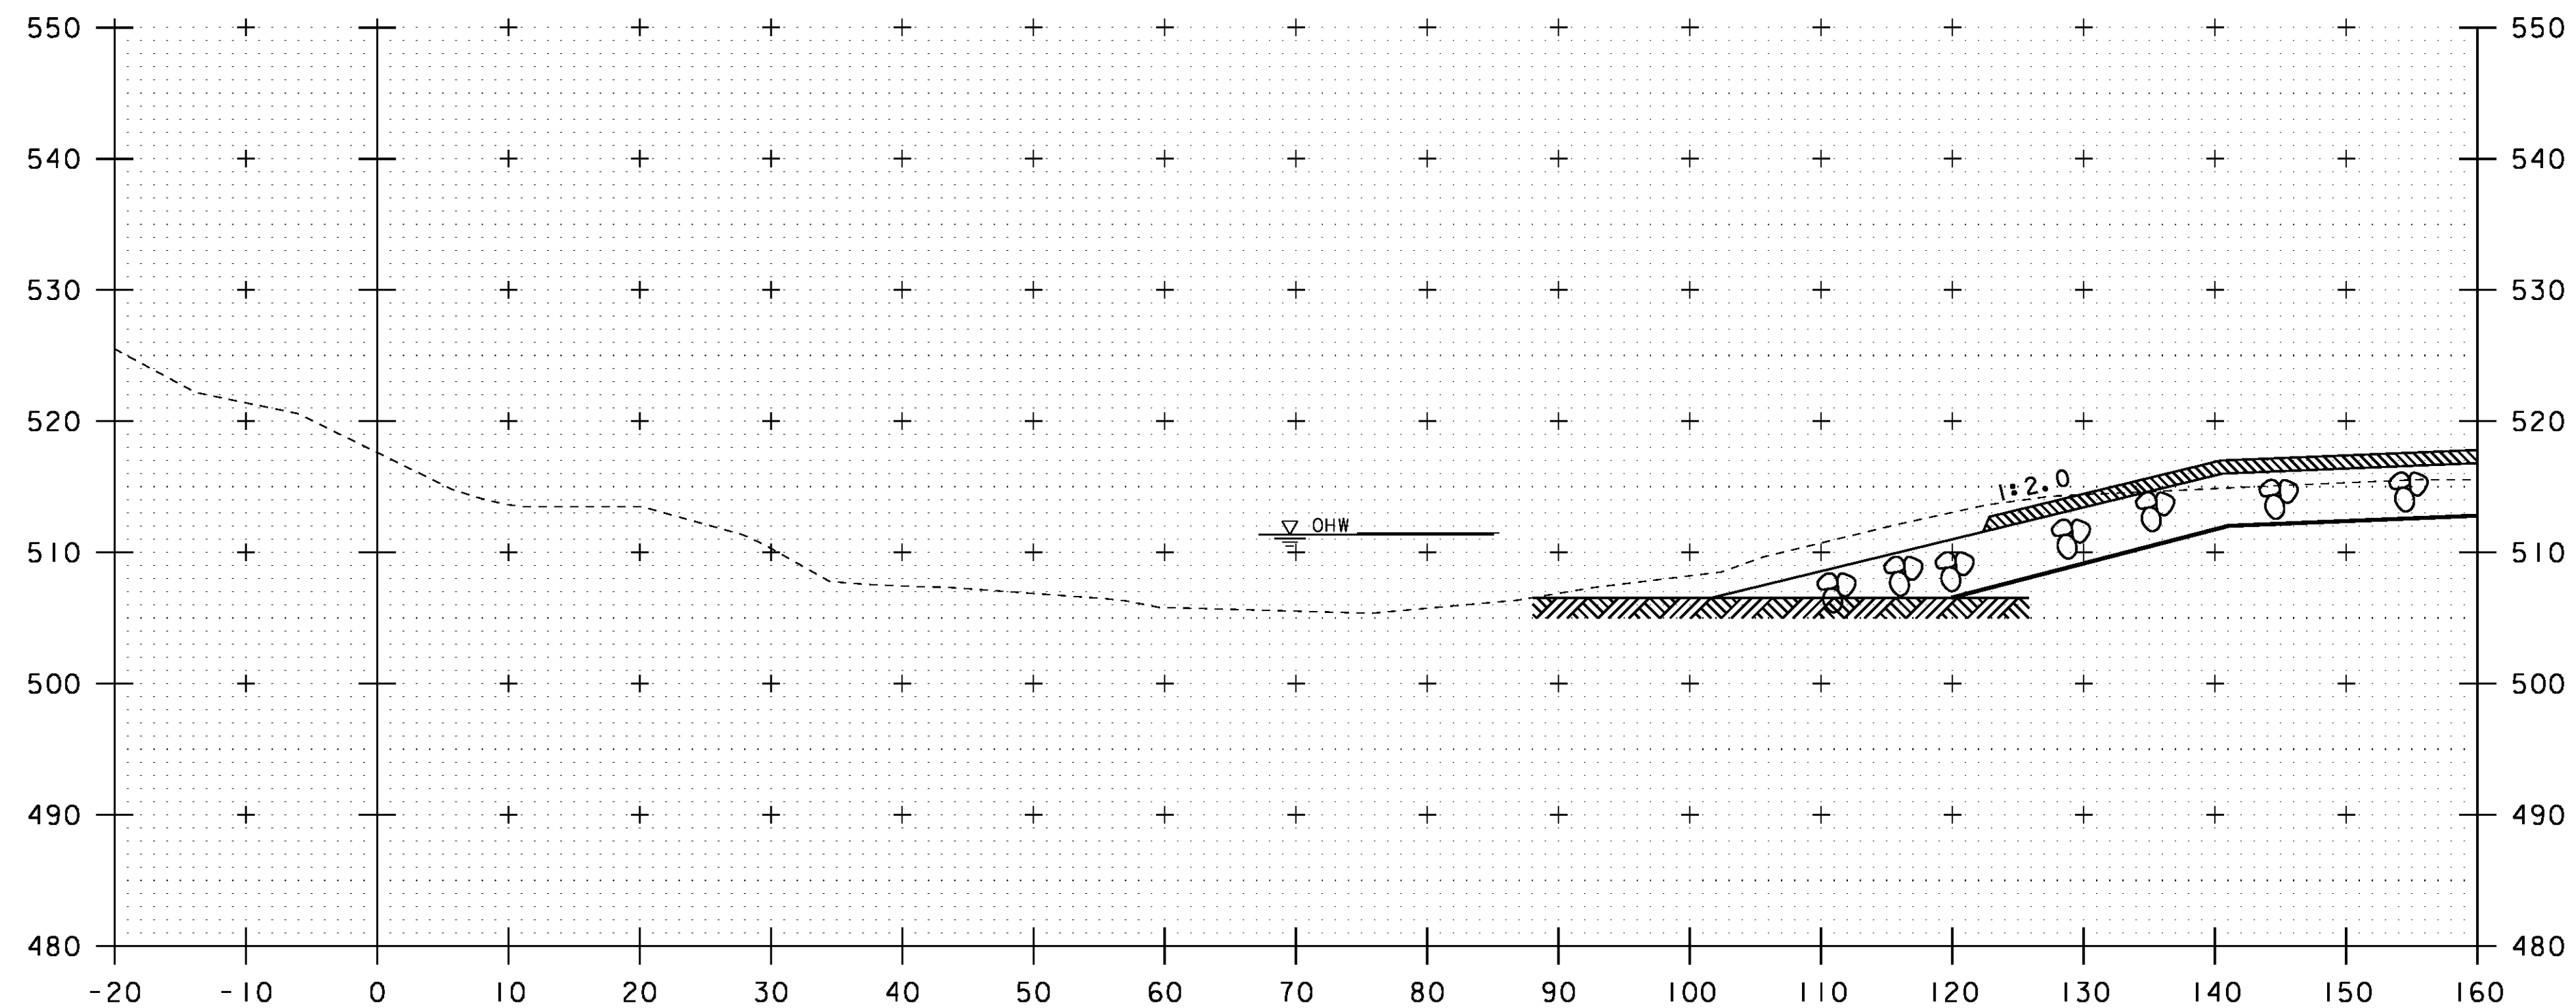






61+90

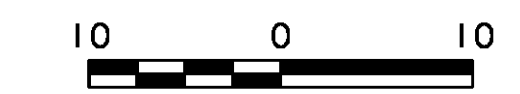

SCALE: 1" = 10'-0"

STA. 61+90 TO STA. 62+00


PROJECT NAME:	ROYALTON
PROJECT NUMBER:	BRS 0147 (13)
FILE NAME:	\BR_28\86e055xsl_28.dgn
PROJECT LEADER:	C. CARLSON
DESIGNED BY:	D. PETERSON
BRIDGE 28 CHANNEL LINE CROSS SECTIONS (9) SHEET	154 OF 186
PLOT DATE:	08-OCT-2013
DRAWN BY:	STR3
CHECKED BY:	C. CARLSON

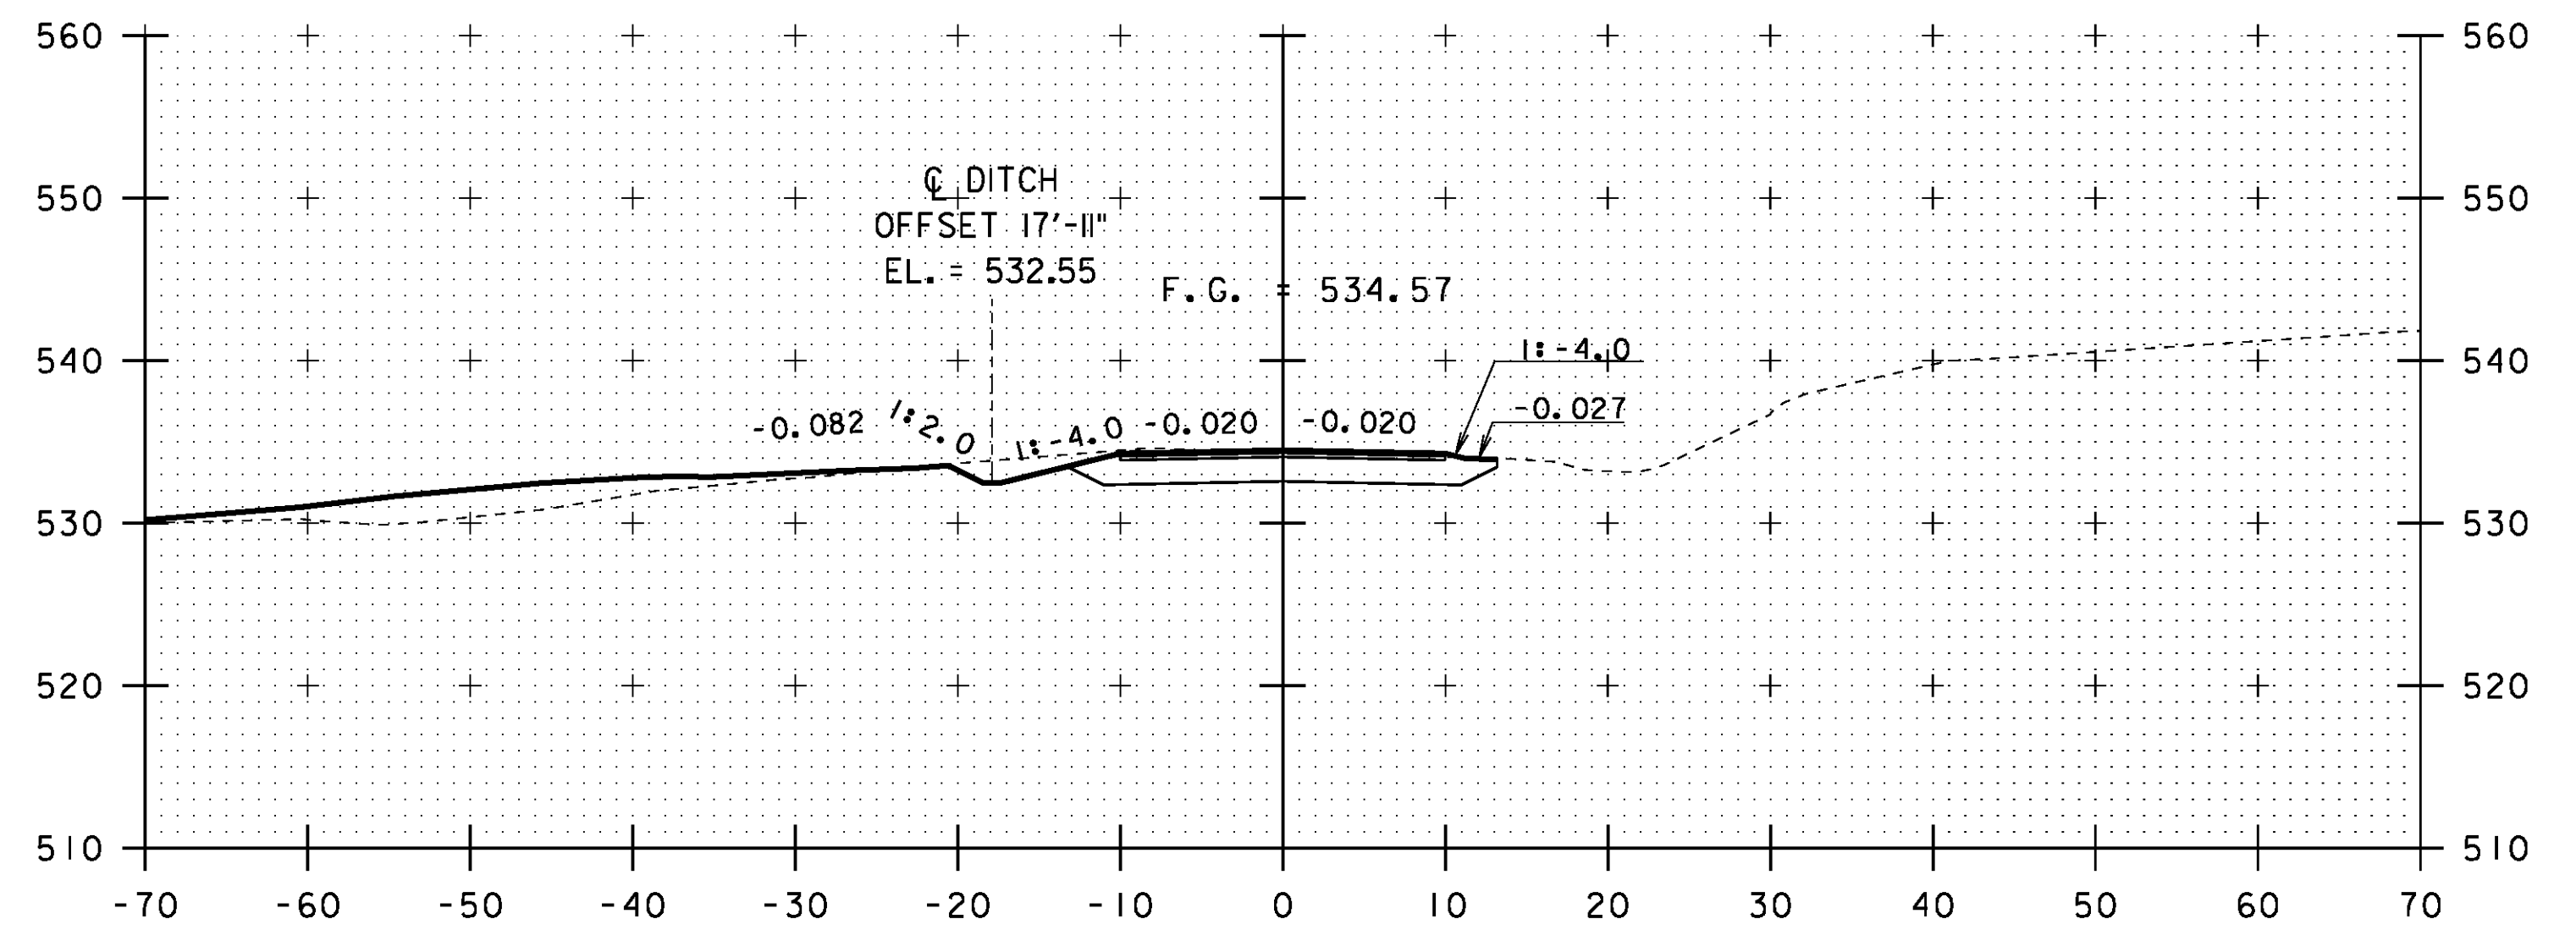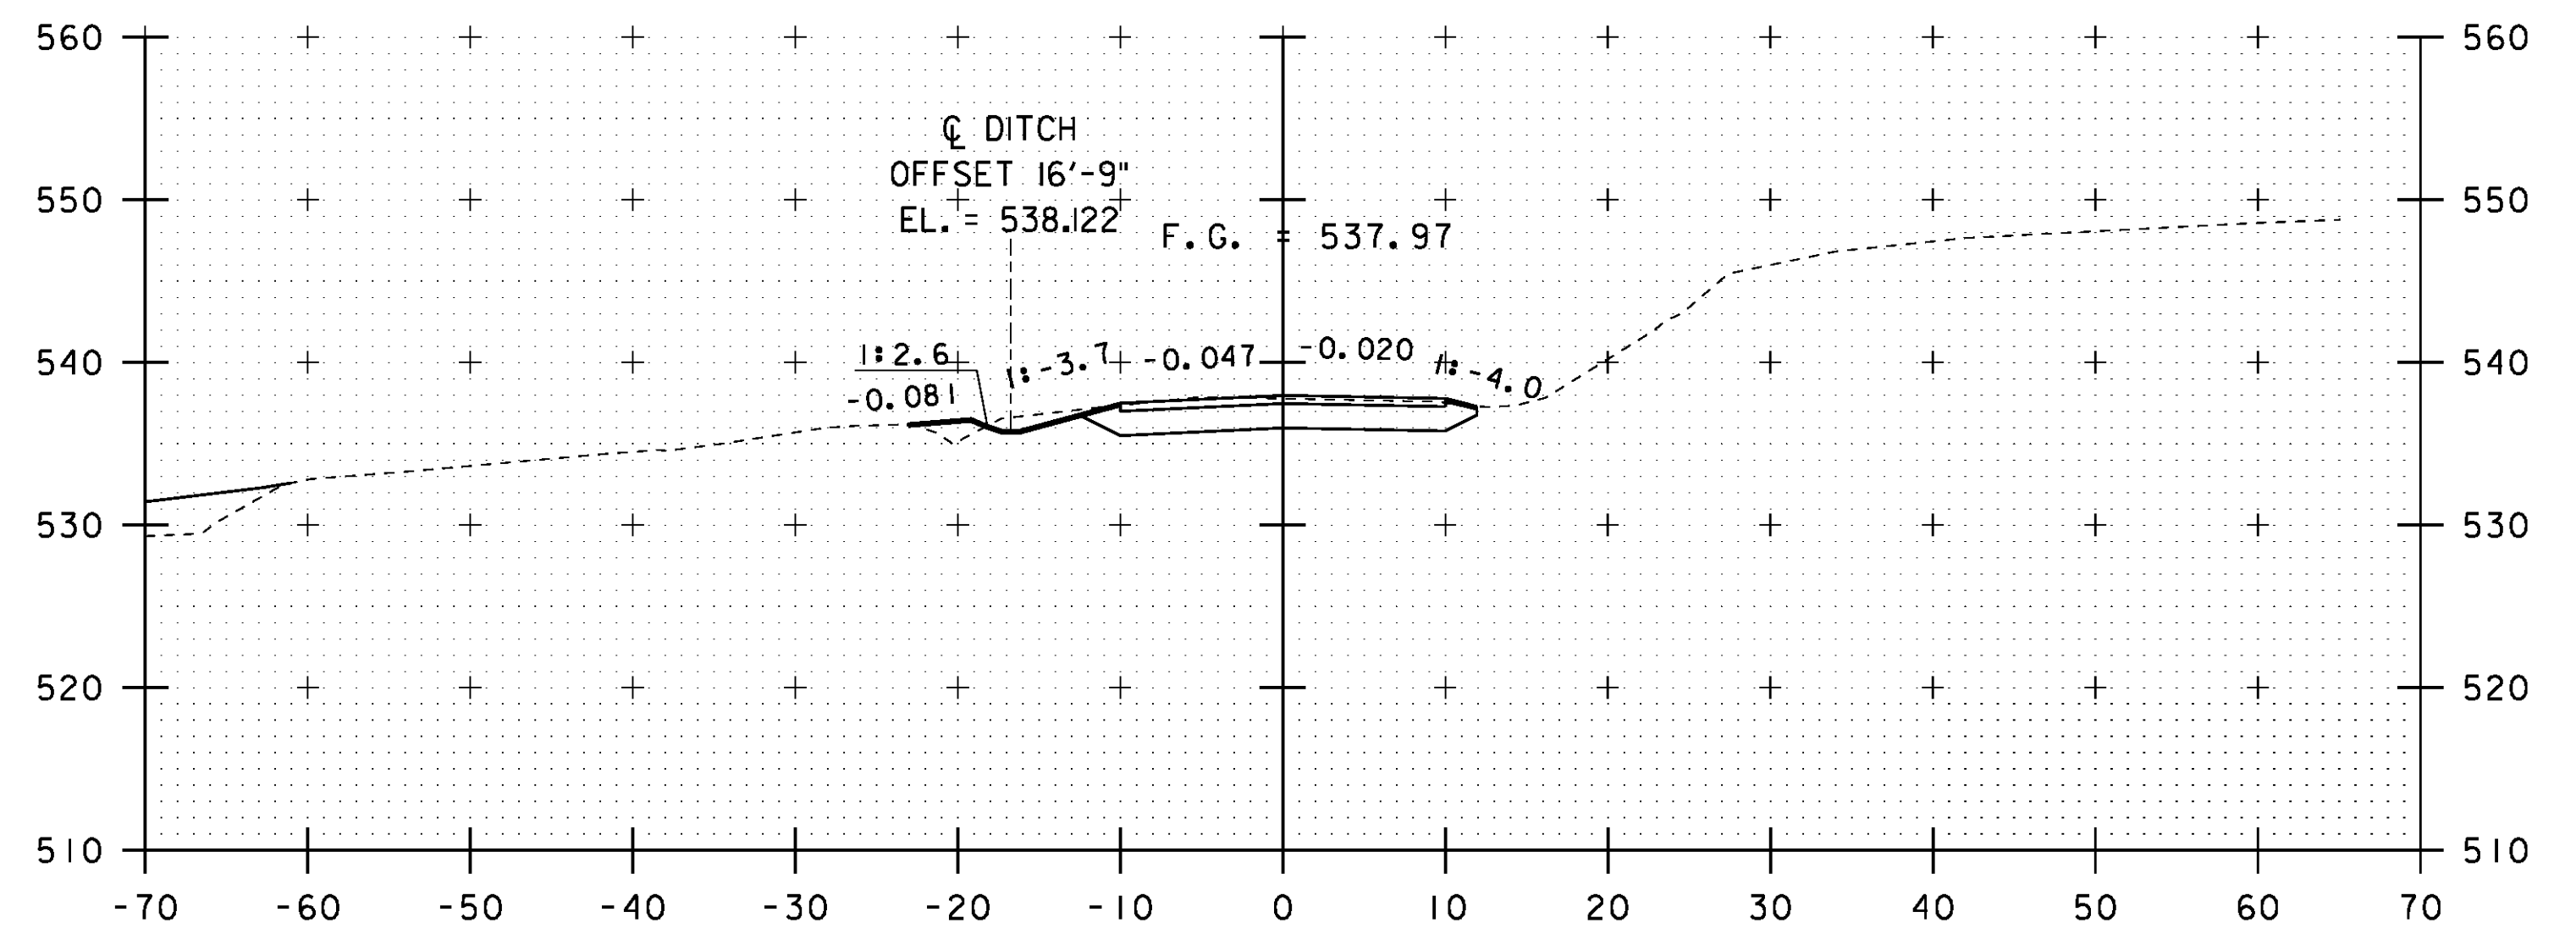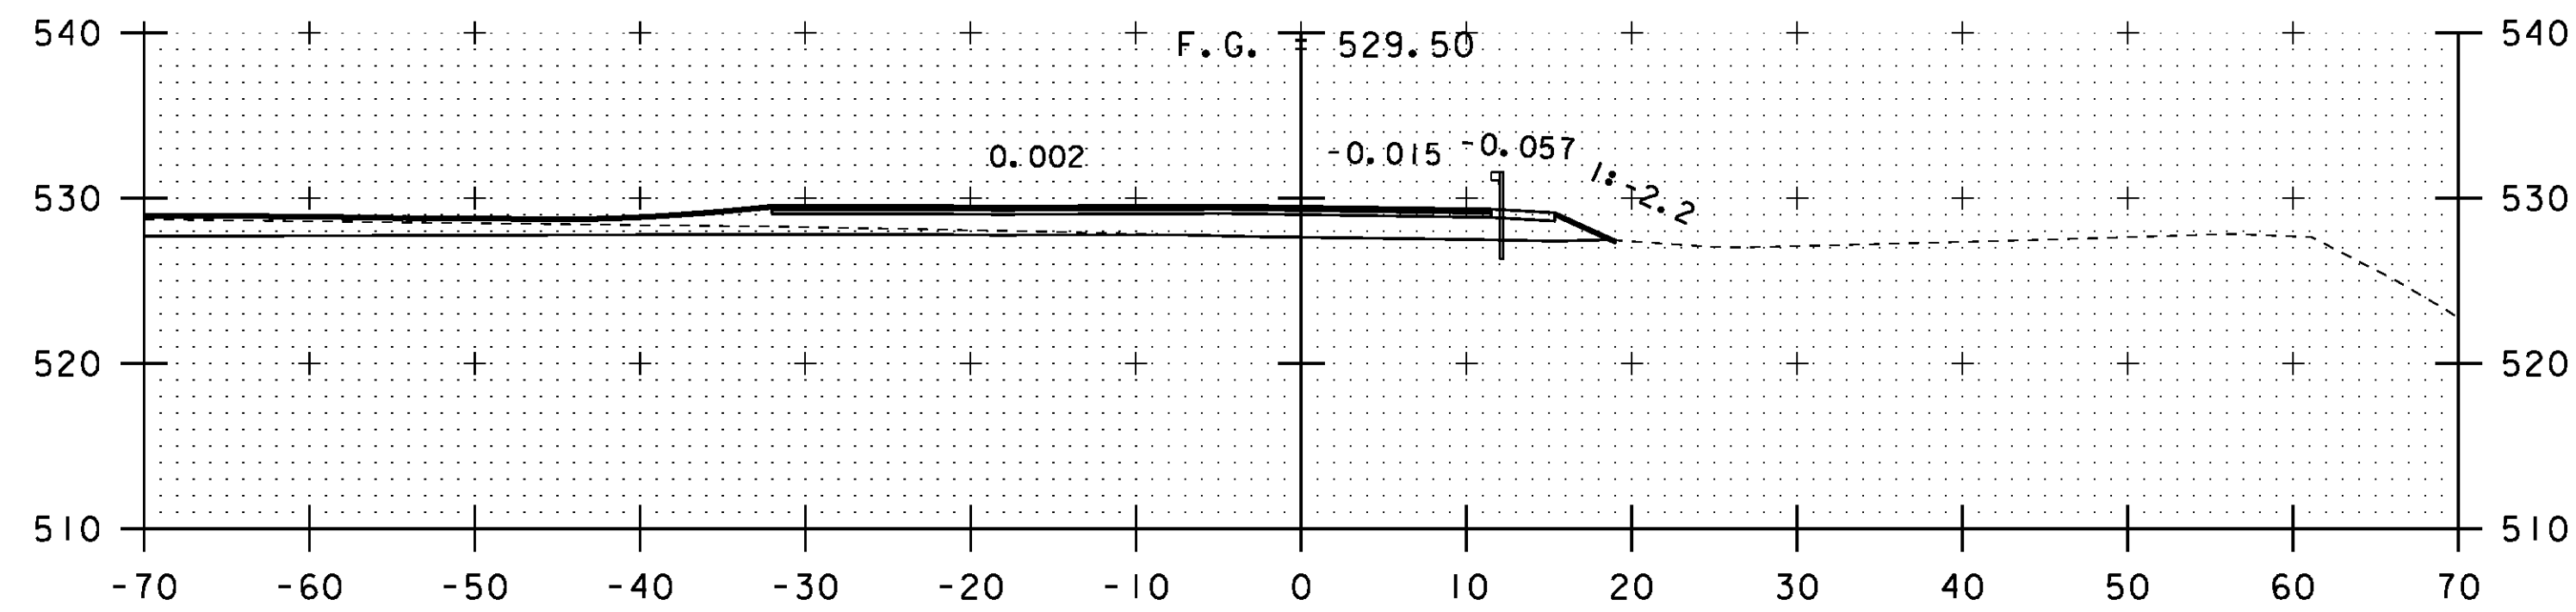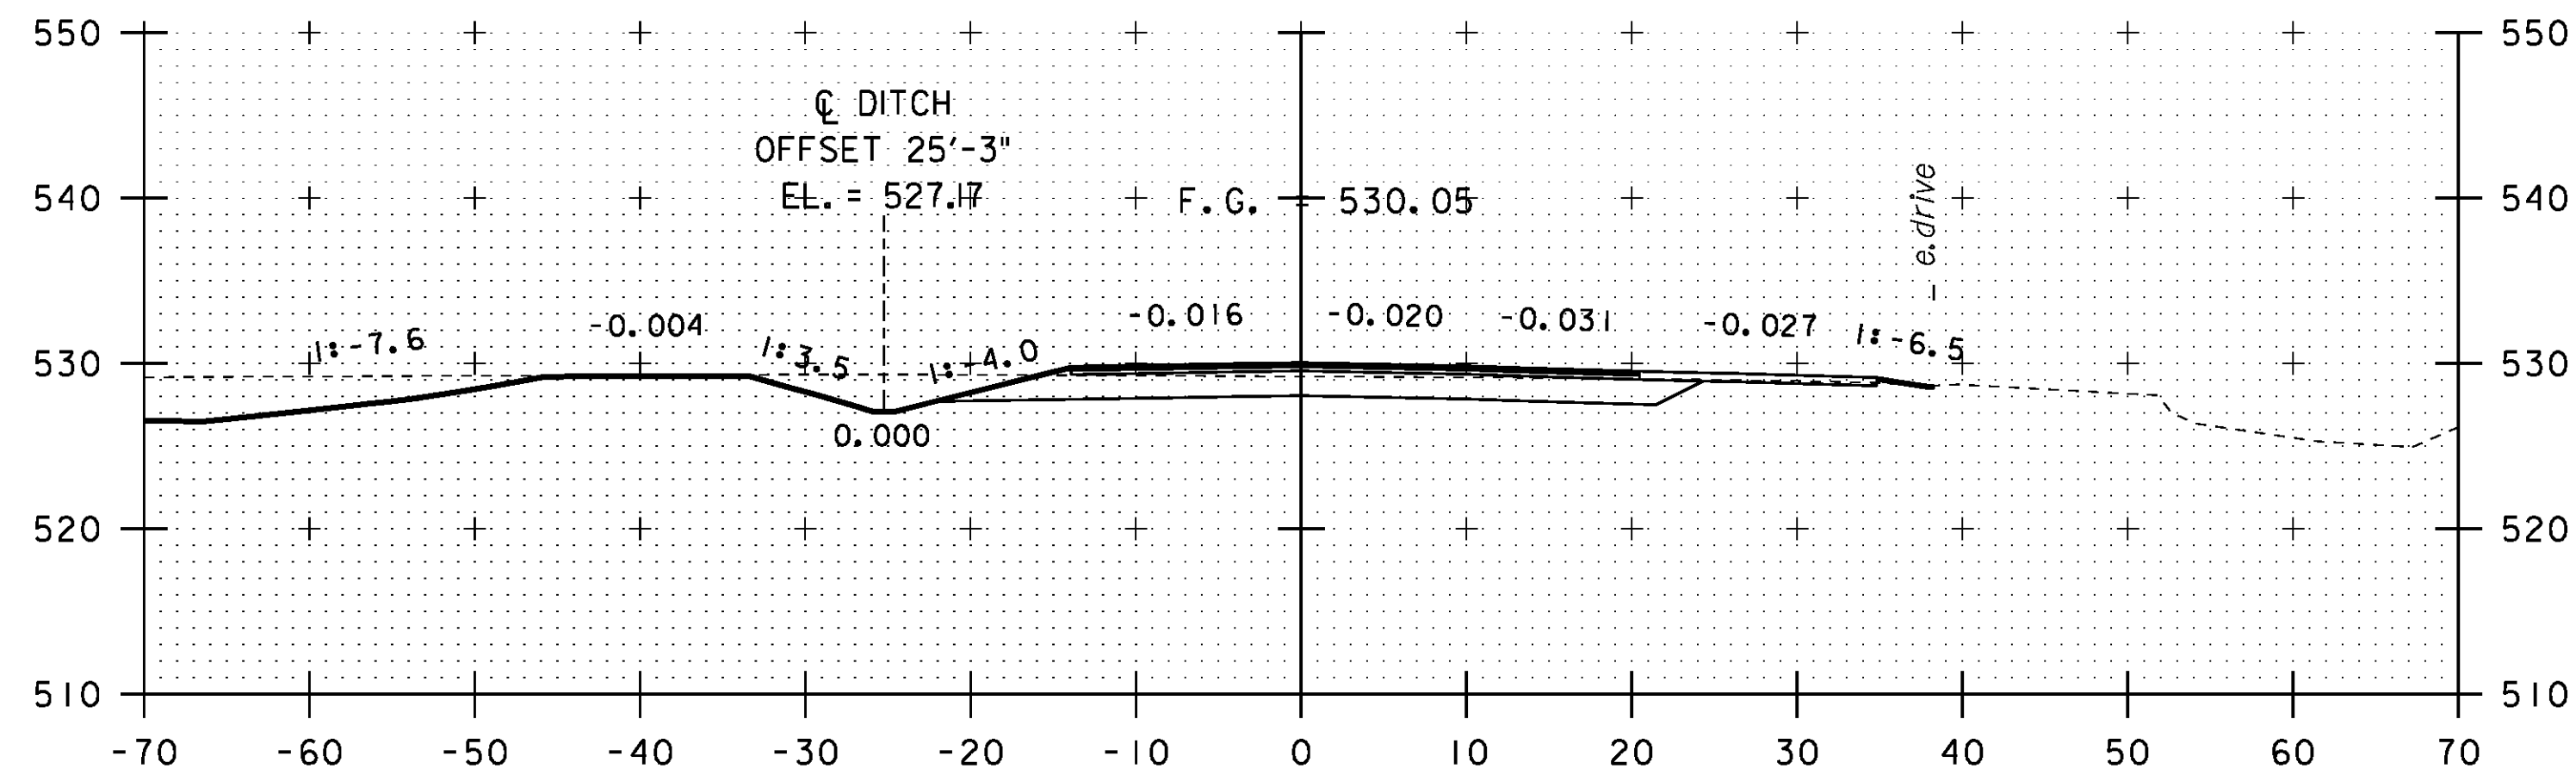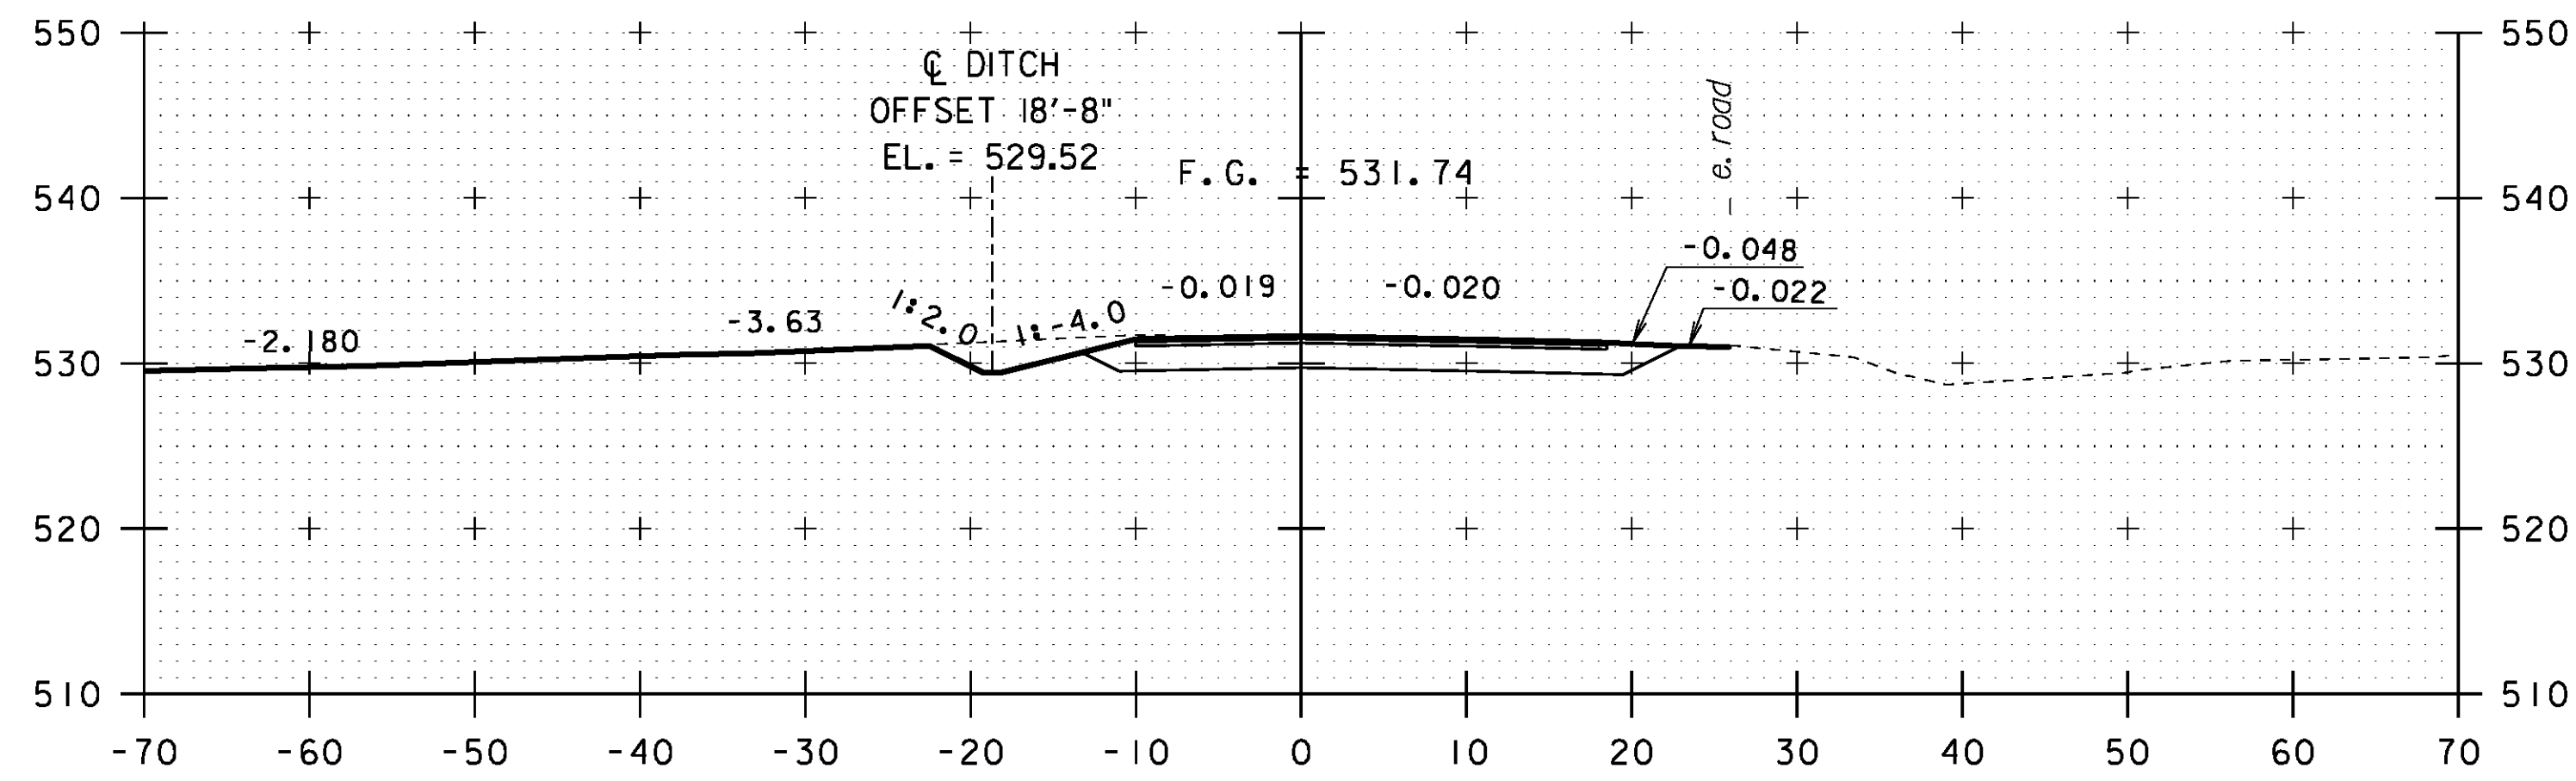

SCALE: 1" = 10'-0"


STA. 30+25 TO STA. 31+25

PROJECT NAME: ROYALTON	PLOT DATE: 08-OCT-2013
PROJECT NUMBER: BRS 0147 (13)	DRAWN BY: STR3
FILE NAME: \BR_28\86e055xsl_28.dgn	CHECKED BY: C. CARLSON
PROJECT LEADER: C. CARLSON	SHEET 155 OF 186
DESIGNED BY: D. PETERSON	
BRIDGE 28 TH 22 CROSS SECTIONS (1)	

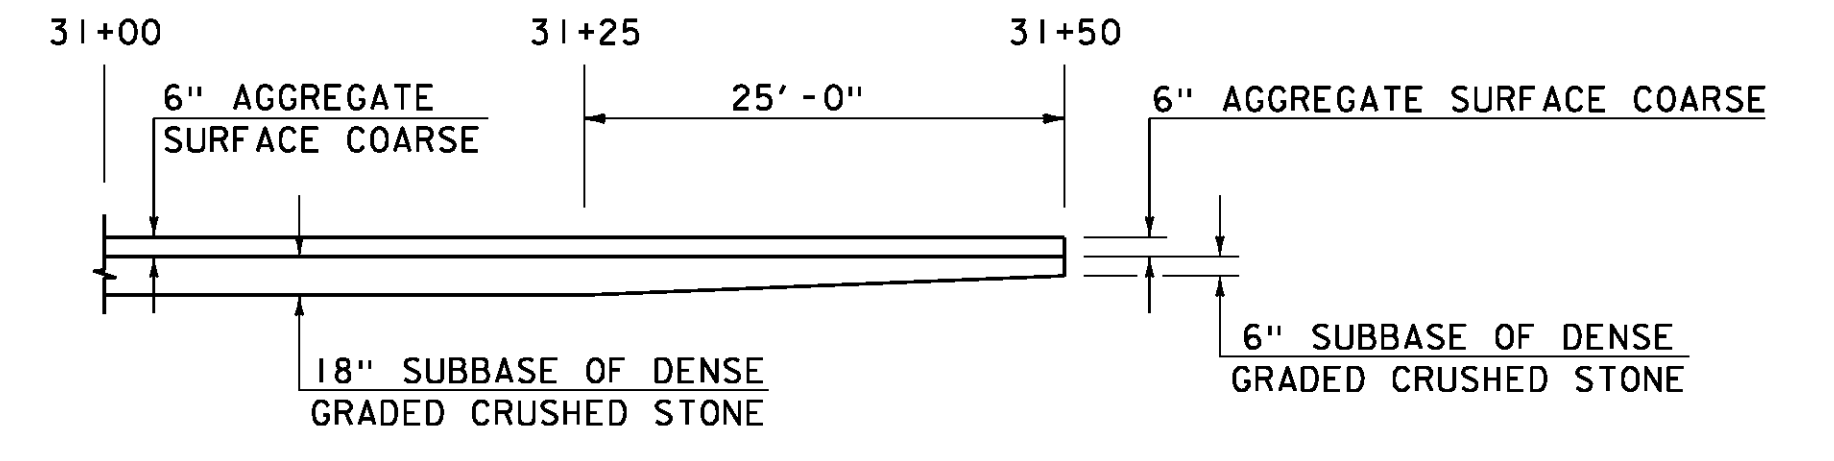


**MATERIAL TRANSITION DIAGRAM**  
**TH #22**


NTS

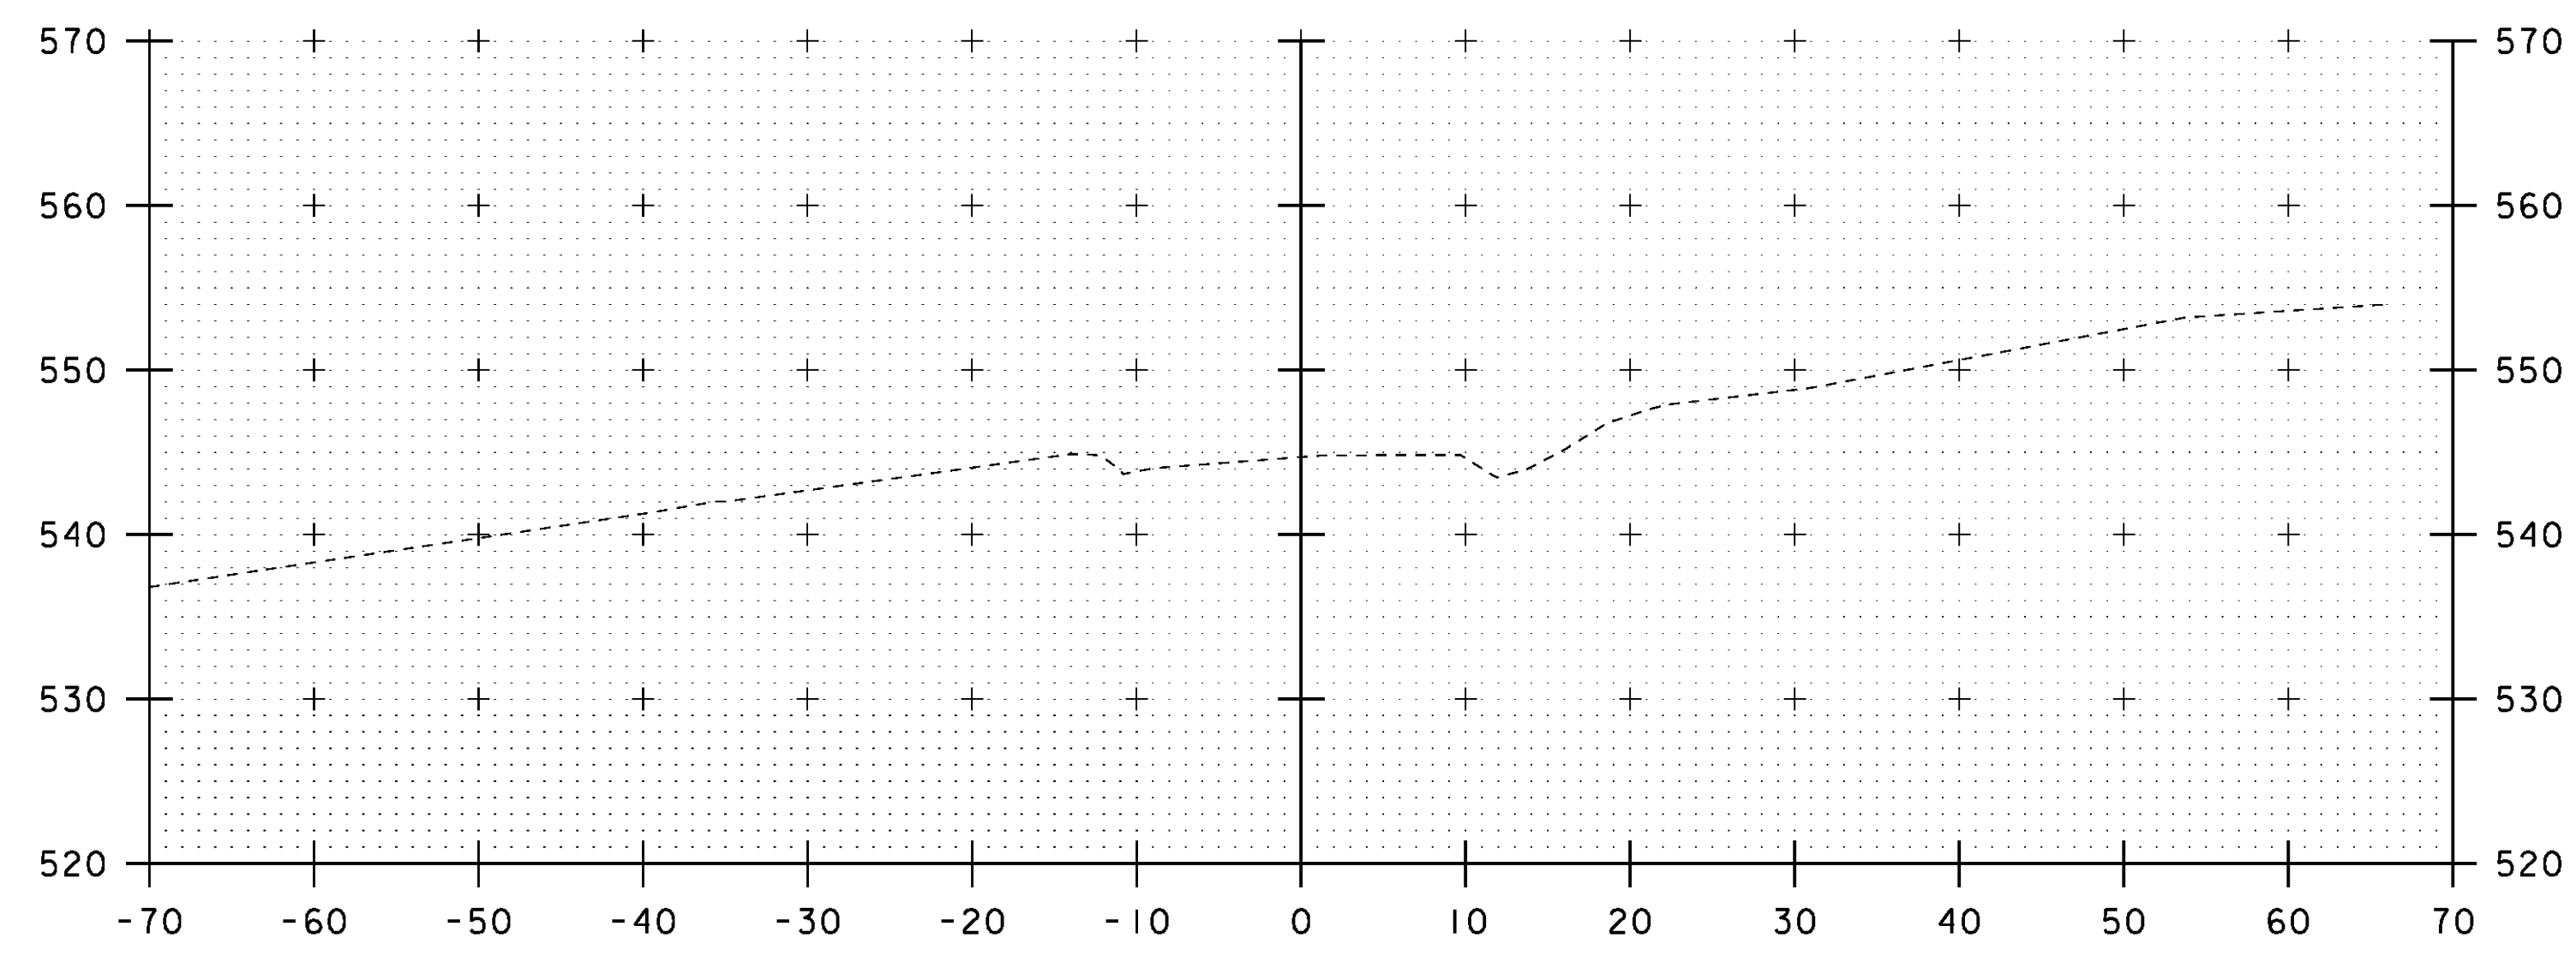

31+75

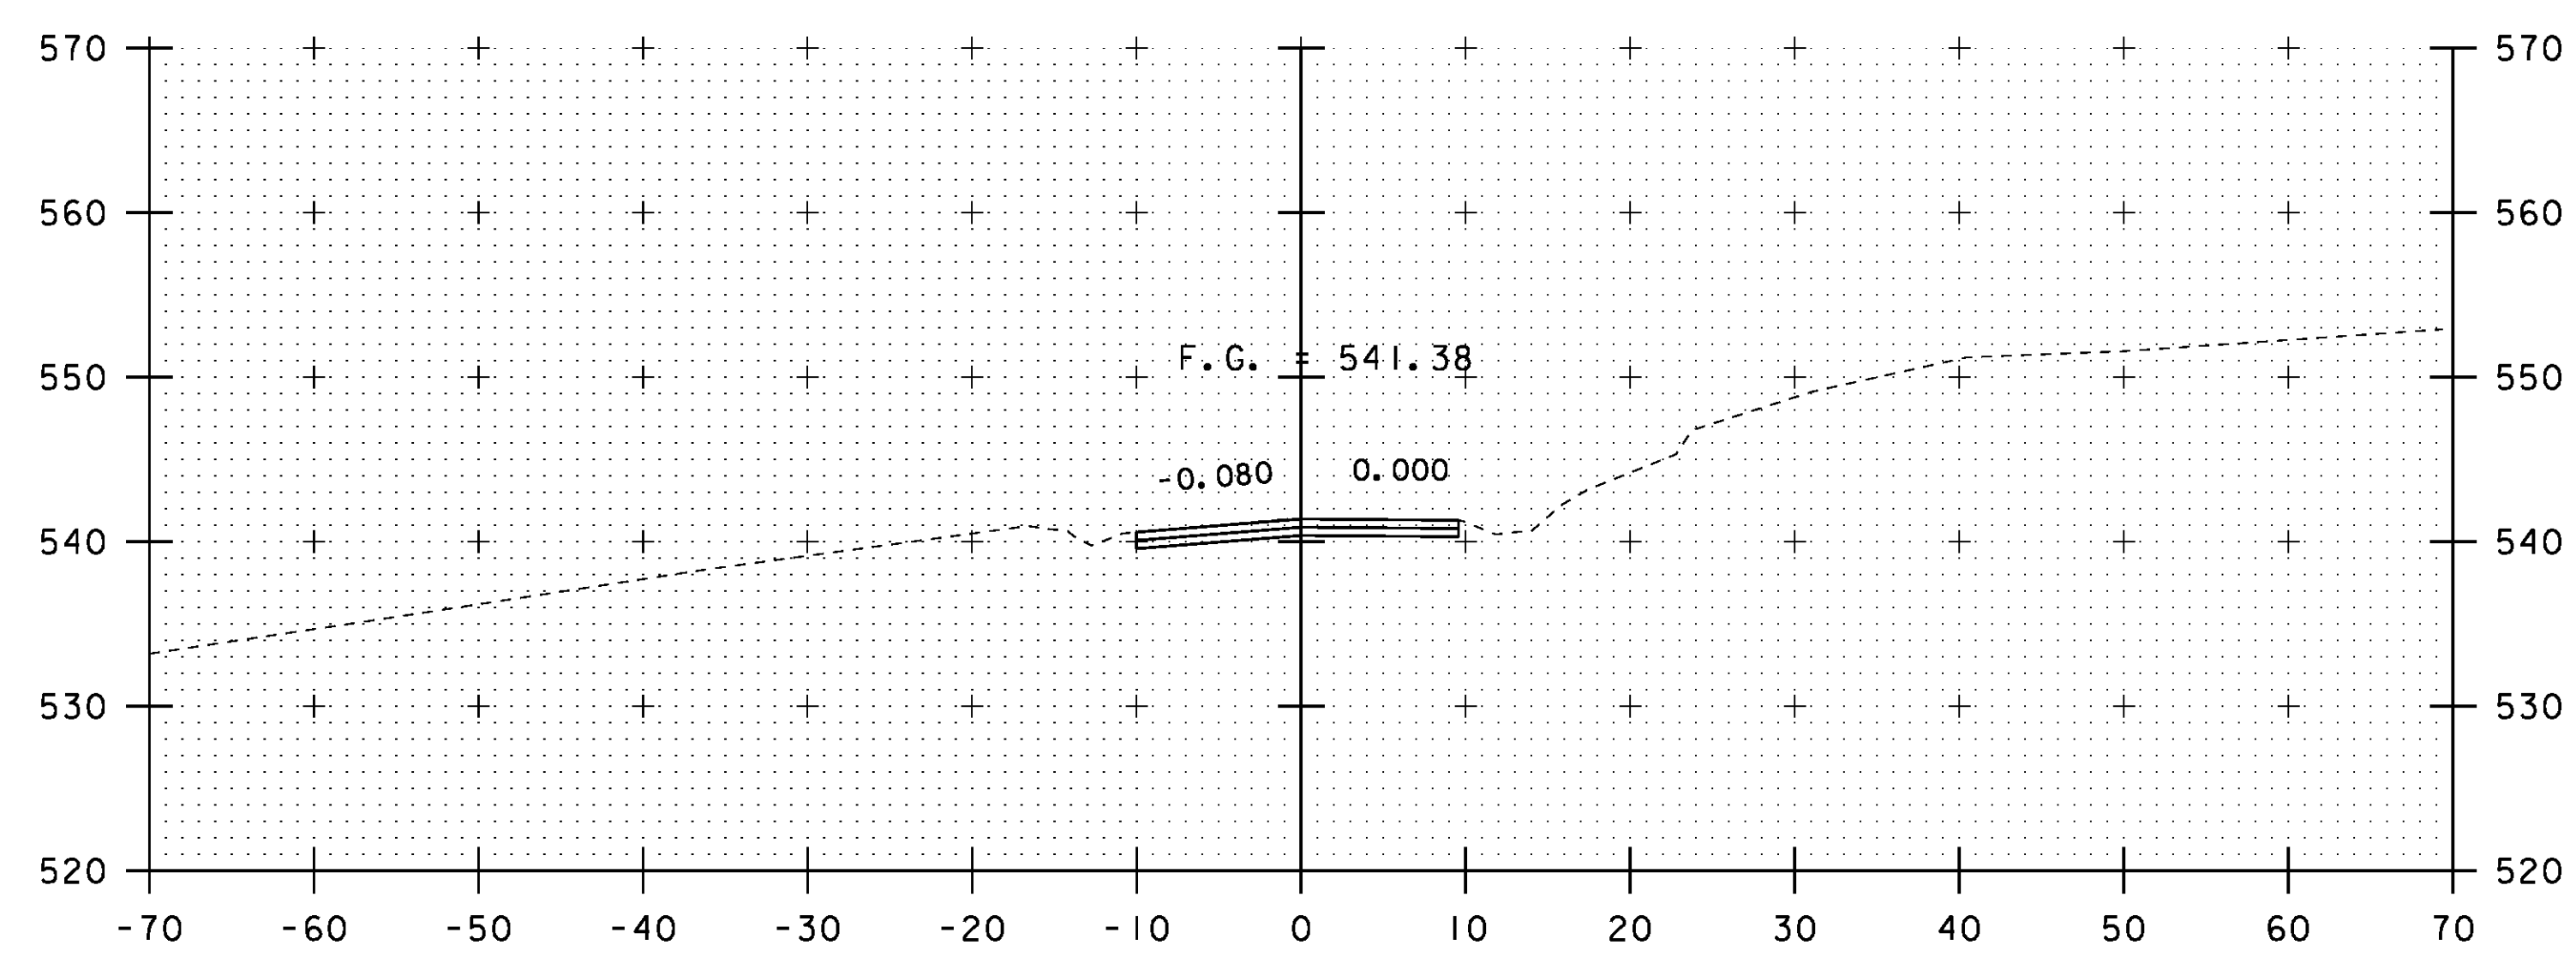

31+50  
END APPROACH

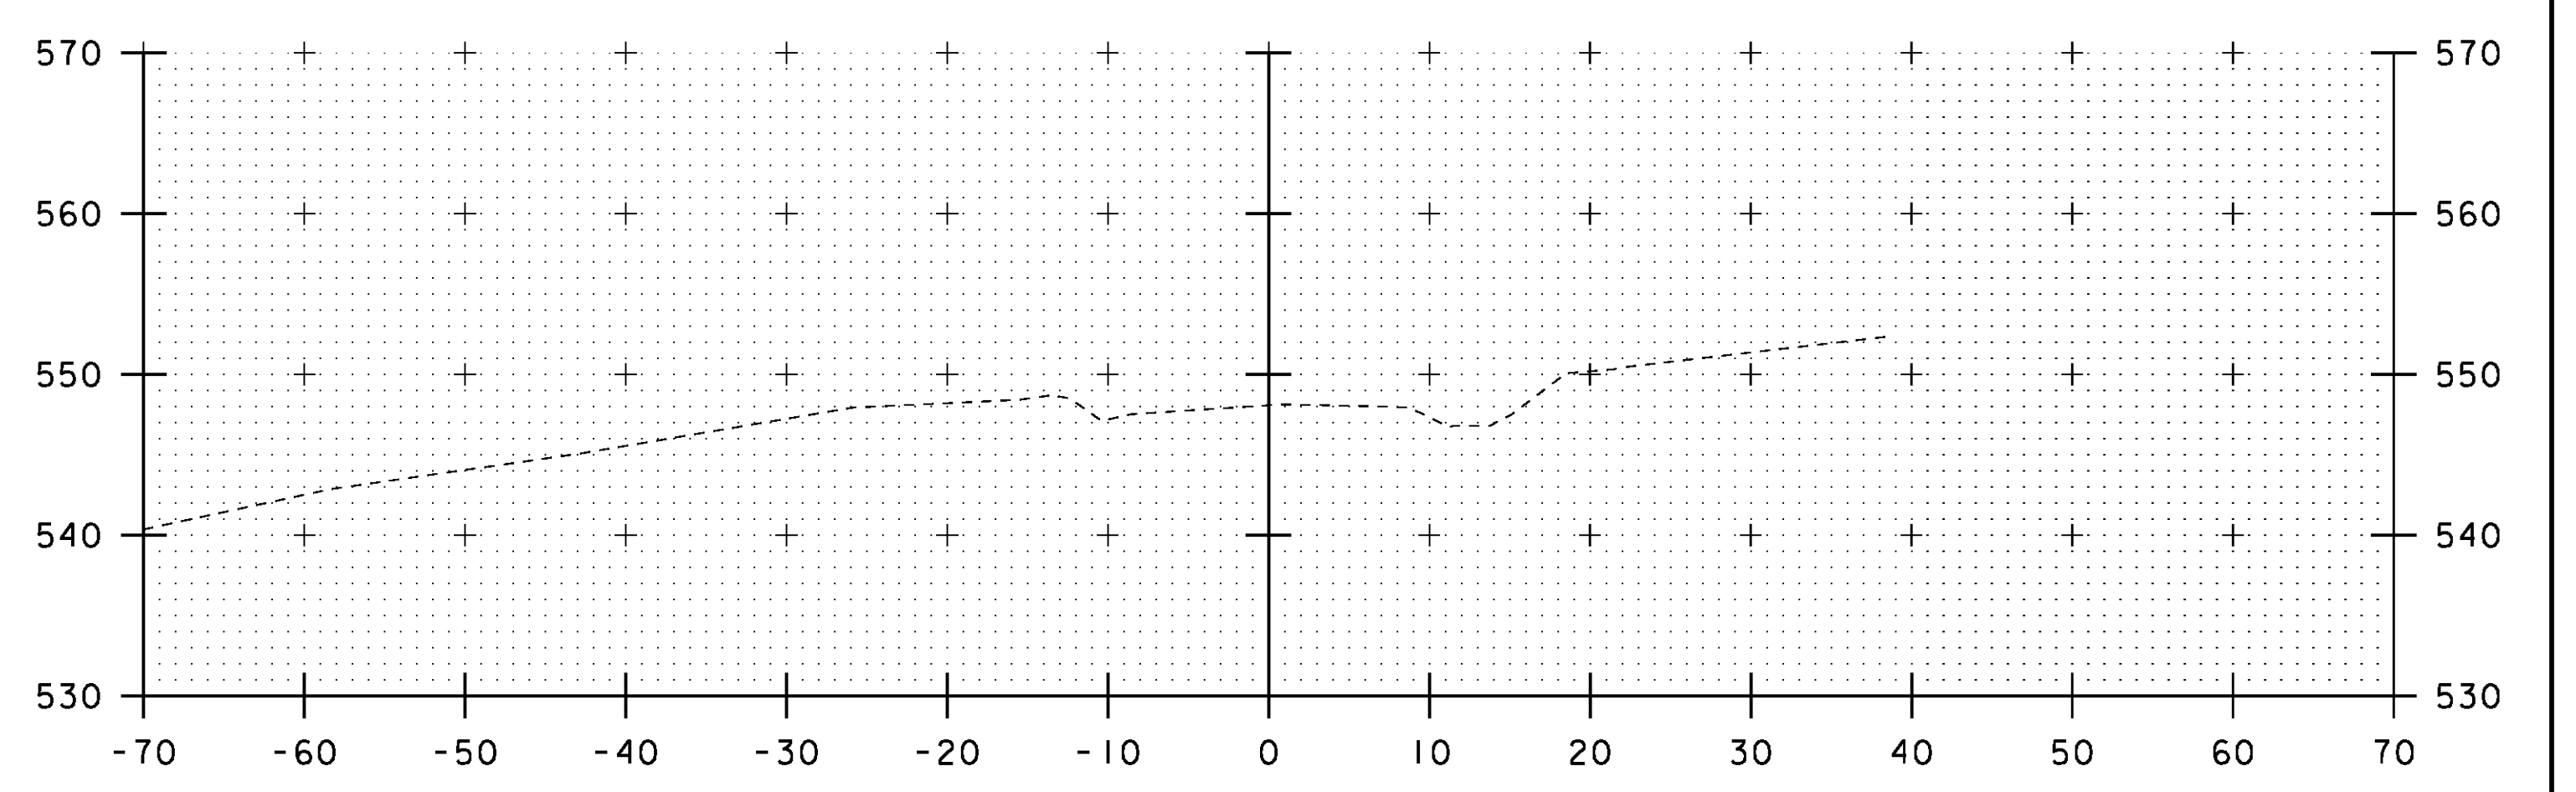


32+00



SCALE: 1" = 10'-0"



STA. 31+50 TO STA. 32+00

PROJECT NAME: ROYALTON	PROJECT NUMBER: BRS 0147 (13)
FILE NAME: \BR_28\86e055xsl_28.dgn	PLOT DATE: 08-OCT-2013
PROJECT LEADER: C. CARLSON	DRAWN BY: STR3
DESIGNED BY: D. PETERSON	CHECKED BY: C. CARLSON
BRIDGE 28 TH 22 CROSS SECTIONS (2)	SHEET 156 OF 186

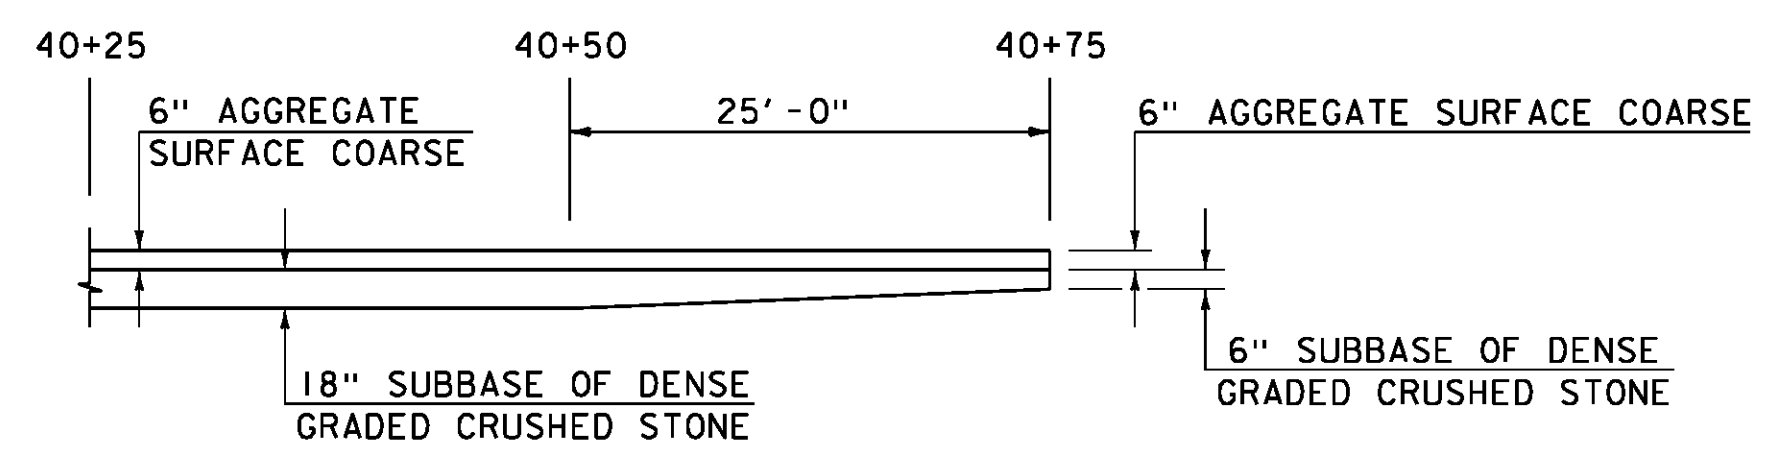


**MATERIAL TRANSITION DIAGRAM**

TH #20  
NTS

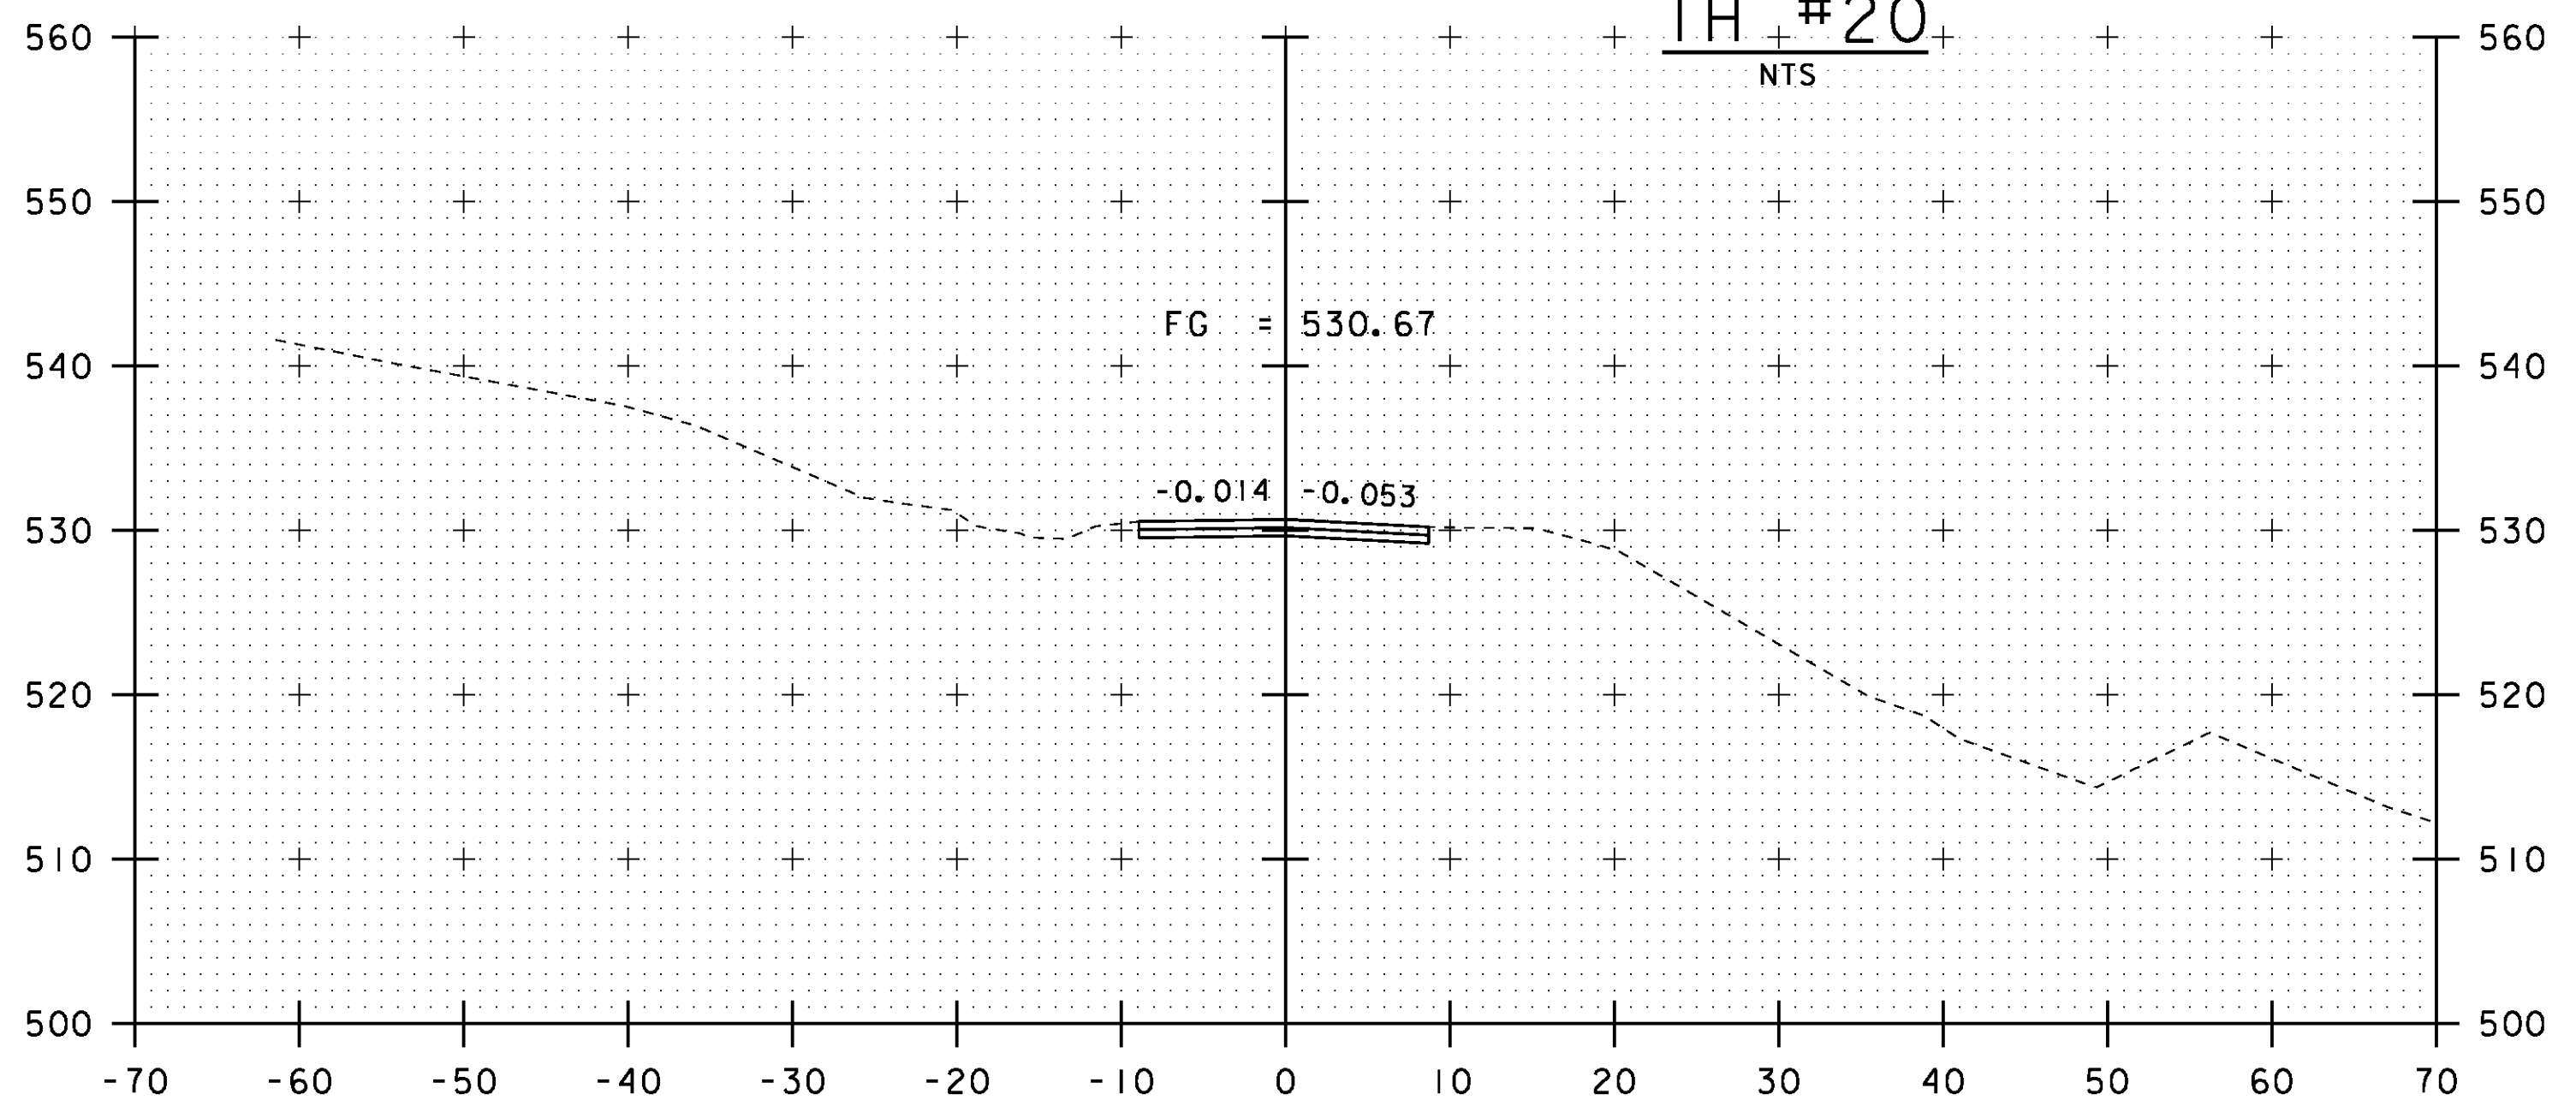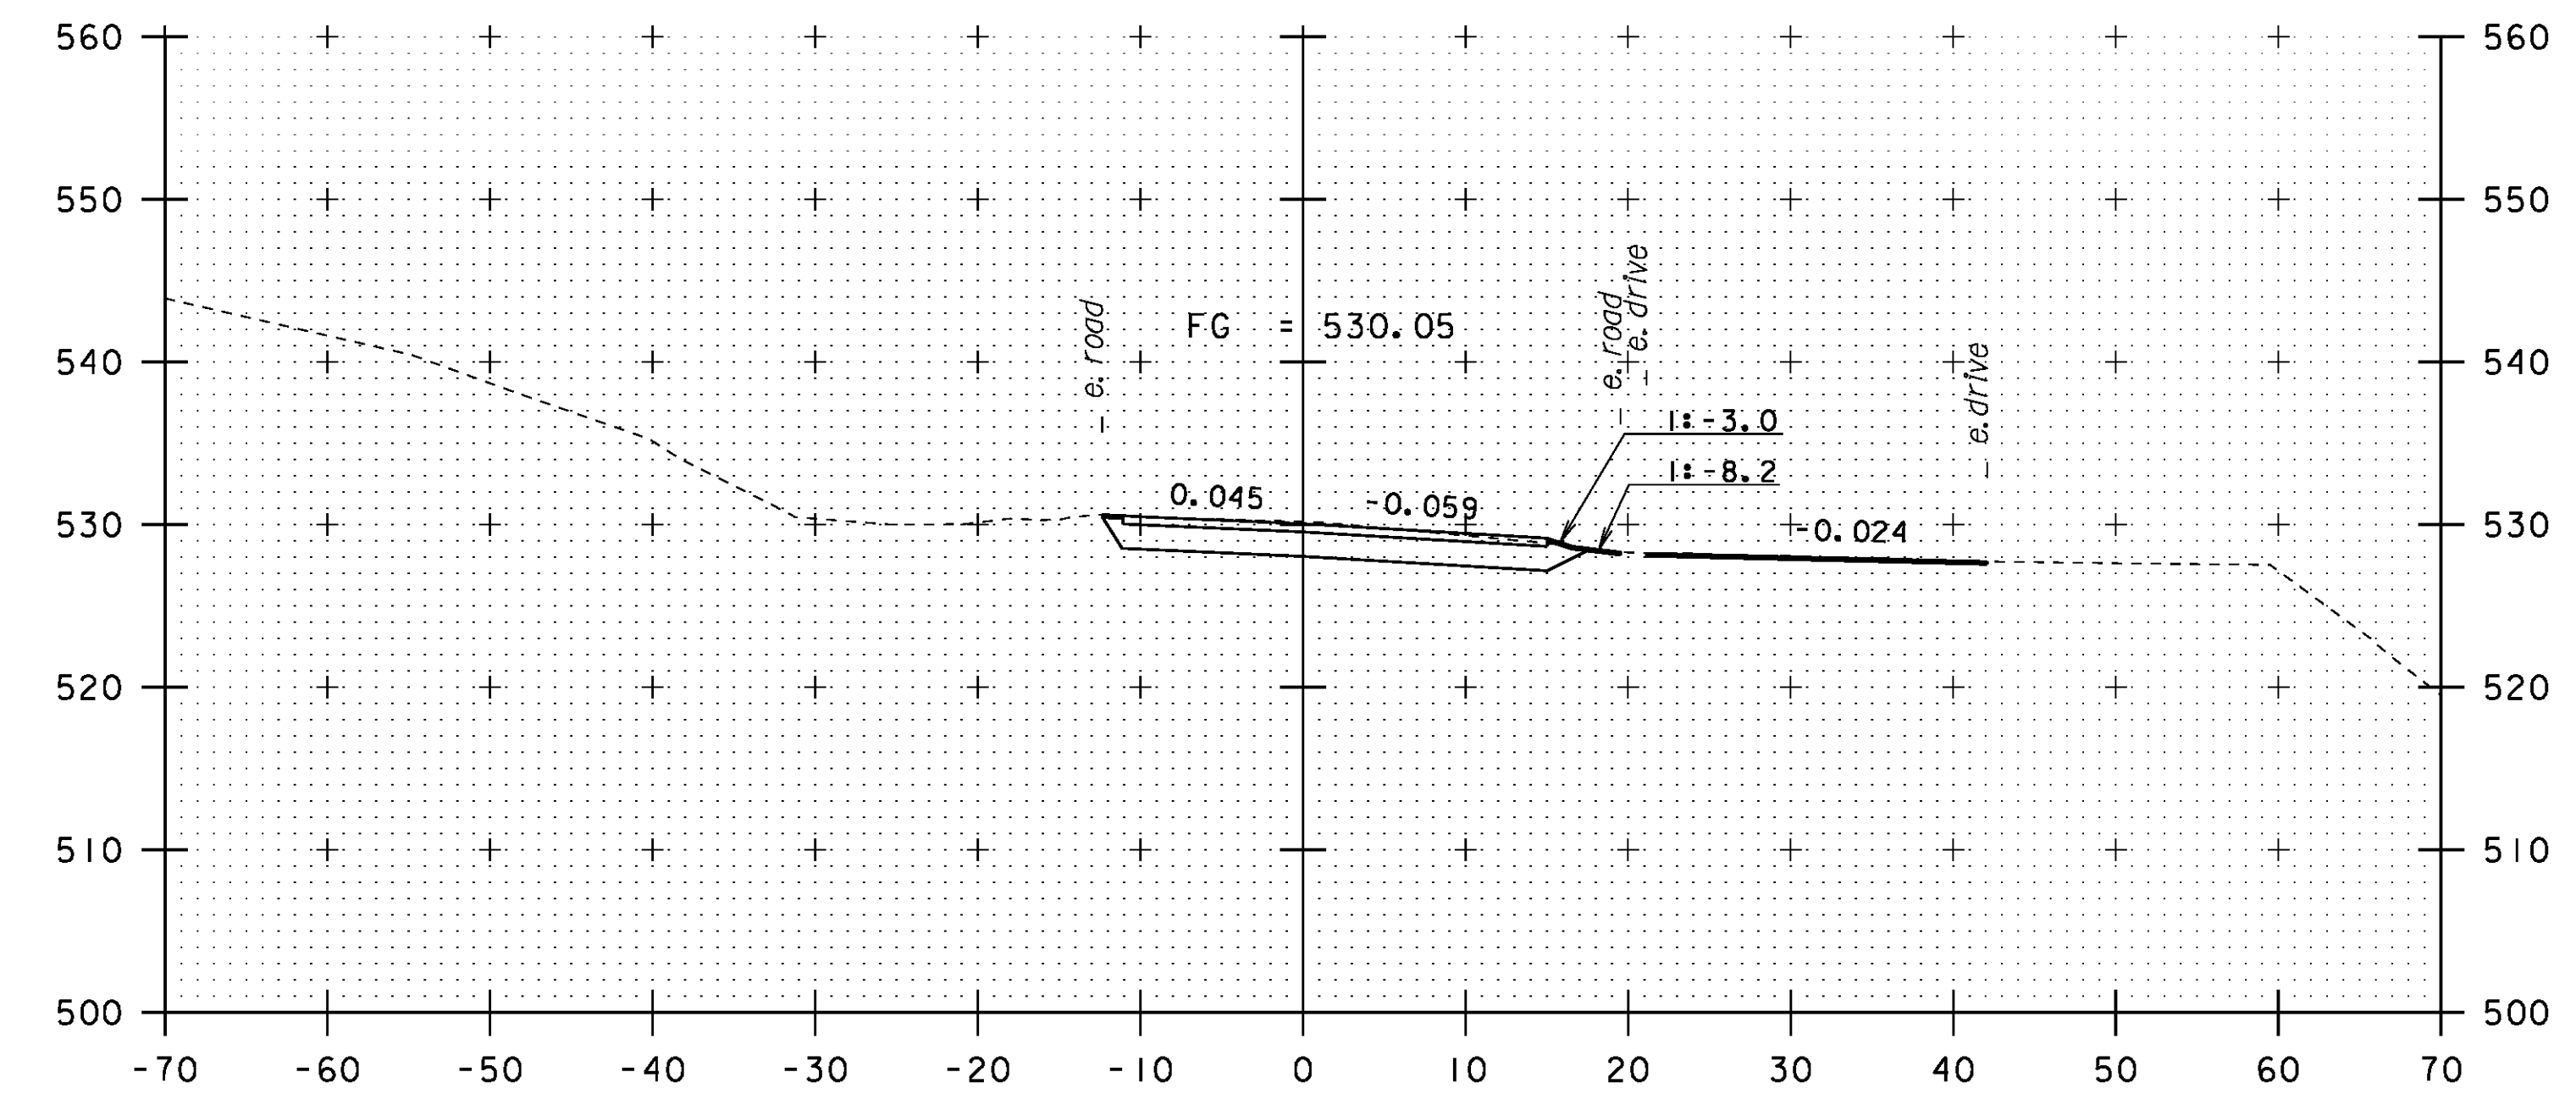


40+34

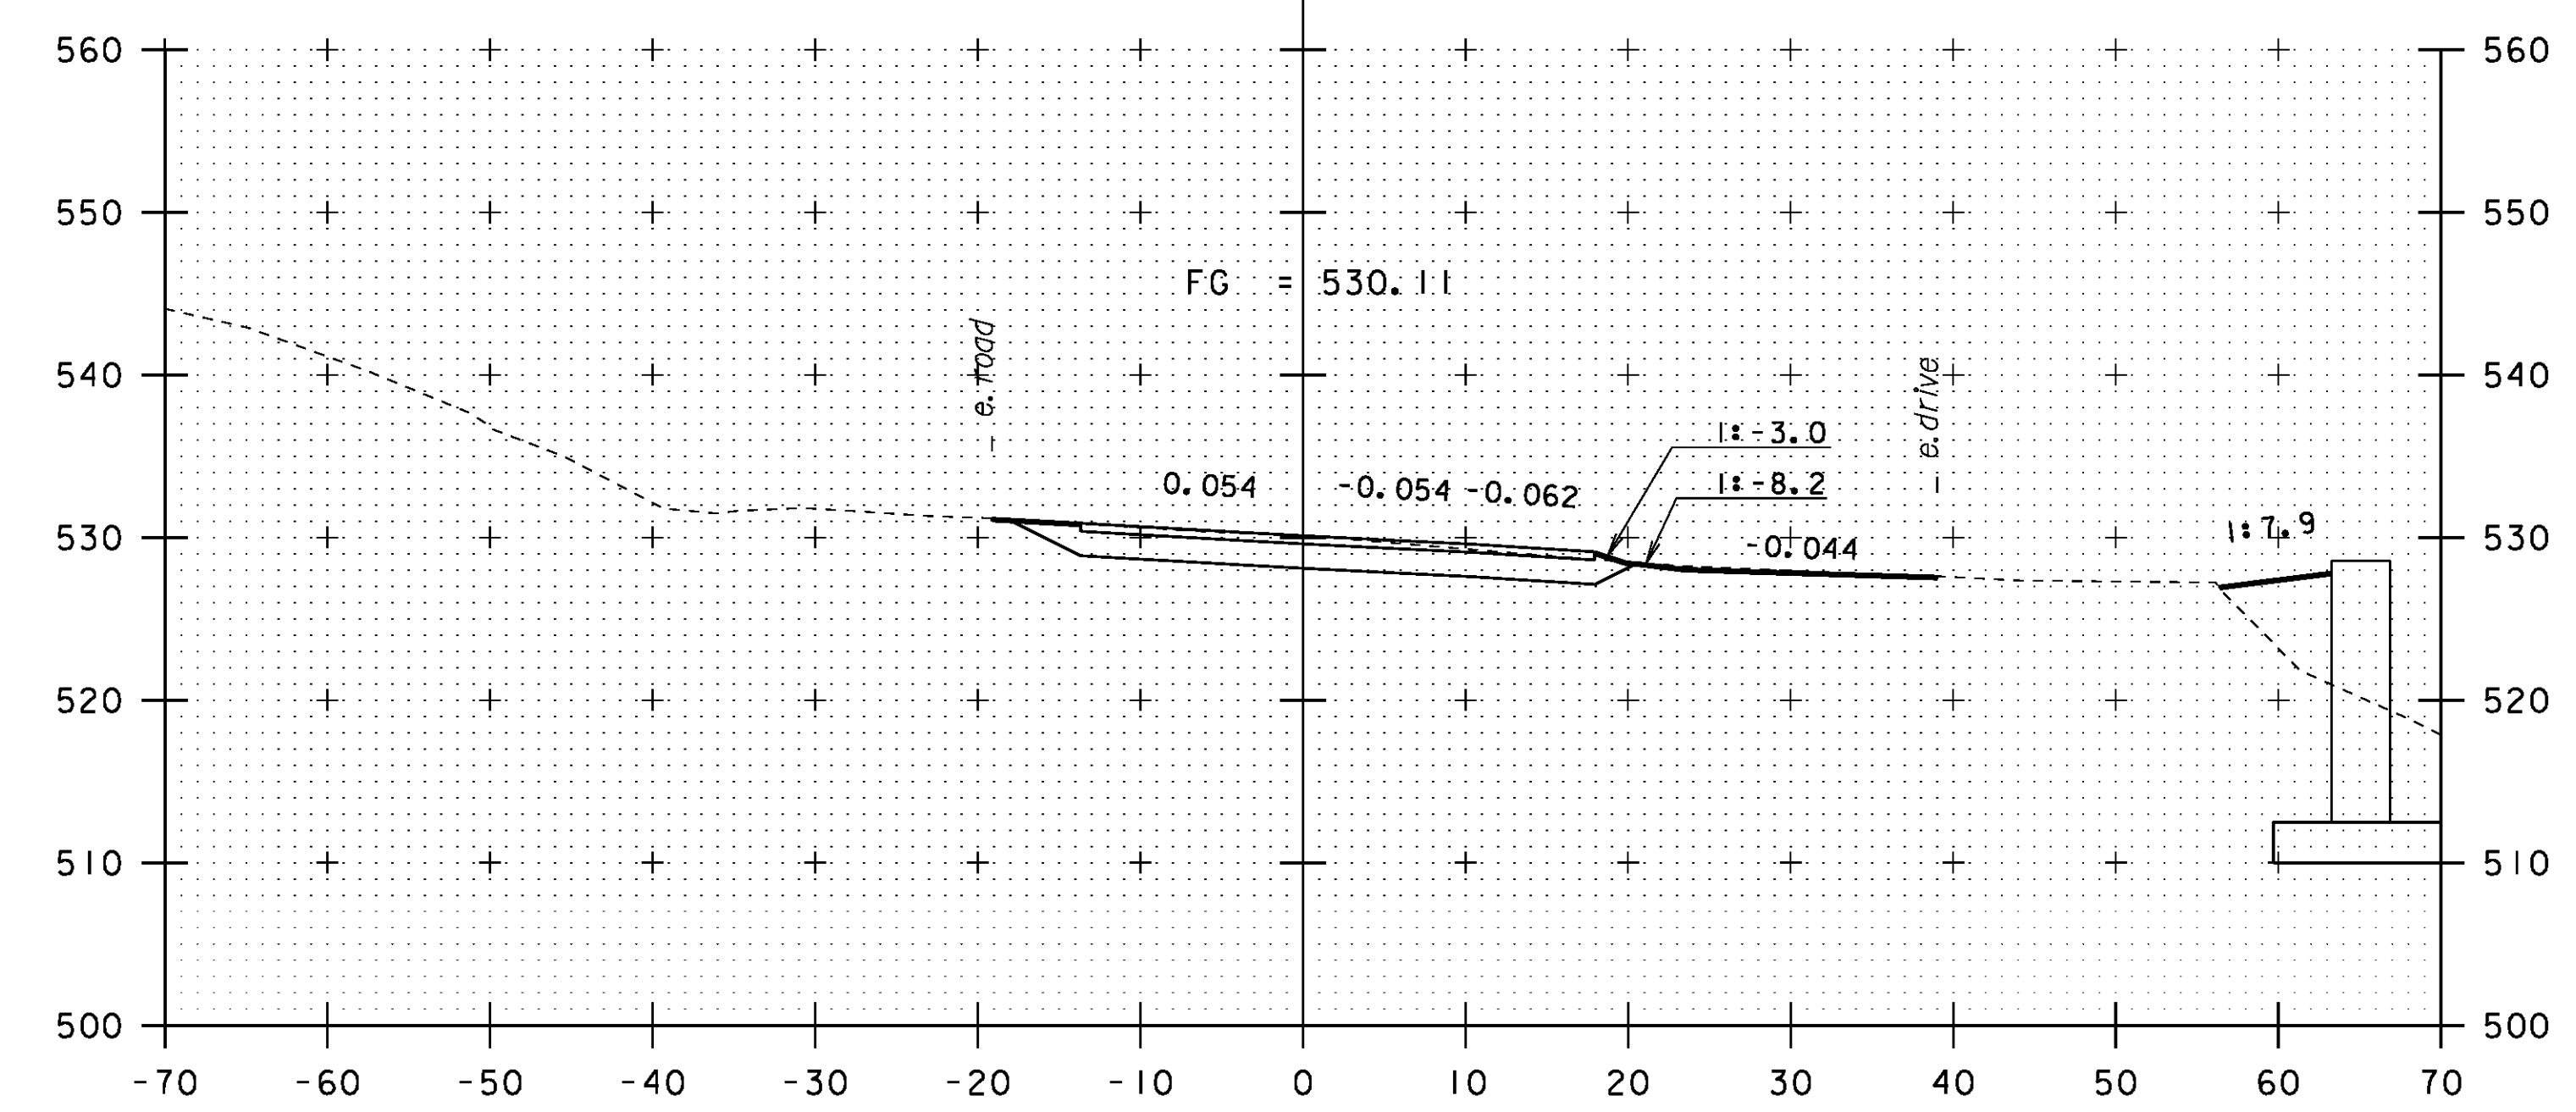


40+25

40+75  
END APPROACH

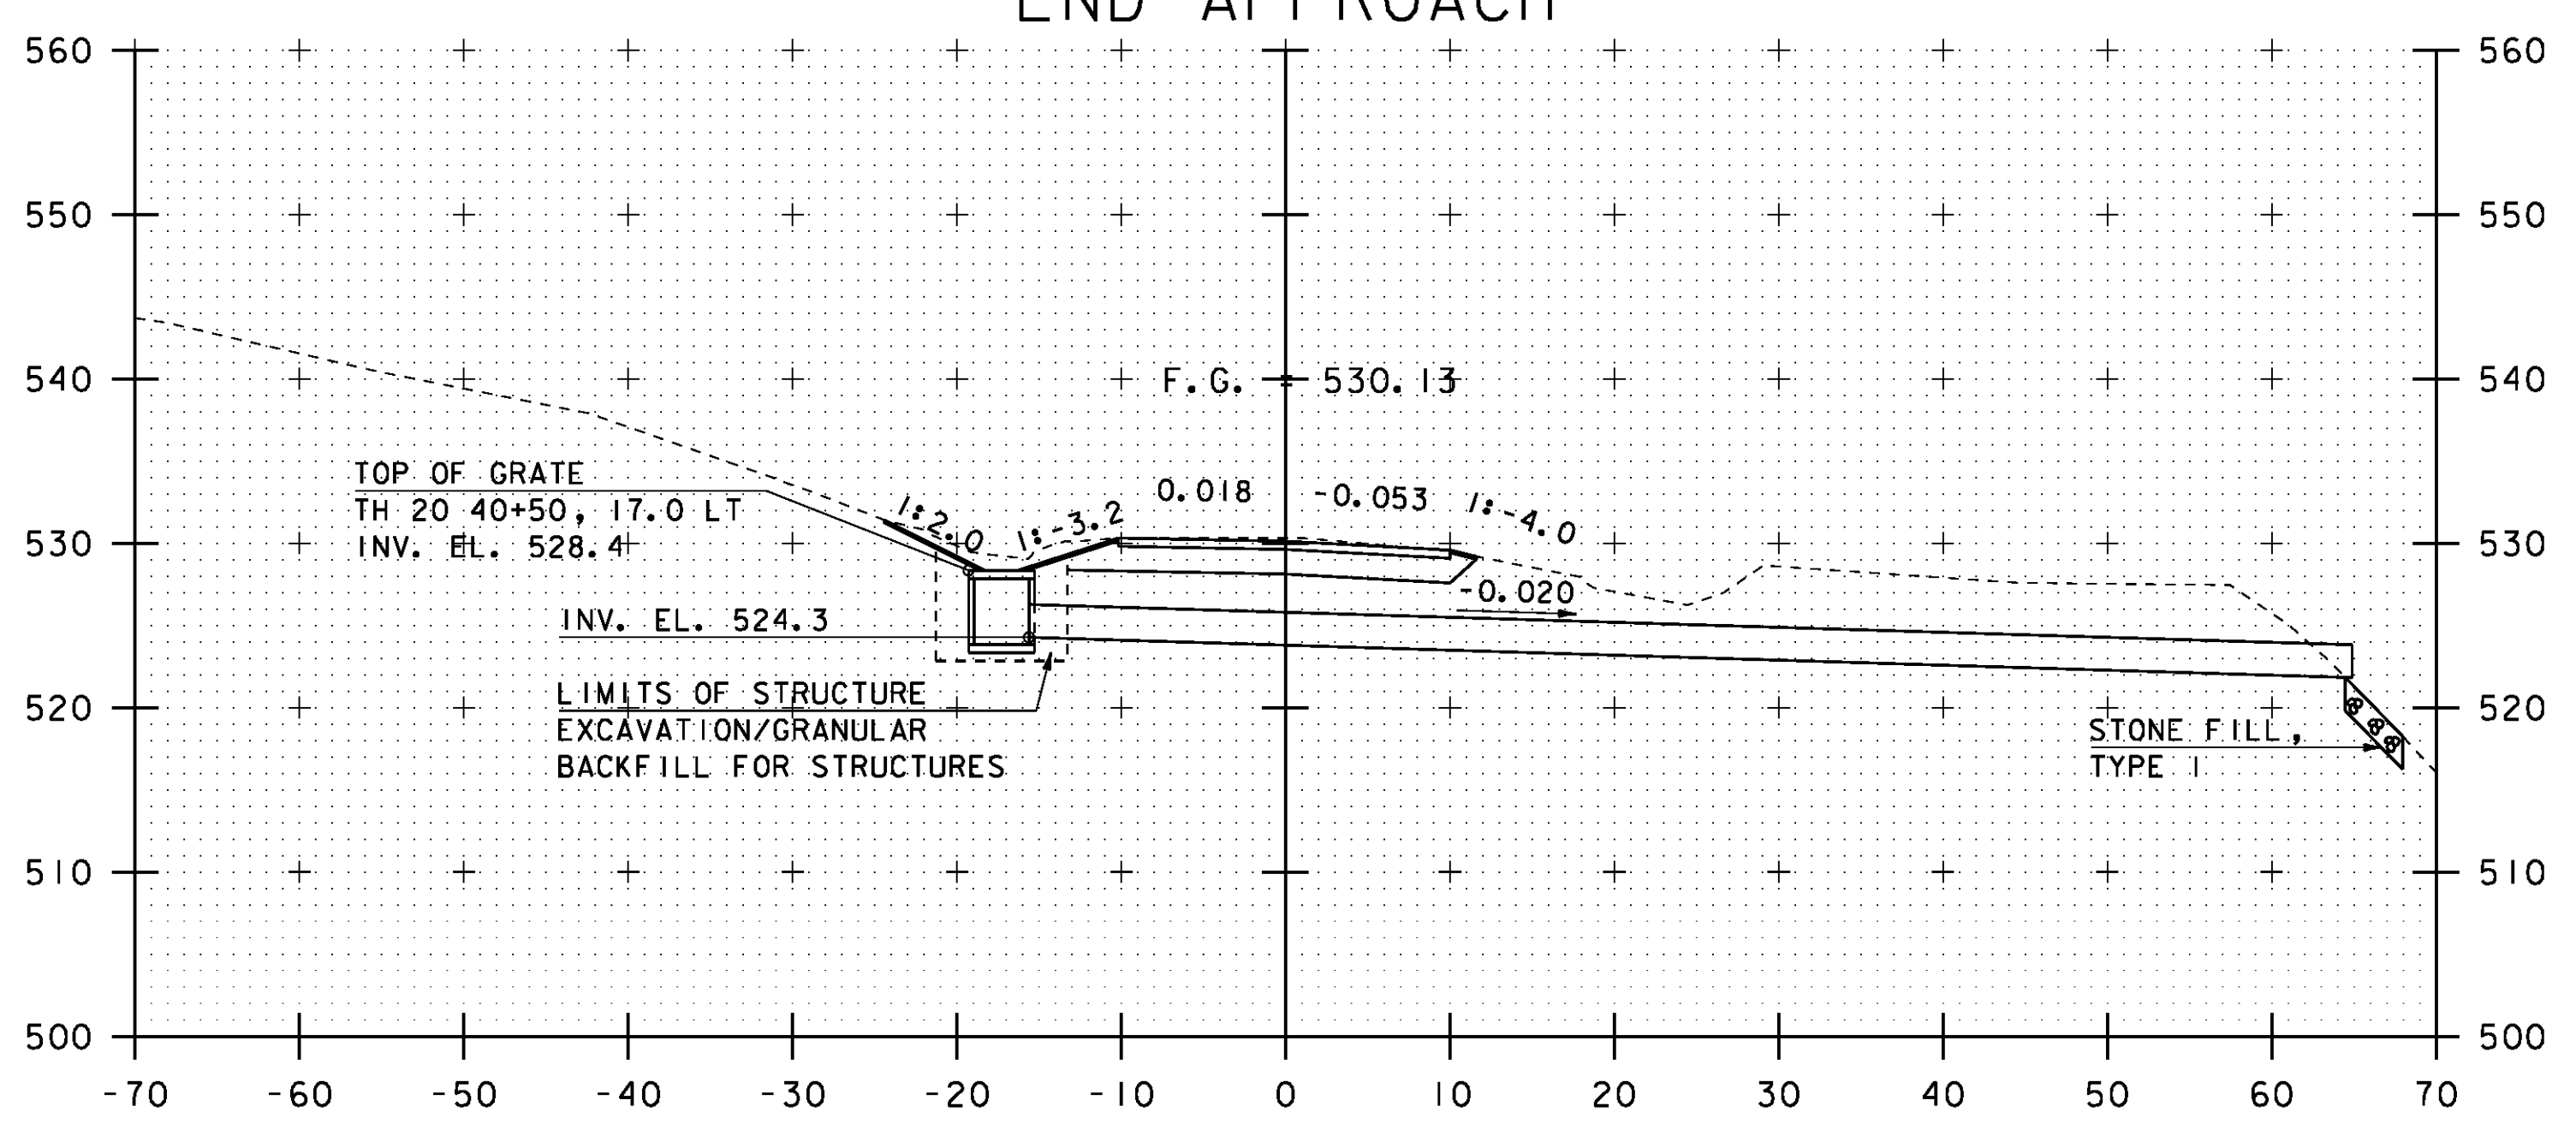

TH #20 STA 40+50 C/L  
NEW PRECAST REINFORCED CONCRETE DROP INLET WITH CAST IRON GRATE, TYPE D, NEW 24" X 85' PCCSP (0.064), CAAP (0.060), RCP (CL. 111), OR CPEP (SL) OPTION W/ STONE FILL, TYPE I @ OUTLET

40+50

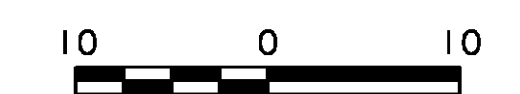

SCALE: 1" = 10' - 0"

STA. 40+25 TO STA. 40+75

PROJECT NAME: ROYALTON	PLOT DATE: 08-OCT-2013
PROJECT NUMBER: BRS 0147 (13)	DRAWN BY: STR3
FILE NAME: \BR_28\86e055xsl_28.dgn	CHECKED BY: C. CARLSON
PROJECT LEADER: C. CARLSON	SHEET 157 OF 186
DESIGNED BY: D. PETERSON	
BRIDGE 28 TH 20 CROSS SECTIONS	

**1. PROJECT DESCRIPTION**

THIS PROJECT INVOLVES THE CONSTRUCTION OF THE NEW BRIDGES #27 AND #28 AND THE INSTALLATION OF A NEW CATTLE PASS IN THE TOWN OF ROYALTON. BRIDGE #27 WILL BE BUILT ALONG A NEW ALIGNMENT UPSTREAM OF THE CURRENT BRIDGE. THE NEW BRIDGE #27 WILL BE INTEGRAL ABUTMENT SPANNING 137.6 FEET OVER THE 2ND BRANCH OF THE WHITE RIVER. BRIDGE #27 IS LOCATED IN THE TOWN OF ROYALTON, ON VT ROUTE 14, APPROXIMATELY 1.4 MILES NORTH FROM THE INTERSECTIONS OF VT ROUTE 107 AND VT ROUTE 14. THE CATTLE PASS WILL BE A PRECAST CONCRETE BOX WITH CONCRETE WINGWALLS. IT IS LOCATED APPROXIMATELY 0.20 MILES NORTH OF BRIDGE #27. BRIDGE #28 WILL BE BUILT ALONG AN ALIGNMENT SIMILAR TO THE EXISTING BRIDGE. THE NEW BRIDGE WILL BE A SINGLE SPAN CURVED GIRDER SPANNING 122.6 FEET OVER THE 2ND BRANCH OF THE WHITE RIVER. BRIDGE #28 IS LOCATED IN THE TOWN OF ROYALTON, ON VT ROUTE 14, APPROXIMATELY 2 MILES NORTH FROM THE INTERSECTIONS OF VT ROUTE 107 AND VT ROUTE 14.

**2. AREA OF DISTURBANCE**

TOTAL AREA OF DISTURBANCE AS SHOWN ON THE ATTACHED EPSC PLAN IS APPROXIMATELY 4.84 ACRES. SEE BREAKDOWN OF DISTURBANCE PER AREA IN # 5 BELOW.

**3. CONSTRUCTION SEQUENCE**

THE CONTRACTOR SHALL SEQUENCE CONSTRUCTION ACTIVITIES TO MINIMIZE THE EXTENT OF DISTURBED SOILS LEFT OPEN TO EROSION AT ANY GIVEN TIME. LIMIT TOTAL AREA OF DISTURBANCE FOR ALL SITES TO < 2 ACRES. A PROPOSED GENERAL SEQUENCE FOR EACH OF THE MAJOR CONSTRUCTION ACTIVITIES IS AS FOLLOWS:

- **ALL SITES-(THIS WORK SHALL BE DONE PRIOR TO ANY WORK LISTED FOR A SPECIFIC SITE.)**
  - 1) ESTABLISH PERIMETER CONTROLS AND MARK BOUNDARIES FOR SENSITIVE RESOURCE AREAS, SUCH AS WETLANDS AND RIPARIAN BUFFER ZONES.
  - 2) INSTALL SEDIMENT CONTROL MEASURES.
  - 3) CLEARING.
  - 4) BEGIN CUT & FILL OPERATIONS.
  
- **CATTLE PASS**
  - 1) CONCURRENTLY INSTALL TEMPORARY AND PERMANENT STABILIZATION AND EPSC MEASURES AND AS WORK PROGRESSES SO THAT EMBANKMENT IS STABILIZED PRIOR TO ALLOWING RUNOFF TO DISCHARGE TO IT.
  - 2) THE DITCH ON THE WEST SIDE OF THE ROADWAY SHALL BE MAINTAINED UNTIL WORK ON THAT SIDE BEGINS.
  - 3) INSTALLATION OF STRUCTURE WILL BE DONE IN PHASED CONSTRUCTION. THE EAST HALF OF THE ROADWAY WILL BE CUT DOWN TO GRADE FIRST AND HALF OF THE BOX, ONE HEADWALL AND THE TWO WINGWALLS WILL BE PLACED.
  - 4) PLACE SUBBASE MATERIAL FOR FIRST HALF OF THE ROADWAY AND STABILIZE ALL EARTH DISTURBANCE AS WORK PROGRESSES.
  - 5) THE CONTRACTOR SHALL INSTALL TEMPORARY RUNOFF MEASURES DURING CONSTRUCTION TO CAPTURE OR DIVERT RUNOFF IN THE DITCH ON THE WEST SIDE OF THE ROAD. THIS DITCH ON THE WEST SIDE, SOUTH OF THE CATTLE PASS WILL BE MAINTAINED TO DRAIN SOUTH TO THE EXISTING PIPE.
  - 6) SWITCH TRAFFIC TO THE COMPLETED SIDE AND CUT THE REMAINING SIDE DOWN TO GRADE.
  - 7) INSTALL THE REST OF THE BOX AND SECOND HEADWALL AND WINGWALLS.
  - 8) PLACE SUBBASE MATERIAL FOR SECOND HALF OF THE ROADWAY AND STABILIZE ALL EARTH DISTURBANCES AS WORK FINISHES.
  - 9) ONCE VEGETATION HAS BEEN ESTABLISHED AND THE STONE-LINED DITCHES INSTALLED, REMOVE THE INSTALLED TEMPORARY RUNOFF MEASURES AND DIVERT WATER INTO THE STONE-LINED DITCHES AS SHOWN ON THE PLANS.
  - 10) PAVE ROADWAY.
  
- **BRIDGE #27**
  - 1) CONSTRUCT TEMPORARY OUTLET CONTROL AND DRAINAGE PIPES FOR USE AS TEMPORARY SEDIMENT BASIN AT LOCATION SHOWN ON THE PLANS.
  - 2) BEGIN CUT/FILL OPERATIONS
  - 3) CONCURRENTLY INSTALL TEMPORARY STABILIZATION AND EPSC MEASURES AS WORK PROGRESSES.
  - 4) INSTALL NEW BRIDGE SUBSTRUCTURE. NO DEWATERING REQUIRED.
  - 5) PLACE SUBBASE MATERIAL UP TO TOP OF PILE CAP.
  - 6) INSTALL NEW BRIDGE SUPERSTRUCTURE.
  - 7) PLACE THE REST OF THE SUBBASE MATERIAL UP TO GRADE.
  - 8) WITH TRAFFIC MOVED TO NEW STRUCTURE, FORM NEW DITCH ALONG LEFT SIDE OF THE ROAD.
  - 9) ONCE PERMANENT STABILIZATION MEASURES ARE IN PLACE AND VEGETATION HAS BEEN ESTABLISHED, DRAIN SEDIMENT BASIN, REMOVE ACCUMULATED SEDIMENTS.
  - 10) DIVERT RUNOFF FROM SEDIMENT BASIN TO THE NEW DITCH.

- **BRIDGE #28**
  - 1) CONSTRUCT TEMPORARY BRIDGE.
  - 2) CONSTRUCT BRIDGE ABUTMENTS. DEWATER EXCAVATIONS AS NECESSARY.
  - 3) BACKFILL AROUND ABUTMENTS.
  - 4) CONSTRUCT BRIDGE.
  - 5) PLACE SUBBASE MATERIAL FOR ROADWAY APPROACHES.
  - 6) PAVE ROADWAY AND SHOULDERS WITH BASE COURSE OF PAVEMENT AS SOON AS SUFFICIENT LENGTH OF ROADWAY IS CONSTRUCTED.
  - 7) REMOVE TEMPORARY BRIDGE AND FINAL GRADE SIDE SLOPES.
  - 8) APPLY PERMANENT STABILIZATION MEASURES TO ALL REMAINING EXPOSED SOIL AREAS.

**4. STABILIZATION OF EXPOSED SOILS**

- SEED AND MULCH WILL BE USED FOR BOTH PERMANENT AND TEMPORARY STABILIZATION MEASURES. ROLLED EROSION CONTROL PRODUCT (RECP) WILL BE USED IN PLACE OF MULCH FOR SLOPES GREATER THAN 1V:3H. MULCH IS TO BE APPLIED AT A MINIMUM APPLICATION RATE AS SHOWN IN THE PLANS, UNLESS DIRECTED OTHERWISE BY THE ENGINEER.
- DISTURBED AREAS AND SOIL STOCKPILES THAT WILL NOT BE WORKED FOR MORE THAN 7 DAYS SHALL BE TEMPORARILY STABILIZED WITH MULCH/RECP WITHIN 48 HOURS.
- DISTURBED AREAS AND SOIL STOCKPILES THAT WILL NOT BE WORKED FOR MORE THAN 30 DAYS SHALL BE TEMPORARILY STABILIZED WITH SEED AND MULCH/RECP WITHIN 48 HOURS.
- EXPOSED AREAS THAT HAVE ACHIEVED FINAL GRADE SHALL BE PERMANENTLY STABILIZED WITHIN 48 HOURS.
- IN AREAS WHERE VEGETATIVE COVER WILL PROVIDE PERMANENT STABILIZATION, SEEDING TO BE COMPLETED BETWEEN APRIL 15 AND SEPTEMBER 15.

**5. DRAINAGE AREAS AND DISCHARGE POINTS**

THE PROJECT HAS THREE DISCRETE DISCHARGE POINTS TO THE RECEIVING WATER, THE 2ND BRANCH OF THE WHITE RIVER. EACH DISCHARGE CORRESPONDS TO A DRAINAGE AREA IN WHICH THE PROJECT HAS BEEN DIVIDED.

- **DRAINAGE AREA 1**  
INCLUDES THE AREA NORTH AND SOUTH OF BRIDGE #27. THE ASSOCIATED AREA OF DISTURBANCE IS 2.76 ACRES. RUNOFF WILL GENERALLY FLOW WEST TO EAST TOWARD THE WETLAND AREA ON THE SOUTH SIDE OF THE BRIDGE. NORTH OF THAT WATER WILL FLOW NORTH TOWARD THE 2ND BRANCH OF THE WHITE RIVER. ON THE NORTH SIDE OF THE BRIDGE WATER WILL FLOW SOUTH ON EACH SIDE OF THE ROADWAY TOWARD THE 2ND BRANCH OF THE WHITE RIVER.
- **DRAINAGE AREA 2**  
INCLUDES MOST OF THE AREA AROUND THE INSTALLATION OF THE CATTLE PASS. THE ASSOCIATED AREA OF DISTURBANCE IS 0.35 ACRE. RUNOFF ON THE WEST SIDE OF THE ROAD WILL FLOW IN VEGETATED SWALES TOWARD THE CATTLE PASS AND RUN THROUGH THE CATTLE PASS TO THE EAST SIDE OF THE ROAD. FROM HERE THE WATER WILL RUN TO THE 2ND BRANCH OF THE WHITE RIVER.
- **DRAINAGE AREA 3**  
CONSISTS OF THE AREA NORTH AND SOUTH OF BRIDGE #28. THE ASSOCIATED AREA OF DISTURBANCE IS 1.73 ACRES. RUNOFF WILL GENERALLY FLOW NORTH TO SOUTH AND INTO THE 2ND BRANCH OF THE WHITE RIVER. MOST RUNOFF WILL BE DISCHARGED TO VEGETATED TREATMENT SWALES WHICH DISCHARGE TO THE RECEIVING WATER.

**DRAINAGE AREA SUMMARY**

DRAINAGE AREA	TOTAL DISTURB. (ACRES)	LIMIT OF CONCURRENT DISTURBANCE	RECEIVING WATER
1	2.76	2 ACRE*	2 ND BRANCH OF WHITE RIVER
2	0.35	2 ACRE*	2 ND BRANCH OF WHITE RIVER
3	1.73	2 ACRE*	2 ND BRANCH OF WHITE RIVER

*ONLY 2 ACRES OF TOTAL DISTURBANCE ALLOWED FOR ALL 3 SITES COMBINED, AT ONE TIME.

**6. WASTE, BORROW, AND STAGING AREAS**

- OFF-SITE WASTE AND BORROW AREAS HAVE NOT BEEN IDENTIFIED FOR THIS PROJECT. IT WILL BE THE CONTRACTOR'S RESPONSIBILITY TO IDENTIFY AND PERMIT, AS NECESSARY, ANY OFF-SITE WASTE AND BORROW AREAS THAT ARE NEEDED. ALL EROSION PREVENTION AND SEDIMENT CONTROL MEASURES NECESSARY FOR WASTE, BORROW, AND STAGING AREAS OUTSIDE THE PROJECT LIMITS SHALL BE PAID FOR PER SUBSECTION 105.29 OF THE STANDARD SPECIFICATIONS FOR CONSTRUCTION.

- LOCATE ADDITIONAL AREAS FOR DISPOSAL OF STUMPS, EXCESS SOILS AND COLLECTED SEDIMENT, IF NECESSARY. DISPOSE OF THESE MATERIALS IN A MANNER THAT WILL NOT RESULT IN SEDIMENTS ENTERING WATERS OF THE STATE.
- DISPOSAL SITES REQUIRE RELATIVELY LEVEL TERRAIN WITH AN ISOLATION DISTANCE OF AT LEAST 100 FT FROM ANY SURFACE WATERS, INCLUDING WETLANDS.
- VEHICLE AND EQUIPMENT STORAGE AREAS OR AREAS ADJACENT TO CONSTRUCTION TRAILERS OR OTHER HIGH TRAFFIC AREAS SHALL BE COVERED WITH GEOTEXTILE FABRIC AND 12 INCHES OF GRAVEL. FOLLOWING COMPLETION OF CONSTRUCTION, ALL NON-NATIVE MATERIALS SHALL BE REMOVED FROM THE STAGING AREA. COMPACTED, RUTTED, OR OTHERWISE DISTURBED SOILS SHALL BE TILLED, RAKED, SEEDED AND MULCHED.

- ERODIBLE MATERIALS STOCKPILED WITHIN THE MATERIAL STORAGE AREAS SHALL BE ISOLATED WITH SILT FENCE OR OTHER ACCEPTABLE SEDIMENT BARRIER. SOIL STOCKPILED ON THE SITE SHALL BE SEEDED AND MULCHED.

**7. WINTER CONSTRUCTION REQUIREMENTS**

IT IS EXPECTED THAT CONSTRUCTION ACTIVITIES WILL CONTINUE INTO THE WINTER CONSTRUCTION SEASON, DEPENDING ON ACTUAL FIELD AND WEATHER CONDITIONS. IF ACTIVITIES ARE ON-GOING BETWEEN OCTOBER 15 AND APRIL 15, THE CONTRACTOR SHALL FOLLOW REQUIREMENTS FOR WINTER CONSTRUCTION, AS DEFINED IN SPECIFIC PERMIT CONDITIONS AND AS FOLLOWS:

- ENLARGED ACCESS POINTS. STABILIZED TO PROVIDE FOR SNOW STOCKPILING.
- LIMITS OF DISTURBANCE MOVED OR REPLACED TO REFLECT BOUNDARY OF WINTER WORK.
- DEVELOPMENT OF A SNOW MANAGEMENT PLAN THAT INCLUDES:
  - ADEQUATE STORAGE AND CONTROL OF MELT-WATER
  - STORAGE OF CLEARED SNOW TO BE PLACED DOWN SLOPE OF DISTURBED AREAS AND OUT OF STORMWATER TREATMENT STRUCTURES
- A MINIMUM 7.5-METER (25-FOOT) BUFFER SHALL BE MAINTAINED FROM PERIMETER CONTROLS.
- DRAINAGE STRUCTURES MUST BE KEPT OPEN AND FREE OF SNOW AND ICE DAMS.
- SILT FENCE AND OTHER PRACTICES REQUIRING EARTH DISTURBANCE MUST BE INSTALLED AHEAD OF FROZEN GROUND.
- MULCH TO BE APPLIED AT TWICE THE REGULAR RATE, AS SHOWN IN THE PLANS, UNLESS DIRECTED OTHERWISE BY THE ENGINEER.
- AREAS OF DISTURBED SOILS MUST BE STABILIZED AT THE END OF EACH WORK DAY, WITH THE FOLLOWING EXCEPTIONS:
  - IF NO PRECIPITATION WITHIN 24 HOURS IS FORECAST AND WORK WILL RESUME IN THE SAME AREA WITHIN 24 HOURS.
  - DISTURBED AREAS THAT COLLECT AND RETAIN RUNOFF, SUCH AS OPEN UTILITY TRENCHES, MUST BE STABILIZED AT THE END OF EACH WORK WEEK.
- PRIOR TO STABILIZATION, SNOW OR ICE MUST BE REMOVED TO LESS THAN 1 INCH IN THICKNESS.

**CONTRACTOR RESPONSIBILITIES, LIMITATIONS & PROHIBITIONS**

**1. GENERAL NOTES**

- IT SHALL BE THE RESPONSIBILITY OF THE CONTRACTOR TO AMEND/UPDATE ALL PLANS AND EXISTING PERMITS WHEN ADDING DETAILED CONSTRUCTION PHASING OR ANYTHING ELSE THAT MAY DEVIATE FROM THE APPROVED PLANS AS DIRECTED BY THE RESIDENT ENGINEER.
- OTHER THAN THOSE SHOWN ON THE PLANS ALL LAND DISTURBANCES WITHIN 50 FT OF ALL WATER BODIES, MEASURED FROM THE TOP OF BANK, AND WETLANDS, ARE PROHIBITED WITHOUT FURTHER REGULATORY REVIEW.
- CONTRACTOR TO MAINTAIN ALL EXISTING STREAMS AND RIPARIAN BUFFER ZONES IN THEIR NATURAL CONDITION.
- OFF-SITE DISCHARGES OF ANY MATERIAL OTHER THAN STORMWATER, SUCH AS VEHICLE AND EQUIPMENT MAINTENANCE SPILLS, FUELS, WASH WATER, CONSTRUCTION DEBRIS, OIL, WET CONCRETE (INCLUDING WASHOUT WATER FROM CONCRETE BATCH TRUCKS OR EQUIPMENT USED TO MIX CONCRETE), AND OTHER SUBSTANCES, ARE PROHIBITED.
- THE FAILURE TO PROMPTLY ABATE THE DISCHARGE OF SEDIMENT OR ANY OTHER WASTE WHICH CAUSES A VISIBLE DISCOLORATION OF SURFACE WATERS (INCLUDING WETLANDS), OR IS FOUND TO BE VIOLATING WATER QUALITY STANDARDS BASED ON MONITORING, IS PROHIBITED. ANY CORRECTIVE ACTION UNDERTAKEN TO REMOVE SEDIMENT FROM A WETLAND IS ALSO PROHIBITED.
- WEATHER CONDITIONS WILL BE MONITORED DURING THE CONSTRUCTION SEASON. IF AN EXTENDED RAIN PERIOD OR HEAVY RAIN IS PREDICTED, EXPOSED SOIL AREAS WILL BE MULCHED PRIOR TO AND DAILY DURING THE RAIN EVENT. IF DETERMINED NECESSARY BY THE RESIDENT ENGINEER, WORK MAY BE SUSPENDED OR LIMITED DURING THE STORM.

PROJECT NAME:	ROYALTON
PROJECT NUMBER:	BRS 0147 (13)
FILE NAME: s86e055ero_narrative.dgn	PLOT DATE: 08-OCT-2013
PROJECT LEADER: C. CARLSON	DRAWN BY: G. ROY
DESIGNED BY: D. PETERSON	CHECKED BY: C. CARLSON
EPSC NARRATIVE (1)	SHEET 158 OF 186

1. EPSC PLAN

THE CONTRACTOR SHALL SUBMIT AN EPSC PLAN IN ACCORDANCE WITH SPECIAL PROVISION SECTION 652 AND PROJECT PERMITS. THE PLAN AT A MINIMUM SHALL TAKE INTO CONSIDERATION THE FOLLOWING:

- **ALL AREAS**  
THE DISTURBANCE AT ANY ONE TIME IN ALL AREAS COMBINED SHALL BE LIMITED TO 2 ACRES.
  
- **DRAINAGE AREA 1**
  - SOIL INFORMATION - ONDAWA FINE SANDY LOAM, 0 TO 3 PERCENT SLOPES, OCCASIONALLY FLOODED, K=0.24. MEDIUM ERODIBILITY.
  - ACCESS TO THE AREA, INCLUDING TEMPORARY AND PERMANENT STABILIZATION OF THE PROPOSED ACCESS DURING AND THEN FOLLOWING CONSTRUCTION OF THE PROJECT
  - STORMWATER RUNOFF TO BE CONTROLLED PRIOR TO, DURING, AND THEN FOLLOWING THE FULL COMPLETION OF STONE FACING THE RIVER EMBANKMENT ON THE SOUTH SIDE OF THE RIVER.
  
- **DRAINAGE AREA 2**
  - SOIL INFORMATION - BUCKLAND LOAM, 8 TO 15 PERCENT SLOPES, K=0.32. HIGHLY ERODIBLE.
  - ACCESS TO THE AREA, INCLUDING TEMPORARY AND PERMANENT STABILIZATION OF THE PROPOSED ACCESS DURING AND THEN FOLLOWING CONSTRUCTION OF THE PROJECT
  - STORMWATER RUNOFF TO BE CONTROLLED PRIOR TO, DURING, AND THEN FOLLOWING THE FULL COMPLETION OF STONE FACING THE RIVER EMBANKMENT ON THE NORTH SIDE OF THE RIVER.
  
- **DRAINAGE AREA 3**
  - SOIL INFORMATION - HITCHCOCK SILT LOAM, 25 TO 50 PERCENT SLOPES, ERODED, K=0.49 AND BUCKLAND LOAM, 8 TO 15 PERCENT SLOPES, K=0.32. HIGHLY ERODIBLE.
  - ACCESS TO THE AREA, INCLUDING TEMPORARY AND PERMANENT STABILIZATION OF THE PROPOSED ACCESS DURING AND THEN FOLLOWING CONSTRUCTION OF THE PROJECT
  - STORMWATER RUNOFF TO BE CONTROLLED PRIOR TO, DURING, AND THEN FOLLOWING THE FULL COMPLETION OF STONE FACING THE RIVER EMBANKMENT ON THE SOUTH SIDE OF THE RIVER.

THE EPSC PLAN SHALL ALSO INCLUDE INFORMATION REGARDING:

- THE CONSTRUCTION OF STONE PADS, INCLUDING STREAM DIVERSION PLANS
- CONSTRUCTION OF TEMPORARY BRIDGES (OR TEMPORARY FILL)
- METHOD FOR TREATMENT OF DISCHARGE FROM DEWATERING.
- CONSTRUCTION OF HAUL ROADS.



2. INSPECTION & MONITORING NOTES

- CONTRACTOR TO CONDUCT INSPECTIONS AND MONITORING IN ACCORDANCE WITH THE SPECIAL PROVISIONS AND PERMIT SPECIFIC REQUIREMENTS.

THE CONTRACTOR SHALL KEEP ONE (1) TURBIDITY MONITOR ONSITE AND HAVE PERSONNEL ON HAND THAT ARE TRAINED IN ITS OPERATION.

PROJECT NAME: ROYALTON  
PROJECT NUMBER: BRS 0147 (13)

FILE NAME: s86e055ero_narrative.dgn	PLOT DATE: 08-OCT-2013
PROJECT LEADER: C. CARLSON	DRAWN BY: G. ROY
DESIGNED BY: D. PETERSON	CHECKED BY: C. CARLSON
EPSC NARRATIVE (2)	SHEET 159 OF 186

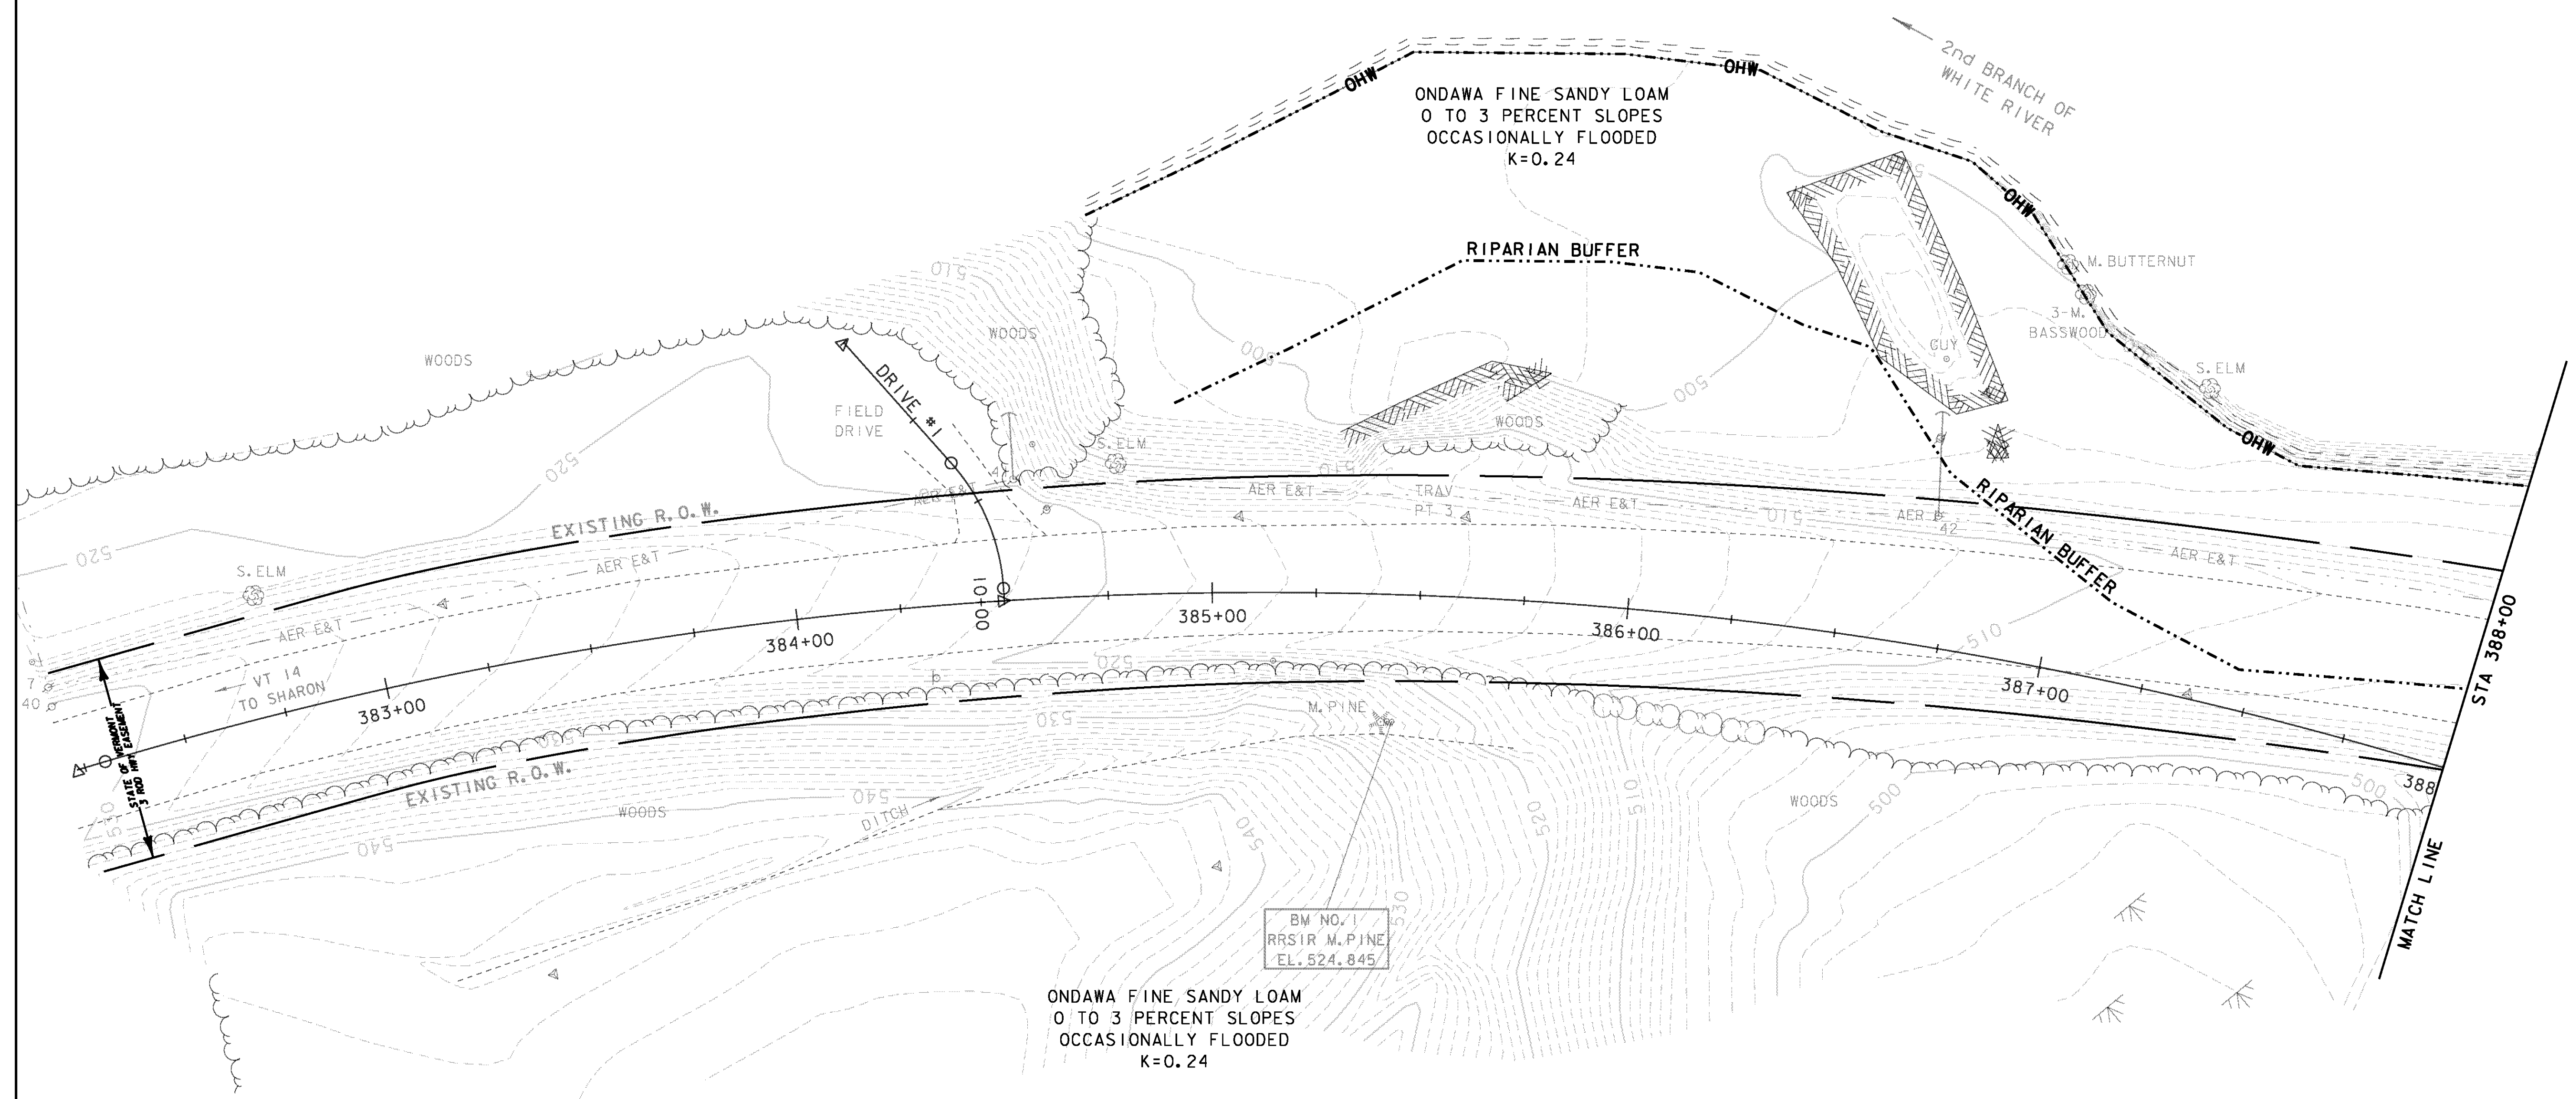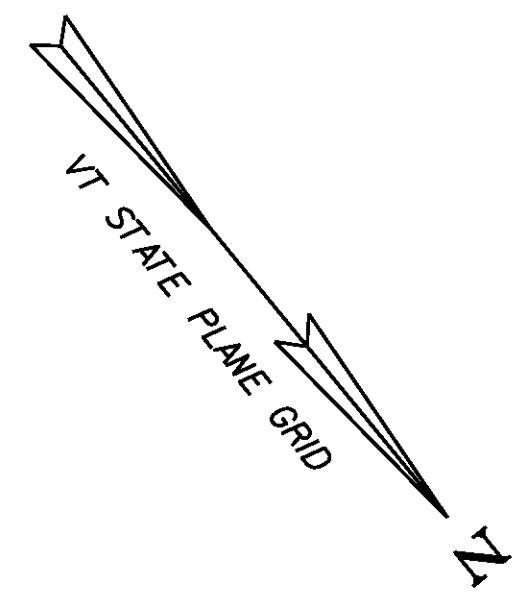

ONDAGA FINE SANDY LOAM  
0 TO 3 PERCENT SLOPES  
OCCASIONALLY FLOODED  
K=0.24


RIPARIAN BUFFER

2nd BRANCH OF  
WHITE RIVER

ONDAGA FINE SANDY LOAM  
0 TO 3 PERCENT SLOPES  
OCCASIONALLY FLOODED  
K=0.24


BM NO. 1  
RRSIR M. PINE  
EL. 524.845

NOTE:  
1. SEE SHEET 175 FOR EPSC LAYOUT PLAN SYMBOLGY LEGEND

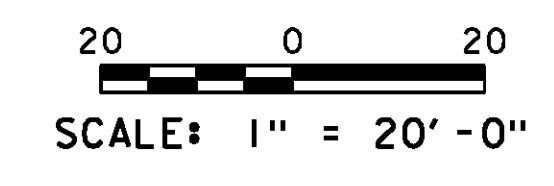

PROJECT NAME:	ROYALTON	FILE NAME:	\BR 27\s86e055erobdr_27.dgn	PLOT DATE:	08-OCT-2013
PROJECT NUMBER:	BRS 0147 (13)	PROJECT LEADER:	C. CARLSON	DRAWN BY:	D. PETERSON
		DESIGNED BY:	D. PETERSON	CHECKED BY:	C. CARLSON
		BRIDGE 27 EPSC EXISTING CONDITION (1)		SHEET	160 OF 186



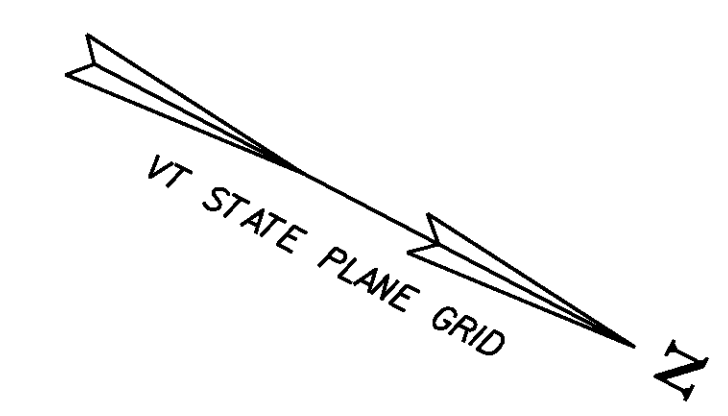


ONDAWA FINE SANDY LOAM  
0 TO 3 PERCENT SLOPES  
OCCASIONALLY FLOODED  
K=0.24


ONDAWA FINE SANDY LOAM  
0 TO 3 PERCENT SLOPES  
OCCASIONALLY FLOODED  
K=0.24

ONDAWA FINE SANDY LOAM  
0 TO 3 PERCENT SLOPES  
OCCASIONALLY FLOODED  
K=0.24



ONDAWA FINE SANDY LOAM  
0 TO 3 PERCENT SLOPES  
OCCASIONALLY FLOODED  
K=0.24

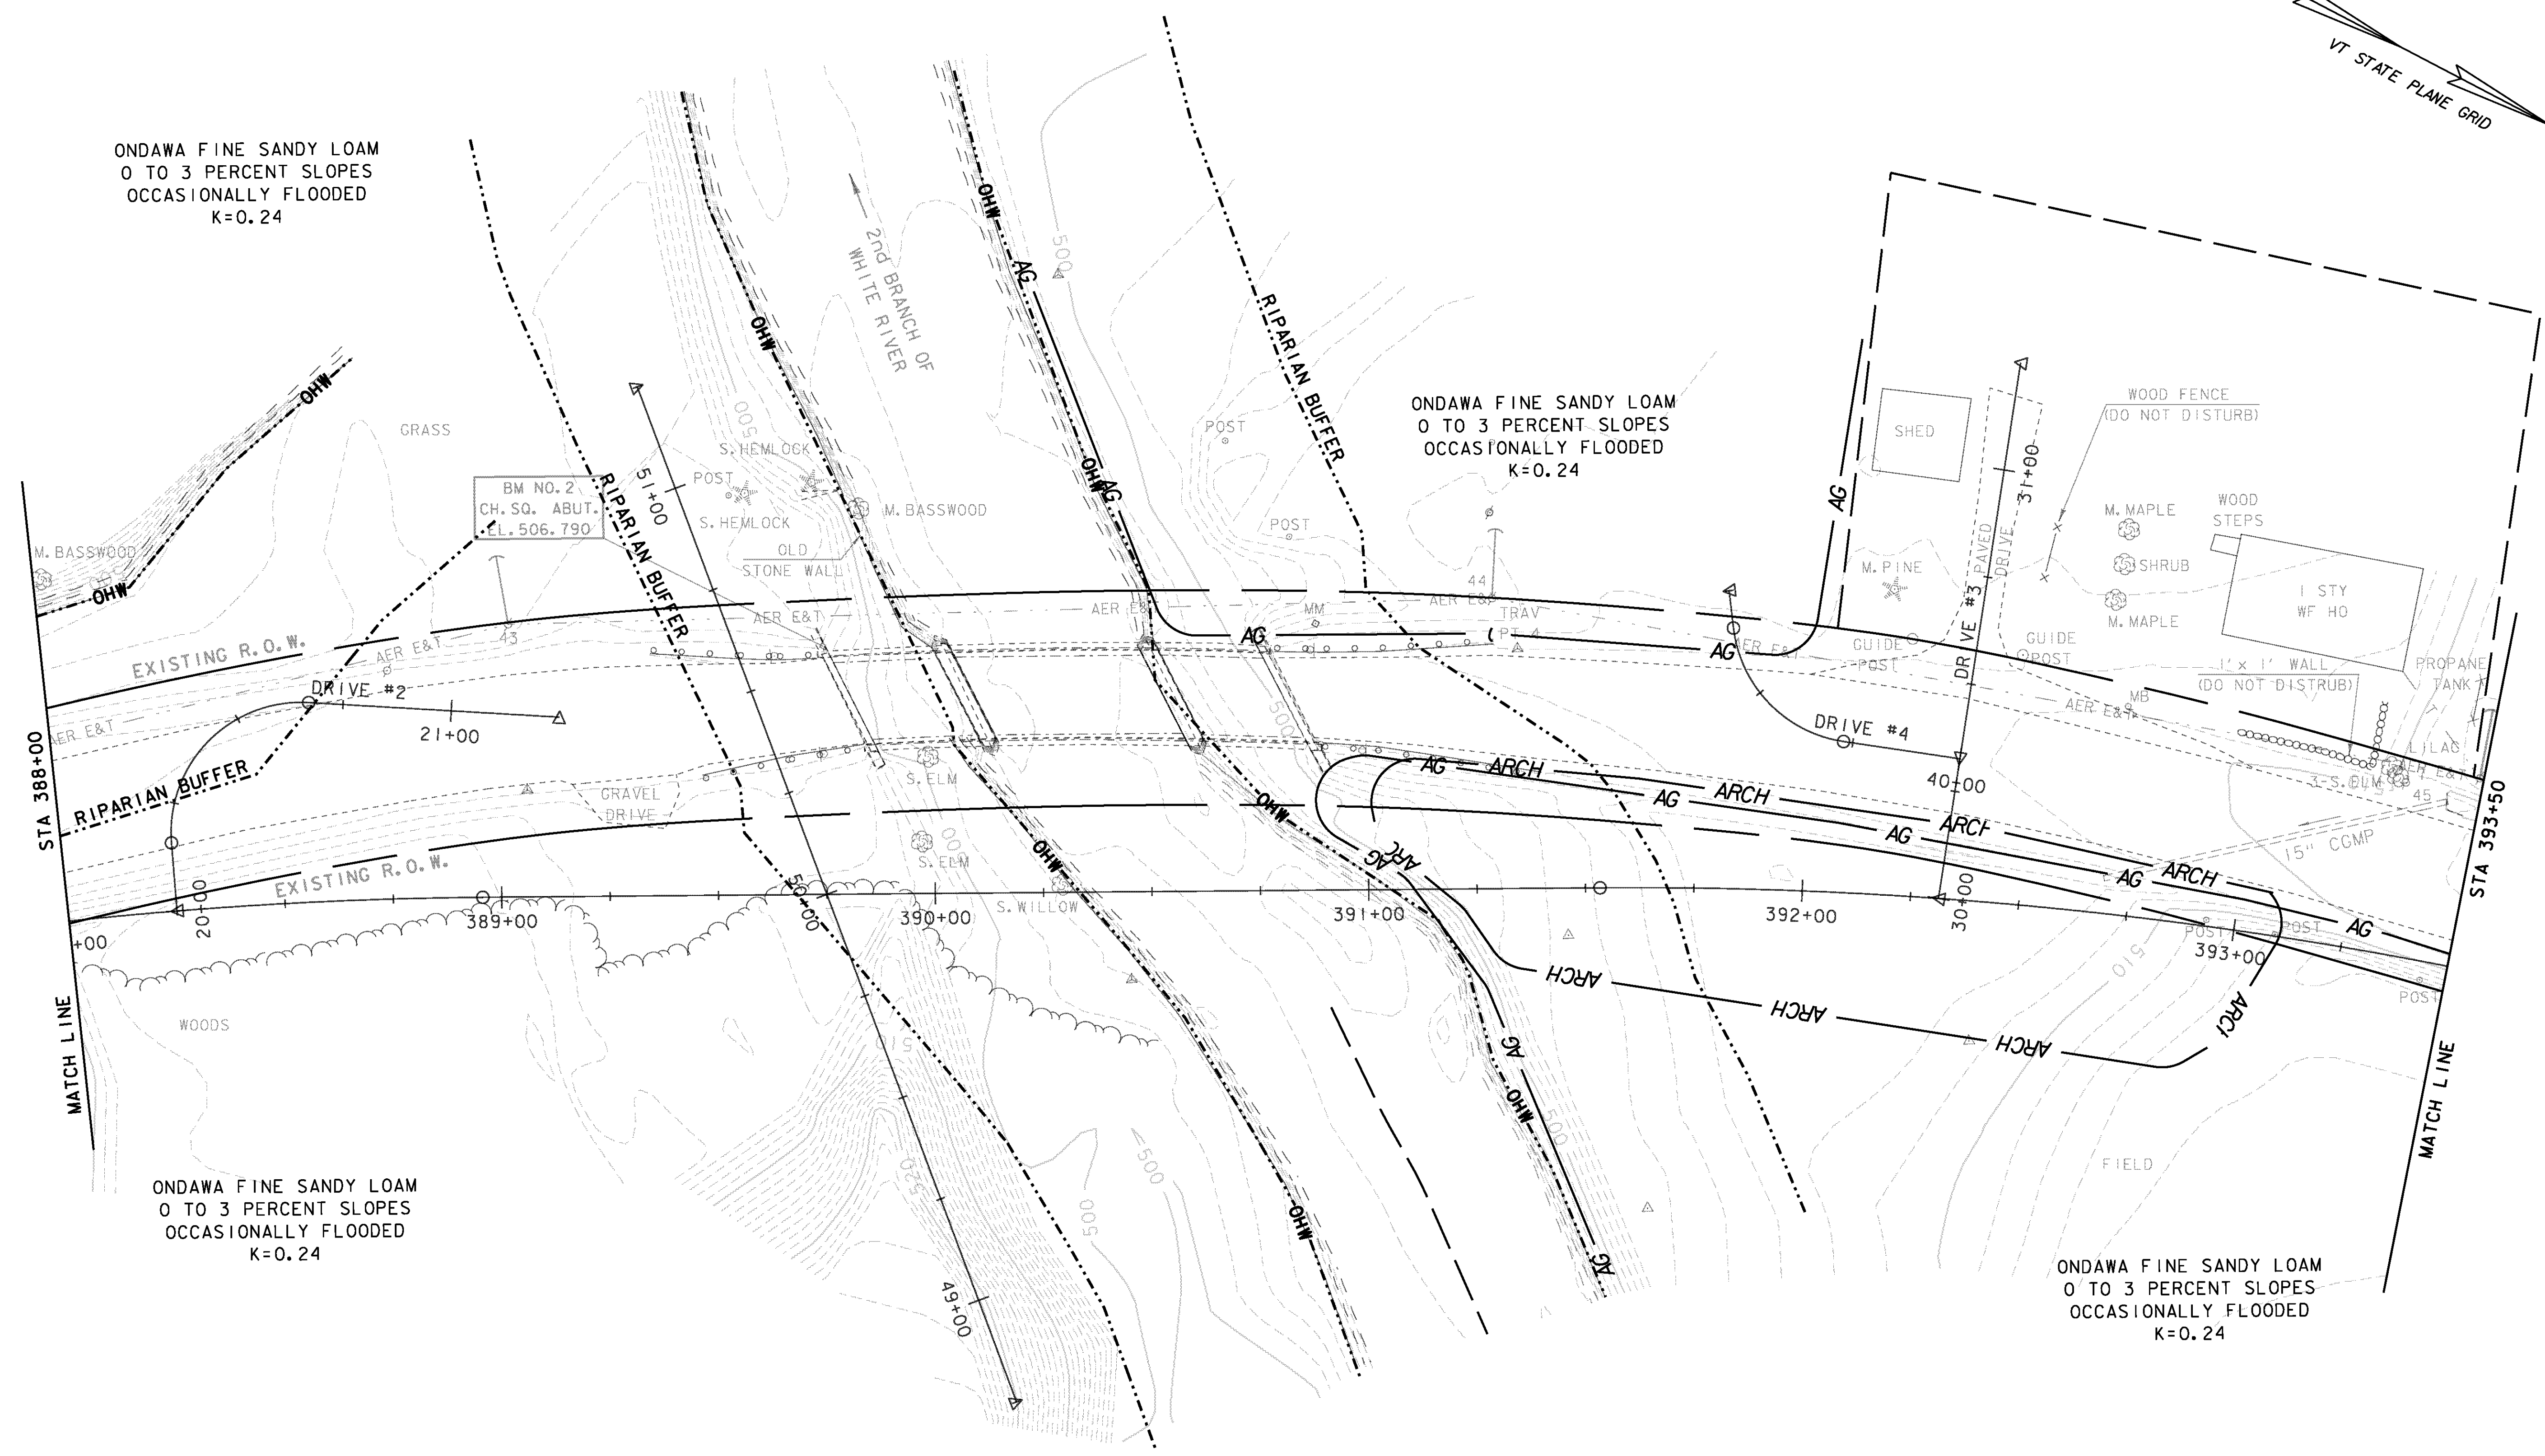


NOTE:  
1. SEE SHEET 175 FOR EPSC LAYOUT PLAN SYMBOLGY LEGEND

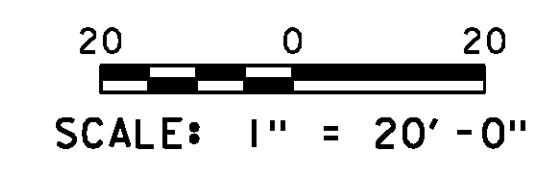

PROJECT NAME:	ROYALTON
PROJECT NUMBER:	BRS 0147 (13)
FILE NAME:	\BR 27\s86e055erobdr_27.dgn
PROJECT LEADER:	C. CARLSON
DESIGNED BY:	D. PETERSON
BRIDGE 27 EPSC EXISTING CONDITION (2)	
PLOT DATE:	08-OCT-2013
DRAWN BY:	D. PETERSON
CHECKED BY:	C. CARLSON
SHEET	161 OF 186

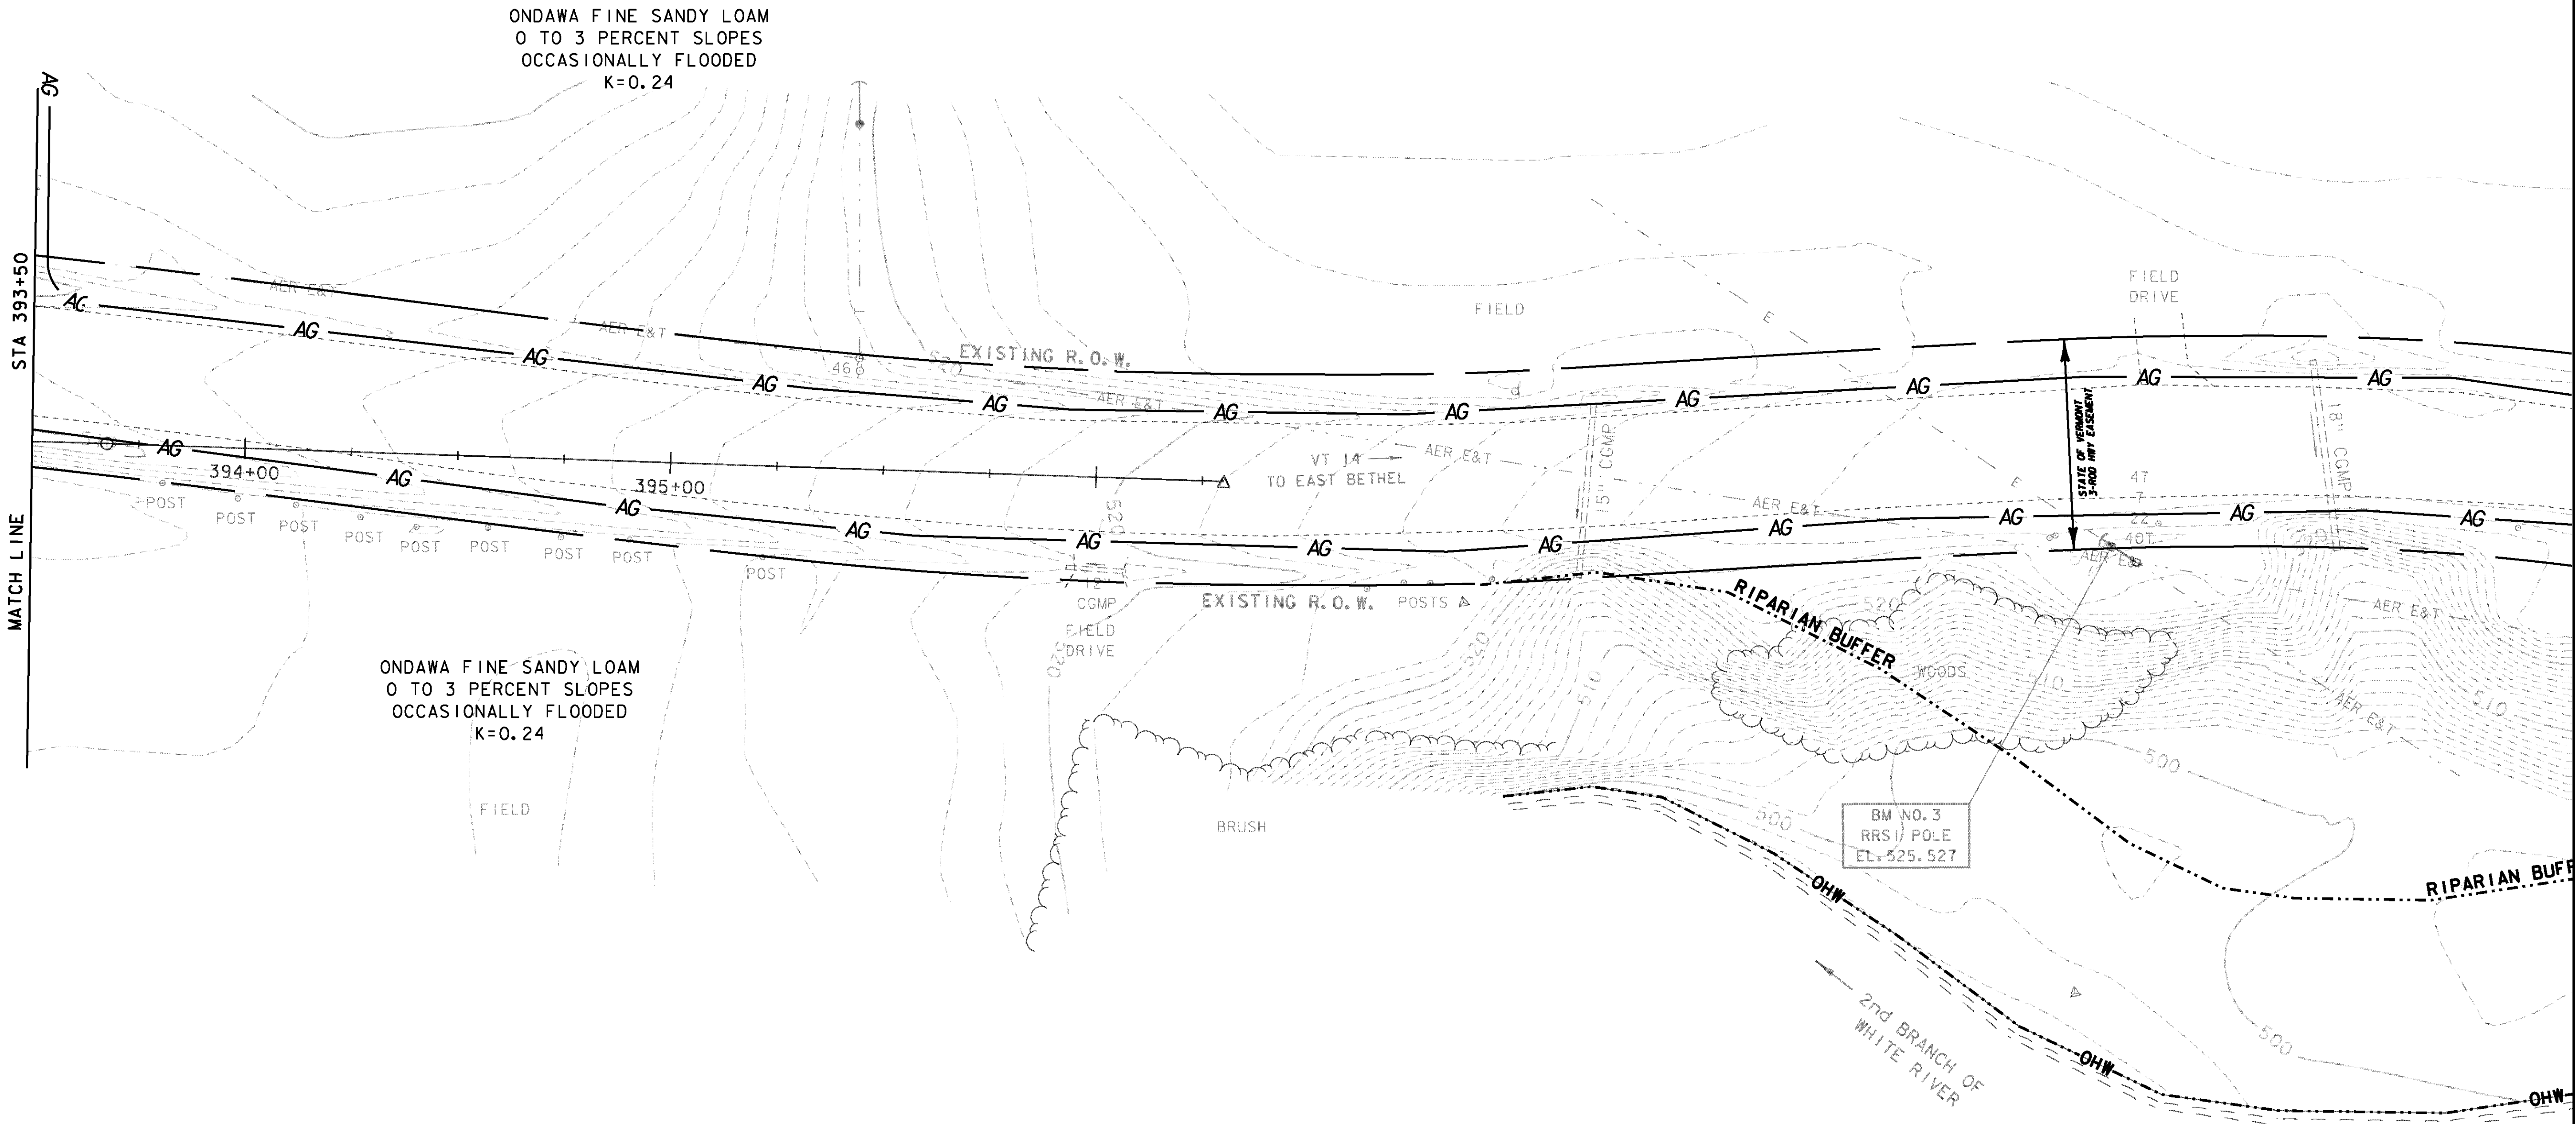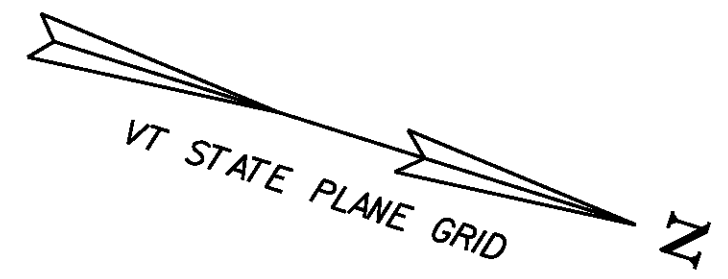




NOTE:  
 1. SEE SHEET 175 FOR EPSC LAYOUT PLAN SYMBOLGY LEGEND

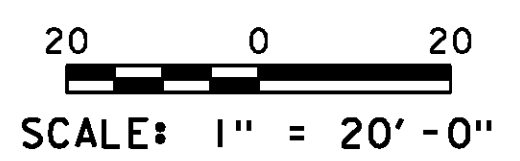



PROJECT NAME:	ROYALTON
PROJECT NUMBER:	BRS 0147 (13)
FILE NAME:	\BR 27\s86e055erobdr_27.dgn
PROJECT LEADER:	C. CARLSON
DESIGNED BY:	D. PETERSON
BRIDGE 27 EPSC EXISTING CONDITION (3)	
PLOT DATE:	08-OCT-2013
DRAWN BY:	D. PETERSON
CHECKED BY:	C. CARLSON
SHEET	162 OF 186

NOTES:

1. SILT FENCE INSTALLATION MAY REQUIRE PHASING TO MAXIMIZE EFFECTIVENESS. INSTALL AND/OR MOVE SILT FENCE AS CONSTRUCTION PROGRESSES TO OBTAIN THE GREATEST PREVENTION OF SEDIMENT TRANSPORT.
2. SEE SHEET 175 FOR EPSC LAYOUT PLAN SYMBOLOLOGY LEGEND

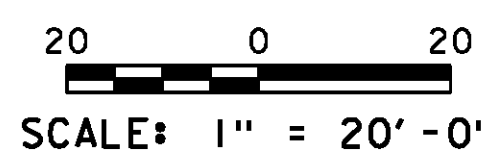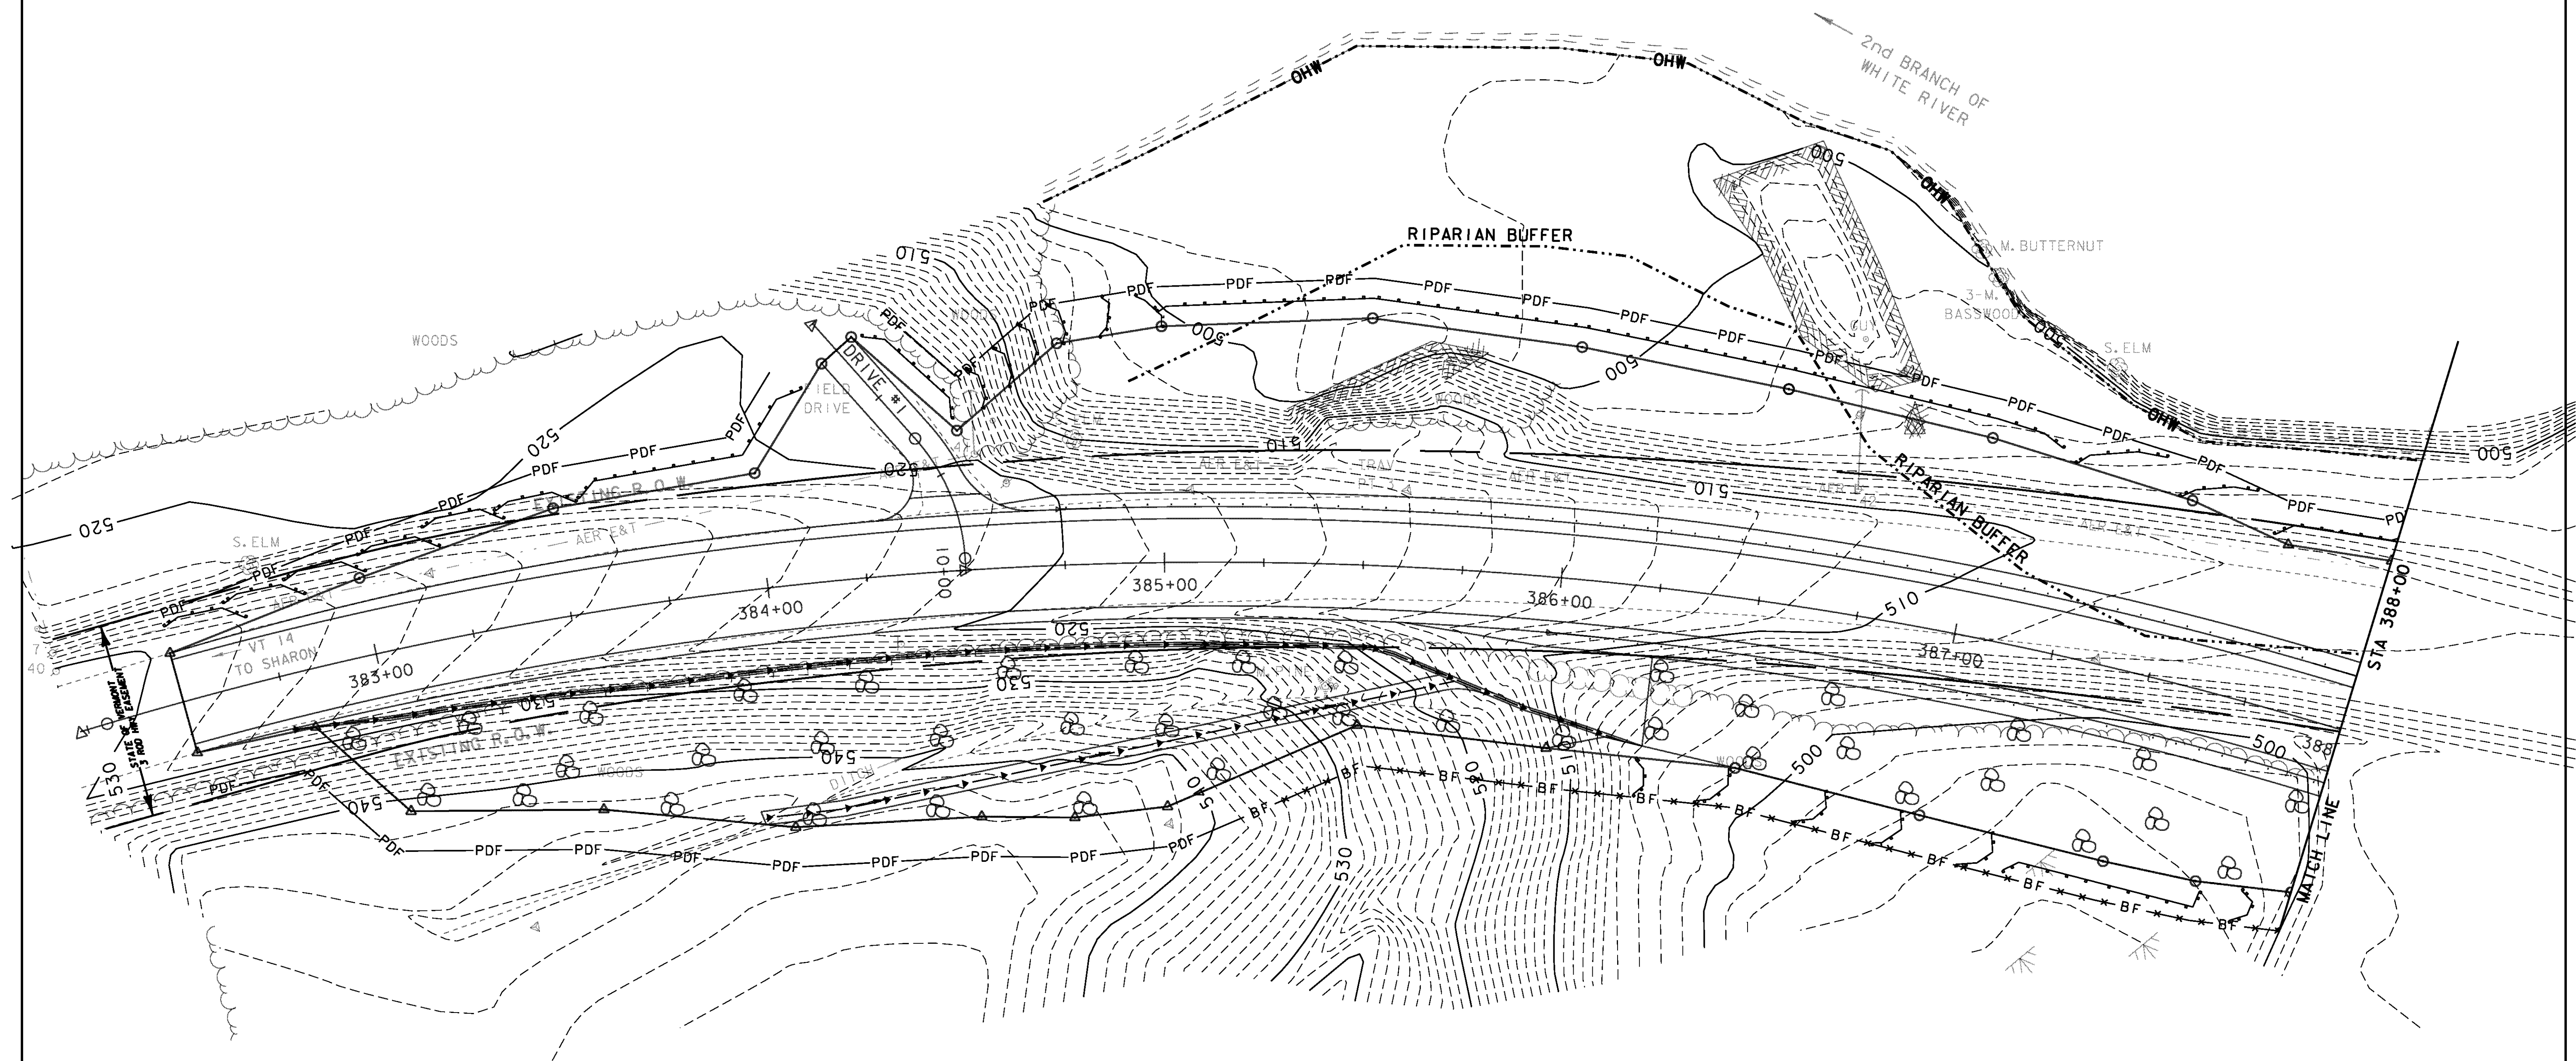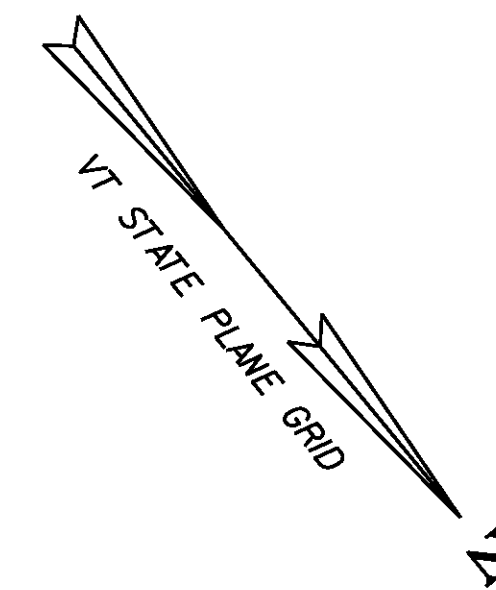


PROJECT NAME:	ROYALTON
PROJECT NUMBER:	BRS 0147 (13)
FILE NAME:	\BR 27\s86e055erobdr_27.dgn
PROJECT LEADER:	C. CARLSON
DESIGNED BY:	D. PETERSON
BRIDGE 27 EPSC CONSTRUCTION CONDITION (1)	
PLOT DATE:	08-OCT-2013
DRAWN BY:	D. PETERSON
CHECKED BY:	C. CARLSON
SHEET	163 OF 186

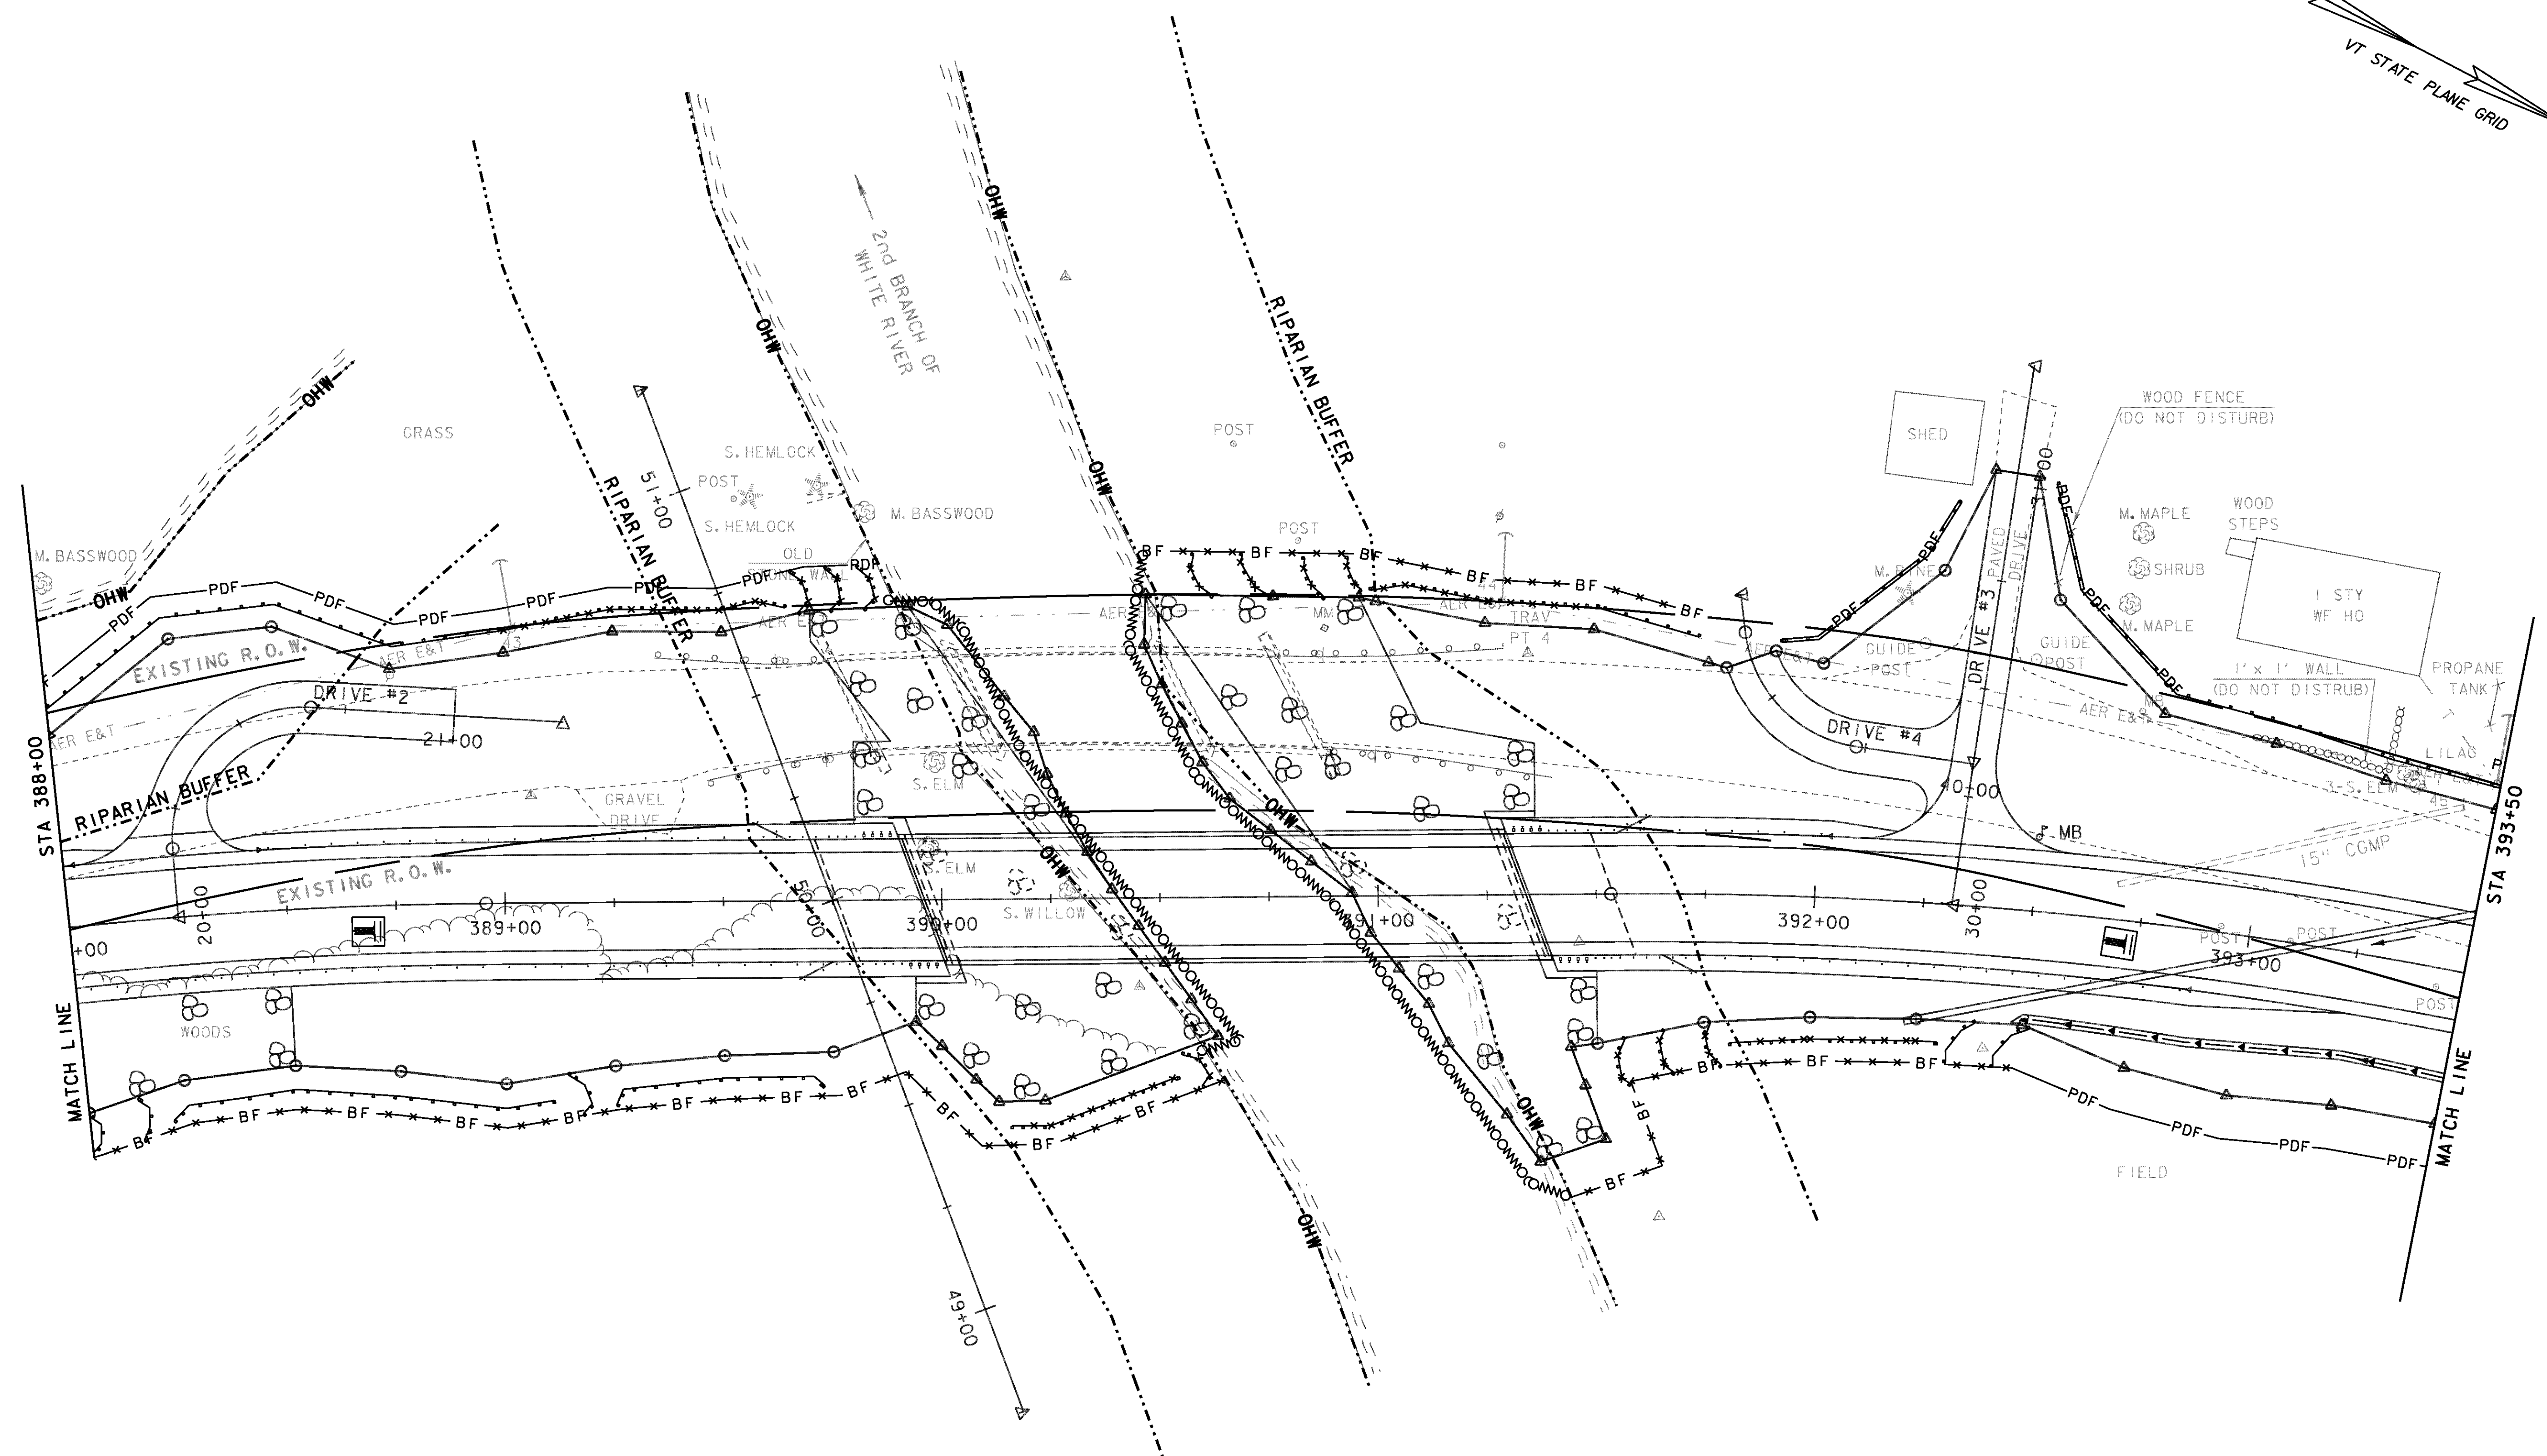
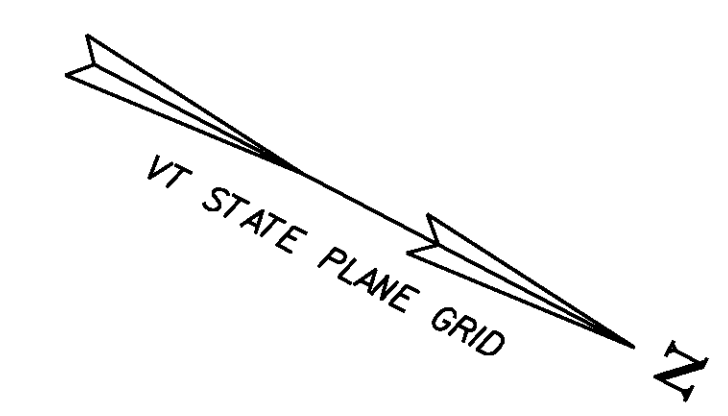


NOTES:


1. SILT FENCE INSTALLATION MAY REQUIRE PHASING TO MAXIMIZE EFFECTIVENESS. INSTALL AND/OR MOVE SILT FENCE AS CONSTRUCTION PROGRESSES TO OBTAIN THE GREATEST PREVENTION OF SEDIMENT TRANSPORT.
2. SEE SHEET 175 FOR EPSC LAYOUT PLAN SYMBOLOGY LEGEND

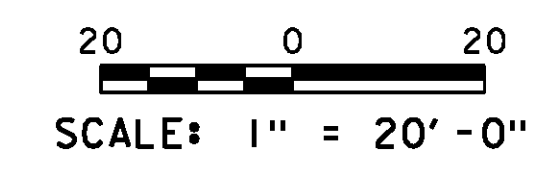

PROJECT NAME:	ROYALTON
PROJECT NUMBER:	BRS 0147 (13)
FILE NAME:	\BR 27\s86e055erobdr_27.dgn
PROJECT LEADER:	C. CARLSON
DESIGNED BY:	D. PETERSON
BRIDGE 27 EPSC CONSTRUCTION CONDITION (2)	
PLOT DATE:	08-OCT-2013
DRAWN BY:	D. PETERSON
CHECKED BY:	C. CARLSON
SHEET	164 OF 186

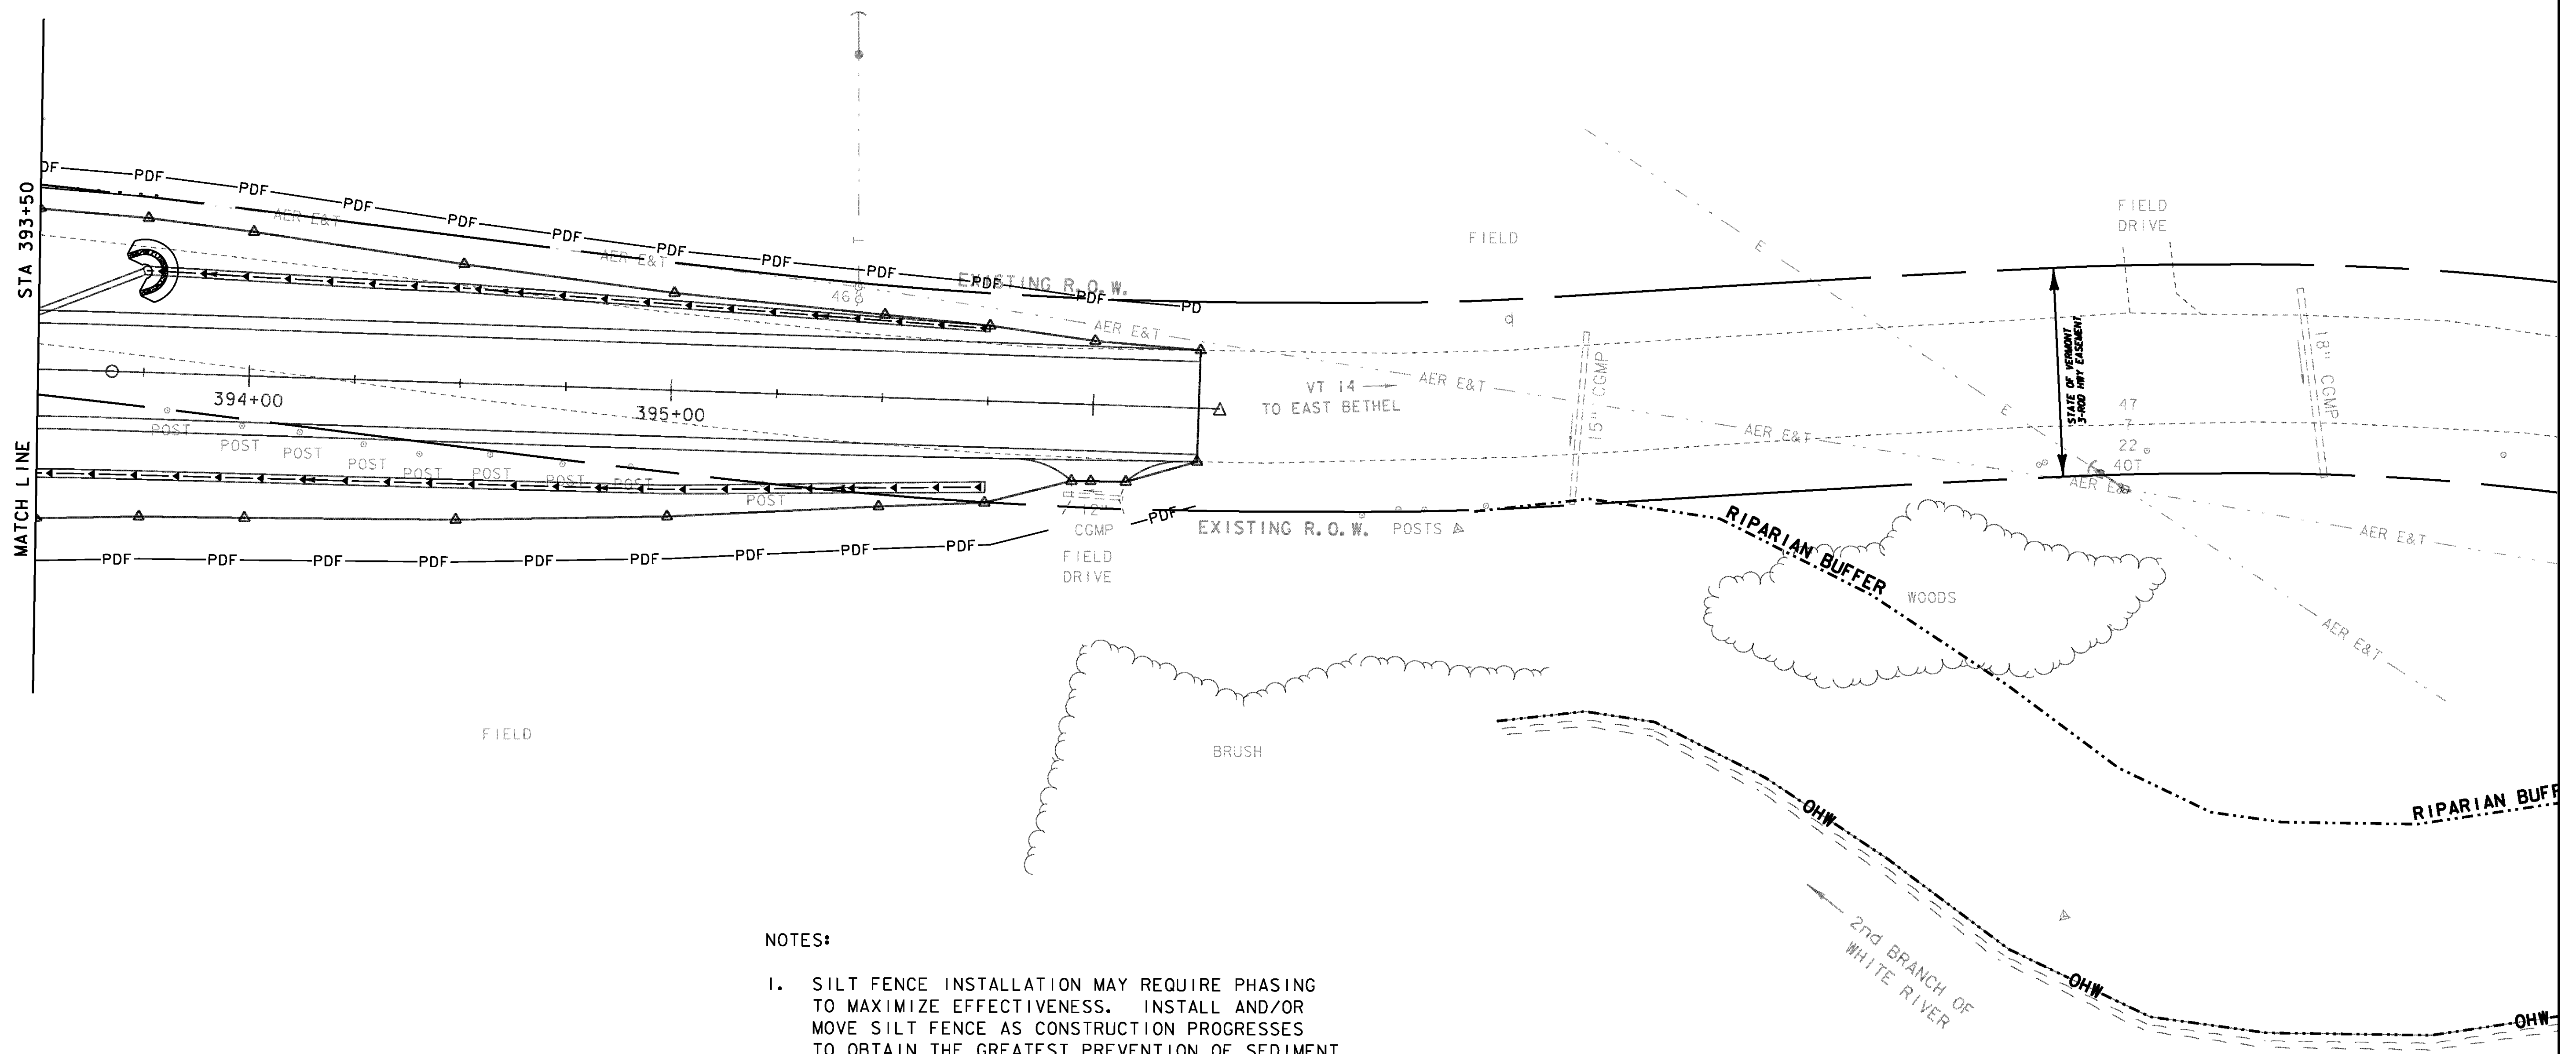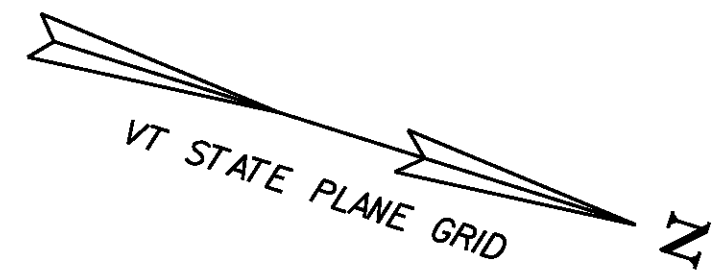




- NOTES:
1. SILT FENCE INSTALLATION MAY REQUIRE PHASING TO MAXIMIZE EFFECTIVENESS. INSTALL AND/OR MOVE SILT FENCE AS CONSTRUCTION PROGRESSES TO OBTAIN THE GREATEST PREVENTION OF SEDIMENT TRANSPORT.
  2. SEE SHEET 175 FOR EPSC LAYOUT PLAN SYMBOLGY LEGEND

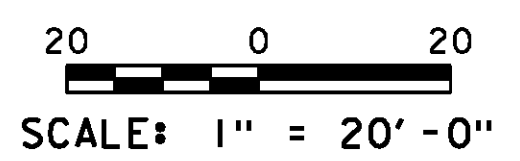



PROJECT NAME:	ROYALTON
PROJECT NUMBER:	BRS 0147 (13)
FILE NAME:	\BR 27\s86e055erobdr_27.dgn
PROJECT LEADER:	C. CARLSON
DESIGNED BY:	D. PETERSON
BRIDGE 27 EPSC CONSTRUCTION CONDITION (3)	
PLOT DATE:	08-OCT-2013
DRAWN BY:	D. PETERSON
CHECKED BY:	C. CARLSON
SHEET	165 OF 186

NOTES:


1. SEE CROSS SECTIONS FOR FINAL GRADE INFORMATION.
2. SEE SHEET 175 FOR EPSC LAYOUT PLAN SYMBOLOGY LEGEND

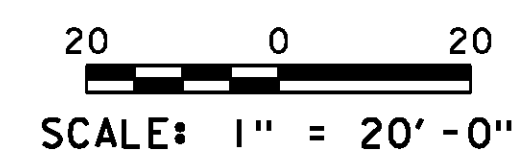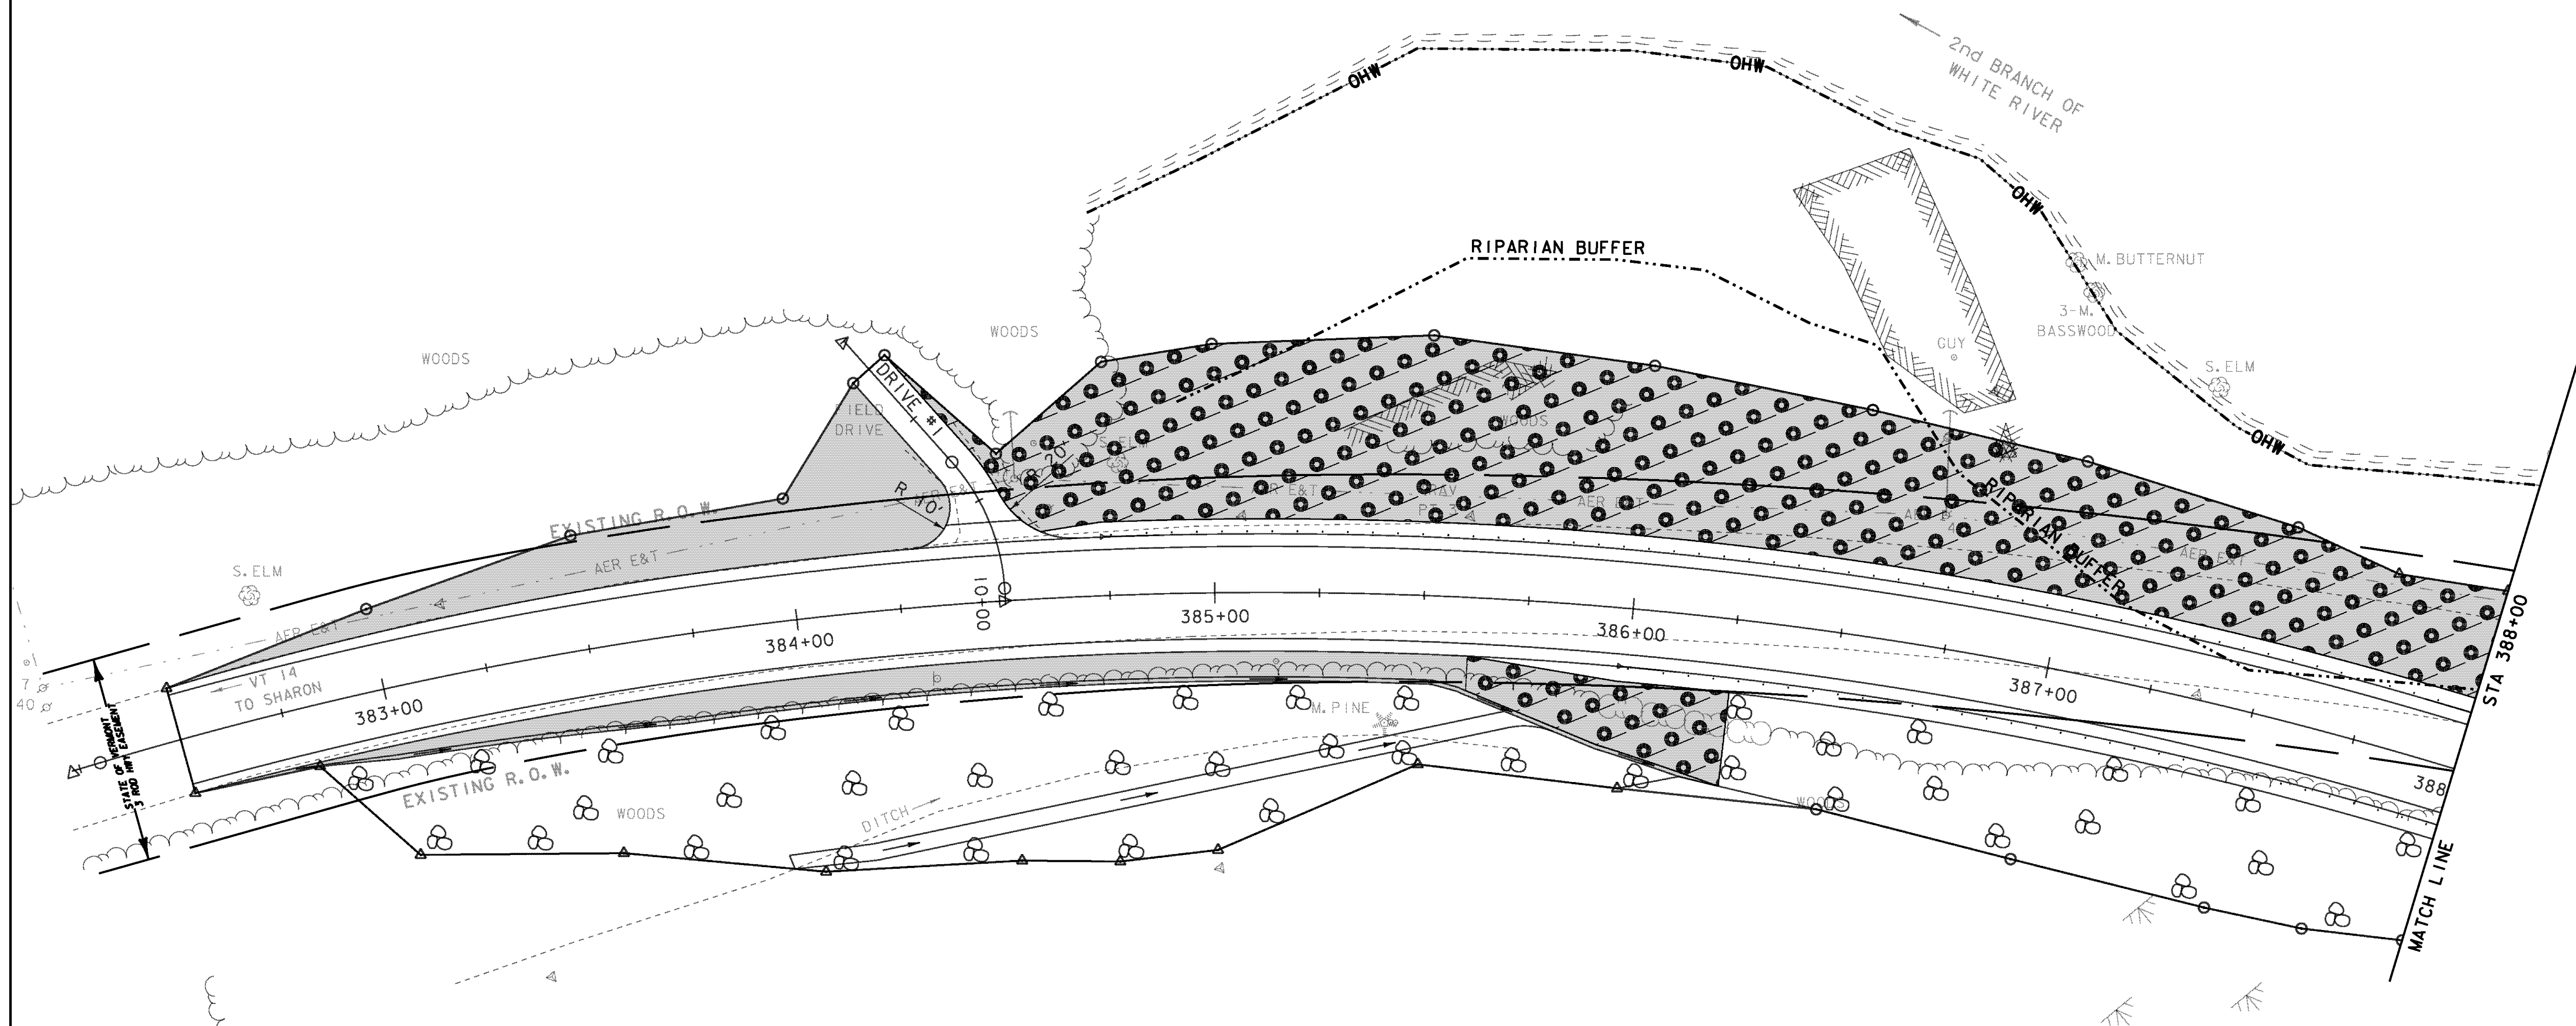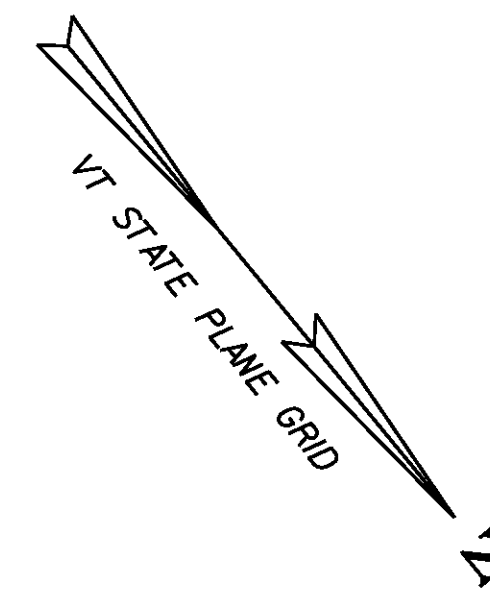



PROJECT NAME:	ROYALTON
PROJECT NUMBER:	BRS 0147 (13)
FILE NAME:	\BR27\s86e055erobdr_27.dgn
PROJECT LEADER:	C. CARLSON
DESIGNED BY:	D. PETERSON
BRIDGE 27 EPSC FINAL CONDITION (1)	
PLOT DATE:	08-OCT-2013
DRAWN BY:	D. PETERSON
CHECKED BY:	C. CARLSON
SHEET	166 OF 186

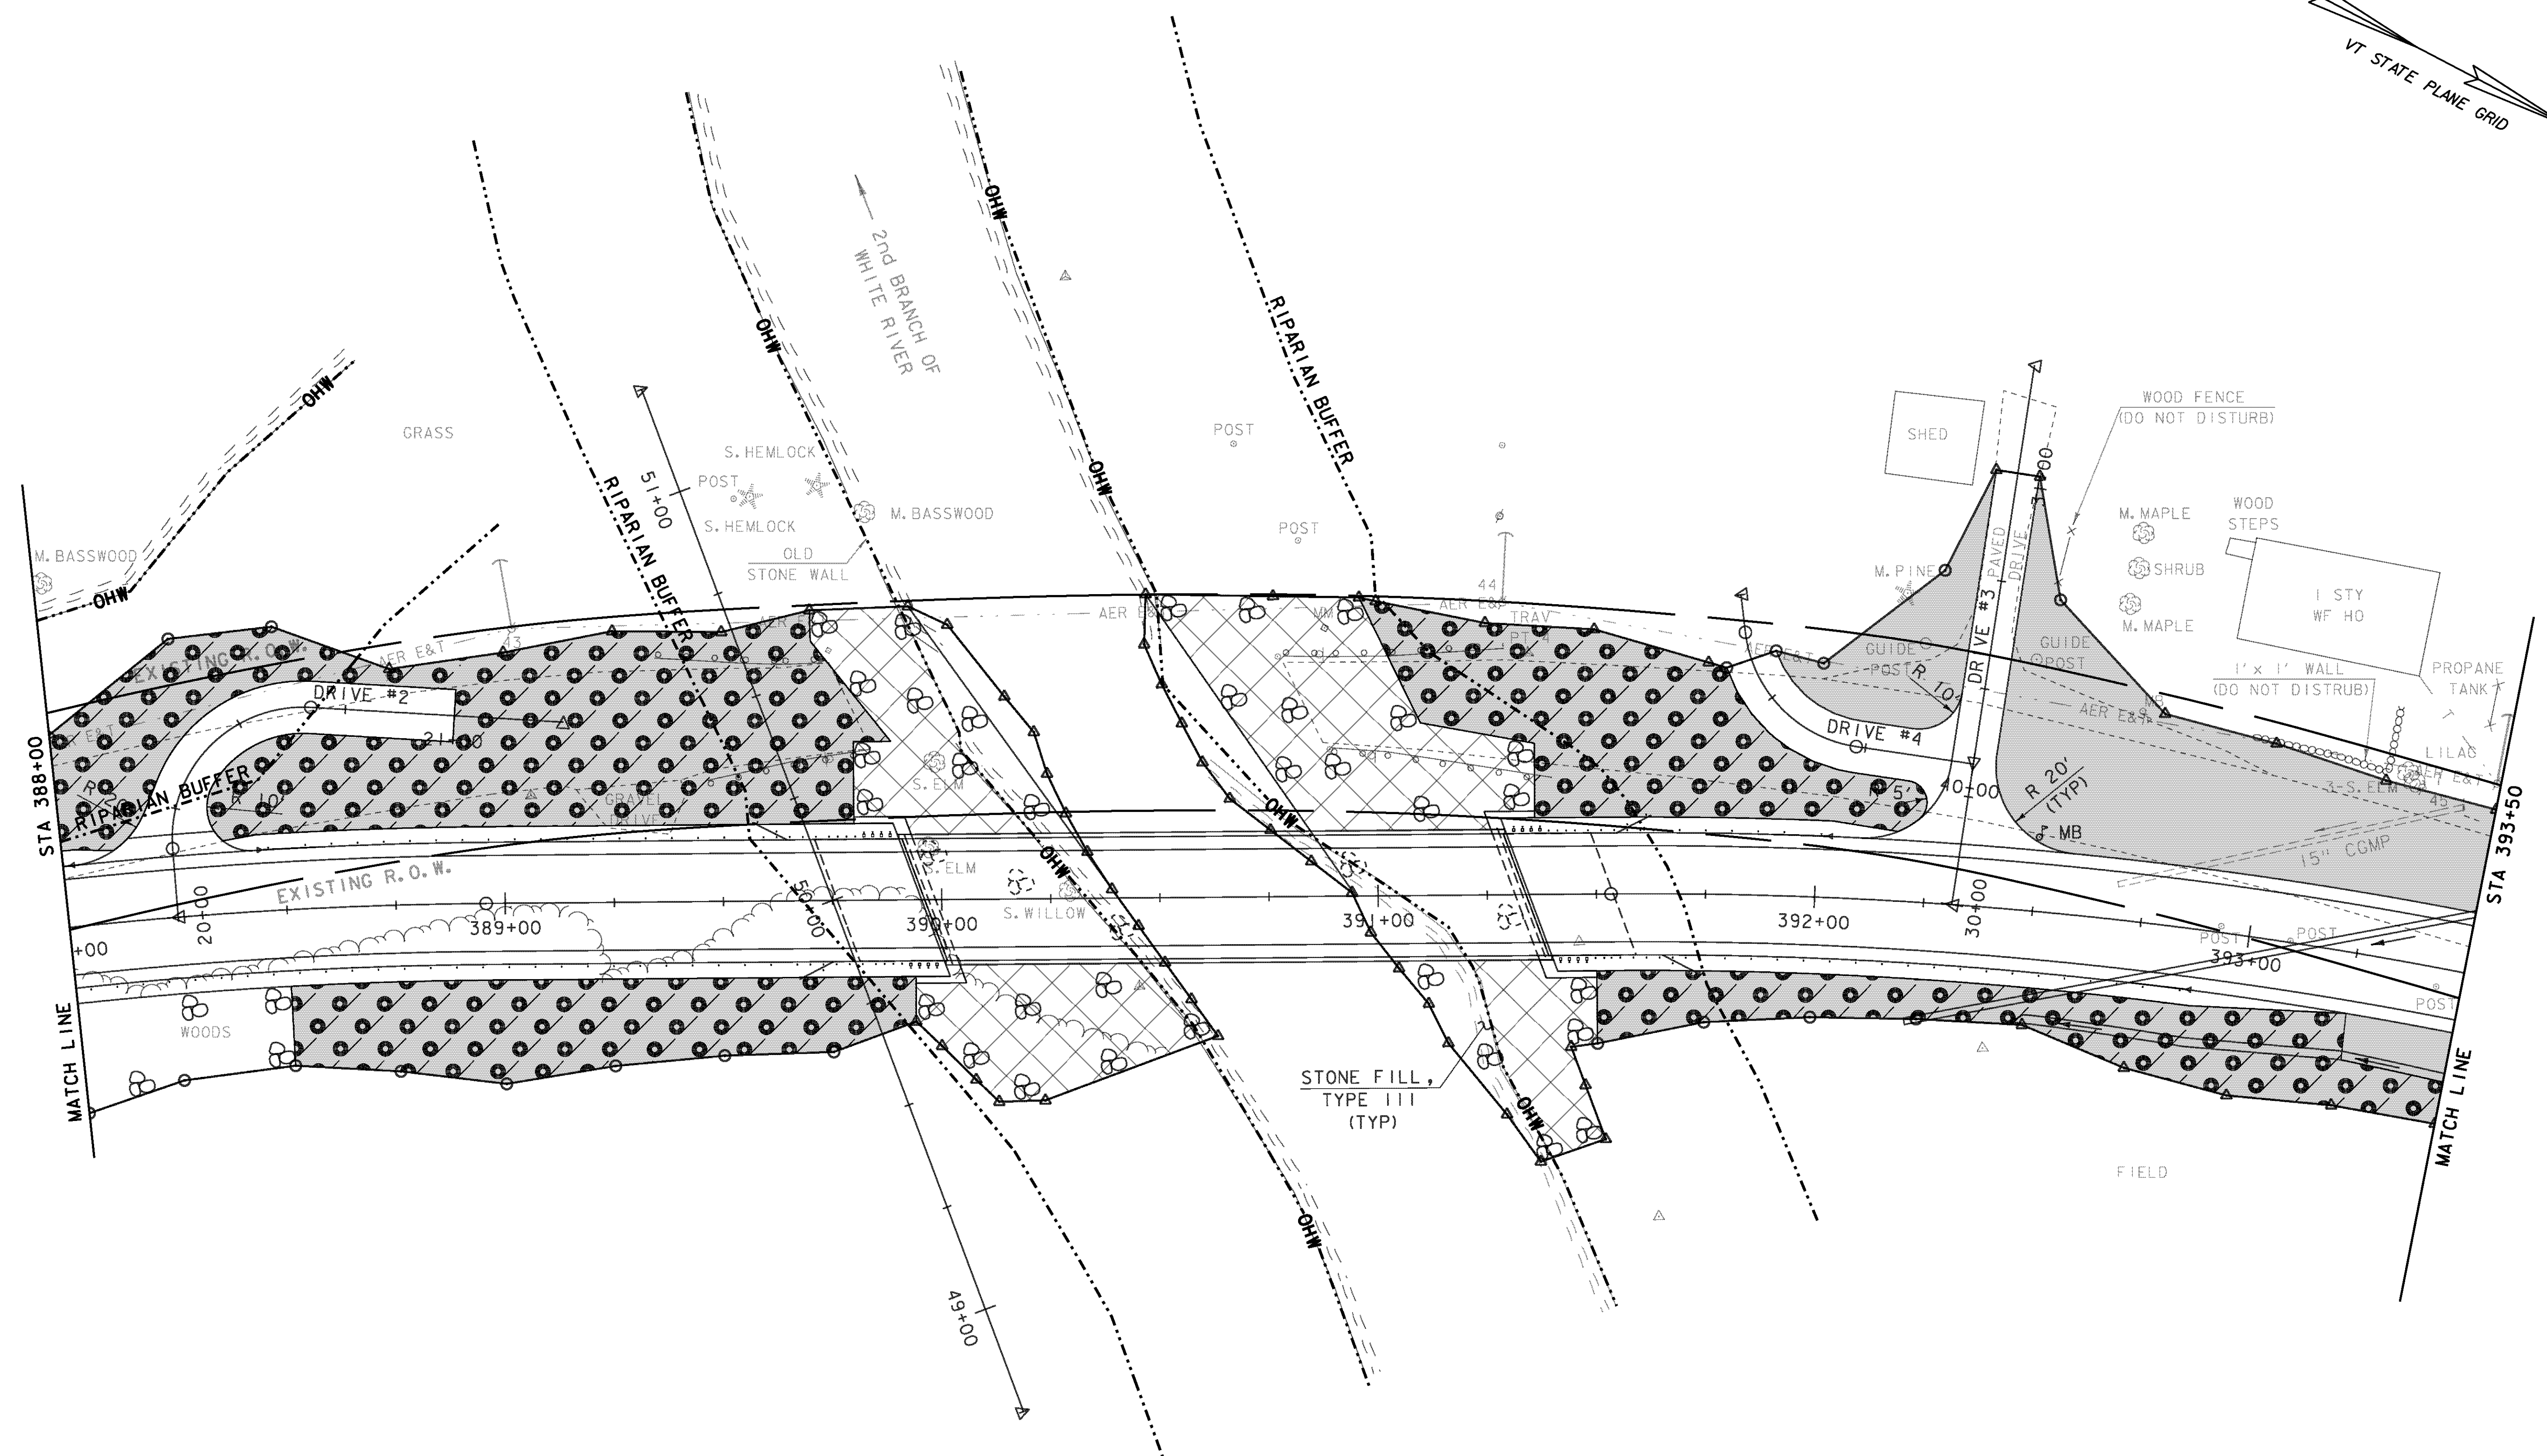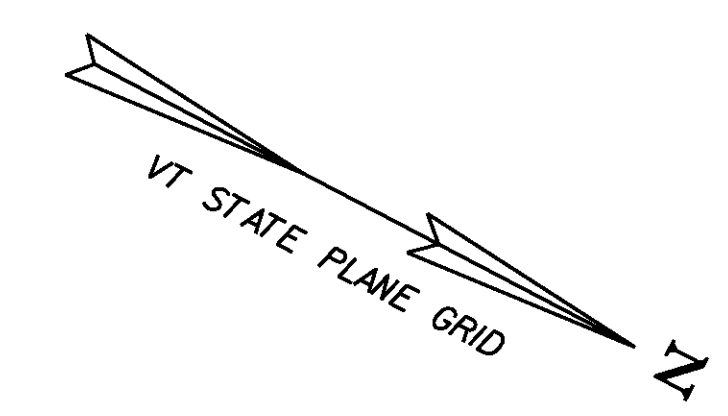


- NOTES:
1. SEE CROSS SECTIONS FOR FINAL GRADE INFORMATION.
  2. SEE SHEET 175 FOR EPSC LAYOUT PLAN SYMBOLGY LEGEND

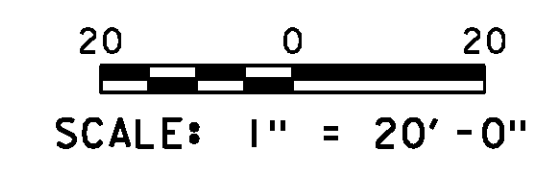

PROJECT NAME:	ROYALTON
PROJECT NUMBER:	BRS 0147 (13)
FILE NAME:	\BR 27\s86e055erobdr_27.dgn
PROJECT LEADER:	C. CARLSON
DESIGNED BY:	D. PETERSON
BRIDGE 27 EPSC FINAL CONDITION (2)	
PLOT DATE:	08-OCT-2013
DRAWN BY:	D. PETERSON
CHECKED BY:	C. CARLSON
SHEET	167 OF 186

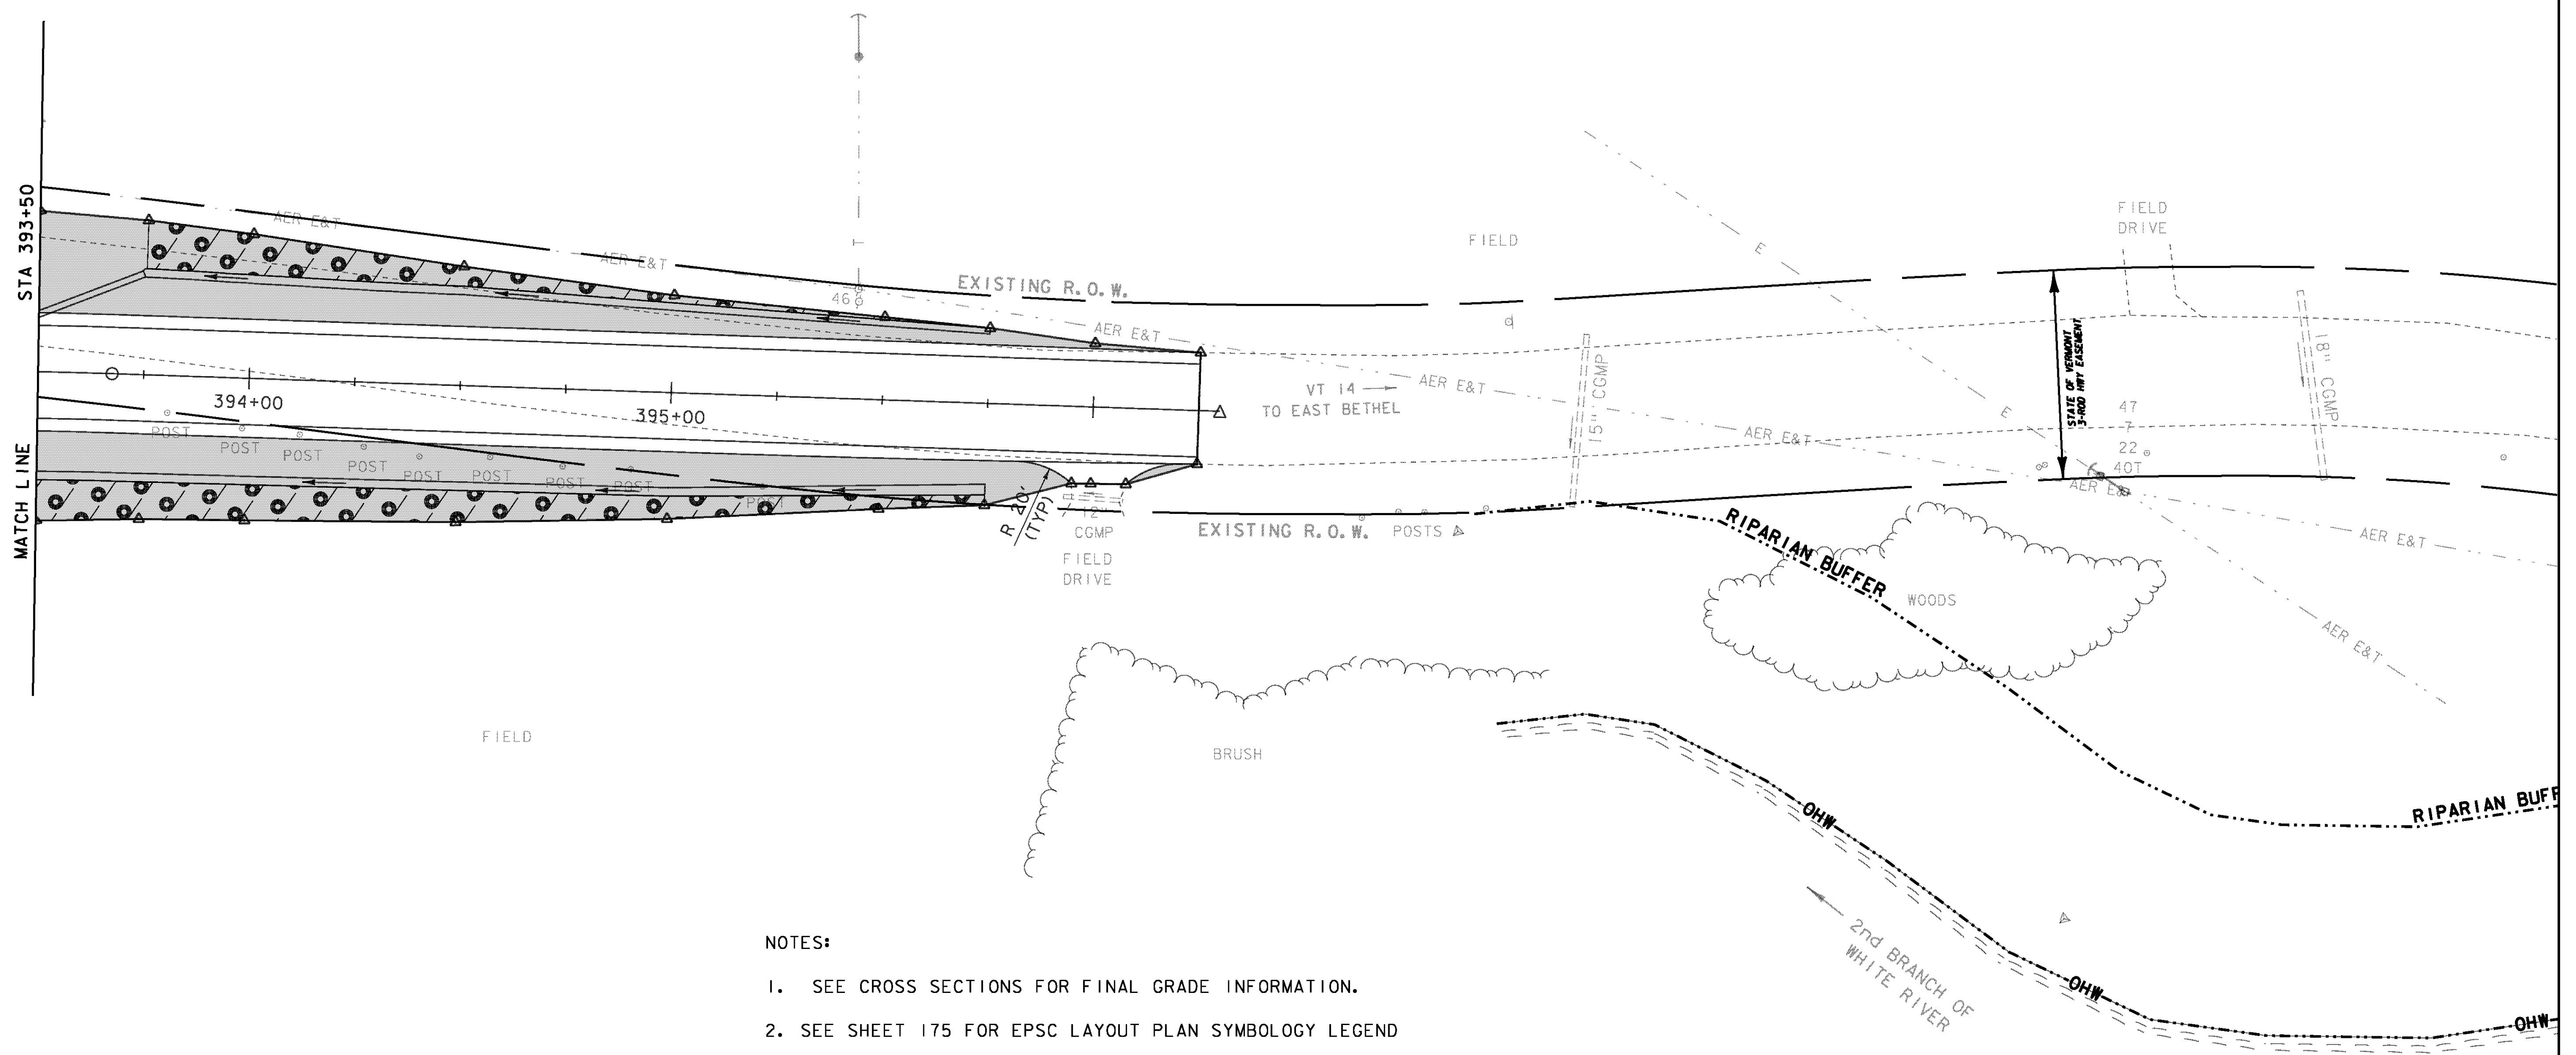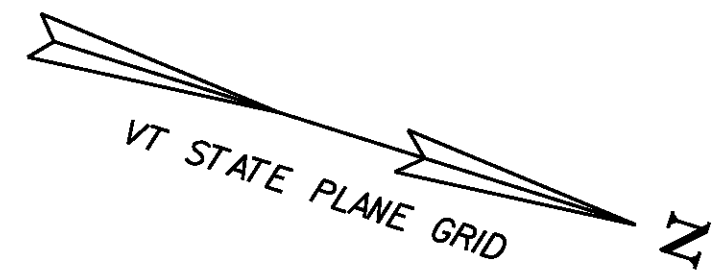

- NOTES:
1. SEE CROSS SECTIONS FOR FINAL GRADE INFORMATION.
  2. SEE SHEET 175 FOR EPSC LAYOUT PLAN SYMBOLGY LEGEND

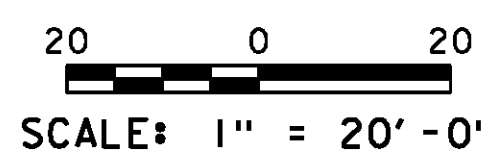


PROJECT NAME:	ROYALTON
PROJECT NUMBER:	BRS 0147 (I3)
FILE NAME:	\BR 27\s86e055erobdr_27.dgn
PROJECT LEADER:	C. CARLSON
DESIGNED BY:	D. PETERSON
BRIDGE 27 EPSC FINAL CONDITION (3)	
PLOT DATE:	08-OCT-2013
DRAWN BY:	D. PETERSON
CHECKED BY:	C. CARLSON
SHEET	168 OF 186



# LEGEND

- AG — AGRICULTURAL RESOURCE
- - - - - 50' RIPARIAN BUFFER

NOTE:  
1. SEE SHEET 175 FOR EPSC LAYOUT PLAN SYMBOLOGY LEGEND

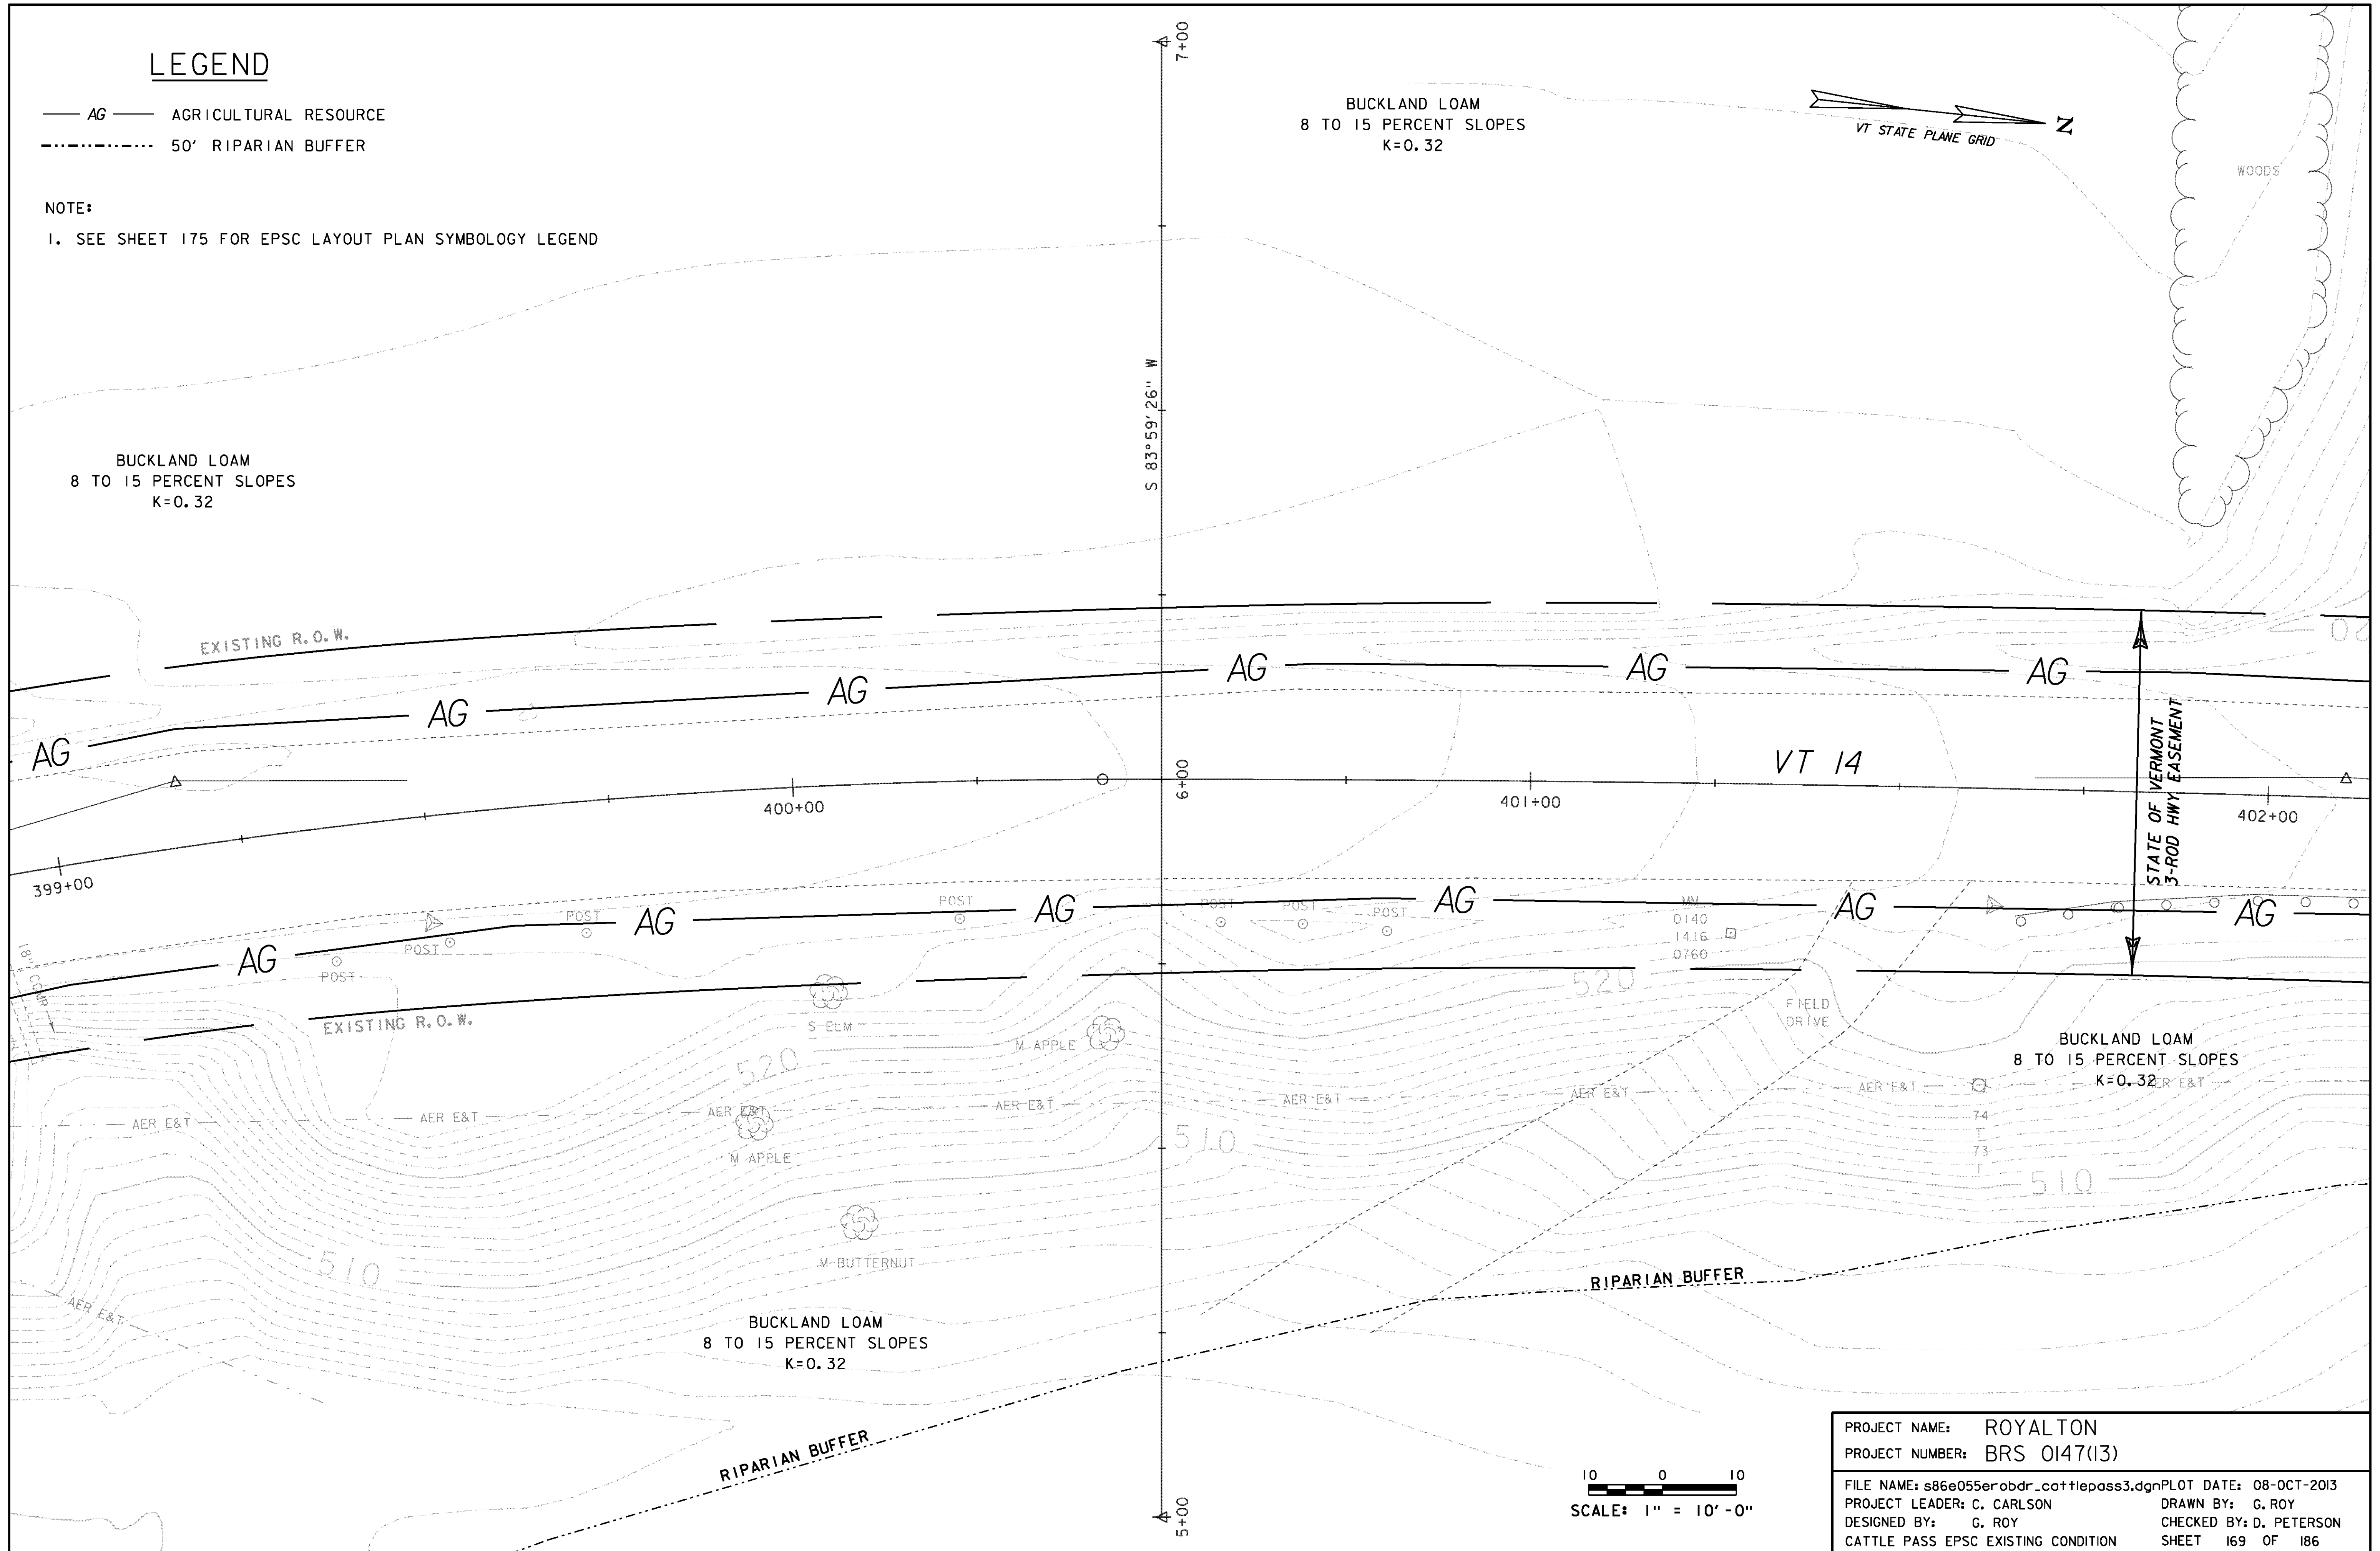

PROJECT NAME:	ROYALTON
PROJECT NUMBER:	BRS 0147(13)
FILE NAME:	s86e055erobdr_cattlepass3.dgn
PLOT DATE:	08-OCT-2013
PROJECT LEADER:	C. CARLSON
DRAWN BY:	G. ROY
DESIGNED BY:	G. ROY
CHECKED BY:	D. PETERSON
CATTLE PASS EPSC EXISTING CONDITION	SHEET 169 OF 186


SCALE: 1" = 10'-0"

# LEGEND

- PDF — PROJECT DEMARCATION FENCE
- SILT FENCE
- - - - 50' RIPARIAN BUFFER
- ▭ STABILIZED CONSTRUCTION ENTRANCE
- ▶—▶ STONE CHECK DAMS

## NOTES:

1. SILT FENCE INSTALLATION MAY REQUIRE PHASING TO MAXIMIZE EFFECTIVENESS. INSTALL AND/OR MOVE SILT FENCE AS CONSTRUCTION PROGRESSES TO OBTAIN THE GREATEST PREVENTION OF SEDIMENT TRANSPORT.
2. SEE SHEET 175 FOR EPSC LAYOUT PLAN SYMBOLOGY LEGEND



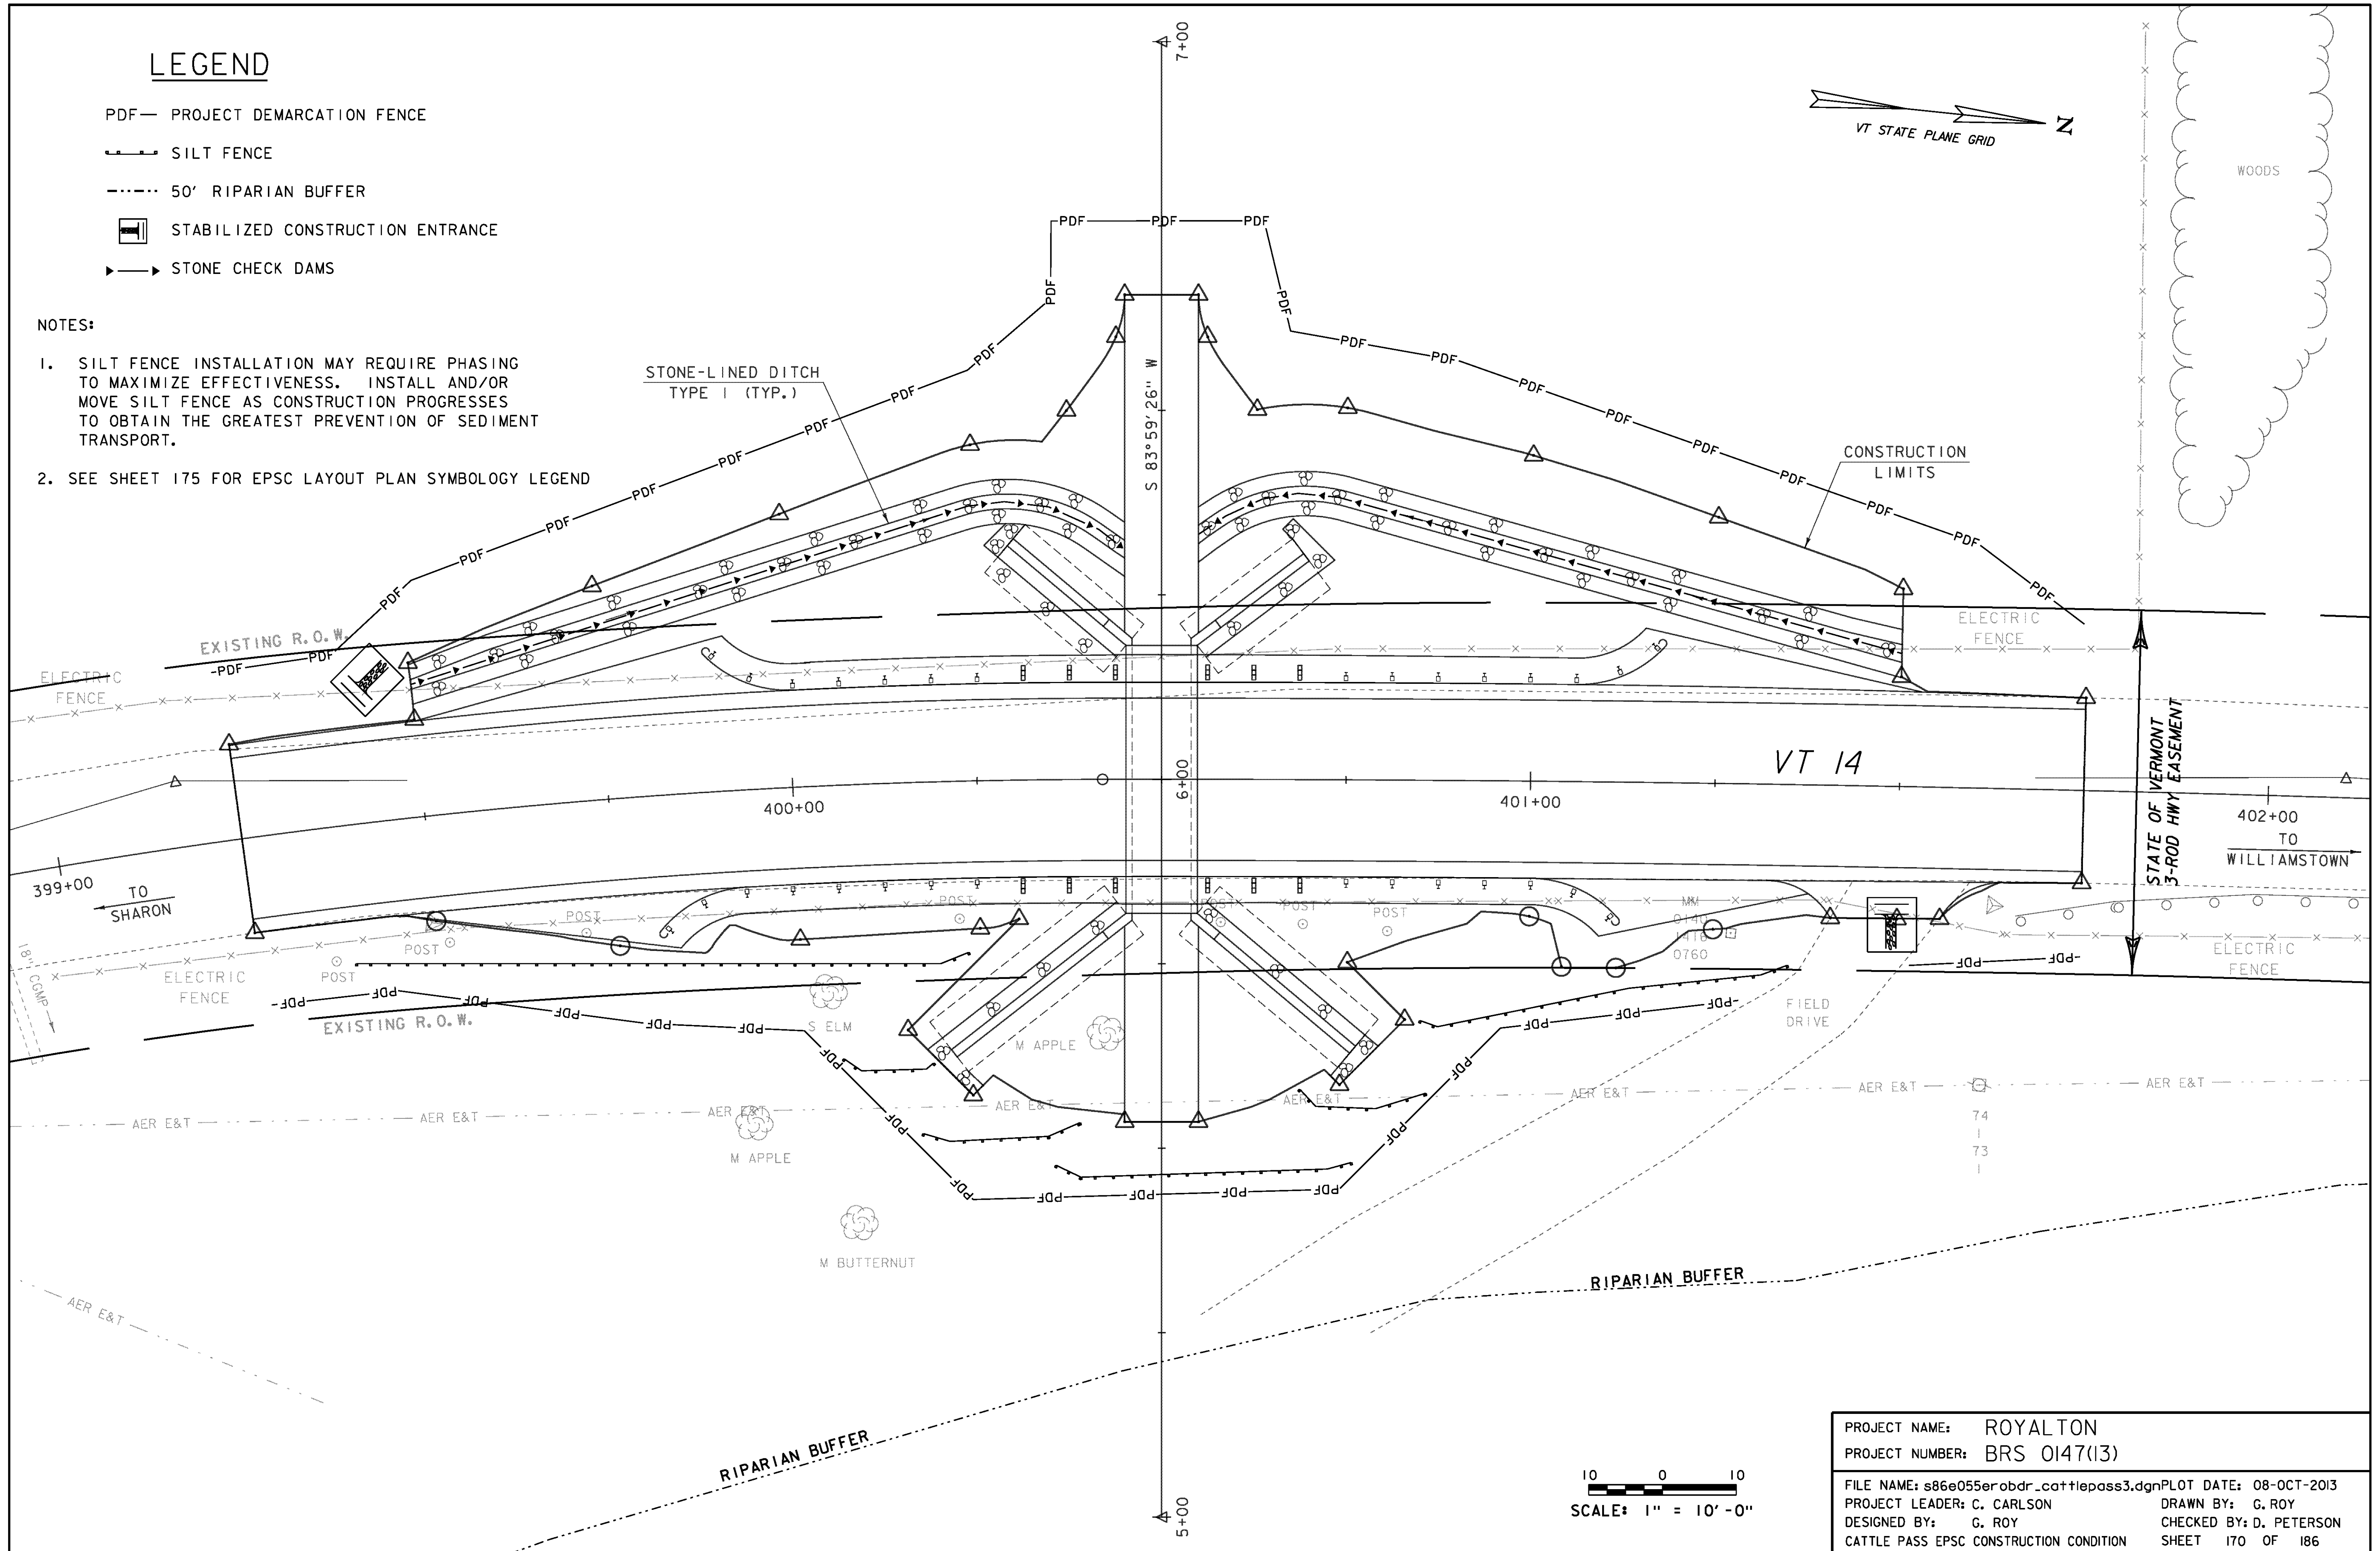


PROJECT NAME:	ROYALTON
PROJECT NUMBER:	BRS 0147(13)
FILE NAME:	s86e055erobdr_cattlepass3.dgn
PLOT DATE:	08-OCT-2013
PROJECT LEADER:	C. CARLSON
DRAWN BY:	G. ROY
DESIGNED BY:	G. ROY
CHECKED BY:	D. PETERSON
CATTLE PASS EPSC CONSTRUCTION CONDITION	SHEET 170 OF 186

# LEGEND

- 50' RIPARIAN BUFFER
- ⊗ STONE FILL, TYPE II
- ⊙ TEMPORARY ROLLED EROSION CONTROL PRODUCT
- ▨ AREAS TO BE SEEDED AND MULCHED

- NOTES:
1. SEE CROSS SECTIONS FOR FINAL GRADE INFORMATION.
  2. SEE SHEET 175 FOR EPSC LAYOUT PLAN SYMBOLOGY LEGEND

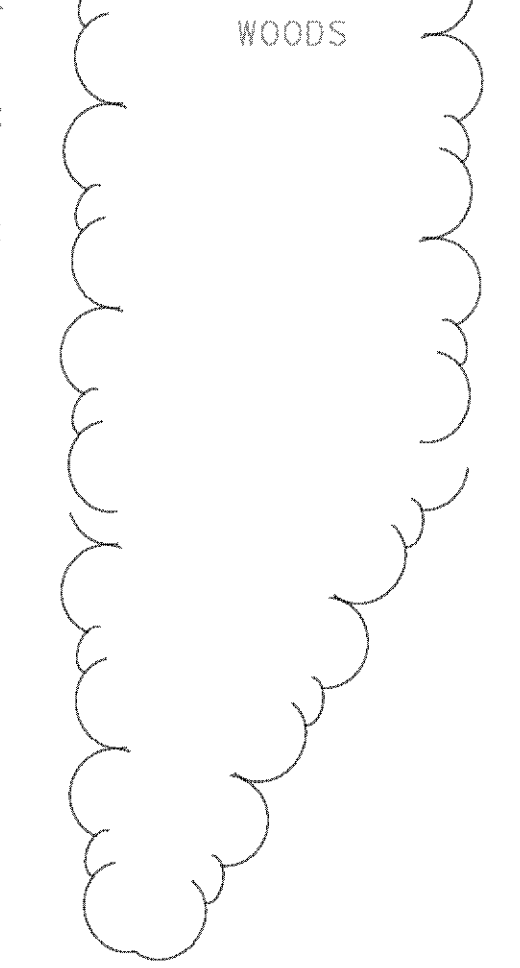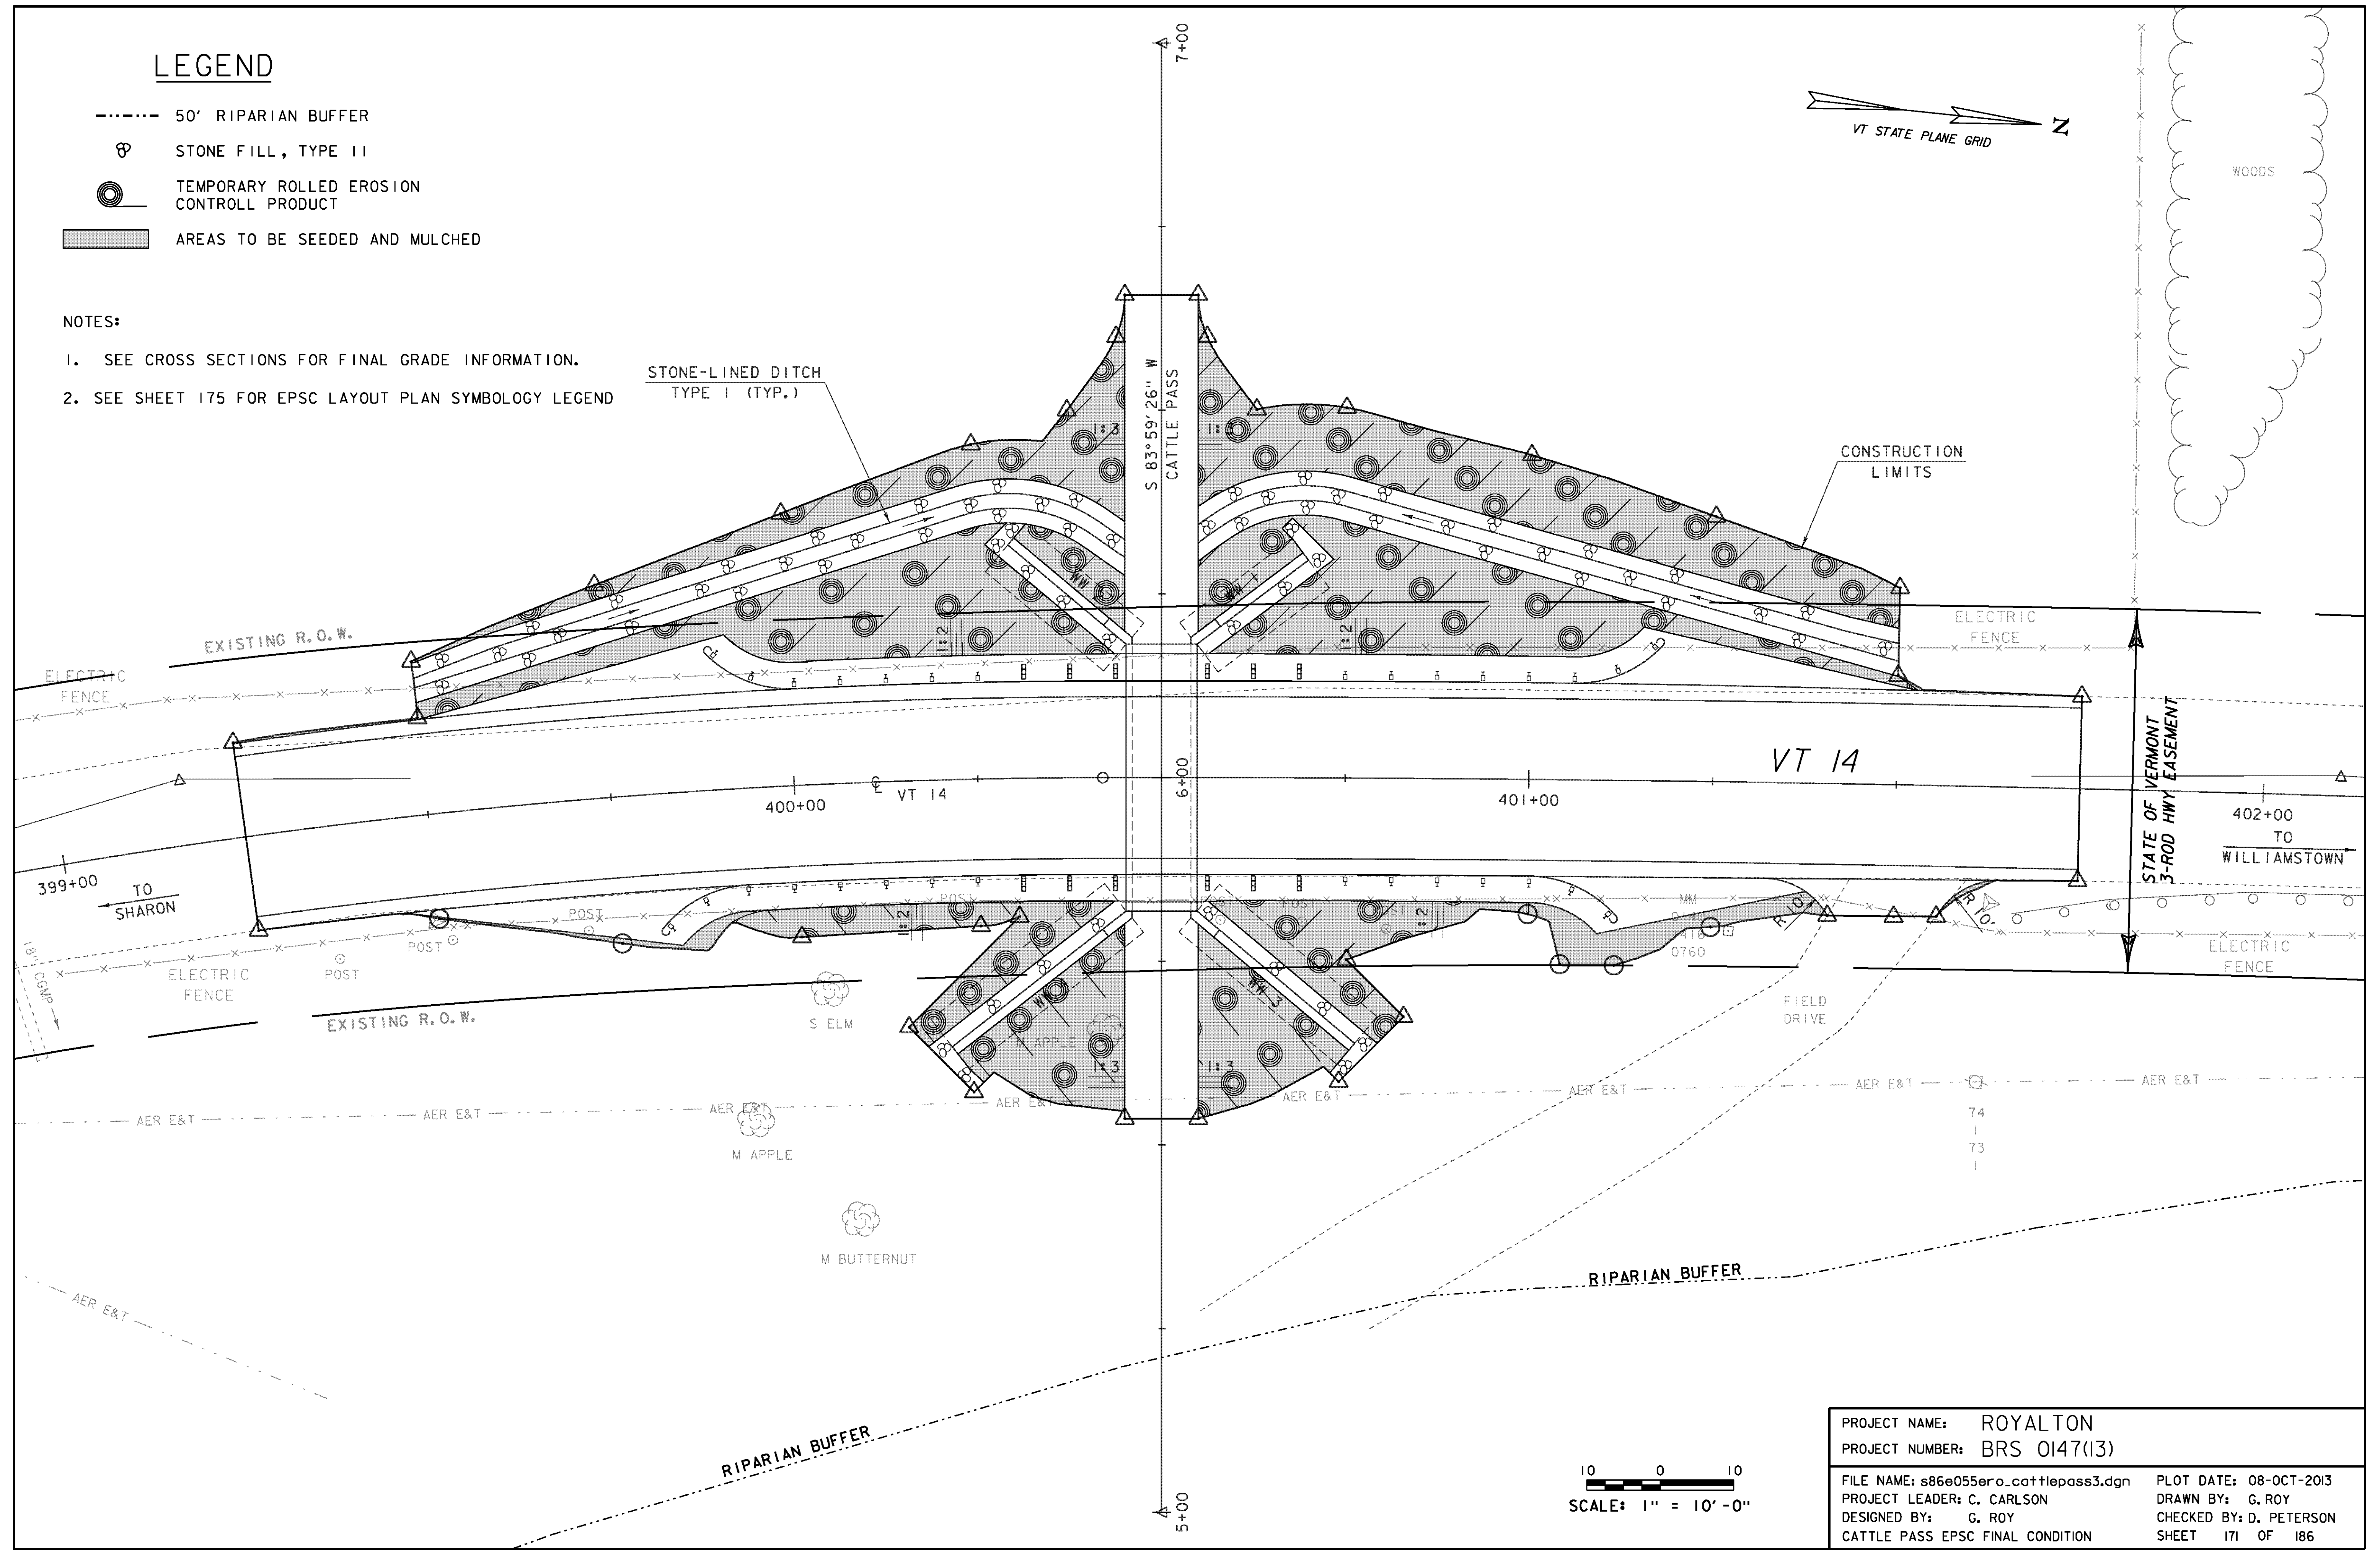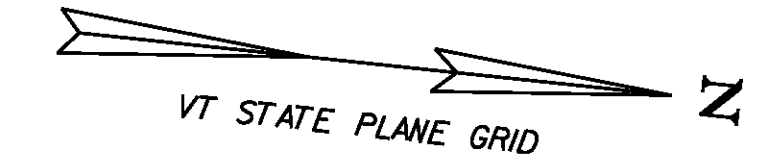


VT 14



STATE OF VERMONT  
3-ROD HWY EASEMENT

RIPARIAN BUFFER

RIPARIAN BUFFER

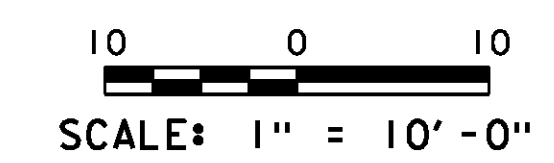


PROJECT NAME:	ROYALTON	FILE NAME:	s86e055ero_cattlepass3.dgn	PLOT DATE:	08-OCT-2013
PROJECT NUMBER:	BRS 0147(13)	PROJECT LEADER:	C. CARLSON	DRAWN BY:	G. ROY
		DESIGNED BY:	G. ROY	CHECKED BY:	D. PETERSON
		CATTLE PASS EPSC FINAL CONDITION		SHEET	171 OF 186

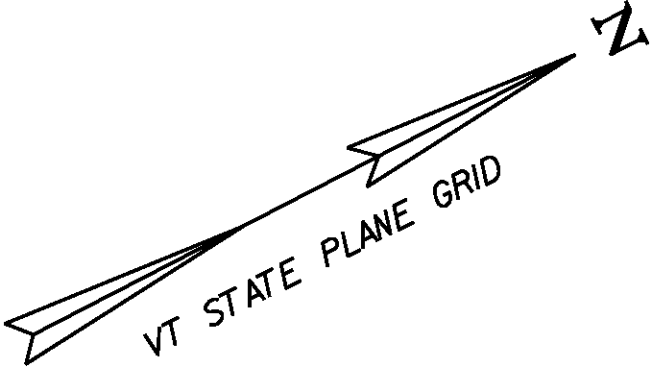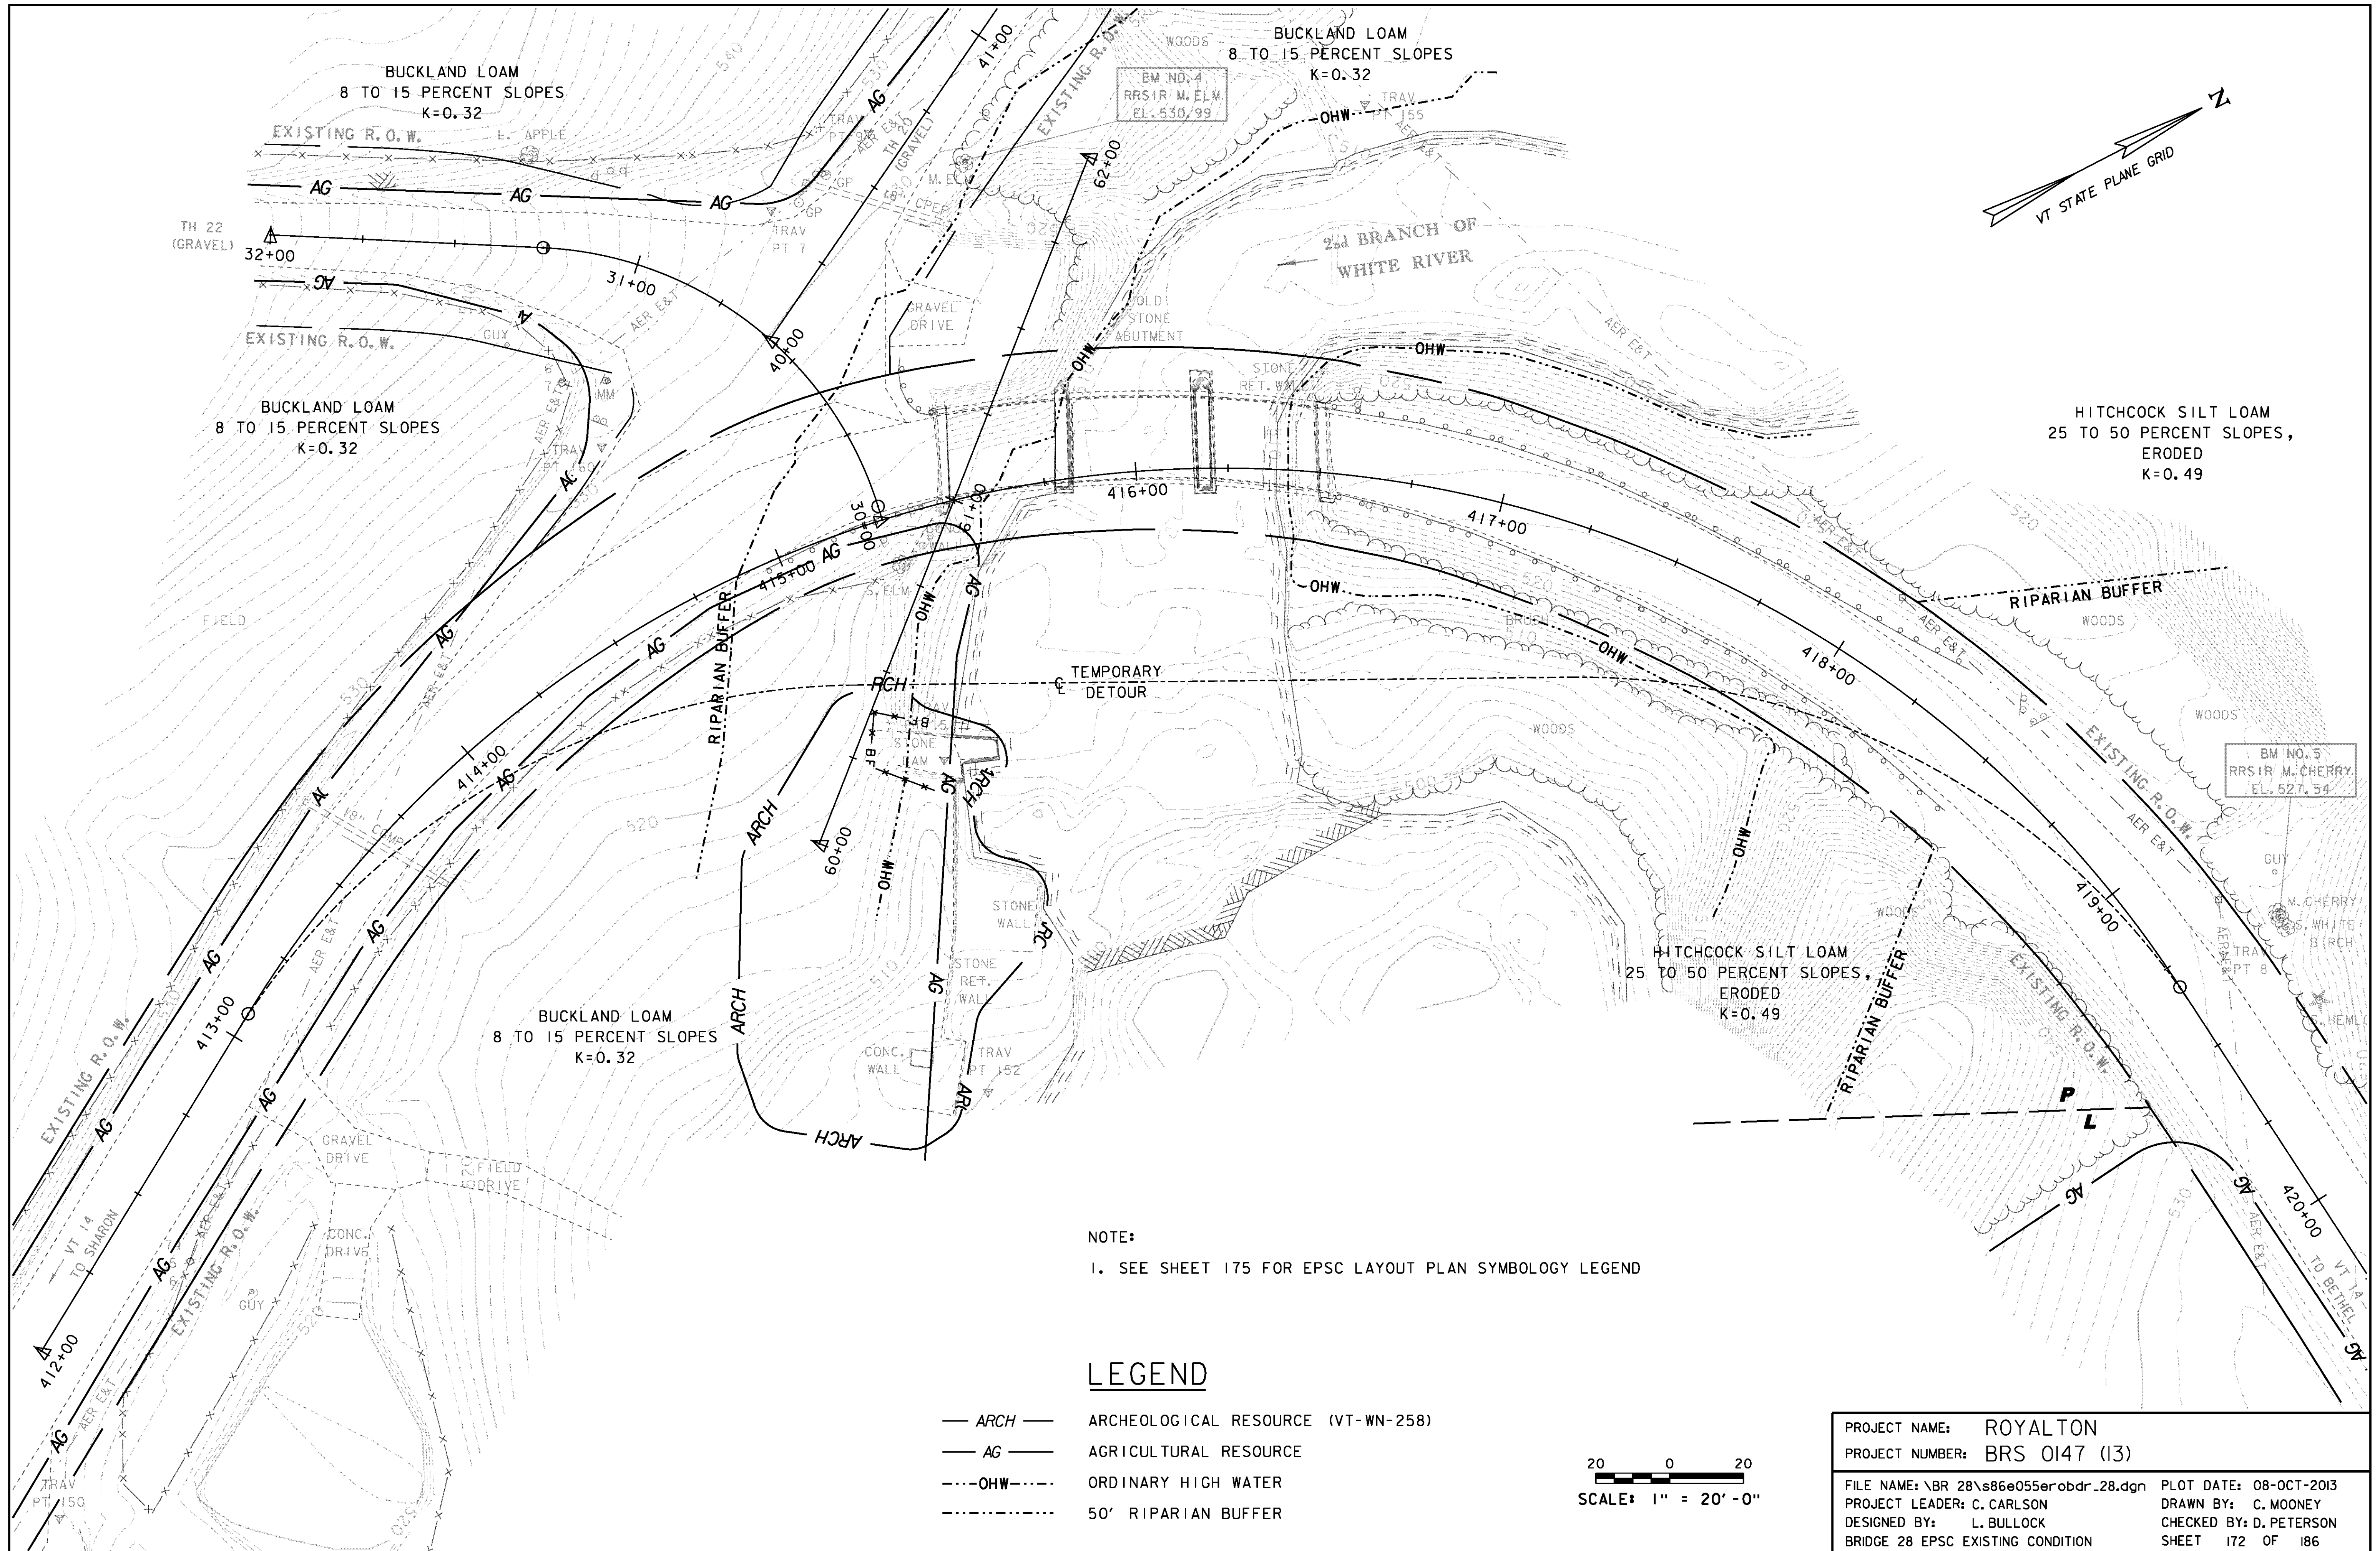


NOTE:  
 1. SEE SHEET 175 FOR EPSC LAYOUT PLAN SYMBOLGY LEGEND

**LEGEND**

- ARCH — ARCHEOLOGICAL RESOURCE (VT-WN-258)
- AG — AGRICULTURAL RESOURCE
- OHW--- ORDINARY HIGH WATER
- 50' RIPARIAN BUFFER

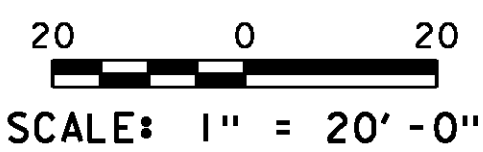


PROJECT NAME:	ROYALTON
PROJECT NUMBER:	BRS 0147 (13)
FILE NAME:	\BR 28\s86e055erobdr_28.dgn
PROJECT LEADER:	C. CARLSON
DESIGNED BY:	L. BULLOCK
BRIDGE 28 EPSC EXISTING CONDITION	
PLOT DATE:	08-OCT-2013
DRAWN BY:	C. MOONEY
CHECKED BY:	D. PETERSON
SHEET	172 OF 186

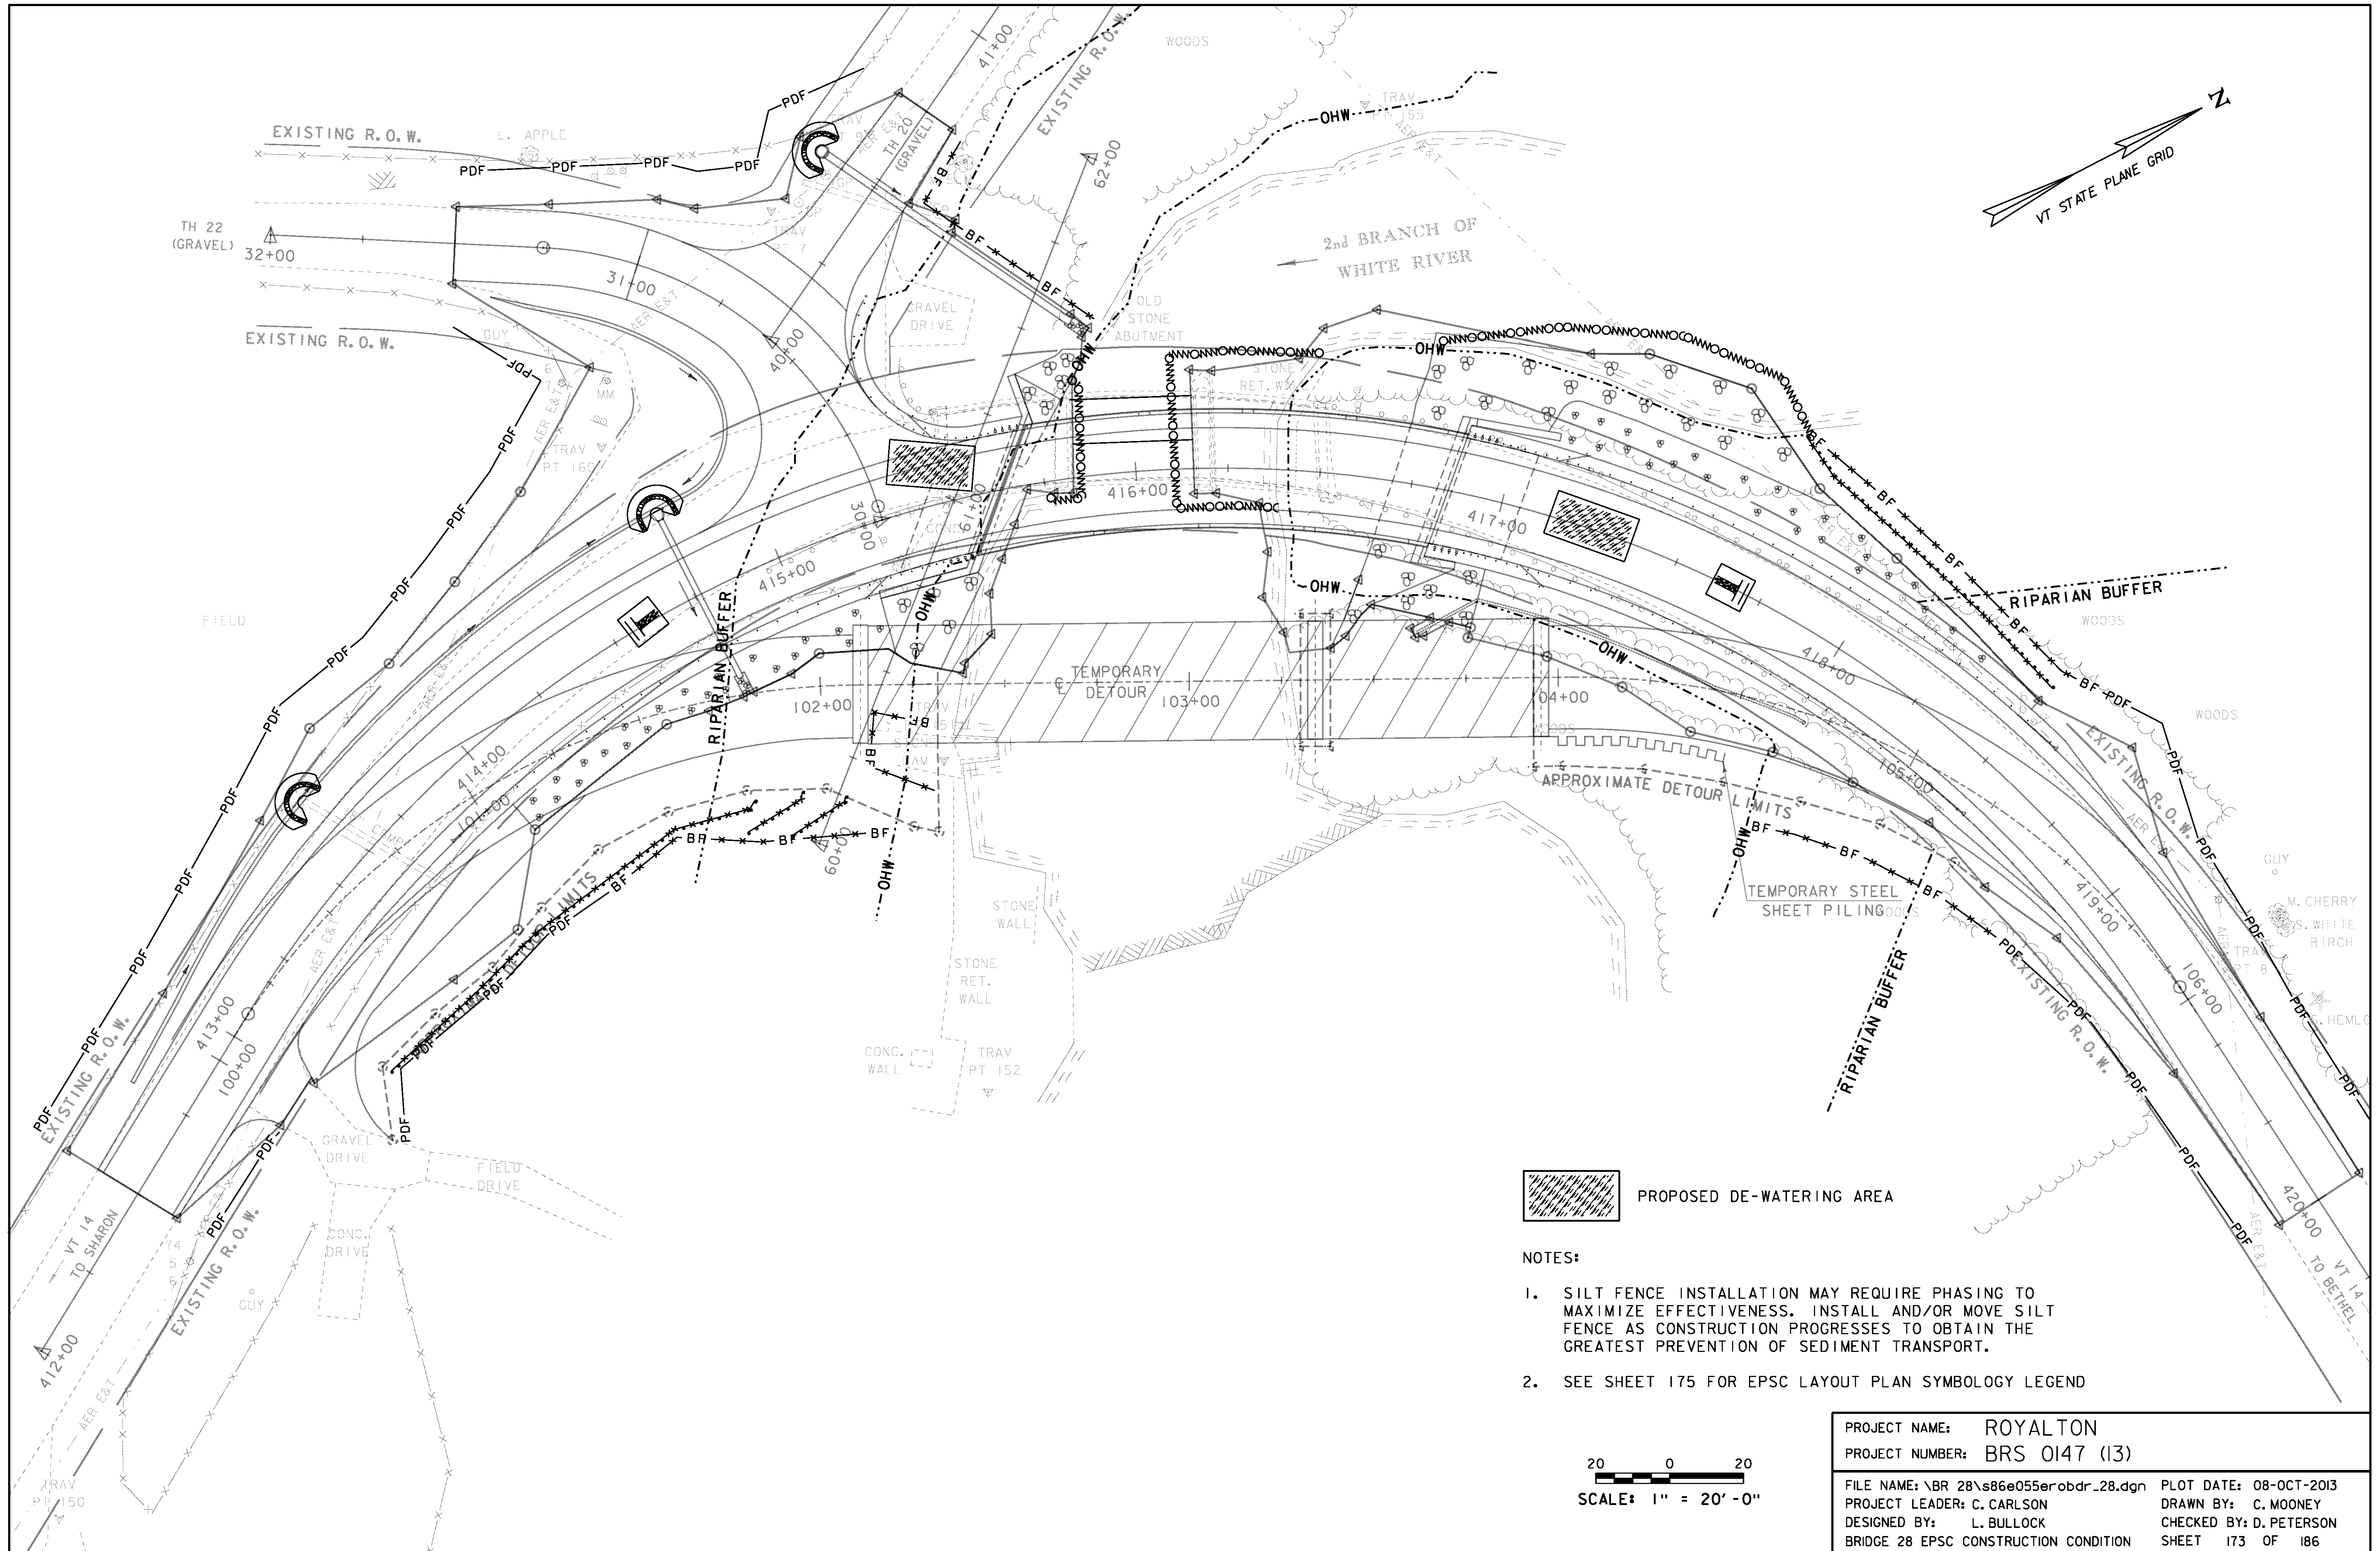


 PROPOSED DE-WATERING AREA

**NOTES:**

1. SILT FENCE INSTALLATION MAY REQUIRE PHASING TO MAXIMIZE EFFECTIVENESS. INSTALL AND/OR MOVE SILT FENCE AS CONSTRUCTION PROGRESSES TO OBTAIN THE GREATEST PREVENTION OF SEDIMENT TRANSPORT.
2. SEE SHEET 175 FOR EPSC LAYOUT PLAN SYMBOLOGY LEGEND

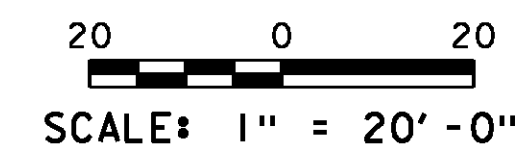


PROJECT NAME:	ROYALTON	PLOT DATE:	08-OCT-2013
PROJECT NUMBER:	BRS 0147 (I3)	DRAWN BY:	C. MOONEY
FILE NAME:	\BR 28\s86e055erobdr_28.dgn	CHECKED BY:	D. PETERSON
PROJECT LEADER:	C. CARLSON	BRIDGE 28 EPSC CONSTRUCTION CONDITION	SHEET 173 OF 186
DESIGNED BY:	L. BULLOCK		

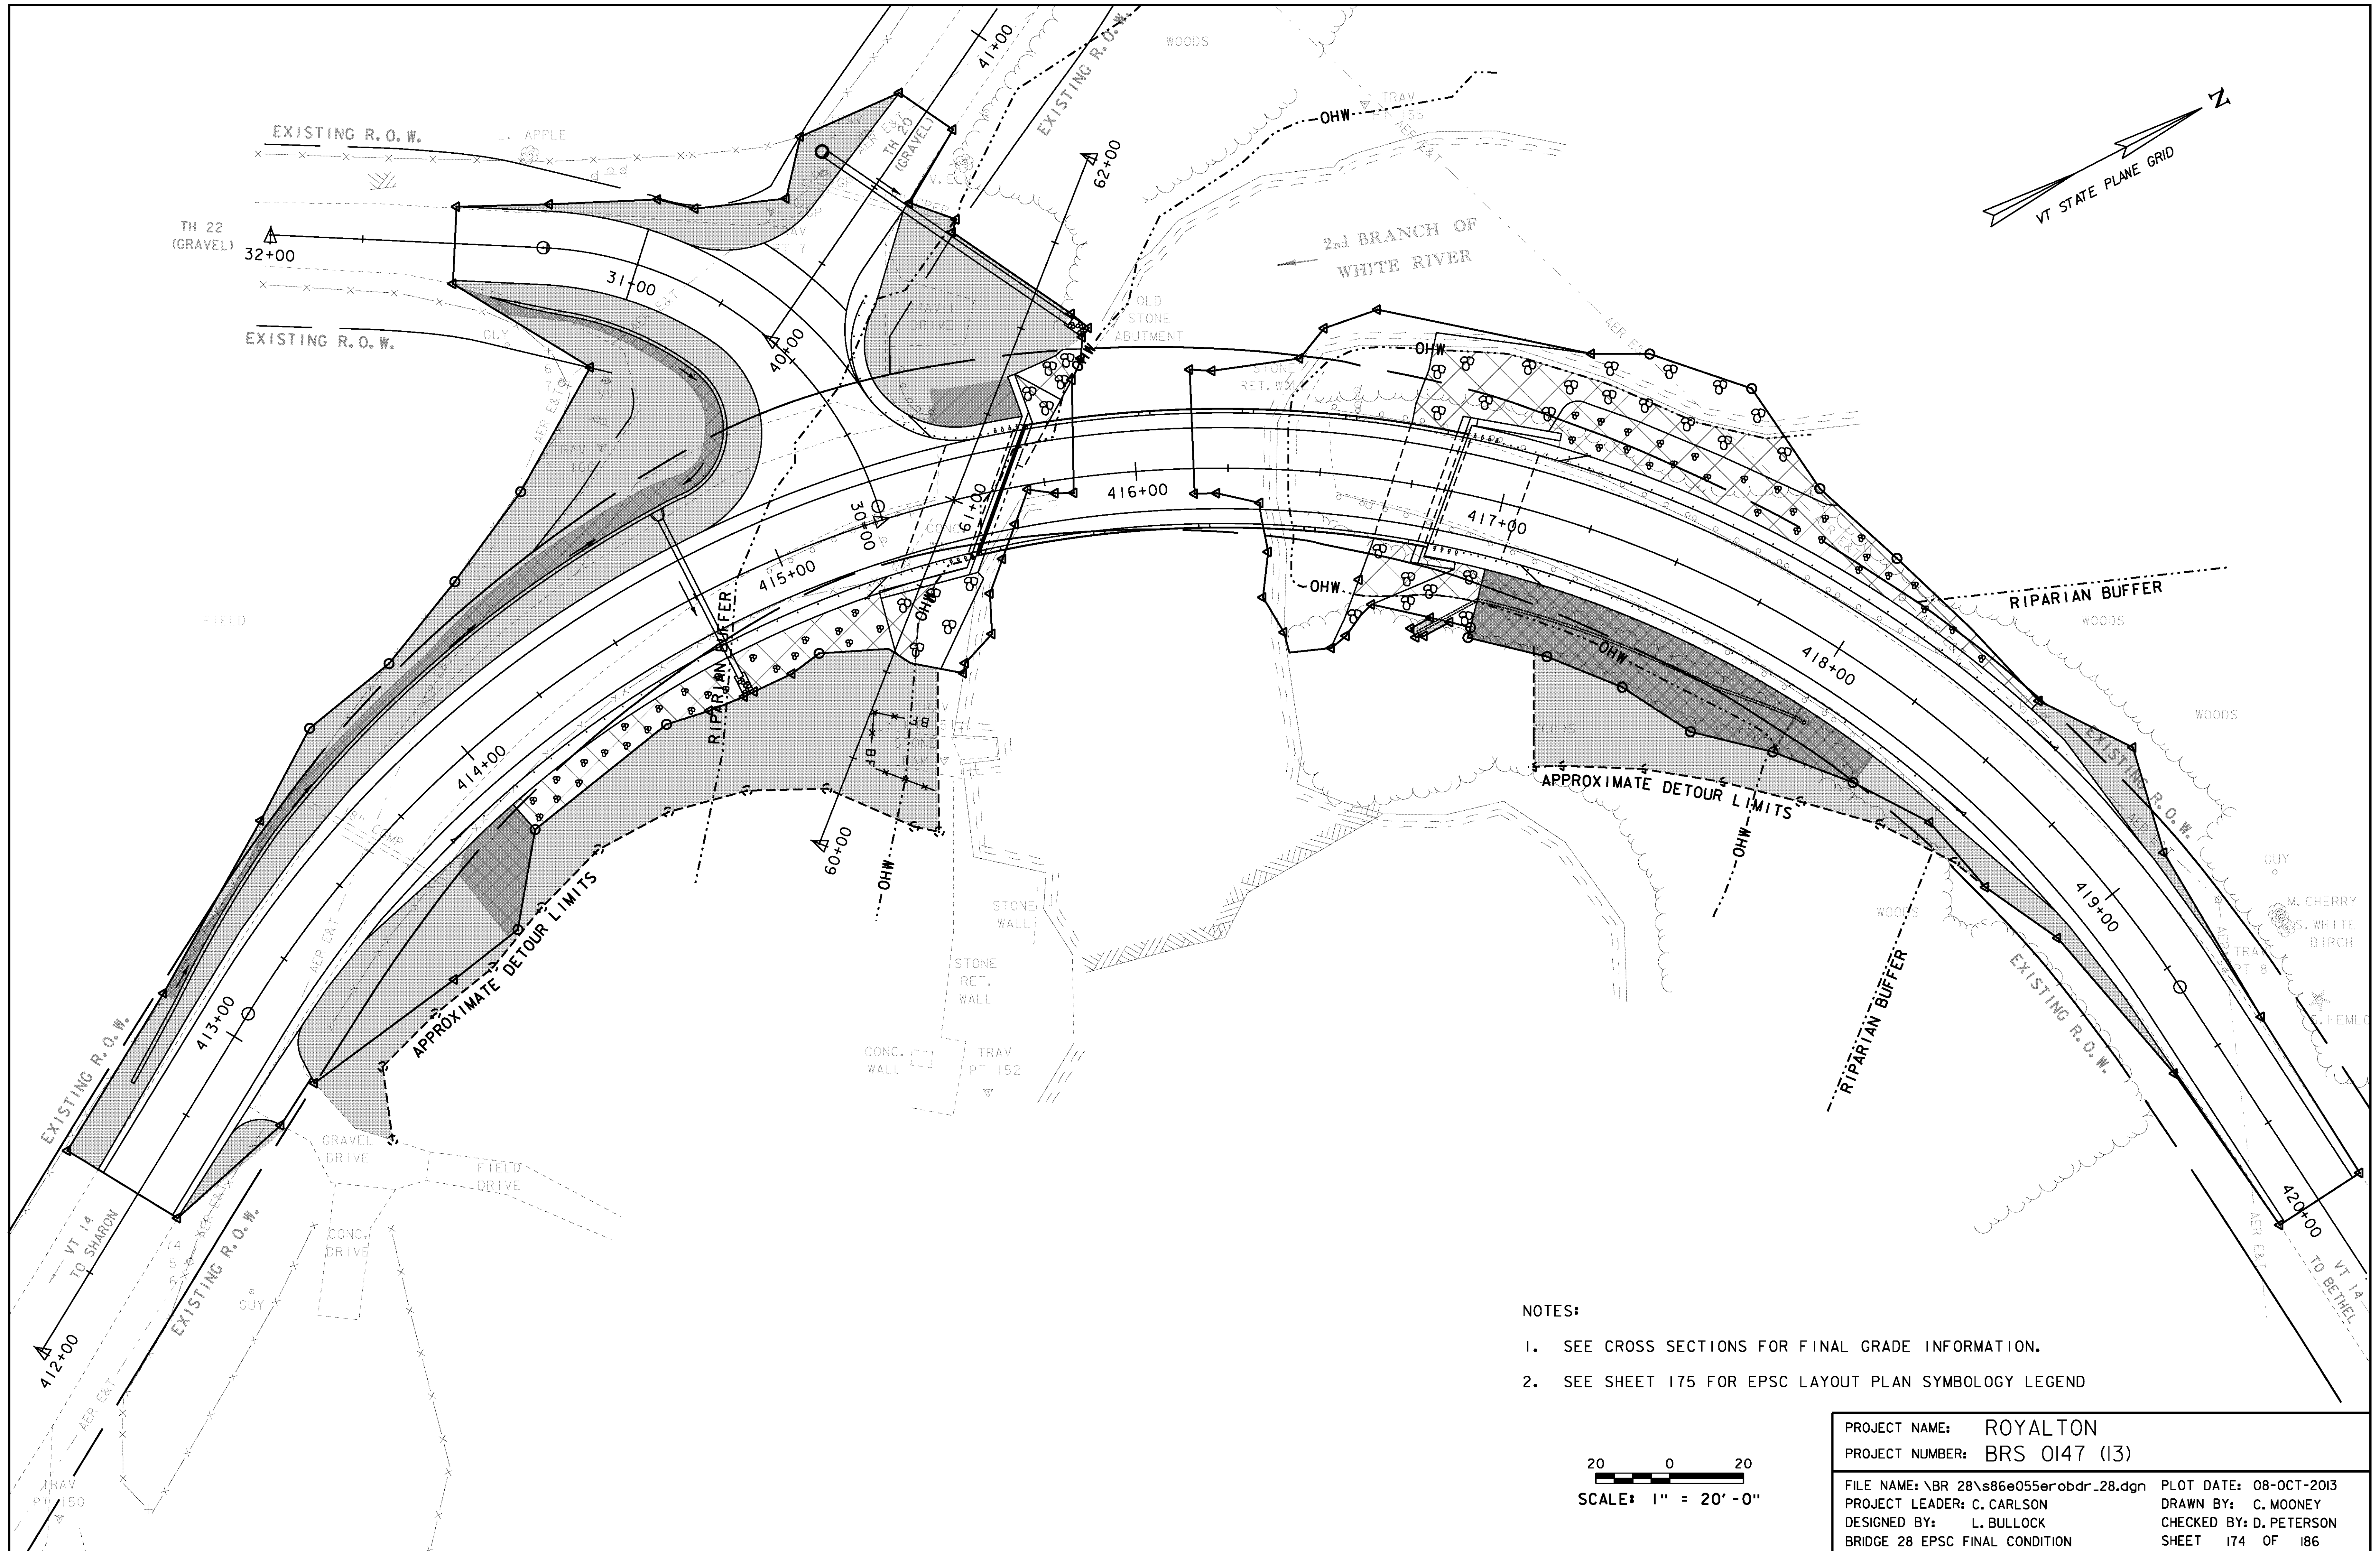


NOTES:


1. SEE CROSS SECTIONS FOR FINAL GRADE INFORMATION.
2. SEE SHEET 175 FOR EPSC LAYOUT PLAN SYMBOLOGY LEGEND

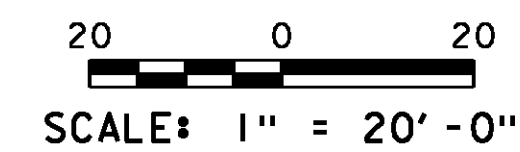

PROJECT NAME:	ROYALTON
PROJECT NUMBER:	BRS 0147 (I3)
FILE NAME:	\BR 28\s86e055erobdr_28.dgn
PROJECT LEADER:	C. CARLSON
DESIGNED BY:	L. BULLOCK
BRIDGE 28 EPSC FINAL CONDITION	
PLOT DATE:	08-OCT-2013
DRAWN BY:	C. MOONEY
CHECKED BY:	D. PETERSON
SHEET	174 OF 186

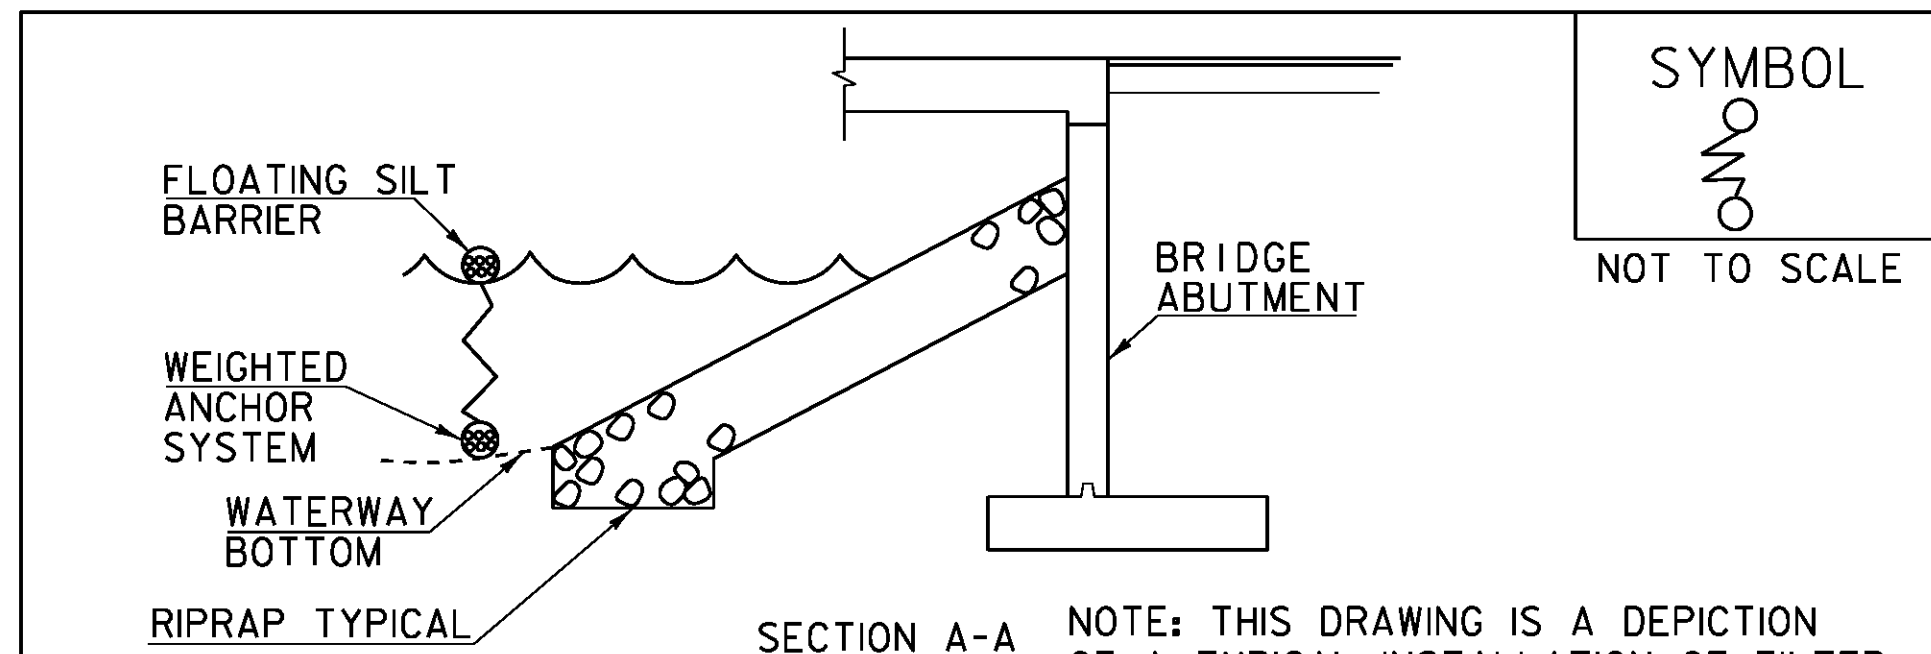

NOTE: THIS DRAWING IS A DEPICTION OF A TYPICAL INSTALLATION OF FILTER CURTAIN. IT IN NO WAY DEFINES THE TYPE OR USE OF COFFERDAM IF USED.

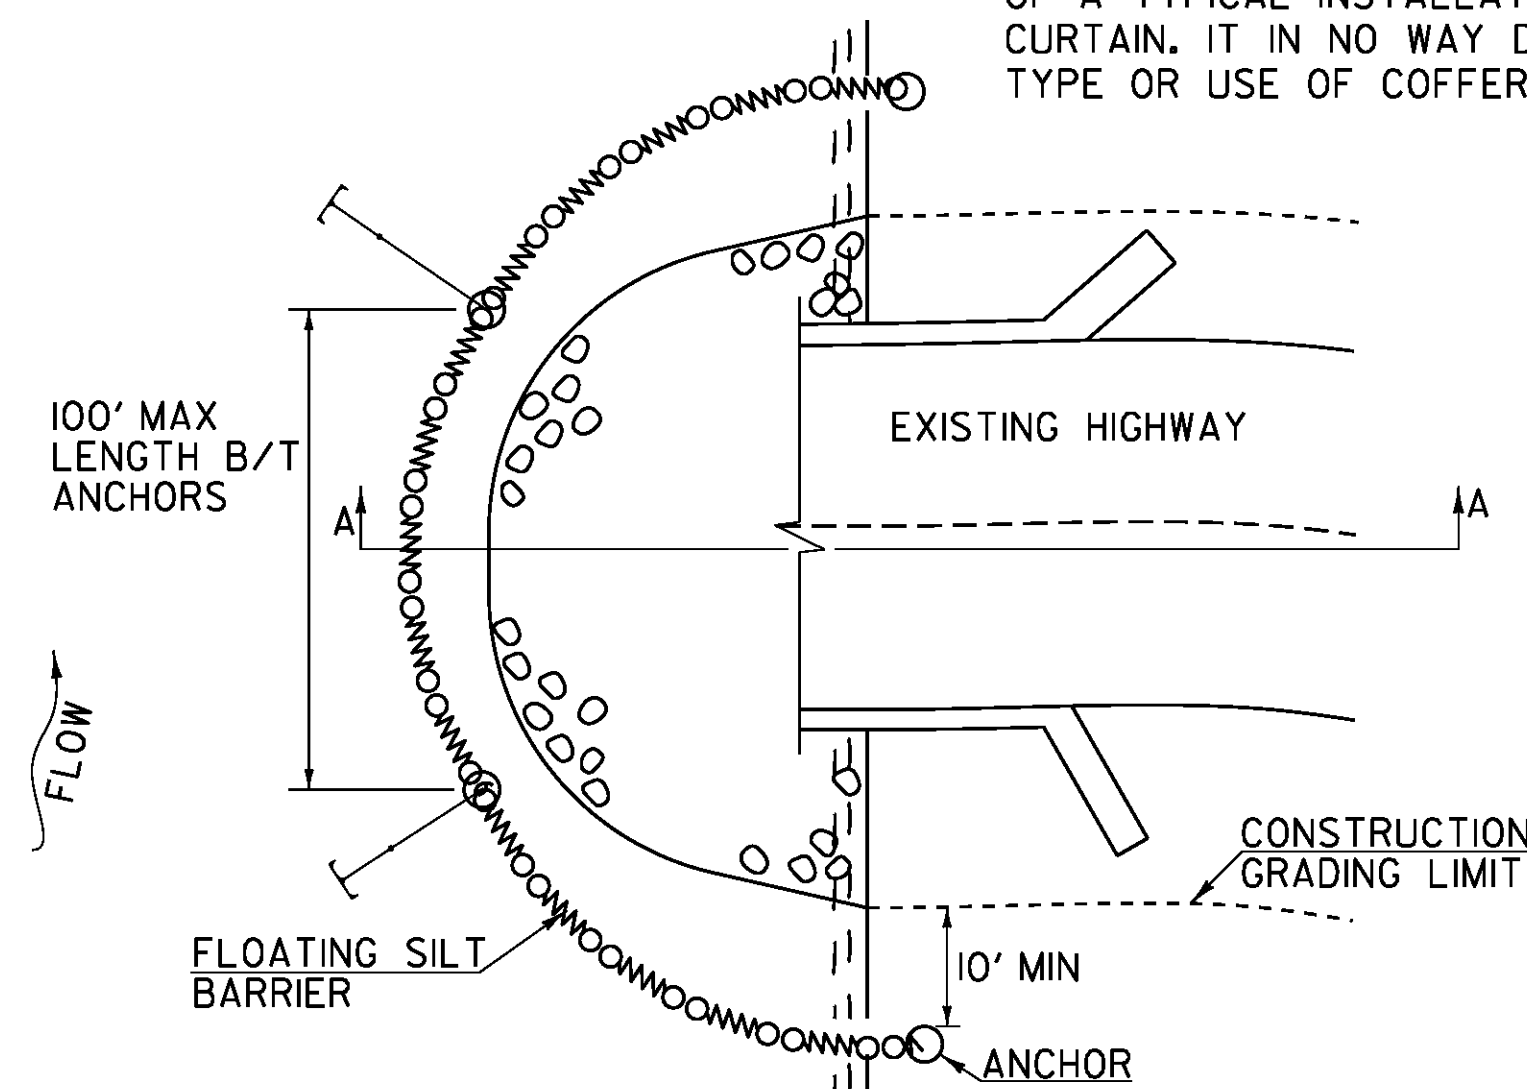



**CONSTRUCTION SPECIFICATIONS**

1. FILTER CURTAIN SHALL NOT BE PLACED ACROSS A FLOWING WATERWAY, OR IN A WATERWAY WITH STREAM VELOCITIES GREATER THAN 1.5 FEET/SECOND.
2. MAXIMUM 100' LENGTH BETWEEN ANCHORS.
3. LAST SECTION SHALL TERMINATE A MINIMUM OF 10' BEYOND LIMIT OF DISTURBANCE.
4. THE WEIGHTED ANCHOR SYSTEM SHALL BE A TYPE WHICH ALLOWS THE CURTAIN TO CONFORM TO THE BOTTOM OF THE WATERWAY.
5. THE CURTAIN SHALL BE REMOVED BY SLOWLY PULLING TOWARD THE SHORE MINIMIZING THE ESCAPE OF SEDIMENTS INTO WATERWAY.

**FILTER CURTAIN**

REVISIONS	
APRIL 1, 2008	WHF
JANUARY 13, 2009	WHF
SEPTEMBER 4, 2009	WHF

THIS WORK SHALL BE PERFORMED IN ACCORDANCE WITH SECTION 649 FOR GEOTEXTILE FOR FILTER CURTAIN (PAY ITEM 649.61).

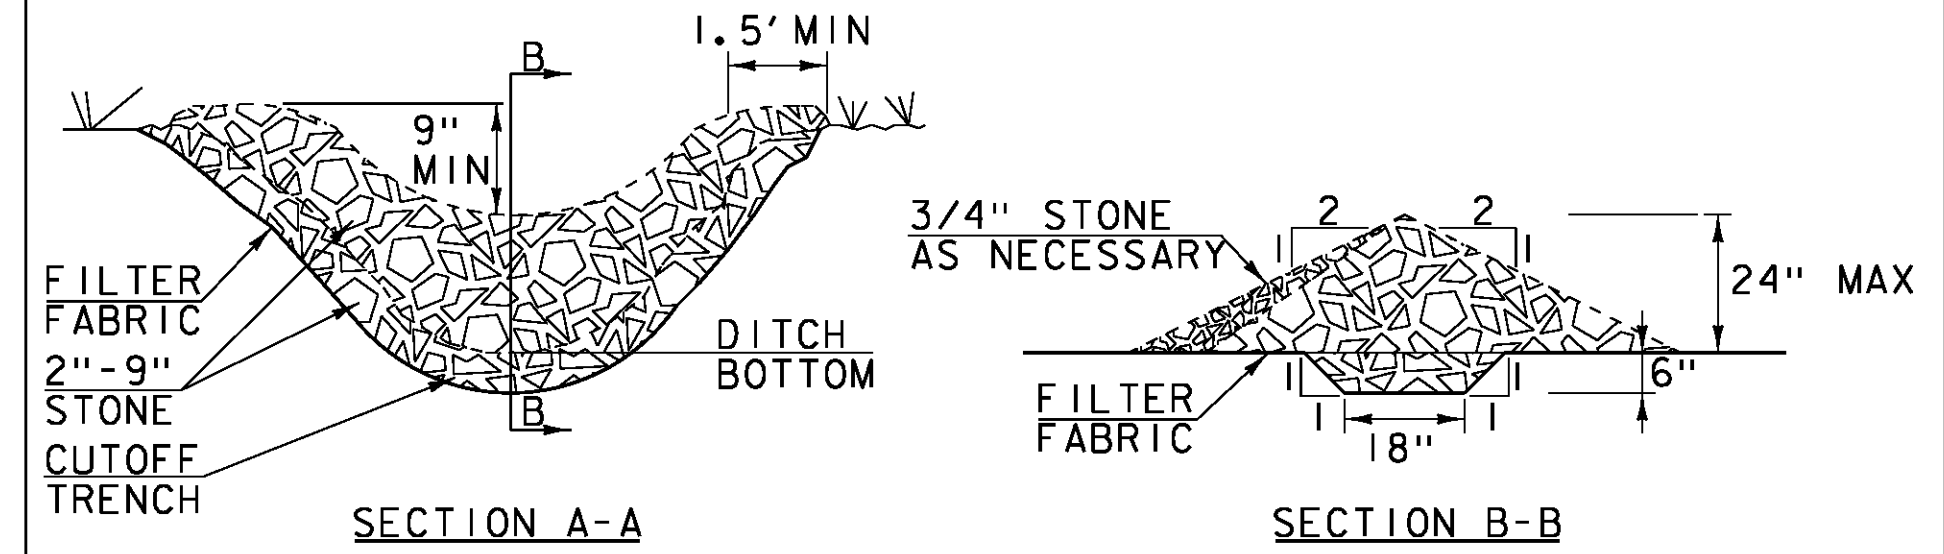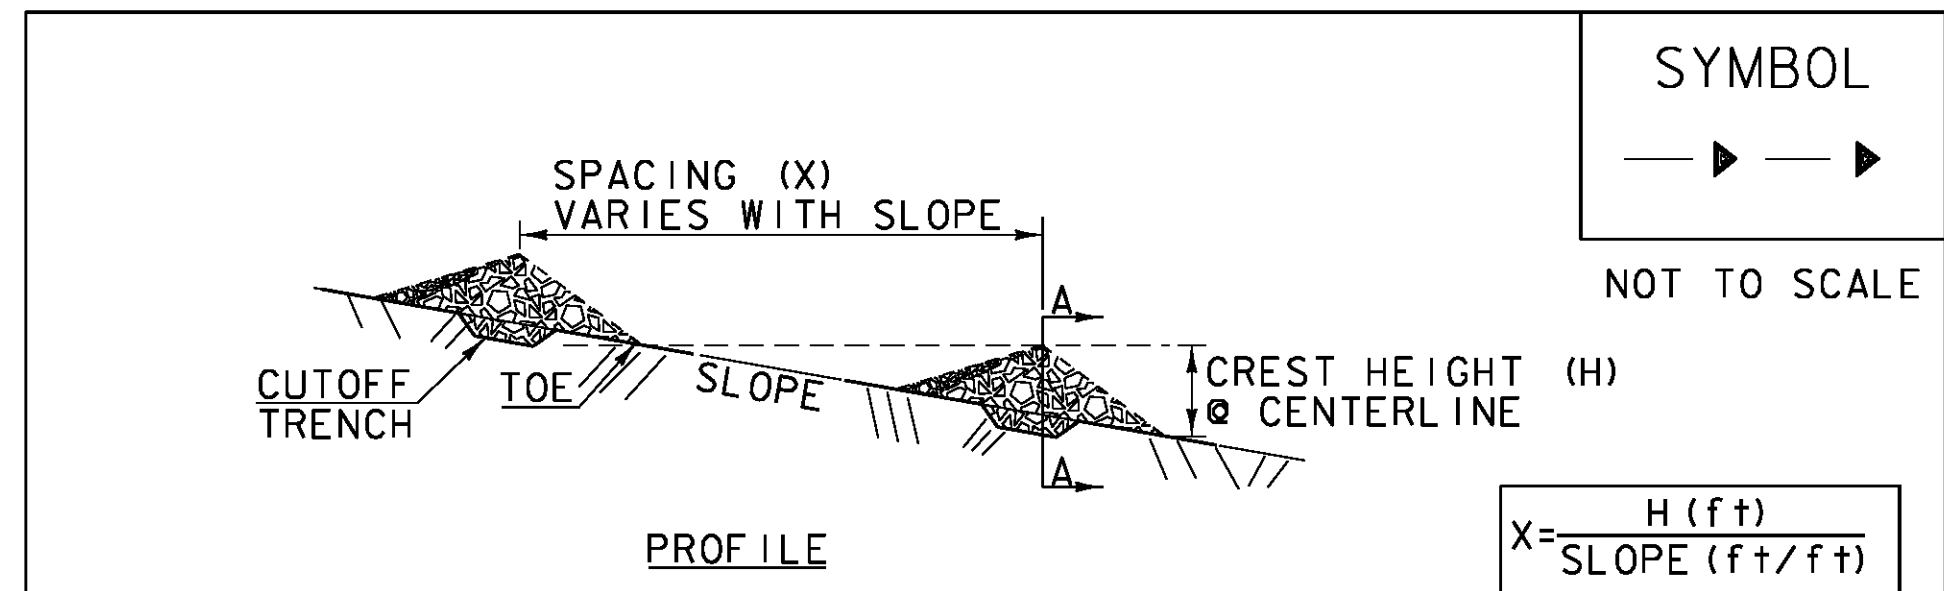

**CONSTRUCTION SPECIFICATIONS**

1. STONE WILL BE PLACED ON A FILTER FABRIC FOUNDATION.
2. CHECK DAMS SHALL BE SPACED SO THAT THE ELEVATION OF THE CREST OF THE DOWNSTREAM DAM IS AT THE SAME ELEVATION AS THE TOE OF THE UPSTREAM DAM.
3. 3/4" FILTERING STONE MAY BE ADDED TO THE FACE OF THE CHECK DAM AS NECESSARY.
4. EXTEND THE STONE A MINIMUM OF 1.5' BEYOND THE DITCH BANKS TO PREVENT CUTTING AROUND THE DAM.
5. PROTECT CHANNEL DOWNSTREAM OF THE LOWEST CHECK DAM FROM SCOUR AND EROSION WITH STONE OR LINER AS APPROPRIATE.
6. ENSURE THAT CHANNEL APPURTENANCES SUCH AS CULVERT ENTRANCES BELOW CHECK DAMS ARE NOT SUBJECT TO DAMAGE OR BLOCKAGE FROM DISPLACED STONE.
7. MAXIMUM DRAINAGE AREA 2 ACRES.

ADAPTED FROM DETAILS PROVIDED BY: NEW YORK STATE DEC  
ORIGINALLY DEVELOPED BY USDA-NRCS  
VERMONT DEPARTMENT OF ENVIRONMENTAL CONSERVATION

**CHECK DAM**

NOTES:  
REFER TO "THE VERMONT STANDARDS & SPECIFICATIONS FOR EROSION PREVENTION & SEDIMENT CONTROL -2006- " FROM THE VT AGENCY OF NATURAL RESOURCES FOR ADDITIONAL GUIDANCE.

THIS WORK SHALL BE PERFORMED IN ACCORDANCE WITH SECTION 653 FOR TEMPORARY STONE CHECK DAM, TYPE I (PAY ITEM 653.25)

REVISIONS	
MARCH 21, 2008	WHF
JANUARY 8, 2009	WHF

**EPSC LAYOUT PLAN SYMBOLOGY LEGEND**

**PROJECT BOUNDARY FENCE**

- PDF — PDF PROJECT DEMARCATION FENCE
- BF — BF BARRIER FENCE

**EPSC MEASURES**

- Filter Curtain
- Silt Fence
- Silt Fence Woven Wire
- Check Dam
- Disturbed Areas Requiring Re-vegetation
- Erosion Matting

**ENVIRONMENTAL RESOURCES**

- Wetland Boundary
- Riparian Buffer Zone
- Wetland Buffer Zone
- Soil Type Boundary
- Threatened & Endangered Species
- Hazardous Waste Area
- Agricultural Land
- Fish & Wildlife Habitat
- Flood Plain
- Ordinary High Water (OHW)
- Storm Water
- USDA Forest Service Lands
- Wildlife Habitat Suit/Conn

**ARCHEOLOGICAL & HISTORIC**

- Archaeological Boundary
- Historic District Boundary
- Historic Area
- Historic Structure

**UTILITY SYMBOLOGY**

- AER E&T — AREAL ELECTRIC & TELEPHONE
- E — AREAL ELECTRIC
- UE — UNDERGROUND ELECTRIC
- UT — UNDERGROUND TELEPHONE
- UC — UNDER GROUND TV
- G — GAS LINE
- W — WATER LINE


**CONSTRUCTION FEATURES**

- Toe of Slope Cut or Fill
- Stone Fill, Type III
- Stone Fill, Type II
- Stone Fill, Type I

PROJECT NAME: ROYALTON  
PROJECT NUMBER: BRS 0147 (13)

FILE NAME: s86e055ero_det.dgn  
PROJECT LEADER: C. CARLSON  
DESIGNED BY: D. PETERSON  
EPSC DETAILS (1)

PLOT DATE: 08-OCT-2013  
DRAWN BY: D. PETERSON  
CHECKED BY: C. CARLSON  
SHEET 175 OF 186

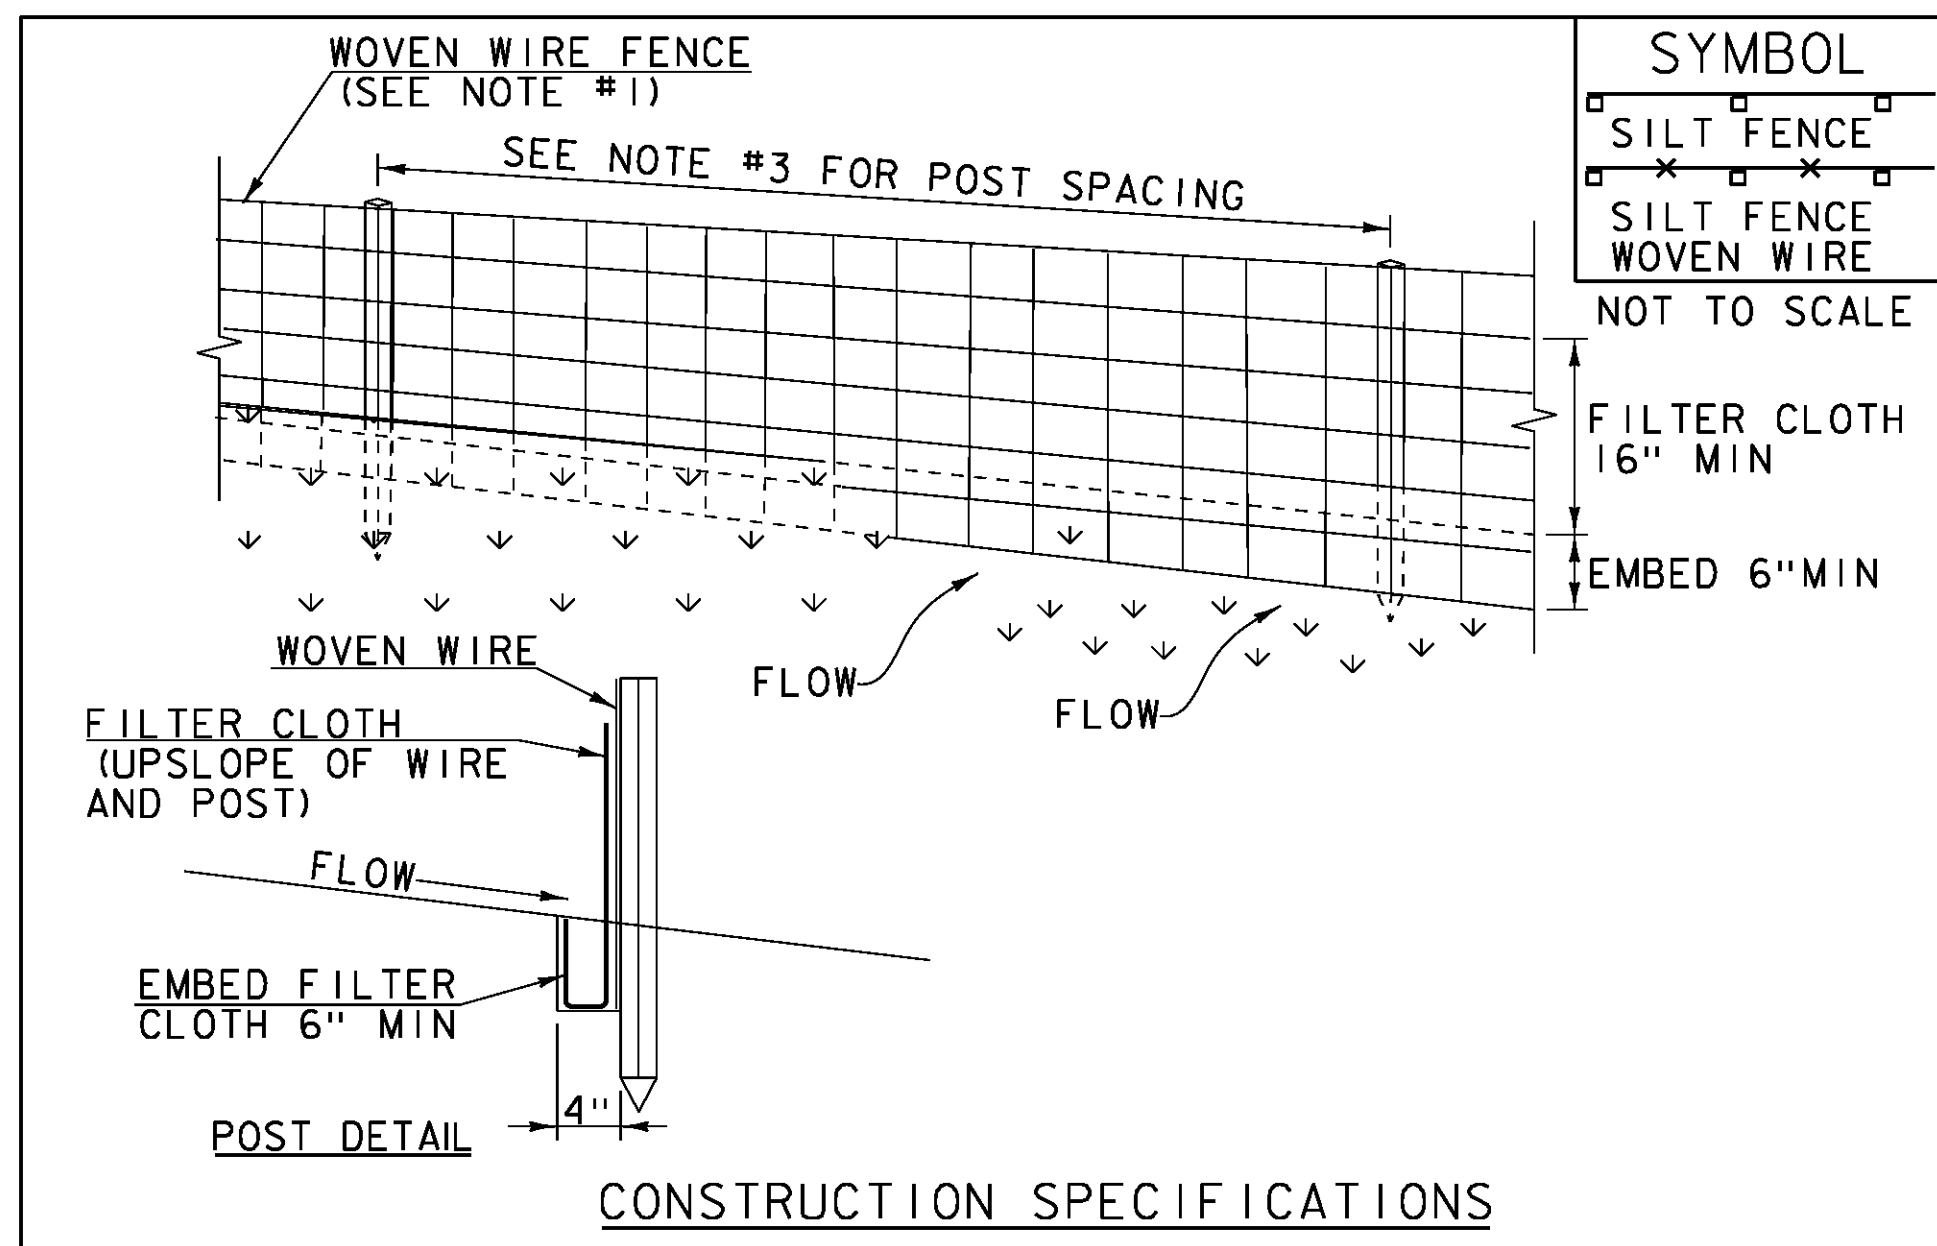

- CONSTRUCTION SPECIFICATIONS**
- WOVEN WIRE REINFORCED FENCE IS REQUIRED WITHIN 100' UPSLOPE OF RECEIVING WATERS WHEN THE PROJECT FALLS UNDER A CONSTRUCTION STORMWATER PERMIT. WOVEN WIRE SHALL BE A MIN. 14 GAUGE WITH A 6" MAX. MESH OPENING.
  - FILTER CLOTH SHALL BE EITHER FILTER X, MIRAF1100X, STABILINKA T140N OR APPROVED EQUIVALENT.
  - POST SPACING FOR WIRE-BACKED FENCE SHALL BE 10' MAXIMUM. FOR FILTER-CLOTH FENCE, WHEN ELONGATION IS >50%, POST SPACING SHALL NOT EXCEED 4' AND WHEN ELONGATION IS <50%, POST SPACING SHALL NOT EXCEED 6'.
  - WOVEN WIRE FENCE IS TO BE FASTENED SECURELY TO FENCE POSTS WITH WIRE TIES. FILTER CLOTH IS TO BE FASTENED SECURELY TO WOVEN WIRE FENCE WITH TIES SPACED EVERY 24" AT TOP AND MID SECTION.
  - WHEN TWO SECTIONS OF FILTER CLOTH ADJOIN EACH OTHER THEY SHALL BE OVER-LAPPED BY 6" AND FOLDED.
  - MAINTENANCE SHALL BE PERFORMED AS NEEDED AND MATERIAL REMOVED WHEN SEDIMENT REACHES HALF OF FABRIC HEIGHT.


ADAPTED FROM DETAILS PROVIDED BY: NEW YORK STATE DEC  
ORIGINALLY DEVELOPED BY USDA-NRCS  
VERMONT DEPARTMENT OF ENVIRONMENTAL CONSERVATION

**SILT FENCE**

NOTES:  
REFER TO "THE VERMONT STANDARDS & SPECIFICATIONS FOR EROSION PREVENTION & SEDIMENT CONTROL -2006- "FROM THE VT AGENCY OF NATURAL RESOURCES FOR ADDITIONAL GUIDANCE.

THIS WORK SHALL BE PERFORMED IN ACCORDANCE WITH SECTION 649 AND AS SHOWN IN THE PLANS FOR GEOTEXTILE FOR SILT FENCE (PAY ITEM 649.51) OR GEOTEXTILE FOR SILT FENCE, WOVEN WIRE REINFORCED (PAY ITEM 649.515).

REVISIONS		
MARCH 21, 2008	WHF	
DECEMBER 11, 2008	WHF	
JANUARY 13, 2009	WHF	

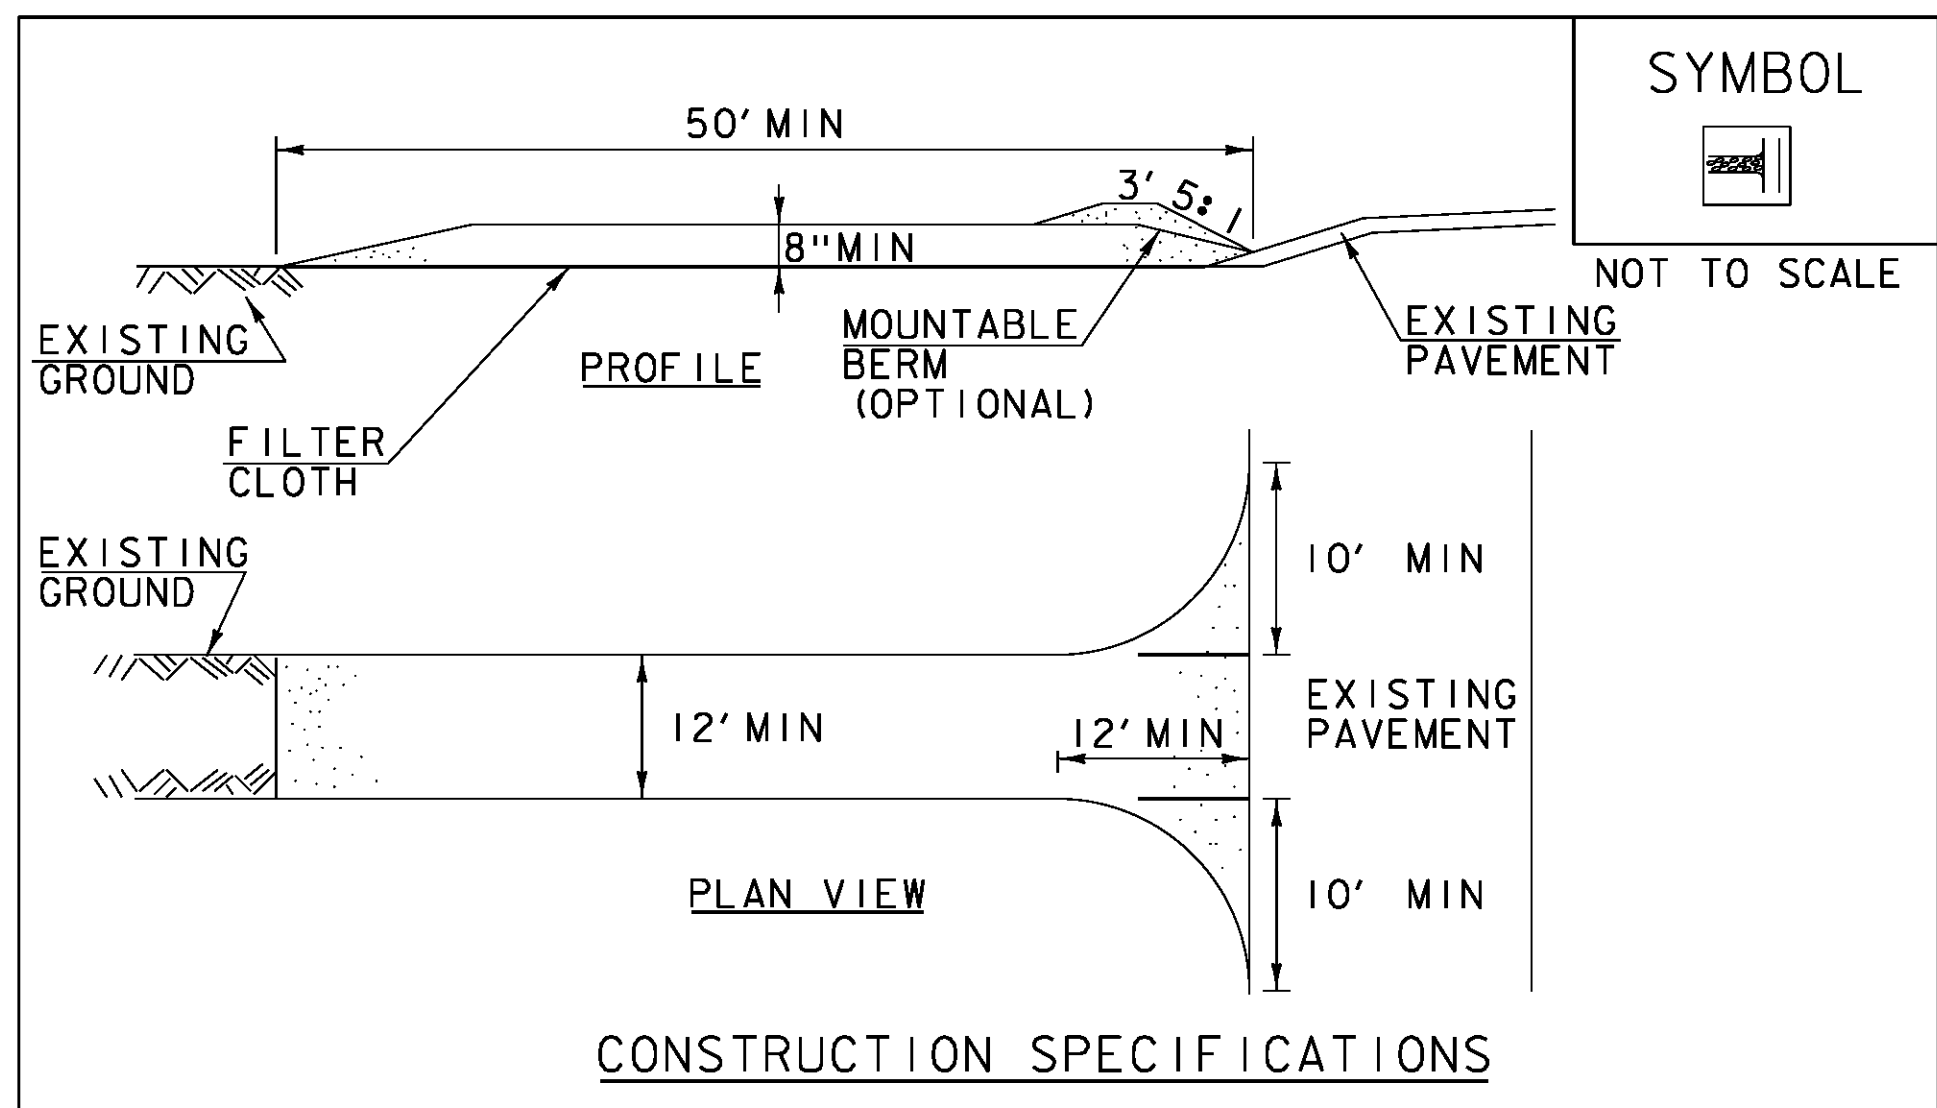

- CONSTRUCTION SPECIFICATIONS**
- STONE SIZE- USE 1-4" STONE, RECLAIMED OR RECYCLED CONCRETE EQUIVALENT.
  - LENGTH- NOT LESS THAN 50' (EXCEPT ON A SINGLE RESIDENCE LOT WHERE A 30' MINIMUM LENGTH APPLIES).
  - THICKNESS- NOT LESS THAN 8".
  - WIDTH- 12' MINIMUM, BUT NOT LESS THAN THE FULL WIDTH AT POINTS WHERE INGRESS OR EGRESS OCCURS. 24" IF SINGLE ENTRANCE TO SITE.
  - GEOTEXTILE MUST BE PLACED OVER THE ENTIRE AREA PRIOR TO PLACING STONE.
  - SURFACE WATER- ALL SURFACE WATER FLOWING OR DIVERTED TOWARD CONSTRUCTION ENTRANCES SHALL BE PIPED BENEATH THE ENTRANCE. IF PIPING IS IMPRACTICAL, A MOUNTABLE BERM WITH 5:1 SLOPES WILL BE PERMITTED.
  - MAINTENANCE- THE ENTRANCE SHALL BE MAINTAINED IN A CONDITION WHICH WILL PREVENT TRACKING OR FLOWING OF SEDIMENT ONTO PUBLIC RIGHTS-OF-WAY, ALL SEDIMENT SPILLED, DROPPED, WASHED OR TRACKED ONTO PUBLIC RIGHTS-OF-WAY MUST BE REMOVED IMMEDIATELY.
  - WHEN WASHING IS REQUIRED, IT SHALL BE DONE ON AN AREA STABILIZED WITH STONE AND WHICH DRAINS INTO AN APPROVED SEDIMENT TRAPPING DEVICE.
  - PERIODIC INSPECTION AND NEEDED MAINTENANCE SHALL BE PROVIDED ACCORDING TO PERMIT REQUIREMENTS.


ADAPTED FROM DETAILS PROVIDED BY: NEW YORK STATE DEC  
ORIGINALLY DEVELOPED BY USDA-NRCS  
VERMONT DEPARTMENT OF ENVIRONMENTAL CONSERVATION

**STABILIZED CONSTRUCTION ENTRANCE**

NOTES:  
REFER TO "THE VERMONT STANDARDS & SPECIFICATIONS FOR EROSION PREVENTION & SEDIMENT CONTROL -2006- "FROM THE VT AGENCY OF NATURAL RESOURCES FOR ADDITIONAL GUIDANCE.

THIS WORK SHALL BE PERFORMED IN ACCORDANCE WITH SECTION 653 FOR VEHICLE TRACKING PAD (PAY ITEM 653.35) OR AS SPECIFIED IN THE CONTRACT.

REVISIONS		
MARCH 24, 2008	WHF	
JANUARY 13, 2009	WHF	

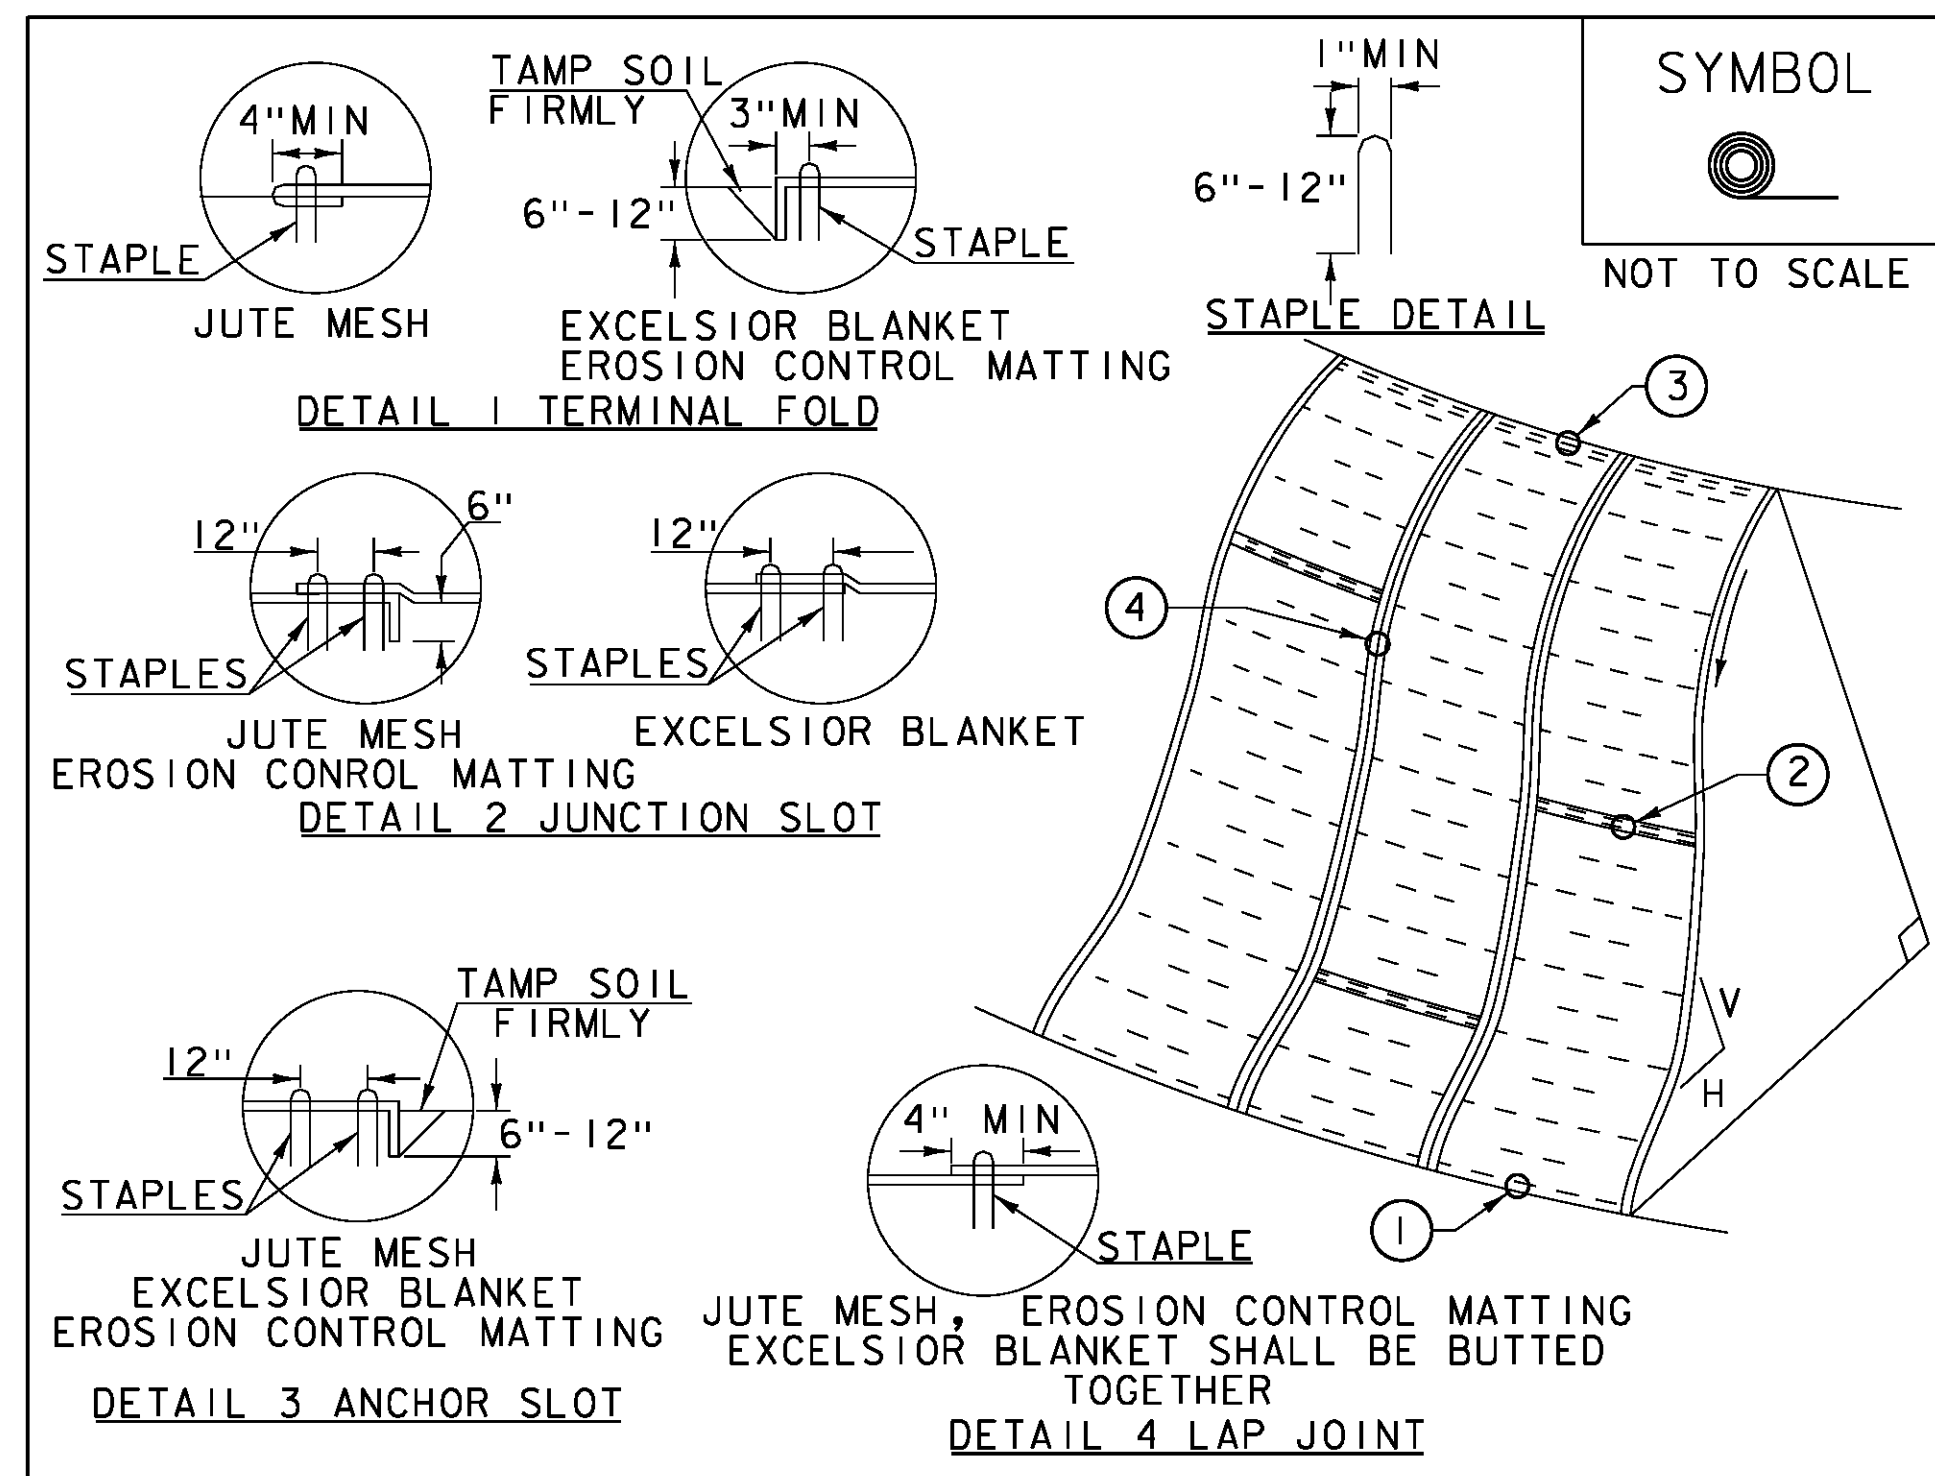

- CONSTRUCTION SPECIFICATIONS**
- APPLY TO SLOPES GREATER THAN 3H:1V OR WHERE NECESSARY TO AID IN ESTABLISHING VEGETATION.
  - APPLY FERTILIZER, LIME SEED PRIOR TO PLACING MATTING.
  - STAPLES ARE TO BE PLACED ALTERNATELY, IN COLUMNS APPROXIMATELY 2' APART AND IN ROWS APPROXIMATELY 3' APART. APPROXIMATELY 175 STAPLES ARE REQUIRED PER 4' X 225' ROLL OF MATERIAL AND 125 STAPLES ARE REQUIRED PER 4' X 150' ROLL OF MATERIAL.
  - DISTURBED AREAS SHALL BE SMOOTHLY GRADED. EROSION CONTROL MATERIAL SHALL BE PLACED LOOSELY OVER GROUND SURFACE. DO NOT STRETCH.
  - ALL TERMINAL ENDS AND TRANSVERSE LAPS SHALL BE STAPLED AT APPROXIMATELY 12" INTERVALS.

ADAPTED FROM DETAILS PROVIDED BY: NEW YORK STATE DEC  
ORIGINALLY DEVELOPED BY USDA-NRCS  
VERMONT DEPARTMENT OF ENVIRONMENTAL CONSERVATION

**ROLLED EROSION CONTROL PRODUCT (RECP) SIDE SLOPE**

NOTES:  
REFER TO "THE VERMONT STANDARDS & SPECIFICATIONS FOR EROSION PREVENTION & SEDIMENT CONTROL -2006- "FROM THE VT AGENCY OF NATURAL RESOURCES FOR ADDITIONAL GUIDANCE.

THIS WORK SHALL BE PERFORMED IN ACCORDANCE WITH SECTION 653 AND AS SHOWN IN THE PLANS FOR TEMPORARY EROSION MATTING (PAY ITEM 653.20) OR PERMANENT EROSION MATTING (PAY ITEM 653.21).

REVISIONS		
APRIL 16, 2007	JMF	
JANUARY 13, 2009	WHF	

PROJECT NAME: ROYALTON  
PROJECT NUMBER: BRS 0147 (13)

FILE NAME: s86e055ero_det.dgn  
PROJECT LEADER: C. CARLSON  
DESIGNED BY: D. PETERSON  
EPSC DETAILS (2)

PLOT DATE: 08-OCT-2013  
DRAWN BY: D. PETERSON  
CHECKED BY: C. CARLSON  
SHEET 176 OF 186



VAOT RURAL AREA MIX					
% WEIGHT	LBS/AC		NAME	GERM %	PURITY %
	BROADCAST	HYDROSEED			
37.5%	22.5	45	CREEPING RED FESCUE	85%	98%
37.5%	22.5	45	TALL FESCUE	90%	95%
5.0%	3	6	RED TOP	90%	95%
15.0%	9	18	BIRDSFOOT TREFOIL	85%	98%
5.0%	3	6	ANNUAL RYE GRASS	85%	95%
100%	60	120			

VAOT URBAN AREA MIX					
% WEIGHT	LBS/AC		NAME	GERM %	PURITY %
	BROADCAST	HYDROSEED			
42.5%	34	68	CREEPING RED FESCUE	85%	98%
10.0%	8	16	PERENNIAL RYE GRASS	90%	95%
42.5%	34	68	KENTUCKY BLUE GRASS	85%	85%
5.0%	4	8	ANNUAL RYE GRASS	85%	95%
100%	80	160			

SOIL AMENDMENT GUIDANCE			
FERTILIZER		LIME	
BROADCAST	HYDROSEED	BROADCAST	HYDROSEED
10-20-10	FOLLOW	PELLETIZED	FOLLOW
500 LBS/AC	MANUFACTURER	2 TONS/AC	MANUFACTURER


**CONSTRUCTION GUIDANCE**

1. RURAL SEED MIX: USE AS INDICATED IN THE PLANS AND/OR FOR ALL ESTABLISHED UPLAND (NON WETLAND) AREAS DISTURBED BY THE CONTRACTOR.
2. URBAN SEED MIX: USE AS INDICATED IN THE PLANS AND/OR FOR ALL ESTABLISHED LAWN AREAS DISTURBED BY THE CONTRACTOR.
3. ALL SEED MIXTURES: SHALL NOT HAVE A WEED CONTENT EXCEEDING 0.40% BY WEIGHT AND SHALL BE FREE OF ALL NOXIOUS SEED.
4. FERTILIZER AND LIMESTONE: SHALL FOLLOW RATES SHOWN ON PLAN OR AS DIRECTED BY THE ENGINEER
5. HAY MULCH: TO BE PLACED ON EARTH SLOPES AT THE RATE OF 2 TONS/ACRE, ACHIEVE 90% GROUND COVER OR AS DIRECTED BY THE ENGINEER.
6. TOPSOIL: TO BE USED WITH SEED AS INDICATED ON THE PLANS, OR AS DIRECTED BY THE ENGINEER.
7. HYDROSEEDING: ALTHOUGH GUIDANCE IS GIVEN ABOVE THE SITE CONDITIONS AND THE TYPE OF HYDROSEED WILL ULTIMATELY DICTATE THE AMOUNTS AND TYPES OF SOIL AMENDMENTS TO BE APPLIED
8. TURF ESTABLISHMENT: PLACING SEED, FERTILIZER, LIME AND MULCH PRIOR TO SEPTEMBER 15 AND AFTER APRIL 15 CAN BETTER ENSURE A VIGOROUS GROWTH OF GRASS.

ADAPTED FROM VTRANS TECHNICAL LANDSCAPE MANUAL FOR ROADWAYS AND TRANSPORTATION FACILITIES

**TURF ESTABLISHMENT**

REVISIONS		
JUNE 23, 2009	WHF	
JANUARY 15, 2010	WHF	
FEBRUARY 16, 2011	WHF	

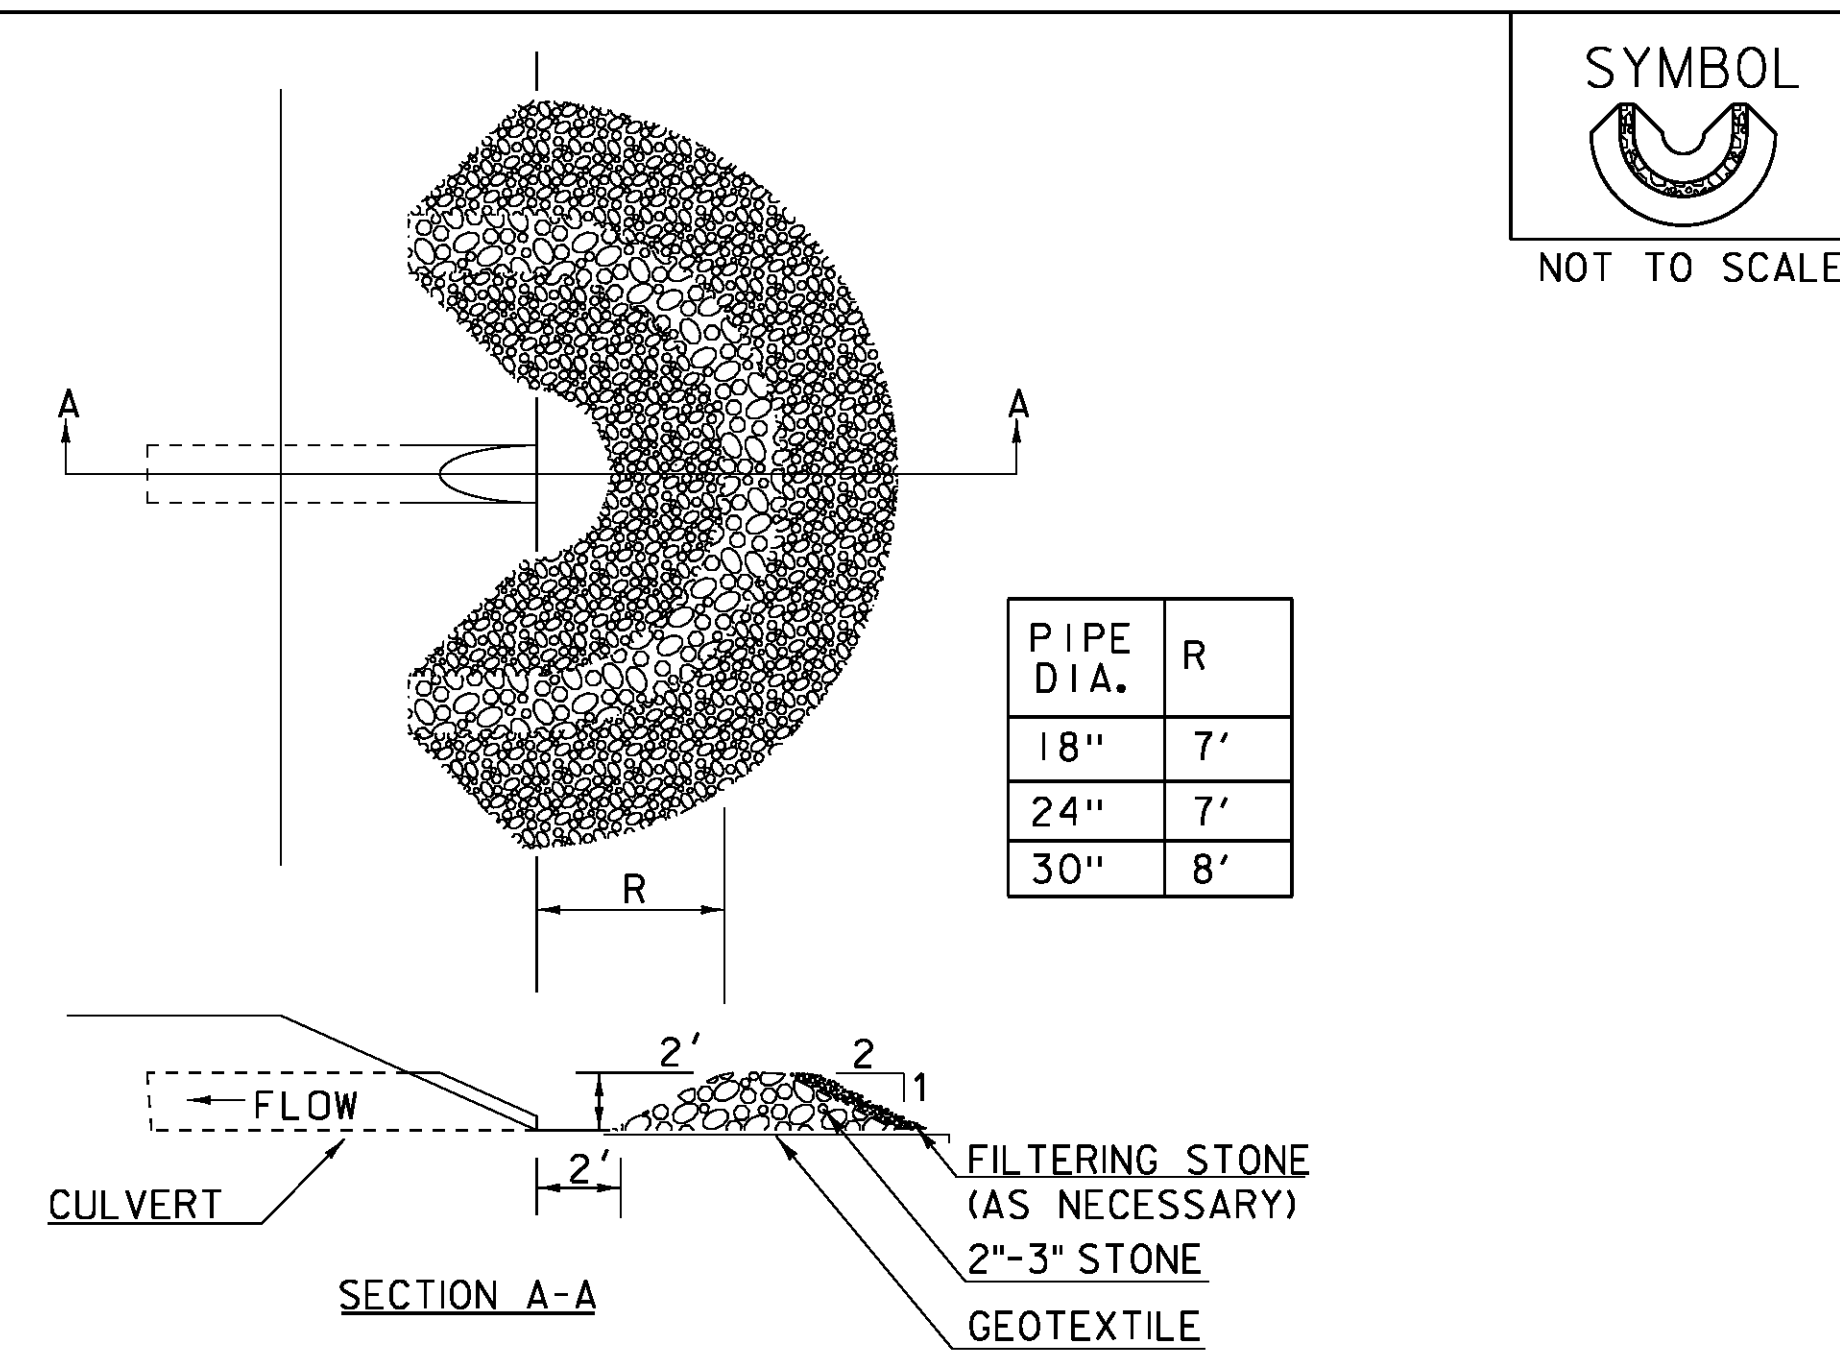

**CONSTRUCTION SPECIFICATIONS**

1. USE 2" TO 3" STONE. FILTERING STONE SHALL BE 3/4".
2. PLACE STONE OVER GEOTEXTILE.
3. ONCE THE AREAS UPSTREAM FROM THE CHECK DAM ARE STABILIZED WITH VEGETATION, THE SEDIMENT TRAPPED BEHIND THE DAM SHALL BE DISPOSED OF IN AN APPROVED WASTE AREA.
4. THE CHECK DAM(S) SHALL BE FLATTENED AND GRADED IN A MANNER WHICH PROTECTS THE AREA FROM EROSION AND CHANNEL BLOCKAGE. (GEOTEXTILE MUST BE REMOVED).
5. THE GEOTEXTILE MUST BE DISPOSED OF APPROPRIATELY.
6. THE AREA CONTRIBUTING TO THE CHECK DAM SHALL NOT EXCEED 4 ACRES.

ADAPTED FROM DETAILS PROVIDED BY: ILLINOIS USDA-NRCS  
ORIGINALLY DEVELOPED BY USDA-NRCS

**PIPE INLET PROTECTION**

REVISIONS		
MARCH 6, 2008	WHF	
JANUARY 13, 2009	WHF	

THIS WORK SHALL BE PERFORMED IN ACCORDANCE WITH SECTION 653 FOR INLET PROTECTION DEVICE, TYPE 1 (PAY ITEM 653.40).

PROJECT NAME: ROYALTON  
PROJECT NUMBER: BRS 0147 (13)

FILE NAME: s86e055ero_det.dgn  
PROJECT LEADER: C. CARLSON  
DESIGNED BY: D. PETERSON  
EPSC DETAILS (3)

PLOT DATE: 08-OCT-2013  
DRAWN BY: D. PETERSON  
CHECKED BY: C. CARLSON  
SHEET 177 OF 186



# RIGHT - OF - WAY DETAIL SHEET


TABLE OF PROPERTY ACQUISITION

PARCEL NO.	PROPERTY OWNER	SHEET NO.	BEGINNING STATION	ENDING STATION	TAKE	REMAINDER	RIGHT			RECORDING DATA				REMARKS					
							AREA±	AREA±	TYPE	(T)/(P)	AREA ±	TITLE	DATE		TOWN / CITY	BOOK	PAGE		
2A	STOCK, ROBERT J. & PEGGY A. - CO-TRUSTEES OF THE ROBERT J. STOCK REVOCABLE TRUST	4, 5	382+73.99 RT	390+89.24 RT±	0.31 A														
			382+75.87 RT	390+64.75 RT															
			382+88.42 RT	388+50.14 RT		CONST.	(T)	0.18 A	WD	06/18/13	ROYALTON	105	105-	INCLUDES PDF, BF & EC; 7,796 SF± INCL. DRAINAGE DITCHES:12,574 SF±					
			388+50.14 RT	389+94 RT		SLOPE	(P)	0.29 A							107				
			389+94 RT	390+63.01 RT		SLOPE	(T)	1,661 SF											
		CHANNEL	(P)	996 SF															
2B		4, 5	382+50.00 RT	390+45.82± LT	0.45 A			ALL R.T. & L								VT RTE. 14; HIGHWAY EASE.			
3	SMITH, MELLISSA FREEMAN, KEVIN J.	5	392+05.47 LT	392+34.00 LT				CONST.	(T)	235 SF	GTR	08/20/13	ROYALTON	105	114-115	INCLUDES PDF, BF & EC			
			392+31.50 LT			DRIVE	(T)									10' PAVED, MM 22.85			
			392+43 LT	392+79 LT		CONST.	(T)	308 SF								INCLUDES PDF, BF & EC			
			DRIVE 30+58.30 LT			REMOVE	(T)										GUIDE POST		
			DRIVE 30+58.50 RT					REMOVE	(T)								GUIDE POST		
4	TOWN OF ROYALTON	10	TH 22 30+38.72 CL	TH 22 31+50 00 CL				APPROACH	(T)		QCD						TH# 22		
			TH 20 40+10.07 CL	TH 20 40+75.00 CL		APPROACH	(T)										TH# 20; INCLUDES REMOVAL OF EXISTING CULVERT, INSTALLATION OF NEW		
			414+95.00 LT	415+00.00 LT		DITCH & DRAIN	(P)	24 SF									CULVERT, REMOVAL OF 2 GUIDE POST GUARDRAIL		
				415+60 LT		415+74 LT	INSTALL	(P)											
			MAINTENANCE AGREEMENT ZONE 1	TH 20 & TH 22 30+15.02 CL	TH 20& TH 22 30+38.72 CL														TH # 20 & TH # 22; L=23.69'

TABLE OF REVISIONS

REVISION NO.	SHEET NO.	DESCRIPTION	DATE

PLOT DATE 08/01/13

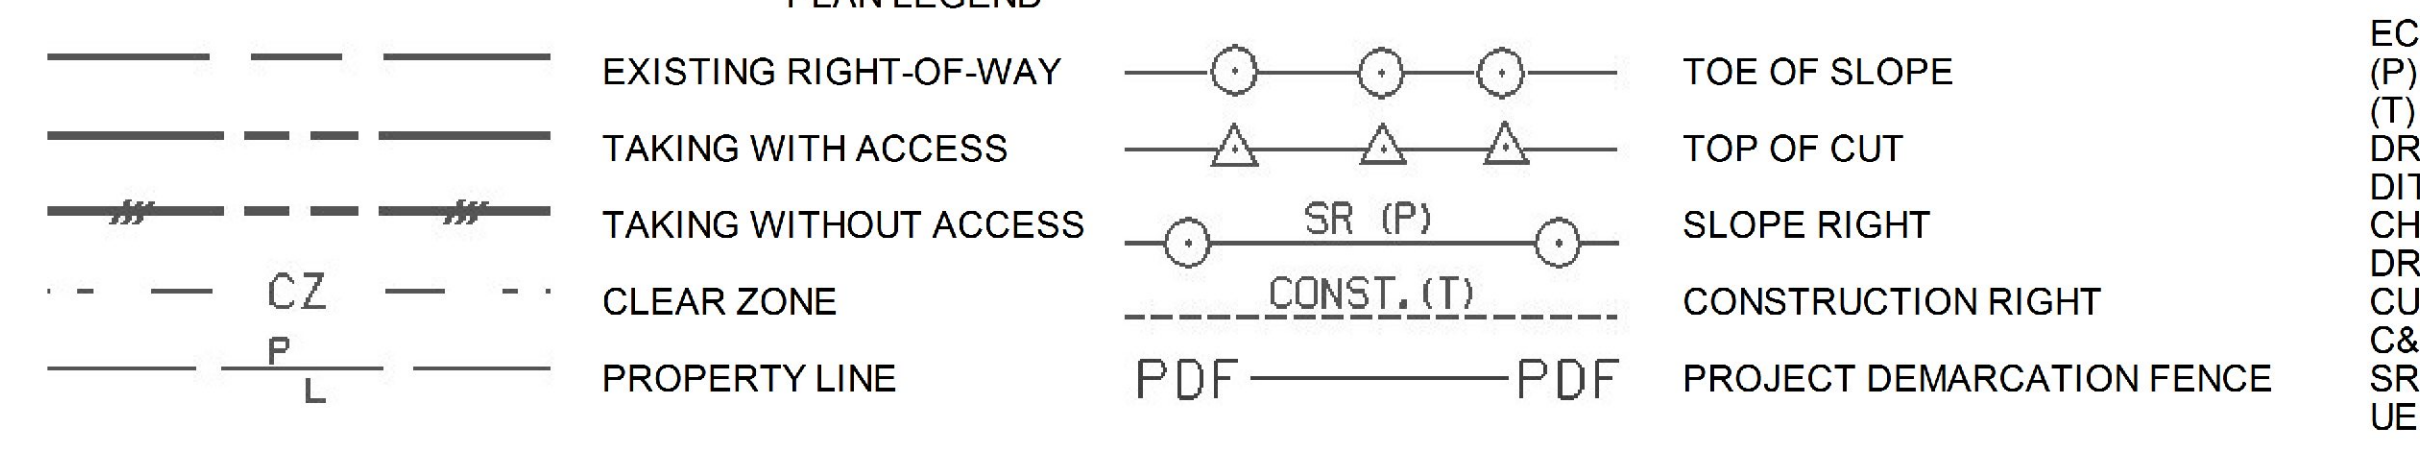

- EC - EROSION CONTROL
- (P) - PERMANENT
- (T) - TEMPORARY
- DR. - DRAINAGE RIGHT
- DIT. - DITCHING RIGHT
- CH. - CHANNEL RIGHT
- DRIVE - DRIVE RIGHT
- CUL. - CULVERT RIGHT
- C&T - CLEARING & TRIMMING RIGHT
- SR - SLOPE RIGHT
- UE - UTILITY EASEMENT
- BF - BARRIER FENCE

APPROVED: HARRY PETROVS DATE: 11-01-2012  
CHIEF, PLANS & TITLES

PROJECT NAME: **ROYALTON**  
 PROJECT NUMBER: **BRS 0147 (13)**  
 FILE NAME: r86e055_detail.xls PLOT DATE:  
 PROJECT LEADER: C. CARLSON DRAWN BY: MR  
 DESIGNED BY: D. PETERSON CHECKED BY: JB  
 R.O.W. DETAIL SHEET #2 ROW SHEET 179 OF 186

- ① VT 14 STA 382+75.0 RT - VT 14 STA 386+25.0 RT  
CONSTRUCT NEW GRASS-LINED DITCH
- ② VT 14 STA 383+91.3 RT - VT 14 STA 385+83.2 RT  
CONSTRUCT NEW DITCH LINED WITH STONE FILL, TYPE I

CONSTRUCT 5' WIDE PAVED APRON  
VT 14 STA 384+28.7 LT - VT 14 STA 384+67.8 LT

CONSTRUCT GRAVEL DRIVE (10' WIDE)  
VT 14 STA 384+50.0 LT

CONSTRUCT SLOPE W/ STONE FILL, TYPE II  
VT 14 STA 382+80.9 RT - VT 14 STA 386+15.0 RT



SPECIAL PROVISION (REINFORCED SOIL SLOPE) W/ STONE FILL, TYPE II  
VT 14 STA 386+25.0 RT - VT 14 STA 388+00.0 RT

BOX BEAM GUARDRAIL

VT 14 STA 384+87.1 LT - VT 14 STA 387+88.8 LT  
VT 14 STA 386+11.7 RT - VT 14 STA 388+00.0 RT

MANUFACTURED TERMINAL SECTION, TANGENT

VT 14 STA 384+73.3 LT - VT 14 STA 384+87.1 LT  
VT 14 STA 385+97.5 RT - VT 14 STA 386+11.7 RT  
VT 14 STA 387+88.8 LT - VT 14 STA 388+00.0 LT

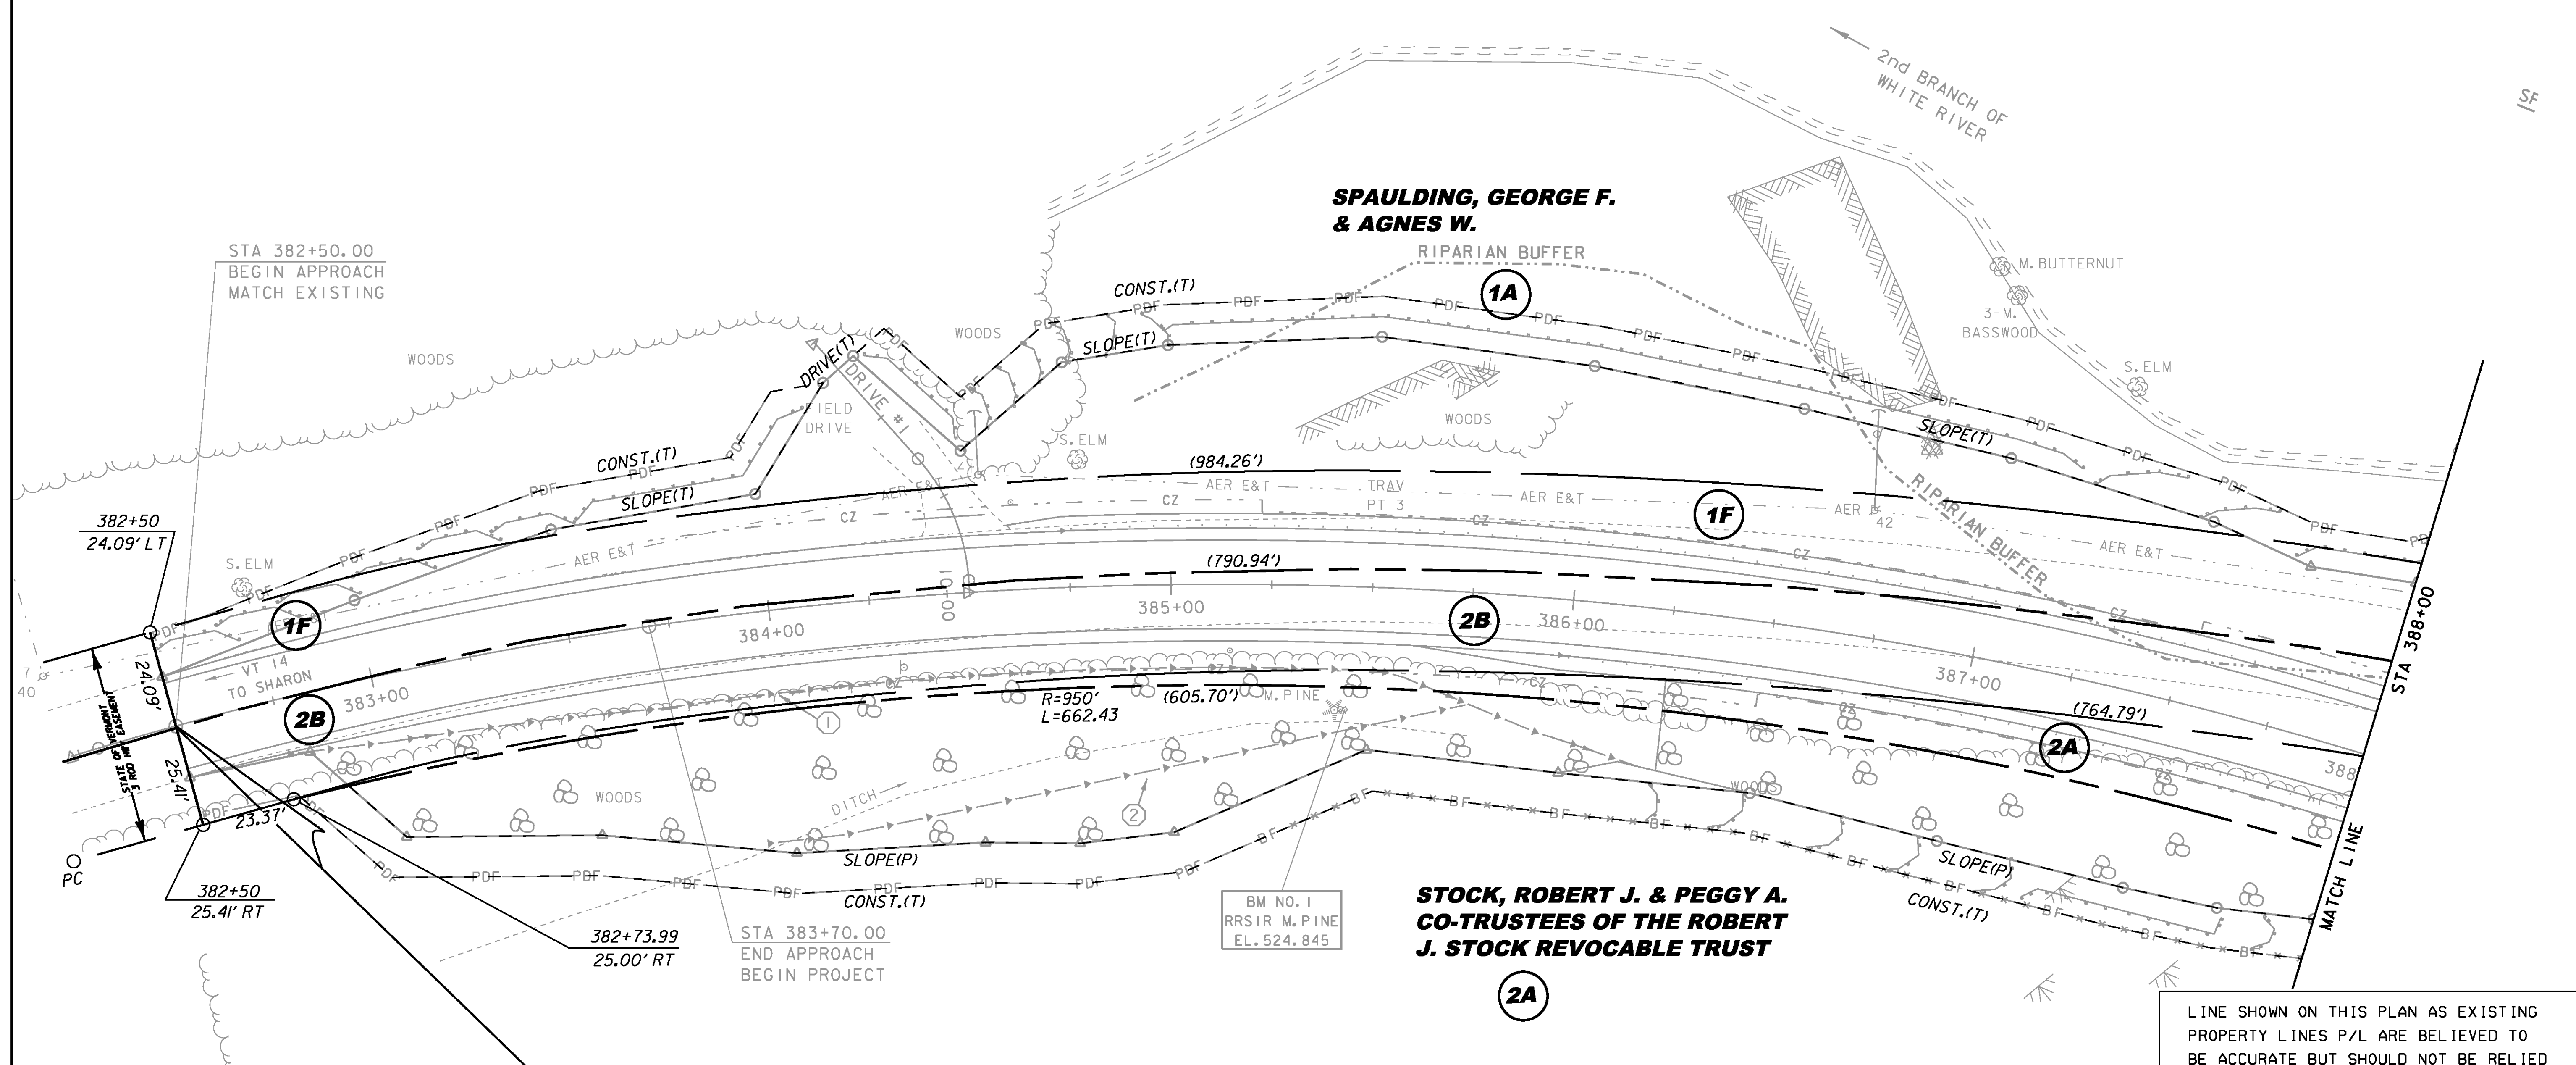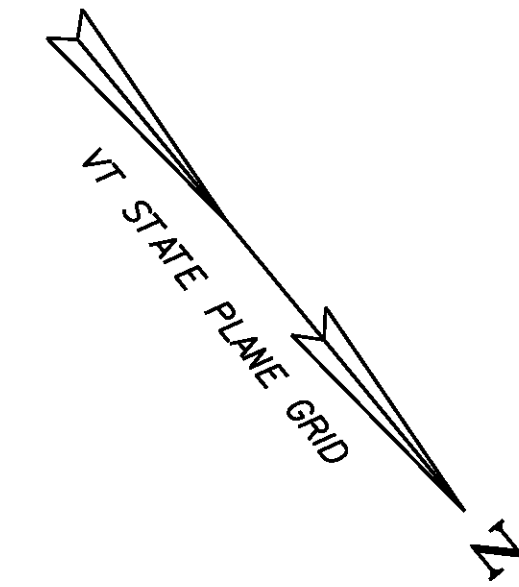

**SPAULDING, GEORGE F. & AGNES W.**

**STOCK, ROBERT J. & PEGGY A.  
CO-TRUSTEES OF THE ROBERT  
J. STOCK REVOCABLE TRUST**

LINE SHOWN ON THIS PLAN AS EXISTING PROPERTY LINES P/L ARE BELIEVED TO BE ACCURATE BUT SHOULD NOT BE RELIED UPON FOR PURPOSES UNRELATED TO THE STATE OF VERMONT'S ACQUISITION OF LAND AND RIGHTS FOR THIS PROJECT.

BEGIN ROW PROJECT  
BRS 0147 (13)  
STA. 382+50.00 C

20 0 20  
SCALE: 1" = 20' - 0"

86E055	
PROJECT NAME:	ROYALTON
PROJECT NUMBER:	BRS 0147(13)
FILE NAME:	\BRIDGE 27 \Layout 1.dgn
PROJECT LEADER:	C. CARLSON
DESIGNED BY:	D. PETERSON
BRIDGE 27 ROW LAYOUT SHEET (I)	PLOT DATE: 08-OCT-2013
	DRAWN BY: MR
	CHECKED BY: JB
	ROW SHEET 180 OF 186

CONSTRUCT 5' WIDE PAVED APRON  
VT 14 STA 388+02.2 LT - VT 14 STA 388+43.1 LT

CONSTRUCT GRAVEL DRIVE (12' WIDE)  
VT 14 STA 388+25.0 LT  
DRIVE NO.3 STA 30+32.6 LT

CONSTRUCT PAVED DRIVE (10' WIDE)  
VT 14 STA 392+31.5 LT

SPECIAL PROVISION (REINFORCED SOIL SLOPE) W/ STONE FILL, TYPE III  
VT 14 STA 388+00.0 RT - VT 14 STA 388+50.0 RT

RELOCATE MAILBOX, SINGLE SUPPORT  
FROM DRIVE NO.3 STA 30+50.5 RT TO VT 14 STA 392+50.0 LT.

REMOVING AND RESETTING FENCE

VT 14 STA 390+78.7 LT - VT 14 STA 392+04.7 LT  
VT 14 STA 390+89.7 LT - VT 14 STA 393+50.0 RT  
VT 14 STA 391+48.7 RT - VT 14 STA 393+50.0 RT  
VT 14 STA 393+44.9 LT - VT 14 STA 393+50.0 LT

BOX BEAM GUARDRAIL

VT 14 STA 388+00.0 RT - VT 14 STA 389+66.8 RT  
VT 14 STA 388+57.9 LT - VT 14 STA 389+56.3 LT  
VT 14 STA 391+63.1 LT - VT 14 STA 391+89.7 LT  
VT 14 STA 391+73.7 RT - VT 14 STA 392+74.1 RT

MANUFACTURED TERMINAL SECTION, TANGENT

VT 14 STA 388+00.0 LT - VT 14 STA 388+02.6 LT  
VT 14 STA 388+44.0 LT - VT 14 STA 388+57.9 LT  
VT 14 STA 391+89.7 LT - VT 14 STA 392+03.5 LT  
VT 14 STA 391+74.1 RT - VT 14 STA 392+88.3 RT

SPECIAL PROVISION (GUARDRAIL APPROACH SECTION TO CONCRETE COMBINATION BRIDGE RAILING)

VT 14 STA 389+56.3 LT - VT 14 STA 389+90.3 LT  
VT 14 STA 389+66.8 RT - VT 14 STA 390+00.8 RT  
VT 14 STA 391+29.2 LT - VT 14 STA 391+63.1 LT  
VT 14 STA 391+39.7 RT - VT 14 STA 391+73.7 RT

BRIDGE RAILING, GALVANIZED STEEL TUBING/CONCRETE COMBINATION

VT 14 STA 389+90.3 LT - VT 14 STA 391+29.2 LT  
VT 14 STA 390+00.8 RT - VT 14 STA 391+39.7 RT

REMOVAL AND DISPOSAL OF GUARDRAIL

VT 14 STA 389+34.8 LT - VT 14 STA 389+72.9 LT  
VT 14 STA 389+46.6 LT - VT 14 STA 389+83.8 LT  
VT 14 STA 390+78.7 LT - VT 14 STA 391+29.2 LT  
VT 14 STA 390+89.7 LT - VT 14 STA 391+40.1 LT

REMOVAL AND DISPOSAL OF GUIDE POSTS

DRIVE NO.3 STA 30+58.3 LT  
DRIVE NO.3 STA 30+58.5 RT  
VT 14 392+93.4 LT  
VT 14 393+09.5 LT  
VT 14 393+44.3 RT

**SPAULDING, GEORGE F. & AGNES W.**

**SPAULDING, GEORGE F. & AGNES W.**

**SMITH, MELLISSA AND FREEMAN, KEVIN J.**

**STOCK, ROBERT J. & PEGGY A. CO-TRUSTEES OF THE ROBERT J. STOCK REVOCABLE TRUST**


**SPAULDING, GEORGE F. & AGNES W.**

- ③ VT 14 STA 392+47.3 RT - VT 14 STA 393+50.0 RT  
CONSTRUCT NEW GRASS-LINED DITCH
- ④ VT 14 STA 392+22.2 RT - VT 14 STA 393+74.4 LT  
NEW 18" X 160" PCCSP (0.064), CAAP (0.060),  
RCP CL. III OR CPEP (SL) OPTION
- ⑤ VT 14 STA 392+68.9 LT - VT 14 STA 393+43.0 LT  
EXISTING 15" CGMP & INLET HEADWALL - REMOVE

EXISTING BRIDGE DATA

THREE-SPAN CONCRETE T-BEAM SUPERSTRUCTURE WITH ASPHALT OVERLAY  
CAST-IN-PLACE CONCRETE ABUTMENTS, WINGWALLS AND PIERS  
BRIDGE LENGTH: 105'  
BRIDGE WIDTH (FASCIA TO FASCIA): 23.7'  
VERTICAL CLEARANCE UNDER BRIDGE: 12'

LINE SHOWN ON THIS PLAN AS EXISTING PROPERTY LINES P/L ARE BELIEVED TO BE ACCURATE BUT SHOULD NOT BE RELIED UPON FOR PURPOSES UNRELATED TO THE STATE OF VERMONT'S ACQUISITION OF LAND AND RIGHTS FOR THIS PROJECT.

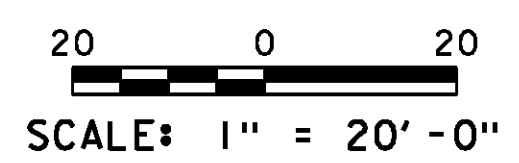

86E055

PROJECT NAME: ROYALTON  
PROJECT NUMBER: BRS 0147(13)

FILE NAME: \BRIDGE 27 \Layout 2.dgn  
PROJECT LEADER: C. CARLSON  
DESIGNED BY: D. PETERSON  
BRIDGE 27 ROW LAYOUT SHEET (2)



PLOT DATE: 08-OCT-2013  
DRAWN BY: MR  
CHECKED BY: JB  
ROW SHEET 181 OF 186

CONSTRUCT 5' WIDE PAVED APRON  
 VT 14 STA 395+82.2 RT - VT 14 STA 396+21.4 RT

REMOVAL AND DISPOSAL OF GUIDE POSTS

- VT 14 STA 393+80.9 RT
- VT 14 STA 393+98.7 RT
- VT 14 STA 394+12.4 RT
- VT 14 STA 394+27.6 RT
- VT 14 STA 394+40.9 RT
- VT 14 STA 394+57.7 RT
- VT 14 STA 394+74.9 RT
- VT 14 STA 394+91.0 RT
- VT 14 STA 395+22.4 RT


REMOVING AND RESETTING FENCE  
 VT 14 STA 393+50.0 RT - VT 14 STA 394+73.3 RT  
 VT 14 STA 393+50.0 RT - VT 14 STA 395+93.4 RT  
 VT 14 STA 393+50.0 RT - VT 14 STA 395+95.7 LT

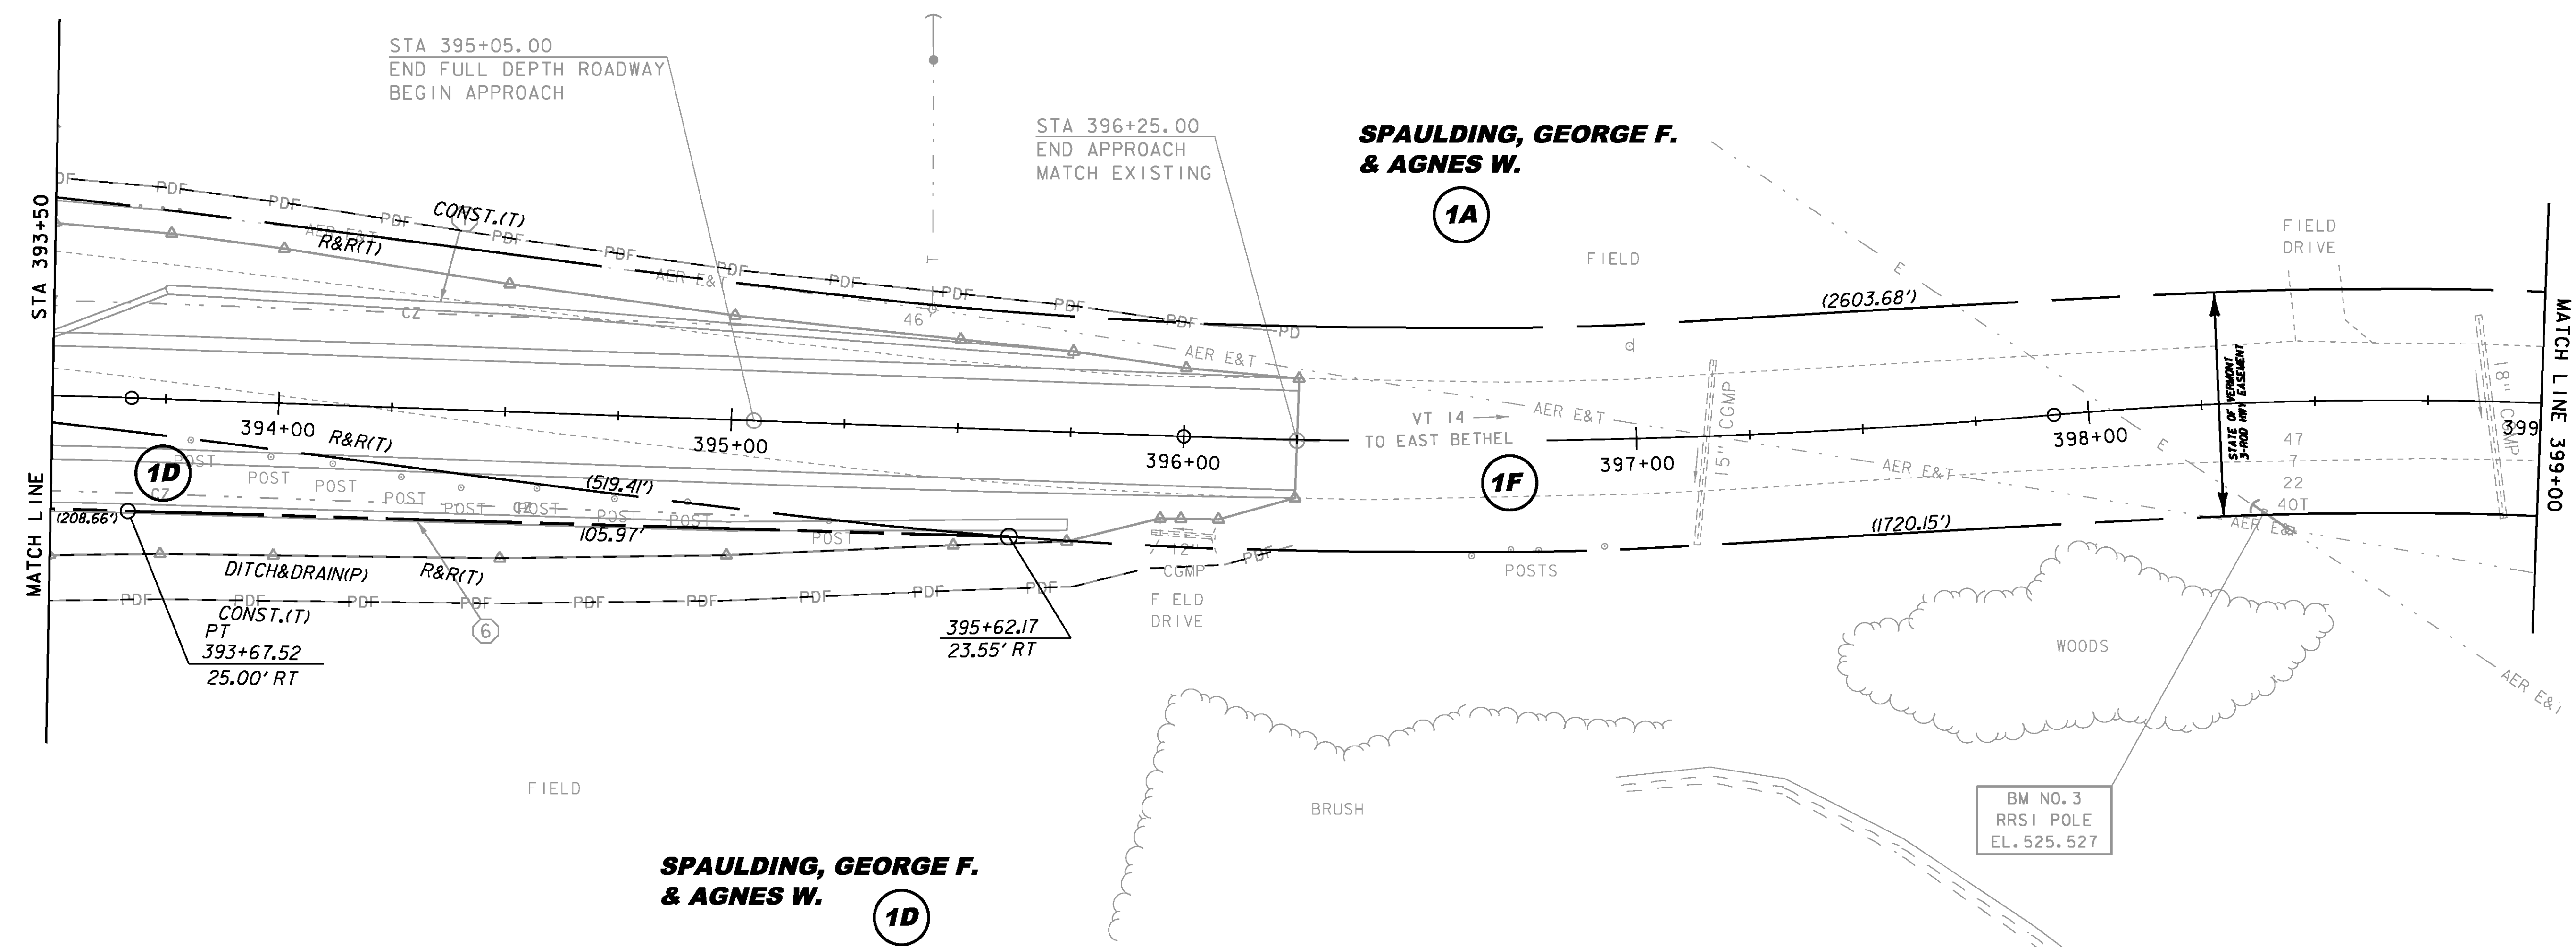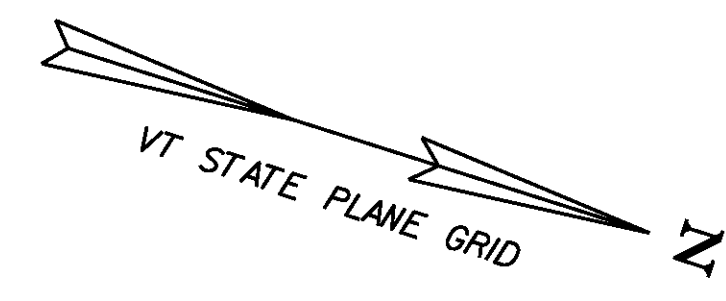

- ⑥ VT 14 STA 393+50.0 RT - VT 14 STA 395+75.0 RT  
CONSTRUCT NEW GRASS-LINED DITCH
- ⑦ VT 14 STA 393+75.0 LT - VT 14 STA 395+75.0 LT  
CONSTRUCT NEW GRASS-LINED DITCH

LINE SHOWN ON THIS PLAN AS EXISTING  
 PROPERTY LINES P/L ARE BELIEVED TO  
 BE ACCURATE BUT SHOULD NOT BE RELIED  
 UPON FOR PURPOSES UNRELATED TO THE  
 STATE OF VERMONT'S ACQUISITION OF LAND  
 AND RIGHTS FOR THIS PROJECT.

86E055	
PROJECT NAME:	ROYALTON
PROJECT NUMBER:	BRS 0147(13)
FILE NAME:	\BRIDGE 27 \Layout 3.dgn
PROJECT LEADER:	C. CARLSON
DESIGNED BY:	D. PETERSON
BRIDGE 27 ROW LAYOUT SHEET (3)	
PLOT DATE:	08-OCT-2013
DRAWN BY:	MR
CHECKED BY:	JB
ROW SHEET	182 OF 186

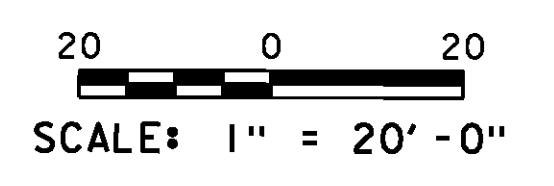


**HD STEEL BEAM GUARDRAIL, GALVANIZED**  
 VT 14 STA 399+80.6 RT - VT 14 STA 400+05.68 RT  
 VT 14 STA 399+88.9 LT - VT 14 STA 400+06.80 LT  
 VT 14 STA 400+93.86 RT - VT 14 STA 401+12.3 RT  
 VT 14 STA 400+93.64 LT - VT 14 STA 401+18.2 LT

**HD STEEL BEAM GUARDRAIL, GALVANIZED/NESTED**  
 VT 14 STA 400+05.68 RT - VT 14 STA 400+93.86 RT  
 VT 14 STA 400+06.80 LT - VT 14 STA 400+93.64 LT


**ANCHOR FOR STEEL BEAM RAIL**  
 VT 14 STA 399+87.6 RT  
 VT 14 STA 399+95.7 LT  
 VT 14 STA 401+05.4 RT  
 VT 14 STA 401+11.0 LT

**CONSTRUCT 5' PAVED APRON**  
 VT 14 STA 401+32.2 RT - VT 14 STA 401+64.4 RT

**CONSTRUCT STONE-LINED DITCH, TYPE 1**  
 VT 14 STA 399+50.0 LT - VT 14 STA 400+45.9 LT  
 VT 14 STA 400+55.0 LT - VT 14 STA 401+50.0 LT

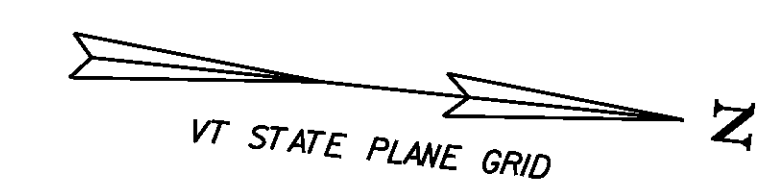

**SPAULDING, GEORGE F. & AGNES W.**

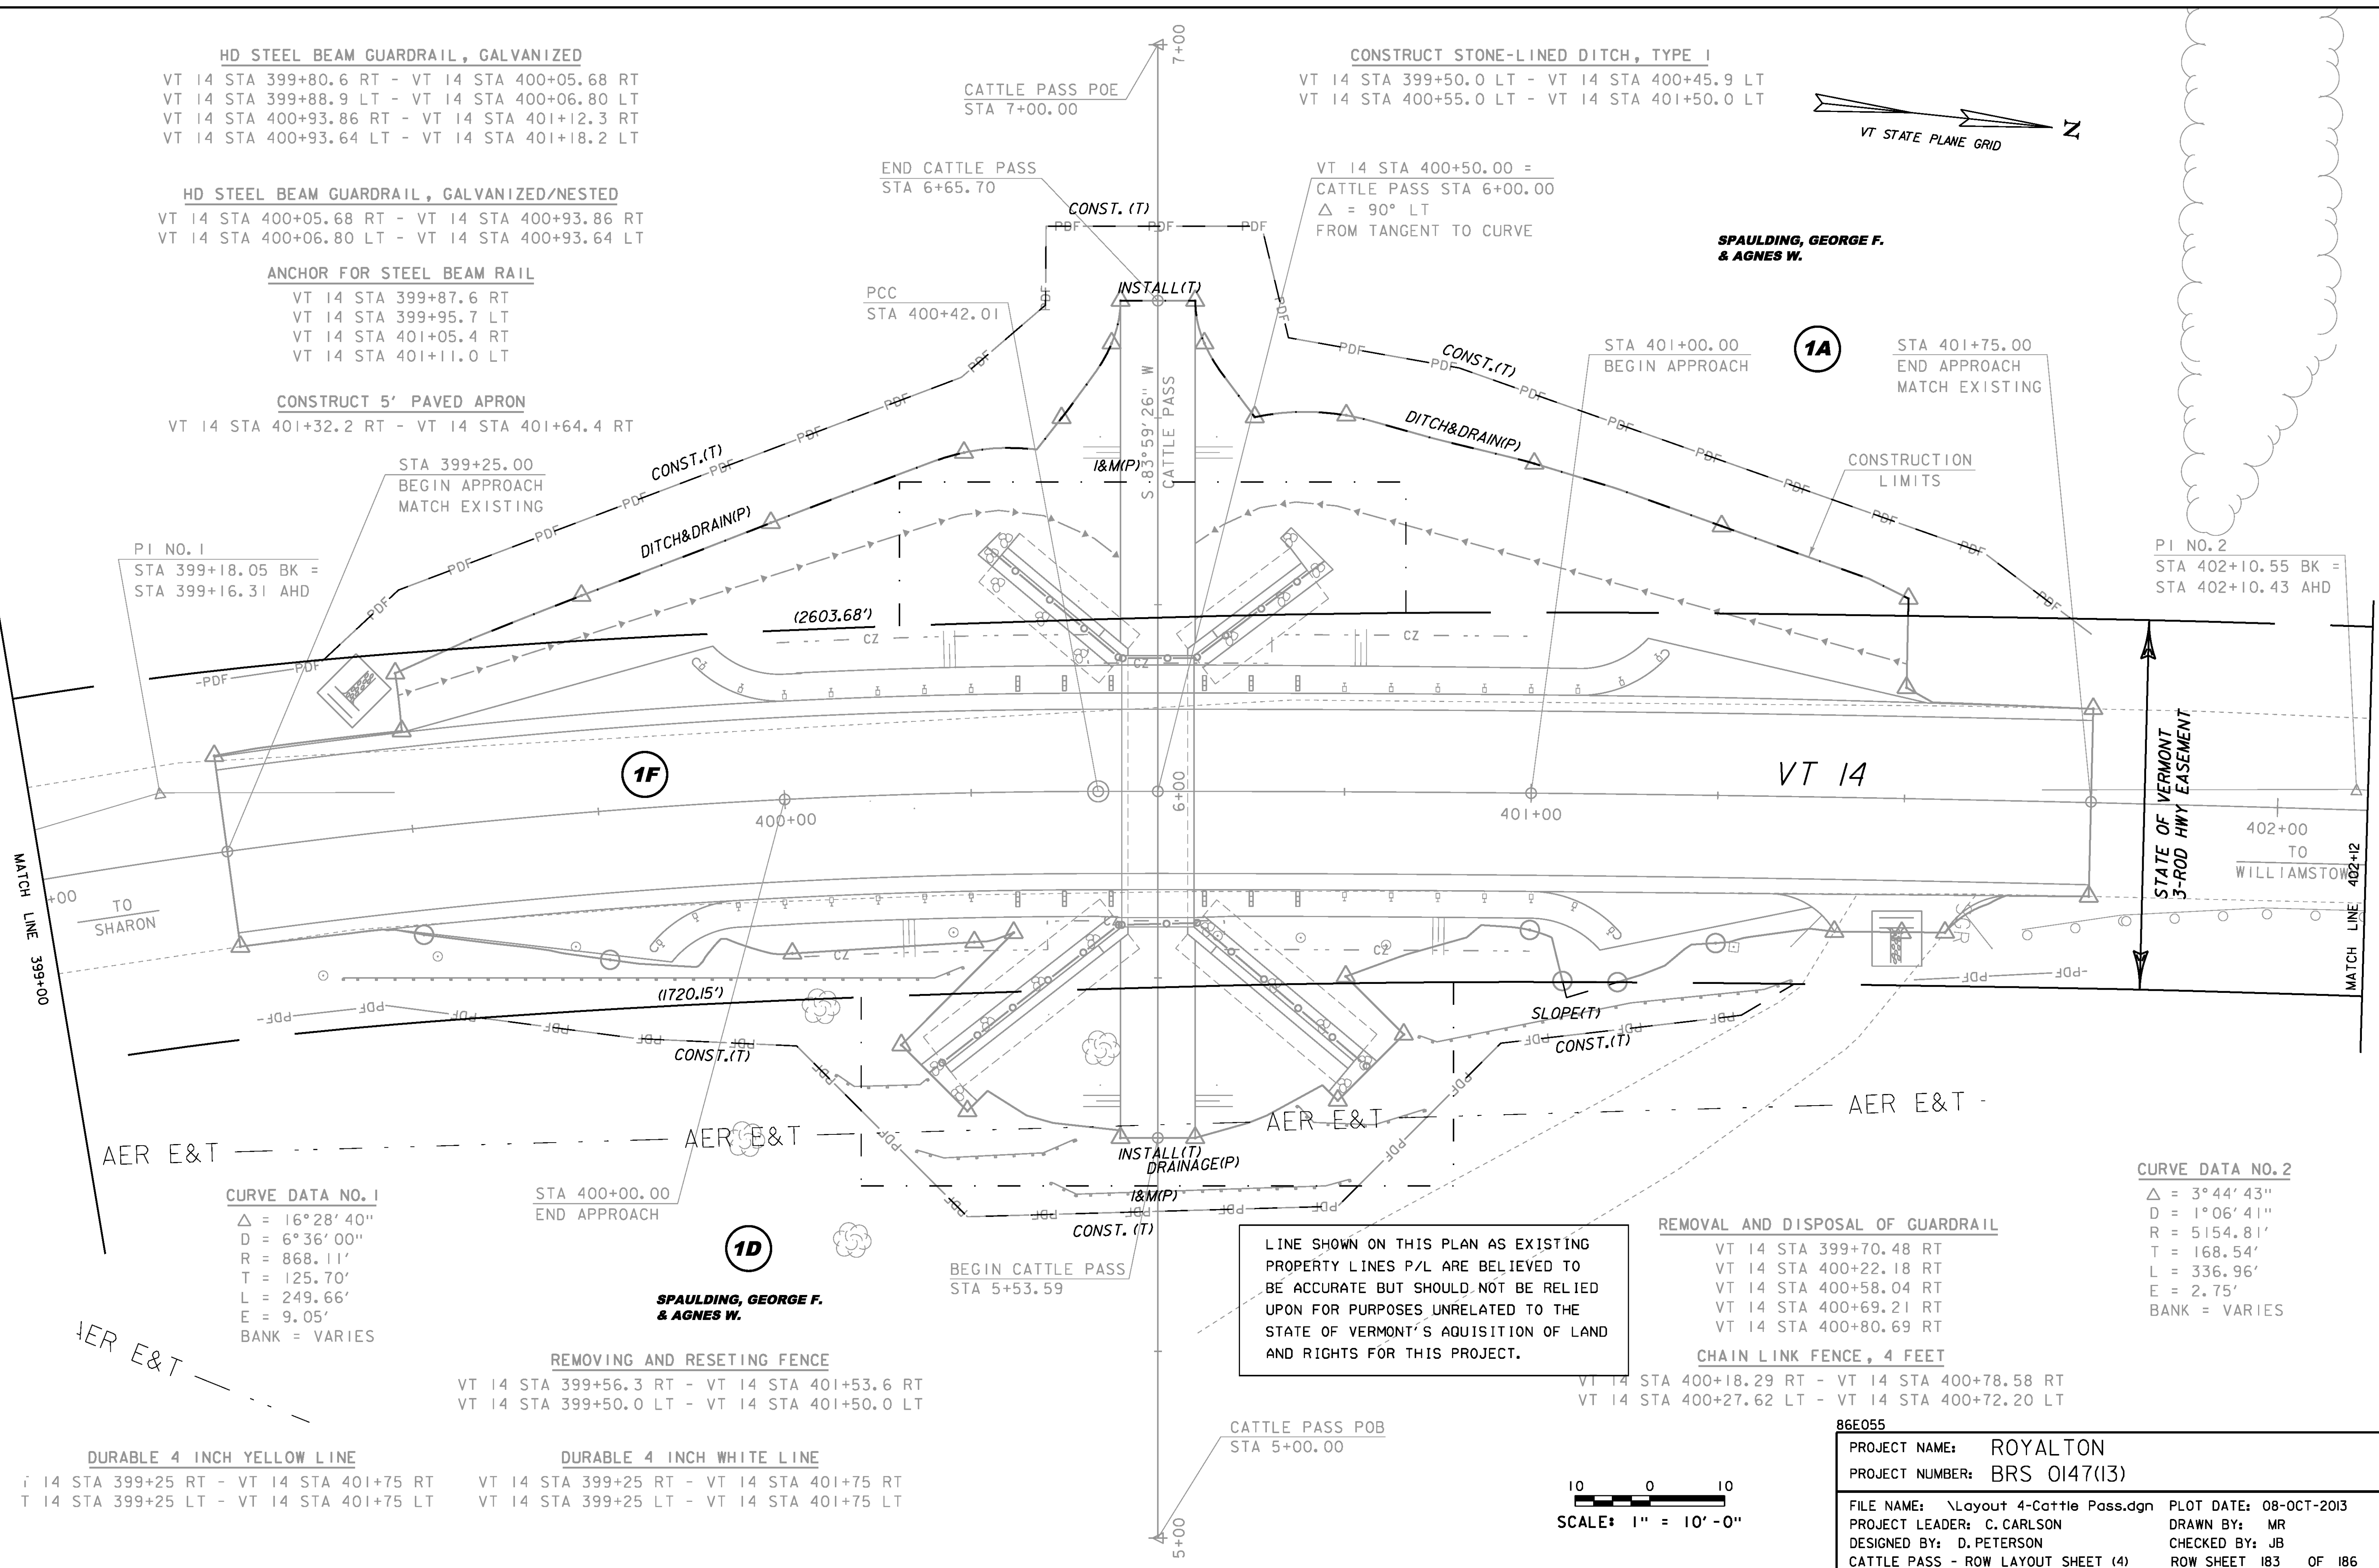

PI NO. 1  
 STA 399+18.05 BK =  
 STA 399+16.31 AHD

PI NO. 2  
 STA 402+10.55 BK =  
 STA 402+10.43 AHD

**CURVE DATA NO. 1**  
 $\Delta = 16^\circ 28' 40''$   
 $D = 6^\circ 36' 00''$   
 $R = 868.11'$   
 $T = 125.70'$   
 $L = 249.66'$   
 $E = 9.05'$   
 BANK = VARIES

**CURVE DATA NO. 2**  
 $\Delta = 3^\circ 44' 43''$   
 $D = 1^\circ 06' 41''$   
 $R = 5154.81'$   
 $T = 168.54'$   
 $L = 336.96'$   
 $E = 2.75'$   
 BANK = VARIES

LINE SHOWN ON THIS PLAN AS EXISTING  
 PROPERTY LINES P/L ARE BELIEVED TO  
 BE ACCURATE BUT SHOULD NOT BE RELIED  
 UPON FOR PURPOSES UNRELATED TO THE  
 STATE OF VERMONT'S ACQUISITION OF LAND  
 AND RIGHTS FOR THIS PROJECT.


**REMOVAL AND DISPOSAL OF GUARDRAIL**  
 VT 14 STA 399+70.48 RT  
 VT 14 STA 400+22.18 RT  
 VT 14 STA 400+58.04 RT  
 VT 14 STA 400+69.21 RT  
 VT 14 STA 400+80.69 RT

**CHAIN LINK FENCE, 4 FEET**  
 VT 14 STA 400+18.29 RT - VT 14 STA 400+78.58 RT  
 VT 14 STA 400+27.62 LT - VT 14 STA 400+72.20 LT

86E055

PROJECT NAME: ROYALTON  
 PROJECT NUMBER: BRS 0147(13)

FILE NAME: \Layout 4-Cattle Pass.dgn PLOT DATE: 08-OCT-2013  
 PROJECT LEADER: C. CARLSON DRAWN BY: MR  
 DESIGNED BY: D. PETERSON CHECKED BY: JB  
 CATTLE PASS - ROW LAYOUT SHEET (4) ROW SHEET 183 OF 186

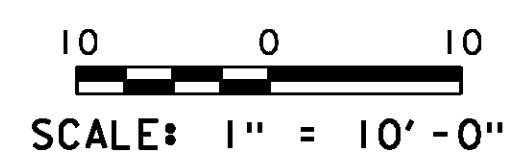


**DURABLE 4 INCH YELLOW LINE**  
 RT 14 STA 399+25 RT - VT 14 STA 401+75 RT  
 LT 14 STA 399+25 LT - VT 14 STA 401+75 LT

**DURABLE 4 INCH WHITE LINE**  
 RT 14 STA 399+25 RT - VT 14 STA 401+75 RT  
 LT 14 STA 399+25 LT - VT 14 STA 401+75 LT

**REMOVING AND RESETTING FENCE**  
 VT 14 STA 399+56.3 RT - VT 14 STA 401+53.6 RT  
 VT 14 STA 399+50.0 LT - VT 14 STA 401+50.0 LT

**SPAULDING, GEORGE F. & AGNES W.**

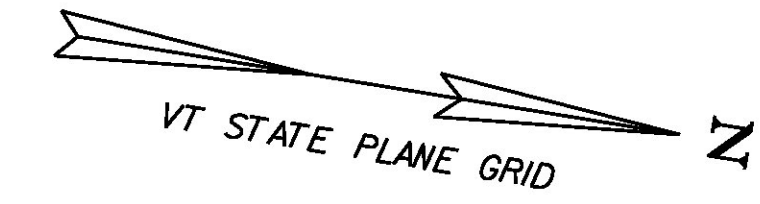



**SPAULDING, GEORGE F.  
& AGNES W.**

**SPAULDING, GEORGE F.  
& AGNES W.**

TO WHITE-DIVER JCT

VT 14


LINE SHOWN ON THIS PLAN AS EXISTING  
PROPERTY LINES P/L ARE BELIEVED TO  
BE ACCURATE BUT SHOULD NOT BE RELIED  
UPON FOR PURPOSES UNRELATED TO THE  
STATE OF VERMONT'S ACQUISITION OF LAND  
AND RIGHTS FOR THIS PROJECT.

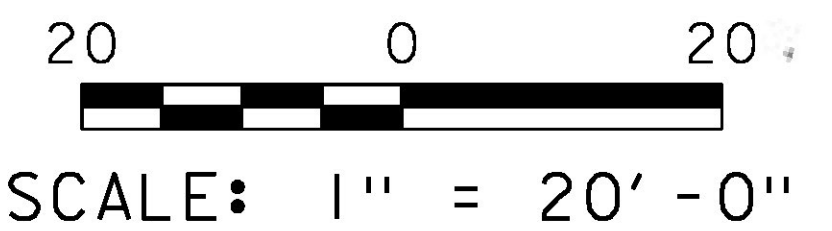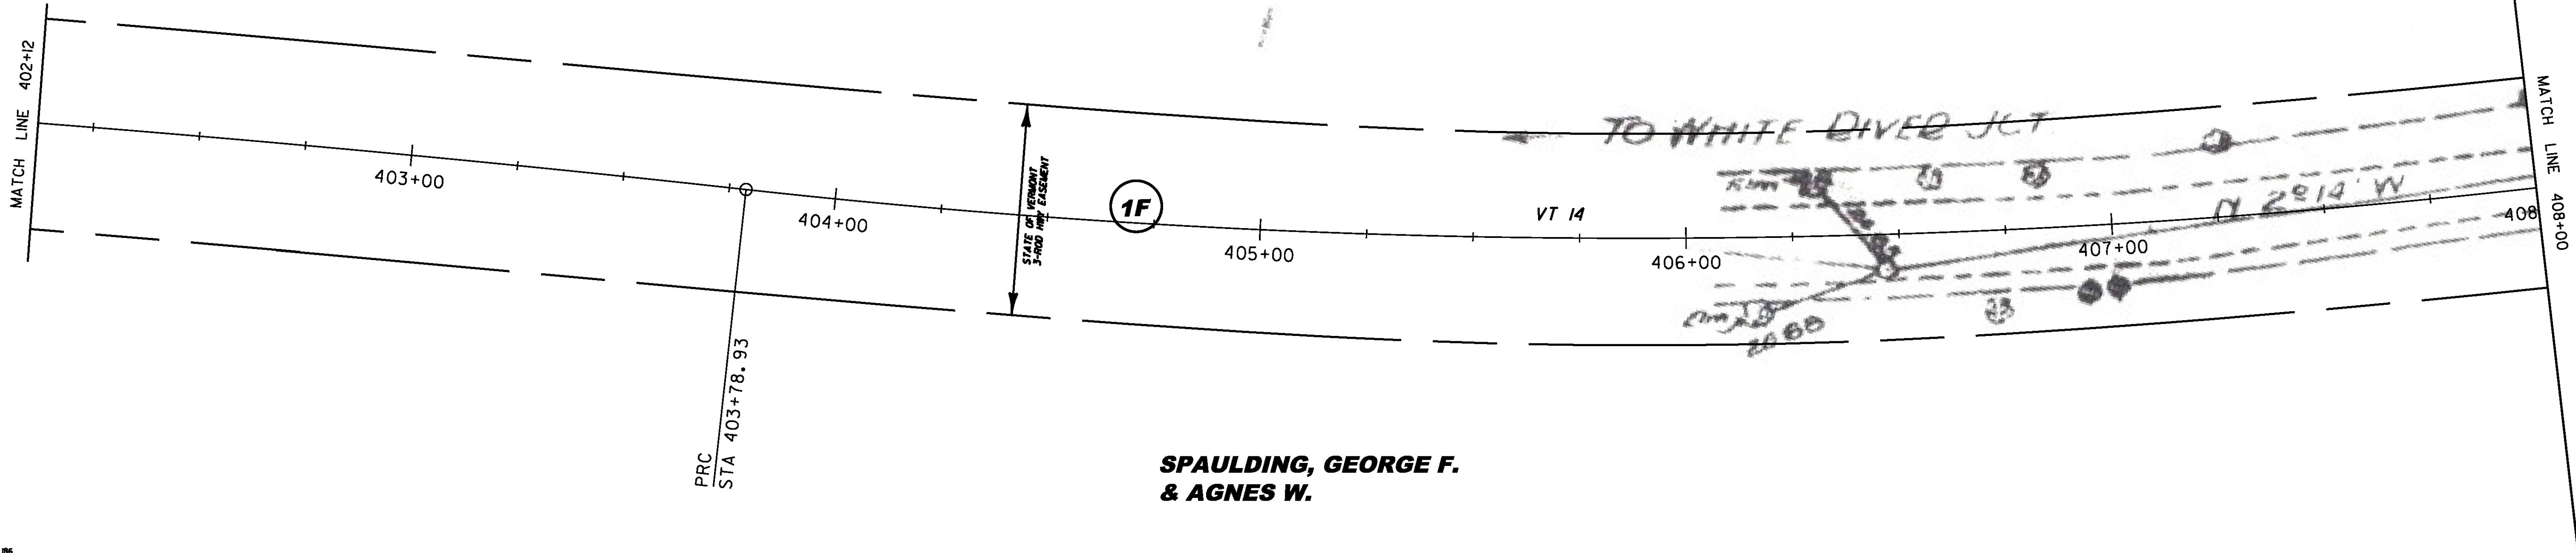

86E055	
PROJECT NAME: ROYALTON	
PROJECT NUMBER: BRS 0147(13)	
FILE NAME: \Layout 5.dgn	PLOT DATE: 08-OCT-2013
PROJECT LEADER: C. CARLSON	DRAWN BY: MR
DESIGNED BY: D. PETERSON	CHECKED BY: JB
ROW LAYOUT SHEET (5)	ROW SHEET 184 OF 186




86E055  
to Sta. 1131

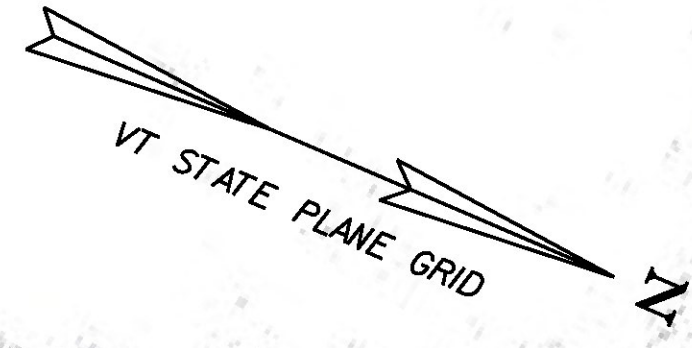

FRANK SPAULDING

**SPAULDING, GEORGE F.  
& AGNES W.**  
 $\Delta = 16^{\circ}30'$  (APPROX.)  
 $D = 8'$   
 $R = 716.3$   
 $T = 103.4$   
 $L = 202.5$   
 $E = 7.4$

DO NOT BANK OR WIDEN

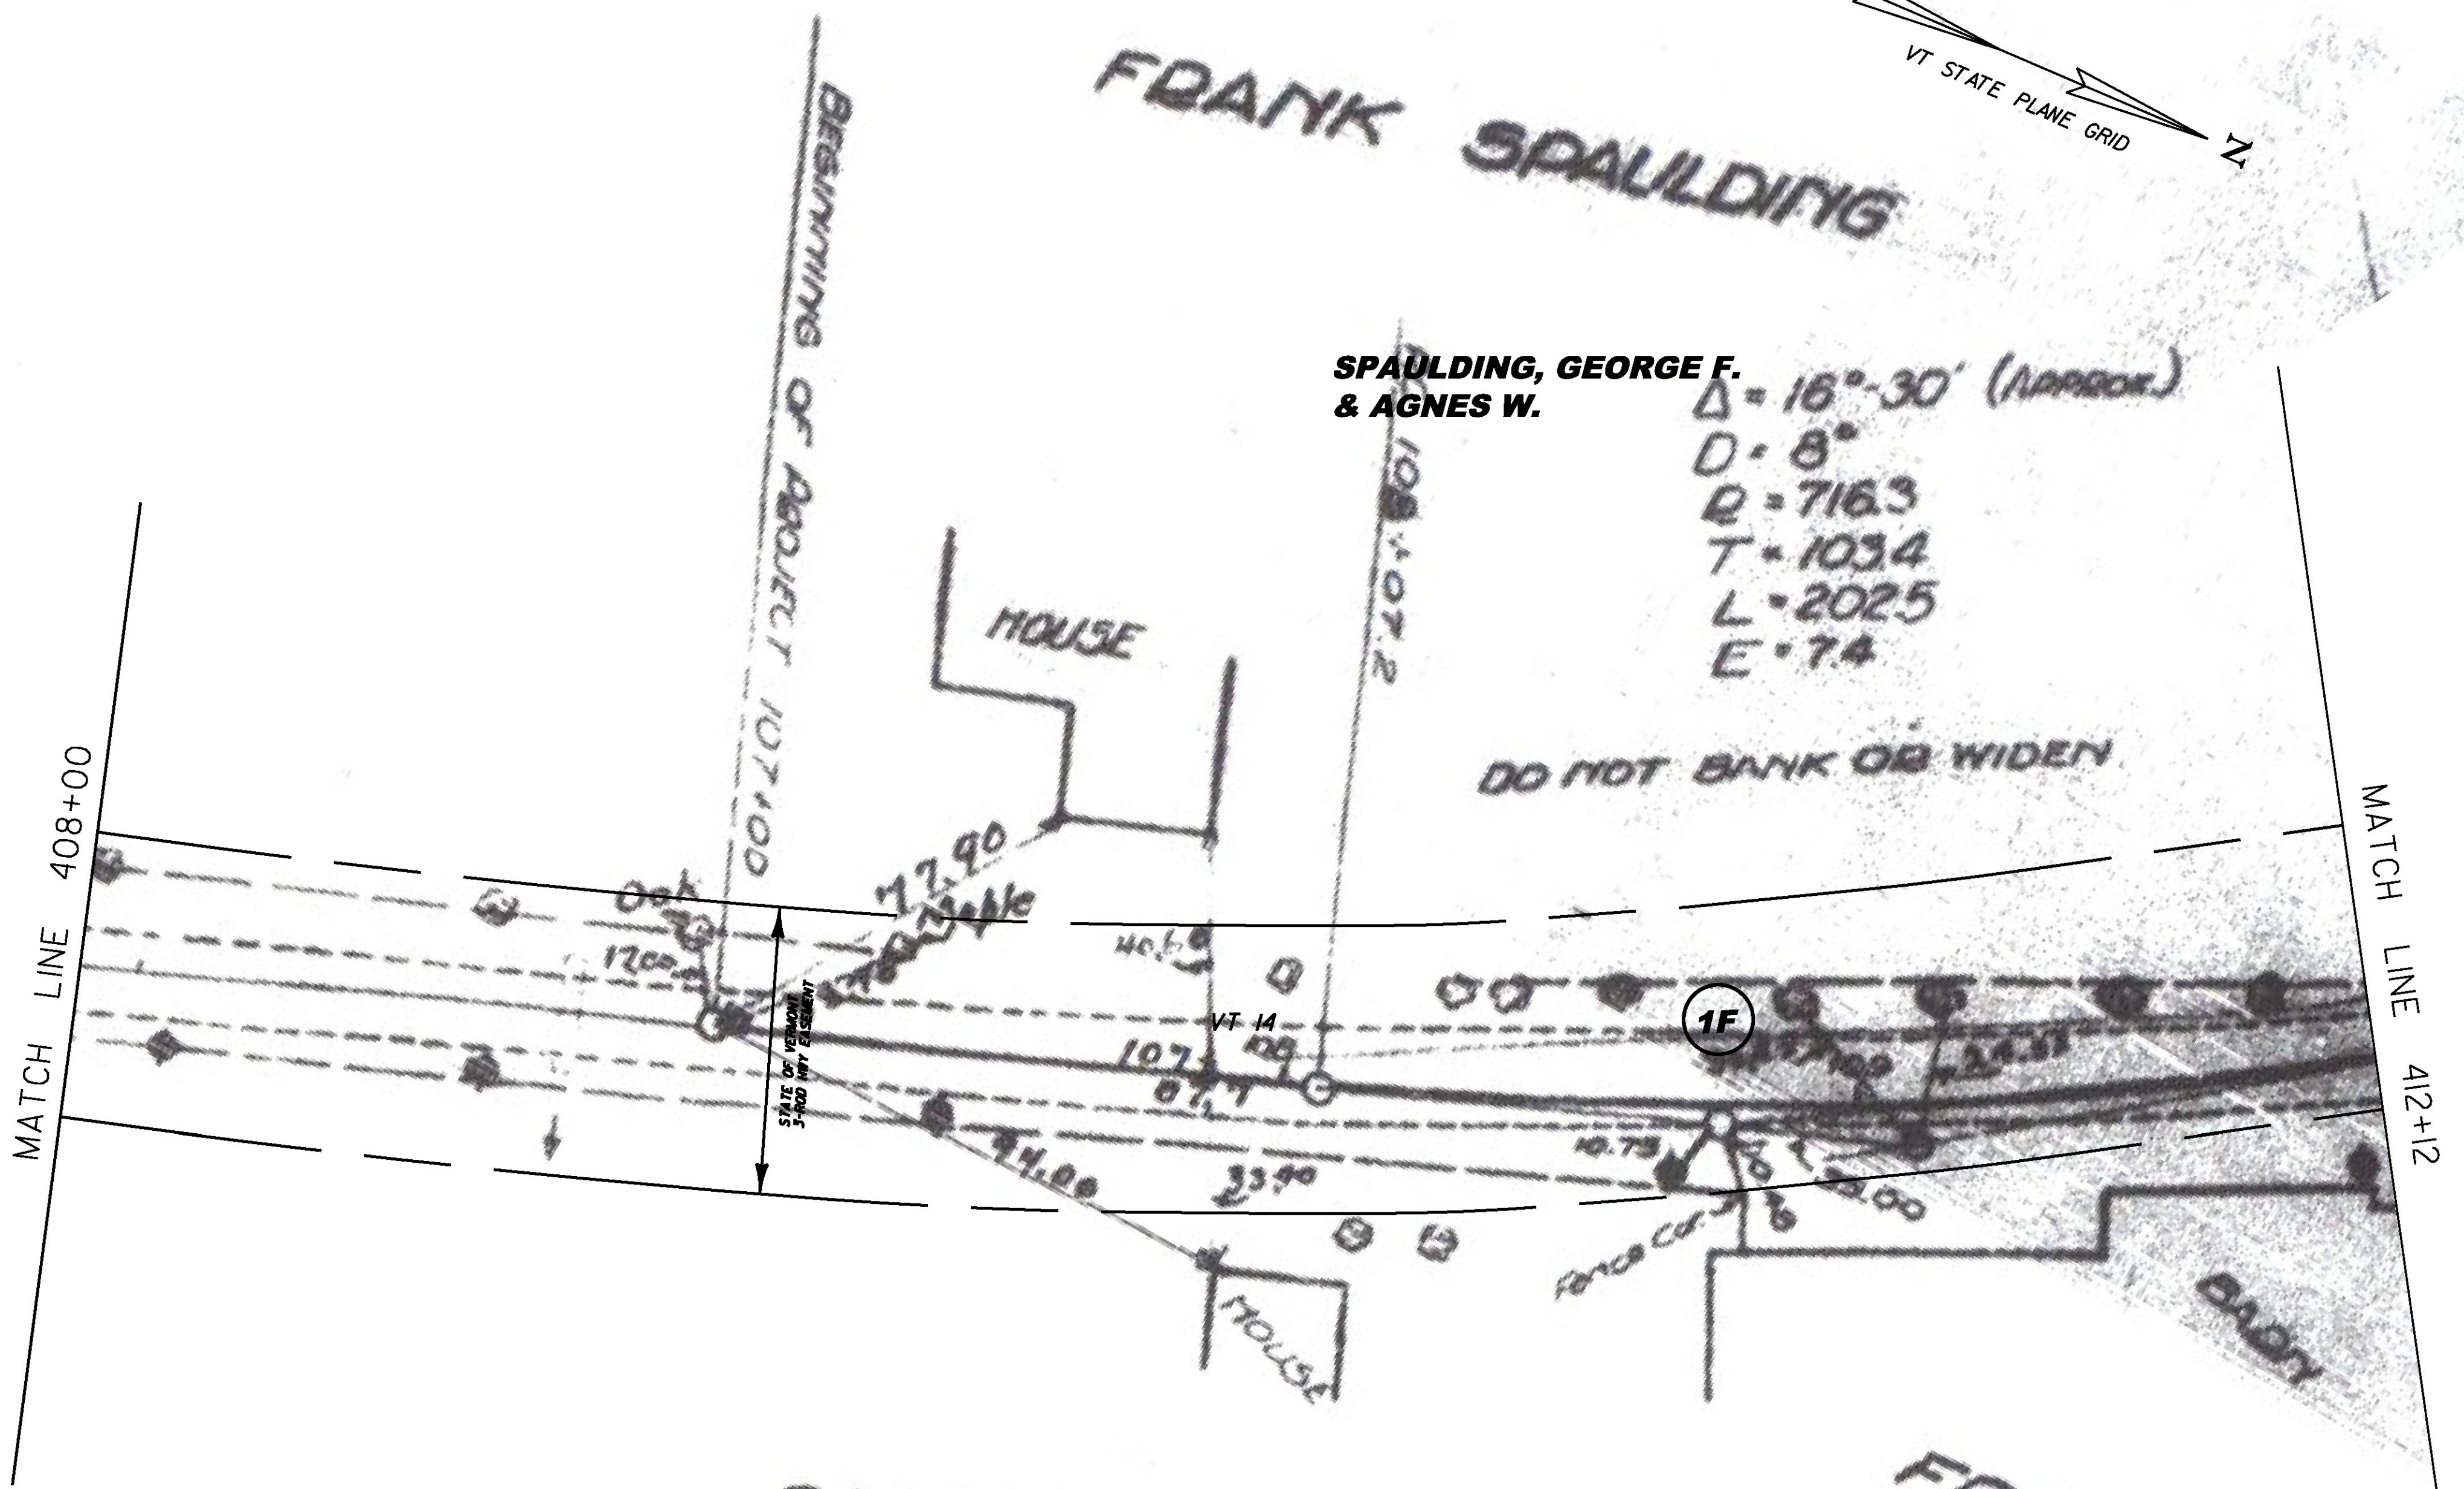


ROYALTON POWER CO.

**SPAULDING, GEORGE F.  
& AGNES W.**

FRANK SPAULDING

LINE SHOWN ON THIS PLAN AS EXISTING  
PROPERTY LINES P/L ARE BELIEVED TO  
BE ACCURATE BUT SHOULD NOT BE RELIED  
UPON FOR PURPOSES UNRELATED TO THE  
STATE OF VERMONT'S ACQUISITION OF LAND  
AND RIGHTS FOR THIS PROJECT.

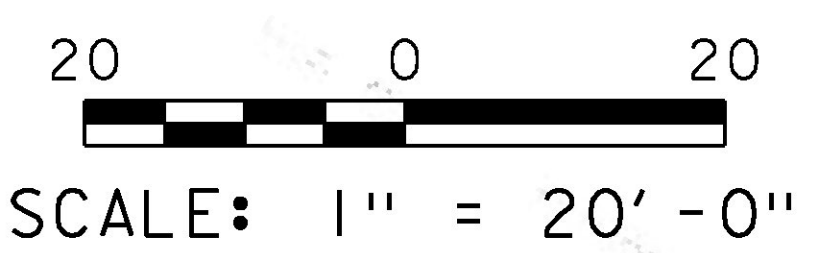


86E055

PROJECT NAME: ROYALTON  
PROJECT NUMBER: BRS 0147(13)

FILE NAME: \Layout 6.dgn  
PROJECT LEADER: C. CARLSON  
DESIGNED BY: D. PETERSON  
ROW LAYOUT SHEET (6)

PLOT DATE: 08-OCT-2013  
DRAWN BY: MR  
CHECKED BY: JB  
ROW SHEET 185 OF 186

PROJECT

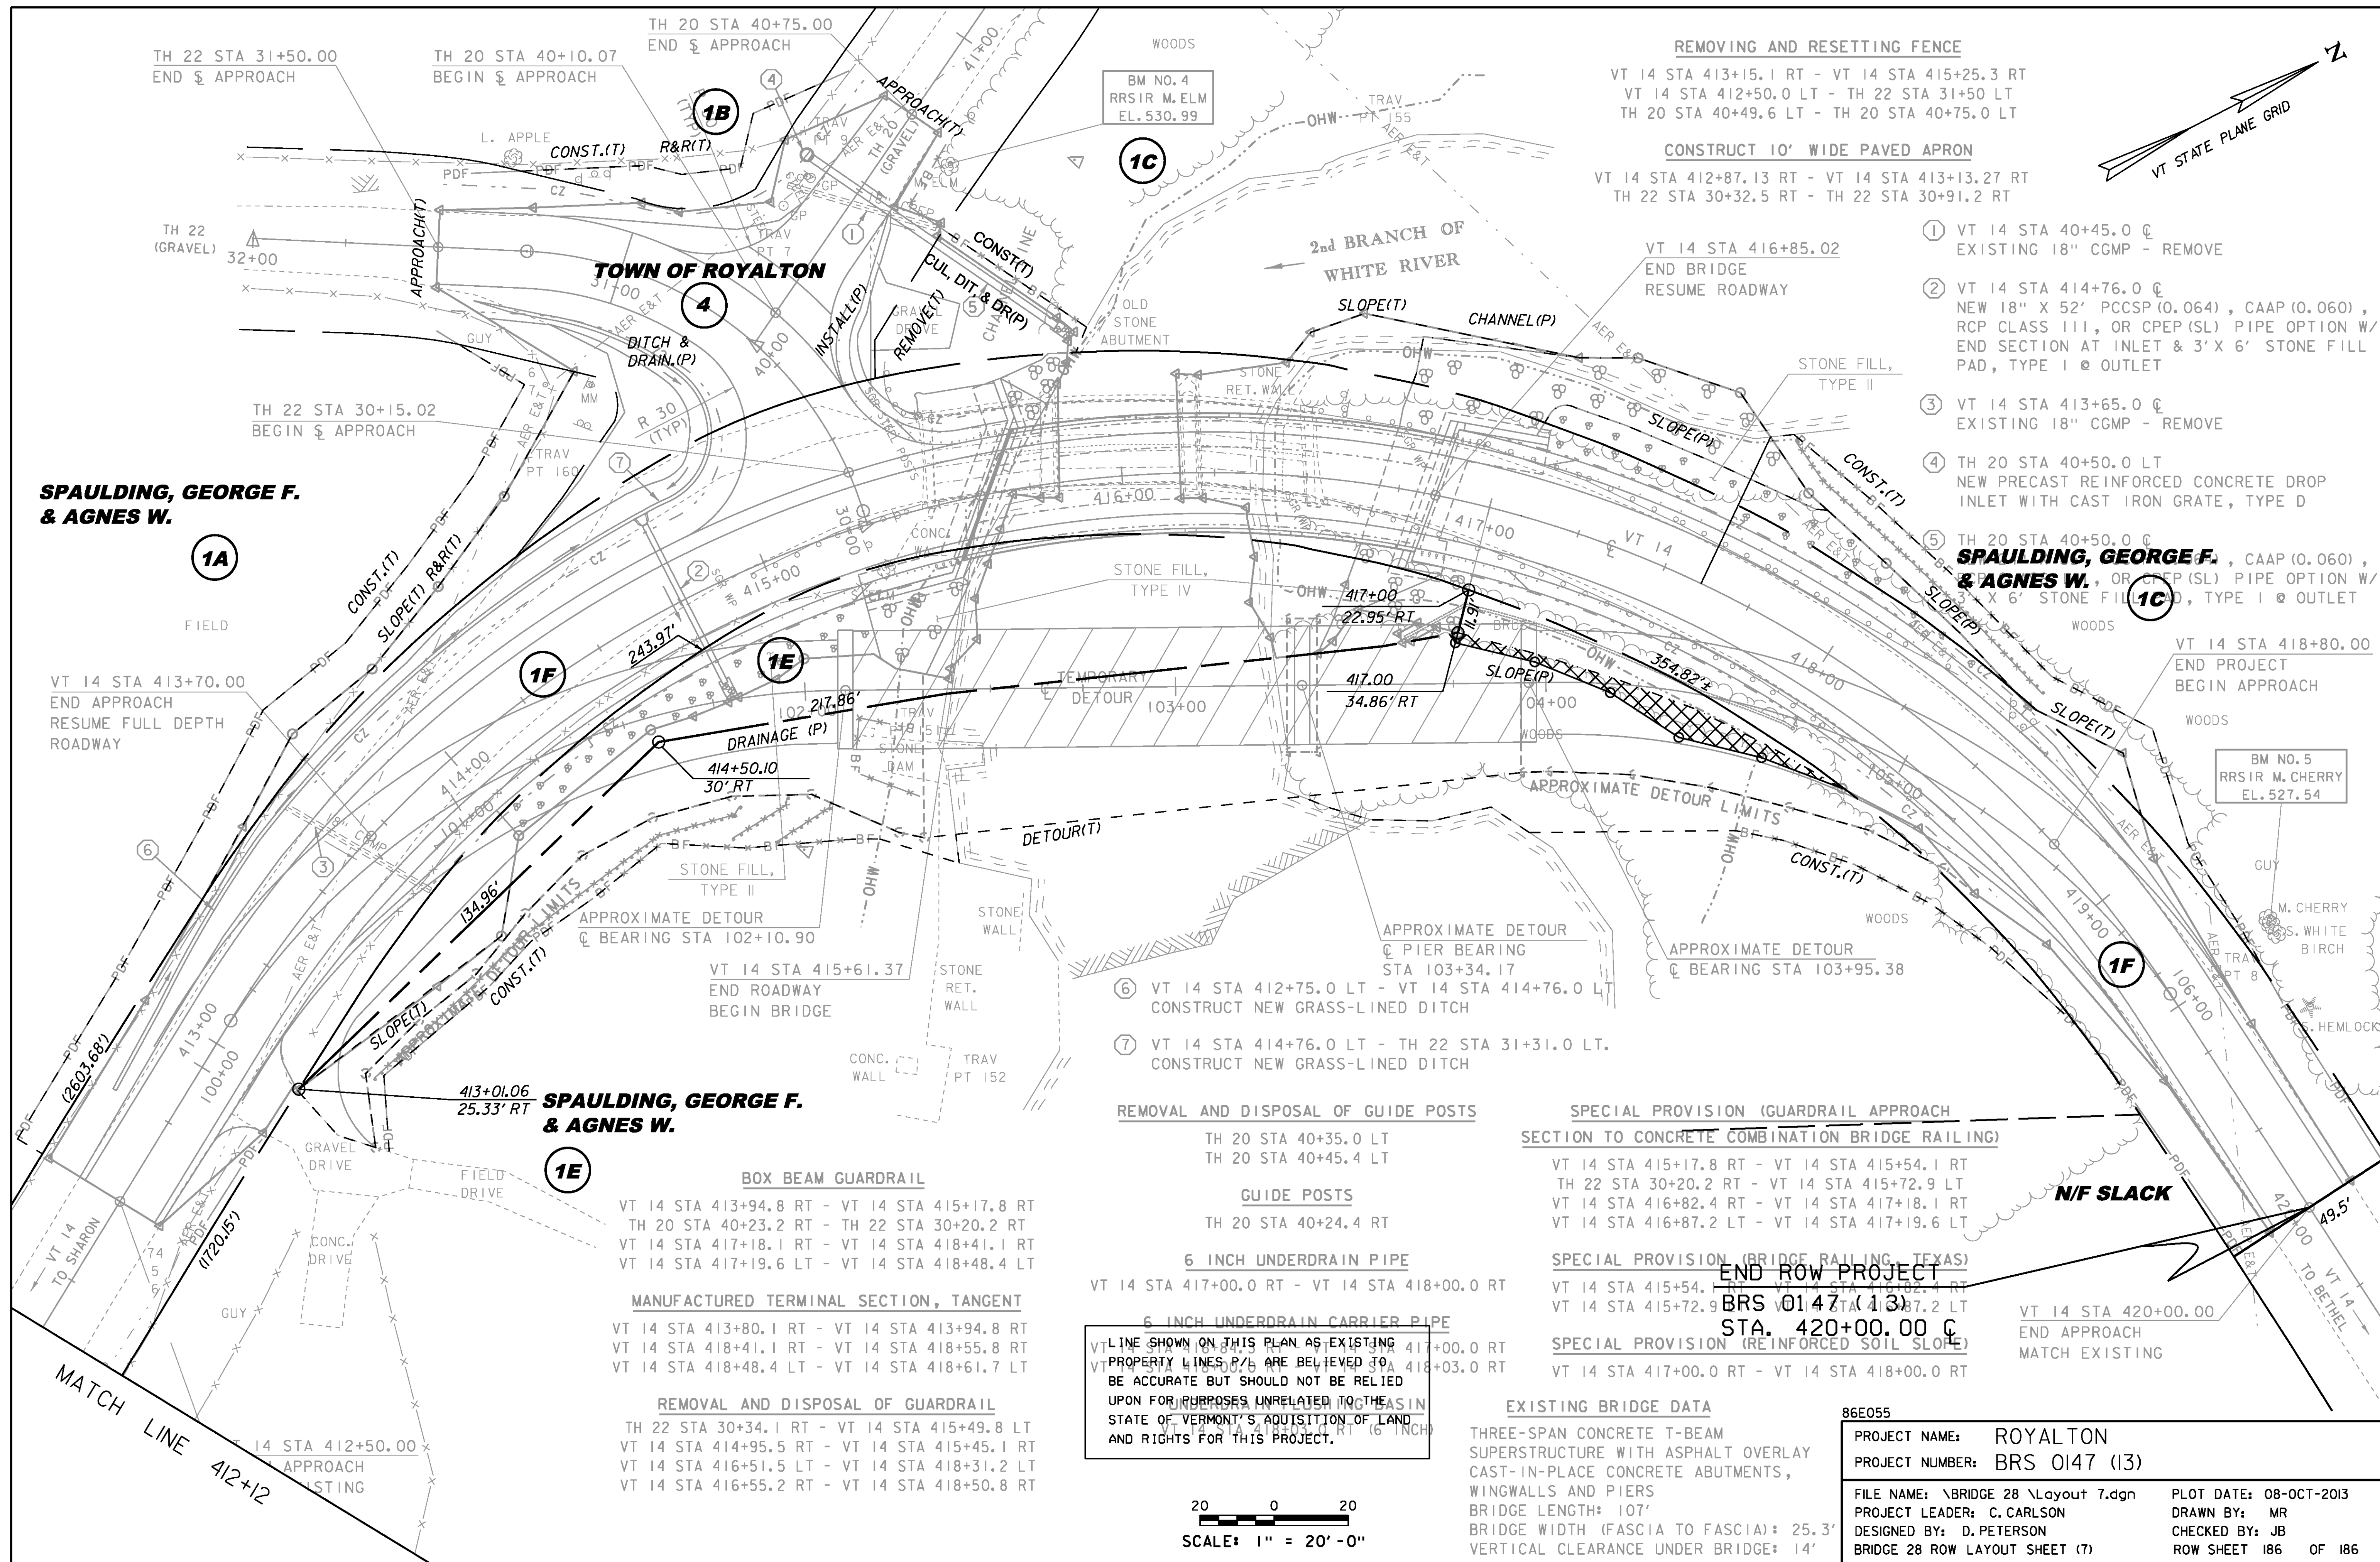

**REMOVING AND RESETTING FENCE**  
 VT 14 STA 413+15.1 RT - VT 14 STA 415+25.3 RT  
 VT 14 STA 412+50.0 LT - TH 22 STA 31+50 LT  
 TH 20 STA 40+49.6 LT - TH 20 STA 40+75.0 LT

**CONSTRUCT 10' WIDE PAVED APRON**  
 VT 14 STA 412+87.13 RT - VT 14 STA 413+13.27 RT  
 TH 22 STA 30+32.5 RT - TH 22 STA 30+91.2 RT

- ① VT 14 STA 40+45.0 C  
EXISTING 18" CGMP - REMOVE
- ② VT 14 STA 414+76.0 C  
NEW 18" X 52' PCCSP (0.064), CAAP (0.060),  
RCP CLASS III, OR CPEP (SL) PIPE OPTION W/  
END SECTION AT INLET & 3' X 6' STONE FILL  
PAD, TYPE I @ OUTLET
- ③ VT 14 STA 413+65.0 C  
EXISTING 18" CGMP - REMOVE
- ④ TH 20 STA 40+50.0 LT  
NEW PRECAST REINFORCED CONCRETE DROP  
INLET WITH CAST IRON GRATE, TYPE D
- ⑤ TH 20 STA 40+50.0 C  
**SPaulding, GEORGE F. & AGNES W.**, CAAP (0.060),  
OR CPEP (SL) PIPE OPTION W/  
3' X 6' STONE FILL PAD, TYPE I @ OUTLET

- ⑥ VT 14 STA 412+75.0 LT - VT 14 STA 414+76.0 LT  
CONSTRUCT NEW GRASS-LINED DITCH
- ⑦ VT 14 STA 414+76.0 LT - TH 22 STA 31+31.0 LT.  
CONSTRUCT NEW GRASS-LINED DITCH

**REMOVAL AND DISPOSAL OF GUIDE POSTS**  
 TH 20 STA 40+35.0 LT  
 TH 20 STA 40+45.4 LT

**SPECIAL PROVISION (GUARDRAIL APPROACH SECTION TO CONCRETE COMBINATION BRIDGE RAILING)**  
 VT 14 STA 415+17.8 RT - VT 14 STA 415+54.1 RT  
 TH 22 STA 30+20.2 RT - VT 14 STA 415+72.9 LT  
 VT 14 STA 416+82.4 RT - VT 14 STA 417+18.1 RT  
 VT 14 STA 416+87.2 LT - VT 14 STA 417+19.6 LT

**GUIDE POSTS**  
 TH 20 STA 40+24.4 RT

**6 INCH UNDERDRAIN PIPE**  
 VT 14 STA 417+00.0 RT - VT 14 STA 418+00.0 RT


**6 INCH UNDERDRAIN CARRIER PIPE**  
 VT 14 STA 417+00.0 RT - VT 14 STA 418+00.0 RT

LINE SHOWN ON THIS PLAN AS EXISTING  
 PROPERTY LINES P/L ARE BELIEVED TO  
 BE ACCURATE BUT SHOULD NOT BE RELIED  
 UPON FOR PURPOSES UNRELATED TO THE  
 STATE OF VERMONT'S ACQUISITION OF LAND  
 AND RIGHTS FOR THIS PROJECT.

**EXISTING BRIDGE DATA**  
 THREE-SPAN CONCRETE T-BEAM  
 SUPERSTRUCTURE WITH ASPHALT OVERLAY  
 CAST-IN-PLACE CONCRETE ABUTMENTS,  
 WINGWALLS AND PIERS  
 BRIDGE LENGTH: 107'  
 BRIDGE WIDTH (FASCIA TO FASCIA): 25.3'  
 VERTICAL CLEARANCE UNDER BRIDGE: 14'


86E055  
**PROJECT NAME: ROYALTON**  
**PROJECT NUMBER: BRS 0147 (13)**  
 FILE NAME: \BRIDGE 28 \Layout 7.dgn  
 PROJECT LEADER: C. CARLSON  
 DESIGNED BY: D. PETERSON  
 BRIDGE 28 ROW LAYOUT SHEET (7)

PLOT DATE: 08-OCT-2013  
 DRAWN BY: MR  
 CHECKED BY: JB  
 ROW SHEET 186 OF 186

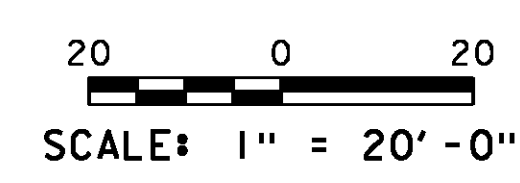


**CONCRETE GENERAL NOTES**

- ALL EXPOSED EDGES OF CONCRETE SHALL BE CHAMFERED 1" x 1"

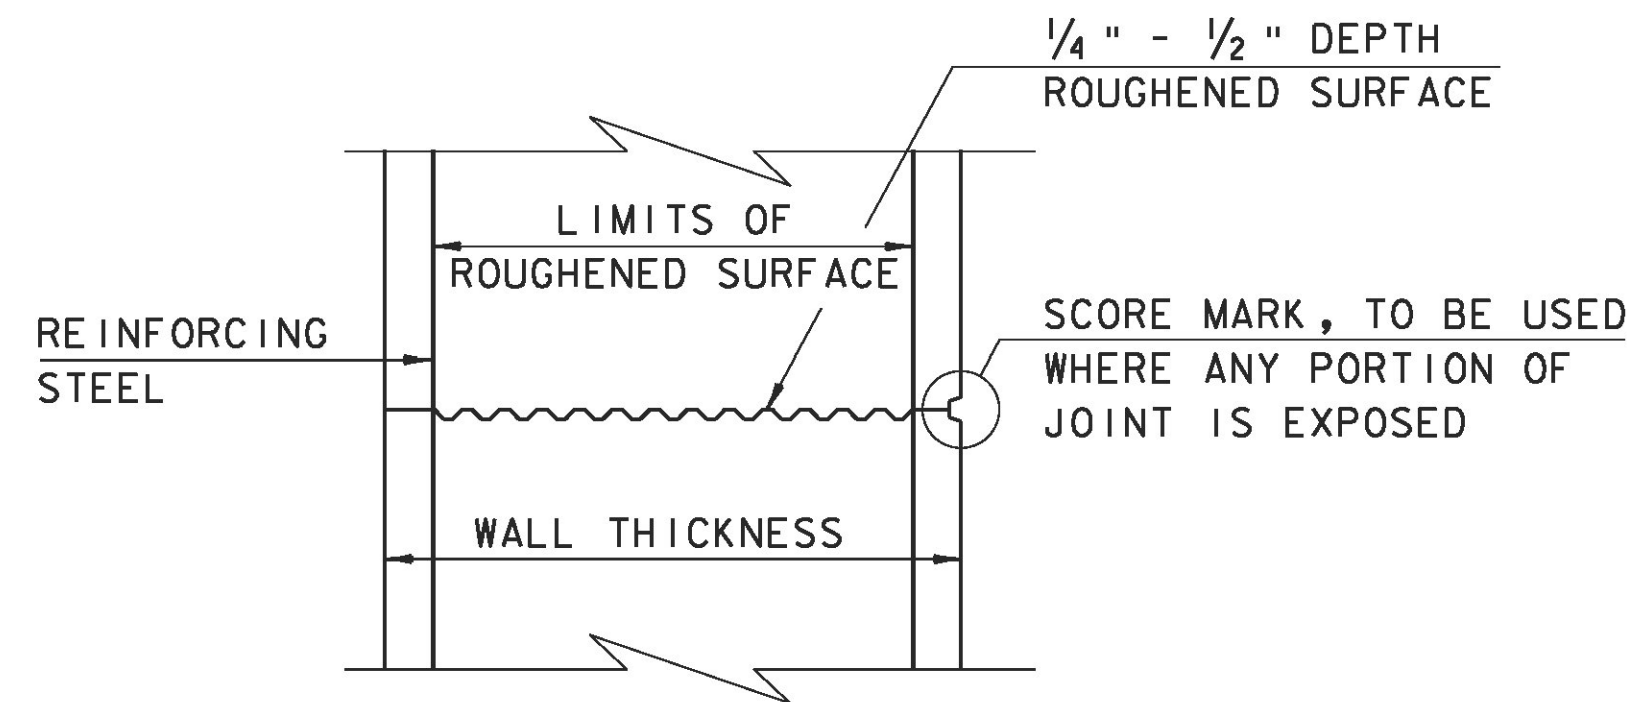


**TYPICAL HORIZONTAL CONSTRUCTION JOINT**  
(NOT TO SCALE)


- THE SURFACE OF THE CONCRETE CONSTRUCTION JOINTS SHALL BE CLEANED AND FREE OF LAITANCE.
- IMMEDIATELY BEFORE NEW CONCRETE IS PLACED, ALL CONSTRUCTION JOINTS SHALL BE WETTED AND STANDING WATER REMOVED.

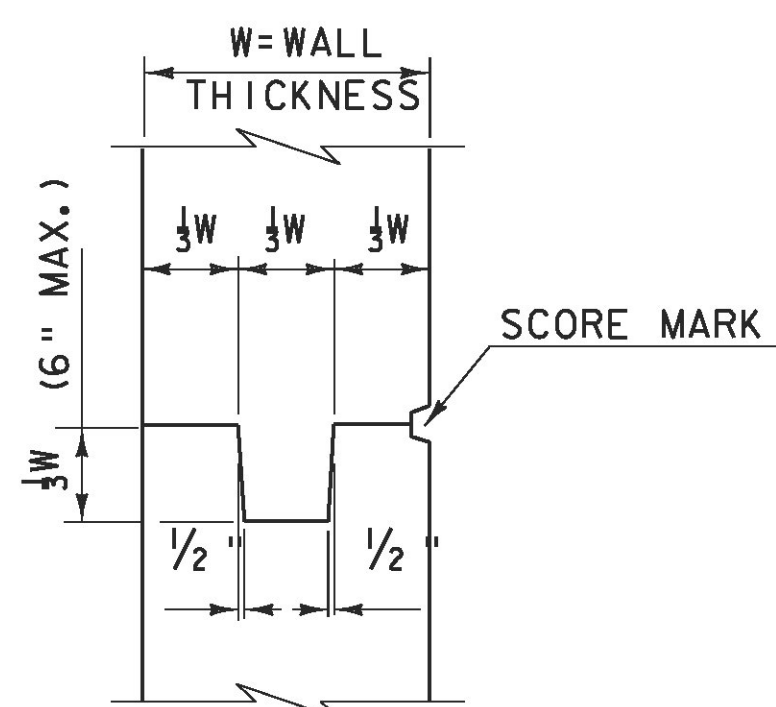


**TYPICAL CONCRETE CONSTRUCTION JOINT**  
(NOT TO SCALE)

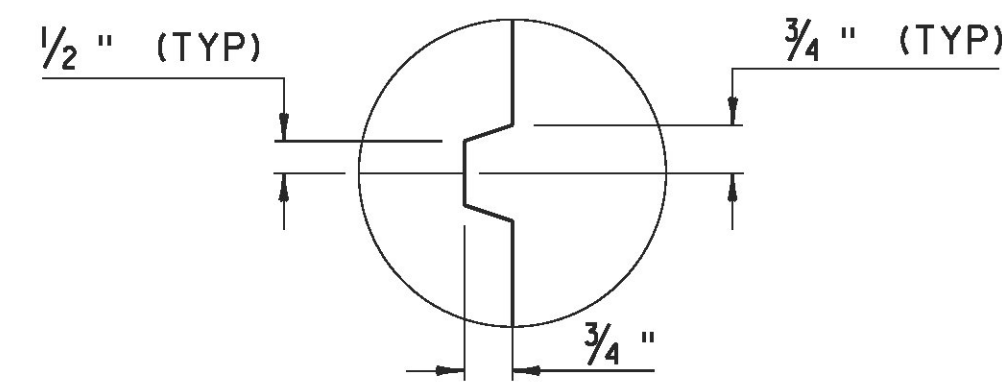

**SCORE MARK DETAIL**  
(NOT TO SCALE)

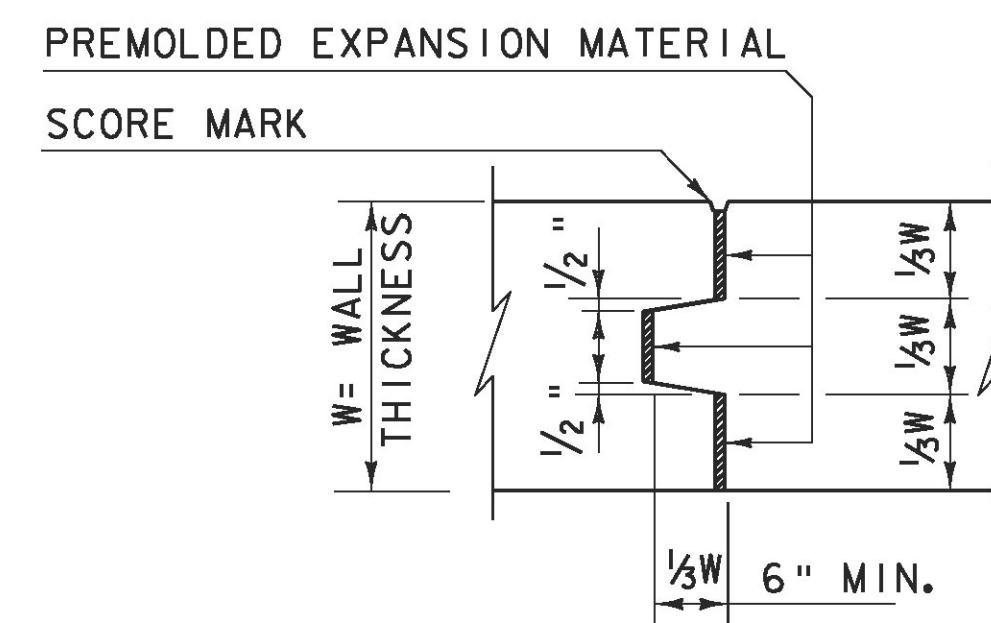

**TYPICAL CONCRETE EXPANSION JOINT**  
(NOT TO SCALE)

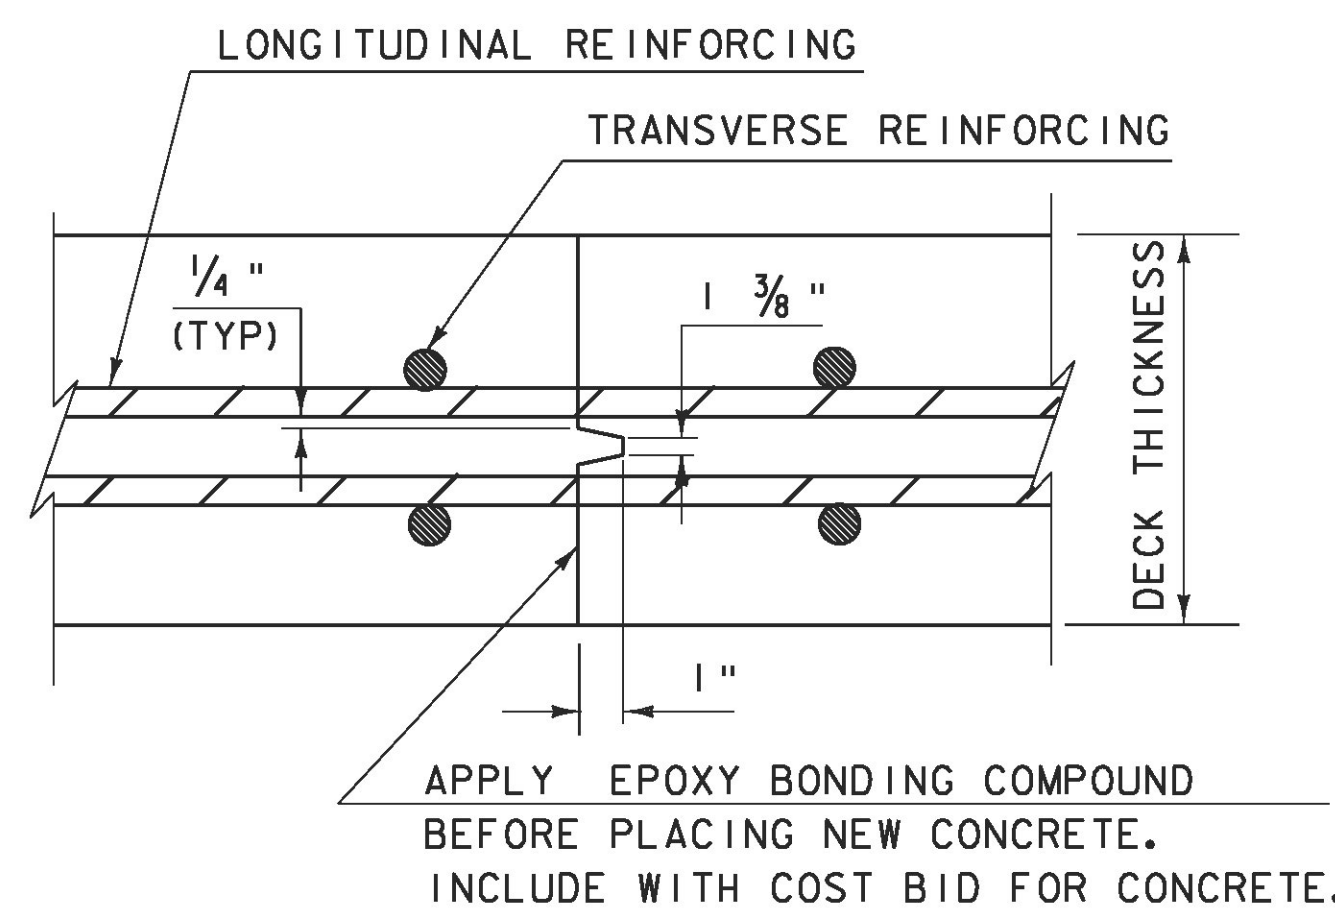


**TRANSVERSE BRIDGE SLAB CONSTRUCTION JOINT DETAILS**  
(NOT TO SCALE)



**P.V.C. WATERSTOP FOR CONSTRUCTION JOINTS**  
(NOT TO SCALE)

PAYMENT FOR THE P.V.C. WATERSTOP SHALL BE INCIDENTAL TO THE UNIT BID PRICE FOR THE ADJACENT CONCRETE.


OTHER CONFIGURATIONS OF WATERSTOP MAY BE USED UPON APPROVAL OF THE ENGINEER.

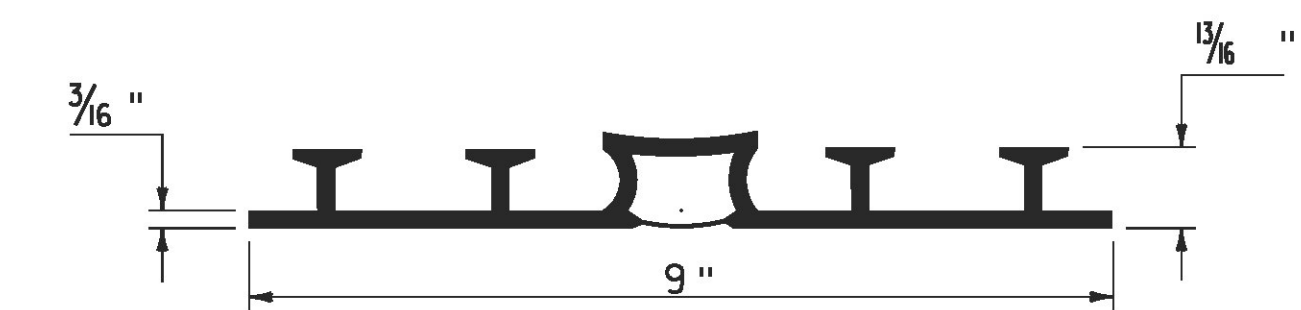

**P.V.C. WATERSTOP FOR EXPANSION JOINTS**  
(NOT TO SCALE)

PAYMENT FOR THE P.V.C. WATERSTOP SHALL BE INCIDENTAL TO THE UNIT BID PRICE FOR THE ADJACENT CONCRETE.


OTHER CONFIGURATIONS OF WATERSTOP MAY BE USED UPON APPROVAL OF THE ENGINEER.

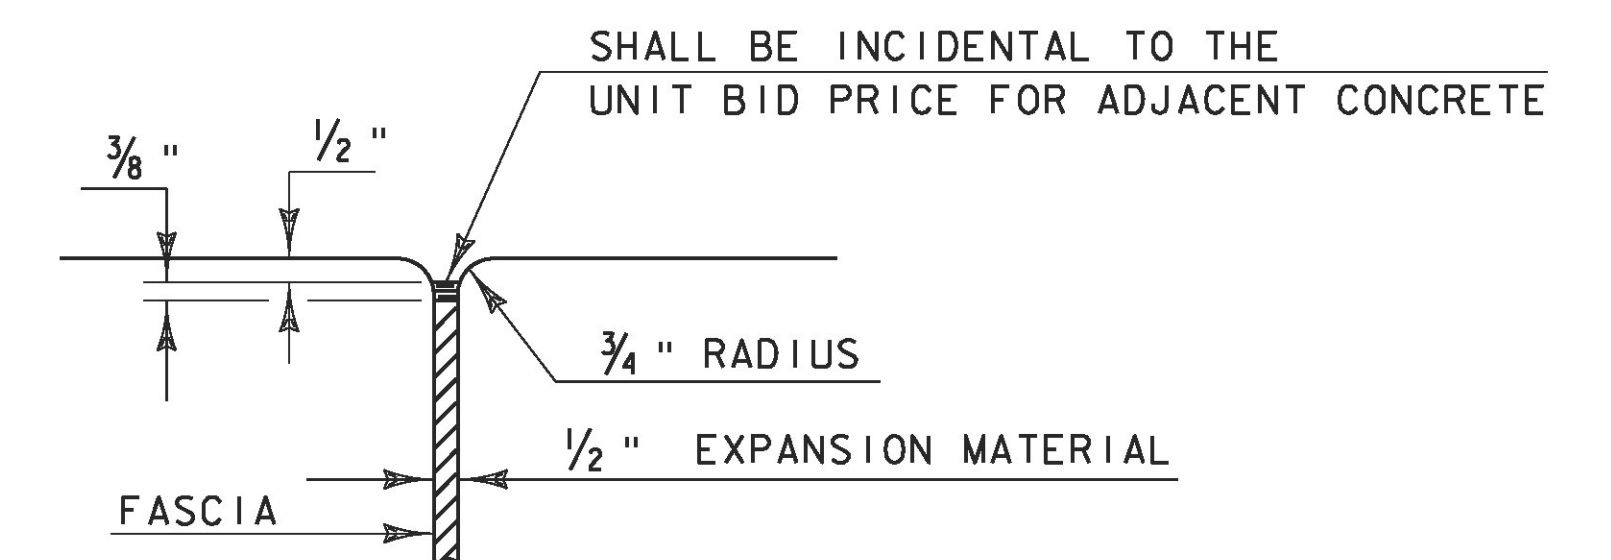


**JOINT BETWEEN FASCIA AND WINGWALL**  
(NOT TO SCALE)

REVISIONS	
MAY 7, 2010	APPROVED FOR USE BY VAOT STRUCTURES SECTION


**CONCRETE  
DETAILS AND NOTES**

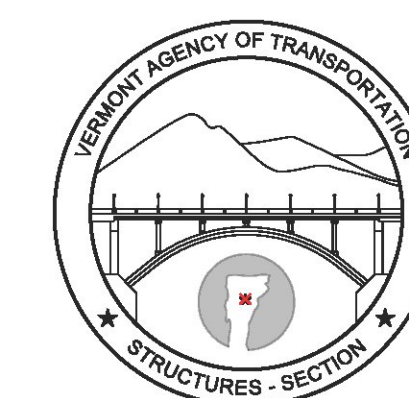

**STRUCTURES  
DETAIL  
SD-5 01.00**

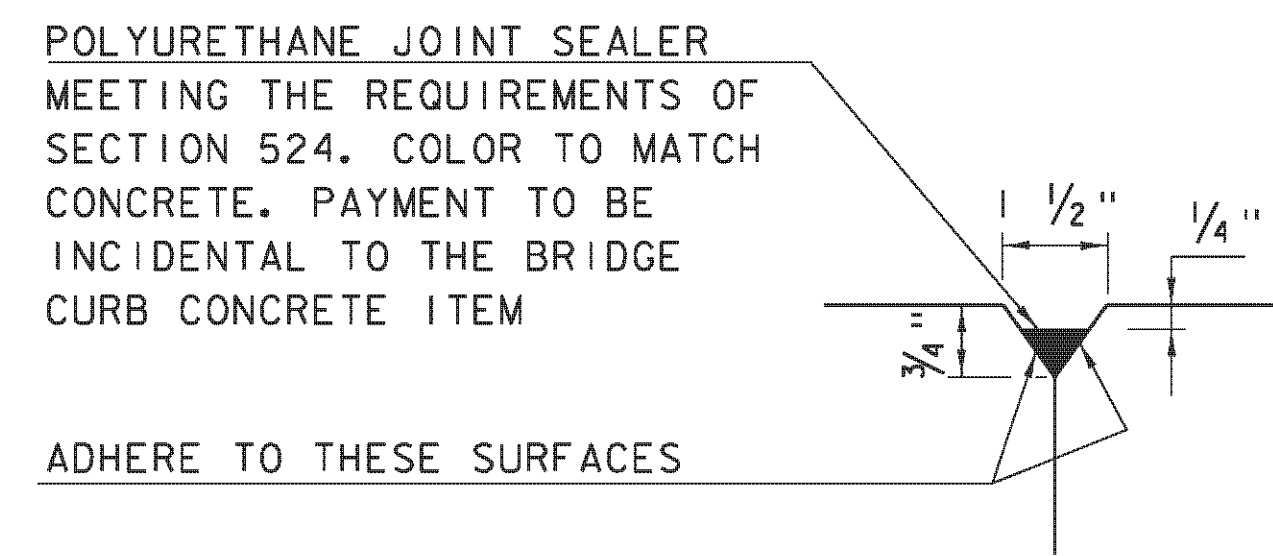


DETAIL "B"  
(NOT TO SCALE)

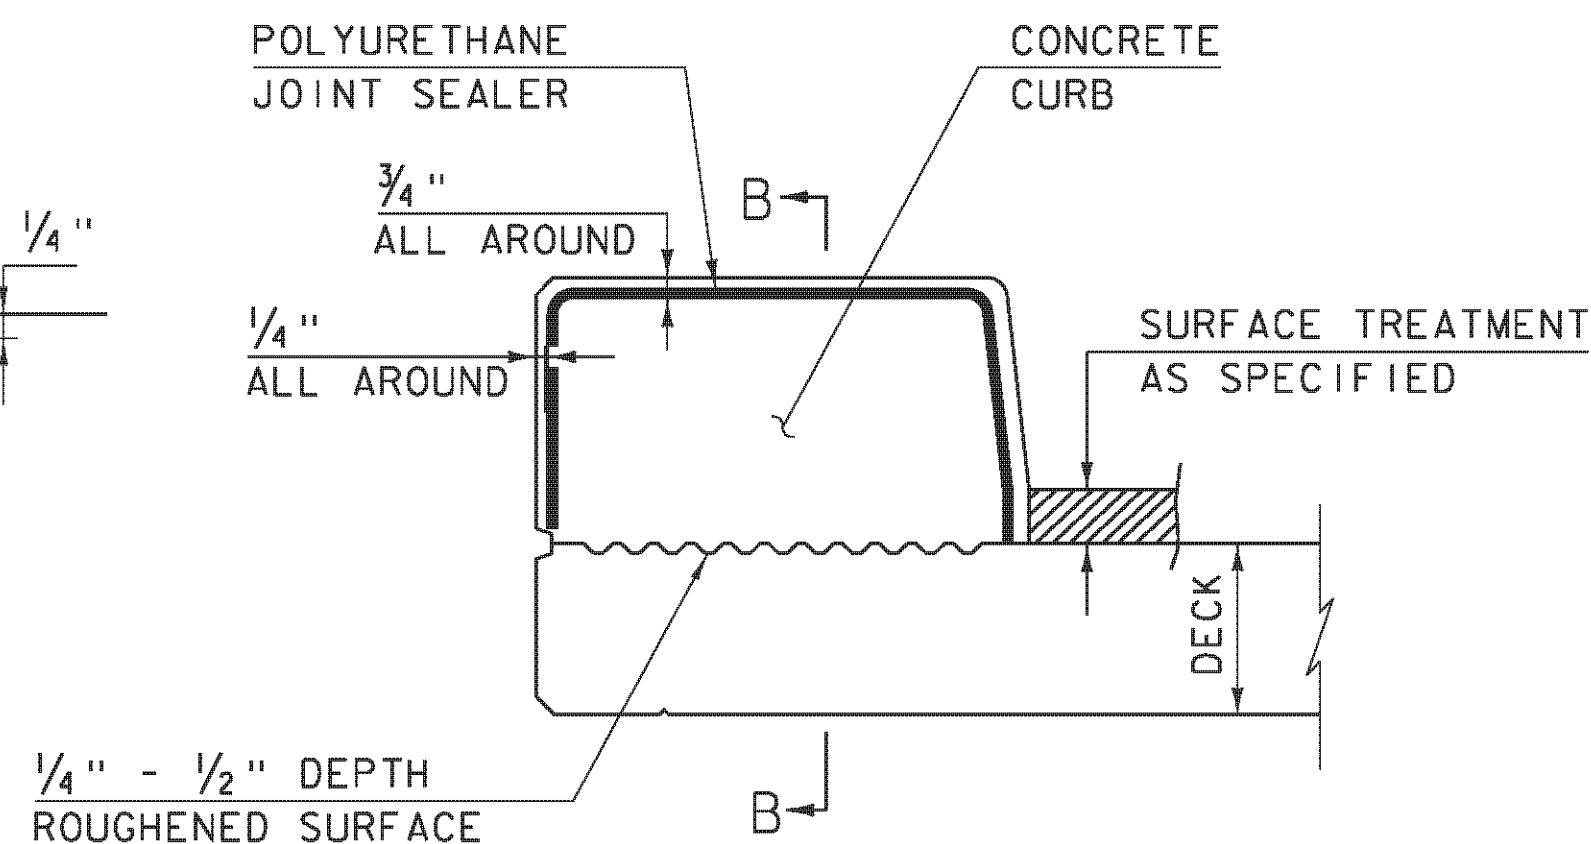


CONCRETE CURB JOINT SECTION  
(NOT TO SCALE)


1. SEE TYPICAL HORIZONTAL CONSTRUCTION JOINT DETAIL FOR ADDITIONAL INFORMATION

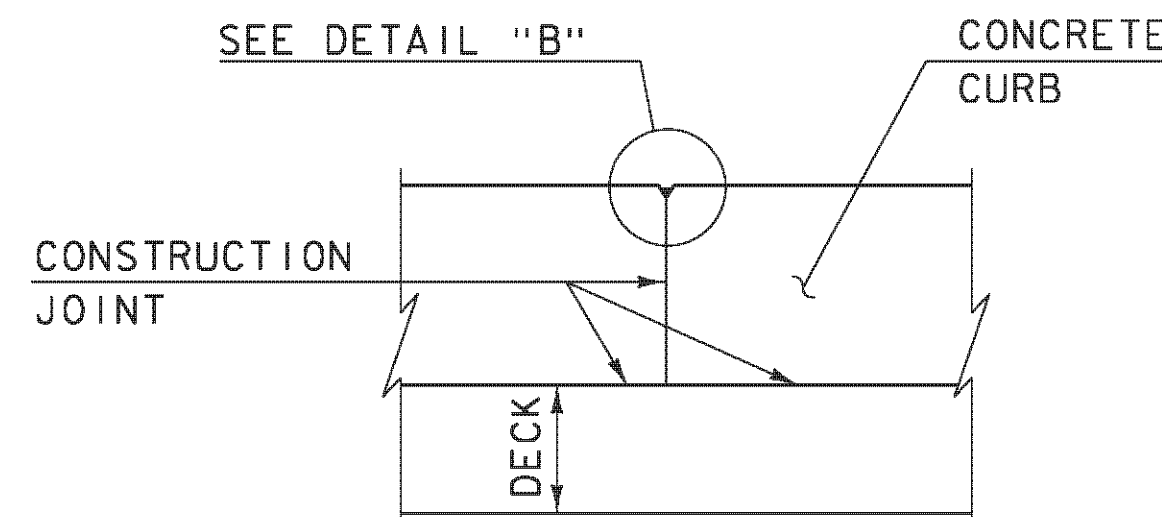

SECTION B - B  
(NOT TO SCALE)

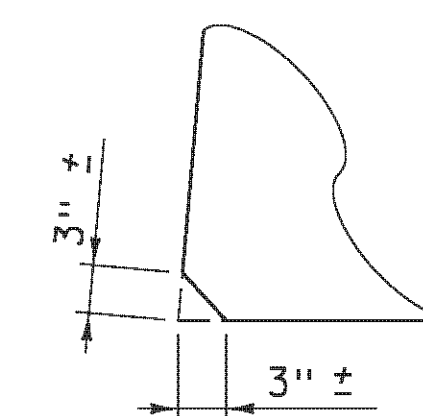


ACUTE ANGLE  
CLIP DETAIL  
(NOT TO SCALE)

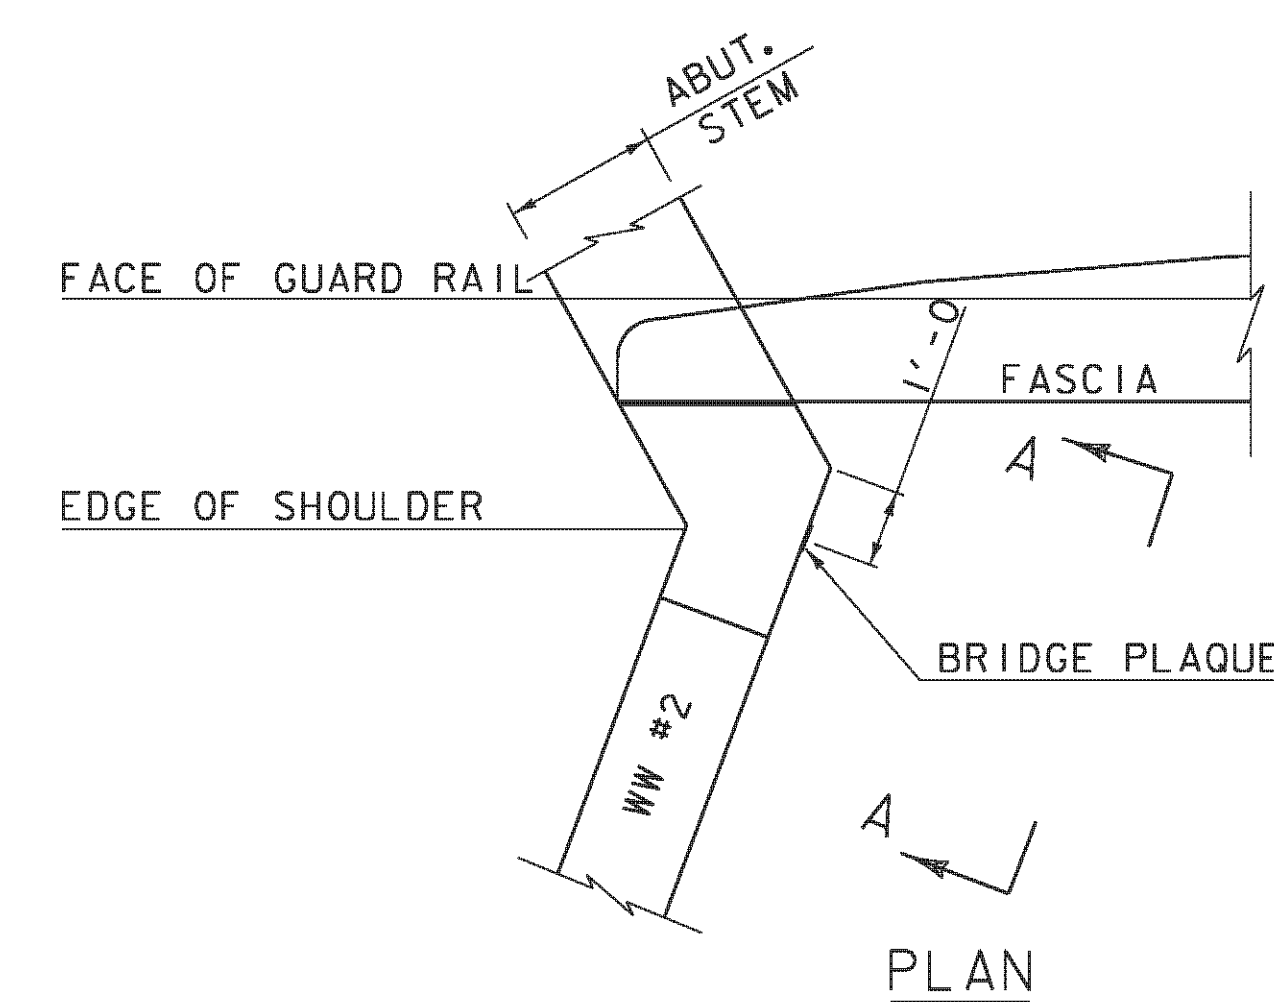


VIEW "A - A"

BRIDGE PLAQUE  
(NOT TO SCALE)

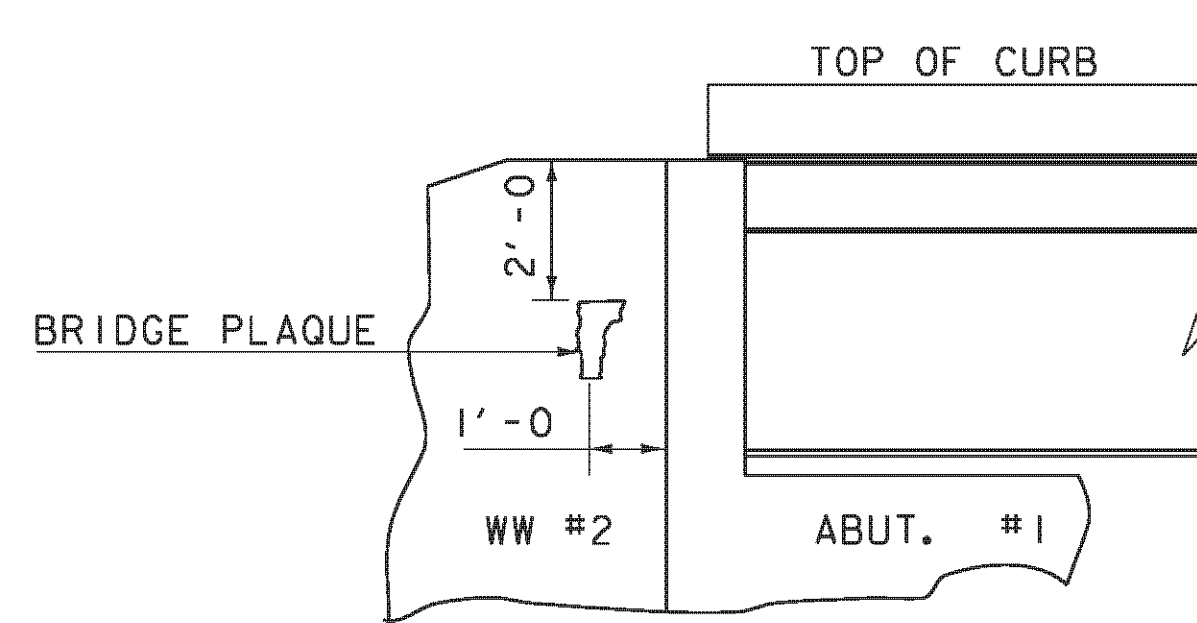


CONCRETE CURB JOINT NOTES

1. CONCRETE CURBS MAY BE PLACED IN ONE CONTINUOUS OPERATION IF AN APPROVED SHRINKAGE REDUCING ADMIXTURE LISTED IN THE SPECIAL PROVISIONS IS USED WITH THE CONCRETE MIX DESIGN. PAYMENT FOR THE SHRINKAGE REDUCING ADMIXTURE WILL BE INCIDENTAL TO THE BRIDGE CURB CONCRETE ITEM.
2. IF THE CONTRACTOR CHOOSES NOT TO USE AN APPROVED SHRINKAGE REDUCING ADMIXTURE, THE CURBS SHALL BE CONSTRUCTED WITH CONSTRUCTION JOINTS SPACED AT A MAXIMUM OF 15'-0" CENTER TO CENTER AND 2'-0" MINIMUM FROM THE CENTER OF NEAREST BRIDGE RAILING POST.
3. ON MULTI-SPAN CONTINUOUS SUPERSTRUCTURES, REGARDLESS OF WHETHER APPROVED SHRINKAGE REDUCING ADMIXTURE IS USED, CURB JOINTS SHALL BE LOCATED OVER THE CENTERLINE OF PIERS AND 7'-0" EACH SIDE OF THE CENTERLINE OF EACH PIER.
4. WHEN CURB JOINTS ARE USED THE CURBS SHALL BE PLACED IN ALTERNATE SECTIONS WITH A MINIMUM OF 48 HOUR DELAY BETWEEN ADJACENT PLACEMENTS.
5. LONGITUDINAL REINFORCING SHALL BE CONTINUOUS THROUGH CURB CONSTRUCTION JOINTS. CURB STIRRUP BARS SHALL BE TURNED AS NECESSARY TO MAINTAIN COVER IN THE FLARED CURB ENDS.
6. THE JOINT SPACING AND DETAILS SHOWN SHALL APPLY TO SIDEWALKS WHEN SHOWN IN THE PLANS.

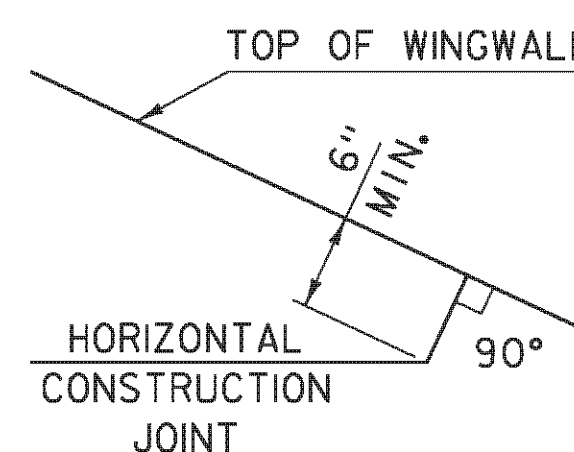

HORIZONTAL WINGWALL  
CONSTRUCTION JOINT  
(NOT TO SCALE)

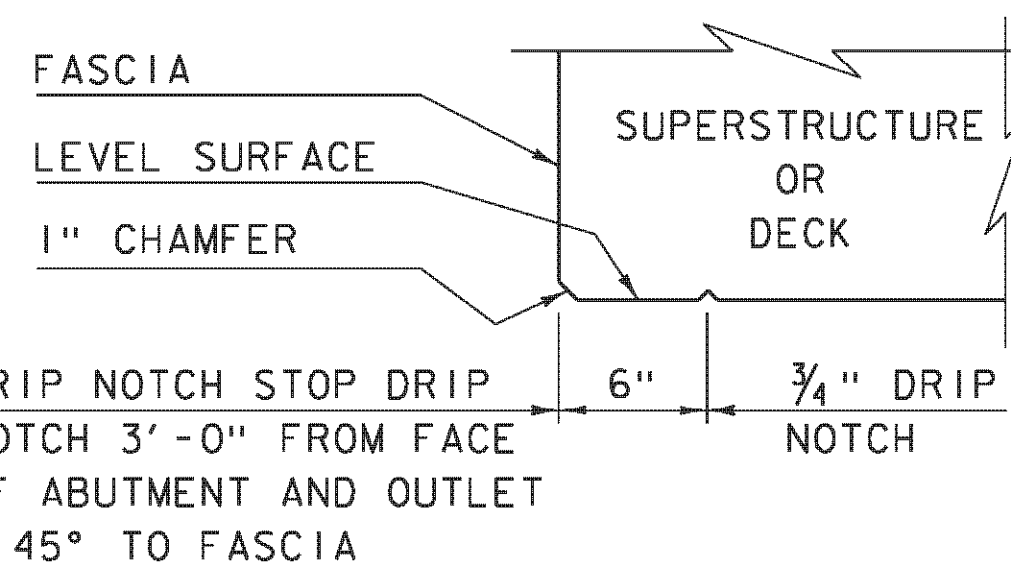

DRIP NOTCH DETAIL  
(NOT TO SCALE)


THE BRIDGE PLAQUE WILL BE SUPPLIED BY THE AGENCY OF TRANSPORTATION AND SHALL BE INSTALLED BY THE CONTRACTOR AT ABUTMENT #1 ON THE RIGHT SIDE AS SHOWN OR AS DIRECTED BY THE ENGINEER.

PAYMENT FOR INSTALLATION OF THE BRIDGE PLAQUE SHALL BE INCIDENTAL TO THE ADJACENT CONCRETE.


REVISIONS

MAY 7, 2010	APPROVED FOR USE BY VAOT STRUCTURES SECTION
JUNE 4, 2010	MODIFIED AND ADDED TWO DETAILS
OCTOBER 10, 2012	MODIFIED HORZ. JOINT WINGWALL ADD 6" MIN. DIMENSION

CONCRETE  
DETAILS AND NOTES

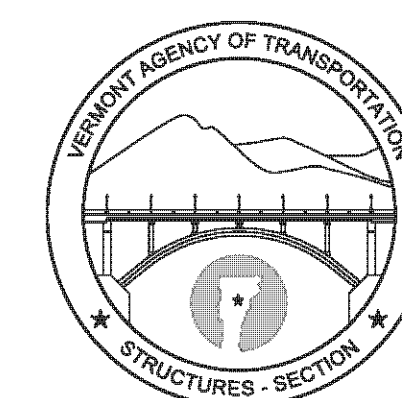


STRUCTURES  
DETAIL  
SD-502.00

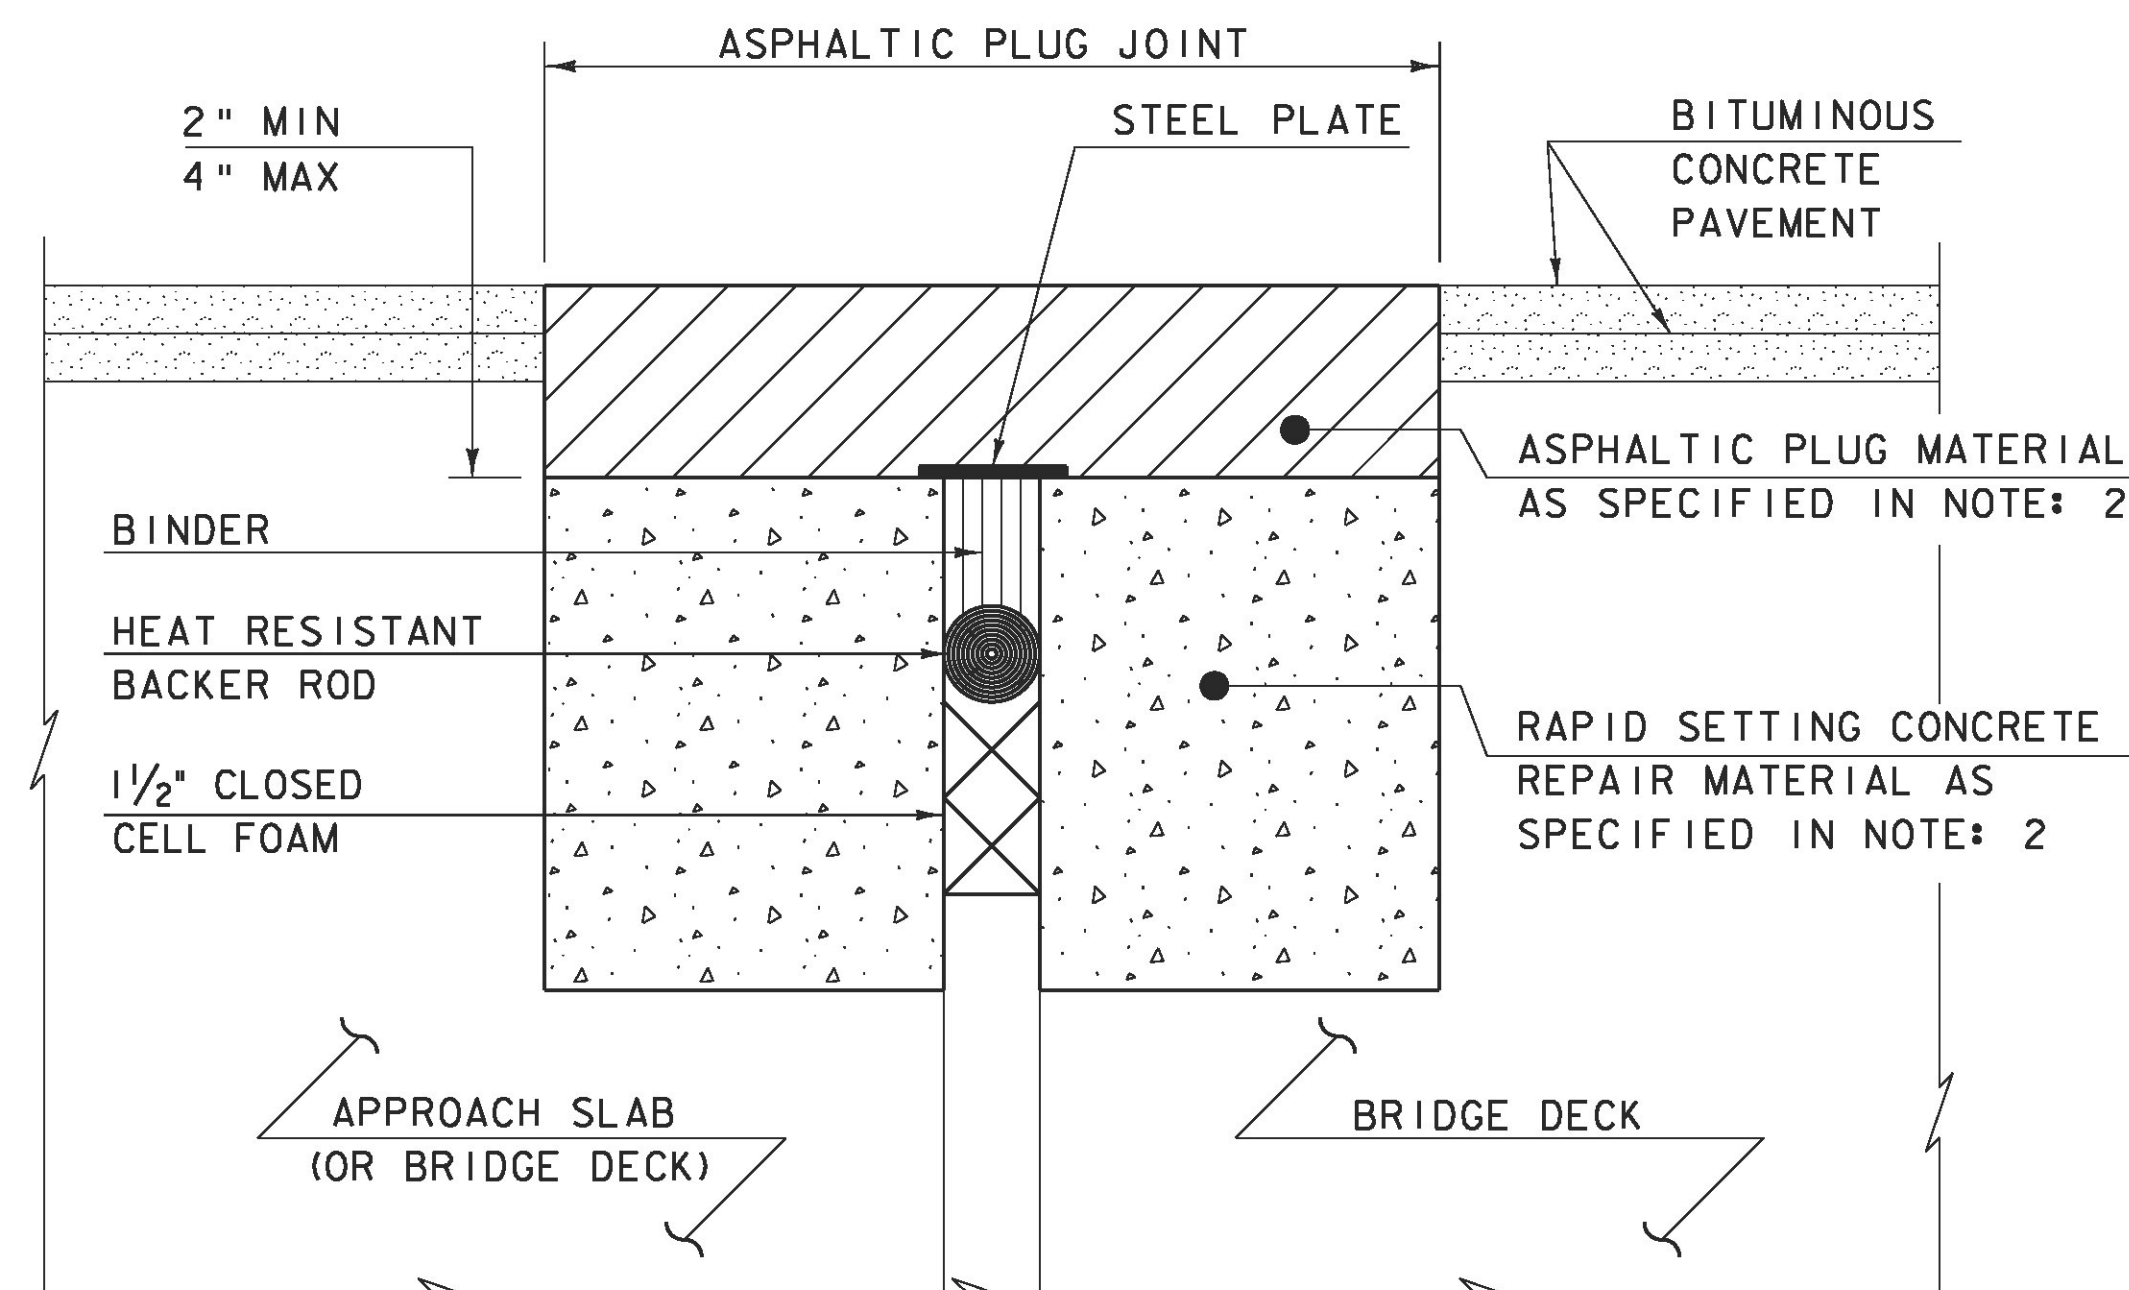

**ASPHALTIC PLUG-JOINT DETAIL - REHAB**

NOTES: (NOT TO SCALE)

1. THE CONTRACTOR SHALL REMOVE ALL ASPHALTIC PLUG JOINT MATERIAL AND DETERIORATED CONCRETE AS DIRECTED BY THE ENGINEER. REMOVAL OF THE FIRST 4 INCHES OF MATERIAL SHALL BE INCLUDED IN THE BID PRICE FOR ITEM 516.10 BRIDGE EXPANSION JOINT, ASPHALTIC PLUG. ANY REMOVAL OF MATERIAL GREATER THAN 4 INCHES SHALL BE INCLUDED IN THE BID PRICE OF ITEM 580.20 RAPID SETTING CONCRETE REPAIR MATERIAL WITH COURSE AGGREGATE.
2. THE CONTRACTOR SHALL REPLACE REMOVED MATERIAL THAT IS LESS THAN 4" FROM FINISHED GRADE WITH ASPHALTIC PLUG JOINT MATERIAL MEETING THE REQUIREMENTS OF SUBSECTION 707.15. ALL REMOVED MATERIAL THAT IS GREATER THAN 4 INCHES FROM FINISHED GRADE SHALL BE REPLACED WITH RAPID SETTING CONCRETE REPAIR MATERIAL WITH COURSE AGGREGATE MEETING THE REQUIREMENTS OF SUBSECTION 780.04.
3. REINFORCING STEEL NOT SHOWN FOR CLARITY.

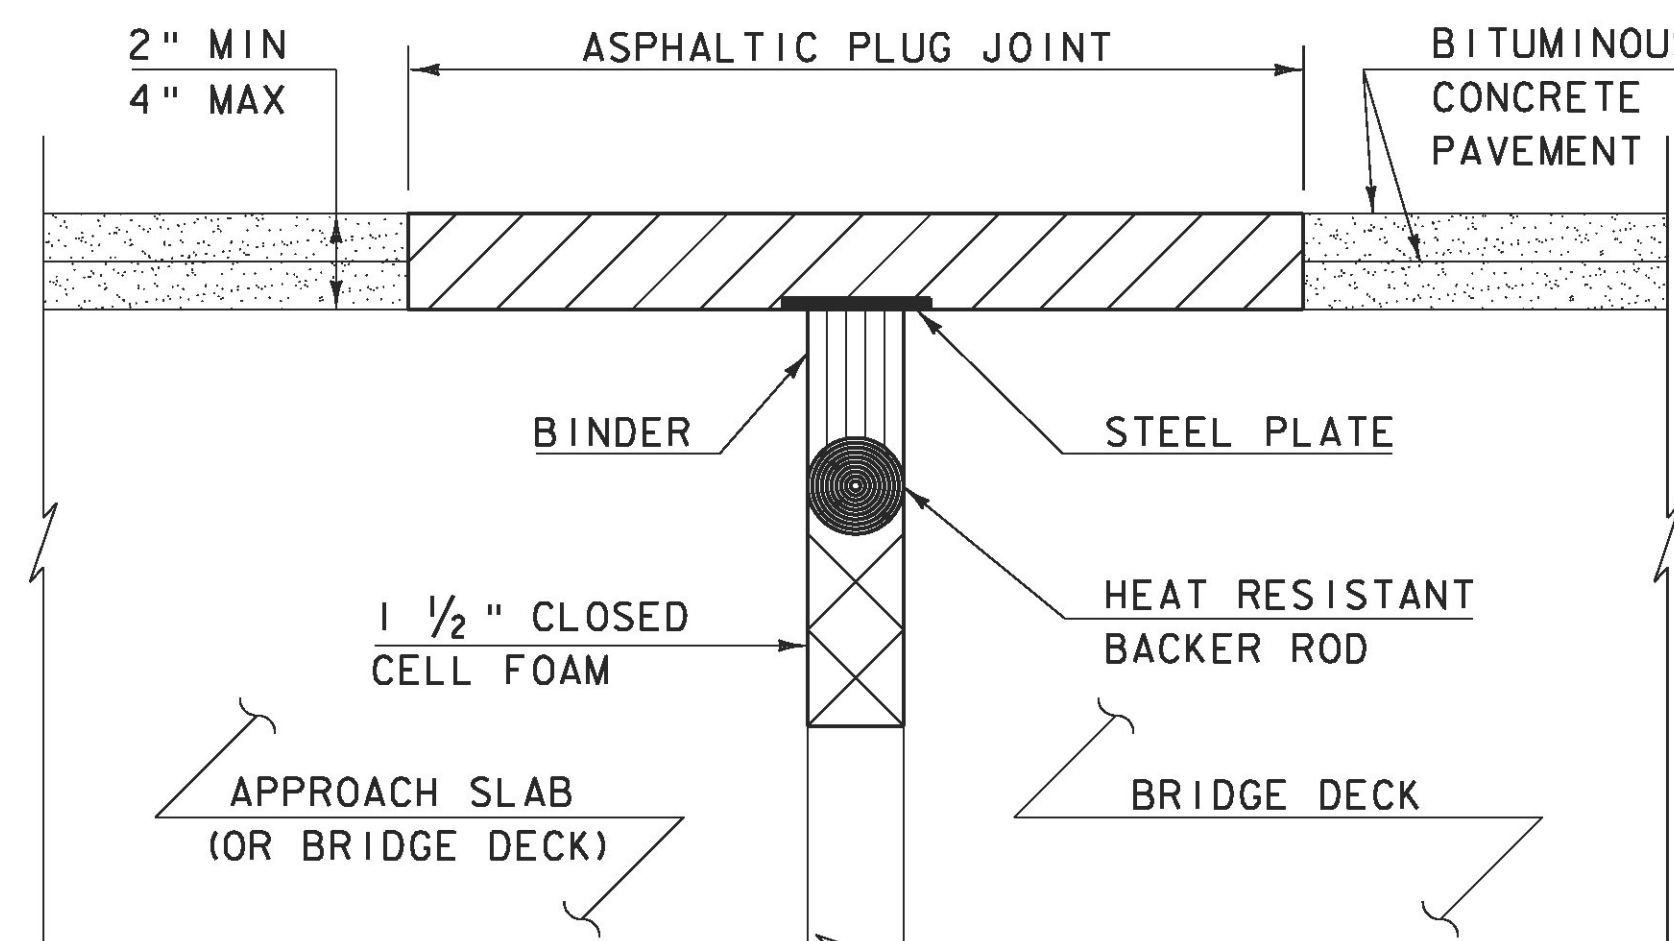

**ASPHALTIC PLUG-JOINT DETAIL - NEW**

(NOT TO SCALE)

**ASPHALTIC PLUG JOINT NOTES**

**INSTALLATION:**

1. LOCATE THE JOINT CENTRALLY OVER THE DECK OVERLAY EXPANSION GAP OR FIXED JOINT, MARKED OUT TO THE MANUFACTURER'S RECOMMENDED WIDTH.
2. REMOVE THE BITUMINOUS CONCRETE PAVEMENT FULL DEPTH AS SHOWN ON THE PLANS. THE PAVEMENT SHALL BE DRY AND SAW CUT TO THE LIMITS REQUIRED TO PLACE THE JOINT. A PNEUMATIC HAMMER AND CHISEL MAY BE USED ADJACENT TO THE CURB ONLY WHEN SAW CUTTING IS NOT POSSIBLE.
3. BLAST CLEAN THE JOINT AREA OF DEBRIS, ASPHALT AND SHEET MEMBRANE. THOROUGHLY DRY THE JOINT AREA WITH COMPRESSED AIR PRIOR TO APPLYING BINDER MATERIAL.
4. REPAIR MATERIAL GREATER THAN 4 INCHES FROM FINISHED GRADE WITH RAPID SETTING CONCRETE REPAIR MATERIAL WITH COURSE AGGREGATE MEETING THE REQUIREMENTS OF SUBSECTION 780.04.
5. PLACE PROPERLY SIZED HEAT RESISTANT BACKER ROD IN THE MOVEMENT GAP ALLOWING FOR 1" +/- OF BINDER ABOVE THE ROD.
6. HEAT AND PLACE THE BINDER MATERIAL AS RECOMMENDED BY THE MANUFACTURER.
7. PLACE 1/4" THICK BY 8" WIDE SECTIONS OF STEEL PLATE OVER THE CENTER OF THE MOVEMENT GAP. SECURE THE PLATES FROM MOVING BY INSERTING LOCATING PINS THROUGH THE PRE-STAMPED HOLES INTO BACKER ROD AND COVER WITH HOT BINDER. THE STEEL PLATES MAY BE OMITTED WHERE THE ENGINEER DETERMINES THAT THE APPROACH SLAB OR BRIDGE DECK WILL PROVIDE INADEQUATE SUPPORT AND WHERE VERTICAL MOVEMENT OF THE PLATES MIGHT OCCUR.
8. HEAT AND MIX THE BINDER MATERIAL AND AGGREGATE AS RECOMMENDED BY THE MANUFACTURER.
9. INSTALLATION OF MATERIAL, COMPACTION, AND TOP COATING SHALL BE AS RECOMMENDED BY THE MANUFACTURER.
10. IMMEDIATELY AFTER TOP COATING, CAST AN ANTI-SKID MATERIAL OVER THE JOINT TO REDUCE THE RISK OF TRACKING.
11. ONCE THE JOINT REACHES 82 DEG C (180 DEG F) +/-, WATER MAY BE USED TO EXPEDITE THE COOLING PROCESS.
12. PROTECT JOINT FROM TRAFFIC UNTIL THE MATERIAL HAS COOLED TO 51 DEG C (125 DEG F) +/-.

**WEATHER LIMITATIONS**


APPLY BINDER MATERIAL ONLY WHEN THE FOLLOWING CONDITIONS PREVAIL OR AS RECOMMENDED BY THE MANUFACTURER:

1. THE AMBIENT AIR TEMPERATURE IS AT LEAST 10 DEG C (50 DEG F) AND RISING.
2. THE ROAD SURFACE IS DRY.
3. WEATHER CONDITIONS OR OTHER CONDITIONS ARE FAVORABLE AND ARE EXPECTED TO REMAIN SO FOR THE PERFORMANCE OF SATISFACTORY WORK.

**REVISIONS**


MAY 7, 2010 APPROVED FOR USE BY VAOT STRUCTURES SECTION

**BRIDGE JOINT  
ASPHALTIC PLUG**

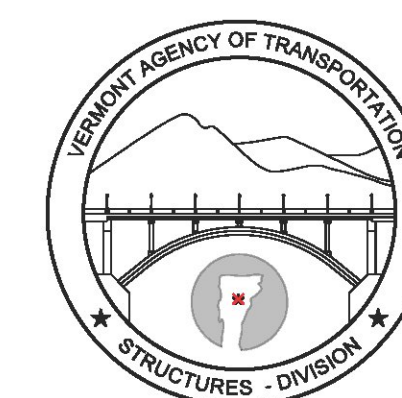


**STRUCTURES  
DETAIL**

**SD-516.10**

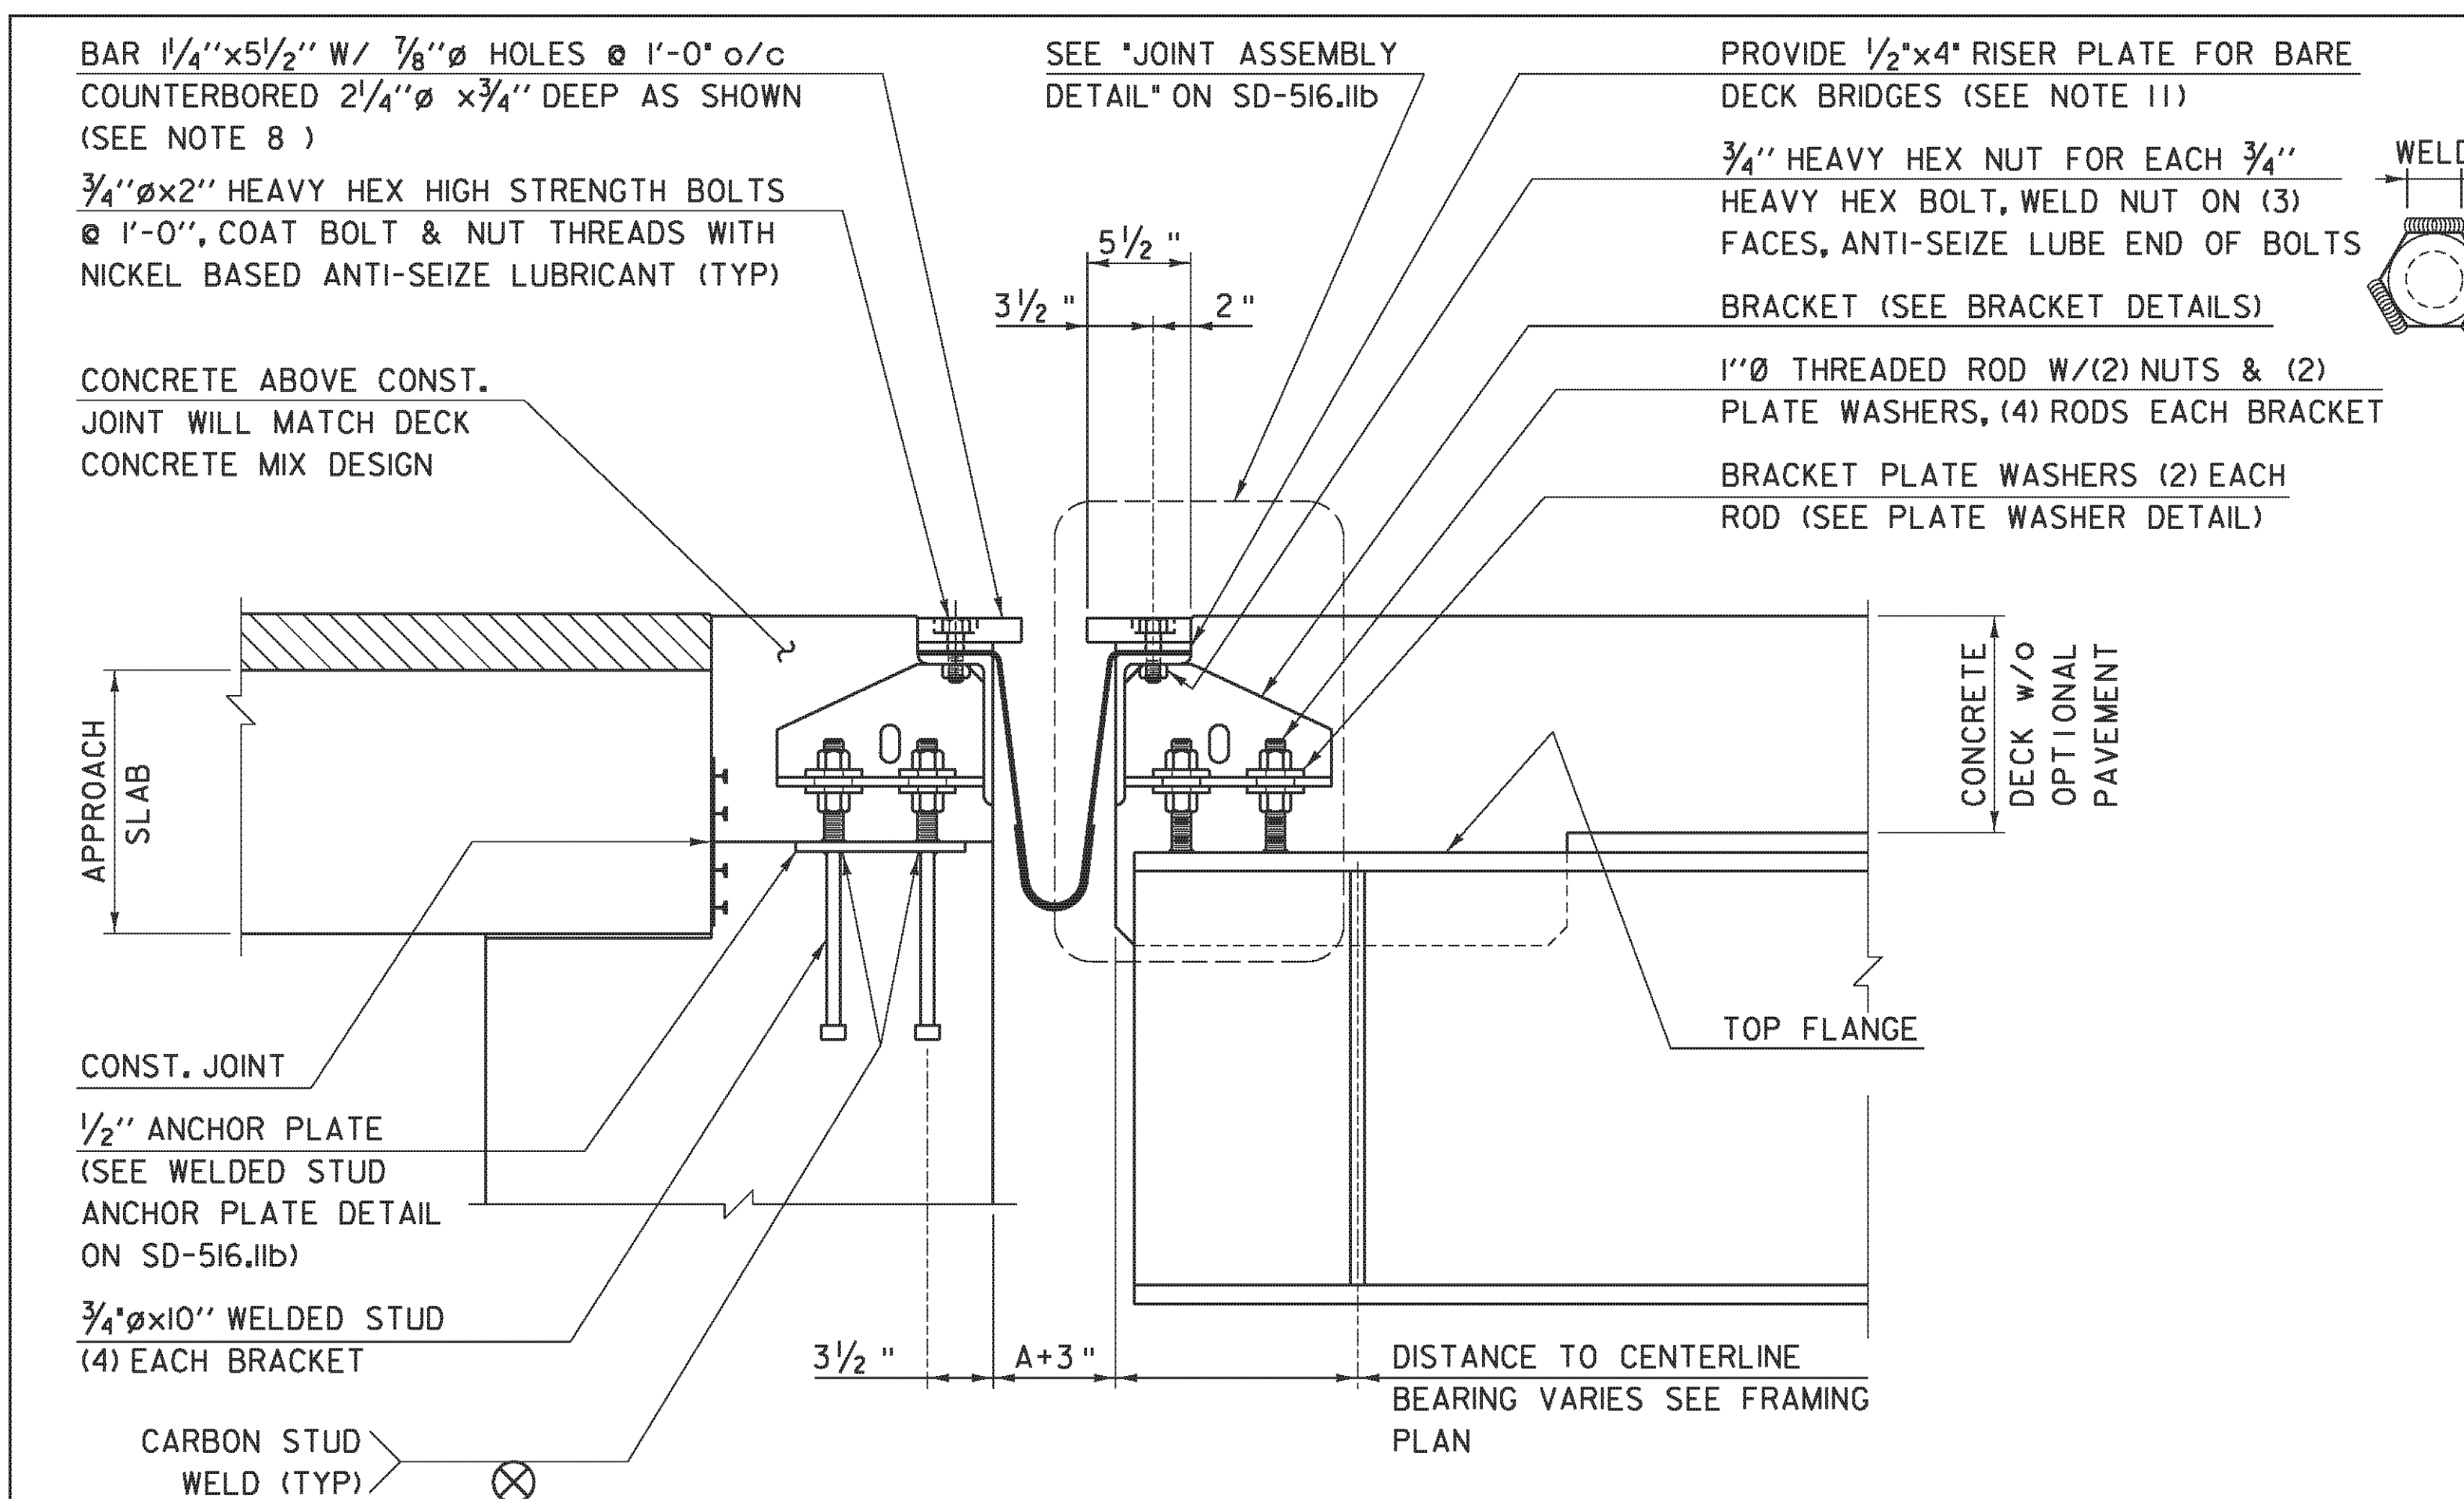

TYPICAL SECTION AT GIRDERS  
SCALE 1/2" = 1'-0"


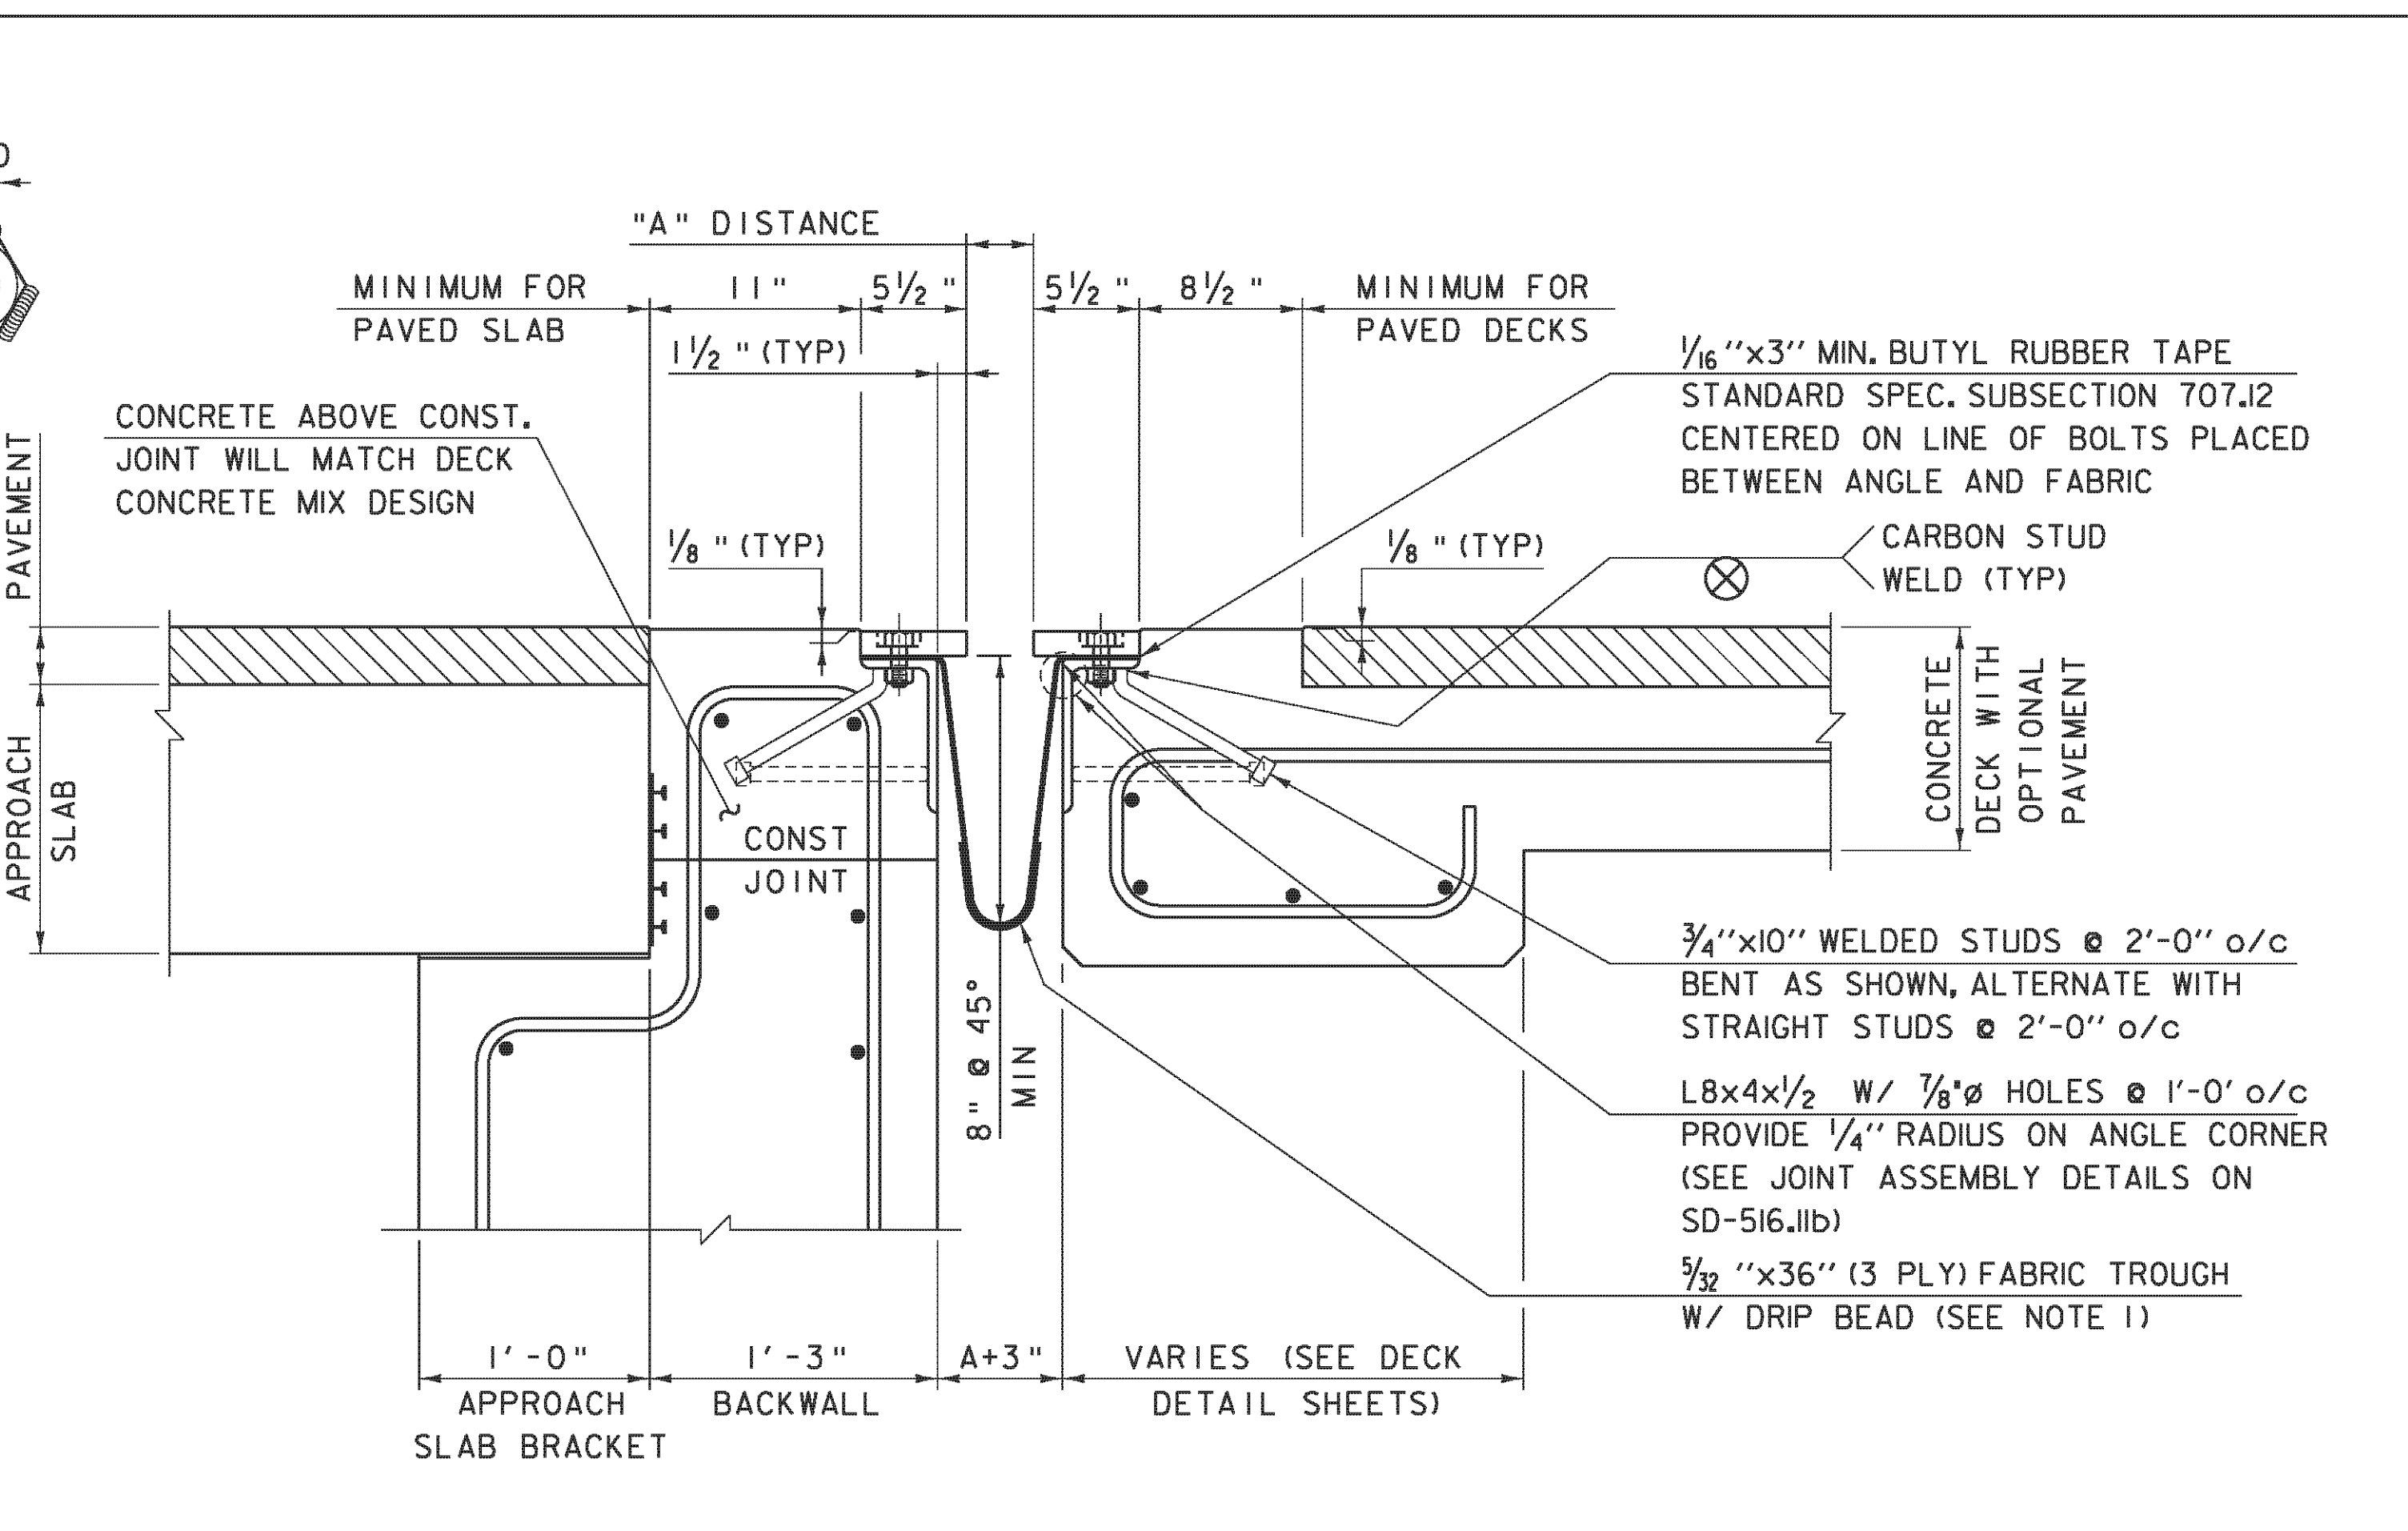


TYPICAL SECTION BETWEEN GIRDERS  
SCALE 1/2" = 1'-0"

NOTES FOR ITEM 516.11 "BRIDGE EXPANSION JOINT, VERMONT"


- FABRIC TROUGH SHALL BE THOROUGHLY CLEANED AND FLUSHED AFTER PAVING OPERATION. A DRIP BEAD OF 1/4"x7" STRIP OF PREFORMED FABRIC MATERIAL SHALL BE CEMENTED TO THE BOTTOM OF THE FABRIC TROUGH USING AN ADHESIVE APPROVED BY THE MANUFACTURER. THE DRIP BEAD SHALL BE APPLIED 1" FROM THE DOWNSPOUT END OF THE TROUGH. PREFORMED FABRIC MATERIAL SHALL BE CONTINUOUS FOR THE FULL LENGTH OF THE JOINT.
- THE EXPANSION DEVICE SHALL BE COVERED TO PROTECT THE FINISH DURING PLACING OF BRIDGE DECK CONCRETE.
- SEE "JOINT GAP DIMENSION TABLE" FOR DISTANCE "A" VALUES IN TEMPERATURE RANGE PROVIDED.
- JOINT BRACKET LENGTH "X" VARIES DEPENDENT ON THE BRIDGE SKEW ANGLE. THE BRACKET MUST BE LOCATED SUCH THAT THE THREADED RODS ARE NOT LESS THAN 1 1/2" FROM GIRDERS END OR FLANGE SIDES.
- ALL STEEL COMPONENTS SHALL BE GALVANIZED OR METALIZED AND MEET THE REQUIREMENTS OF SUBSECTION 516.02. PRIOR TO GALVANIZING OR METALIZING, ALL CORNERS AND EDGES OF STEEL PLATES, SHAPES, ETC., SHALL BE GROUND TO A 1/16" INCH RADIUS. THREADED RODS SHALL CONFORM TO THE REQUIREMENTS OF 714.04. THE "WELDED STUD ANCHOR PLATE" AND WELDED STUDS MAY BE SUPPLIED WITHOUT GALVANIZING OR METALIZING.

- THE 4"x8"x1/2" ANGLES MAY BE FURNISHED AS ONE CONTINUOUS PIECE OR SPLICED AS SHOWN IN THE FIELD SPLICE DETAIL WHEN SPECIFIED. THE 1/4"x5 1/2" BARS EACH SIDE OF THE JOINT SHALL BE PROVIDED IN TWO EQUAL LENGTHS.
- PROJECTING THREADS OF THE 3/4" Ø BOLTS IN THE JOINT SHALL BE GREASED BY THE CONTRACTOR PRIOR TO PLACING ADJACENT CONCRETE. THIS WILL FACILITATE BOLT REMOVAL IF REQUIRED IN THE FUTURE.
- FILL COUNTERBORED HOLES WITH HOT POURED JOINT SEALER (STD. SPEC. 707.04) AFTER BOLT INSTALLATION. PAYMENT FOR THE WORK SHALL BE INCIDENTAL TO ITEM 516.11 "BRIDGE EXPANSION JOINT, VERMONT".
- THE EXPANSION JOINT, INCLUDING THE FABRIC TROUGH, SHALL BE SHOP ASSEMBLED AND SHIPPED AS ONE UNIT. IF THE EXPANSION JOINT HAS A FIELD SPLICE SPECIFIED, THE FABRIC TROUGH SHALL BE SHIPPED WITH ONE UNIT AND ASSEMBLED WITH THE SECOND UNIT PRIOR TO CONCRETE PLACEMENT.
- TEMPORARY SHIPPING ATTACHMENTS SHALL BE ATTACHED BY BOLTING; WELDING WILL NOT BE PERMITTED.
- BARE DECK "RISER PLATE" AS SHOWN IN "TYPICAL SECTION AT GIRDERS" DRAWING SHALL BE INCLUDED ON BRIDGES WITH BARE CONCRETE DECK SPECIFIED. RISER PLATES SHALL BE INCLUDED FOR BOTH SIDES AND MATCH THE LENGTHS OF THE 1/4"x5 1/2" BARS. THE RISER PLATE CAN BE REMOVED IF THE DECK IS MILLED IN THE FUTURE.

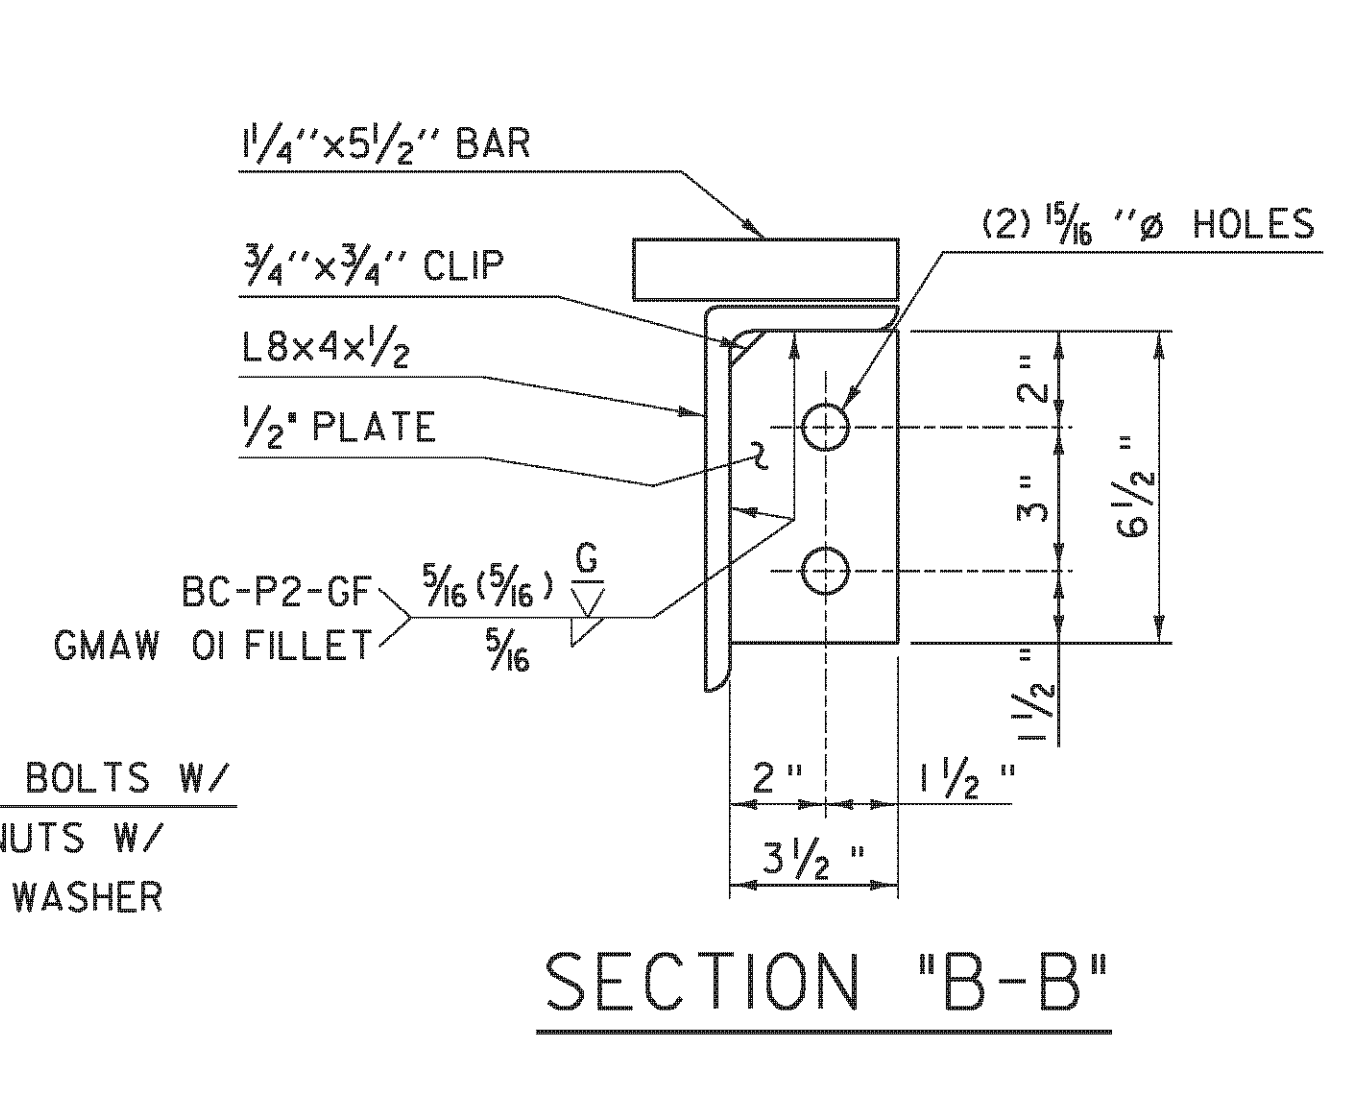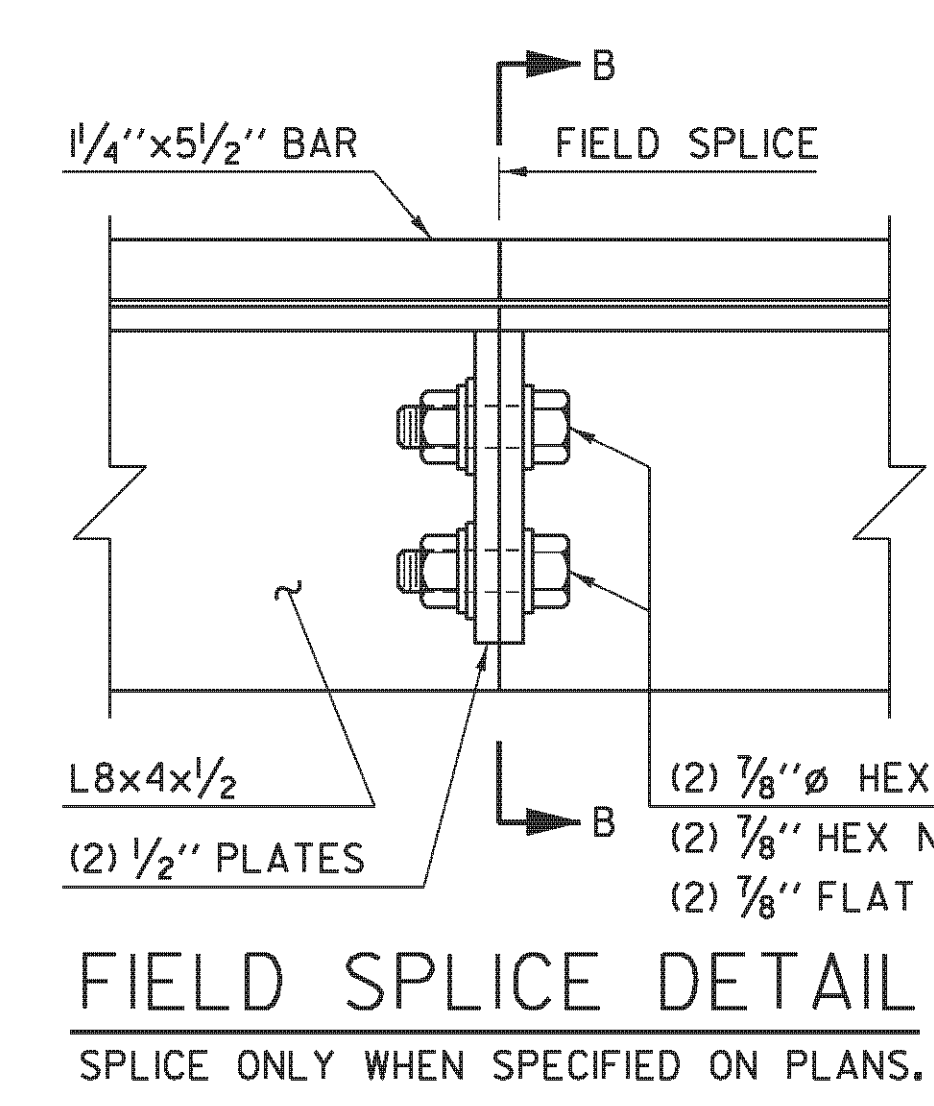



REVISIONS	
FEBRUARY 24, 2011	APPROVED FOR USE BY VAOT STRUCTURES SECTION

# BRIDGE EXPANSION JOINT, VERMONT

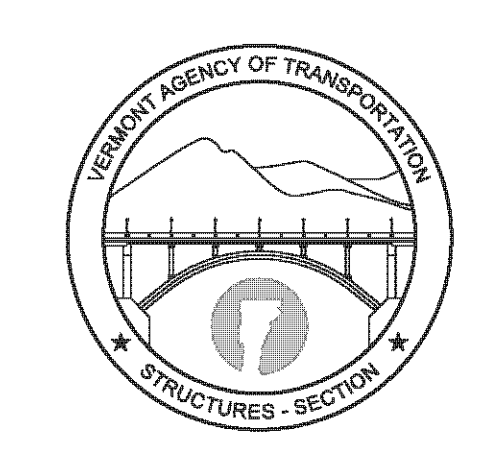

## STRUCTURES DETAIL SD-516.11a





NOTE: SEE PROJECT SPECIFIC PLANS & DETAILS FOR BRIDGE GEOMETRY & DETAILS THAT ARE REQUIRED TO CONSTRUCT THE EXPANSION JOINT.

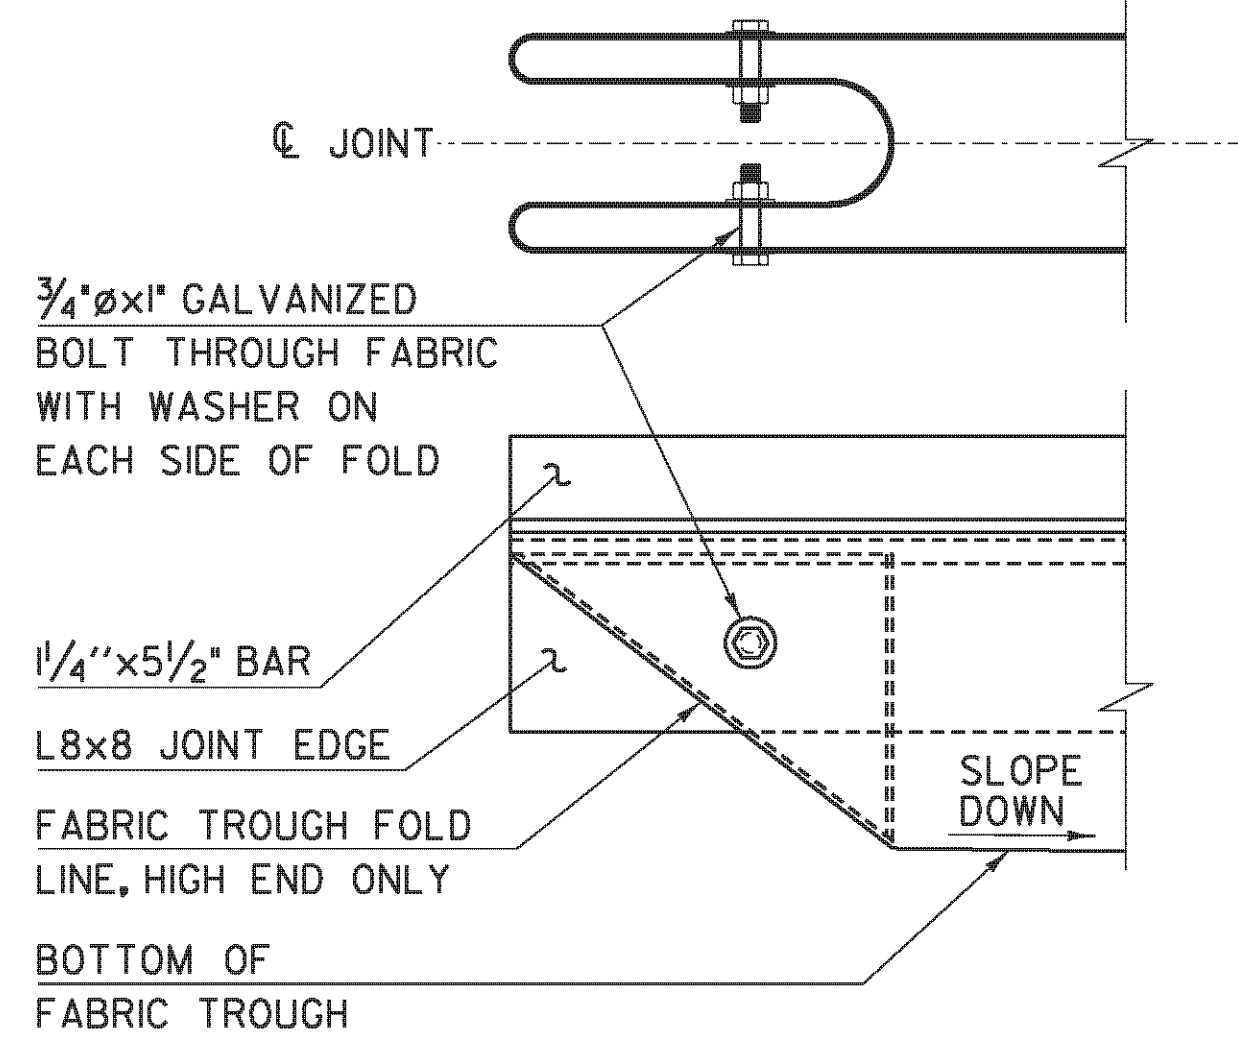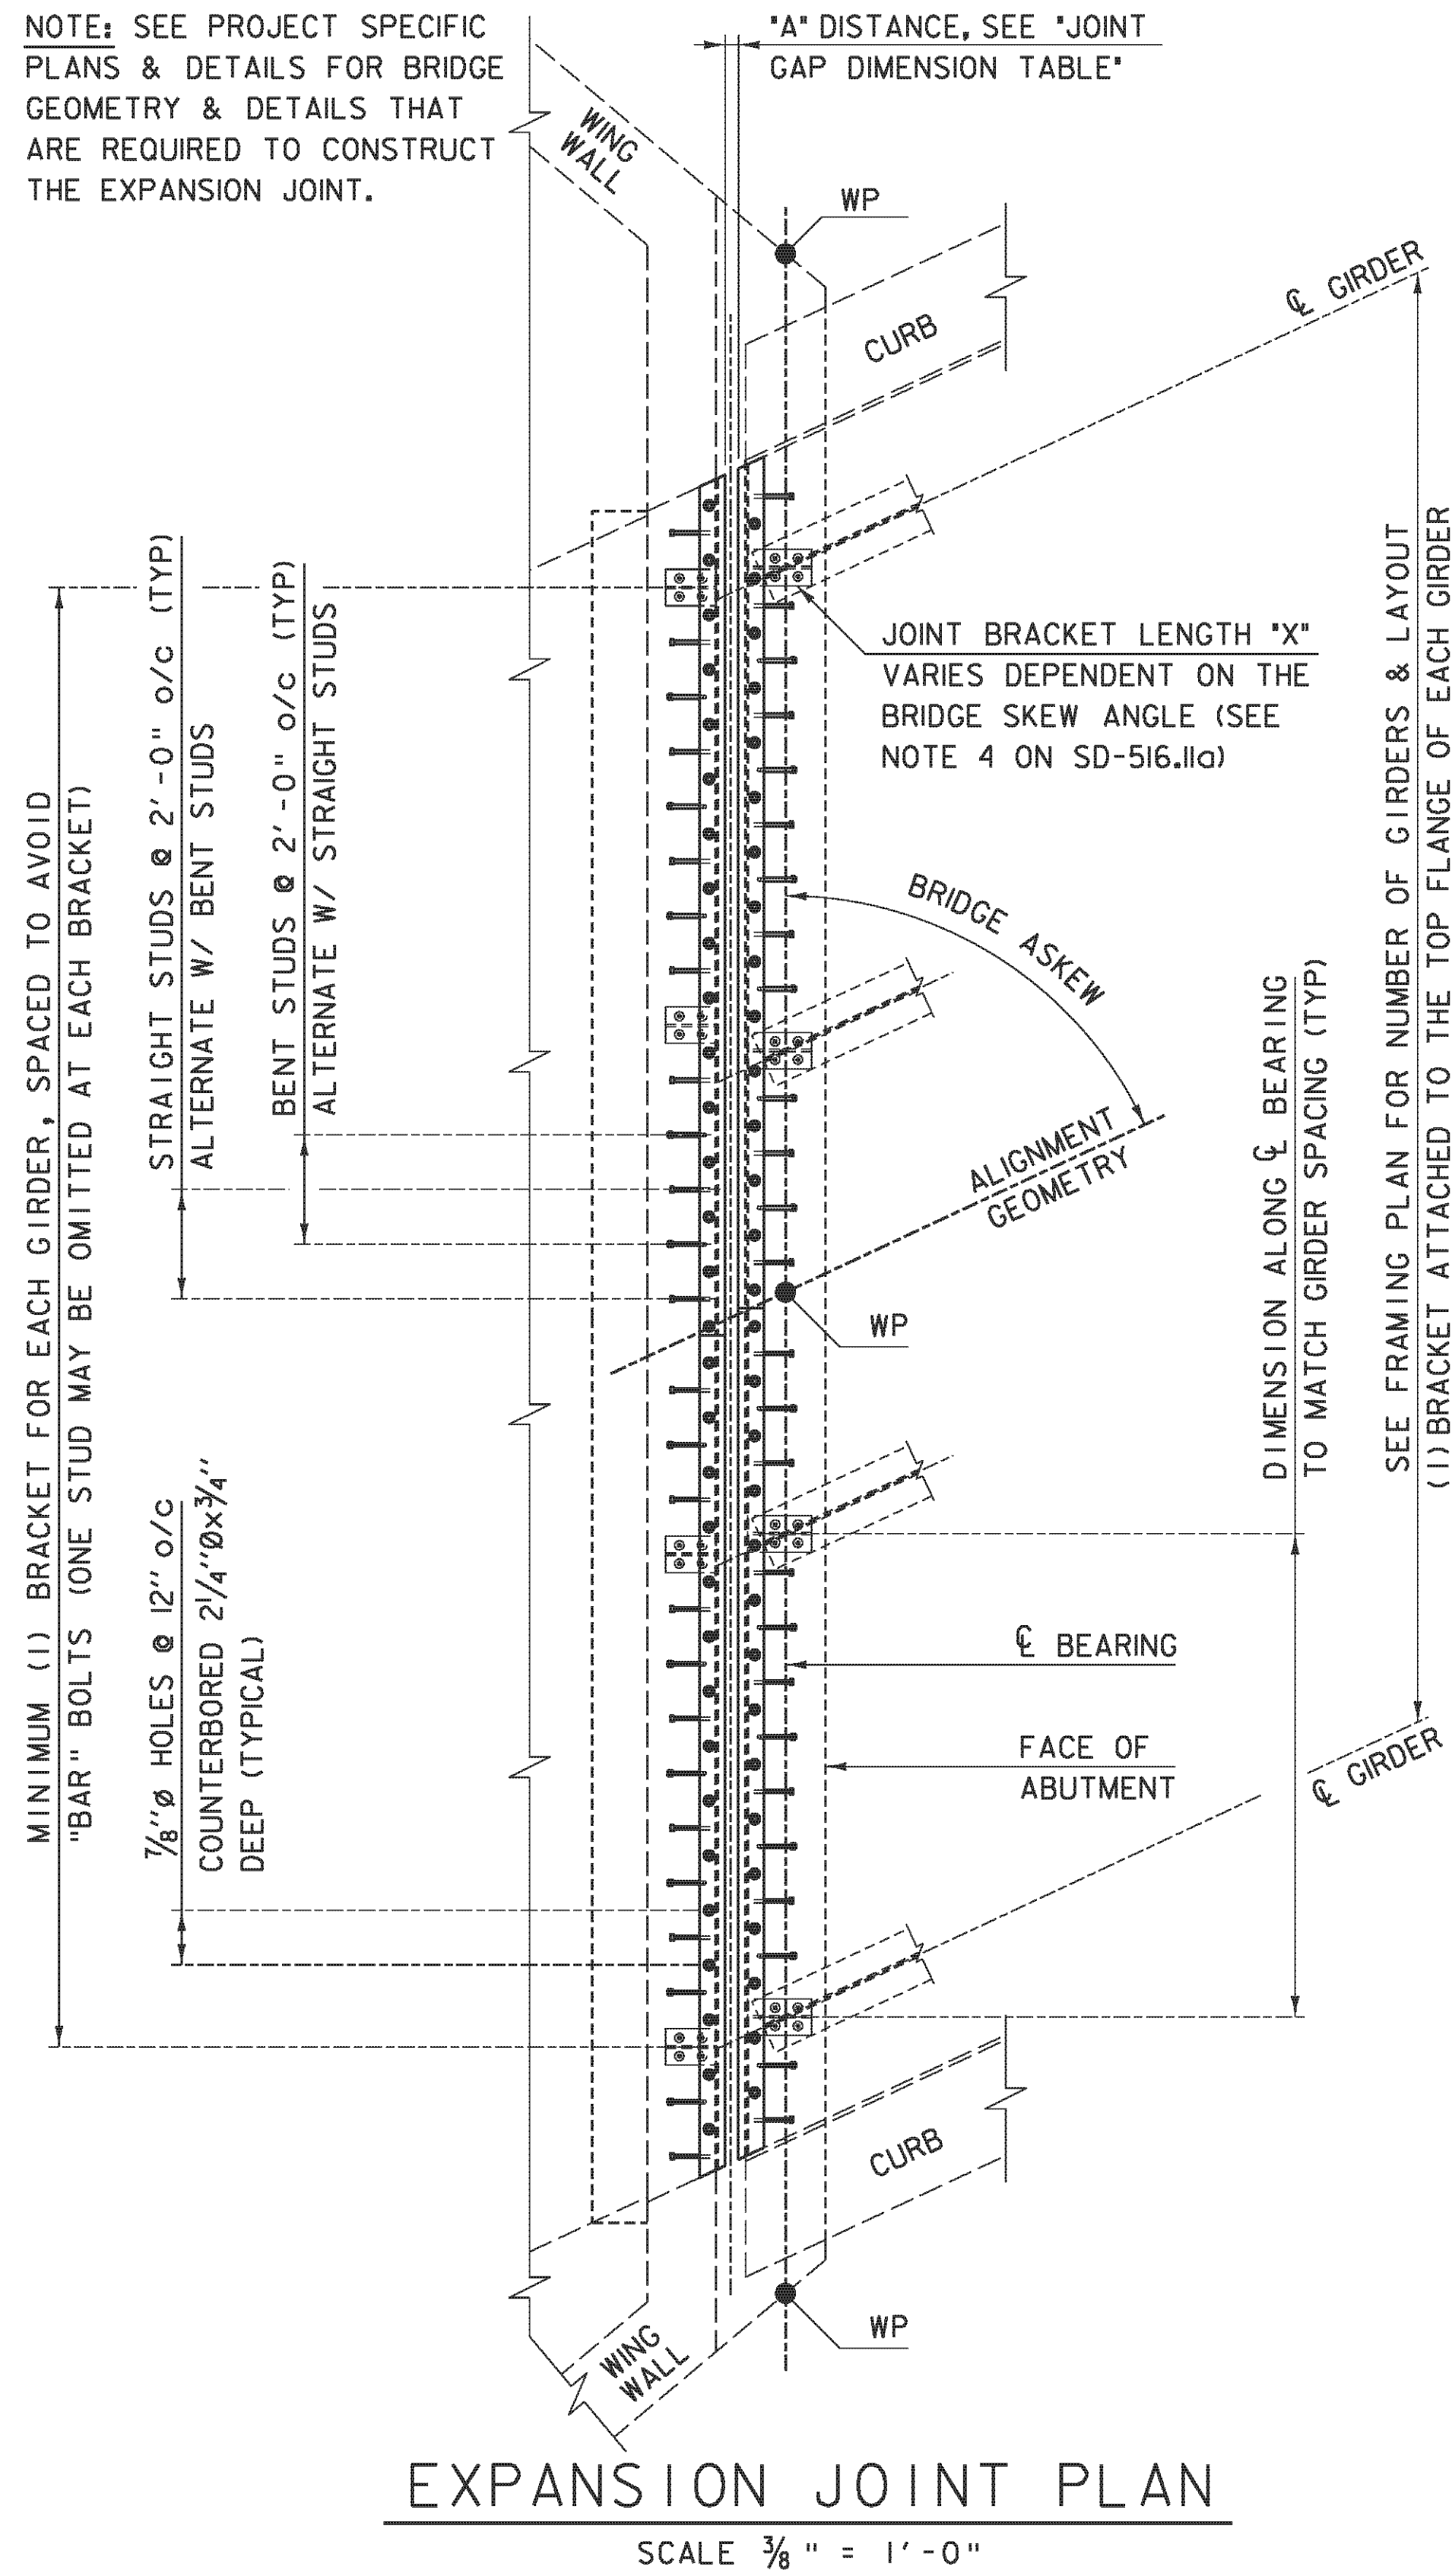

1. TROUGH SHALL BE FOLDED AT HIGH ENDS. TROUGH SHALL SLOPE AT MIN 2% DOWN TOWARD THE NEAREST DRAINAGE SPOUT HOPPER LOCATION.
2. BOLTS, NUTS AND WASHERS FOR FOLD SHALL MEET REQUIREMENTS OF SUBSECTION 714.04 AND SHALL BE GALVANIZED.


Temp (°F)	Expansion Length (ft)				
	100 - 120	>120 - 140	>140 - 160	>160 - 180	>180 - 200
0	1 5/8	1 13/16	1 7/8	1 15/16	2 1/8
15	1 1/2	1 5/8	1 11/16	1 3/4	1 7/8
30	1 5/16	1 1/2	1 1/2	1 1/2	1 5/8
45	1 3/16	1 5/16	1 5/16	1 5/16	1 7/16
60	1 1/16	1 1/8	1 1/8	1 1/16	1 3/16
75	15/16	1	15/16	7/8	15/16
90	3/4	13/16	3/4	11/16	11/16
105	5/8	11/16	9/16	7/16	1/2

- 1) Expansion Length: Length of span, from Expansion Joint to nearest Fixed Bearing.
- 2) "A" Distance: measured distance during joint placement.
- 3) Temp: Approximate temperature of steel during joint placement.

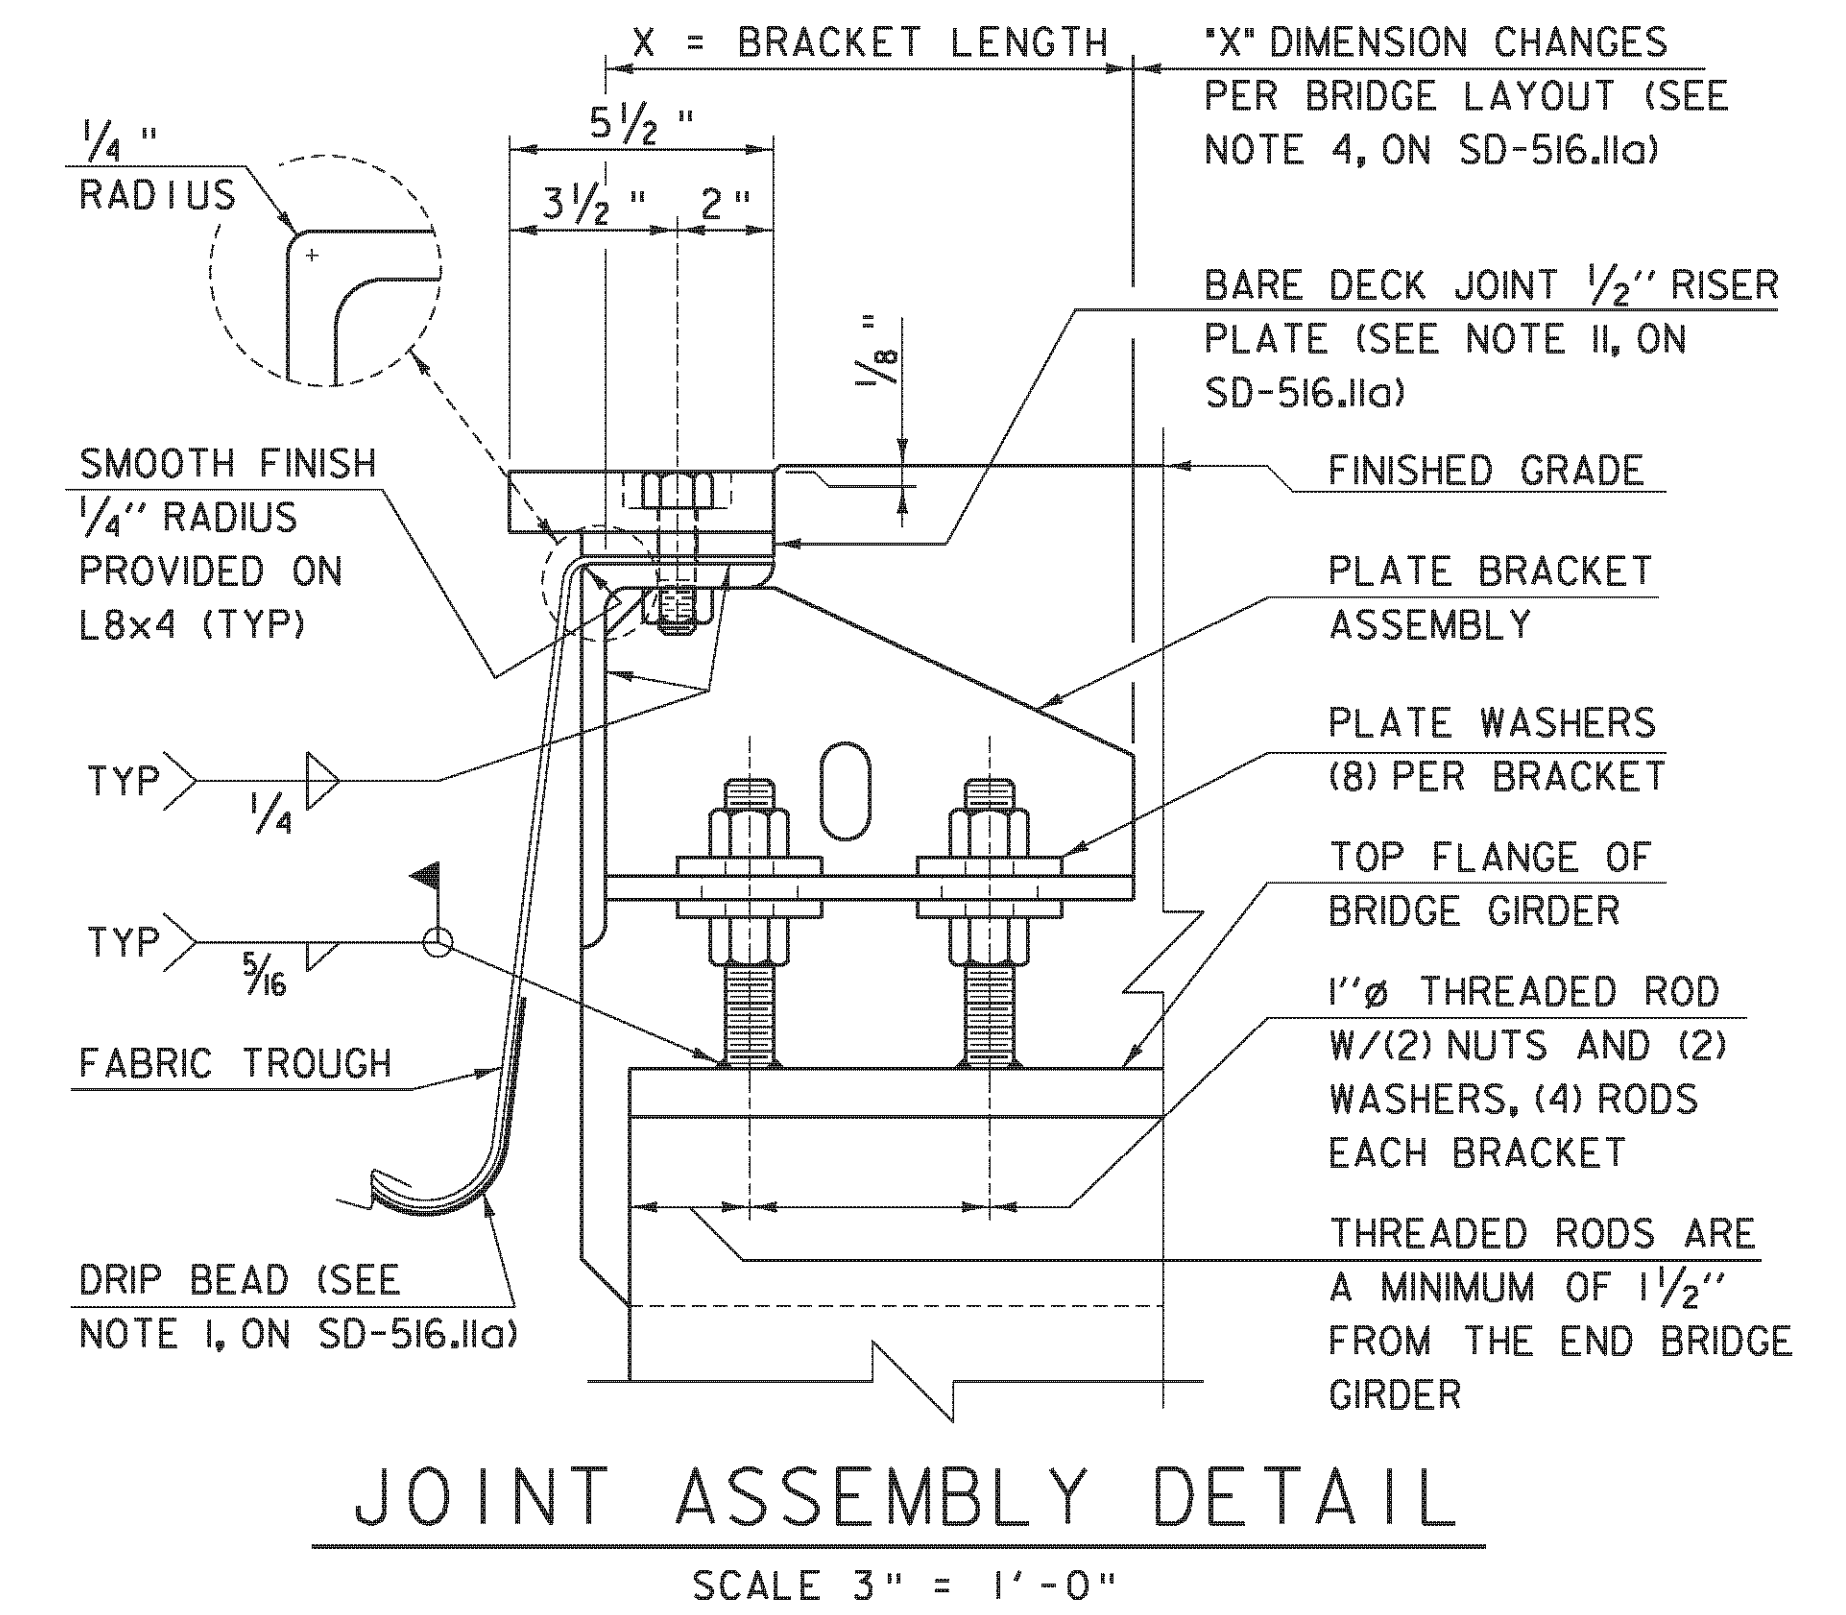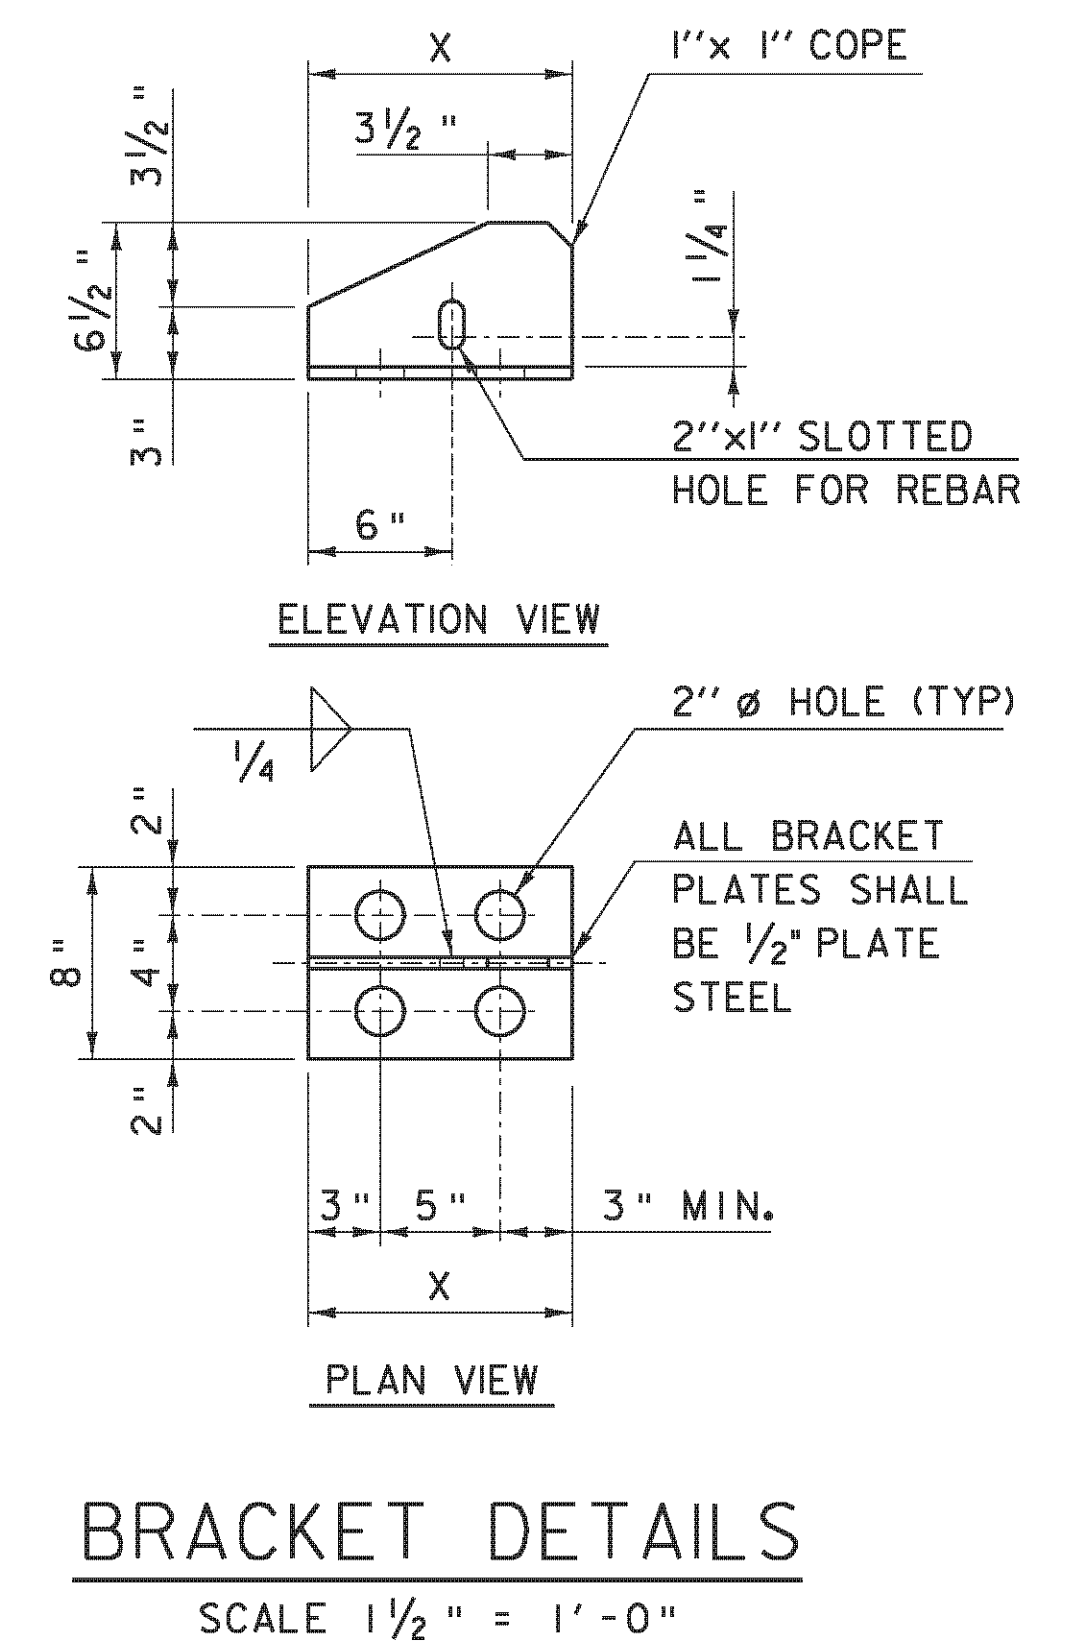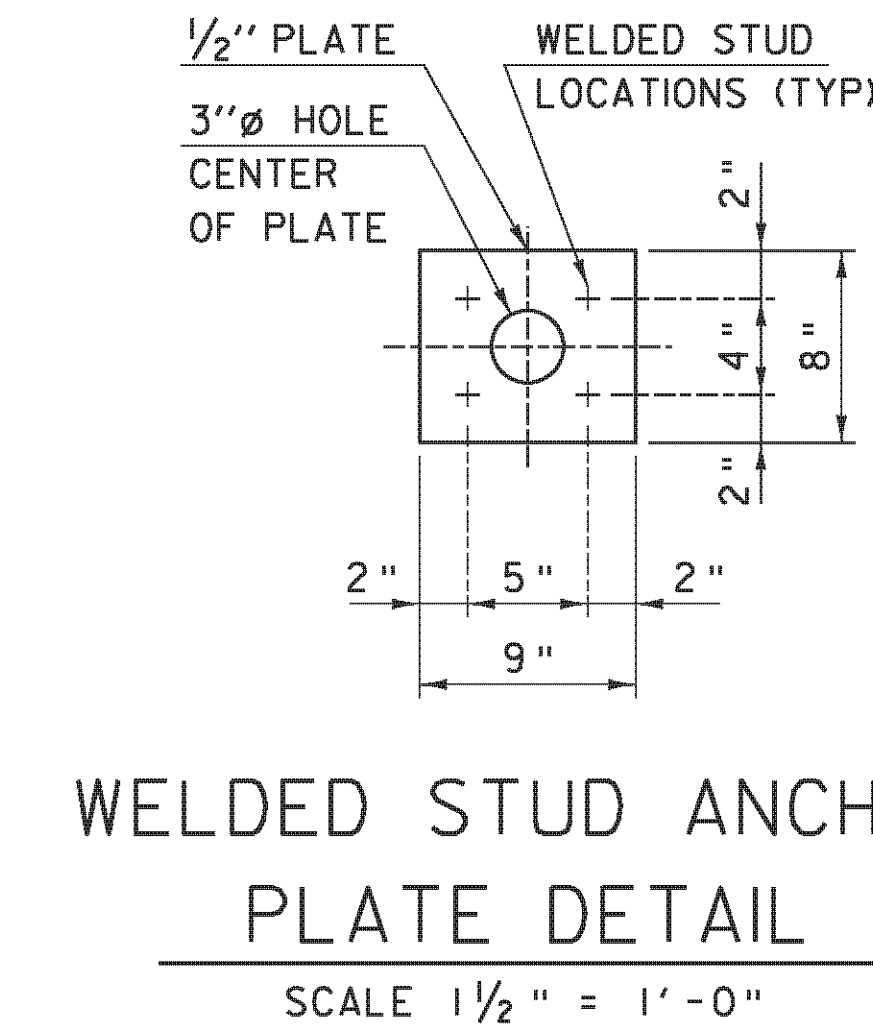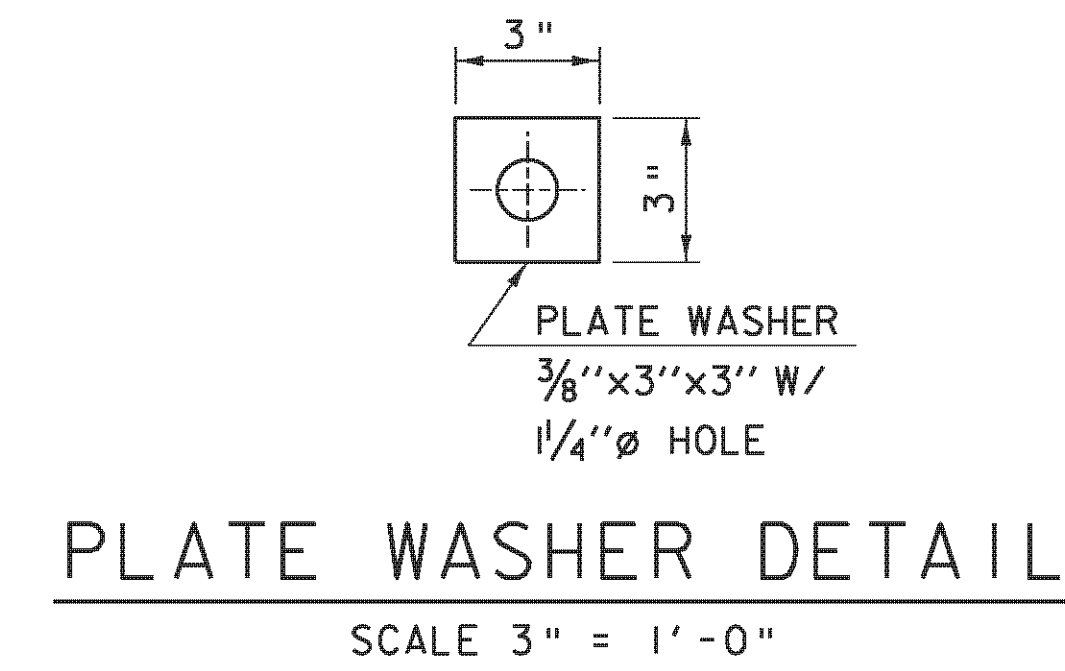

REVISIONS	
FEBRUARY 24, 2011	APPROVED FOR USE BY VAOT STRUCTURES SECTION


# BRIDGE EXPANSION JOINT, VERMONT

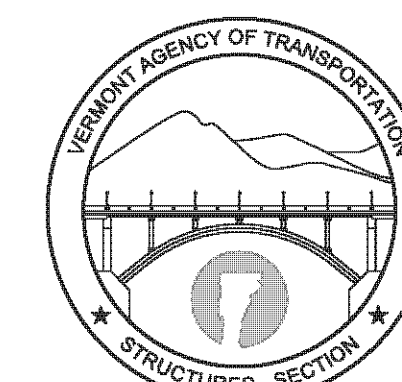

# STRUCTURES DETAIL SD-516.11b

**STRUCTURAL STEEL GENERAL NOTES:**


1. ALL FIELD CONNECTIONS SHALL BE MADE WITH 7/8" DIAMETER HIGH-STRENGTH BOLTS IN 15/16" DIAMETER HOLES, PER SUBSECTION 506.I9, UNLESS OTHERWISE SPECIFIED.
2. ALL HOLES IN THE WEBS OF THE FASCIA GIRDERS THAT ARE NOT OTHERWISE FILLED, SHALL BE FILLED WITH EITHER BUTTON HEAD OR HEX HEAD BOLTS. THESE BOLTS SHALL BE TIGHTENED IN ACCORDANCE WITH SUBSECTION 506.I9.
3. ALL WELDING SHALL CONFORM TO THE PROVISIONS OF SUBSECTION 506.I0.
4. ANY CONNECTIONS THAT ARE NOT DETAILED ON THE PLANS SHALL BE DETAILED BY THE FABRICATOR AND SUBMITTED TO THE STRUCTURES ENGINEER FOR APPROVAL.
5. STRUCTURAL STEEL MEMBERS DESIGNATED "CVN" IN THE PLANS SHALL BE CHARPY V-NOTCH TESTED IN ACCORDANCE WITH SUBSECTION 714.01 OF THE STANDARD SPECIFICATIONS.
6. ENDS OF GIRDERS ARE TO BE VERTICAL IN THEIR FINAL POSITION.
7. AFTER SUPERSTRUCTURE STEEL HAS BEEN ERECTED, ELEVATIONS ALONG THE TOP OF THE GIRDERS SHALL BE TAKEN AS DIRECTED BY THE RESIDENT ENGINEER FOR USE IN DETERMINING FINISHED GRADES.

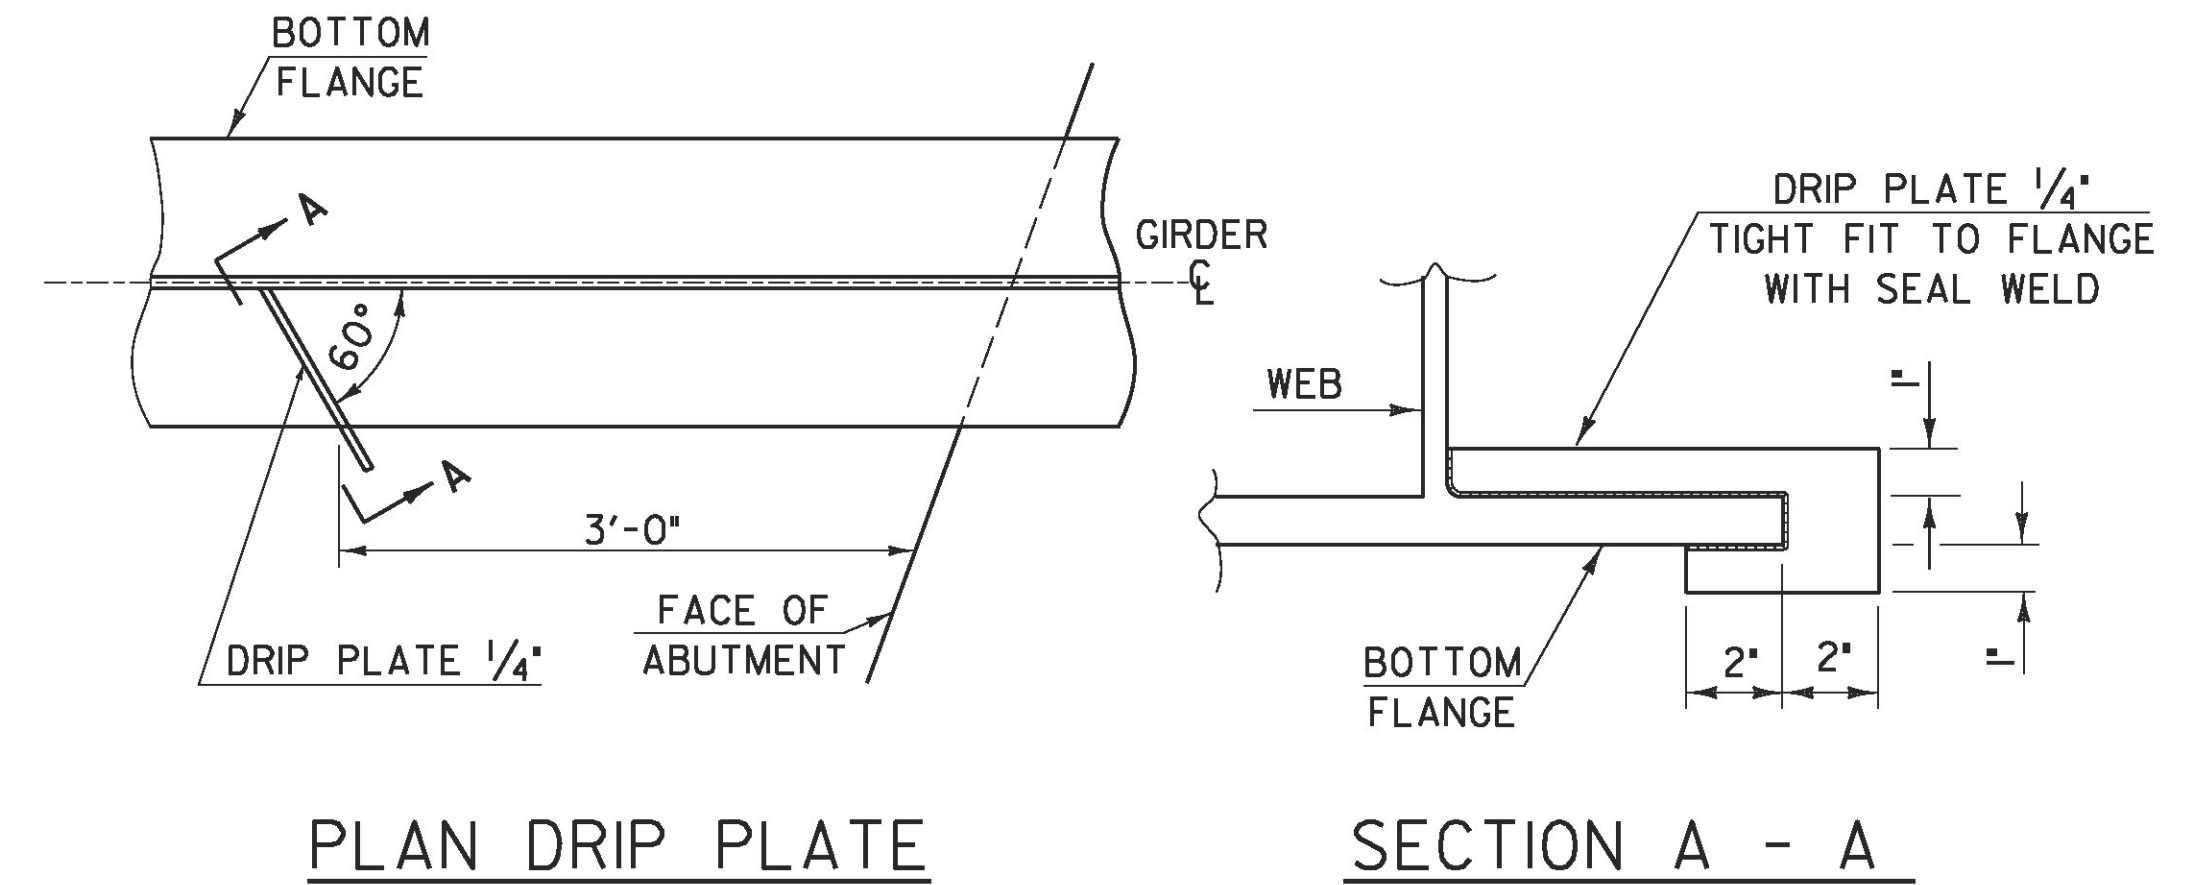

**PLAN DRIP PLATE**


**SECTION A - A**

NOTE: DRIP PLATES SHALL BE PLACED ON OUTSIDE EDGE OF FASCIA GIRDERS ON THE HIGH SIDE OF ALL PIERS AND ABUTMENTS OR AS INDICATED ON PROJECT PLANS.

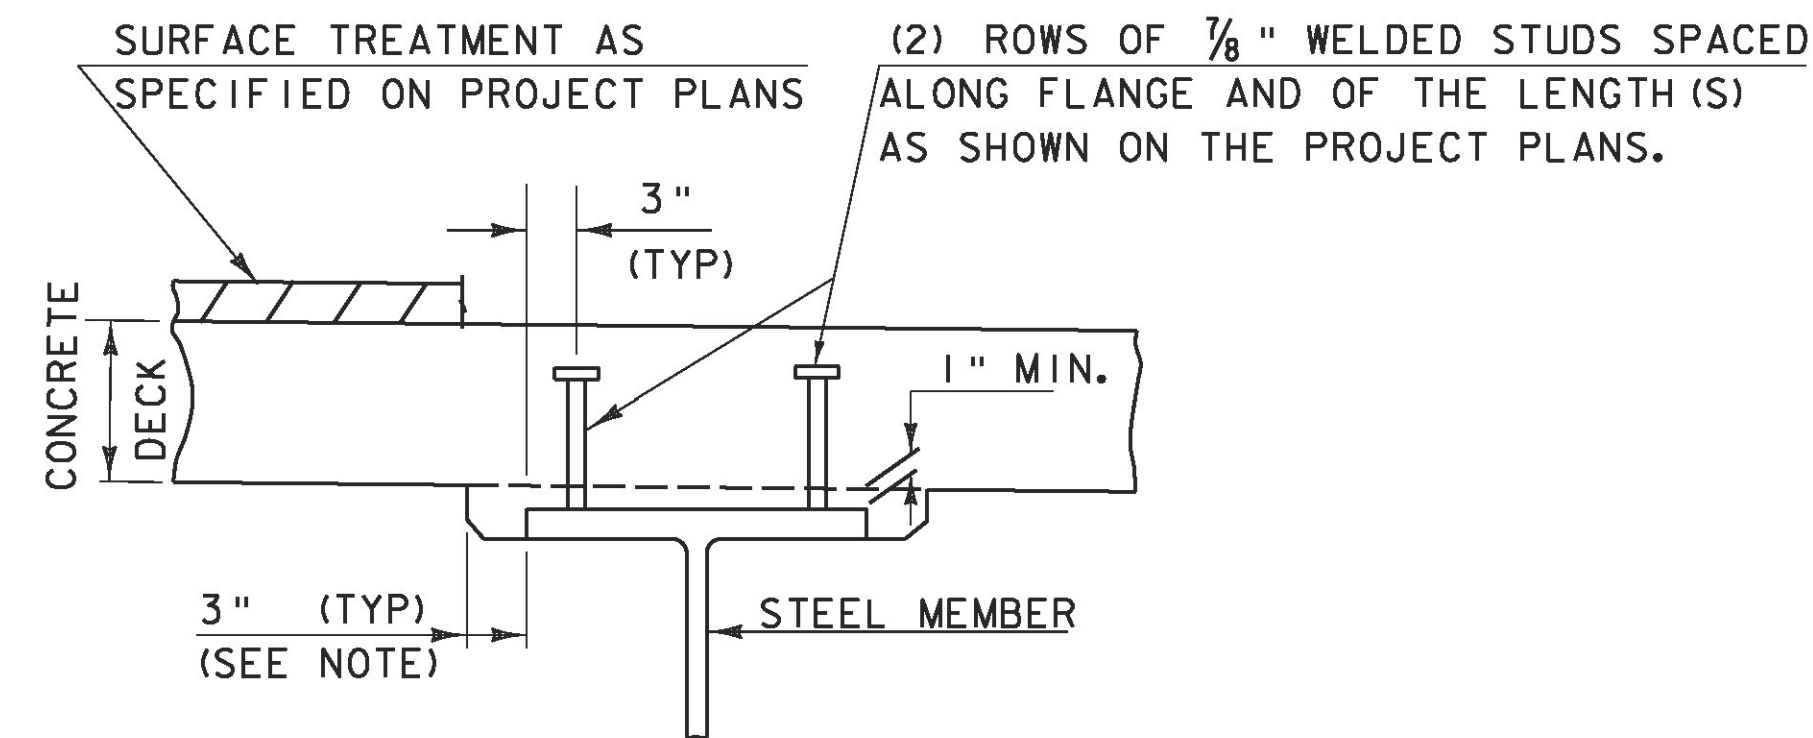

NOTE:  
THE 3" HORIZONTAL SECTION MAY BE ELIMINATED FOR FORMING SYSTEMS DESIGNED FOR THE CONSTRUCTION OF VERTICAL HAUNCHES. ANY VOIDS RESULTING FROM FORMING SYSTEM ELEMENTS SHALL BE FILLED WITH JOINT SEALER, POLYURETHANE MEETING THE REQUIREMENTS OF SECTION 524. THE COST OF THE JOINT SEALER, POLYURETHANE SHALL BE INCIDENTAL TO THE ADJACENT CONCRETE.

**HAUNCH AND SHEAR CONNECTOR DETAIL**

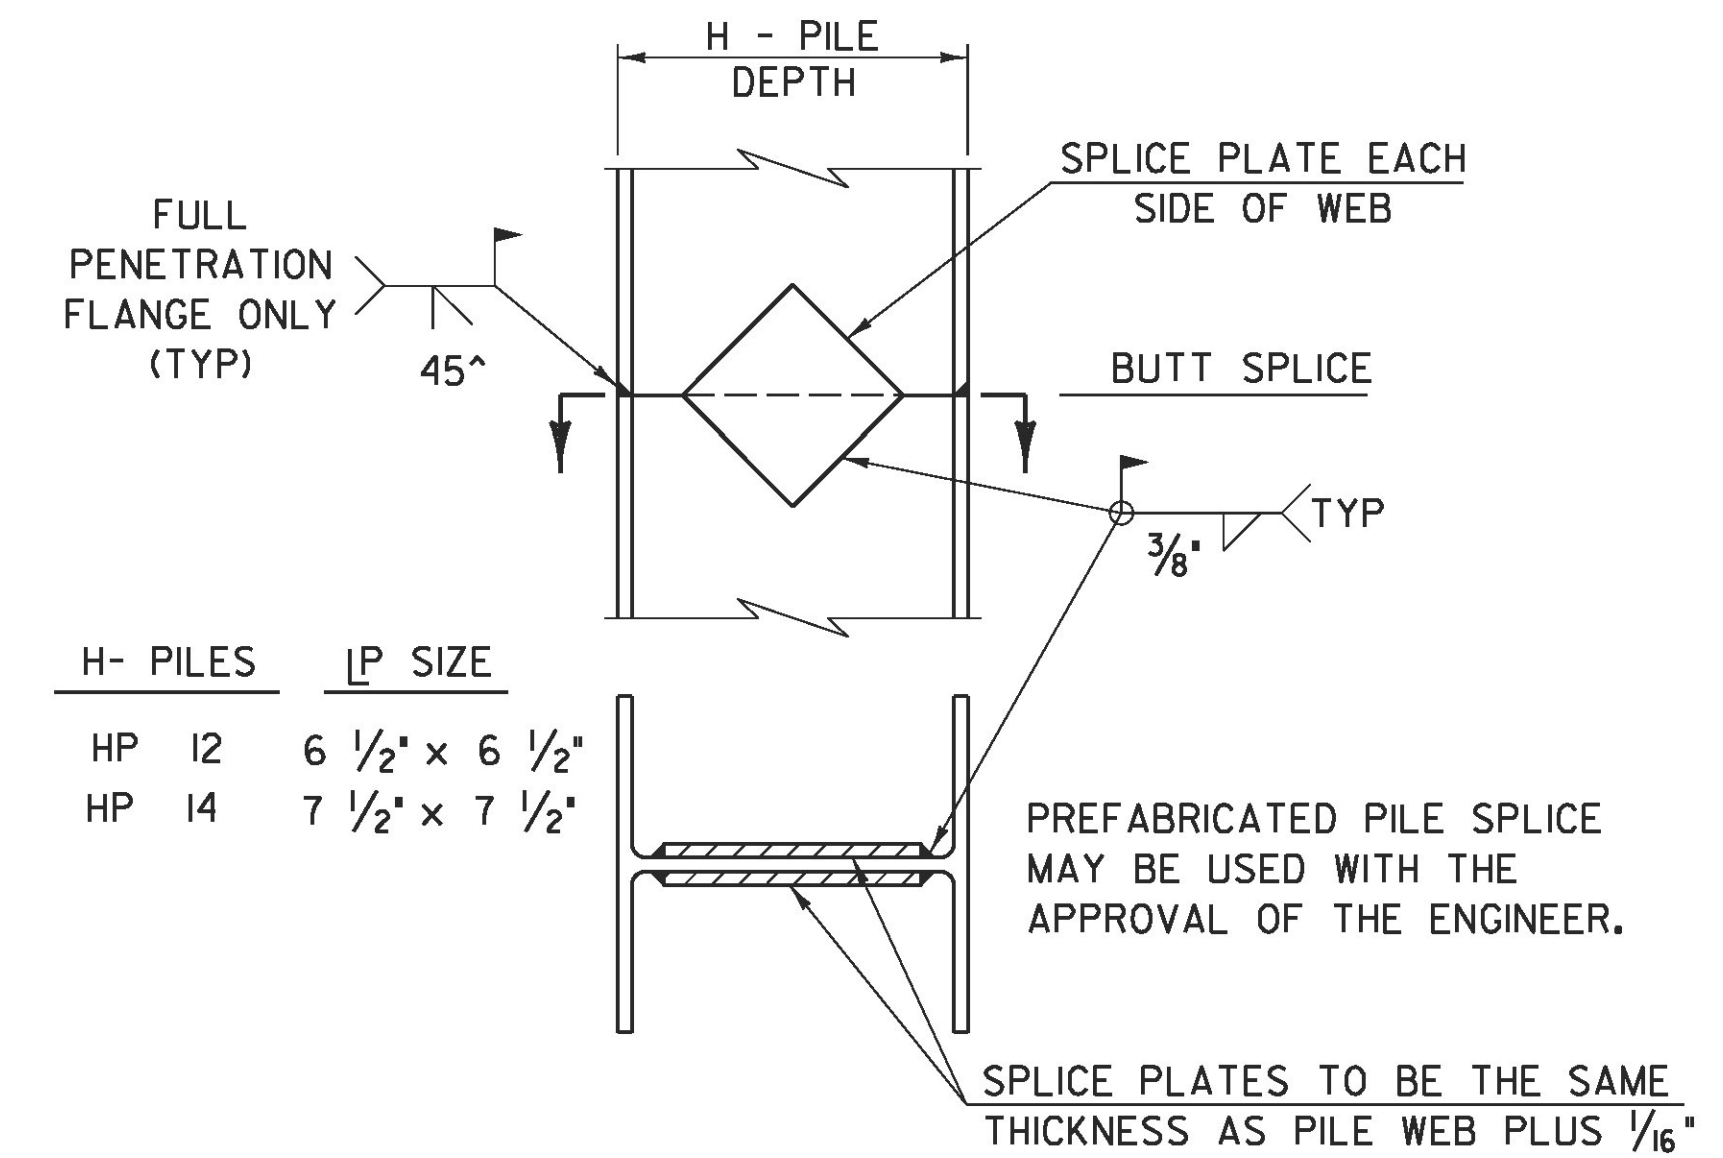


**DETAIL OF PILE SPLICE**

DETAILS ON THIS SHEET ARE "NOT TO SCALE" UNLESS NOTED OTHERWISE.

**REVISIONS**


MAY 7, 2010	APPROVED FOR USE BY VAOT STRUCTURES SECTION
JUNE 4, 2010	MODIFIED NOTES

**STRUCTURAL STEEL  
DETAILS & NOTES**

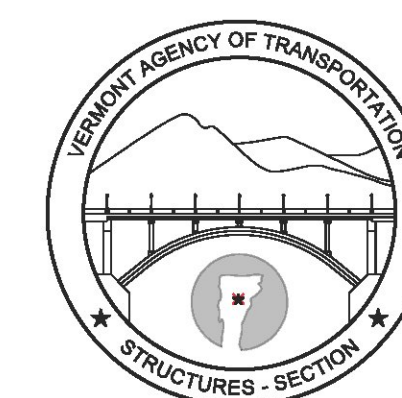


**STRUCTURES  
DETAIL  
SD-6 01.00**



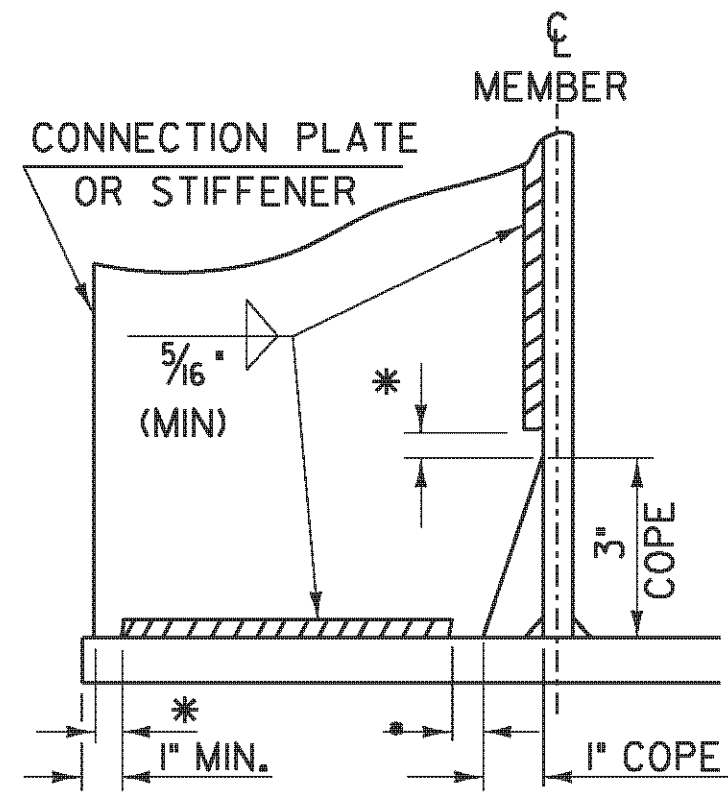


**WELD TERMINATION AND COPING  
DETAILS FOR STEEL MEMBERS**

*NO WELD FOR 3/8" MIN. 7/8" MAX. (EXCEPT MUST MAINTAIN 1" MINIMUM FROM EDGE OF FLANGE)

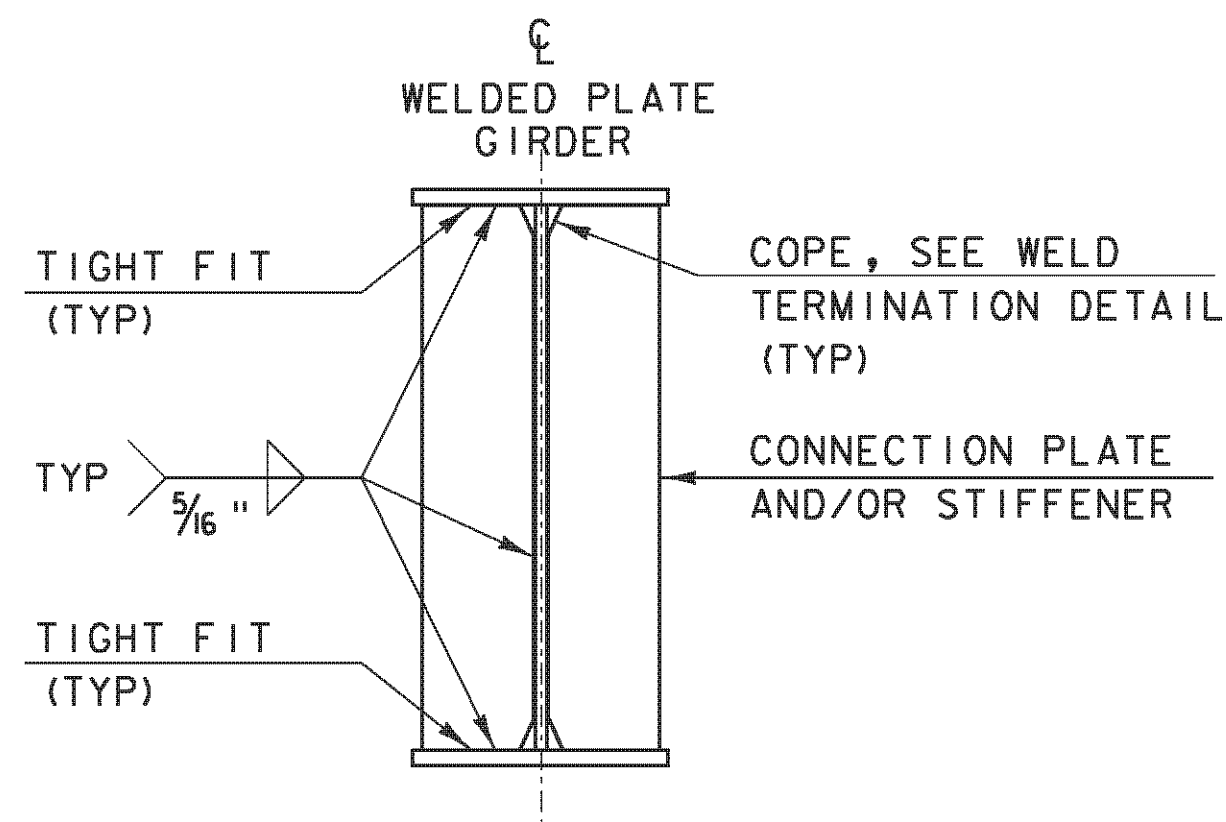


**INTERMEDIATE CONNECTION PLATES  
AND/OR STIFFENERS FOR WELDED  
PLATE GIRDERS**


INTERMEDIATE DETAIL IS ONLY USED WHEN PLATE DOES NOT OCCUR AT AN ABUTMENT OR PIER.

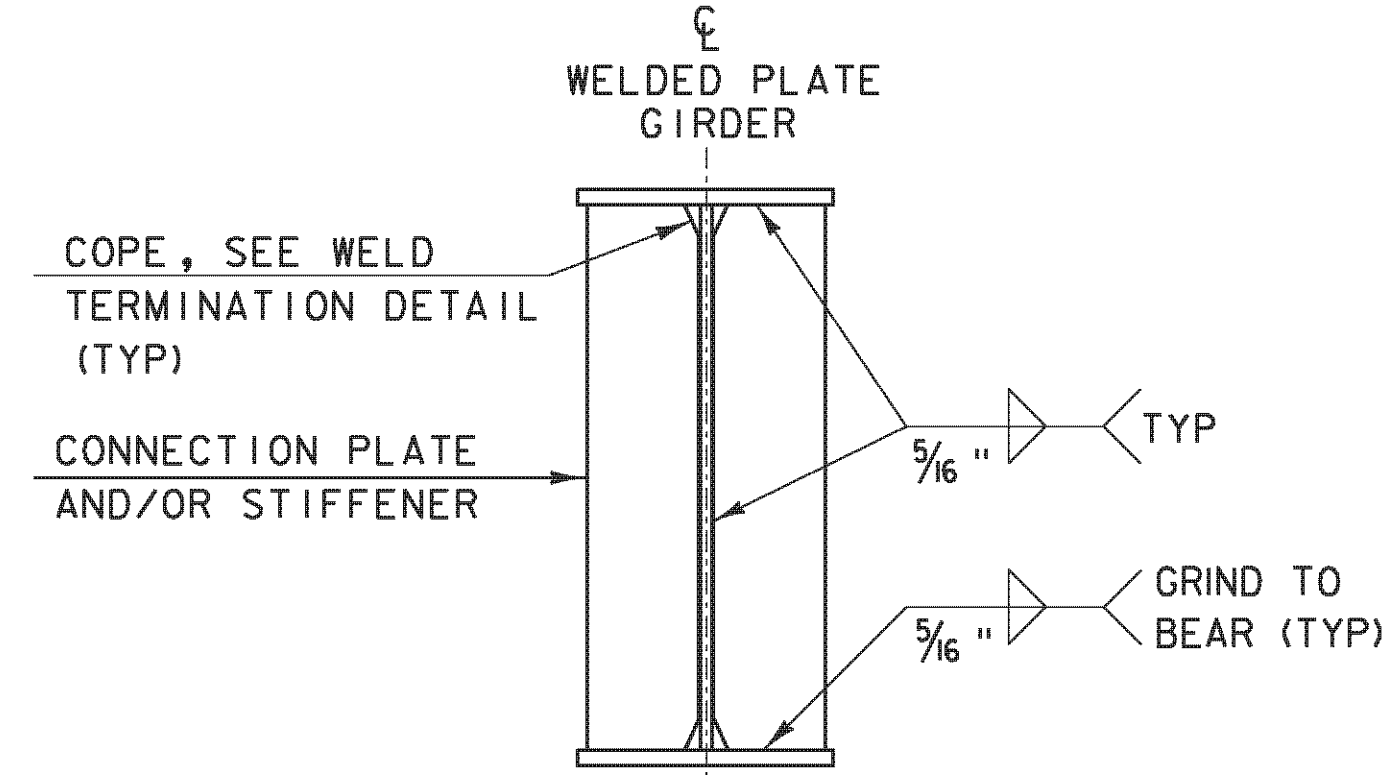

**ABUTMENT BEARING STIFFENERS  
AND/OR CONNECTION PLATES  
FOR WELDED PLATE GIRDERS**

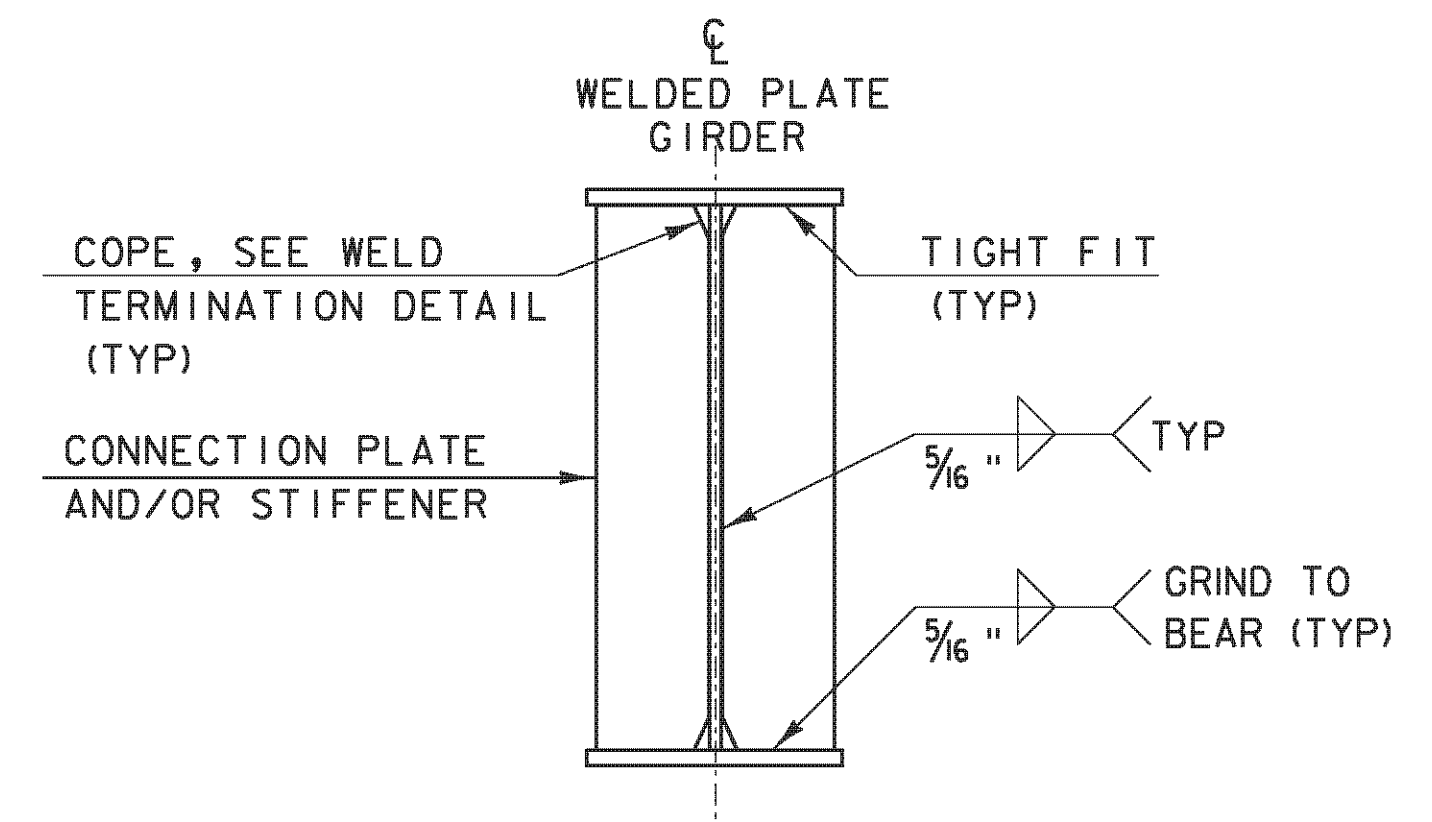


**PIER BEARING STIFFENERS  
AND/OR CONNECTION PLATES  
FOR WELDED PLATE GIRDERS**

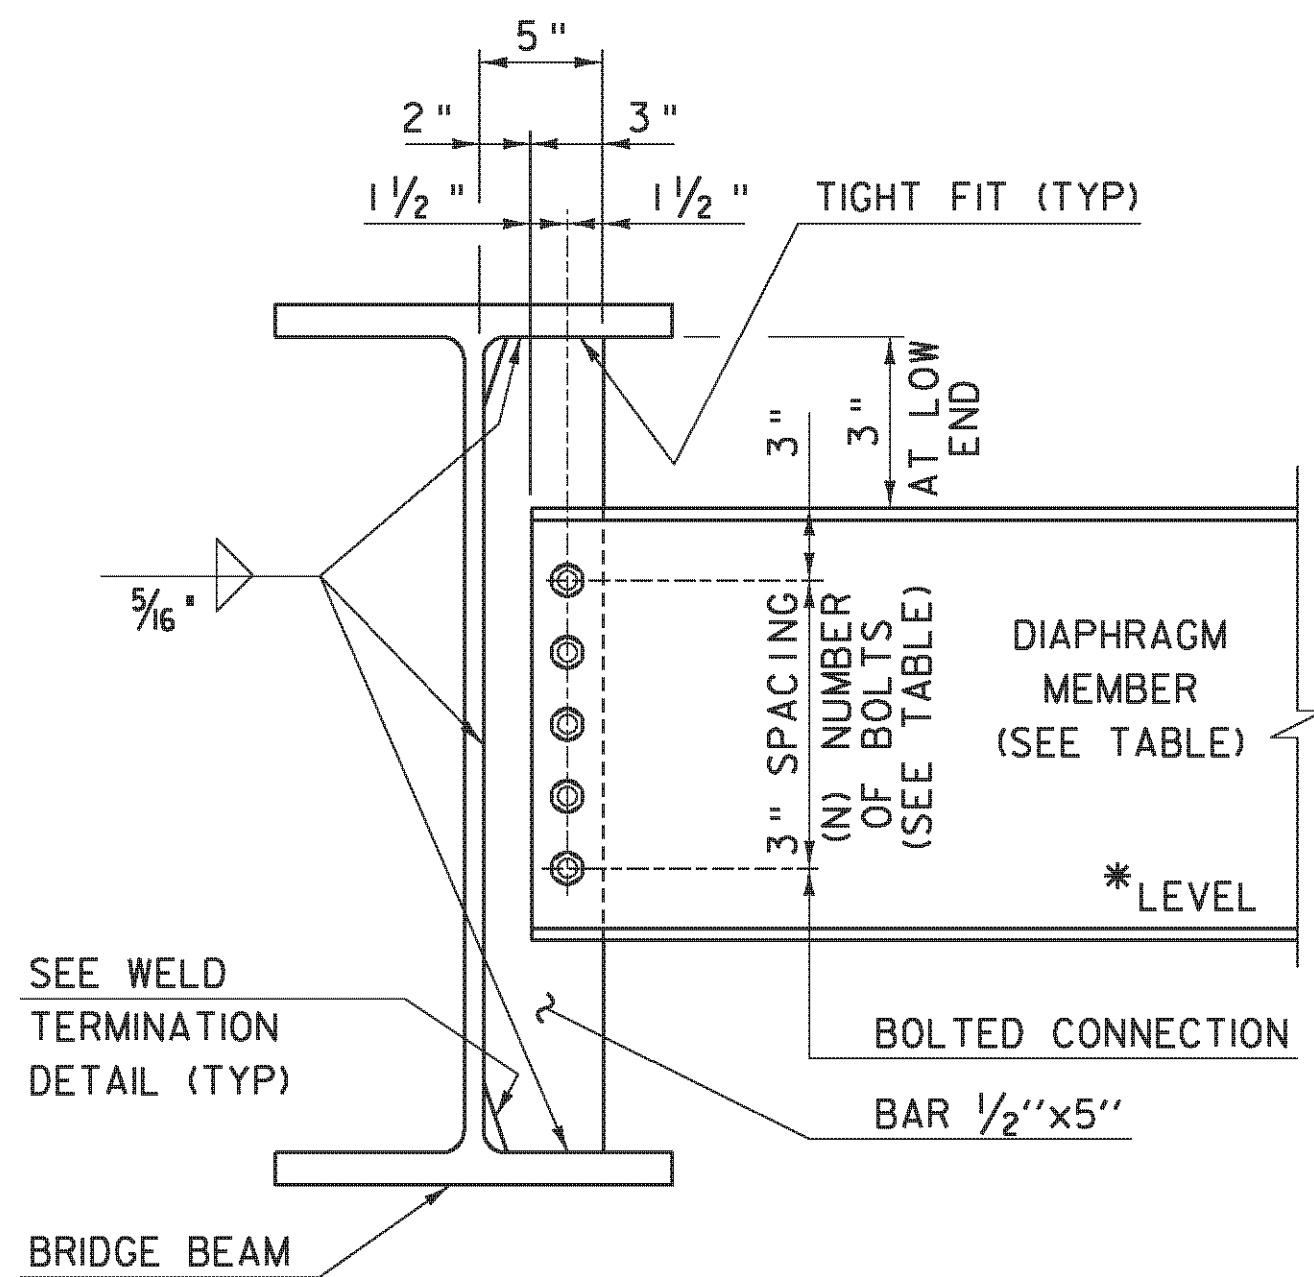


**INTERMEDIATE DIAPHRAGMS  
FOR 24" TO 48" BRIDGE BEAMS**

* IF CLEARANCE CANNOT BE MET, DIAPHRAGM MAY BE SLOPED.

	DEPTH	DIAPHRAGM MEMBER	(N) BOLTS
ROLLED BEAM	24"	C15x33.9	4
	30"		
	31"	MC18x42.7	5
	36"		
PLATE GIRDER WEB	37"	W21x44	6
	42"		
PLATE GIRDER WEB	31"	W27x84	7
	36"		
	37"	W33x118	9
	42"		
	43"	W36x135	10
	48"		

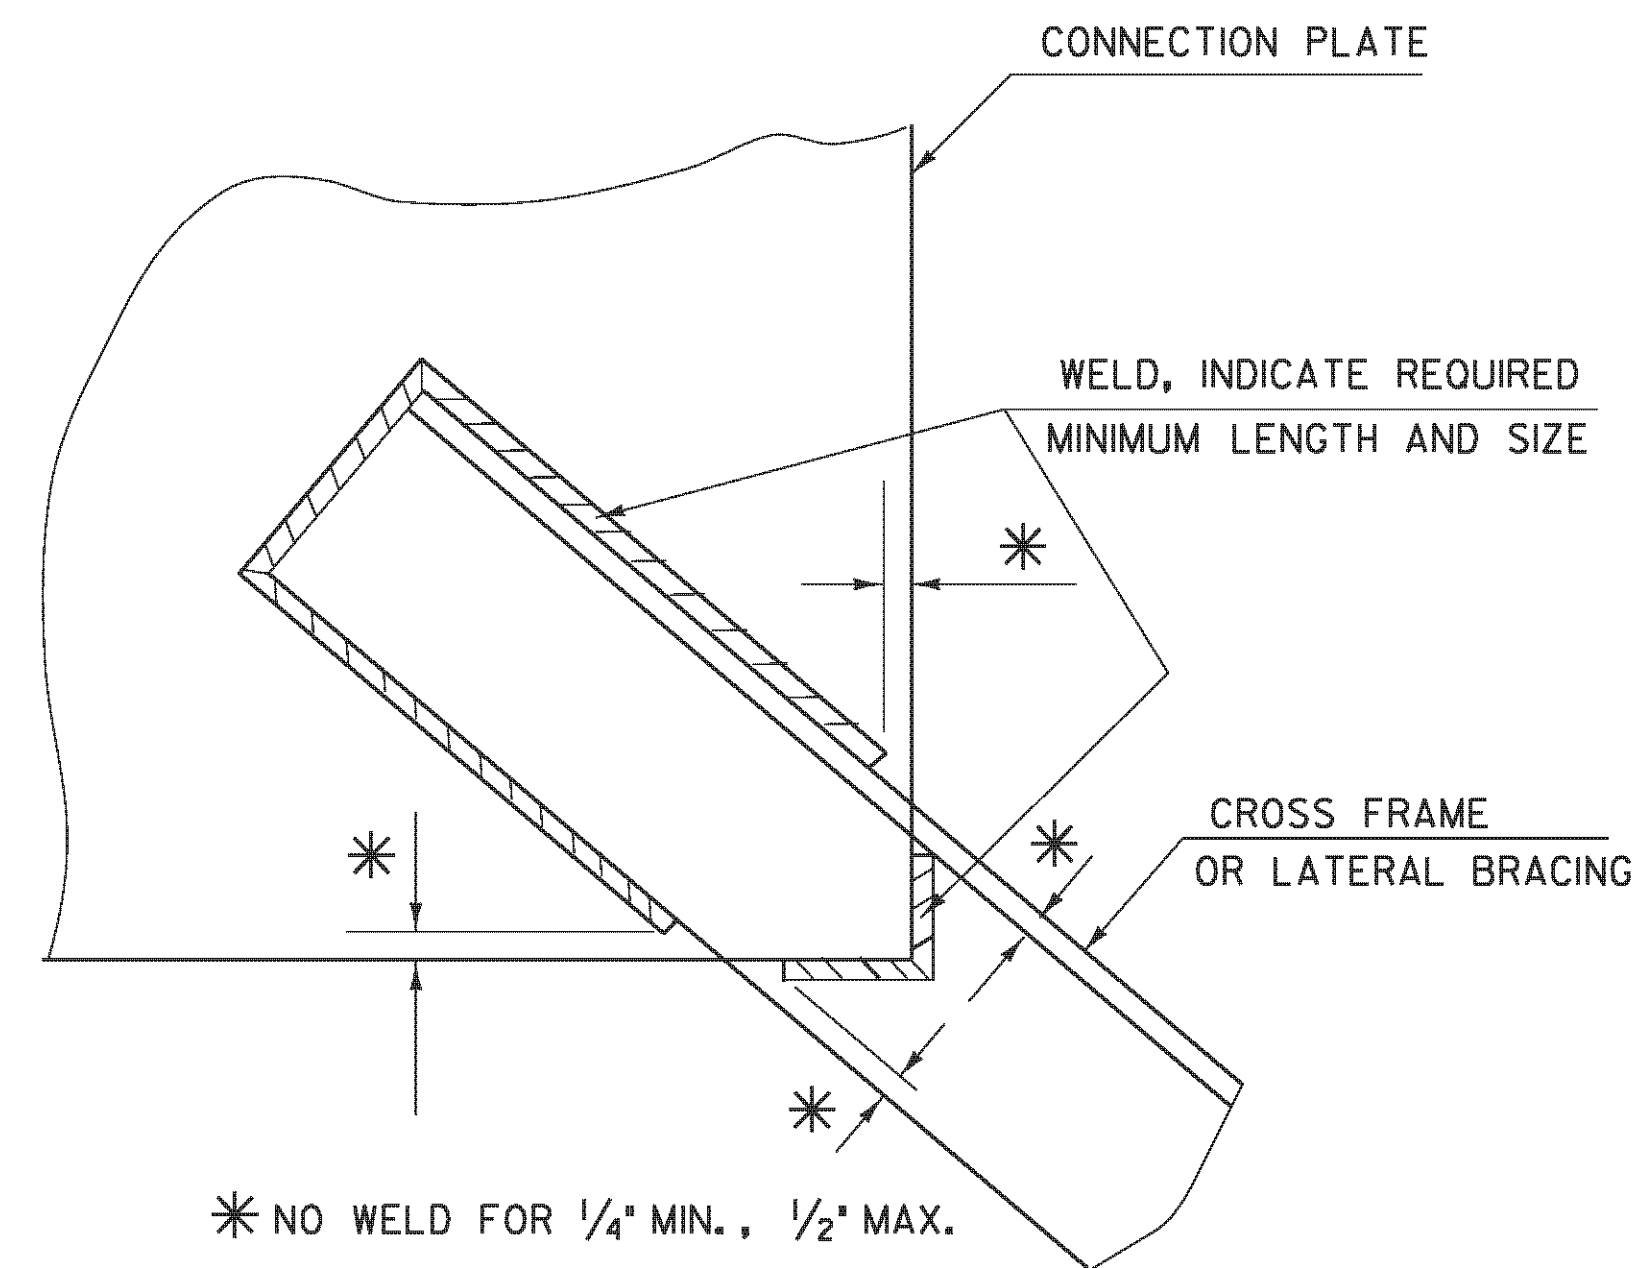

**WELD LOCATION DETAIL AT CROSS  
FRAMES AND LATERAL BRACING**

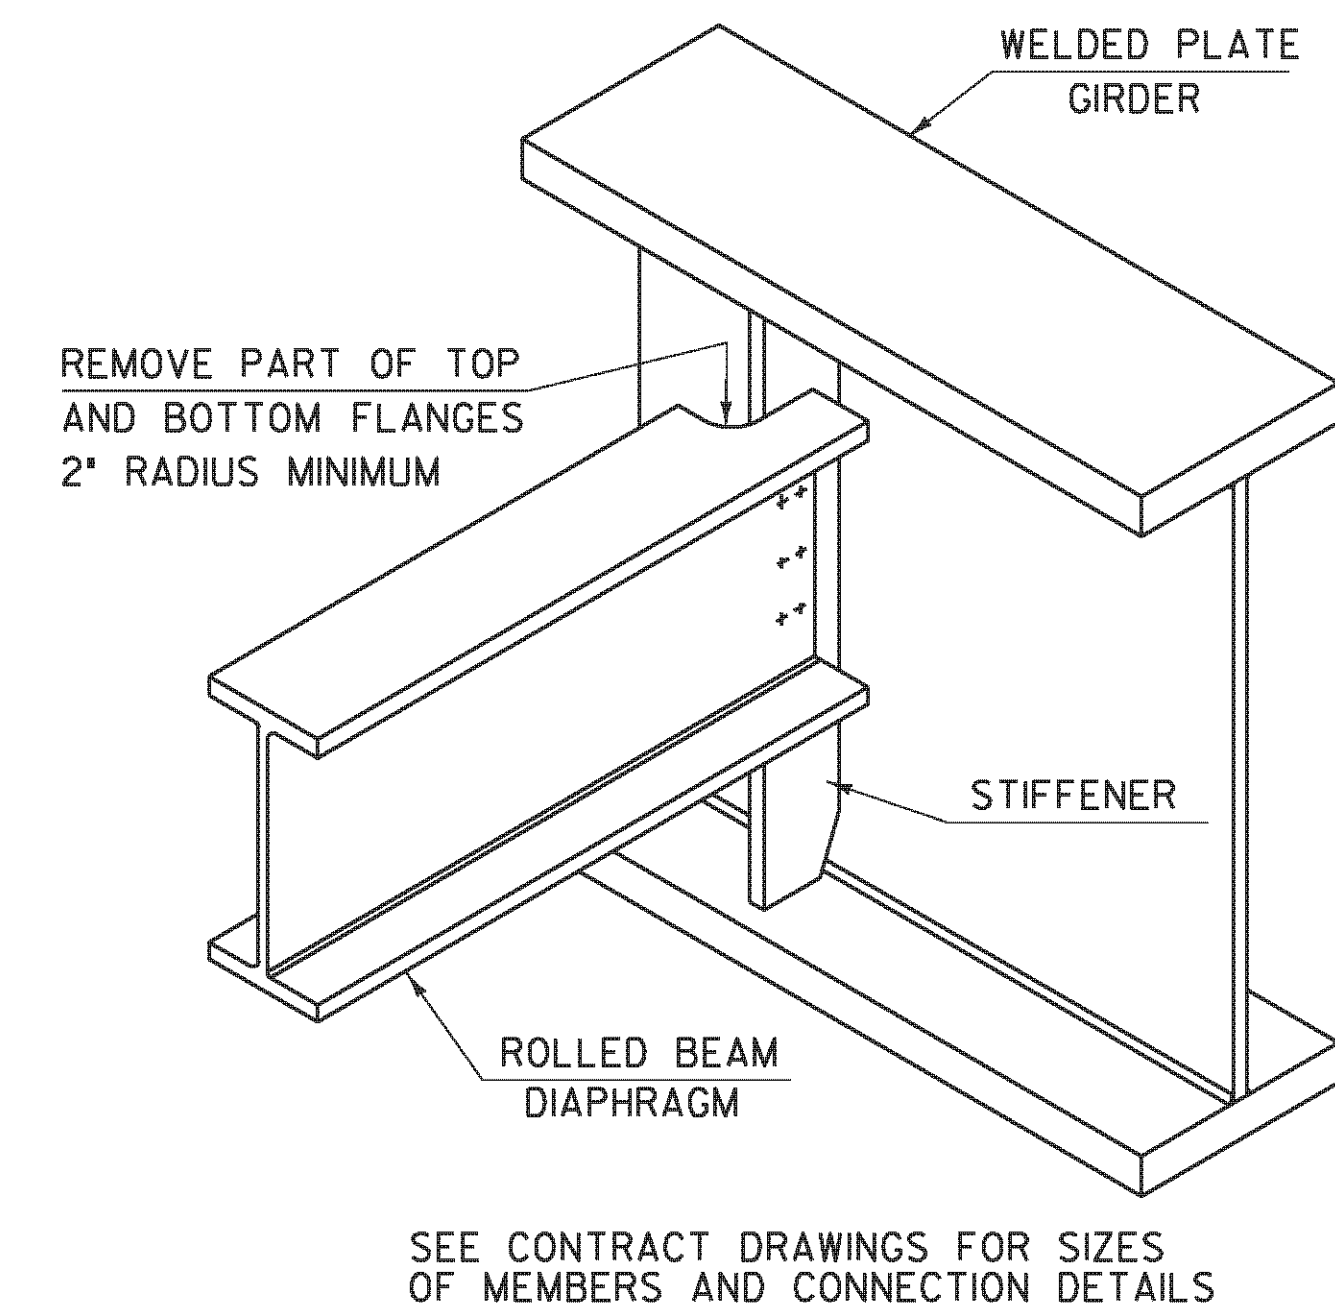


**ROLLED BEAM USED AS DIAPHRAGM**

DETAILS ON THIS SHEET ARE *NOT TO SCALE* UNLESS NOTED OTHERWISE.

REVISIONS	
MAY 7, 2010	APPROVED FOR USE BY VAOT STRUCTURES SECTION
MAY 2, 2011	ADD INTERMEDIATE DIAPHRAGMS DETAIL & ADD NOT TO SCALE NOTE

# STRUCTURAL STEEL PLATE GIRDER DETAILS AND NOTES

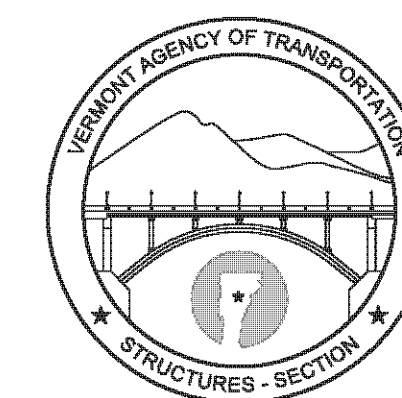

**STRUCTURES  
DETAIL  
SD-6 02.00**