




LAND SHOWN ON THIS PLAN IS EITHER
 PUBLICLY OWNED OR BELONGS TO
 AN ADJACENT LOT OWNER WHO HAS
 GIVEN PERMISSION TO USE THE
 STATE OF VERMONT'S ACQUISITION OF EASE
 AND RIGHT FOR THIS PROJECT.

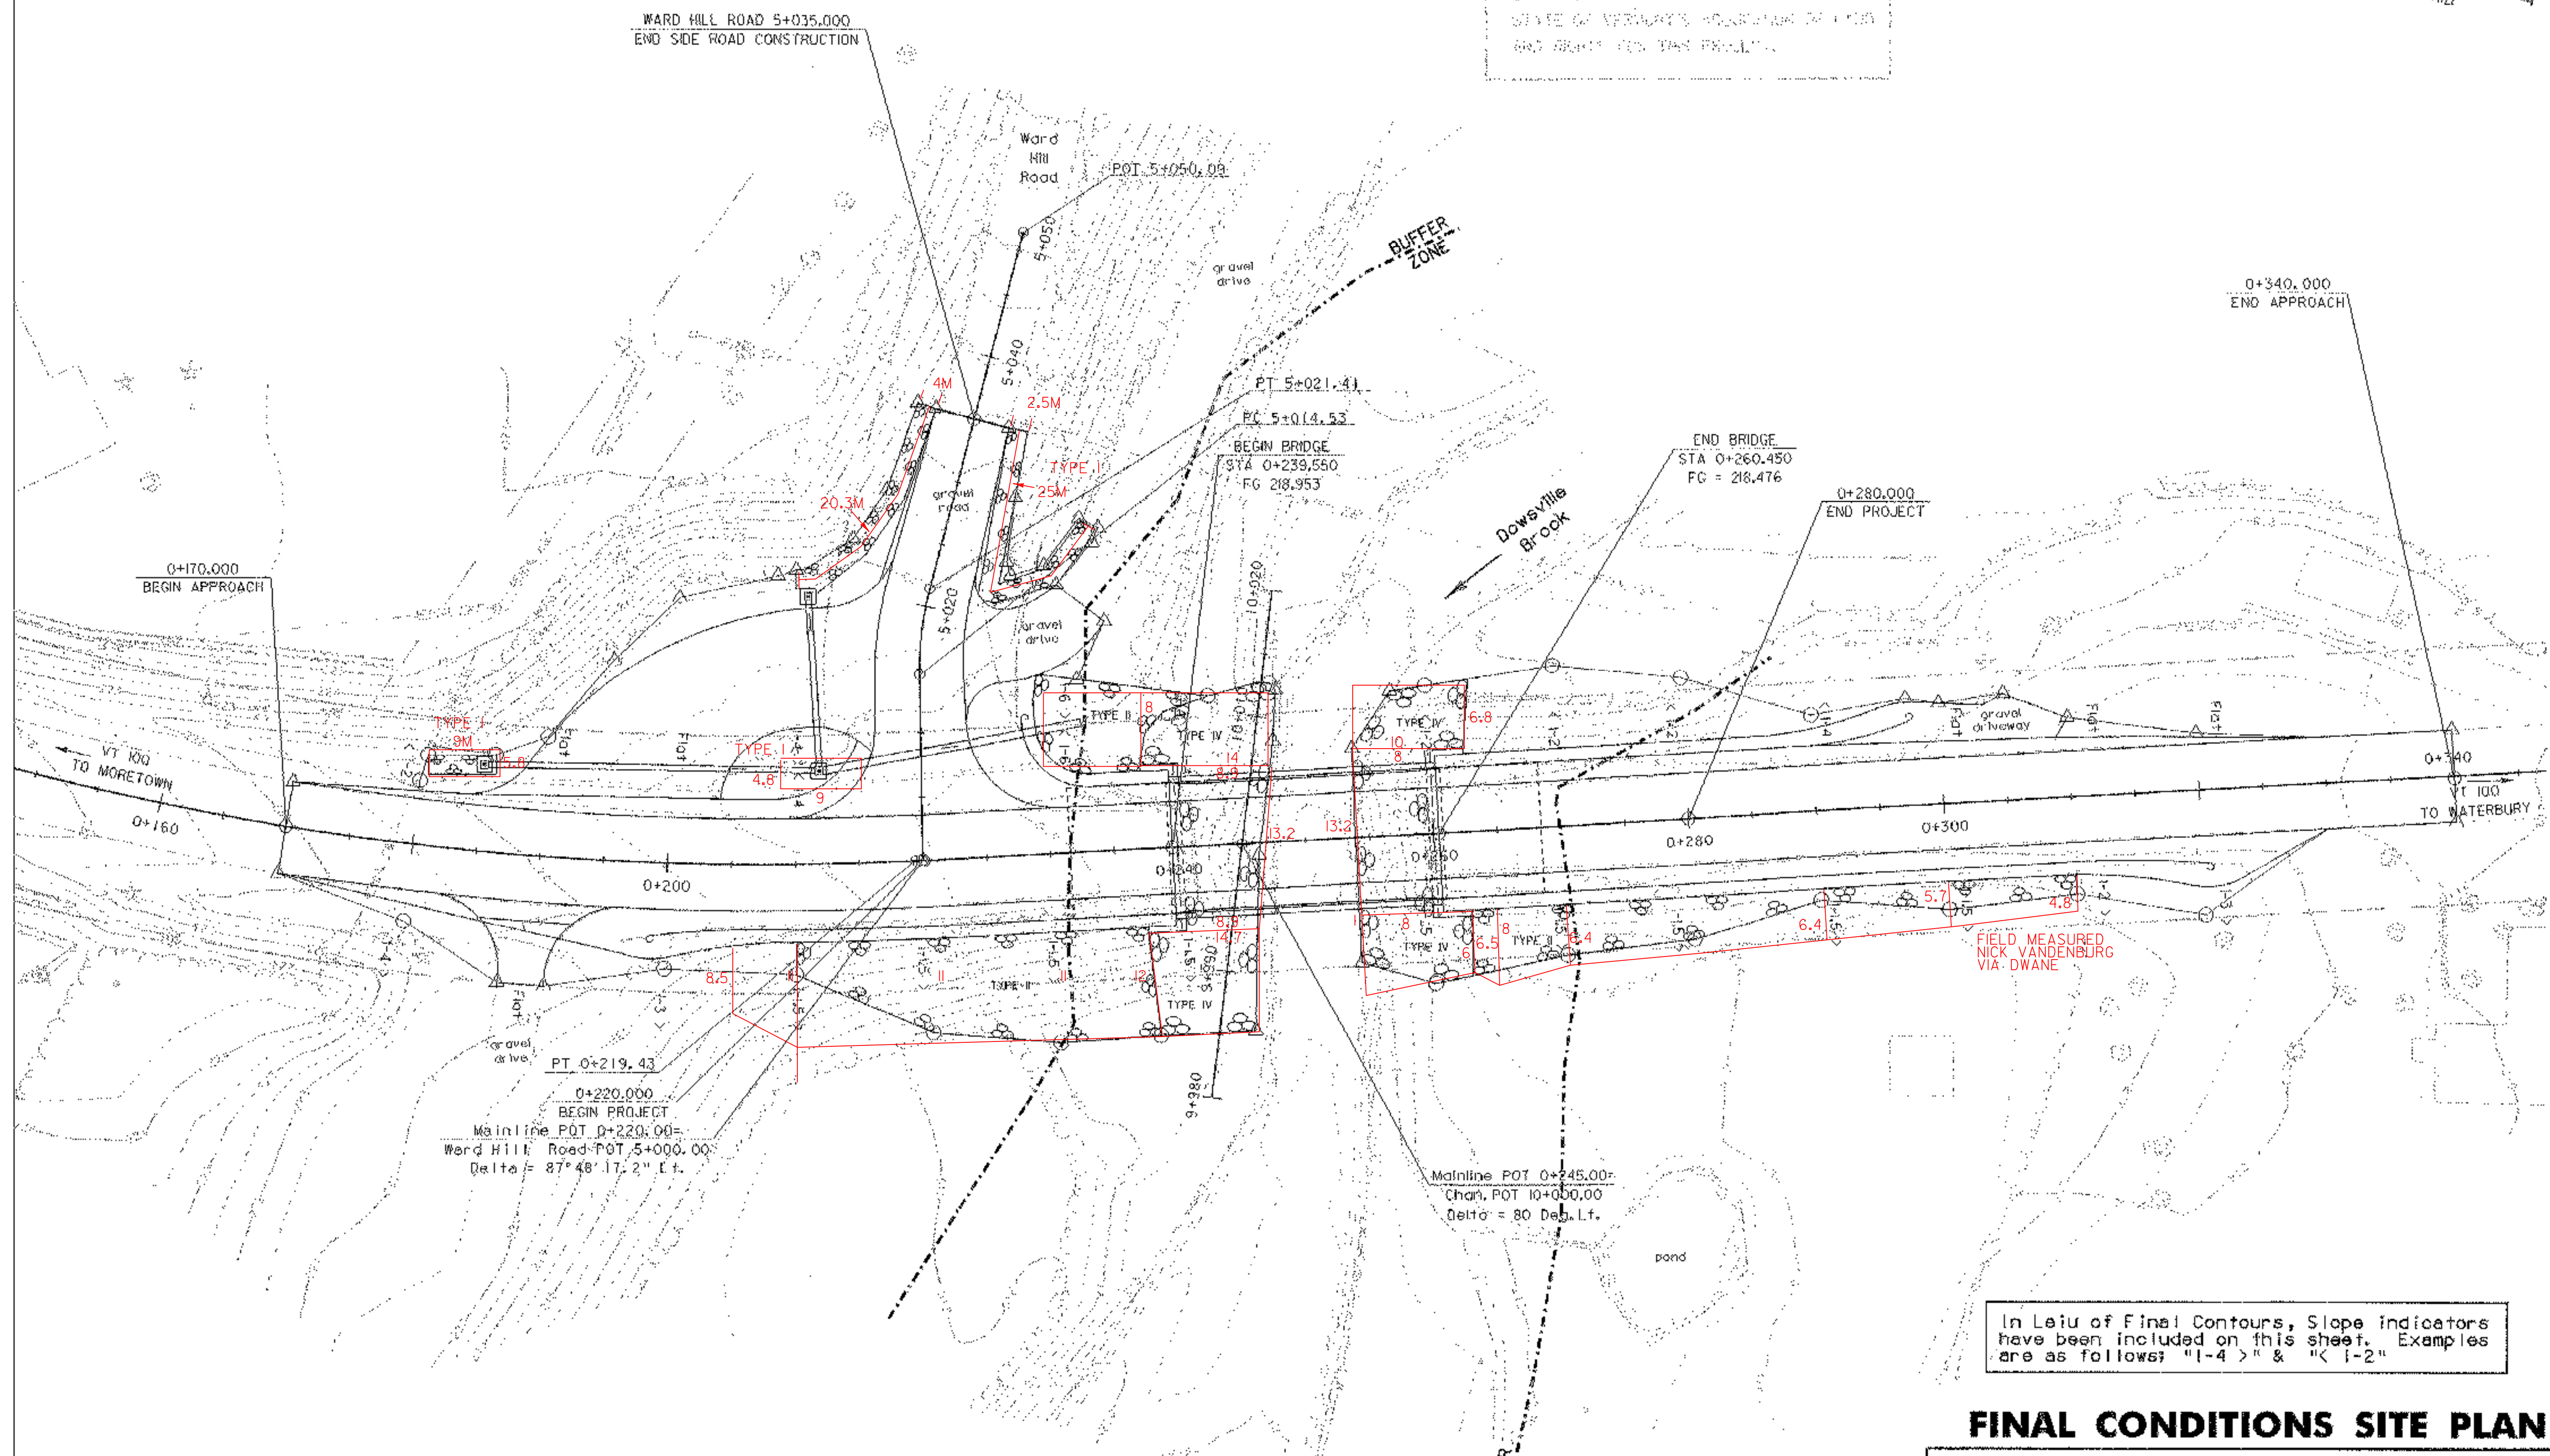

In Lieu of Final Contours, Slope indicators
 have been included on this sheet. Examples
 are as follows: "1-4 >" & "< 1-2"

DATUM
 VERTICAL NAVD88
 HORIZONTAL NAD 83 (992)



IMPACTS WITHIN THE
 BUFFER ZONE SHALL
 BE MINIMIZED.

FINAL CONDITIONS SITE PLAN

PROJECT NAME:	DUXBURY	PLOT DATE:	20-OCT-2005
PROJECT NUMBER:	STP 013-4(24)	DRAWN BY:	J. GILMORE
FILE NAME:	/s/r/5/86e059/se059ec.dgn	CHECKED BY:	T. SUMNER
PROJECT LEADER:	C. KELLER	SHEET	23 OF 62
DESIGNED BY:	B. NYQUIST		
	se059ec.d		