

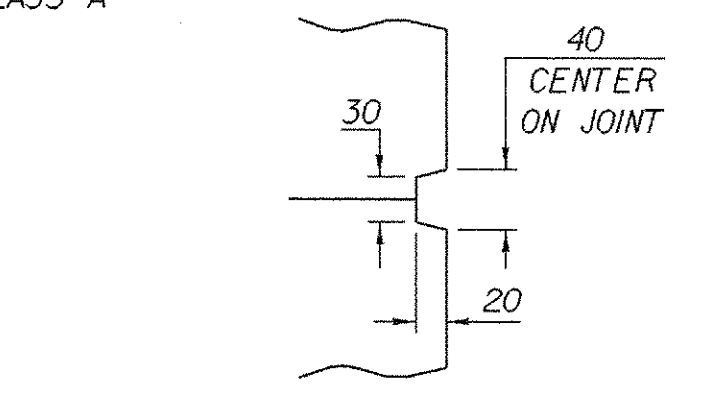


DECK TYPICAL SECTION


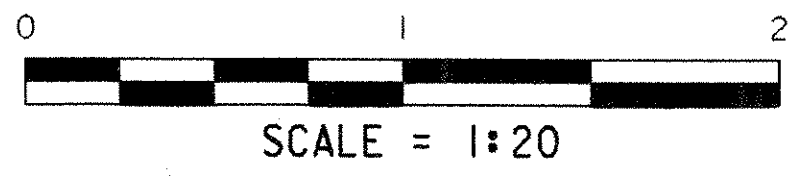


SCORE MARK DETAIL
NTS


NOTE:
SHEET MEMBRANE WATERPROOFING SHALL EXTEND TO FACE OF CURB AS SHOWN BELOW.

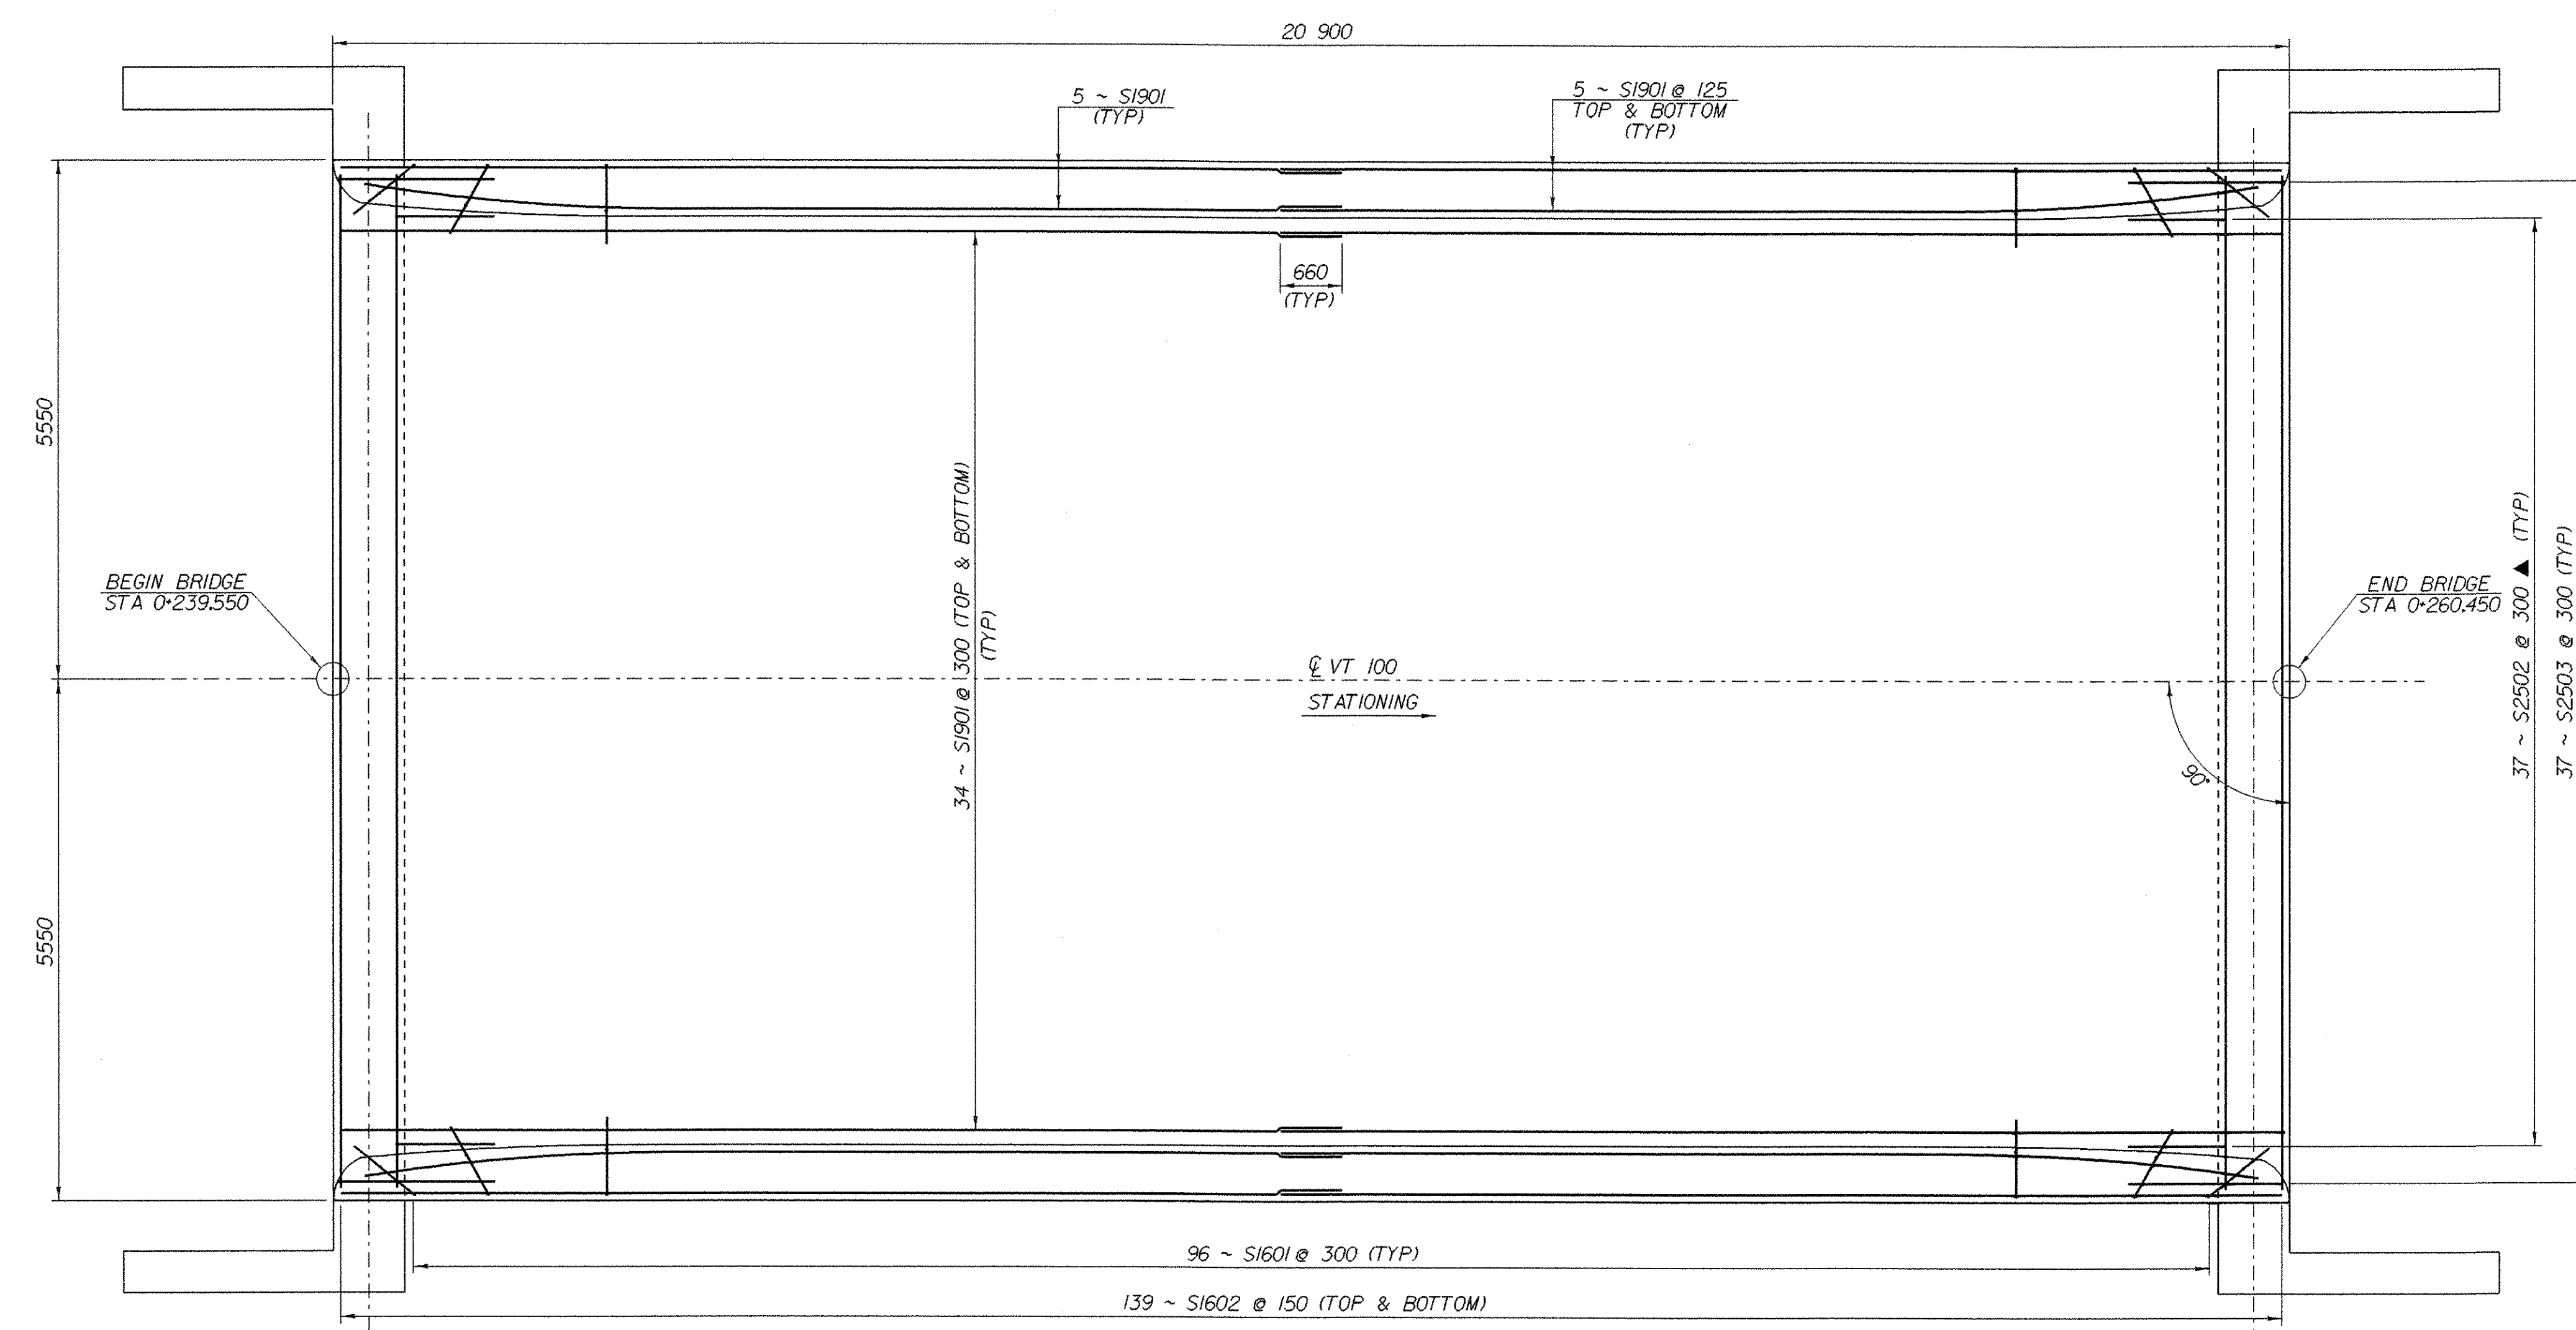

DECK PLAN

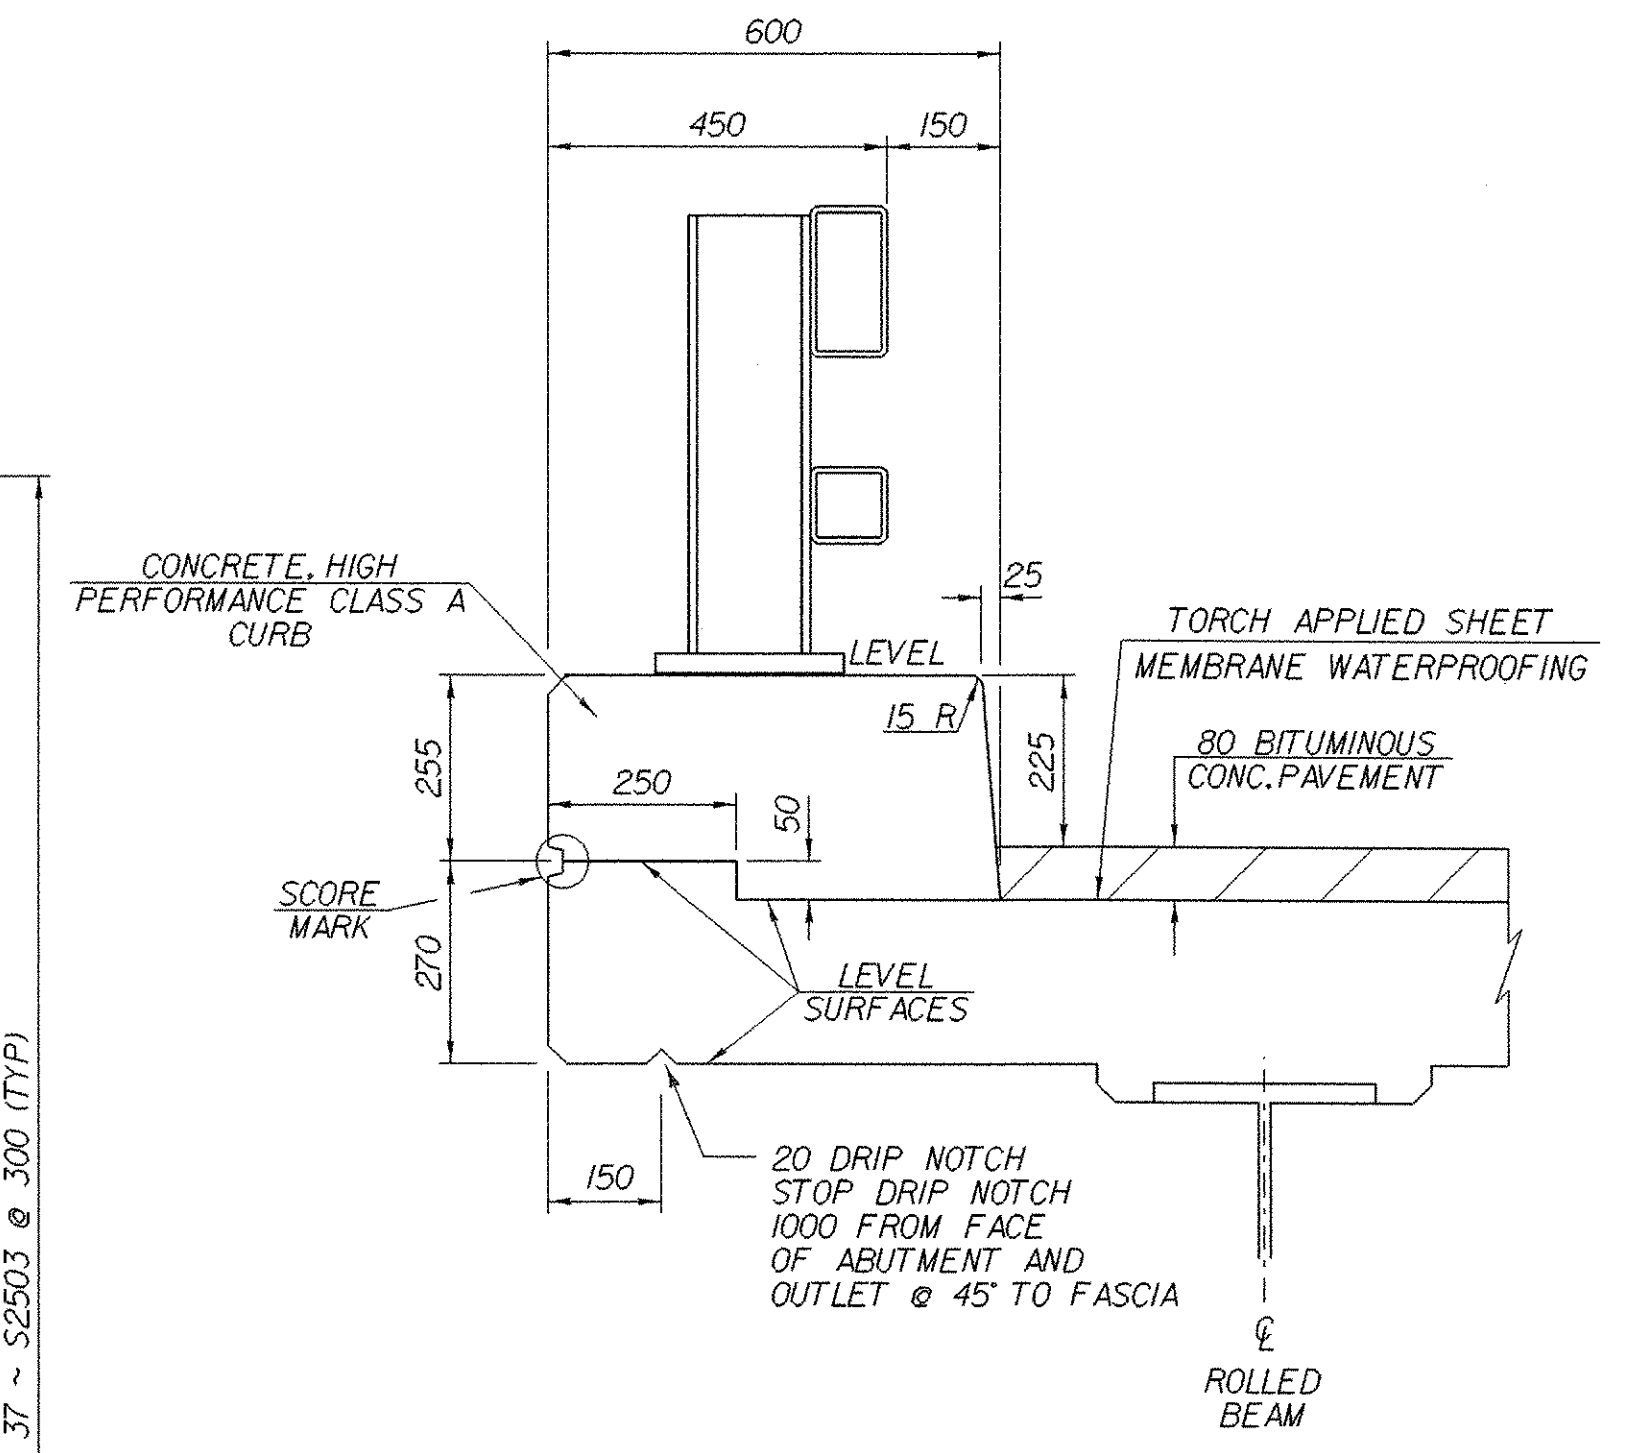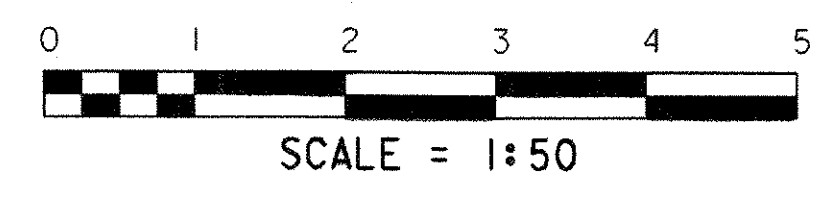

TYPICAL 600 CURB SECTION

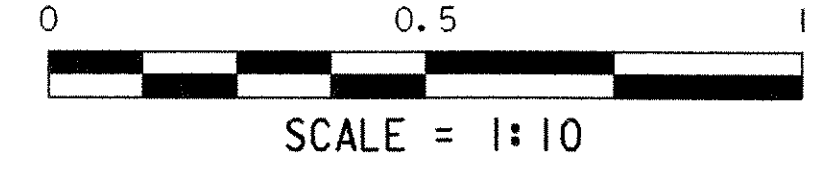

DECK TYPICAL AND DECK PLAN

PROJECT NAME: DUXBURY	PLOT DATE: 20-OCT-2005
PROJECT NUMBER: STP 013-4(24)	DRAWN BY: R. VANHAMBURG
FILE NAME: /s/r5/86e059/se059sup.dgn	CHECKED BY: T. SUMNER
PROJECT LEADER: C. KELLER	SHEET 34 OF 62
DESIGNED BY: W. FARLEY	
se059dck.i	