

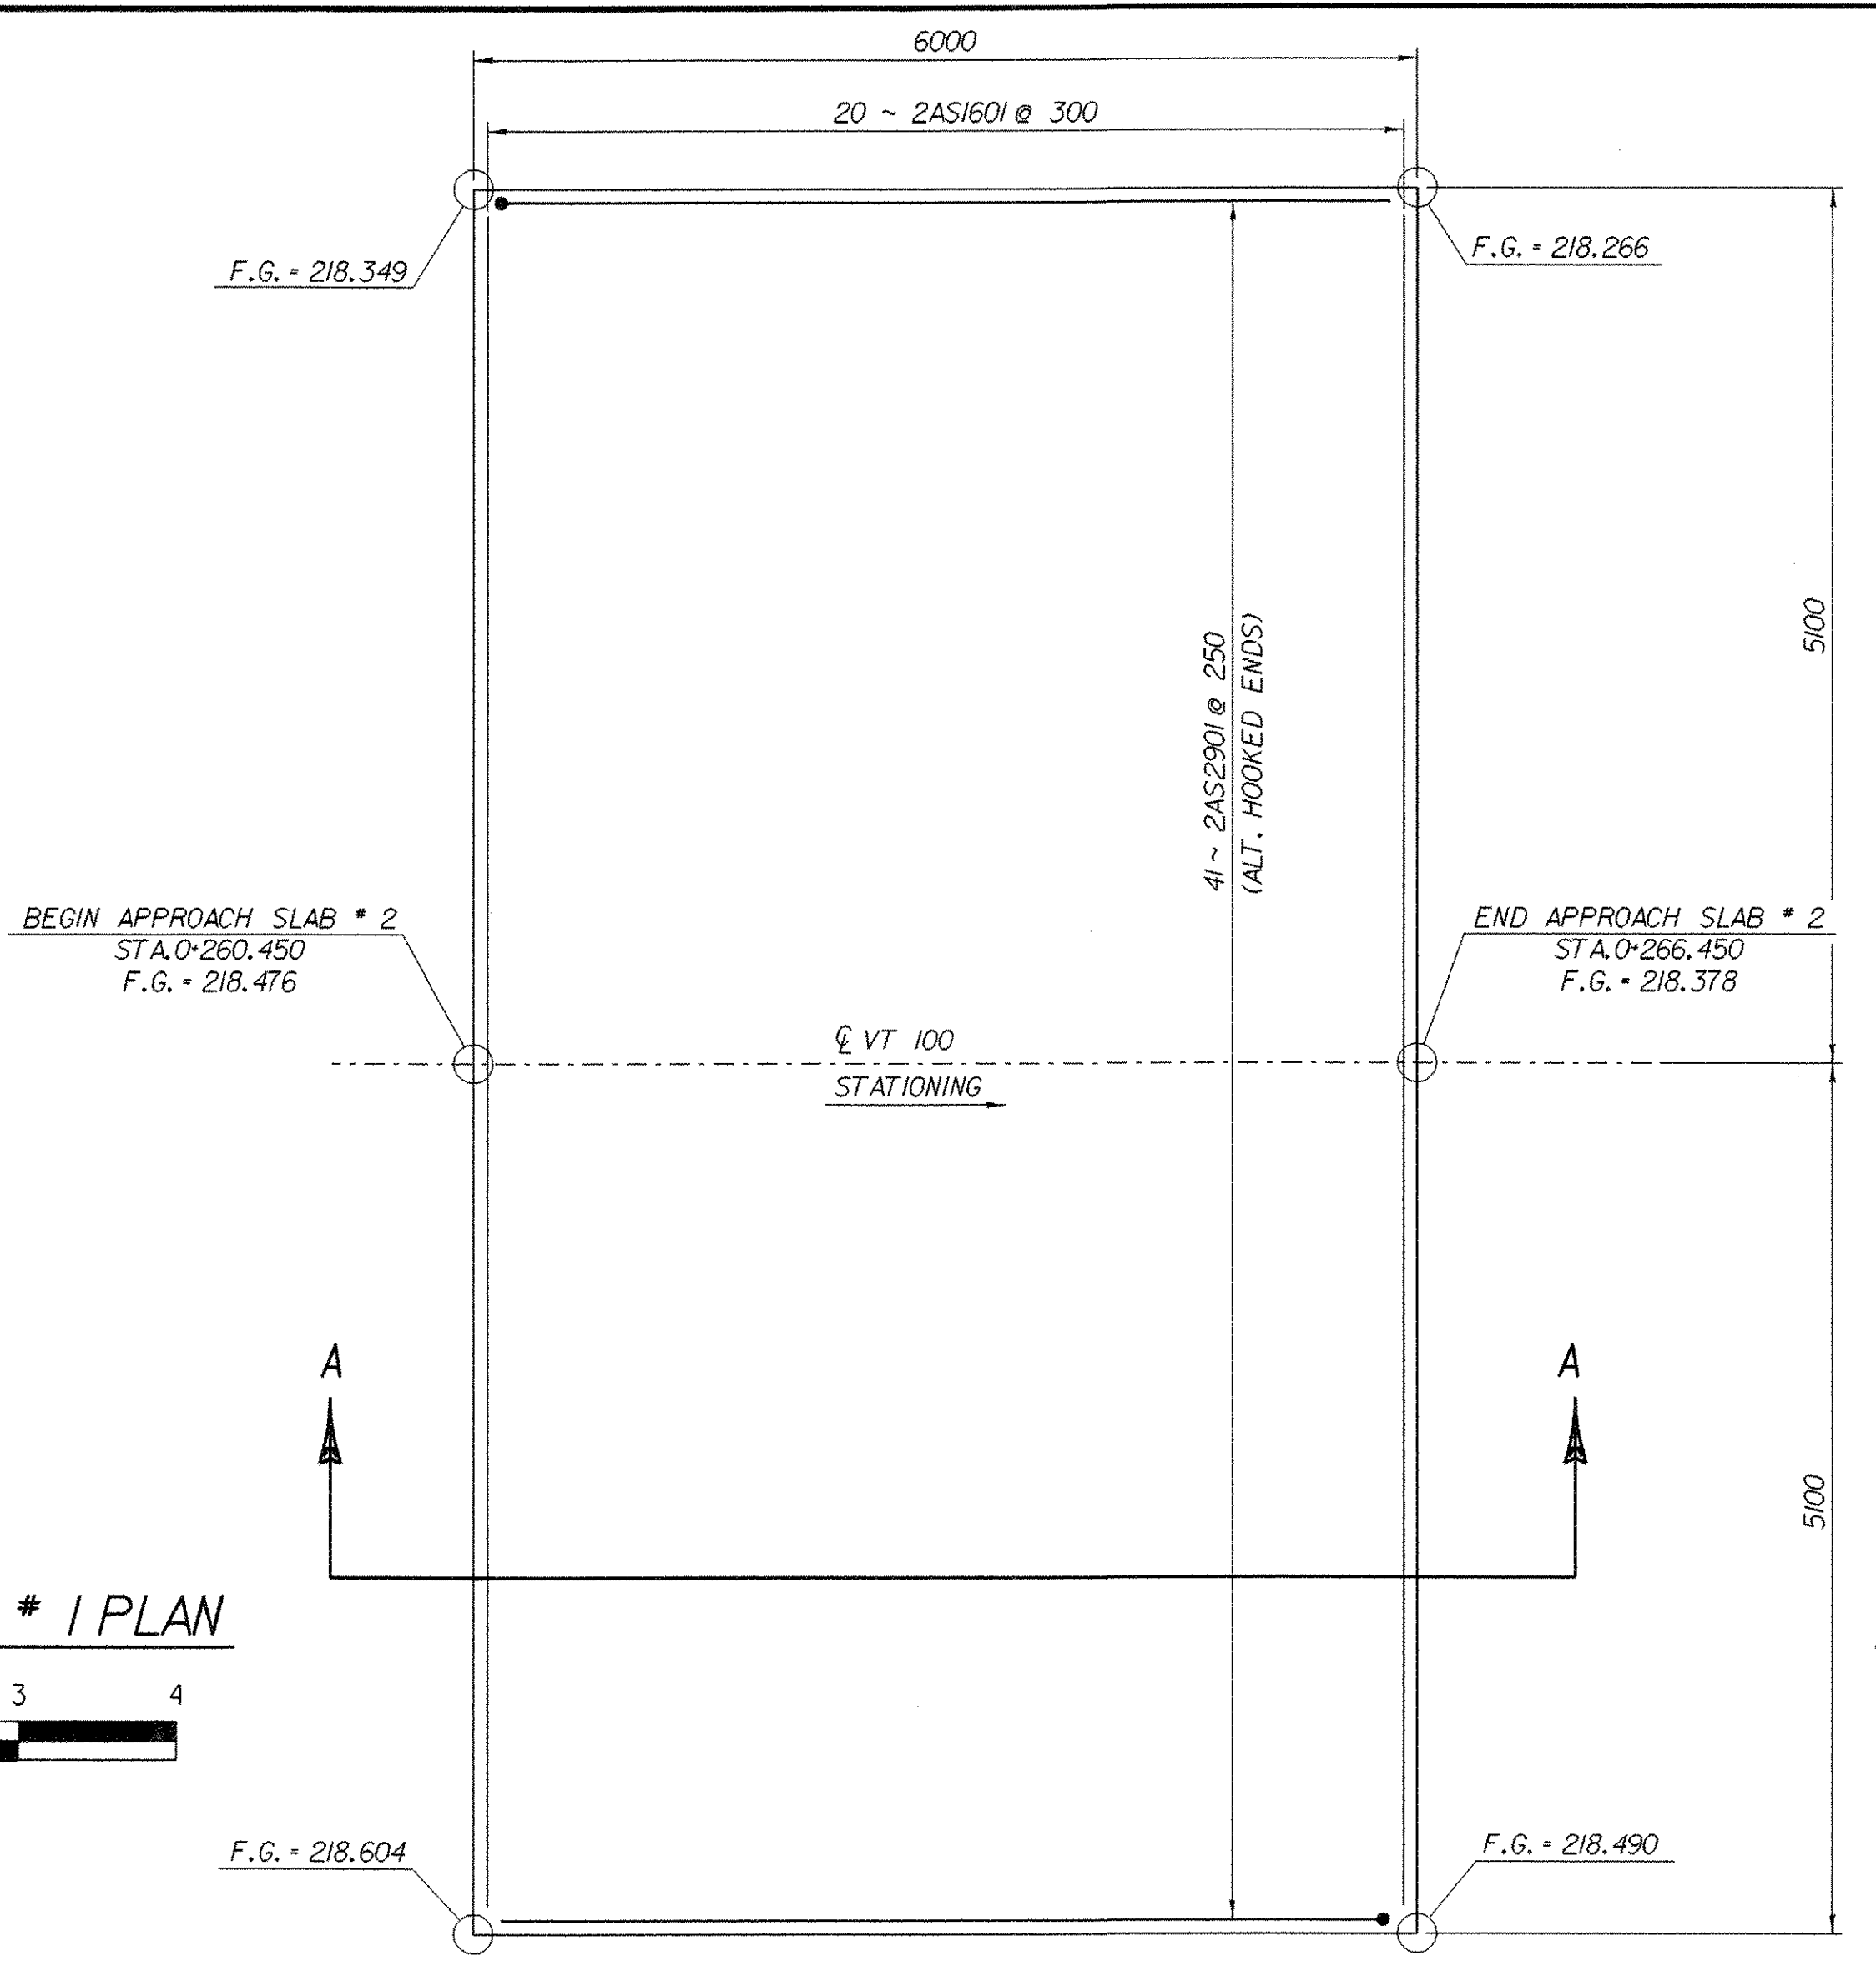



**APPROACH SLAB # 1 PLAN**  
 SCALE = 1:40

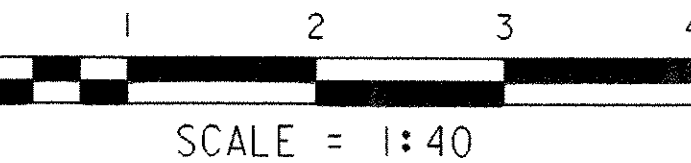


**APPROACH SLAB # 2 PLAN**  
 SCALE = 1:40

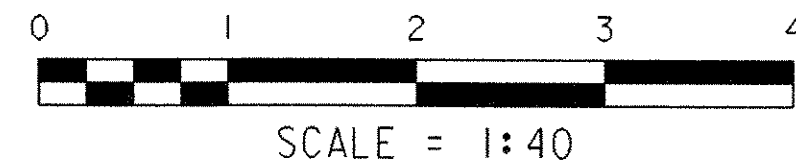

\* ALL REINFORCING STEEL WILL BE EPOXY COATED REINFORCING STEEL

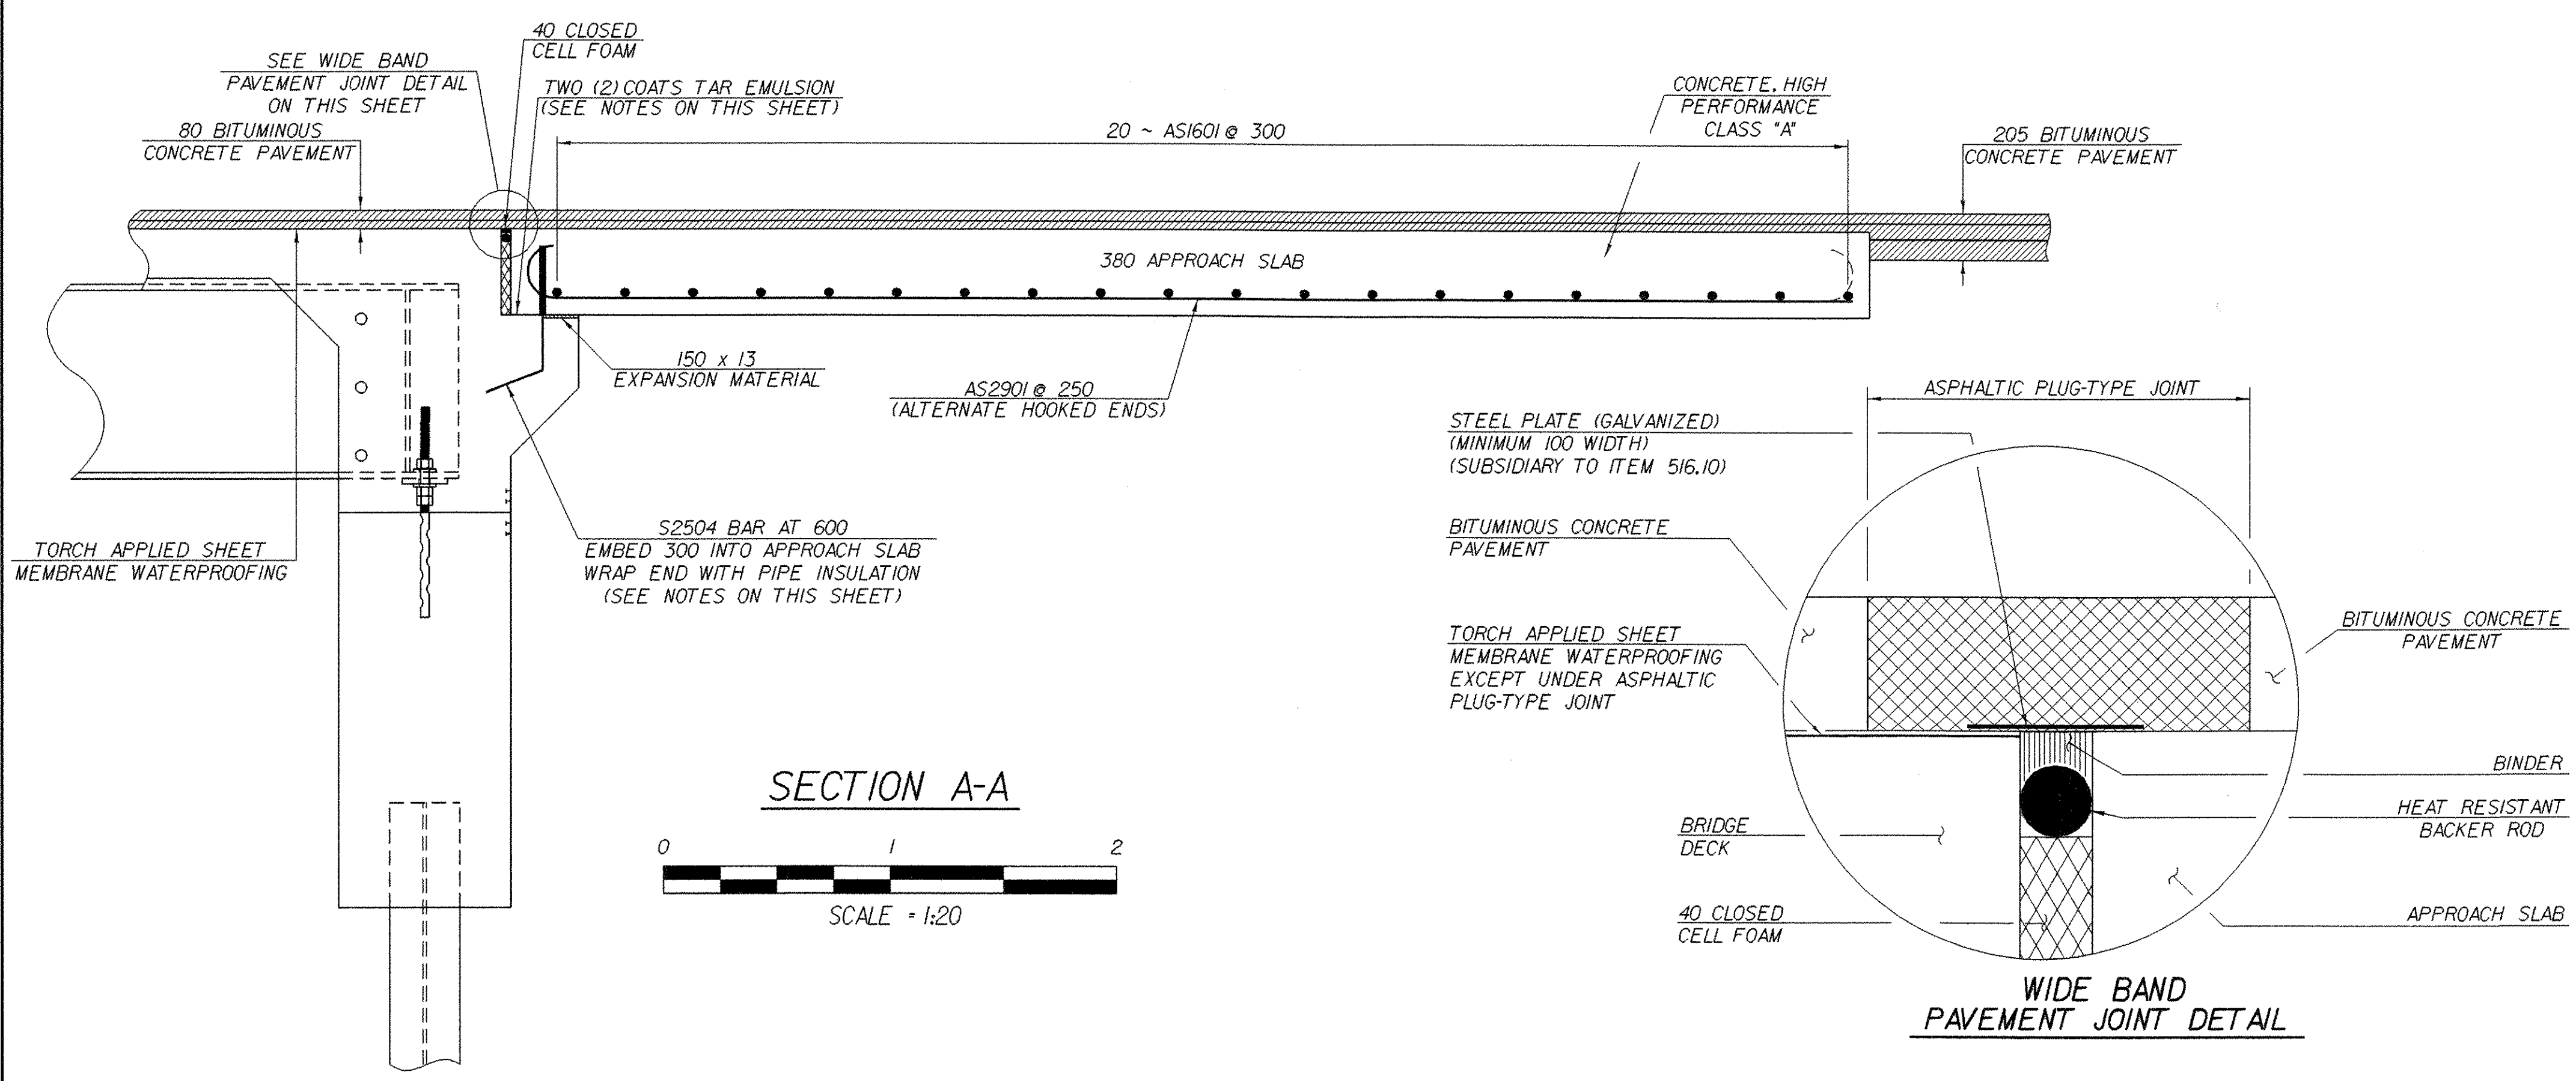

**SECTION A-A**  
 SCALE = 1:20

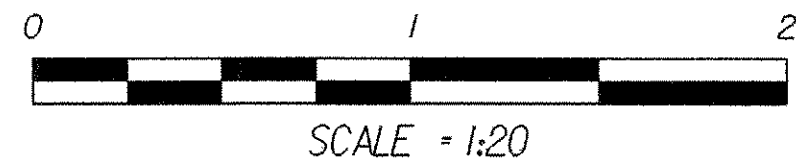

- NOTES:**
- PAYMENT FOR TAR EMULSION, PIPE INSULATION AND EXPANSION MATERIAL AND THEIR APPLICATION AND INSTALLATION SHALL BE INCIDENTAL TO ITEM 501.33, "CONCRETE, HIGH PERFORMANCE CLASS A".
  - 75 CLEAR UNLESS OTHERWISE NOTED.

**APPROACH SLAB DETAILS**

PROJECT NAME:	DUXBURY	PLOT DATE:	20-OCT-2005
PROJECT NUMBER:	STP 013-4(24)	DRAWN BY:	R. VANHAMBURG
FILE NAME:	/str5/86e059/se059sup.dgn	CHECKED BY:	T. SUMNER
PROJECT LEADER:	C. KELLER	SHEET	37 OF 62
DESIGNED BY:	W. FARLEY		
se059apr.1			