



**Mainline (VT Route 100)  
Material Transition Diagram**

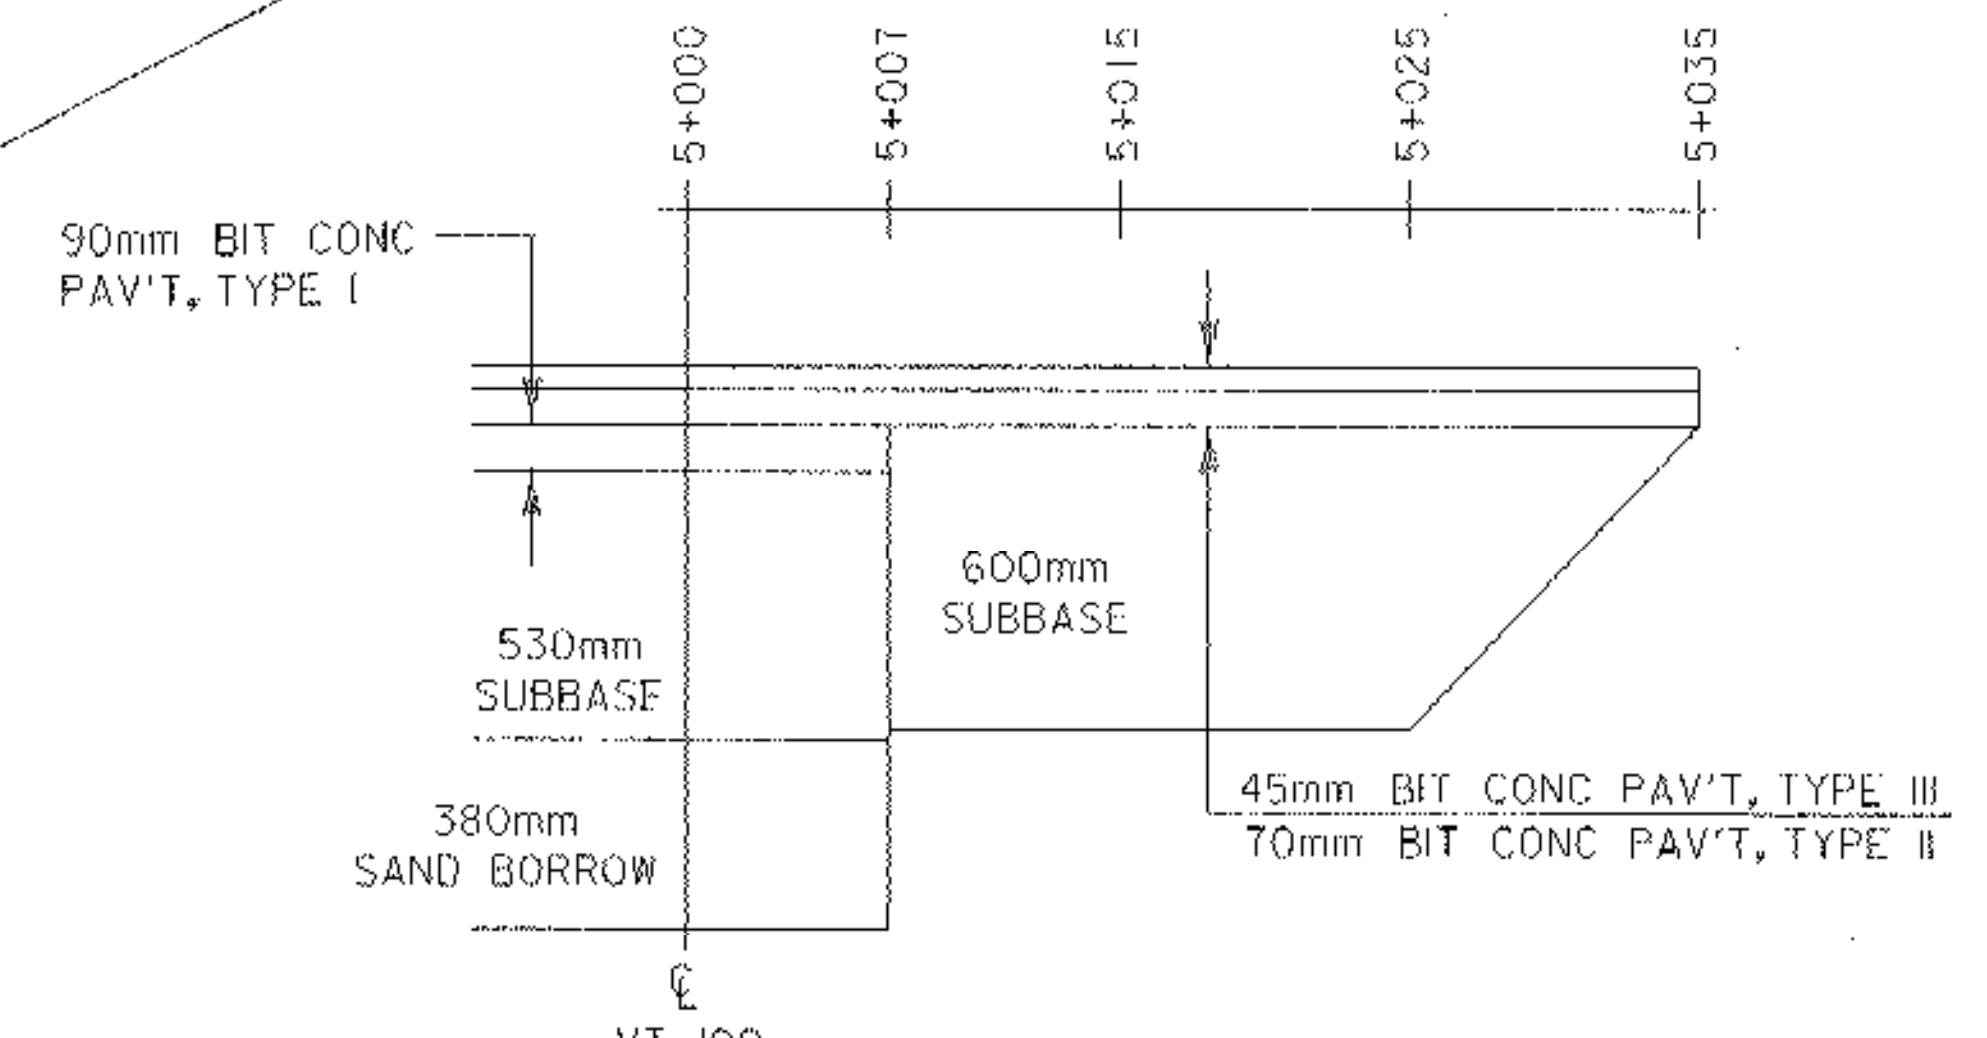

**Sideline (Ward Hill Road)  
Material Transition Diagram**

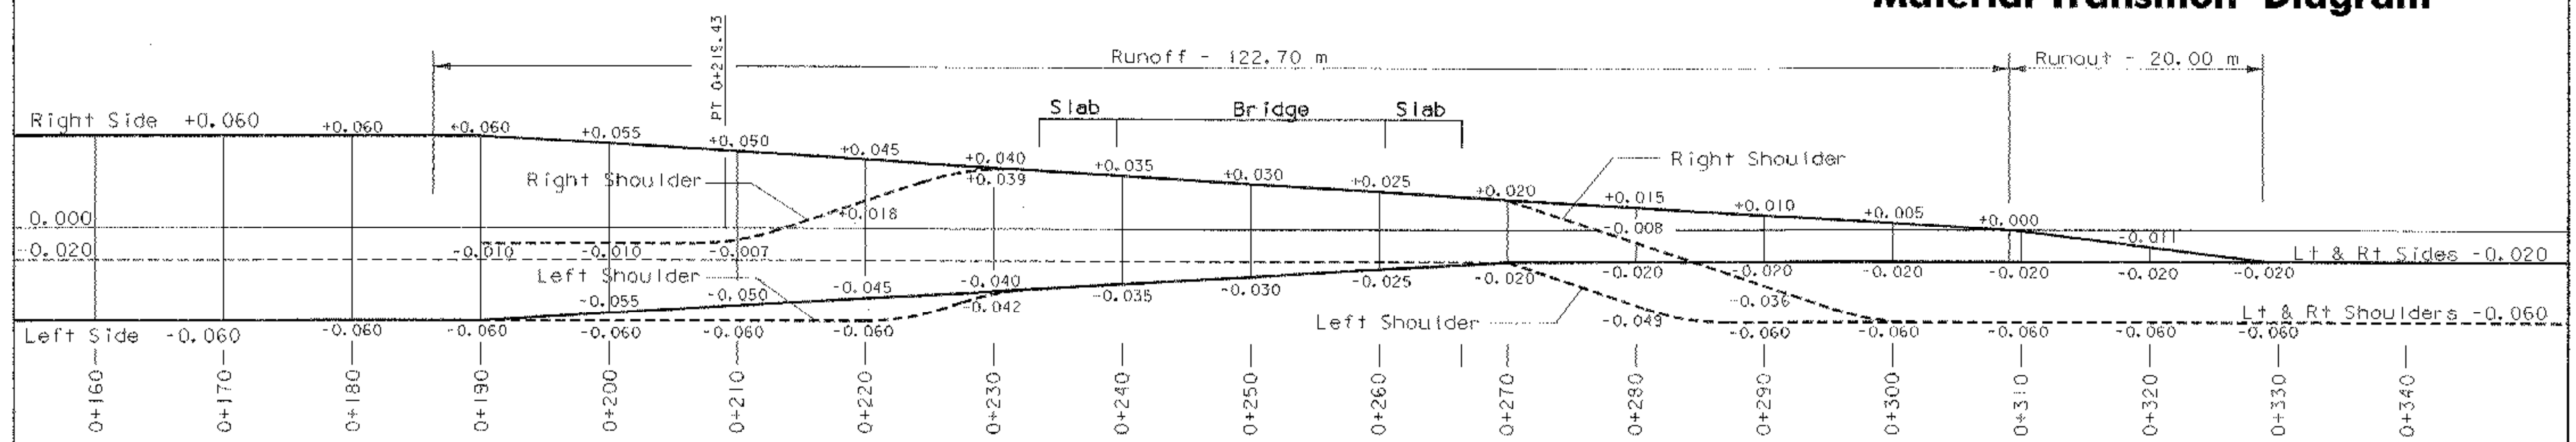

**Mainline (VT Route 100)  
Superelevation Diagram**

**MATERIAL TRANSITION DIAGRAM  
SUPERELEVATION DIAGRAM**

PROJECT NAME:	DUXBURY	FILE NAME:	/str/5/86e059/se059xsl.dgn	PLOT DATE:	20-OCT-2005
PROJECT NUMBER:	STP 013-4(24)	PROJECT LEADER:	C. KELLER	DRAWN BY:	Grow
		DESIGNED BY:	B. NYQUIST	CHECKED BY:	T. SUMNER
			se059mtd.i		SHEET 47 OF 62