




0+210 RT.
BEGIN 1-1.5 SLOPE
W/ STONE FILL TYPE II

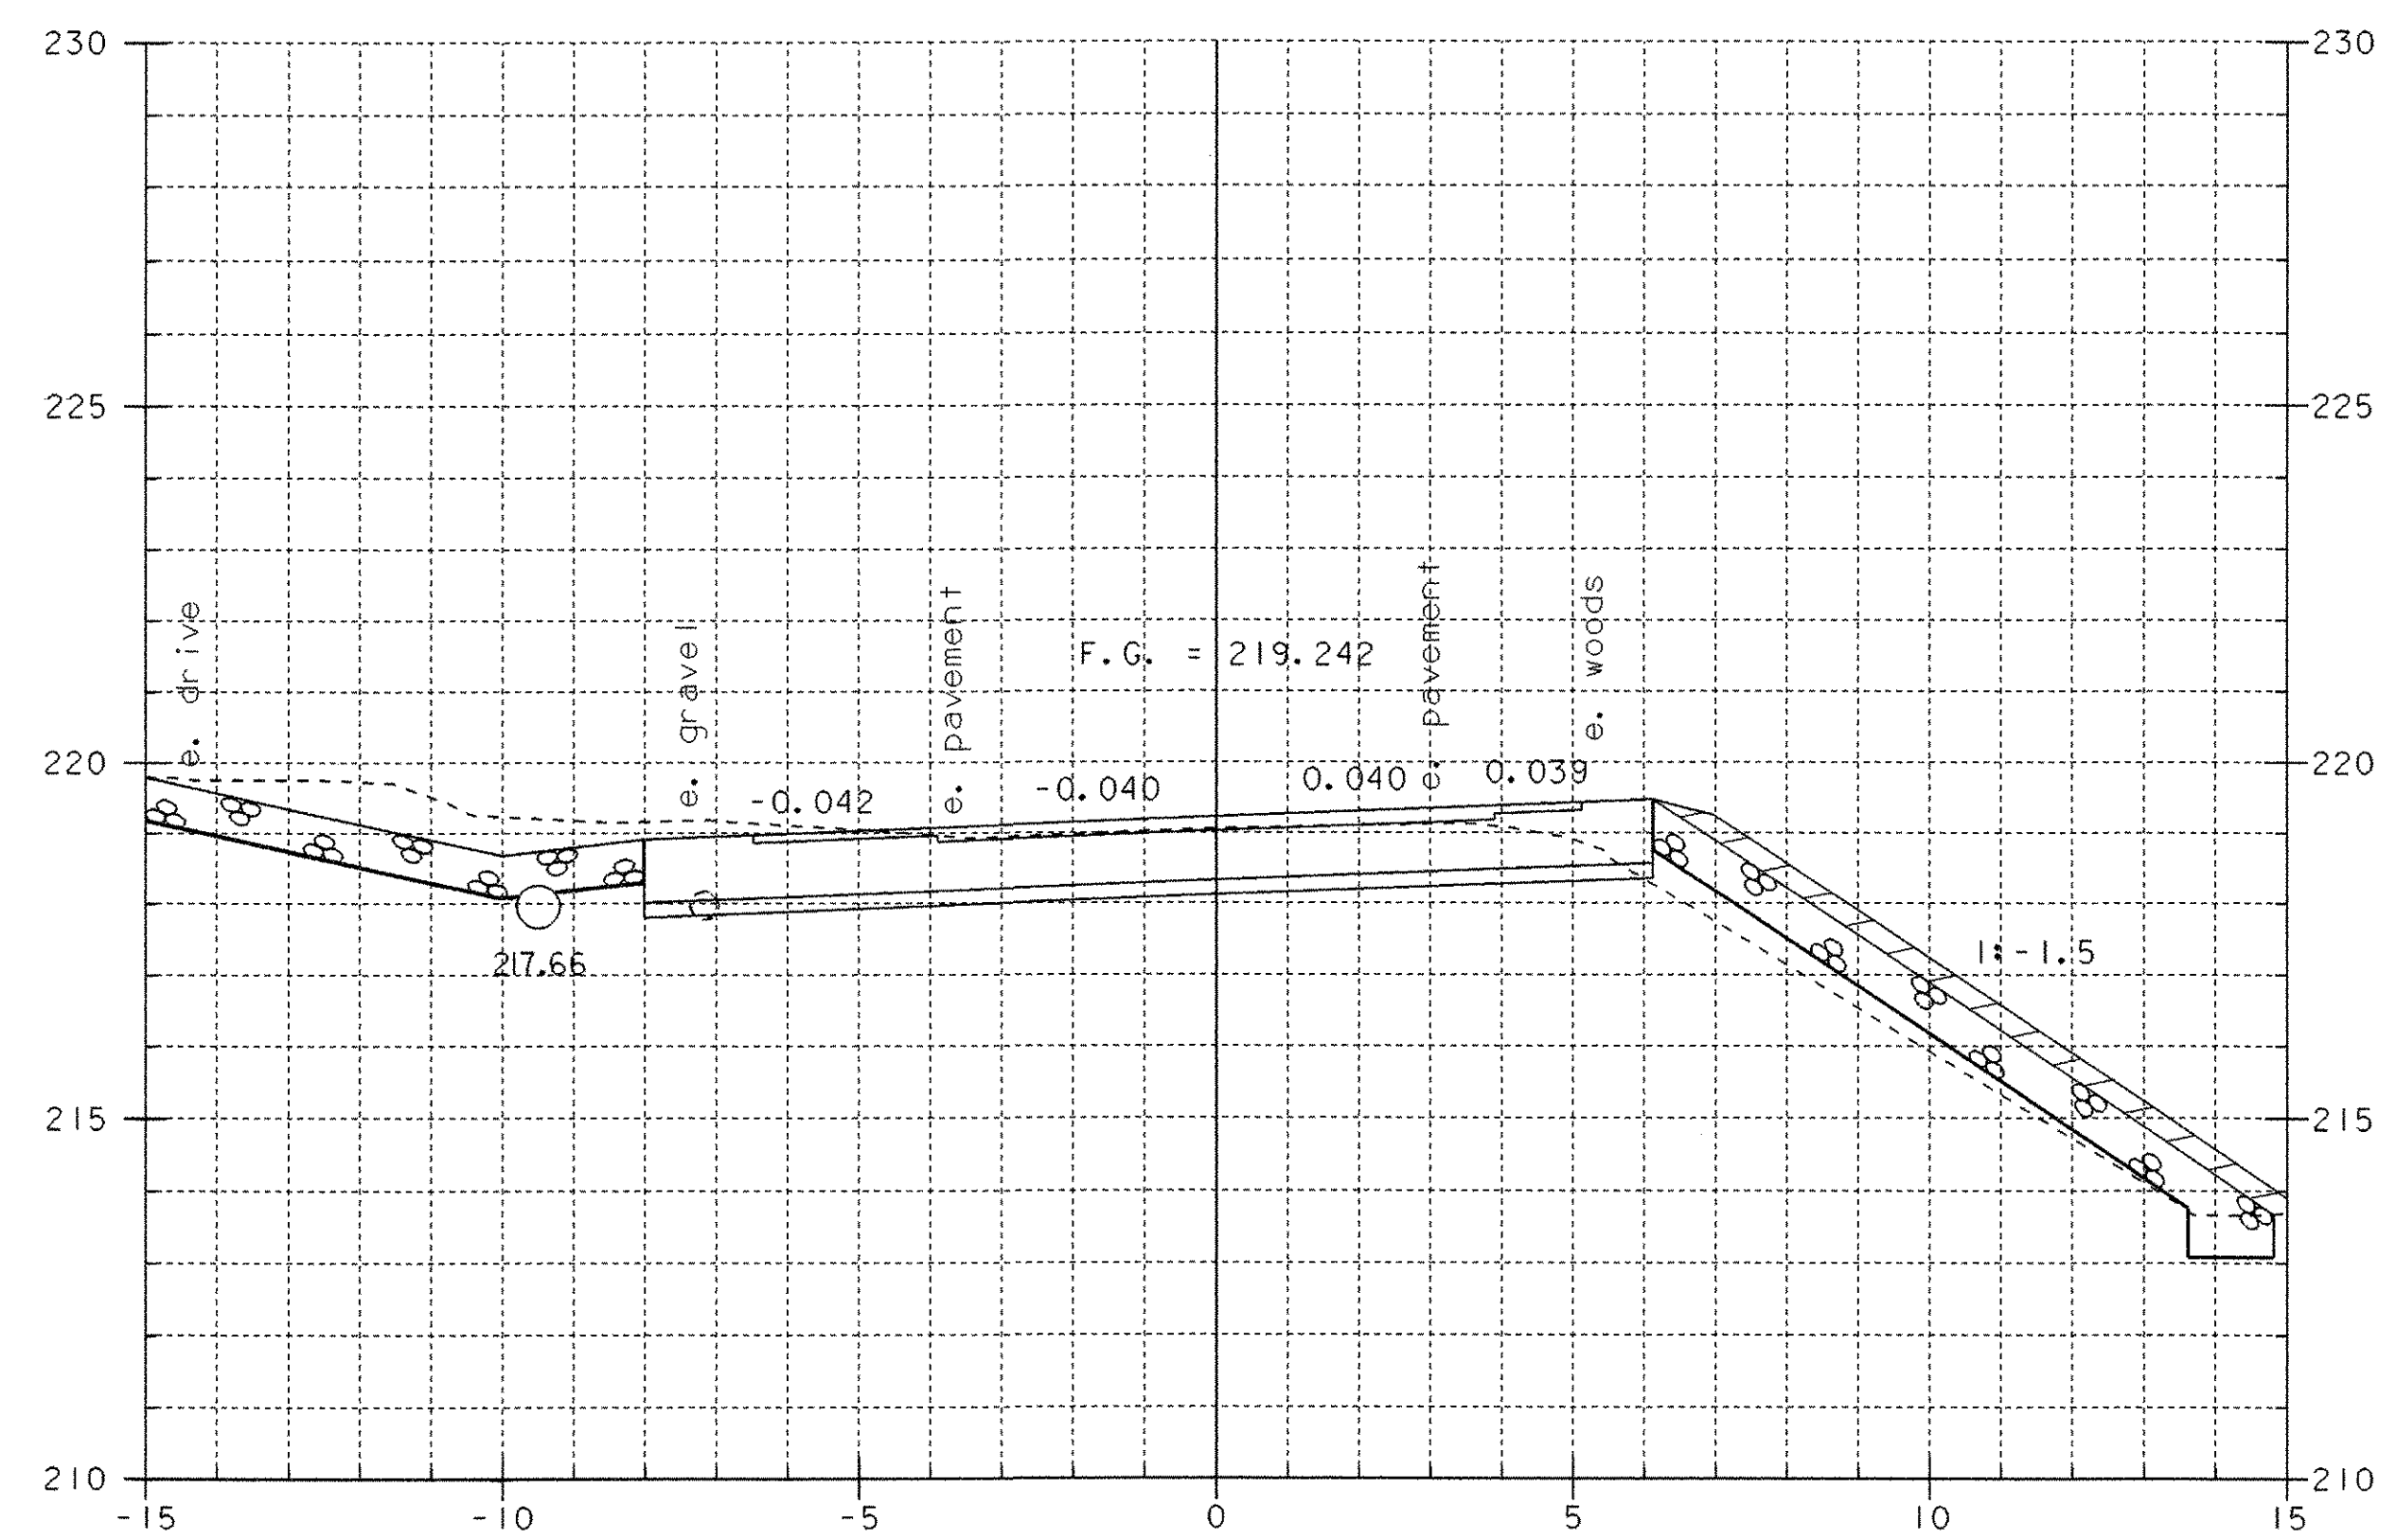

0+230

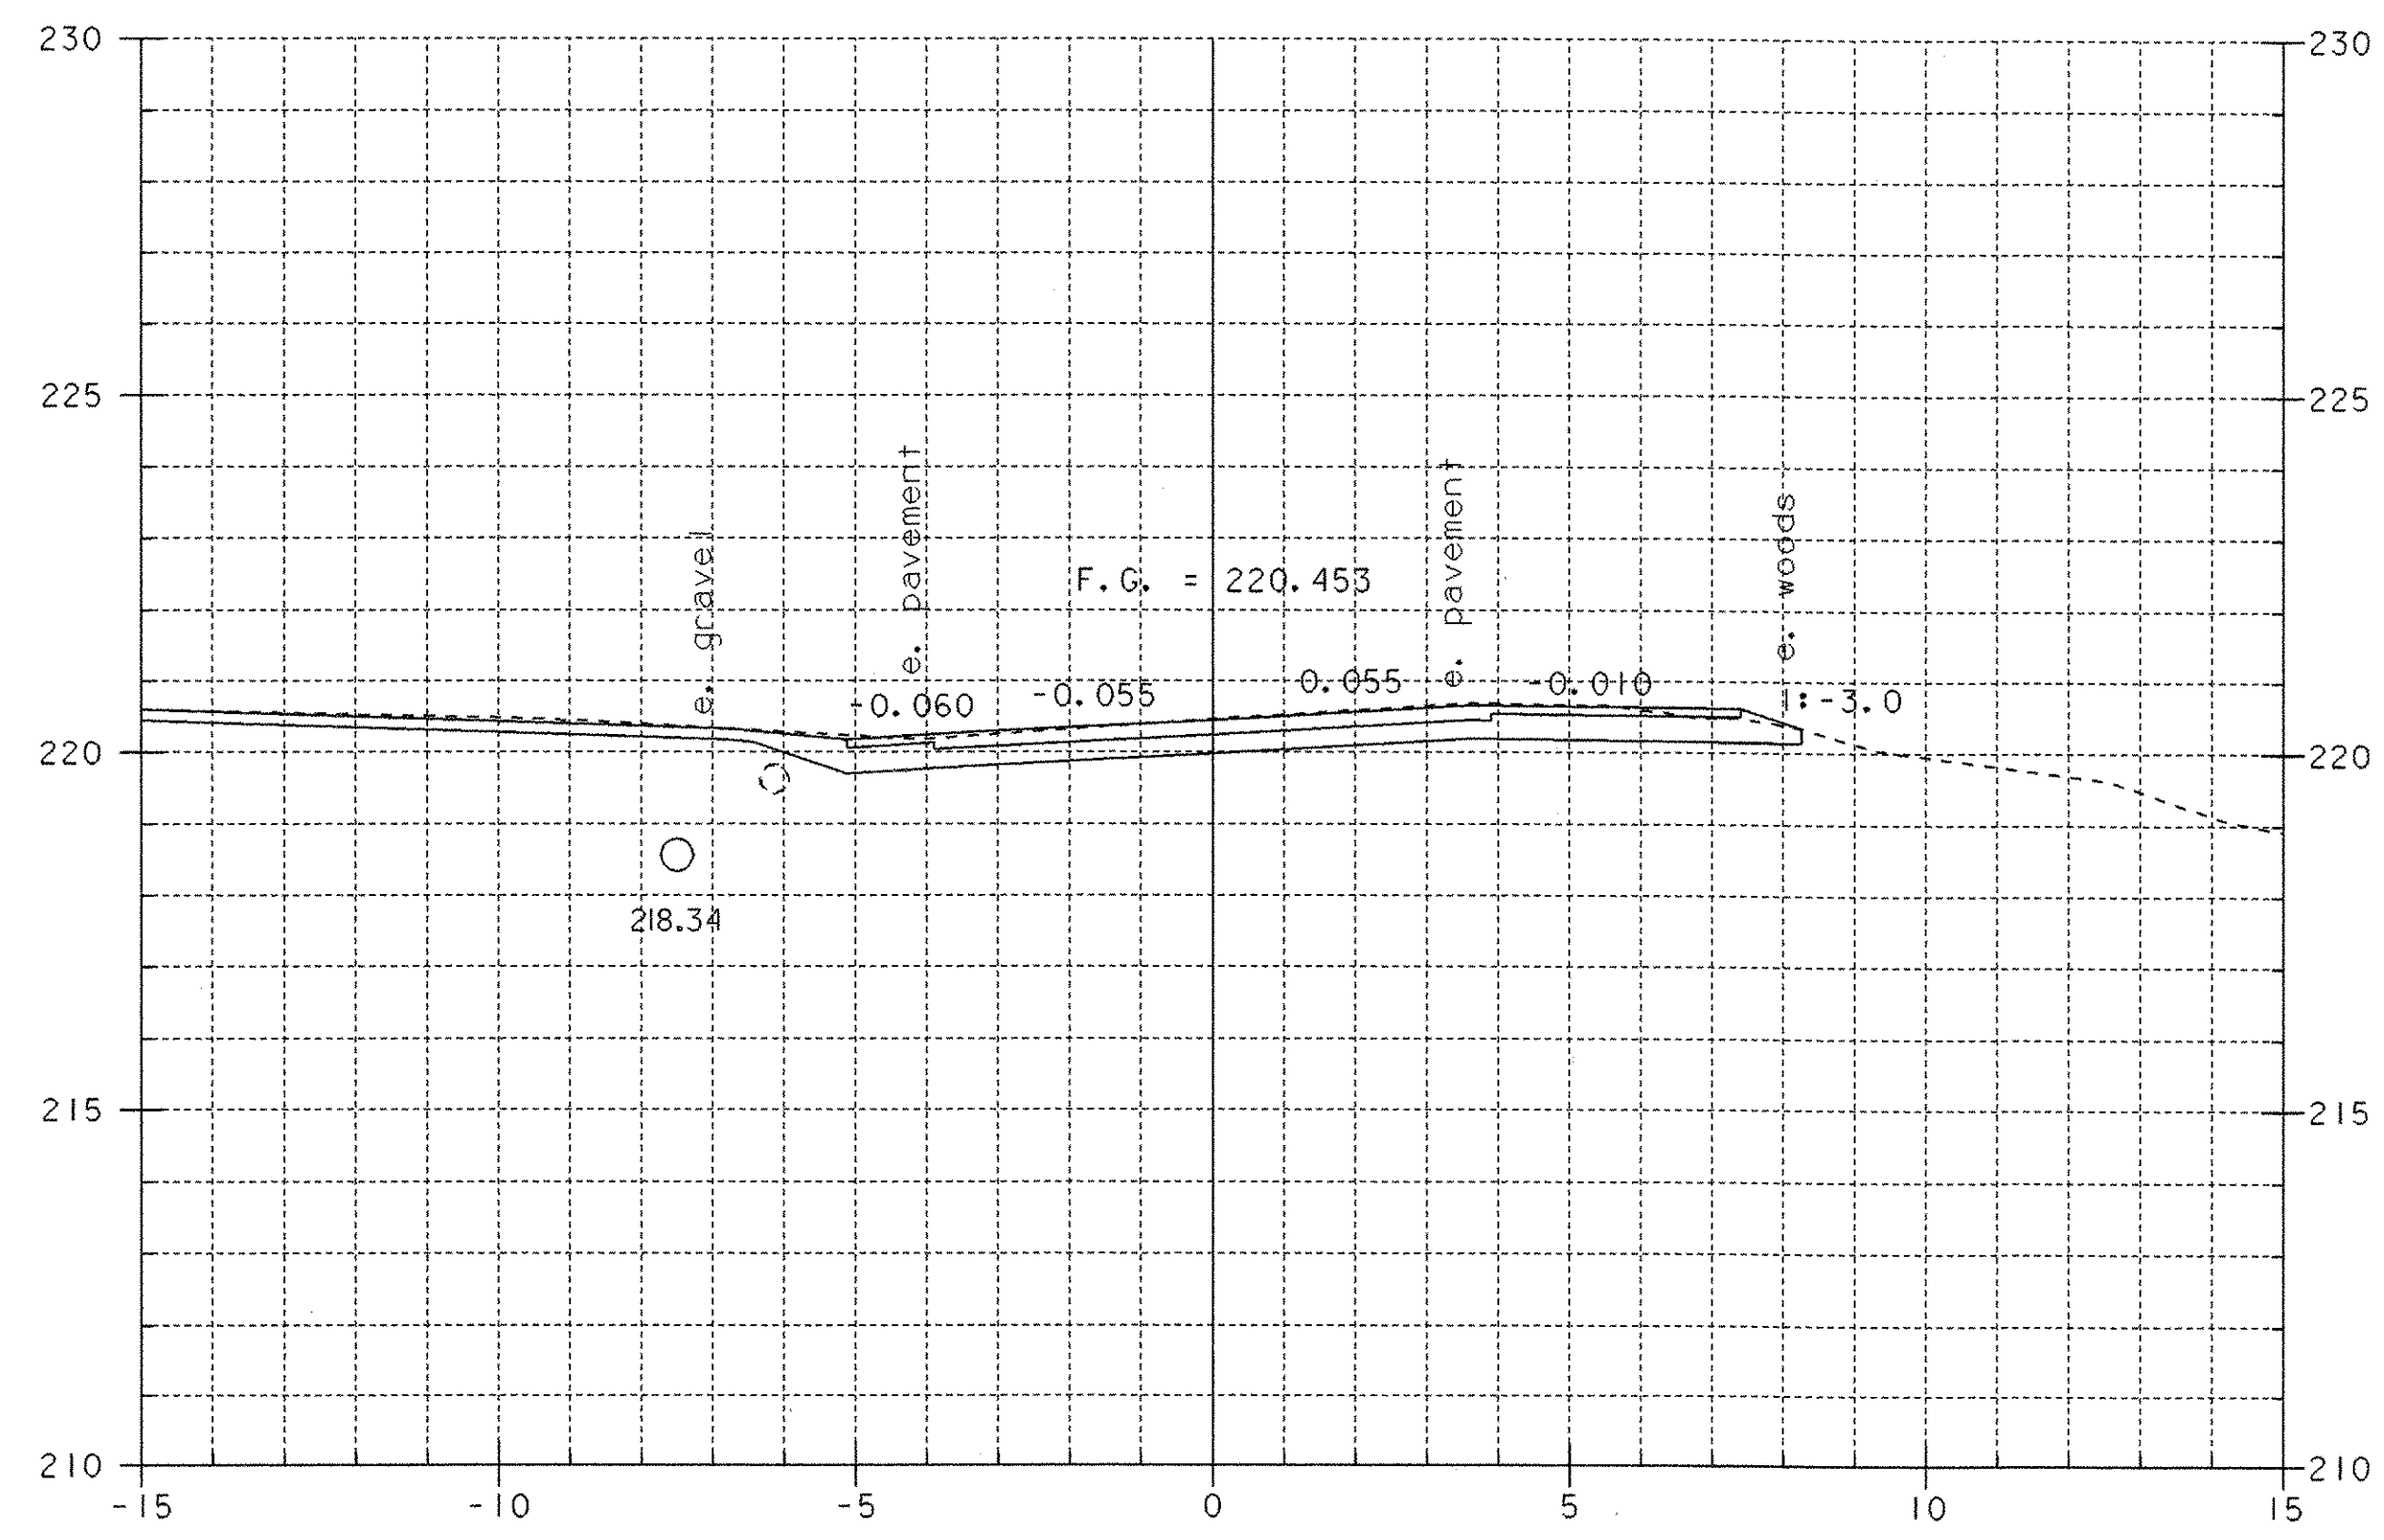


0+200

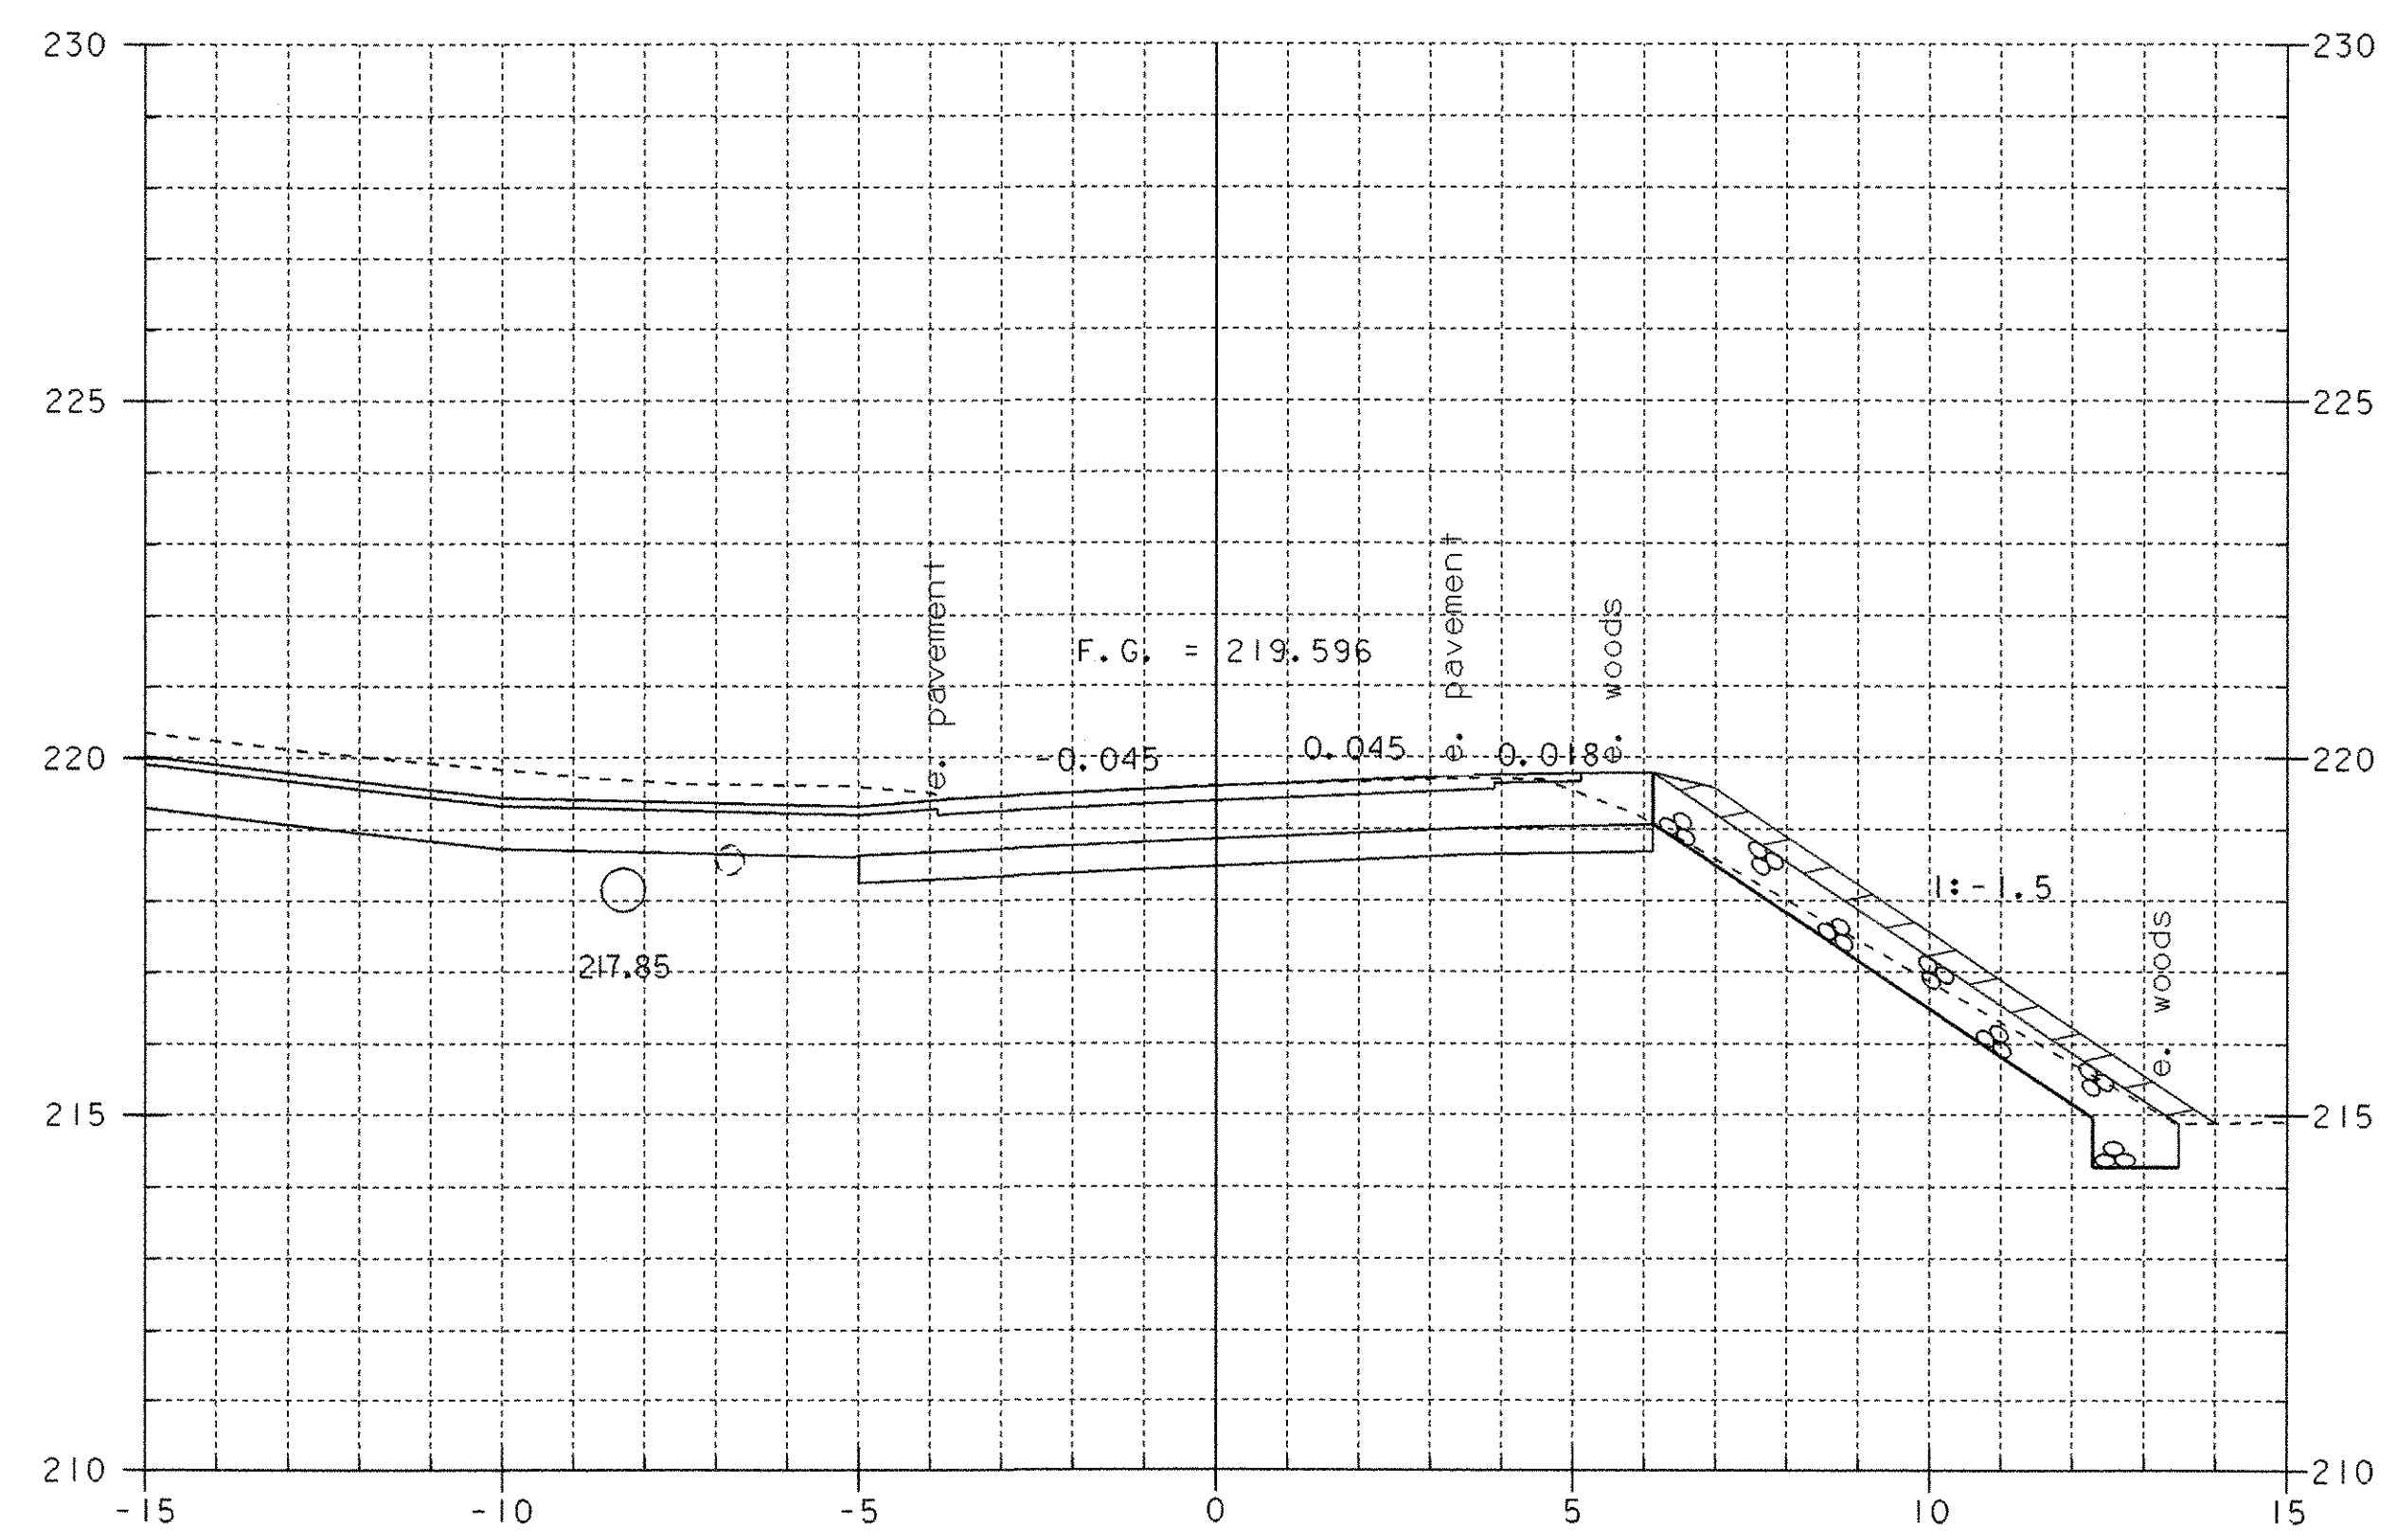

0+220

MAINLINE CROSS SECTIONS

Begin Project

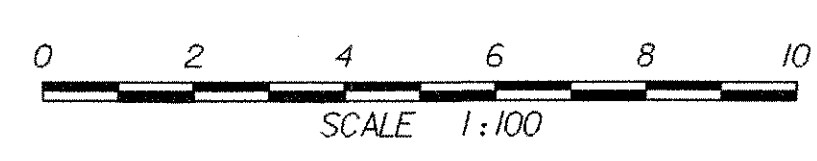

PROJECT NAME:	DUXBURY	FILE NAME:	/str5/86e059/se059xsl.dgn	PLOT DATE:	20-OCT-2005
PROJECT NUMBER:	STP 013-4(24)	PROJECT MANAGER:	C. KELLER	DRAWN BY:	R.H. PELLETT
		DESIGNED BY:	G. SHANGRAW	CHECKED BY:	T. SUMNER
			se059mx2.1	SHEET	49 OF 62