




0+260.45
End Bridge

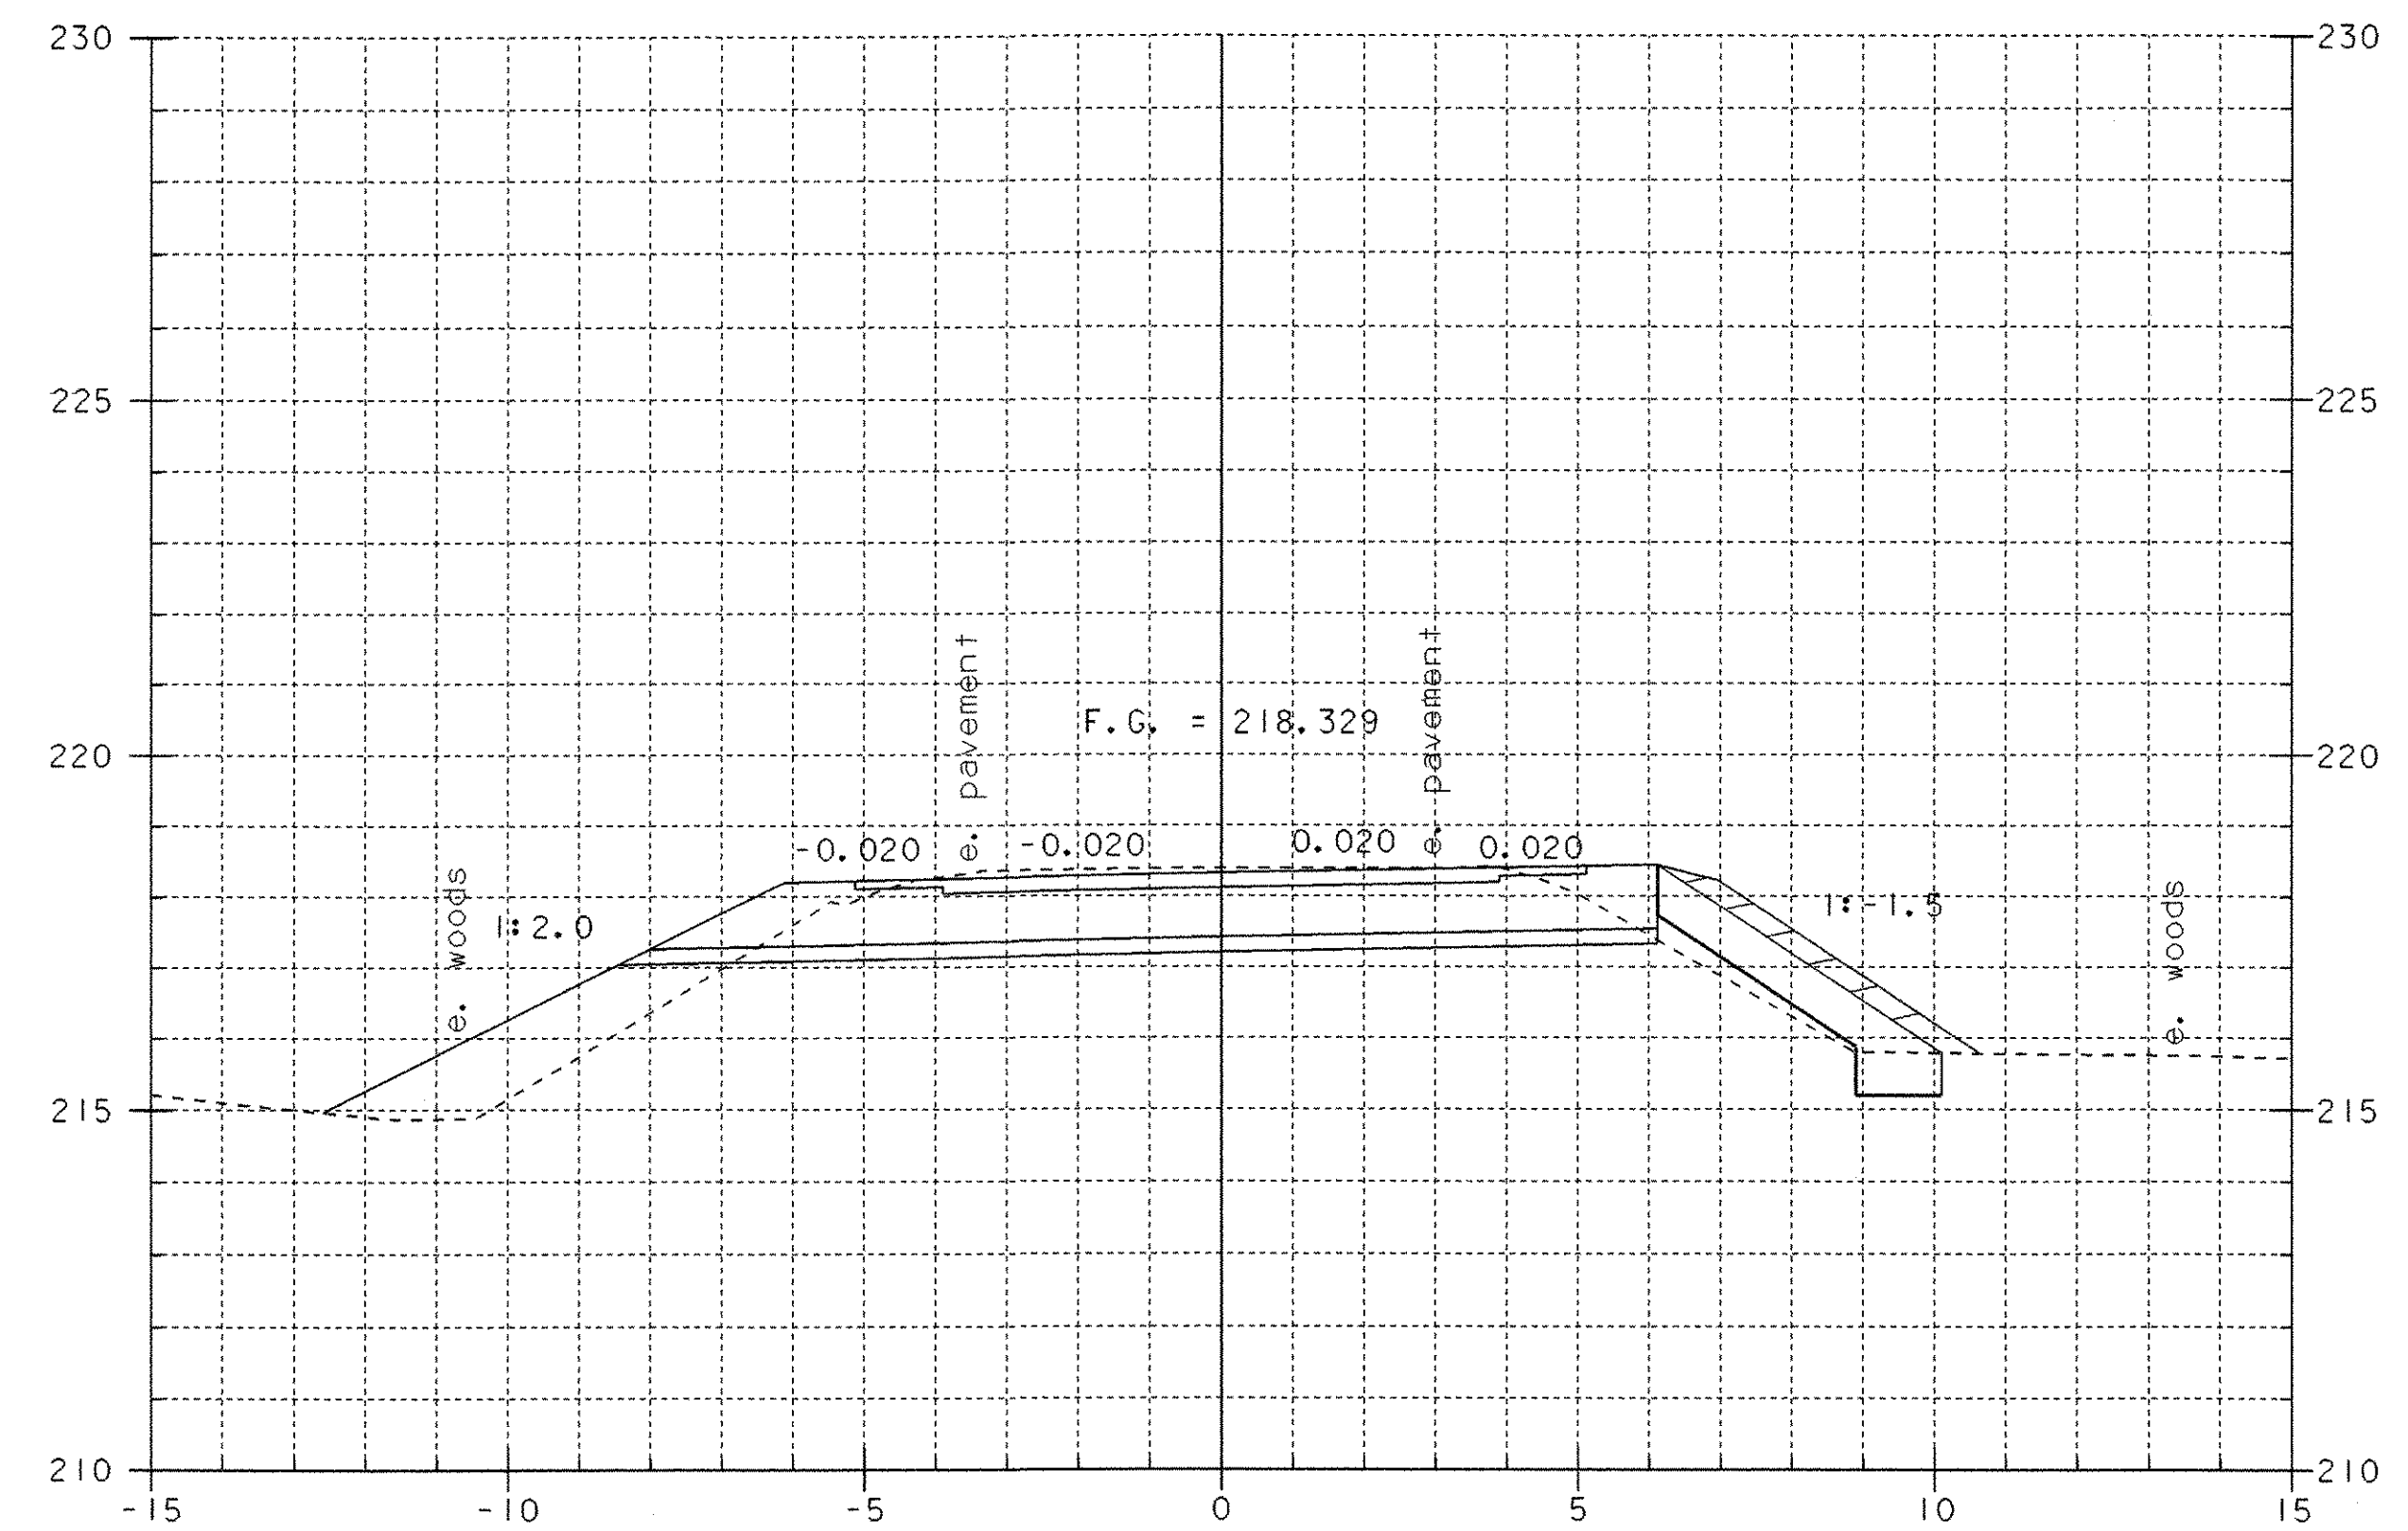

0+270

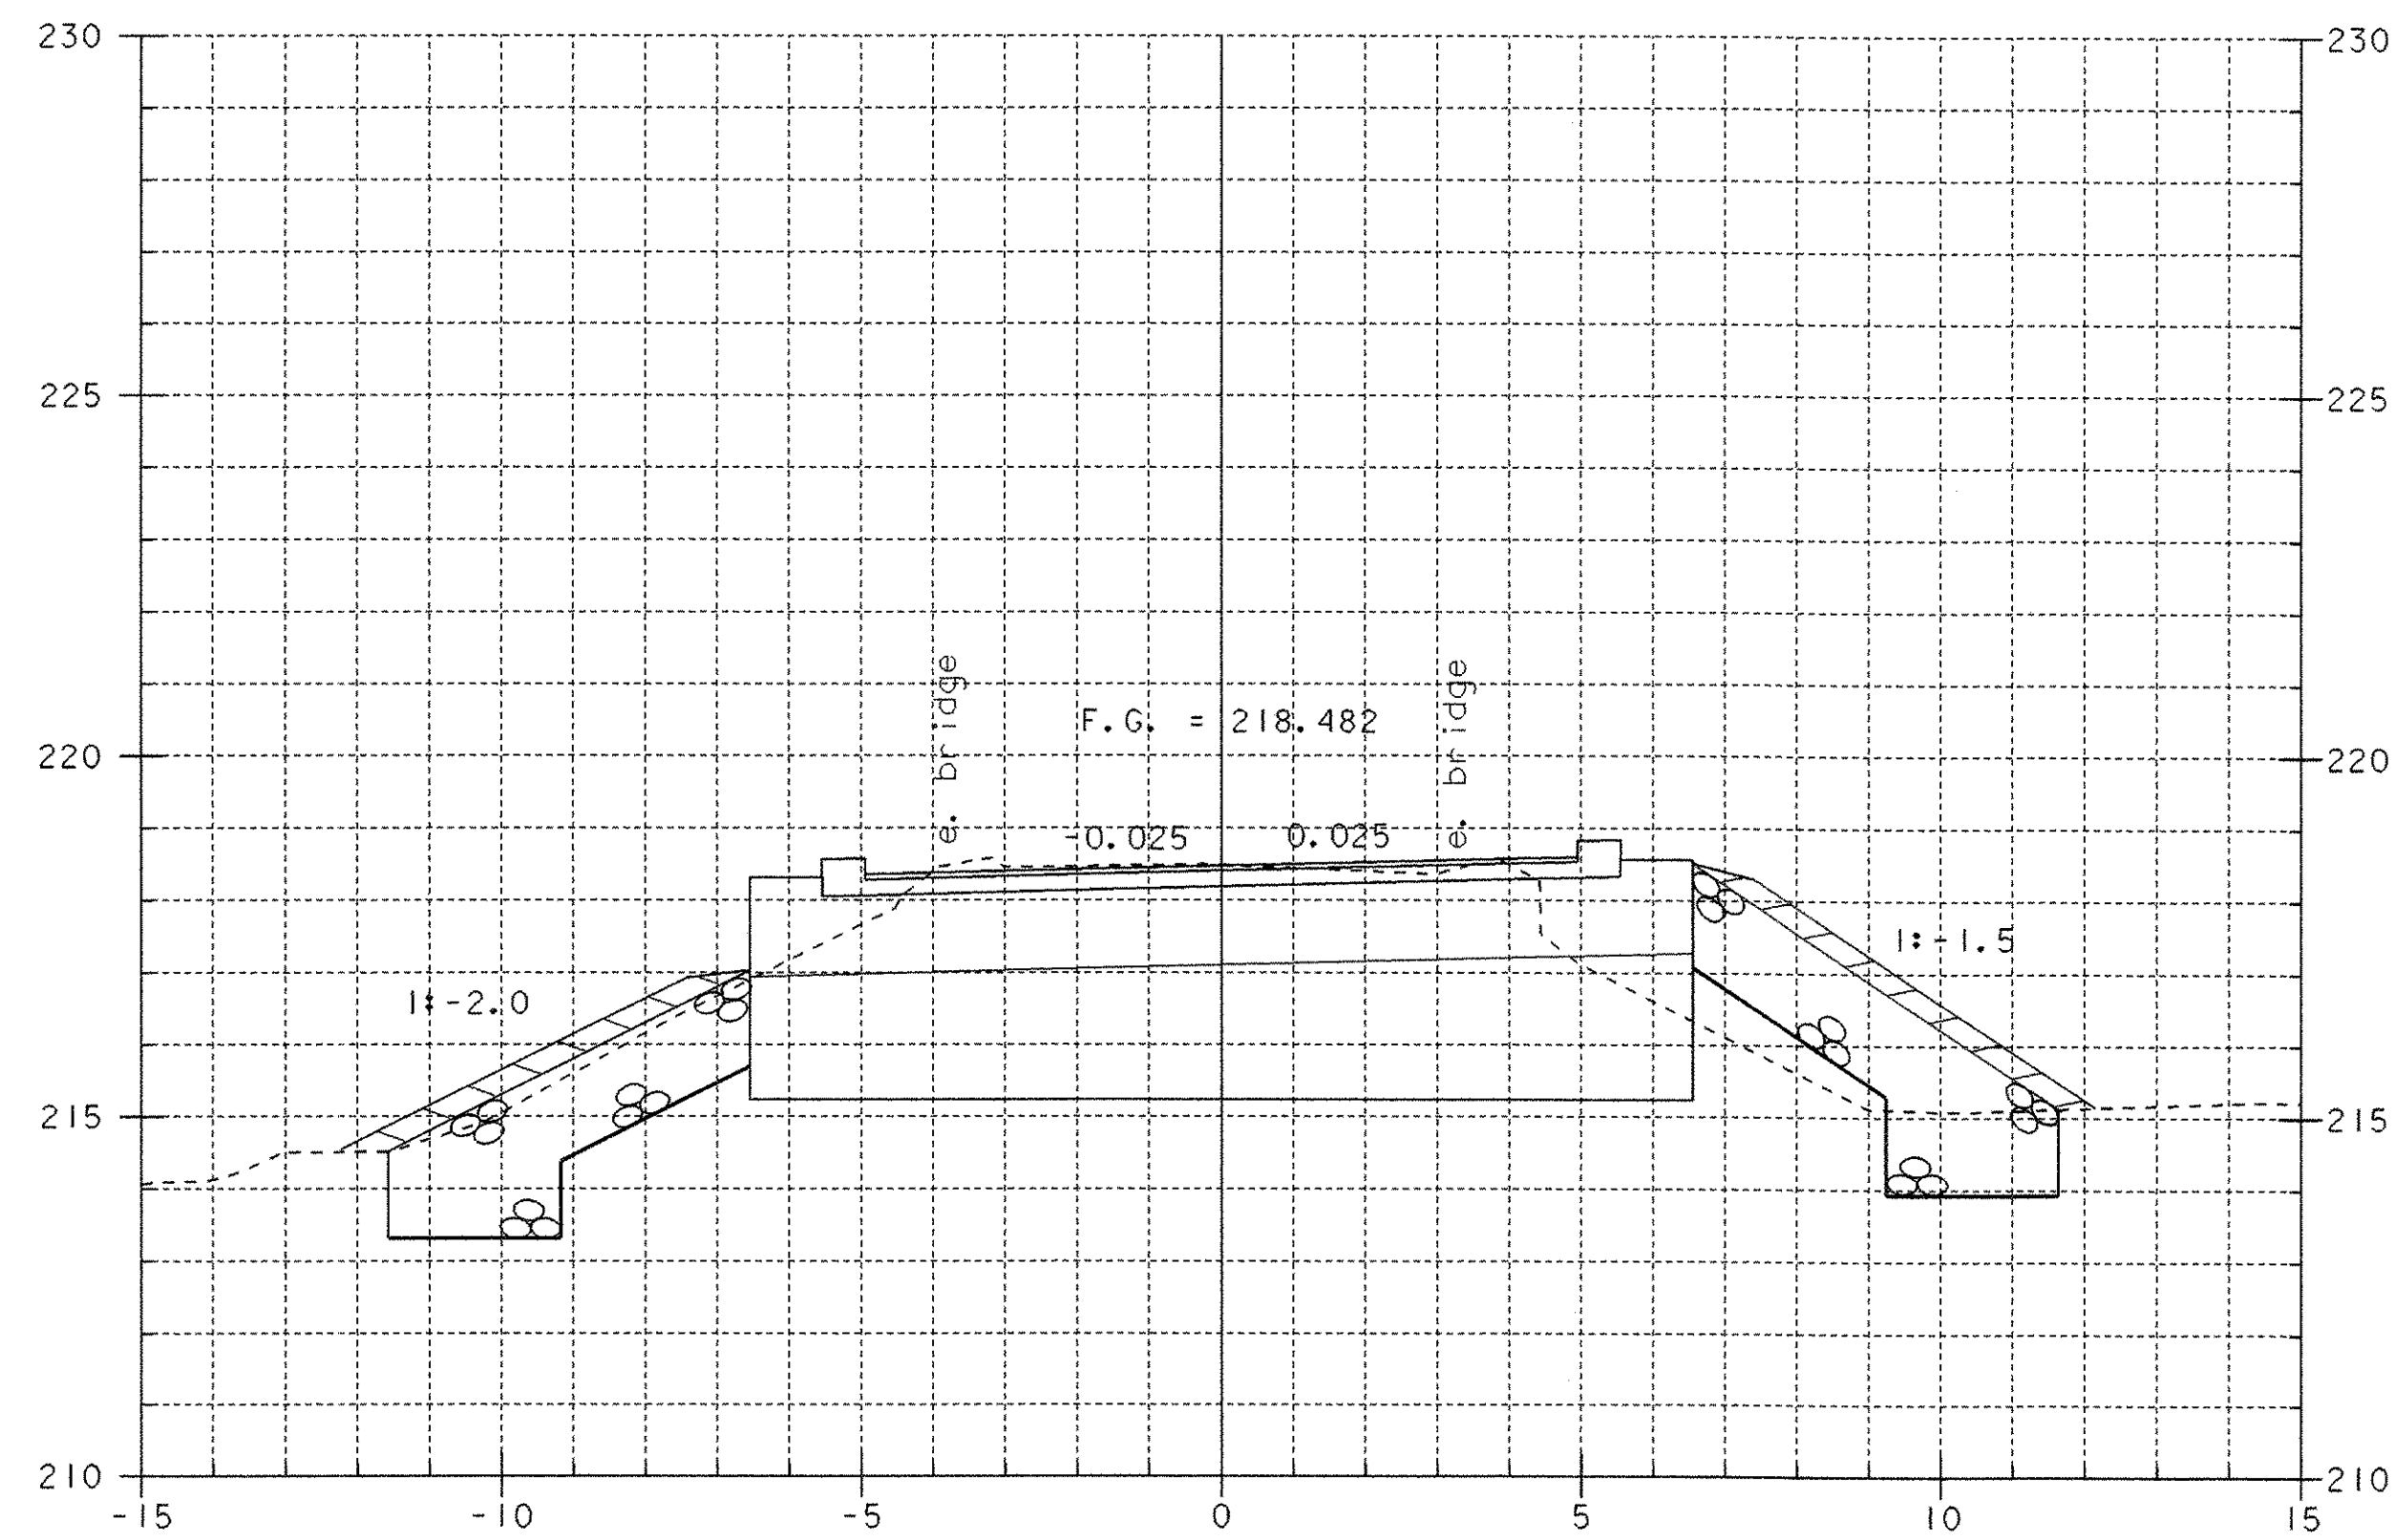


0+260

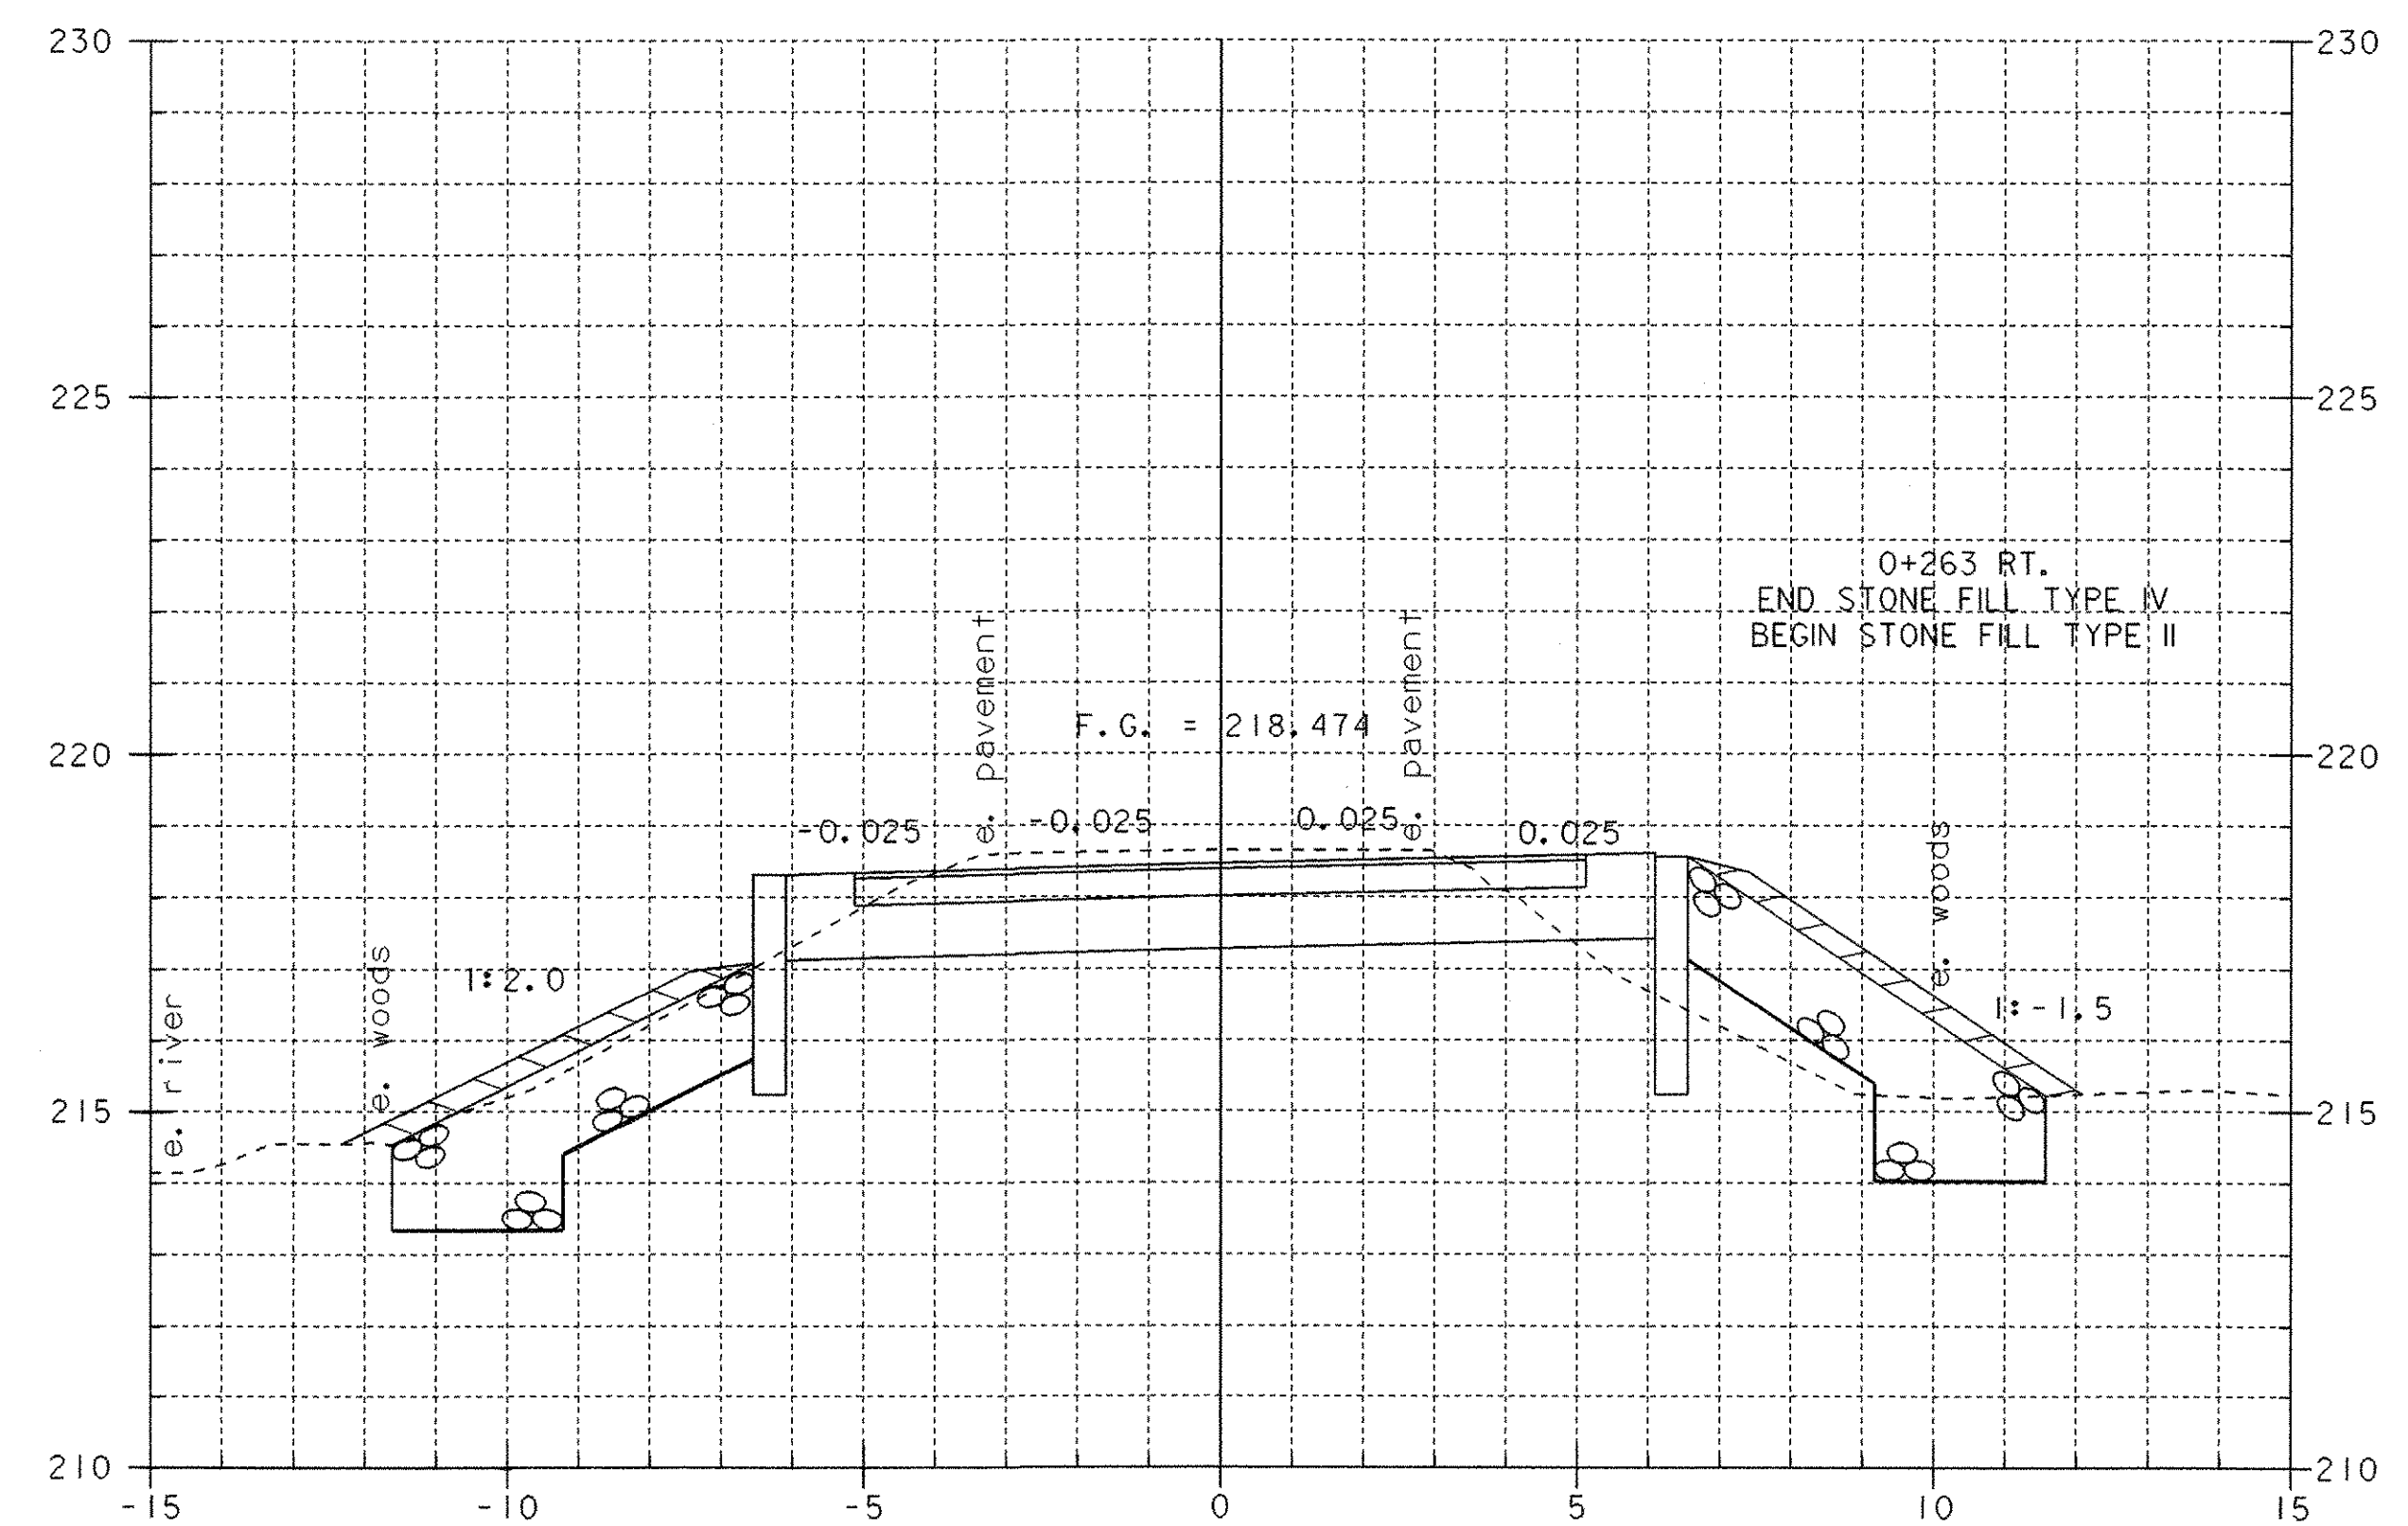

0+260.46

MAINLINE CROSS SECTIONS

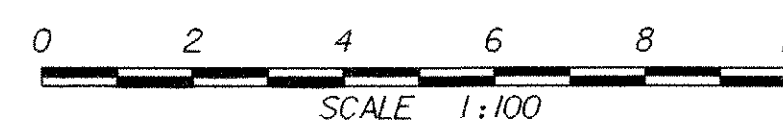

PROJECT NAME: DUXBURY	PLOT DATE: 20-OCT-2005
PROJECT NUMBER: STP 013-4(24)	DRAWN BY: R.H. PELLETT
FILE NAME: /str5/86e059/se059xsl.dgn	CHECKED BY: T. SUMNER
PROJECT MANAGER: C. KELLER	SHEET 51 OF 62
DESIGNED BY: G. SHANGRAW	
se059mx4.1	