


Mainline 0+185.335 Lt  
Begin New 450 x 27 m Option Pipe

**PIPE DI SECTION 1**

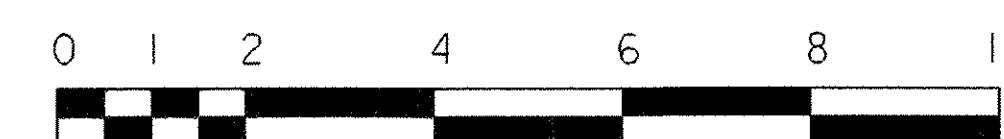

SCALE = 1:100

PROJECT NAME: DUXBURY	FILE NAME: /str5/86e059/se059xsl.dgn	PLOT DATE: 20-OCT-2005
PROJECT NUMBER: STP 013-4(24)	PROJECT MANAGER: C. KELLER	DRAWN BY: R.H. PELLETT
	DESIGNED BY: G. SHANGRAW	CHECKED BY: T. SUMNER
	se059d11.l	SHEET 54 OF 62