


Mainline 0+212 Lt  
 End (2) New 450 x 27 m Option Pipes  
 Begin New 600 x 20 m Option Pipe

**PIPE DI SECTION 2**

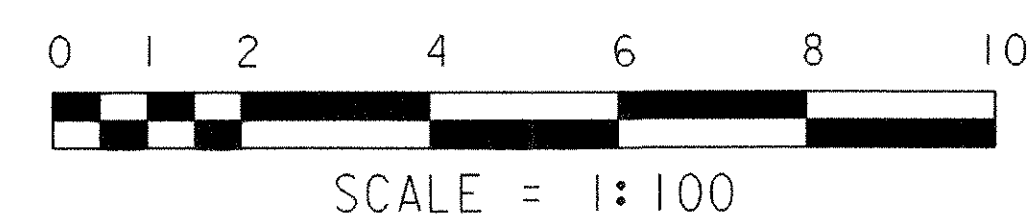

PROJECT NAME: DUXBURY	PLLOT DATE: 20-OCT-2005
PROJECT NUMBER: STP 013-4(24)	DRAWN BY: R.H. PELLETT
FILE NAME: /str5/86e059/se059xsl.dgn	CHECKED BY: T. SUMNER
PROJECT MANAGER: C. KELLER	SHEET 55 OF 62
DESIGNED BY: G. SHANGRAW	