


PIPE PROFILE UNDER TURN AROUND
NEW 450 X 13 M OPTION PIPE

PIPE PROFILE 2

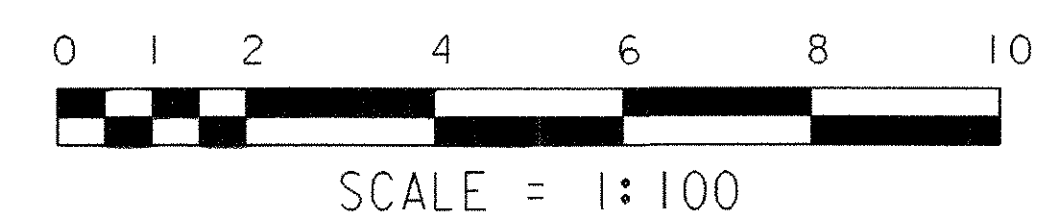

PROJECT NAME: DUXBURY	PLOT DATE: 20-OCT-2005
PROJECT NUMBER: STP 013-4(24)	DRAWN BY: R.H. PELLETT
FILE NAME: /str5/86e059/se059xsl.dgn	CHECKED BY: T. SUMNER
PROJECT MANAGER: C. KELLER	SHEET 57 OF 62
DESIGNED BY: G. SHANGRAW	