


PIPE PROFILE UNDER WARD HILL ROAD
NEW 610 X 20 OPTION PIPE

PIPE PROFILE 3

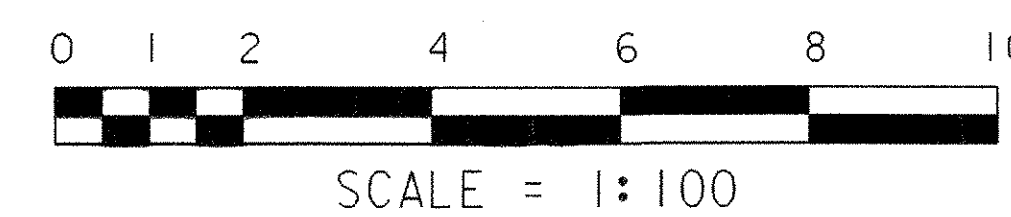

PROJECT NAME: DUXBURY	PLOT DATE: 20-OCT-2005
PROJECT NUMBER: STP 013-4(24)	DRAWN BY: R.H. PELLETT
FILE NAME: /str5/86e059/se059xsl.dgn	CHECKED BY: T. SUMNER
PROJECT MANAGER: C. KELLER	SHEET 58 OF 62
DESIGNED BY: G. SHANGRAW	
se059d15.1	