


BILL OF MATERIAL (BOTH SIDES OF BRIDGE)	
Qty.	Description
20	W150x37.1 POST W/BASEPLATE (620mm) OAL
4	W150x37.1 DRIVEN POST (2.134m) OAL
4	W150x37.1 DRIVEN POST (1.956m) OAL
4	TS 203 x 102 x 8 (3.93m) OAL
2	TS 203 x 102 x 8 (6.39m) OAL
2	TS 203 x 102 x 8 (7.29m) OAL
4	TS 102 x 102 x 6 (3.93m) OAL
2	TS 102 x 102 x 6 (6.39m) OAL
2	TS 102 x 102 x 6 (7.29m) OAL
4	TS 203 x 102 x 8 (2.483m) OAL CUT AND WELD
4	TS 102 x 102 x 6 (2.483m) OAL CUT AND WELD
10	TS 178 x 76 x 10 SPLICE TUBE 510 LG.
10	TS 76 x 76 x 8 SPLICE TUBE 510 LG.
20	3mm BEARING PAD
4	BACK UP PLATE 381x254x10
4	TERMINAL CONNECTOR
136	M20 ROUND HEAD BOLT, 152 LONG W/NUT AND WASHER
80	M16 SPLICE BOLT, 44 LONG W/PLAIN HARDENED WASHER
* 80	M24 ANCHOR STUD, 305 LG. W/(2) HEX NUTS/(1) JAMB NUT/(1) WASHER
* 20	SPACER PLATE 330 x 238 x 10
16	M20 x 13 SCH. 40 PIPE SPACER

ITEMS MARKED "*" ARE NOT SUPPLIED BY HIGHWAY SAFETY CORPORATION, AND THEY ARE SHOWN ONLY FOR REFERENCE.

TOTAL ITEM 525.33 (BOTH SIDES OF BRIDGE) = 54m

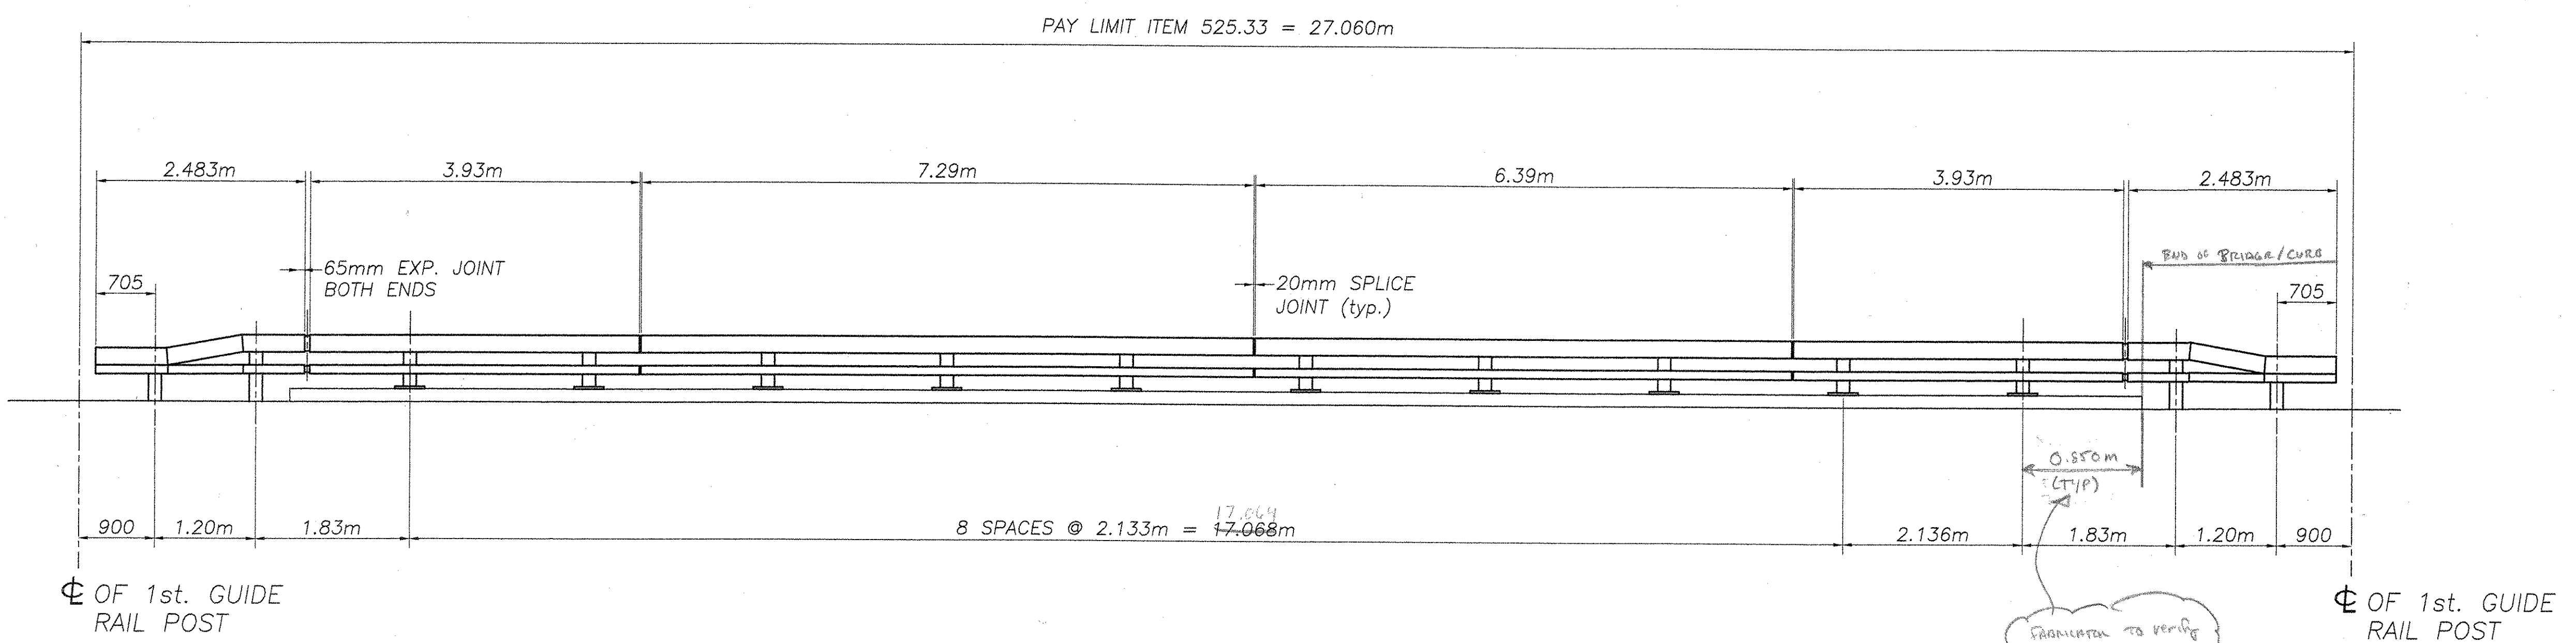

RAIL ELEVATION
LOOKING UPSTREAM
DOWNSTREAM SIMILAR

STRUCTURES COPY

RECEIVED
OK'D BY JTR
FEB 22 2006
RESUBMIT APPROVED As Noted
BY Wjg Date 3/13/06



REVISIONS		
No.	Remarks	Date
0	Initial submittal	

HIGHWAY SAFETY CORP. GLASTONBURY, CT	
ITEM 525.33 - BRIDGE RAILING-NETC 2 RAIL	DRAWN MHM
PROJECT No. STP 013-4(24)	CHECKED [Signature]
TOWN OF DUXBURY Br. No. 187	DATE 1-25-06
WASHINGTON COUNTY, ROUTE NO: VT 100	SCALE NONE
	HSC REFERENCE NO. 1533
GENERAL CONTRACTOR	SIZE D REVISION 0
SUB CONTRACTOR	SHEET NO.
F.R. LAFAYETTE, INC.	1 of 2