



THE GRADES SHOWN TO THE NEAREST TENTH ARE THE ORIGINAL GROUND ELEVATIONS ALONG THE PROPOSED ALIGNMENT.

THE GRADES SHOWN TO THE NEAREST HUNDREDTH ARE THE FINISH GRADES ALONG THE PROPOSED ALIGNMENT.

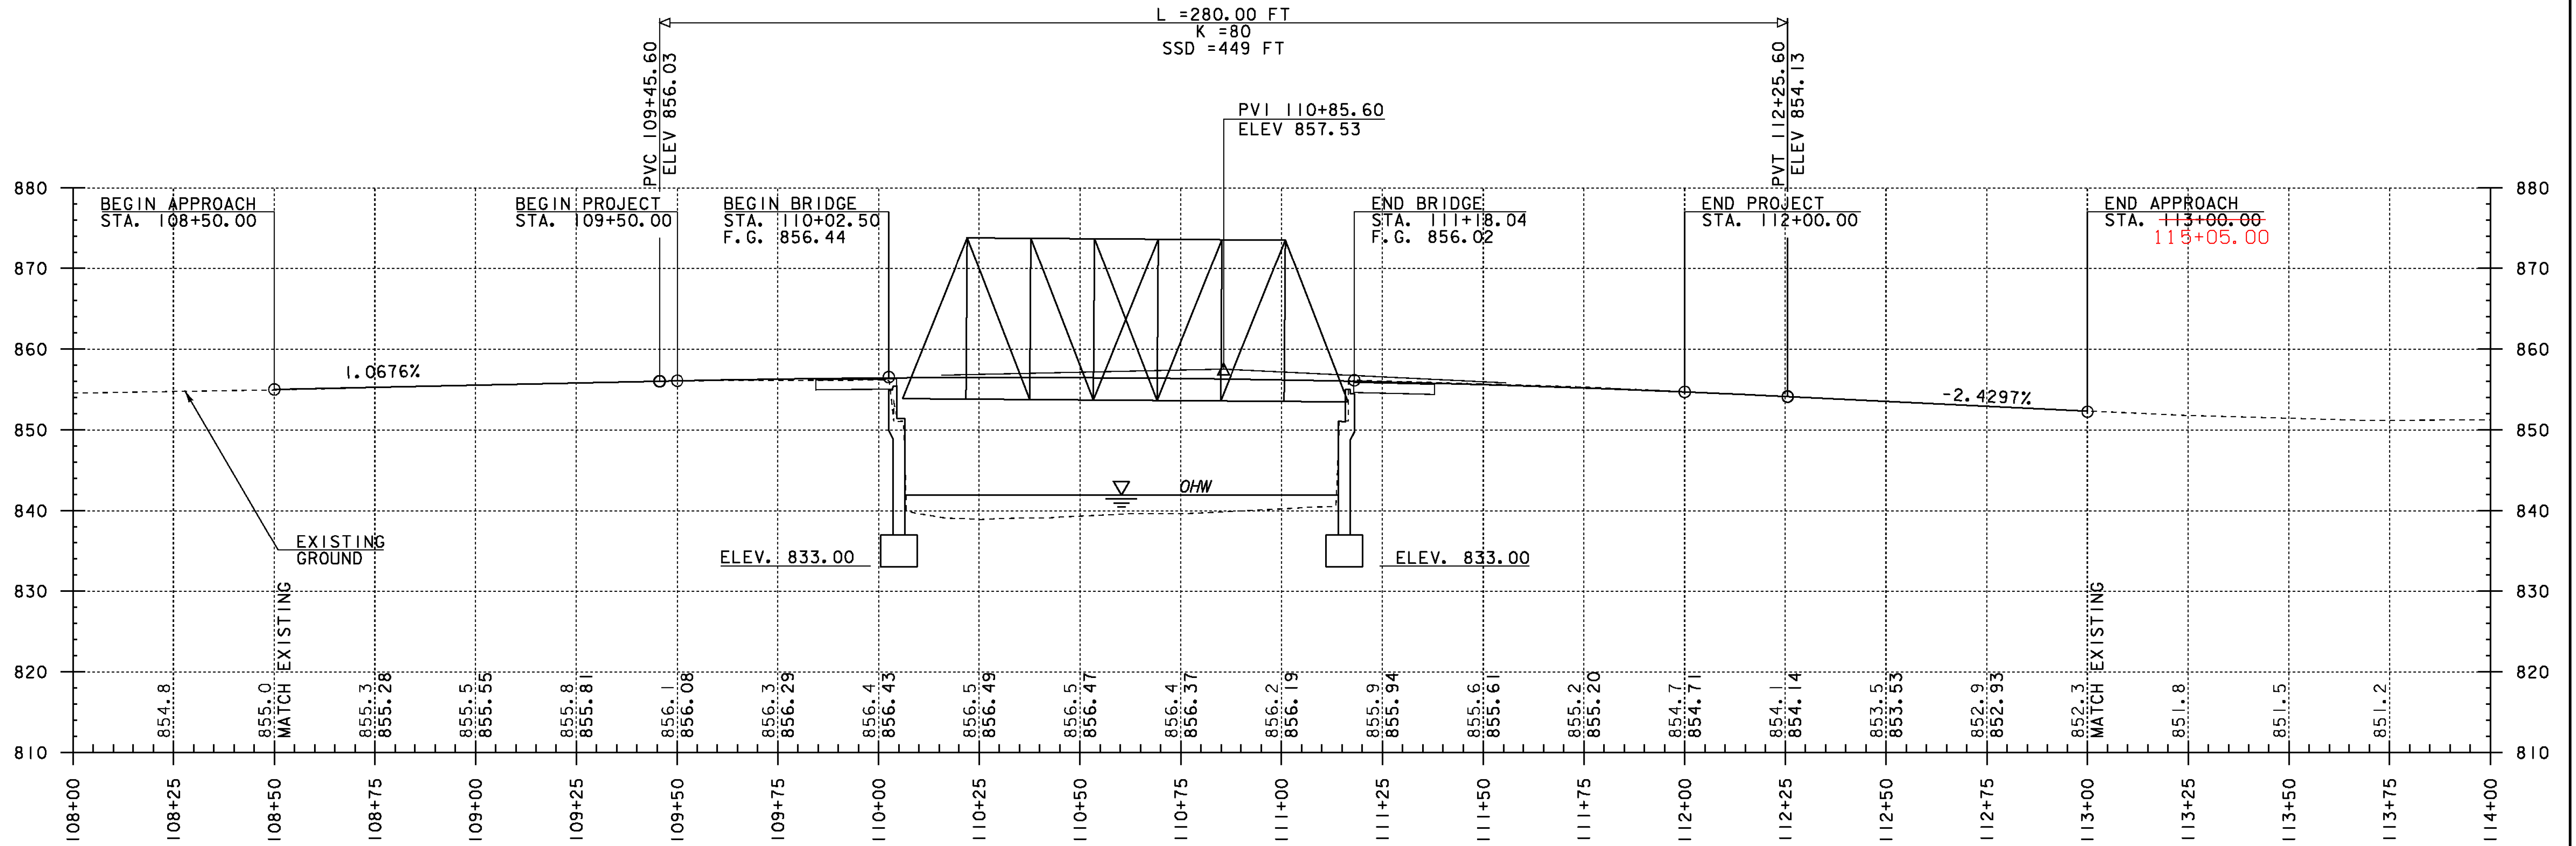

MAINLINE PROFILE
 HOR. SCALE 1" = 20'
 VER. SCALE 1" = 10'

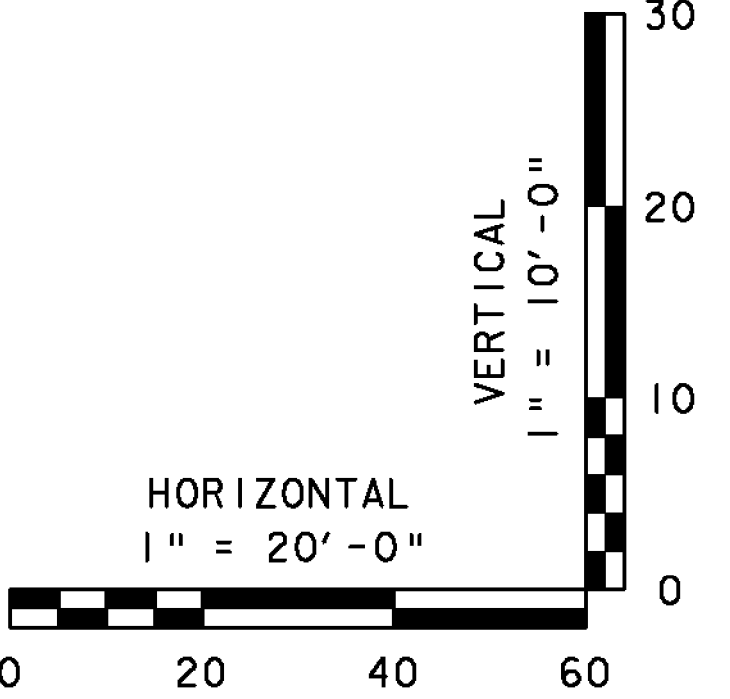

PROJECT NAME: BRIDGEWATER	
PROJECT NUMBER: BRS 0149(4)	
FILE NAME: s86e062xs.dgn	PLOT DATE: 31-DEC-2009
PROJECT LEADER: K. HIGGINS	DRAWN BY: J. SALVATORI
DESIGNED BY: T. FILLBACH	CHECKED BY: T. FILLBACH
PROFILE	SHEET 10 OF 58